



02780	UNIT PAVERS			0.000	DEMOLITION	
02780.A5	Concrete Pavers			0.014	remove existing railings and curbs, typical	
02821	CHAIN-LINK FENCES AND GATES			0.016	remove existing pool depth markers, typical	
02821.A1	Chain-Link Fence	10801.P2	Diaper-Changing Station, surface mounted	0.016	remove existing lifeguard stands, typical	
02821.B1	Single Swing Gate	10801.G1	Underlayment Guard	0.017	remove existing flagpole	
02821.B2	Double Swing Gate	10801.R2	Mop and Broom Holder with Utility Shelf	0.018	remove existing drain to slab level	
02821.B5	Single Horizontal Slide Gate			0.019	remove existing balluster	
03300	CAST-IN-PLACE CONCRETE			0.021	fill existing trench to match existing floor	
03300.A5	Concrete Slab-on-Grade	13110	SWIMMING POOLS	0.022	remove existing light fixture	
03300.A1	Concrete Slab	13110.D2	Pool Interior Finish	0.031	remove curb to exist pool deck level	
03300.D1	Concrete Footing			0.034	line of pool deck slab above remove existing concrete sidewalk, typical	
03300.E2	Concrete Wall	13110.E4	Recessed Lane Line & Rope Anchors	0.035	remove existing curb to slab level	
03300.F1	Concrete Curb	13110.L1	Main Drain Box	0.043	patch cracks and imperfections on underside existing pool deck slab	
03300.F2	Concrete Equipment Base	13110.L2	Lifeguard Chairs	0.044	remove existing masonry as required for new opening	
03300.H1	Reinforcing Bars	13110.M1	S.S. Ladder	0.046	remove existing concrete louver	
04720	CAST STONE			0.052	remove mortar from perimeter joints	
04720.A9	Cast stone monument			0.054	remove existing downspout and scupper	
04810	UNIT MASONRY ASSEMBLIES			0.074	remove existing steel plate	
04810.A1	Concrete Masonry Unit			0.081	remove existing handrail	
04810.E1	Face Brick			0.081	remove existing expansion joint sealant, typical	
04801	CLAY MASONRY RESTORATION AND CLEANING			0.094	remove existing door and frame	
04801.A1	Face Brick			0.094	remove existing raised floor	
04801.E1	Clean Brickwork			0.121	existing curbing, sandblast and epoxy coat, paint to match new	
04801.F1	Remove Paint			0.122	top of existing concrete curb	
04801.H1	Repoint Masonry			0.131	existing concrete slab to remain	
04801.H2	Repoint Brick			0.132	existing concrete poles to remain	
05621	PIPE AND TUBE RAILINGS			0.133	existing trench to remain	
05621.A2	Aluminum Tube Railing			0.134	existing concrete pier to remain	
05621.B2	Stainless-Steel Tube Railing			0.135	existing pool deck slab to remain	
07210	BUILDING INSULATION			0.137	existing concrete railing to remain	
07210.A1	Extruded-Polystyrene Board Insulation			0.138	existing precast parapet cap	
08220	PORTLAND CEMENT PLASTER			0.139	existing ballusters to remain	
08220.A1	Portland Cement Plaster			0.141	existing masonry to remain	
08280	GYPSON BOARD ASSEMBLIES			0.141	existing masonry to remain	
08280.B1	Steel Studs			0.143	existing brick wall	
08511	ACOUSTICAL PANEL CEILINGS			0.203	remove existing curb	
08511.A1	Suspended Acoustical Panel Ceiling System			0.208	remove existing sign	
08511.A2	Suspended Gypsum Based Panel Ceiling System			0.213	remove existing chain link fence	
09545	METAL CEILINGS			0.284	existing fence to remain	
09545.A1	Suspended Metal Ceiling System			0.353	existing concrete structure to remain	
09851	RESILIENT TILE FLOORING			0.704	remove existing light fixture and metal pole	
09851.A5	Vinyl Composition Tile			0.758	existing concrete light pole to remain	
09851.B1	Wall Base			1.000	ARCHITECTURAL	
09851.C1	Steel Tread			1.012	well	
09851.C3	Stair Stringer			1.027	exposed structure	
09851.E1	Cap for cone carpet			1.031	pool depth markers	
09851.E7	Reducer strip for resilient flooring			1.032	roof drain	
09851.E8	Tile and carpet jointer			1.033	extend flashing beyond clamping ring	
09871	RESINOUS FLOORING			1.034	2 x 12 roof joist	
09871.A1	Resinous Flooring			1.035	extend field plies 6" min. above head of cant	
09880	CARPET			1.036	seal top of flashing with a 3-course of vertical grade	
09880.A1	Carpet - CPT-1			1.063	roof cement and reinforcement fabric	
09912	PAINTING			1.078	expansion joint	
09912.A4	Paint, Low-Luster			1.108	entire pool deck to be pavers	
09912.A5	Paint, Semi-Gloss			2.000	refrigerator (n.l.e.)	
09912.C1	Acrylic-Enamel Finish			2.013	SITWORK	
09912.D1	Textured Coating			2.021	concrete sidewalk	
10350	FLAGPOLES			2.027	tooled edge	
10350.A1	Aluminum flagpoles			2.057	concrete apron	
10505	METAL LOCKERS			2.102	tooled control joint	
10505.B3	Athletic Lockers, Double tier			2.104	expansion joint material	
10505.C1	Locker benches			2.157	repair existing gap in fence	
10520	FIRE-PROTECTION SPECIALTIES			4.000	PLUMBING	
10520.A1	Portable Fire Extinguishers			4.051	roof drain	
10520.K1	Fire Extinguisher Cabinet			4.205	mop sink (floor mounted)	
10570	EDUCATIONAL SPECIALTIES			4.255	prefabricated shower	
10570.D2	Colling Mount TV Bracket			4.301	electric water cooler	
10801	TOILET AND BATH ACCESSORIES			4.354	water fountain	
10801.A1	Toilet Tissue (Roll) Dispenser			7.000	ELECTRICAL	
10801.E2	Liquid-Soap Dispenser			7.121	pole light fixture	
10801.F1	Grab Bar			7.123	globe light fixture	
10801.G6	Sanitary Napkin Disposal Unit, Recessed					
10801.G7	Sanitary Napkin Disposal Unit, Partition-Mounted, Dual-Access					
10801.J1	Mirror Unit					
10801.N7	Warm-Air Dryer, Surface mounted, Electronic-sensor Operation					

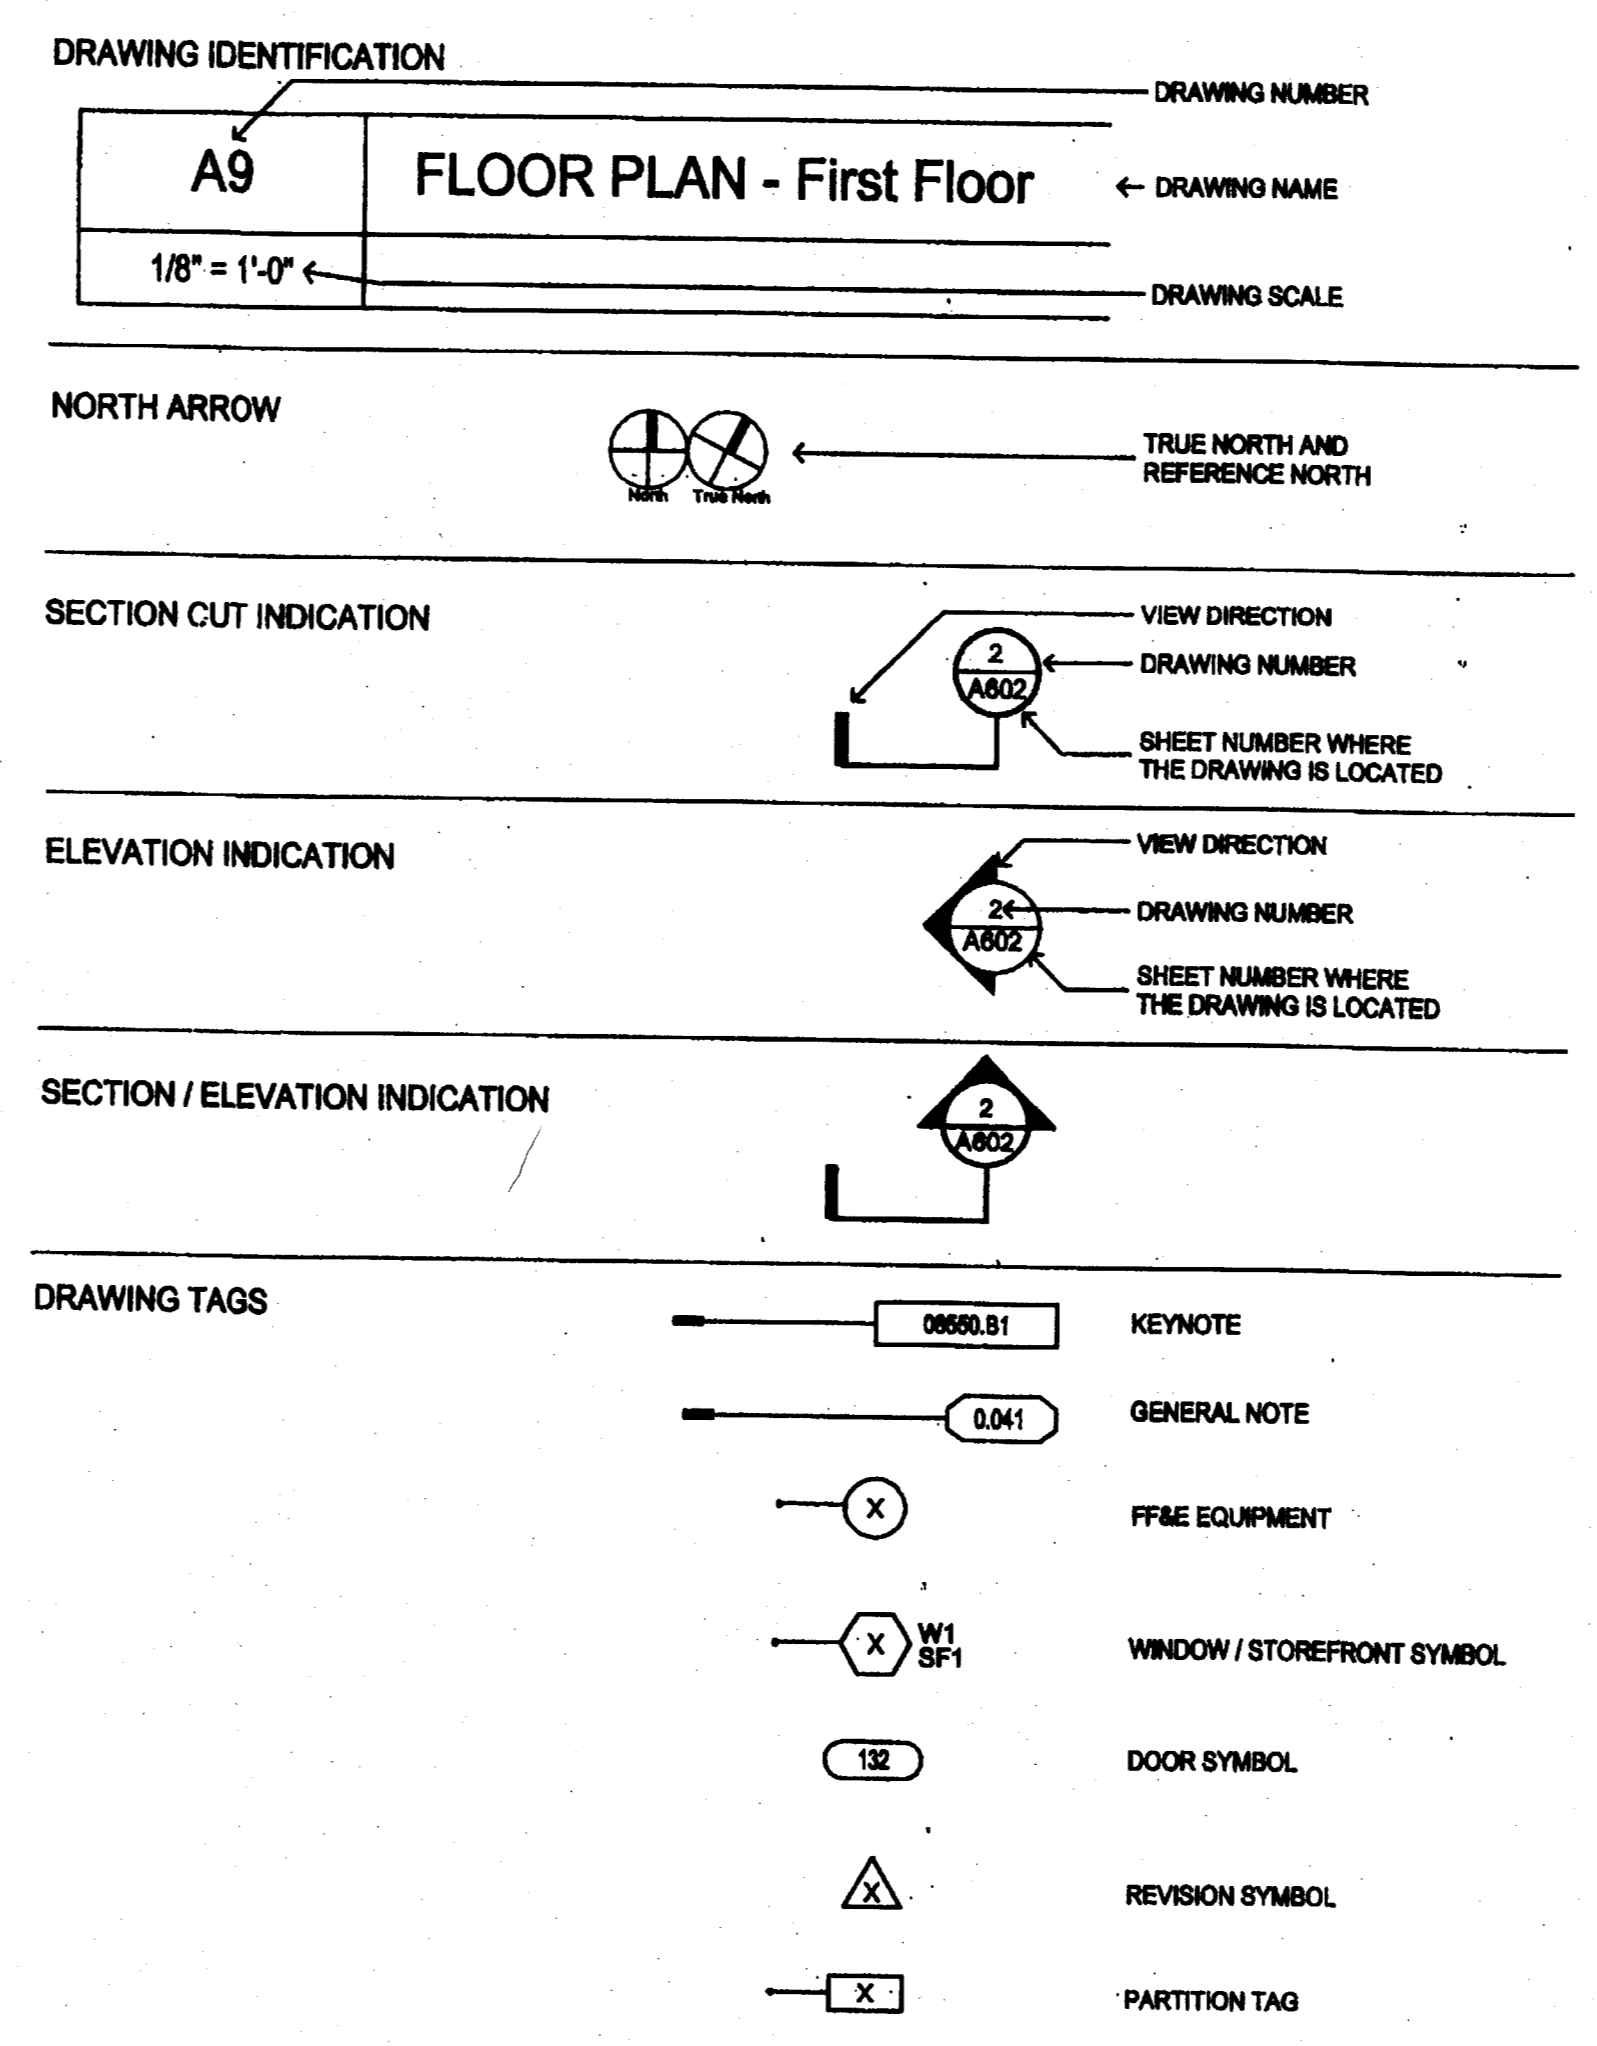

F8 ARCHITECTURAL DRAWING SYMBOLS

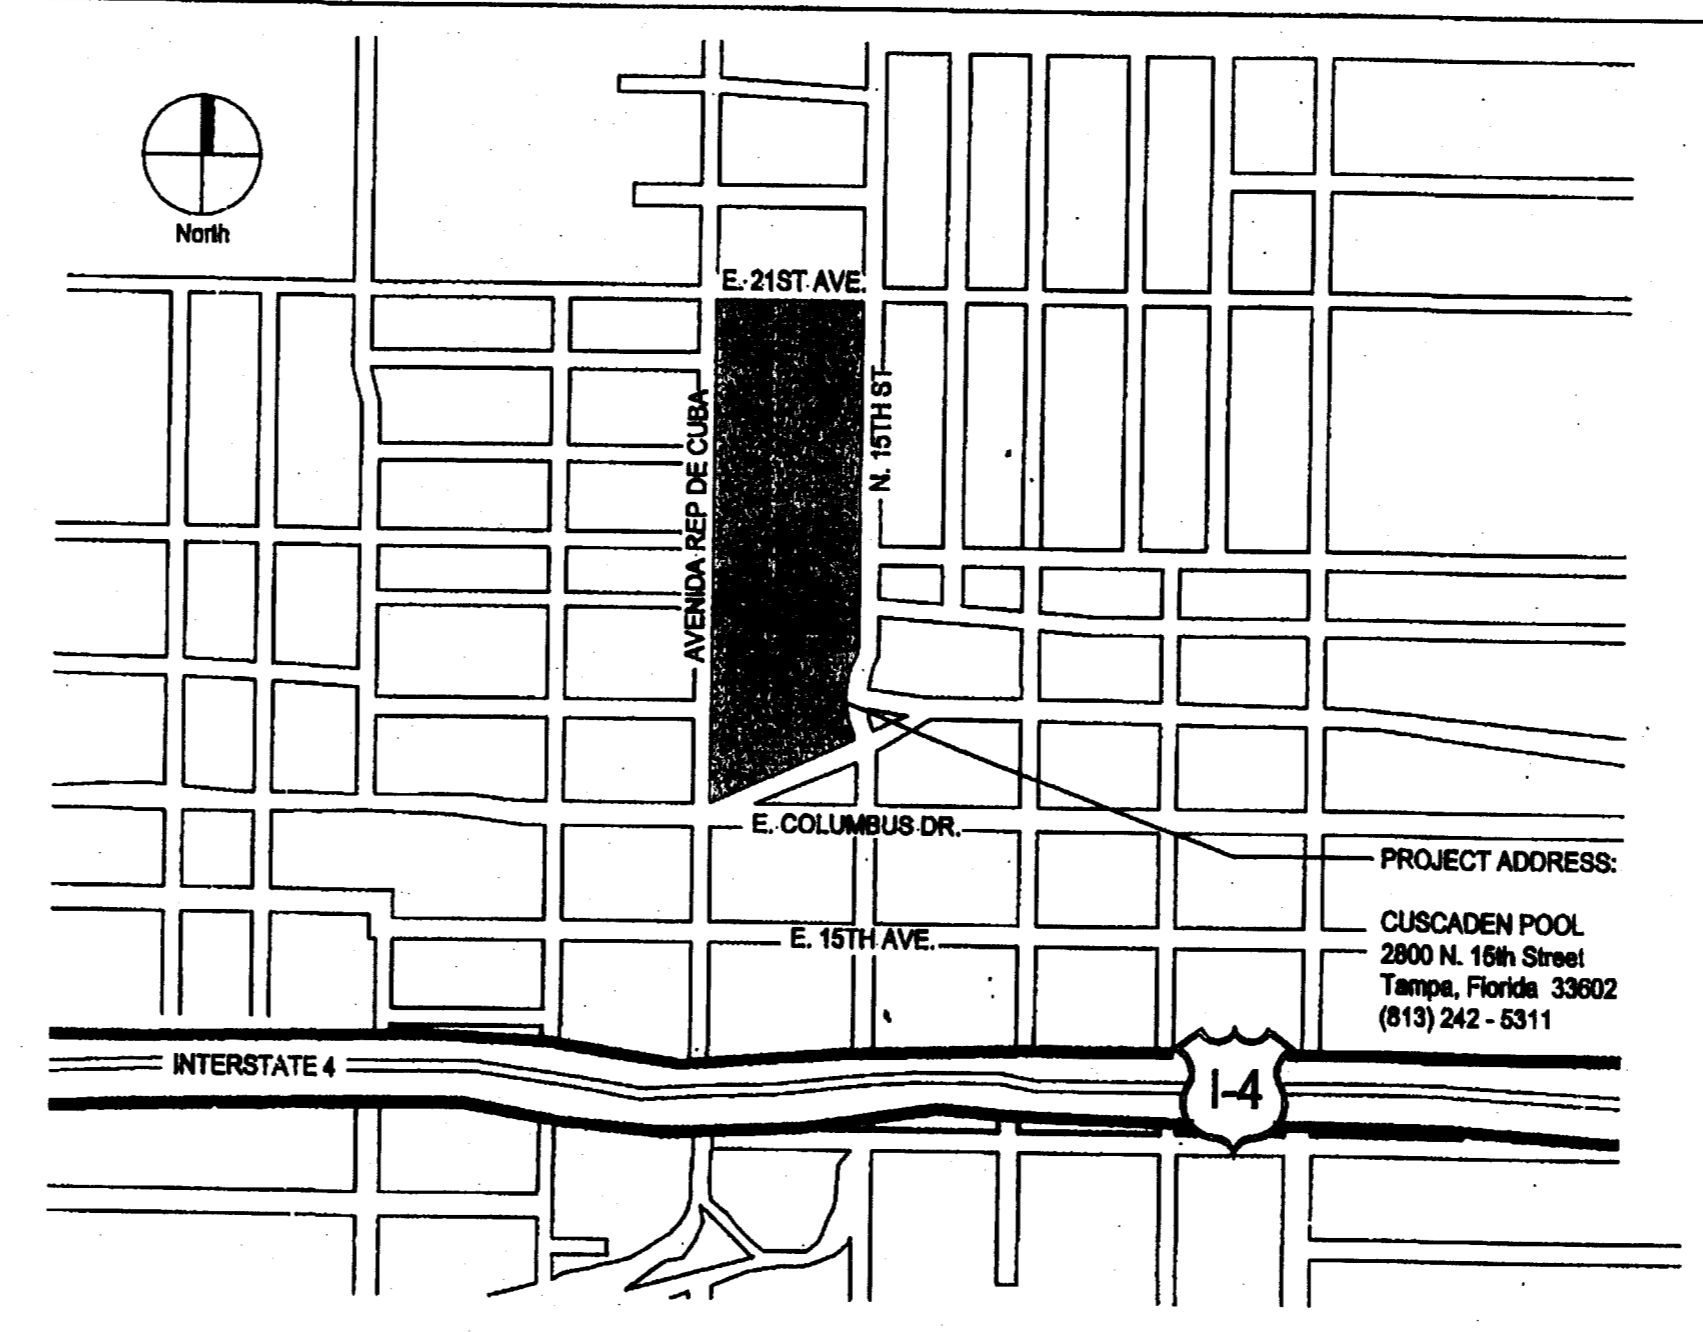

A8 VICINITY MAP
NO SCALE

COVER

GENERAL INFORMATION
G100 GENERAL INFORMATION SHEET

CIVIL
C1 GENERAL NOTES & SPECIFICATIONS
C2 SITE PLAN
C3 PAVING, GRADING & DRAINAGE PLAN
C4 UTILITY PLAN
C5 CIVIL DETAILS
C6 UTILITY DETAILS

LANDSCAPE
L1 LANDSCAPE PLAN
L2 LANDSCAPE SCHEDULES & DETAILS
L3 LANDSCAPE SPECIFICATIONS
L4 IRRIGATION PLAN / SWIRRISE SHOPPING
L5 IRRIGATION SCHEDULES & DETAILS
L6 IRRIGATION SPECIFICATIONS

STRUCTURAL
S101 FOUNDATION PLAN
S201 TOP DECK PLAN
S301 FRAMING PLAN AND TOP DECK PLAN
S401 TYPICAL DETAILS, GENERAL NOTES, AND SECTIONS
S501 WALL ELEVATIONS/DETAILS
S602 WALL ELEVATION

ARCHITECTURAL
A101 DEMO PLAN - FIRST FLOOR
A102 DEMO PLAN - SECOND FLOOR POOL DECK
A100 SITE PLAN
A101 FLOOR PLAN - First Floor
A101.1 DIMENSION FLOOR PLAN - First Floor
A102 FLOOR PLAN - Second Floor Pool Deck
A103 ROOF PLAN
A201 ELEVATIONS - East & West
A202 ELEVATIONS - North & South
A301 BUILDING SECTIONS
A302 SECTIONS
A303 SECTIONS
A404 DETAILS
A501 ENLARGED PLANS
A502 ENLARGED SPLASH PAD PLAN, SECTIONS, AND DETAILS
A601 REFLECTED CEILING PLANS
A801 WINDOW & DOOR LOUVER DETAILS

SPECIAL CONSTRUCTION (13 SHEETS)
Q101 PLUMBING LAYOUT
Q301 POOL SECTIONS
Q401 HEADPIECE SECTION AND DETAILS
Q402 POOL DETAILS
Q701 ENLARGED POOL EQUIPMENT ROOM PLANS
Q702 PLUMBING LAYOUT FOR SPLASH PAD

CODE COMPLIANCE
CC101 CODE COMPLIANCE PLAN - First Floor
CC102 CODE COMPLIANCE PLAN - Pool Deck

MECHANICAL
M001 LEGEND
M201 FIRST FLOOR
M202 SECOND FLOOR POOL DECK
M301 DETAILS
M302 DETAILS
M401 SCHEDULES
M501 CONTROLS

ELECTRICAL
E001 LEGEND
E101 SITE PLAN
E201 FIRST FLOOR LIGHTING
E202 SECOND FLOOR POOL DECK LIGHTING
E301 FIRST FLOOR POWER PLAN
E302 SECOND FLOOR POOL DECK POWER PLAN
E401 FIRST FLOOR ELECTRIC SYSTEMS
E402 SECOND FLOOR POOL DECK ELECTRIC SYSTEMS
E501 DETAILS
E601 SINGLE LINE DIAGRAM & PANEL SCHEDULES
E701 PANEL SCHEDULES

PLUMBING
P001 LEGEND
P200 UNDERGROUND PLAN
P201 FIRST FLOOR
P202 SECOND FLOOR POOL DECK
P301 ENLARGED PLANS
P401 RISERS
P501 DETAILS
P601 FIXTURE SCHEDULE

A13 DRAWING INDEX

CUSCADEN POOL RENOVATION

CITY OF TAMPA
308 East Jackson Street
Tampa, Florida 33602


Project No. 0202.00

Distribution	Date
BID DOCUMENTS	02.02.04

GENERAL INFORMATION SHEET


RECORD DWG.
DATE 01/20/05



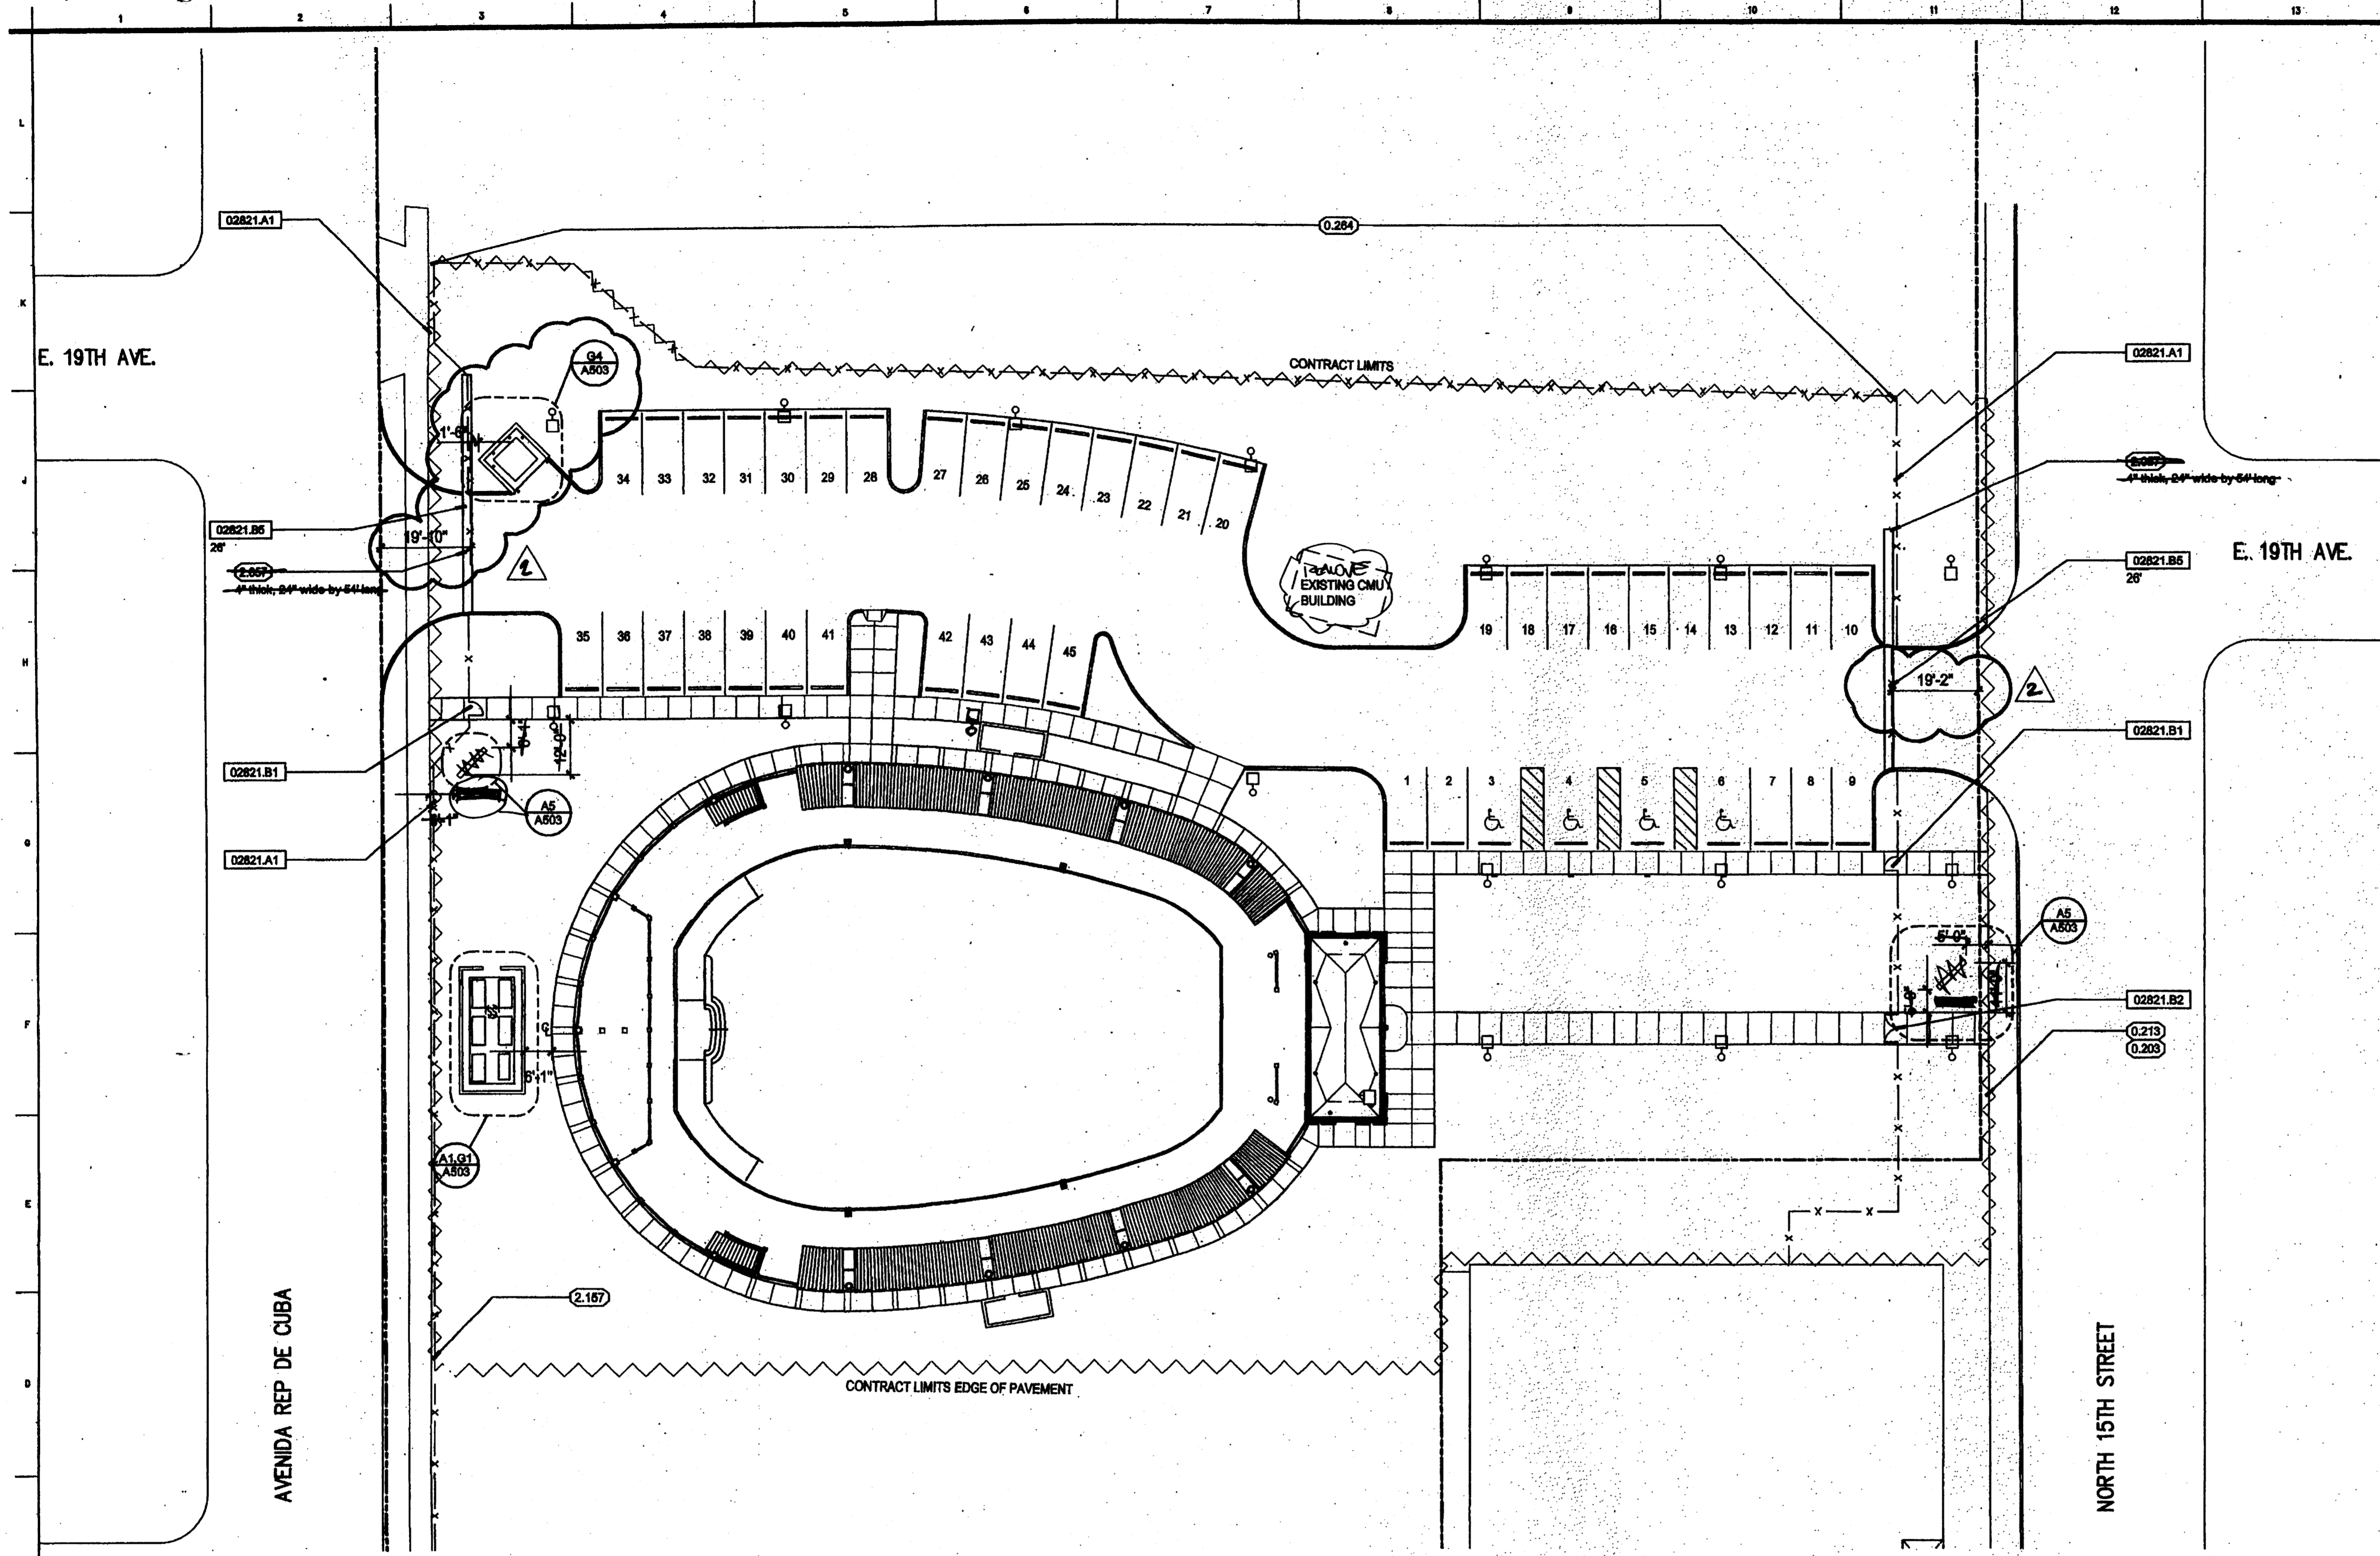

- KEYNOTES**
- 02821 CHAIN-LINK FENCES AND GATES
 - 02821.A1 Chain-Link Fence
 - 02821.B1 Single Swing Gate
 - 02821.B2 Double Swing Gate
 - 02821.B5 Single Horizontal Slide Gate
- GENERAL NOTES**
- 0.000 DEMOLITION
 - 0.203 remove existing curb
 - 0.213 remove existing chain link fence
 - 0.264 existing fence to remain
 - 1.000 ARCHITECTURAL
 - 1.012 wall
 - 2.000 SITEWORK
 - 2.013 concrete sidewalk
 - 2.021 footed edge
 - 2.057 concrete apron
 - 2.102 footed control joint
 - 2.104 expansion joint material
 - 2.157 repair existing gap in fence

ROWE ARCHITECTS
INCORPORATED
100 Madison Street, Suite 200
Tampa, Florida 33602.4704
www.RoweArchitects.com
Fax: 813.221.8154
813.221.8771
AAC002172

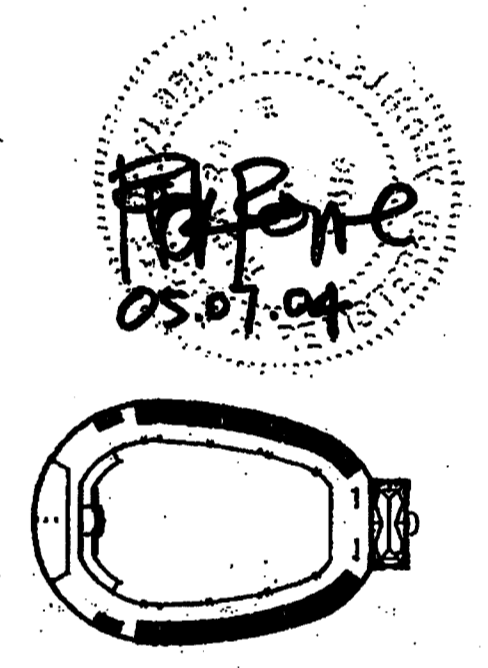

F14 KEYNOTES


CUSCADEN POOL RENOVATION

CITY OF TAMPA
306 East Jackson Street
Tampa, Florida 33602

Project No.0202.00	
Distribution	Date
BID DOCUMENTS	02.02.04
REVISION 2	05-07-04


C1 SITE PLAN

1" = 20'-0"

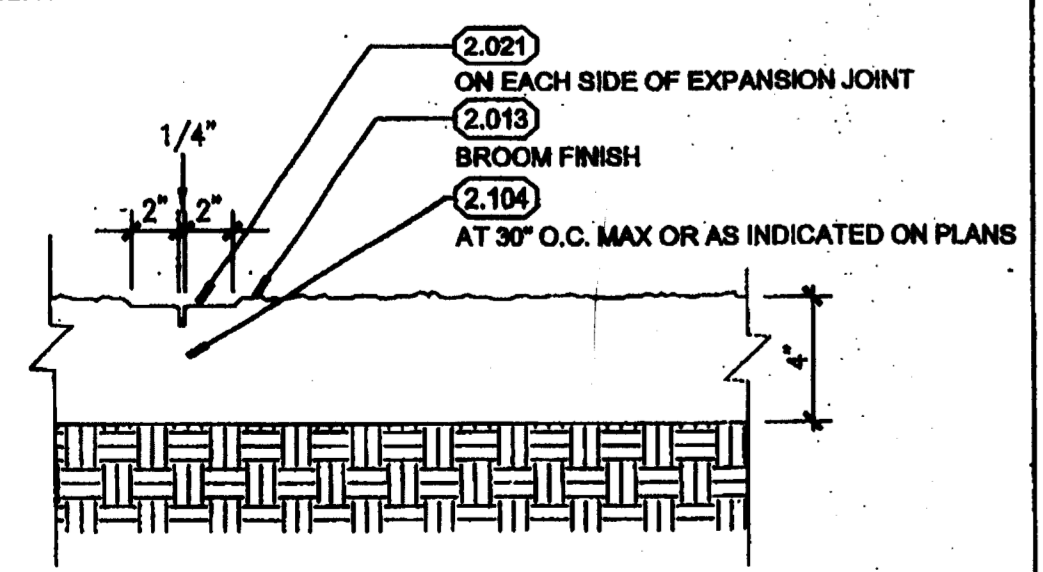


A1 CONTROL JOINT DETAIL

1 1/2" = 1'-0"

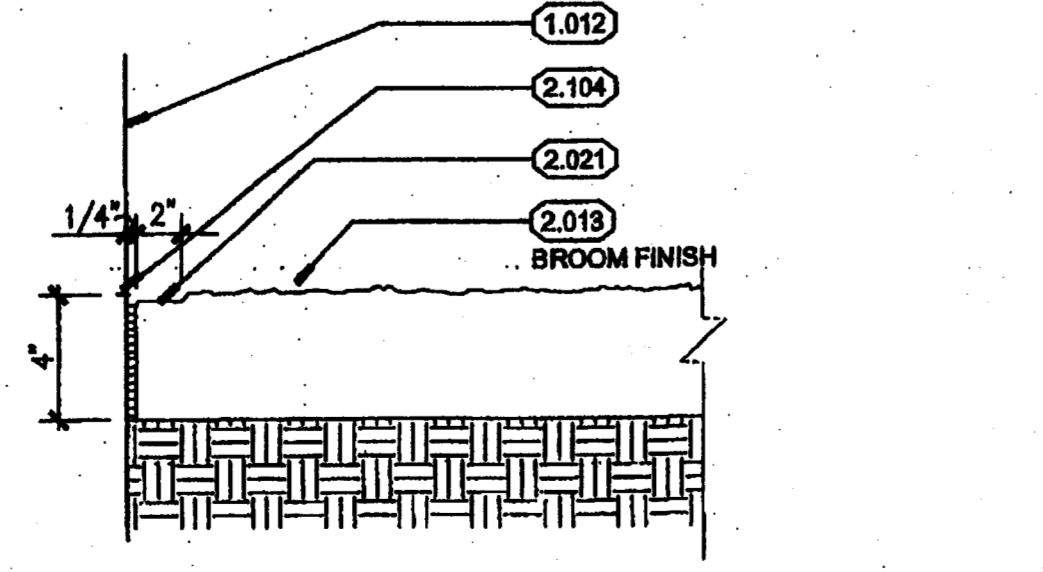

A4 EXPANSION JOINT DETAIL

1 1/2" = 1'-0"

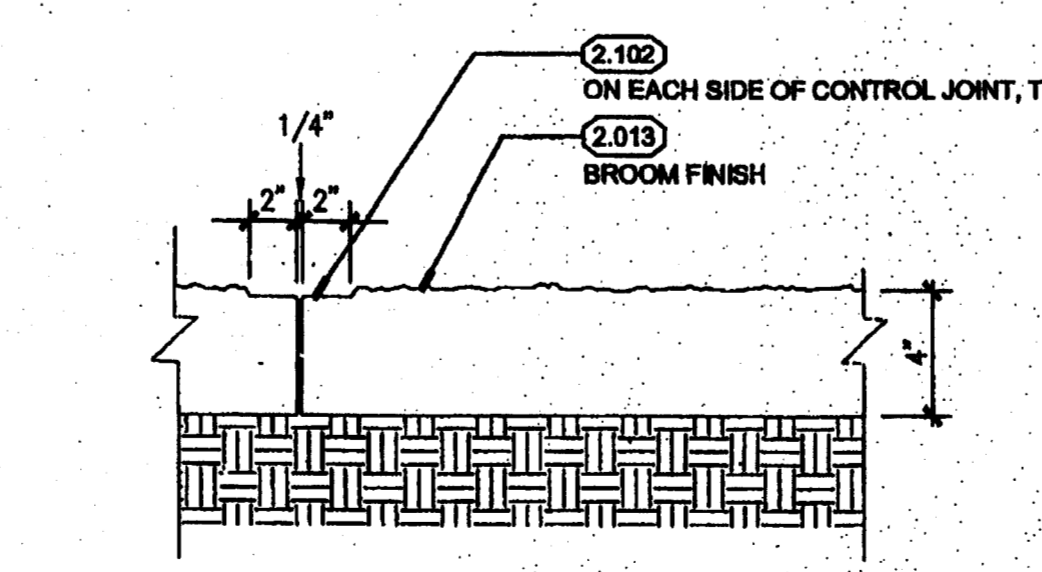


A7 EXPANSION JOINT DETAIL

1 1/2" = 1'-0"


A14 LEGENDS / NOTES

SITE PLAN
RECORD DWG.
DATE 8/26/05

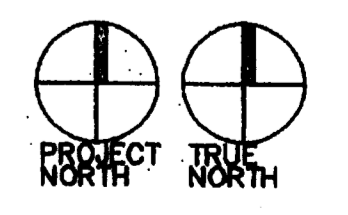

A100




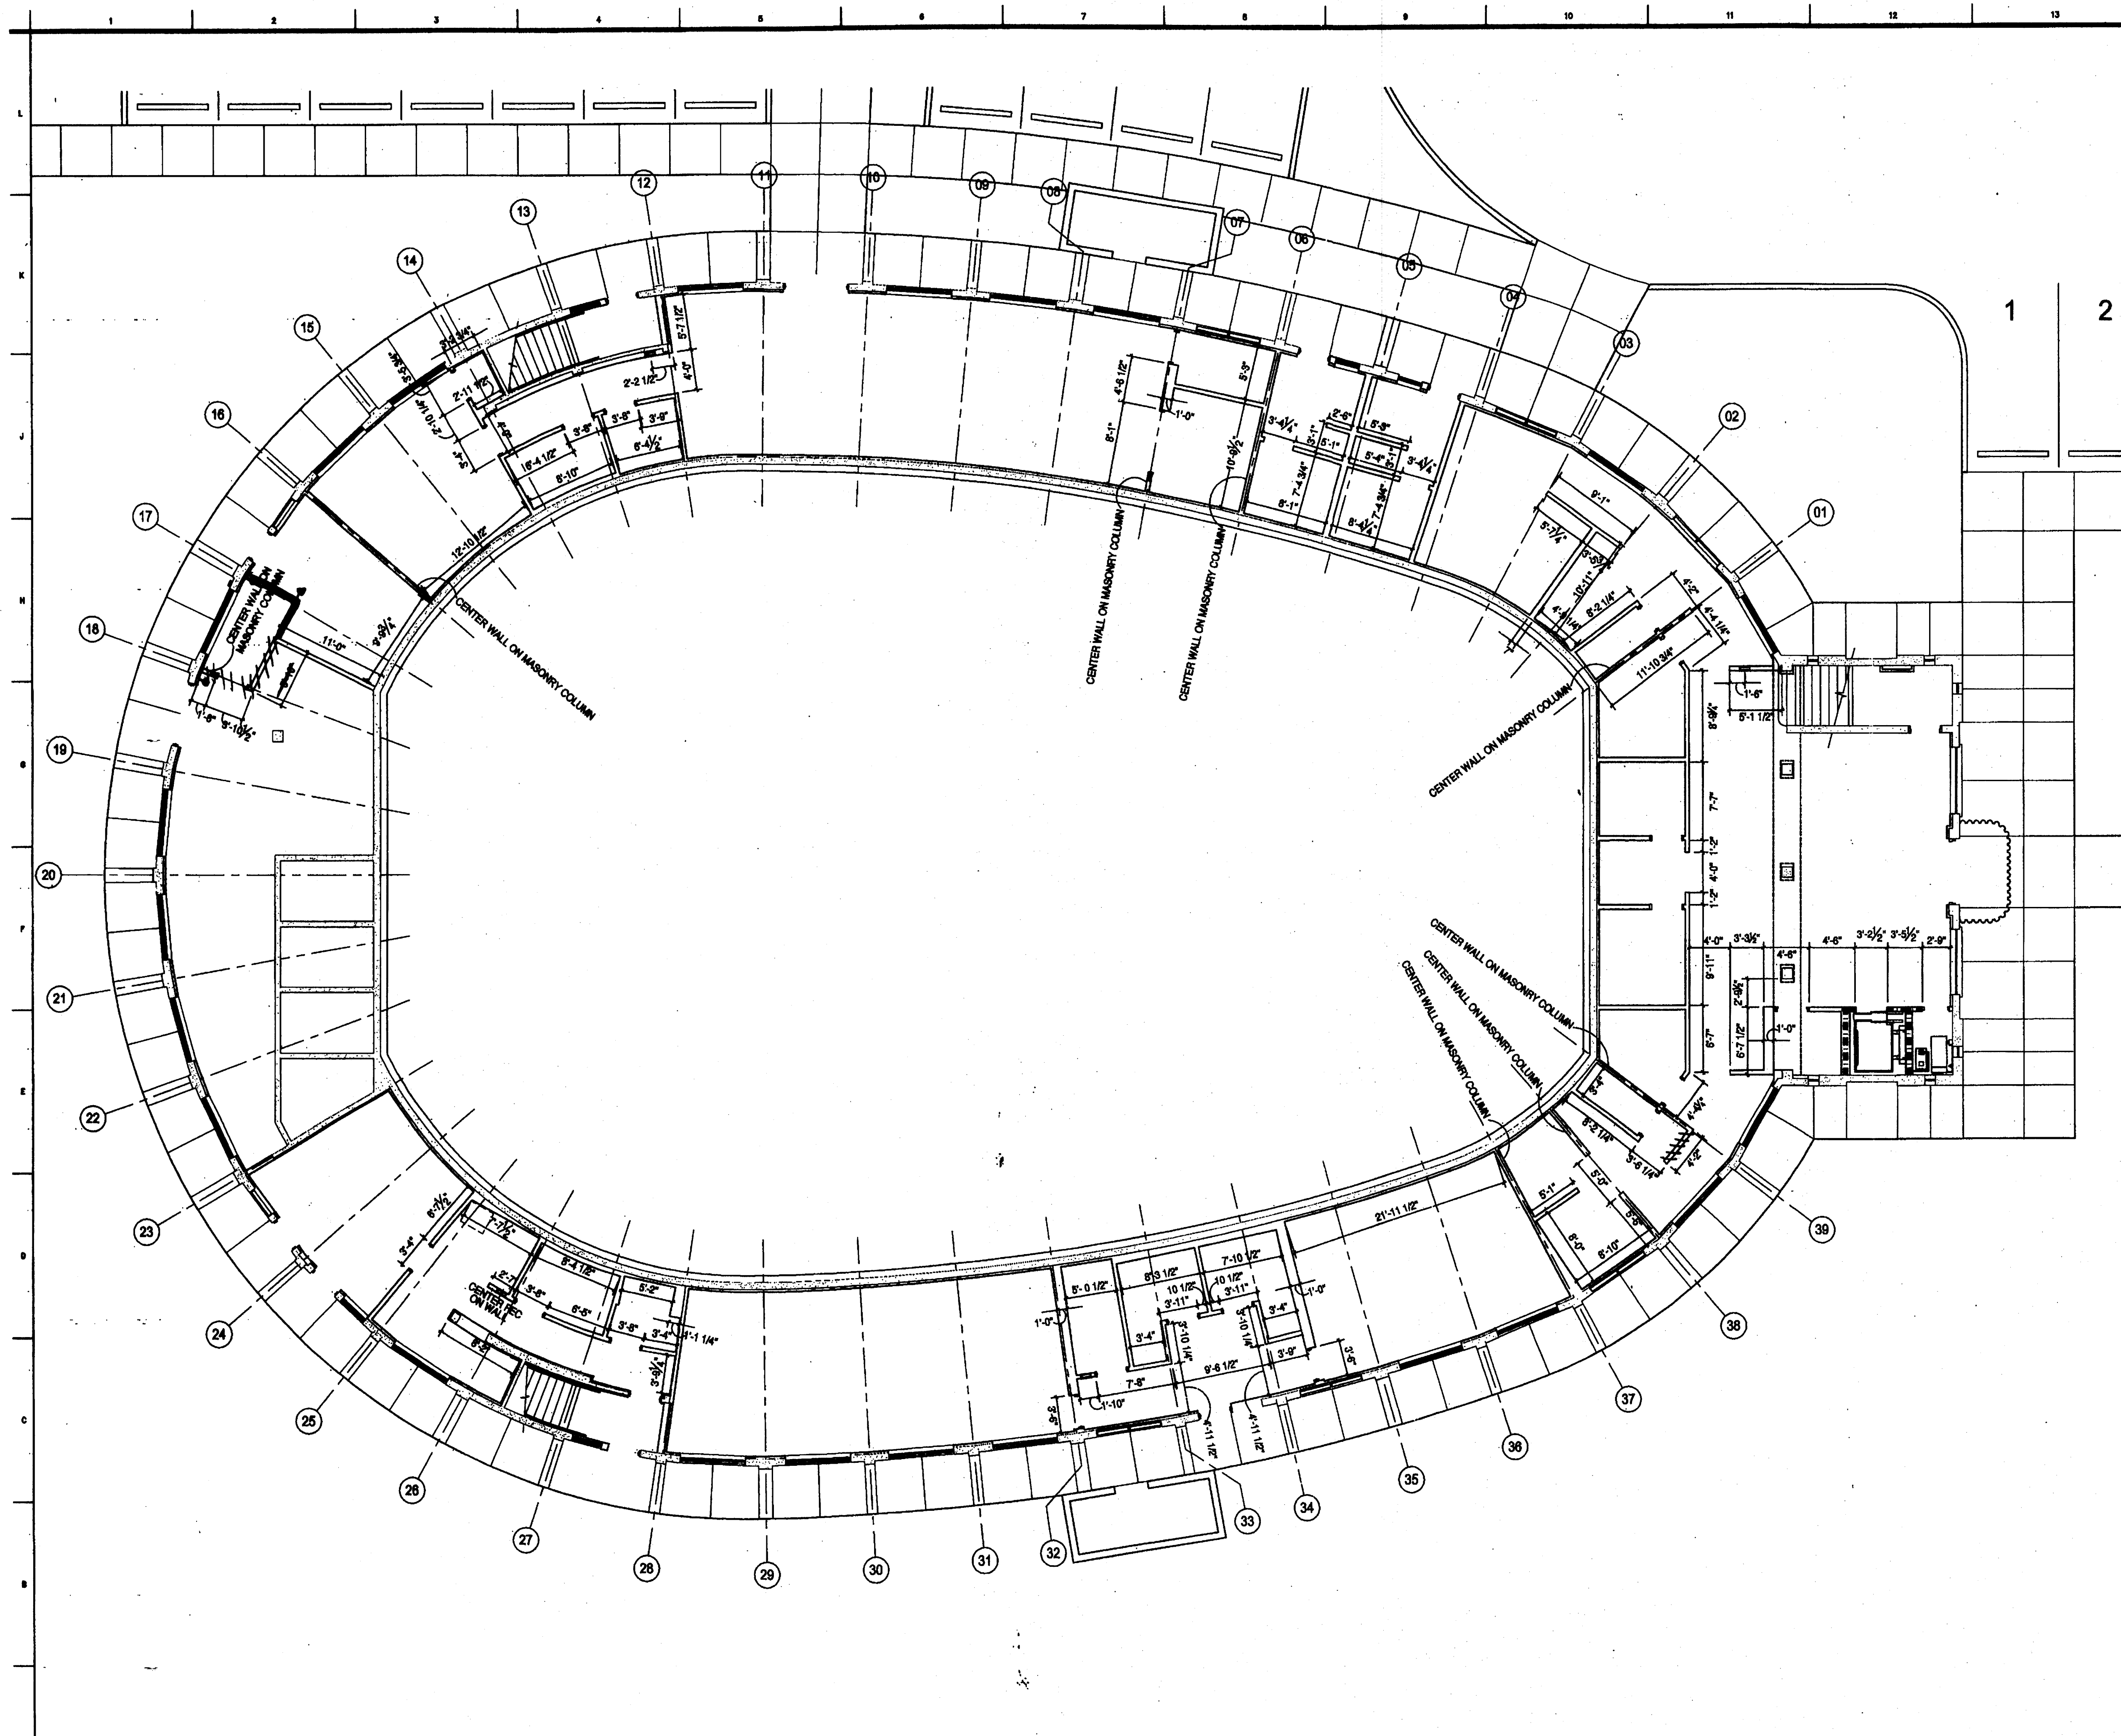

INSTANCES OF ALL NOTES ARE TYPICAL

ROME ARCHITECTS
INCORPORATED
100 Madison Street, Suite 200
Tampa, Florida 33602.4704
www.RomeArchitects.com
Fax: 813.221.9154
813.221.8771
AAC002172

F14 KEYNOTES

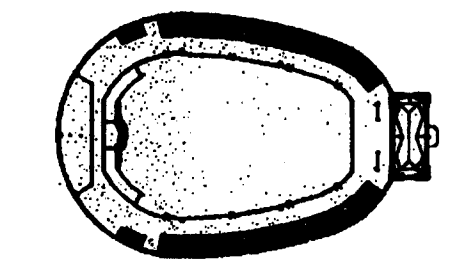

CUSCADEN POOL RENOVATION

CITY OF TAMPA
308 East Jackson Street
Tampa, Florida 33602

Project No. 0202.00

Distribution	Date
BID DOCUMENTS	02.02.04

DIMENSION PLAN LEGEND

- MASONRY WALL PARTITION
- MTL STUD PARTITION
- EXISTING MASONRY WALL TO REMAIN
- CONSTRUCTION ABOVE OR BELOW

GENERAL NOTES

1. Refer to Architectural Floor Plans for locations of all new openings.
2. Dimensions of new partitions are to the finished face unless noted otherwise.
3. All elevation indications reference control point 0'-0".

DIMENSION FLOOR PLAN
First Floor **RECORD DWG.**


SCALE: 1/8" = 1'-0"
DATE 8/22/05

A1 DIMENSION FLOOR PLAN - First Floor

1/8"=1'-0"

A14 LEGEND / NOTES

RECEIVED
PROJECT NORTH TRUE NORTH FEB 23 2004
A101.1
CONSTR. TECH. GROUP, INC.
2/7 007

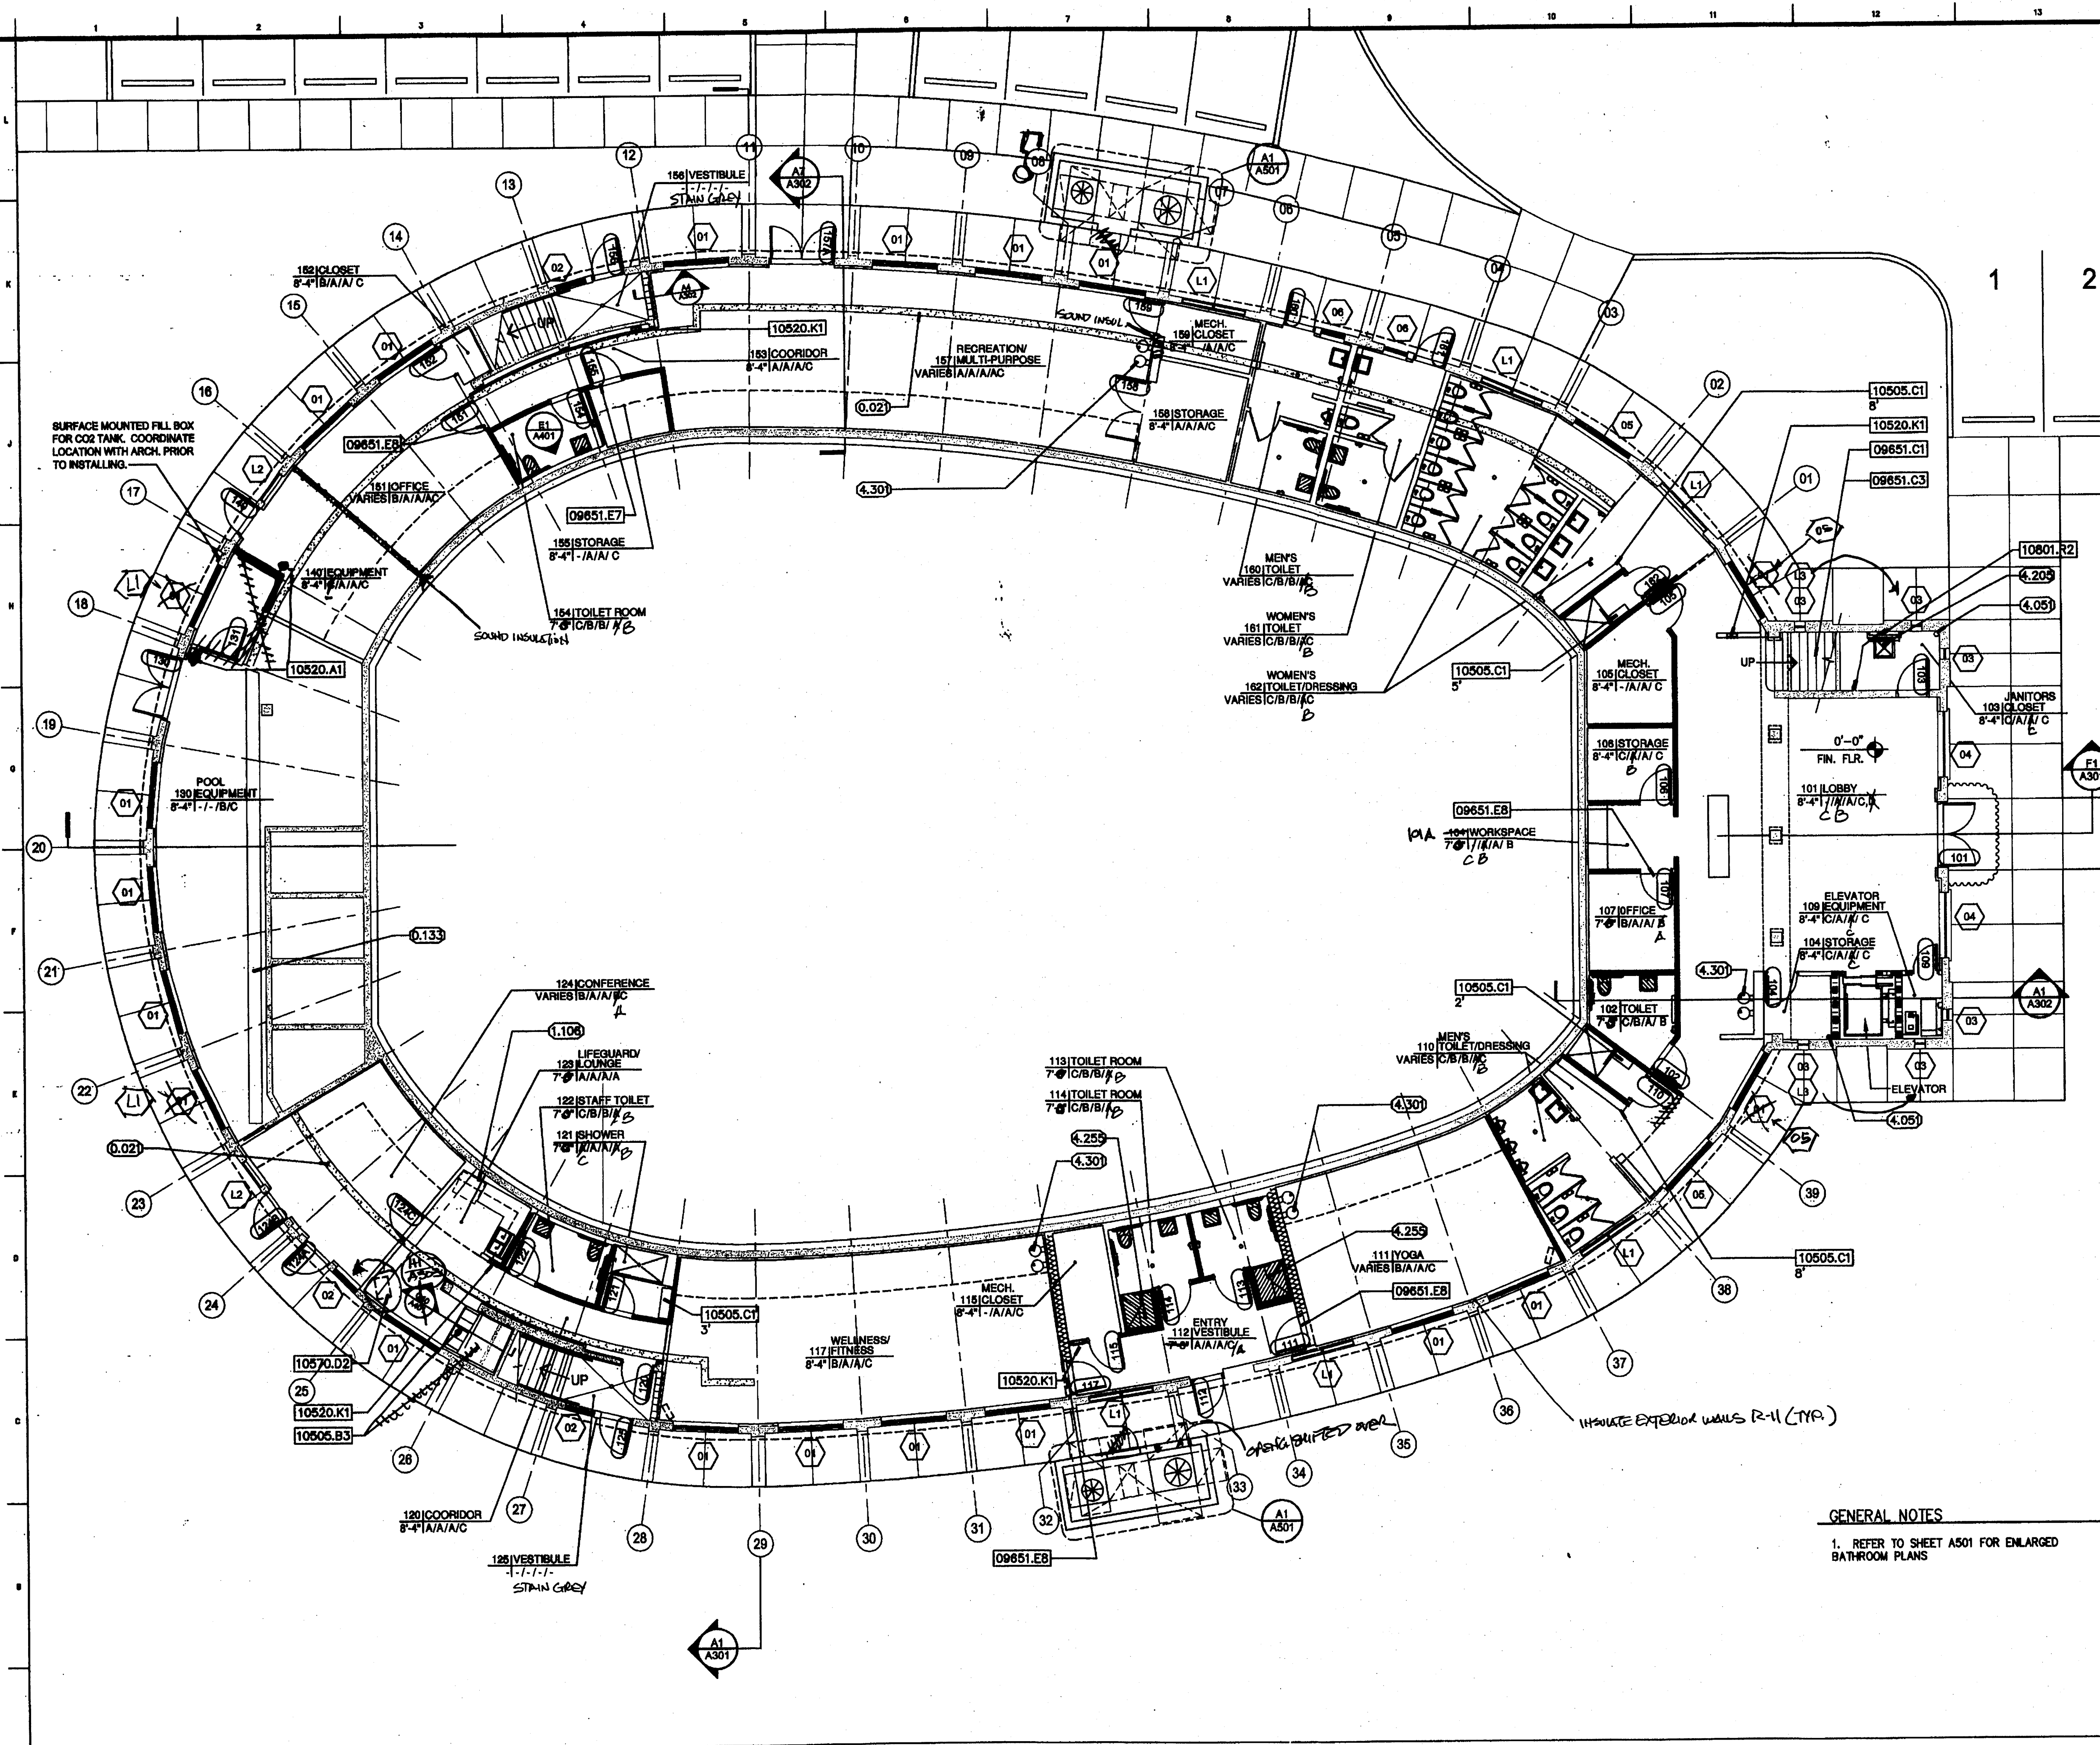

- KEYNOTES**
- 0951 ACUSTICAL PANEL CEILING
 - 0951.A1 Suspended Acoustical Panel Ceiling System
 - 0951.A2 Suspended Gypsum Based Panel Ceiling System
 - 0965 RESILIENT TILE FLOORING
 - 0965.B1 Wall Base
 - 0965.C1 Stair Tread
 - 0965.C3 Stair Stringer
 - 0965.E1 Cap for save-carpet
 - 0965.E7 Reducer strip for resilient flooring
 - 0965.E8 Tile and carpet jointer
 - 0967 RESINOUS FLOORING
 - 0967.A1 Resinous Flooring
 - 0980 CARPET
 - 0980.A1 Carpet - OPT-1
 - 0992 PAINTING
 - 0992.A4 Paint, Low-Luster Acrylic-Enamel Finish
 - 0992.A5 Paint, Semigloss Acrylic-Enamel Finish
 - 0992.D1 Epoxy Emulsion Coating
 - 10505 METAL LOCKERS
 - 10505.B3 Athletic Lockers, Double tier
 - 10505.C1 Locker benches
 - 10520 FIRE-PROTECTION SPECIALTIES
 - 10520.A1 Portable Fire Extinguishers
 - 10520.K1 Fire Extinguisher Cabinet
 - 10570 EDUCATIONAL SPECIALTIES
 - 10570.D2 Ceiling Mount TV Bracket
 - 10801 TOILET AND BATH ACCESSORIES
 - 10801.R2 Map and Broam Holder with Utility Shelf
- GENERAL NOTES**
- 0.000 DEMOLITION
 - 0.021 fill existing trench to match existing floor
 - 0.133 existing trench to remain
 - 1.000 ARCHITECTURAL refrigerator (n.l.c.)
 - 1.106 PLUMBING
 - 4.000 roof drain
 - 4.051 mop sink (floor mounted)
 - 4.255 prefabricated shower
 - 4.301 electric water cooler


F14 KEYNOTES

ROOM FINISH LEGEND	
09651.E1	VCT
09880.A1	Carpet
09671.A1	Resinous Flooring
Base	
09651.B1	Resilient Wall Base
09671.A1	Resinous Flooring
Walls	
09912.A5	Paint on Gypsum Board
09912.D1	Epoxy Emulsion Coating on Gypsum Board
09912.A4	Paint on Existing Concrete
Ceiling	
09511.A1	Suspended Acoustical Panel System
09511.A2	Suspended Gypsum Board Panel
09912.A4	Paint on Existing Concrete

- DRAWING LEGEND**
- HANDICAPPED ACCESSIBLE PLUMBING FIXTURE OR SHOWER STALL
 - MTL STUD PARTITION
 - MTL STUD PARTITION WITH BATT INSULATION
 - EXISTING CONCRETE OR MASONRY WALL TO REMAIN
 - CMU MASONRY WALL
 - CONSTRUCTION ABOVE OR BELOW
- ROOM INFORMATION KEY**
- ROOM NUMBER ROOM NAME
- 100 LOBBY
- CEILING HEIGHT FINISHES (FLOOR/BASE/WALL/CEILING)

GENERAL NOTES

1. REFER TO SHEET A501 FOR ENLARGED BATHROOM PLANS

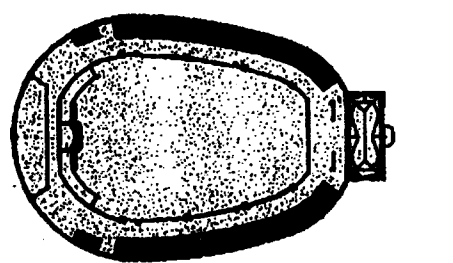

CUSCADEN POOL RENOVATION

CITY OF TAMPA
308 East Jackson Street
Tampa, Florida 33602

Project No. 0202.00
Distribution Date
BID DOCUMENTS 02.02.04

FLOOR PLAN
First Floor


RECORD DWG.
DATE 8/28/05
1/8" = 1'-0"
0 4 8 16 FT

RECEIVED
PROJECT NORTH
TRUE NORTH
FEB 23 2004
A101
CONSULT. TECH. GROUP, INC. 217 009

A1 FLOOR PLAN - First Floor

1/8"=1'-0"

A14 LEGEND / NOTES

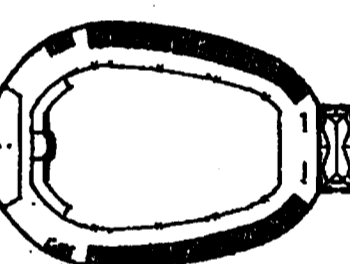

CUSCADEN
POOL
RENOVATION

CITY OF TAMPA
306 East Jackson Street
Tampa, Florida 33602



Project: No.0202.00

Distribution	Date
BID DOCUMENTS	02.02.04
DOH PERMIT SUBMITTAL	02.12.04

FLOOR PLAN
First Floor

RECORD DWG.

DATE 8/26/05

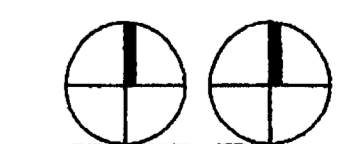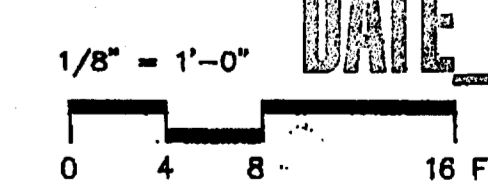


A101

2/1
001


KEYNOTES	
0951	ACOUSTICAL PANEL CEILING
0951.A1	Suspended Acoustical Panel Ceiling System
0951.A2	Suspended Gypsum Based Panel Ceiling System
09651	RESILIENT TILE FLOORING
09651.B1	Wall Base
09651.C1	Stair Tread
09651.C3	Stair Stringer
09651.E1	Cap for cove carpet
09651.E7	Reducer strip for resilient flooring
09651.E8	Tile and carpet jointer
09671	RESINOUS FLOORING
09671.A1	Resinous Flooring
09680	CARPET
09680.A1	Carpet - CPT-1
09912	PAINTING
09912.A4	Paint, Low-Luster
09912.A5	Acrylic-Enamel Finish
09912.D1	Acrylic-Enamel Finish Epoxy Emulsion Coating
10505	METAL LOCKERS
10505.B3	Athletic Lockers, Double tier.
10505.C1	Locker benches.
10520	FIRE-PROTECTION SPECIALTIES
10520.A1	Portable Fire Extinguishers
10520.K1	Fire Extinguisher Cabinet
10570	EDUCATIONAL SPECIALTIES
10570.D2	Ceiling Mount TV Bracket
10801	TOILET AND BATH ACCESSORIES
10801.R2	Mop and Broom Holder with Utility Shelf
GENERAL NOTES	
0.000	DEMOLITION
0.021	fill existing trench to match existing floor
0.133	existing trench to remain
1.000	ARCHITECTURAL refrigerator (n.l.c.)
1.106	
4.000	PLUMBING
4.051	roof drain
4.205	mop sink (floor mounted)
4.255	prefabricated shower
4.301	electric water cooler
F14 KEYNOTES	
ROOM FINISH LEGEND	
Floor	
A	[09651.E1] VCT
B	[09680.A1] Carpet
C	[09671.A1] Resinous Flooring
Base	
A	[09651.B1] Resilient Wall Base
B	[09671.A1] Resinous Flooring
Walls	
A	[09912.A5] Paint on Gypsum Board
B	[09912.D1] Epoxy Emulsion Coating on Gypsum Board
C	[09912.A4] Paint on Existing Concrete
Ceiling	
A	[09511.A1] Suspended Acoustical Panel System
B	[09511.A2] Suspended Gypsum Board Panel
C	[09912.A4] Paint on Existing Concrete
DRAWING LEGEND	
[Symbol]	HANDICAPPED ACCESSIBLE PLUMBING FIXTURE OR SHOWER STALL
[Symbol]	MTL STUD PARTITION
[Symbol]	MTL STUD PARTITION WITH BATT INSULATION
[Symbol]	EXISTING CONCRETE OR MASONRY WALL TO REMAIN
[Symbol]	CMU MASONRY WALL
[Symbol]	CONSTRUCTION ABOVE OR BELOW
ROOM INFORMATION KEY	
ROOM NUMBER	ROOM NAME
100 LOBBY	9'-0" DIA / A / A / A
CEILING HEIGHT	FINISHES (FLOOR, BASE, WALL, CEILING)

GENERAL NOTES
1. REFER TO SHEET A501 FOR ENLARGED BATHROOM PLANS

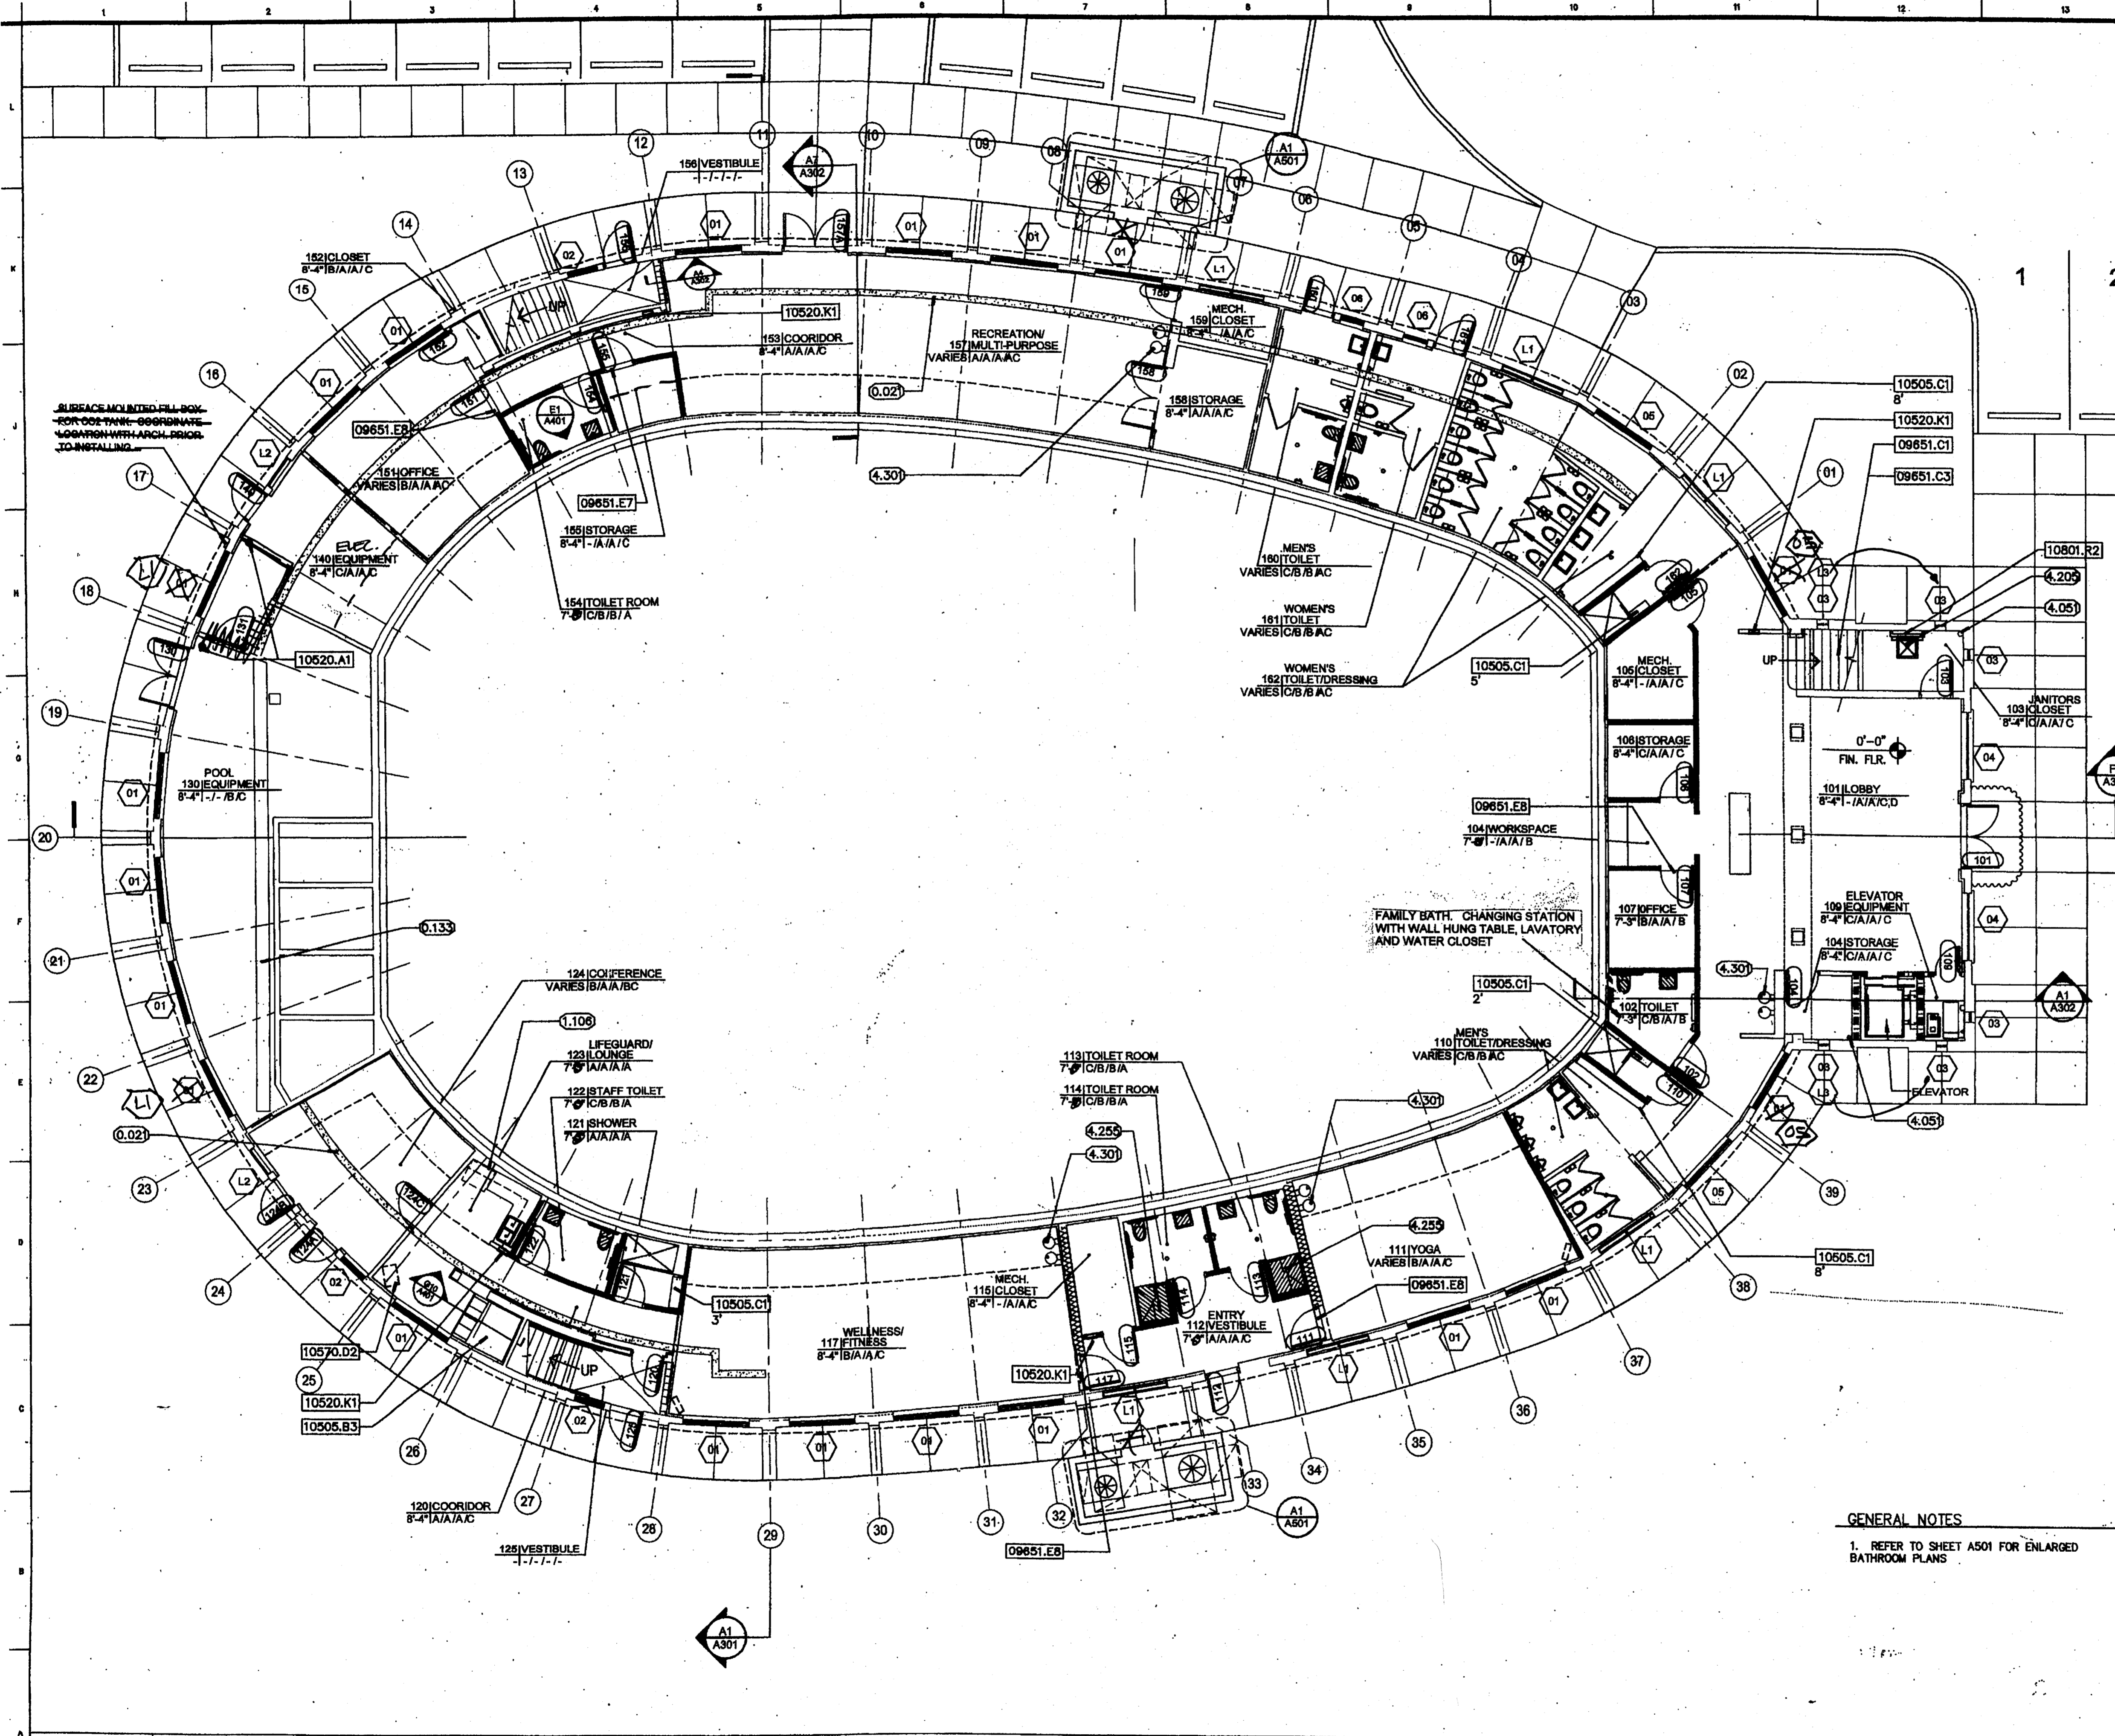


A1 FLOOR PLAN - First Floor
1/8"=1'-0"

A14 LEGEND / NOTES

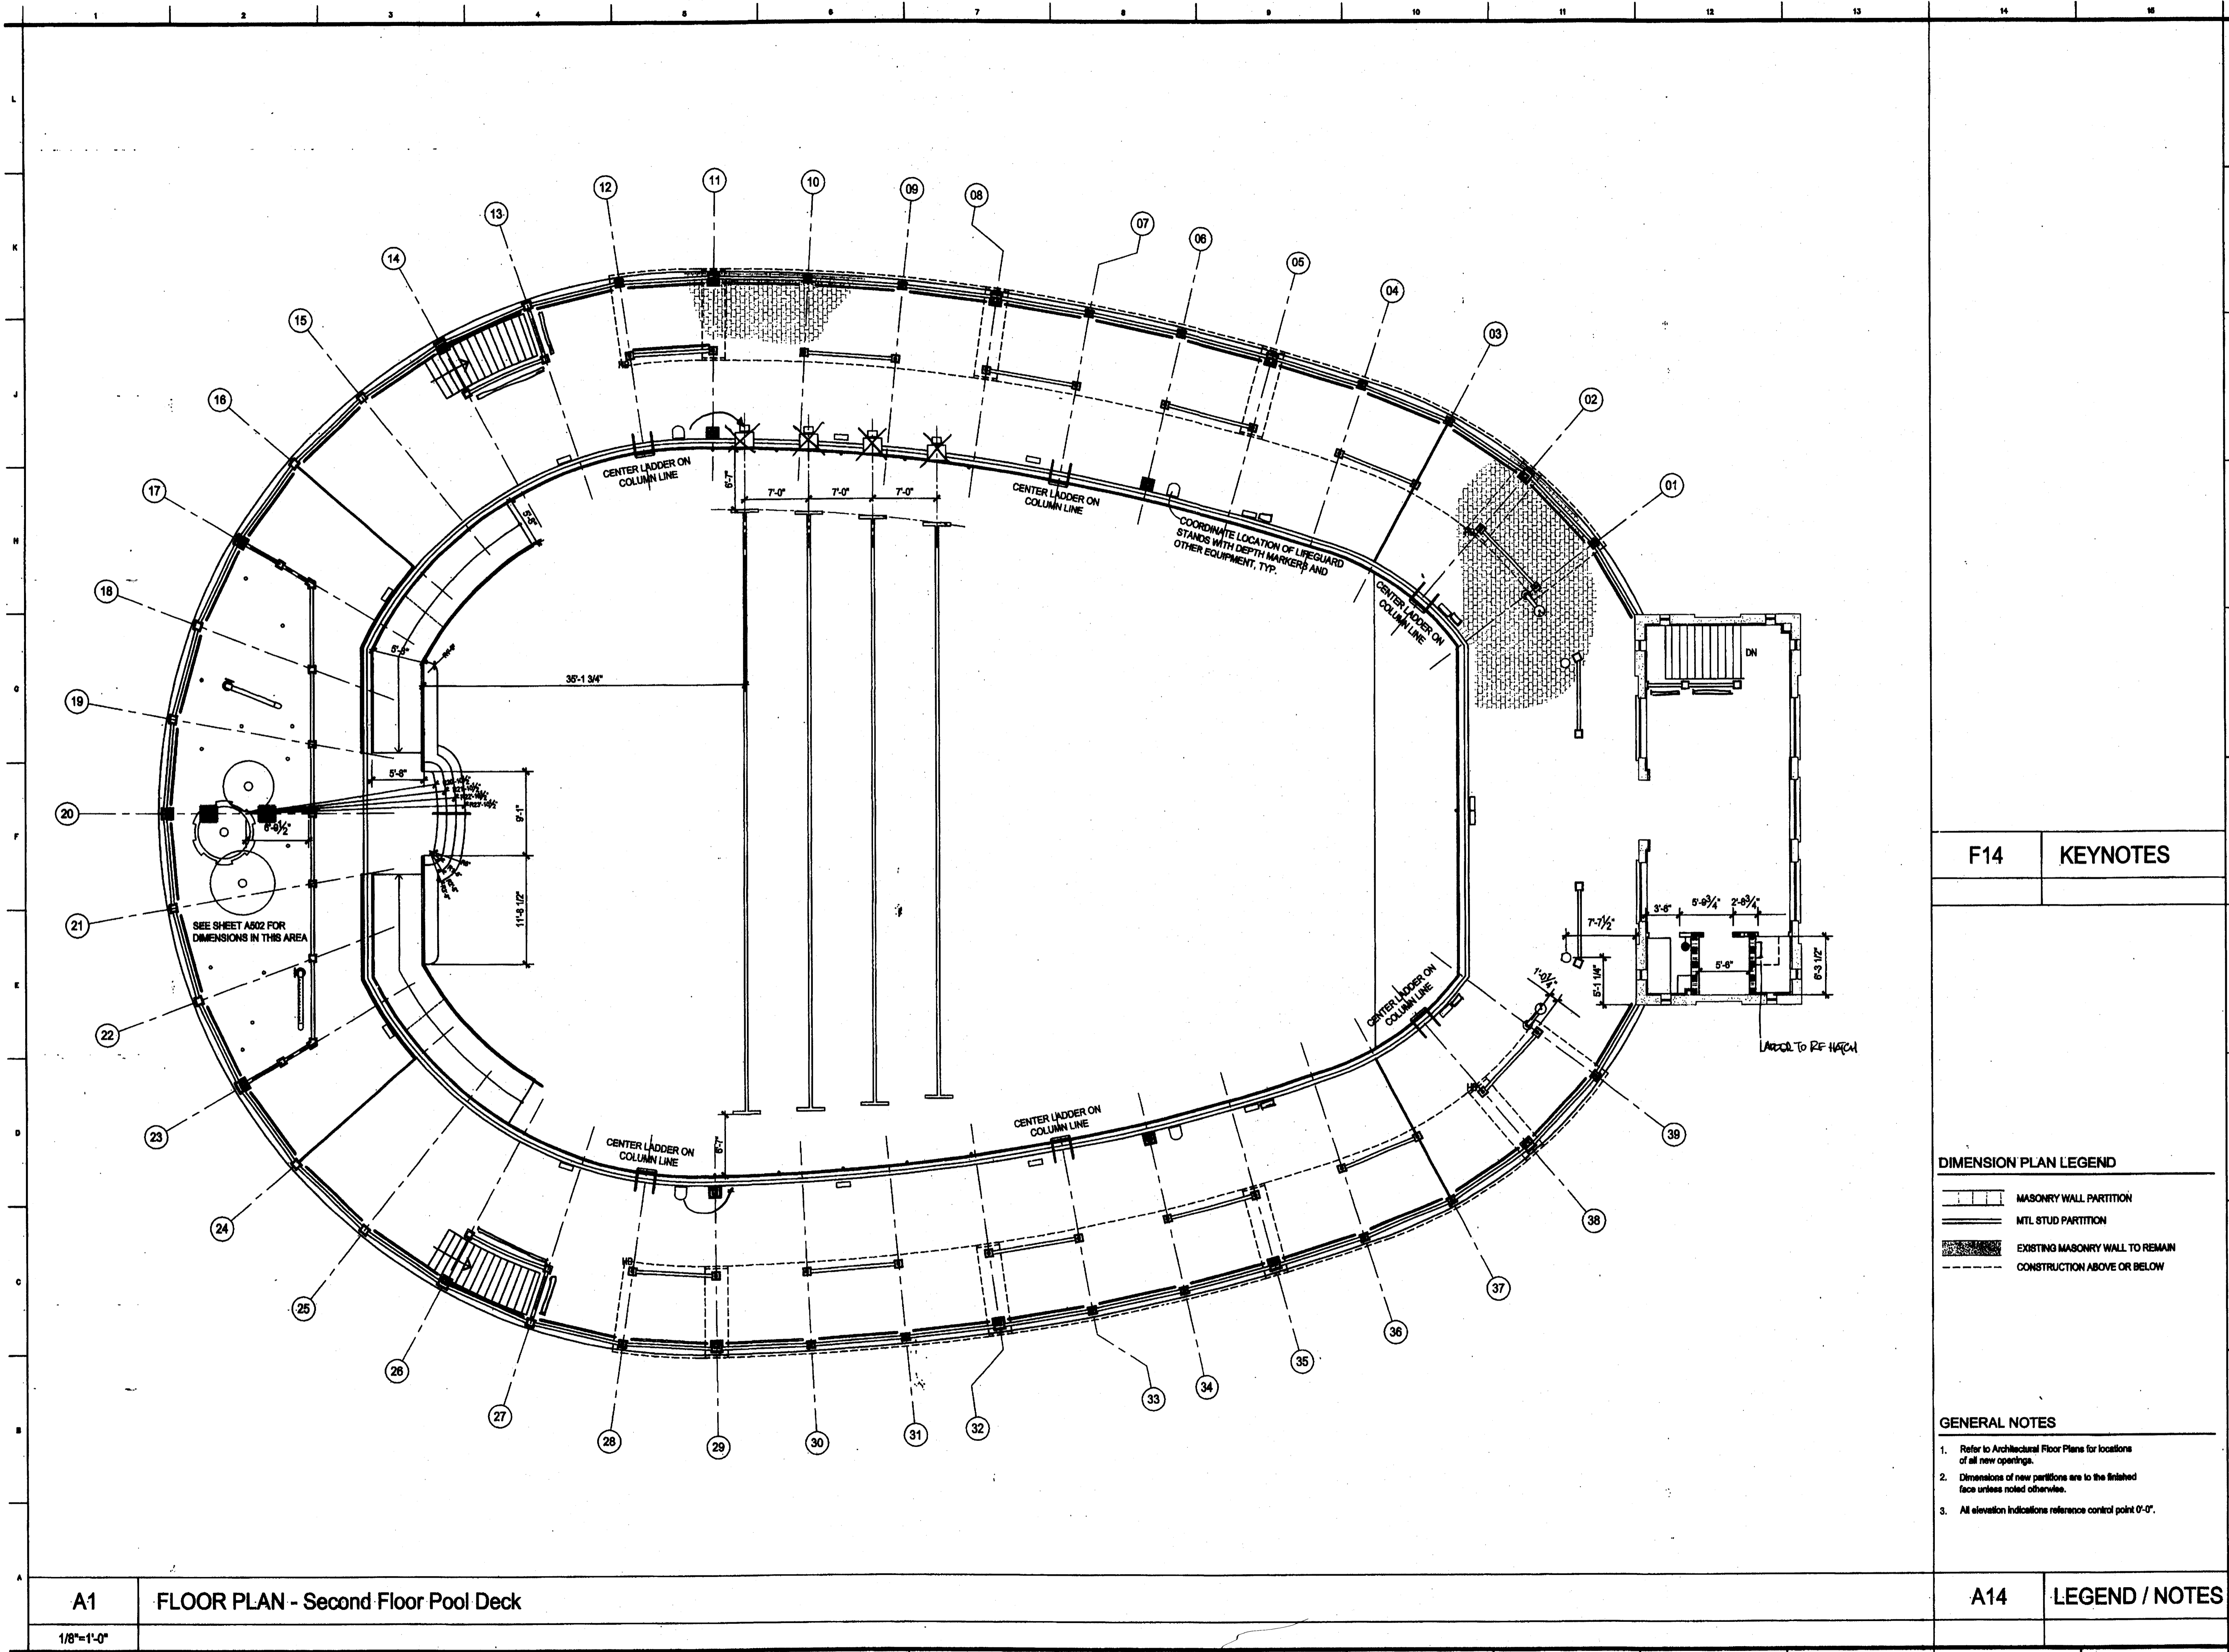

F14	KEYNOTES
-----	----------

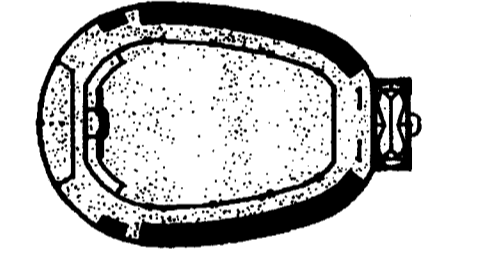

**CUSCADEN
 POOL
 RENOVATION**

CITY OF TAMPA
 305 East Jackson Street
 Tampa, Florida 33602

Project No.	0202.00
Distribution	Date
BID DOCUMENTS	02.02.04

DIMENSION PLAN LEGEND

	MASONRY WALL PARTITION
	MTL STUD PARTITION
	EXISTING MASONRY WALL TO REMAIN
	CONSTRUCTION ABOVE OR BELOW

- GENERAL NOTES**
1. Refer to Architectural Floor Plans for locations of all new openings.
 2. Dimensions of new partitions are to the finished face unless noted otherwise.
 3. All elevation indications reference control point 0'-0".

A1 FLOOR PLAN - Second Floor Pool Deck
 1/8"=1'-0"

A14	LEGEND / NOTES
-----	----------------

DIMENSION PLAN
 Second Floor
 Pool Deck

RECORD DWG.
 DATE 8/26/05

A102.1

RECEIVED
 FEB 23 2004
 CIVIL TECH. GROUP, INC.

2/7
 009

KEYNOTES

04720	CAST STONE
04720.A9	Cast stone monument
05521	PIPE AND TUBE RAILINGS
05521.A2	Aluminum Tube Railing
05521.B2	Stainless-Steel Tube Railing
06511	ACOUSTICAL PANEL CEILING
06511.A1	Suspended Acoustical Panel Ceiling System
06511.A2	Suspended Gypsum Based Panel Ceiling System
09551	RESILIENT TILE FLOORING
09551.B1	Wall Base
09551.E1	Cap for cove carpet
09571	RESINOUS FLOORING
09571.A1	Resinous Flooring
09580	CARPET
09580.A1	Carpet - CPT-1
09912	PAINTING
09912.A4	Paint, Low-Luster Acrylic-Enamel Finish
09912.A5	Paint, Semigloss Acrylic-Enamel Finish
09912.D1	Epoxy Emulsion Coating
10520	FIRE-PROTECTION SPECIALTIES
10520.A1	Portable Fire Extinguishers
13110	SWIMMING POOLS
13110.D2	Recessed Lane Line & Rope Anchors
13110.L1	Lifeguard Chairs
13110.L2	S.S. Ladder

GENERAL NOTES

1.000	ARCHITECTURAL expansion joint
1.063	entire pool deck to be pavers
1.078	
4.000	PLUMBING roof drain
4.051	prefabricated shower
4.255	water fountain

F14 KEYNOTES

ROOM FINISH LEGEND

Floor	
A	09551.E1 VCT
B	09580.A1 Carpet
C	09571.A1 Resinous Flooring

Base	
A	09551.B1 Resilient Wall Base
B	09571.A1 Resinous Flooring

Walls	
A	09912.A5 Paint on Gypsum Board
B	09912.D1 Epoxy Emulsion Coating on Gypsum Board
C	09912.A4 Paint on Existing Concrete

Ceiling	
A	06511.A1 Suspended Acoustical Panel System
B	06511.A2 Suspended Gypsum Board Panel
C	09912.A4 Paint on Existing Concrete


DRAWING LEGEND

- HANDICAPPED ACCESSIBLE PLUMBING FIXTURE OR SHOWER STALL
- MTL STUD PARTITION
- MTL STUD PARTITION WITH BATT INSULATION
- EXISTING CONCRETE OR MASONRY WALL TO REMAIN
- CMU MASONRY WALL
- CONSTRUCTION ABOVE OR BELOW

ROOM INFORMATION KEY

ROOM NUMBER	ROOM NAME
100 LOBBY	9'-0" / A / A / A / A
CEILING HEIGHT	FINISHES (FLOOR/BASE/WALL/CEILING)

A14 LEGEND / NOTES

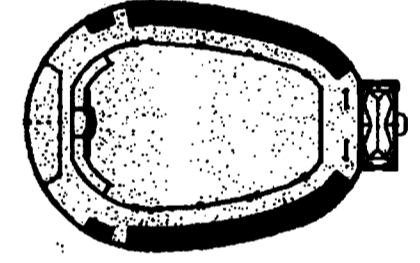

CUSCADEN POOL RENOVATION

CITY OF TAMPA
305 East Jackson Street
Tampa, Florida 33602


Project No. 0202.00

Distribution Date
BID DOCUMENTS 02.02.04

FLOOR PLAN
Second Floor
Pool Deck


RECORD DWG.

DATE 8/26/05

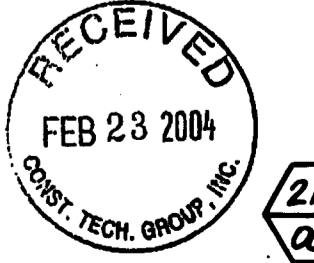


A102

217

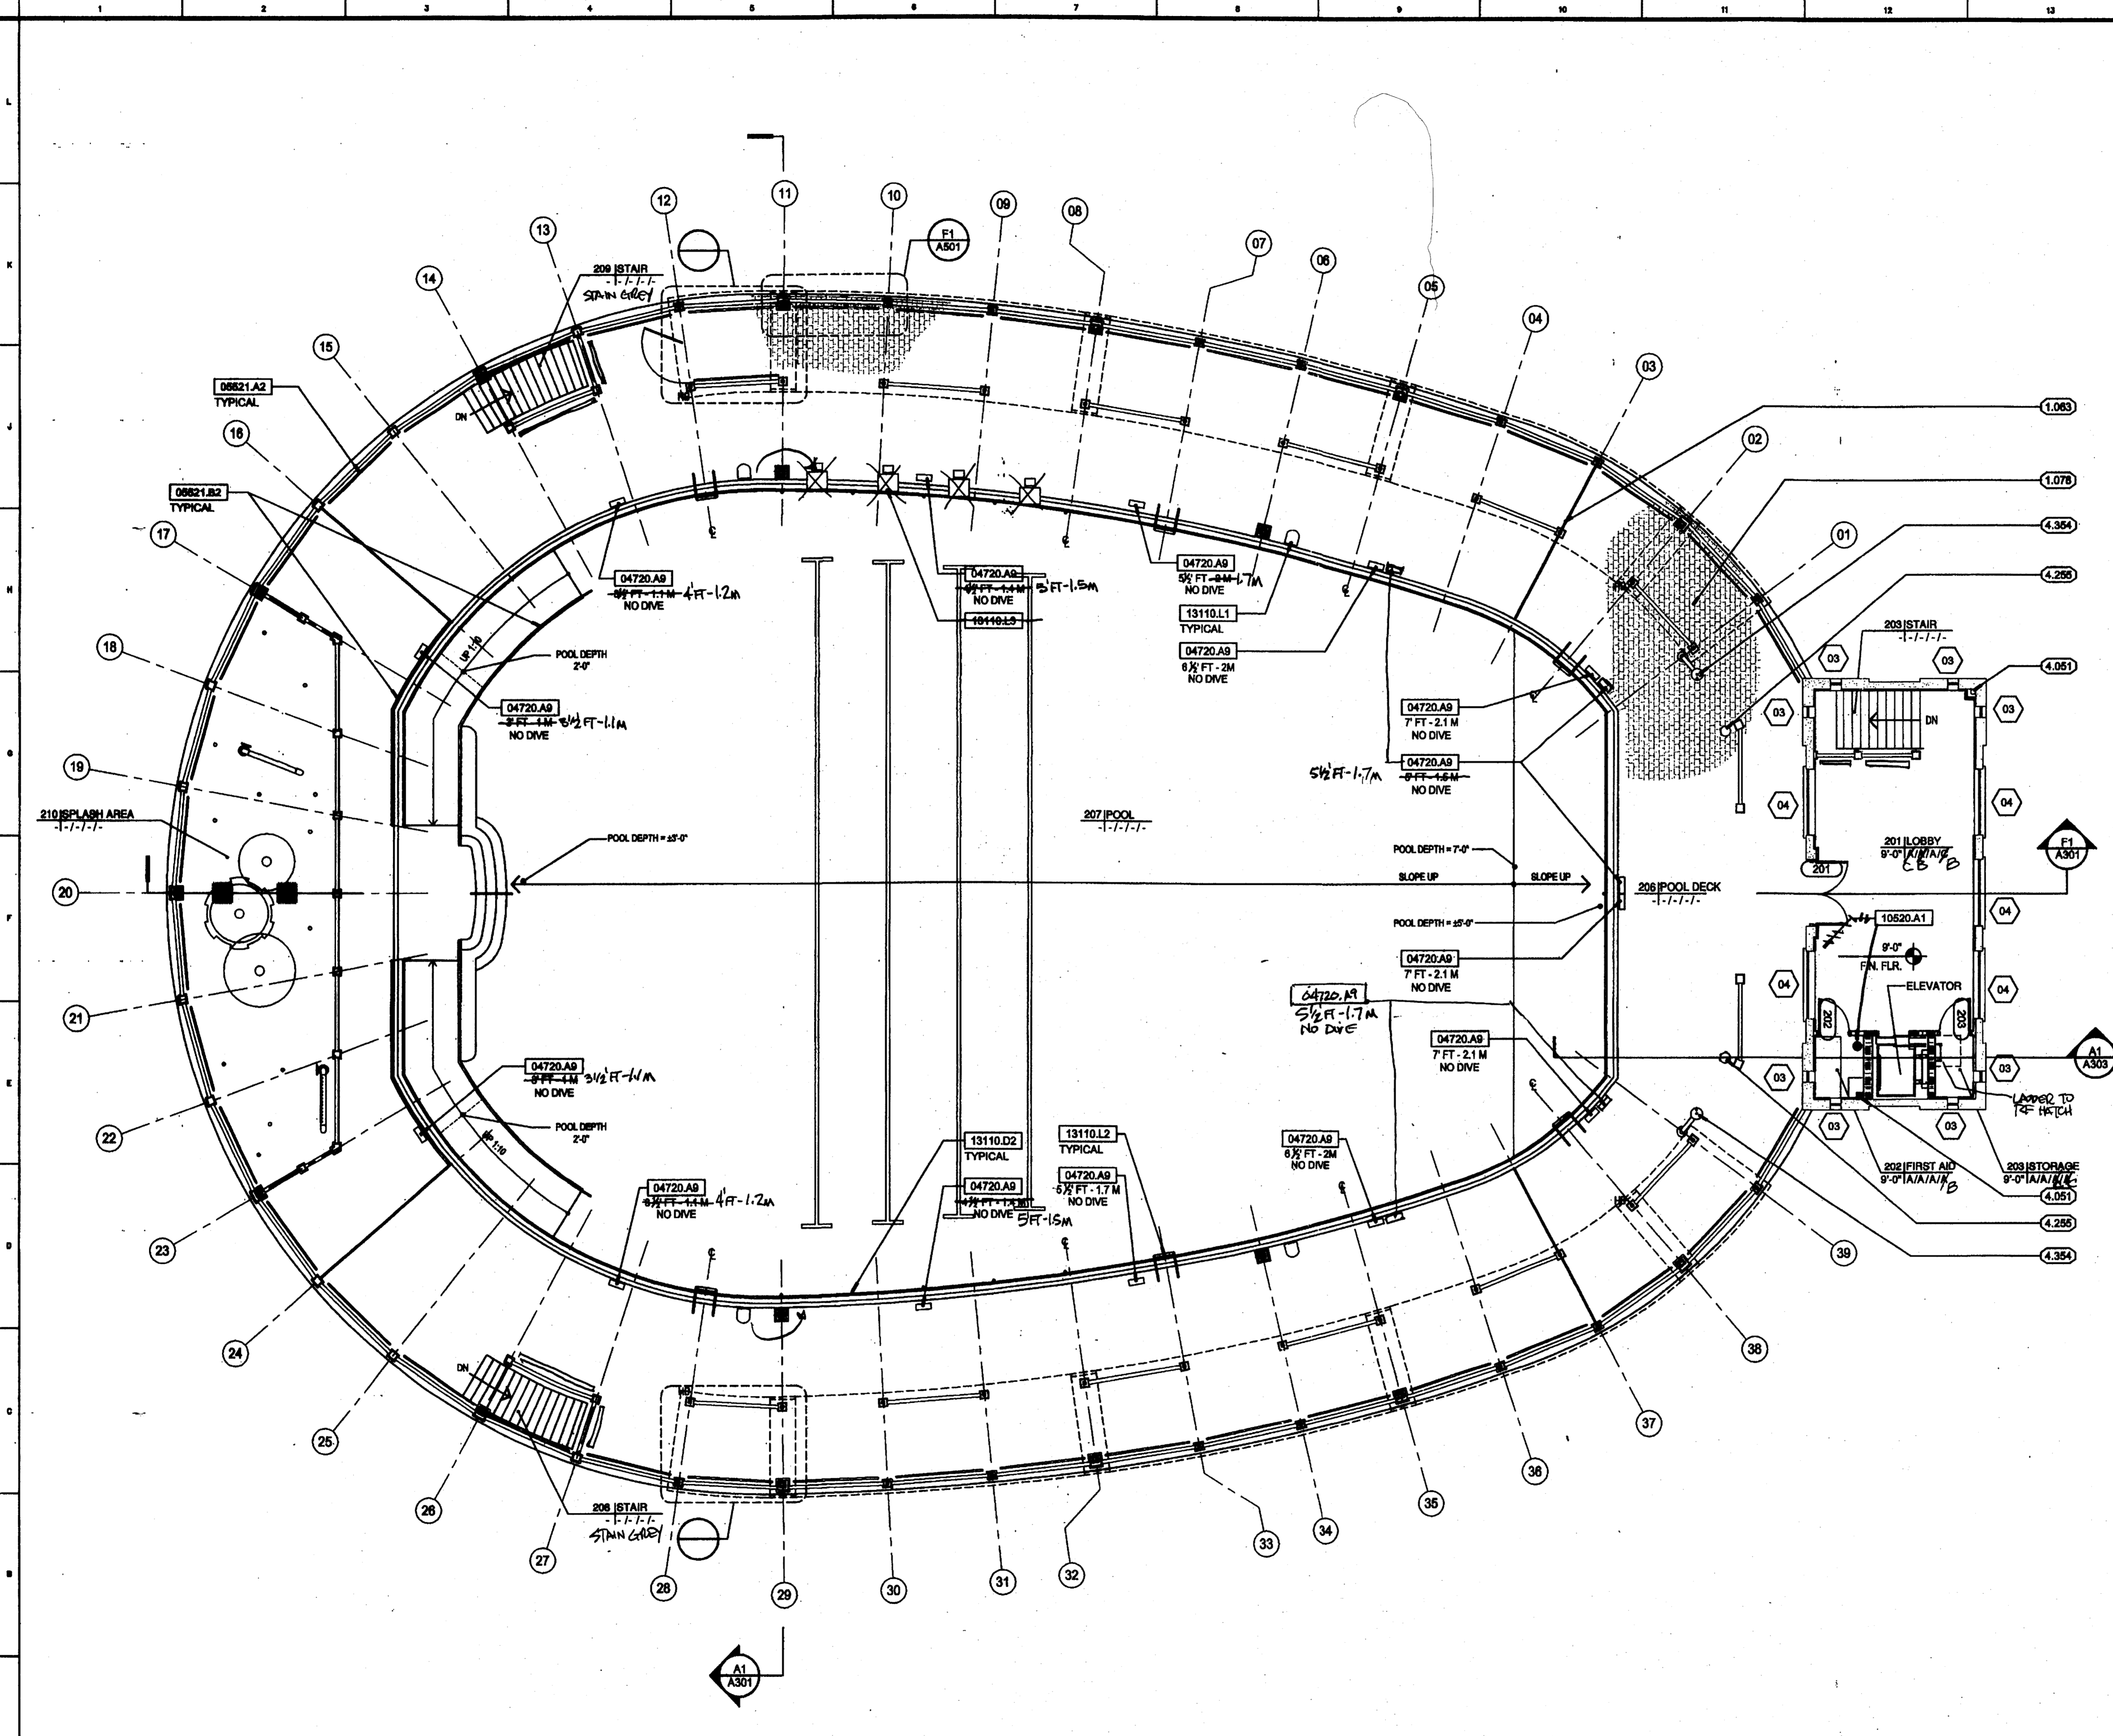


A1 FLOOR PLAN - Second Floor Pool Deck

1/8"=1'-0"

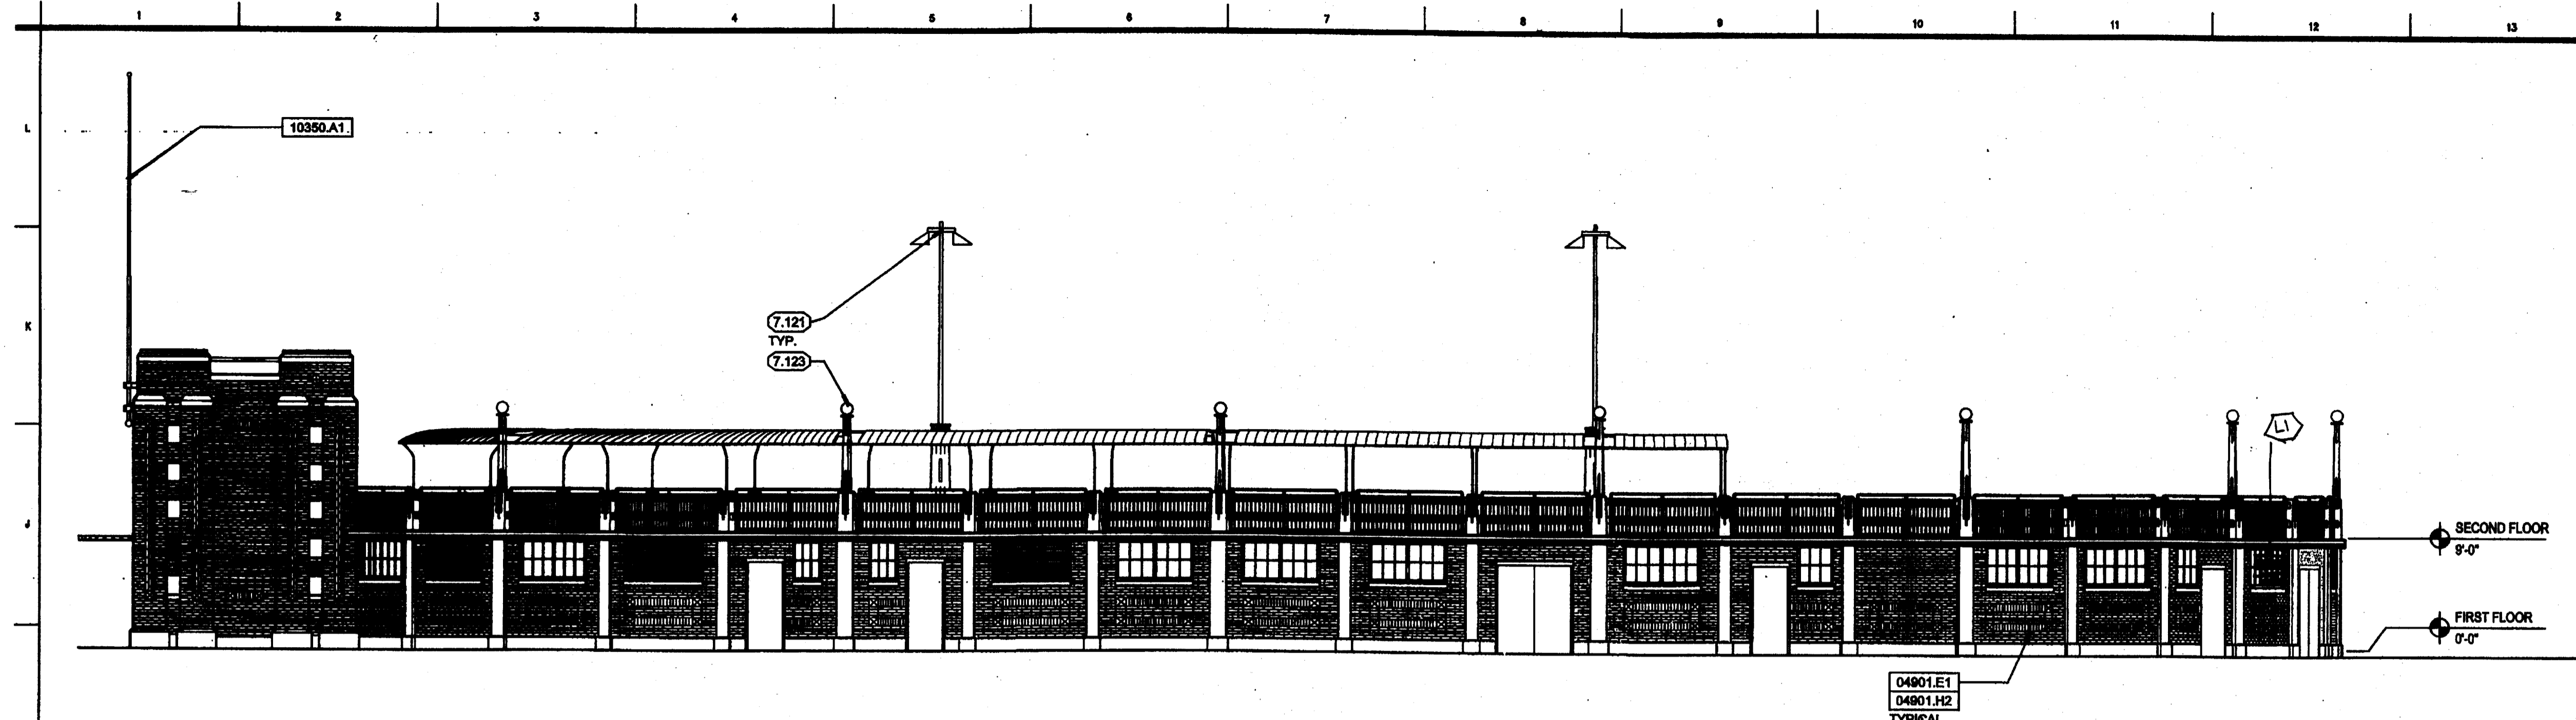


H1 NORTH ELEVATION

1/8" = 1'-0"

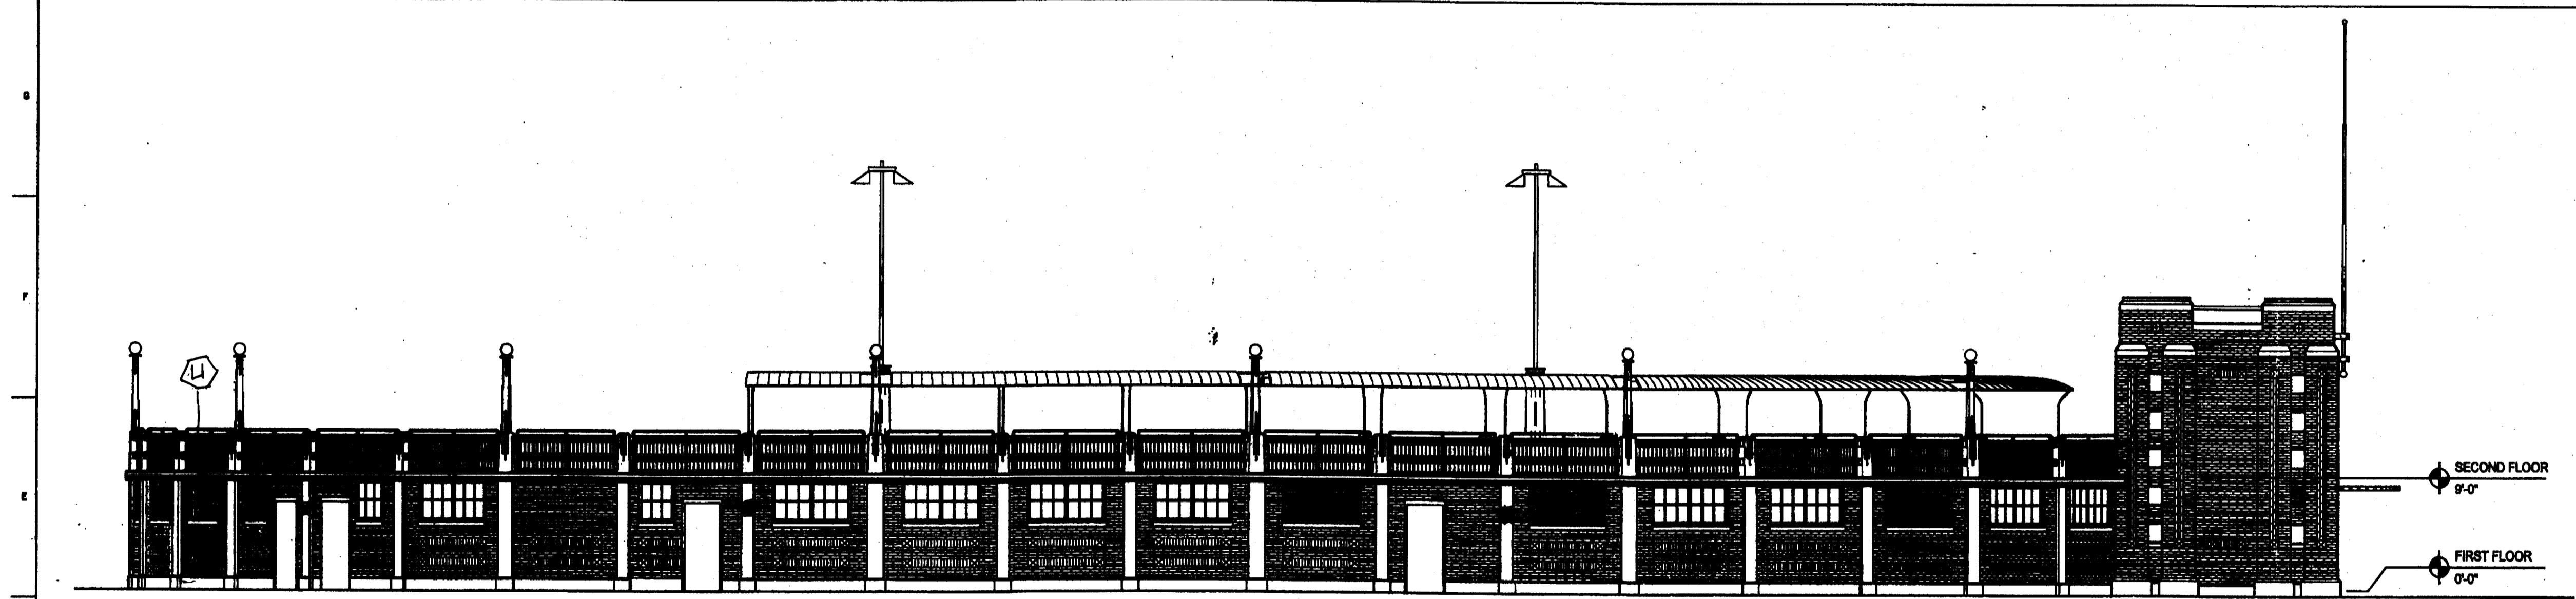

D1 SOUTH ELEVATION

1/8" = 1'-0"

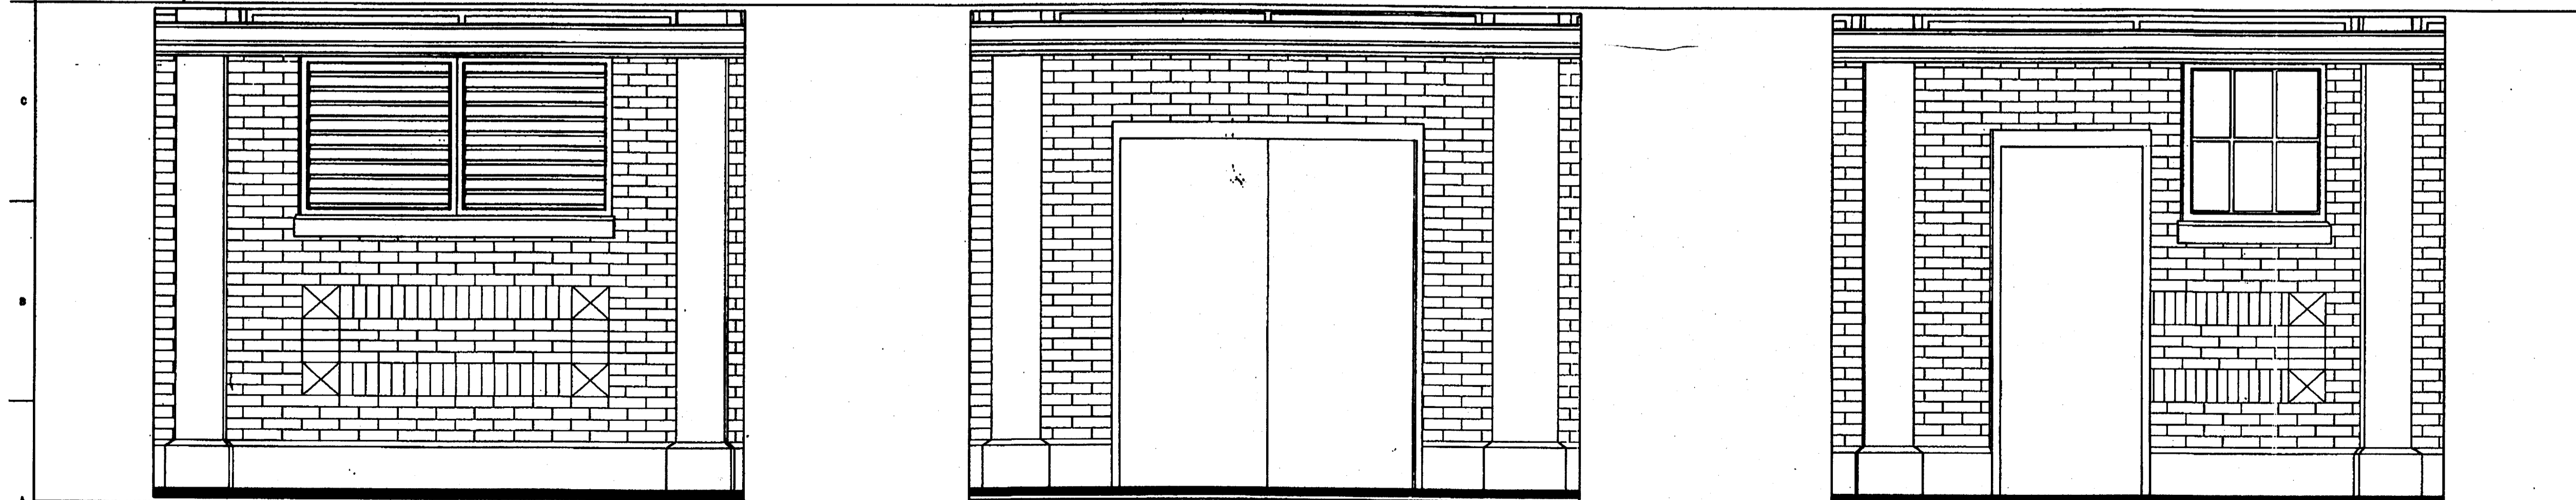

A1 ENLARGED ELEVATIONS
(TYPICAL BAY ELEVATIONS)

1/2" = 1'-0"


KEYNOTES

- 04901 CLAY MASONRY RESTORATION AND CLEANING
- 04901.E1 Clean Brickwork
- 04901.H2 Repoint Brick
- 10350 FLAGPOLES
- 10350.A1 Aluminum flagpoles.

GENERAL NOTES

- 7.000 ELECTRICAL
- 7.121 pole light fixture
- 7.123 globe light fixture

ROWE ARCHITECTS
INCORPORATED
100 Madison Street, Suite 200
Tampa, Florida 33602.4704
www.RoweArchitects.com
Fax: 813.221.9164
813.221.8771
AAC002172

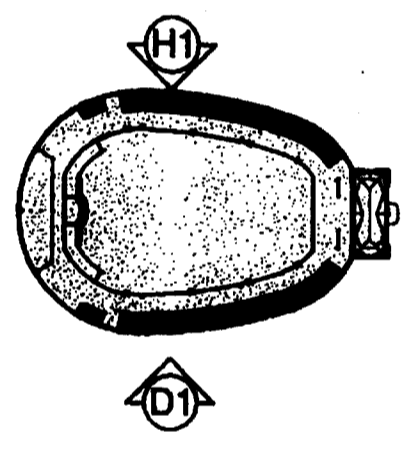

CUSCADEN POOL RENOVATION

CITY OF TAMPA
306 East Jackson Street
Tampa, Florida 33602

Project No.	0202.00
Distribution	Date
BID DOCUMENTS	02.02.04

ELEVATIONS
North & South


RECORD DWG.
DATE 8/26/05



A202


A14 LEGEND / NOTES

217
009

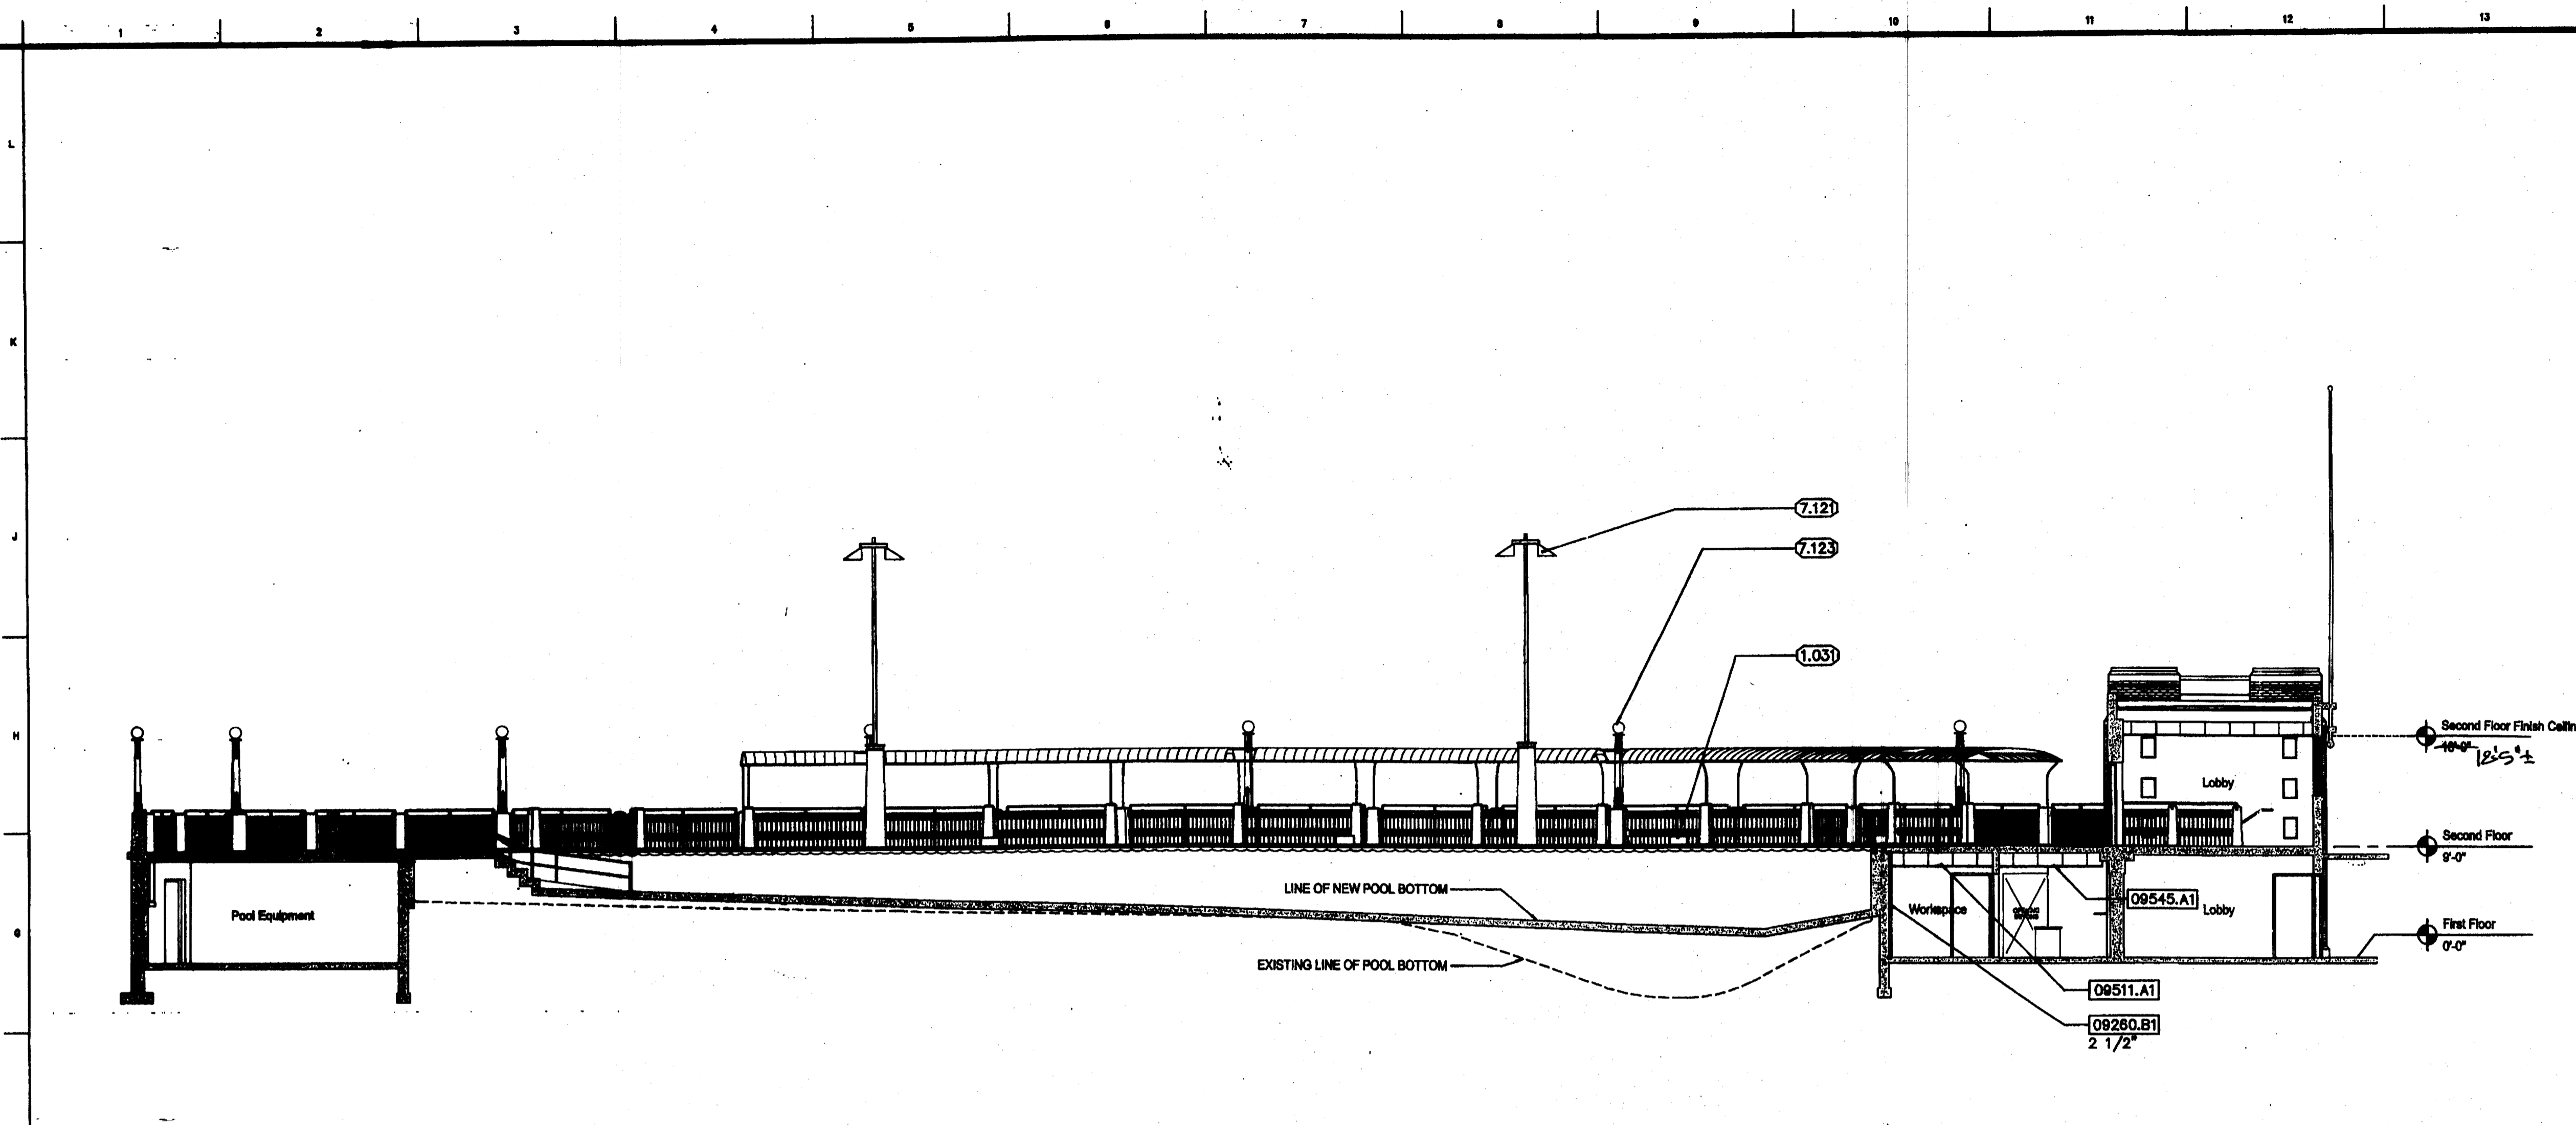

F1 BUILDING SECTION

1/8" = 1'-0"

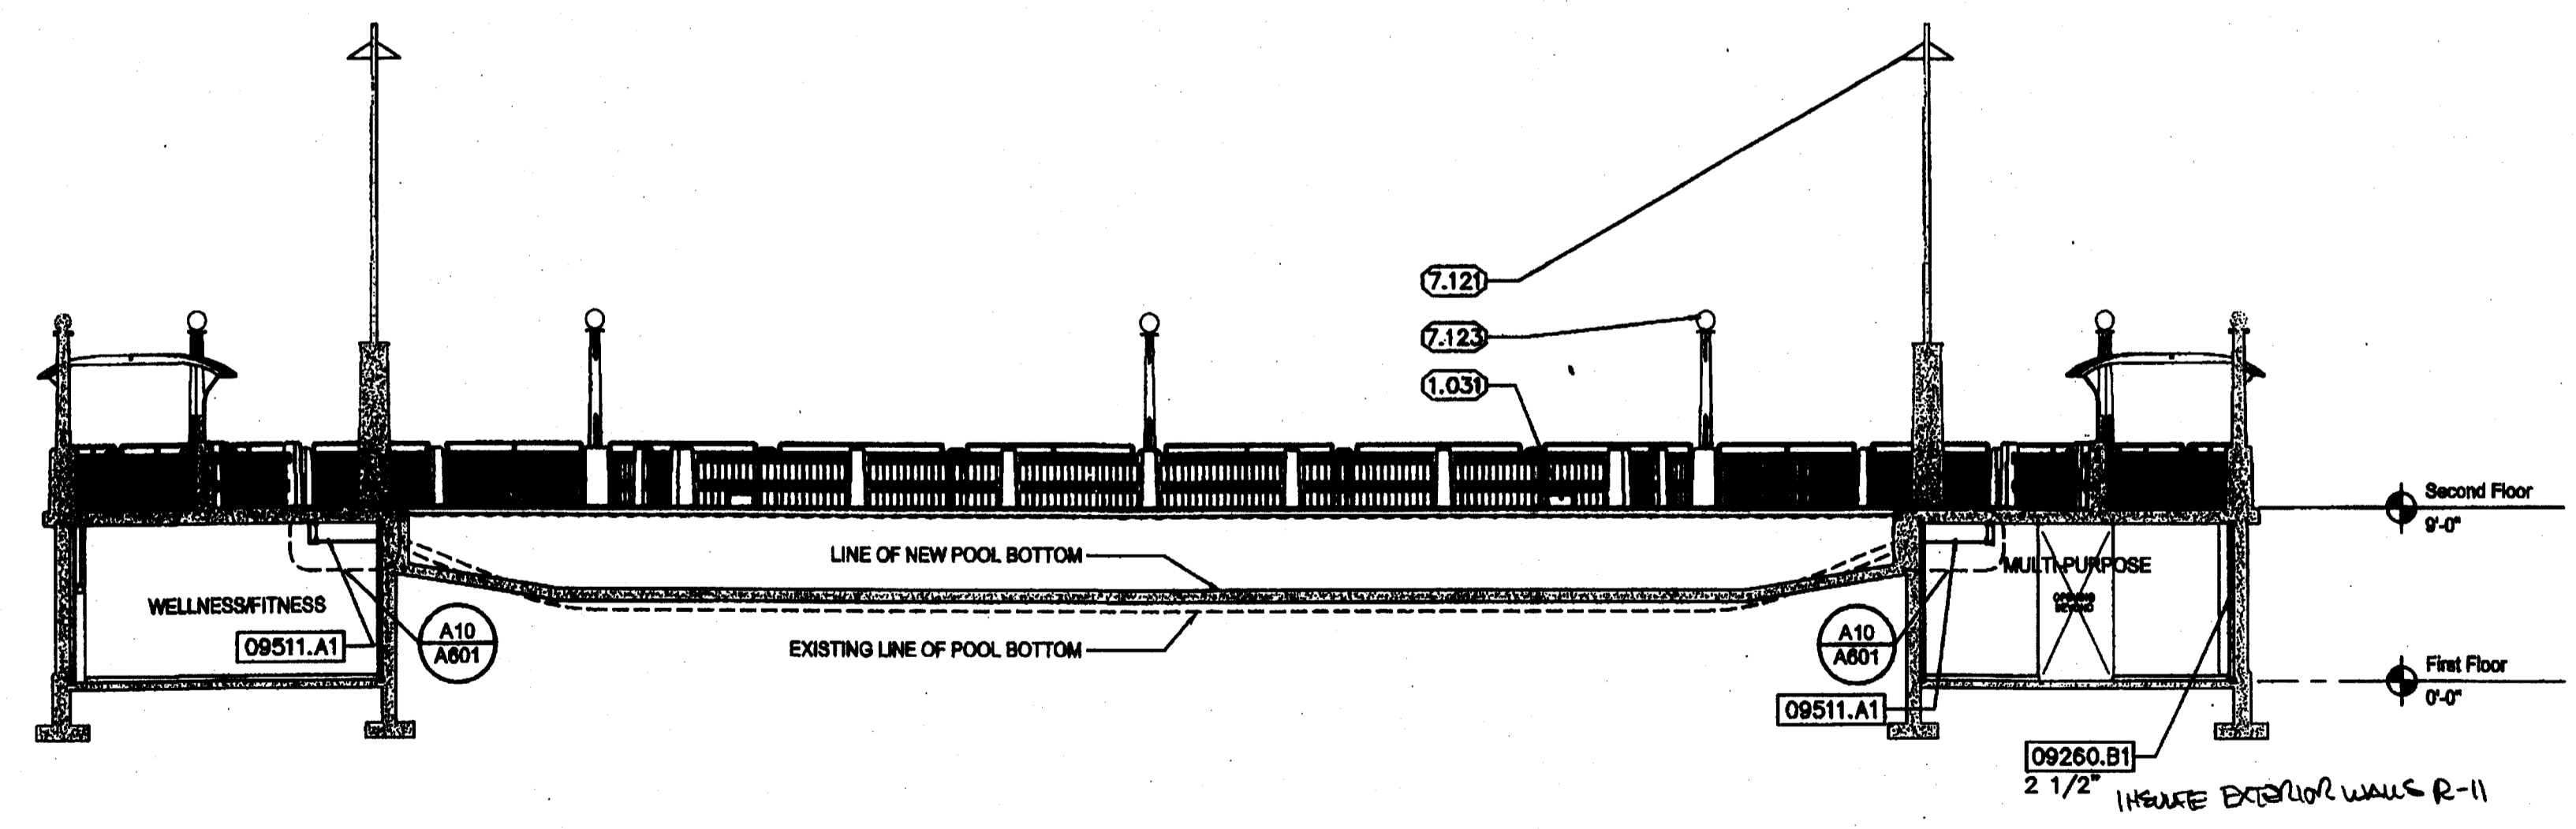


A5 BUILDING SECTION

1/8" = 1'-0"

- KEYNOTES**
- 08280 GYPSUM BOARD ASSEMBLIES
 - 09260.B1 Steel Studs
 - 08811 ACOUSTICAL PANEL CEILING
 - 09511.A1 Suspended Acoustical Panel Ceiling System
 - 08545 METAL CEILING
 - 09545.A1 Suspended Metal Ceiling System

- GENERAL NOTES**
- 1.000 ARCHITECTURAL
 - 1.031 pool depth markers
 - 7.000 ELECTRICAL
 - 7.121 pole light fixture
 - 7.123 globe light fixture

ROWE ARCHITECTS
INCORPORATED
100 Madison Street, Suite 200
Tampa, Florida 33602-4704
www.RoweArchitects.com
Fax: 813.221.9154
813.221.8771
AAC002172

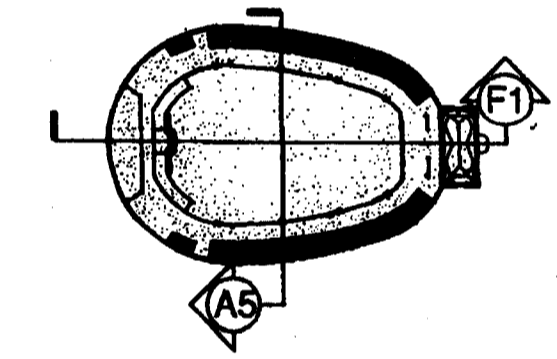


CUSCADEN POOL RENOVATION

CITY OF TAMPA
306 East Jackson Street
Tampa, Florida 33602

Project No.	0202.00
Distribution	Date
BID DOCUMENTS	02.02.04

BUILDING SECTIONS

RECORD DWG.
DATE 8/26/05

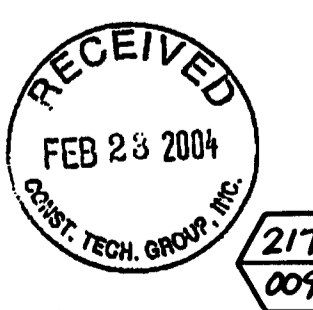


A14 LEGEND / NOTES

A301

217
009

- KEYNOTES**
- 02780 UNIT PAVERS
02780.A5 Concrete Pavers
 - 04810 UNIT MASONRY ASSEMBLIES
04810.A1 Concrete Masonry Unit
 - 09220 PORTLAND CEMENT PLASTER
09220.A1 Portland Cement Plaster
 - 09260 GYPSUM BOARD ASSEMBLIES
09260.B1 Steel Studs
 - 09511 ACOUSTICAL PANEL CEILING
09511.A1 Suspended Acoustical Panel Ceiling System
 - 09651 RESILIENT TILE FLOORING
09651.A5 Vinyl Composition Tile
09651.B1 Wall Base
 - 09912 PAINTING
09912.C1 Textured Coating

- GENERAL NOTES**
- 0.000 DEMOLITION
 - 0.141 existing masonry to remain

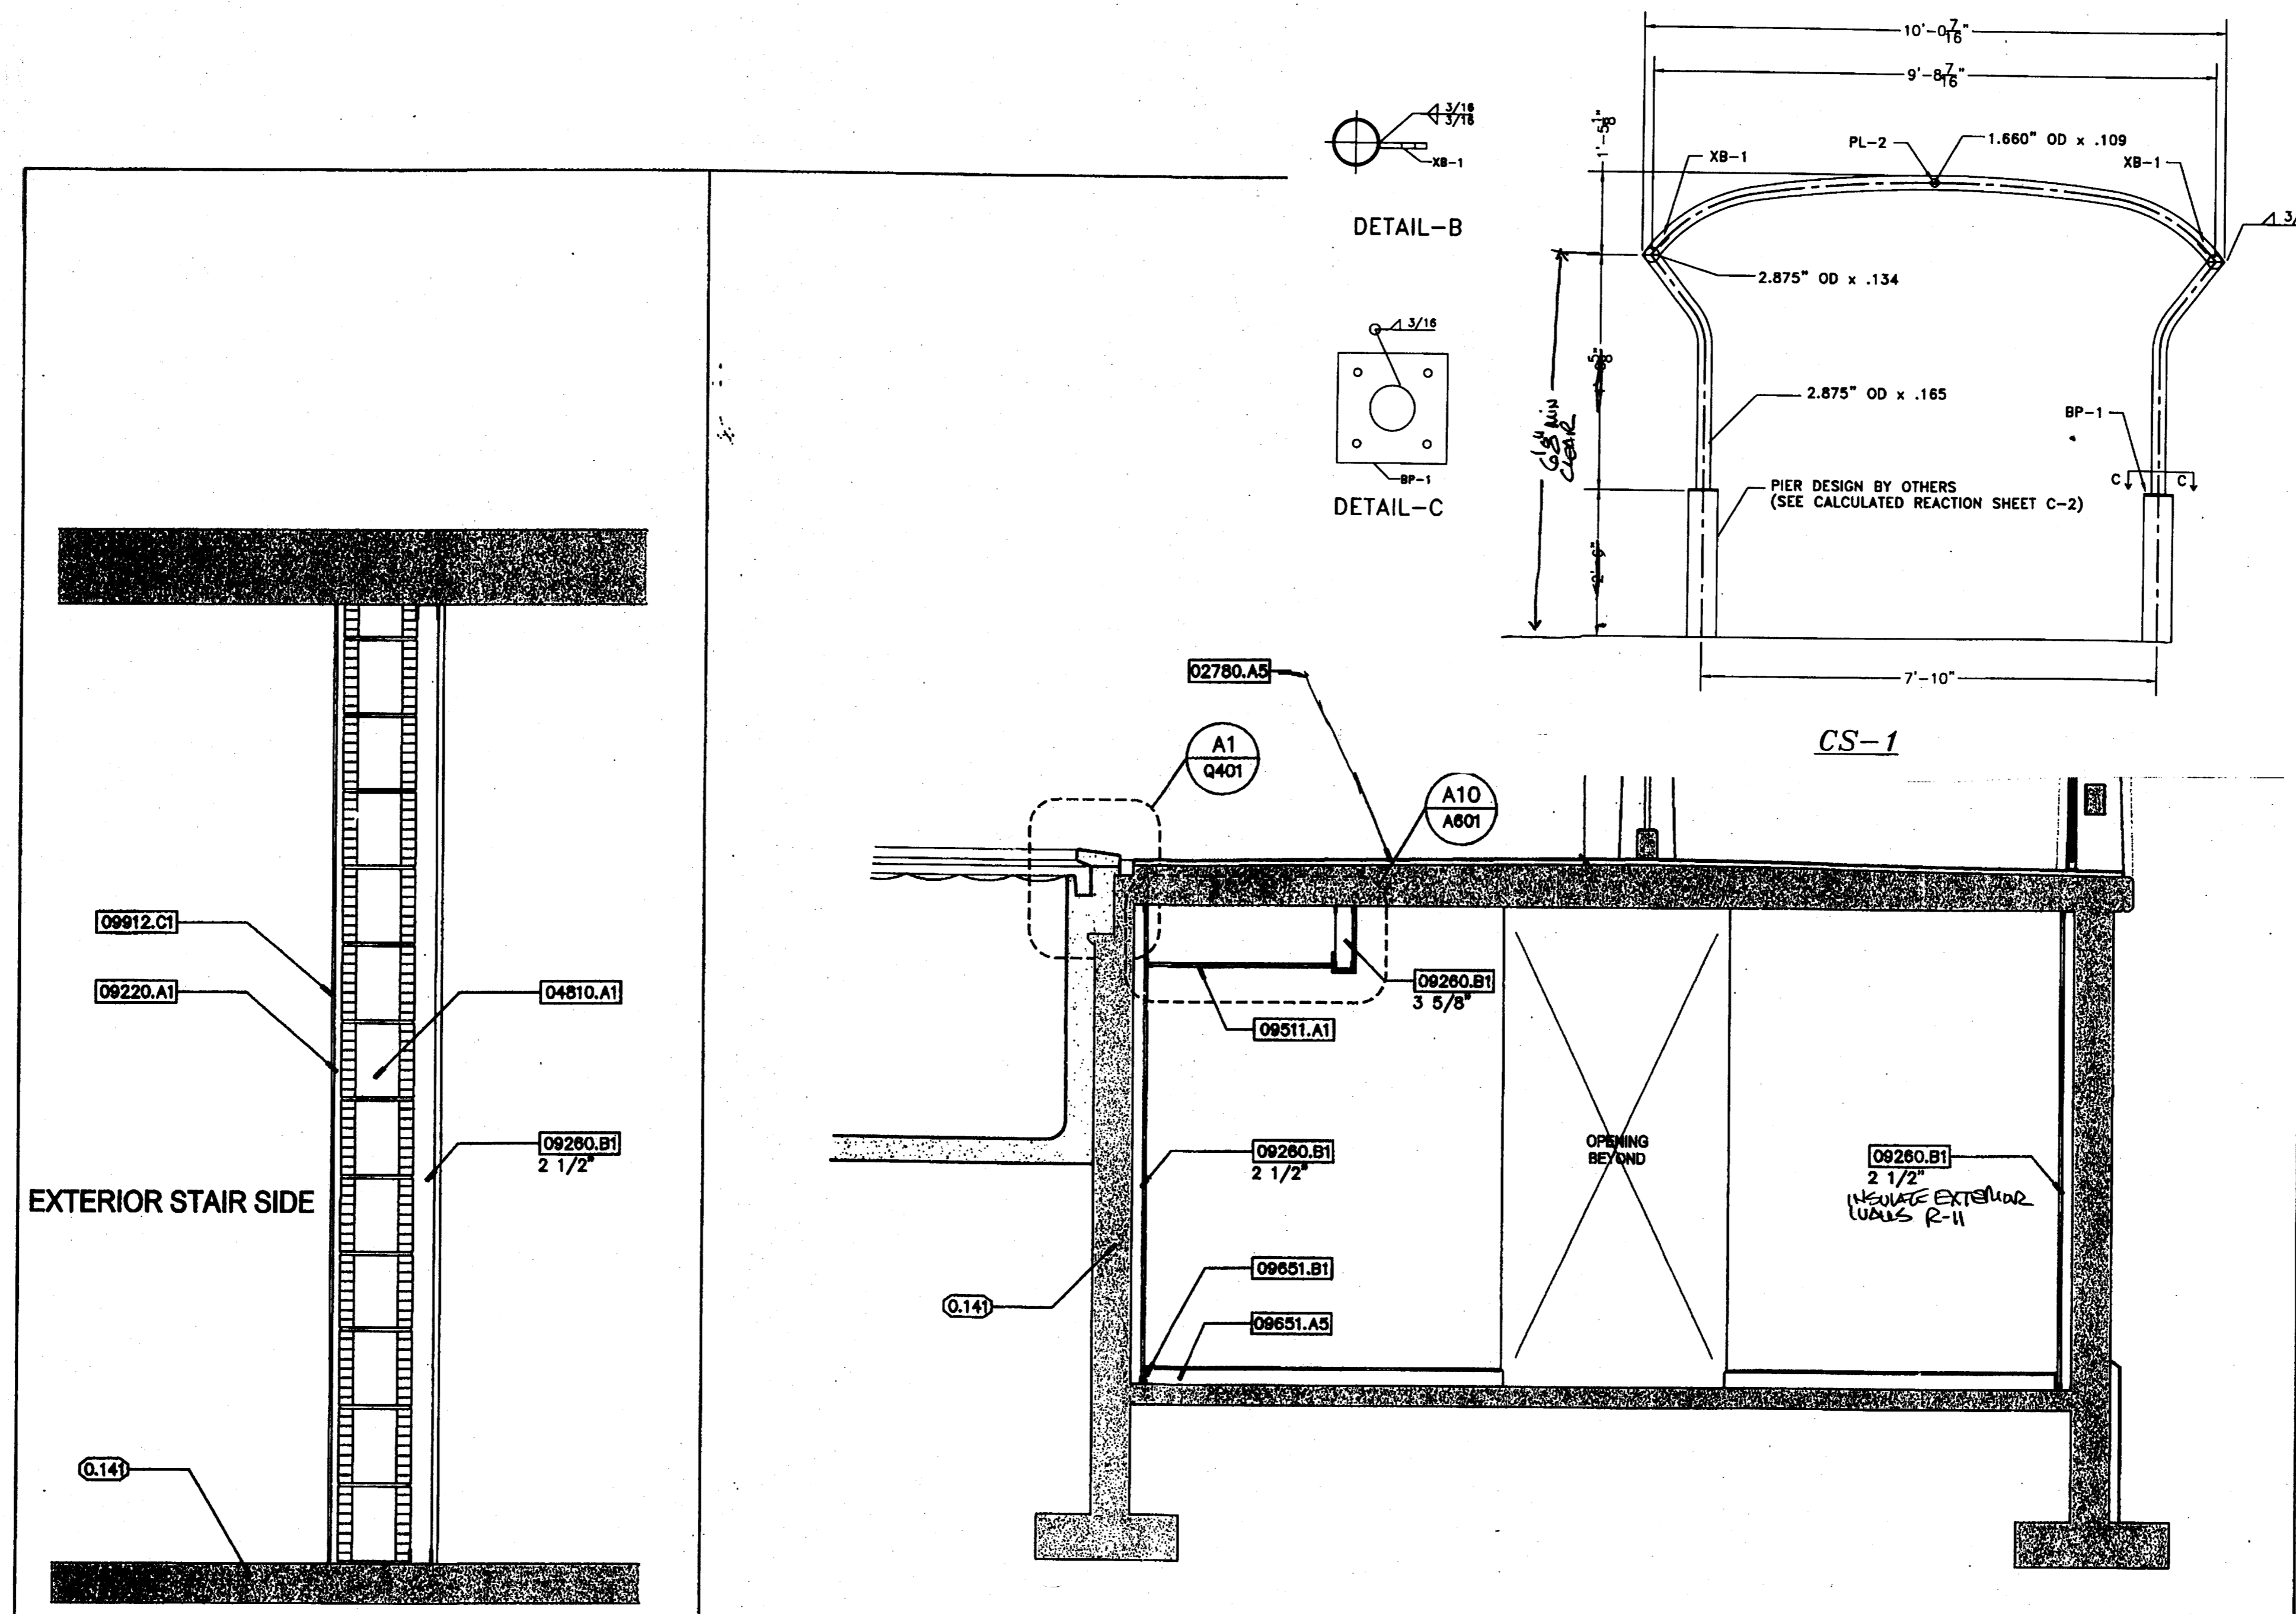


A4 WALL SECTION
1" = 1'-0"

A7 BUILDING SECTION
1/2" = 1'-0"

DRAWING LEGEND

	NEW WALL CONSTRUCTION
	EXISTING MASONRY WALL TO REMAIN

A14 LEGEND / NOTES

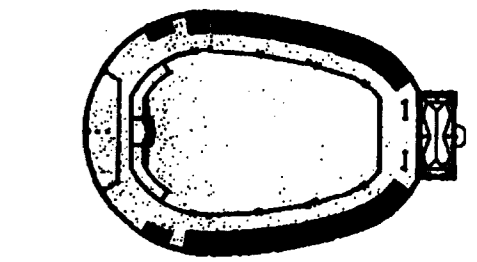

CUSCADEN POOL RENOVATION

CITY OF TAMPA
306 East Jackson Street
Tampa, Florida 33602

Project No.	0202.00
Distribution	Date
BID DOCUMENTS	02.02.04


SECTIONS

RECORD DWG

DATE 8/26/05


RECEIVED
FEB 23 2004
CONSTR. TECH. GROUP, INC.

A302

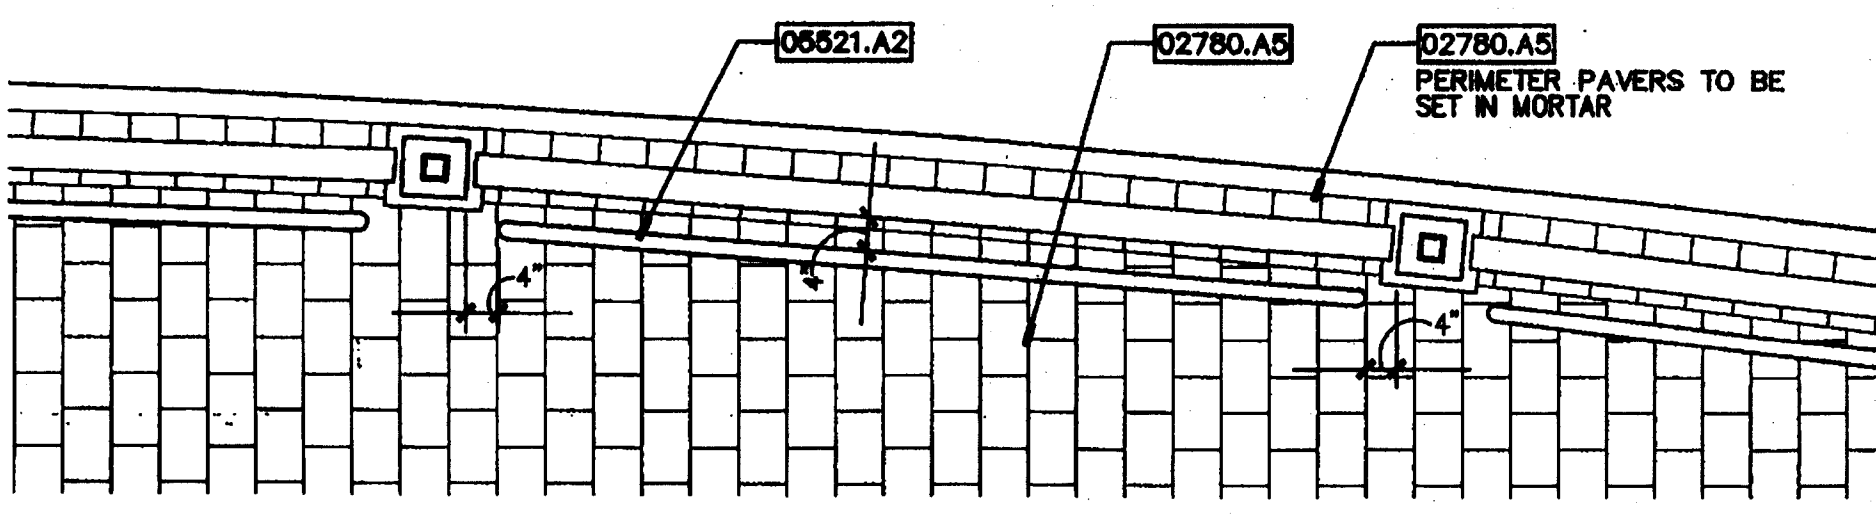





K1 INTERIOR POOL DECK RAILING PLAN

1/2" = 1'-0" TYPICAL

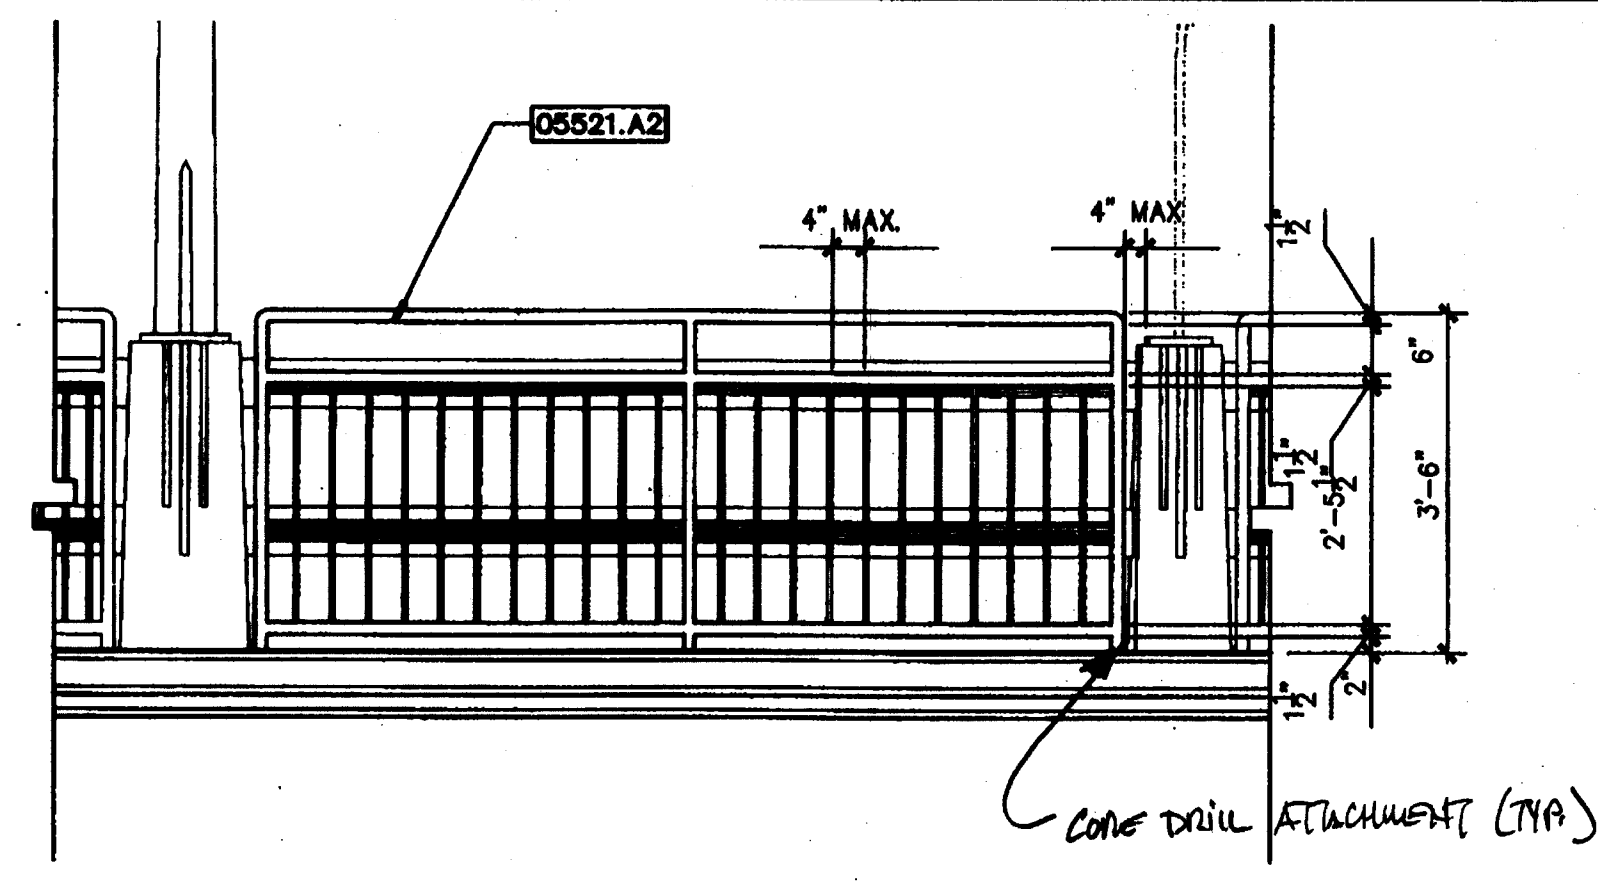


G1 INTERIOR POOL DECK RAILING ELEVATION

1/2" = 1'-0" TYPICAL

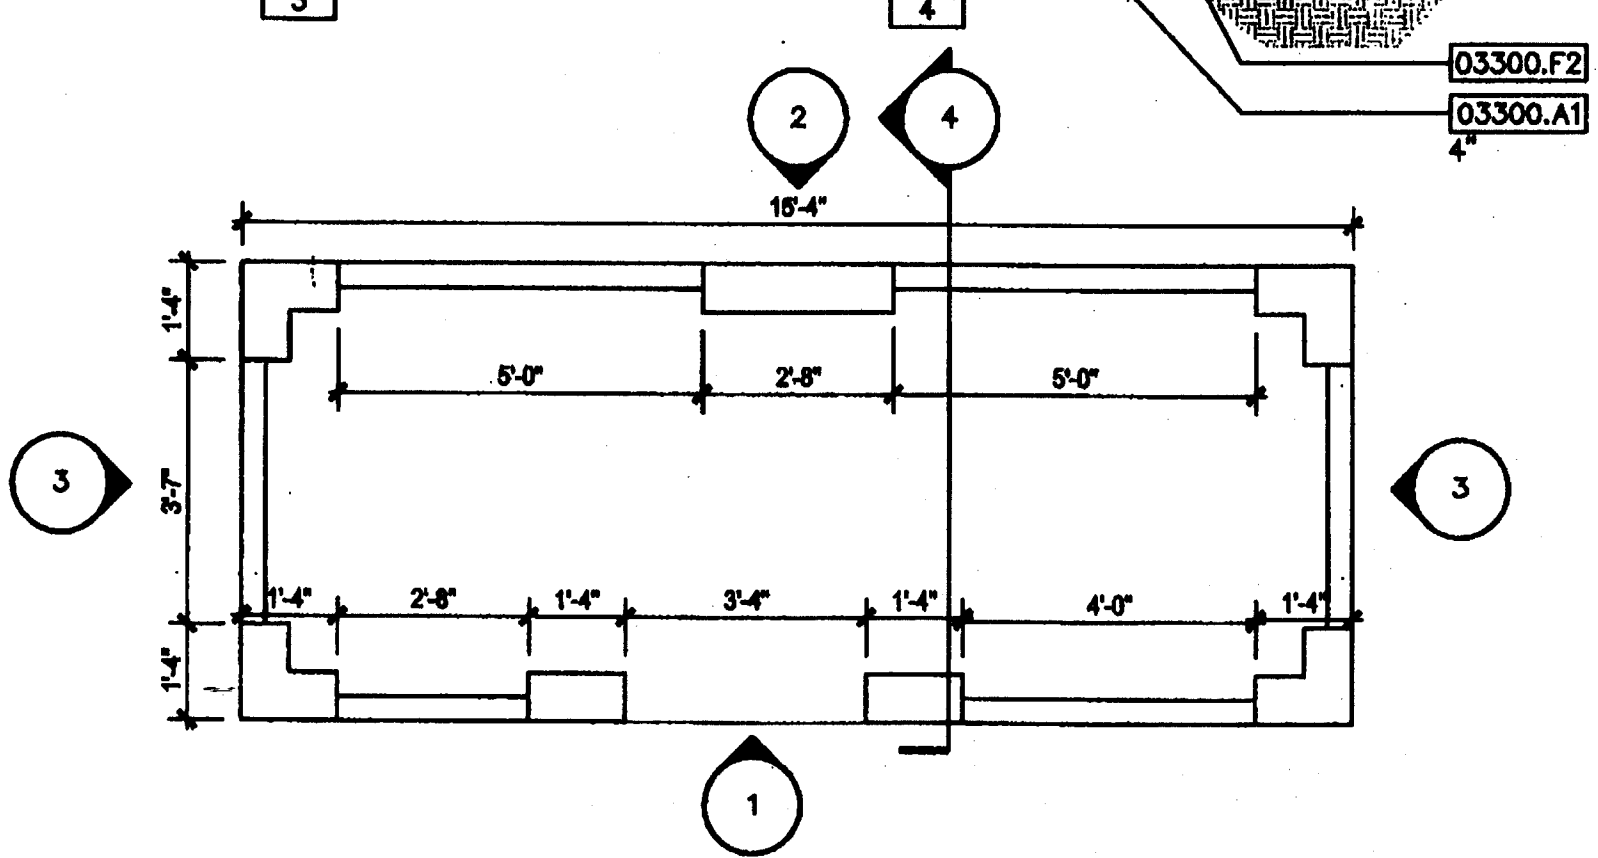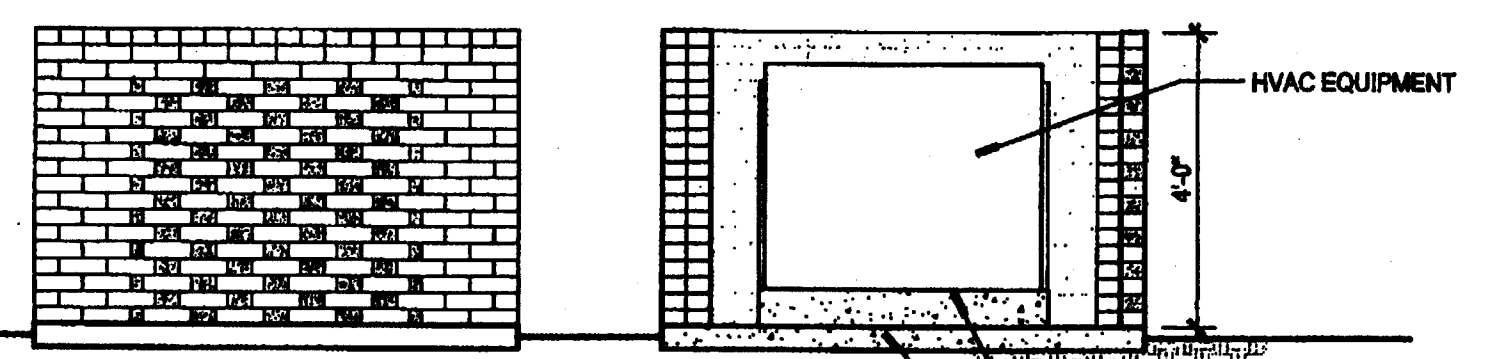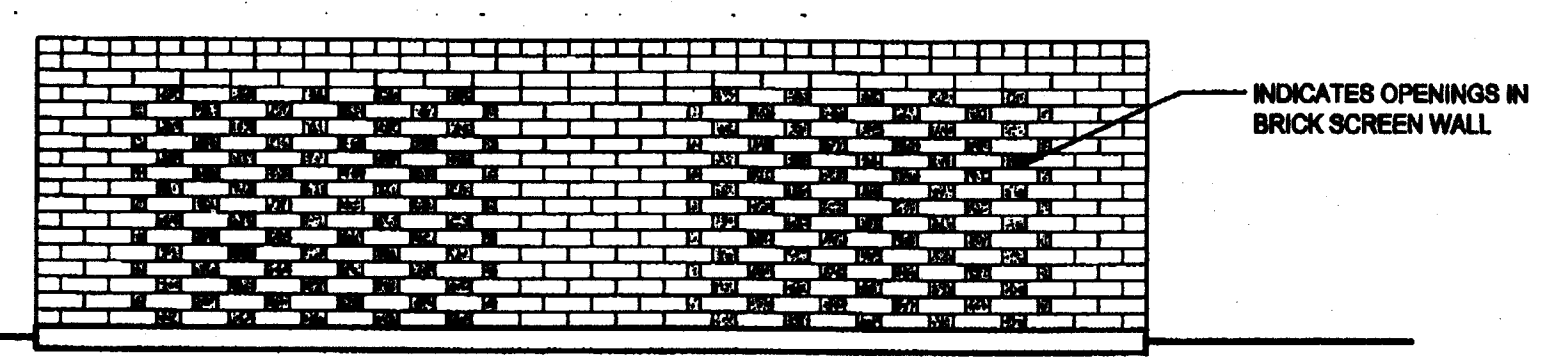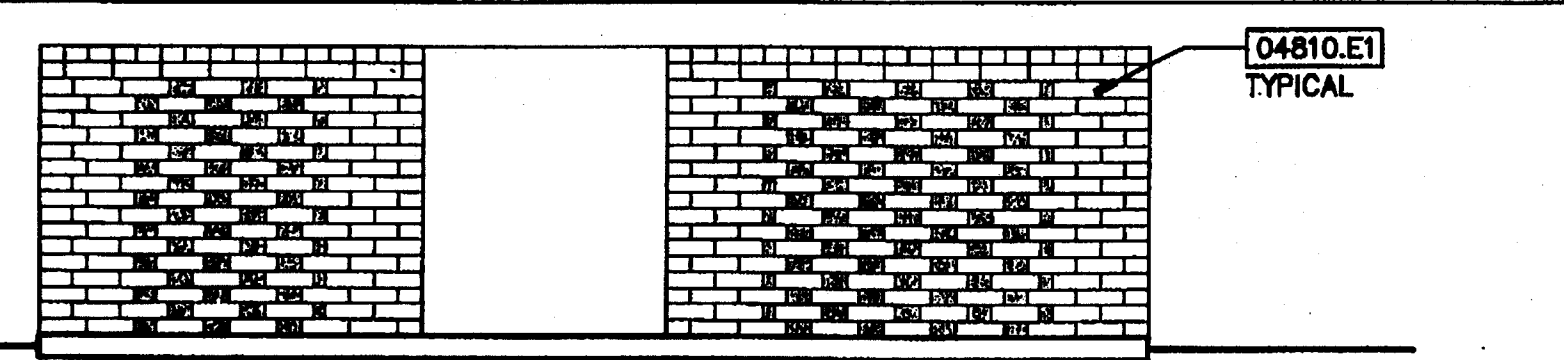


A1 ENLARGED EQUIPMENT SCREEN

3/8" = 1'-0"

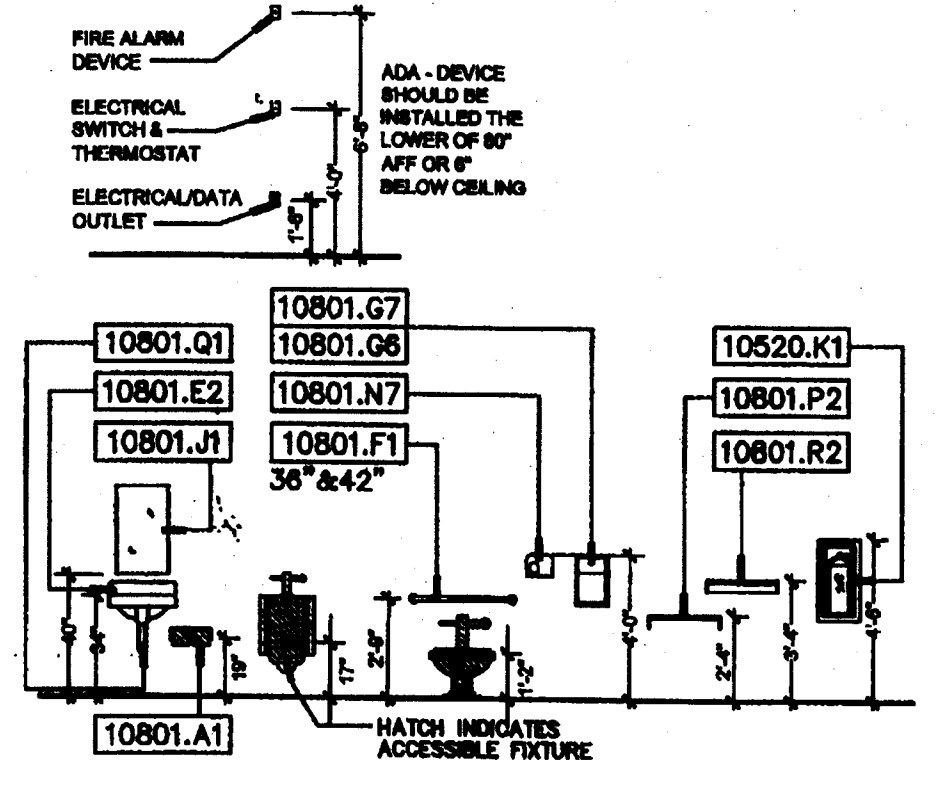


H10 TYPICAL MOUNTING HEIGHTS

3/16" = 1'-0"

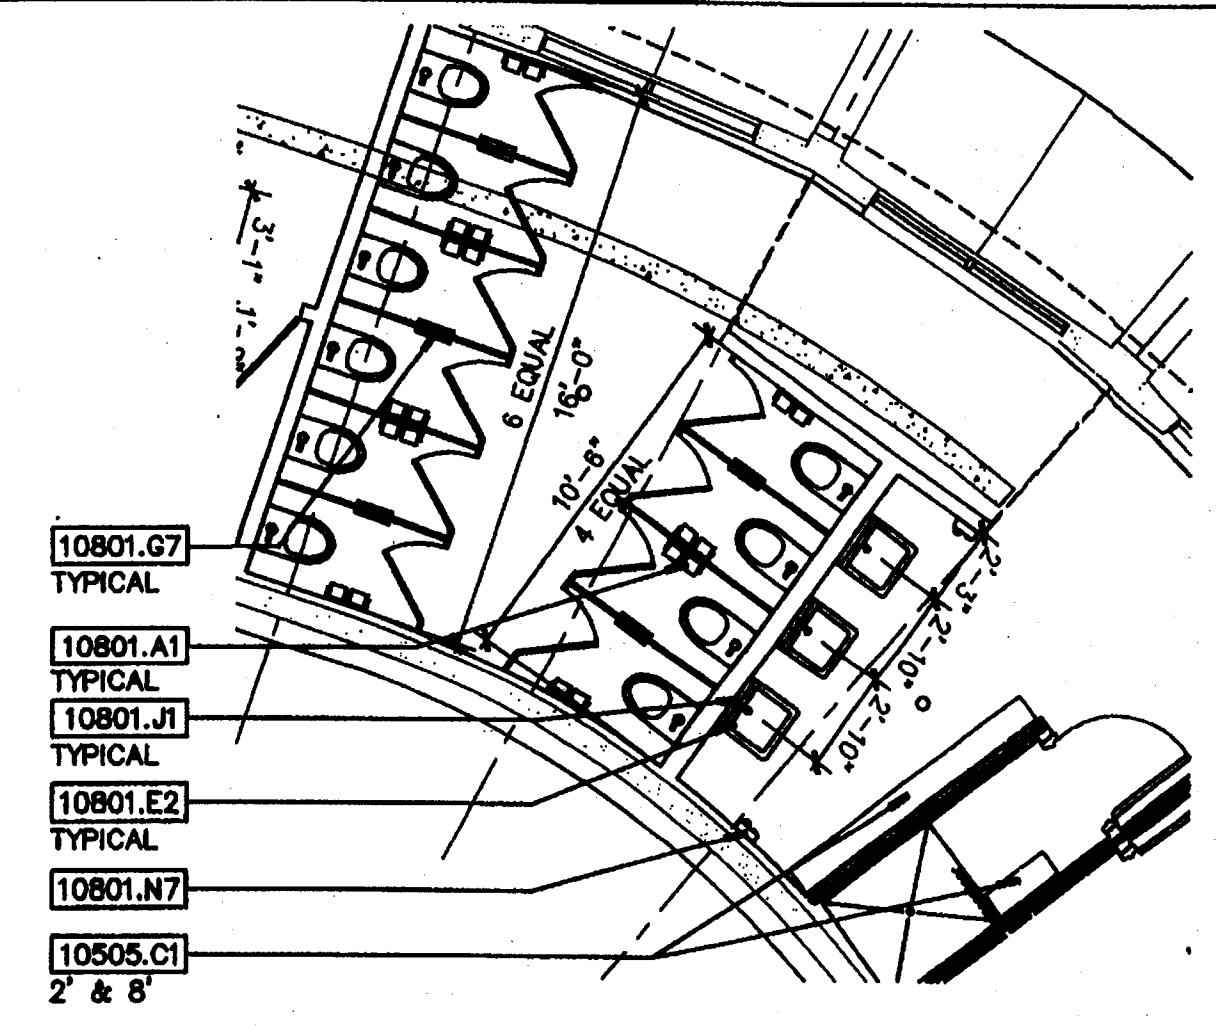


E10 ENLARGED TOILET ROOM 162

3/16" = 1'-0"

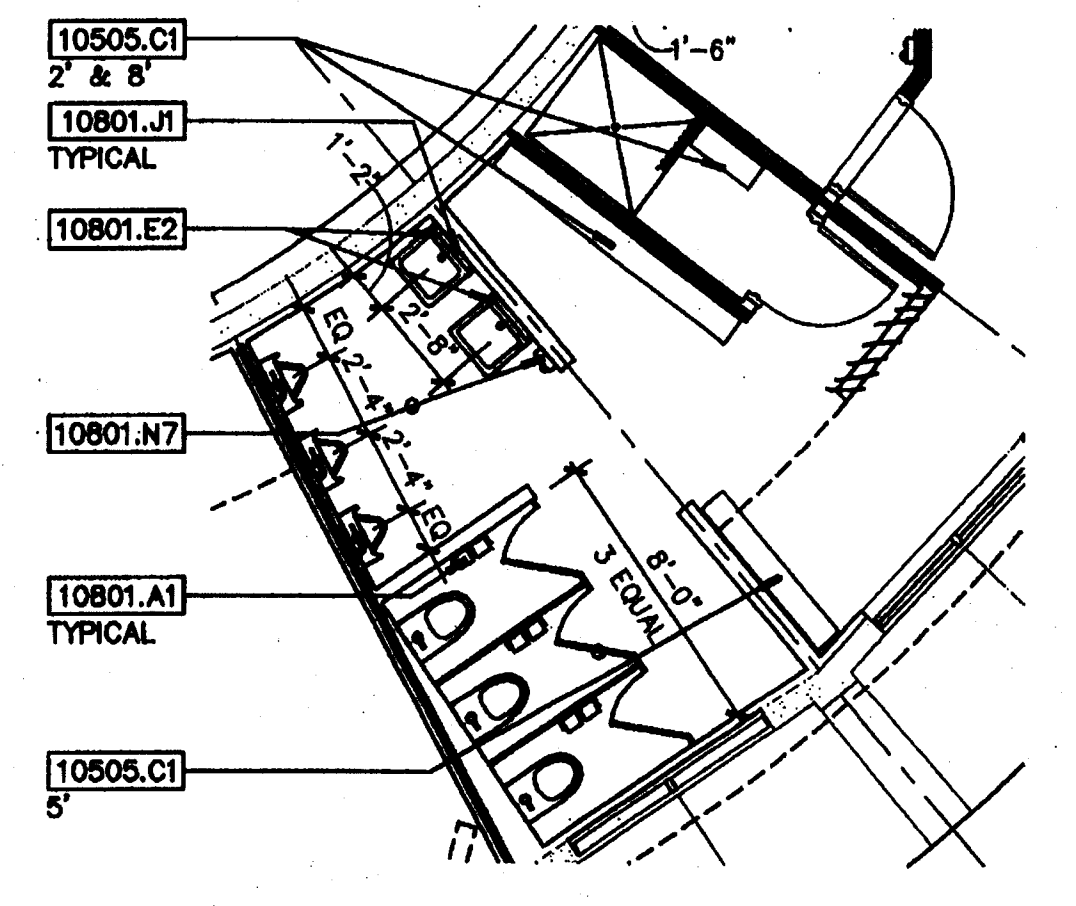

A10 ENLARGED TOILET ROOM 110


3/16" = 1'-0"

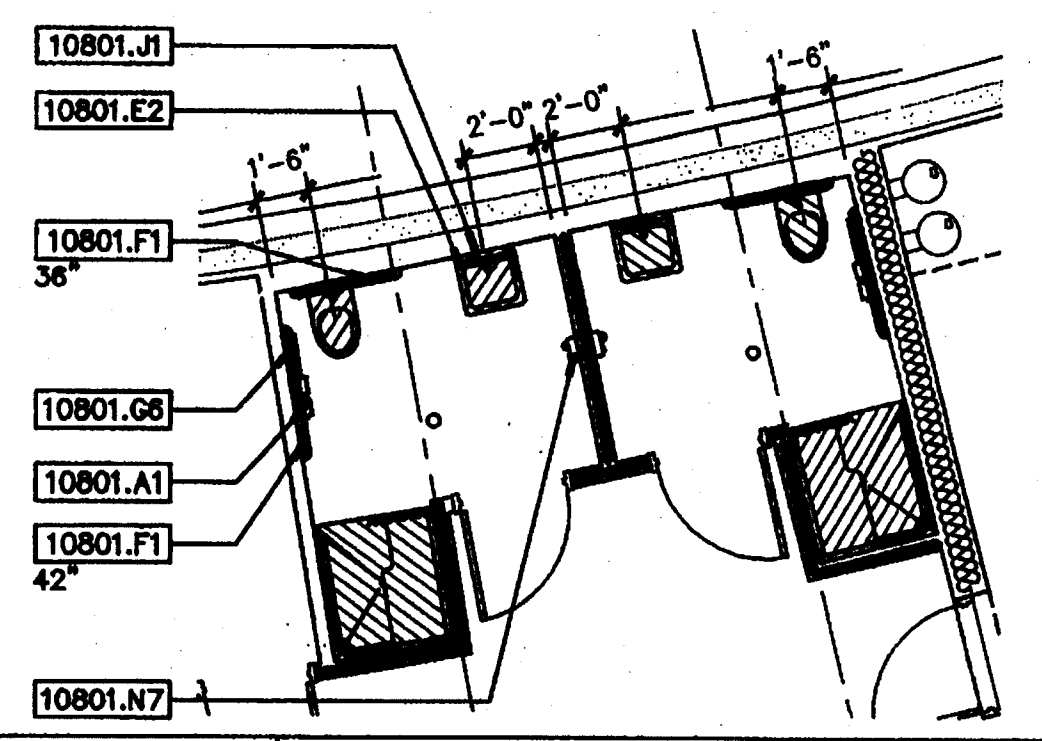

J6 ENLARGED TOILET ROOM PLAN 113 & 114

3/16" = 1'-0"


ACCESSIBLE

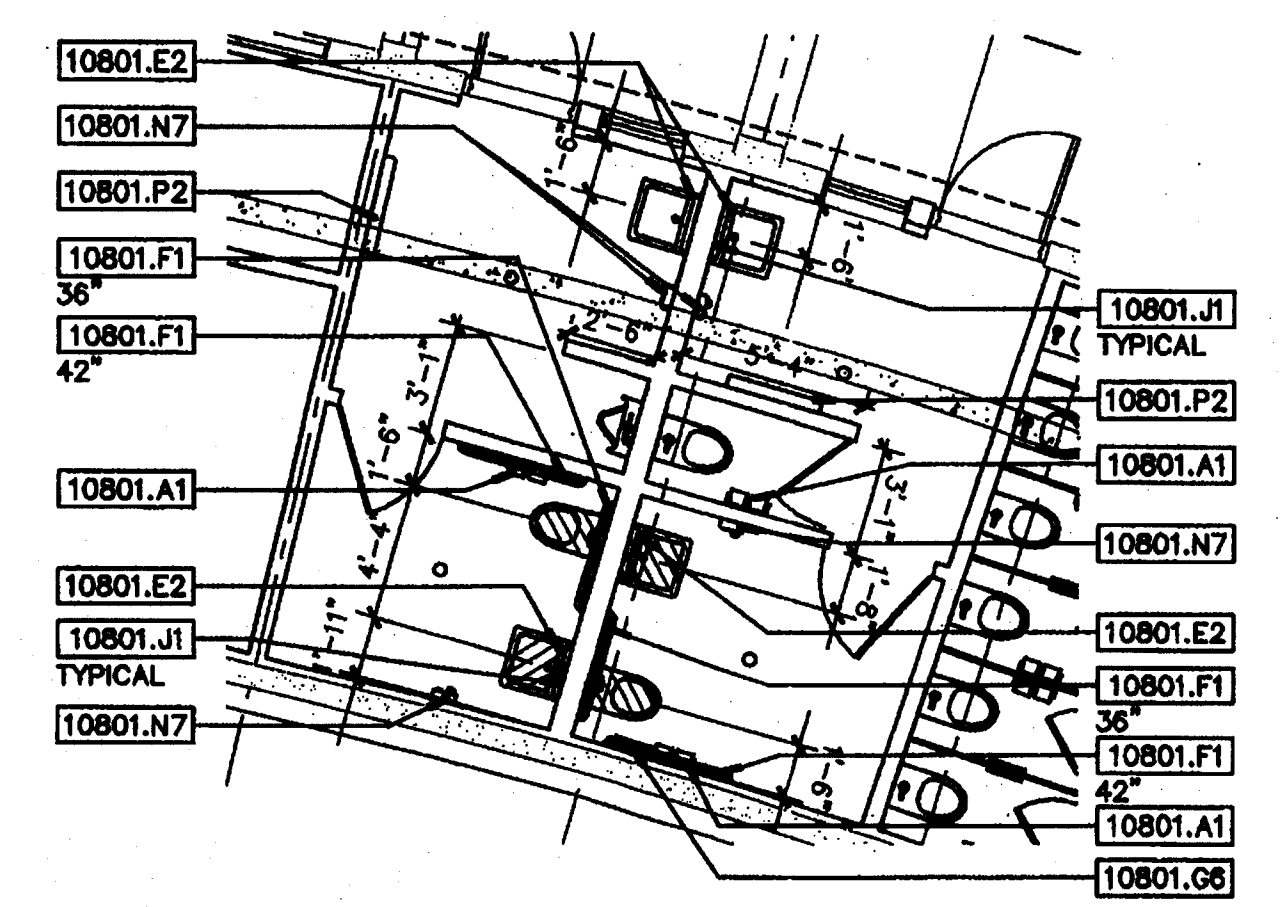

F6 ENLARGED TOILET ROOM PLAN 160 & 161

3/16" = 1'-0"


ACCESSIBLE

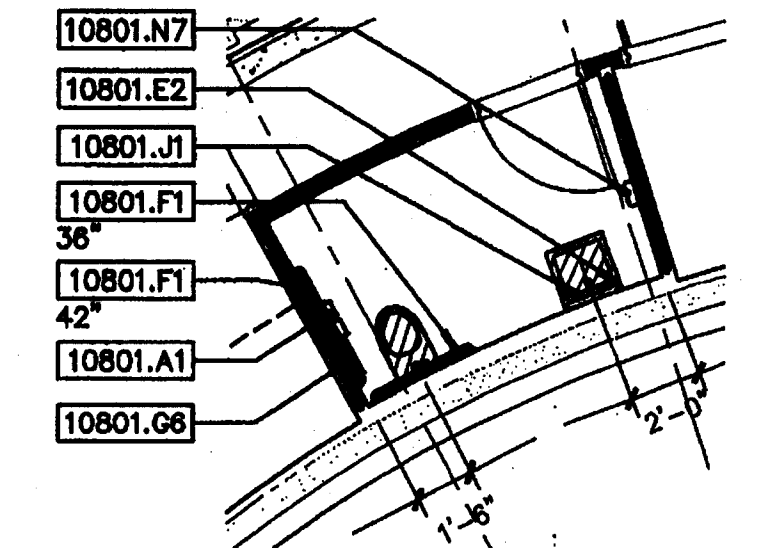

D6 ENLARGED TOILET ROOM 154

3/16" = 1'-0"

(STAFF TOILET 122 SIM.) ACCESSIBLE

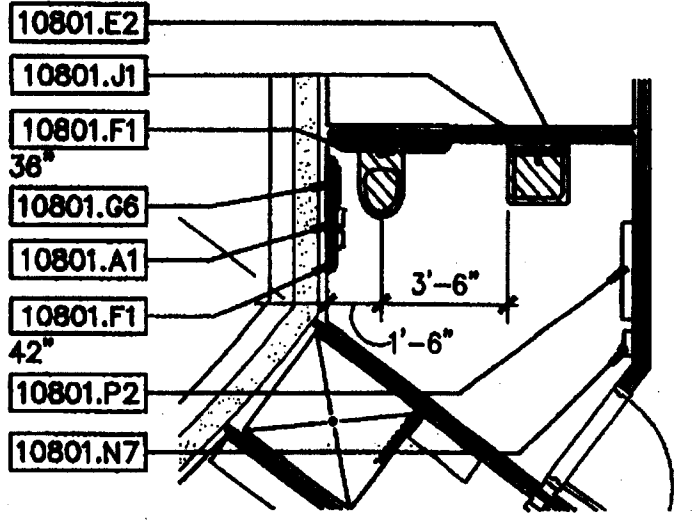

A6 ENLARGED TOILET ROOM 102


3/16" = 1'-0"

ACCESSIBLE

- KEYNOTES**
- 02780 UNIT PAVERS
 - 02780.A5 Concrete Pavers
 - 03300 CAST-IN-PLACE CONCRETE
 - 03300.A1 Concrete Slab-on-Grade
 - 03300.F2 Concrete Equipment Base
 - 04810 UNIT MASONRY ASSEMBLIES
 - 04810.E1 Face Brick
 - 05521 PIPE AND TUBE RAILINGS
 - 05521.A2 Aluminum Tube Railing
 - 10805 METAL LOCKERS
 - 10505.C1 Locker benches.
 - 10820 FIRE-PROTECTION SPECIALTIES
 - 10820.K1 Fire Extinguisher Cabinet
 - 10801 TOILET AND BATH ACCESSORIES
 - 10801.A1 Toilet Tissue (Roll) Dispenser
 - 10801.E2 Liquid-Soap Dispenser
 - 10801.F1 Grab Bar
 - 10801.G6 Sanitary Napkin Disposal Unit, Recessed
 - 10801.G7 Sanitary Napkin Disposal Unit, Partition-Mounted, Dual-Access
 - 10801.J1 Mirror Unit
 - 10801.N7 Warm-Air Dryer, Surface mounted, Electronic-sensor Operation
 - 10801.P2 Diaper-Changing Station, surface mounted
 - 10801.Q1 Underlatory Guard
 - 10801.R2 Mop and Broom Holder with Utility Shelf

F14 KEYNOTES

ROME ARCHITECTS INCORPORATED
 100 Madison Street, Suite 200
 Tampa, Florida 33602-4704
 www.RomeArchitects.com
 Fax: 813.221.9154
 813.221.8771
 AAC002172

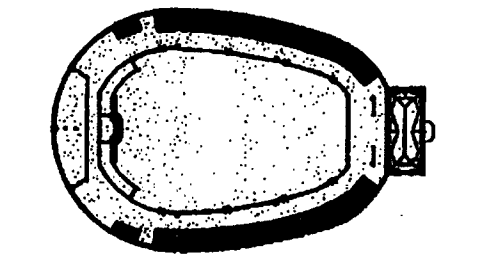


CUSCADEN POOL RENOVATION

CITY OF TAMPA
 305 East Jackson Street
 Tampa, Florida 33602


Project No.	0202.00
Distribution	Date
BID DOCUMENTS	02.02.04

ENLARGED PLANS
RECORD DWG.
 DATE 8/26/05

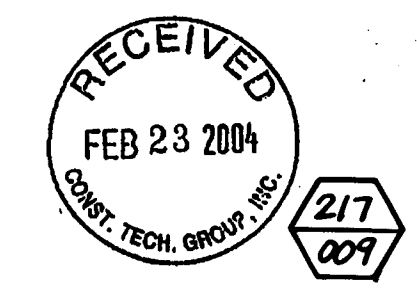


A501

2/7 009

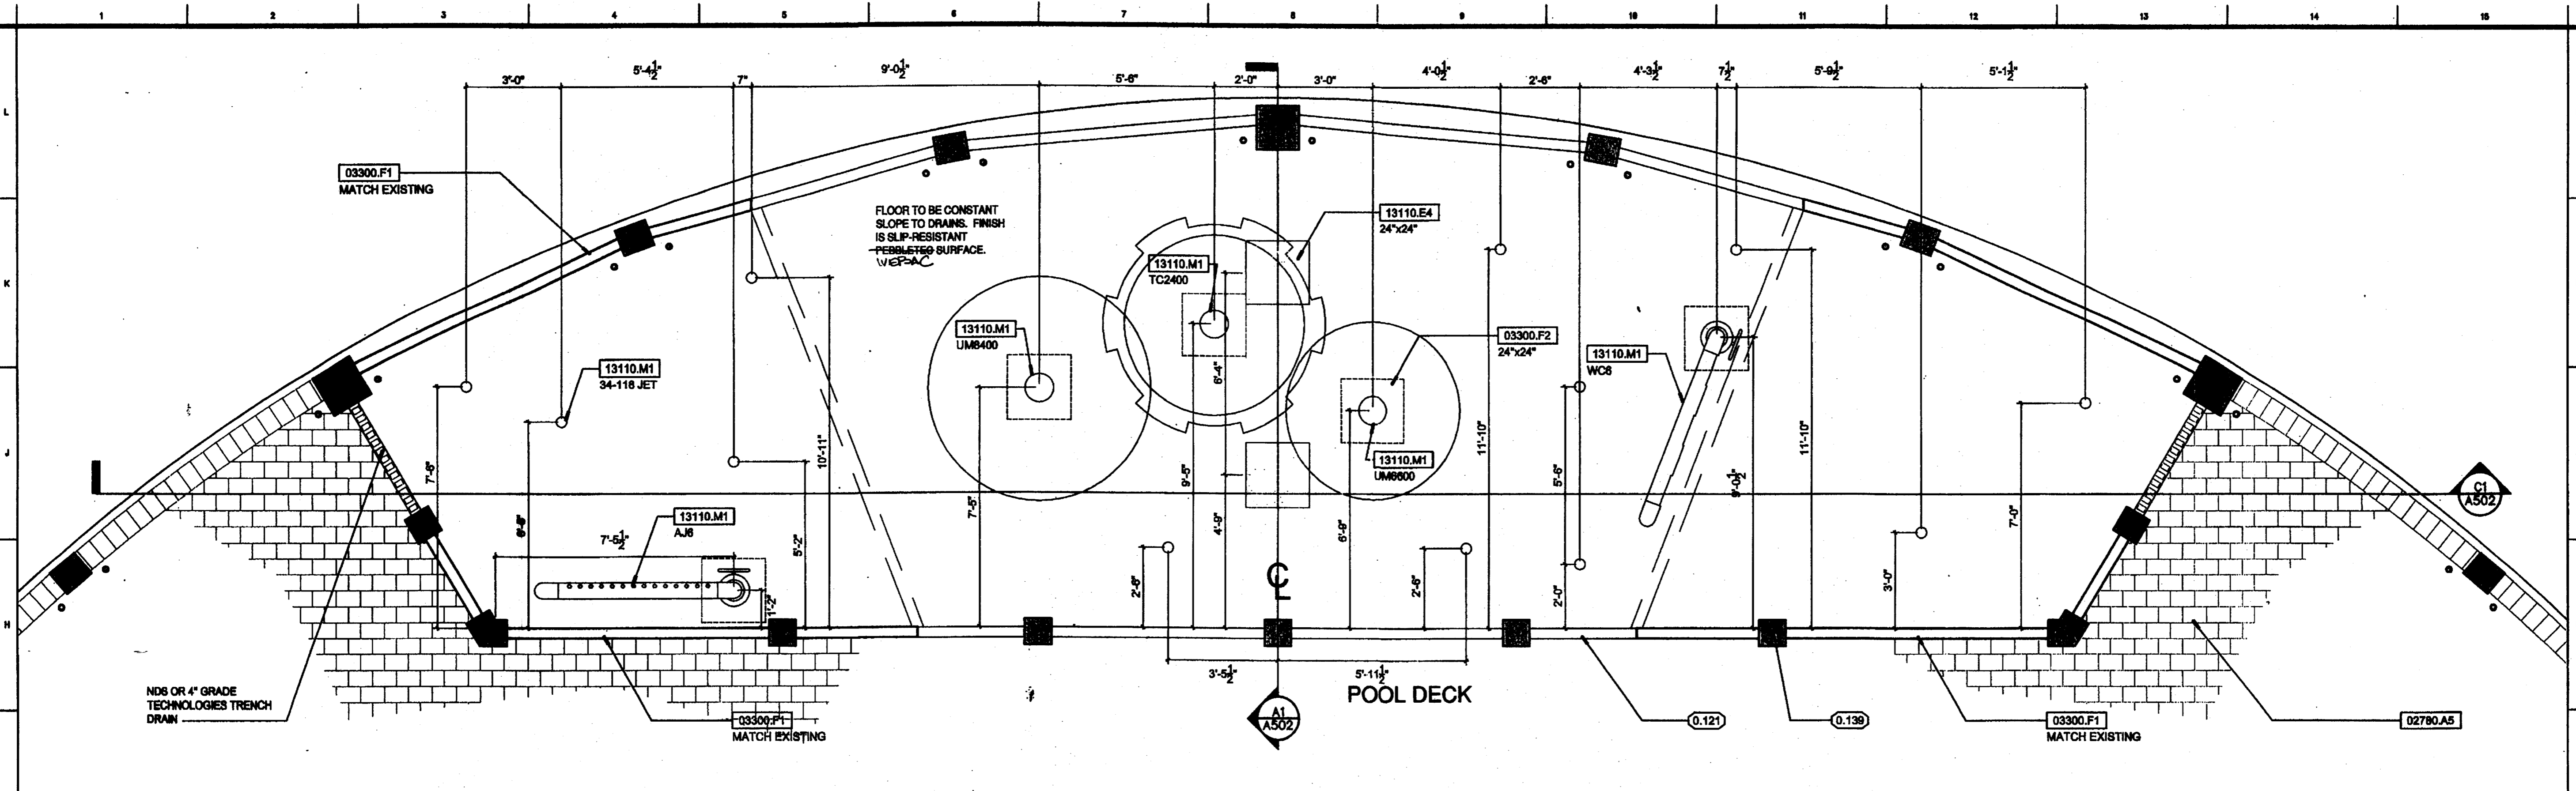


G1 ENLARGED SPLASH PAD PLAN

3/8" = 1'-0"

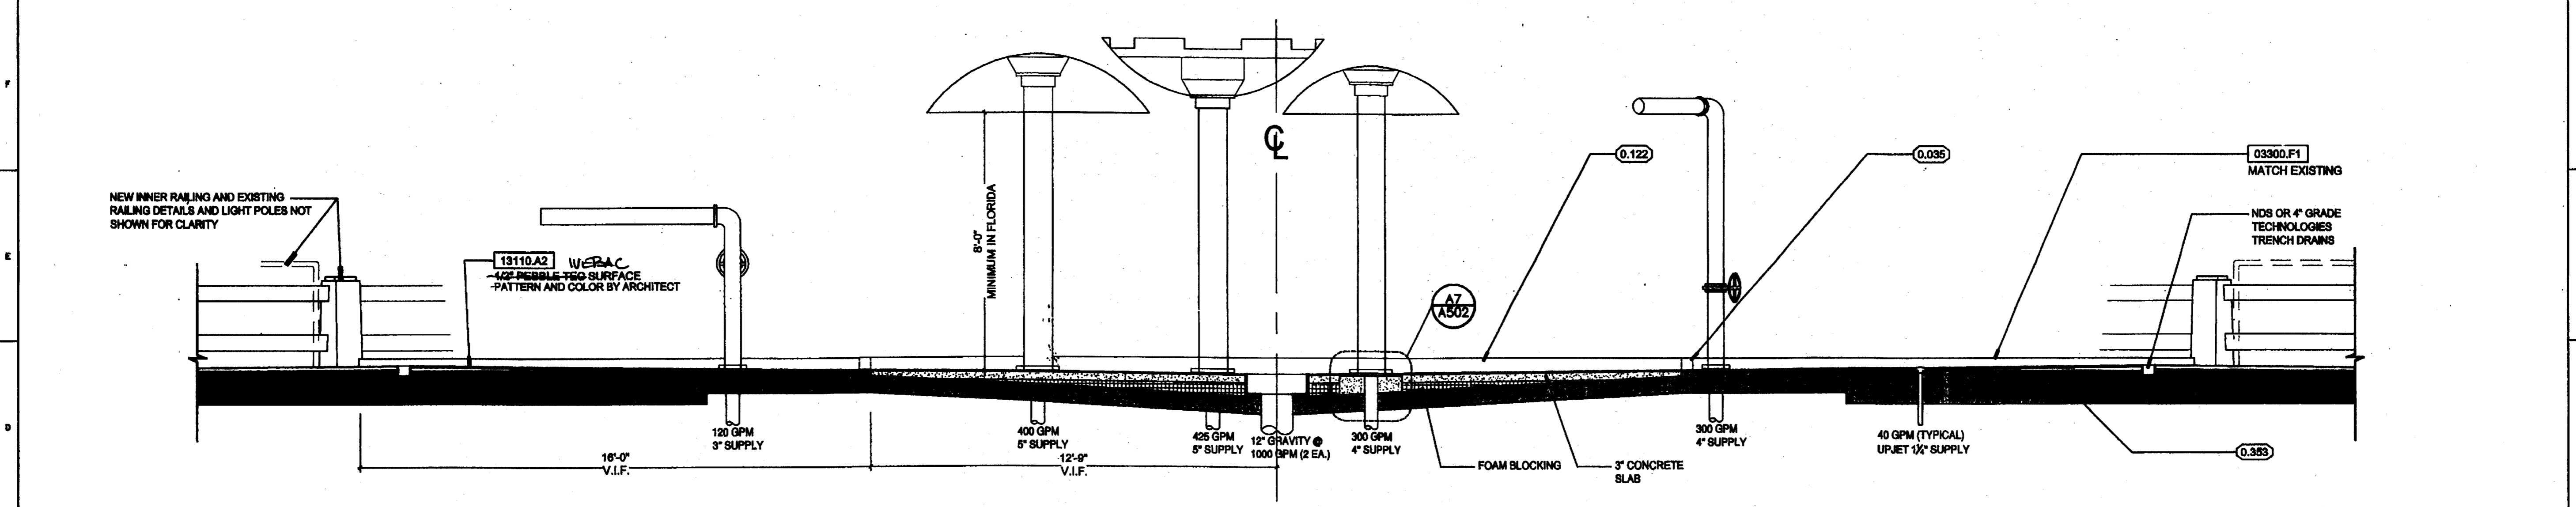


C1 SPLASH PAD SECTION

3/8" = 1'-0"

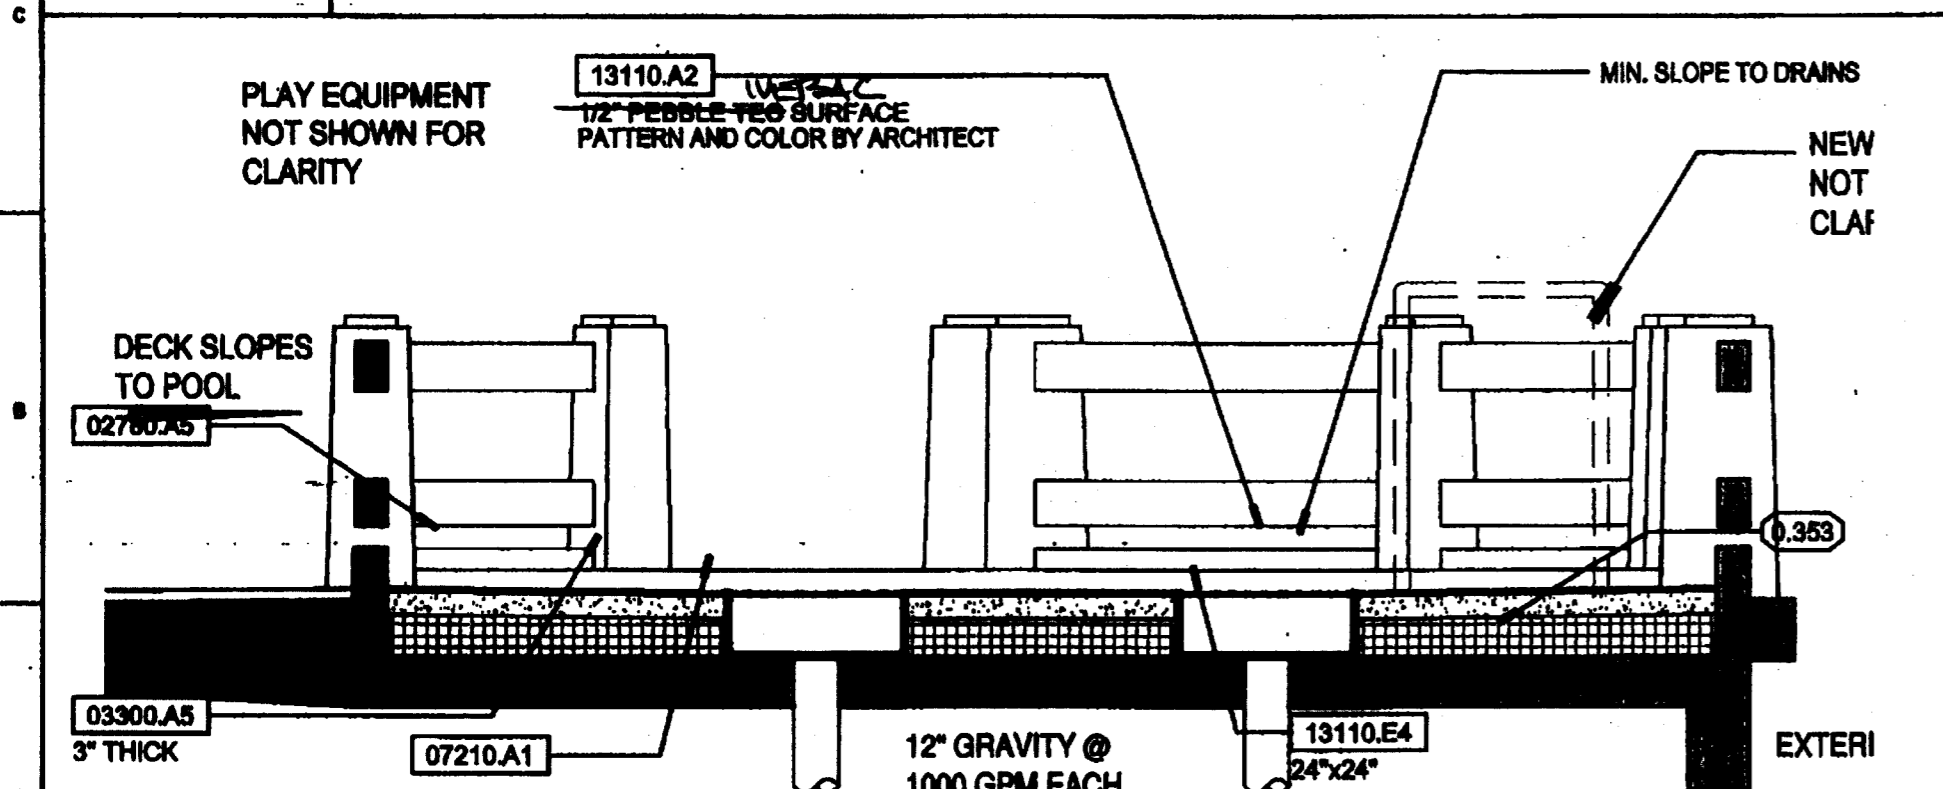

A1 SPLASH PAD SECTION

3/8" = 1'-0"

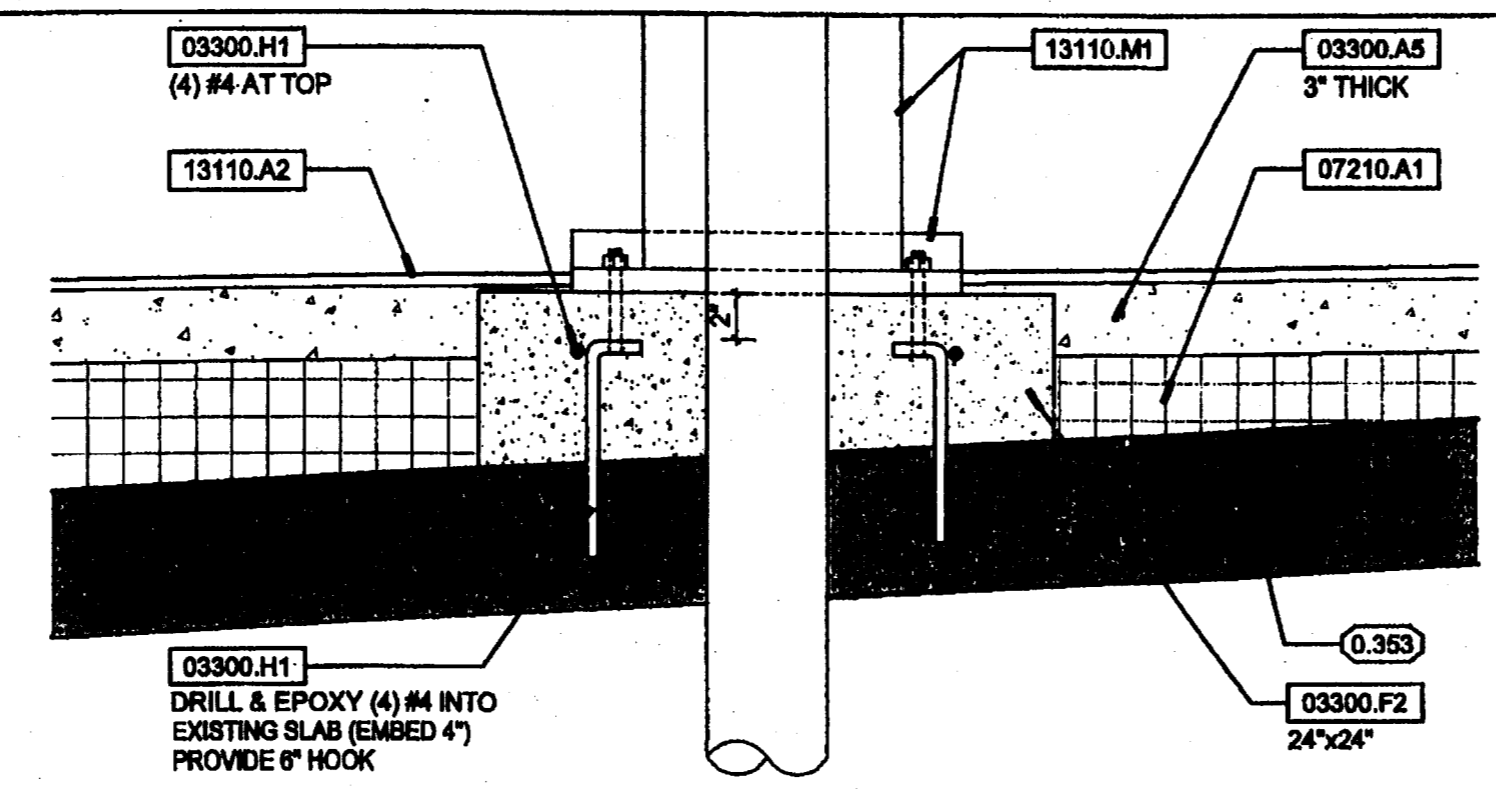

A7 EQUIPMENT PAD DETAIL

1 1/2" = 1'-0"

EQUIPMENT LIST & DEMANDS


1 EA. TC2400	TEECUP	425 GPM
1 EA. UM8600	UMBRELLA (SMALL)	300 GPM
1 EA. UM8400	UMBRELLA	400 GPM
1 EA. WC6	WATER CURTAIN	300 GPM
1 EA. AJ6	ARCH JET	120 GPM
12 EA. 34-118	RECREONICS JET	40 GPM (8 ONLY SIMULTANEOUSLY)
TOTAL WATER DEMAND		1865 GPM
7% EXCESS CAPACITY INCLUDED		2000 GALS AVAILABLE SUPPLY

KEYNOTES

02780	UNIT PAVERS
02780.A5	Concrete Pavers
03300	CAST-IN-PLACE CONCRETE
03300.A5	Concrete Slab
03300.F1	Concrete Curb
03300.F2	Concrete Equipment Base
03300.H1	Reinforcing Bars
07210	BUILDING INSULATION
07210.A1	Extruded Polystyrene Board Insulation
13110	SWIMMING POOLS
13110.A2	Pool Interior Finish
13110.E4	Main Drain Box
13110.M1	Splash Pad Water Feature
GENERAL NOTES	
0.000	DEMOLITION
0.035	remove existing curb to slab level
0.121	existing curbing, sandblast and epoxy coat, paint to match new top of existing concrete curb
0.122	existing balusters to remain
0.139	existing concrete structure to remain
0.353	existing concrete structure to remain

A14 KEYNOTES

NO SCALE

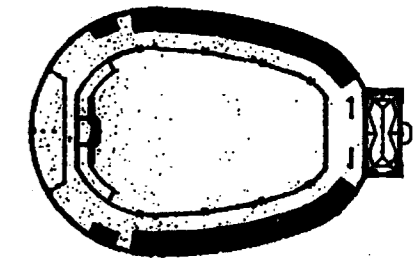

CUSCADEN POOL RENOVATION

CITY OF TAMPA
308 East Jackson Street
Tampa, Florida 33602

Project No. 0202.00

Distribution	Date
BID DOCUMENTS	02.02.04

ENLARGED SPLASH PAD PLAN, SECTIONS, AND DETAILS

RECORD DWG.
DATE 8/26/05




WATER FEATURES

MAIN DRAIN	2 EA 24" X 24" AND
DRAINS TO COLLECTOR TANK 2 EA.	12"
COL TANK TO PUMPS 2 EA.	10"
WATER FEATURES PUMPS	2 EA. 15 HP
TURNOVER RATE FOR FEATURES	1065 GPM
SUPPLY LINES TO FEATURES EACH FEATURE INDIVIDUALLY VALVED AT THE EQUIPMENT ROOM. SUPPLY PIPING NOT TO EXCEED 8' PER SECOND VELOCITY.	

Silcox Engineering, Inc. Civil Engineering
ERNEST S. SILCOX P.E. #0006161
Post Office Box 8574
Tampa, FL 33674 813/920-9192

11-4-04
08.05.04

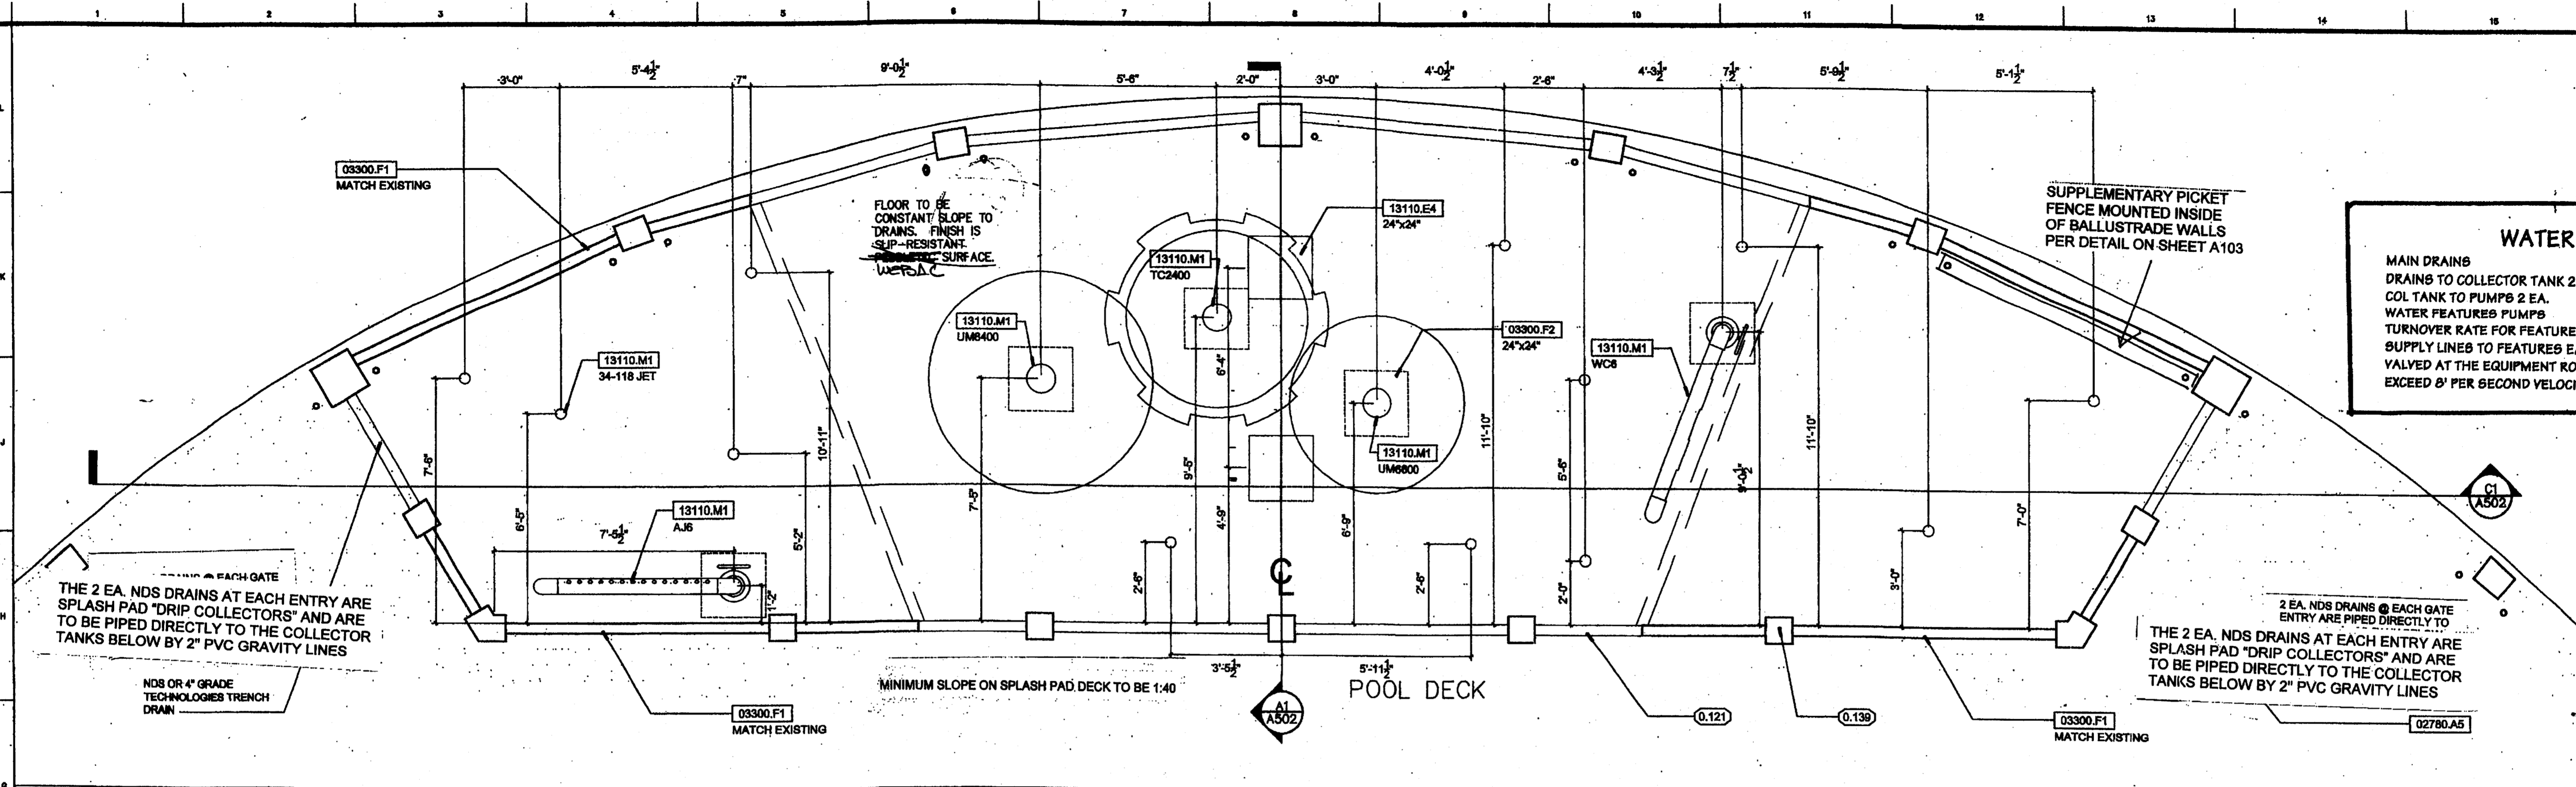


G1 ENLARGED SPLASH PAD PLAN

3/8" = 1'-0"

SPLASH PAD DATA

PERIMETER SURFACE AREA	PROX. 137
COLLECTOR TANK CAPACITIES 2 @ 1000	PROX. 705 SQ. FT.
TURNOVER RATE	2,000 GAL.
TURNOVER TIME	67 GPM
FILTER	30 MIN.
FILTER RATE	30" HI-RATE SAND
CIRCULATING PUMP	13.7 GPM PLR SQ.FT. FILT. AREA
HYPOCHLORINATION	2 HP
PH CONTROL	STRANTRON SYSTEM 5
	CO ₂

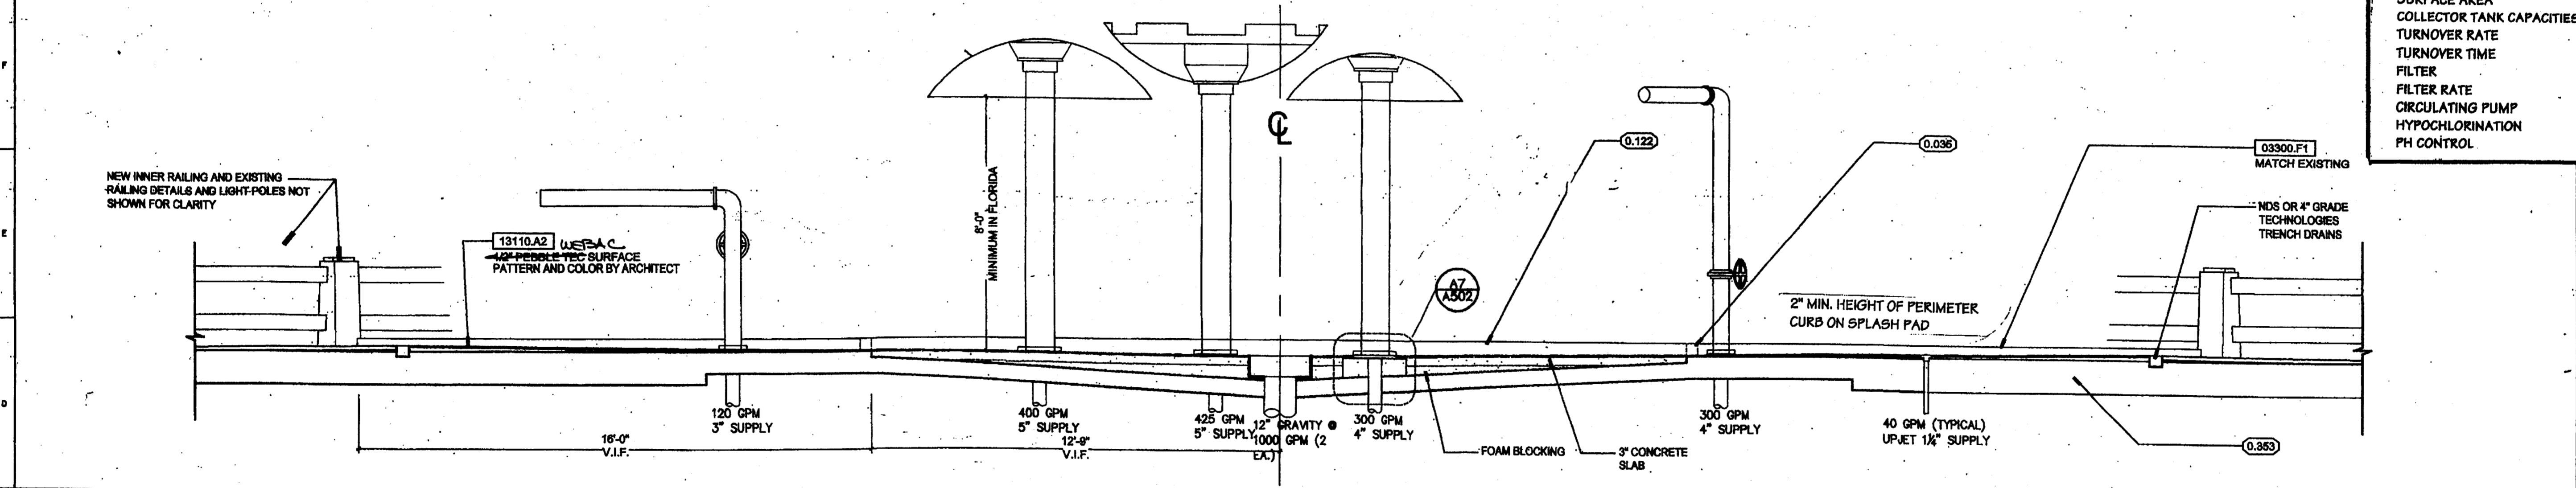

C1 SPLASH PAD SECTION

3/8" = 1'-0"

EQUIPMENT LIST & DEMANDS

1 EA. TC2400	TEECUP	425 GPM
1 EA. UMB8000	UMBRELLA (SMALL)	300 GPM
1 EA. UMB400	UMBRELLA	400 GPM
1 EA. WC6	WATER CURTAIN	300 GPM
1 EA. AJ6	ARCH JET	120 GPM
12 EA. 34-118	RECREONICS JET	40 GPM (8 ONLY SIMULTANEOUSLY)

TOTAL WATER DEMAND 1865 GPM
7% EXCESS CAPACITY INCLUDED 2000 GALS AVAILABLE SUPPLY


SPLASH PAD LAYOUT AND SECTIONS SHOWING WATER FEATURES

KEYNOTES

02780.A5	UNIT PAVERS
03300	Concrete Pavers
03300.A5	CAST-IN-PLACE CONCRETE
03300.F1	Concrete Slab
03300.F2	Concrete Curb
03300.H1	Concrete Equipment Base
07210	Reinforcing Bars
07210.A1	BUILDING INSULATION
13110	Extruded Polyethylene Board Insulation
13110.E2	SWIMMING POOLS
13110.E4	Pool Interior Finish WEPAAC
13110.M1	Main Drain Box
13110.M1	Splash Pad Water Feature


GENERAL NOTES

0.000	DEMOLITION
0.035	remove existing curb to slab level
0.121	existing curbing, sandblast and epoxy coat, paint to match new top of existing concrete curb
0.122	existing ballustrade to remain
0.139	existing ballustrade to remain
0.363	existing concrete structure to remain

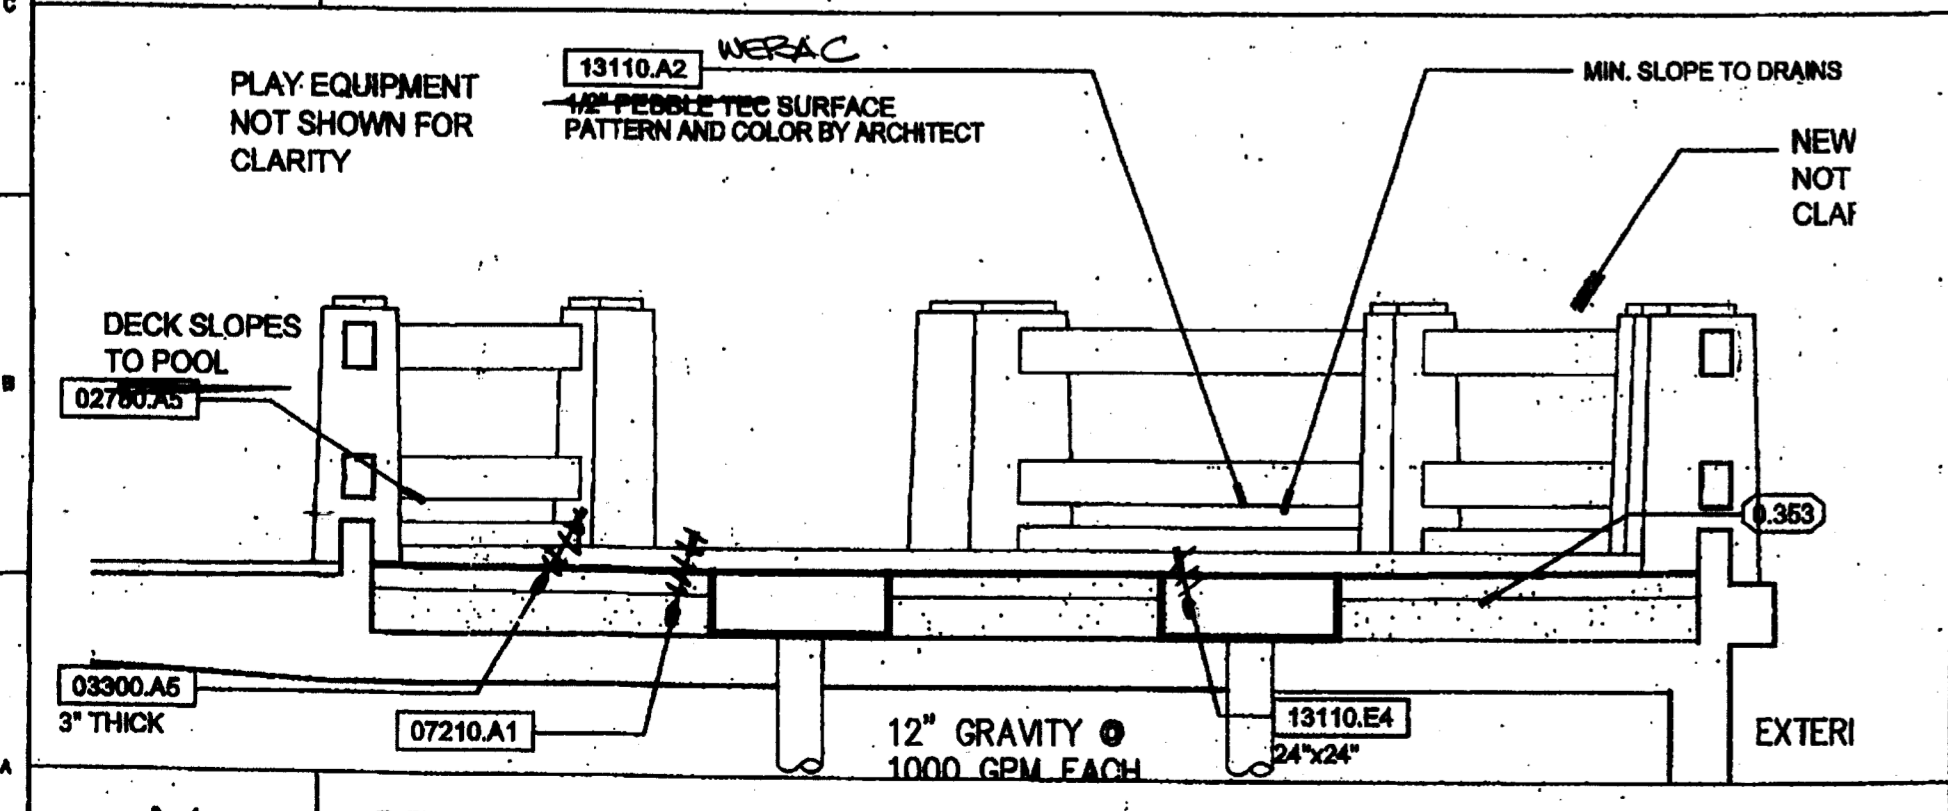

A1 SPLASH PAD SECTION

3/8" = 1'-0"

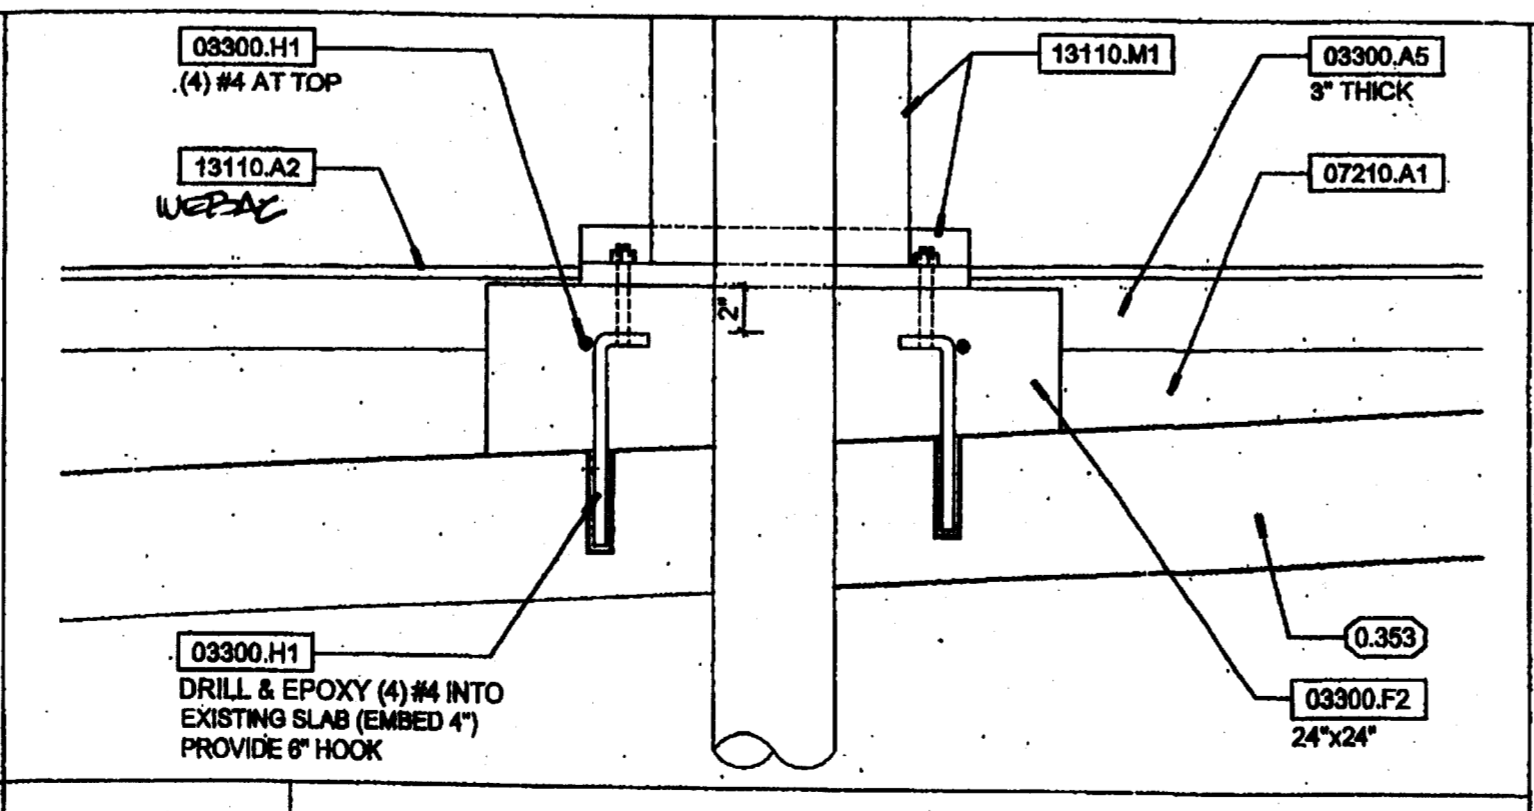

A7 EQUIPMENT PAD DETAIL

1 1/2" = 1'-0"

A14 KEYNOTES

NO SCALE

CUSCADEN POOL RENOVATION

CITY OF TAMPA
306 East Jackson Street
Tampa, Florida 33602

Project No. 0202.00


Distribution	Date
BID DOCUMENTS	02.02.04
DOH PERMIT SUBMITTAL	07.12.04

ENLARGED SPLASH PAD PLAN, SECTIONS, AND DETAILS


RECORD DWG.
DATE 8/22/05

A502



217
009

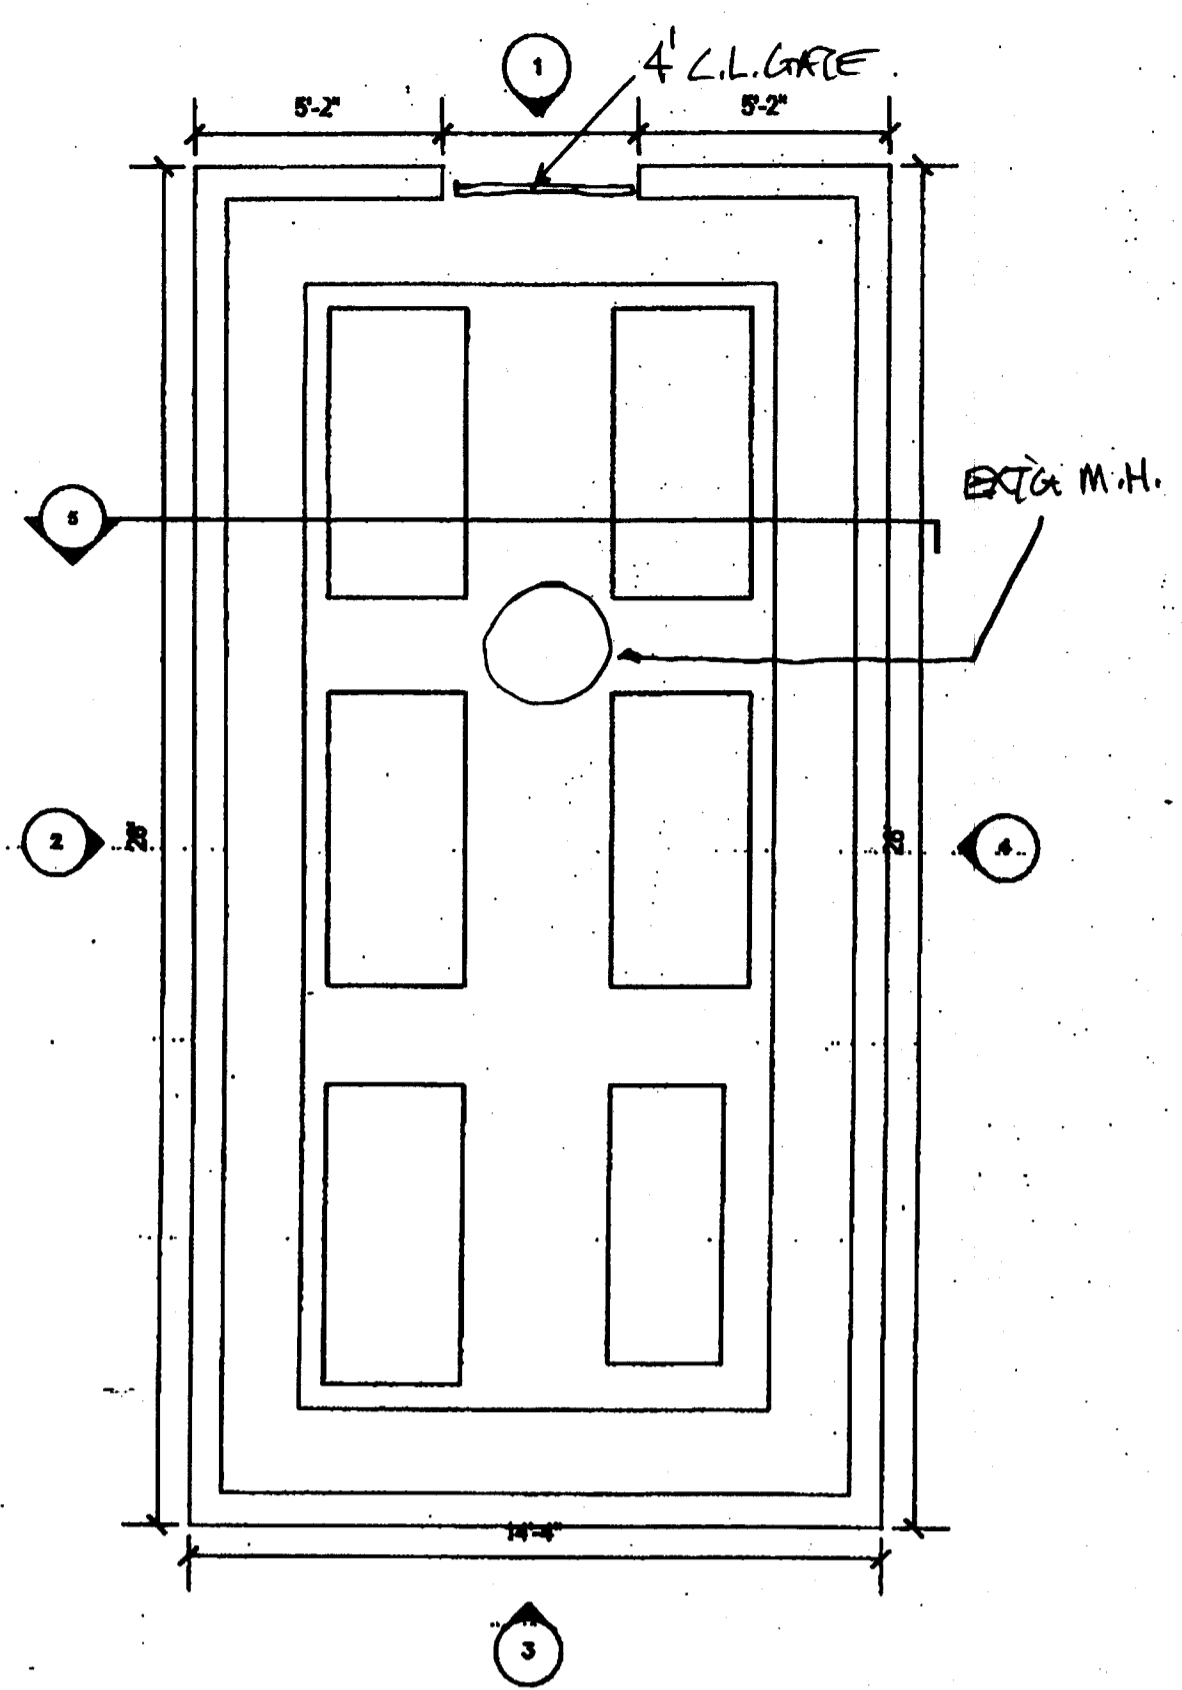

G1 HEATER FLOOR PLAN
1/4" = 1'-0"

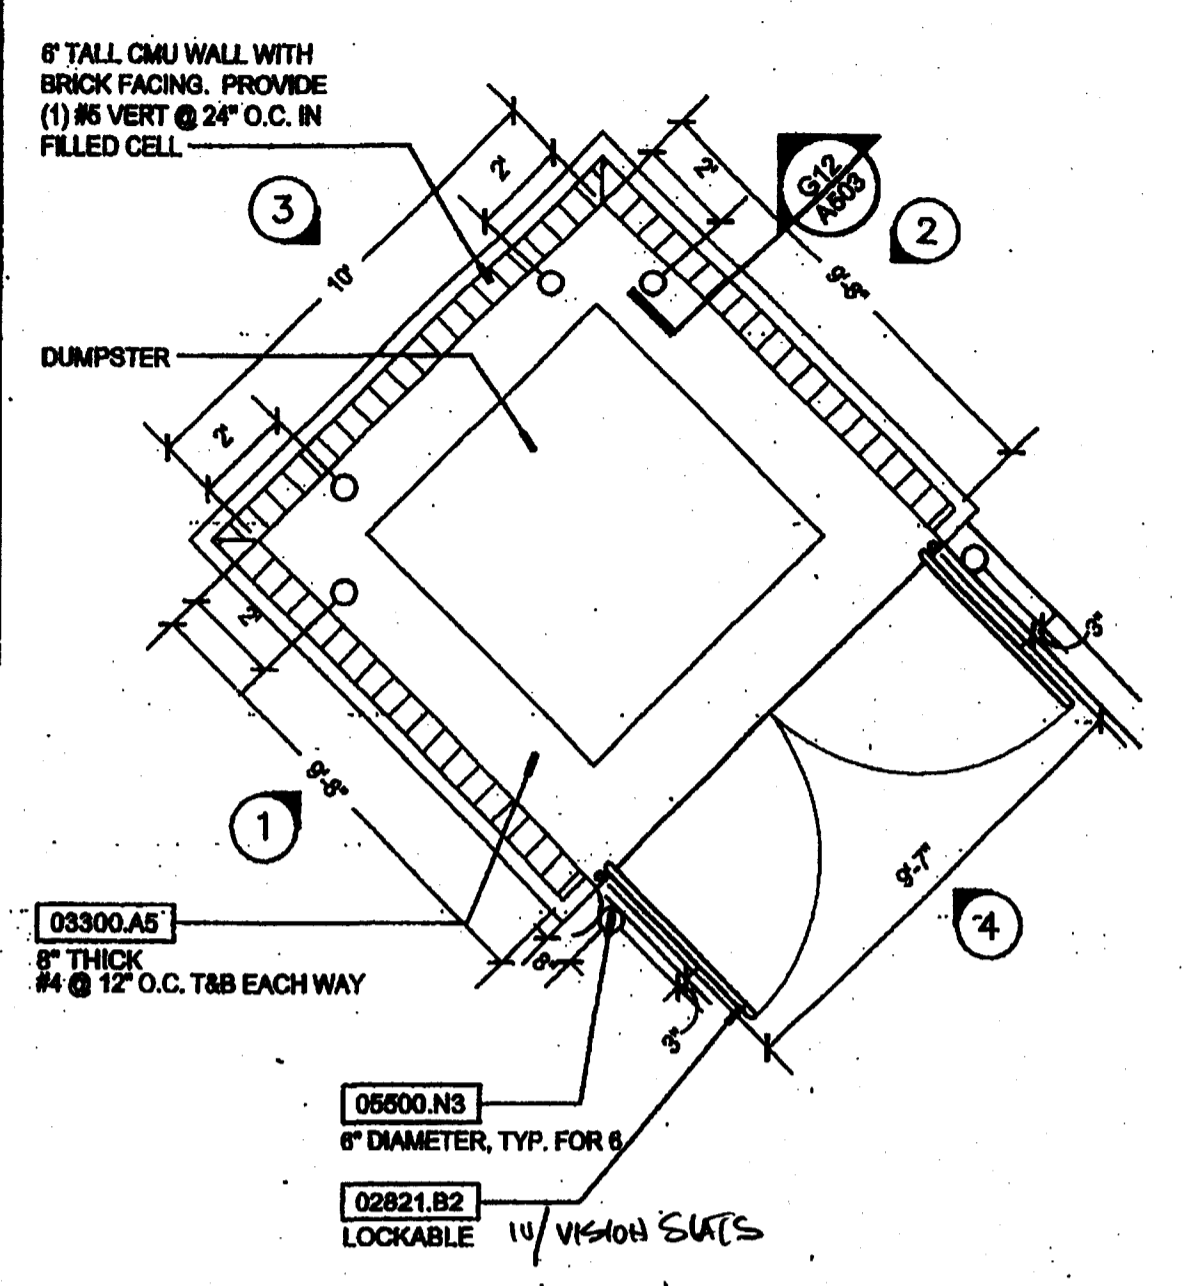




G4 DUMPSTER ENCLOSURE DETAILS
1/4" = 1'-0"

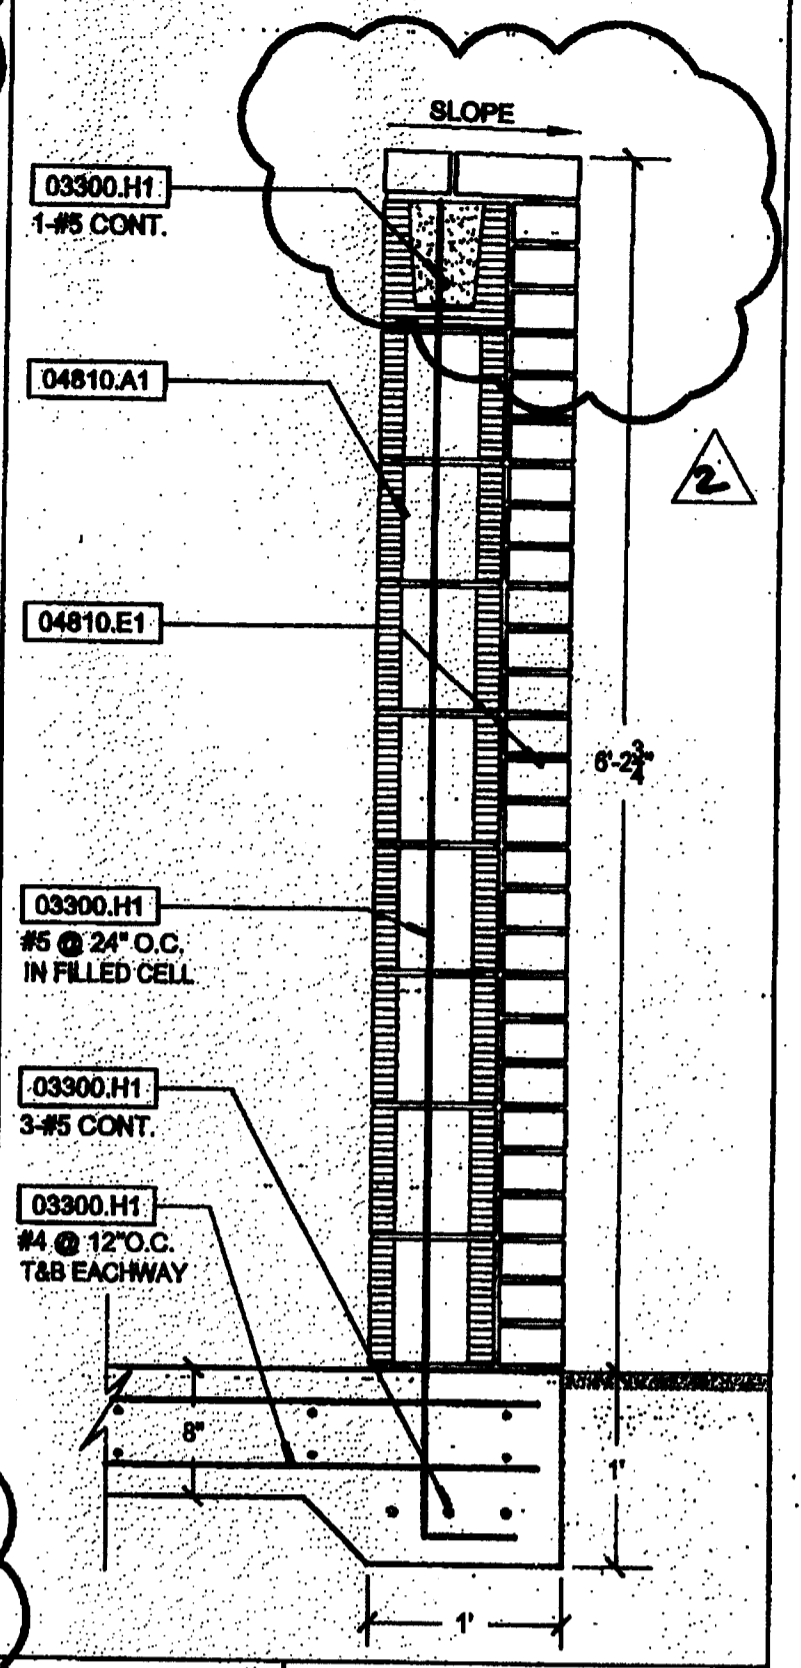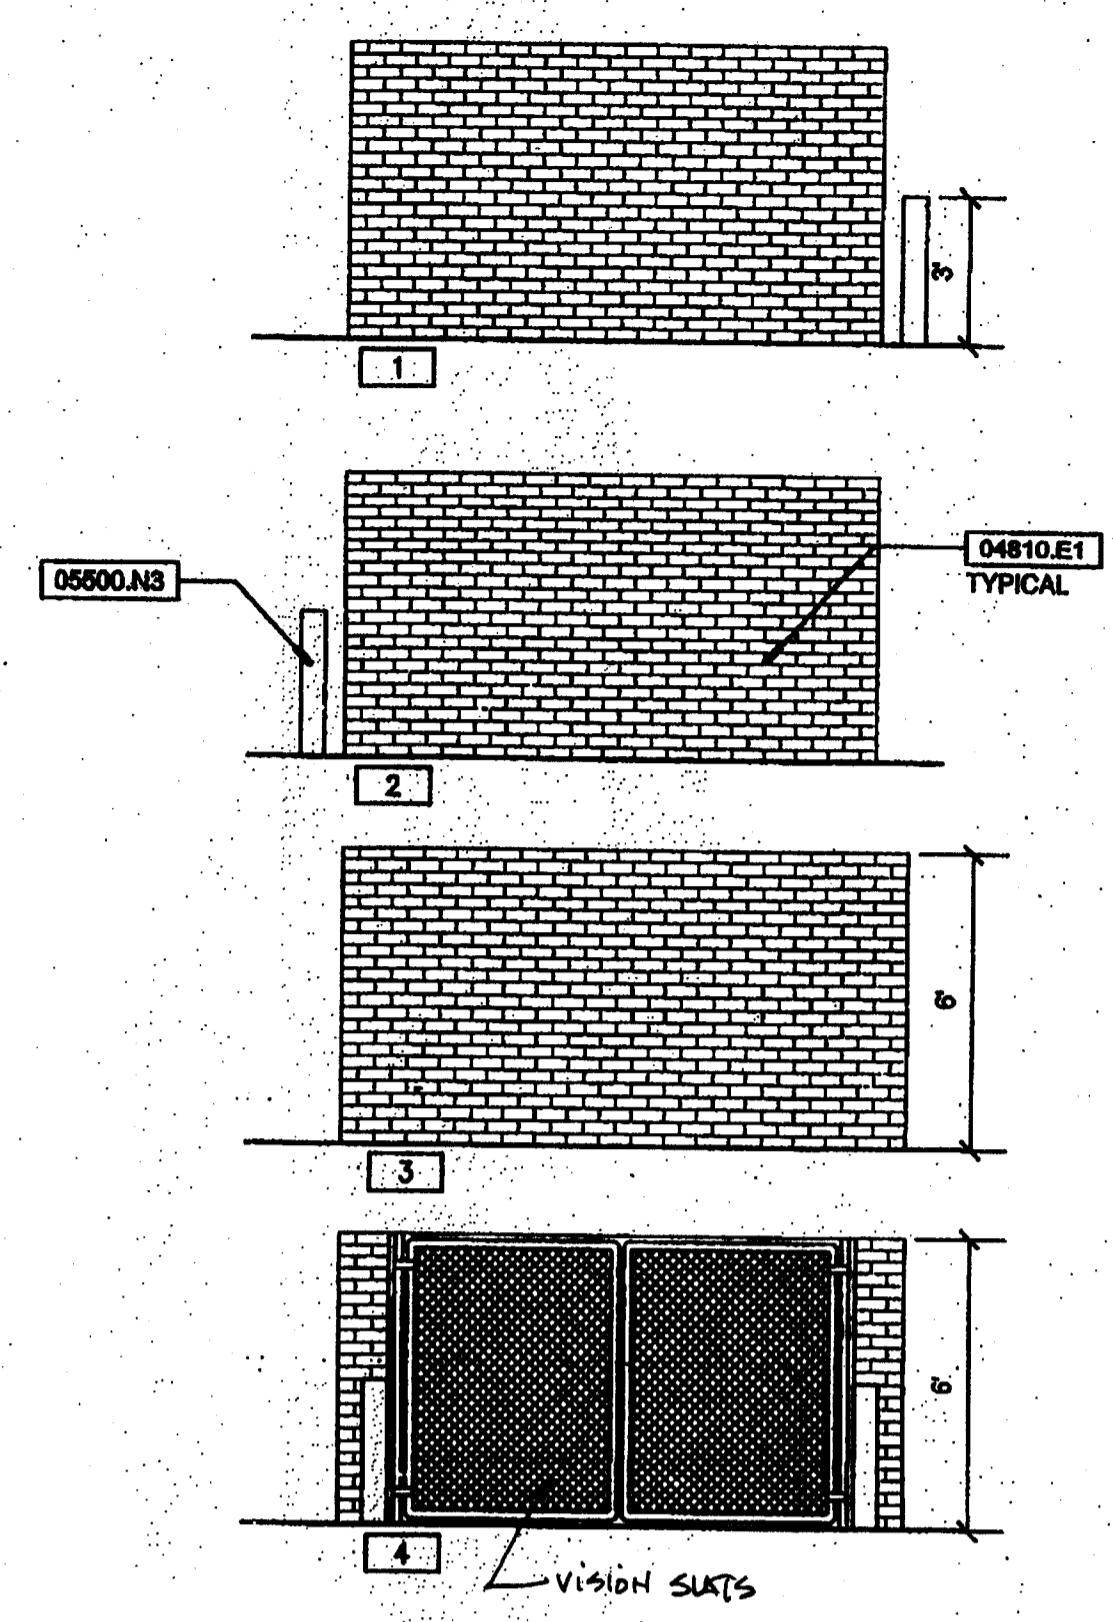



G12 WALL SECTION
1" = 1'-0"

- KEYNOTES**
- 02821 CHAIN-LINK FENCES AND GATES
 - 02821.B2 Double Swing Gate
 - 03300 CAST-IN-PLACE CONCRETE
 - 03300.A5 Concrete Slab
 - 03300.D1 Concrete Footing
 - 03300.E2 Concrete Wall
 - 03300.H1 Reinforcing Bars
 - 04810 UNIT MASONRY ASSEMBLIES
 - 04810.A1 Concrete Masonry Unit
 - 04810.E1 Face Brick
 - 05500 METAL FABRICATIONS
 - 05500.N3 Pipe Bolts



ROWE ARCHITECTS
INCORPORATED
100 Madison Street, Suite 200
Tampa, Florida 33602.4704
www.RoweArchitects.com
Fax: 813.221.8154
813.221.8771
AAC002172

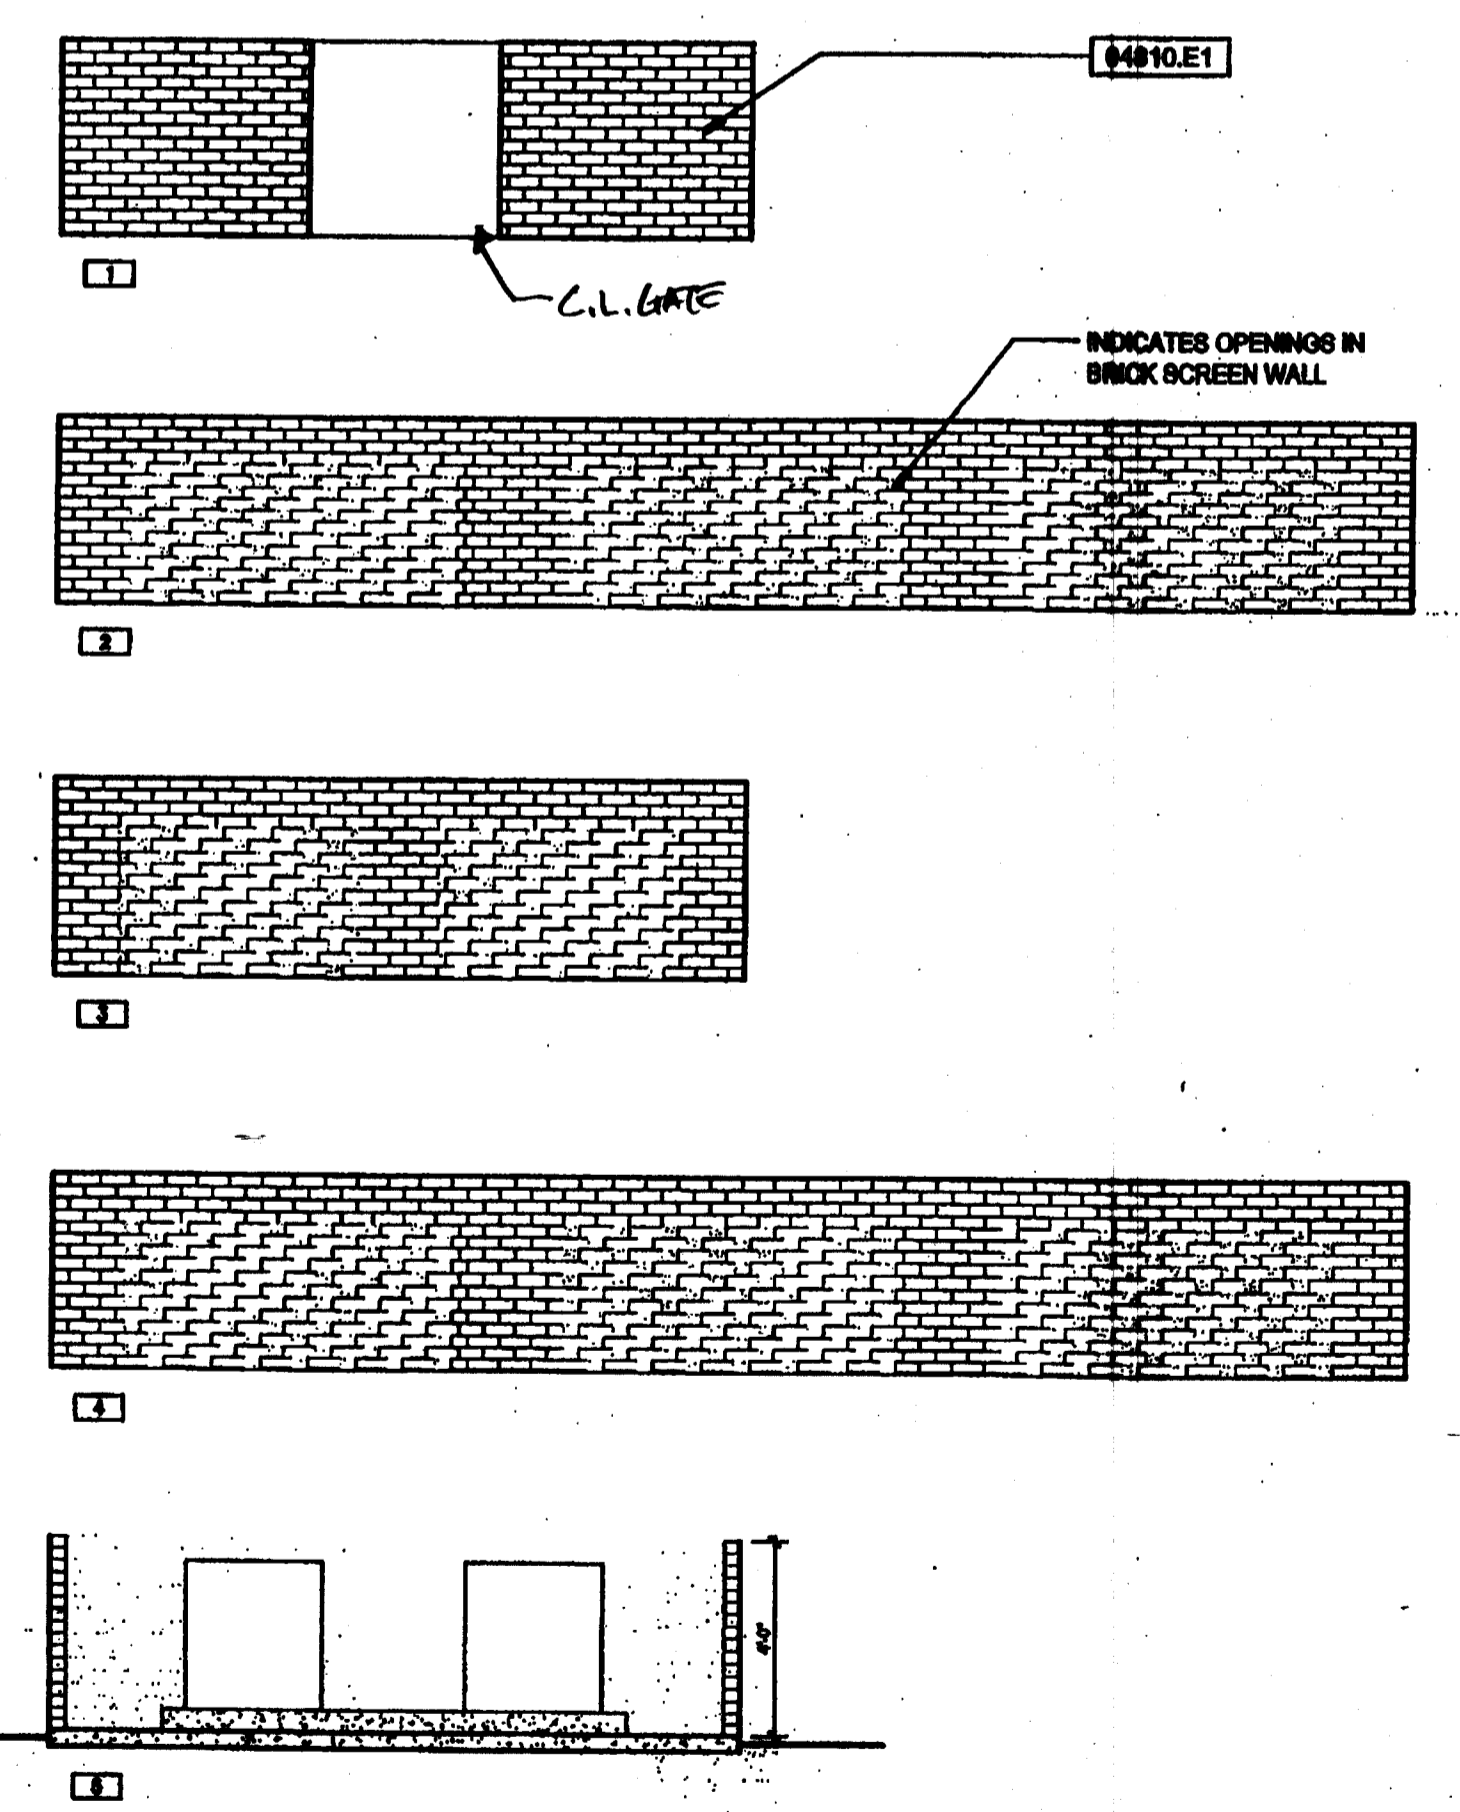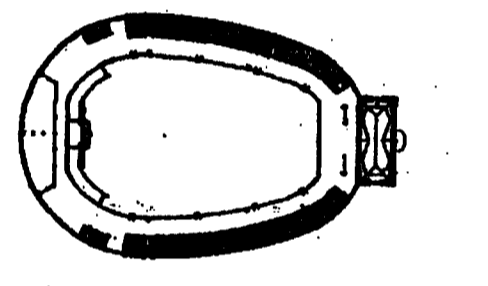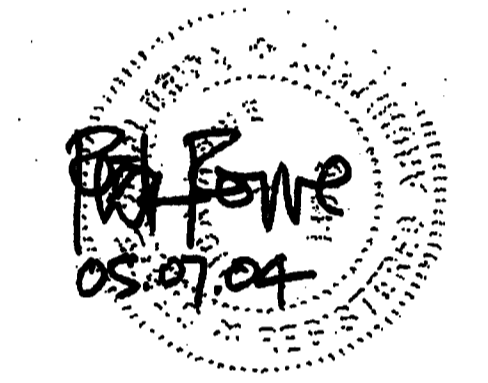

A1 EQUIPMENT
1/4" = 1'-0"

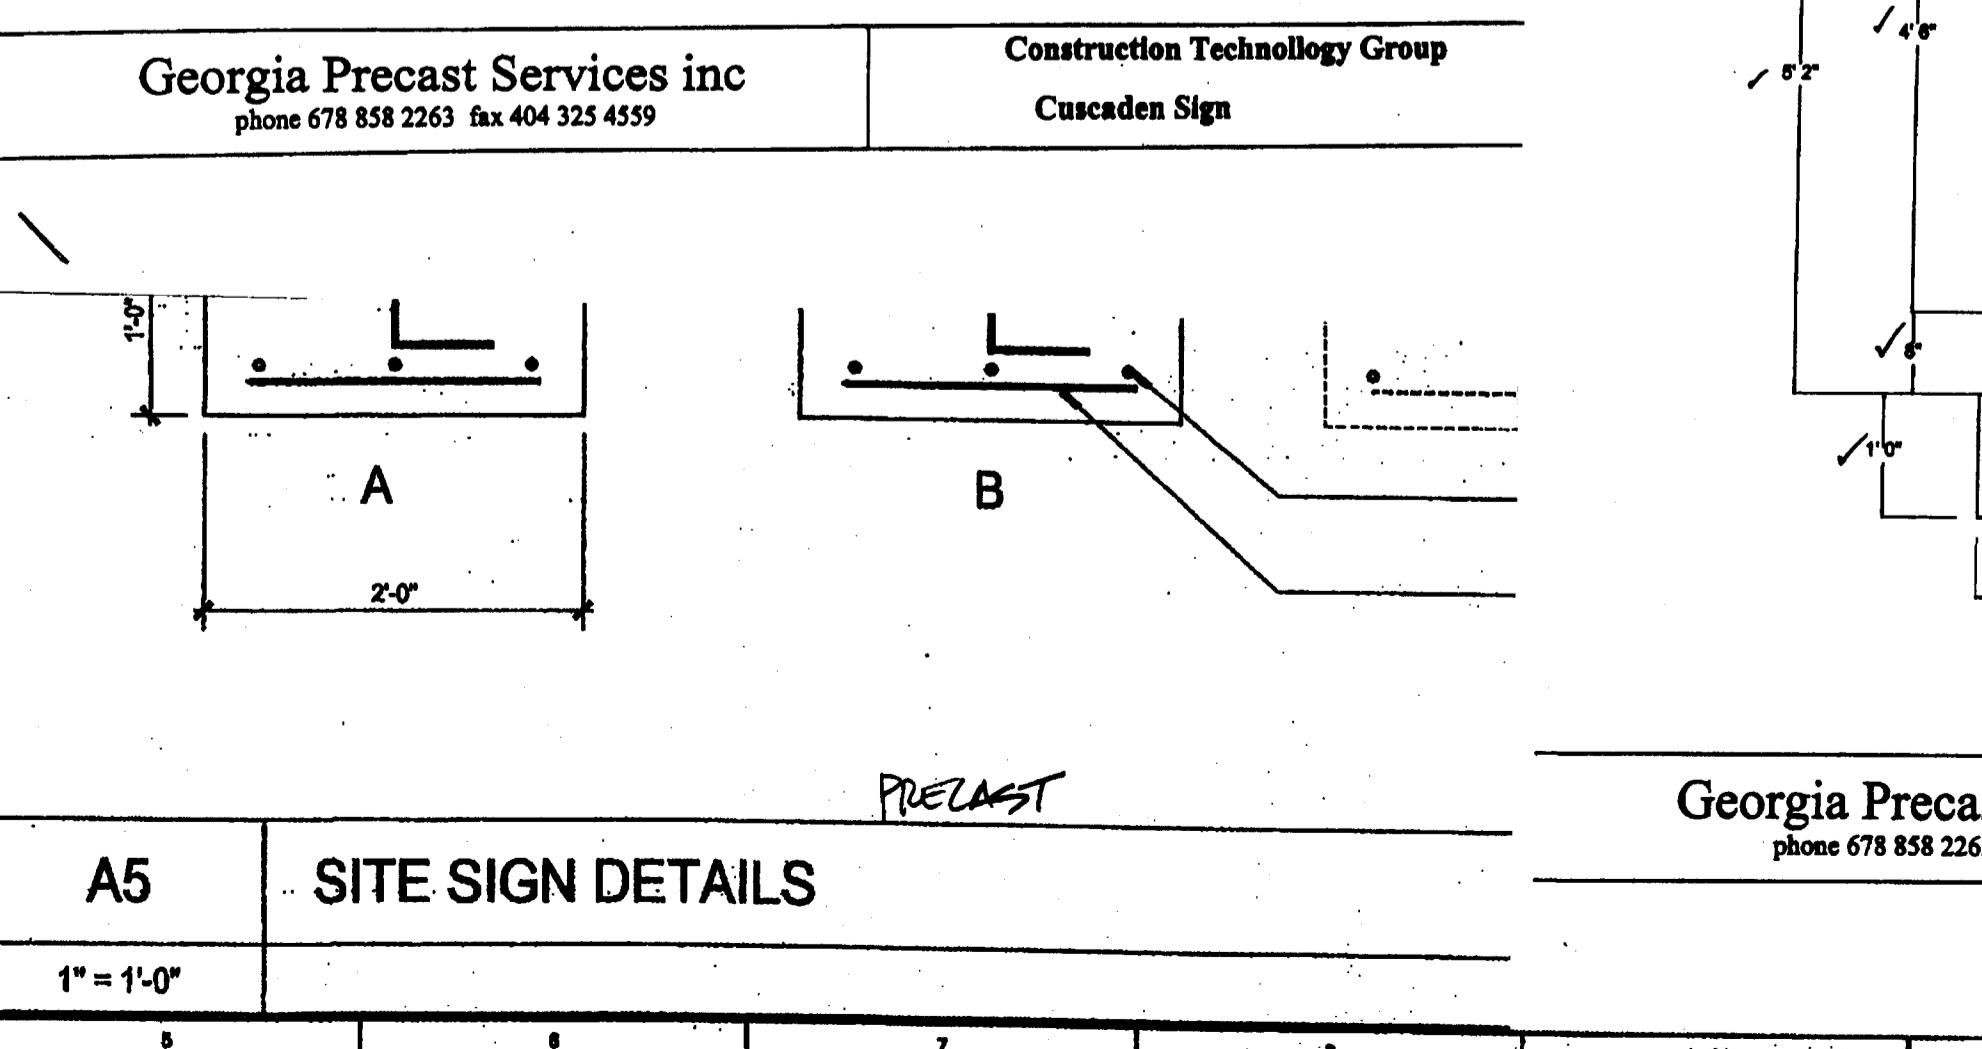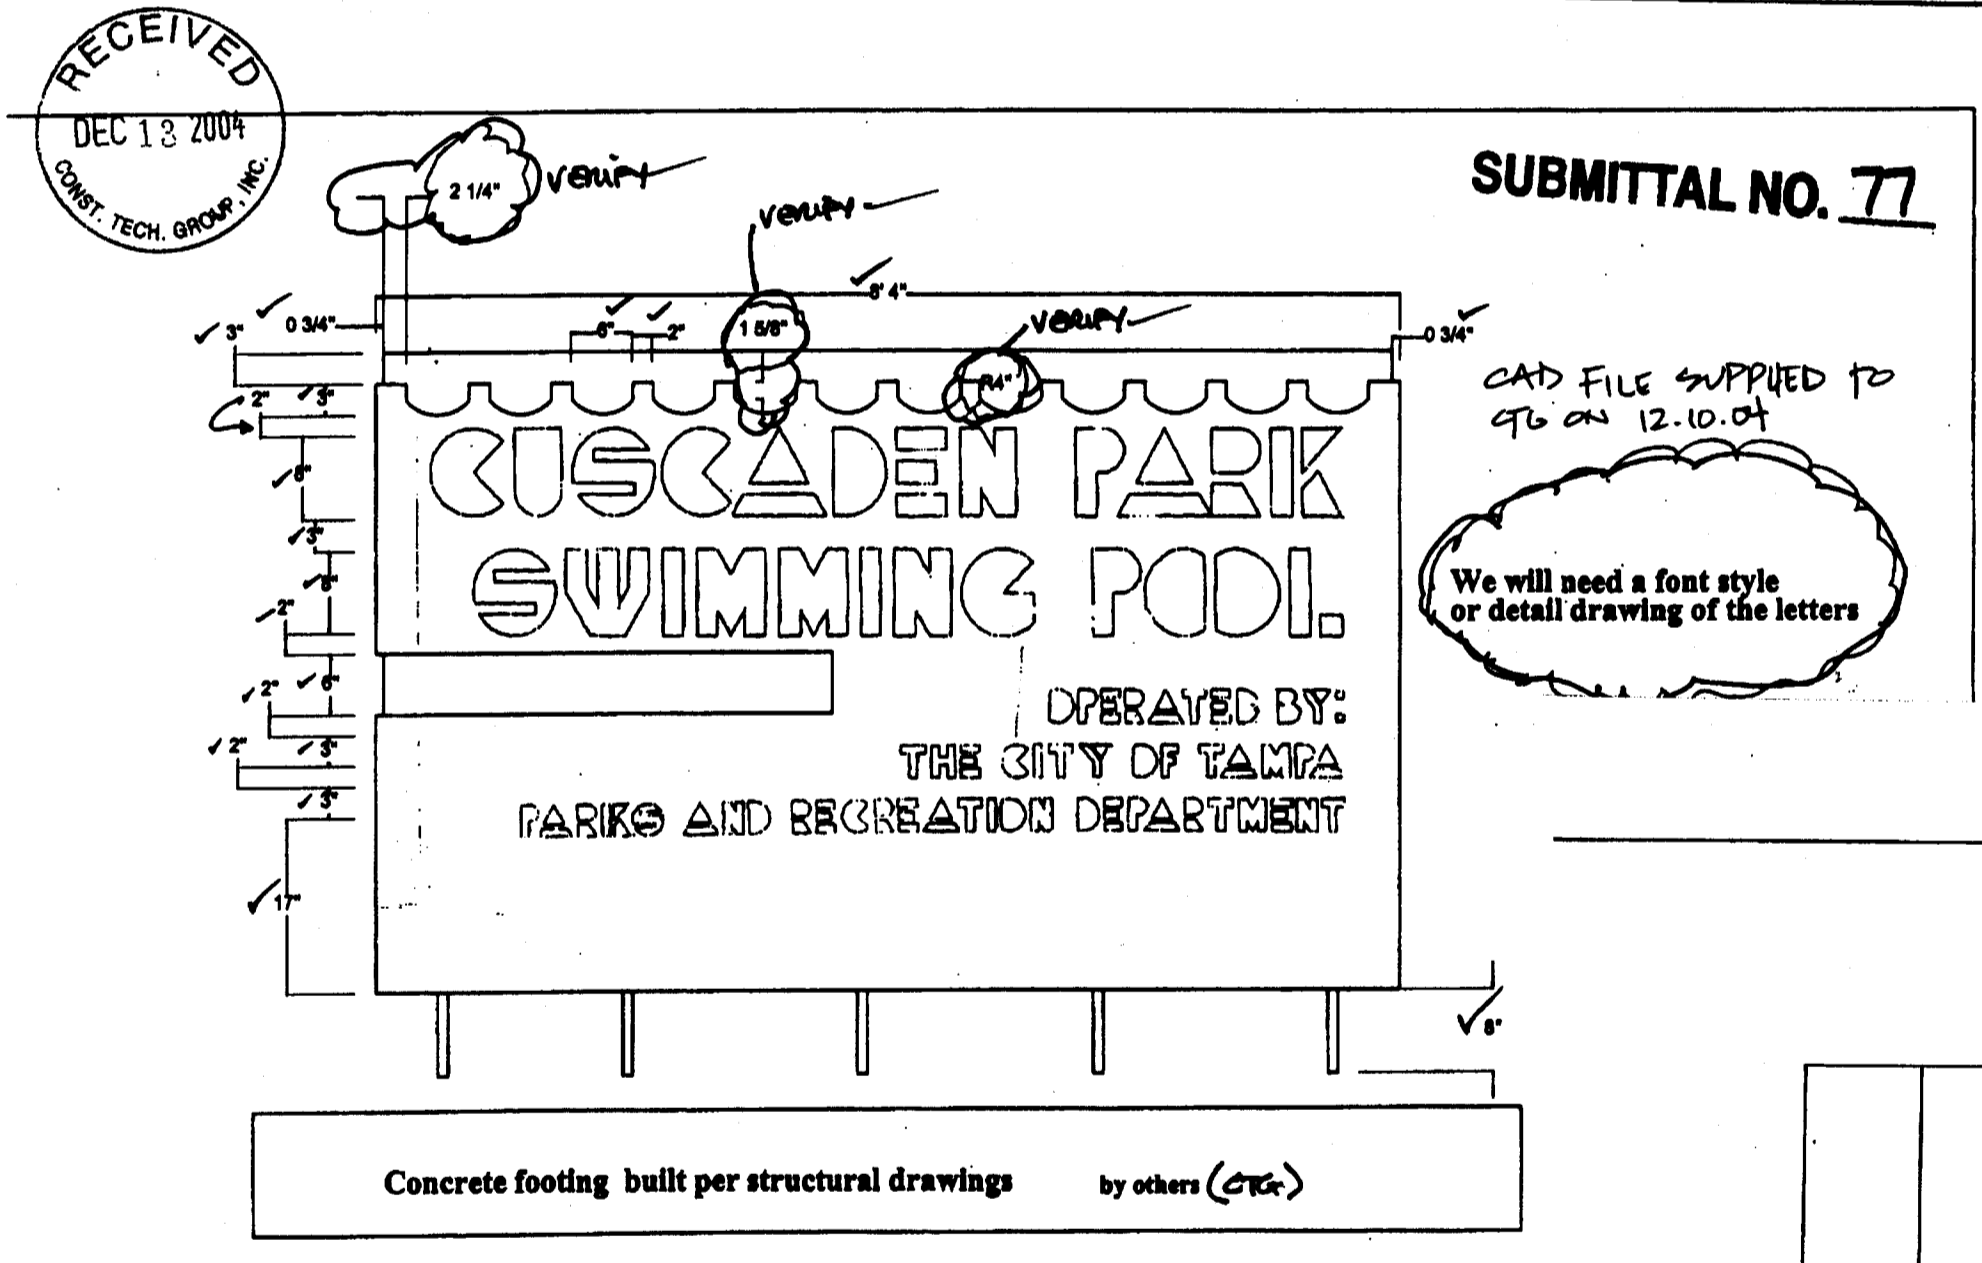

A5 SITE SIGN DETAILS
1" = 1'-0"

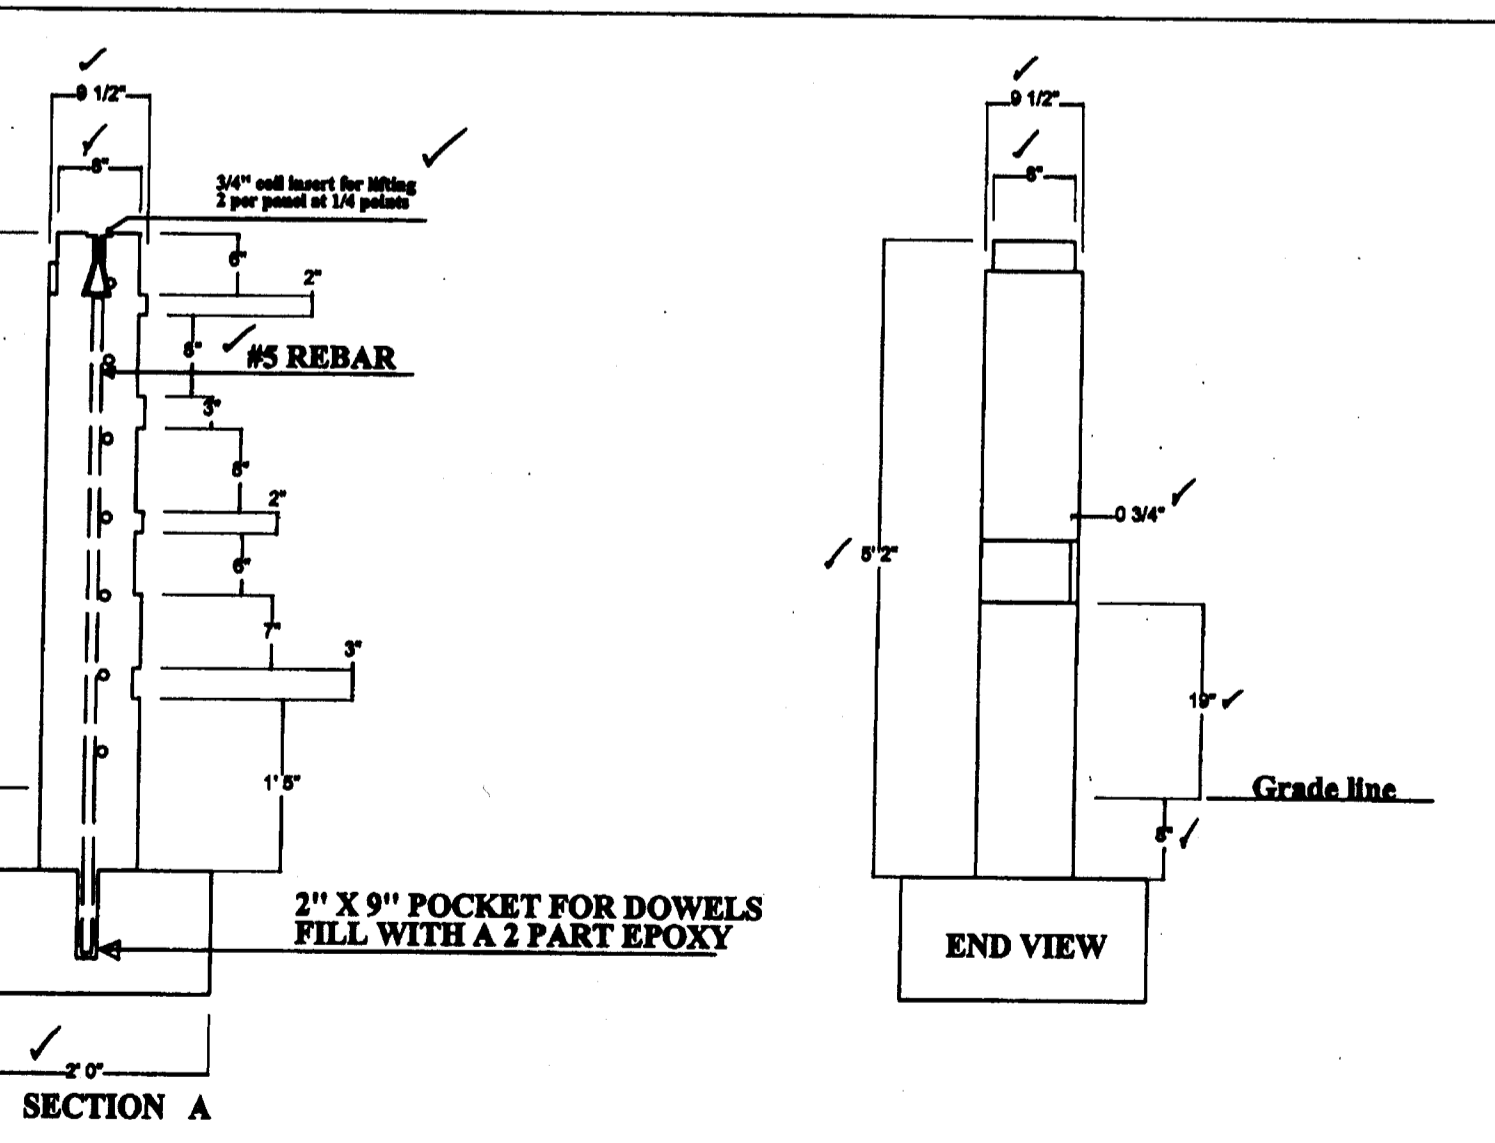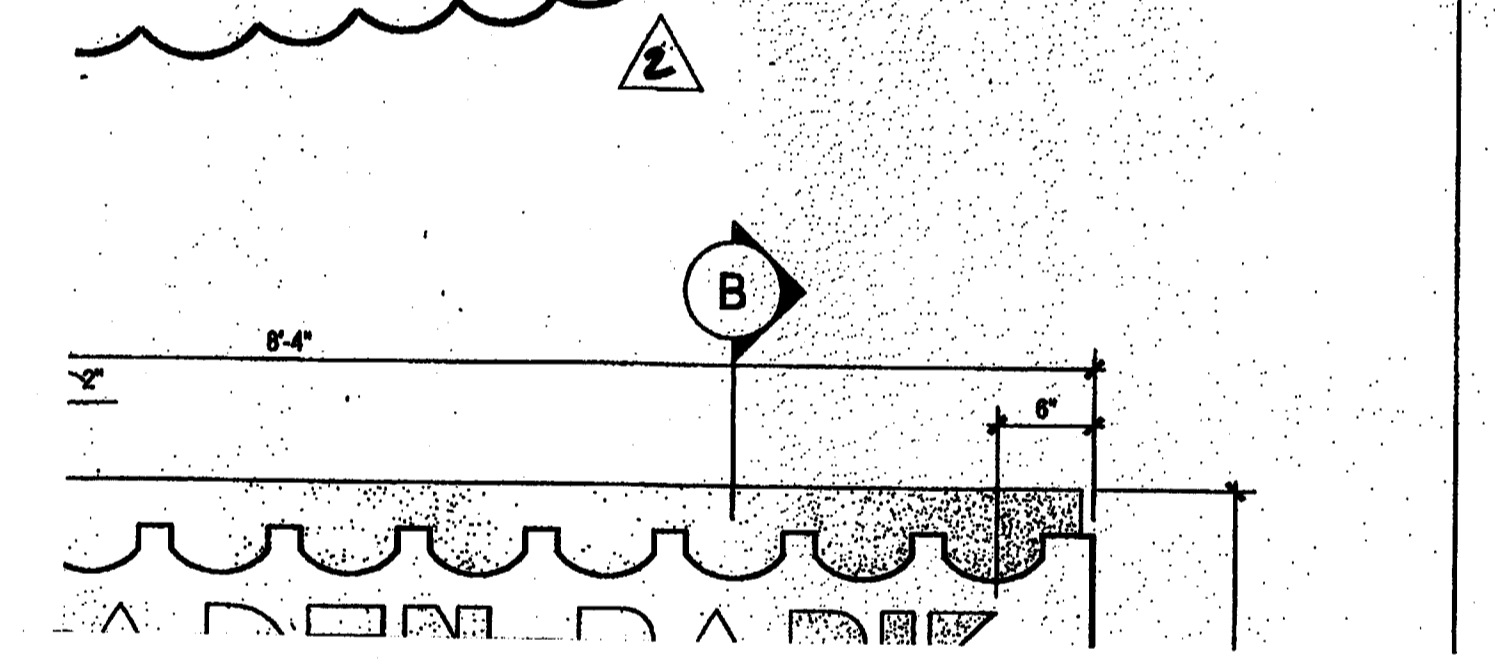

S3

CUSCADEN POOL RENOVATION


CITY OF TAMPA
306 East Jackson Street
Tampa, Florida 33602

Project No.0202.00	
Distribution	Date
BID DOCUMENTS	02.02.04
REVISION 2	05.07.04

ENLARGED PLANS AND DETAILS

RECORD DWG.
DATE 8/26/05

4 LEGEND / NOTES

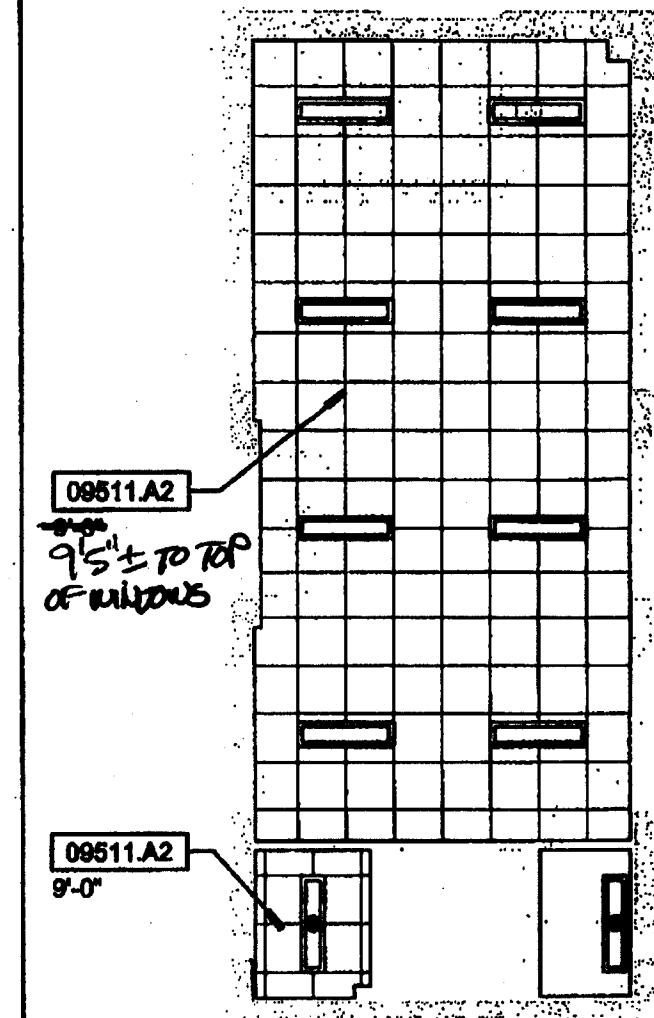

H14 REF. CLG. PLAN

1/8"=1'-0" Second Floor

FIXTURE LEGEND

- SURFACE MOUNTED FLOURESCENT
- SURFACE MOUNTED FLOURESCENT
- SURFACE MOUNTED FLOURESCENT
- WALL SCONCE
- RECESSED FLOURESCENT FIXTURE
- EMERGENCY EXIT DEVICE

KEYNOTES

- 0220 GYPSUM BOARD ASSEMBLIES
- 0220.B1 Steel Studs
- 0220.C3 Gypsum Wallboard
- 09511 ACUSTICAL PANEL CEILING
- 09511.A1 Suspended Acoustical Panel Ceiling System
- 09511.A2 Suspended Gypsum Based Panel Ceiling System
- 09545 METAL CEILING
- 09545.A1 Suspended Metal Ceiling System


GENERAL NOTES

- 0.000 DEMOLITION
- 0.131 existing concrete slab to remain
- 1.000 ARCHITECTURAL
- 1.027 exposed structure

C14 KEYNOTES

GENERAL NOTES

1. Locate all ceiling fixtures per Architectural Drawings.
2. Where existing concrete ceiling is to remain, repair/patch as necessary and paint.
3. Elevations given on Reflected Ceiling Plans are from finish floor to finish ceiling at point directly below indicator.
4. All rooms with one fixture - Fixture to be centered in room.

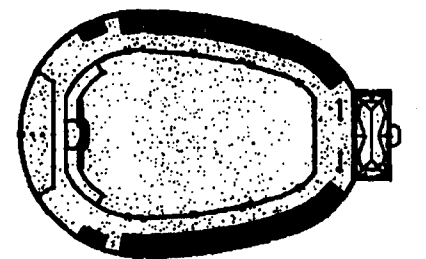

CUSCADEN POOL RENOVATION

CITY OF TAMPA
308 East Jackson Street
Tampa, Florida 33602


Project No. 0202.00

Distribution Date
BID DOCUMENTS 02.02.04

REFLECTED CEILING PLAN

RECORD DWG.


DATE 8/26/05

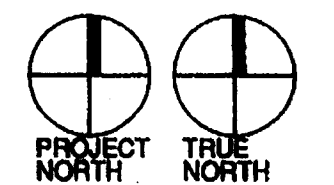

RECEIVED
FEB 23 2004
CONCT. TECH. GROUP, INC.

A601

217
009

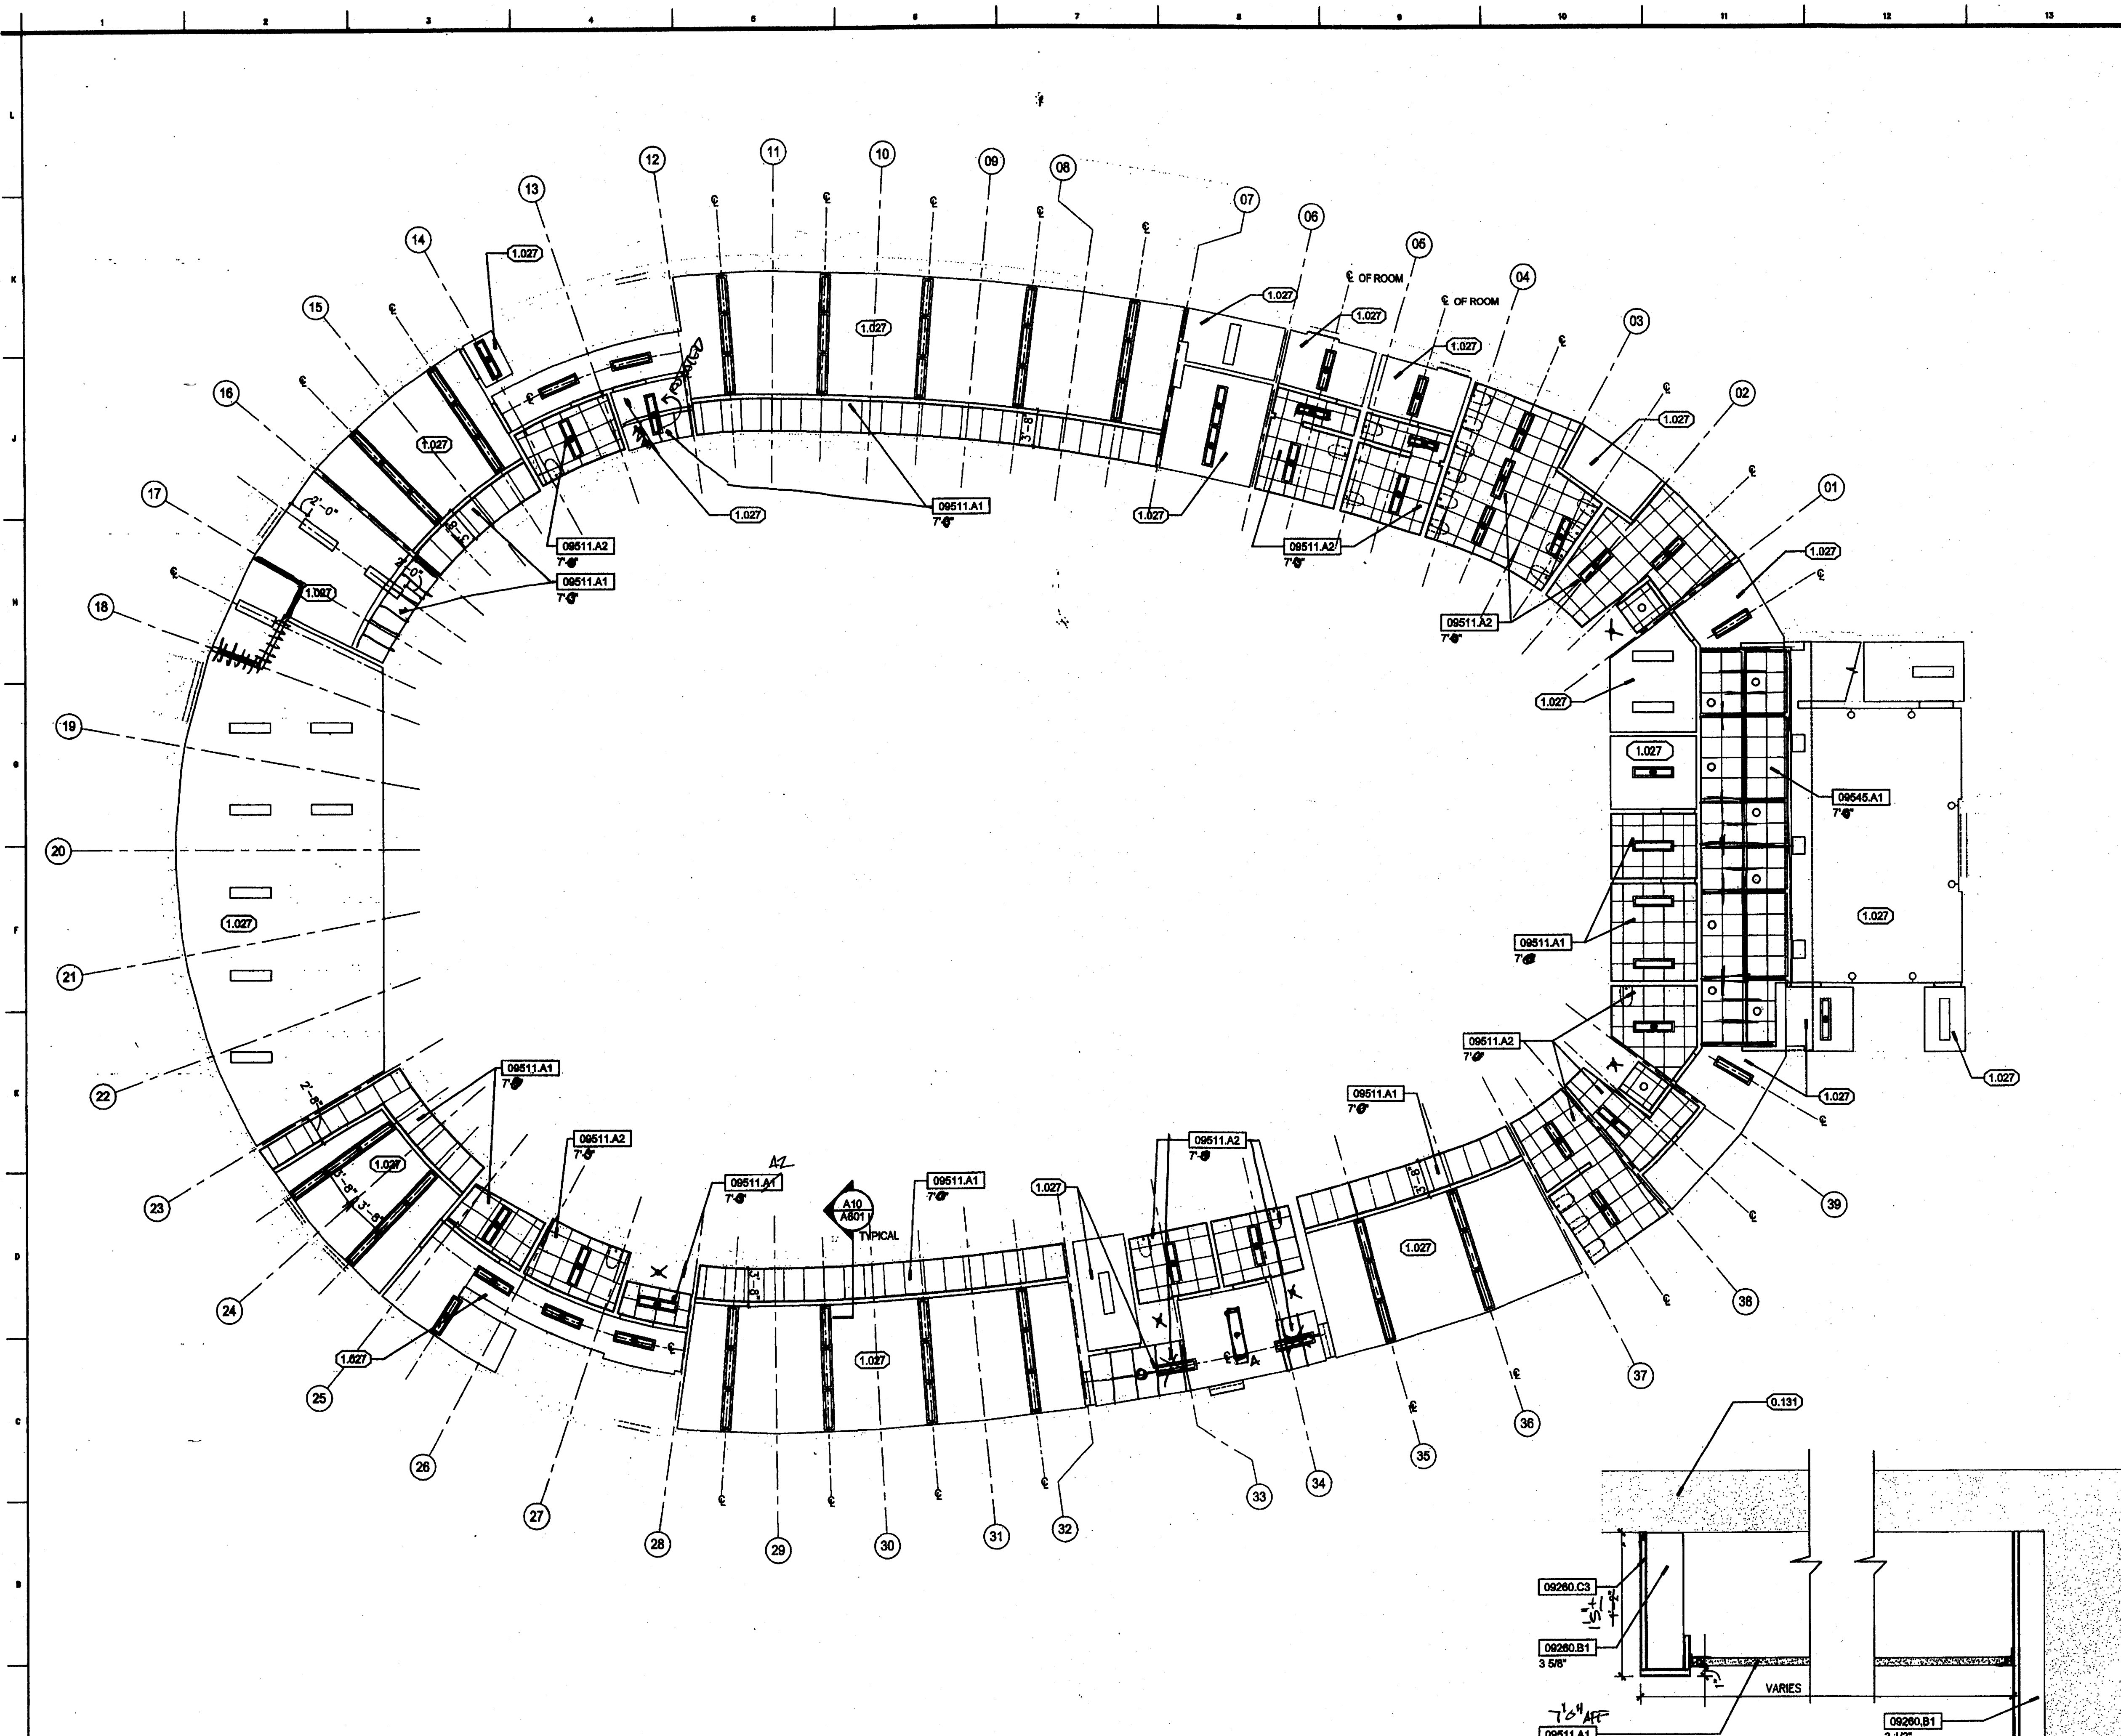

A1 REFLECTED CEILING PLAN - First Floor

1/8"=1'-0"

A10 TYPICAL SOFFIT DETAIL

1 1/2"=1'-0"

A14 LEGEND / NOTES

DOOR HARDWARE

Hardware Set #1 - doors: 101, 130, 201; each to have:
 2 Cylinder 3080/1080 630
 Remainder of hardware specified with aluminum door

Hardware Set #2 - doors: 157; each to have:
 6 ea Hinges FBB191 4.5 x 4.5 NRP 630
 1 Classroom Lock ML2055 NSM 630
 2 Closer with Stop 4111 CUSH 689
 2 Flush Bolts 555 12" 630
 1 Lock Guard LG10 630
 1 Threshold 2005AV
 1 Rain Drip 348C
 1 set Weather Stripping S88BL

Hardware Set #3 - doors: 120 (90 Min. Rated Door & Frame); each to have:
 3 ea Hinges FBB191 4.5 x 4.5 NRP 630
 1 Storeroom Lock ML2057 NSM 630
 1 Closer with Stop 4111 CUSH 689
 1 Lock Guard LG10 630
 1 Threshold 2005AV
 1 Rain Drip 348C
 1 set Weather Stripping S88BL

Hardware Set #4 - doors: 124A, 124B, 140; each to have:
 3 ea Hinges FBB191 4.5 x 4.5 NRP 630
 1 Storeroom Lock ML2057 NSM 630
 1 Closer with Stop 4111 CUSH 689
 1 Lock Guard LG10 630
 1 Threshold 2005AV
 1 Rain Drip 348C
 1 set Weather Stripping S88BL

Hardware Set #5 - doors: 125, 156; each to have:
 3 ea Hinges FBB191 4.5 x 4.5 NRP 630
 1 Exit Device/Panic Hardware 98EO 630
 1 Closer with Stop 4111 CUSH 689
 1 Door Top Weather Strip 346

Hardware Set #6 - doors: 112, 160, 161; each to have:
 3 ea Hinges FBB191 4.5 x 4.5 NRP 630
 1 Deadlock DL4017 630
 1 Push Plate 70F 630
 1 Door Pull BF112 630
 1 Closer with Stop 4111 CUSH 689
 1 Rain Drip 348C

Hardware Set #7 - doors: 102, 110, 113, 114, 121, 122, 154 and 162; each to have:
 3 ea Hinges FBB191 4.5 x 4.5 630
 1 Privacy Set ML2030 NSM 630
 1 Stop
 3 ea Silencers

Hardware Set #8 - doors: 103, 104, 105, 106, 131, 152, 159, 203; each to have:
 3 ea Hinges FBB191 4.5 x 4.5 630
 1 Storeroom Lock ML2057 NSM 630
 1 Stop
 3 ea Silencers

Hardware Set #9 - doors: 107, 151; each to have:
 3 ea Hinges FBB191 4.5 x 4.5 630
 1 Office Lock ML2061 NSM 630
 1 Stop
 3 ea Silencers

Hardware Set #10 - doors: 109 (90 Min. Rated Door & Frame); each to have:
 3 ea Hinges FBB191 4.5 x 4.5 630
 1 Storeroom Lock ML2057 NSM 630
 1 Closer with Stop 4111 CUSH 689
 3 ea Silencers

Hardware Set #11 - doors: 111, 117, 202; each to have:
 3 ea Hinges FBB191 4.5 x 4.5 630
 1 Classroom Lock ML2055 NSM 630
 1 Stop
 3 ea Silencers

Hardware Set #12 - doors: 115, 155; each to have:
 3 ea Hinges FBB191 4.5 x 4.5 630
 1 Storeroom Lock ML2057 NSM 630
 1 Overhead Stop GJ450 series 630
 3 ea Silencers

Hardware Set #13 - doors: 124C; each to have:
 3 ea Hinges FBB191 4.5 x 4.5 630
 1 Office Lock ML2051 NSM 630
 1 Overhead Stop GJ450 series 630
 3 ea Silencers


Hardware Set #14 - doors: 158; each to have:
 6 ea Hinges FBB191 4.5 x 4.5 630
 1 Storeroom Lock ML2057 NSM 630
 2 Overhead Stops GJ450 series 630
 2 Flush Bolts 555 12" 630
 1 Dustproof Strike 570 630
 2 ea Silencers

ALUMINUM STOREFRONT HARDWARE


Hardware Set #01
 Opening: 101, each to have:
 6 Hinges FBB 191 4.5 x 4.5 NRP 630
 2 Exit Device/Panic Hardware Kawneer Paneline® CR-90
 2 Pulls Kawneer CPN
 2 Closers with stop 4111 CUSH 689
 1 Astragal
 1 Threshold 2005AS
 1 Weather Seals S88BL

Hardware Set #02
 Opening: 201, each to have:
 6 Hinges FBB 191 4.5 x 4.5 NRP 630
 2 Exit Device/Panic Hardware Kawneer Paneline® CR-90, locate on pool side of door.
 2 Pulls Kawneer CPN
 2 Closers with stop 4111 CUSH 689
 1 Astragal
 1 Threshold 2005AS
 1 Weather Seals S88BL

Hardware Set #03
 Opening: 130, each to have:
 6 Hinges FBB 191 4.5 x 4.5 NRP 630
 1 Storeroom Lock ML2057 NSM 630
 2 Flush Bolts 555 12" 630
 2 Overhead Stop GJ450 Series 630
 1 Threshold 2005AS
 1 Weather Seals S88BL


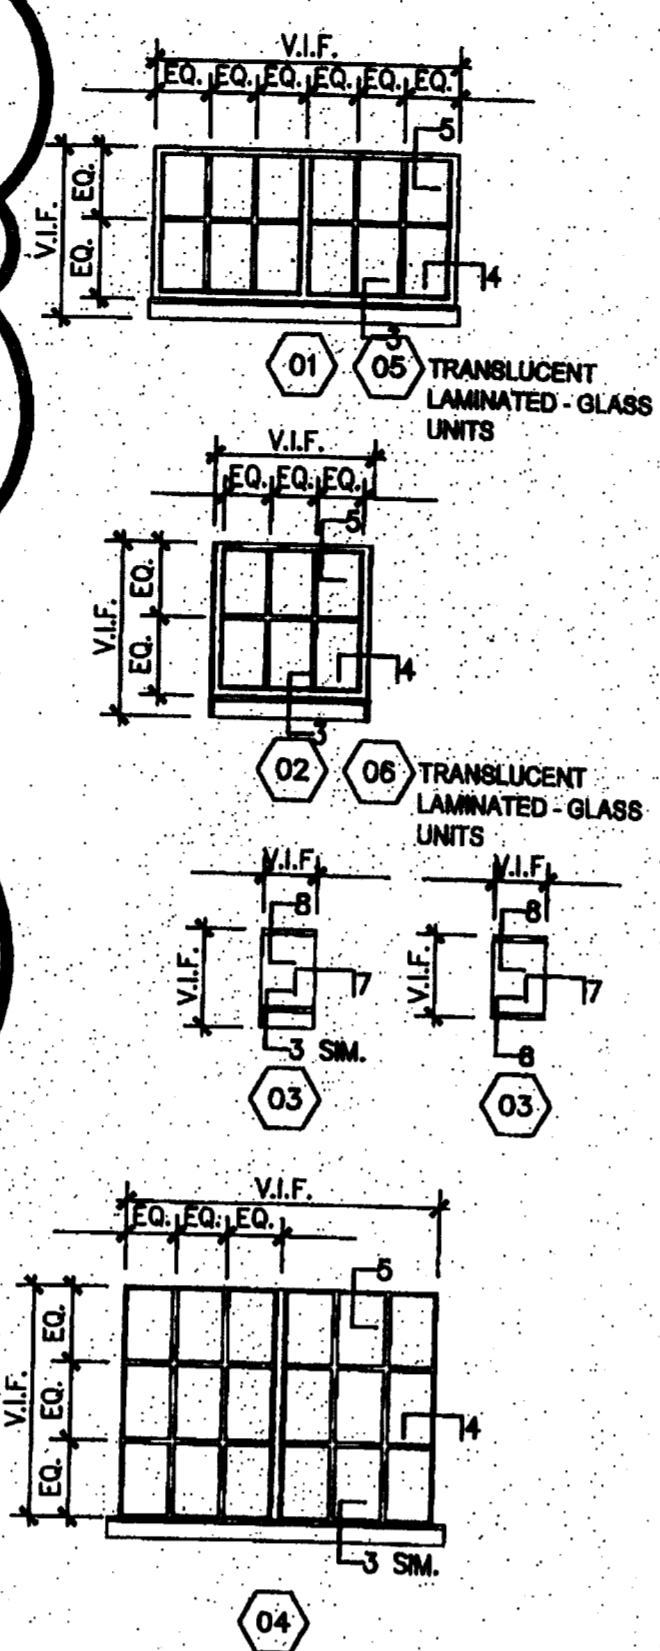


NO EXCEPTION TAKEN
 EXCEPT AS NOTED
 REJECTED
 REVISE AND RESUBMIT
 Review of the submitted is only for general conformance with the design of the project and general compliance with the requirements of the Contract Documents. The Contractor is responsible for confirming processes and techniques of construction and coordinating the work with work of other trades.
 DATE 11/11/04
 ROWE ARCHITECTS INCORPORATED

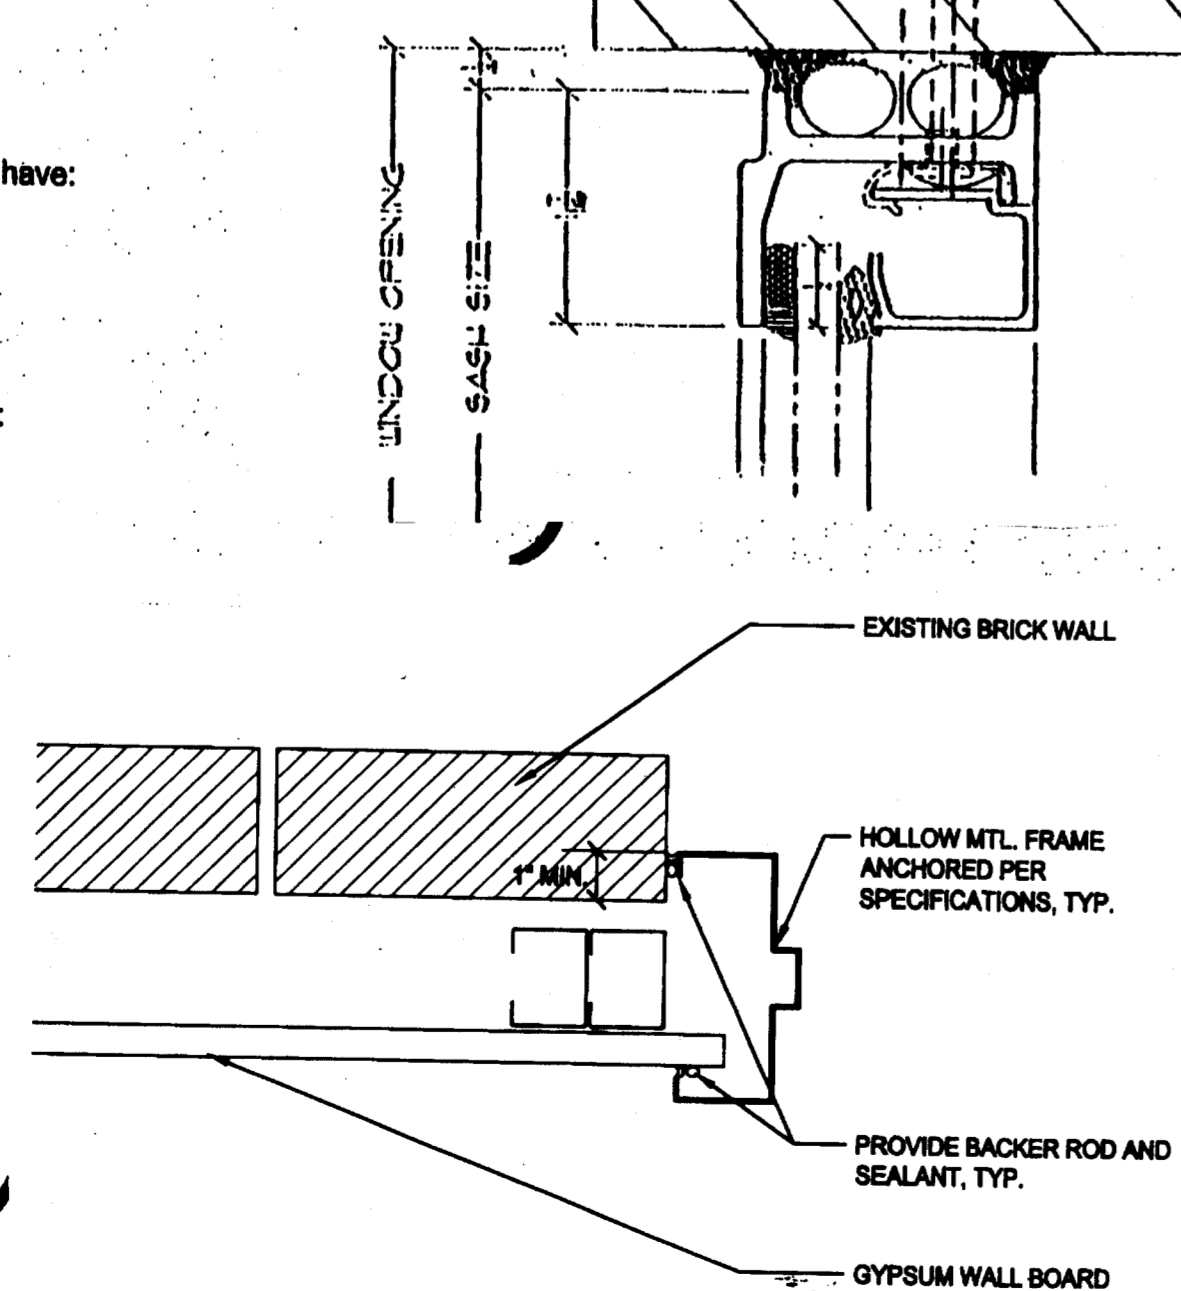


E6 WINDOW ELEVATIONS & DETAILS

DETAILS AT 3" = 1'-0"

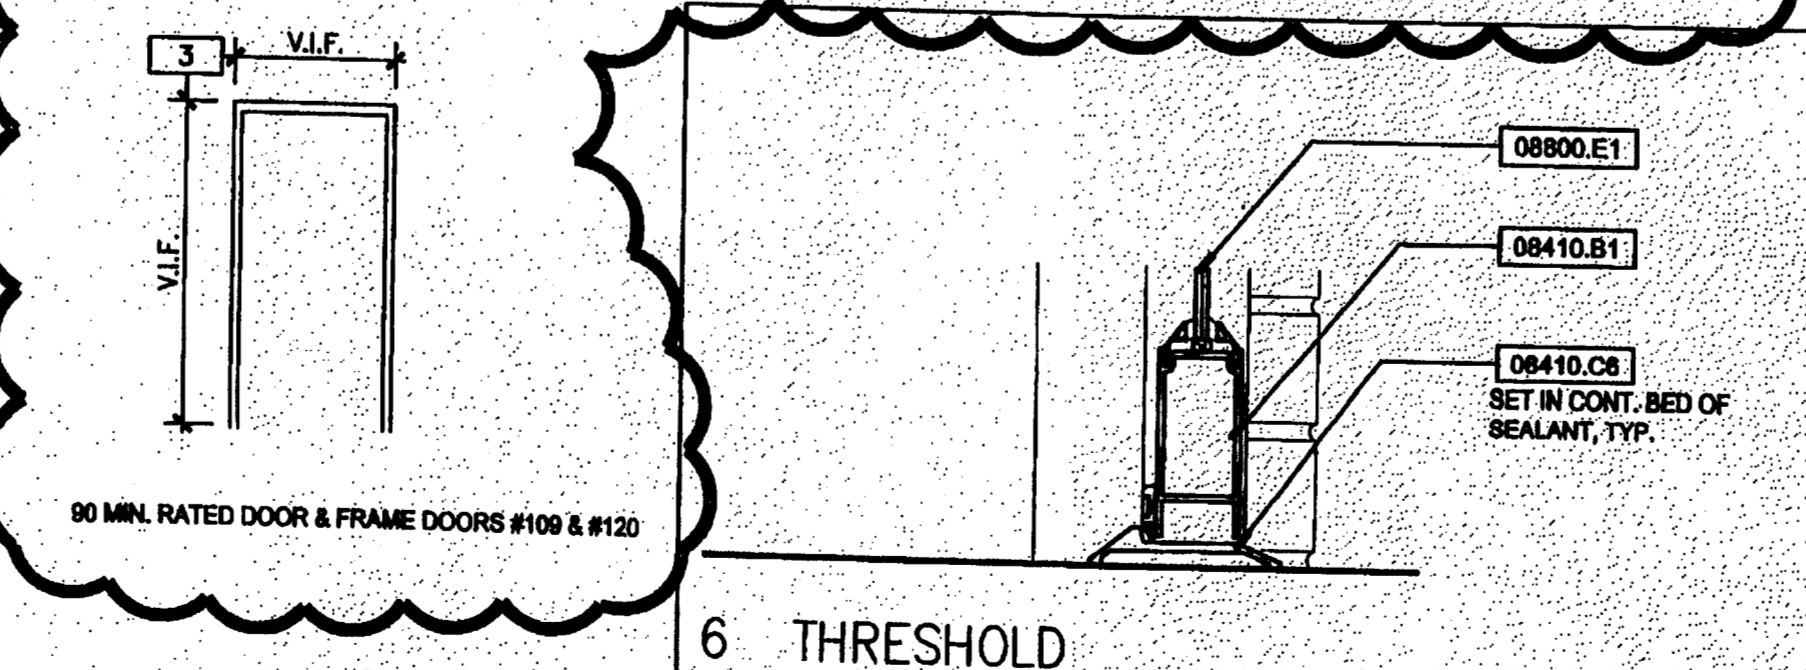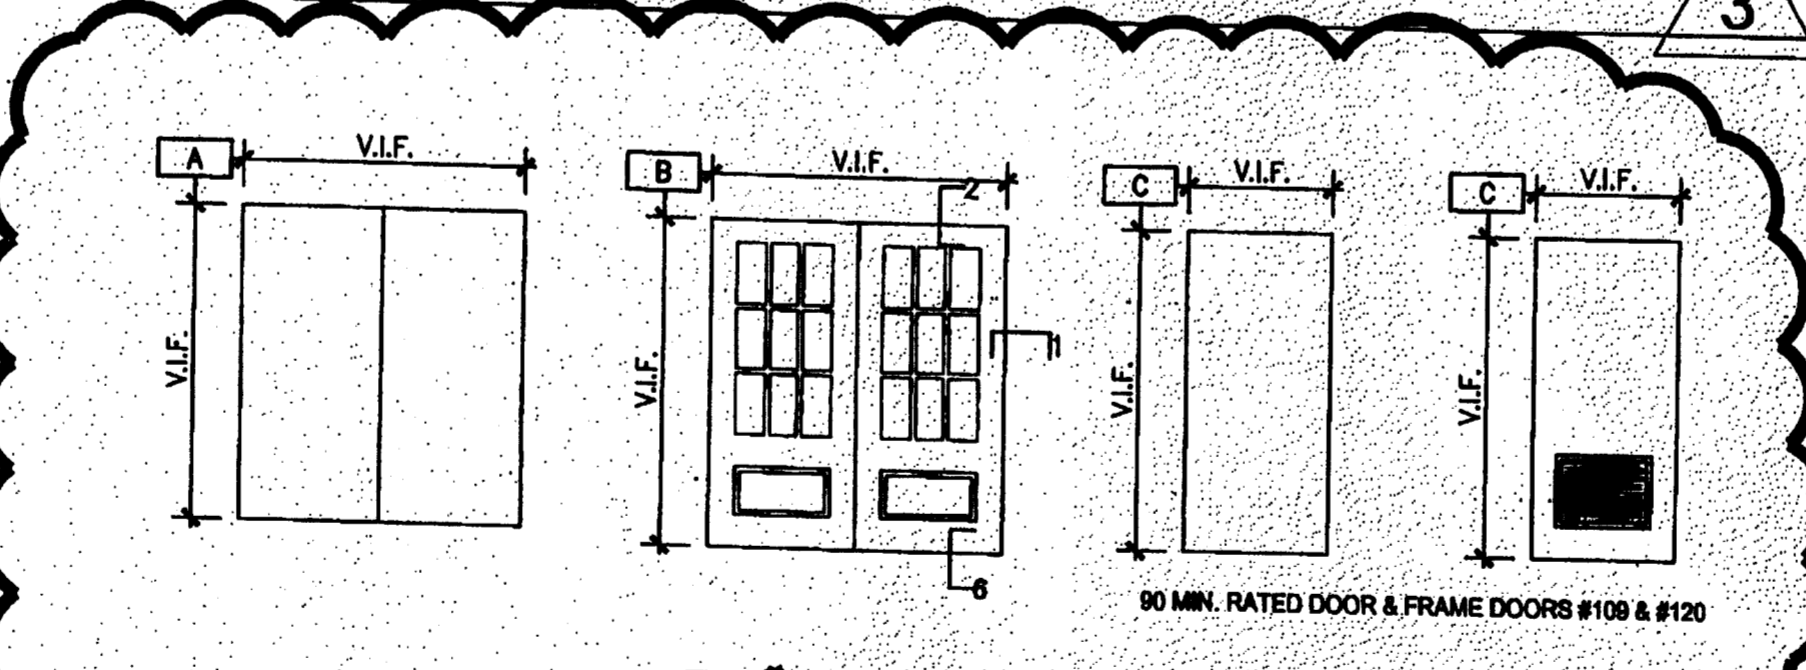

A6 DOOR AND FRAME ELEVATIONS AND DETAILS

DETAILS AT 3" = 1'-0"

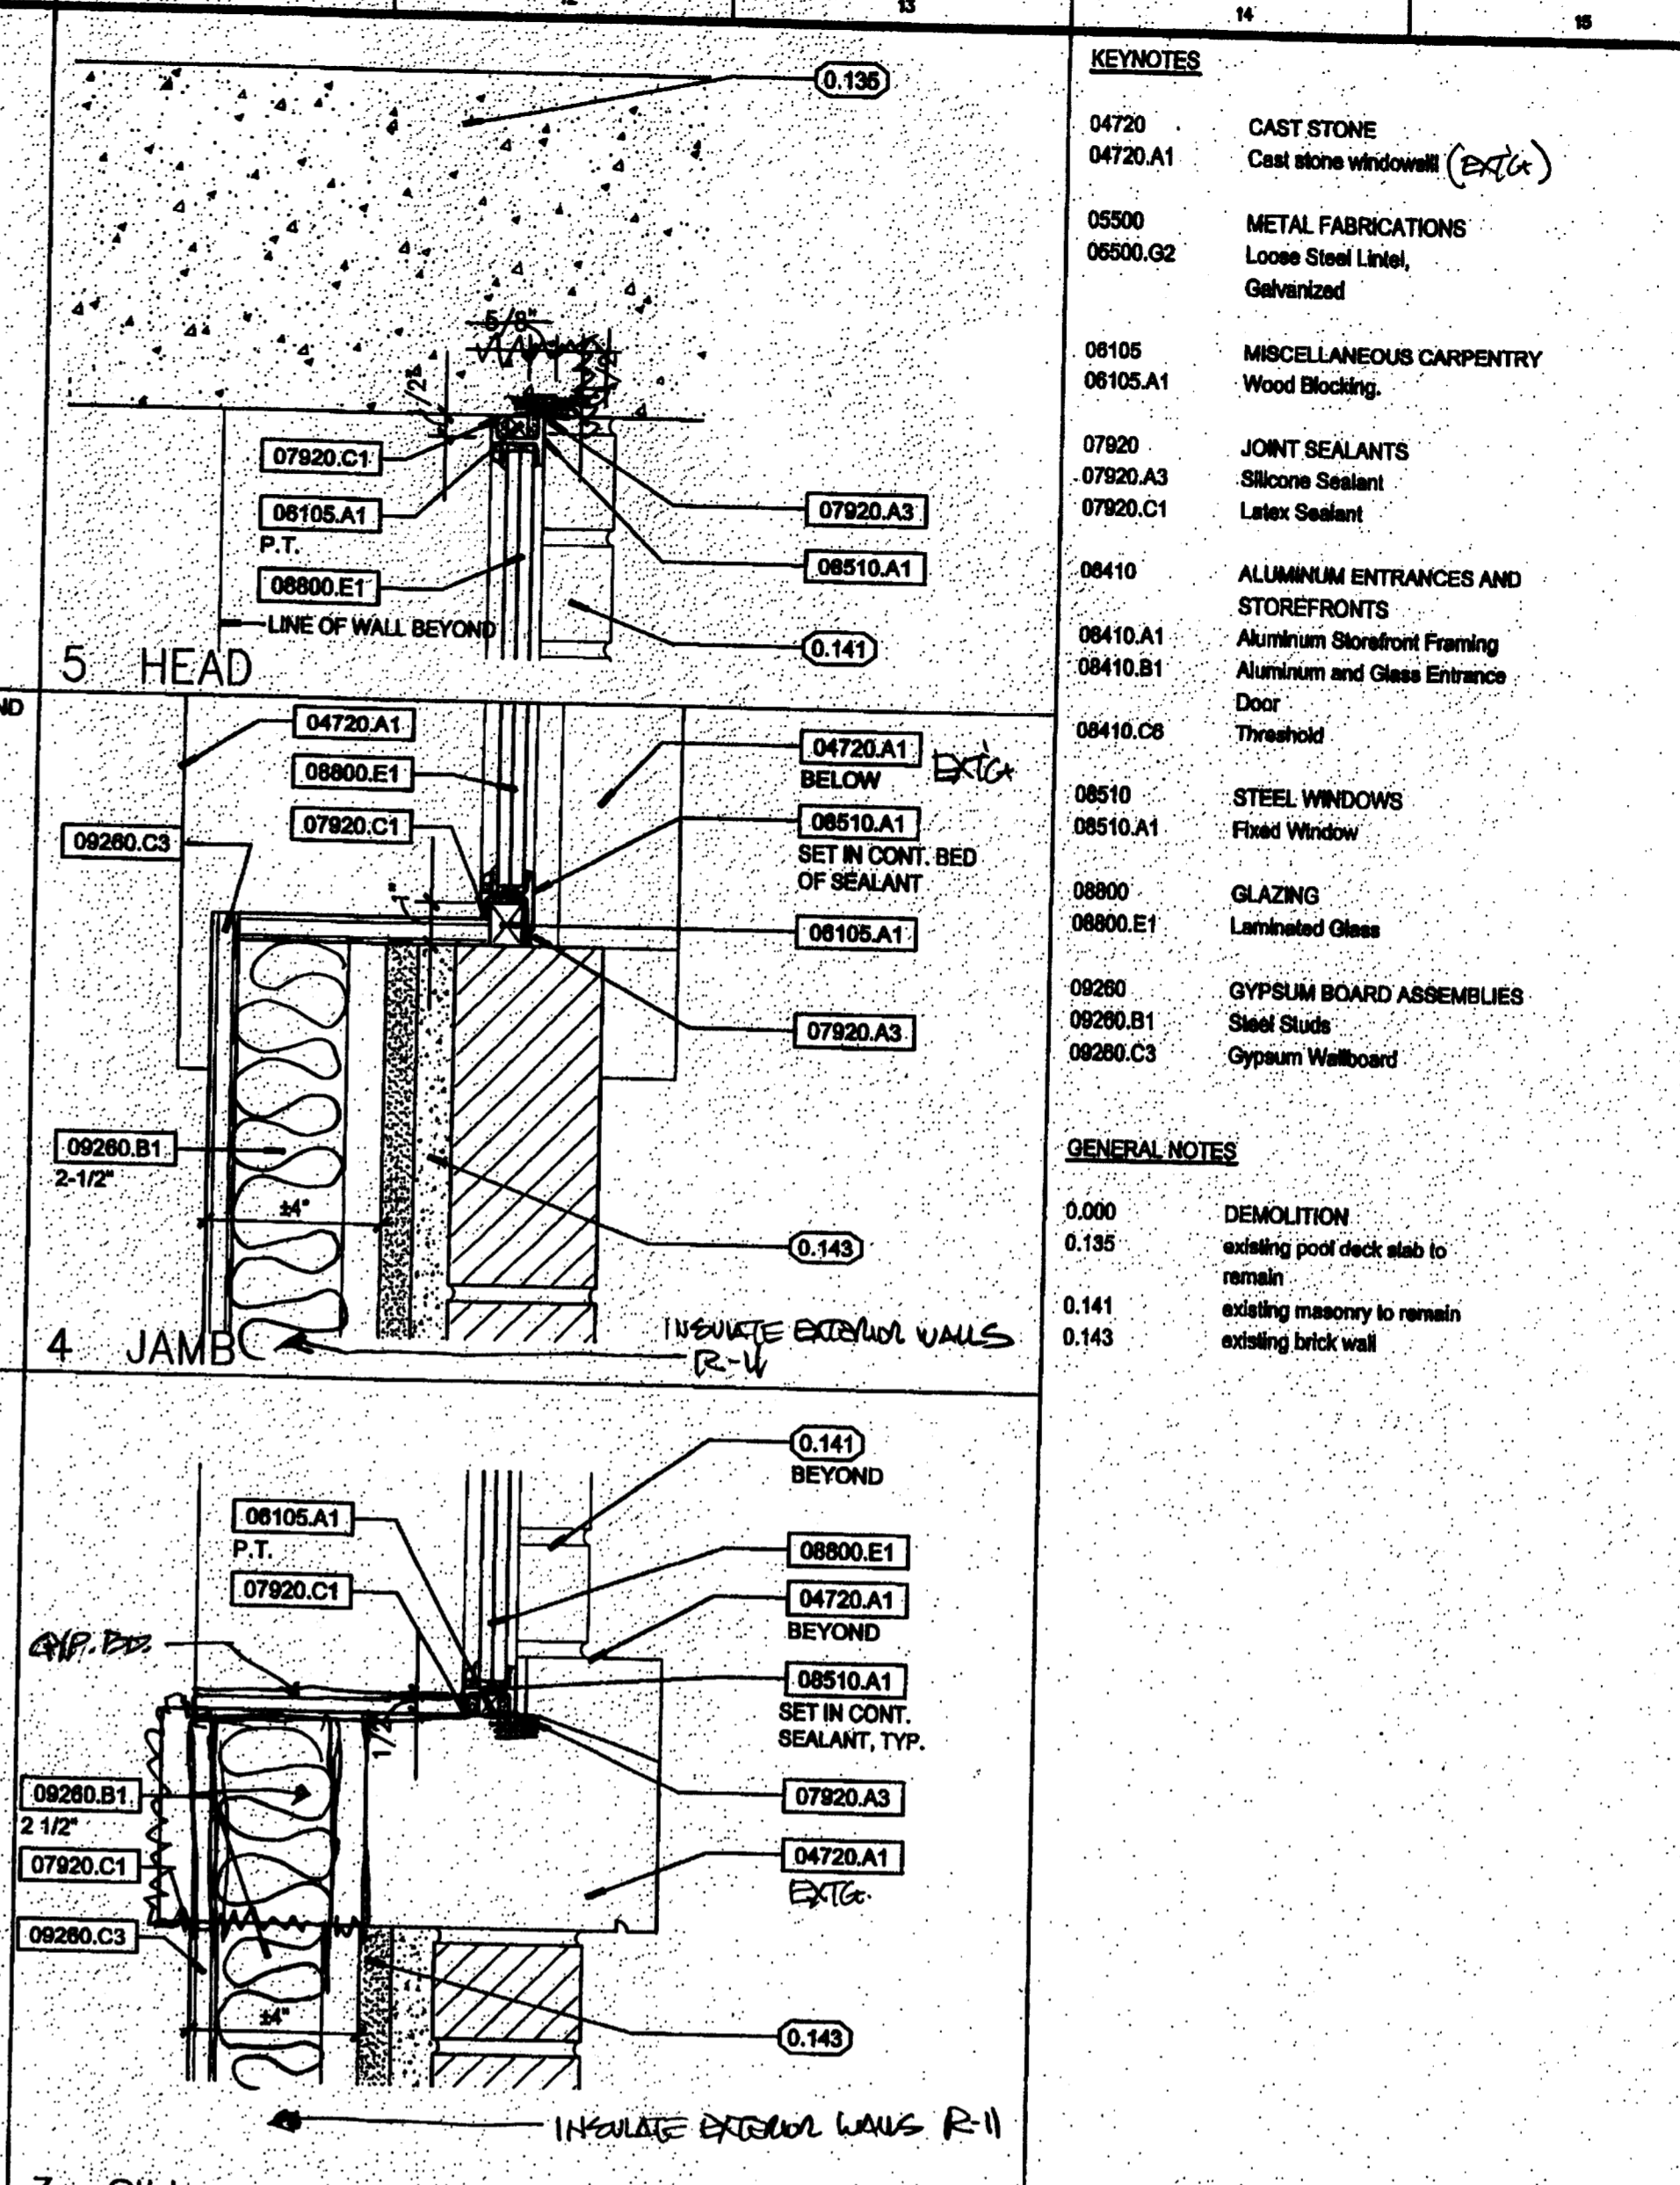


KEYNOTES

04720	CAST STONE
04720.A1	Cast stone window sill (EXT.)
05500	METAL FABRICATIONS
06500.G2	Loose Steel Lintel, Galvanized
06105	MISCELLANEOUS CARPENTRY
06105.A1	Wood Blocking
07820	JOINT SEALANTS
07920.A3	Silicone Sealant
07920.C1	Latex Sealant
08410	ALUMINUM ENTRANCES AND STOREFRONTS
08410.A1	Aluminum Storefront Framing
08410.B1	Aluminum and Glass Entrance Door
08410.C8	Threshold
08510	STEEL WINDOWS
08510.A1	Fixed Window
08800	GLAZING
08800.E1	Laminated Glass
09280	GYPSUM BOARD ASSEMBLIES
09280.B1	Steel Studs
09280.C3	Gypsum Wallboard

GENERAL NOTES

0.000	DEMOLITION
0.135	existing pool deck slab to remain
0.141	existing masonry to remain
0.143	existing brick wall

E14 KEYNOTES

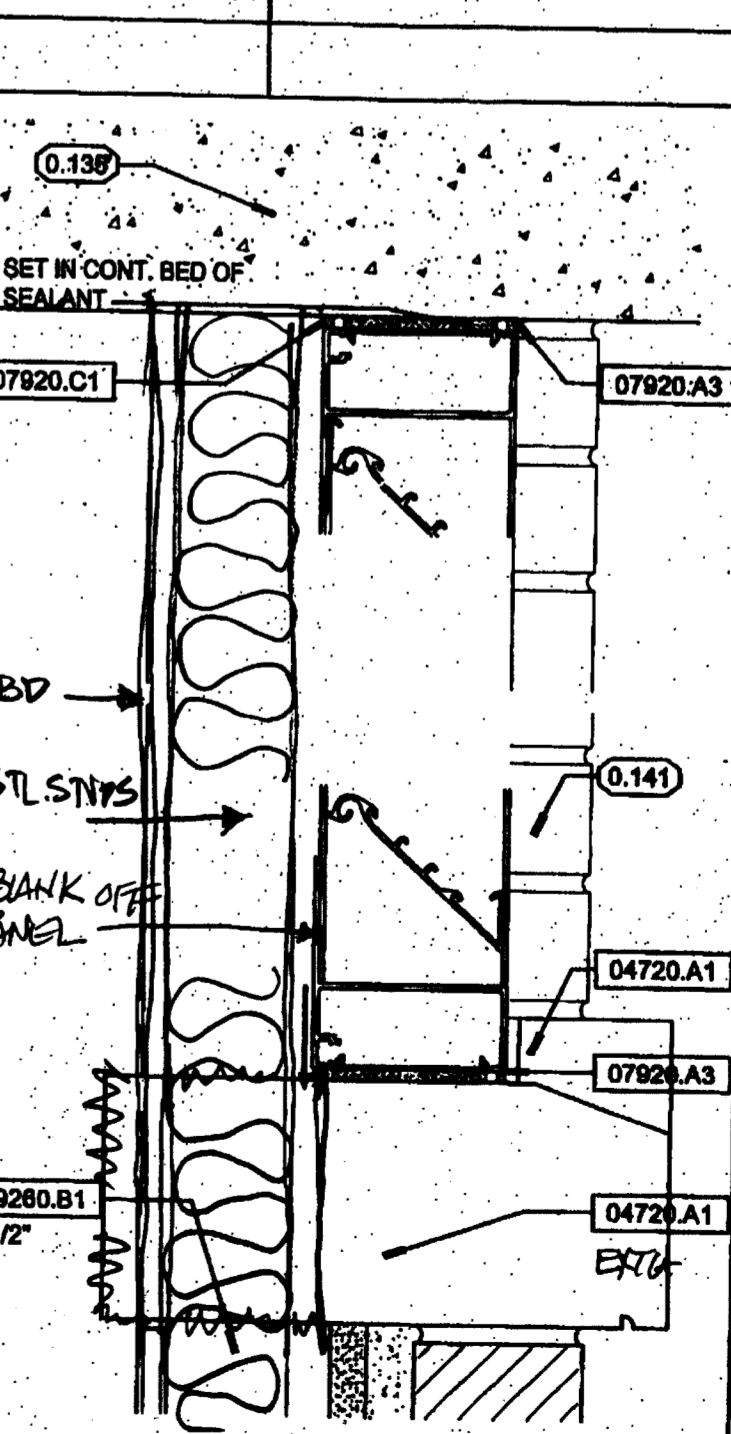

A14 LOUVER DETAILS

3" = 1'-0"

ROWE ARCHITECTS

100 Madison Street, Suite 200
 Tampa, Florida 33602-4704
 www.RoweArchitects.com
 Fax: 813.221.9154
 813.221.8771
 AAC002172

CUSCADEN POOL RENOVATION

CITY OF TAMPA
 306 East Jackson Street
 Tampa, Florida 33602

Project No.0202.00

Distribution	Date
BID DOCUMENTS	02.02.04
REVISION A	05.07.04
REVISION B	07.14.04


WINDOW, DOOR & LOUVER DETAILS

RECORD DWG.
 DATE 8/26/05

REVISED
 JUL 16 2004

CITY OF TAMPA
 COMMERCIAL PLAN REVIEW

A801

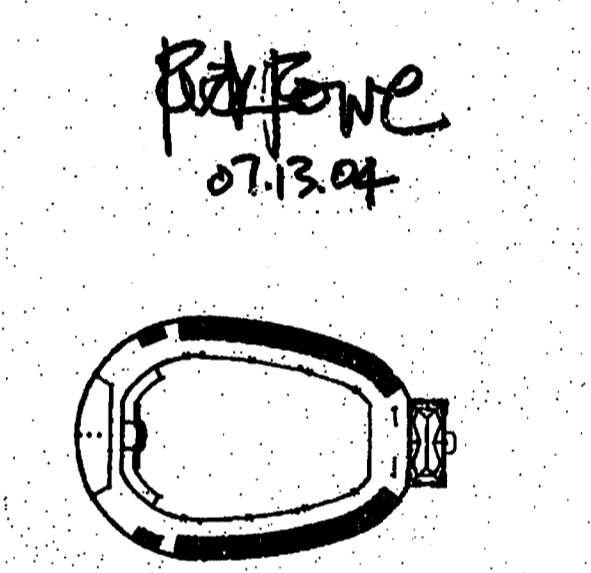

PRE-BID SUBMITTAL
THE CONTRACTOR SHALL VISIT THE PROJECT SITE PRIOR TO BIDDING TO FAMILIARIZE HIMSELF WITH THE CONDITIONS FOR CONSTRUCTION ACTIVITIES. THE CONTRACTOR SHALL OBTAIN FROM THE OWNER A WRITTEN LIST OF ALL PERMITS AND COPIES THEREOF, AND CAREFULLY REVIEW ALL PLANS, SPECIFICATIONS, AND PERMITS PREVIOUSLY SECURED ON BEHALF OF THE OWNER. IN CASE OF ANY DISCREPANCY OTHER THAN CLERICAL MISTAKES, PLANS, DRAWINGS, OR SPECIFICATIONS, THE CONTRACTOR MUST PROMPTLY SUBMIT A WRITTEN CLARIFICATION REQUEST TO THE OWNER, WHO WILL PROMPTLY FORWARD SAME TO THE ENGINEER WHO WILL MAKE A DETERMINATION IN WRITING. THE CONTRACTOR MUST VERIFY EXISTING FACILITY INFORMATION, AND ALL DESIGN/PERMIT DATA REQUIRED FOR WORK THAT IS TO CONNECT WITH EXISTING FACILITIES. ANY DISCREPANCIES BETWEEN THE CONTRACT REQUIREMENTS AND THE EXISTING CONDITIONS MUST BE REFERRED TO THE OWNER, IN WRITING, FOR AN ENGINEERING DETERMINATION. ANY FURTHER ADJUSTMENT DUE TO FAILURE BY THE CONTRACTOR TO IDENTIFY THE RELATED DISCREPANCY, WILL BE AT THE CONTRACTOR'S EXPENSE. THE CONTRACTOR SHALL BE RESPONSIBLE FOR OBTAINING ANY LICENSES AND ADDITIONAL PERMITS, AND FOR COMPLYING WITH ALL APPLICABLE FEDERAL, STATE AND LOCAL LAWS, CODES, AND REGULATIONS IN CONNECTION WITH THE PERFORMANCE OF THE WORK.

CONSTRUCTION SAFETY AND LIABILITY
THE CONTRACTOR MUST TAKE PROPER SAFETY AND HEALTH PRECAUTIONS TO PROTECT THE WORK, THE WORKERS, THE PUBLIC, AND THE PROPERTY OF OTHERS. THE CONTRACTOR IS RESPONSIBLE FOR ALL MATERIALS DELIVERED AND WORK PERFORMED UNTIL COMPLETION AND ALL ACCEPTANCES HAVE BEEN OBTAINED. THE CONTRACTOR SHALL MAINTAIN TRAFFIC DURING CONSTRUCTION IN ACCORDANCE WITH THE STATE OF FLORIDA MANUAL ON UNIFORM TRAFFIC CONTROL DEVICES. THE CONTRACTOR IS RESPONSIBLE FOR ALL DAMAGES TO PERSONS OR PROPERTY THAT OCCURS AS A RESULT OF HIS NEGLIGENCE. THE CONTRACTOR MUST SAVE HARMLESS AND INDEMNIFY THE OWNER AND CHARLOTTE ENGINEERING AND SURVEYING, INC., ITS OFFICERS, REPRESENTATIVES AND EMPLOYEES FROM ALL CLAIMS, LOSSES, DAMAGES, ACTIONS, CAUSES OF ACTION, AND/OR EXPENSES RESULTING FROM, BROUGHT FOR, OR ON ACCOUNT OF ANY PERSONAL INJURY OR PROPERTY DAMAGE RECEIVED OR SUSTAINED BY ANY PERSONS OR PERSONAL INJURY OR PROPERTY DAMAGE, OR ATTRIBUTABLE TO ANY WORK PERFORMED OR RELATED TO THE PROJECT, IN WHOLE OR IN PART, WHETHER OR NOT CAUSED BY THE NEGLIGENCE, AGENT, OR OMISSIONS OF THE CONTRACTOR, ANY SUBCONTRACTOR, OR ANY EMPLOYEE, AGENT, OR REPRESENTATIVE OF THE CONTRACTOR OR ANY SUBCONTRACTOR.

PRE-CONSTRUCTION
THE OWNER SHALL SECURE PRIOR TO CONSTRUCTION A PROFESSIONAL LAND SURVEYOR TO PERFORM ALL SURVEYING AND TO PREPARE ALL PLANS, SPECIFICATIONS, PERMITS, AND ALSO SECURE PRIOR TO CONSTRUCTION A PROFESSIONAL ENGINEER TO PROVIDE THE APPROPRIATE SERVICES NEEDED IN ORDER TO OBTAIN ALL APPLICABLE REGULATORY AGENCIES THAT THE IMPROVEMENTS WERE CONSTRUCTED IN SUBSTANTIAL COMPLIANCE WITH ALL APPLICABLE LAWS, ORDINANCES, AND REGULATIONS. THE CONTRACTOR SHALL PRE-CONSTRUCTION MEETING WITH THE ENGINEER, SURVEYOR, CONTRACTOR, TESTING LAB, UTILITY COMPANIES, AND APPROPRIATE REGULATORY AGENCIES. THE CONTRACTOR SHALL PROVIDE A SHOP DRAWING SUBMISSION SCHEDULE FOR ALL PROJECT MATERIALS AND COMPONENTS. THE CONTRACTOR SHALL NOT INITIATE CONSTRUCTION OF ANY PORTION OF THE IMPROVEMENTS UNTIL THE SHOP DRAWINGS HAVE BEEN REVIEWED AND APPROVED FOR THAT PORTION BY THE ENGINEER, THE OWNER, CONTRACTOR, ENGINEER AND UTILITY COMPANY. THE CONTRACTOR SHALL OBTAIN ALL NECESSARY PERMITS AND APPROVALS FOR FACILITIES TRANSFER FROM THE OWNER TO THE UTILITY COMPANY UPON PROJECT COMPLETION. UNLESS OTHERWISE SPECIFIED BY THE UTILITY COMPANY, THE FOLLOWING DOCUMENTS SHALL BE PROVIDED:

- UTILITY EASEMENTS: MUST BE RECORDED AT COUNTY CLERK OF COURT OFFICE PRIOR TO SUBMITTING TO UTILITY.
- EASEMENT ACKNOWLEDGEMENT.
- AFFIDAVIT.
- RELEASE OF LIEN.
- ASSIGNMENT OF RIGHTS UNDER UTILITY AGREEMENT: WHEN PROPERTY HAS BEEN TRANSFERRED TO A NEW OWNER.
- DESCRIPTION OF FACILITIES: A SHORT EXPLANATION DEPICTING WHAT HAS BEEN CONSTRUCTED.
- DETAILED COST OF CONSTRUCTION: MUST INCLUDE INDIVIDUAL ITEMS OR APPURTENANCES, UNIT COST AND TOTAL COST OF EACH. DO NOT INCLUDE WATER SERVICE LINES.
- RECORD DRAWINGS (AS-BUILT): MUST BE SIGNED AND SEALED BY ENGINEER OF RECORD. SUBMIT A REPRODUCIBLE MYLAR AND TWO COPIES OF PRINTS.
- F.I.D.P.E. APPLICATION(S).
- INSPECTION REPORT(S).
- PRESSURE TEST REPORT(S).
- INFILTRATION-EXFILTRATION TEST REPORT(S), INCLUDING VIDEO TAPES AND LAMPING REPORTS.
- LIFT STATION INSPECTION (START-UP) REPORT(S) AND EQUIPMENT SHOP DRAWINGS.
- BACTERIOLOGICAL TEST REPORT(S).
- ENGINEER'S CERTIFICATE OF SUBSTANTIAL COMPLIANCE TO F.D.E.P. SYSTEMS ACCEPTANCE LETTER(S) FROM F.D.E.P.
- NOTES: ITEM 1-8 TO BE SUPPLIED BY OWNER. ITEMS 9-17 TO BE SUPPLIED BY ENGINEER OF RECORD.

UNLESS OTHERWISE SPECIFIED BY THE UTILITY, THE CONTRACTOR SHALL NOTIFY THE SUPERINTENDENTS OF THE GAS, GAS SEWER, TELEPHONE, AND POWER COMPANIES, 10 DAYS IN ADVANCE, THAT HE INTENDS TO START WORK IN A SPECIFIC AREA. THE OWNER AND ENGINEER DISCLAIM ANY RESPONSIBILITY FOR THE SUPPORT AND PROTECTION OF GASES, DRAINS, WATER LINES, GAS LINES, CONDUITS OF ANY KIND, UTILITIES OR OTHER STRUCTURES OWNED BY THE CITY, COUNTY, STATE OR BY PRIVATE OR PUBLIC UTILITIES LEGALLY OCCUPYING ANY STREET, ALLEY, PUBLIC PLACE, RIGHT-OF-WAY, OR EASEMENT.

PROJECT SIGN
THE CONTRACTOR SHALL PROVIDE AND MAINTAIN A CONSTRUCTION PROJECT SIGN AT A CORNER OF THE PROJECT, AS DETERMINED BY THE ENGINEER AND SURVEYOR. THE SIGN SHALL PROVIDE A SEPARATE SIGN FOR INSTALLATION BY THE CONTRACTOR AT THIS LOCATION. THESE SIGNS SHALL BE ERECTED WITHIN 15 DAYS AFTER RECEIVING A NOTICE TO PROCEED. UPON PROJECT COMPLETION, THE CONTRACTOR SHALL REMOVE THESE SIGNS AND RETURN TO CHARLOTTE ENGINEERING AND SURVEYING, INC. THEIR SIGN.

ENVIRONMENTAL RESTRICTIONS DURING CONSTRUCTION
PROTECTION OF LAND RESOURCES-EXCEPT IN AREAS IDENTIFIED ON THE PLANS TO BE CLEARED, THE CONTRACTOR MUST NOT DEFACE, INJURE, OR DESTROY TREES OR SHRUBS OR REMOVE OR CUT THEM WITHOUT WRITTEN AUTHORIZATION FROM THE OWNER. IN THE ABSENCE OF A CLEANSING PLAN, AREAS SHOWN FOR IMPROVEMENTS SHALL BE CLEARED UNLESS NOTED OTHERWISE.

PROTECTION OF WATER RESOURCES-IT IS THE RESPONSIBILITY OF THE CONTRACTOR TO INVESTIGATE AND COMPLY WITH ALL APPLICABLE FEDERAL, STATE, REGIONAL, COUNTY, AND MUNICIPAL LAWS CONCERNING POLLUTION OF WATER RESOURCES. WORK MUST BE PERFORMED IN SUCH A MANNER THAT OBSCURABLE CONDITIONS WILL NOT BE CREATED IN PUBLIC WATERS RUNNING THROUGH, OR ADJACENT TO THE PROJECT AREA.

EROSION AND SEDIMENT CONTROL-ALL PRACTICABLE AND NECESSARY EFFORT SHOULD BE TAKEN DURING CONSTRUCTION TO CONTROL AND PREVENT EROSION, AND THE TRANSPORT OF SEDIMENT TO SURFACE DRAINS, SURFACE WATER, OR ONTO OTHER PROPERTY BY ANY OR ALL OF THE FOLLOWING METHODS:

- STORMWATER FACILITIES ARE TO BE INSTALLED EARLY IN THE CONSTRUCTION PHASE AS POSSIBLE TO ENSURE THE TREATMENT OF STORMWATER RUNOFF. TEMPORARY EROSION AND SEDIMENT CONTROL MEASURES, HOWEVER, SUCH AS BERMS, SEDIMENT BASINS, GRASSING, SOODING, SAND BAGGING, STRIPPED HAY OR STRAW, FLOATING SILT BARRIERS, STACKED SILT BARRIERS, ETC. MUST BE PROVIDED AND MAINTAINED UNTIL THE PERMANENT FACILITIES ARE COMPLETED AND OPERATIONAL.
- RE-VEGETATION AND STABILIZATION OF DISTURBED GROUND SURFACES SHOULD BE ACCOMPLISHED AS SOON AS POSSIBLE.
- FILL COMPACTION OF ANY FILL MATERIAL PLACED AROUND NEWLY INSTALLED STRUCTURES.
- PROHIBIT THE USE OF ANY CONSTRUCTION EQUIPMENT THAT LEAKS EXCESSIVE AMOUNTS OF FUEL, OIL, OR HYDRAULIC FLUID.

ALL DISTURBED AREAS SHALL BE GRADED FOR POSITIVE DRAINAGE, EXCEPT RETENTION AREAS, AND SHALL BE STABILIZED BY SOODING, EXCEPT WHERE SEEDING AND MULCHING ARE CALLED FOR ON THE PLANS. THE LATEST VERSION OF THE F.D.O.T. ROAD AND BRIDGE SPECIFICATIONS SHALL BE USED, UNLESS MORE RESTRICTIVE LOCAL SPECIFICATIONS EXIST.

PROTECTION OF FISH AND WILDLIFE
THE CONTRACTOR MUST AT ALL TIMES PERFORM ALL WORK IN A WAY AND TAKE SUCH STEPS AS REQUIRED TO PREVENT ANY INTERFERENCE WITH OR DISTURBANCE TO FISH AND WILDLIFE. THE CONTRACTOR SHALL NOT ALTER WATER FLOWS OR OTHERWISE DISTURB NATIVE HABITATS AND JURISDICTIONAL WETLANDS LOCATED WITHIN AND/OR ADJACENT TO THE PROJECT AREA.

RECORDING AND PRESERVING HISTORICAL AND ARCHAEOLOGICAL FINDS
ALL ITEMS HAVING ANY APPARENT HISTORICAL OR ARCHAEOLOGICAL INTEREST THAT ARE DISCOVERED IN THE COURSE OF ANY CONSTRUCTION ACTIVITIES MUST BE CAREFULLY PRESERVED. THE CONTRACTOR MUST FURTHER NOTIFY THE ENGINEER AND HIS REPRESENTATIVE AND IMMEDIATELY REPORT THE FIND TO THE OWNER SO THAT THE PROPER AUTHORITY MAY BE NOTIFIED.

EARTHWORK
I. GENERAL
1.01 SUBMITTALS
A. GENERAL
B. COMPACTION TESTS
C. SOIL CLASSIFICATION TESTS
D. PRESERVATION PLANS
1.02 SITE EXAMINATION
A. BEFORE SUBMITTING BIDS, CONTRACTORS SHALL INFORM THEMSELVES AS TO LOCATION AND NATURE OF THE WORK, CHARACTER OF EQUIPMENT AND FACILITIES NEEDED FOR PERFORMANCE OF THE WORK, GENERAL AND LOCAL CONDITIONS PREVALENT AT THE SITE, AND OTHER MATTERS WHICH MAY, IN ANY WAY, AFFECT THE WORK UNDER CONTRACT.
B. EXAMINE SOURCES OF INFORMATION CONCERNING GROUND WATER LEVEL, WHETHER SURFACE OR SUBSURFACE. EACH BIDDER SHALL DETERMINE HIS OWN CONCEPTION CONCERNING GROUND WATER LEVEL AND HOW WATER AFFECTS HIS WORK.

1.03 SUBSURFACE INVESTIGATIONS
A. SUBSURFACE DATA, INCLUDING GROUND WATER ELEVATIONS OR CONDITIONS, IF SHOWN ON THE DRAWINGS OR ATTACHED TO THESE SPECIFICATIONS, ARE PRESENTED ONLY AS INFORMATION THAT IS AVAILABLE WHICH INDICATED CERTAIN CONDITIONS FOUND AND LIMITED TO THE EXACT LOCATIONS. SHALL NOT BE INTERPRETED AS AN INDICATION OF CONDITIONS THAT WILL ACTUALLY BE DEVELOPED THROUGH THE PERIOD OF CONSTRUCTION. BIDDERS SHALL EXAMINE THE SITE OF THE WORK AND MAKE THEIR OWN DETERMINATION OF THE CHARACTER OF MATERIALS AND THE CONDITIONS TO BE ENCOUNTERED ON THE WORK, AND THEIR PROPOSAL SHALL BE BASED UPON THEIR OWN INVESTIGATIONS. THE OWNER AND ENGINEER SHALL NOT BE HELD RESPONSIBLE FOR VARIATIONS FOUND TO EXIST BETWEEN THE ATTACHED DATA ABOVE REFERRED TO AND ACTUAL FIELD CONDITIONS THAT DEVELOP THROUGH THE PERIOD OF CONSTRUCTION.
B. WHERE EXISTING OWNER AND ENGINEER ASSUME NO RESPONSIBILITY FOR CORRECTNESS OF EXISTING CONDITIONS INDICATED, THE CONTRACTOR SHALL ASCERTAIN EXACT LOCATIONS OF UTILITIES AND SUBSTRUCTURES THAT MAY BE AFFECTED BY THIS PROJECT, AND SHALL BE RESPONSIBLE FOR ANY DAMAGE OR INJURY THAT MAY RESULT FROM WORKING ON OR NEAR THOSE UTILITIES, SUBSTRUCTURES WHICH ARE NOT TO BE REMOVED OR DEMOLISHED.
C. THE CONTRACTOR SHALL MAKE HIS OWN DEDUCTIONS OF THE SUBSURFACE CONDITIONS WHICH MAY AFFECT METHODS OR COST OF CONSTRUCTION AND HE AGREES THAT HE WILL MAKE NO CLAIM FOR DAMAGES OR OTHER COMPENSATION, EXCEPT SUCH AS ARE PROVIDED FOR IN THE AGREEMENT, SHOULD HE FIND CONDITIONS DURING THE PROGRESS OF THE WORK DIFFERENT FROM THOSE AS CALCULATED OR ANTICIPATED BY HIM.

1.04 BENCH MARKS AND MONUMENTS
A. MAINTAIN CAREFULLY EXISTING BENCH MARKS, MONUMENTS, AND OTHER REFERENCE POINTS, IF DISTURBED OR DESTROYED, REPLACE AS DIRECTED.
1.05 JOB CONDITIONS
A. CONDITION OF PREMISES: ACCEPT SITE AS FOUND AND EXCAVATE, FILL, COMPACT, AND BACKFILL SITE AS HEREAFTER SPECIFIED.
B. PROTECTION OF EXISTING STRUCTURES AND PROPERTY: TAKE PRECAUTIONS TO GUARD AGAINST MOVEMENT OR SETTLEMENT OF ADJACENT STRUCTURES AND FACILITIES. PROMOTE AND PLACE BRACKING OR SHORING OR SHIELDING OR EQUIPMENT IN CONNECTION WITH THE WORK. THE CONTRACTOR SHALL BE RESPONSIBLE FOR SAFETY AND SUPPORT OF SUCH STRUCTURES; BE LIABLE FOR ANY MOVEMENT OR SETTLEMENT, ANY DAMAGE OR INJURY CAUSED THEREBY OR RESULTING THEREFROM, IF AT ANY TIME THE SAFETY OF ANY ADJACENT STRUCTURE OR PROPERTY IS ENDANGERED BY SUCH OPERATION. TAKE PRECAUTIONS TO SUPPORT SUCH STRUCTURES AND NOTIFY THE OWNER. RESUME OPERATIONS ONLY AFTER PERMISSION HAS BEEN GRANTED BY THE OWNER.
2. SIDEWALKS AND STREETS: TAKE PRECAUTIONS TO GUARD AGAINST MOVEMENT, SETTLEMENT OR COLLAPSE OF ANY SIDEWALKS, CURBS OR STREET PASSAGES ON ADJOINING SITE; BE LIABLE FOR ANY SUCH MOVEMENT, SETTLEMENT OR COLLAPSE; REPAIR OR REPLACE AS DIRECTED. TAKE PRECAUTIONS TO GUARD AGAINST SUCH SHORING, INCLUDING SHEET PILING, AS MAY BE REQUIRED DURING EXCAVATION, TO PROTECT BANKS, ADJACENT PAVING, STRUCTURES AND UTILITIES.
3. RESPONSIBILITY: BE RESPONSIBLE FOR ANY DAMAGE TO EXISTING STRUCTURES OR TO EQUIPMENT AND FURNISHINGS HOUSED THEREIN WHICH ARE DUE DIRECTLY OR INDIRECTLY TO CONSTRUCTION OPERATIONS. EXCEPT WHERE REMOVAL IS NECESSITATED BY SITE GRADING OR LOCATION OF NEW BUILDING, USE EVERY POSSIBLE PRECAUTION TO PREVENT INJURY TO EXISTING SIDEWALKS, DRIVES, CURBS, AND WALKS ON OR ADJACENT TO SITE OF THE WORK AND REPLACE, AT NO EXPENSE TO OWNER, ANY OF SUCH THAT ARE DESTROYED.

2.01 EXCAVATION
I. GENERAL
A. ACCOMPLISH IN A MANNER THAT PROVIDES FOR THE SAFETY OF THE PUBLIC AND WORKMEN AND PROVIDE FOR THE PROTECTION OF ALL PROPERTY.
B. CONSTRUCTION: DO NOT CLOSE, DESTROY OR STORE MATERIAL OR EQUIPMENT IN LOCAL SIDEWALKS, ALLEYS OR PASSAGEWAYS WITHOUT A PERMIT IN ACCORDANCE WITH LOCAL ORDINANCES, REGULATIONS, AND CODES.
C. INTERFERENCE: CONDUCT OPERATIONS WITH MINIMUM INTERFERENCE WITH ROADS, SIDEWALKS, DRIVEWAYS, AND ALLEYS.
D. PNEUMATIC TOOLS: WORK WITH PNEUMATIC OR VIBRATORY TOOLS WILL BE PERMITTED ONLY IN A MANNER WHICH CAUSES NO RELATED DAMAGES.
E. REMOVAL: UNLESS OTHERWISE NOTED OR SPECIFIED BY THE CONTRACTOR AND ARE BE REMOVED COMPLETELY AWAY FROM THE SITE BY HIM. DO NOT STORE OR PERMIT DEBRIS TO ACCUMULATE ON THE SITE.
F. TEMPORARY STRUCTURES: REMOVE ALL TEMPORARY STRUCTURES WHEN THEY ARE NO LONGER REQUIRED.
G. REPAIR: CLEAN UP, REPAIR OR REPLACE AT NO COST TO OWNER ALL PROPERTY DAMAGED BY REASON OF REQUIRED WORK. ALL PATCH WORK SHALL MATCH EXISTING AND BE PERFORMED IN A NEAT AND WORKMANLIKE MANNER. WORKMEN SKILLED IN THE TRADE INVOLVED, IN NEWLY GRADED AREAS TAKE EVERY PRECAUTION AND TEMPORARY MEASURE NECESSARY TO PREVENT DAMAGE FROM EROSION OF FRESHLY GRADED AREAS; WEATHER PROTECTION OF EXCAVATIONS TO BE MADE AT THE ACCEPTANCE OF THE WORK, REPAIR AND RE-ESTABLISH GRADES TO THE REQUIRED ELEVATIONS AND SLOPES AT NO ADDITIONAL COST TO THE OWNER. THIS APPLIES TO DAMAGE TO THE NEWLY GRADED AREAS WITHIN THE CONSTRUCTION LIMITS AND DAMAGE TO ADJACENT PROPERTIES BY EROD MATERIAL.

2.02 LOCATIONS AND ELEVATIONS
A. CONTRACTOR SHALL BE RESPONSIBLE FOR ALL SURVEYS, MEASUREMENTS AND LAYOUTS REQUIRED FOR PROPER EXECUTION OF THE WORK, AS SHOWN ON DRAWINGS.
2.03 CLEARING AND GRUBBING
A. WITHIN LIMITS OF AREAS DESIGNATED FOR GRADING AND SITE CONSTRUCTION WORK, REMOVE TREES, BRUSH, STUMPS, LIMBS AND OTHER DELETERIOUS MATERIALS NOT REQUIRED TO REMAIN AS PART OF THE FINISHED WORK.
B. REMOVE ALL GRASS, PLANTS, VEGETATION AND ORGANIC MATERIAL FROM SAME AREA.
2.04 SLOPING
A. STRIP ALL TOPSOIL, ORGANIC MATERIAL, SURFACE LITTER, RUBBLE, AND OVERBURDEN FOR ENTIRE DEPTH OF ROOT SYSTEM OF GRASS OR OTHER VEGETATION OVER THE LIMITS OF CONSTRUCTION.
B. STOCKPILE TOPSOIL ON SITE WHERE DIRECTED.
2.05 EXCAVATION
A. BEGIN EXCAVATION AFTER STRIPPING, CLEARING AND GRUBBING WHERE APPLICABLE, HAS BEEN COMPLETED.
B. EXCAVATE TO GRADES REQUIRED TO ACCOMMODATE THE PROPOSED CONSTRUCTION: DE-WATER AS NEEDED.
C. REMOVE UNSATISFACTORY MATERIALS ENCOUNTERED FROM THE BUILDING AREAS, AND OTHER NON-LANDSCAPED AREAS.
D. EXCAVATE IN SUCH A MANNER THAT QUICK AND EFFICIENT DRAINAGE OF STORMWATER WILL BE AFFECTED.
E. CLASSIFY EXCAVATED MATERIALS AND STOCKPILE SEPARATELY SUITABLE SOILS FOR USE AS BACKFILL MATERIALS. IF SUFFICIENT QUANTITIES OF EXCAVATED MATERIALS MEETING THESE REQUIREMENTS ARE NOT AVAILABLE ON-SITE, PROVIDE MATERIALS MEETING THESE REQUIREMENTS.
F. STOCKPILE EXCAVATED MATERIAL SUITABLE FOR USE AS FILL AND BACKFILL.

2.06 FILLING, BACKFILLING, AND COMPACTION OF EXISTING EARTH (EXCLUDES ROCK), SURFACES AFTER EXCAVATION, FILLING AND COMPACTION OF SAND AREA TO LEVELS REQUIRED WITH SUITABLE BACKFILL MATERIAL.
A. MATERIALS: SATISFACTORY FILL MATERIALS: AASHTO CLASSIFICATION A-3 OR BETTER, SHALL BE USED IN FILLS AND BACKFILLS.
B. FILLING AND BACKFILLING: PLACE SATISFACTORY FILL MATERIAL IN HORIZONTAL LAYERS NOT EXCEEDING SIX (6) INCHES IN LOOSE DEPTH. CONTACT AS SPECIFIED HEREIN. NO MATERIAL SHALL BE USED OR PLACED THAT IS MUDDY.
C. COMPACTION: COMPACTION SHALL BE WITH EQUIPMENT SUITED TO SOIL BEING COMPACTED. MOISTEN OR AERATE MATERIAL, AS NECESSARY, TO PROVIDE MOISTURE CONTENT THAT WILL FACILITATE FACILITATE AASHTO CLASSIFICATION A-3 OR BETTER. IMPACT USED. IMPACT EACH LAYER TO NOT LESS THAN PERCENTAGE OF MAXIMUM DENSITY SPECIFIED BELOW, DETERMINED IN ACCORDANCE WITH AASHTO T-180. INSURE THAT THE COMPACTION OF PREVIOUSLY PREPARED FILL AREAS HAS BEEN MAINTAINED PRIOR TO PLACING NEW LAYERS.
D. RECONSTRUCTION OF SUBGRADE: WHERE APPROVED COMPACTED SUBGRADES ARE DISTURBED BY THE CONTRACTOR'S SUBSEQUENT OPERATIONS OR ADVERSE WEATHER, SUBGRADE SHALL BE SCARRED AND COMPACTED AS SPECIFIED HEREBEFORE TO REQUIRED DENSITY PRIOR TO FURTHER CONSTRUCTION THEREON. THE CONTRACTOR OVER UNDERGROUND UTILITIES SHALL BE BY POWER-DRIVEN HAND TAMPERS.
F. COMPACTION REQUIREMENTS:
1. FILL UNDER LAWS AND PLANTED AREAS: 95%
2. BELOW SLABS ON GRADE AND CONCRETE WALKS: 95%
3. UNDER PAVING AND PARKING AREAS: 95%

2-07 TESTING
A. THE CONTRACTOR WILL PROVIDE THE SERVICES OF A TESTING LABORATORY TO PERFORM SPECIFIED TESTS, INSPECTIONS, INSTRUMENTATION AND INSPECTION OF THE WORK.
B. TESTS OF MATERIALS SHALL BE AS FOLLOWS:
1. SOIL CLASSIFICATION: ONE TEST FROM EACH TYPE OF MATERIAL ENCOUNTERED AND/OR PROPOSED TO BE USED.
2. LABORATORY TESTS FOR MOISTURE-CONTENT AND DENSITY ACCORDING TO AASHTO T-180. ONE TEST FOR EACH MATERIAL ENCOUNTERED AND/OR PROPOSED TO BE USED.
3. FIELD TESTS FOR MOISTURE CONTENT AND DENSITY: ONE TEST PER LAYER OF FILL FOR 5,000 SQUARE FEET OF AREA.
C. ONE COPY OF ALL TEST REPORTS, SIGNED AND SEALED BY TESTING LABORATORY ARE TO BE PROVIDED TO THE ENGINEER.

SUBSURFACE INVESTIGATIONS
GENERAL
THE CONTRACTOR SHALL BECOME FAMILIAR WITH AND ADHERE TO THE SPECIFICATIONS AND STANDARDS OF THE UTILITY COMPANIES WHICH ARE SERVING THE PROJECT. THE CONTRACTOR SHALL BECOME FAMILIAR WITH AND COMPLY WITH ALL SITE DEVELOPMENT STANDARDS AND CODES OF THE REGULATORY AGENCIES SERVING THIS PROJECT. THE LATEST VERSION OF THE FLORIDA DEPARTMENT OF TRANSPORTATION ROAD AND BRIDGE CONSTRUCTION STANDARD SPECIFICATIONS, THE LATEST FLORIDA DEPARTMENT OF TRANSPORTATION ROADWAY AND TRAFFIC DESIGN STANDARDS SHALL BE INCLUDED WITHIN THE PROJECT SPECIFICATIONS, UNLESS OTHERWISE NOTED, EITHER ON THE PLANS OR WITHIN THE SPECIFICATIONS, THE APPLICABLE SECTIONS OF THE FLORIDA DEPARTMENT OF TRANSPORTATION ROADWAY AND TRAFFIC DESIGN STANDARDS SHALL APPLY INCLUDING REFERENCES THEREIN. THE GENERAL DESCRIPTION OF THE NATURE OF THE WORK SHALL BE SUFFICIENT CORRELATION TO THE FLORIDA DEPARTMENT OF TRANSPORTATION SPECIFICATIONS, EXACT ITEM DESCRIPTION IS NOT REQUIRED. IN THE EVENT THERE ARE CONFLICTS BETWEEN SPECIFICATIONS OR REQUIREMENTS, THE MOST RESTRICTIVE (CONSERVATIVE) SPECIFICATION OR REQUIREMENT SHALL BE USED.

POTABLE WATER DISTRIBUTION/WASTEWATER COLLECTION INSTALLATION
UNLESS OTHERWISE NOTED ON THE PLANS, THE STANDARDS AND SPECIFICATIONS OF THE ASSOCIATED UTILITY COMPANY SERVING THE PROJECT SITE SHALL BE ADHERED TO FOR ALL MATERIALS, INSTALLATION, TESTING, AND CERTIFICATION ACTIVITIES FOR ALL PUMP STATIONS, MAIN LINES, SERVICES, AND APPURTENANCES, IF STANDARDS AND SPECIFICATIONS ARE NOT AVAILABLE, THE CONTRACTOR SHALL CONFORM TO THE LATEST STANDARDS AND SPECIFICATIONS, OR ADOPTED BY LOCAL UTILITIES, LOCAL GOVERNMENTAL REGULATIONS, OR THE MANUFACTURER'S RECOMMENDED INSTALLATION PROCEDURES, WHICHEVER IS SPECIFICALLY THE MOST RESTRICTIVE.

STORMWATER PIPE INSTALLATION AND MISCELLANEOUS EXCAVATIONS
UNLESS OTHERWISE NOTED ON THE PLANS OR SPECIFICATIONS, THE CONTRACTOR SHALL PERFORM THE EXCAVATION, BEDDING, JOINTS, AND BACKFILL OPERATIONS IN ACCORDANCE WITH THE POTABLE WATER/WASTEWATER INSTALLATION SPECIFICATIONS, LOCAL GOVERNMENTAL REGULATIONS OR STANDARDS, F.D.O.T. STANDARDS AND SPECIFICATIONS, OR MANUFACTURER'S RECOMMENDED INSTALLATION PROCEDURES, WHICHEVER IS SPECIFICALLY THE MOST RESTRICTIVE.

UNSATISFACTORY MATERIALS
IF UNSATISFACTORY MATERIAL IS ENCOUNTERED WITHIN THE ROADWAY AREA AND/OR UTILITY AREAS IT SHALL BE REMOVED TO A DEPTH OF THREE (3) FEET BELOW THE SUB-BASE OR TRENCH BOTTOM AND SHALL BE BACKFILLED WITH A-3 MATERIAL OR BETTER WITH PLACEMENT AND COMPACTION METHODS IN ACCORDANCE WITH THE LATEST EDITION OF THE FLORIDA DEPARTMENT OF TRANSPORTATION STANDARD SPECIFICATIONS, OR AS OTHERWISE NOTED ON THE PLANS. UNSATISFACTORY MATERIALS SHALL BE REMOVED FROM THE SITE, UNLESS THE ENGINEER APPROVES USE WITHIN LANDSCAPED AREAS.

DE-WATERING
I. GENERAL
A. DE-WATERING CONSISTS OF PERFORMING ALL WORK NECESSARY TO REMOVE SURFACE WATER AND/OR CONTROL THE GROUND WATER LEVELS AND HYDROSTATIC PRESSURES IN ORDER TO PERMIT ALL EXCAVATION AND CONSTRUCTION UNDER THIS CONTRACT TO BE PERFORMED IN THE DRY.
B. WORK OF THIS SECTION INCLUDES INSTALLATION, OPERATIONS, MAINTENANCE, SUPERVISION, SUPPLY, DISMANTLING, AND REMOVAL FROM THE SITE OF THE DE-WATERING EQUIPMENT.
C. THE CONTRACTOR MUST FAMILIARIZE HIMSELF WITH THE POTENTIAL FOR EXCESSIVE SPALLS, THE GROUND CONDITIONS, AND THE GROUND WATER CONDITIONS. GROUND WATER ELEVATION CAN FLUCTUATE. IT IS ACCEPTED THAT ANY EXCAVATIONS MAY ENCOUNTER THE GROUND WATER TABLE.
D. DRAINAGE OF THE SITE: AT ALL TIMES THE CONTRACTOR SHALL MAINTAIN AND OPERATE ADEQUATE SURFACE AND SUBSURFACE DRAINAGE METHODS IN ORDER TO KEEP THE CONSTRUCTION SITE DRY AND IN SUCH A CONDITION THAT PLACEMENT AND COMPACTION OF FILL MAY PROCEED UNHINDERED BY SATURATION OF THE AREA.
DURING CONSTRUCTION, THE SURFACE OF THE BACKFILL AREA SHALL BE LEFT IN PLACE TO PREVENT PRECIPITATION AND/OR SURFACE WATER WILL RUN OFF WITHOUT PONDING.

1.01 METHOD
A. THE CONTROL OF ALL SURFACE AND SUBSURFACE WATER IS PART OF THE DE-WATERING REQUIREMENTS. MAINTAIN ADEQUATE CONTROL SO THAT THE STABILITY OF EXCAVATED AND CONSTRUCTION SLOPES IS NOT ADVERSELY AFFECTED BY WATER, THAT EROSION IS CONTROLLED, AND THE FLOODING OF EXCAVATIONS OR DAMAGE TO STRUCTURES DOES NOT OCCUR. REMOVE SURFACE WATER AWAY FROM THE EXCAVATION.
B. DISPOSE OF ALL WATER REMOVED FROM THE EXCAVATION IN A MANNER THAT WILL NOT ENDANGER PUBLIC HEALTH, PROPERTY, OR PORTIONS OF THE WORK UNDER CONSTRUCTION OR COMPLETED. DISPOSE OF WATER IN A MANNER THAT WILL CAUSE NO INCONVENIENCE AND INTERFERENCE TO THE OPERATIONS OF OTHERS ENGAGED IN WORK AT THE SITE.
C. DISPOSE OF WATER RESULTING FROM DE-WATERING OPERATIONS IN ACCORDANCE WITH CITY, COUNTY, STATE AND FEDERAL REGULATIONS.
D. CONTACT OPERATIONS TO PREVENT WATER RUNOFF. SEDIMENT IS NOT DISCHARGED TO THE ADJACENT WATER BODIES, SEWERS, STREETS AND ADJACENT PROPERTIES.
E. DE-WATERING SYSTEM SHALL BE SO DESIGNED AS TO PREVENT REMOVAL OF SOIL FINES FROM THE SITE DURING THE DE-WATERING OPERATION.






PORTLAND CEMENT CONCRETE PAVING
1.01 QUALITY ASSURANCE
A. COMPLY WITH ALL STANDARDS "RECOMMENDED PRACTICES FOR CONSTRUCTION OF CONCRETE PAVEMENTS AND CONCRETE BASES" (AC308, LATEST EDITION).
1.02 REFERENCE STANDARDS
A. THE FOLLOWING REFERENCE STANDARDS OF THE ISSUES LISTED BELOW, BUT REFERRED TO BY BASIC DESIGNATION ONLY, FORM A PART OF THIS SPECIFICATION TO THE EXTENT INDICATED BY THE REFERENCES THEREIN:
1. AMERICAN SOCIETY FOR TESTING AND MATERIALS (ASTM)
2. AMERICAN ASSOCIATION OF STATE HIGHWAY AND TRANSPORTATION OFFICIALS (AASHTO) STANDARD
3. FLORIDA DEPARTMENT OF TRANSPORTATION (FDOT) 1888 STANDARDS AND SPECIFICATIONS FOR ROAD AND BRIDGE CONSTRUCTION
4. SECTION 350 - SEMENT CONCRETE PAVEMENT
5. T-180 MOISTURE-DENSITY RELATIONS OF SOILS
1.03 SUBMITTALS
A. THE CONTRACTOR SHALL SUBMIT TWO COPIES OF TEST REPORTS PREPARED BY AN INDEPENDENT TESTING LABORATORY AND CERTIFIED BY A PROFESSIONAL ENGINEER REGISTERED TO PRACTICE IN THE STATE OF FLORIDA. THESE REPORTS SHALL INDICATE ALL TESTS PERFORMED AND SHALL INCLUDE A CERTIFICATION STATEMENT OF COMPLIANCE WITH THE PROJECT SPECIFICATIONS. TESTS SHALL BE PERFORMED AS SPECIFIED UNDER THIS SECTION.
1. SUBMIT FOR REVIEW THE FOLLOWING:
A. CONCRETE DESIGN MIX AND PROVING FLEXURAL STRENGTH
B. EXPANSION JOINT FILLER DATA
C. JOINT SEALER DATA
D. PROPOSED PAVING CONSTRUCTION PLAN WHICH SHALL SHOW THE CONCRETE PAVING JOINT TYPES AND LOCATIONS AND SHALL INCLUDE A STATEMENT OF PROPOSED SEQUENCE AND SCHEDULE OF PAVING OPERATIONS
E. CONCRETE TESTS
F. RESULTS OF FIELD TESTS OF LBR AND COMPACTION OF STABILIZED SUBGRADE
1.04 MATERIALS
A. STABILIZED SUBGRADE: PROVIDE 12 INCH STABILIZED SUBGRADE (LBR 40 W) COMPACTED TO A MINIMUM DENSITY OF 98% AS DETERMINED BY AASHTO T-180
B. CONCRETE: CONCRETE FOR CONCRETE PAVEMENT SHALL HAVE A COMPRESSIVE STRENGTH OF 3000 PSI AT 28 DAYS. A SLUMP RANGE BETWEEN 2 TO 4 INCHES AND A 28-DAY MODULUS OF RUPTURE OF 850 PSI AS DETERMINED BY THE REQUIREMENTS OF PARAGRAPH TESTING SPECIFIED HEREAFTER.
C. JOINT SEALER: JOINT SEALING SHALL CONFORM TO FEDERAL SPECIFICATIONS SS-51401 OR SS-51402 (COG APPLIED).
D. PRE-MOLDED EXPANSION JOINT FILLER: PRE-MOLDED EXPANSION JOINT FILLER SHALL CONFORM TO ASTM D1751-73.
1.05 EXECUTION
A. COMPLY WITH ACI STANDARD 318-74 AND SECTION 350, FOOT STANDARDS AND SPECIFICATIONS, UNLESS OTHERWISE SPECIFIED HEREIN.
B. FINAL GRADING: ALL CONCRETE PAVEMENT SHALL HAVE A MAXIMUM DEVIATION OF 1/8 INCH (+/-) FROM THE SPECIFIED SURFACE PLANE AND PLAN GRADING. THE SURFACE FINISH SHALL BE IN ACCORDANCE WITH THE OWNER'S REPRESENTATIVE. IN GENERAL, THE TEXTURE IS OF A MEDIUM BROOM FINISH AFTER FLOATING.

JOINTS
1. CONSTRUCTION JOINTS INDICATED ON DRAWINGS, OR AS REQUIRED, SHALL BE PLACED PERPENDICULAR TO THE FINISH GRADE OF THE CONCRETE. JOINTS SHALL BE CUT TO A DEPTH OF 1/4 OF THE SLAB THICKNESS BY CUTTING WITH A CONSTRUCTION TO THE NEXT.
2. MATERIALS SHALL BE AS FOLLOWS:
A. SOIL CLASSIFICATION: ONE TEST FROM EACH TYPE OF MATERIAL ENCOUNTERED AND/OR PROPOSED TO BE USED.
B. LABORATORY TESTS FOR MOISTURE-CONTENT AND DENSITY ACCORDING TO AASHTO T-180. ONE TEST FOR EACH MATERIAL ENCOUNTERED AND/OR PROPOSED TO BE USED.
C. FIELD TESTS FOR MOISTURE CONTENT AND DENSITY: ONE TEST PER LAYER OF FILL FOR 5,000 SQUARE FEET OF AREA.
D. ONE COPY OF ALL TEST REPORTS, SIGNED AND SEALED BY TESTING LABORATORY ARE TO BE PROVIDED TO THE ENGINEER.
3. EXPANSION JOINTS SHALL BE PLACED WHERE INDICATED ON DRAWINGS, OR AS REQUIRED USING 1/2 INCH DEEP PRE-CAST EXPANSION JOINT FILLER. ANCHOR WITH APPROVED DEVICES TO PREVENT DISPLACEMENT DURING PLACEMENT AND FINISHING. EDGES SHALL BE ROUNDED WITH AN EDGING TOOL. JOINTS SHALL BE FULL DEPTH OF CONCRETE EXCEPT THAT TOP EDGES SHALL BE 1/2 INCH BELOW THE FINISH CONCRETE SURFACE. EXPANSION JOINTS SHALL BE SEALED TO THE SURFACE BY FILING WITH JOINT SEALING COMPOUND. JOINTS SHALL BE CLEAN AND DRY BEFORE SEALING COMPOUND IS PUT IN PLACE.
4. CONSTRUCTION JOINTS ARE TO BE USED AT CONSTRUCTION JOINT LOCATIONS TO STOP CONCRETE POURS.
5. CURING: CONCRETE SHALL BE CURED BY PROTECTING IT AGAINST LOSS OF MOISTURE AND MECHANICAL INJURY FOR AT LEAST THREE DAYS AFTER PLACEMENT. A PREMOISTENED CURING MEMBRANE SHALL BE APPLIED IMMEDIATELY AFTER FINISHING. OPERATION AT THE RATE OF ONE GALLON TO NOT MORE THAN 200 SQUARE FEET. CLEANING AND SEALING JOINTS: JOINTS SHALL BE FILLED WITH JOINT SEALING MATERIAL NO LESS THAN 8 HOURS AND WITHIN 2 WEEKS AFTER JOINTS ARE CUT. PRIOR TO SEALING, EACH JOINT SHALL BE THOROUGHLY CLEANED OF ALL FOREIGN MATERIAL INCLUDING ANY MEMBRANE CURING COMPOUND.
6. CONSTRUCTION JOINTS AND FIELD TESTING SHALL BE AT THE CONTRACTOR'S EXPENSE. IN ADDITION, ALL RETESTING SHALL BE DONE AT CONTRACTOR'S EXPENSE.
7. DESIGN MIXES AND TESTING REQUIREMENTS FOR THE CONCRETE PAVEMENT SHALL BE AS FOLLOWS:
A. SUBMIT FOR REVIEW THE FOLLOWING:
1. SLUMP, MODULUS OF RUPTURE AND 7- AND 28-DAY COMPRESSIVE STRENGTH TESTS SHALL BE PERFORMED ON SAMPLES TAKEN AT THE SITE AT A FREQUENCY OF TWO PER 10,000 SF.
2. WHERE THE FLEXURAL STRENGTH OF THE CONCRETE IS SPECIFIED, MAKE ONE STRENGTH TEST AND ONE FLEXURAL TEST FOLLOWING ASTM C192 AND ASTM C78 FOR EACH 100 CUBIC YARDS OR FRACTION THEREOF PLACED PER DAY.
B. MAINTAIN RECORDS OF TESTING AND CERTIFICATION ACTIVITIES FOR ALL FLEXURAL TEST, TEST ONE AT THREE DAYS, ONE AT SEVEN DAYS AND ONE AT 28 DAYS.

PAVEMENT MARKING
1.01 QUALITY ASSURANCE
A. WORK SHALL BE PERFORMED IN ACCORDANCE WITH THE CONTRACT DOCUMENTS IN A MANNER THAT WILL PROVIDE THE MOST DURABLE AND LONGEST LASTING PAVEMENT.
B. ALL EQUIPMENT SHALL BE OF A TYPE AND DESIGN WHICH WILL READILY OBTAIN THE REQUIRED UNIFORMITY OF APPLICATION OF THE PAVEMENT MARKINGS BOTH AS TO THICKNESS OF COATING AND AS TO ALIGNMENT.
1.02 EXECUTION
A. THE FOLLOWING PUBLICATIONS OF THE ISSUE LISTED BELOW, BUT REFERRED TO HEREAFTER BY BASIC DESIGNATION ONLY, FORM A PART OF THIS SPECIFICATION TO THE EXTENT INDICATED BY THE REFERENCES THEREIN:
1. FDOT STANDARD SPECIFICATIONS FOR ROAD AND BRIDGE CONSTRUCTION, LATEST EDITION.
2. MANUAL ON UNIFORM TRAFFIC CONTROL DEVICES (MUTCD) FOR STREETS AND HIGHWAYS AS PREPARED BY THE U.S. DEPARTMENT OF TRANSPORTATION, FEDERAL HIGHWAY ADMINISTRATION, LATEST EDITION.
1.03 SUBMITTALS
A. PRELIMINARY TESTS, AS SPECIFIED IN SECTION 971 OF THE FOOT SPECIFICATIONS AND AS APPLICABLE TO HEREAFTER SPECIFIED MATERIAL.
1.04 MATERIALS AND COLORS
A. THERMOPLASTIC: IN ACCORDANCE WITH REQUIREMENTS AS SPECIFIED IN SECTION 971 OF THE FOOT SPECIFICATIONS.
B. PAINT: IN ACCORDANCE WITH REQUIREMENTS AS SPECIFIED IN SECTION 971-12, CODE T-2 OF THE FOOT SPECIFICATIONS, LATEX PAINT ONLY.
C. COLOR: YELLOW AND WHITE PER FOOT, OR AS INDICATED ON THE DRAWINGS.
1.05 EXECUTION
A. TIME OF APPLICATION: PAINTING SHALL BE DONE ONLY DURING DAYLIGHT HOURS AND, AS FAR AS PRACTICAL, SHALL BE TERMINATED IN TIME TO PERMIT PROPER CURE.
B. WEATHER LIMITATIONS: NO PAINT SHALL BE APPLIED WHEN ANY MOISTURE IS PRESENT ON THE SURFACE TO BE PAINTED OR WHEN THE AIR TEMPERATURE IS BELOW 40 DEGREES FAHRENHEIT. PAINTING SHALL NOT BE DONE WHEN WINDS ARE SUFFICIENT TO CAUSE SPRAY DUST.
C. PREPARATION OF SURFACE TO BE PAINTED: THE SURFACE WHICH IS TO BE PAINTED SHALL BE CLEANED, BY COMPRESSED AIR OR OTHER EFFECTIVE MEANS, IMMEDIATELY BEFORE THE START OF PAINTING AND SHALL BE CLEAN AND DRY WHEN THE PAINT IS APPLIED. ANY VEGETATION OR LOOSE SOILS SHALL BE REMOVED FROM THE PAVED OR STRIPING IS BEGUN.
D. MIXING PAINT: THE PAINT SHALL BE THOROUGHLY MIXED BEFORE IT IS Poured INTO THE PAINTING MACHINE. THE PAINT SHALL BE PAINTED AT EACH DENSITY TEST LOCATION. A PROFESSIONAL ENGINEER'S CERTIFICATION OF COMPLIANCE SHALL BE PROVIDED BY THE TESTING LAB.
E. RATE OF PAINT APPLICATION: THE MINIMUM RATE OF APPLICATION FOR PAINT SHALL BE AS FOLLOWS:
1. FOUR INCH SOLID: 20 GALLONS PER MILE.
2. HANDICAP LOGS: IN CONFORMANCE TO THE REQUIREMENTS OF THIS SECTION SHALL BE AS FOLLOWS:
3. ANY OTHER WIDTH STRIPE OR MARKINGS: A DIRECT PROPORTION OF THE ABOVE ITEM 1.
G. REQUIRED FILM THICKNESS: THE MINIMUM WET FILM THICKNESS FOR ALL PAINTED AREAS SHALL BE 15 MILS.
H. ALIGNMENT OF STRIPES: WHERE A STRIPE DEVIATES FROM THE CORRECT ALIGNMENT, AS INDICATED BY THE STRING LINE, BY MORE THAN ONE INCH IN ANY 20 FOOT LENGTH, IT SHALL BE ORIGINATED AND THE STRIPE CORRECTED HEREAFTER AS SPECIFIED IN SECTION 1.06 "CORRECTIVE MEASURES".
1.06 PROTECTION OF PAINTED MARKINGS
A. PROTECTION OF STRIPES: ALL NEWLY PAINTED STRIPES, OR OTHER MARKINGS, SHALL BE PROTECTED UNTIL THE PAINT IS SUFFICIENTLY DRY TO PERMIT VEHICLES TO CROSS THE MARKING WITHOUT DAMAGE FROM THE TIRES.
B. REPAIR OF DAMAGED AREAS: ANY PORTIONS OF THE STRIPES DAMAGED BY PASSING TRAFFIC OR FROM ANY OTHER CAUSE, SHALL BE REPAINTED AT THE CONTRACTOR'S EXPENSE.
1.07 DIMENSION AND ALIGNMENT TOLERANCE
A. DIMENSIONS: NO MARKING SHALL BE LESS THAN THE SPECIFIED WIDTH, NO MARKINGS SHALL EXCEED THE SPECIFIED WIDTH BY MORE THAN ONE-HALF INCH. ALIGNMENT TOLERANCES SHALL BE AS SPECIFIED IN PARAGRAPH 1.08 (a).
B. CORRECTION RATES: ANY CORRECTIONS OF VARIATION IN THE WIDTH OF OR IN THE ALIGNMENT OF STRIPES SHALL NOT BE MADE ABRUPTLY BUT THE STRIPES SHALL BE RETURNED TO THE DESIGN WIDTH AT THE RATE OF AT LEAST 10 FEET FOR EACH 1/2 INCH OF CORRECTION.
1.08 CORRECTIVE MEASURES
A. ALL PAINTED MARKINGS WHICH FAIL TO MEET THE SPECIFICATIONS, INCLUDING THE PERMISSIBLE TOLERANCES AND THE APPEARANCE REQUIREMENTS, OR ARE MARKED OR DAMAGED BY TRAFFIC OR FROM OTHER CAUSES, SHALL BE CORRECTED AT THE CONTRACTOR'S EXPENSE. ALL DIRT AND SPATTERED PAINT SHALL BE REMOVED. WHENEVER IT IS NECESSARY TO REMOVE PAINT, IT SHALL BE DONE BY MEANS WHICH WILL NOT DAMAGE THE SURFACE OF THE PAVEMENT. WHEN NECESSARY TO CORRECT A DEVIATION WHICH EXCEEDS THE PERMISSIBLE TOLERANCE IN ALIGNMENT, THAT PORTION OF THE STRIPE AFFECTED SHALL BE REMOVED AND REPAINTED IN ACCORDANCE WITH THESE SPECIFICATIONS.
B. CORRECTIONS OF STRIPES: CORRECTIONS OF STRIPES, ETC., SHALL BE CORRECTED BY CHEMICAL AGENTS, OR BY ANY OTHER TYPE OF MECHANICAL DEVICE, WHICH WILL EFFECTIVELY REMOVE THE PAINT WITHOUT DAMAGE TO THE PAVEMENT SURFACE. RESULTS WHICH WILL PREVENT THE RE-APPLICATION OF MARKINGS.
1.09 SCARF PAINT
A. PROVIDE THE OWNER WITH A MINIMUM OF FIVE (5) GALLONS OF TRAFFIC PAINT FROM THE SAME BATCH USED IN APPLICATION OF PAVEMENT MARKINGS. ALSO PROVIDE PAINT CERTIFICATIONS AND THE MANUFACTURER'S IDENTIFICATION NUMBER OF THE PAINT USED.
1.10 MARKING TYPE
A. ANY PAVEMENT MARKINGS LOCATED WITHIN PUBLIC RIGHTS-OF-WAY SHALL BE PAINT UNLESS OTHERWISE INDICATED.
B. ANY PAVEMENT MARKINGS LOCATED ON-SITE SHALL BE PAINT UNLESS OTHERWISE INDICATED.

CONSTRUCTION TOLERANCES
THE FOLLOWING ARE THE ALLOWABLE DEVIATIONS FROM PROJECT DESIGN GRADES AND GRADIENTS. THE CONTRACTOR SHALL BE RESPONSIBLE TO CONFIRM AND DOCUMENT COMPLIANCE WITH THESE TOLERANCES PRIOR TO PROCEEDING FROM ONE PHASE OF CONSTRUCTION TO THE NEXT.
I. STORMWATER MANAGEMENT/DRAINAGE FACILITIES
A. PERIMETER CONTAINMENT BERM:
MINIMUM ELEVATION = DESIGN GRADE
MAXIMUM ELEVATION = DESIGN GRADE + 0.10 FOOT
B. WATER CONTROL STRUCTURE:
1. MINIMUM GRADE ELEVATION = DESIGN GRADE
MAXIMUM GRADE ELEVATION = DESIGN GRADE + 0.10 FOOT
2. MINIMUM CREST ELEVATION = DESIGN GRADE
MAXIMUM CREST ELEVATION = DESIGN GRADE + 0.05 FOOT
3. MINIMUM BLEEDER ELEVATION = DESIGN GRADE
MAXIMUM BLEEDER ELEVATION = DESIGN GRADE + 0.05 FOOT
4. MAXIMUM TOP OF FILTER ELEVATION = DESIGN GRADE + 0.05 FOOT
C. CATCH BASINS/INLETS/PIPE INVERTS:
1. MINIMUM ELEVATION = DESIGN GRADE + 0.05 FOOT
MAXIMUM ELEVATION = DESIGN GRADE + 0.05 FOOT
2. SWALE GRADIENTS:
1. MINIMUM ELEVATION = DESIGN GRADE - 0.10 FOOT
MAXIMUM ELEVATION = DESIGN GRADE + 0.10 FOOT
2. MINIMUM FLOWLINE GRADIENT = 90% OF DESIGN GRADIENT
D. PAVEMENT GRADIENTS:
1. MINIMUM ELEVATION = DESIGN GRADE - 0.10 FOOT
MAXIMUM ELEVATION = DESIGN GRADE + 0.10 FOOT
2. FLEXIBLE PAVEMENT GRADIENT = 90% OF DESIGN GRADIENT (OR ANGULARITY)
3. RIGID (CONCRETE) PAVEMENT GRADE:
MINIMUM ELEVATION = DESIGN GRADE - 0.05 FOOT
MAXIMUM ELEVATION = DESIGN GRADE + 0.05 FOOT
4. RIGID PAVEMENT GRADIENTS:
A) MINIMUM GRADIENTS = 90% OF DESIGN GRADIENT (OR ANGULARITY)
B) MAXIMUM GRADIENTS = 90% OF DESIGN GRADIENT (OR ANGULARITY)
C) GRADIENT UNLESS OTHERWISE SPECIFIED BY LOCAL CODES
II. STORMWATER MANAGEMENT/DRAINAGE FACILITIES
UNLESS OTHERWISE SPECIFIED BY THE LOCAL UTILITY COMPANIES, THE FOLLOWING ARE THE ALLOWABLE TOLERANCES FOR THESE ACTIVITIES:
A. MANHOLES AND PIPE INVERTS:
1. MINIMUM ELEVATION = DESIGN GRADE - 0.05 FOOT
MAXIMUM ELEVATION = DESIGN GRADE + 0.05 FOOT
2. MINIMUM LINE GRADIENT = 90% OF DESIGN GRADIENT
B. ALIGNMENT/LOCATION OF APPURTENANCES:
AS ALLOWED BY THE APPLICABLE UTILITY AND/OR LOCAL GOVERNMENTAL REGULATIONS, THE CONTRACTOR SHALL CONFORM AND DOCUMENT THIS PRIOR TO CONSTRUCTION.

TESTING
THE CONTRACTOR SHALL BE RESPONSIBLE FOR SCHEDULING, COORDINATING, DOCUMENTING, AND PROVIDING THE FOLLOWING MINIMUM TESTING:
WATER DISTRIBUTION-UNLESS OTHERWISE SPECIFIED BY THE UTILITY COMPANY, THE LINES SHALL BE PRESSURE TESTED TO THE RATING OF THE PIPE. THE LINES SHALL BE TESTED IN SECTIONS BETWEEN MANHOLES, BACKFLOW PREVENTERS, AND VALVES. TESTS SHALL BE TAKEN AT ALL BRANCH LINE TERMINATION POINTS OR CONNECTION POINTS, AND ALONG THE MAIN LINES AT DISTANCES NOT TO EXCEED 2,640 FEET. ALL HYDRANTS AND VALVES SHALL BE OPERATED TO TEST PERFORMANCE. DEPENDING UPON WATER TABLE CONDITIONS DETERMINED BY THE ENGINEER, THE GRAVITY LINES SHALL BE TESTED FOR EITHER INFILTRATION OR EXFILTRATION AND INFLOW. THERE SHALL BE NO INFILTRATION, EXFILTRATION OR INFLOW ALLOWED. THE CONTRACTOR SHALL SEAL ANY PIPE, FITTING OR MANHOLE AS REQUIRED. THE CONTRACTOR SHALL PROVIDE A VIDEO TAPE OF ALL MAIN GRAVITY LINES ALONG WITH A LOG OF LATERAL LOCATIONS. ALL ELECTRICAL AND MECHANICAL DEVICES AT LIFT STATIONS SHALL BE TESTED TO VERIFY PROPER OPERATION. THE CONTRACTOR SHALL PROVIDE STRUCTURE MAINTENANCE MANUALS TO THE OWNER. THE CONTRACTOR SHALL PROVIDE A MINIMUM OF 36 HOURS NOTICE TO THE ENGINEER OF RECORD PRIOR TO TESTING.
WASTEWATER COLLECTION-UNLESS OTHERWISE SPECIFIED BY THE UTILITY COMPANY, THE FORCE MAIN SHALL BE PRESSURE TESTED TO THE RATING OF THE PIPE. VALVES SHALL BE OPERATED TO TEST PERFORMANCE. DEPENDING UPON WATER TABLE CONDITIONS DETERMINED BY THE ENGINEER, THE GRAVITY LINES SHALL BE TESTED FOR EITHER INFILTRATION OR EXFILTRATION AND INFLOW. THERE SHALL BE NO INFILTRATION, EXFILTRATION OR INFLOW ALLOWED. THE CONTRACTOR SHALL SEAL ANY PIPE, FITTING OR MANHOLE AS REQUIRED. THE CONTRACTOR SHALL PROVIDE A VIDEO TAPE OF ALL MAIN GRAVITY LINES ALONG WITH A LOG OF LATERAL LOCATIONS. ALL ELECTRICAL AND MECHANICAL DEVICES AT LIFT STATIONS SHALL BE TESTED TO VERIFY PROPER OPERATION. THE CONTRACTOR SHALL PROVIDE STRUCTURE MAINTENANCE MANUALS TO THE OWNER. THE CONTRACTOR SHALL PROVIDE A MINIMUM OF 36 HOURS NOTICE TO THE ENGINEER OF RECORD PRIOR TO TESTING.
PRIVATE ASPHALT PAVING-ASPHALTIC CONCRETE SHALL BE TESTED FOR THE PRIVATE ASPHALT PAVING. THE SUBGRADE SHALL BE TESTED FOR THE LBR VALUE AT A FREQUENCY OF TWO PER 10,000 SF. DENSITY TESTS SHALL BE PERFORMED AT A FREQUENCY OF TWO PER 10,000 SF. THICKNESS SHALL BE MEASURED AT EACH DENSITY TEST LOCATION. A PROFESSIONAL ENGINEER'S CERTIFICATION OF COMPLIANCE SHALL BE PROVIDED BY THE TESTING LAB.
PRIVATE ASPHALT PAVING-ASPHALTIC CONCRETE SHALL BE TESTED FOR THE PRIVATE ASPHALT PAVING. THE SUBGRADE SHALL BE TESTED FOR THE LBR VALUE AT A FREQUENCY OF TWO PER 10,000 SF. DENSITY TESTS SHALL BE PERFORMED AT A FREQUENCY OF TWO PER 10,000 SF. A SIEVE ANALYSIS SHALL BE PERFORMED AT EACH DENSITY TEST LOCATION. A PROFESSIONAL ENGINEER'S CERTIFICATION OF COMPLIANCE SHALL BE PROVIDED BY THE TESTING LAB.
PUBLIC RIGHTS-OF-WAY AS REQUIRED BY THE ENTITY HAVING JURISDICTION, THE CONTRACTOR SHALL DETERMINE AND DOCUMENT THESE SPECIFICATIONS PRIOR TO BIDDING.
PORTLAND CEMENT CONCRETE-CONCRETE SHALL BE TESTED FOR THE FOLLOWING PARAMETERS: SLUMP, MODULUS OF RUPTURE, AND 7 AND 28 DAY COMPRESSIVE

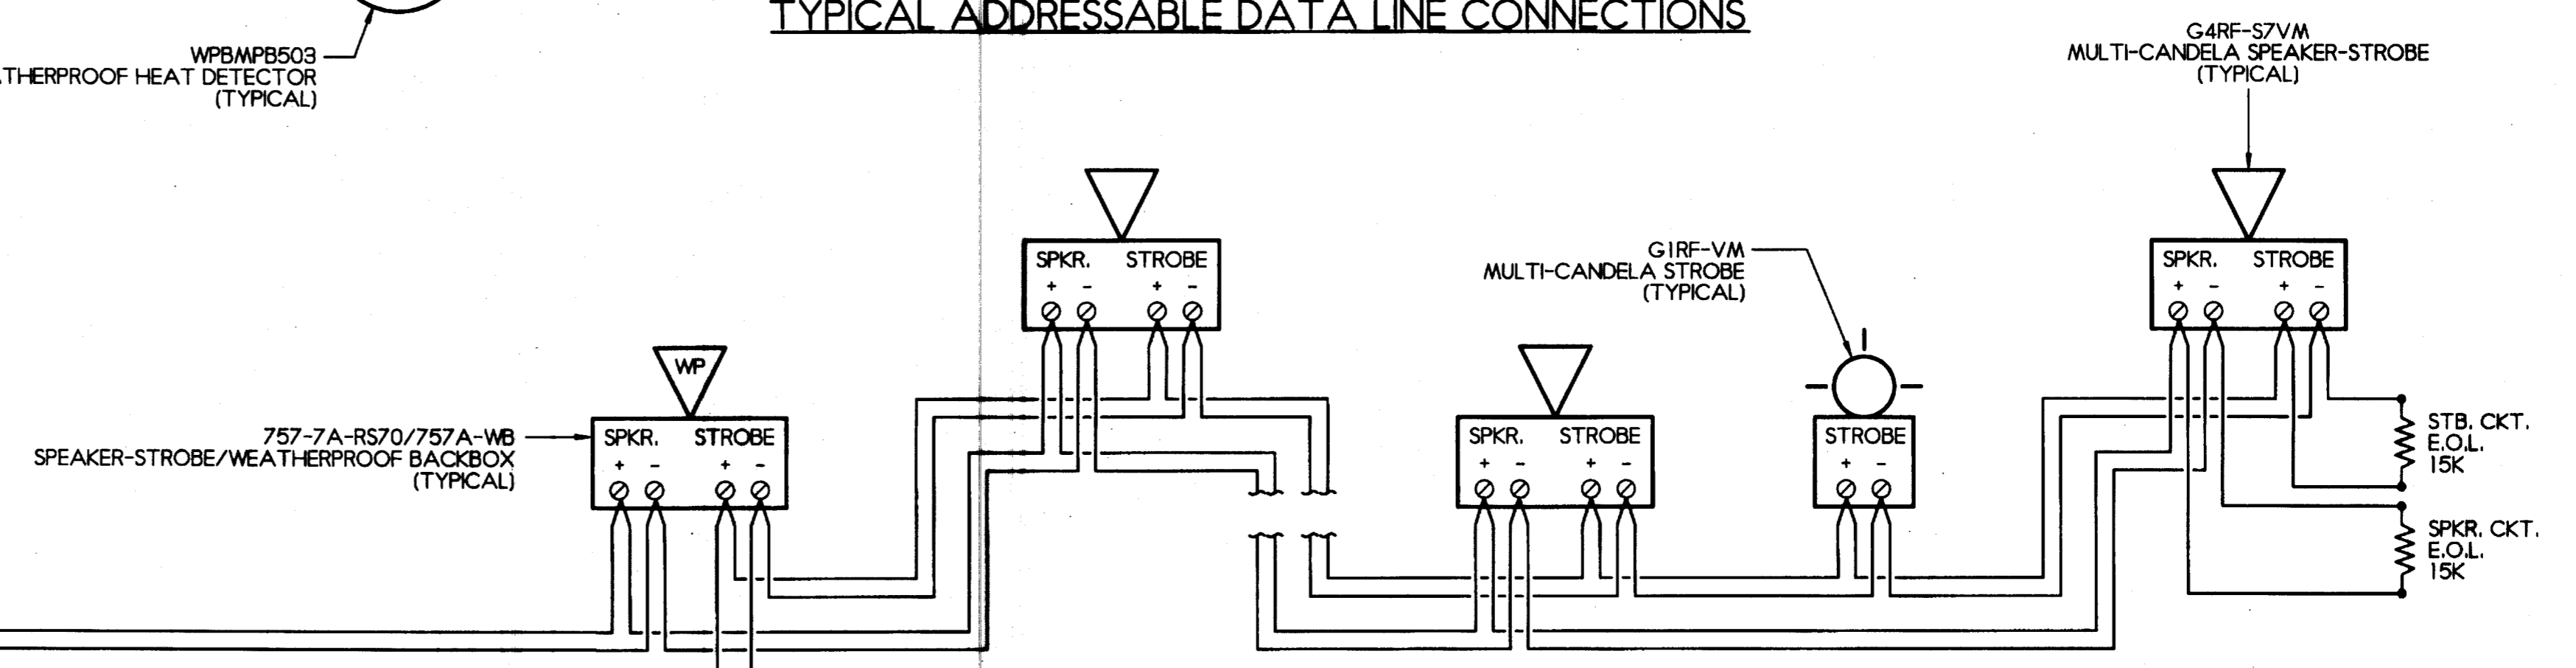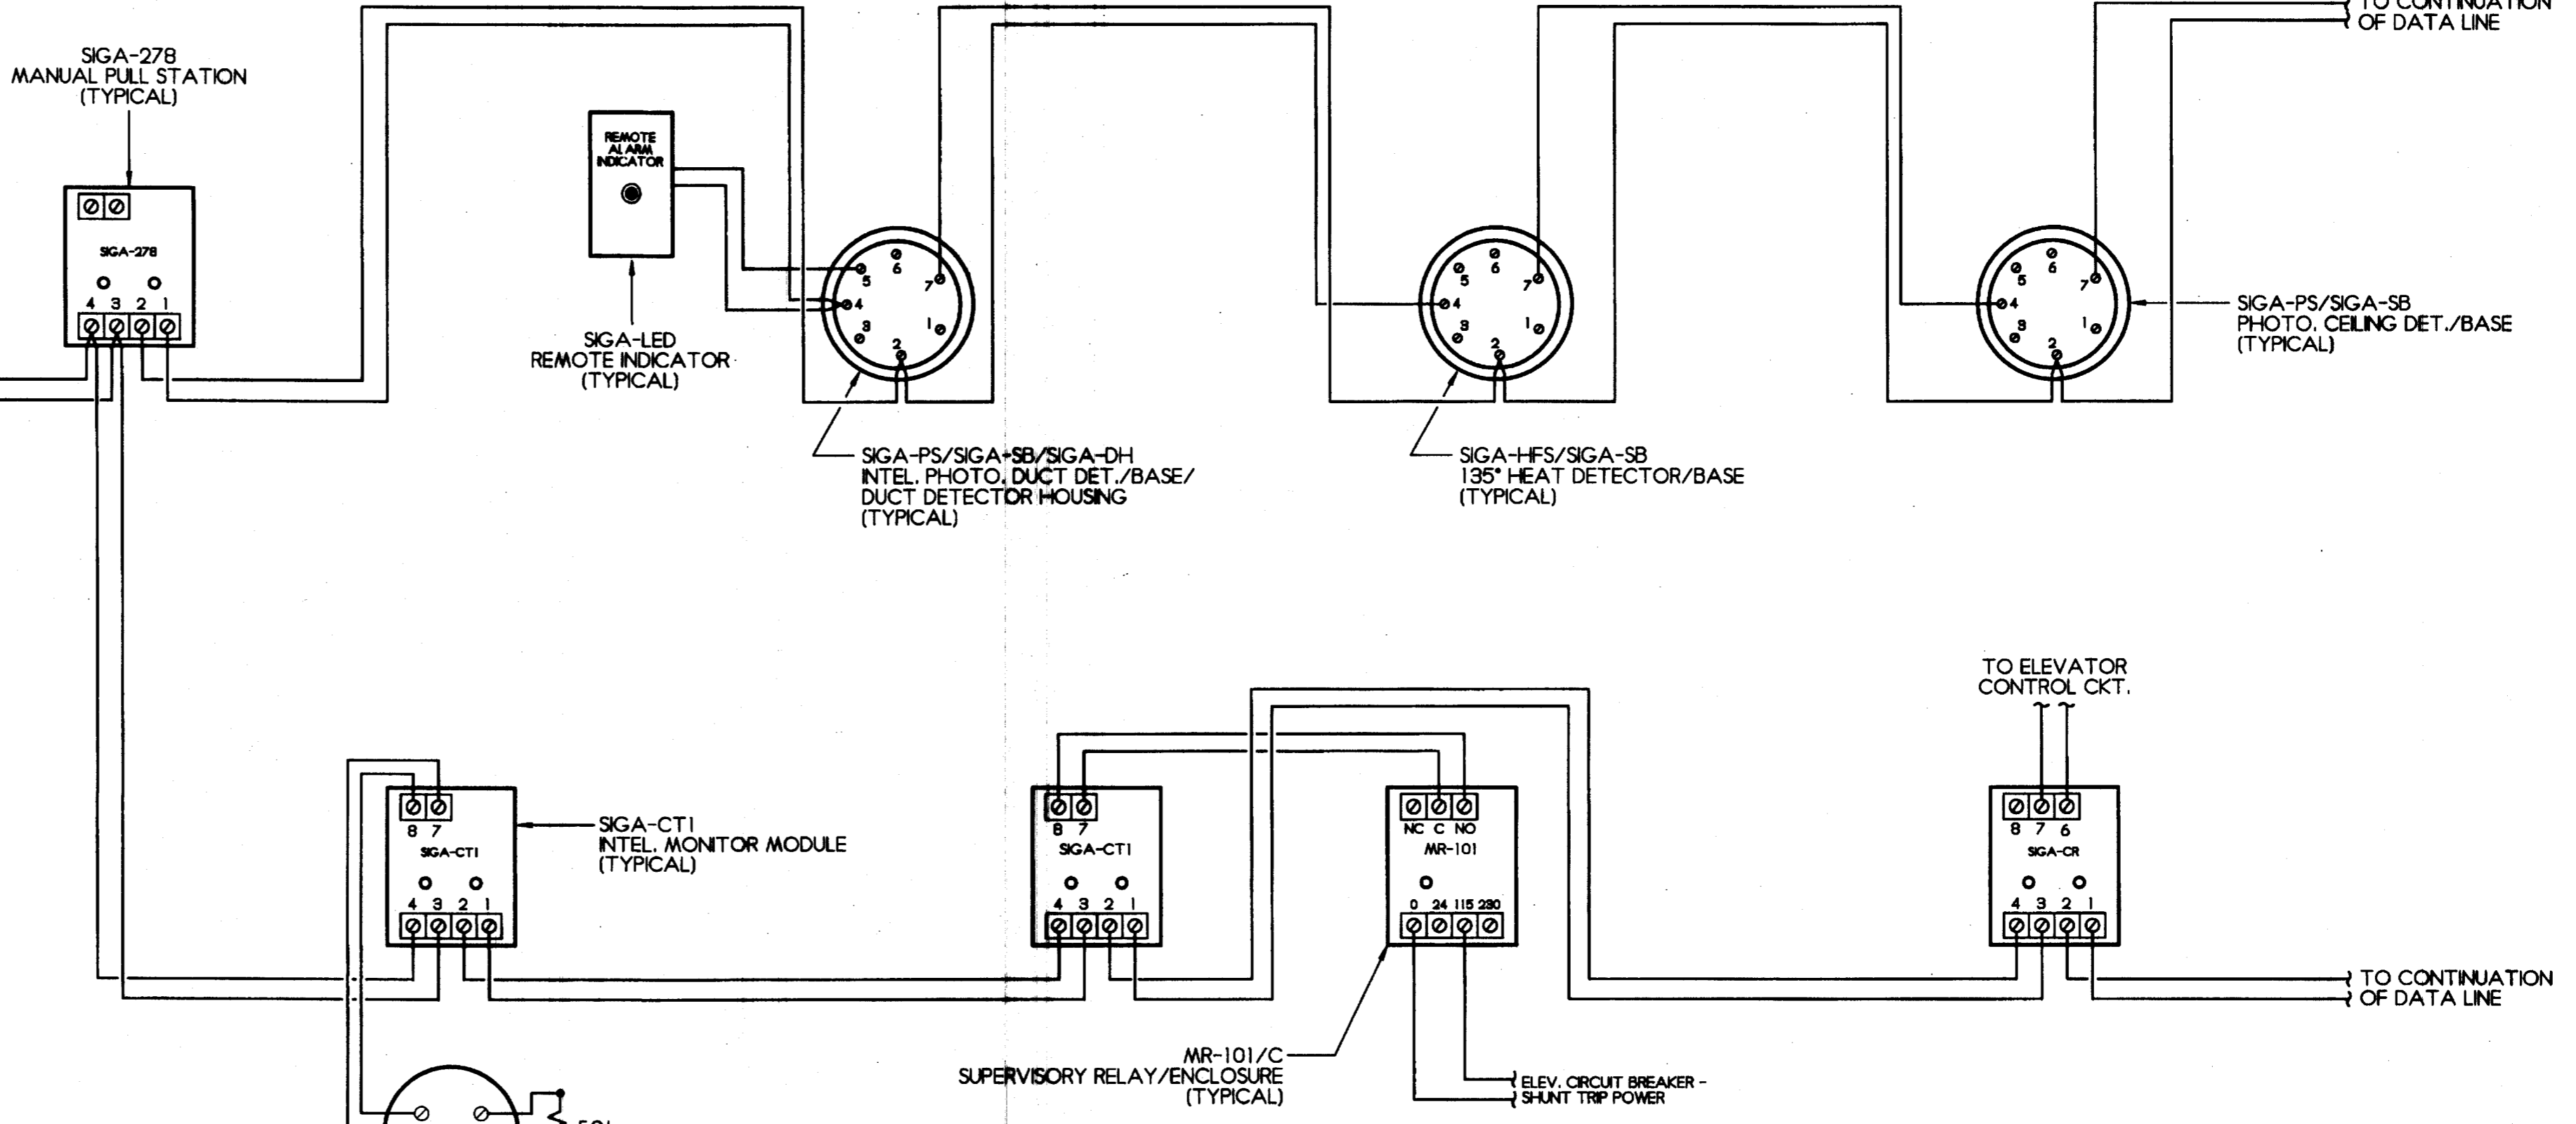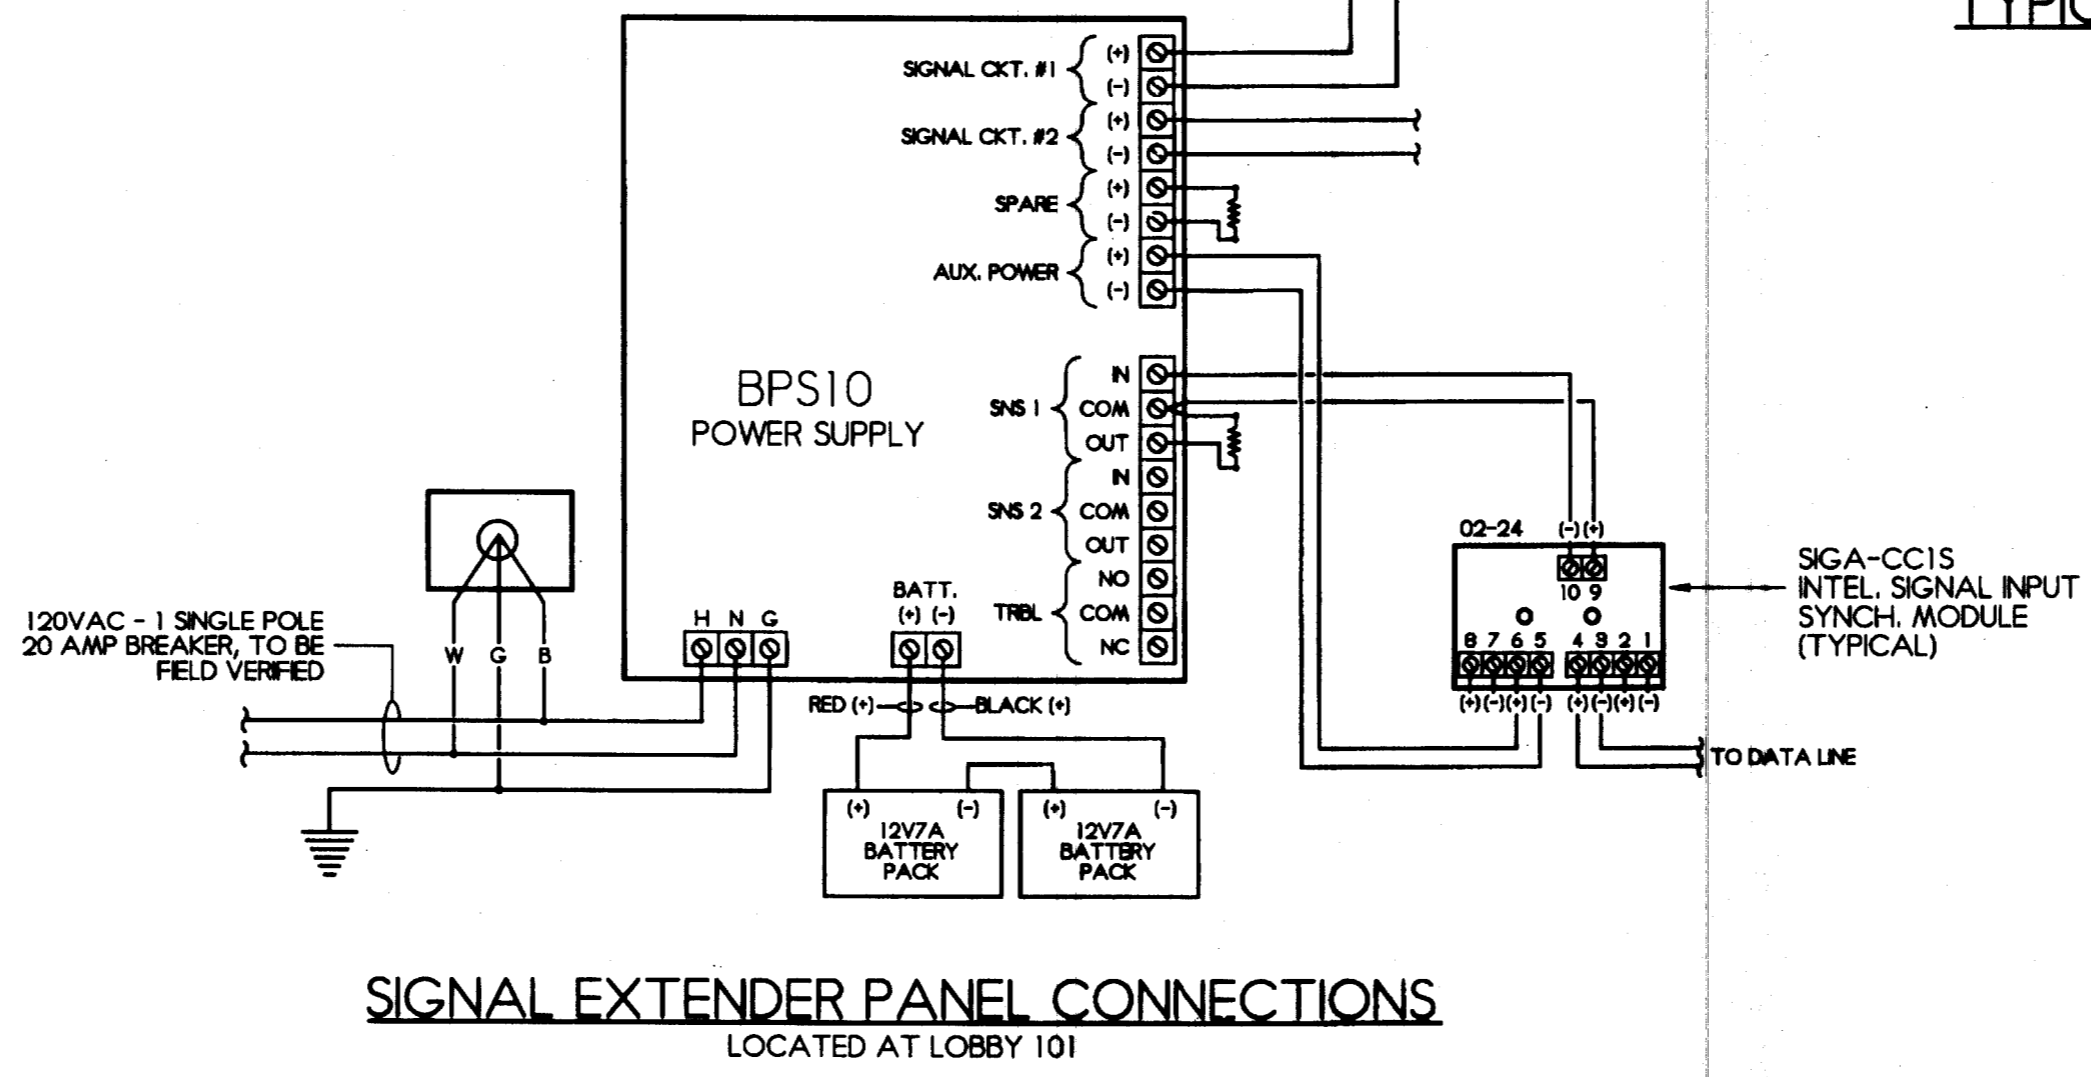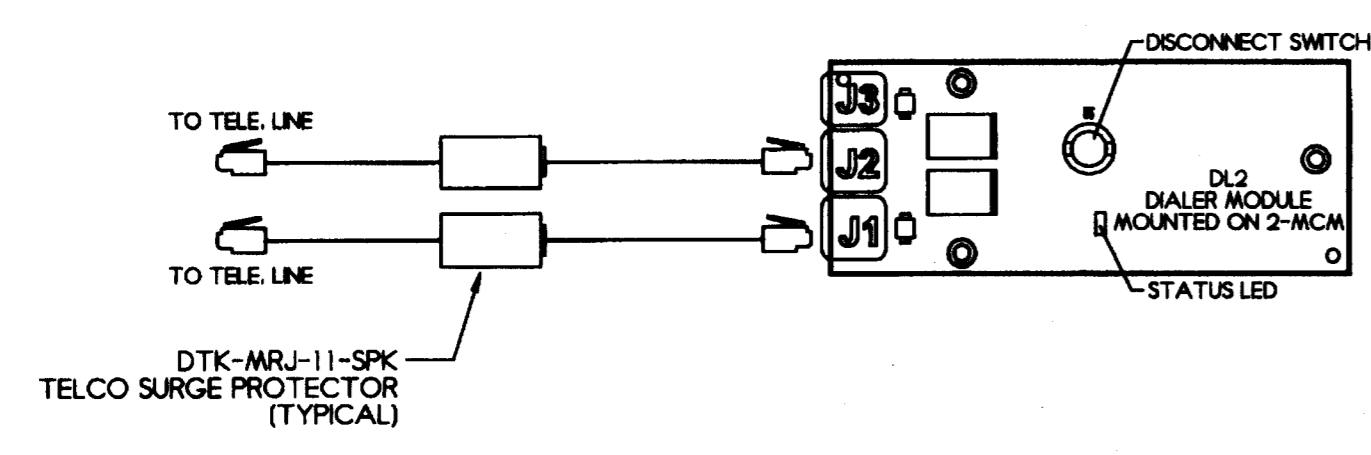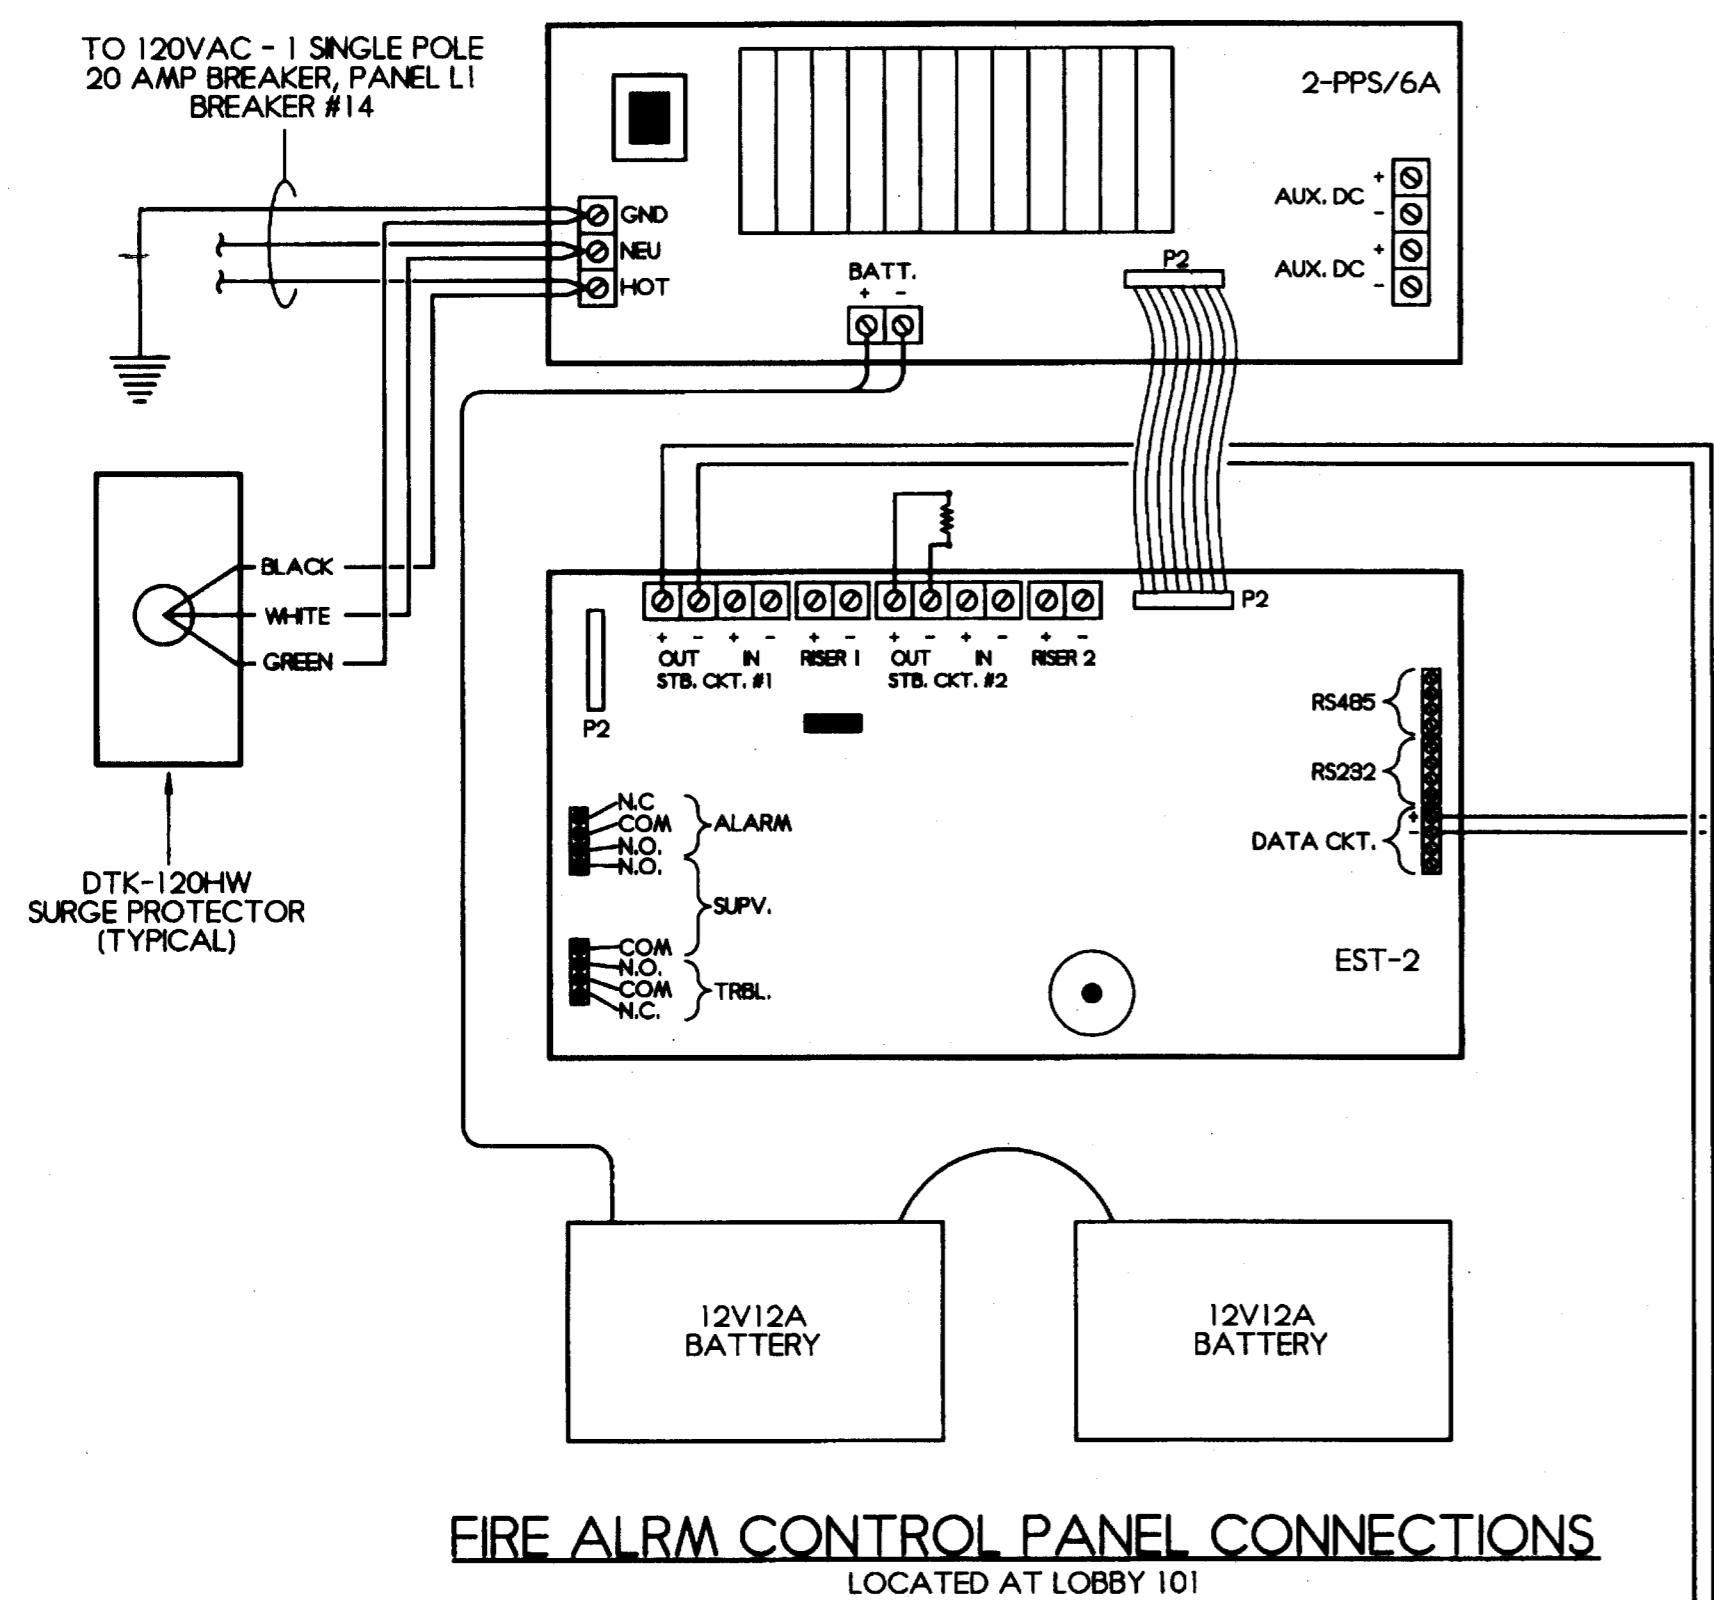

SAI inc. SYSTEMS DIVISION
2995 24TH AVE NORTH
SAINT PETERSBURG, FLORIDA 33713
TELEPHONE: (727) 323-4300
FLA STATE LIC. EP-000295, EP-0001045
CONTRACTOR: AMERICAN ELEC. SERVICES - TAMPA, FL

CUSCADEN POOL RENOVATION
TAMPA, FLORIDA
FIRE ALARM SYSTEM PLAN



REVISIONS
REVISED 11/10/04 - PER FIRE MARSHAL'S COMMENTS
REVISED 03/09/05 - PER MATRIX
11/23/04 COMMENTS

SCALE: AS NOTED
DRAWN BY: BK
APPROVED BY: RJS
DRAWING DATE: 08/11/04
REF. DWG. DATE: 02/02/04

STAMP

SHEET 3 OF 3
04J-0078-C1

RECORD DWG.
DATE 8/26/05

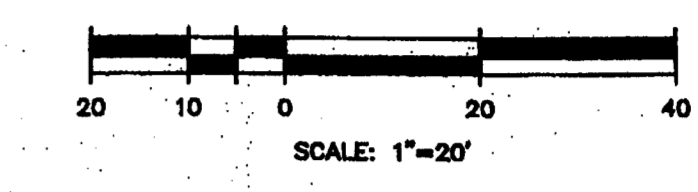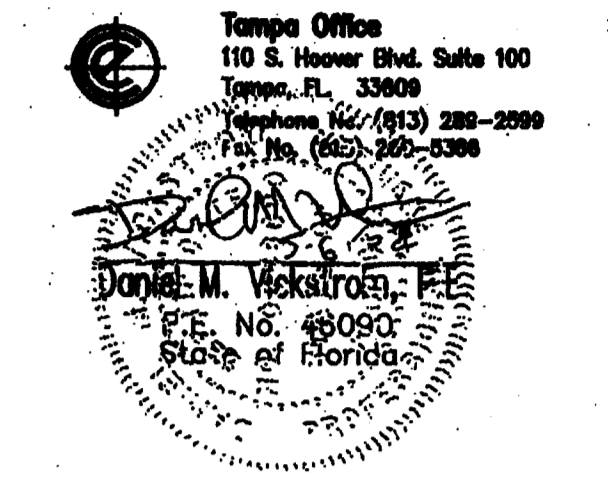

TREE LEGEND	
12" Ⓞ	= 12" OAK TREE
12" Ⓞ	= 12" WILLOW TREE
12" Ⓞ	= 12" MULBERRY TREE
12" Ⓞ	= 12" PALM TREE
12" Ⓞ	= 12" BAY TREE
12" Ⓞ	= 12" MAGNOLIA TREE
12" Ⓞ	= 12" CITRUS TREE
12" Ⓞ	= 12" EUCALYPTUS TREE
12" Ⓞ	= 12" SYCAMORE TREE
12" Ⓞ	= 12" PINE TREE
12" Ⓞ	= 12" CEDAR
12" Ⓞ	= 12" ELM TREE
12" Ⓞ	= 12" MAPLE TREE
12" Ⓞ	= 12" WAX MYRTLE TREE
12" Ⓞ	= 12" OTHER SPECIES
12" Ⓞ	= 12" CYPRESS TREE
12" Ⓞ	= 12" PECAN TREE
12" Ⓞ	= 12" BOTTLE BRUSH TREE
12" Ⓞ	= 12" CAMPHOR TREE
12" Ⓞ	= 12" CHINABERRY TREE
12" Ⓞ	= 12" PERSIMMON TREE

EXISTING PARKING	
HANDICAP SPACES	4 SPACES
REGULAR SPACES	28 SPACES
TOTAL PARKING PROVIDED	32 SPACES

PROPOSED PARKING	
HANDICAP SPACES	4 SPACES
REGULAR SPACES	41 SPACES
TOTAL PARKING PROVIDED	45 SPACES

NOTES:

- SEE ARCHITECTURAL SITE PLAN FOR FENCING AND GATES.
- ALL STRIPING & SIGNAGE MUST COMPLY FULLY WITH FDOT ROADWAY & TRAFFIC STANDARDS MANUAL (2002 EDITION) INDEX #17346 & #17355.



LEGEND






- DENOTES ASPHALT PAVEMENT
- DENOTES CONCRETE WALKS/PATHS
- DENOTES CONCRETE PAVEMENT
- DENOTES NO. OF PARKING SPACES
- DENOTES HANDICAP PARKING
- TRAFFIC CIRCULATION (NOT FOR PAINTING)

CUSCADEN POOL RENOVATION

CITY OF TAMPA
308 East Jackson Street
Tampa, Florida 33602

Project No.0202.00	
Distribution	Date
BID DOCUMENTS	02.02.04
CITY COMMENTS	05.08.04
REVISION 2	05.03.04

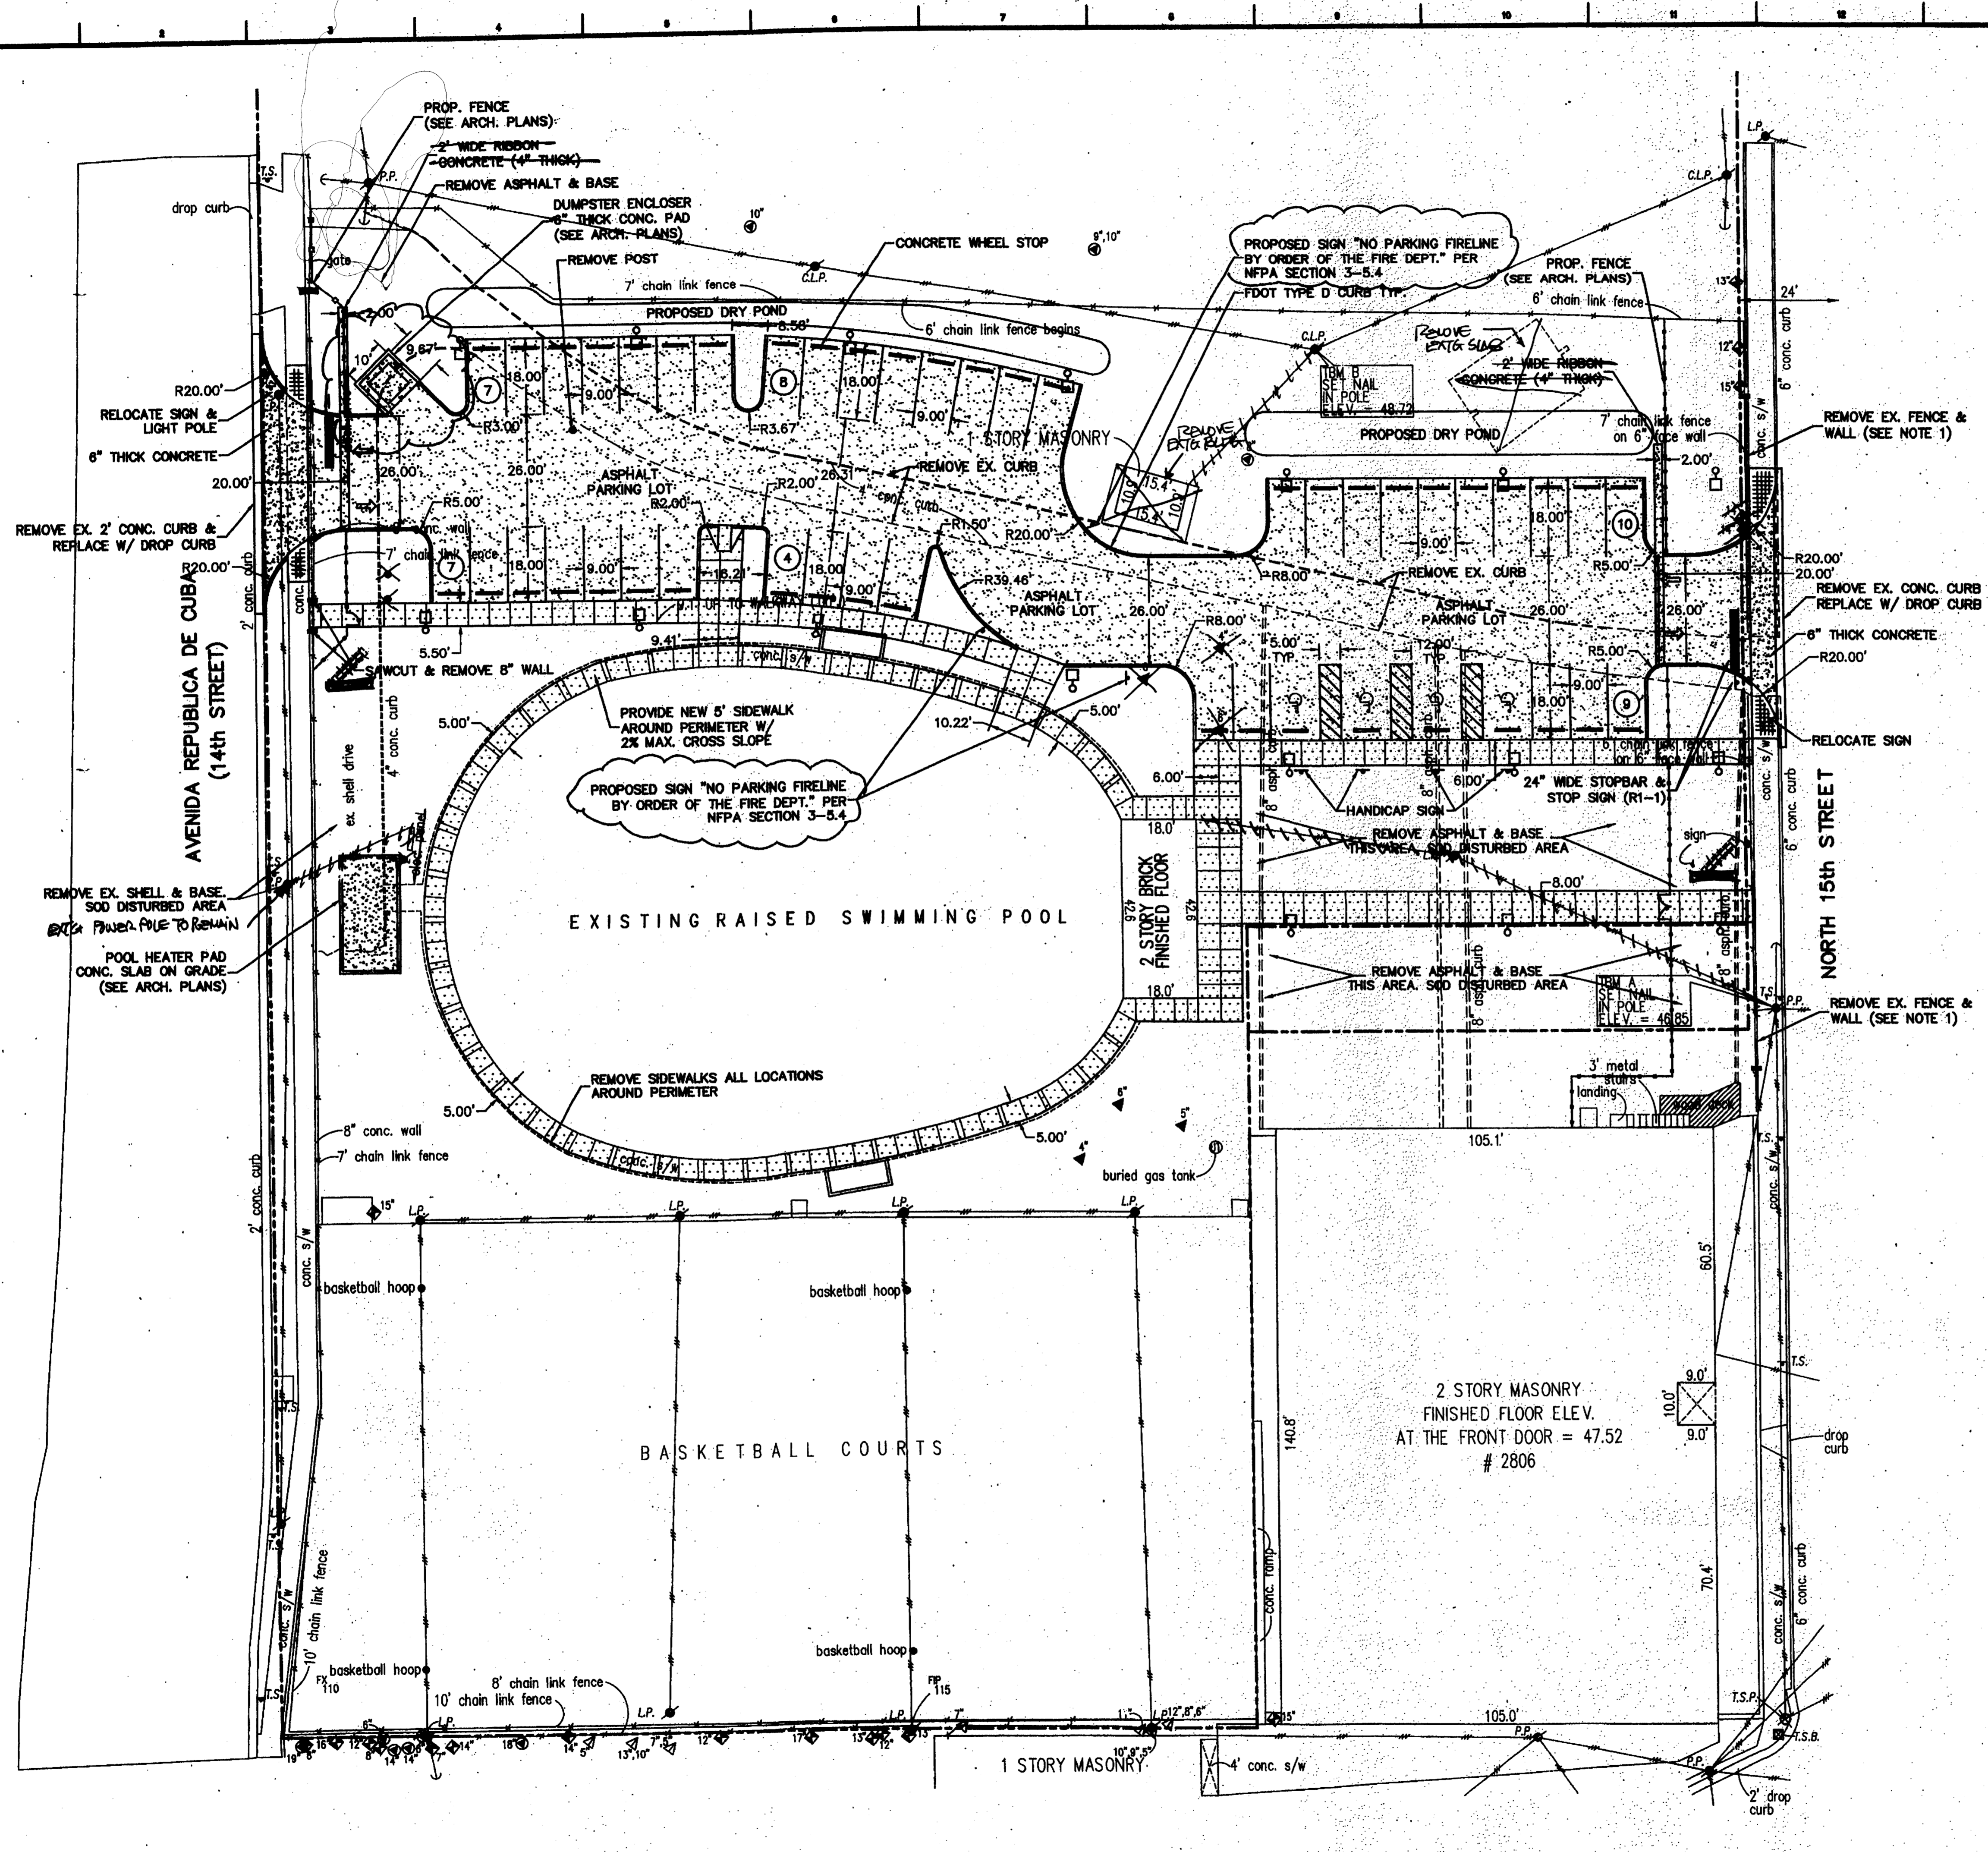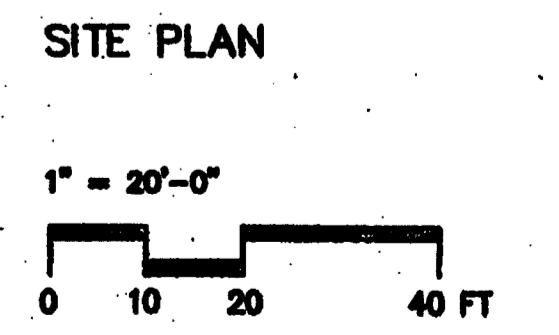

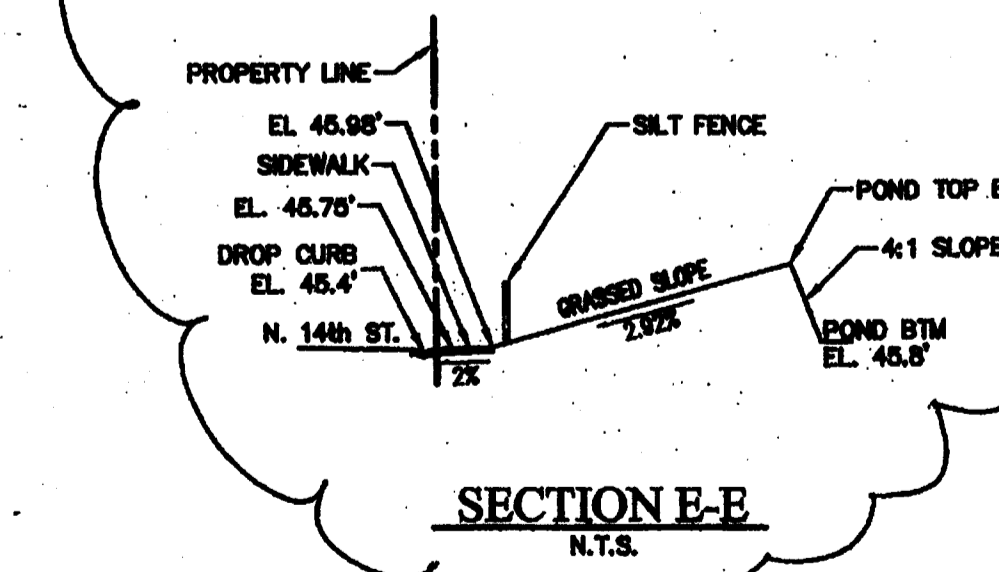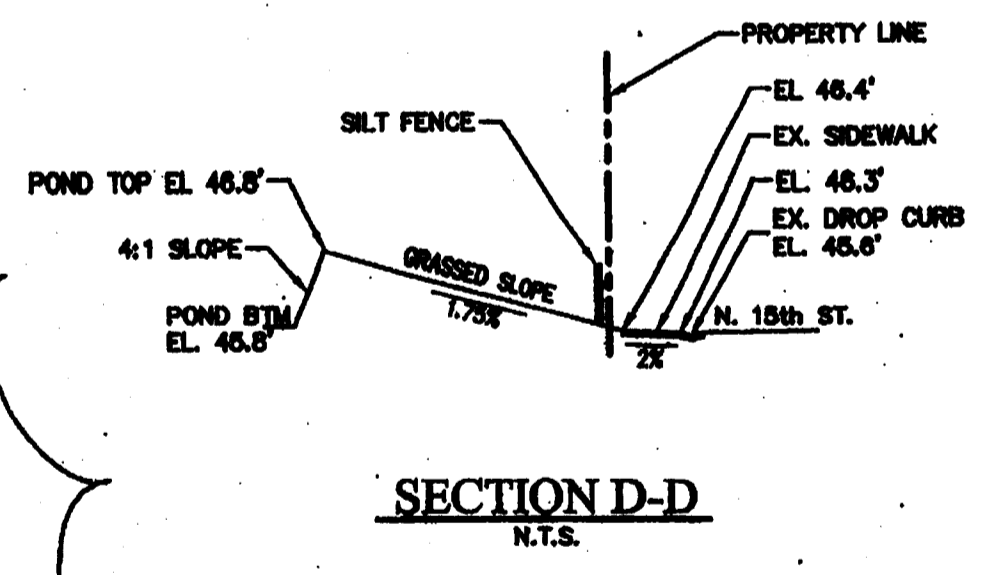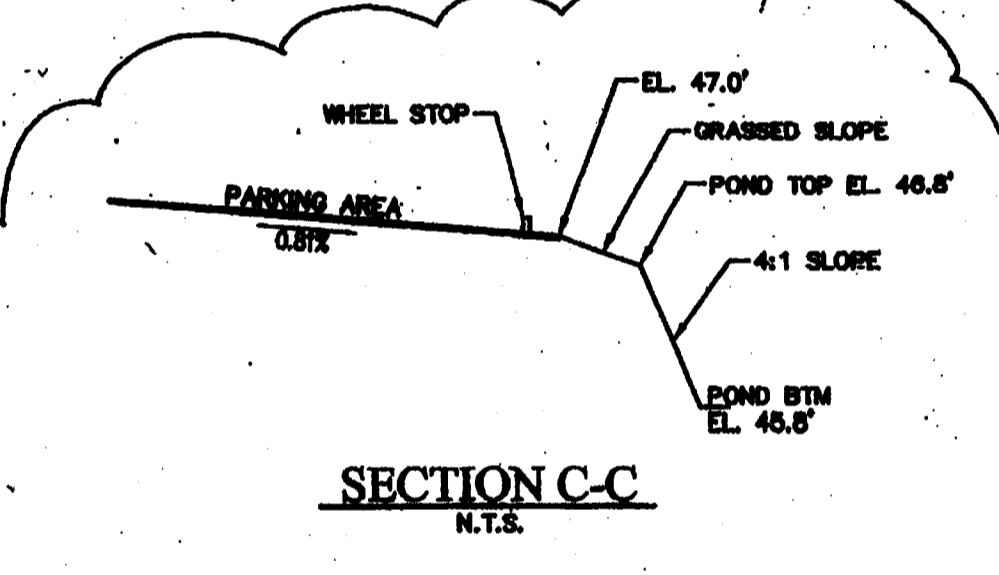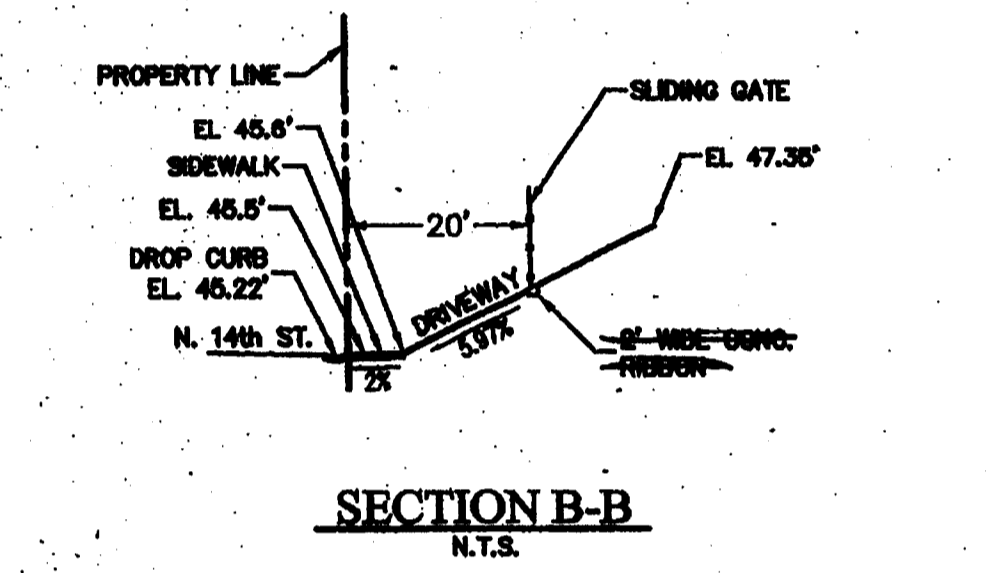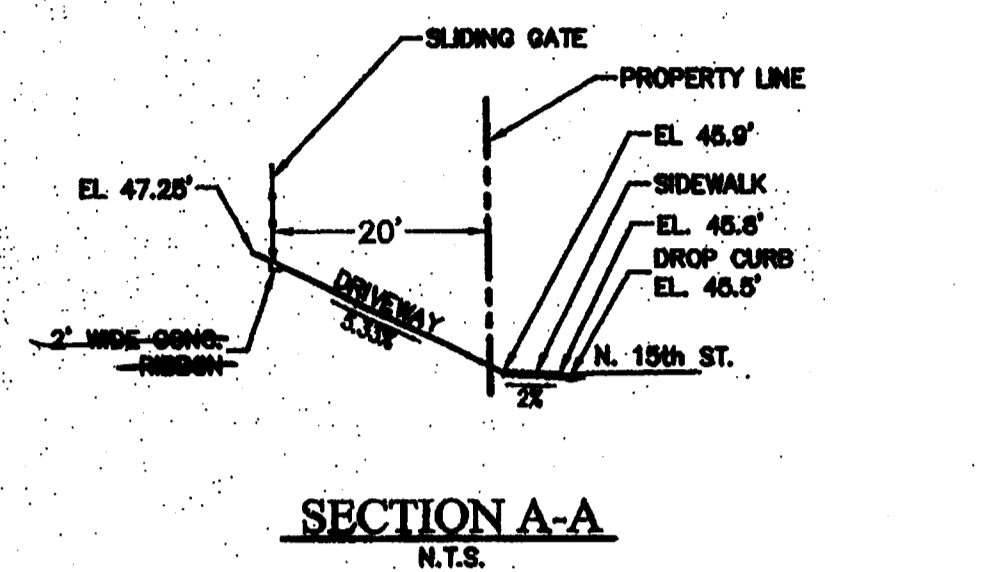

LEGEND



- PROPOSED FLOW DIRECTION ARROW
- (ELEV) PROPOSED TOP OF WALK/CURB ELEVATION
- (ELEV) PROPOSED EDGE OF PAVEMENT ELEVATION
- (ELEV) PROPOSED ELEVATION
- (ELEV) EXISTING ELEVATION
- EXISTING STORM SEWER



CUSCADEN POOL RENOVATION

CITY OF TAMPA
308 East Jackson Street
Tampa, Florida 33602

Project No. 0202.00	
Distribution	Date
BID DOCUMENTS	02.02.04
CONTRACT COMMENTS	05.05.04
REVISION 2	05.04.04

PAVING, GRADING & DRAINAGE PLAN

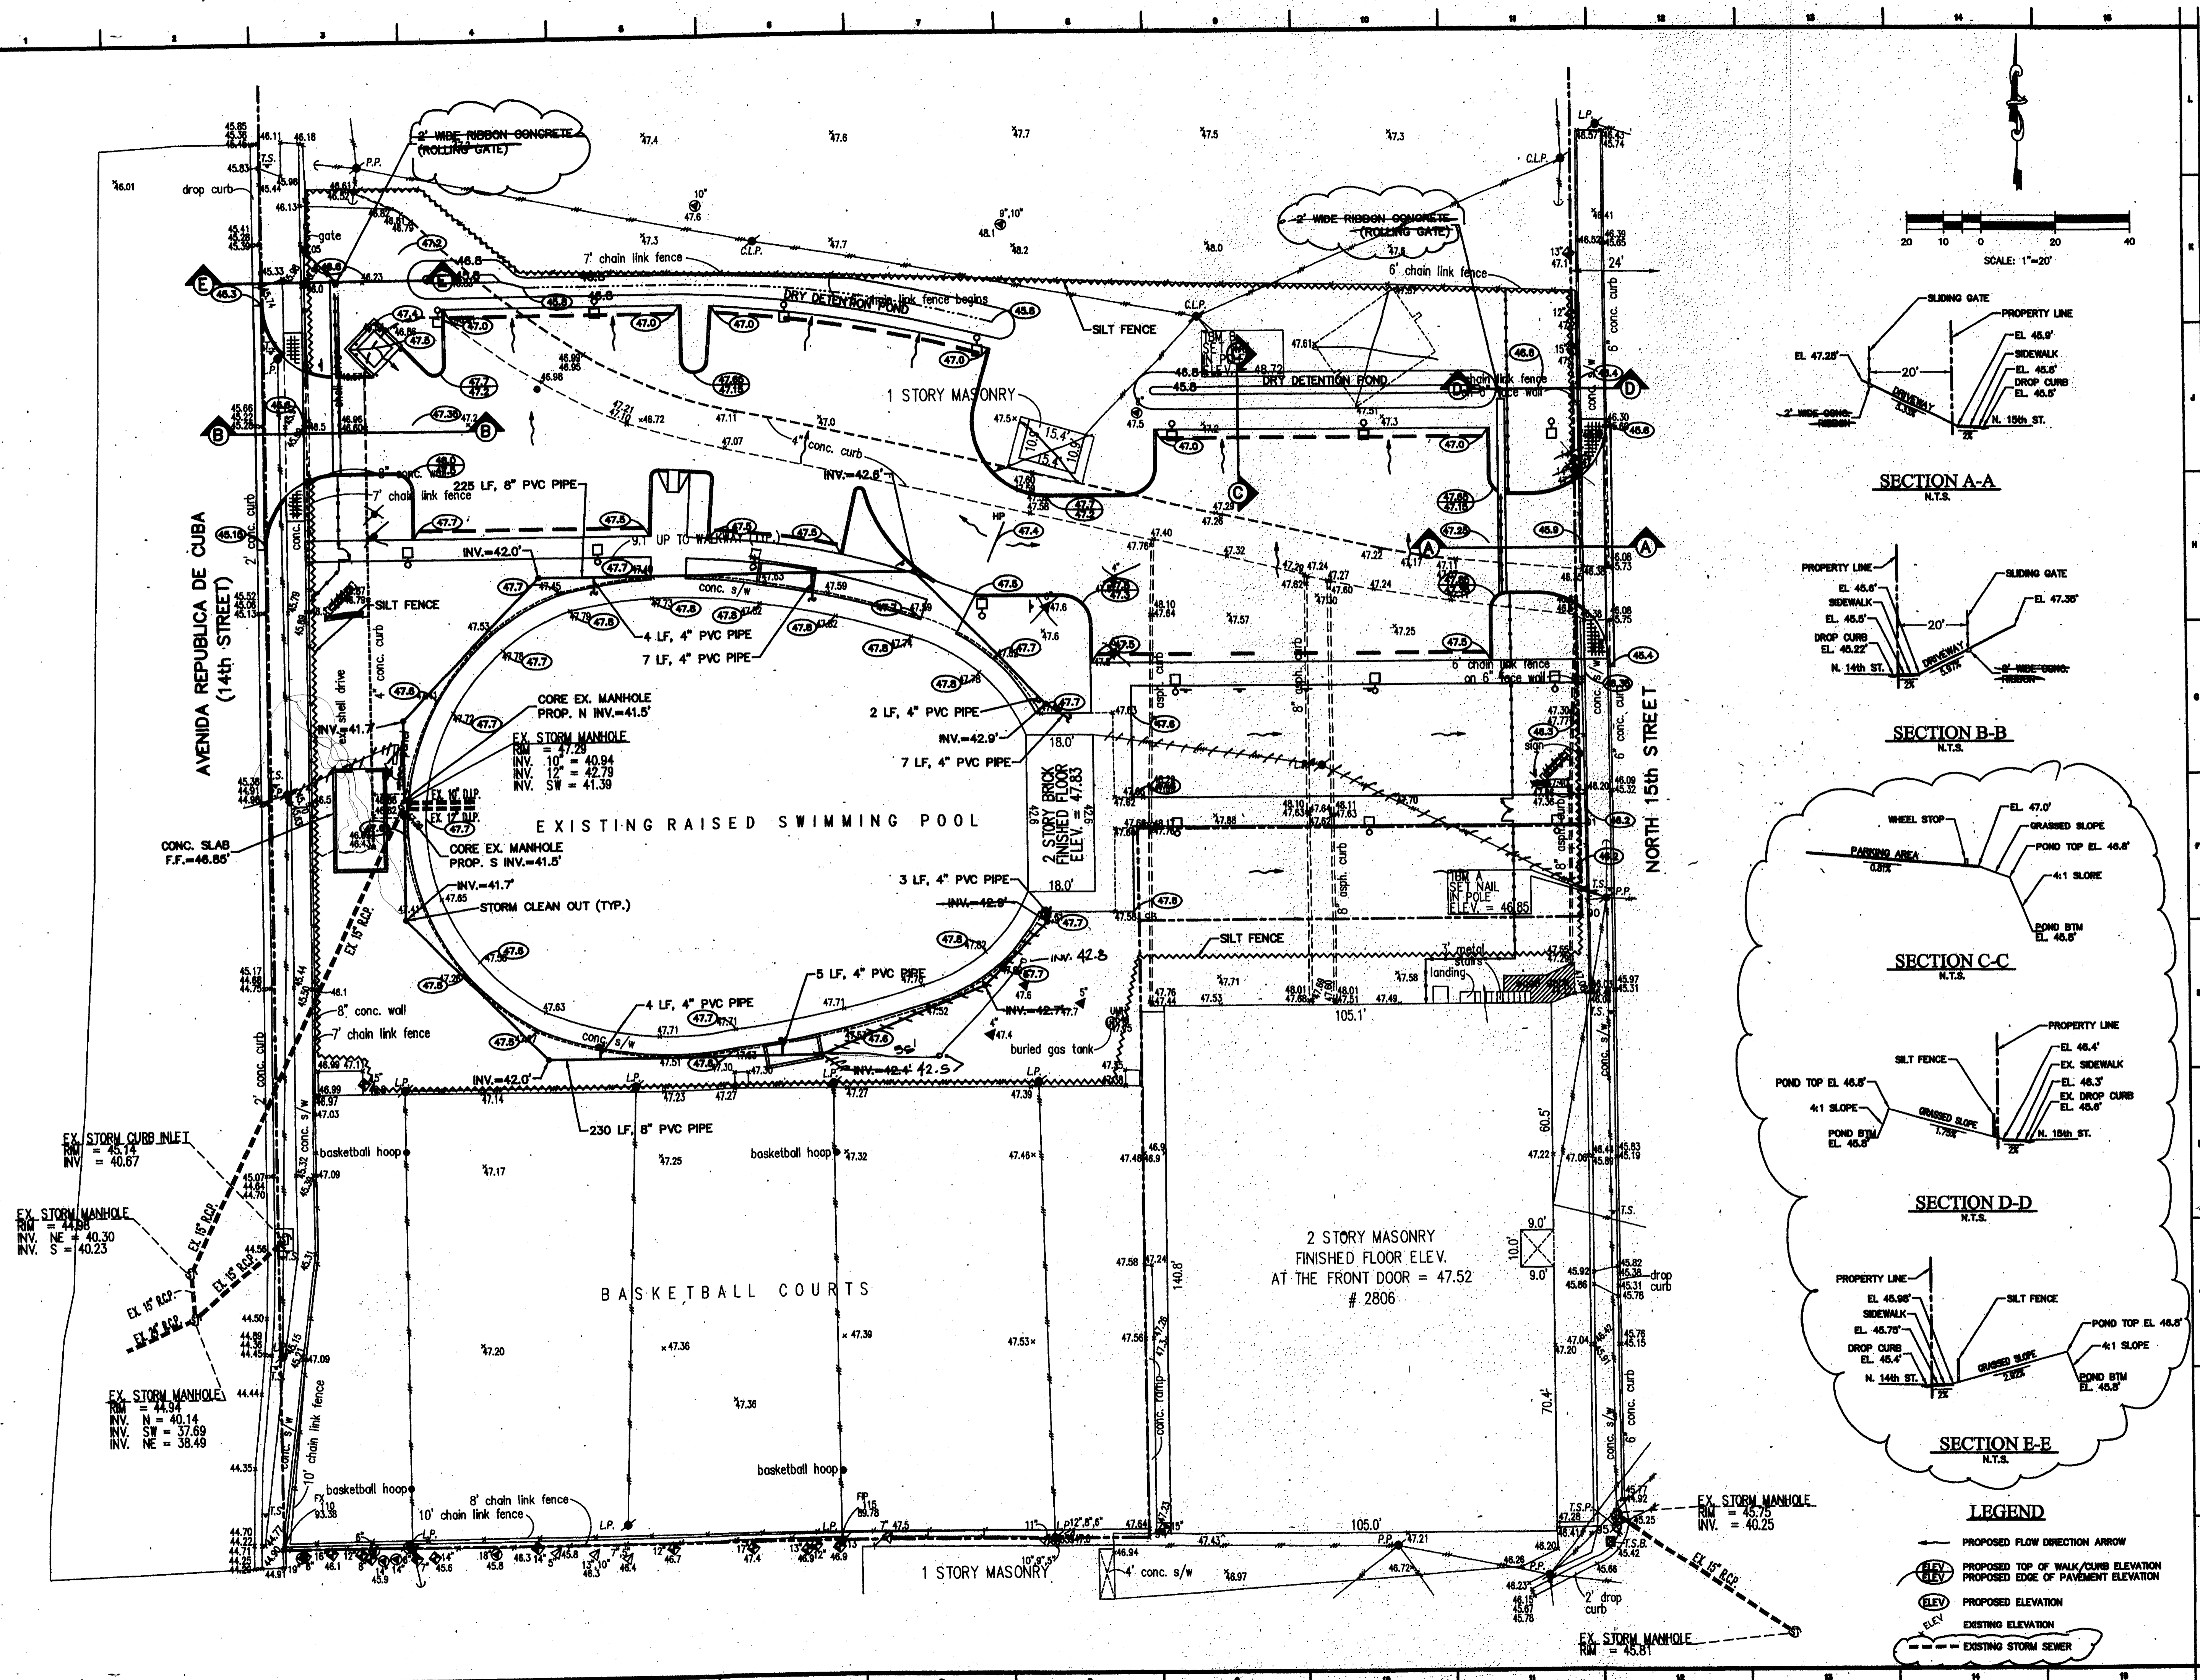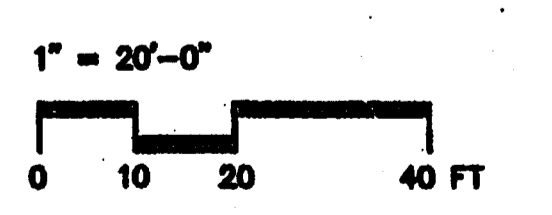

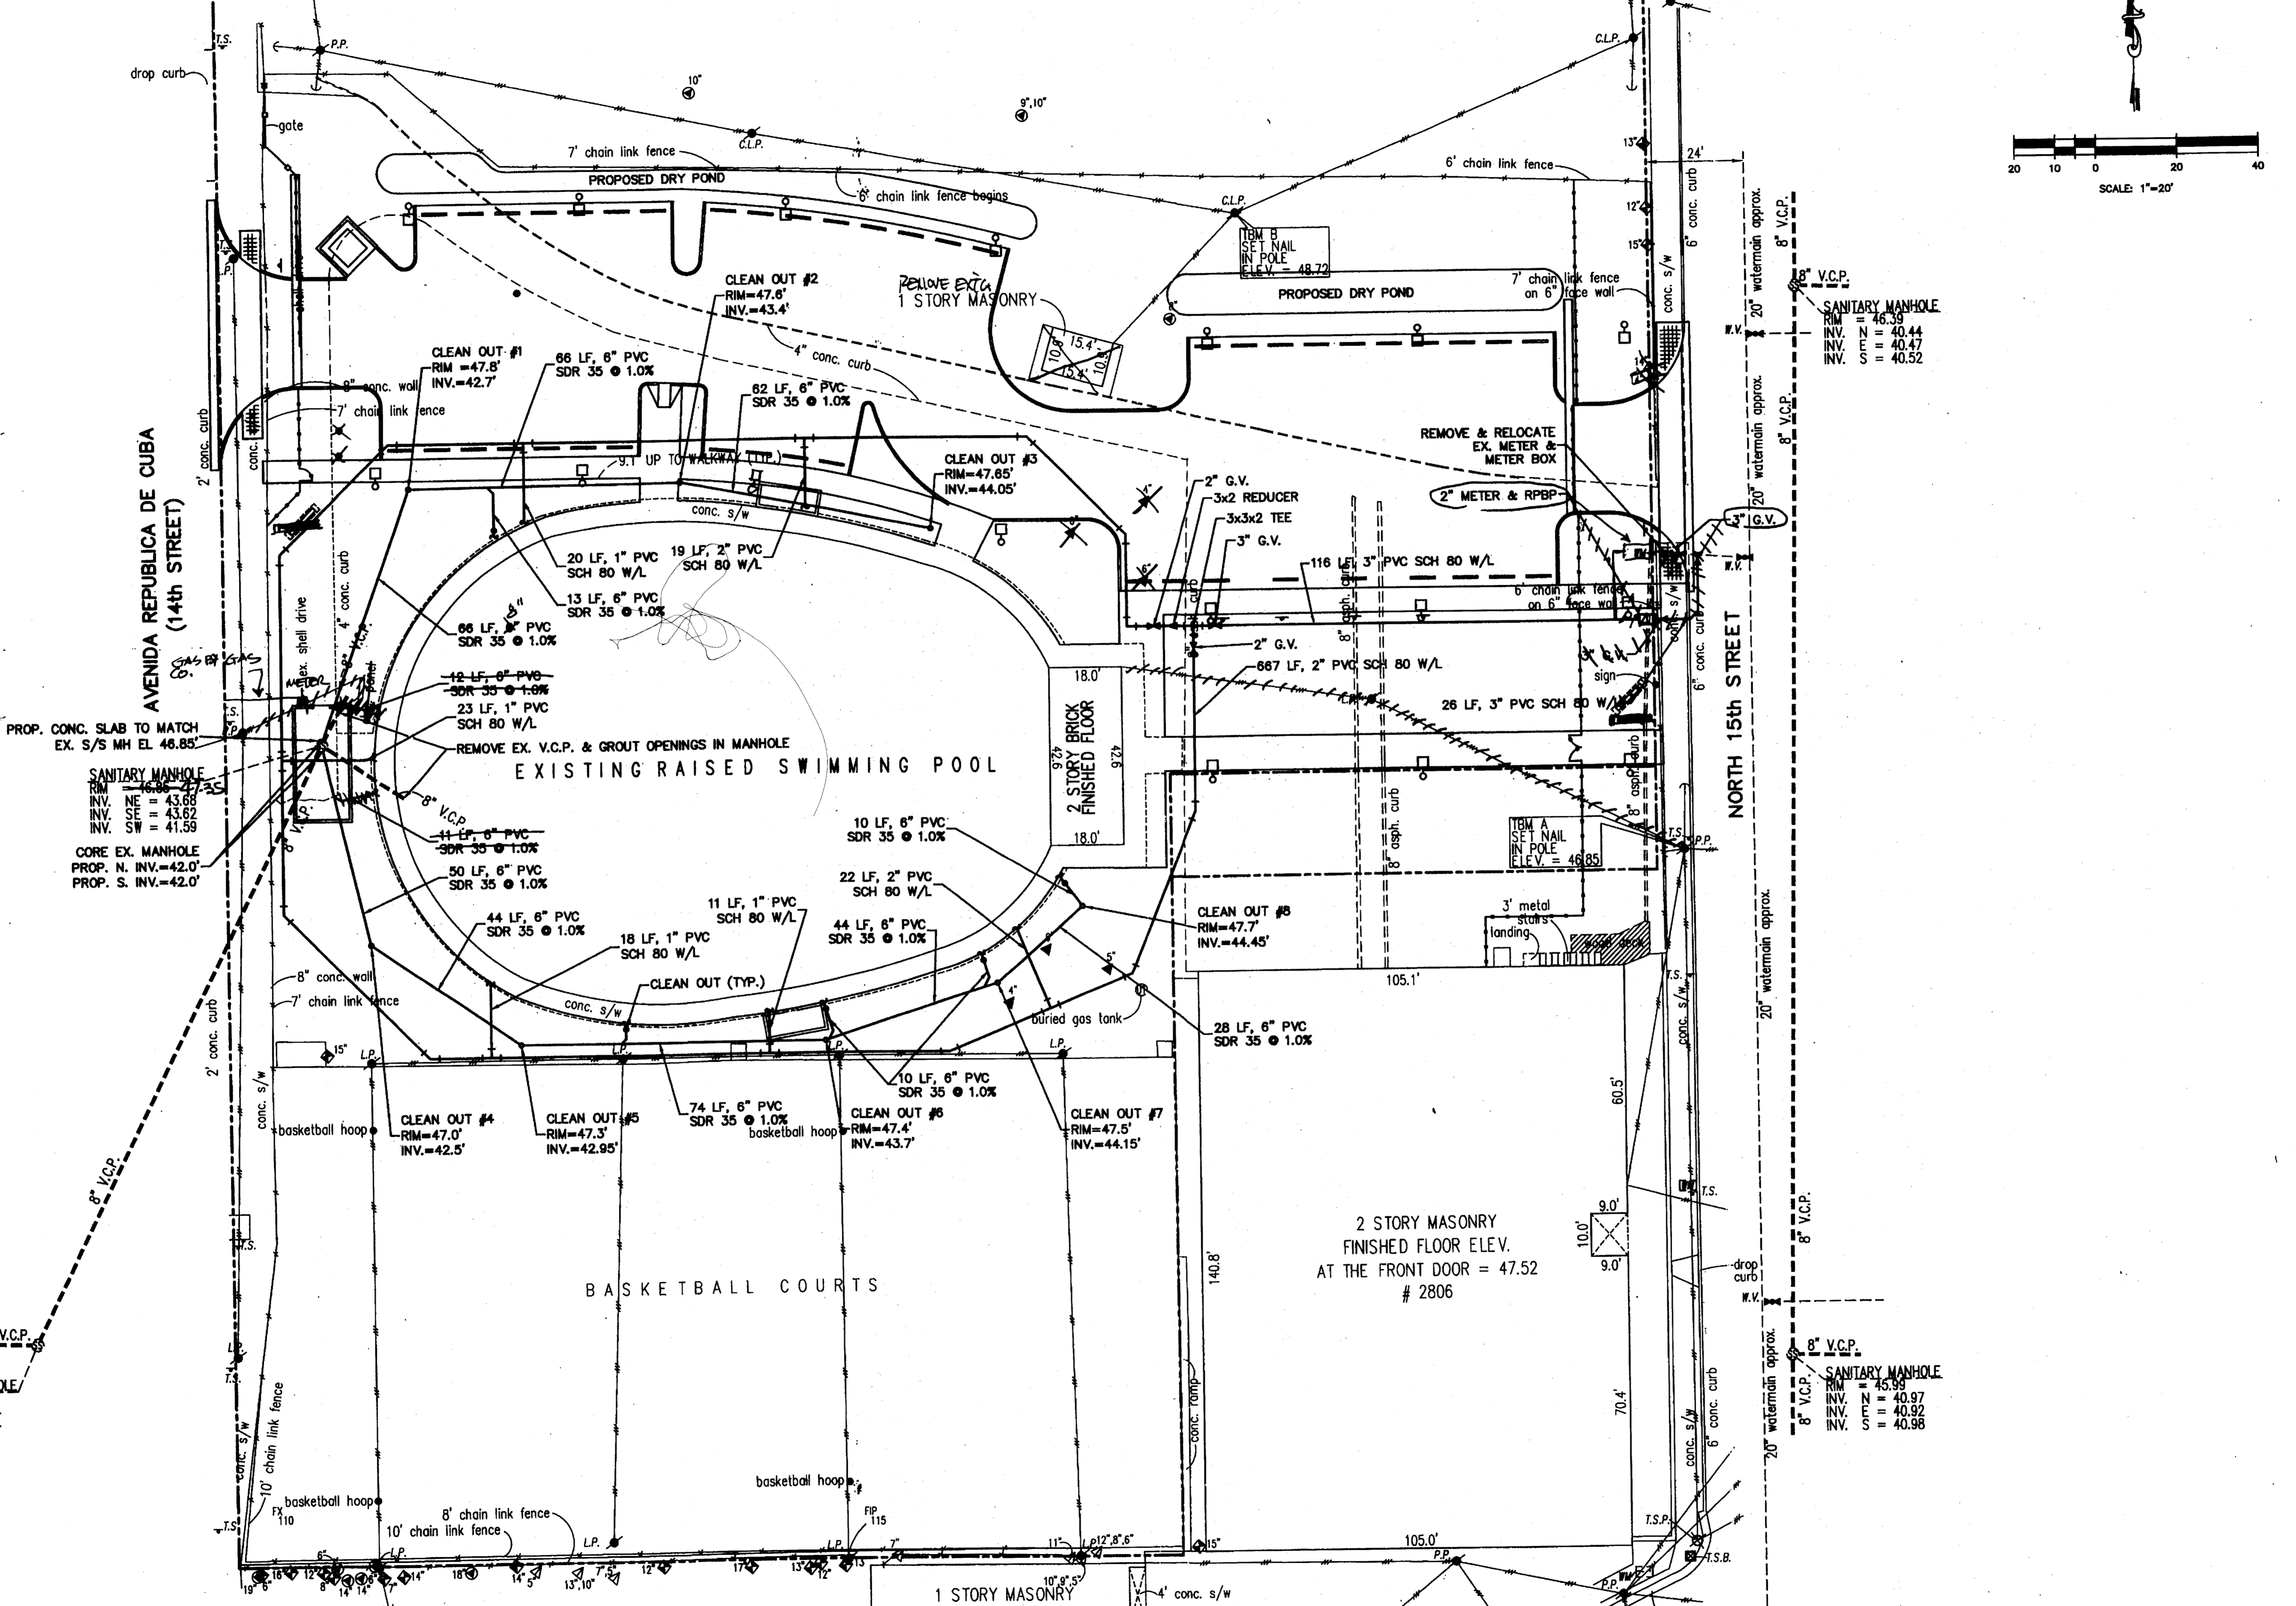
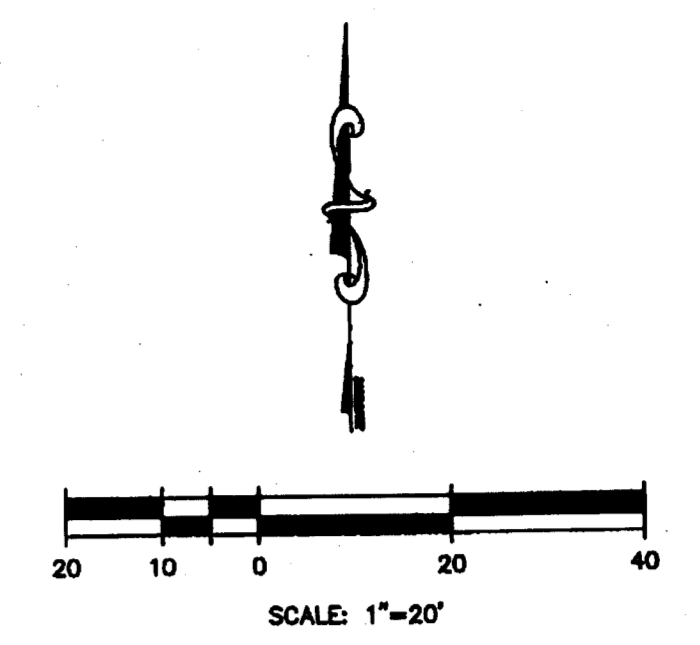


CUSCADEN POOL RENOVATION

CITY OF TAMPA
308 East Jackson Street
Tampa, Florida 33602


Project No.0202.00	
Distribution	Date
BID DOCUMENTS	02.02.04

UTILITY PLAN

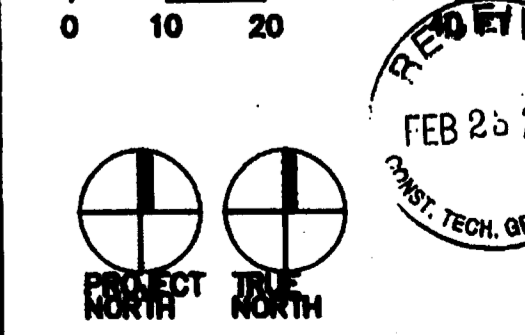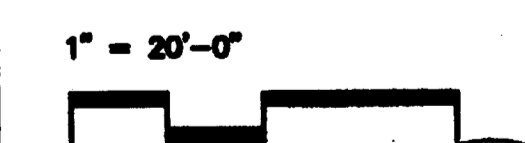


C4 RECORD DWG.

DATE 8/26/05 217

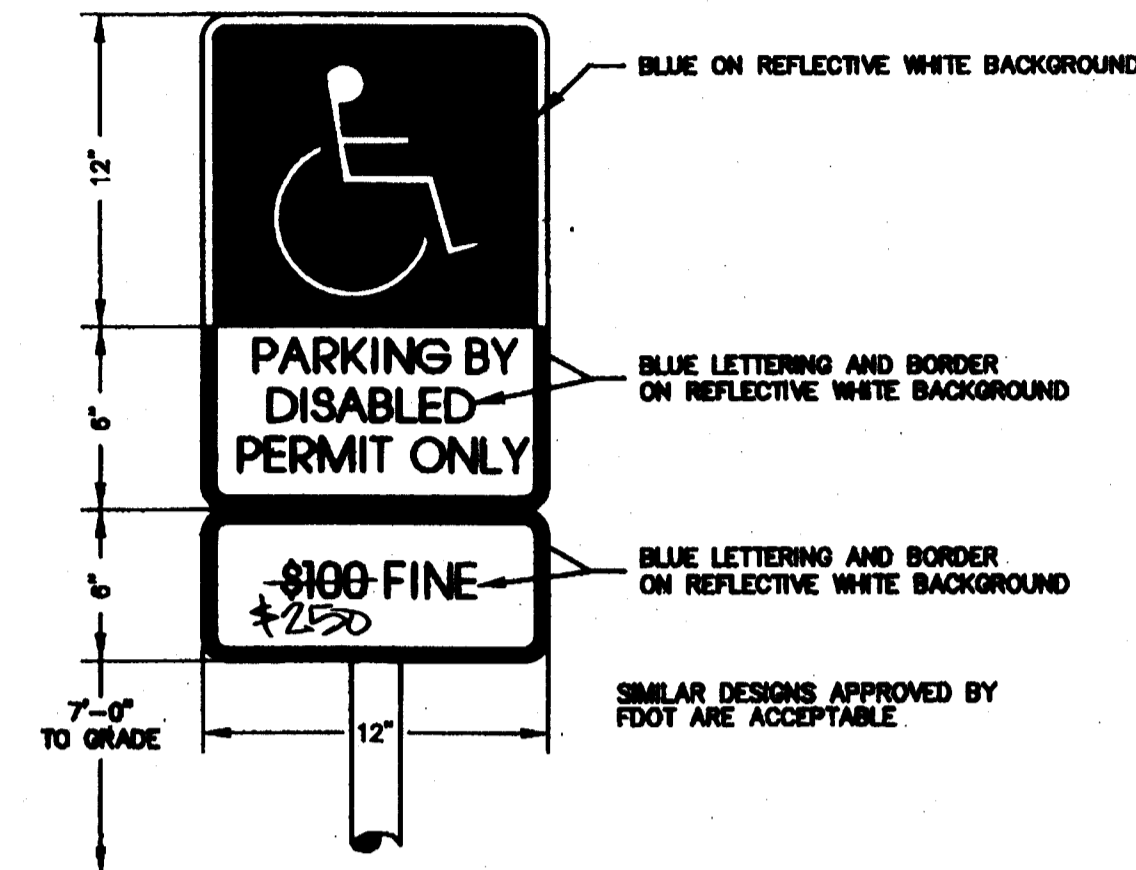


HANDICAPPED SIGN
NOT TO SCALE

NOTE:
ALL HANDICAP PARKING SPACES MUST BE SIGNED AND MARKED IN ACCORDANCE WITH THE STANDARDS ADOPTED BY THE DEPARTMENT OF TRANSPORTATION.

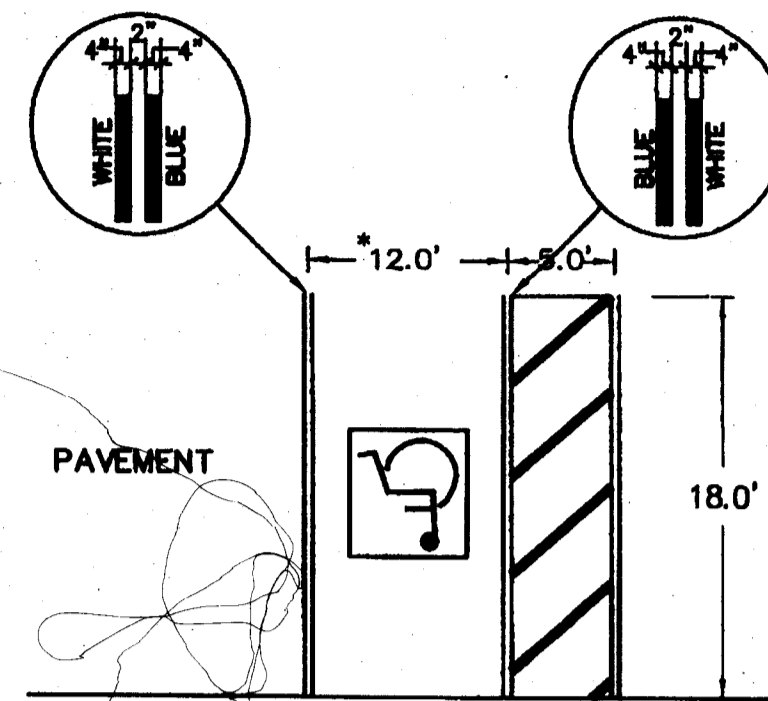


* HANDICAP SPACES SHALL BE 12 FEET WIDE AND A HANDICAP SYMBOL SHALL BE PAINTED IN STALL INSIDE A PAINTED 5'X5' BLUE BOX AND A HANDICAP SIGN ERECTED.

TYPICAL HANDICAP PARKING SPACE DETAIL
NOT TO SCALE

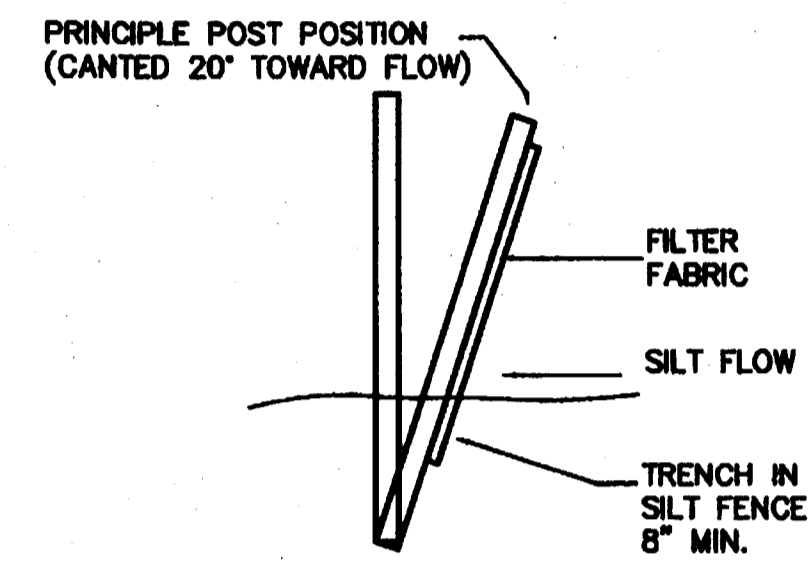


SECTION

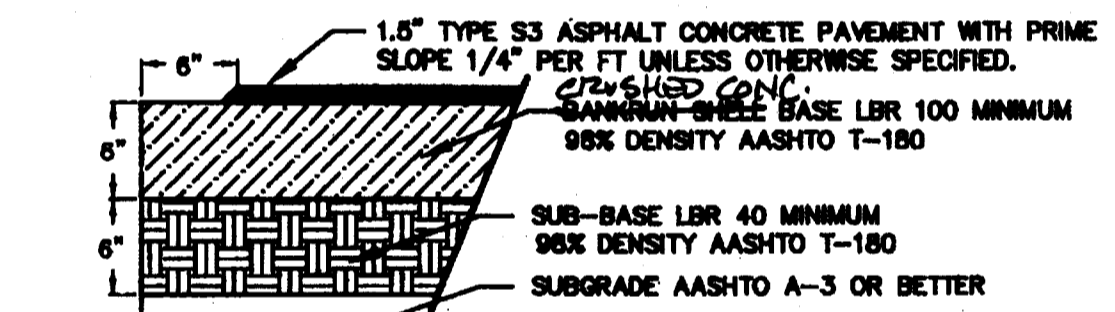


NOTE:
THE SUBGRADE SHALL CONSIST OF A-3 OR BETTER MATERIAL FOR A DEPTH OF 3 FEET BELOW THE SUB-BASE. IF THE SUBGRADE IS REPLACED OR DISTURBED, IT SHALL BE COMPACTED TO 98% T-180 TO THE DEPTH REPLACED OR DISTURBED.
THE SUB-BASE MAY BE STABILIZED IN PLACE TO PROVIDE REQUIRED LBR AND DENSITY.
SANDWICH-BEES BASE MAY BE SUBSTITUTED WITH SOIL CEMENT-CONSISTING OF LOCAL SHELL MATERIAL WITH A MINIMUM LBR VALUE 100 SOURCE SITE-MIXED WITH 2 1/2% CEMENT COMPACTED 98% T-180.

TYPICAL ASPHALT PAVEMENT SECTION
NOT TO SCALE

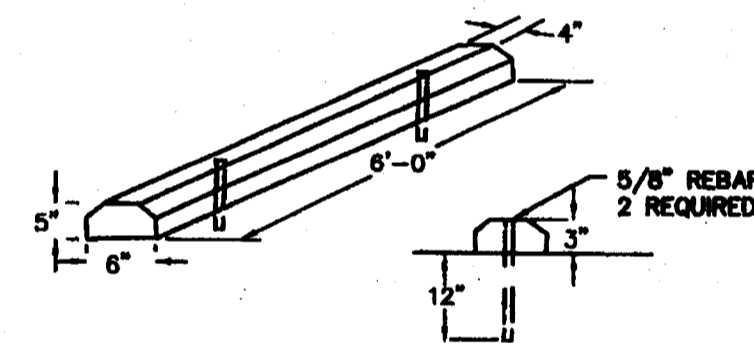


CONC. WHEEL STOP
NOT TO SCALE

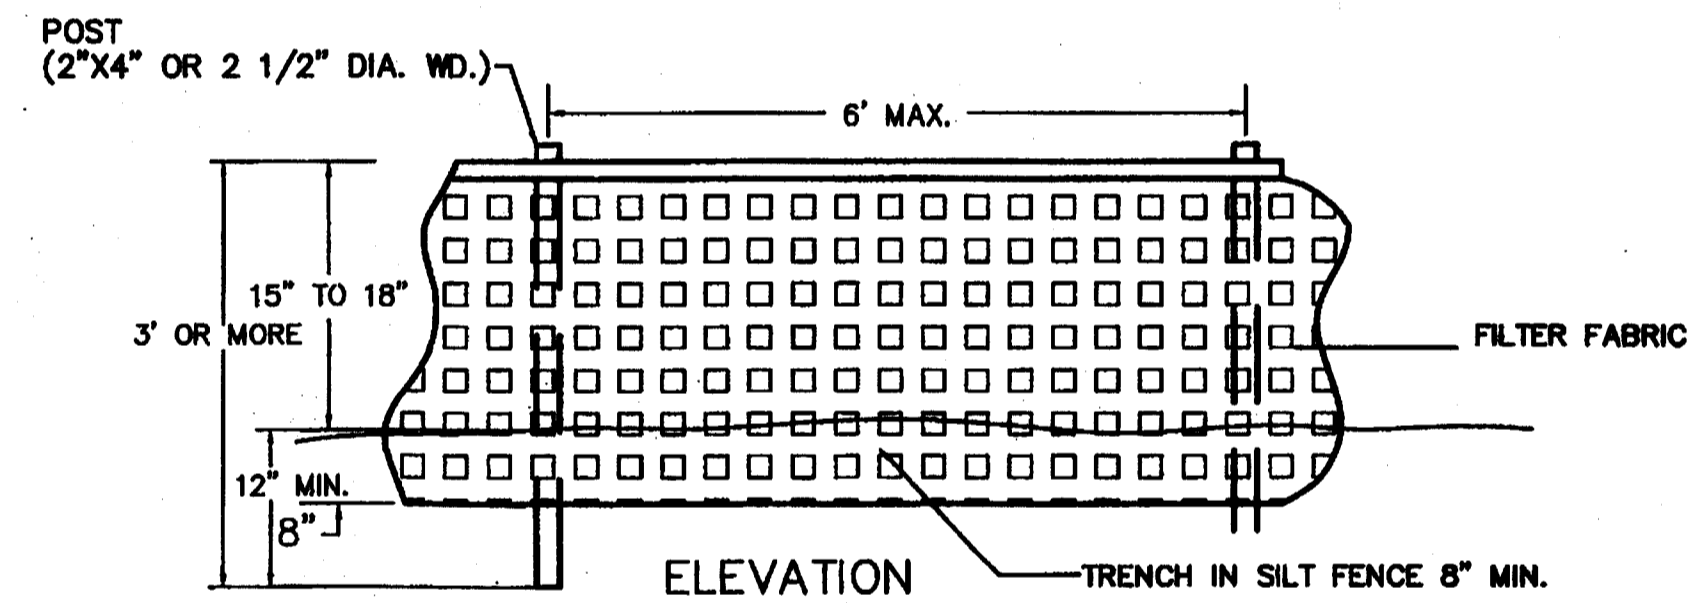


ELEVATION

EROSION CONTROL CONSTRUCTION NOTES
CONTRACTOR SHALL PERFORM DAILY INSPECTIONS FOR ANY EXISTING OR POTENTIAL EROSION PROBLEMS AT ANY LOW POINTS DURING CONSTRUCTION. IF ANY EXISTING OR POTENTIAL EROSION PROBLEMS ARE ENCOUNTERED DURING CONSTRUCTION THE CONTRACTOR SHALL INSTALL (SILT FENCES, HAY BALES ETC.) EROSION CONTROL IMMEDIATELY.

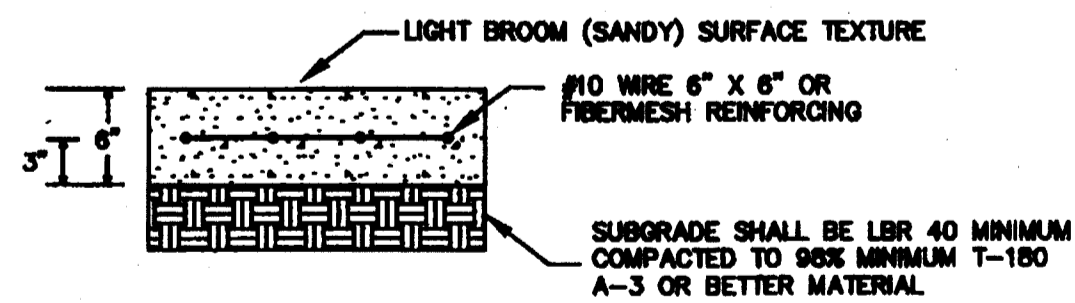

NOTE:
1. EXPANSION JOINTS EVERY 400 SQUARE FEET OF CONCRETE PAVEMENT.

TYPICAL CONCRETE PAVEMENT SECTION
NOT TO SCALE

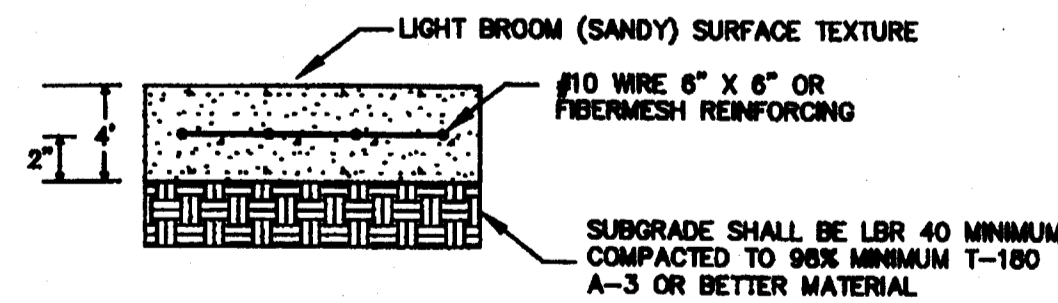

NOTE:
1. EXPANSION JOINTS EVERY 400 SQUARE FEET OF CONCRETE PAVEMENT.

TYPICAL CONCRETE SIDEWALK SECTION
NOT TO SCALE

TYPICAL SILT FENCE
NOT TO SCALE

ROME ARCHITECTS
INCORPORATED
100 Madison Street, Suite 200
Tampa, Florida 33602.4704
www.RomeArchitects.com
Fax: 813.221.9184
813.221.6771
AAC002172

CHARLOTTE ENGINEERING & SURVEYING, INC.
Tampa Office
110 S. Hoover Blvd. Suite 100
Tampa, FL 33609
Telephone No. (813) 286-2589
Fax No. (813) 286-5386


Daniel M. Vickstrom, P.E.
P.E. No. 46090
State of Florida

CUSCADEN POOL RENOVATION

CITY OF TAMPA
308 East Jackson Street
Tampa, Florida 33602


Project No.0202.00	
Distribution	Date
BID DOCUMENTS	02.02.04

CIVIL DETAILS

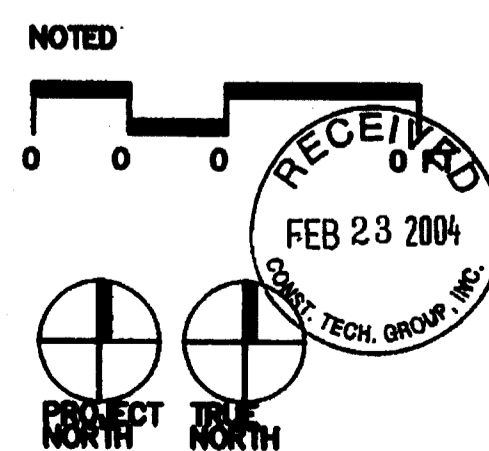

C5 RECORD DWG.

DATE 8/26/05

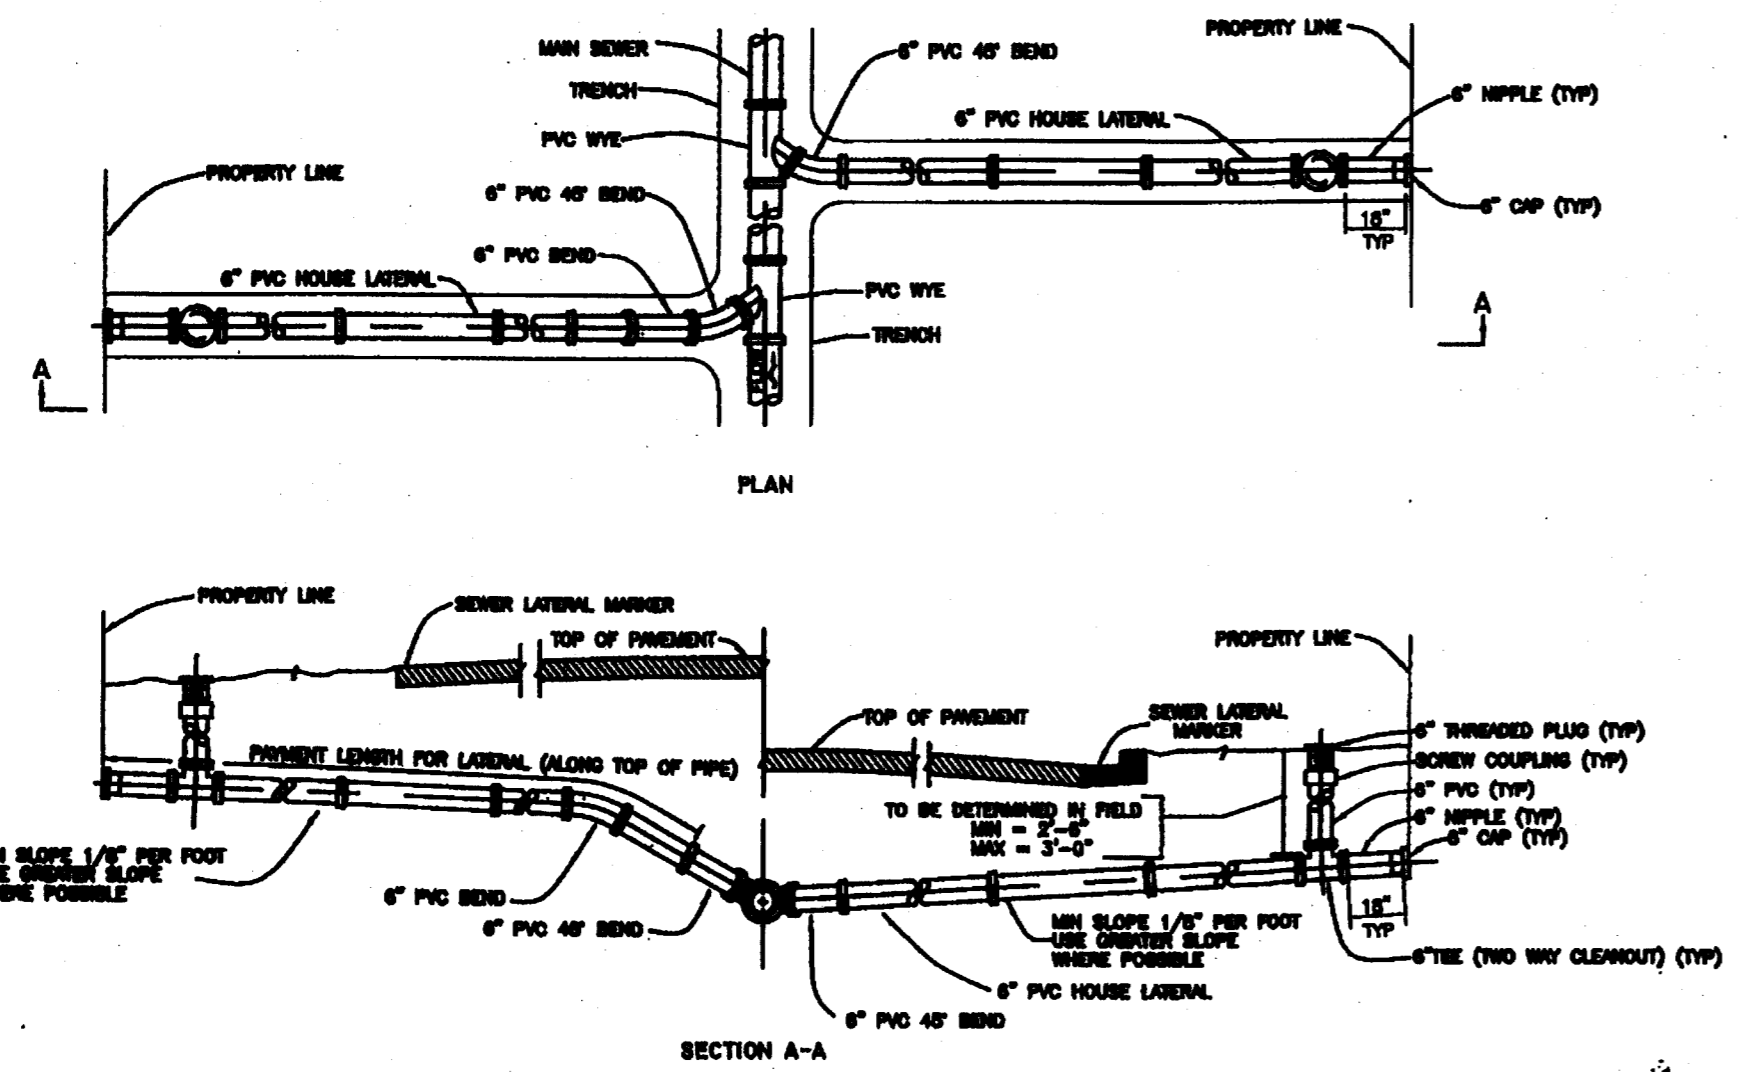


TYPE A HOUSE LATERAL DETAIL
NOT TO SCALE

NOTES

1. THE LOCATIONS OF HOUSE LATERALS BY SYMBOLS ON PLANS ARE APPROXIMATE ONLY AND THE EXACT LOCATIONS AND DEPTHS WILL BE DETERMINED BY THE FIELD BY THE CONTRACTOR WITH THE APPROVAL OF THE ENGINEER.
2. THE MINIMUM DIAMETER OF ALL HOUSE LATERALS SHALL BE 6".
3. HOUSE LATERALS WHICH PASS UNDER DRIVEWAYS SHOULD HAVE LESS THAN 1/8" OF COVER OR UNDER PORCHES AND PATIOS LESS THAN 1/4" OF COVER UNDER PORCHES SHALL BE CLASS 54 FIELD-LINED 6" PVC UNDERDRIVE.
4. THE ENGINEER'S RESPONSIBILITY IS LIMITED TO THE VERIFICATION OF THE LOCATION OF HOUSE LATERALS AND THE DEPTHS OF THE HOUSE LATERALS AS SHOWN ON THE PLANS. IT IS THE CONTRACTOR'S RESPONSIBILITY TO ADDRESS THE MOST COMMON CONFLICT CONDITIONS.
5. THE MINIMUM CLEARANCE FROM HOUSE LATERALS AND MAIN LINES SHALL BE 6" TO ALL UTILITIES EXCEPT 12" WATER MAINS. IF A HOUSE LATERAL IS BELOW A WATER MAIN AND THE CLEARANCE IS LESS THAN 6" THE CONTRACTOR SHALL PROVIDE A 12" WATER MAIN CROSSING OVER/UNDER THE WATER MAIN.
6. IF THE HOUSE LATERAL MUST PASS OVER ANY UTILITY OTHER THAN A WATER MAIN WITH LESS THAN 6" CLEARANCE, THE LATERAL SHALL BE 8" PVC.
7. IF THE HOUSE LATERAL MUST PASS UNDER ANY UTILITY OTHER THAN A WATER MAIN WITH LESS THAN 1/8" CLEARANCE, THE LATERAL SHALL REMAIN 6" PVC PIPE UNLESS THE UTILITY PROVIDES A STRUCTURAL LOAD TOO HEAVY FOR THE 6" PVC LATERAL. EACH CONFLICT WILL BE RESOLVED ON A CASE BY CASE BASIS.
8. TRANSITIONS FROM 8" TO 6" PVC TO 8" OR 10" OR 12" RIGID PIPE SHALL BE MADE WITH PVC BEND ADAPTERS. TRANSITIONS FROM 8" TO 6" PVC TO 8" OR 10" OR 12" RIGID PIPE SHALL BE MADE WITH PERFORATED FLEXIBLE ADAPTERS OR SADDLES.

CONNECTION DETAIL
NOT TO SCALE

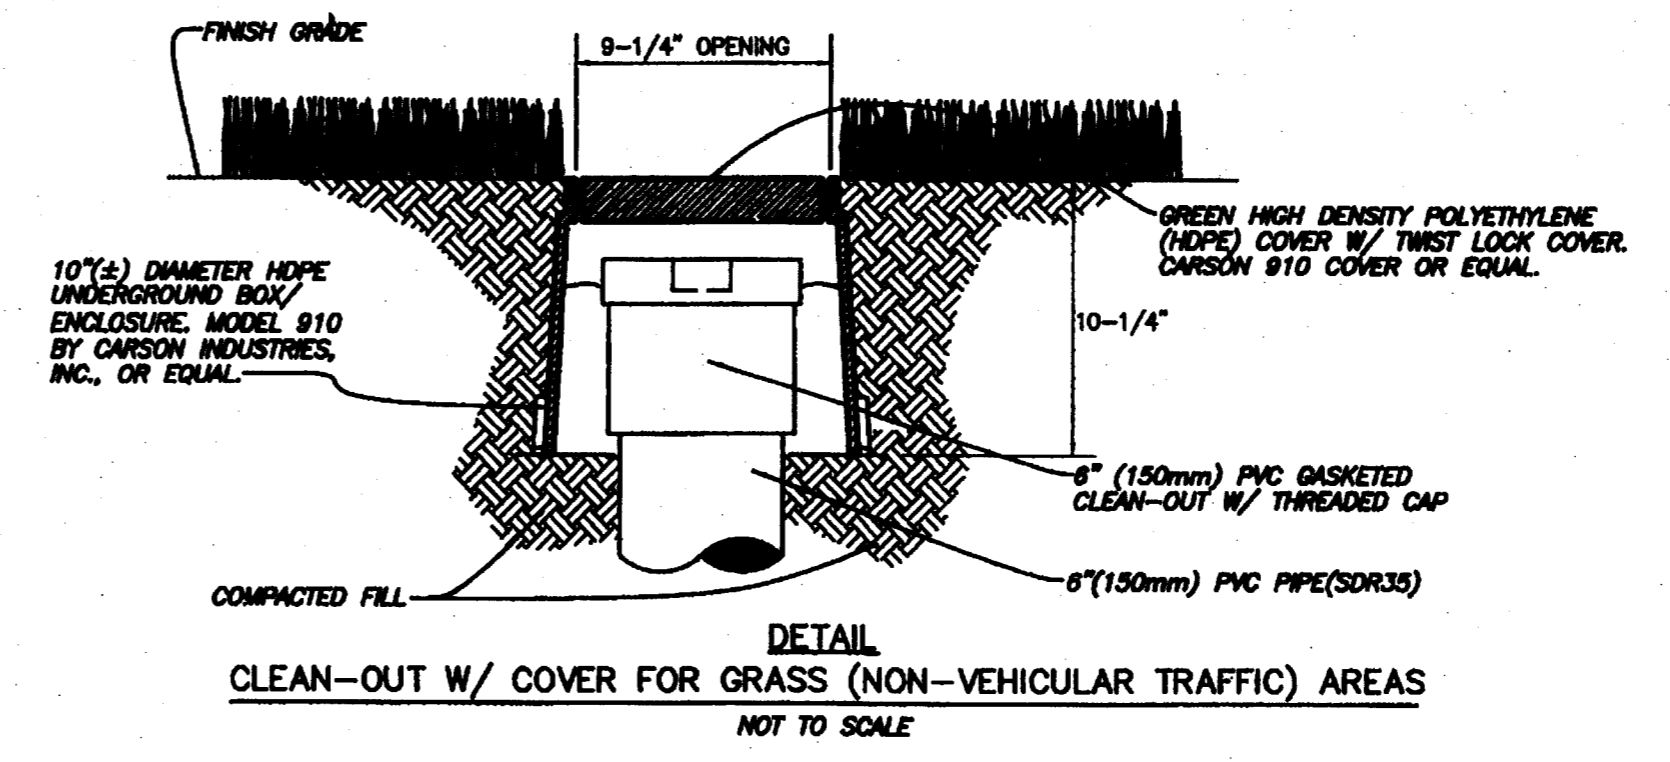

DETAIL
CLEAN-OUT W/ COVER FOR GRASS (NON-VEHICULAR TRAFFIC) AREAS
NOT TO SCALE

NOTES:

1. CONTRACTOR SHALL ADJUST THE CLEAN-OUT AND CAST IRON RING AND COVER OR HDPE BOX AND COVER SO THAT THE COVER IS SEATED SECURELY AND THE TOP OF THE COVER IS FLUSH WITH THE FINISH GRADE. THE PVC CAP OF THE CLEAN OUT SHALL BE NO MORE THAN 4 INCHES DEEPER THAN THE FINISH GRADE.
2. PVC CAP MAY BE PROVIDED WITH RECESSED NUT.
3. CAST IRON COVER SHALL BE PROVIDED WITH AN EMBOSSED LETTER "S" FOR IDENTIFICATION. HDPE COVER SHALL BE MARKED "SEWER" FOR IDENTIFICATION.
4. CAST IRON RING AND COVER, OR HDPE BOX AND COVER, AS WELL AS THE FOUR (4 SQ) SQUARE FEET OF MATERIAL (CONCRETE OR ASPHALT AROUND THE CLEAN OUT) ARE PART OF THE CLEAN-OUT INSTALLATION AND COST SHALL BE INCLUDED WITHIN THE UNIT PRICE FOR CLEAN-OUT WITH NO ADDITIONAL PAYMENT.
5. ALL CLEAN-OUTS ON THIS PROJECT SHALL BE ONE OF THE TYPES SHOWN ON THIS SHEET. FIELD CONDITIONS WILL DETERMINE WHICH TYPE.


CLEANOUT COVER DETAIL
NOT TO SCALE

CUSCADEN POOL RENOVATION

CITY OF TAMPA
306 East Jackson Street
Tampa, Florida 33602

Project No.0202.00	
Distribution	Date
810 DOCUMENTS	02.02.04

UTILITY DETAILS

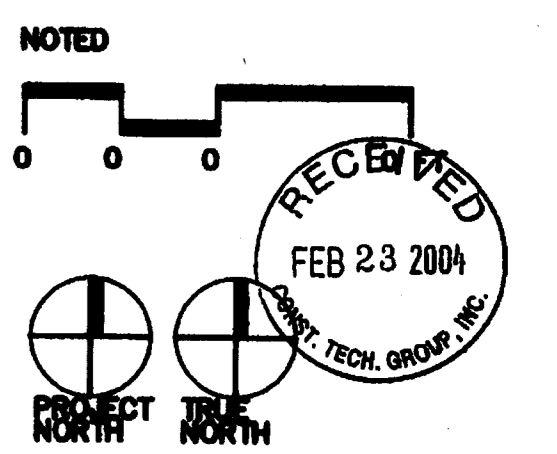

C6 RECORD DWG.

DATE 8/26/05 217/009

KEYNOTE LEGEND
INSTANCES OF ALL NOTES ARE TYPICAL
10620 FIRE-PROTECTION SPECIALTIES
10520.A1 Portable Fire Extinguishers
10520.K1 Fire Extinguisher Cabinet

F14 KEYNOTES

PLUMBING FIXTURE TABULATION


TOILET FIXTURES REQUIRED BY 2001 FLORIDA BUILDING CODE BY ASSOCIATED OCCUPANCY

COUNT BY POOL SF PER CODE			
DISTRIBUTION BY 2001 FLORIDA BUILDING CODE			
POOL SURFACE AREA	7,827 SF	Required	Provided
MEN			
WATER CLOSETS		4	4
URINALS		4	4
LAVATORIES		4	4
WOMEN			
WATER CLOSETS		12	12
LAVATORIES		4	5
DRINKING FOUNTAINS		2	2
RINSE SHOWER		0	0
SHOWER STALLS		0	0

GENERAL NOTES

- A. CONNECTION TO A FUTURE EMERGENCY ELECTRIC POWER: WILL BE PROVIDED IN ACCORDANCE WITH THE NATIONAL ELECTRIC CODE.
- B. ACCESSIBILITY FOR THE DISABLED WILL BE PROVIDED IN ACCORDANCE WITH THE FLORIDA BUILDING CODE, CHAPTER 11.
- C. SMOKE DETECTION WILL BE PROVIDED IN ACCORDANCE WITH THE FLORIDA MECHANICAL CODE.
- D. FIRE ALARM SYSTEM WITH VOICE COMMUNICATION & FIRE DEPARTMENT NOTIFICATION WILL BE PROVIDED IN ACCORDANCE WITH GOVERNING CODES.
- E. FIRE EXTINGUISHERS WILL BE PROVIDED IN ACCORDANCE WITH GOVERNING CODES.

Red Bone
07.13.04

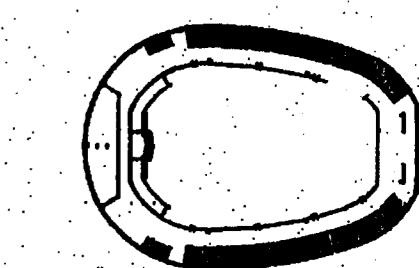

CUSCADEN POOL RENOVATION

CITY OF TAMPA
306 East Jackson Street
Tampa, Florida 33602

Project No.0202.00

Distribution	Date
BID DOCUMENTS	02.02.04
REVISION A	07.14.04

CODE COMPLIANCE PLAN
First Floor

RECORD DWG

DATE *8/26/05*
REVISED


JUL 16 2004

CITY OF TAMPA
COMMERCIAL PLAN REVIEW

DRAWING LEGEND - LIFE SAFETY

- PRIMARY EXIT
- TWO HOUR FIRE RATED WALL OR PARTITION
- EXIT TRAVEL DISTANCE
- TRAVEL DISTANCE TO FIRE EXTINGUISHERS
- 1 HOUR, B-LABEL FIRE RATED DOOR
- EXIT LIGHT
- FIRE EXTINGUISHER CABINET WITH FIRE EXTINGUISHER
- WALL MOUNTED FIRE EXTINGUISHER

A14 LEGENDS

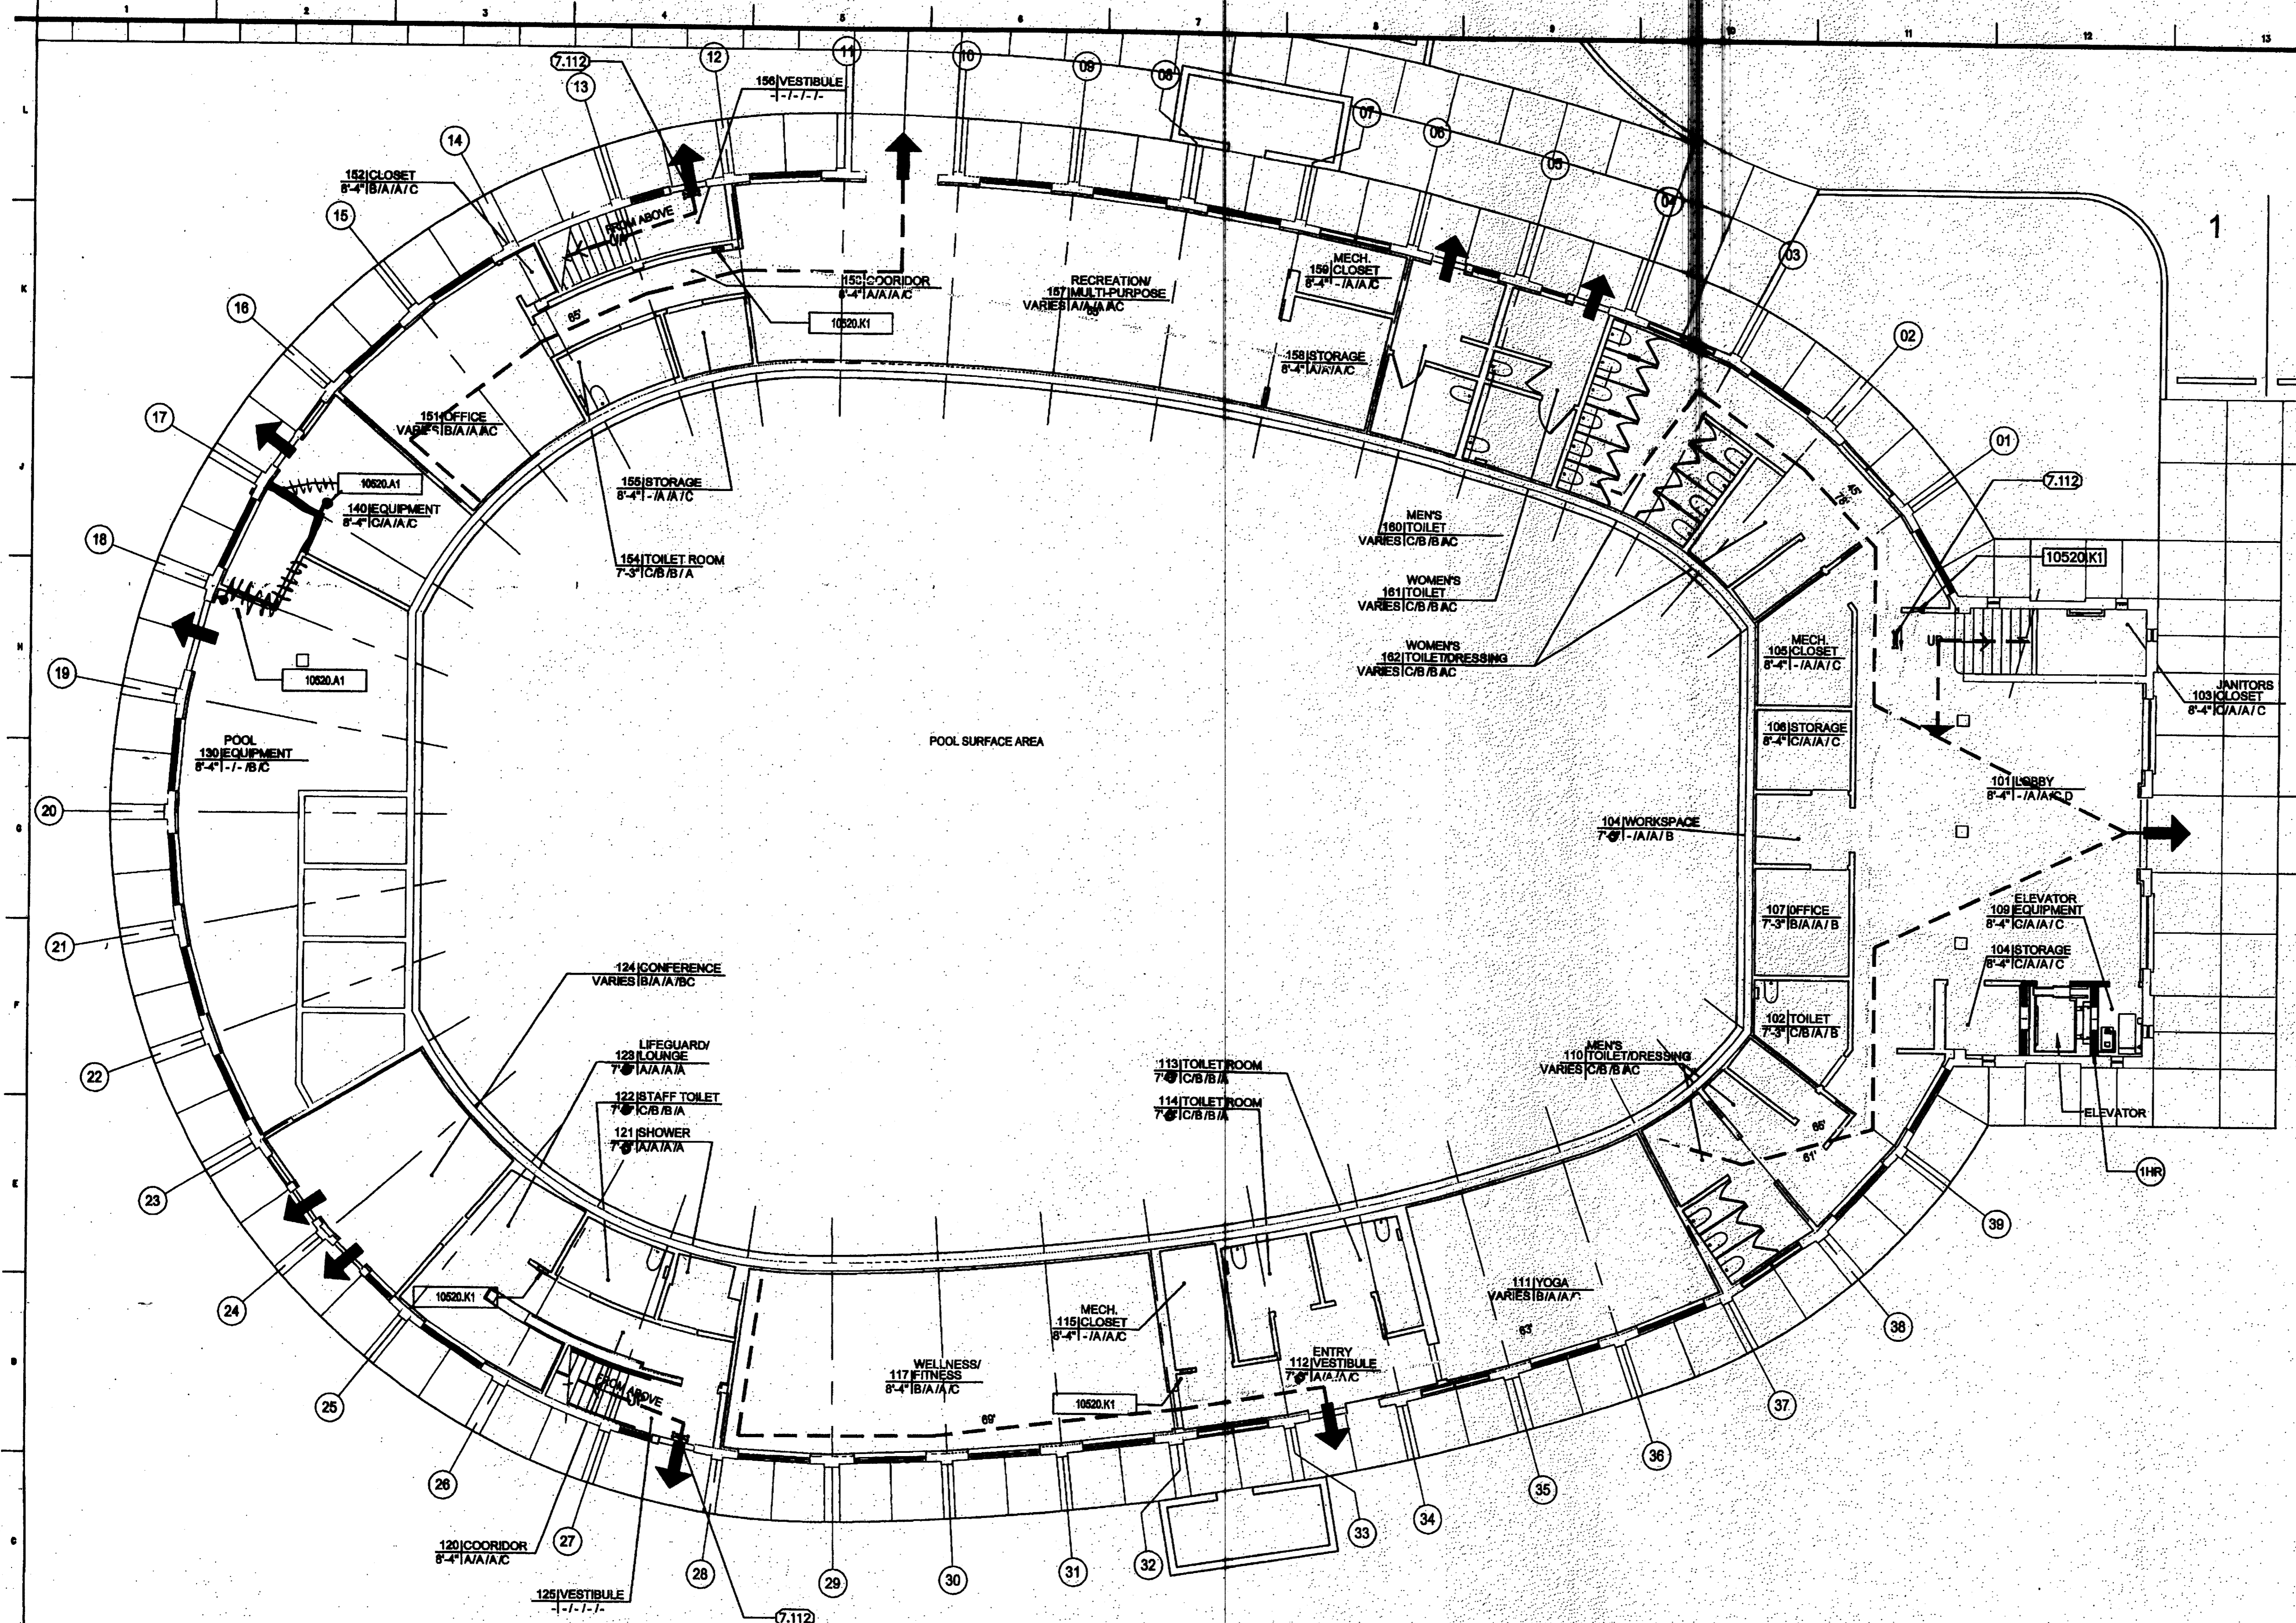

A1 CODE COMPLIANCE PLAN - First Floor

1/8"=1'-0"

CODE SUMMARY

CODE AUTHORITY:
FLORIDA BUILDING CODE, 2001
FLORIDA FIRE PREVENTION CODE, 2001
NATIONAL ELECTRIC CODE

OCCUPANCY CLASSIFICATION:
1. NEW BUSINESS: ALL AREAS, 100 GSF/OCCUPANT
FIRST FLOOR: 7,721 GSF = 77 OCCUPANTS
SECOND FLOOR: 633 GSF = 6 OCCUPANTS
2. ASSEMBLY: POOL DECK, 30 GSF/OCCUPANT
POOL SURFACE, 50 GSF/OCCUPANT
POOL DECK: 7,345 GSF = 245 OCCUPANTS
POOL SURFACE: 5,152 GSF = 163 OCCUPANTS
TOTAL PERSONS = 461 PERSONS

TYPE IV CONSTRUCTION, UNPROTECTED, UNSPRINKLERED
HEIGHT LIMIT: 55'-0"
AREA DENSITY: 17,000 SQ FT

EGRESS:
BUSINESS OCCUPANCY, UNSPRINKLERED, MAXIMUMS:
COMMON PATH OF TRAVEL: 75'-0"
DEAD END CORRIDOR: 20'-0"
TRAVEL DISTANCE TO EXIT: 200'-0"
REQUIRED EGRESS CAPACITY: 0.2 / PERSON
(112)(0.2) = 22.4'
LEVEL (RAMPS/DOORS/CORRIDORS)
MINIMUM CORRIDOR WIDTH: 44" (36" IF SERVES LESS THAN 50)
MINIMUM CLEAR OPENING OF EXIT DOORS: 32"
MINIMUM NUMBER OF EXITS: 2


CODE DATA

MAX. HEIGHT ALLOWED:
MAX. NO. OF STORIES ALLOWED:
MAX. TRAVEL DIST. TO EXIT ALLOWED: 200 FT.
MAX. AREA ALLOWED:
MIN. OCCUPANT LOAD:

BUILDING AREA

GROSS BUILDING AREA:
FIRST FLOOR: 7,721 SF
SECOND FLOOR: 633 SF
POOL DECK: 7,345 SF
POOL SURFACE: 5,152 SF
TOTAL: 23,851 SF

3

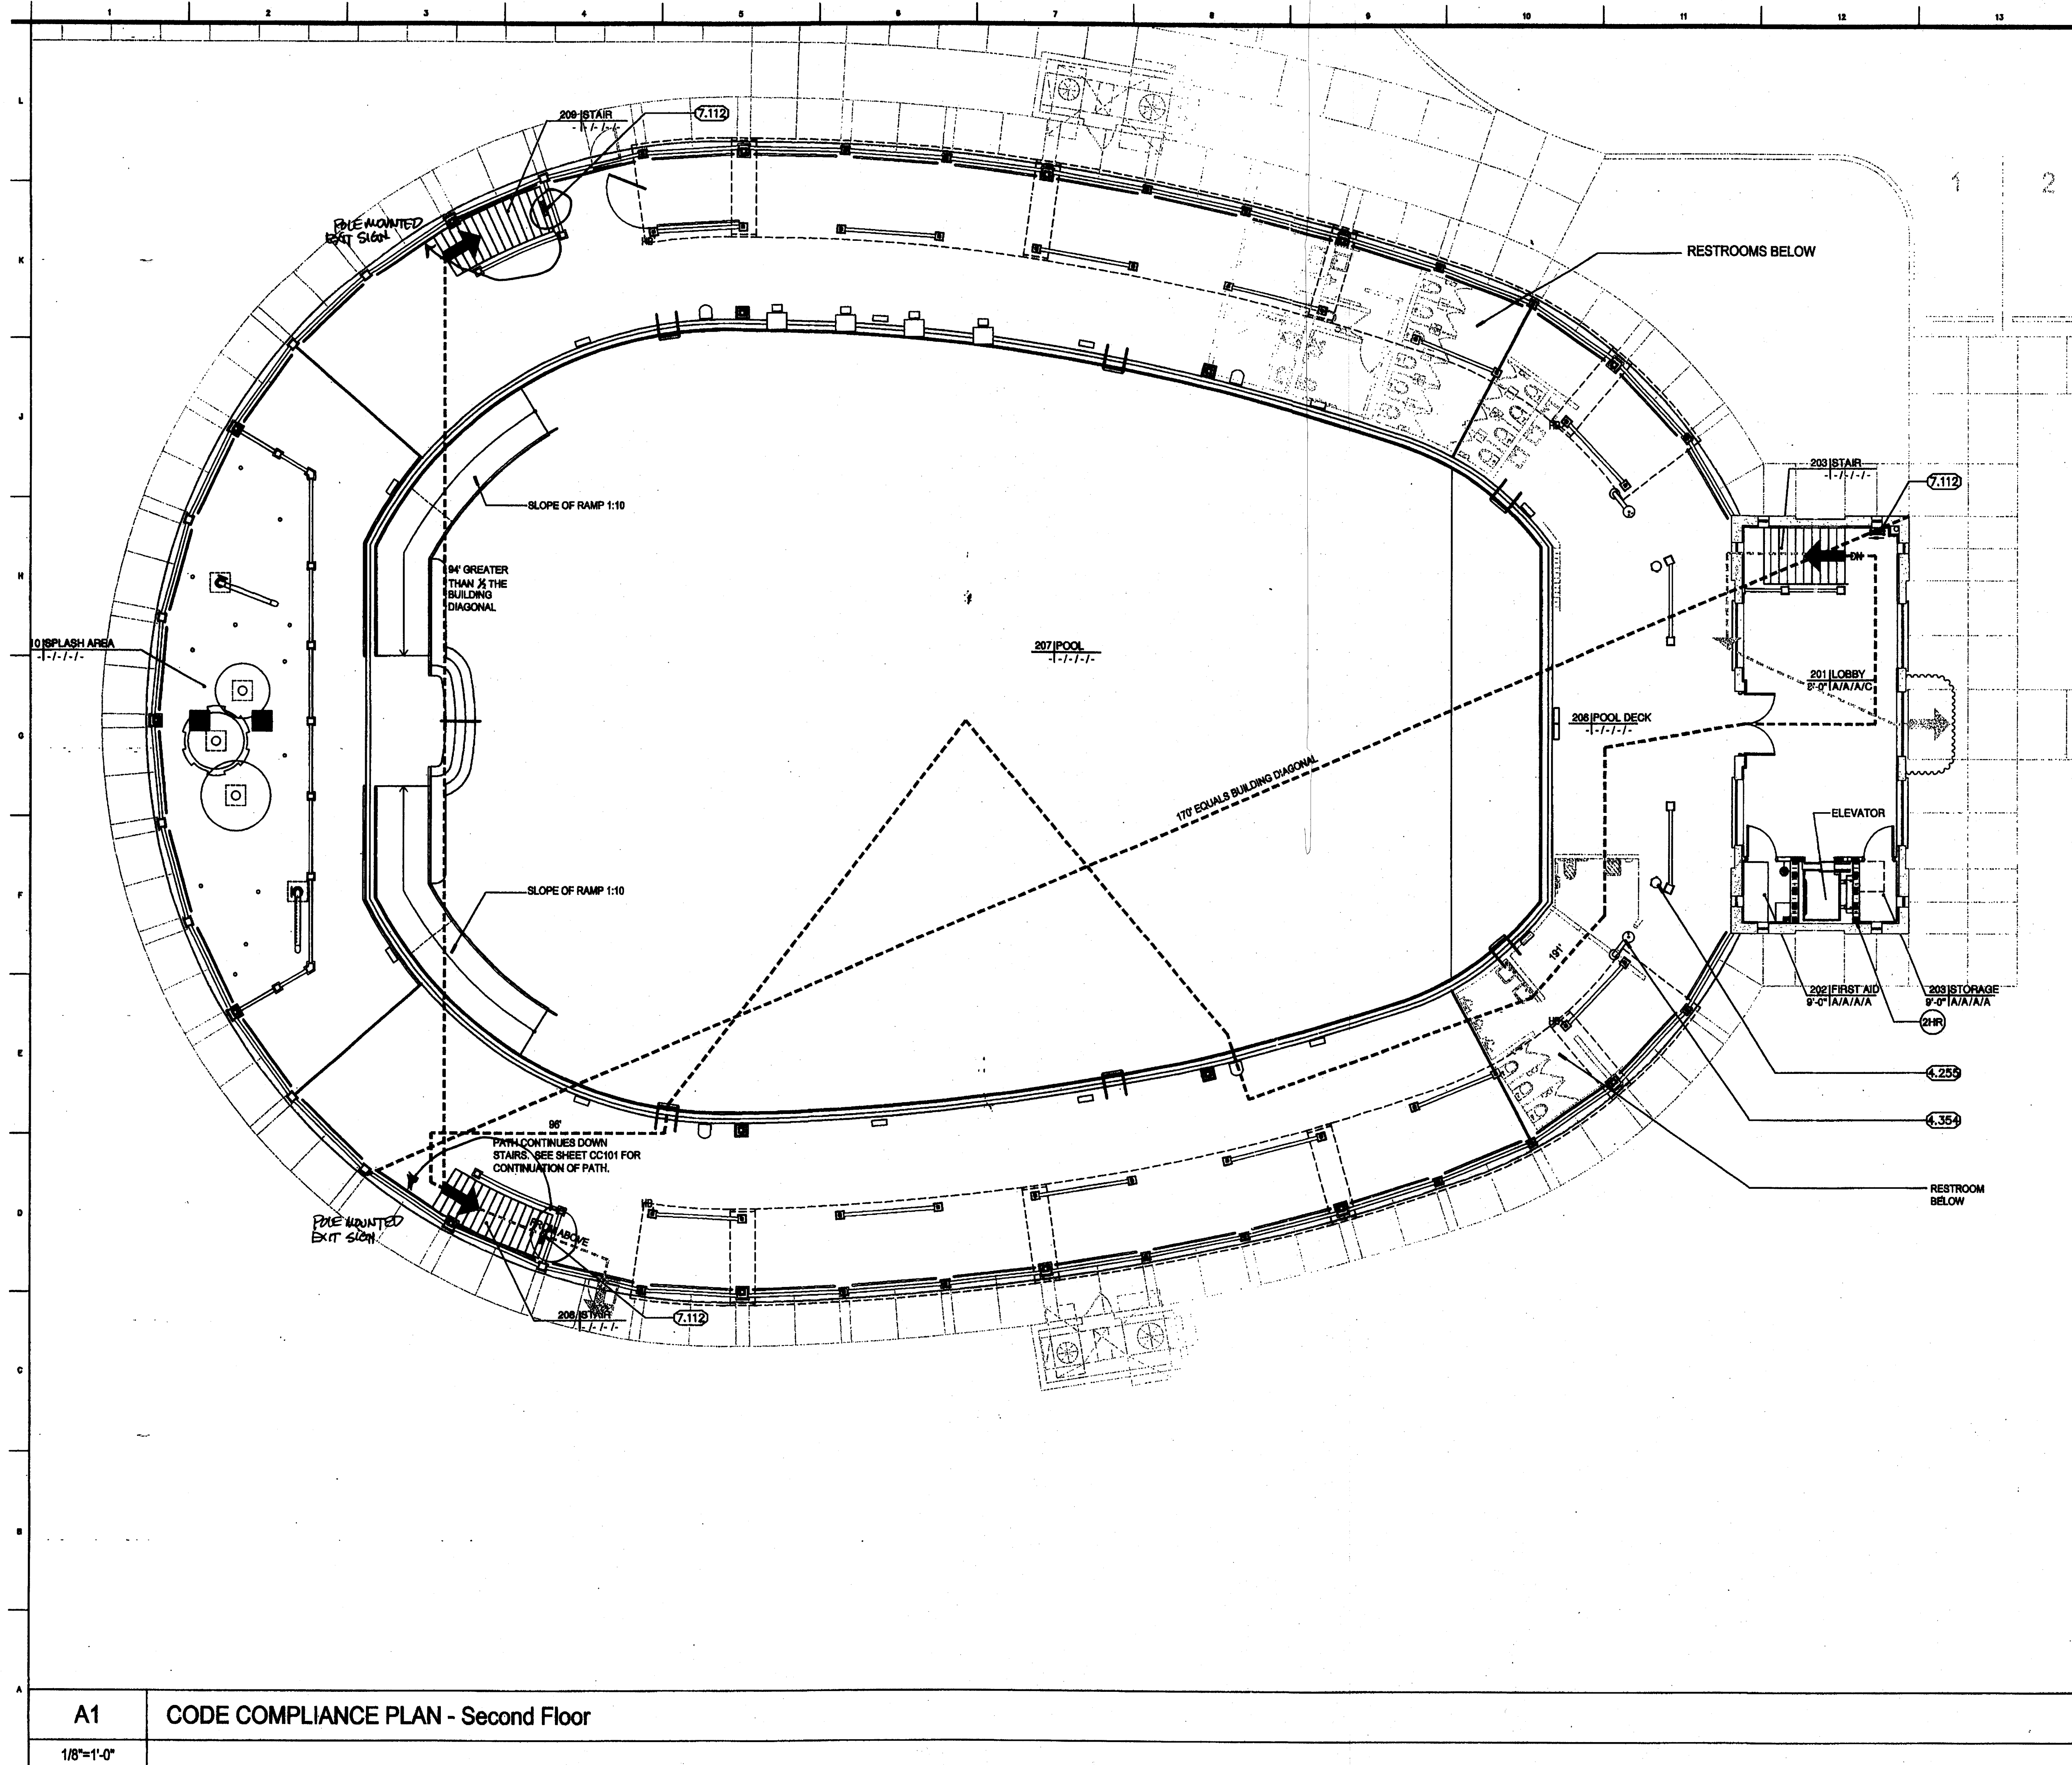


GENERAL NOTES
 7.000 ELECTRICAL
 7.112 exit light fixture

F14 KEYNOTES

DRAWING LEGEND - LIFE SAFETY

	PRIMARY EXIT
	TWO HOUR FIRE RATED WALL OR PARTITION
	TWO HOUR FIRE RATED WALL OR PARTITION
	EXIT TRAVEL DISTANCE
	1 HR 1 HOUR, B-LABEL FIRE RATED DOOR
	EXIT LIGHT
	FIRE EXTINGUISHER CABINET WITH FIRE EXTINGUISHER
	WALL-MOUNTED FIRE EXTINGUISHER

ROWE ARCHITECTS
 INCORPORATED
 100 Madison Street, Suite 200
 Tampa, Florida 33602.4704
 www.RoweArchitects.com
 Fax: 813.221.9154
 813.221.8771
 AAC002172

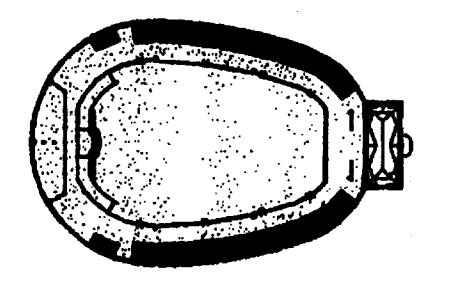

CUSCADEN POOL RENOVATION

CITY OF TAMPA
 308 East Jackson Street
 Tampa, Florida 33602

Project No.	0202.00
Distribution	Date
BID DOCUMENTS	02.02.04


CODE COMPLIANCE PLAN
 First Floor
RECORD DWG
 DATE 2/26/05



A1 CODE COMPLIANCE PLAN - Second Floor
 1/8"=1'-0"


A14 LEGENDS

CC102

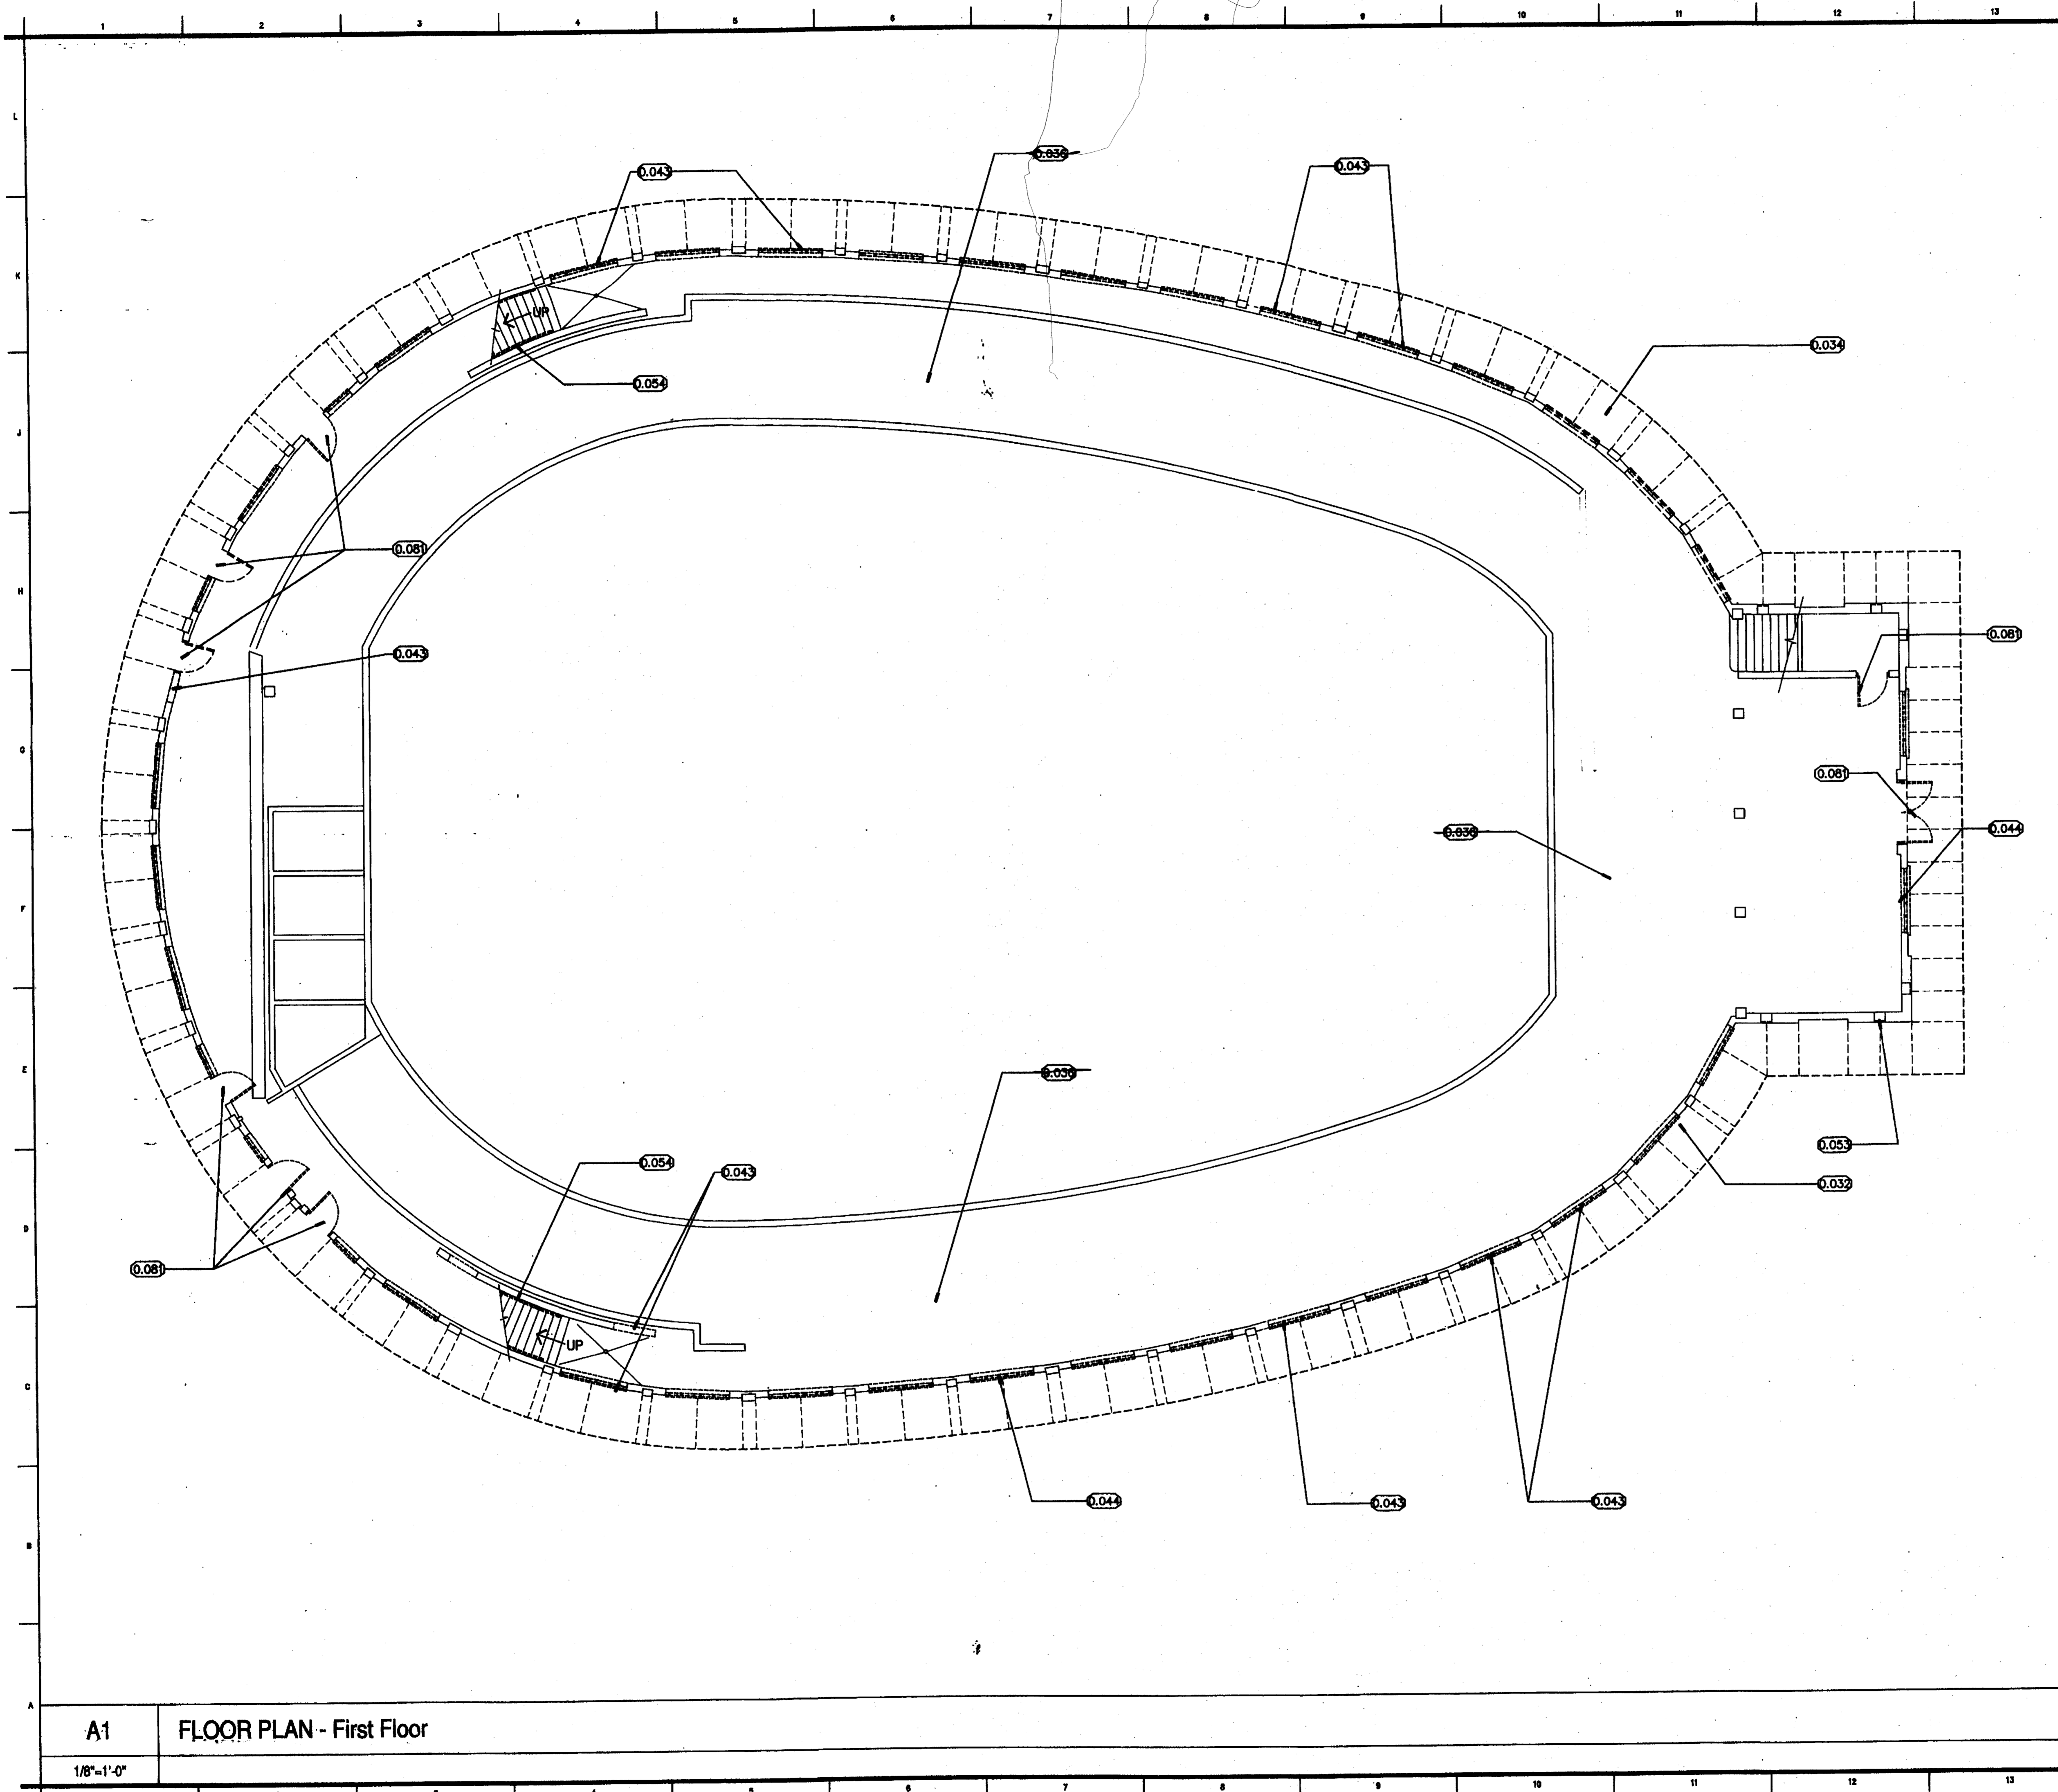

- GENERAL NOTES**
- 0.000 DEMOLITION
 - 0.032 line of pool deck slab above
 - 0.034 remove existing concrete sidewalk, typical
 - 0.036 patch - create end - imperfections on underside - existing pool deck slab
 - 0.043 remove existing masonry as required for new opening
 - 0.044 remove existing concrete louver
 - 0.053 remove existing steel plate
 - 0.054 remove existing handrail
 - 0.081 remove existing door and frame

F14 KEYNOTES

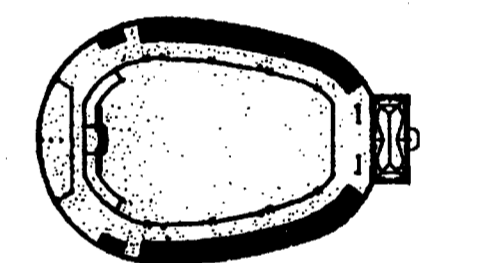

CUSCADEN POOL RENOVATION

CITY OF TAMPA
306 East Jackson Street
Tampa, Florida 33602

Project No.	0202.00
Distribution	Date
BID DOCUMENTS	02.02.04

DEMO PLAN
First Floor

RECORD DWG.

DATE 8/26/05

PROJECT NORTH TRUE NORTH


RECEIVED
FEB 23 2004
D101

2/7
009

A1 FLOOR PLAN - First Floor

A14 LEGEND / NOTES


1/8"=1'-0"

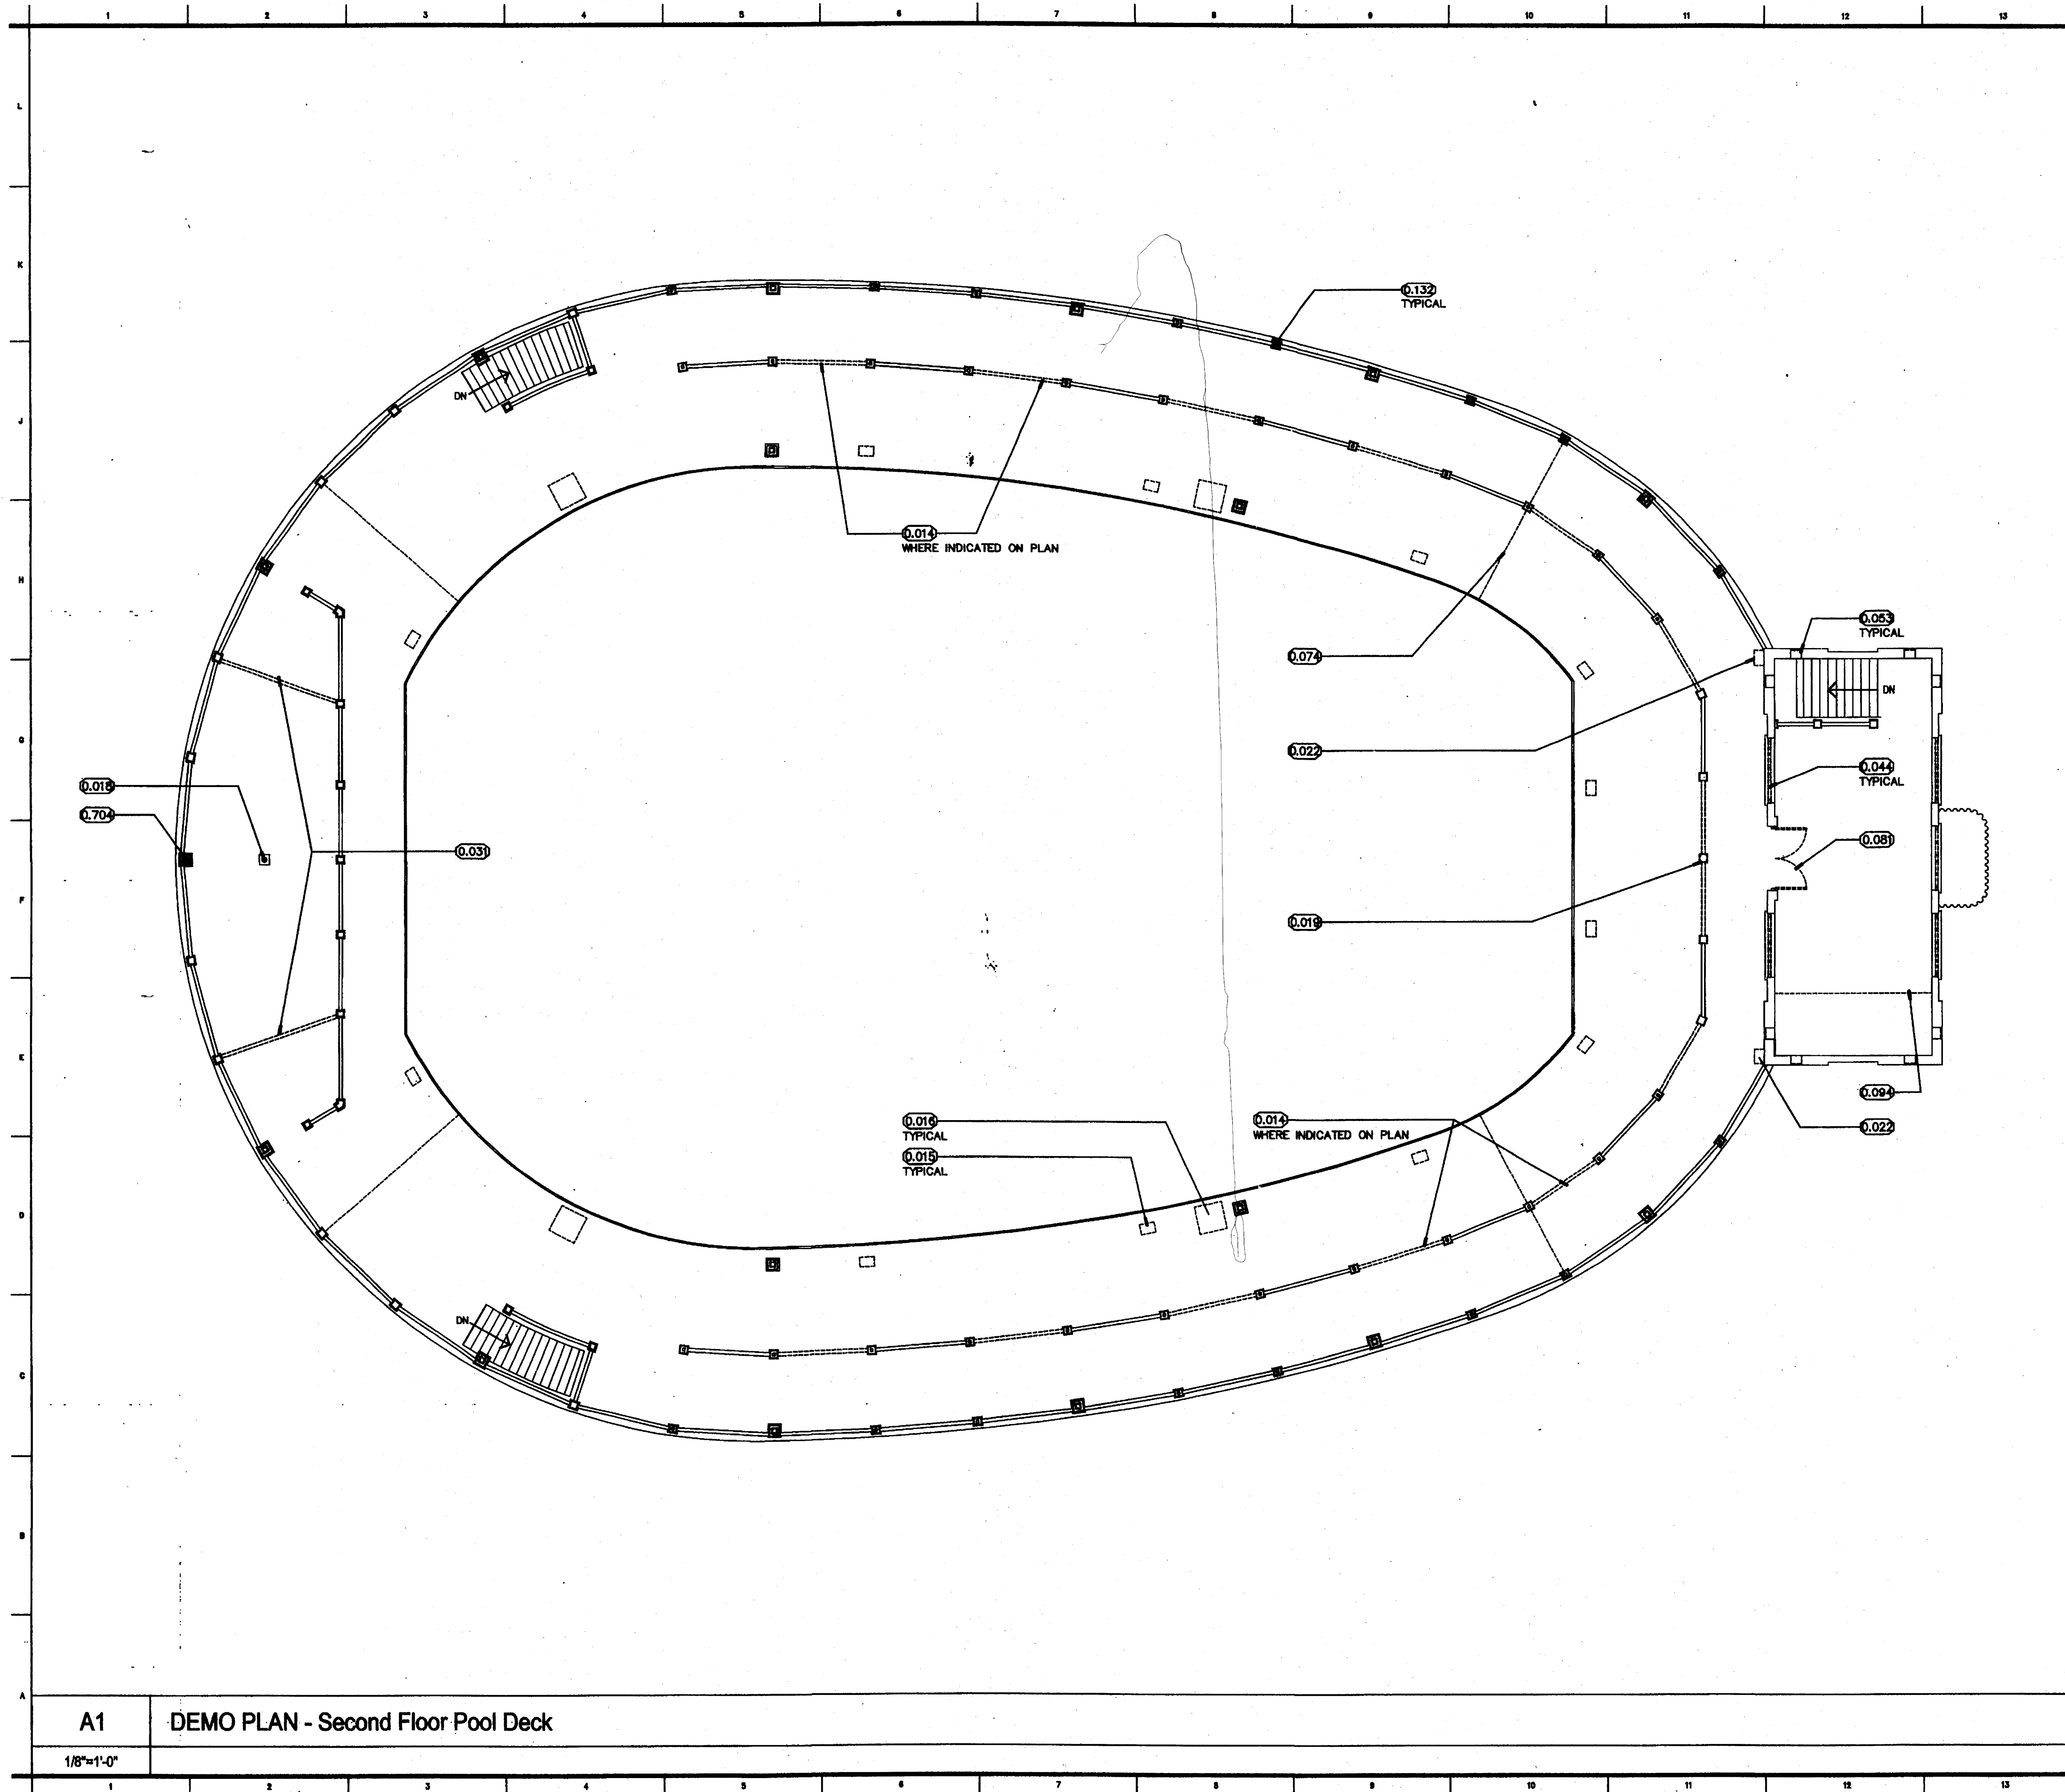

- GENERAL NOTES**
- 0.000 DEMOLITION
 - 0.014 remove existing railings and curbs, typical
 - 0.015 remove existing pool depth markers, typical
 - 0.016 remove existing lifeguard stands, typical
 - 0.018 remove existing drain to slab level
 - 0.019 remove existing balluster
 - 0.022 remove existing light fixture
 - 0.031 remove curb to exist pool deck level
 - 0.044 remove existing concrete louver
 - 0.053 remove existing metal plate
 - 0.074 remove existing expansion joint sealant, typical
 - 0.081 remove existing door and frame
 - 0.094 remove existing raised floor
 - 0.132 existing concrete poles to remain
 - 0.704 remove existing light fixture

F14	KEYNOTES
-----	----------

ROWE ARCHITECTS
INCORPORATED
100 Madison Street, Suite 200
Tampa, Florida 33602-4704
www.RoweArchitects.com
Fax: 813.221.9154
813.221.8771
AAC002172

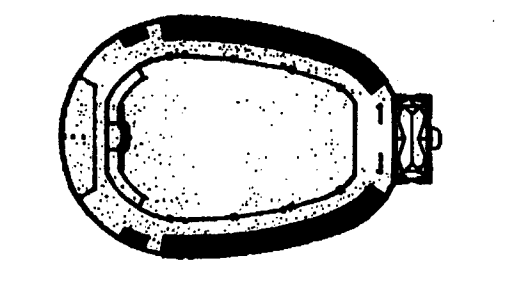


**CUSCADEN
POOL
RENOVATION**

CITY OF TAMPA
306 East Jackson Street
Tampa, Florida 33602

Project No.	0202.00
Distribution	Date
BID DOCUMENTS	02.02.04

DEMO PLAN
Second Floor
Pool Deck

RECORD DWG.
DATE 8/26/05

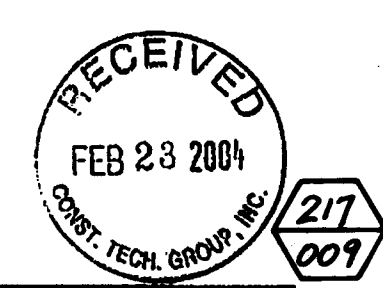

A1 DEMO PLAN - Second Floor Pool Deck
1/8"=1'-0"

A14 LEGEND / NOTES

D102

ELECTRICAL SYMBOL LEGEND		
SYMBOL	DESCRIPTION	MOUNTING AND NOTES
	TYPICAL LIGHTING SYMBOL NOTES 1. UPPER CASE LETTER INDICATES FIXTURE TYPE, SEE FIXTURE SCHEDULE. 2. LOWER CASE LETTER INDICATES SWITCHED LEG. 3. SHARED FIXTURE SYMBOL INDICATES EMERGENCY FIXTURE. 4. "NL" INDICATES NIGHT LIGHT CIRCUIT.	
	CEILING OUTLET FOR INCANDESCENT, "PL" FLUORESCENT OR HIGH INTENSITY DISCHARGE DISCHARGE EQUIVALENT FIXTURE.	SEE FIXTURE SCHEDULE
	WALL OUTLET FOR INCANDESCENT, "PL" FLUORESCENT OR HIGH INTENSITY DISCHARGE DISCHARGE EQUIVALENT FIXTURE.	SEE FIXTURE SCHEDULE
	CEILING OUTLET FOR 2x4 FLUORESCENT FIXTURE.	SEE FIXTURE SCHEDULE
	CEILING OUTLET FOR 2x2 FLUORESCENT FIXTURE.	SEE FIXTURE SCHEDULE
	CEILING OUTLET FOR 1x4 FLUORESCENT FIXTURE, SURFACE, RECESSED, VANAVAN, VANAVAN-PREED?	SEE FIXTURE SCHEDULE
	CEILING OUTLET FOR FLUORESCENT FIXTURE, PENDANT MOUNT, CHANNEL, INDUSTRIAL.	SEE FIXTURE SCHEDULE
	CEILING OUTLET FOR SINGLE FACE EXIT LIGHT FIXTURE, ARROW INDICATES DIRECTION.	SEE FIXTURE SCHEDULE
	CEILING OUTLET FOR DOUBLE FACE EXIT LIGHT FIXTURE, ARROW INDICATES DIRECTION.	SEE FIXTURE SCHEDULE
S	SINGLE POLE SWITCH	48" AFF UDN.
S ₃	THREE WAY SWITCH	48" AFF UDN.
S ₄	FOUR WAY SWITCH	48" AFF UDN.
S _H	MOTOR RATED SWITCH WITHOUT THERMAL OVERLOADS FOR FRACTIONAL HORSEPOWER MOTORS.	
S _{sc}	SPEED CONTROL	
S _K	SINGLE POLE SWITCH KEY OPERATED	48" AFF UDN.
S ₂	WALL BOX TYPE DIMMER SWITCH PROVIDE DIMMING BALLAST WHERE REQUIRED.	48" AFF UDN.
	TYPICAL RECEPTACLE, OUTLET AND JUNCTION BOX SUFFIX LEGEND: EVC = ELECTRIC WATER COOLER EWH = ELECTRIC WATER HEATER GFI = GROUND FAULT INTERRUPTER EX = EXPLOSION PROOF UP = UP (CONDUIT) DN = DOWN (CONDUIT) E = EXISTING IG = ISOLATED GROUND D = DIVERT R = RAMP VP = WEATHERPROOF PS = PAYPHONE STATION REF = REFRIGERATOR P = PEDestal	
	DUPLEX RECEPTACLE (GSA, 150V), FLOOR	FLUSH FLOOR OUTLET
	DUPLEX RECEPTACLE (GSA, 150V).	NH, 16" AFF UDN.
	DUPLEX RECEPTACLE (GSA, 150V), ABOVE COUNTER.	48" AFF, ABOVE COUNTER BACKSLASH UDN.
	DOUBLE DUPLEX RECEPTACLE (GSA, 150V), FLOOR	FLUSH FLOOR OUTLET
	DOUBLE DUPLEX RECEPTACLE (GSA, 150V).	16" AFF UDN.
	RANGE RECEPTACLE, 30A, 250V, ONE PHASE, FOUR WIRE.	4" AFF UDN.
	DRYER RECEPTACLE, 30A, 250V, ONE PHASE, FOUR WIRE.	36" AFF UDN.
	SPECIAL PURPOSE RECEPTACLE, AMPS, VOLTS AND WIRE AS NOTED.	18" AFF UDN.
	JUNCTION OR OUTLET BOX, 4" SQUARE BOX UDN.	AS NOTED
	FLOOR MOUNTED JUNCTION OR OUTLET BOX, 4" SQUARE BOX UDN.	AS NOTED
30/3	NON-FUSIBLE DISCONNECT SWITCH, 30A, 3 POLE, UDN.	SEE SPECIFICATIONS
60/40/3	FUSIBLE DISCONNECT SWITCH, AMPS/FUSE SIZE/NO. POLES AS NOTED.	SEE SPECIFICATIONS
	COMBINATION MAGNETIC MOTOR STARTER	SEE SPECIFICATIONS
	VARIABLE FREQUENCY DRIVE	
	MOTOR, NUMERAL INDICATES HORSEPOWER	BY OTHER DIVISION
	ELECTRIC DUCT HEATER	BY OTHER DIVISION
	VARIABLE AIR VOLUME CONTROL	
	DRY TYPE TRANSFORMER, SIZE AS SHOWN ON RISER	FLOOR OR AS NOTED
	PANELBOARD, 120/200V, 3 PH, 4W	6'-6" AFF NDN TO TOP
	TELEPHONE TERMINAL CABINET	NH, 6'-6" NDN TO TOP
	TELEPHONE TERMINAL BOARD, AS NOTED	6'-6" AFF NDN TO TOP
	RACEWAY RISER, UP OR DOWN AS NOTED.	SEE SPECIFICATIONS
	RACEWAY CONCEALED UNDER FLOOR, IN SLAB OR BELOW GRADE	SEE SPECIFICATIONS
	RACEWAY CONCEALED IN WALL OR CEILING	SEE SPECIFICATIONS
	HOMERUN TO PANEL, LETTERS INDICATE PANEL, NUMBERS INDICATE CIRCUITS.	SEE SPECIFICATIONS

NOTE:
NOT ALL SYMBOLS SHOWN IN THIS LEGEND MAY NECESSARILY APPEAR IN THESE DOCUMENTS. ADDITIONAL SYMBOLS MAY BE DEFINED ELSEWHERE IN SPECIFIC DRAWINGS.

Legend - Electrical

N.T.S.

ELECTRICAL SYMBOL LEGEND		
SYMBOL	DESCRIPTION	MOUNTING AND NOTES
	TYPICAL FIRE ALARM DEVICE SUFFIX LEGEND: F = FLASHING STROBE LIGHT S = SUPPLY R = RETURN	
	FIRE ALARM HEAT DETECTOR	CEILING, UDN.
	FIRE ALARM PHOTOELECTRIC SMOKE DETECTOR	CEILING, UDN.
	FIRE ALARM PHOTOELECTRIC DETECTOR, INSIDE DUCT.	DUCT
	FIRE ALARM MANUAL PULL STATION	48" AFF TO TOP, UDN.
	FIRE ALARM SYSTEM FAN OR AHU SHUTDOWN OR RUN RELAY	
	FIRE ALARM DUCT SMOKE DETECTOR TEST SWITCHES & LIGHTS, ONE PER SMOKE DUCT DETECTOR	48" AFF TO TOP, UDN.
	FIRE ALARM HORN (WEATHER PROOF WHEN INSTALLED OUTDOORS.)	8'-0" AFF TO TOP, UDN.
	FIRE ALARM HORN/FLASHING STROBE LIGHT.	80" AFF TO TOP, UDN.
	FIRE ALARM WITH FLASHING STROBE LIGHT.	80" AFF TO TOP, UDN.
	FIRE ALARM CONTROL PANEL.	NH, 60" NDN TO TOP
	FIRE ALARM REMOTE ANNUCIATOR PANEL.	NH, 60" NDN TO TOP
	FIRE ALARM TERMINAL CABINET	NH, 60" NDN TO TOP
	FIRE ALARM PULL STATION SIGN - FOR INTERIOR MOUNTED STATION	NH, 48" NDN TO TOP
	FIRE ALARM PHOTOELECTRIC SMOKE DETECTOR WITH ELEVATOR RECALL CONTACTS.	CEILING, UDN.
	FIRE ALARM WATER TAMPER SWITCH	48" AFF TO TOP, UDN.
	FIRE ALARM WATER FLOW SWITCH	48" AFF TO TOP, UDN.
	SOUND SYSTEM CALL IN SWITCH	NH, 48" TO TOP, UDN.
	EMERGENCY POWER OFF SWITCH WITH LEGEND PLATE IDENTIFYING IT AS "EMERGENCY POWER OFF."	NH, 48" TO TOP, UDN.
	EMERGENCY POWER EMERGENCY EXHAUST FAN ON SWITCH WITH LEGEND PLATE IDENTIFYING IT AS "EMERGENCY EXHAUST ON."	NH, 48" TO TOP, UDN.
	POWER RESTORE SWITCH WITH LEGEND PLATE IDENTIFYING IT AS "POWER RESTORE SWITCH."	NH, 48" TO TOP, UDN.
	MECHANICALLY HELD 6 POLE CONTACTOR WITH 150V COIL CLEARING CONTACTS MOUNTED IN NEMA-1 ENCLOSURE ABOVE SUSPENDED CEILING.	MOUNTED ABOVE CEILING
	(1) RJ-45 OUTLET ORANGE ICON FOR VOICE TERMINATION	16" AFF, UDN.
	(2) RJ-45 OUTLETS (1) WITH ORANGE ICON FOR VOICE TERMINATION AND (2) WITH BLUE ICON FOR DATA TERMINATION.	16" AFF, UDN.
	REFER TO LIKE NUMBERED KEY NOTES.	

GENERAL NOTES ELECTRICAL


- DO NOT SCALE FROM THESE DRAWINGS.
- ALL WORK SHALL BE DONE IN STRICT ACCORDANCE WITH THE NATIONAL ELECTRICAL CODE.
- COORDINATE WORK WITH ALL OTHER TRADES TO ASSURE PROPER CLEARANCES FOR EQUIPMENT AND TO KEEP THE JOB PROGRESSING.
- ALL EMERGENCY SYSTEMS SHALL BE RUN IN SEPARATE RACEWAY/CONDUIT SYSTEM(S).
- PROVIDE COILED MOUNTED RED LED, ALARM INDICATOR FOR EACH SMOKE DETECTOR MOUNTED IN PLUMBING SPACE(S) OR CONCEALED AREAS.
- FROM EACH FURN MOUNTED PANEL BOARD, STRIP-OUT INTO CEILING CAVITY ABOVE, A 3/4" C. FOR EACH SET OF 3 - SPARES AND/OR SPACES OR FRACTIONS OF EITHER MET THEREOF.
- REFER TO MECHANICAL DRAWINGS FOR INTERLOCKING REQUIREMENTS OF MECHANICAL EQUIPMENT (MOTORS, PUMPS, PUMPS, ETC.). INSTALL ANY ELECTRICAL EQUIPMENT (STARTERS, RELAYS, VFD'S, ETC.) FURNISHED BY DIV 15.
- TELEPHONE RACEWAY SYSTEM: PROVIDE RACEWAY FOR TELEPHONE CABLE TO BE INSTALLED BETWEEN EACH SERVICE AND DISTRIBUTION FRAME. IN ADDITION, PROVIDE THE REQUIRED CLEARANCE BETWEEN EACH DISTRIBUTION FRAME. PROVIDE ALL TERMINAL BOUNDS, SIZED AND LOCATED, AS REQUIRED.
- ALL CEILING MOUNTED ITEMS SHALL BE INSTALLED IN ACCORDANCE WITH THE ARCHITECTURAL REFLECTIVE CEILING PLANS. IF LOCATION FOR AN ITEM IS NOT SHOWN ON THE ARCHITECTURAL REFLECTIVE CEILING PLANS, VERIFY THE EXACT LOCATION OF THE ITEM WITH THE ARCHITECT PRIOR TO INSTALLATION. THESE REQUIREMENTS APPLY TO ALL CEILING TYPES IN ALL AREAS.
- PROVIDE ADEQUATE POWER IN THE FIRE ALARM SYSTEM TO OPERATE ALL LIFE SAFETY SYSTEM AND E.M.C.S. CONTROL DEVICES.
- WHERE NON-FUSED DISCONNECT IS NOT PROVIDED "WITHIN SIGHT" OF MOTOR (OR HEATER UNIT), FEEDER (AND/OR BRANCH CIRCUIT) OVER-CURRENT DEVICE SERVING SUCH MOTOR (OR HEATER) SHALL HAVE APPROVED "LOCKED-OFF" PROVISION.
- PROVIDE WALL SWITCHES IN EACH OFFICE/AREA TO CONTROL THE LIGHT FIXTURE(S) IN EACH OFFICE/AREA.
- REFERENCE MECHANICAL DRAWINGS FOR ALL MECHANICAL EQUIPMENT MOUNTING CONNECTIONS. MAKE ALL CONNECTIONS AND PROVIDE APPROPRIATE WIRE CONDUIT AND OVERCURRENT PROTECTION FOR ALL EQUIPMENT. COORDINATE EXACT REQUIREMENTS WITH MECHANICAL CONTRACTOR.
- PROVIDE EXIT SIGNAGE AS INDICATED ON DRAWINGS.
- RECEPTACLES IN MECHANICAL ROOM, ELECTRICAL ROOMS, STORAGE ROOMS AND JANITOR CLOSETS TO BE MOUNTED 48" AFF, AND G.F.I.
- ALL EXTERIOR WIRING DEVICES TO BE WEATHERPROOF AND GROUND INTERRUPTING TYPE.
- CONDUIT RUNS SHOWN ARE DIAGRAMMATIC IN NATURE. CONTRACTOR IS RESPONSIBLE FOR SIZING AND LOCATING PULL BOXES PER NEC AND FOR COORDINATION WITH OTHER DISCIPLINES.
- ALL HLD. AND FLUORESCENT LIGHT FIXTURES SHALL BE FURNISHED WITH INTEGRAL FUSING.
- FURNISH AND INSTALL ONE (1) LIGHT FIXTURE WITH SWITCH AND ONE (1) DUPLEX RECEPTACLE IN ELEVATOR PIT. COORDINATE EXACT LOCATION WITH ELEVATOR CONTRACTOR AND INSPECTOR.
- COORDINATE EXACT LOCATIONS OF ELEVATOR DISCONNECT SWITCH WITH ELEVATOR CONTRACTOR AND INSPECTOR. PROVIDE ALL NECESSARY EQUIPMENT CONTROLS AS REQUIRED BY ELEVATOR CODE.
- COORDINATE EXACT LOCATIONS OF ALL ITEMS INSTALLED ON SITE WITH CIVIL ENGINEER.
- COORDINATE ALL LOCATIONS OF RECEPTACLES AND SYSTEMS OUTLETS WITH IN ALL CASEWORK.
- USE 10 AWG CU. CONDUCTORS FOR 30 AMPERE, 120 VOLT BRANCH CIRCUITS LONGER THAN 75 FEET. USE 90 AND CU.
- ALL SITE LIGHTING POLES AND POLE BASES SHALL BE CAPABLE OF SUPPORTING THE ENTIRE WEIGHT AND WIND LOADS (UNIDS OF 130 MPH) OF THE ENTIRE LIGHTING SYSTEM. ALL DRAWINGS MUST INCLUDE DRAWINGS OF THE ENTIRE ASSEMBLY FOR EACH OF THE MOUNTING CONFIGURATIONS USED. DRAWINGS MUST BE SIGNED AND SEALED BY A FLORIDA REGISTERED STRUCTURAL ENGINEER.

LIGHT FIXTURE SCHEDULE					
TYPE	MANUFACTURER	CATALOG NUMBER	LAMPS		REMARKS
			QTY	VOLTS MOUNTING	
A	LIGHTOLIER	QVT-1-S-PF-232-120-50-6L-EM100	2	32W TB	17x4" SURFACE MOUNTED FLUORESCENT DIRECT / INDIRECT FIXTURE. ELECTRONIC BALLAST WITH LESS THAN 100 TMD. SHARED FIXTURES PROVIDE EMERGENCY BATTERY WITH NO LESS THAN 1100 LUMEN OUTPUT. PROVIDE FUSING.
B	LIGHTOLIER	SL-8-1-S-XX-VA-232-120-1E10-6L-EM100	2	32W TB	17x4" SURFACE MOUNTED FLUORESCENT FIXTURE WITH ACRYLIC PRISMATIC 0.125" NOMINAL LENS. ELECTRONIC BALLAST WITH LESS THAN 100 TMD. SHARED FIXTURES PROVIDE EMERGENCY BATTERY WITH NO LESS THAN 1100 LUMEN OUTPUT. PROVIDE FUSING. PROVIDE DAMP LABEL.
C	LIGHTOLIER	ST-8E-8-VA-232-120-PA10-6L-EM100	2	32W TB	SURFACE MOUNTED FLUORESCENT FIXTURE WITH FIBERGLASS HOUSING. SHARED FIXTURE PROVIDE EMERGENCY BATTERY CAPABLE OF TWO LAMPS OPERATING WITH NO <100 LUMEN OUTPUT. ELECTRONIC BALLAST WITH <10% THD. DAMP LOCATION LISTED. PROVIDE FUSING.
D	KENALL	MH421-48-R-MV-PP-4-32-PR6-1-120-P61-EUSE	4	32W TB	17x4" RECESSED TAPERED REFLECTOR LUMINAIRE. FOUR FLUORESCENT LAMPS. MARINE GRADE ALUMINUM BODY WITH DIE-CAST CAPS. HIGH PRESS POLYCARBONATE LENS AND LIFETIME GUARANTEE. PROVIDE FUSING AND ALL COMPONENTS NECESSARY FOR MOUNTING. SHARED FIXTURES PROVIDE EMERGENCY BATTERY WITH NO LESS THAN 1100 LUMEN OUTPUT.
F	HALO PRESOLITE CAPRI LITHONIA	H77-71 PBX-TL1 R9-R16P-50W LP6-6L02	1	60W A19	7" RECESSED DOWNLIGHT WITH 80 WATT INCANDESCENT LAMP. PLASTIC DROP OPAL LENS. UL LISTED FOR DAMP LOCATIONS.
G	RAL G.E. PHOENIX	VPW8100-60-175 H7-X15F-3W-00 VP 100	1	100W	ENCLOSED AND GASKETED INCANDESCENT FIXTURE. CLEAR GLASS GLOBE. DIE CAST ALUMINUM GUARD.
H	GARCOO	MAG18-1/2-3-175MH-277-XX-F	1	175 MH	175W MH OUTDOOR GLOWPOW LUMINAIRE. SINGLE OR DOUBLE FIXTURES @ 90 POLE MOUNT. PROVIDE MOUNTING BRACKET AND POLE REFERENCE FIXTURE SCHEDULE FOR POLE TYPE, TYPE 3 DISTRIBUTION. PROVIDE FUSING. COLOR BY ARCHITECT.
H2	GARCOO	RA4-15	NA	NA	15" STRAIGHT ROUND ALUMINUM POLE WITH 4-BOLT ANCHOR BASE DESIGNED FOR SIDE-MOUNT LIGHT FIXTURES. POLE SHALL BE RATED FOR 130 MPH WIND LOADS AS A MIN. REFER TO DETAIL SHEET FOR MORE INFORMATION. VERIFY PATTERN AND SIZE.
J	NITEBRITES	PM2-1024-MT-M6-PM2-M6	1	1000 MH	1000W MH OUTDOOR SPORTS LIGHTING LUMINAIRE. PROVIDE MOUNTING BRACKET BCS-002-TUB AND POLE REFERENCE FIXTURE SCHEDULE FOR POLE TYPE, N6 DISTRIBUTION. PROVIDE FUSING. COLOR BY ARCHITECT. (*)
J2	NITE BRITES	RSS-418-007-XXX-CBA	NA	NA	15" STRAIGHT ROUND STEEL POLE WITH 4-BOLT ANCHOR BASE DESIGNED FOR SIDE-MOUNT LIGHT FIXTURES. POLE SHALL BE RATED FOR 130 MPH WIND LOADS AS A MIN. REFER TO DETAIL SHEET FOR MORE INFORMATION. VERIFY BOLT PATTERN AND SIZE. COORDINATE MOUNTING REQUIREMENTS WITH STRUCTURAL DRAWINGS.
K	DYNAMIC LIGHTING INC	D130/G16ACH-100-PM06	1	100 MH	100W MH OUTDOOR GLOBE LUMINAIRE WITH PELLAR MOUNT STATION AND BASE WITH INTEGRAL BALLAST. PROVIDE ALL MOUNTING COMPONENTS TO MOUNT TO EXISTING POLE. PROVIDE FUSING. COLOR BY ARCHITECT.
L	PORTFOLIO		1	32W TRT	RECESSED 6" OPEN CONE FLUORESCENT DOWNLIGHT WITH 32W LAMPS. CLEAR ALUM. REFLECTOR WITH LENS. PROVIDE ELECTRONIC BALLAST WITH LESS THAN 100 TMD. WHERE SHARED FIXTURE PROVIDE EMERGENCY BATTERY W/ NO LESS 850 LUMENS. PROVIDE FUSING. DAMP LABEL.
M	LIGHTOLIER		2	50W T15	WALL MOUNTED DIRECT / INDIRECT FLUORESCENT FIXTURE WITH 2-50W T15 LAMPS. MICRO PERFORATED MESH LAMP SHIELD.
N	MCGRAW EDISON DAYRITE LITHONIA G.E.		1	100W MH	100W METAL HALIDE FLOOD LIGHT. PROVIDE ALL NECESSARY MOUNTING HARDWARE, SLIP FITTER AND TEMON MOUNTED TO CONCRETE BASE. PROVIDE FUSING.
X	LITHONIA OW COLE CHLORIDE	LVS-N-1/2-R-120-EM-100-W LX-16X-RED-EM-W-120 R-L-N-1/2-R-W-WLWS-X	1	LED	EXIT LIGHT SIGN FOR OUTDOOR USE. UL LISTED FOR WET LOCATION. RED LED LAMP. CLEAR LETTERS. AND WHITE FRISK. SINGLE OR DOUBLE SIDED. PROVIDE WITH AC INDICATOR LAMP, TEST SWITCH, AND DUAL WELDED WATERTIGHT-PIE. NICKEL CADMIUM BATTERY WITH 90 MINUTE CAPACITY. UNIVERSAL MOUNT.

COORDINATE ALL EQUALS WITH ARCHITECT FOR PRIOR ADOPT.
* PROVIDE PHOTOMETRICS AND AIMING OF FIXTURES FOR EQUAL FIXTURES

ROWE ARCHITECTS
INCORPORATED
100 Madison Street, Suite 200
Tampa, Florida 33602.4704
www.RoweArchitects.com
Fax: 813.221.9154
813.221.8771
AAC0021772

ENGINEERING MATRIX, INC.
CONSULTING ENGINEERS
5000 W. BRADSHAW BLVD. SUITE 100
TAMPA, FLORIDA 33618
TEL: 813-988-8888 FAX: 813-988-8888
WWW.EMATRIX.COM

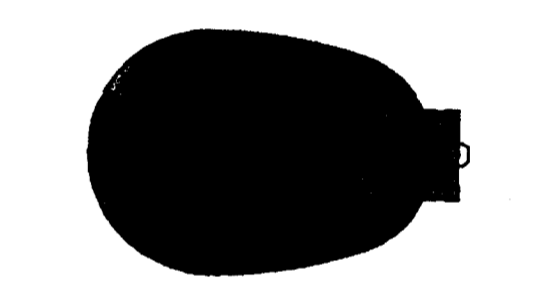

CUSCADEN POOL RENOVATION

CITY OF TAMPA
305 East Jackson Street
Tampa, Florida 33602


Project No. 0202.00
Distribution _____ Date _____
BID DOCUMENTS _____ 02.02.04

Legend Electrical
RECORD DWG.
DATE 2/26/05

RECEIVED
FEB 23 2004
E001
217/009

E. 19TH AVE.

E. 19TH AVE.

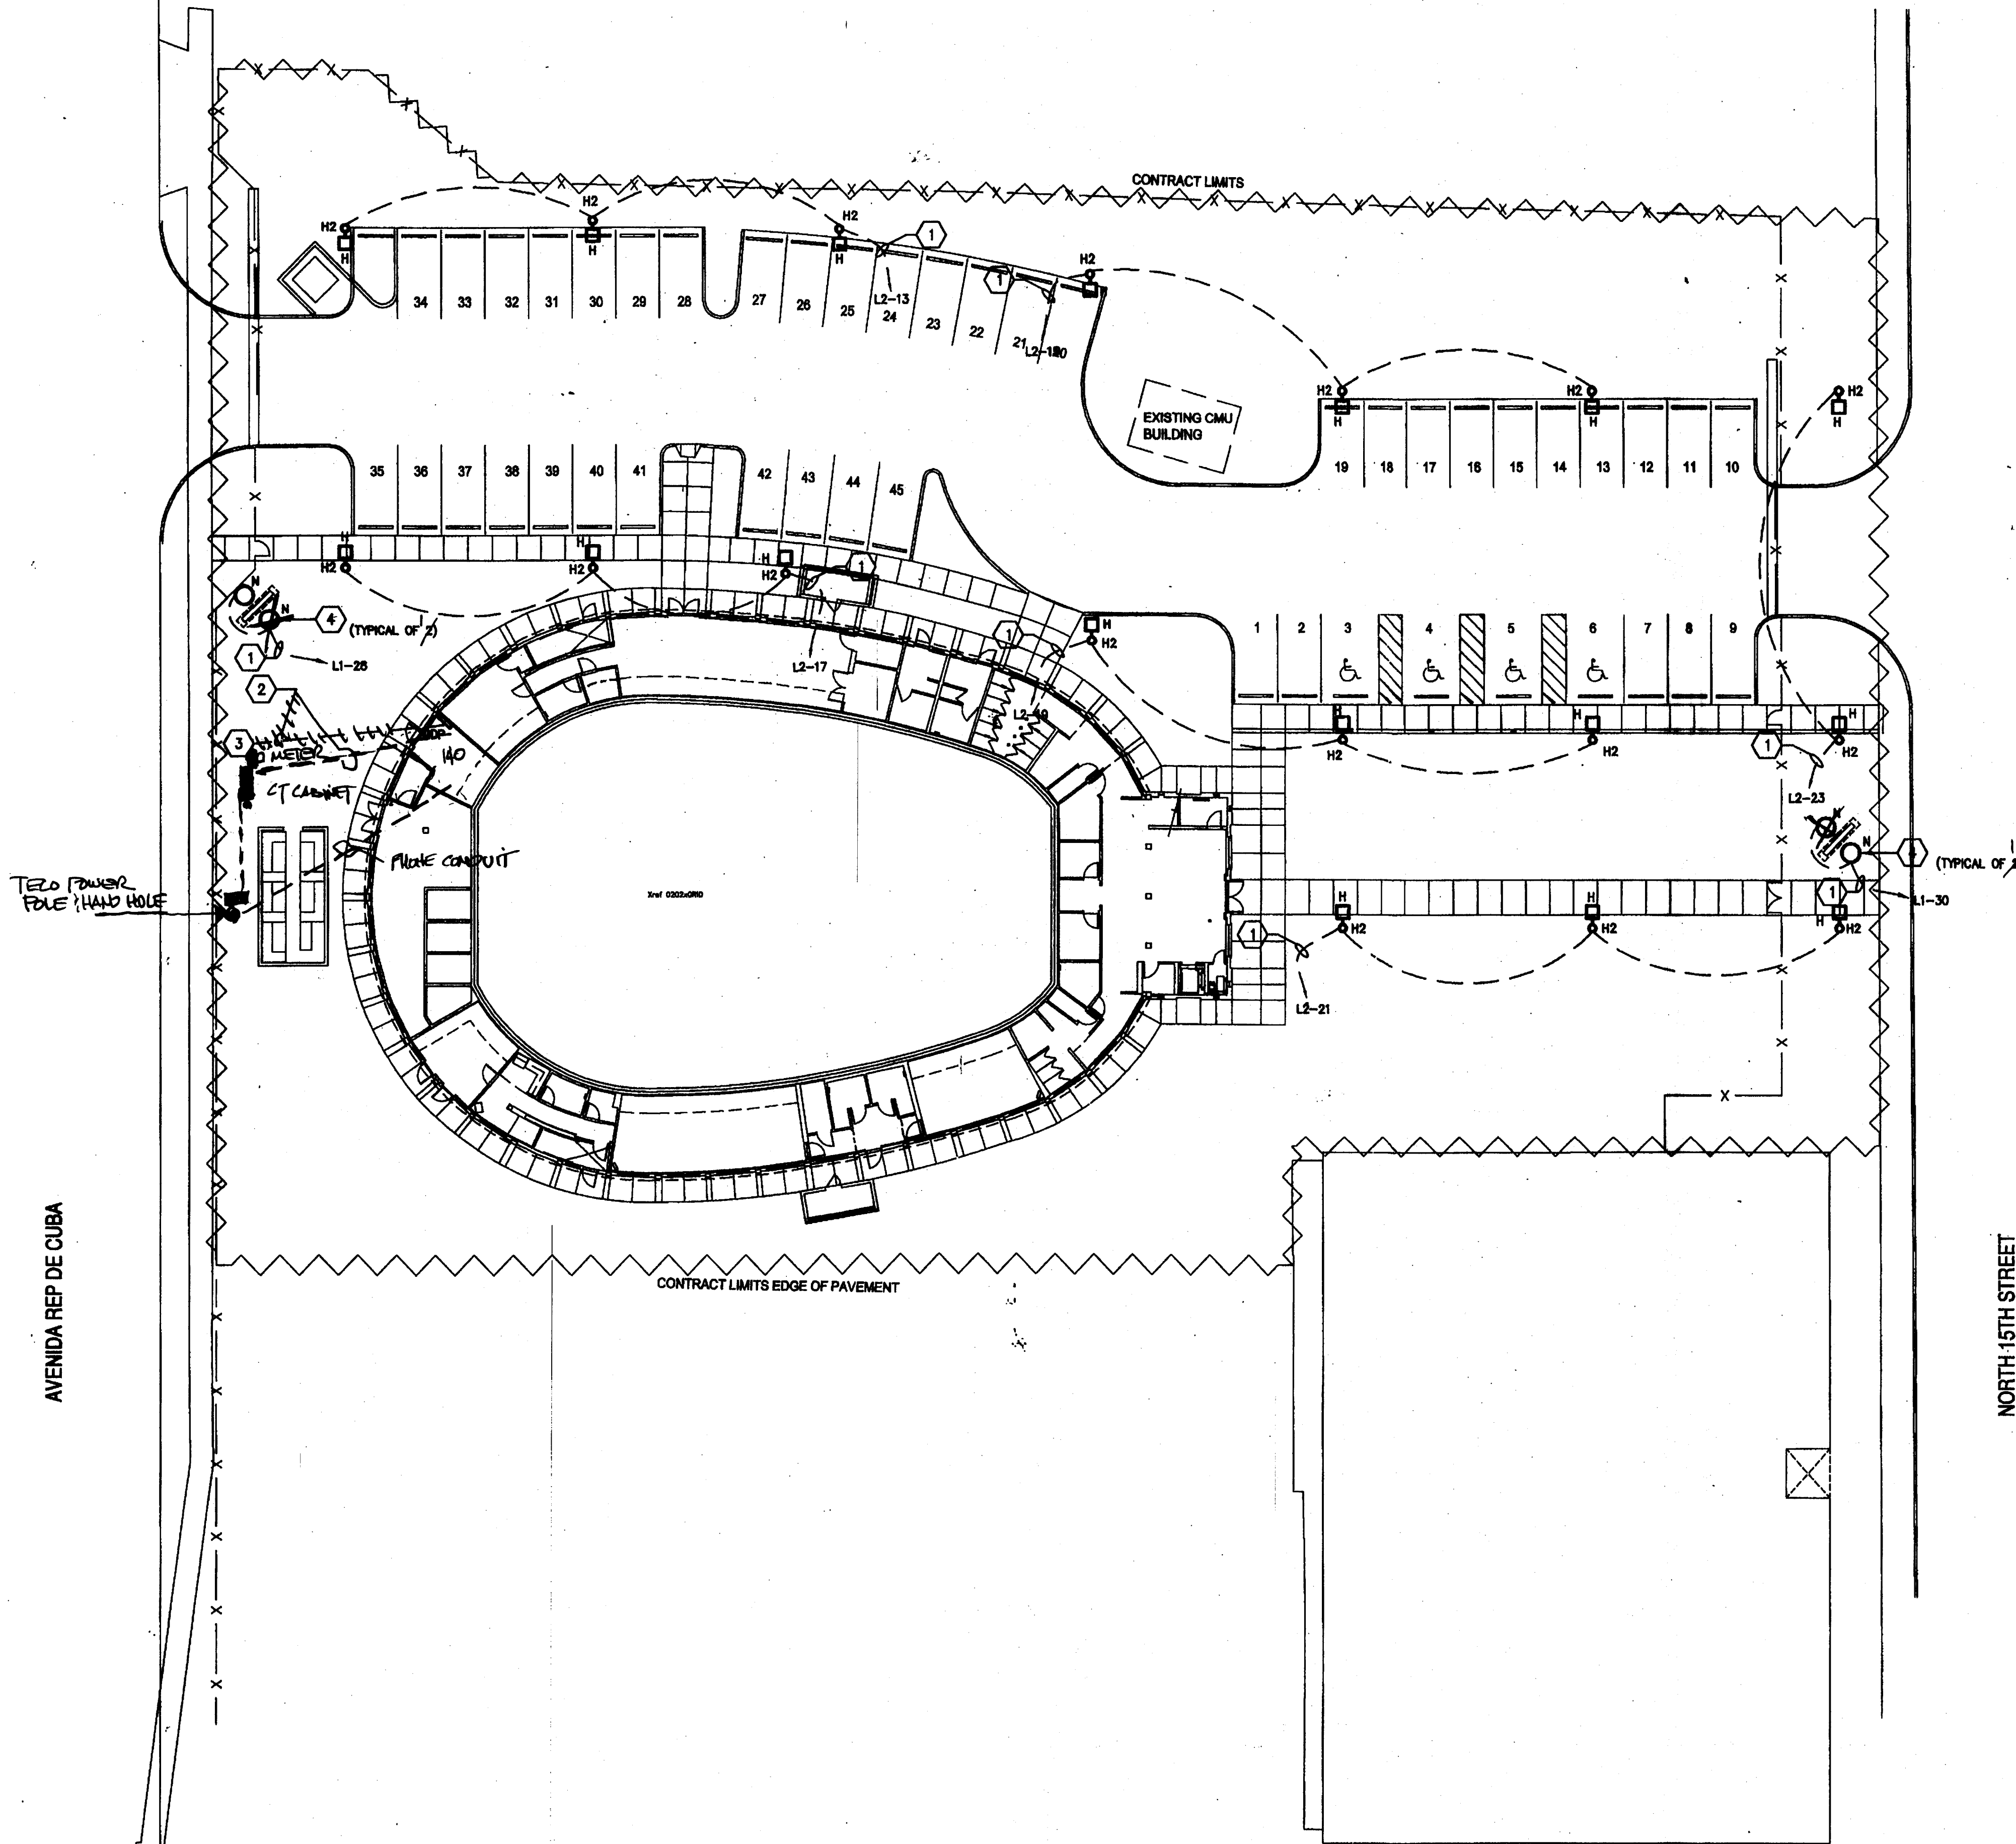


GENERAL NOTES

1. ALL EXTERIOR SITE LIGHTING SHALL BE CONTROLLED BY PHOTOCELL (ON)/ TIME CLOCK (OFF) PROVIDE PHOTOCELL, TIME CLOCK, (INTERMATIC T174CR OR EQUAL AS PROVIDED BY PARAGON OR TORK), ELECTRICALLY HELD CONTACTOR (NUMBER OF CONTACTORS/ POLES AS REQUIRED), CONDUIT, BOXES, WIRING, ETC. AS REQUIRED. COORDINATE CONTROL REQUIREMENTS WITH OWNER.

KEYED NOTES

- ① CONTROLLED VIA PHOTOCELL / TIME CLOCK / BMS LOCATED IN STORAGE ROOM 140. COORDINATE CONTROL REQUIREMENTS WITH OWNER.
- ② PROVIDE SECONDARY CONDUCTORS TO PULL BOX AT BASE OF UTILITY POLE. PROVIDE CONDUCTOR LENGTH AS REQUIRED TO REACH POLE MOUNTED TRANSFORMER, LOOP CONDUCTOR IN PULL BOX FOR UTILITY FINAL TERMINATION TO TRANSFORMER. REFER TO SINGLE LINE FOR ADDITIONAL INFORMATION.
- ③ POLE MOUNTED TRANSFORMER. COORDINATE EXACT LOCATION WITH UTILITY. PROVIDE PULL BOX AT BASE OF POLE BY TECO
- ④ COORDINATE PROPER SET-BACK AND AIMING WITH SIGNAGE PRIOR TO ROUGH-IN.

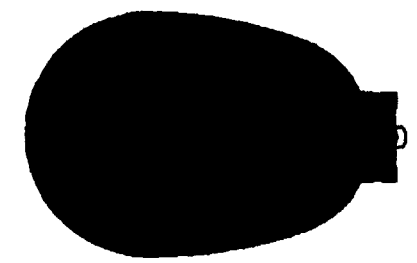

CUSCADEN POOL RENOVATION

CITY OF TAMPA
306 East Jackson Street
Tampa, Florida 33602

Project No. 0202.00


Distribution	Date
BID DOCUMENTS	02.02.04

Site Plan -
Electrical

RECORD DWG.

DATE 2/24/05

E101

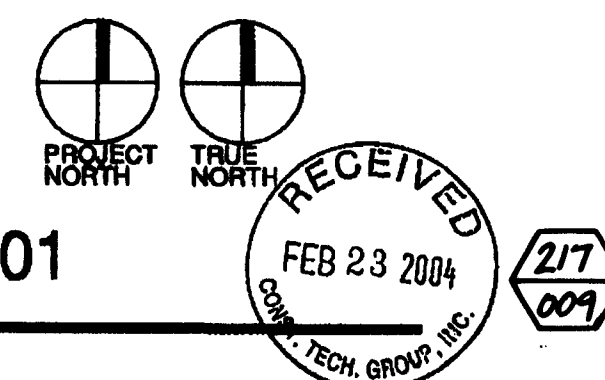

Site Plan - Electrical



1" = 20'-0"

GENERAL NOTES

1. PROVIDE WIRING AS NECESSARY TO ACCOMMODATE SWITCHING FUNCTION AS INDICATED ON FLOOR PLAN.
2. ALL LIGHTING FIXTURES SHALL BE TYPE 'A' U.O.N.
3. ALL EMERGENCY FIXTURES AND EXIT SIGNS SHALL BE CONNECTED TO A LOCAL (WITHIN SAME ROOM) LIGHTING CIRCUIT AHEAD OF SWITCHING.

KEYED NOTES

- ① SITE LIGHTING CONTACTOR TO BE CONTROLLED VIA PHOTOCELL (ON)/ TIME CLOCK (OFF) PROVIDE PHOTOCELL, TIME CLOCK, (INTERMATIC T174CR OR EQUAL AS PROVIDED BY PARAGON OR TORX), ELECTRICALLY HELD CONTACTOR (NUMBER OF CONTACTORS/ POLES AS REQUIRED), CONDUIT, BOXES, WIRING, ETC. AS REQUIRED. COORDINATE SUITABLE LOCATION PRIOR TO ROUGH-IN.
- ② EXTERIOR LIGHTING CONTACTOR TO BE CONTROLLED VIA PHOTOCELL (ON)/ TIME CLOCK (OFF) PROVIDE PHOTOCELL, TIME CLOCK, (INTERMATIC T174CR OR EQUAL AS PROVIDED BY PARAGON OR TORX), ELECTRICALLY HELD CONTACTOR (NUMBER OF CONTACTORS/ POLES AS REQUIRED), CONDUIT, BOXES, WIRING, ETC. AS REQUIRED. COORDINATE SUITABLE LOCATION PRIOR TO ROUGH-IN.
- ③ TIME CLOCK FOR EXTERIOR LIGHTING. COORDINATE SUITABLE LOCATION PRIOR TO ROUGH-IN.
- ④ COORDINATE ALL LIGHTING LOCATIONS WITH POOL EQUIPMENT AND PIPING IN THIS AREA.
- ⑤ PROVIDE JUNCTION BOX FOR PRE-FABRICATED SHOWER LIGHT. COORDINATE EXACT LOCATION AND MOUNTING PRIOR TO ROUGH-IN.
- ⑥ ALL NEW CONDUIT AND CIRCUITRY SHALL BE RUN WITHIN NEW SOFFITS AND CONCEALED AS MUCH AS POSSIBLE.

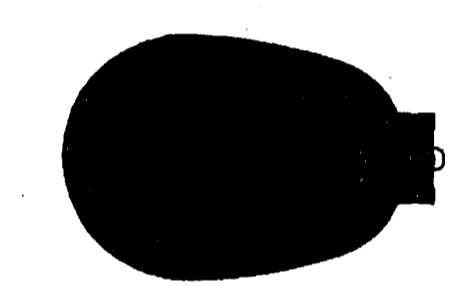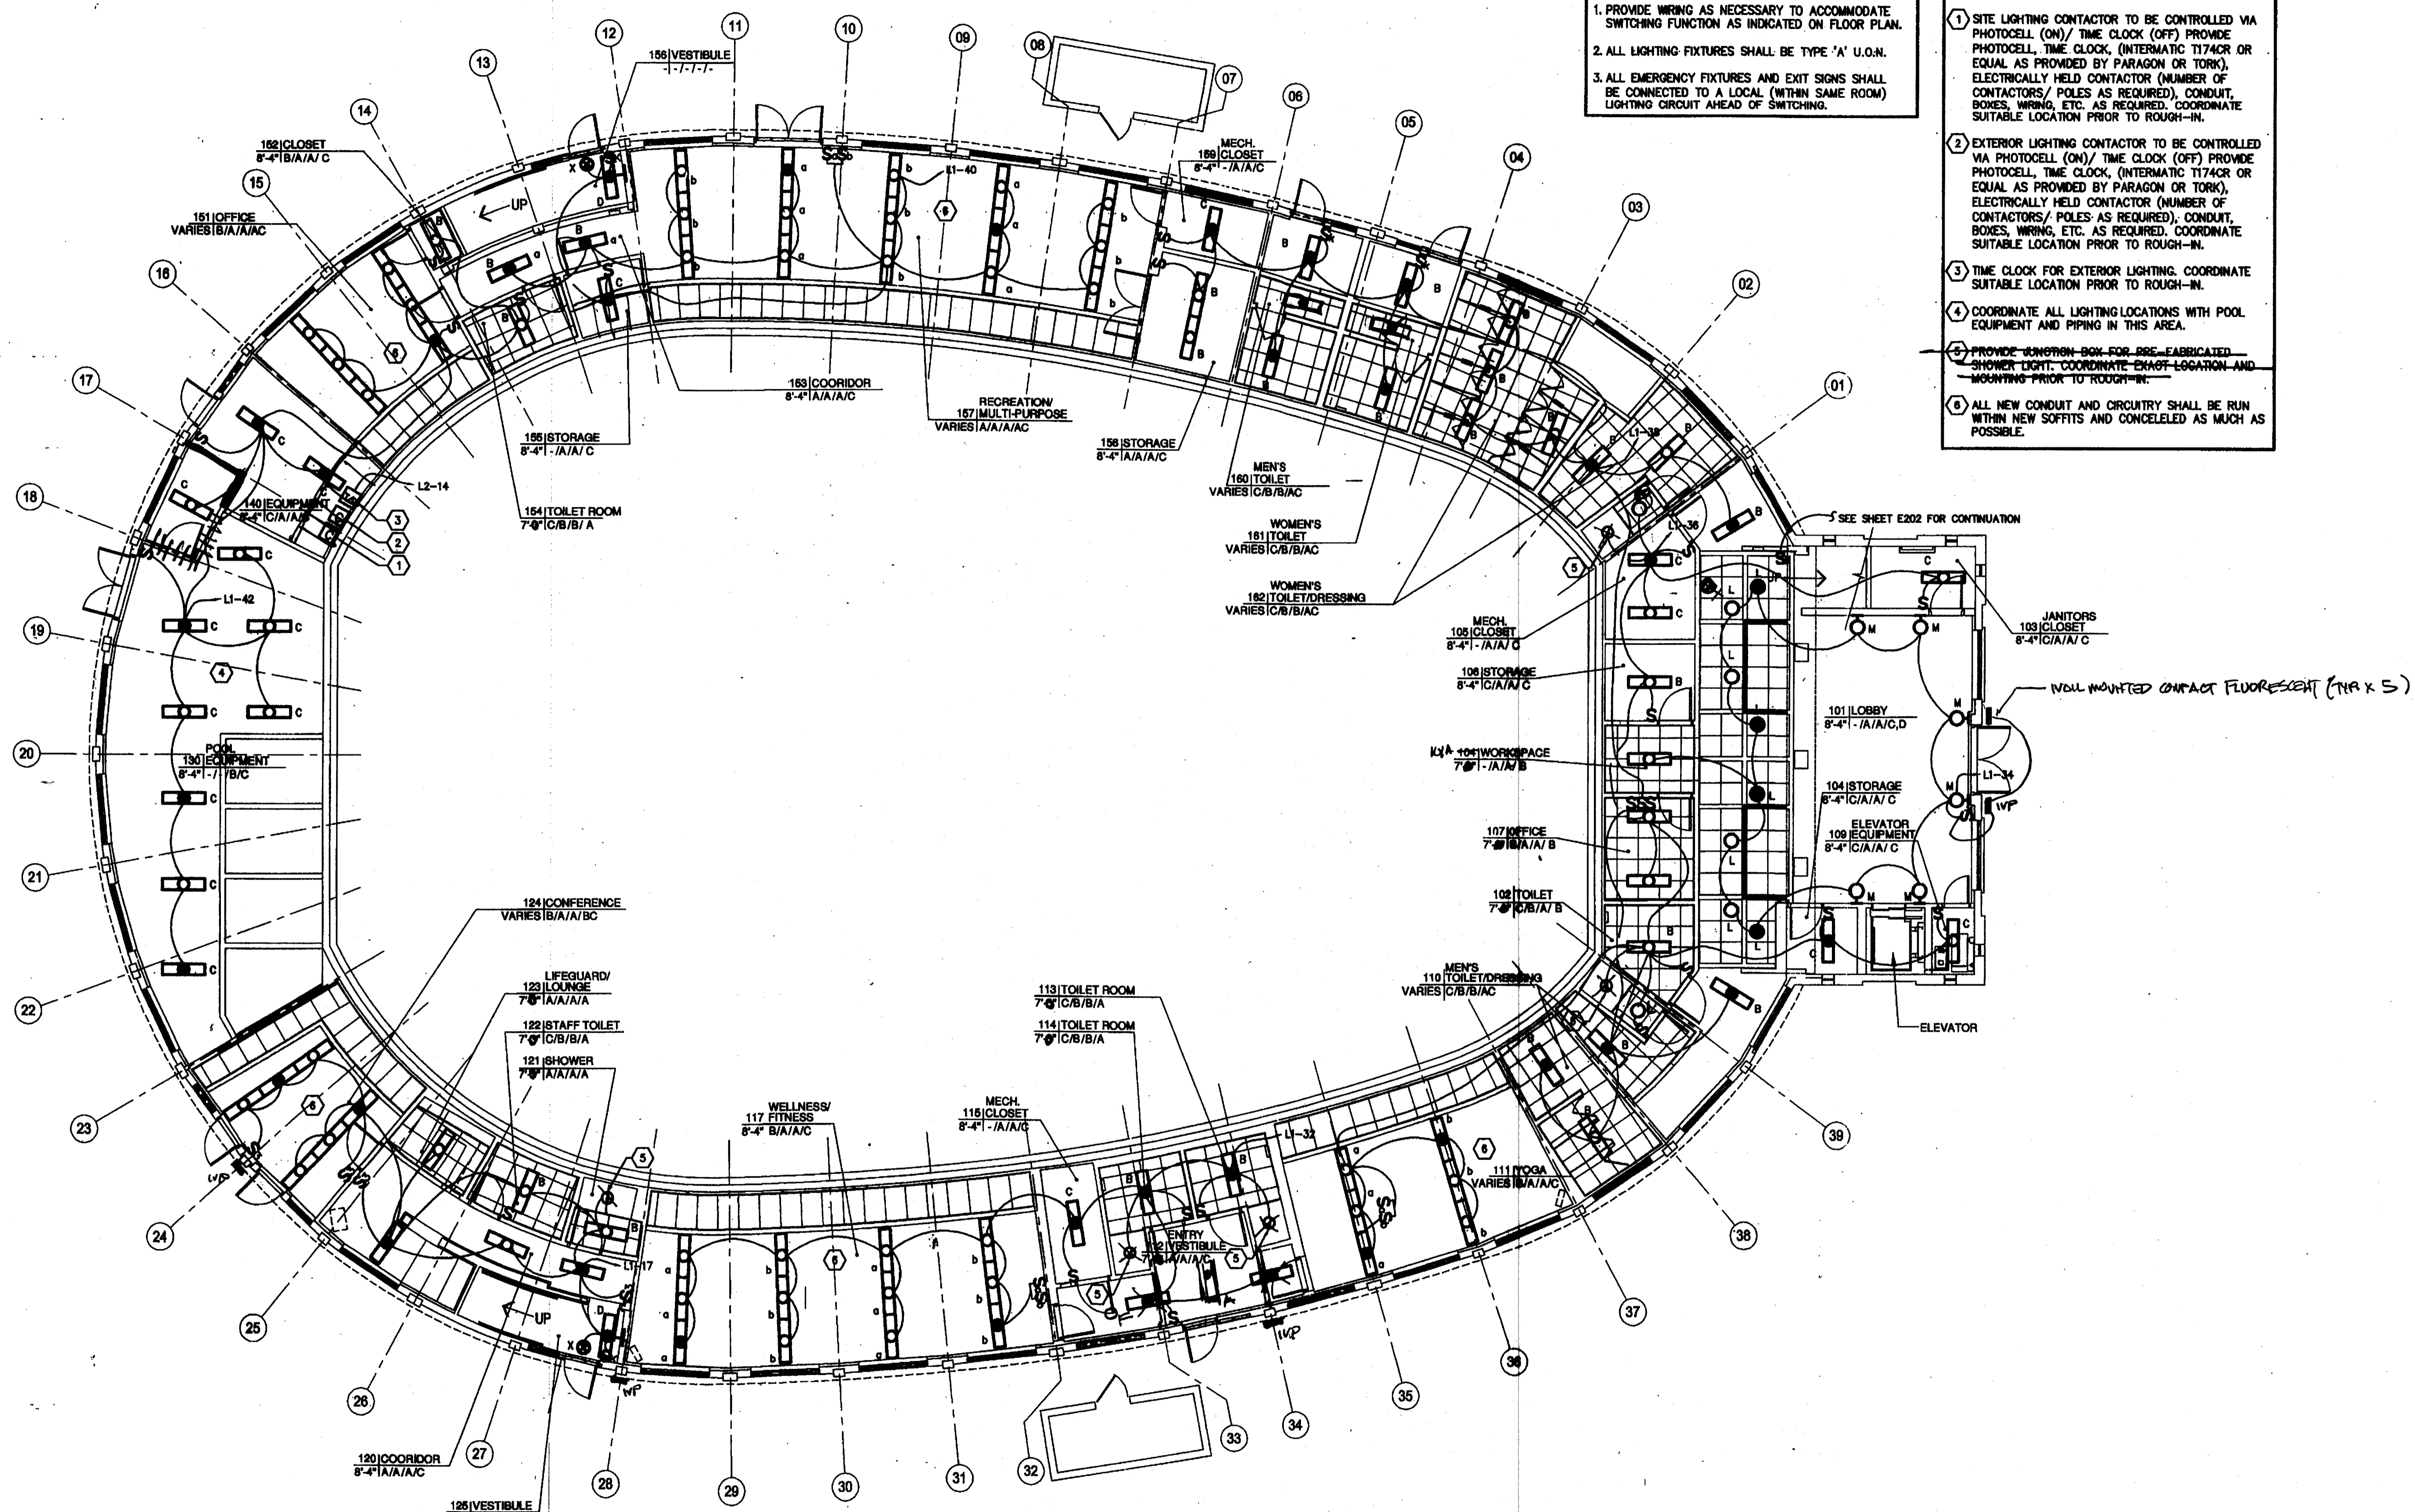

CUSCADEN POOL RENOVATION

CITY OF TAMPA
306 East Jackson Street
Tampa, Florida 33602

Project No.	0202.00
Distribution	Date
BID DOCUMENTS	02.02.04

Floor Plan
First Floor
Lighting

RECORD DWG.
DATE 2/26/05

PROJECT NORTH

RECEIVED
FEB 23 2004
217
009

First Floor - Lighting



1/8"=1'-0"

GENERAL NOTES

1. PROVIDE WIRING AS NECESSARY TO ACCOMMODATE SWITCHING FUNCTION AS INDICATED ON FLOOR PLAN.
2. ALL LIGHTING FIXTURES SHALL BE TYPE 'A' U.O.N.
3. ALL EMERGENCY FIXTURES AND EXIT SIGNS SHALL BE CONNECTED TO A LOCAL (WITHIN SAME ROOM) LIGHTING CIRCUIT AHEAD OF SWITCHING.
4. ALL EXTERIOR LIGHTING SHALL BE CONTROLLED BY PHOTOCELL (ON) / TIME CLOCK (OFF) PROVIDE PHOTOCELL, TIME CLOCK, (AUTOMATIC T174CR OR EQUAL AS PROVIDED BY PARAGON OR TORX), ELECTRICALLY HELD CONTACTOR (NUMBER OF CONTACTORS / POLES AS REQUIRED), CONDUIT, BOXES, WIRING, ETC. AS REQUIRED.

KEYED NOTES

- 1 CONTROLLED VIA PHOTOCELL / TIME CLOCK LOCATED IN STORAGE ROOM 140.
- 2 USE EXISTING CONDUIT WITHIN EXISTING POLE. CAPTURE AND EXTEND TO NEW LIGHT MOUNTED TO EXISTING POLE. NO EXPOSED CONDUIT SHALL BE USED.
- 3 CONTRACTOR TO COORDINATE AMING ANGLES OF FIXTURES. PROVIDE PHOTOMETRICS TO ARCHITECT FOR PRIOR APPROVAL.

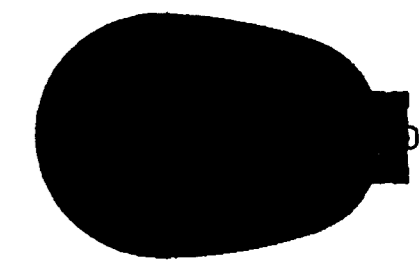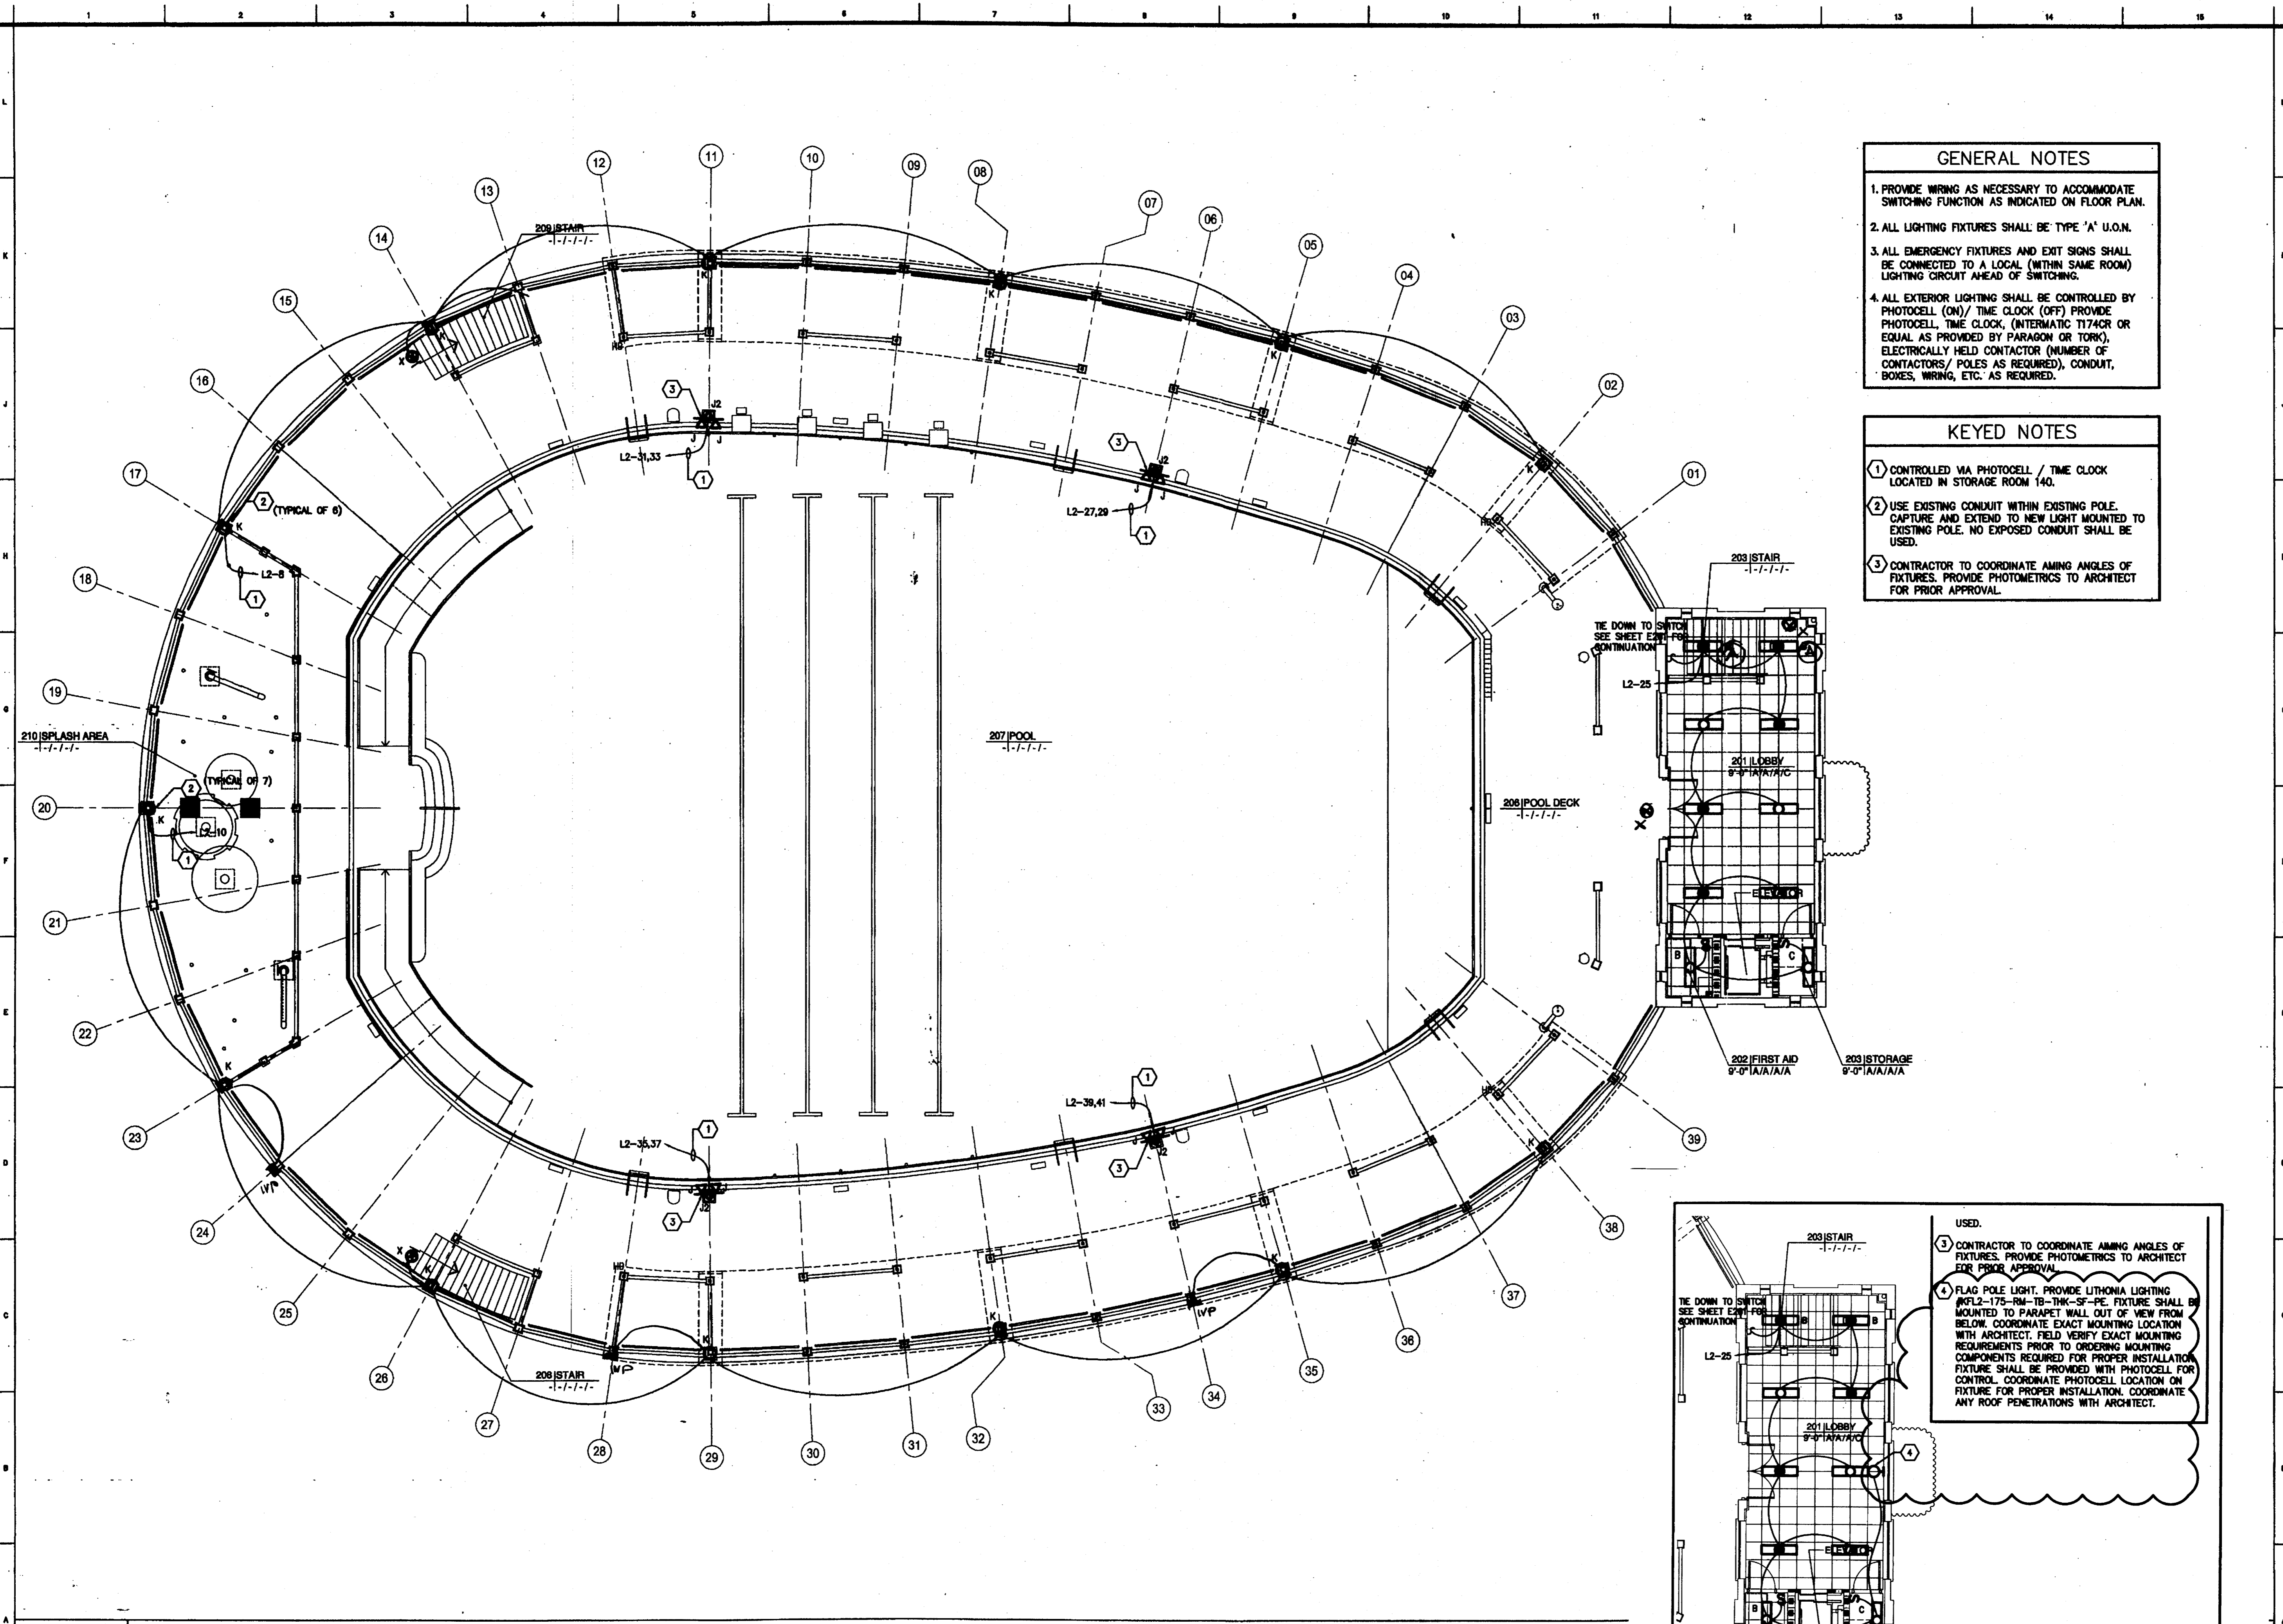

CUSCADEN POOL RENOVATION


CITY OF TAMPA
308 East Jackson Street
Tampa, Florida 33602

Project No. 0202.00

Distribution	Date
BID DOCUMENTS	02.02.04

Floor Plan
Second Floor Pool Deck
Lighting

RECORD DWG.
DATE 2/26/05

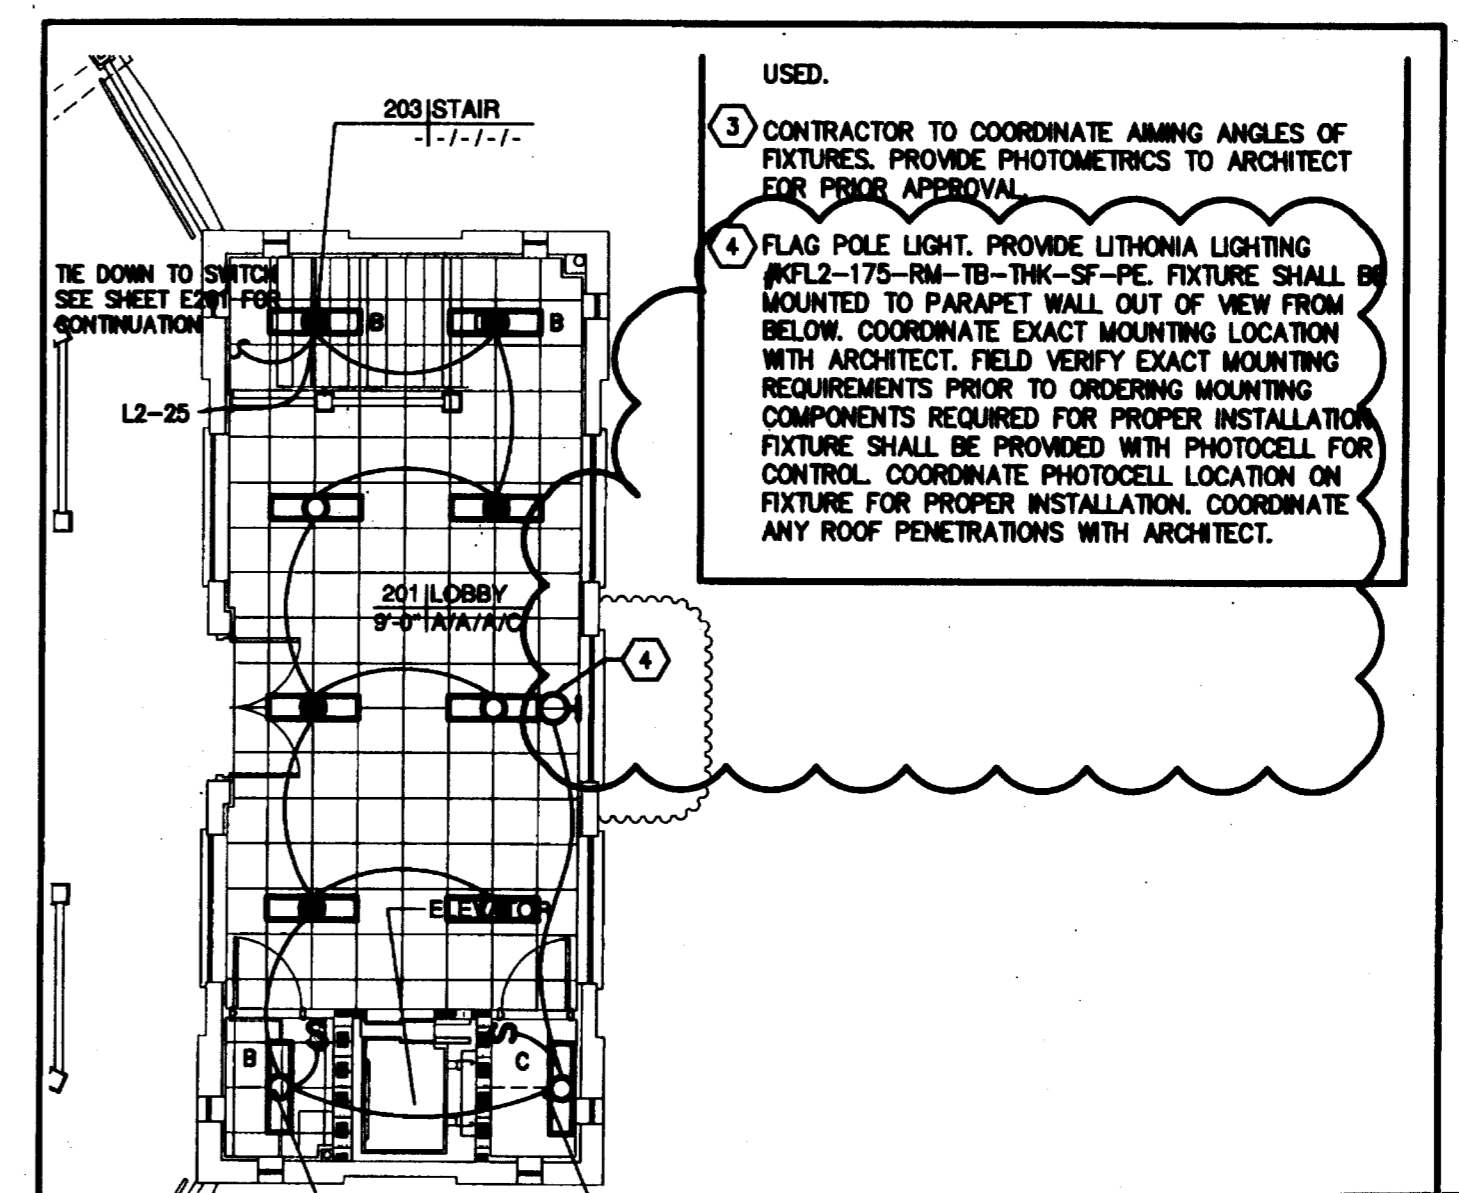

Second Floor Pool Deck - Lighting


1/8"=1'-0"

PROJECT NORTH

RECEIVED
FEB 23 2004
CONS. TECH. GROUP, INC.

E202

2/7 009

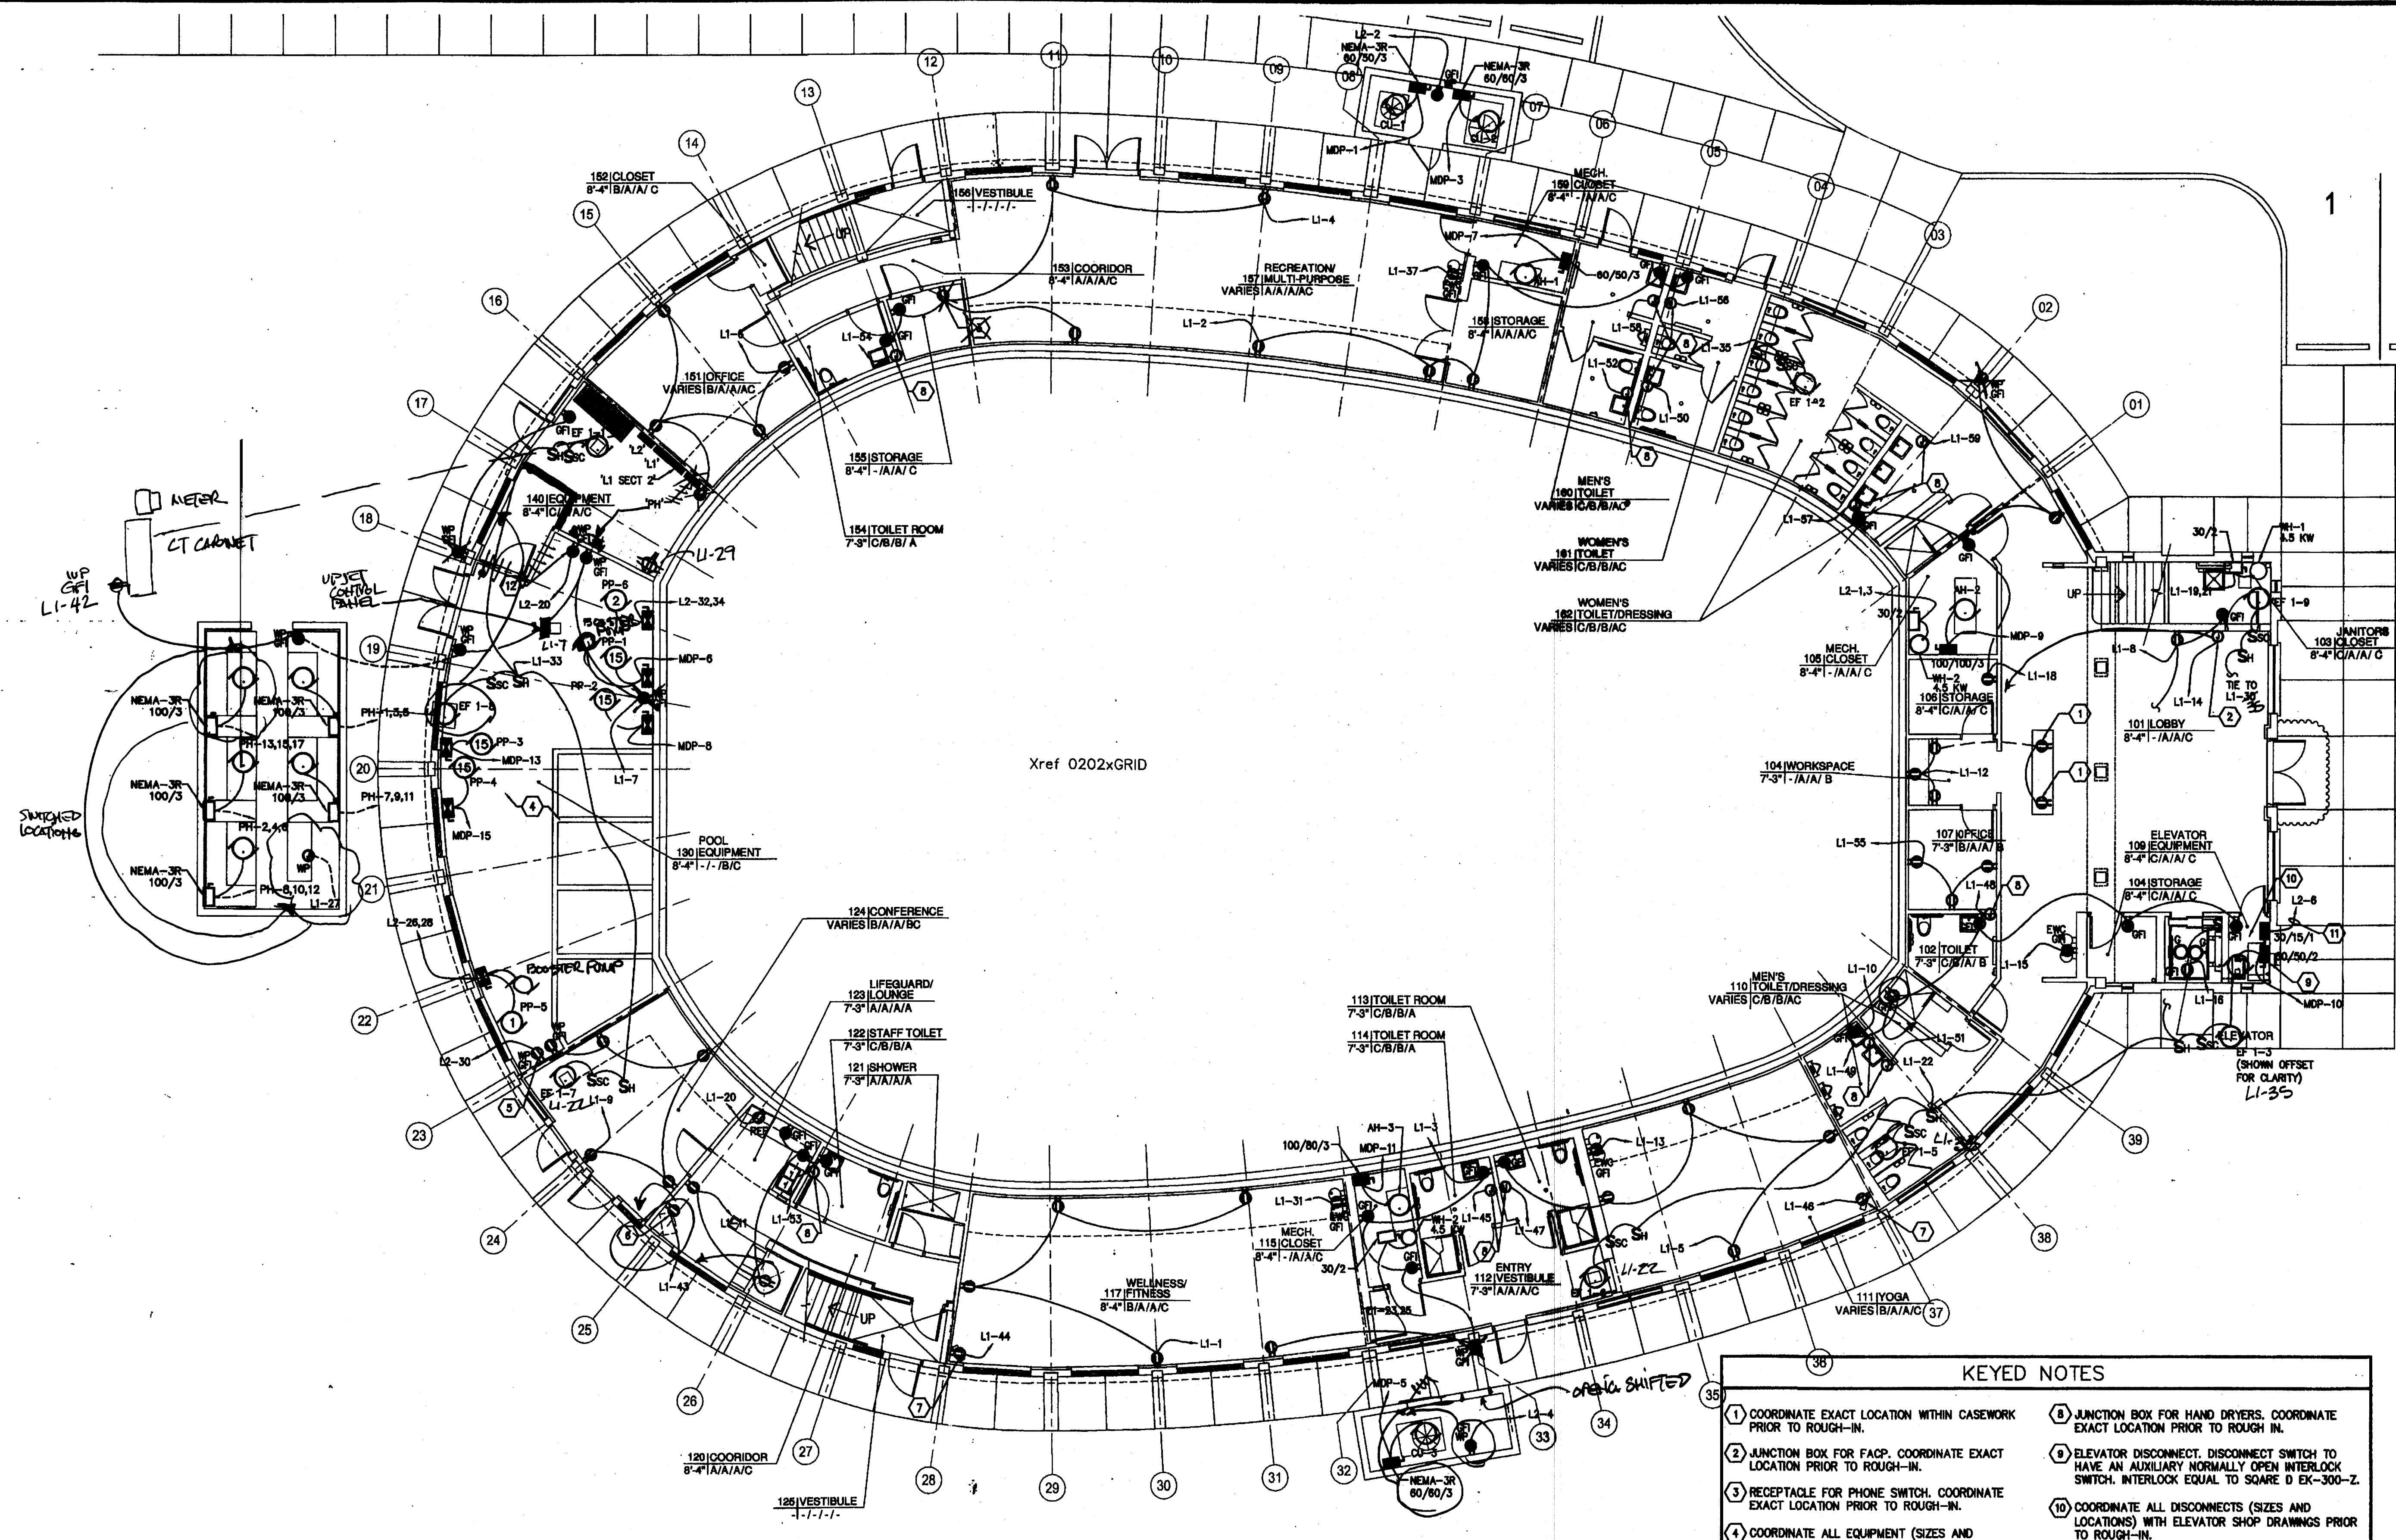

KEYED NOTES	
1	COORDINATE EXACT LOCATION WITHIN CASEWORK PRIOR TO ROUGH-IN.
2	JUNCTION BOX FOR FACP. COORDINATE EXACT LOCATION PRIOR TO ROUGH-IN.
3	RECEPTACLE FOR PHONE SWITCH. COORDINATE EXACT LOCATION PRIOR TO ROUGH-IN.
4	COORDINATE ALL EQUIPMENT (SIZES AND LOCATIONS) WITH POOL CONSULTANT DRAWINGS PRIOR TO ROUGH-IN.
5	RECEPTACLE FOR CHEMICAL FEEDERS. COORDINATE EXACT LOCATION WITH POOL CONSULTANT DRAWINGS PRIOR TO ROUGH-IN. INTERLOCK RECEPTACLE WITH PP-5.
6	RECEPTACLES FOR TELEVISION. COORDINATE EXACT LOCATION AND MOUNTING HEIGHT PRIOR TO ROUGH IN.
7	RECEPTACLES FOR OSCILLATING FANS. COORDINATE EXACT LOCATION AND MOUNTING HEIGHT PRIOR TO ROUGH IN.
8	JUNCTION BOX FOR HAND DRYERS. COORDINATE EXACT LOCATION PRIOR TO ROUGH IN.
9	ELEVATOR DISCONNECT. DISCONNECT SWITCH TO HAVE AN AUXILIARY NORMALLY OPEN INTERLOCK SWITCH. INTERLOCK EQUAL TO SQUARE D EK-300-Z.
10	COORDINATE ALL DISCONNECTS (SIZES AND LOCATIONS) WITH ELEVATOR SHOP DRAWINGS PRIOR TO ROUGH-IN.
11	ELEVATOR CAB LIGHTING. PROVIDE 2-#12 CU. THWN. 1-#12 E.G. CU. THWN. IN 1" CONDUIT. FIELD VERIFY LOCATION OF ELEVATOR CAB LIGHTING TERMINATION POINT AT ELEVATOR CAB. PROVIDE ALL ELECTRICAL COMPONENTS (DEVICES, CONDUIT, WIRING, ETC.) AS REQUIRED FOR COMPLETE ELEVATOR CAB LIGHTING POWER TERMINATIONS PER N.E.C. AND FLORIDA ELEVATOR CODE.
12	RECEPTACLE FOR CHEMICAL FEEDERS. COORDINATE EXACT LOCATION WITH POOL CONSULTANT DRAWINGS PRIOR TO ROUGH-IN. INTERLOCK RECEPTACLE WITH PP-1 AND PP-2.

CUSCADEN POOL RENOVATION

CITY OF TAMPA
806 East Jackson Street
Tampa, Florida 33602

Project No. 0202.00
Distribution Date
BID DOCUMENTS 02.02.04


First Floor - Power Plan

RECORD DWG.
DATE 2/26/05

PROJECT NORTH
E301
RECEIVED
FEB 23 2004
217
001


First Floor - Power

1/8"=1'-0"

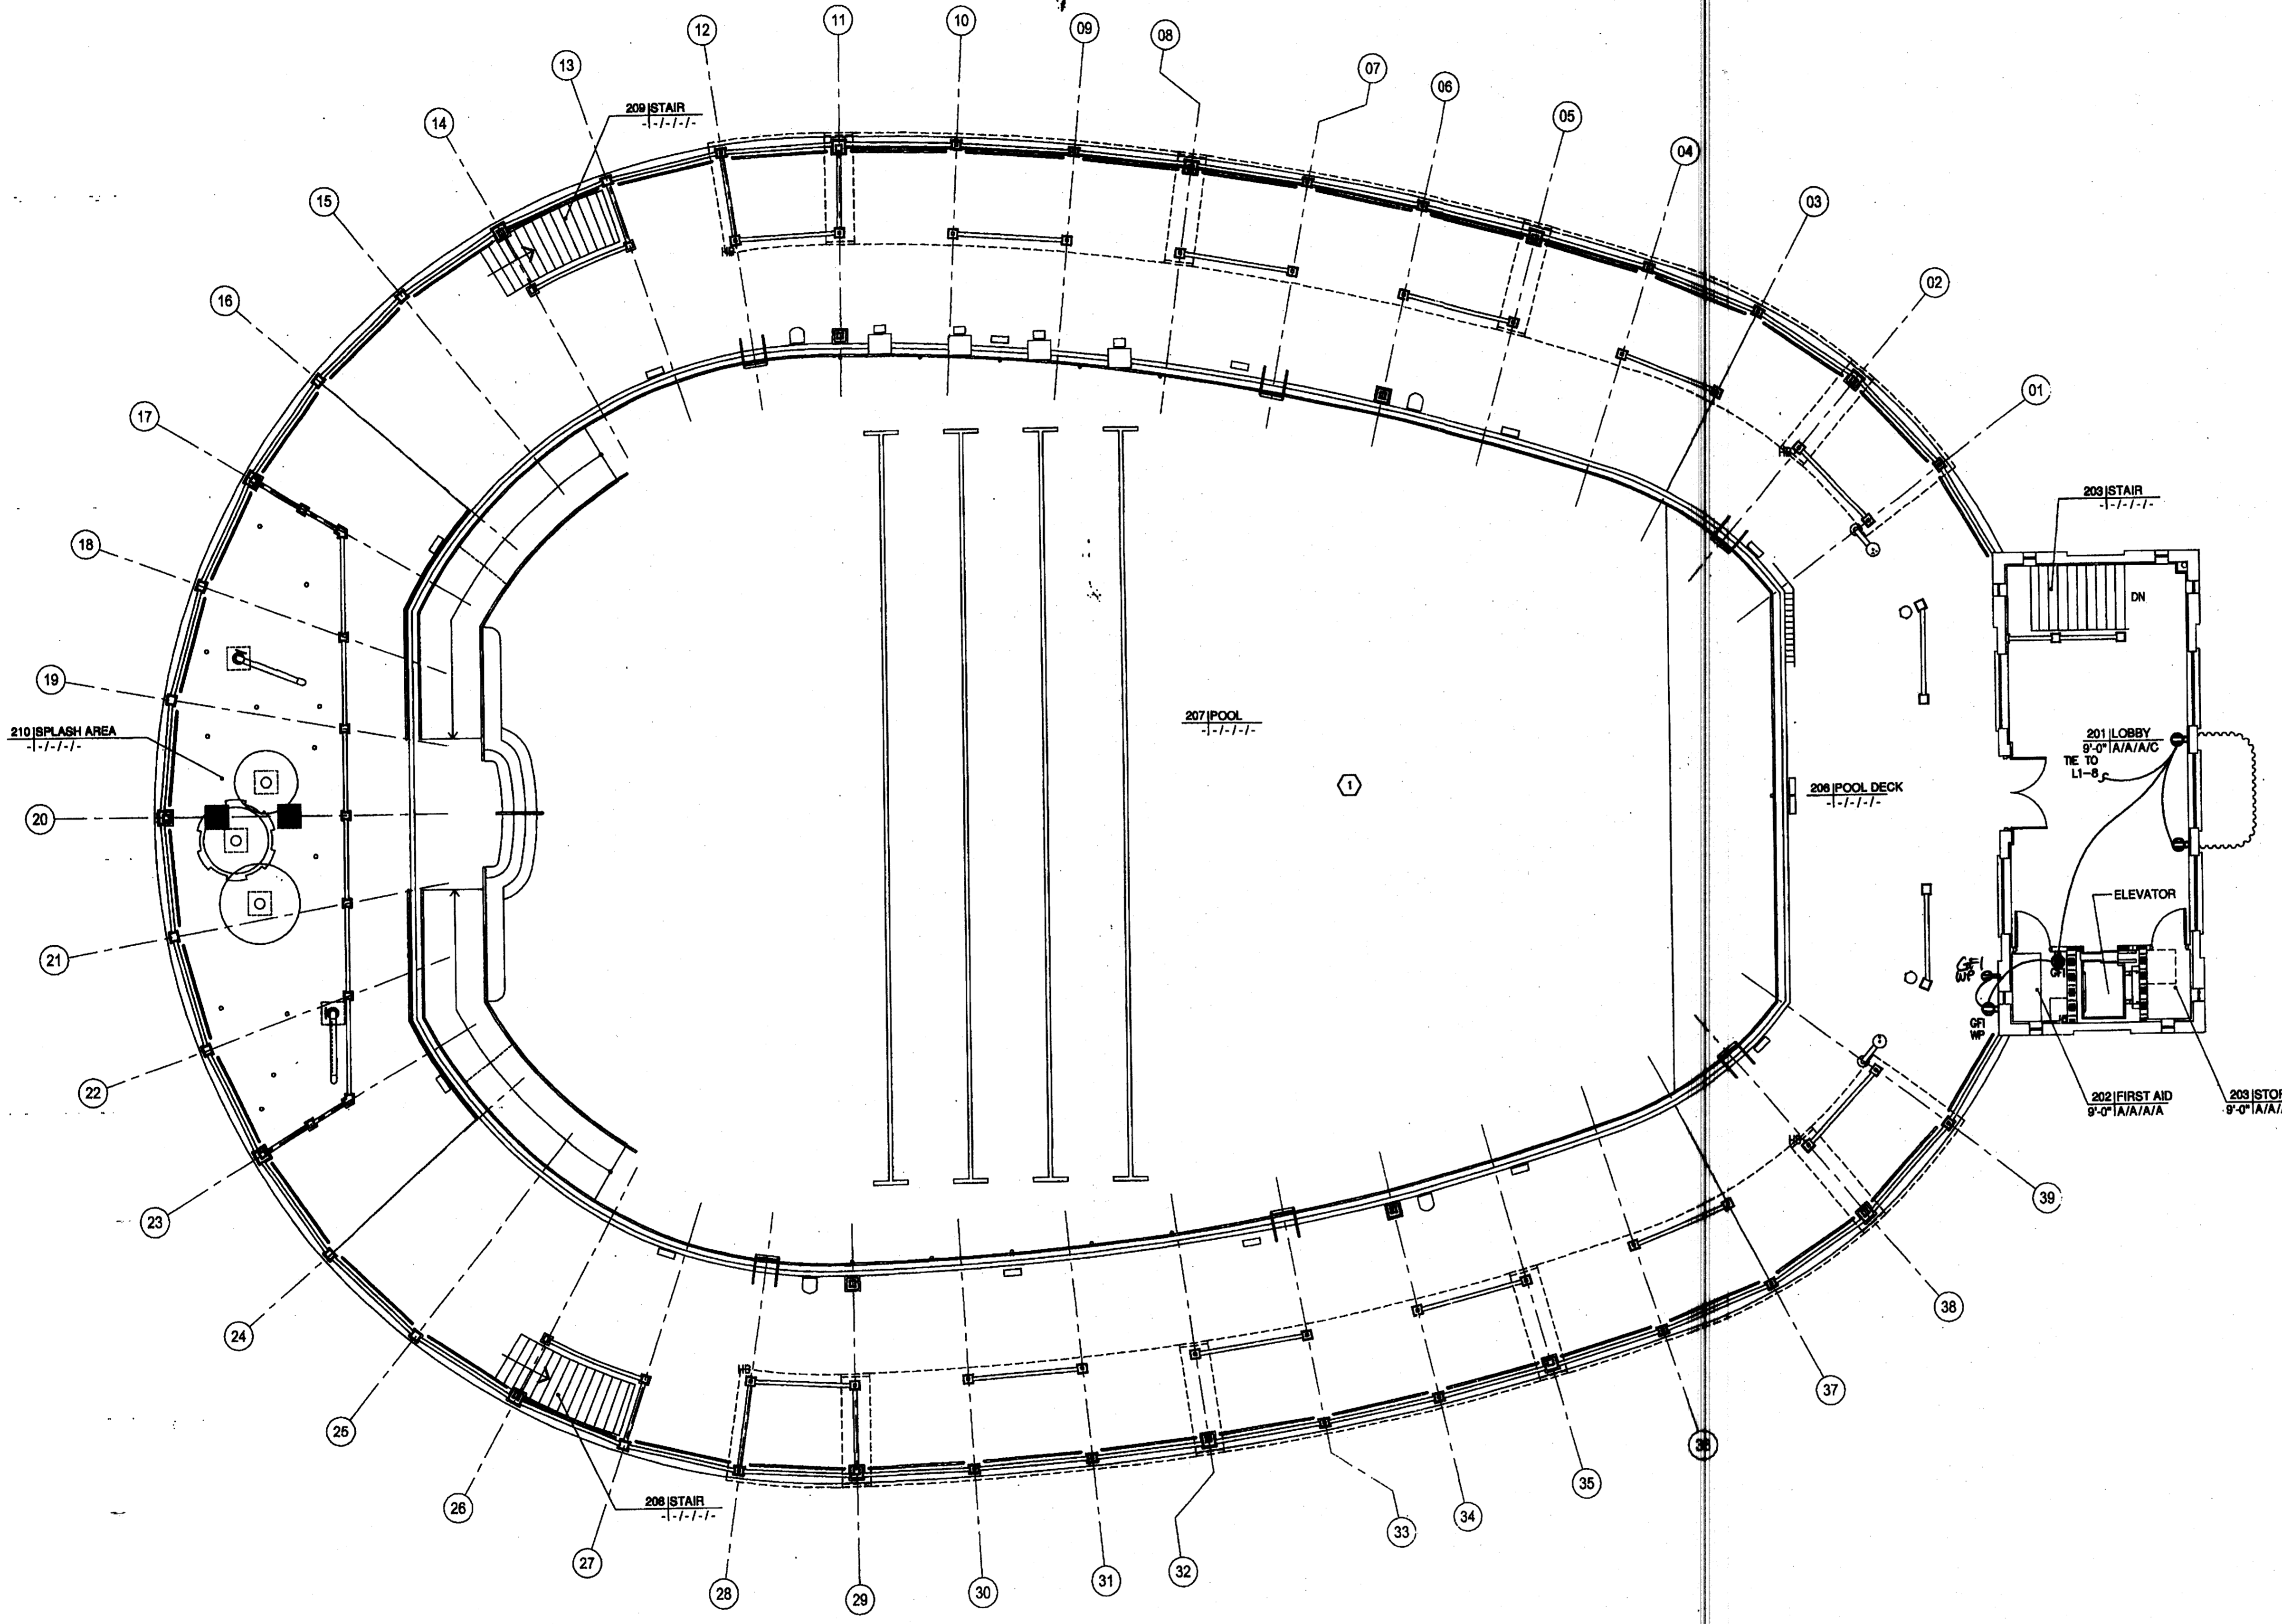

KEYED NOTES

1 COMMON BONDING GRID SHALL MEET THE REQUIREMENTS OF THE N.E.C. ARTICLE 880. RUN NUMBER 8 MINIMUM BARE COPPER SOLID CONDUCTOR CONTINUOUSLY TO ALL EXISTING REINFORCING STEEL, LADDERS, NICHE FIXTURES, TRANSFORMERS, STEP RAILINGS, ANY METALLIC DECK EQUIPMENT, ETC. TERMINATE IN ELECTRICAL ROOM AT PANEL 'MDP'.

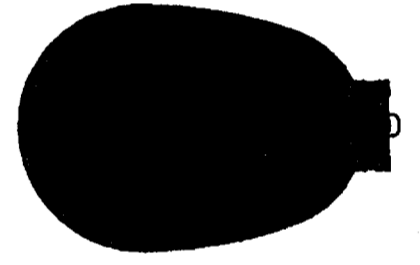


**CUSCADEN
POOL
RENOVATION**

CITY OF TAMPA
306 East Jackson Street
Tampa, Florida 33602

Project No.	0202.00
Distribution	Date
BID DOCUMENTS	02.02.04

Second Floor Pool Deck -
Power Plan


RECORD DWG.
DATE 2/26/05

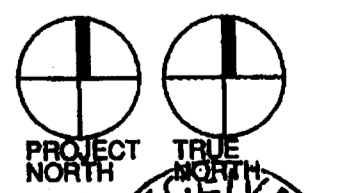

E302 RECEIVED
FEB 23 2004
217
009

Second Floor Pool Deck - Power

1/8"=1'-0"

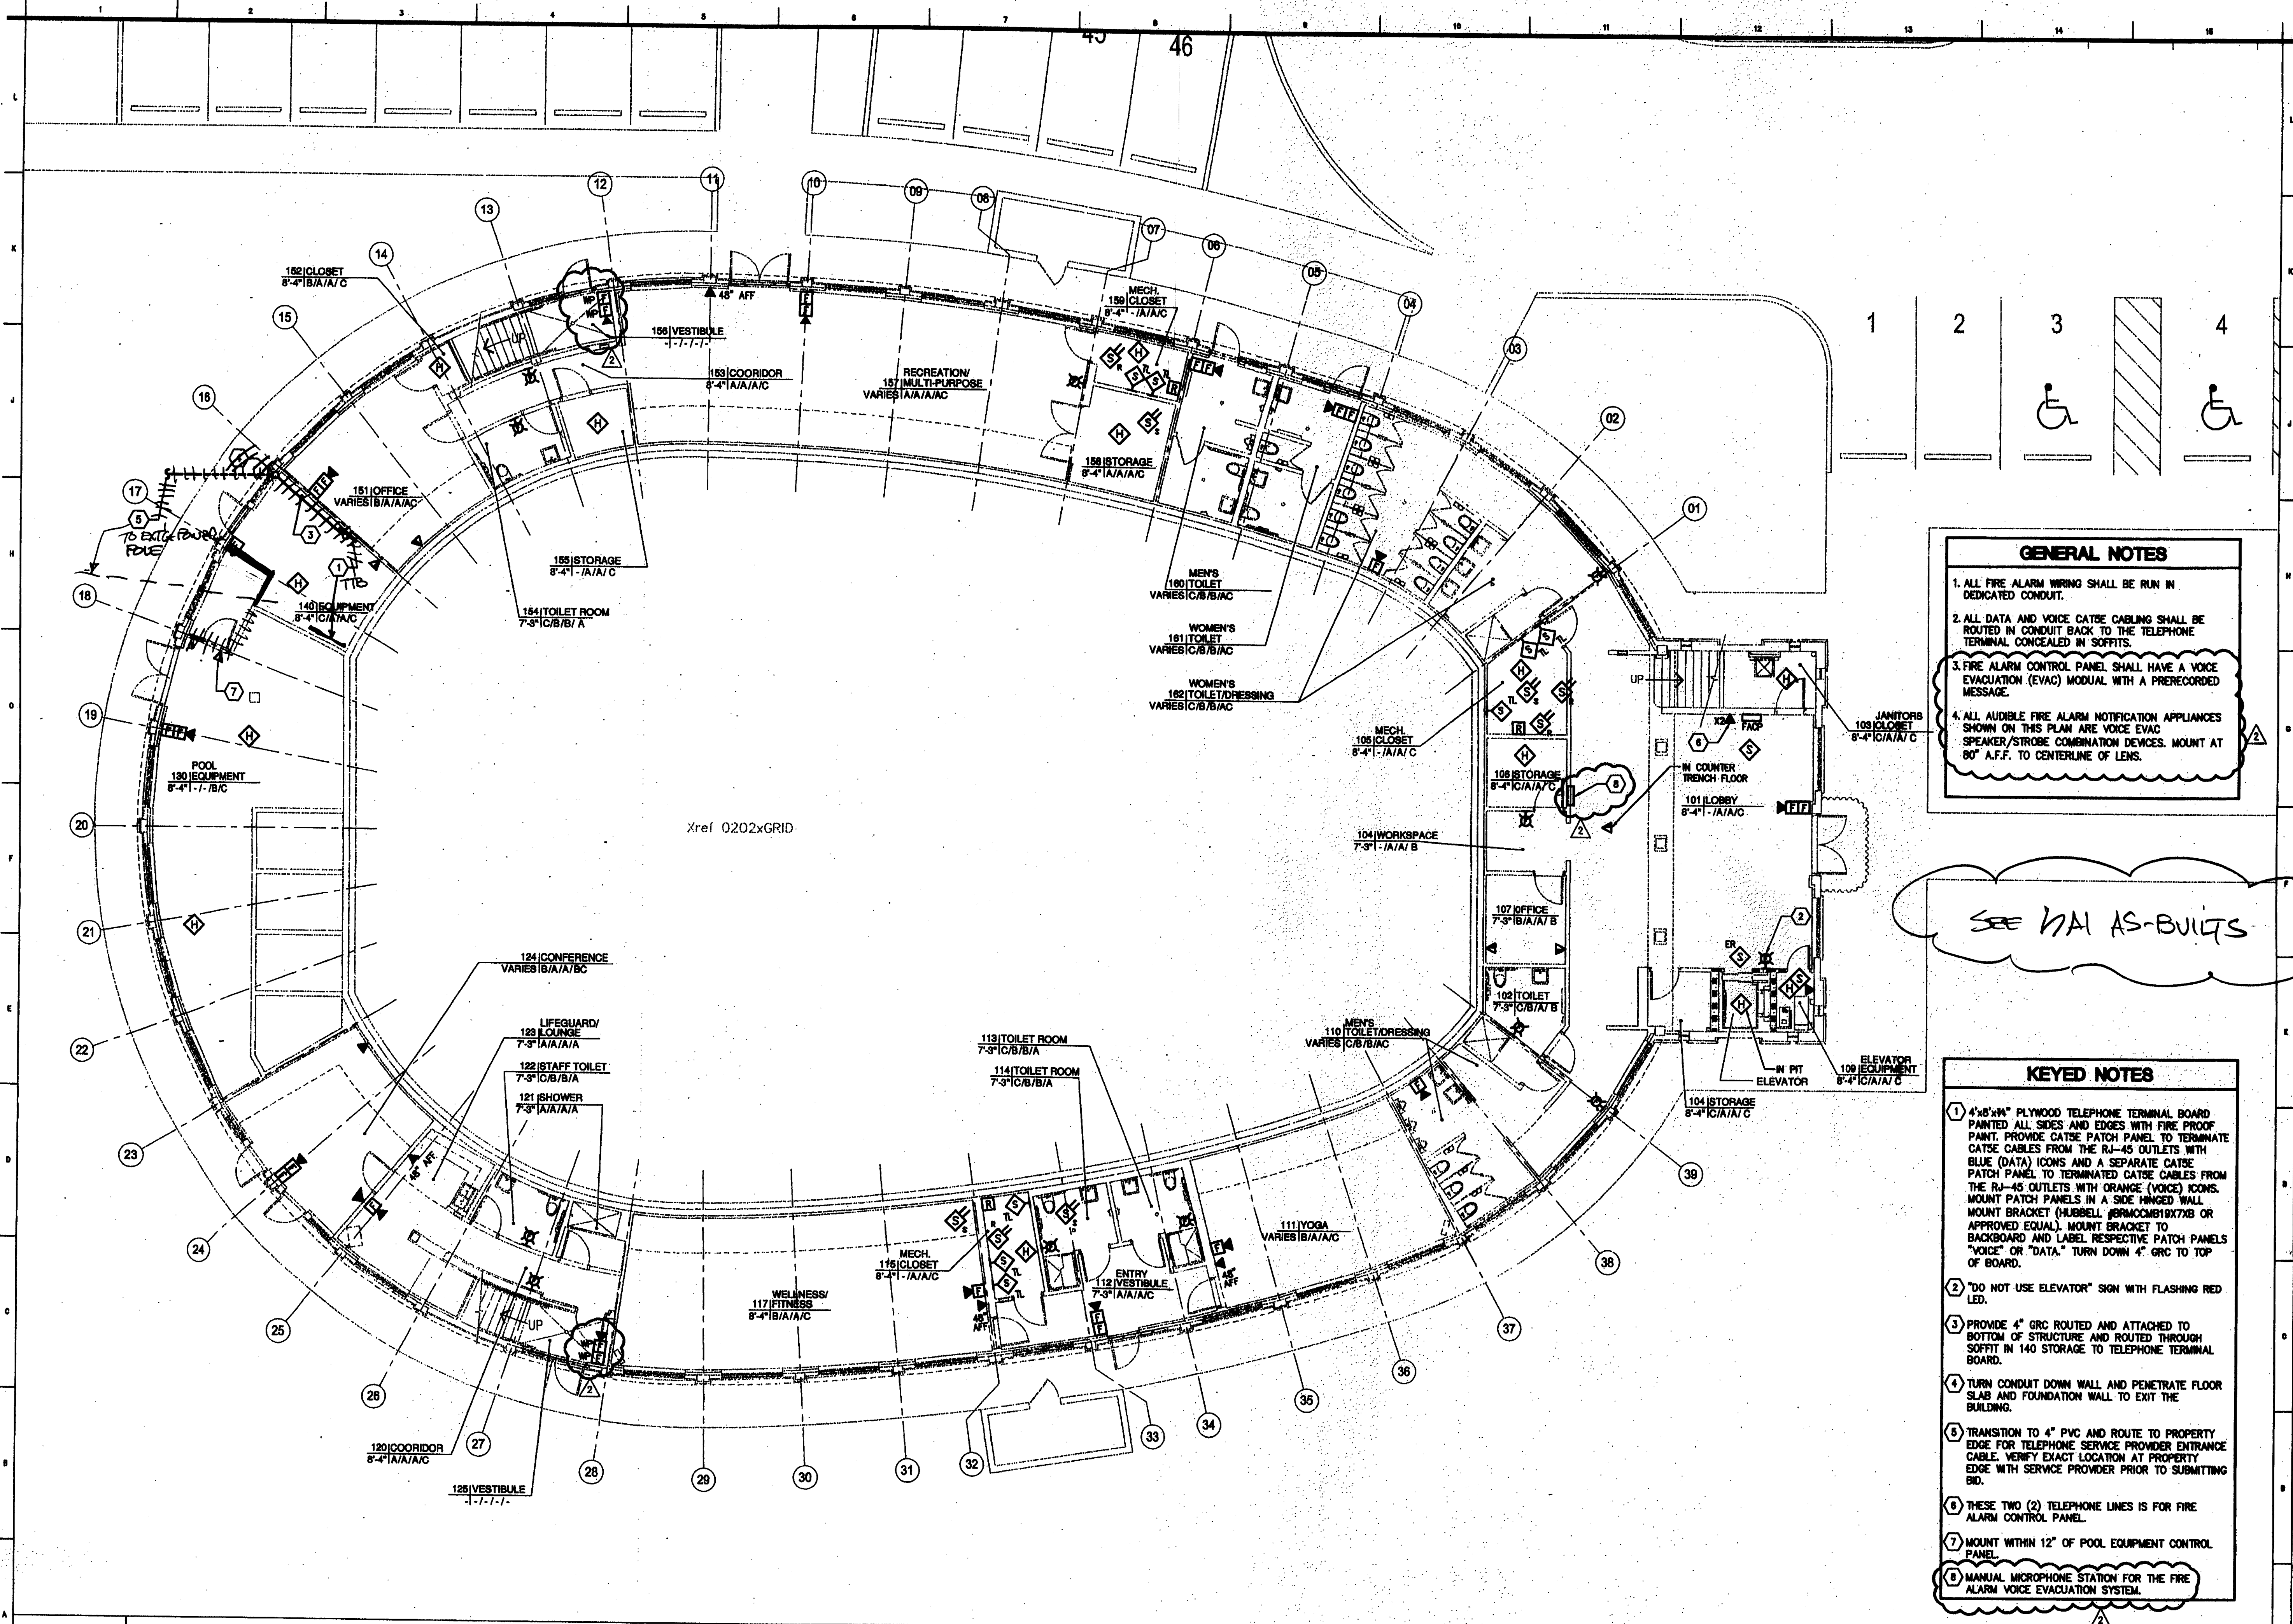

GENERAL NOTES

1. ALL FIRE ALARM WIRING SHALL BE RUN IN DEDICATED CONDUIT.
2. ALL DATA AND VOICE CATSE CABLING SHALL BE ROUTED IN CONDUIT BACK TO THE TELEPHONE TERMINAL CONCEALED IN SOFFITS.
3. FIRE ALARM CONTROL PANEL SHALL HAVE A VOICE EVACUATION (EVAC) MODUL WITH A PRERECORDED MESSAGE.
4. ALL AUDIBLE FIRE ALARM NOTIFICATION APPLIANCES SHOWN ON THIS PLAN ARE VOICE EVAC SPEAKER/STROBE COMBINATION DEVICES. MOUNT AT 80" A.F.F. TO CENTERLINE OF LENS.

SEE I/AI AS-BUILTS

KEYED NOTES

1. 4"x8"x1/4" PLYWOOD TELEPHONE TERMINAL BOARD PAINTED ALL SIDES AND EDGES WITH FIRE PROOF PAINT. PROVIDE CATSE PATCH PANEL TO TERMINATE CATSE CABLES FROM THE RJ-45 OUTLETS WITH BLUE (DATA) ICONS AND A SEPARATE CATSE PATCH PANEL TO TERMINATE CATSE CABLES FROM THE RJ-45 OUTLETS WITH ORANGE (VOICE) ICONS. MOUNT PATCH PANELS IN A SIDE HINGED WALL MOUNT BRACKET (HUBBELL #BRMCCMB19X7X8 OR APPROVED EQUAL). MOUNT BRACKET TO BACKBOARD AND LABEL RESPECTIVE PATCH PANELS "VOICE" OR "DATA." TURN DOWN 4" GRC TO TOP OF BOARD.
2. "DO NOT USE ELEVATOR" SIGN WITH FLASHING RED LED.
3. PROVIDE 4" GRC ROUTED AND ATTACHED TO BOTTOM OF STRUCTURE AND ROUTED THROUGH SOFFIT IN 140 STORAGE TO TELEPHONE TERMINAL BOARD.
4. TURN CONDUIT DOWN WALL AND PENETRATE FLOOR SLAB AND FOUNDATION WALL TO EXIT THE BUILDING.
5. TRANSITION TO 4" PVC AND ROUTE TO PROPERTY EDGE FOR TELEPHONE SERVICE PROVIDER ENTRANCE CABLE. VERIFY EXACT LOCATION AT PROPERTY EDGE WITH SERVICE PROVIDER PRIOR TO SUBMITTING BID.
6. THESE TWO (2) TELEPHONE LINES IS FOR FIRE ALARM CONTROL PANEL.
7. MOUNT WITHIN 12" OF POOL EQUIPMENT CONTROL PANEL.
8. MANUAL MICROPHONE STATION FOR THE FIRE ALARM VOICE EVACUATION SYSTEM.


CUSCADEN POOL RENOVATION

CITY OF TAMPA
305 East Jackson Street
Tampa, Florida 33602


Project No.	0202.00
Distribution	Date
BID DOCUMENTS	02.02.04
REVISION A	05.07.04

FLOOR PLAN
First Floor
Electrical Systems

RECORD DWG.
DATE 8/26/05

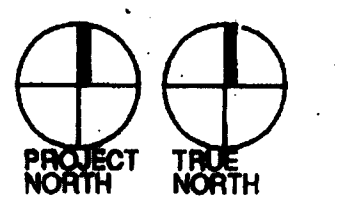


E401

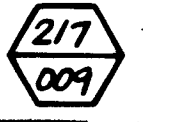


First Floor - Electrical Systems

1/8"=1'-0"

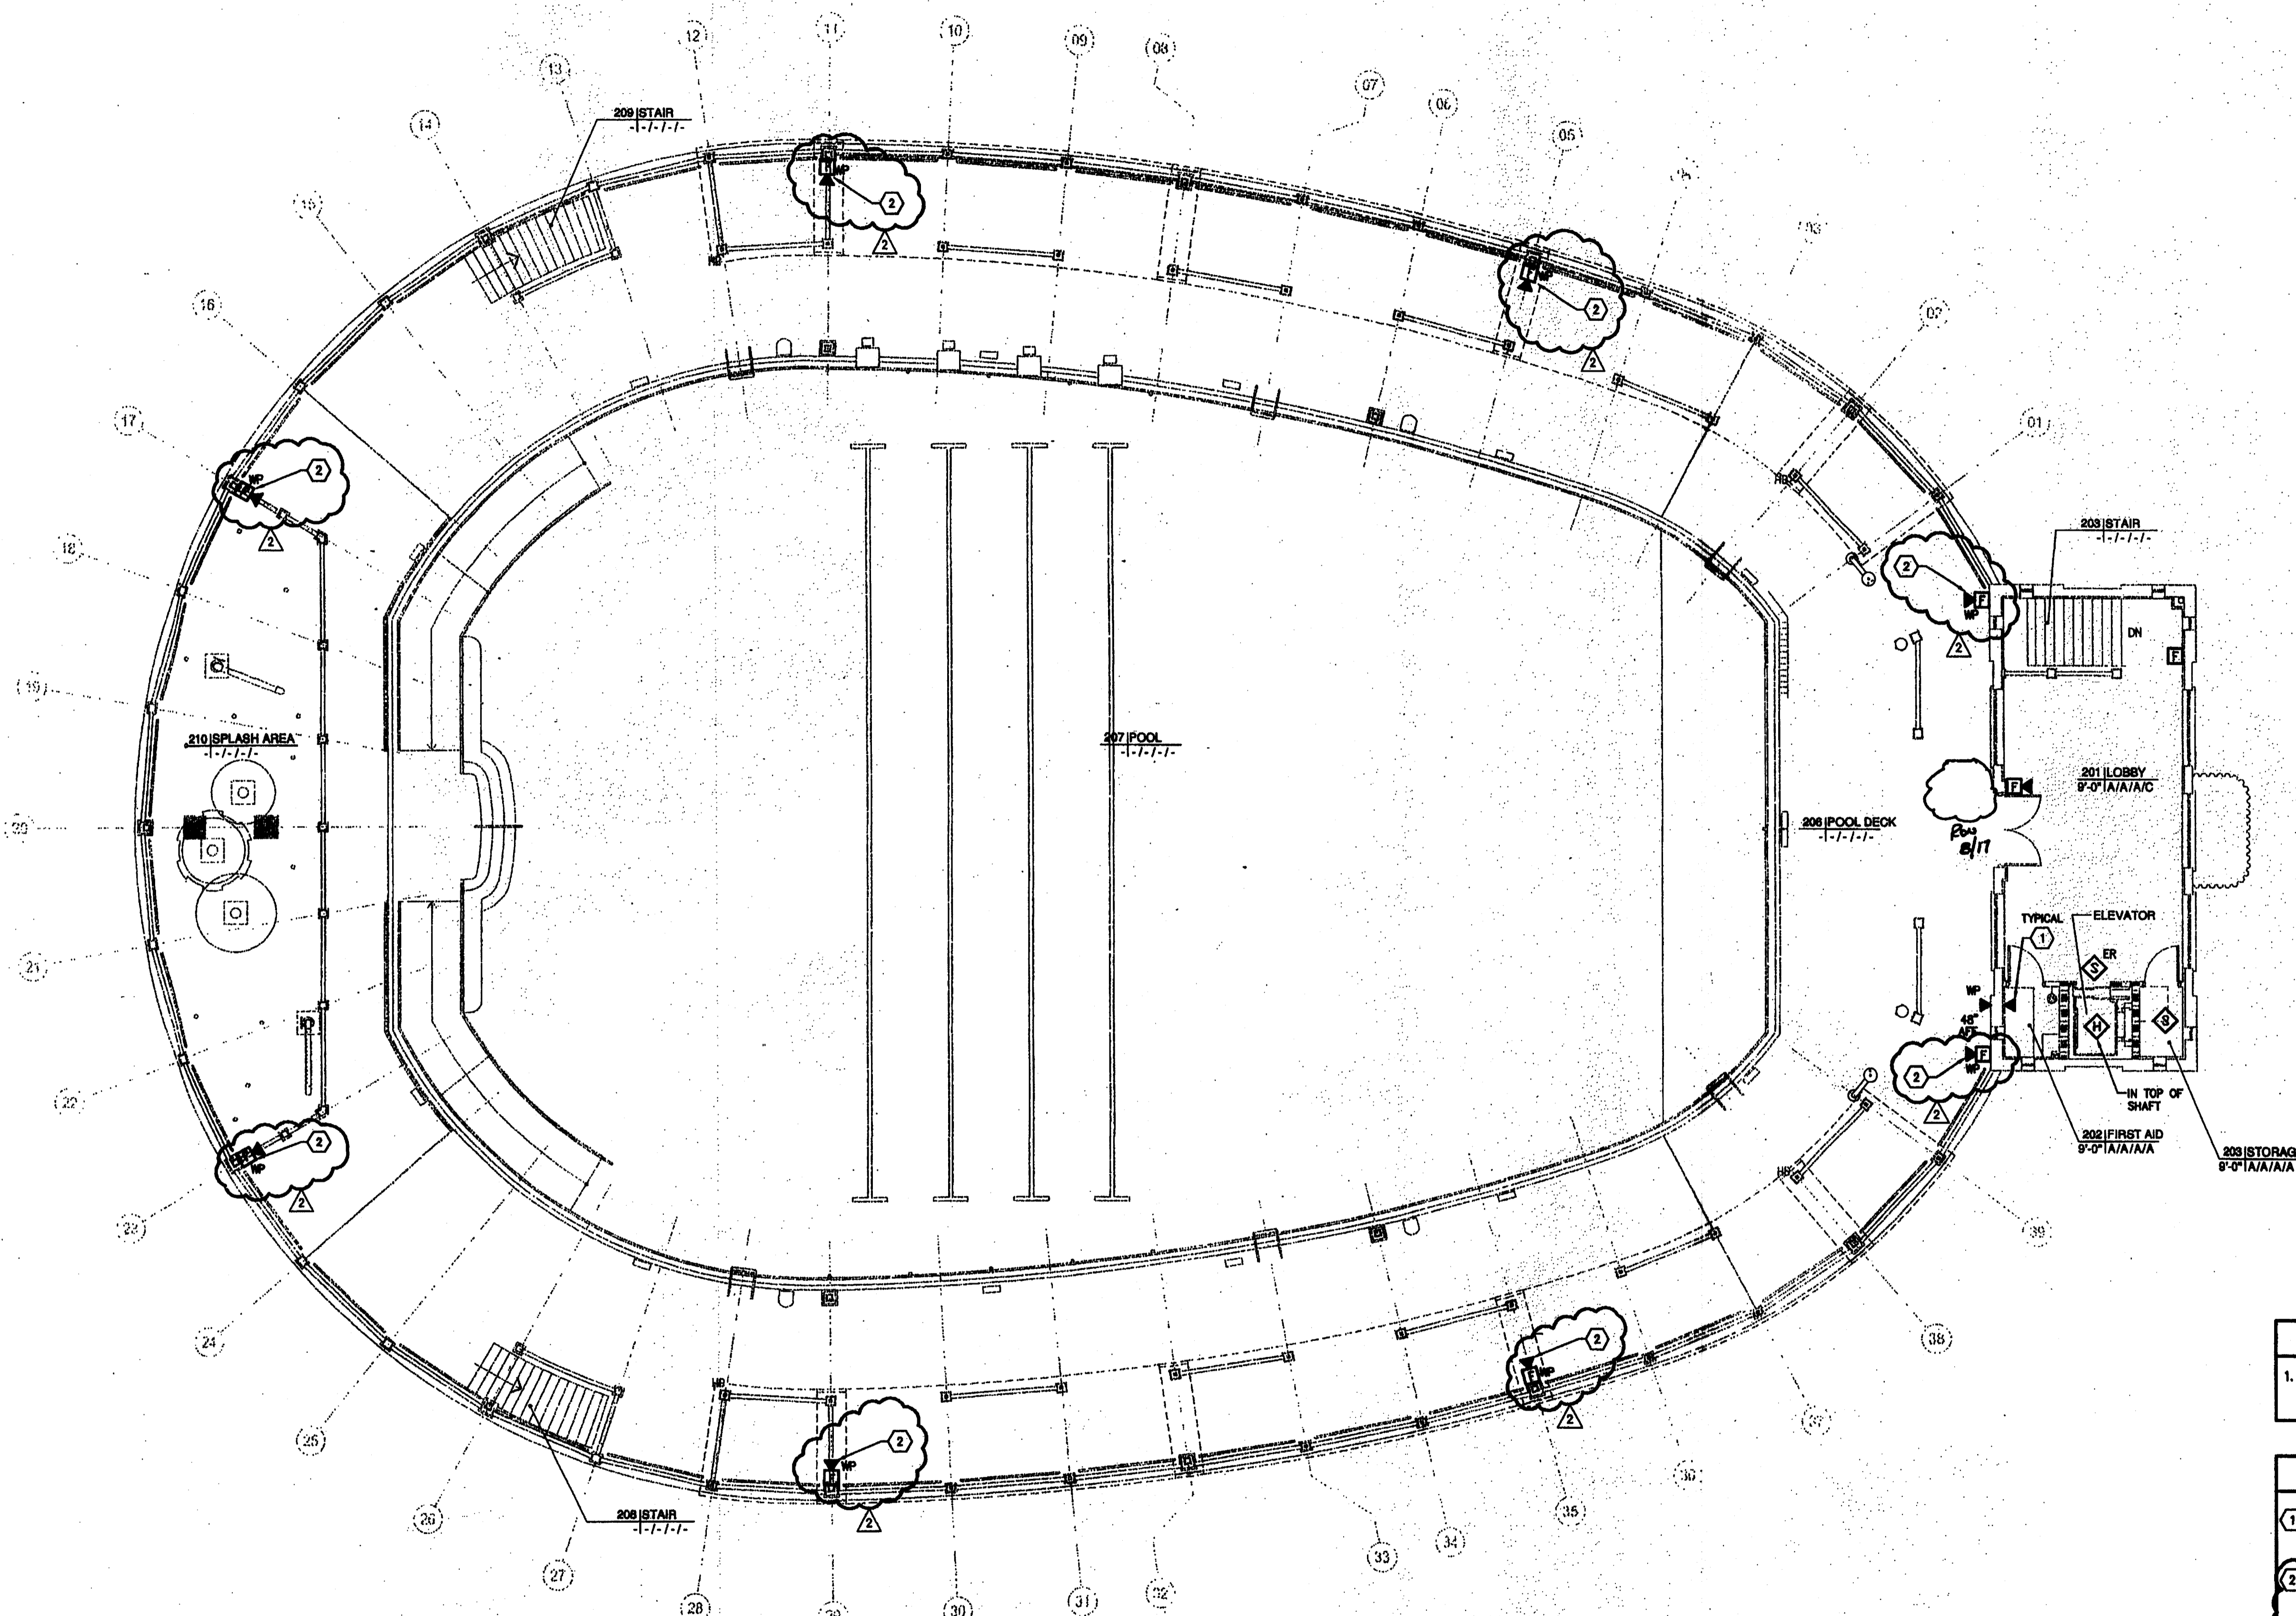

SEE SAI AS-BUILTS

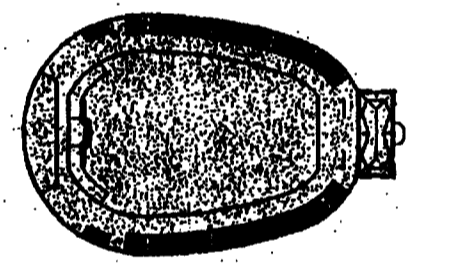

**CUSCADEN
POOL
RENOVATION**

CITY OF TAMPA
306 East Jackson Street
Tampa, Florida 33602

Project No.	0202.00
Distribution	Date
BID DOCUMENTS	02.02.04
REVISION A	05.07.04

FLOOR PLAN
Second Floor Pool Deck
Electrical Systems


RECORD DWG.
DATE 8/26/05

GENERAL NOTES
1. ALL FIRE ALARM WIRING SHALL BE RUN IN DEDICATED CONDUIT.

KEYED NOTES
1. PROVIDE CONDUIT AND (1) CAT5E CABLE BACK TO TELEPHONE TERMINAL BOARD IN STORAGE ROOM 140 CONCEALED IN SOFFITS.
2. WEATHER PROOF VOICE EVAC SPEAKER/STROBE COMBINATION DEVICE. MOUNT AT 80" A.F.F. TO CENTERLINE OF LENS. WHERE LOCATED ON POLES, ROUTE CONDUIT INSIDE OF POLE. WHERE WALL MOUNTED ROUTE CONDUIT THROUGH WALL TO CONCEAL. CUT-IN FLUSH MOUNT NEMA3R BOXES AT ALL LOCATIONS.


Second Floor Pool Deck - Electrical Systems

1/8"=1'-0"

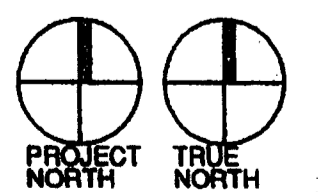

E402





2/17
009

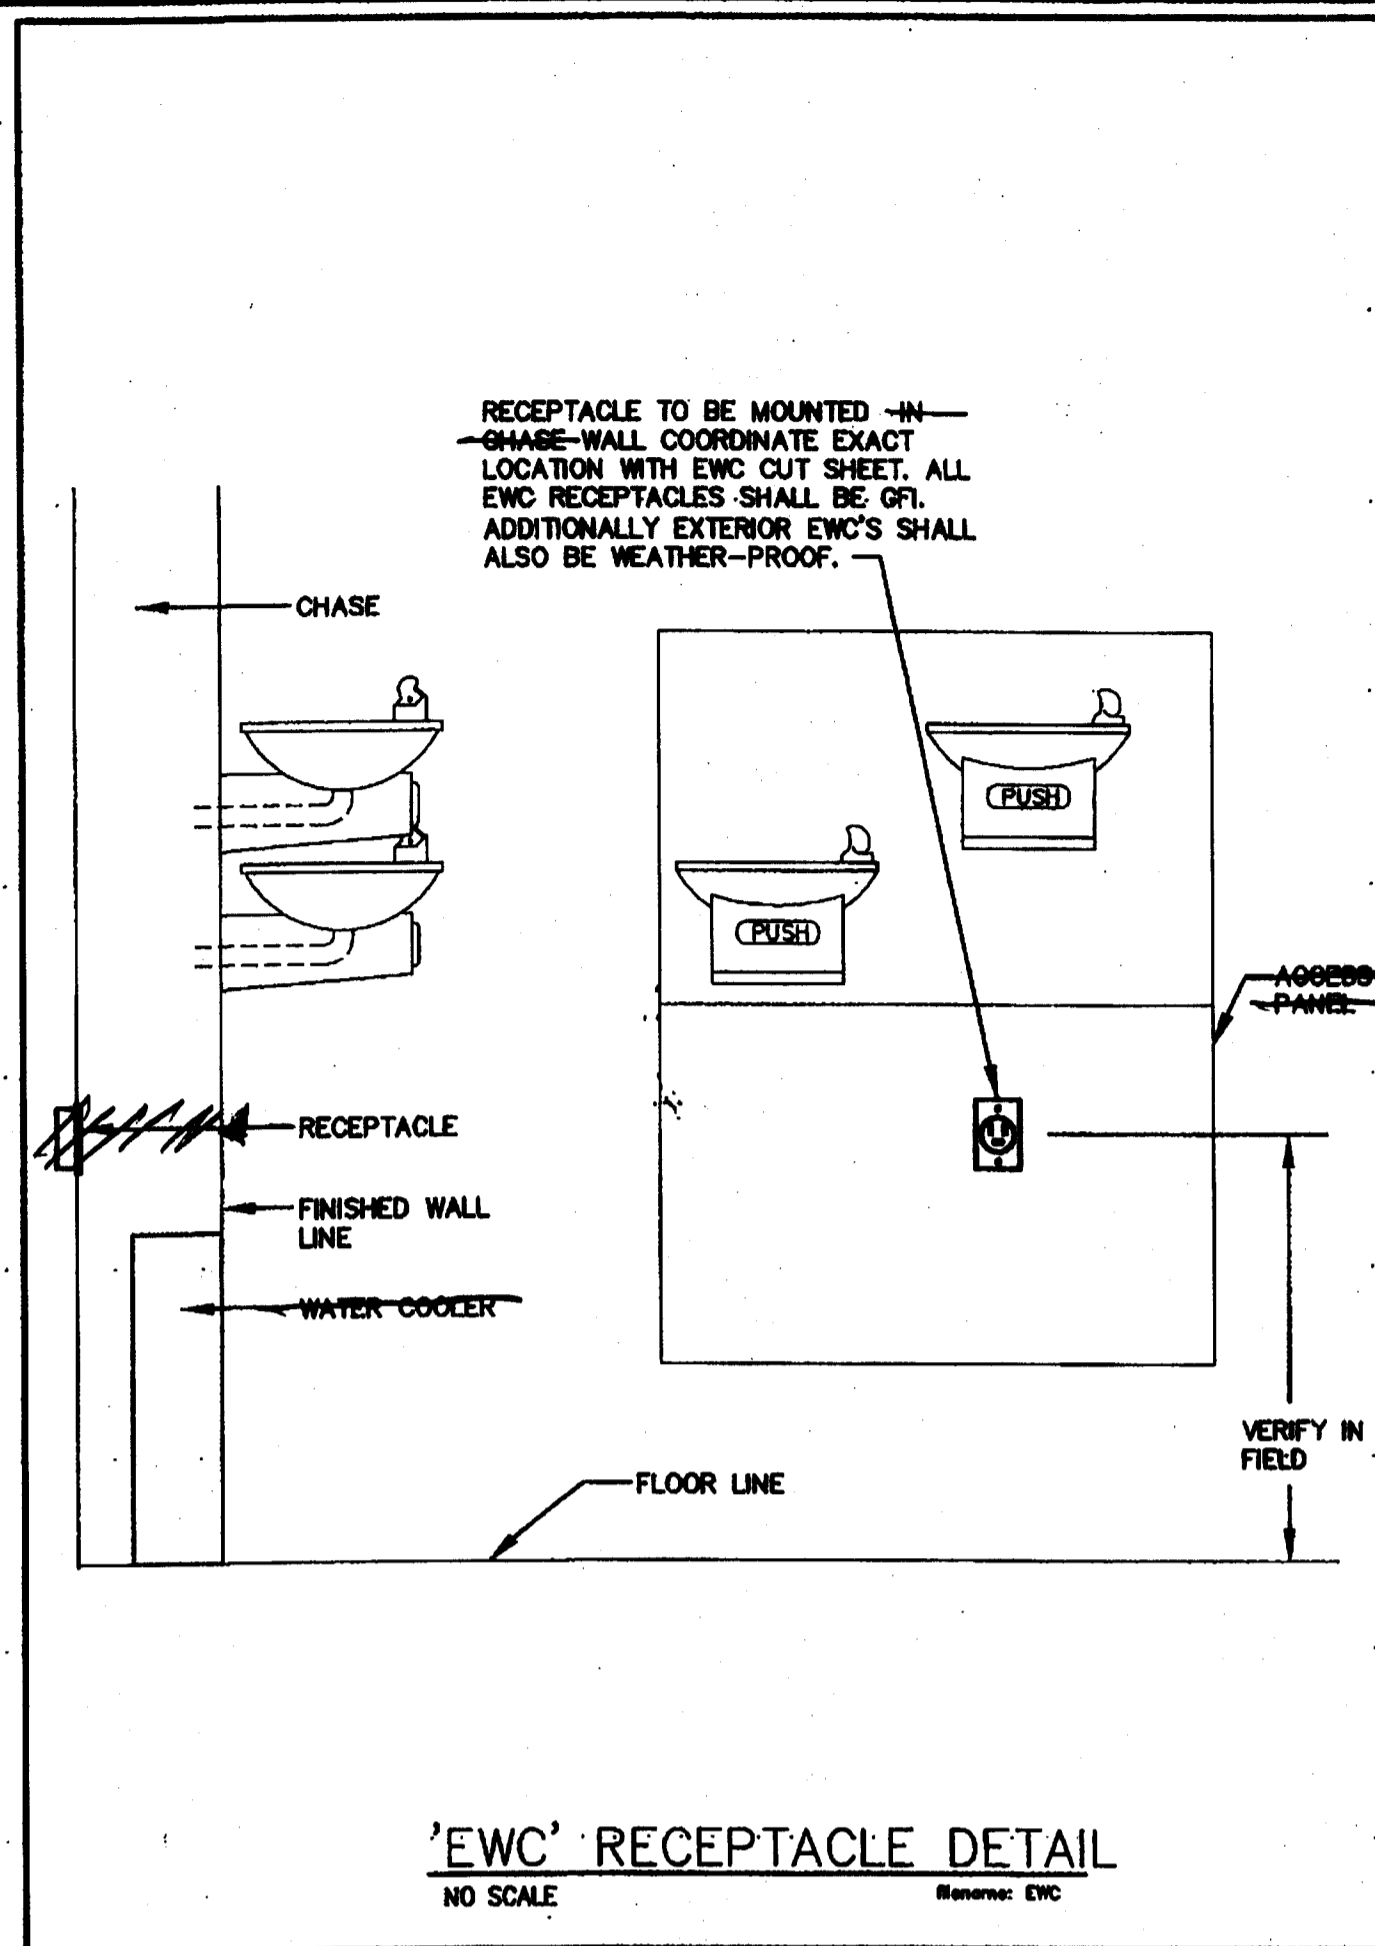

- GENERAL NOTES**
- ALL GROUNDING ELECTRODE CONDUCTORS/GROUNDING CONDUCTORS INSTALLED UNDERGROUND/IN-SLAB SHALL BE IN PVC CONDUIT.
 - REFERENCE NEC 250.52 (B) AND 250.104(B) FOR BONDING METAL GAS PIPING. GAS PIPING TO BE GROUNDING WITH A GROUNDING CONDUCTOR SIZED PER NEC TABLE 250.122 OR A MINIMUM OF #6 AWG COPPER.
 - REFERENCE NEC 250.104(B) FOR BONDING ALL INTERIOR METAL PIPING AND AIR DUCTS. GROUND ALL SAME INTERIOR PIPING/DUCTS.
 - REFERENCE NEC 250.52(A)(6) FOR A GROUND RING ENCIRCLING THE BUILDING OR STRUCTURE. IF INSTALLED, GROUNDING CONDUCTOR SHALL NOT BE LESS THAN 2.5' BELOW THE EARTH'S SURFACE, CONSISTING OF AT LEAST 20' OF BARE COPPER, NOT SMALLER THAN #2 AWG.
 - REFERENCE NEC 250.108 AND NFPA 780 FOR LIGHTNING PROTECTION SYSTEMS. IF INSTALLED, LIGHTNING PROTECTION SYSTEM TERMINAL SHALL BE BONDED TO THE BUILDING OR STRUCTURE GROUND BUS.
 - ALL FLOOR-MOUNTED SWITCHBOARDS, PANELBOARDS AND TRANSFORMERS ARE TO BE INSTALLED ON 4" CONCRETE HOUSEKEEPING PADS.
 - ALL TVSS DEVICES SHALL BE PROVIDED AND INSTALLED PER DIVISION 16000 AND PER MANUFACTURERS STANDARDS. FOR CLARITY ONLY BONDING, BRANDING AND NEUTRAL CONDUCTORS/CONNECTORS ARE SHOWN.
 - ALL COPPER GROUNDING ELECTRODE CONDUCTORS SHALL BE IDENTIFIED EVERY 4' WITH GREEN TAPE IF INSULATED AND EXPOSED.
 - REFERENCE NEC 250.08 COMMON GROUNDING ELECTRODE - WHERE SEPARATE SERVICES SUPPLY A BUILDING, THEY SHALL BE PROVIDED WITH A COMMON GROUNDING ELECTRODE.
 - ALL NATIONAL ELECTRICAL CODE ARTICLE NUMBERS ARE BASED ON THE 2003 N.E.C.
 - EACH CONDUCTOR SHALL BE PERMANENTLY IDENTIFIED AT GROUND BUS AS TO EQUIPMENT SERVED.

- KEYED NOTES**
- STRUCTURAL BUILDING STEEL.
 - BOND MAIN METAL PLUMBING PIPING WITHIN 5' OF EXTERIOR BUILDING. IF UNDERGROUND PLUMBING PIPING IS PVC, GROUND METAL PLUMBING WITHIN BUILDING AT CLOSEST ACCESSIBLE POINT.
 - GROUNDING ELECTRODE CONDUCTOR SIZED PER TABLE 250.66.
 - GROUND BUS - 4" WIDE X 18" LONG MINIMUM X 1/4" THICK SOLID COPPER TERMINAL BUS MOUNTED ON INSULATORS OFF WALL.
 - MINIMUM #4 COPPER GROUNDING ELECTRODE CONDUCTOR.
 - MAIN GROUNDING ELECTRODE CONDUCTOR 20' BARE COPPER IN EARTH, BURIED 24" DEEP, SIZED PER TABLE 250.66. INSURE CONDUCTOR IS BURIED OUTSIDE OF BUILDING PAD AND NOT INSTALLED UNDER SLAB OR FOOTER.
 - FOOTER STEEL IN GROUND. GROUND CONNECTIONS TO BE EXOTHERMIC WELDS TO A MIN. 1/2" THICK BY 20' LONG REBAR.
 - NOT USED.
 - THREE COPPER GROUND RODS, 5/8" BY 20' LONG, SPACED A MINIMUM OF 10' APART. GROUND CONNECTIONS SHALL BE EXOTHERMIC WELDS. PROVIDE 6" PVC SLEEVE WITH THREADED CAP INSTALLED FLUSH WITH FINISHED GRADE FOR ACCESS FOR SERVICE AND/OR INSPECTION.
 - EQUIPMENT GROUNDING CONDUCTOR ROUTED WITH PRIMARY AND SECONDARY FEEDERS SIZED PER TABLE 250.122. CONNECT TO GROUND BUS AT PANELBOARD.
 - NOT USED.

- KEYED NOTES (CONT.)**
- NEUTRAL (GROUNDED CONDUCTOR) SHALL NOT BE BONDED AT SECONDARY PANELBOARDS (FLOAT IF APPLICABLE).
 - ALL ENCLOSURES/CONTROL CABINETS FOR SYSTEMS PER DETAIL SHALL BE GROUNDING WITH A MINIMUM #4 COPPER GROUNDING CONDUCTOR TO MAIN GROUNDING ELECTRODE BUSBAR.
 - INSTALL A GROUND BAR KIT CAPABLE OF TERMINATING ALL EQUIPMENT GROUNDING CONDUCTORS ENTERING THE ENCLOSURE.
 - LIGHTNING PROTECTION SYSTEM AIR TERMINAL(S). (SEE GENERAL NOTE #5)
 - IF PROVIDED, LIGHTNING PROTECTION SYSTEM GROUND TERMINALS SHALL BE BONDED TO MAIN BUILDING GROUNDING ELECTRICAL SYSTEM/BUS.
 - GROUND RING. (SEE GENERAL NOTE #4)
 - MADE ELECTRODES INSTALLED AS NECESSARY PER MANUFACTURERS REQUIREMENTS. GROUND CONNECTIONS SHALL BE EXOTHERMIC WELDS. PROVIDE 6" PVC SLEEVE WITH THREADED CAP INSTALLED FLUSH WITH FINISHED GRADE FOR ACCESS FOR SERVICE AND/OR INSPECTION.
 - NEUTRAL (GROUNDED CONDUCTOR) TO BE BONDED ONLY AT SERVICE MAIN. ALL OTHER BUILDING MAIN NEUTRALS ARE NOT TO BE BONDED (FLOATING).
 - NOT USED.
 - METAL HVAC DUCTWORK SHALL BE BONDED AS PER 250.104 (B) WITHIN THE MECHANICAL ROOM IN WHICH THEY ORIGINATE WITH A MINIMUM #6 AWG COPPER.

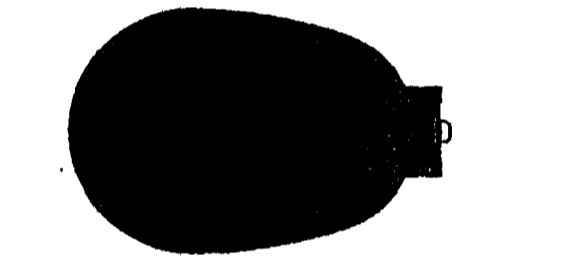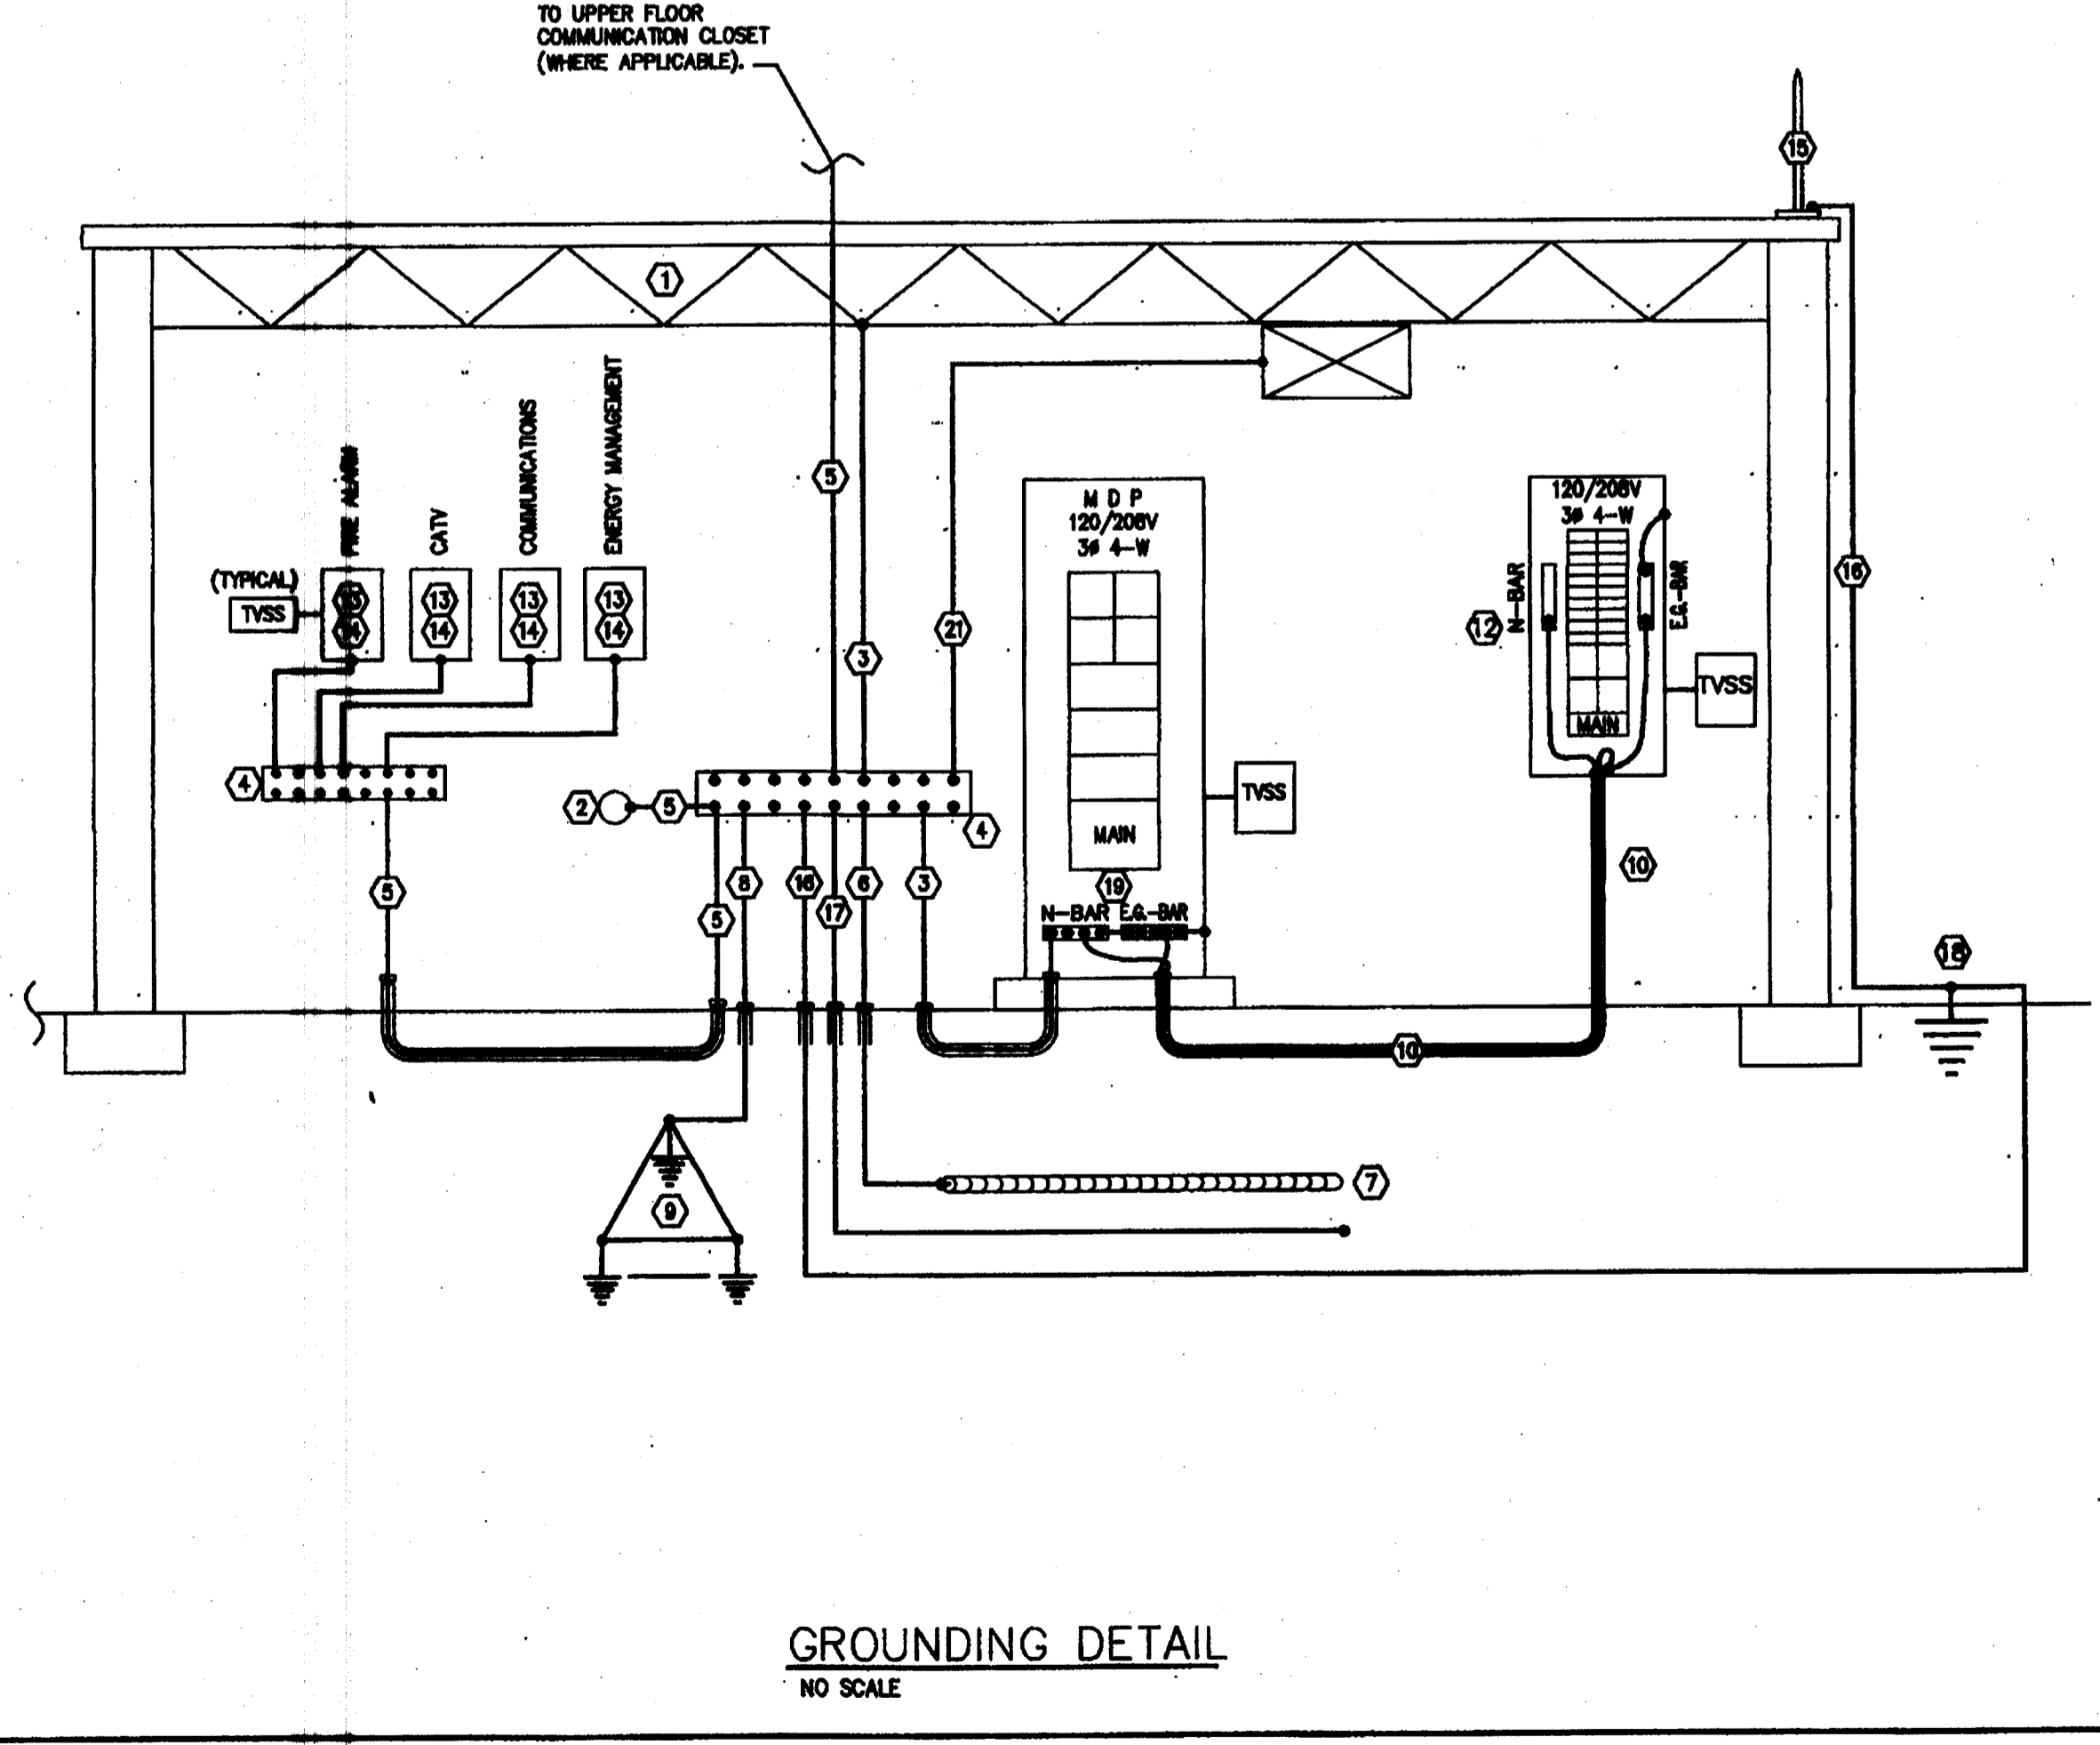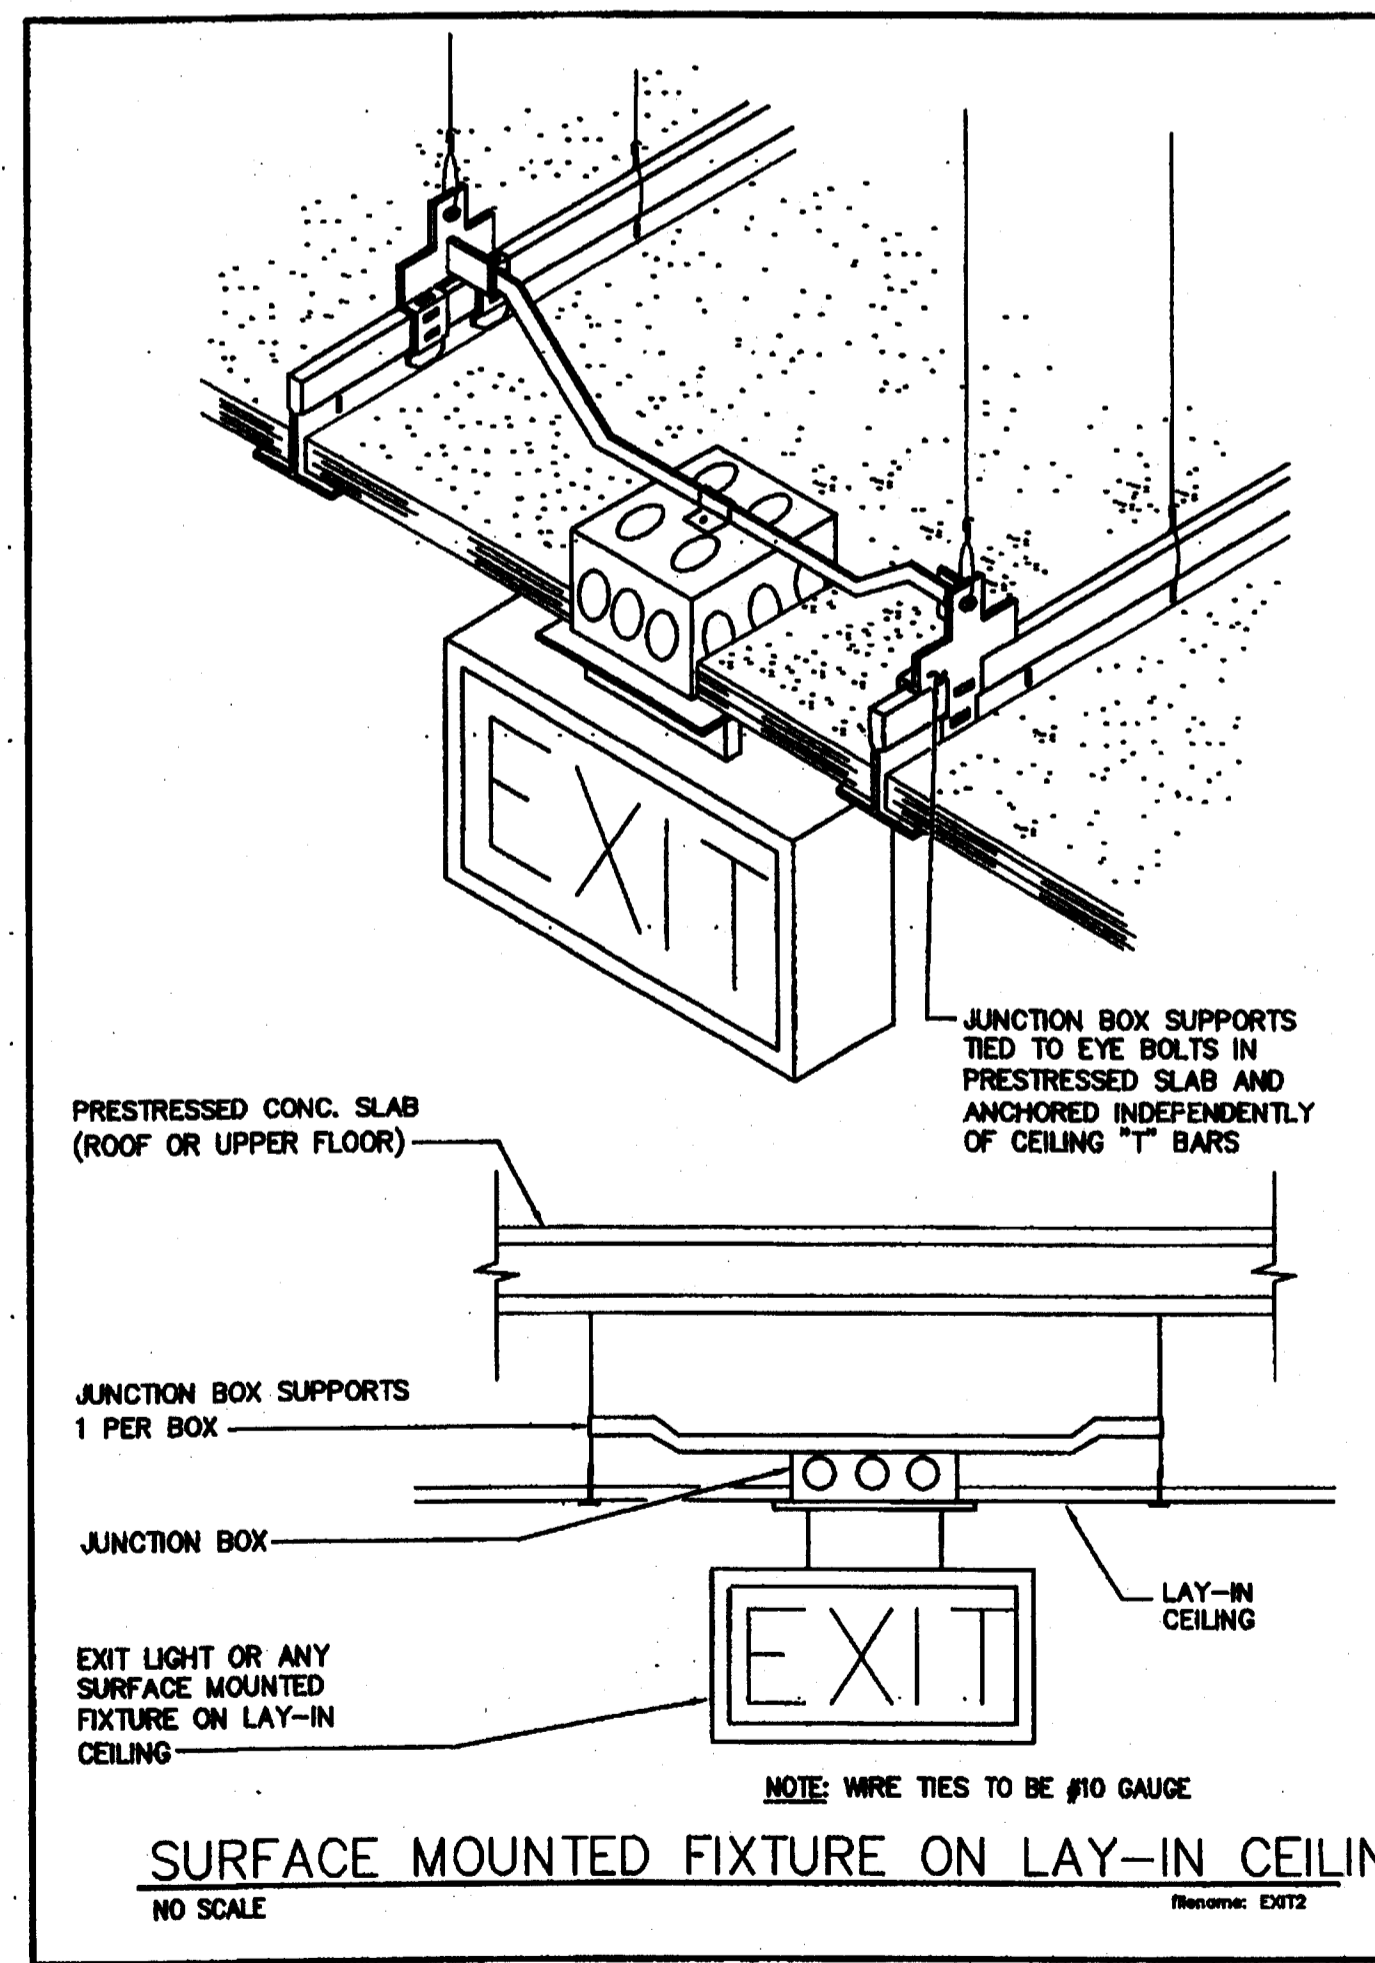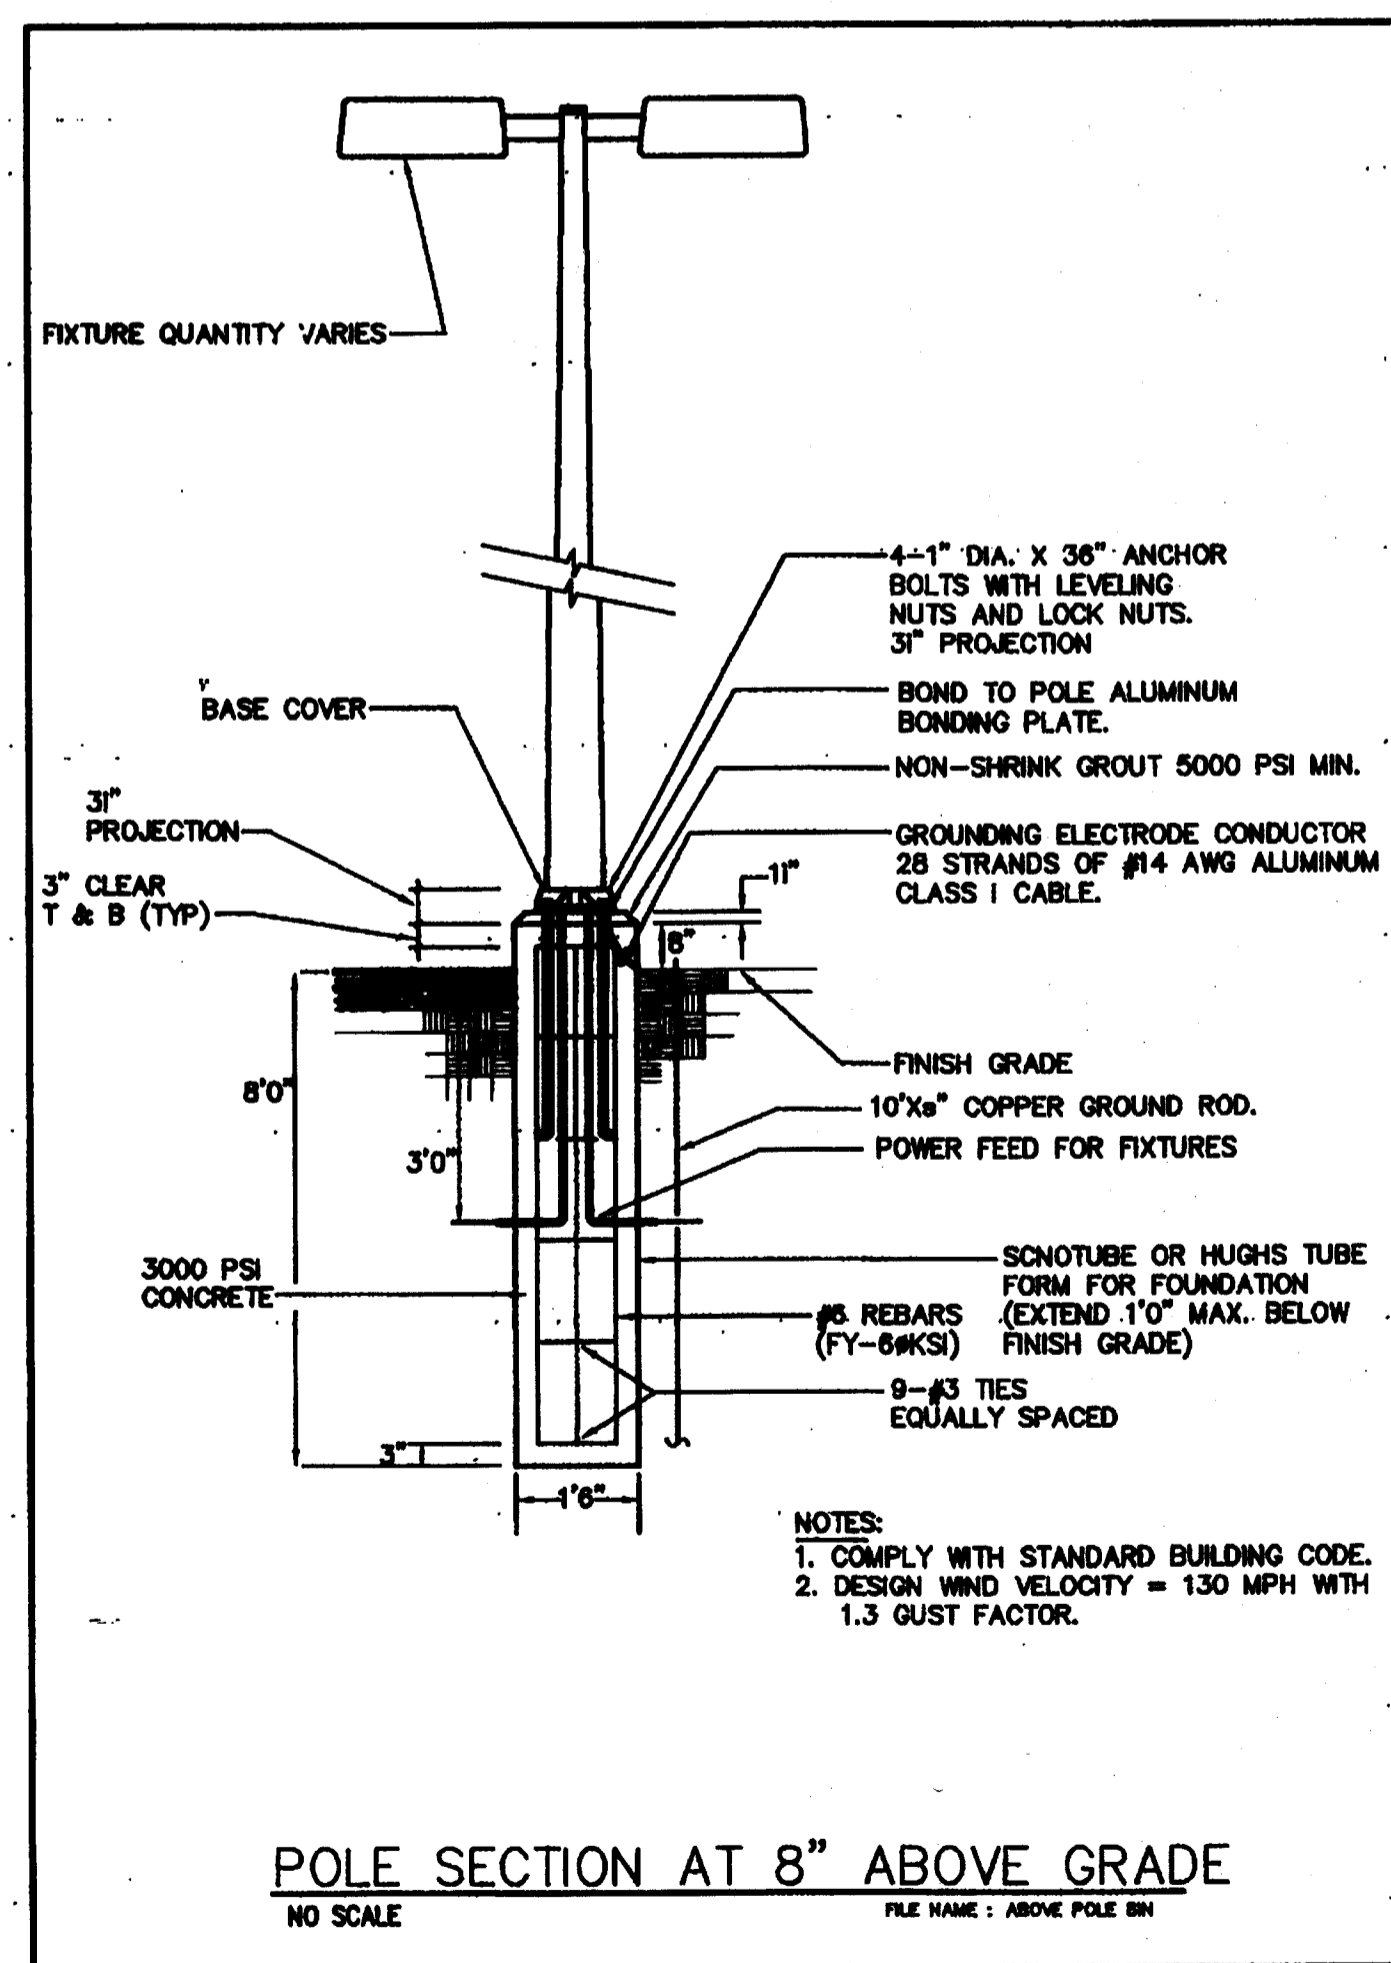

CUSCADEN POOL RENOVATION

CITY OF TAMPA
906 East Jackson Street
Tampa, Florida 33602

Project No. 0202.00

Distribution	Date
BID DOCUMENTS	02.02.04


Details - Electrical

RECORD DWG.
DATE 2/26/05


RECEIVED
FEB 23 2004

E501

217
009

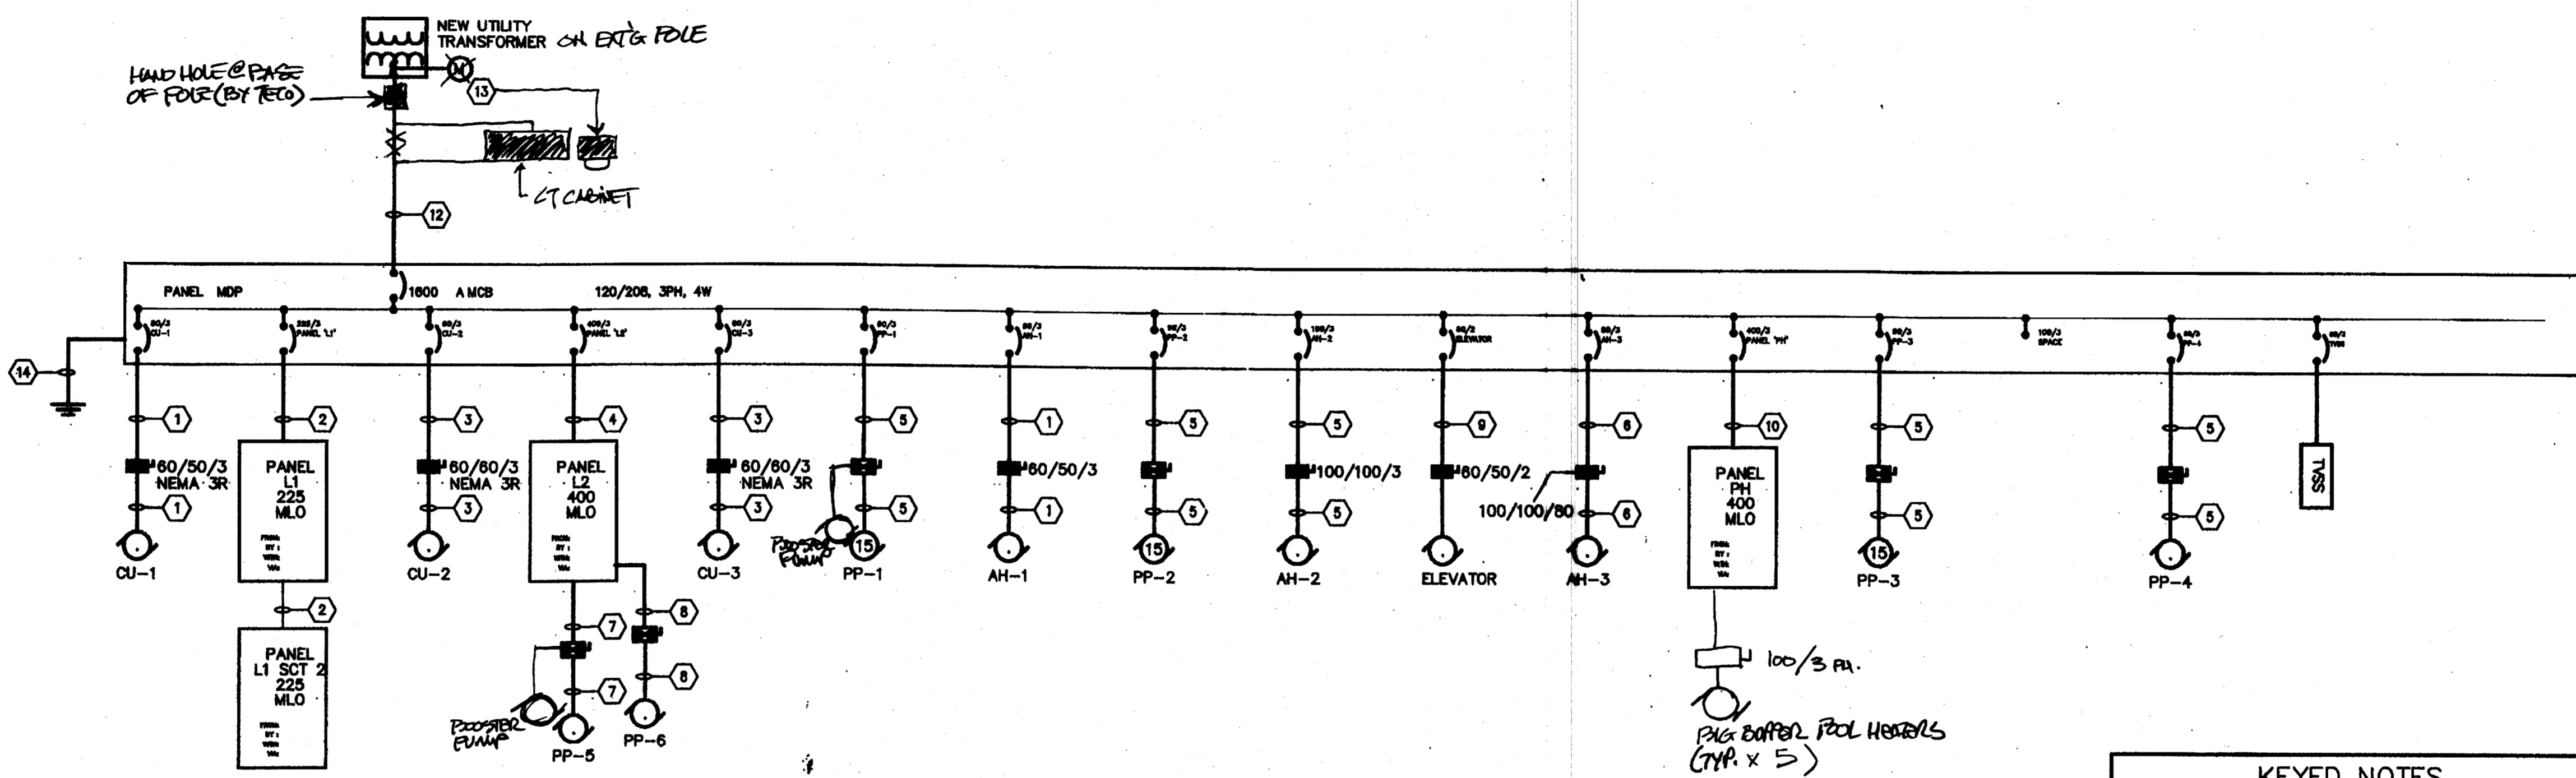

KEYED NOTES	
①	PROVIDE 3-#8 THWN CU AND 1-#10 E.G. CU IN 2" CONDUIT.
②	PROVIDE 4-#10 THWN CU AND 1-#4 E.G. CU IN 2" CONDUIT.
③	PROVIDE 3-#8 THWN CU AND 1-#10 E.G. CU IN 2" CONDUIT.
④	PROVIDE 2 RUNS OF 2" CONDUIT WITH 4-#3/0 THWN CU AND 1-#3 E.G. CU IN EACH.
⑤	PROVIDE 3-#3 THWN CU AND 1-#8 E.G. CU IN 1" CONDUIT.
⑥	PROVIDE 3-#4 THWN CU AND 1-#8 E.G. CU IN 1" CONDUIT.
⑦	PROVIDE 2-#12 THWN CU AND 1-#12 E.G. CU IN 2" CONDUIT.
⑧	PROVIDE 2-#10 THWN CU AND 1-#10 E.G. CU IN 2" CONDUIT.
⑨	PROVIDE 2-#8 THWN CU AND 1-#10 E.G. CU IN 2" CONDUIT.
⑩	PROVIDE 2 RUNS OF 2" CONDUIT WITH 4-#3/0 THWN CU AND 1-#3 E.G. CU IN EACH.
⑪	NOT USED.
⑫	PROVIDE 4 RUNS OF 4" CONDUIT WITH 4-#800 MCM THWN CU IN EACH.
⑬	NEW METER COORDINATE EXACT REQUIREMENTS WITH UTILITY COMPANY.
⑭	GROUNDING. PROVIDE 3/0 COPPER GROUNDING ELECTRODE CONDUCTOR TO BUILDING STEEL, METALLIC COLD WATER PIPE AND 3-20'-0"X3/4" COPPERCLAD GROUND RODS SPACED ONE ROD LENGTH APART. GROUNDING SHALL BE IN ACCORDANCE WITH N.E.C. PROVIDE ALL COMPONENTS FOR COMPLETE GROUNDING SYSTEM. REFER TO GROUNDING DETAIL FOR ADDITIONAL GROUNDING REQUIREMENTS.

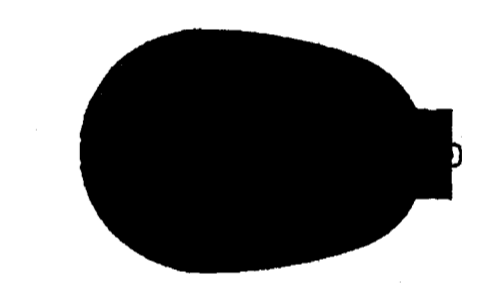


CUSCADEN POOL RENOVATION

CITY OF TAMPA
900 East Jackson Street
Tampa, Florida 33602

Project No.	0202.00
Distribution	Date
BID DOCUMENTS	02.02.04

Single Line Diagram & Panel Schedules
Electrical


RECORD DWG.
DATE 8/26/05

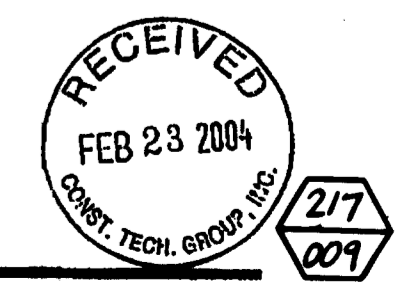

E601

Single Line Diagram & Panel Schedules - Electrical


N.T.S

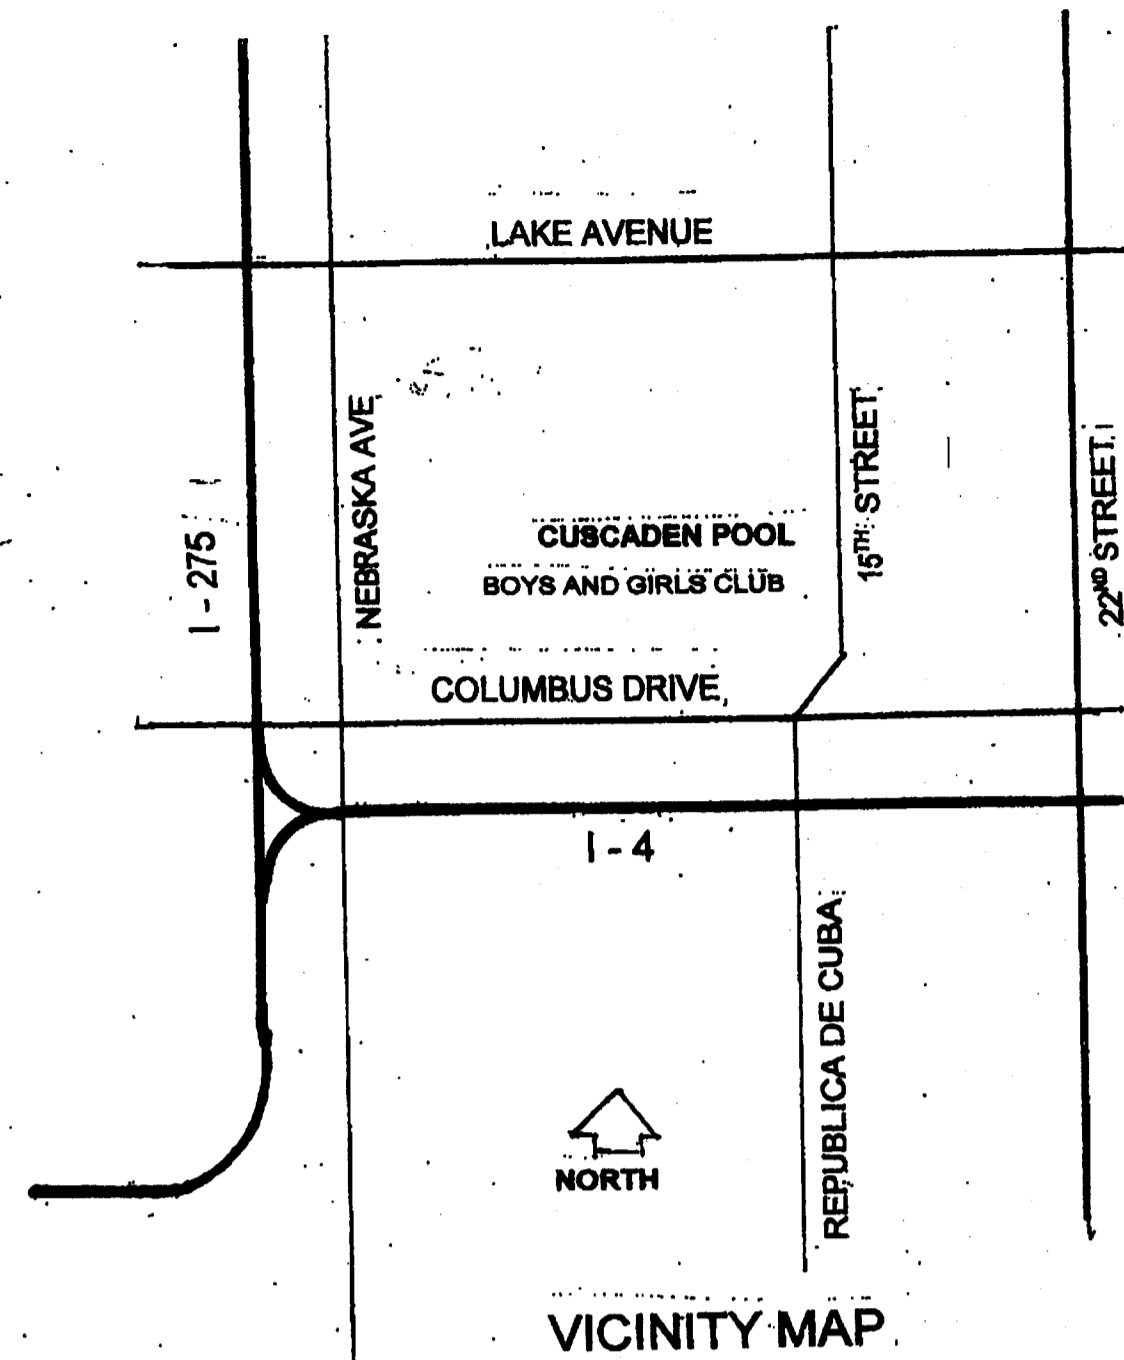

VICINITY MAP

LEGAL DESCRIPTION

CUSCADEN'S GROVE FIRST ADDITION N 825 FT OF LOT A LESS LOT BEG 210 FT N OF SE COR OF LOT A & RUN N 170 FT W 129 FT S 170 FT & E 120 FT TO BEG, PLAT BOOK 26 PAGE 7 AND CUSCADEN'S GROVE FIRST ADDITION LOTS 51 TO 64 INCL, PLAT BOOK 26 PAGE 7

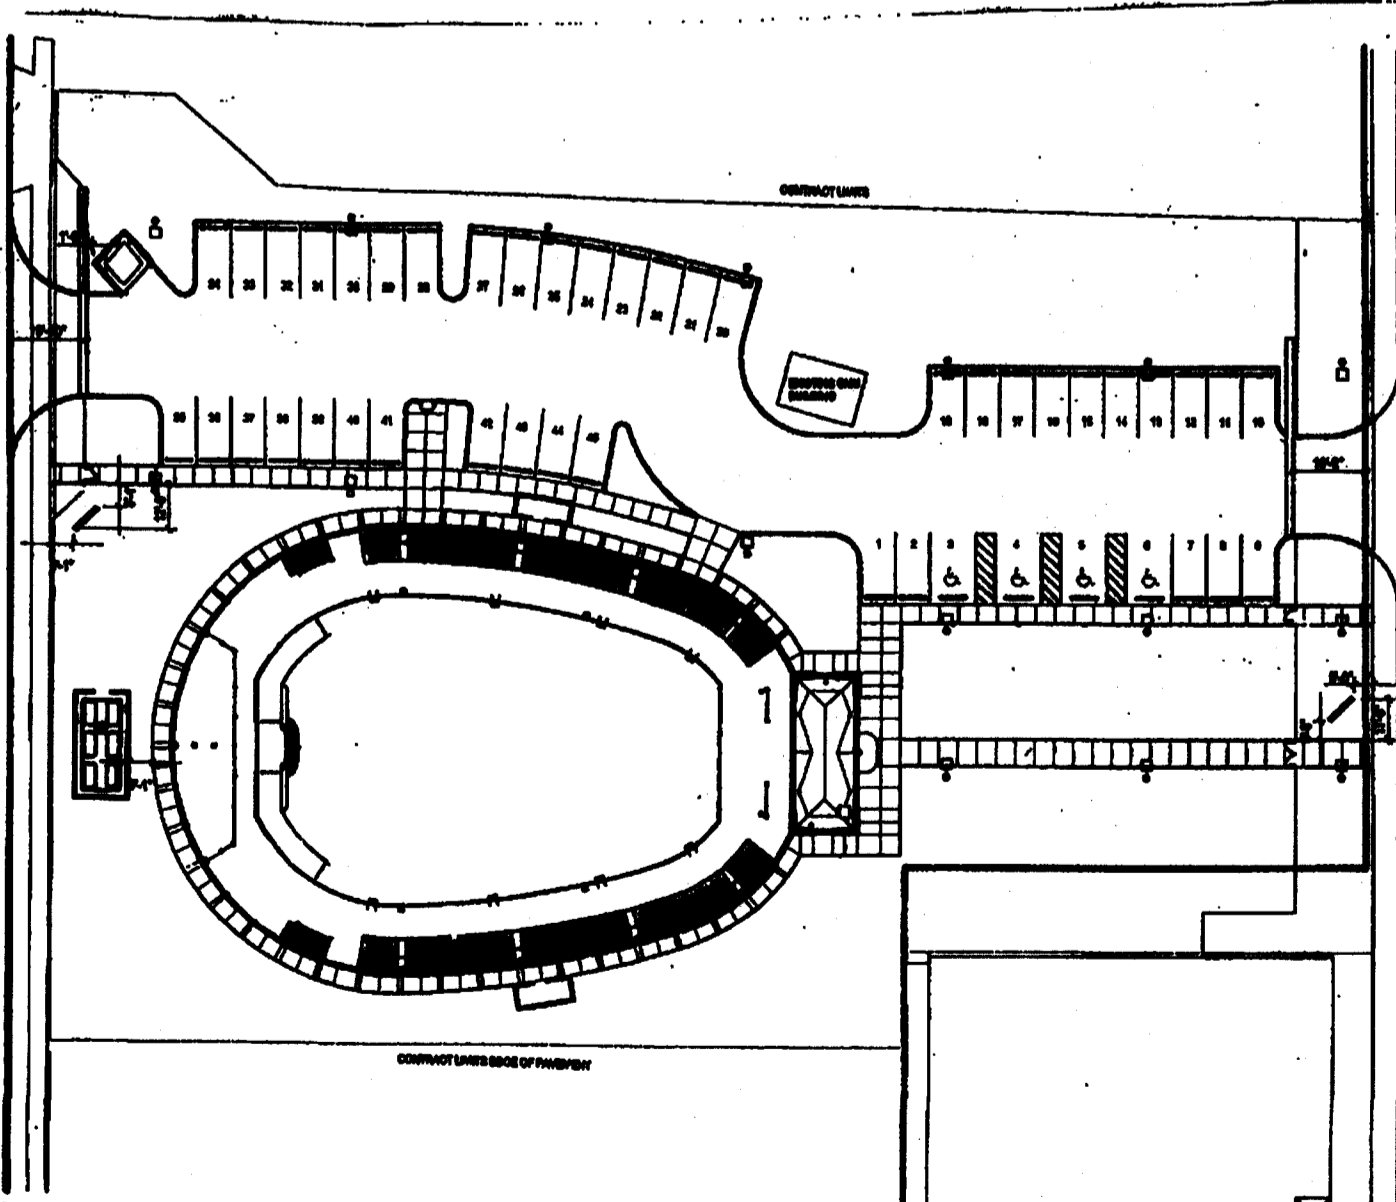

SITE PLAN 1"=50'

GENERAL NOTES & CONDITIONS PERTAINING TO 64E-9 F.A.C.

IT IS THE INTENT OF THESE PLANS AND SPECIFICATIONS THAT THEY COMPLY WITH CHAPTER 64E-9 F.A.C., HOWEVER, REGARDLESS OF STATEMENTS OR DETAILS IN THESE DOCUMENTS, THE POOL AND SPLASH PAD MUST BE CONSTRUCTED IN COMPLIANCE WITH CURRENT HEALTH DEPARTMENT REQUIREMENTS AND BUILDING CODES IN FORCE IN THIS JURISDICTION.

DEEP BOWL REQUIREMENTS

#1. IF THE DEPTH AT THE DEEPEST POINT (MAIN DRAIN GRATE) DEVIATES MORE THAN 3 INCHES IN DEPTH FROM THE SIDE WALLS AT THAT LOCATION, A SECOND DEPTH MARKER SHALL BE INSTALLED INDICATING THE DEPTH AT THE DEEP POINT.

#2. EACH MAIN DRAIN GRATE SHALL HAVE SUFFICIENT AREA SO THAT THE MAXIMUM VELOCITY THROUGH THE GRATE WILL NOT EXCEED 1.5 FEET PER SECOND.

#3. EACH MAIN DRAIN GRATE SHALL BE SECURELY FASTENED WITH STAINLESS STEEL SCREWS TO PREVENT UNAUTHORIZED REMOVAL BY BATHERS.

INTERIOR FINISH

SHALL BE SLIP RESISTANT AND REFLECTIVE IN NATURE TO ASSIST IN THE IDENTIFICATION OF PERSONS BENEATH THE SURFACE OF THE WATER IN THE POOL.

DECK REQUIREMENTS

#1. DECKS SHALL HAVE A MINIMUM UNOBSTRUCTED WIDTH OF 4 FEET AROUND THE PERIMETER OF THE POOL INCLUDING LADDERS AND HANDRAILS. (AND AS SHOWN ON THE DRAWING OF THE SPLASH PAD PER VARIANCE ISSUED 6/6/05.)

DECKING WILL SLOPE TOWARD THE POOL AND DRAIN INTO A CONTINUOUS CHANNEL DRAIN AROUND THE POOL PERIMETER LOCATED DIRECTLY BEHIND THE COPING STONE AS SHOWN ON THE DRAWINGS OF THE POOL DECK (PER VARIANCE ISSUED 6/6/05).

DECK SHALL BE COMPRESSED CONCRETE PAVERS PROX. 1" IN THICKNESS LAID OVER THE EXISTING CONCRETE PERIMETER DECKING. THE PATTERN OF THE PAVERS AS WELL AS THE COLORS WILL BE SELECTED BY THE ARCHITECT.

JOINTS WILL BE FITTED TO LESS THAN 1/8" SPACING AND THEN SANDED WITH BUILDER'S SAND.

THE PERIMETER COURSE OF PAVERS WILL BE SECURED IN PLACE BY A SOLDIER COURSE SECURED TO THE EXISTING SLAB WITH THINSET OR EQUAL BEDDING MATERIAL. FIELD PAVERS WILL BE LAID OVER A 1/2" THICK BEDDING OF BUILDER'S SAND.

#2. ALL DECKING SHALL BE SLIP RESISTANT AND NON ABSORBENT MATERIAL.

#3. THE MINIMUM VERTICAL CLEARANCE BETWEEN THE WATER SURFACE AND DECKS AND ANY OVERHEAD OBSTRUCTIONS IS 7 FEET.

#4. NO WOOD DECKING, WOOD EXPANSION JOINT OR CARPETING SHALL BE INSTALLED IN THE DECK AREA.

DECK SHOWER REQUIREMENTS

#1. A DECK SHOWER IS TO BE LOCATED WITHIN 20 FEET FROM THE WATERLINE EDGE OF THE MAIN POOL. WASTE SHALL BE TO DECK DRAINAGE.

#2. THE SHOWER PIPING SHALL BE SECURED TO A PERMANENT STRUCTURE OR COLUMN.

#3. THE SHOWER NOZZLE SHALL BE AS SPECIFIED BY THE ARCHITECT IN THE PLUMBING SECTION OF THE SPECIFICATIONS.

#4. A SUFFICIENT NUMBER OF HOSE BIBBS WITH VACUUM BREAKERS ARE REQUIRED SO THAT THE ALL PORTIONS OF THE POOL DECK MAY BE WASHED DOWN WITH A 100 FOOT HOSE. THEY MAY BE INCORPORATED WITH THE SHOWER COLUMN(S).

POOL SHELL

#1. THE WALLS OF THE POOL SHELL SHALL BE PNEUMATICALLY PLACED CONCRETE, MINIMUM DESIGN STRENGTH 4,000 PSI. (FLOORS ARE TO BE MONOLITHICALLY POURED CONCRETE OR DIVIDED BY LOAD TRANSFERRING ISOLATION JOINTS WITH DUMBBELL WATERSTOPS.) STEEL SCHEDULE AND SECTION PROFILE ARE TO BE AS SHOWN ON THE DRAWINGS.

#2. THE POOL WALLS SHALL ALL BE VERTICAL (PERPENDICULAR) FLOOR TO WALL RADIUS AT ALL POINTS AROUND THE POOL PERIMETER IS TO BE 0'.

#3. THE OVERFLOW GUTTER LIP SHALL BE UNIFORMLY LEVEL WITH A MAXIMUM TOLERANCE OF .25" BETWEEN THE HIGH AND THE LOW POINTS. THE GUTTER BOTTOM SHALL BE LEVEL. WATER SHALL BE DIRECTED TO THE GUTTER DRAINS BY HYDRAULIC PITCH.

#4. REFER TO THE POOL DRAWINGS AND SPECIFICATIONS FOR WALL, FLOOR AND GUTTER SURFACING MATERIALS.

#5. INSIDE AND OUTSIDE VERTICAL CORNERS SHALL HAVE A MINIMUM 2" RADIUS.

#6. MINIMUM POOL DEPTH SHALL BE 3 FEET. MAXIMUM DEPTH AT LEAST 4 FEET (ACTUAL DEPTH 7').

#7. THE GUTTER DRAIN FITTINGS SHALL BE PLACED AS INDICATED ON THE DRAWINGS, BUT SHALL NOT BE SPACED FURTHER THAN TEN FEET APART.

RESTROOM SIGNAGE REQUIREMENTS

#1. SEPARATE DIRECTIONAL SIGNS SHALL BE INSTALLED IN THE POOL AREA DIRECTING BATHERS TO THE RESTROOMS WHICH ARE LOCATED ON THE FLOOR BELOW DIRECTLY BENEATH THE POOL DECK. THESE MUST BE LEGIBLE FROM ALL PARTS OF THE POOL DECK.

LETTERING OF THE SIGN(S) SHALL BE BLACK, AT LEAST 4" HIGH AND ON A LIGHT BACKGROUND.

RESTROOM REQUIREMENTS RESTROOM FLOORS SHALL BE CONSTRUCTED OF CONCRETE WITH A SLIP RESISTANCE FINISH AND SHALL SLOPE TO FLOOR DRAINS. INTERSECTION AT THE WALL AND FLOOR MUST BE COVERED.

HOSE BIBBS WITH VACUUM BREAKERS MUST BE PROVIDED IN OR NEAR EACH RESTROOM.

POOL PIPING

#1. ALL PERIMETER PIPING SHALL BE CAST INTO THE CONCRETE POOL SHELL, SECURELY ATTACHED TO THE POOL STRUCTURE WITH CORROSION PROOF STRAPPING, OR PLACED ON DENSELY CONSOLIDATED SOIL.

#2. FLOOR INLETS SHALL BE PROVIDED AT THE RATE OF ONE INLET FOR EVERY 20 FEET OF PERIMETER. THEY SHALL BE NO MORE THAN 20 FEET APART AND OUTSIDE FLOOR INLETS SHALL NOT BE FURTHER THAN 10 FEET FROM WALLS.

MAXIMUM FLOW IS 15 GPM PER INLET FITTING.

#3. MAXIMUM VELOCITY THROUGH THE 2 7/8" X 6" GUTTER DRAIN GRATES AT 1.5 FPS IS 21.5 GPM PER FITTING.

#4. WALL MOUNTED VACUUM FITTINGS ARE TO BE MINIMUM 10 INCHES BELOW THE WATERLINE AND KEPT CLOSED WITH A SPRING LOADED COVER WHEN THE FITTING IS NOT IN USE.

POTABLE WATER SUPPLY AND WASTE WATER DISPOSITION SERVING THE POOL IS TO BE PROVIDED BY OTHERS AND IS NOT PART OF THE SCOPE OF WORK OF THE SWIMMING POOL CONTRACTOR. THIS INCLUDES THE POOL SIDE SHOWER(S) AND DECK AREA HOSE BIBBS BY OTHERS.

FRESH WATER TO THE POOL WILL BE SUPPLIED BY THE CITY OF TAMPA WATER DEPARTMENT.

WASTE WATER IS TO BE DISCHARGED INTO AN EXISTING 12" X 12" X 12" OPEN DRAINAGE TROUGH IN THE EQUIPMENT ROOM. ALL WASTE WATER DISCHARGING INTO THE TROUGH SHALL HAVE AN 4" ATMOSPHERIC GAP OF AT LEAST 4". WASTE WATER DISPOSITION IS TO CITY OF TAMPA STORM SEWER.

ALL HOSE BIBBS AROUND THE POOL DECK AND IN THE EQUIPMENT ROOM WILL BE EQUIPPED WITH VACUUM BREAKERS.

AREA LIGHTING ALL AREAS OF THE POOL DECK AND POOL SURFACES ARE TO BE ILLUMINATED TO 15 FOOT CANDLES IF NIGHT SWIMMING IS TO BE ALLOWED AND THIS MUST BE CERTIFIED BY THE ELECTRICIAN OF RECORD OR AN ELECTRICAL ENGINEER.

FENCING

SPLASH PAD WILL BE ISOLATED FROM THE SWIMMING POOL BY AN EXISTING CONCRETE BALUSTRADE WITH VERTICAL RICKETS.

CHEMICAL STORAGE

WILL BE SEPARATE FROM, BUT ADJACENT TO THE EQUIPMENT ROOM. IT MUST BE SECURE, SAFE FROM PUBLIC ACCESS AND DRY.

POOL GRAPHICS

DEPTH MARKERS ARE TO BE PLACED AS SHOWN ON THE DRAWINGS AND SHALL CONSIST OF PRECAST CONCRETE MONUMENTS 6 1/2" X 27" X 6 1/2" WITH CERAMIC TILE DEPTH MARKER REBATED INTO THE MONUMENTS AS SHOWN IN THE DRAWINGS. (PER VARIANCE DATED 6/6/05)

THEY SHALL BE LOCATED A MAXIMUM OF 25 FEET APART. EACH MONUMENT SHALL HAVE AN INTERNATIONAL "NO DIVING" SYMBOL TILE REBATED IN EACH END OF THE MONUMENT.

CHARACTERS ON THE TILE MARKERS SHALL BE A MINIMUM OF 4 INCHES HIGH.

CERAMIC TILES ARE REQUIRED, NO PAINTING OF CHARACTERS FOR DEPTH MARKINGS IS ALLOWED. MARKINGS WILL BE IN FEET AND METERS.

ABBREVIATIONS FOR "FEET", "INCHES" AND "METERS" WILL BE "FT.", "IN" AND "M" RESPECTIVELY.

SIGNS STATING "NO DIVING" IN LETTERS AT LEAST 4" HIGH MUST BE POSTED AT THE POOL RULE SIGN LOCATION SO AS TO BE CLEARLY VISIBLE TO BATHERS USING THE POOLS.

ALL DEPTH MARKINGS SHALL BE LOCATED TO ACCURATELY DEPICT THE ACTUAL WATER DEPTH WITHIN 3 INCHES WHEN MEASURED THREE FEET FROM THE VERTICAL WALL DEPTH MARKINGS.

HANDRAILS AND STEPS

#1. THE HANDRAIL SHALL BE ANCHORED ON THE DECK AND THE BOTTOM STEP. IT SHALL EXTEND A MINIMUM 28" ABOVE THE DECK AND STEP NOBINGS. HANDRAIL SHALL BE FABRICATED OF 1 1/2" O.D. STAINLESS STEEL AND MOUNTED IN BRASS COMPRESSION ANCHORS AT EACH END.

#2. A DARK, CONTRASTING BULLNOSE #4200 IS REQUIRED AT THE NOBING INTERSECTIONS OF EACH TREAD AND RISER. THESE TILES SHALL HAVE A VERTICAL HEIGHT OF 2" AND .75" WIDTH ON THE HORIZONTAL TREAD SURFACE FOR VISIBILITY.

#3. THE MAXIMUM RISER ALLOWED IS 10 INCHES. THE RISERS SHALL BE UNIFORMLY EQUAL AND DIMENSIONED AS INDICATED. THE MINIMUM TREAD LENGTH IS 24" AND DIMENSIONED AS INDICATED. ALL STEP TREADS SHALL BE SLIP RESISTANT.

LADDER/RAIL REQUIREMENTS

#1. ONLY CROSS-BRACED LADDERS ARE PERMISSIBLE. EACH LADDER SHALL EXTEND A MINIMUM 28 INCHES ABOVE THE DECK ELEVATION. THE MAXIMUM DISTANCE BETWEEN THE POOL WALL AND THE LADDER SHALL BE 6 INCHES. THE MINIMUM DISTANCE SHALL BE 3 INCHES.

THE LADDERS SHALL BE CONSTRUCTED OF STAINLESS STEEL. EACH LADDER TREAD SHALL BE SLIP RESISTANT.

EACH LADDER AND RAIL MUST BE SECURED TO THE DECKING USING COMPRESSION DECK ANCHORS WITH STAINLESS STEEL ESCUTCHEON PLATES.

FILTER NOTES

#1. THE SWIMMING POOL FILTER SHALL BE AS PRESENTLY EXISTING. A VACUUM SAND SYSTEM DIVIDED INTO FOUR SEPARATE CHAMBERS FOR BACKWASHING AT PROPER FLOW. (PER VARIANCE DATED 6/6/05)

THE VACUUM SAND SYSTEM WILL BE DESIGNED SO AS TO MEET THE REQUIREMENTS OF HIGH RATE SAND FILTER SYSTEMS WITH GAUGES, FLOW METER, SIGHT GLASS AND VALVING FOR OPERATING THE FILTER IN ALL OF THE FOLLOWING MODES:

- FILTER VACUUM TO WASTE (SPLASH PAD WILL VACUUM C.T. TANK VACUUM TO FILTER (N/A SPLASH PAD SYSTEM) DRAIN THE POOL (N/A SPLASH PAD SYSTEM) BACKWASH FILTERS INDIVIDUALLY (SPLASH PAD 1 TANK)

#2. OTHER FILTERS AND FILTER EQUIPMENT MUST BE NSF APPROVED. THE PRESSURE SAND FILTER ON THE SPLASH PAD CT TANK SHALL HAVE AN AIR RELIEF VALVE. A SIGHT GLASS IN THE BACKWASH LINE, VACUUM AND PRESSURE GAUGES AND AN AIR RELIEF DEVICE.

THE HRS FILTER SHALL BE CAPABLE OF PERFORMING IN THE FOLLOWING MODES:

- FILTER CT TANK WATER VACUUM CT TANK TO FILTER VACUUM TO WASTE DRAIN FILTER TANK

#2. ALL PIPING WILL BE SCHEDULE 40 (OR #80) AND SHALL CARRY A NSF APPROVAL AND BE CONTINUOUSLY MARKED (NSF-PW).

MAXIMUM VELOCITY IN PRESSURE PIPING, 8 FPS. . . IN SUCTION PIPING 6 FPS. . . AND IN GRAVITY PIPING 3 FPS.

#3. CIRCULATING PUMPS WILL BE FLOODED SUCTION STYLE DESIGNED TO DELIVER RATED FLOW AT 50 FT TDH FOR THE VACUUM SAND SYSTEM AND 80 FT FOR THE PRESSURE SAND SYSTEM.

VACUUM PUMP WILL BE SIZED TO DELIVER 45 GPM AT 60 FT. OF HEAD. EACH PUMP SHALL HAVE A MIN. 8" H & L STRAINER. THE VACUUM PUMP OF THE SPLASH PAD SYSTEM SHALL ALSO SERVE TO DRAIN THE CT TANK.

#4. HYPOCHLORITE FEEDING ON POOL AND SPLASH PAD WILL BE BY VENTURI TYPE FEEDER KNOWN AS "THE SOLUTION." SODIUM HYPOCHLORITE WILL BE DRAWN FROM 55 GALLON CHLORINE SHIPPING CONTAINERS. SEE TECH SHEETS.

PH CONTROL ON THE SWIMMING POOL AND THE SPLASH PAD WILL BE BY STRANTRON CO2 FEEDERS.

BOTH POOLS WILL BE EQUIPPED WITH STRANTRON SYSTEM 3 CONTROLLERS. SEE TECH SHEETS ATTACHED.

#5. SWIMMING POOL PIPING WILL BE ARRANGED SO THAT 100 PERCENT OF RATED FLOW CAN BE ACCOMMODATED THROUGH THE GUTTER SYSTEM AS WELL AS THE MAIN DRAINS.

#6. EACH SYSTEM WILL BE EQUIPPED WITH FLOW METERS ON THE RETURN LINE SIZED TO READ 100 PERCENT OF THE DESIGN FLOW AND INSTALLED TO MATCH THE PIPE ON WHICH THEY ARE MOUNTED. INSTALL PER MFGR SPECIFICATIONS.

#7. VENTILATION OF THE EQUIPMENT ROOM IS BY TWO WALL LOUVER.

#8. CIRCULATING PUMP ON THE SPLASH PAD CT TANKS SHALL BE EQUIPPED WITH A 8" HAIR AND LINT STRAINER.

#9. SAND FILTER TANKS WILL HAVE 2" COVE AT THE INTERSECTION OF THE WALLS AND FLOOR AND THE FLOOR OF THE TANKS SHALL SLOPE TO THE TANK DRAINS.

#10. ELECTRICAL CHEMICAL FEEDERS SHALL HAVE AN ELECTRICAL INTERLOCK WITH THE FILTER PUMP. CHEMICAL FEED LINES SHALL BE ENCASED IN PVC RIGID CONDUIT PERMANENTLY SECURED IN PLACE.

#11. ALL VALVES WILL BE PERMANENTLY TAGGED OR MARKED WITH BRADY LABELS. PIPING WILL BE IDENTIFIED WITH PERMANENT MARKINGS.

#12. EQUIPMENT AREA WILL BE EQUIPPED WITH A TAYLOR #2006 TEST KIT FOR TESTING FOR FAC, TAG, PH, TA, CH, CYA.

#13. OPERATING INSTRUCTIONS WILL BE MOUNTED IN CLEAR PROTECTIVE COVER AND POSTED IN THE EQUIPMENT ROOM OR ENCLOSURE.

#14. THE EQUIPMENT ROOM ENCLOSURE SHALL BE LOCKABLE. EQUIPMENT ROOM FLOOR SLOPE TO A CONTINUOUS DRAINAGE CHANNEL.

THE EQUIPMENT ROOM MUST BE PROVIDED WITH A HOSE BIBB, VACUUM BREAKER, 7 FEET OF HEADROOM AND ILLUMINATED TO 50 FOOT CANDLES. THE EQUIPMENT ROOM SHALL HAVE FORCED DRAFT OR CROSS VENTILATION. ALL WIRING INSIDE THE POOL EQUIPMENT AREA ROOM OR ENCLOSURE SHALL BE ENCASED IN APPROVED PVC CONDUIT.

ACCESS TO THE EQUIPMENT ROOM SHALL BE THROUGH AN OPENING AT LEAST 3' WIDE AND 6' HIGH.

#15. DRY, SECURE, CHEMICAL STORAGE MUST BE PROVIDED OUTSIDE THE EQUIPMENT ROOM.

TIME CLOCKS THE FILTER SYSTEMS ARE TO BE OPERATED 24/7 (CONTINUOUSLY), HOWEVER EACH SYSTEM WILL BE EQUIPPED WITH A TIME CLOCK SO THAT SHOULD THE OWNER CHOOSE, FILTERING CAN COMMENCE 3 HRS. BEFORE THE POOLS ARE OPEN AND RUN CONTINUOUSLY UNTIL 3 HRS. AFTER THE POOLS ARE CLOSED.

PLUMBING NOTES

#1. ALL VALVES SHALL BE PROPORTIONAL EXCEPT HEATER ISOLATION VALVES.

#2. GAUGES SHALL HAVE FACE DIAMETER OF AT LEAST 2". PRESSURE GAUGES SHALL PREFERABLY READ 0 TO 30 POUNDS, BUT SHALL NOT EXCEED 0 TO 60 POUNDS. VACUUM GAUGES SHALL READ 0 TO 30 INCHES OF MERCURY.

#3. ANY PVC PIPING EXPOSED TO SUNLIGHT AND UV RAYS SHALL BE PROTECTED FROM DEGRADATION BY APPLYING AN ULTRA VIOLET RESISTANT COATING.

#5. AN AUTOMATIC WATER MAKE-UP DEVICE MUST BE INSTALLED IN EITHER THE CT TANK OR THE SWIMMING POOL WITH A SOLID STATE FLOAT SWITCH, OR A 2" STATIC PIPE FROM THE POOL WALL (12" DEEP MINIMUM) TO A SEPARATE WATER CHAMBER AT THE FILTER TANK EQUIPPED WITH AN ELECTRONICALLY CONTROLLED MAKE-UP DEVICE. THE POOL AND THE SPLASH PAD SHALL EACH HAVE MANUAL MAKE-UP WATER CAPABILITY.

#6. HYPOCHLORINATION MATERIAL (SODIUM HYPOCHLORITE) MAY BE PUMPED DIRECTLY FROM THE SHIPPING CONTAINERS PROVIDED THEY ARE CLEARLY MARKED WITH CONTENT AND CAPACITY IN GALLONS. FEEDING EQUIPMENT MUST BE CAPABLE OF DISCHARGING 9X PPM CHLORINE IN THE RETURN PIPING.

ELECTRICAL NOTES

ELECTRICAL WORK IS NOT INCLUDED IN THE SCOPE OF WORK OF THE SWIMMING POOL CONTRACTOR.

ELECTRICAL EQUIPMENT TO BE SUPPLIED BY THE POOL BUILDER AS SHOWN ON THE POOL EQUIPMENT LISTS. OTHER ELECTRICAL PARAPHERNALIA IS TO BE PROVIDED BY OTHERS. THIS INCLUDES STARTERS, DISCONNECTS, SWITCHING, WIRING OF ALL ELECTRIC MOTORS AND OTHER EQUIPMENT.

A #8 SOLID COPPER BONDING GRID LOOP SHALL RUN COMPLETELY AROUND THE POOLS WHICH SHALL BE BONDED AT NO LESS THAN TWO OPPOSITE CORNERS (EACH POOL). BONDING GRIDS WILL INCLUDE ALL FIXED METAL PARTS WITHIN FIVE FEET OF THE INSIDE OF THE POOLS INCLUDING FIXTURES, LADDERS, HANDRAILS, STARTING BLOCK ANCHORS, LIFEGUARD CHAIRS AND OTHER METALLIC COMPONENTS AND THE PUMP MOTORS.

AT LEAST ONE 115 V GFI PROTECTED RECEPTACLE SHALL BE LOCATED MORE THAN 10 FEET BUT LESS THAN 15 FEET FROM POOL.

POOL FILTERING EQUIPMENT SHALL BE GROUNDED TO THE GROUND BUBB OF THE POOL DISTRIBUTION PANEL WITH #8 SOLID CONDUCTOR AS REQUIRED BY NEC.

THERE SHALL BE NO POWER LINES WITHIN TEN FEET HORIZONTALLY OF THE WATERLINE OF ANY OF THE POOLS.

ALL MOTORS SHALL HAVE INTEGRAL THERMAL PROTECTION.

ALL ELECTRICAL EQUIPMENT SHALL BE UL LISTED. ALL ELECTRICAL WORK SHALL CONFORM TO NEC ARTICLE 680 AND ALL APPLICABLE LOCAL CODES.

ALL WIRING SHALL BE COPPER WITH TYPE THW INSULATION. MINIMUM WIRE SIZE SHALL BE #12 AWG.

POOL RULE SIGNS POOL RULE SIGNS MUST BE POSTED SO AS TO BE VISIBLE TO BATHERS FROM ALL PARTS OF THE POOL DECK. A SPECIMEN SIGN IS SHOWN BELOW.

POOL RULES

NO DIVING IN THIS POOL
NO FOOD, DRINK GLASS OR ANIMALS IN THE POOLS OR POOL AREAS
BATHING LOAD - 161 PERSONS
POOL HOURS ____ A.M. TO ____ P.M.
SHOWER BEFORE ENTERING THE POOLS
NO LIFEGUARD ON DUTY

THE WORDS "POOL RULES" AND "NO DIVING" MUST BE IN CHARACTERS AT LEAST FOUR INCHES HIGH. BALANCE OF THE LETTERS MUST BE IN LETTERS AT LEAST ONE INCH HIGH. DIRECTIONAL SIGNS TO THE RESTROOMS MUST BE VISIBLE FROM ALL AREAS OF THE DECK.

NO FOOD IS TO BE CONSUMED IN THE POOL DECK AREA. NO FOOD SERVICE IS TO BE PROVIDED CLOSER THAN 12 FEET FROM THE WATER'S EDGE.

FIRST AID EQUIPMENT MUST BE STORED NEARBY AND READILY AVAILABLE TO BATHERS WHEN THE POOL IS IN USE.

CUSCADEN POOL RENOVATION

CITY OF TAMPA
306 East Jackson Street
Tampa, Florida 33602

ROWE ARCHITECTS
Fax: 813/221-9154
Ph: 813/221-8771

Swimming Pool Plan Review
Silcox Engineering, Inc.
Ernest Silcox
98 8161

Silcox Engineering, Inc. Civil Engineering
ERNEST S. SILCOX, P.E., #0008161
Post Office Box 2374
Tampa, FL 33674 813/920-9192

REVISED PER HILLSBOROUGH COUNTY DEPARTMENT OF HEALTH NOV. 5, 2004

RECORD DWG.
DATE 8/2/05

APPROVED
HILLSBOROUGH COUNTY HEALTH DEPARTMENT
DATE 11/19/05 PERMIT NO. 29-60-384
ENGINEER: [Signature]
NOTE: THIS APPROVAL IS NOT INTENDED TO COVER STRUCTURAL DESIGN.

NOV 19 2004

RECEIVED
JAN 06 2005
COUNTY TECH. GROUP, INC.

SYSTEM OPERATION POOL

THE POOL IS DESIGNED WITH USE OF THE EXISTING VACUUM SAND AND GRAVEL FILTER SYSTEM. WATER IS SUPPLIED TO THE FILTER BY GRAVITY. THE FILTER CONSISTS OF FOUR INDEPENDENT TANKS, FED WITH A COMMON TROUGH SET ABOVE THE SAND-BEDS. THE TROUGH ALSO ACTS AS THE WASTE ACCUMULATOR DURING BACKWASH OPERATION. ALL WATER ENTERS THE FILTERS THROUGH THE TROUGH AND IS DRAWN AT THE BASE OF THE TANKS THROUGH INDIVIDUAL PORTS, TIED TO A COMMON 8" SUCTION LINE. THE WATER IS CHEMICALLY TREATED AND RETURNED TO THE POOL.

MAIN DRAIN DESIGN THE MAIN DRAINS ARE LOCATED AT THE DEEPEST POINT IN THE POOL. COLLECTION UTILIZES THREE 12" X 12" X 12" FIBERGLASS MAIN DRAIN BOXES. EACH BOX IS EQUIPPED WITH A 12" X 12" MOLDED FRAME AND GRATE WITH A TYPICAL OPEN SURFACE AREA OF 85.6 S.F. WHICH WILL ALLOW RATED FLOW AT A VELOCITY WHICH DOES NOT EXCEED .8FFS. EACH BOX IS CONNECTED TO A COMMON 12" LINE THAT IS INSTALLED ALONG THE LONG AXIS OF THE POOL AND ENTERS THE EQUIPMENT ROOM JUST ABOVE FLOOR LEVEL. THE 12" LINE TIES TO ALLOW DIRECT SUCTION FOR BACKWASH AND CONTINUES TO A MODULATING VALVE FOR FLOW CONTROL. FOR DESIRED FLOW VERSUS THE GUTTER LINE. (40/60) THE 12" LINE THEN ENTERS THE FILTER TROUGH.

GUTTER DESIGN CONSISTS OF 36 EACH 2 1/2" X 6" DRAINS, SPACED EVENLY AROUND THE POOL PERIMETER PROX. 8" APART. THE POOL WATER, OVERFLOWING THE GUTTER AREA IS DIRECTED TO THE DRAINS, TIED TO FOUR SEPARATE 6" GUTTER LINES. THE TWO PRIMARY 6" LINES, 255 GPM EACH, ARE SET IN THE HEADPIECE WITH THE GUTTER DROPS TYING INTO THE 6" LINES DIRECTLY BELOW. THE TWO PRIMARY LINES TURN OUT OF THE HEADPIECE ON THE NORTH AND SOUTH SIDE OF THE POOL AFTER ACCUMULATING 255 GPM EACH AND CONTINUE TO THE EQUIPMENT AREA OUTSIDE THE POOL WALL. IN A SOFFIT DESIGNED FOR THIS PURPOSE. THE SOUTH LINE PENETRATES THE FILTER WALL AND PASSES THROUGH THE FILTER EXITING INTO THE EQUIPMENT AREA. THE TWO SECONDARY 6" LINES, 172 GPM EACH, CONTINUE IN THE HEADPIECE, TIE TOGETHER IN THE HEADPIECE AND EXIT THE HEADPIECE IN THE EQUIPMENT ROOM. AT THE CEILING ELEVATION, THE FOUR GUTTER LINES JOIN IN A MANIFOLD, PASS THROUGH A 12" MODULATING VALVE THEN ENTER THE FILTER AND DISCHARGE INTO THE 1-4" X 12" DISTRIBUTION TROUGH WHICH RUNS FULL LENGTH OF THE FILTER TANK.

MODULATING VALVES ARE DIAPHRAGM VALVE OPERATED, CONTROLLED BY POTABLE WATER LINE PRESSURE REGULATED BY BALL FLOAT VALVES MOUNTED IN THE FILTER TANK. THESE ARE SPECIAL VALVE COMBINATIONS THAT ALLOW FLOW CONTROL ON FILTER TANK RISE AND POSITIVE SHUTOFF AS THE WATER REACHES A POINT 10", PLUS OR MINUS, FROM THE TOP OF THE FILTER TANK. THIS CONTROL PROCEDURE IS REQUIRED BECAUSE THE POOL WATER LINE (LIP OF THE GUTTER) IS SET AT 2.5' ABOVE THE EXISTING TANK CEILING. THE ANTICIPATED NORMAL TANK LEVEL DURING FILTER OPERATION IS AT 2' BELOW FILTER TANK CEILING.

CIRCULATING SYSTEM THE CIRCULATION PUMP IS A 15 HP MARLOW HANDLING 900 GPM AT 80 HDP. THE PUMP PULLS WATER OUT OF THE INDIVIDUAL FILTER TANKS THROUGH A COMMON 8" MANIFOLD, AND 1 1/2" LATERAL 25' TO EACH TANK. A 4" VACUUM GAUGE IN THIS SUCTION LINE IS INSTALLED TO MONITOR THE FILTER CONDITION. THE WATER IS THEN DIRECTED TO THE RETURN VALVE. (IN BACKWASH CYCLE, POOL WATER WILL BE DRAWN THROUGH THE MAIN DRAINS AND INTRODUCED INTO THE BOTTOM HEADERS AND LATERALS.)

THE LINE IS VALVED TO DIVERT A PORTION OF THE RETURN WATER INTO A 4" HEATER LOOP (FUTURE USE) AND HAS MOUNTED IN IT THE FLOW METER, PRESSURE AND TEMPERATURE GAUGES AND CHEMICAL INJECTION PORTS.

FILTERED WATER IS MONITORED FOR PH AND CHLORINE RESIDUALS WITH A STRANTRON SYSTEM 3" CONTROLLER. AND THE CHEMICAL TREATMENT IS BY SODIUM HYPOCHLORITE FEEDER, VENTURI STYLE, AND A CO2 GAS FEEDER IS SPECIFIED FOR PH CONTROL. FILTERED WATER IS PIPED THROUGH A 1.25" LINE WHICH SUPPLIES THE VENTURI HYPOCHLORITE FEEDER AND SAMPLE WATER TO THE CONTROLLER. AFTER CHLORINATION, THIS 1.25" LINE CONNECTS TO THE 8" RETURN LINE JUST PRIOR TO THE POOL WALL PENETRATION. CO2 IS THE LAST INJECTION POINT IN THE LINE.

BACKWASH WATER IS A 10" LINE CONNECTED TO THE FILTER TROUGH VIA THE COMMON 12" FILTER SUPPLY MANIFOLD. THE BACKWASH WATER LINE IS VALVED AND IS CONNECTED TO AN EXISTING OPEN 12" WASTE LINE AT THE FLOOR LEVEL. (THIS WASTE DEPOSITORY IS A 12" X 12" CONCRETE TROUGH WHICH RUNS THE FULL LENGTH OF THE FILTER WALLS AND TERMINATES IN A 12" LINE TO WASTE.)

VACUUM SYSTEM CONSISTS OF A 2HP PUMP CONNECTED TO A 3" LINE AND THEN TO 6" VACUUM FITTINGS LOCATED IN THE POOL WALL. THE VACUUM EFFLUENT IS VALVED TO BOTH THE FILTER TANK AND TO THE OPEN WASTE TROUGH.

MAKE-UP WATER IS INTRODUCED TO THE POOL AT THE DECK LEVEL TO ACHIEVE THE REQUIRED AIR GAP. THE SYSTEM IS A 1" POTABLE WATER LINE CONTROLLED BY A 1" HYDRAULICALLY OPERATED VALVE, WITH A PILOT DUTY VALVE SET IN A DECK MOUNTED BOX IN THE ENTRY LANDING TO THE POOL.

SYSTEMS OPERATION SPLASH PAD

THE TWO INDIVIDUAL COLLECTOR TANKS WILL BE CONNECTED TOGETHER WITH 12" PVC THIMBLES AND THEY ARE TO BE LOCATED ALONG WITH THE FILTERING EQUIPMENT AT GROUND LEVEL DIRECTLY BELOW THE SPLASH PAD.

THEY ARE 4'-10" X 5'-11" X 4'-7" DEEP AND HAVE A 1000 GALLON CAPACITY EACH. THE TANKS ARE TIED TOGETHER WITH ONE 12" PVC PIPE AT THE FLOOR OF THE TANKS.

THE DEMAND OF THE ACTIVITIES WATER FEATURES IS PROX. 1,000 GPM. THE SPLASH PAD IS DESIGNED TO DRAIN DRY EXCEPT WHEN THE WATER FEATURES ARE IN OPERATION. WHEN FEATURES ARE FLOWING WATER, THE WATER DRAINS IMMEDIATELY INTO THE TWO 24" X 24" GRATED DRAINS AT THE CENTER OF THE SPLASH PAD.

FROM THERE THE FEATURES WATER DROPS DIRECTLY INTO THE TWO 1,000 GALLON COLLECTOR TANKS BELOW (CONTACT TIME TANK) WHERE IT IS FILTERED, TREATED AND CHLORINATED.

WATER IS DRAWN FROM THE COLLECTOR TANKS BY TWO 15 HP PUMPS AND SUPPLIED TO THE FEATURES THROUGH TWO MANIFOLDS OF RETURN VALVES WHICH CONTROL THE WATER FLOW TO EACH OF THE 17 SEPARATELY VALVED WATER FEATURES.

THE WATER FOR THE ACTIVITIES FEATURES STORED IN THE 2,000 GALLON COLLECTOR TANK IS FILTERED AND CHEMICALLY TREATED BY A 30 SQ. IN. HI-RATE SAND FILTER (FILTER AREA 4.9 SQ. FT.) THE FILTER WILL ACCEPT 73.5 GPM, HOWEVER, THE TURNOVER RATE WILL BE REDUCED TO 67 GPM WHICH WILL DELIVER A 30 MINUTE TURNOVER FOR THE COLLECTOR TANKS. BY REDUCING THE FLOW THROUGH THE FILTER TO 67 GPM AN EXTENDED CYCLE WILL BE ACHIEVED.

THE CIRCULATING PUMP WILL DRAW WATER FROM THE TWO SIDE PORTED MAIN DRAINS IN THE COLLECTOR TANK AS WELL AS THE TWO FLOATING SKIMMERS, ONE IN EACH TANK. CIRCULATED WATER WILL BE RETURNED TO THE TANKS AFTER PASSING THROUGH THE FILTER, THE HYPOCHLORINATION TREATMENT AND THE FOUR WALL RETURN INLETS IN THE COLLECTOR TANKS.

THE CIRCULATING PUMP TOGETHER WITH TWO TANK DRAINS AT FLOOR LEVEL WILL ALSO SERVE AS AN "EMERGENCY DRAIN" SYSTEM IN THE EVENT THE COLLECTOR TANK MUST BE DRAINED AND CLEANED. IN SUCH CASE, THE ENTIRE CONTENTS OF THE FEATURE SYSTEM WILL BE DRAINED AND PUMPED TO THE SEWER.

CHEMICAL CONTROL IS BY SYSTEM 3 STRANTRON CHLORINATING EQUIPMENT.

HYPOCHLORINATION WILL BE BY SODIUM HYPOCHLORITE, PH CONTROL WILL BE BY CO2 GAS.

THE TWELVE UP-JETS ARE DESIGNED SO THAT EACH JET IS INDEPENDENTLY OPENED WITH AN ELECTRIC SOLENOID VALVE. THE PROGRAMMING DEVICE WILL RANDOMLY OPEN EIGHT UP-JETS SIMULTANEOUSLY SO THAT THE BATHERS WILL BE ABLE TO PREDICT WHERE THE NEXT UP-JET ACTION WILL OCCUR.

THE TWELVE UP-JETS ALONG WITH THE THREE UMBRELLAS, THE ARCH JET AND THE WATER CURTAIN ARE ALL EQUIPPED WITH PROPORTIONING VALVES IN THEIR SUPPLY LINE. THIS WILL ENABLE EACH OF THE WATER FEATURES TO DELIVER A CONSTANT FLOW OF WATER AT THE RATED GPM.

THE FLOOR OF THE SPLASH PAD WILL BE FINISHED WITH A PRODUCT KNOWN AS **PERBLEN** WHICH IS AN ASSORTMENT OF SMALL 1/4" DOWN ROUND GRAVEL WHICH ARE LOCKED IN WITH A WHITE CEMENT/WHITE MARBLE MATRIX SIMILAR TO POOL PLASTER. THIS WILL PRODUCE A NEARLY SLIP-PROOF FINISH AND THE PERBLEN WILL BE APPLIED IN A PATTERN USING THREE OR FOUR DIFFERENT COLORS OF AGGREGATE. THE MULTI-COLORED PATTERN IS SHOWN IN THE ARCHITECTURAL SECTION.

THE SPLASH PAD WILL BE SURROUNDED BY AND ISOLATED FROM THE POOL BY THE EXISTING BALUSTRADE RAILING

SPLASH PAD EQUIPMENT LIST

QTY	DESCRIPTION	MFG.	PART #
4	24" X 24" MAIN DRAIN RINGS AND GRATES	GRATE TECH	
1	WATER FEATURES ASSEMBLIES	VAKPAK	
	TEECUP		TC2400
	SMALL UMBRELLA		UM6800
	UMBRELLA		UM8400
	WATER CURTAIN		WC6
	ARCH JET		AJ6
12	UP-JETS - VARIABLE ORIFICE EYEBALL FTNG	RECREONICS	34-116
12	1 1/2" JANDY PROPORTIONING VALVES FOR ABOVE	JANDY	4724
12	1 1/2" INLINE SOLENOID VALVES	RITE-FLO	200-01-06
1	ELECTRONIC PROGRAMMER FOR 12 UP-JETS	CRYSTAL FOUNTAINS SPECIAL	
2	6" PVC BUTTERFLY VALVES	RECREONICS	32-057.06
3	4" PVC BUTTERFLY VALVES	RECREONICS	32-037.04
1	3" PVC BUTTERFLY VALVE	RECREONICS	32-037.03
2	10" PVC BUTTERFLY VALVE GEAR OPERATED	RECREONICS	32-254
3	2" JANDY	RECREONICS	4724
2	FIBERGLASS COLLECTOR TANK	VAK PAK	CT1000
2	FLOATING SURFACE SKIMMERS (1 1/2" LILLYPAD TYPE WITH 3" FLEXIBLE UMBILICAL HOSE)	WIZARD (VAKPAK)	SPECIAL
4	INLETS FOR FIBERGLASS COLLECTOR TANK	RECREONICS	34-015
1	VACUUM FITTING W/SPRING LOADED COVER	RECREONICS	34-015
2	8" X 8" COMMERCIAL MAIN DRAIN WITH ABS POT	HAYWARD	9P1082
2	FEATURES PUMPS - 15 HP	GRISWOLD	R0FL15T
1	10" X 6" S.S. H & L STRAINERS	LINCOLN	14-550
1	2 HP WHISPER FLOW RECIRCULATING PUMP		
	208/230 VOLT	PENTAIR	01514
1	30" HI-RATE SAND FILTER (N8F) 4.9 SQ.FT.	PENTAIR	146010
1	2 1/2" DIAL VALVE FOR ABOVE	PENTAIR	261-050
3	4" PRESSURE GAUGES	RECREONICS	32-816
3	4" VACUUM GAUGES	RECREONICS	32-826
1	FLOWMETER FOR 3" PIPE (FILTER)	RECREONICS	32-074
1	FLOWMETER FOR 8" PIPE (FEATURE SYSTEM)	RECREONICS	32-345
1	STRANTRON SYSTEM 3 CONTROLLERS	STRANTRON	CA9Y9-3
1	SODIUM HYPOCHLORITE VENTURI FEEDER	CES	BX22152-01
1	CO2 FEEDER AND REGULATOR	STRANTRON	BG002-3
1	WATER LEVEL CONTROL, 110V SOLID STATE, 5J FLOAT SWITCH	RITE-FLO	1588U
1	3/4" ELECTRIC SOLENOID VALVE, 110V	RITE-FLO	RICHDELL

AND OTHER MISCELLANEOUS EQUIPMENT NOT LISTED ABOVE NECESSARY TO COMPLETE A WORKABLE INSTALLATION.

WHERE SPECIFICS SUPPLIERS ARE LISTED "OR EQUAL" SUBSTITUTION IS INFERRED IF APPROVED BY THE OWNER BEFORE CONSTRUCTION.

SODIUM HYPOCHLORITE STORAGE WILL BE IN 55 GALLON DELIVERY DRUMS

SPLASH PAD DATA

PERIMETER	PROX. 137'
SURFACE AREA	PROX. 705 SQ. FT.
COLLECTOR TANK CAPACITIES 2 @ 1000	2,000 GALS.
TURNOVER RATE	67 GPM
TURNOVER TIME	30 MIN.
FILTER	30" HI-RATE SAND
FILTER RATE	13.7 GPM PER SQ.FT. FLT. AREA
CIRCULATING PUMP	2HP
HYPOCHLORINATION	STRANTRON SYSTEM 3
PH CONTROL	CO2

FEATURE WATER TURNOVER 1065 GPM

POOL DATA

BATHING LOAD	161
PERIMETER	PROX. 325 L/F
SURFACE AREA	7800 SQ. FT.
DEPTH	3 FT TO 7 FT.
VOLUME	38,870 CF
GALLONAGE	291,500
TURNOVER RATE	808 GPM
TURNOVER TIME	6 HRS.
FILTER	EXISTING VACUUM SAND
FILTER AREA	216 SQ. FT.
FILTER RATE	3.75 GPM PER SQ.FT. FILTER AREA
360° FLOOR INLETS	54 @ 14.9 GPM
2 7/8" X 6" GUTTER DRAINS	38 @ 21.3 GPM
MAIN DRAINS	3 @ 270 GPM
MAIN DRAIN GRATE VELOCITY	1.02 FPS
VACUUM FITTINGS	6 EA.

EQUIPMENT LIST FOR POOL MODIFICATION

QUANTITY	ITEM & DESCRIPTION	MFG.	PART #
54	1 1/2" FLOOR INLETS	HAYWARD	9P14258
38	2 1/2" X 6" GUTTER FITTINGS	PENTAIR	842038
1	1 1/2" WALL VACUUM FITTINGS		
	W/SPRING LOADED COVER	HAYWARD	9P1022
3	12" X 12" X 12" MAIN DRAIN BOXES	PENTAIR	845026
1	EXISTING VACUUM SAND FILTER IS TO BE RENOVATED AND REMAIN IN SERVICE. SEE DRAWING		
1	24" VERTICAL LEXAN 9ITE GLASS EXTERNALLY MOUNTED ON FILTER WALLS. TO BE JOB FABRICATED.		
1	15 HP 1750 RPM 208/230 V, 6" X 5"	MARLOW	5L19C
1	2 HP VACUUM PUMP	PENTAIR	01514
1	HORIZONTAL MOUNTED FLOWMETER 10" PIPE	RECREONICS	32-346
1	INLINE THERMOMETER 5 1/2" STEM	RECREONICS	32-700
1	4" PRESSURE GAUGE 0 - 60#	RECREONICS	32-816
1	4" VACUUM GAUGE 0 - 30#	RECREONICS	32-826
2	12" MODULATING VALVE	RECREONICS	32-046
1	1/2" FLOAT CONTROL	RECREONICS	32-001
1	1" HYDRAULIC WATER MAKE-UP VALVE	LINCOLN	20-010
1	8" X 6" S.S. H & L STRAINERS	LINCOLN	14-545
1	6" BUTTERFLY VALVES (LEVER)	RECREONICS	32-037.06
1	8" BUTTERFLY VALVES (GEAR)	RECREONICS	32-254
1	10" BUTTERFLY VALVES (GEAR)	RECREONICS	32-255
1	12" BUTTERFLY VALVES (GEAR)	RECREONICS	32-255
1	SYSTEM 3 CONTROLLER	STRANTRON	CA9Y9-3
1	SODIUM HYPOCHLORITE VENTURI FEEDER	CES	BX22152-01
1	CO2 FEEDER AND REGULATOR	STRANTRON	BG002-3
6	3 TREAD CROSS BRACED S.S. LADDER, 30" THROAT	S.R. SMITH	LFB-30-35
1	60" HANDRAIL MIN. ABOVE STEP 28"	PARAGON	34202
14	1.8" BRASS DECK ANCHORS	ATLANTIS	5786
14	8.5" DEEP ROUND ESCUTCHEON	FROST	A41664-1
(AS NEEDED - ATLANTIS DECK ANCHORS AND FROST ESCUTCHEONS FOR SPECIAL 1.8" O.D. RAILS ON ENTRY RAMP AND DECK BARRIERS AT ENTRY RAMP. SEE ARCHITECTURAL DRAWINGS FOR DETAIL)			
4	STARTING PLATFORMS, STANDARD.	KDI PARAGON	22113
10	RECESSED LANE LINE AND ROPE ANCHORS	HAYWARD	9P1040
5	MAXIMUM RACING LANES (KIEFER) MUST BE CUSTOM TO LENGTH	RECREONICS	14-625
15	AERATING WATER MAKE-UP JET DEPTH MARKER MONUMENTS	JOB MADE	
1	SPECIALLY PRE-CAST 3" X 3 1/8" CHANNEL DRAIN	HOLLOWAY CAST STONE	MINI DRAIN
1	TEST KIT, CL, ACID, TA		
1	CALC HARDNESS, PH, CYA	TAYLOR	2006
1	24" WALL BRUSH WITH QUICK CONNECT	RECREONICS	10-155
1	LEAF RAKE WITH QUICK CONNECT	RECREONICS	10-124
2	18" ALUMINUM POLE, STRAIGHT	GIAMMANCO	16
1	TELESCOPING HANDLE 18/22"	RECREONICS	10-334
2	POLE HANGAR SETS	ALADDIN	866
1	24" COMMERCIAL FLEX VACUUM HEAD	RECREONICS	10-201
1	1 1/2" X 40" VAC HOSE W/SPWEL GUFF	RECREONICS	10-413
2	24" U.S. COAST GUARD LIFE RING	CAL-JUNE	GW24
2	LIFE RING HOLDER, S.S.	FROST	41160-0
2	60' 1/4" LIFE LINE ROPE WITH BALL	GIAMMANCO	60
2	SHEPHERDS CROOK	RAINBOW	221026-153

AND OTHER MISCELLANEOUS EQUIPMENT NOT LISTED ABOVE NECESSARY TO COMPLETE A WORKABLE INSTALLATION IN COMPLIANCE WITH 64E-9 FAC. COUNTS AND QUANTITIES ARE GIVEN FOR ASSISTANCE TO THE BIDDERS AND ARE ONLY APPROXIMATE.

POOL HEATING EQUIPMENT IS BY SEPARATE CONTRACT

SCOPE OF WORK

The Scope of Work for the swimming pool contractor on this project will include, but not be restricted to, the furnishing of all labor and material necessary to complete the following:

- Layout, earth handling, shaping and compaction involved with the remodeling work on the pool.
- Installation of a new concrete shell inside of the walls of the existing swimming pool. Construction of a new water features pool (Splash Pad) and other structures shown on these drawings.
- Installation of pool interior finish and provision of all deck equipment shown in the drawings and specifications.
- Construction of a water feature kiddies pool adjacent to the pool.
- Deckwork, fences, balustrades and other improvements around the pool are not part of the pool contractor's scope of work.
- Installation of drainage conduit around the pool perimeter is included in the pool contractor's scope.

7. All perimeter and underpool piping serving the pool and all face piping within the equipment room as shown on the drawings.

8. All filtering and chemical treatment equipment, piping, and appurtenances incidental to the proper installation of the pool and water features filtering and water treatment equipment.

9. Initial startup and balancing of the pool water and operation of the pools until the owner has been instructed in its operation and the pool work approved by the Health Department.

10. Any other material or labor necessary to construct a complete an operational swimming pool and water feature installation.

11. Arrangement for inspections by the Hillsborough County Health Department, Environmental Engineering Section and procurement of an Operating Permit. Submission Fees will be paid by the owner.

12. Heating equipment will be per drawings and specifications.



13. Underwater lighting is not included in this contract. Lighting for night swimming will be by overhead illumination to 15 footcandles.

SCOPE OF WORK, SYSTEMS, EQUIPMENT LISTS AND POOL DATA

HILLSBOROUGH COUNTY HEALTH DEPARTMENT


RECORD DWG.
DATE 8/2/13

AVENIDA REPUBLICA DE CUBA
(14th STREET)

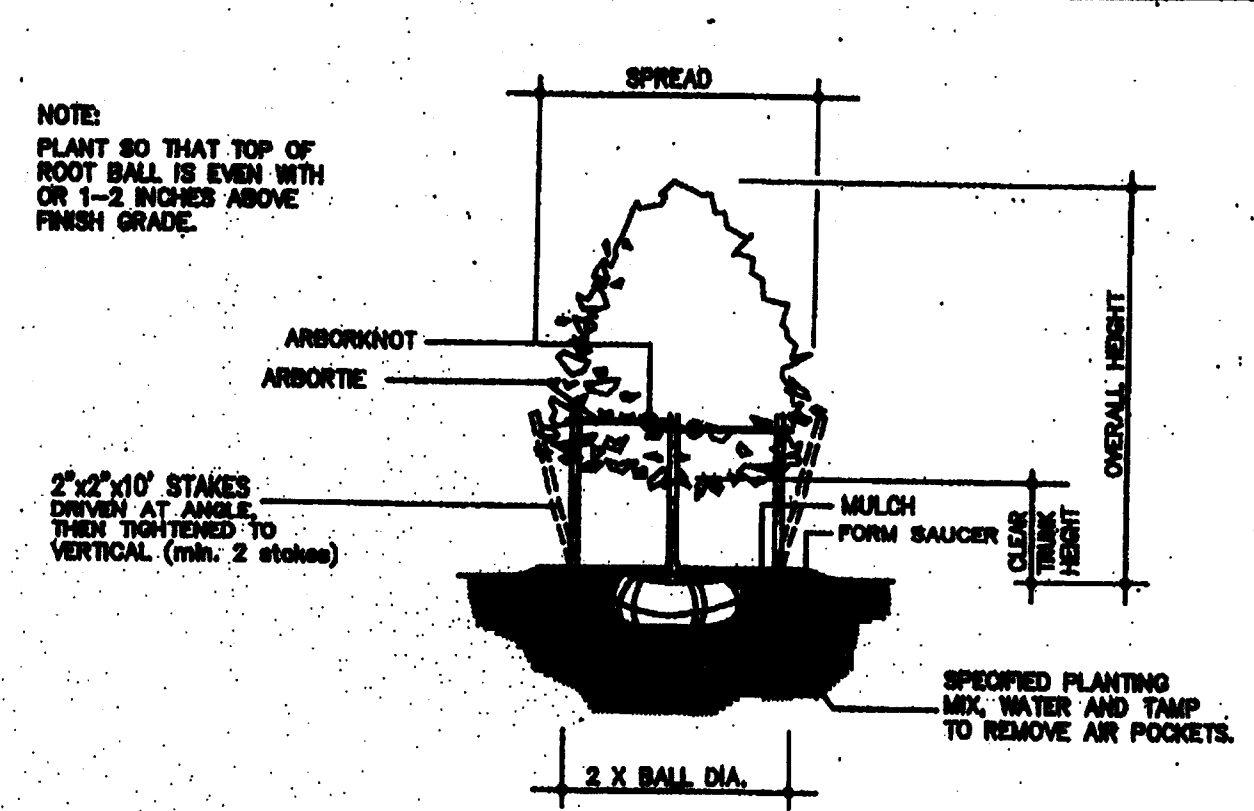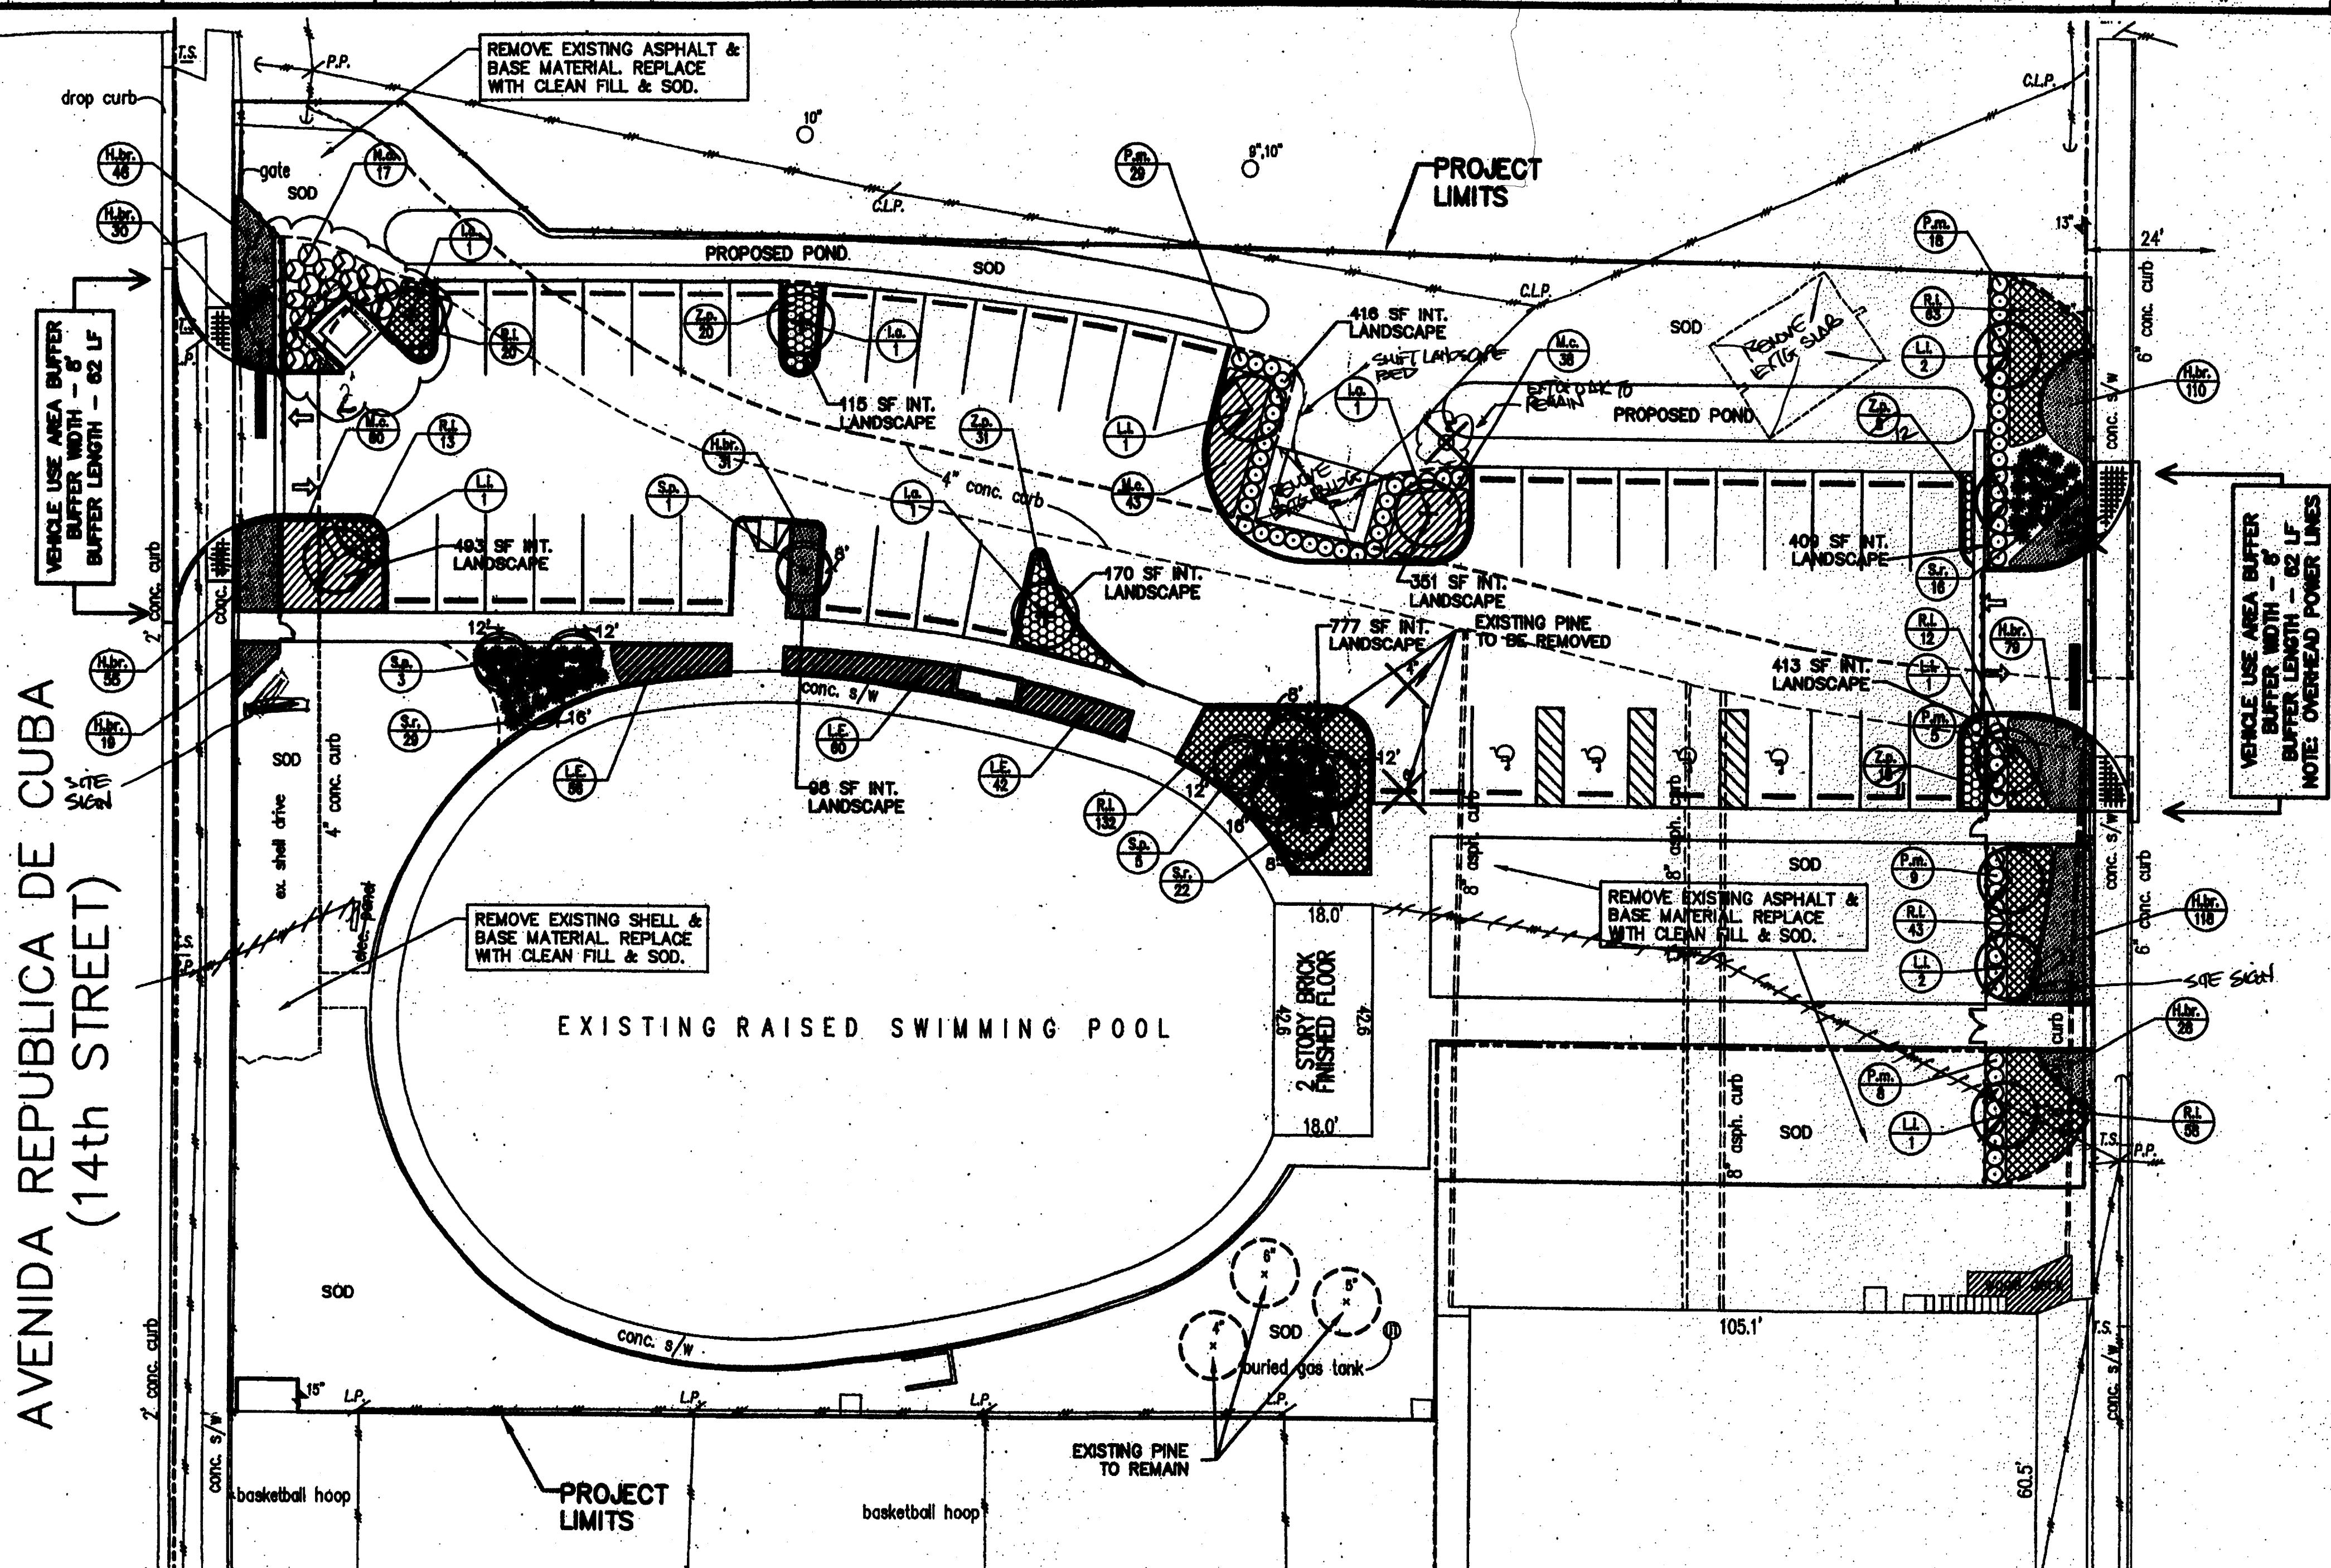


TREE PLANTING DETAIL (2" CALIPER OR LESS)

SCALE: NOT TO SCALE

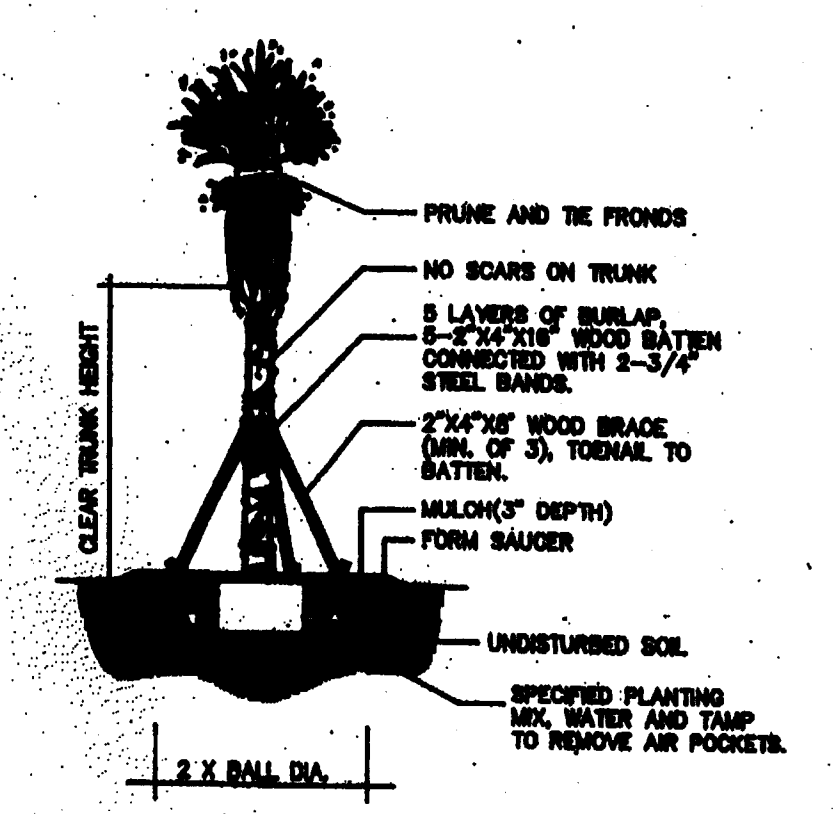

CABBAGE PALM PLANTING DETAIL

SCALE: NOT TO SCALE

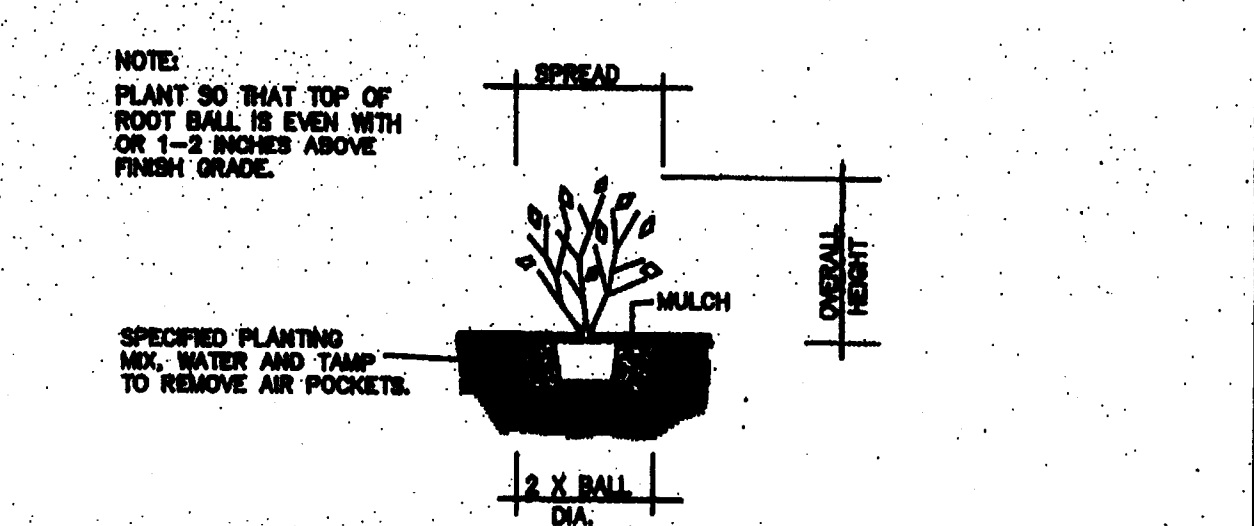

SHRUB & GROUND COVER PLANTING DETAIL

SCALE: NOT TO SCALE

LANDSCAPE REQUIREMENTS

PERIMETER LANDSCAPE BUFFER

VEHICLE USE AREA
Avenida Republica De Cuba - Buffer Width - 6' / Buffer Length - 62LF
Trees Required - 1 Tree per 40 LF - 62/40 = 2
Trees Provided - 2
Shrubs/Plants Provided - Yes
Shrubs/Plants Provided - Yes

N. 15th Street - Buffer Width - 6' / Buffer Length - 62LF
Trees Required - 1 Tree per 40 LF - 62/40 = 2
Trees Provided - 2
Shrubs/Plants Provided - Yes
Shrubs/Plants Provided - Yes

INTERIOR LANDSCAPE REQUIREMENTS

INTERIOR LANDSCAPE AREA (50 percent of vehicle use area)
Total Vehicle Use Area - 18,276 SF x 50% = 9,138 SF
Interior Landscape Area Required - 4,569 SF
Interior Landscape Area Provided - 3,778 SF

INTERIOR TREE REQUIREMENTS
(1 Tree per 1,000 SF of Parking Area)
Total Vehicle Use Area - 18,276 SF / 1,000 SF = 18
Interior Trees Required - 18
Interior Trees Provided - 13

TREE CREDIT<DEBIT> REQUIREMENTS

Replacement Trees Required - 0
Tree Credits Available - 0

TREE CREDIT<DEBIT> REQUIREMENTS				
TREES TO BE REMOVED				
QUANTITY	DESCRIPTION	CALIPER	MULTIPLIER CREDIT<DEBIT>	TOTAL REPLACEMENT TREES CREDIT<DEBIT>
1	PINE	4" Cal.	<0>	<0>
2	PINE	6" Cal.	<0>	<0>
TOTAL TREE REPLACEMENT<CREDIT>				
TREES TO BE PRESERVED				
QUANTITY	DESCRIPTION	CALIPER	MULTIPLIER CREDIT<DEBIT>	TOTAL REPLACEMENT TREES CREDIT<DEBIT>
1	PINE	4" Cal.	0	0
1	PINE	6" Cal.	0	0
1	PINE	6" Cal.	0	0
TOTAL TREE CREDITS				
0				

PLANT LIST			
SYMBOL	SYMBOL/COMMON NAME	DESCRIPTION	QUANTITY
TREES			
La	Sho-b-oh-mee-oh-mee-oh	WINGED BLM 8 1/2" x 8 1/2" Sp. 2'0", 20 gal, Full	4
Ll	Lagotis-oh-mee-oh	8 1/2" x 8 1/2" Sp. 2'0", 20 gal, Full	8
PLANTS			
Pa	Sho-b-oh-mee-oh	8-10", 20 Pin Per Stem	8
Pc	Sho-b-oh-mee-oh	10-12" x 8 Sp. 3rd, 30"OC, Full	67
SHRUBS			
Ma	Sho-b-oh-mee-oh	20-40" x 10-20" Sp. 3 gal, 30"OC, Full, Stock	17
Pa	Sho-b-oh-mee-oh	20-40" x 10-20" Sp. 3 gal, 30"OC, Full	69
GROUNDCOVER			
Ma	Sho-b-oh-mee-oh	12" x 12" Sp. 1 gal, 18"OC, Full, European	80
Le	Sho-b-oh-mee-oh	10-12" x 8 Sp. 1 gal, Full, 8 lbs min, 30"OC	150
Ma	Sho-b-oh-mee-oh	10" x 12" Sp. 1 gal, 30"OC, Full	10
Ll	Sho-b-oh-mee-oh	8-10" x 8 Sp. 3 gal, 30"OC, Full	30
Za	Sho-b-oh-mee-oh	8-10" x 8 Sp. 3 gal, 30"OC	74
IRRIGATION			
	Sho-b-oh-mee-oh	3" depth min.	± 6,363 SF
	Sho-b-oh-mee-oh	Steel Pipe	± 52,885 SF
	Sho-b-oh-mee-oh	Per Notes and Details	255.9 CY
	Sho-b-oh-mee-oh	Per Details	12 Trees / 8 Plants

GENERAL NOTES

All plant materials shall be Florida Grade No. 1 or better, as specified in GRASSES AND STANDARDS FOR NURSERY PLANTS, Parts I and II, by the Division of Plant Industry, Florida Department of Agriculture and Consumer Services, and shall conform to current American Association of Nurserymen STANDARDS FOR NURSERY STOCK, unless otherwise specified on the plans and plant list.

All plant materials shall be guaranteed for a period of one year (365 days) after final acceptance. All replacement materials shall be guaranteed for an additional 365 days.

All planting beds shall be mulched with Eucalyptus mulch, Grade II or better, to a depth of three (3) inches. All trees in good grade shall have a 30" min. radius mulched tree ring. Soil shall be Populatus rotunda "Bald" soil.


Landscape shall be irrigated by a fully automatic irrigation system, utilizing low volume nozzles where practical and equipped with a rain or moisture sensing device.

All plantings shall receive soil amendments consisting of 50% (50) percent native processed soil and 50% (50) percent planting mix. Planting mix shall consist of 50% (50) percent Florida Peat, twenty (20) percent Compost, and twenty (20) percent Sand. Refer to the planting details & specifications for additional planting specifications.

Where building or paving occurs within the protective area of an existing tree to remain, the CONTRACTOR shall first frame those roots affected by the construction. Roots shall be clearly graded to an elevation deep enough to avoid loading of the roots 18 inches beyond the construction area.

Proposed utility lines for water, irrigation, electric, telephone and sanitary sewer lines shall be located through the roots of the existing trees to remain when rediment is not an acceptable alternative.

Remove all existing sod within the project limits & return the existing soils to a depth of 12" prior to the installation of the new plantings and sod.

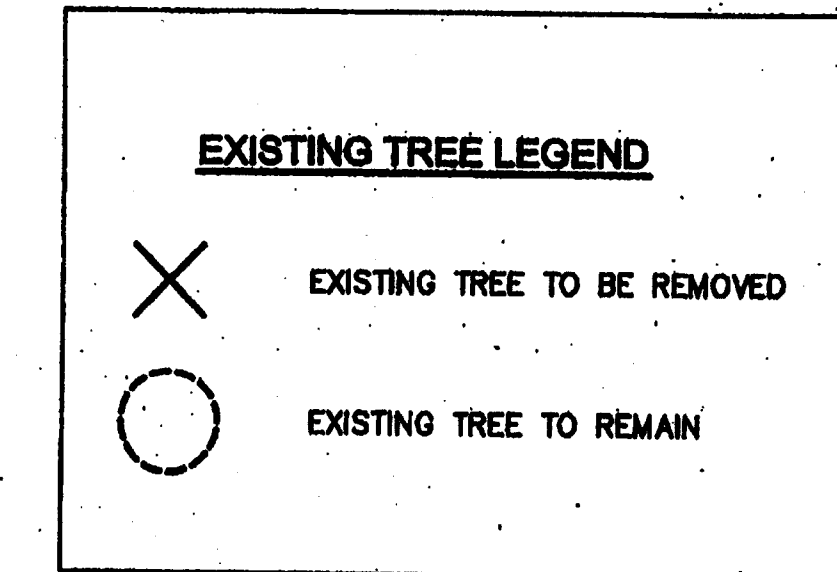

ROME ARCHITECTS
INCORPORATED

100 Madison Street, Suite 200
Tampa, Florida 33602-4704
www.RomeArchitects.com
Fax: 813.221.9154
813.221.8771
AAC002172

CHARLOTTE ENGINEERING
& SURVEYING, INC.

Port Charlotte Office
1700 El Jobean Road,
Port Charlotte, Florida 33948
Telephone No. (841) 629-2552
Fax No. (841) 743-8286

John J. Smith, R.L.A.
L.A. No. 0001032
State of Florida
Charlotte Engineering & Surveying, Inc.
Corporation No. 2804

CUSCADEN
POOL
RENOVATION

CITY OF TAMPA
308 East Jackson Street
Tampa, Florida 33602

Project No.0202.00	
Distribution	Date
SD DOCUMENTS	02.02.04
REV PER COMMENTS	08.03.04
REVISION 1	5.01.04

LANDSCAPE PLAN





L1

RECORD DWG.

DATE 8/26/05

14TH STREET

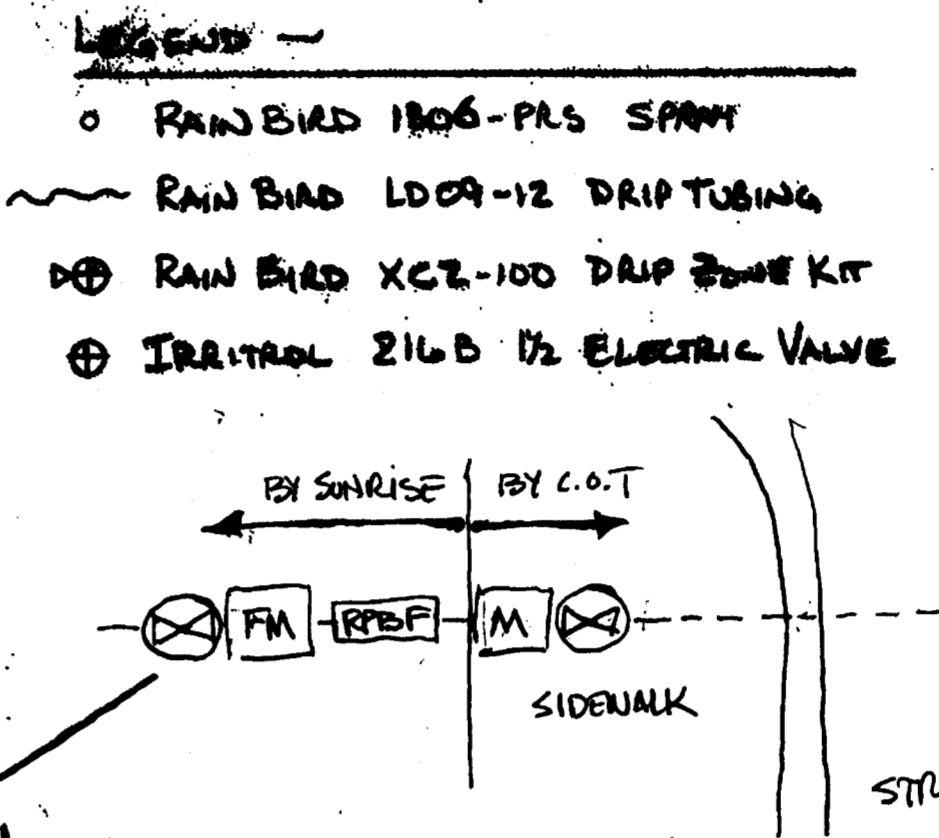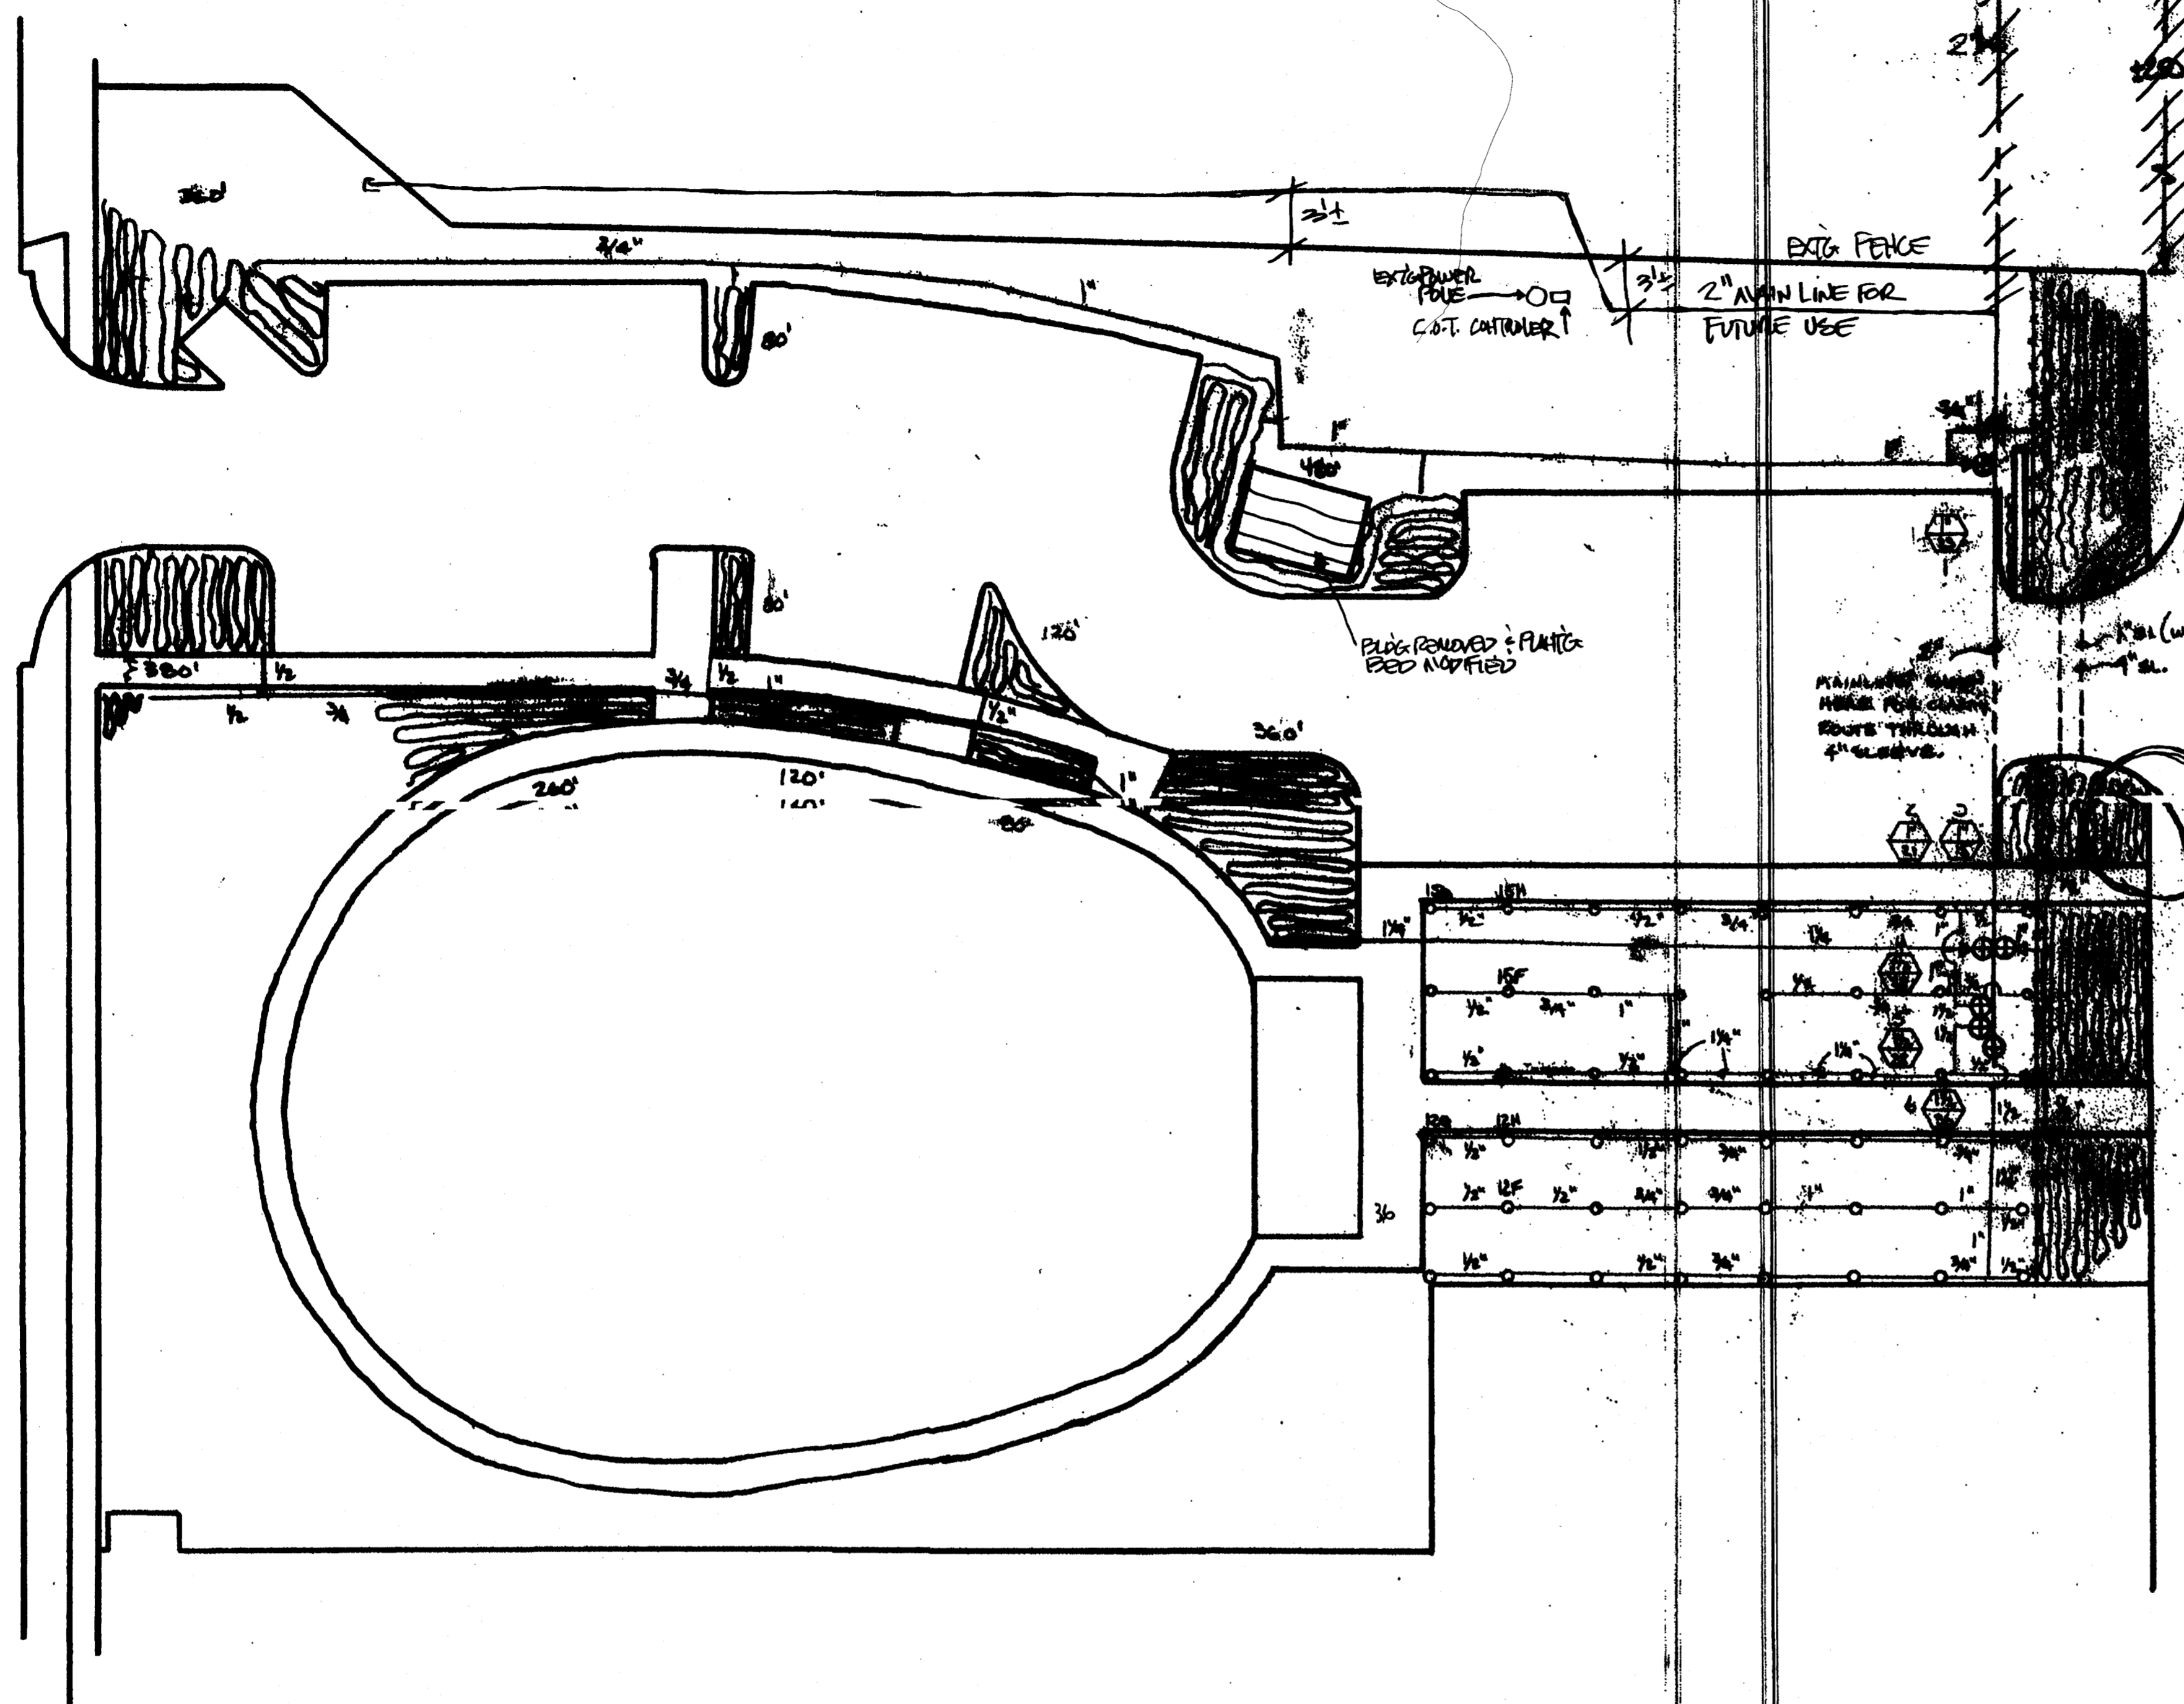

SUBMITTAL NO. 21

CUSCADEN POOL RENOVATION

CITY OF TAMPA
308 East Jackson Street
Tampa, Florida 33602

Project No.	0001
Distribution	Date
BD DOCUMENTS	1-24-05

PROJECT NO. 10406

NO EXCEPTIONS TAKEN

MAKE CORRECTIONS NOTED

RESUBMIT CORRECTED COPY


SELECTED - RESUBMIT

RESUBMIT SPECIFIED ITEM


REVISE AND RESUBMIT

This review is limited to general conformance of the product and general compliance with the contract documents and in no way relieves the subcontractor of his responsibilities either expressed or implied within the contract documents. The subcontractor is responsible for obtaining and coordinating all dimensions on the project site, including all construction, coordination of his work and other trades and satisfactory performance of the work.


CONSTRUCTION TECHNOLOGY GROUP, INC.
DATE: 1/24/05 BY: UKS

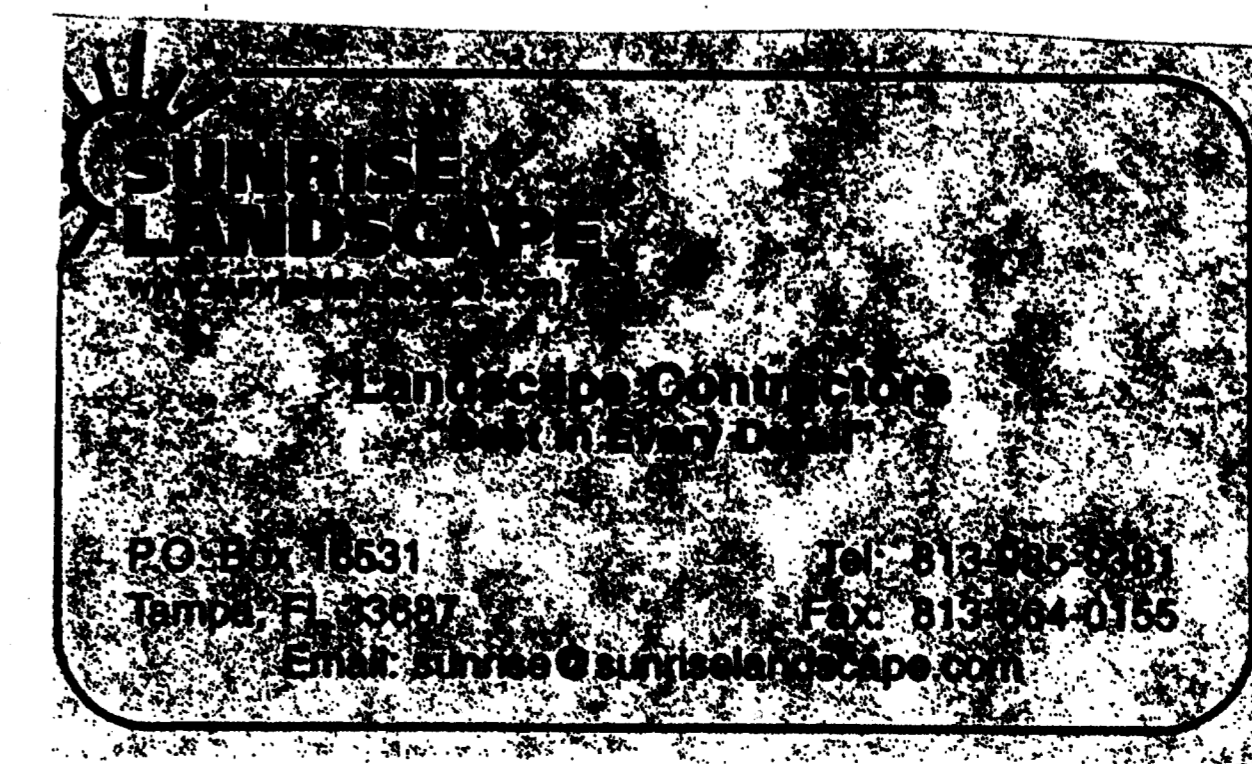

IRRIGATION PLAN

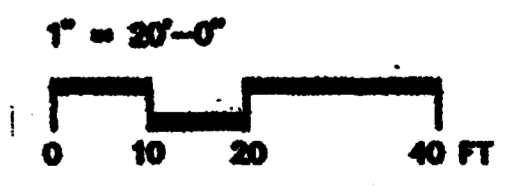

RECORD DWG.
DATE 2/26/05

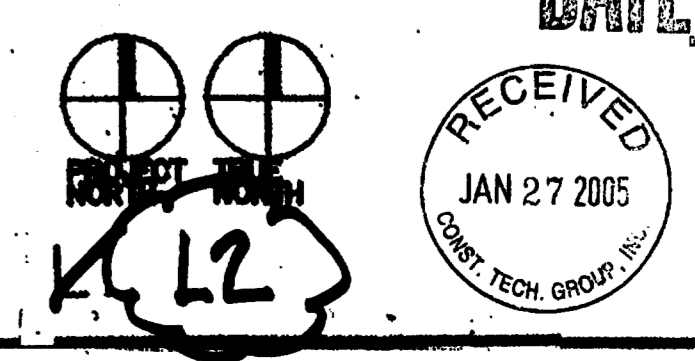

ROWE ARCHITECTS
INCORPORATED
100 Madison Street, Suite 200
Tampa, Florida 33602.6704
www.RoweArchitects.com
Fax: 813.221.9154
813.221.8771
AA0002172

CHARLOTTE ENGINEERING & SURVEYING, INC.

Port Charlotte Office
1700 El Jobson Road
Port Charlotte, Florida 33948
Telephone No. (941) 629-2522
Fax No. (941) 743-8296
(e-mail)

[Signature]
John L. Sney, R.L.S.
L.A. No. 0001032
State of Florida
Charlotte Engineering & Surveying, Inc.
Corporation No. 2904


CUSCADEN POOL RENOVATION

CITY OF TAMPA
306 East Jackson Street
Tampa, Florida 33602

Project No. 0202.00	
Distribution	Date
BD DOCUMENTS	02.02.04
REV. FOR COMMENTS	08.08.04
REVISION 2	5.07.05


CONTRACTOR TO TIE INTO EXISTING 2" MAIN (VERIFY CONNECTION LOCATION WITH THE CITY OF TAMPA). CONNECT ELECTRIC VALVE WIRES TO EXISTING CONTROLLER (VERIFY LOCATION WITH THE CITY OF TAMPA). SYSTEM DESIGN CRITERIA AT POINT OF CONNECTION PROVIDED BY THE CITY OF TAMPA (20 PSI TO 70 PSI). IRRIGATION CONTROLLER SHALL BE EQUIPPED WITH A RAIN OR MOISTURE SENSING DEVICE. (VERIFY WITH THE CITY OF TAMPA).

IRRIGATION CALCULATIONS:
TOTAL SITE AREA - 89,879 SF
LESS IMPERVIOUS AND STORMWATER AREA - <42,709 SF>
TOTAL GREENSPACE AREA - 27,170 SF
ALLOWABLE IRRIGATED TURFGRASS(50%) - 13,585 SF
ALLOWABLE IRRIGATED AREA(OTHER THAN MICROSPRAY) - 13,585 SF
IRRIGATION PROVIDED:
PLANTING BEDS (OTHER THAN MICROSPRAY) - 6353 SF (23.3%)
TURFGRASS(OTHER THAN MICROSPRAY) - 5899 SF (21.7%)
TOTAL IRRIGATED AREA - 12,252 SF (45%)

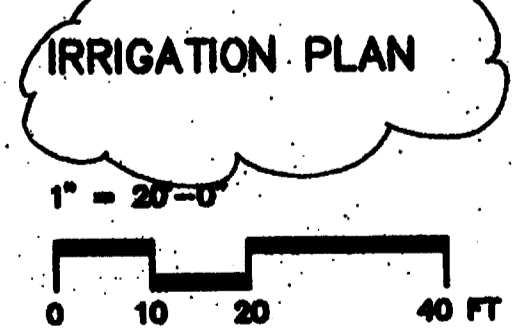

SEE SOURCE SLOPE PAGE

L2 **RECORD DWG.**
DATE 8/26/05 217/009

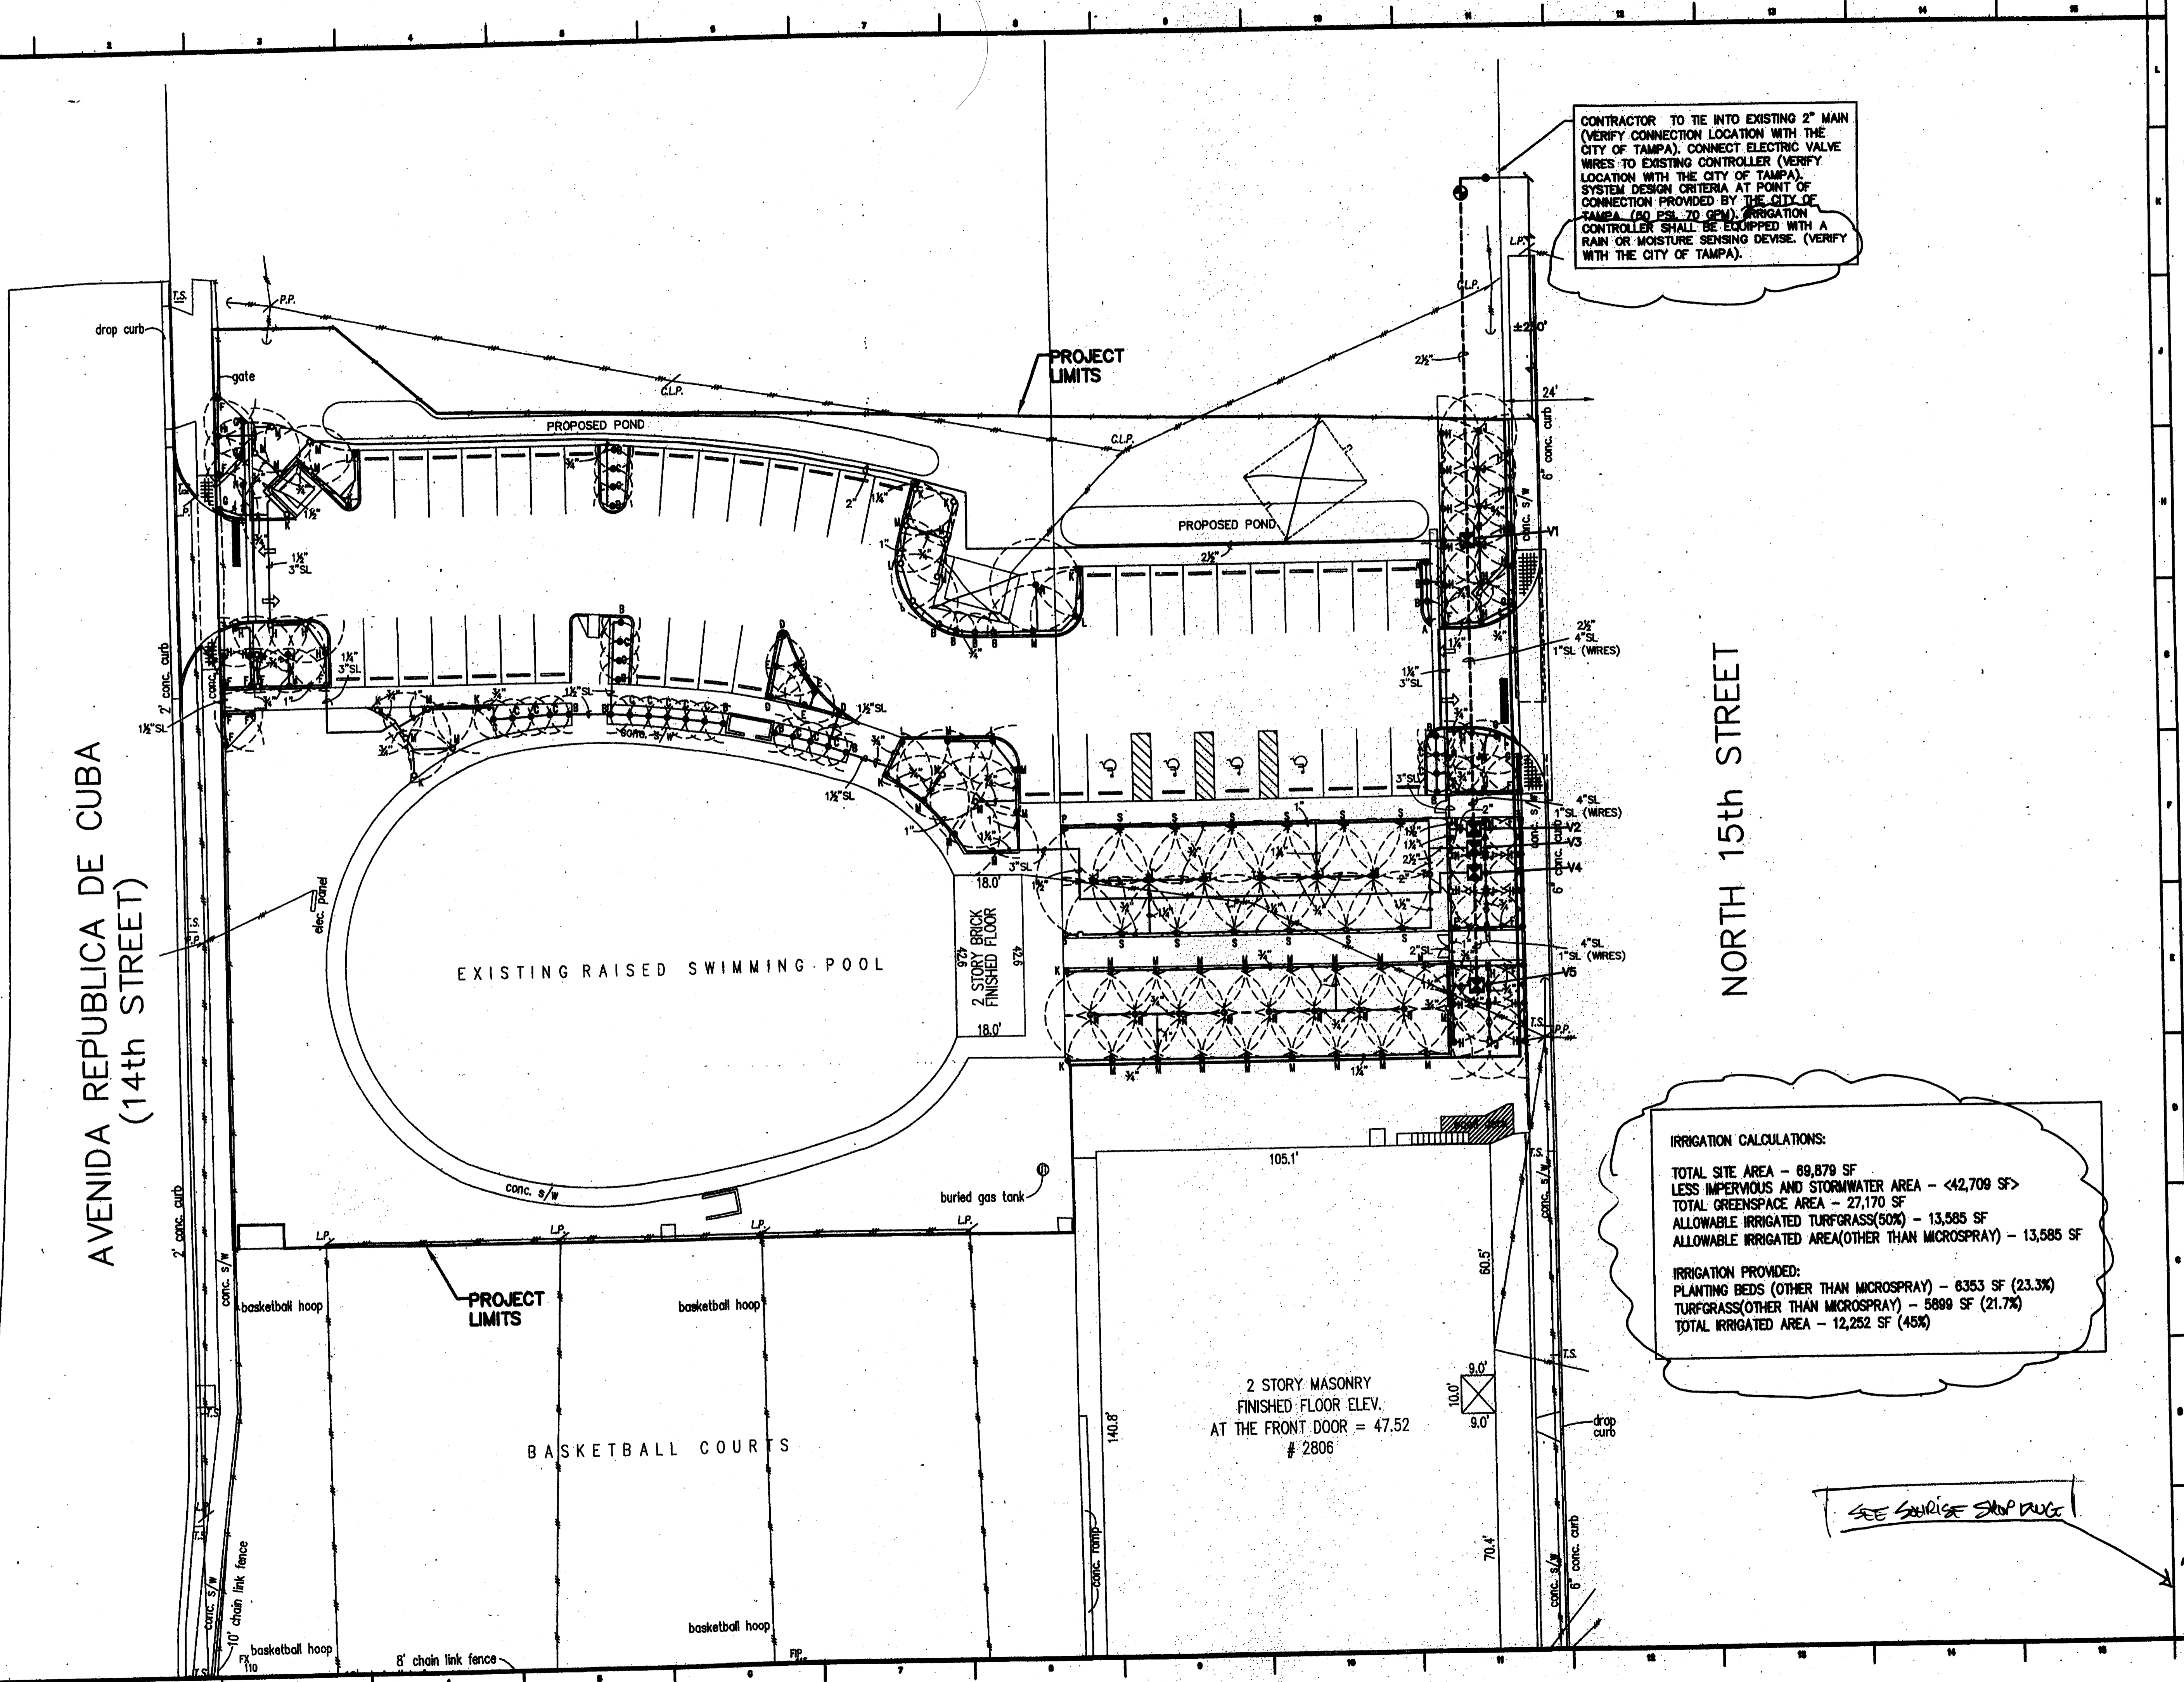

AVENIDA REPUBLICA DE CUBA
(14th STREET)

NORTH 15th STREET

EXISTING RAISED SWIMMING POOL


BASKETBALL COURTS

2 STORY MASONRY
FINISHED FLOOR ELEV.
AT THE FRONT DOOR = 47.52
2806

IRRIGATION CALCULATIONS:

TOTAL SITE AREA - 89,879 SF
LESS IMPERVIOUS AND STORMWATER AREA - <42,709 SF>
TOTAL GREENSPACE AREA - 27,170 SF
ALLOWABLE IRRIGATED TURFGRASS(50%) - 13,585 SF
ALLOWABLE IRRIGATED AREA(OTHER THAN MICROSPRAY) - 13,585 SF
IRRIGATION PROVIDED:
PLANTING BEDS (OTHER THAN MICROSPRAY) - 6353 SF (23.3%)
TURFGRASS(OTHER THAN MICROSPRAY) - 5899 SF (21.7%)
TOTAL IRRIGATED AREA - 12,252 SF (45%)

IRRIGATION PLAN

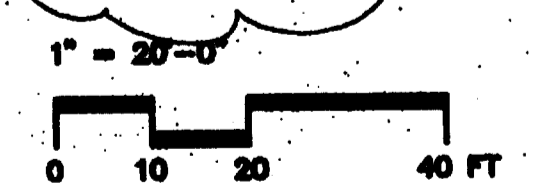

SEE SOURCE SLOPE PAGE

L2 **RECORD DWG.**
DATE 8/26/05 217/009

SYM. EQUIPMENT


○	Rainbird 1800-PRS Series 4" Pop-Up Sprinkler Model No. 1804-PRS. See Plan For Nozzle Size
●	Rainbird 1800-PRS Series 12" Pop-Up Sprinkler Model No. 1812-PRS. See Plan For Nozzle Size
Rainbird MPR Nozzles	
A	5Q - 0.10 gpm @ 30 psi/5' Spacing
B	5H - 0.20 gpm @ 30 psi/5' Spacing
C	5F - 0.41 gpm @ 30 psi/5' Spacing
D	8Q - 0.26 gpm @ 30 psi/8' Spacing
E	8H - 0.52 gpm @ 30 psi/8' Spacing
F	10Q - 0.39 gpm @ 30 psi/10' Spacing
G	10T - 0.53 gpm @ 30 psi/10' Spacing
H	10H - 0.79 gpm @ 30 psi/10' Spacing
J	10F - 1.58 gpm @ 30 psi/10' Spacing
K	12Q - 0.65 gpm @ 30 psi/12' Spacing
L	12T - 0.87 gpm @ 30 psi/12' Spacing
M	12H - 1.30 gpm @ 30 psi/12' Spacing
N	12F - 2.60 gpm @ 30 psi/12' Spacing
P	15Q - 0.92 gpm @ 30 psi/15' Spacing
R	15T - 1.23 gpm @ 30 psi/15' Spacing
S	15H - 1.85 gpm @ 30 psi/15' Spacing
T	15F - 3.70 gpm @ 30 psi/15' Spacing
U	12TT - 1.75 gpm @ 30 psi/12' Spacing
☒	Irritrol 200B Series, 2" Electric Valve, Model 217B with Manual Flow Control
⊕	2 1/2" Gate Valve (Per City Of Tampa Specifications)

ZONE	GPM	PSI
V1	48.99	30
V2	40.50	30
V3	48.94	30
V4	19.88	30
V5	44.20	30

WATER SCHEDULE


SPRAYS	WEEK 1	WEEK 2	WEEK 3
	DAILY / (2) CYCLES PER DAY / 20 MINUTES PER CYCLE	DAILY / (1) CYCLE PER DAY / 20 MINUTES PER CYCLE	(3) CYCLES PER WEEK / (1) CYCLE PER DAY / 20 MINUTES PER CYCLE

NOTE: AFTER WEEK 3, SET WATERING SCHEDULE TO COMPLY WITH ALL LOCAL & STATE WATERING RESTRICTIONS.

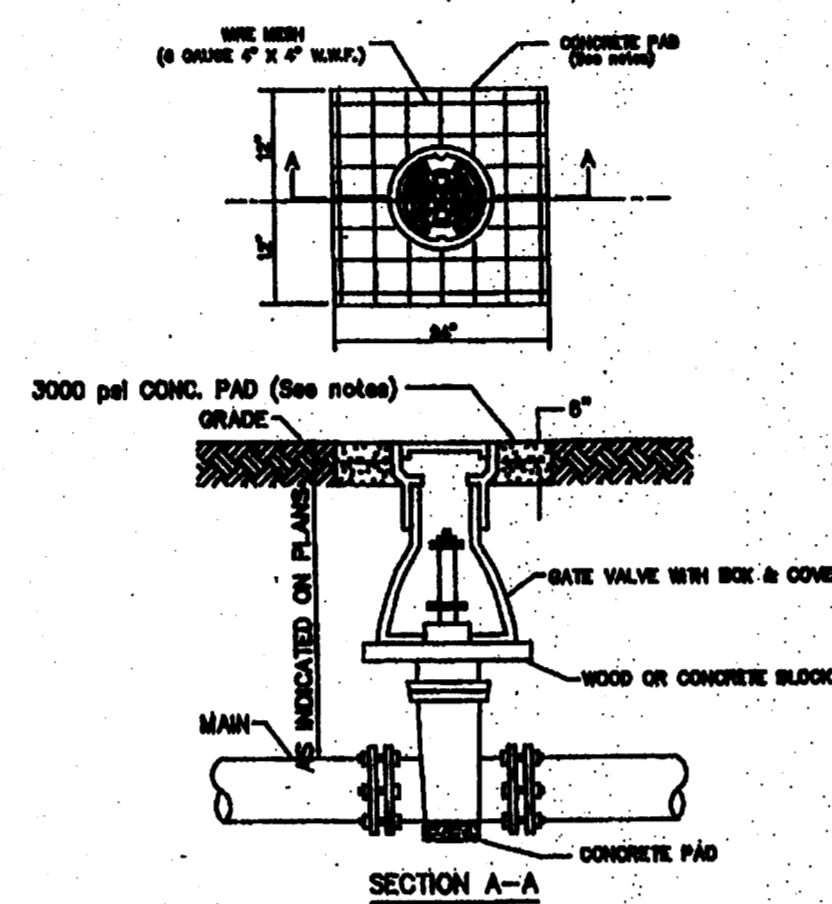


- Notes:**
- Pod Required When:
 - When valve box is installed in pavement (includes roadways, driveways, etc.).
 - As directed by the Engineer.
 - Cast iron valve boxes shall be firmly supported and maintained centered and plumb over the operating nut of the valve by the contractor with valve box cover flush with the surface of the finished pavement or at such other level as may be directed.


TYPICAL GATE VALVE VALVE BOX AND PAD INSTALLATION

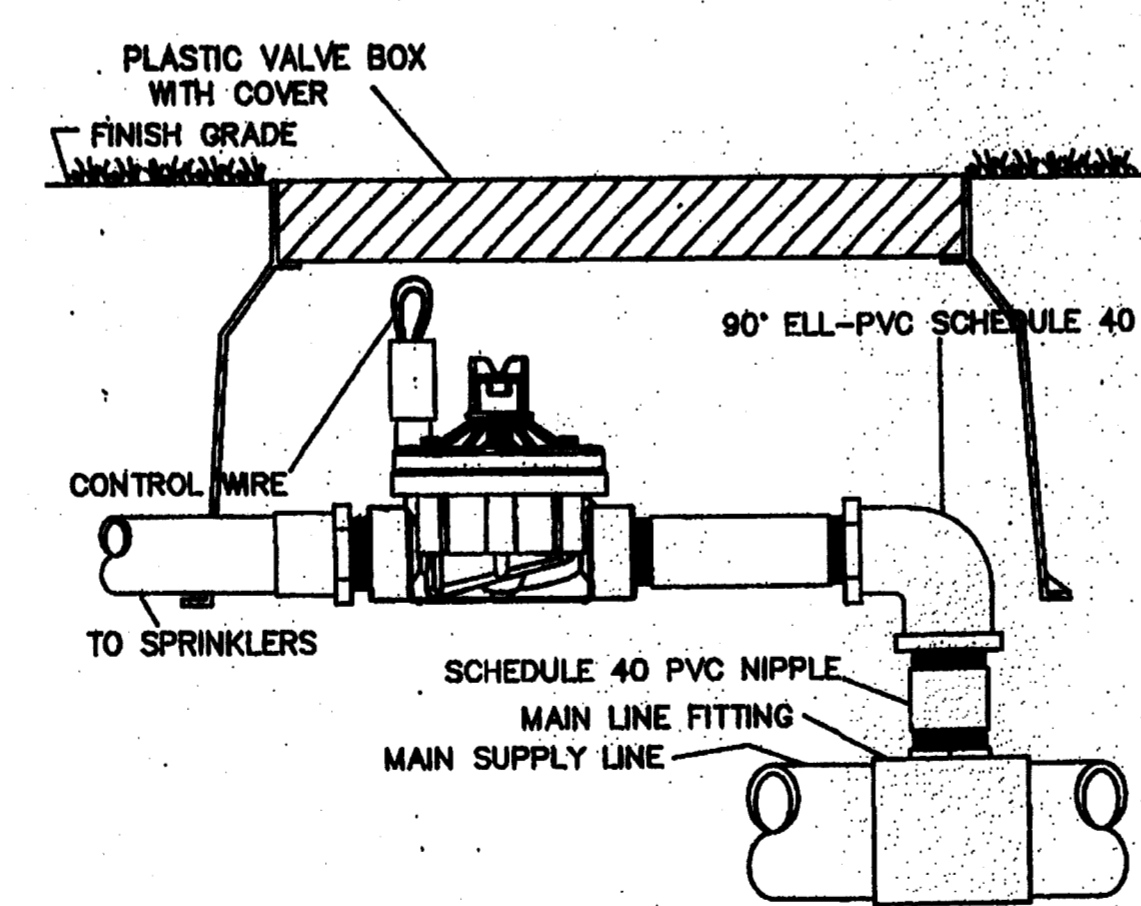

IRRITROL 200B SERIES ELECTRIC VALVE

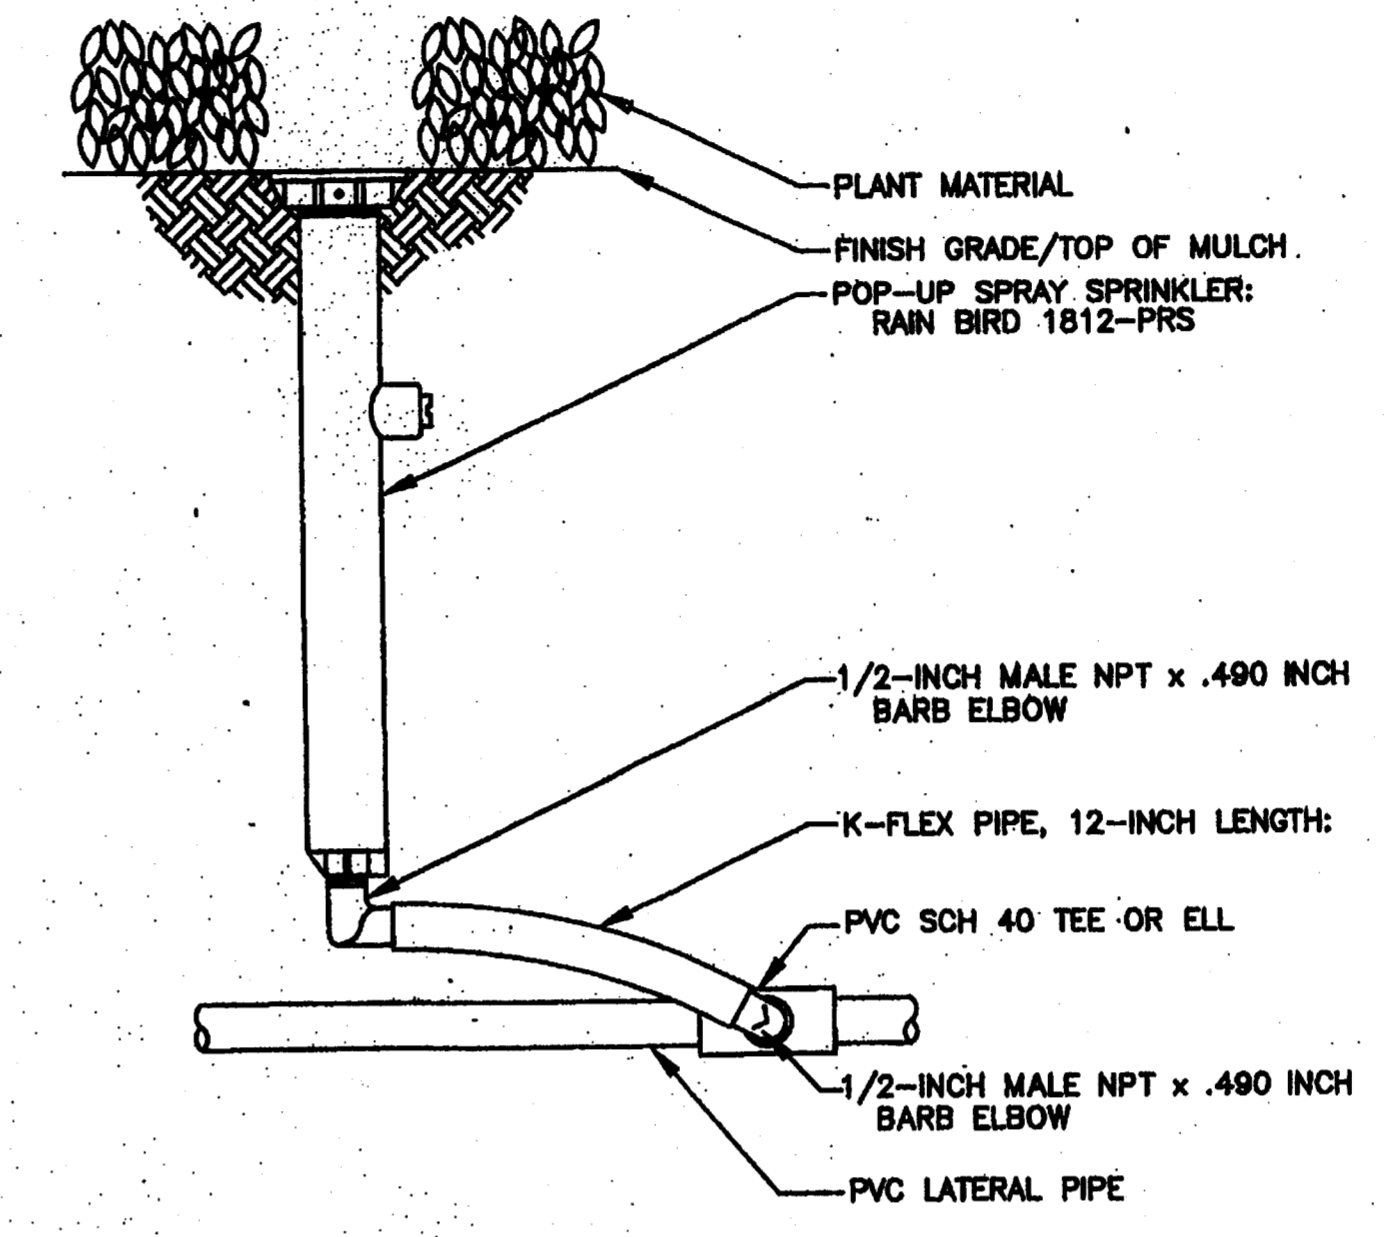

RAINBIRD 1800-PRS 12" POP-UP

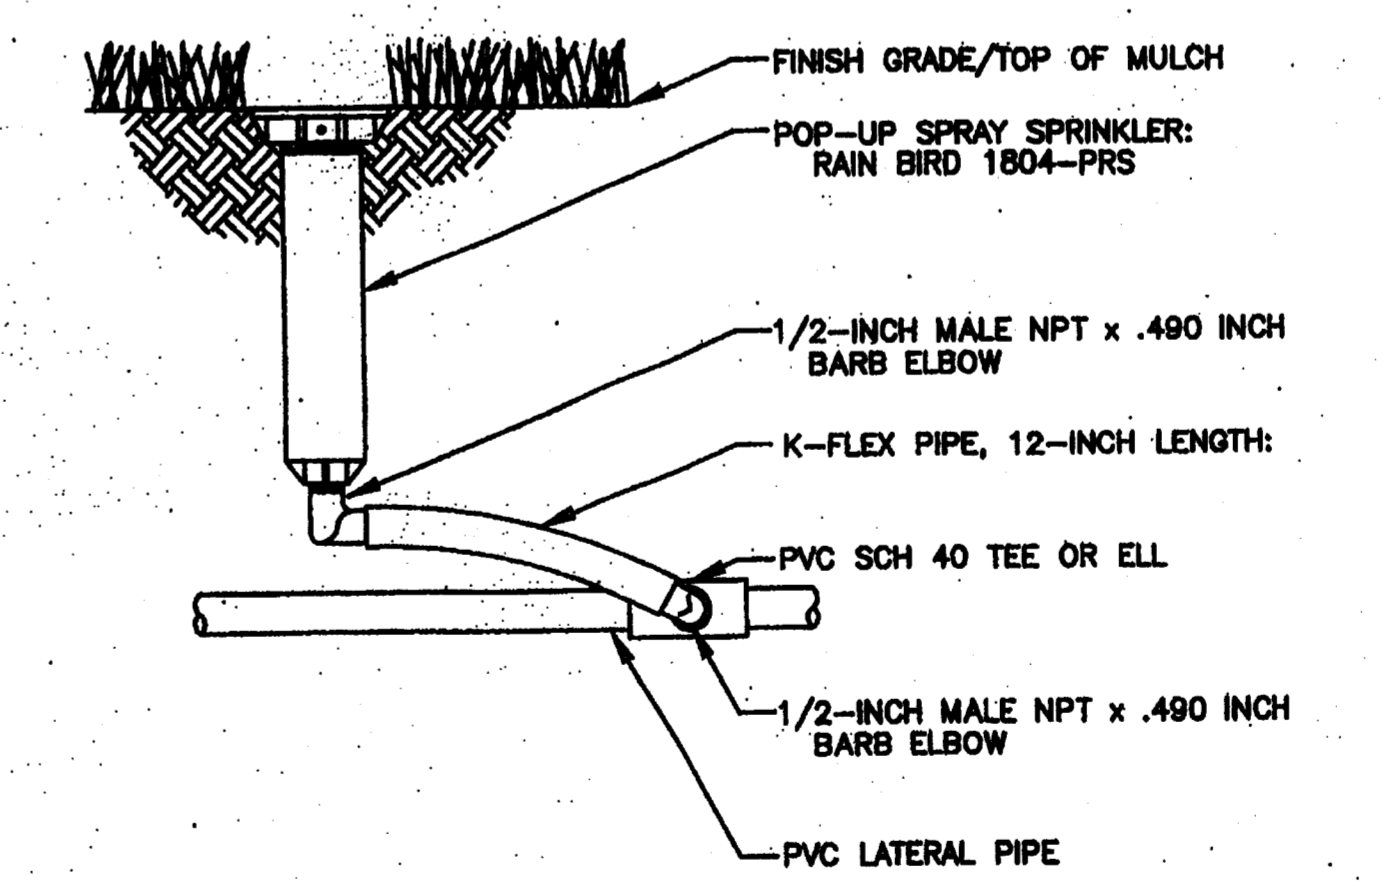

RAINBIRD 1800-PRS 4" POP-UP

CUSCADEN POOL RENOVATION

CITY OF TAMPA
306 East Jackson Street
Tampa, Florida 33602

Project No. 0202.00

Distribution	Date
BD DOCUMENTS	02.02.04
REV. PER COMMENTS	06.03.04
REVISION 2	07.07.04

IRRIGATION SCHEDULES & DETAILS

MECHANICAL SYMBOL LEGEND	
SYMBOL	DESCRIPTION
S/S	STAINLESS STEEL
W/	WITH
	SIGNAL TYPE (ALAO, DLDO)
	FUNCTIONAL DESCRIPTION

CONTROLS SYMBOL LEGEND	
SYMBOL	DESCRIPTION
AI	ANALOG INPUT
AO	ANALOG OUTPUT
DI	DIGITAL INPUT
DO	DIGITAL OUTPUT
T	TEMPERATURE SENSOR/TRANSMITTER
P	PRESSURE SENSOR/TRANSMITTER
CO2	CARBON DIOXIDE SENSOR/TRANSMITTER
TS	THERMOSTAT
	"AND" LOGIC GATE
	THREE INPUT "AND" LOGIC GATE
	SIGNAL OUT OF DIGITAL (EMCS) SOFTWARE INTO HARDWARE
	SIGNAL OUT OF HARDWARE INTO DIGITAL (EMCS) SOFTWARE
	"NOT" INPUT LOGIC


MECHANICAL SYMBOL LEGEND	
SYMBOL	DESCRIPTION
	NEW
	CONDENSING UNIT
	AIR MONITOR
	EXHAUST FAN
	SPLIT SYSTEM AIR HANDLER
	INSERT INDICATES TYPE OF AIR DEVICE (REFER TO SCHEDULE)
	KEY NOTE
	DIAMETER
	DIAMETER
- C.D. -	DIAMETER

MECHANICAL SYMBOL LEGEND	
SYMBOL	DESCRIPTION
	SUPPLY DUCT (SECTION)
	RETURN/EXHAUST DUCT (SECTION)
	RETURN/EXHAUST AIR
	UNDERCUT DOOR, DOORS SHALL HAVE A 3/4 INCH UNDERCUT. THIS CONTRACTOR SHALL COORDINATE ALL DOOR UNDERCUTS WITH DOOR INSTALLATION CONTRACTOR PRIOR TO BID.
	LOUVERED DOOR, DOOR LOUVERS SHALL BE MINIMUM 12" X 12". UNLESS OTHERWISE NOTED ON THE DRAWINGS, THIS CONTRACTOR SHALL COORDINATE ALL DOOR LOUVERS WITH DOOR INSTALLATION CONTRACTOR PRIOR TO BID.
	DROP IN DUCT ELEVATION
	90 DEGREE SQUARE ELBOW WITH TURNING VANES
	DUCT TEE WITH TURNING VANES AND SPLITTER
	VOLUME DAMPER
	FLEXIBLE CONNECTION IN DUCT
	BRANCH TAKE-OFF WITH SHOE FITTING
	RECTANGULAR TO ROUND TRANSITION (SINGLE LINE)
	SPIN-IN FITTING WITH VOLUME DAMPER
	SPIN-IN FITTING WITH OUT VOLUME DAMPER
	MOTORIZED DAMPER
	SMOKE DETECTORS, WITH 6X6 ACCESS DOOR
	RIGID TO FLEXIBLE DUCT TRANSITION
	90 DEGREE SQUARE ELBOW WITH TURNING VANES
	VOLUME DAMPER
	PIPE DOWN

MECHANICAL SYMBOL LEGEND	
SYMBOL	DESCRIPTION
	VIBRATION ISOLATOR
	ANGLE GATE VALVE W/ HOSE BIB
	PRESSURE REDUCING VALVE
	3-WAY CONTROL VALVE
	SHUT-OFF VALVE IN VALVE BOX
	COMBINATION MAGNETIC MOTOR STARTER

ROWE ARCHITECTS
INCORPORATED
100 Madison Street, Suite 200
Tampa, Florida 33602.4704
www.RoweArchitects.com
Fax: 813.221.9154
813.221.8771
AAC002172

ENGINEERING MATRIX, INC.
CONSULTING ENGINEERS
2000 GULF BLVD., SUITE 200
ST. PETERSBURG, FLORIDA 33710
TEL: 888-888-8888 FAX: 727-321-1111
WWW.EMATRIX.COM

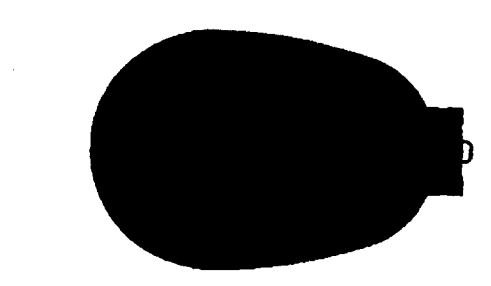


**CUSCADEN
POOL
RENOVATION**

CITY OF TAMPA
306 East Jackson Street
Tampa, Florida 33602

Project No.	0202.00
Distribution	Date
BID DOCUMENTS	02.02.04

Legend -
Mechanical

RECORD DWG.
DATE 8/26/05

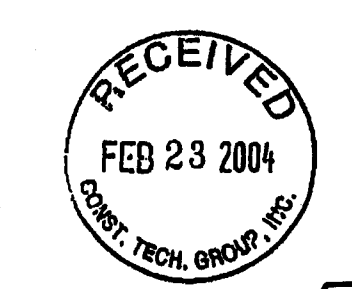


M001






Legend - Mechanical

None

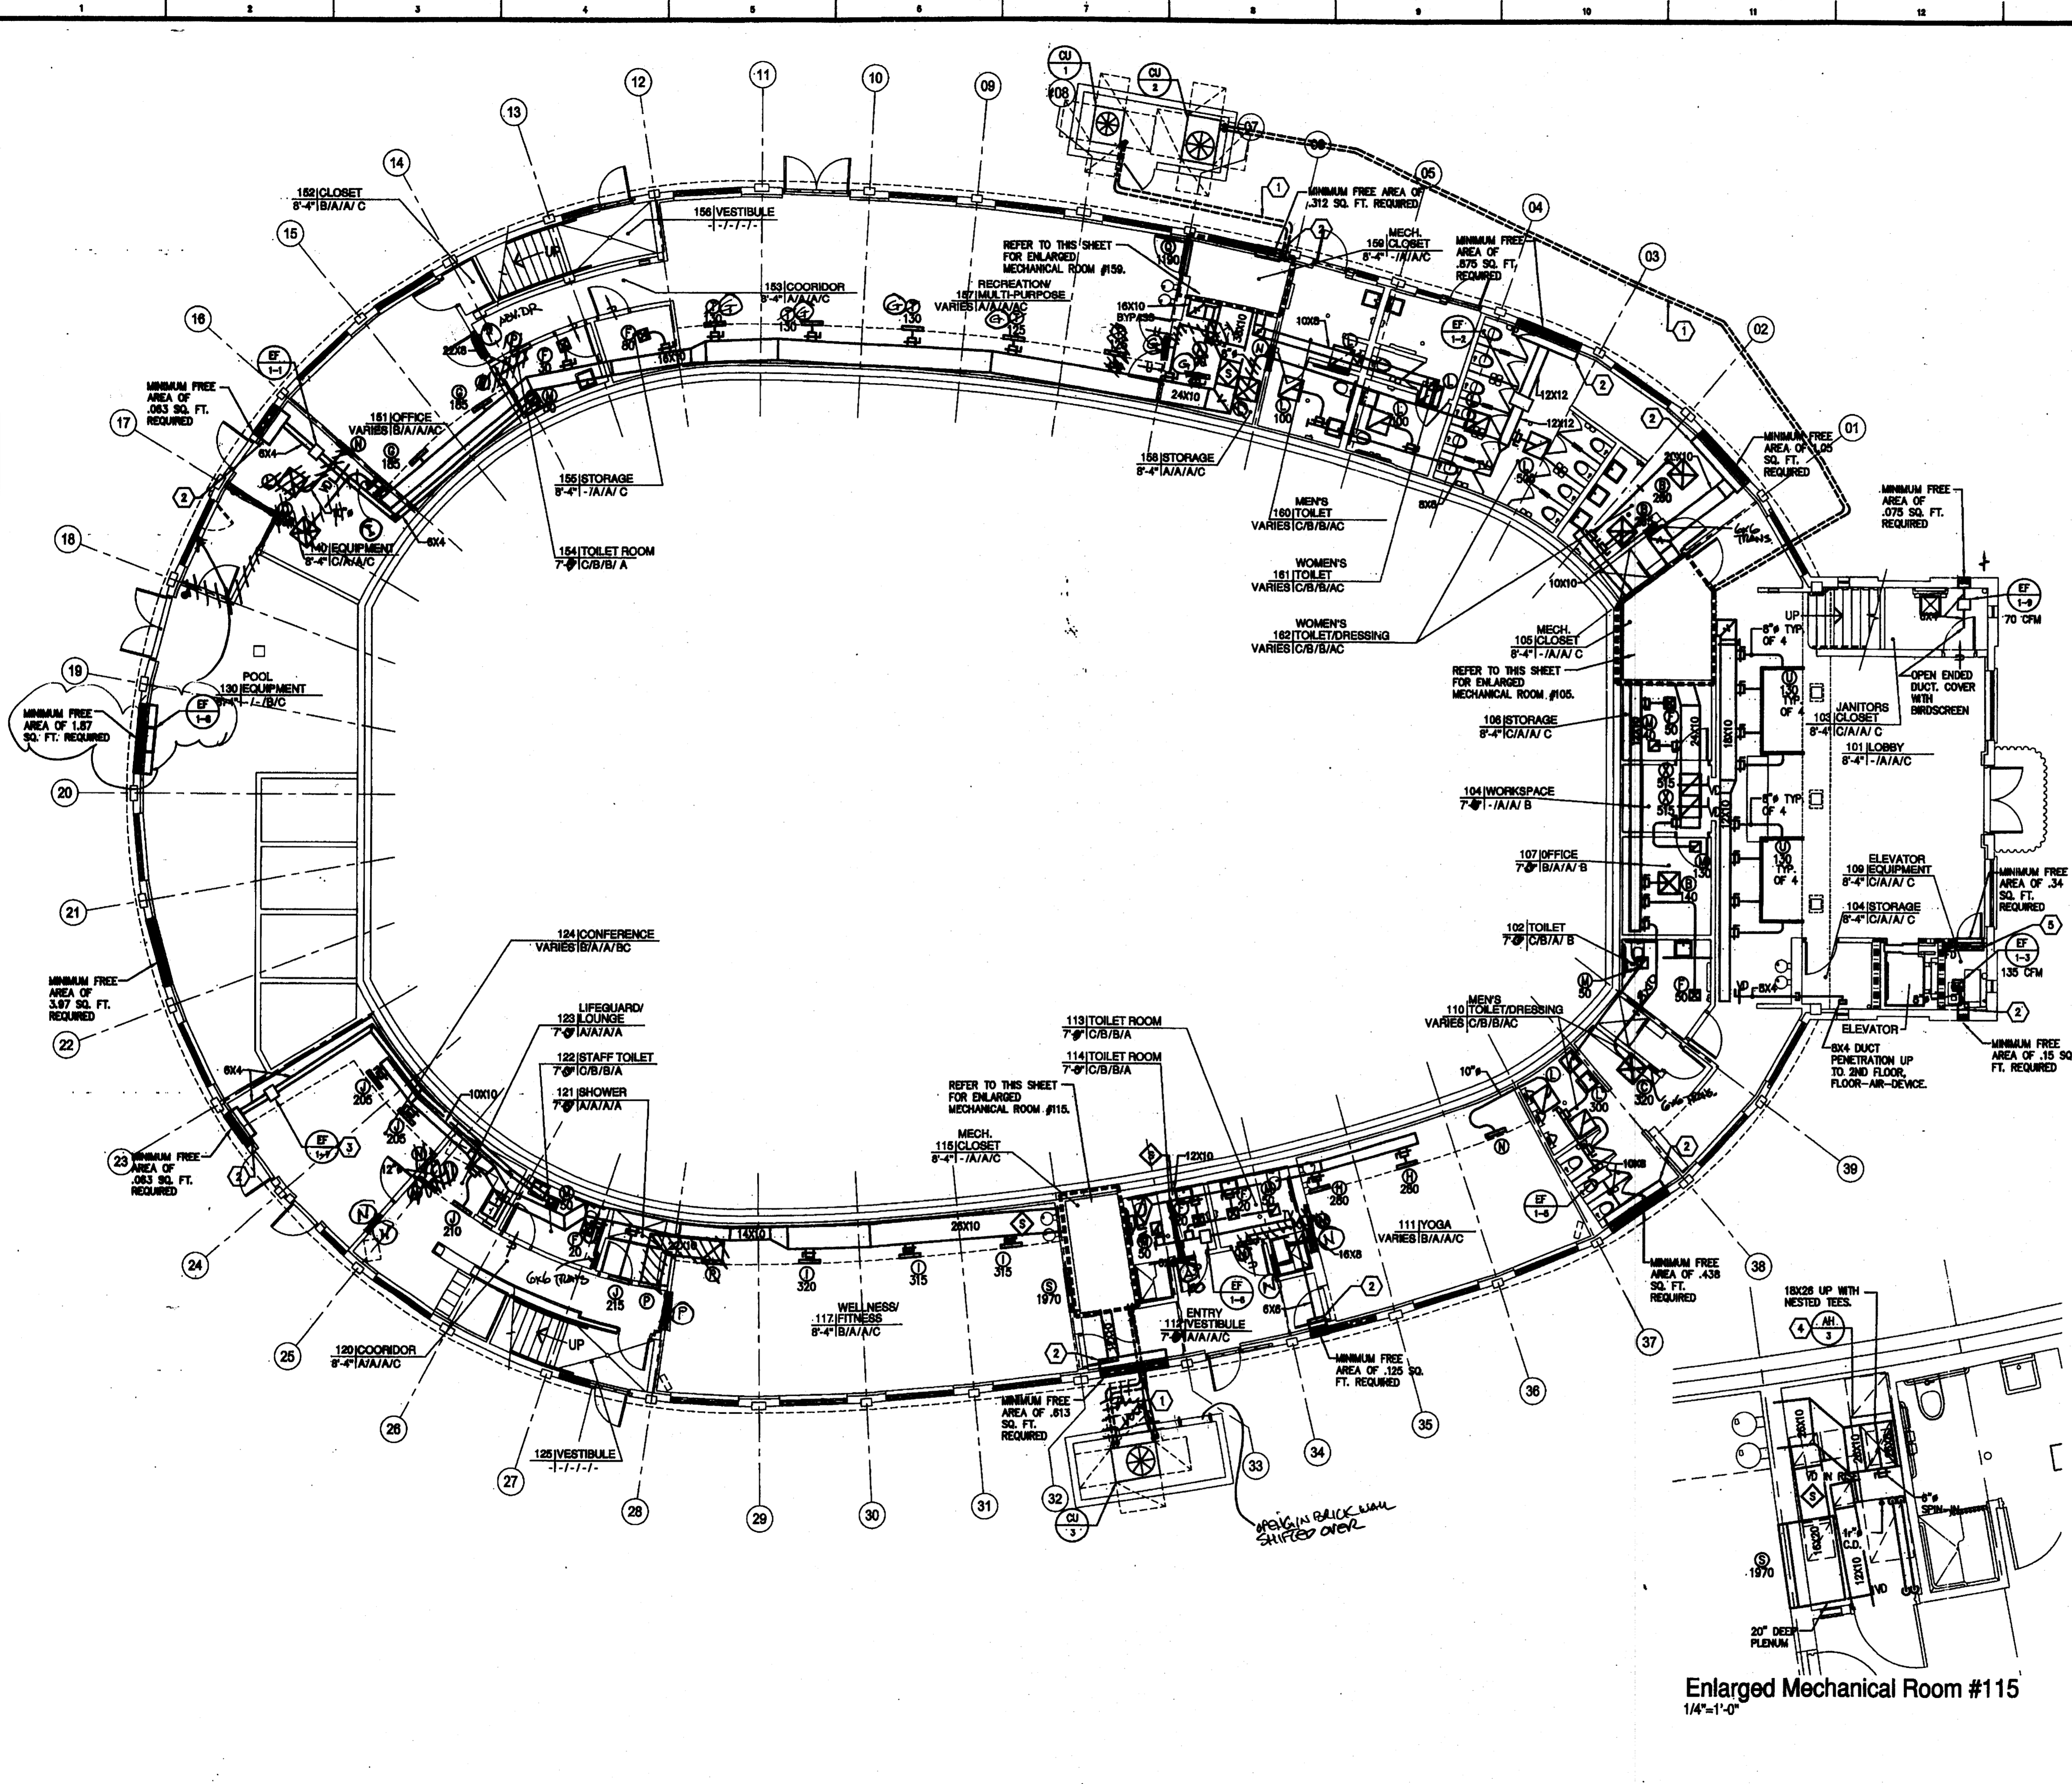

- ### GENERAL NOTES
1. INSTALL ALL MECHANICAL EQUIPMENT IN ACCORDANCE WITH ALL STATE AND LOCAL CODES.
 2. PROVIDE ALL TRANSITIONS, FITTINGS, ELBOWS, DUCTWORK, PIPING, SUPPORTS, ETC. NECESSARY FOR A PROPER INSTALLATION AND OPERATION OF NEW HVAC SYSTEM.
 3. COORDINATE INSTALLATION WORK WITH OTHER TRADES TO AVOID CONFLICTS.
 4. COORDINATE EXACT LOCATIONS OF NEW MECHANICAL EQUIPMENT WITH LIGHT LOCATIONS, TILE LOCATIONS, AND OTHER EQUIPMENT. REFER TO ARCHITECT'S REFLECTED CEILING PLAN LAYOUT.
 5. ALL DUCT DIMENSIONS SHOWN ON DRAWINGS ARE CLEAR INSIDE DIMENSIONS.
 6. INSTALL ALL DUCTWORK AND EQUIPMENT TIGHT TO DECK.
 7. DUCT DETECTORS SHOWN ON PLANS ARE DIAGNOSTIC. REFER TO MANUFACTURER'S INSTRUCTIONS FOR EXACT/OPTIMUM LOCATION IN DUCT.

- ### KEYED NOTES
1. REFRIGERANT LINES BELOW GRADE RISE IN MECHANICAL ROOM, ALONG WALL THEN RUN OVERHEAD TO AIR HANDLER. COVER RISE WITH ALUMINUM JACKET. NUMBER AND SIZE OF REFRIGERANT LINES PER MANUFACTURER'S RECOMMENDATIONS. BASED ON THE ACTUAL ROUTING, PRESSURE DROP, AND LENGTH OF PIPING FOR THE REQUIREMENTS OF THE UNIT. REFER TO DETAIL ON SHEET M3.2.
 2. PROVIDE SHEET METAL PLENUM ABOVE CEILING. REFER TO ARCHITECTURAL DRAWINGS FOR CONCEALMENT OF PLENUM ABOVE CEILING.
 3. PROVIDE WITH ACCESS DOOR BELOW EXHAUST FAN, LARGE ENOUGH TO REMOVE EXHAUST FAN, AND IN NO CASE SMALLER THAN 22"x36".
 4. PROVIDE STRUCTURAL SHEET METAL PLENUM BELOW AIR HANDLER, STRONG ENOUGH TO SUPPORT AIR HANDLER AND TALL ENOUGH TO CONNECT RETURN AIR, OUTDOOR AIR, AND BYPASS AIR DUCTS.
 5. FIRE DAMPER IN PLENUM ABOVE DOOR, AFFIXED TO TRANSFER AIR GRILLE; COORDINATE WITH ARCHITECTURAL DRAWINGS.

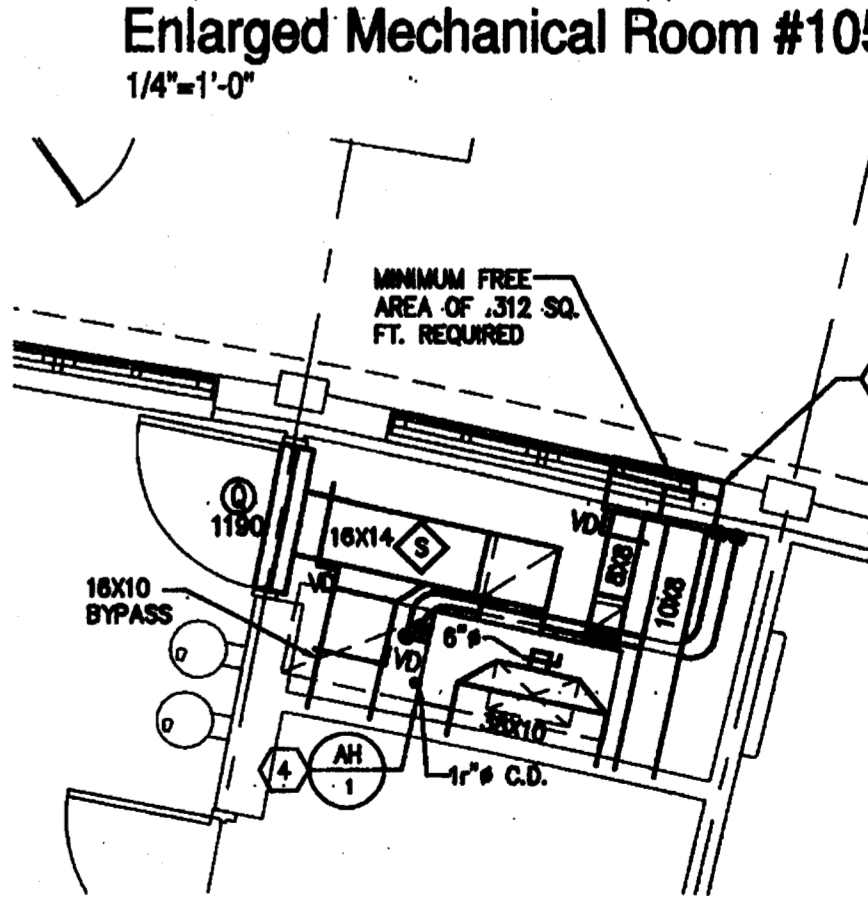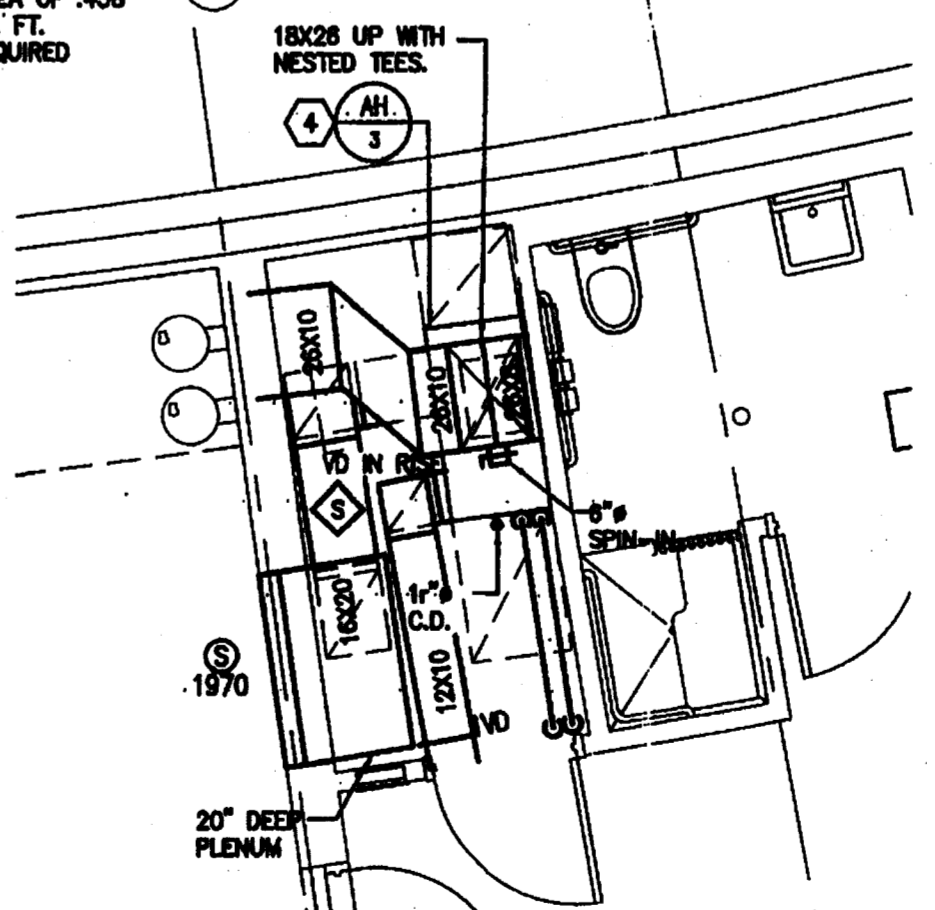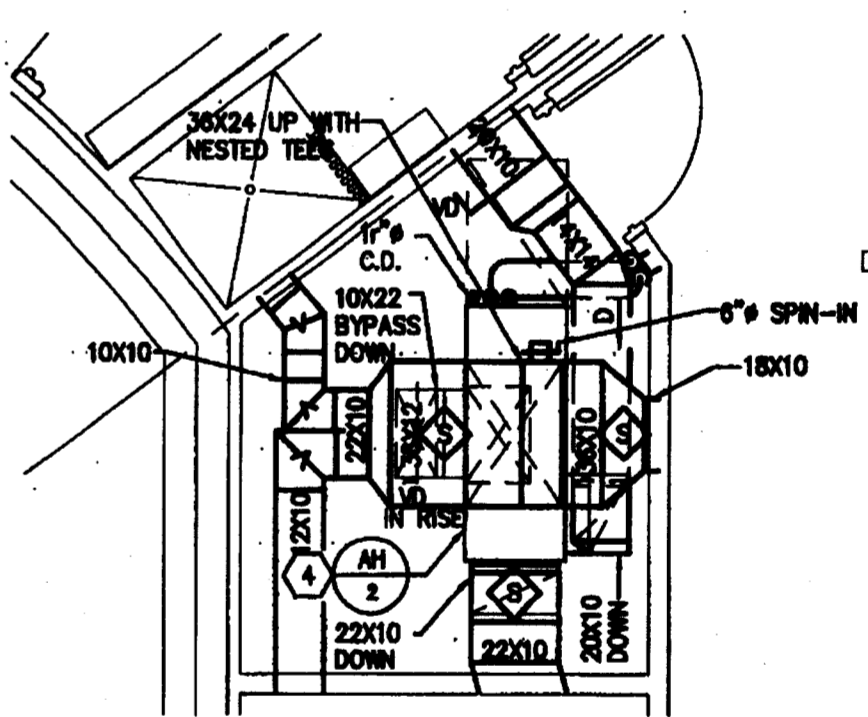

First Floor - Mechanical

1/8"=1'-0"

ROME ARCHITECTS
INCORPORATED
100 Madison Street, Suite 200
Tampa, Florida 33602-4704
www.RomeArchitects.com
Fax: 813.221.9154
813.221.8771
AAC002172

ENGINEERING MATRIX, INC.
CONSULTING ENGINEERS
10000 W. BRADSHAW BLVD., SUITE 100
TAMPA, FLORIDA 33607
TEL: 813-988-0000 FAX: 813-988-0000
WWW.EMATRIX.COM

CUSCADEN
POOL
RENOVATION


CITY OF TAMPA
306 East Jackson Street
Tampa, Florida 33602

Project No. 0202.00
Distribution Date
BID DOCUMENTS 02.02.04

First Floor - Mechanical

RECORD DRAWING
DATE 8/21

RECEIVED
FEB 23 2004
CUST. TECH. GROUP, INC.


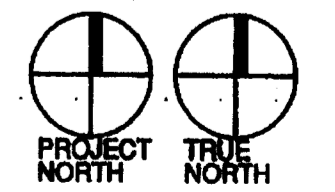


M201

217
009

GENERAL NOTES

1. INSTALL ALL MECHANICAL EQUIPMENT IN ACCORDANCE WITH ALL STATE AND LOCAL CODES.
2. PROVIDE ALL TRANSITIONS, FITTINGS, ELBOWS, DUCTWORK, PIPING, SUPPORTS, ETC. NECESSARY FOR A PROPER INSTALLATION AND OPERATION OF NEW HVAC SYSTEM.
3. COORDINATE INSTALLATION WORK WITH OTHER TRADES TO AVOID CONFLICTS.
4. COORDINATE EXACT LOCATIONS OF NEW MECHANICAL EQUIPMENT WITH LIGHT LOCATIONS, TILE LOCATIONS, AND OTHER EQUIPMENT. REFER TO ARCHITECTS REFLECTED CEILING PLAN LAYOUT.
5. ALL DUCT DIMENSIONS SHOWN ON DRAWINGS ARE CLEAR INSIDE DIMENSIONS.

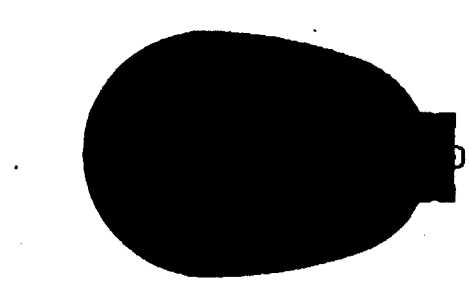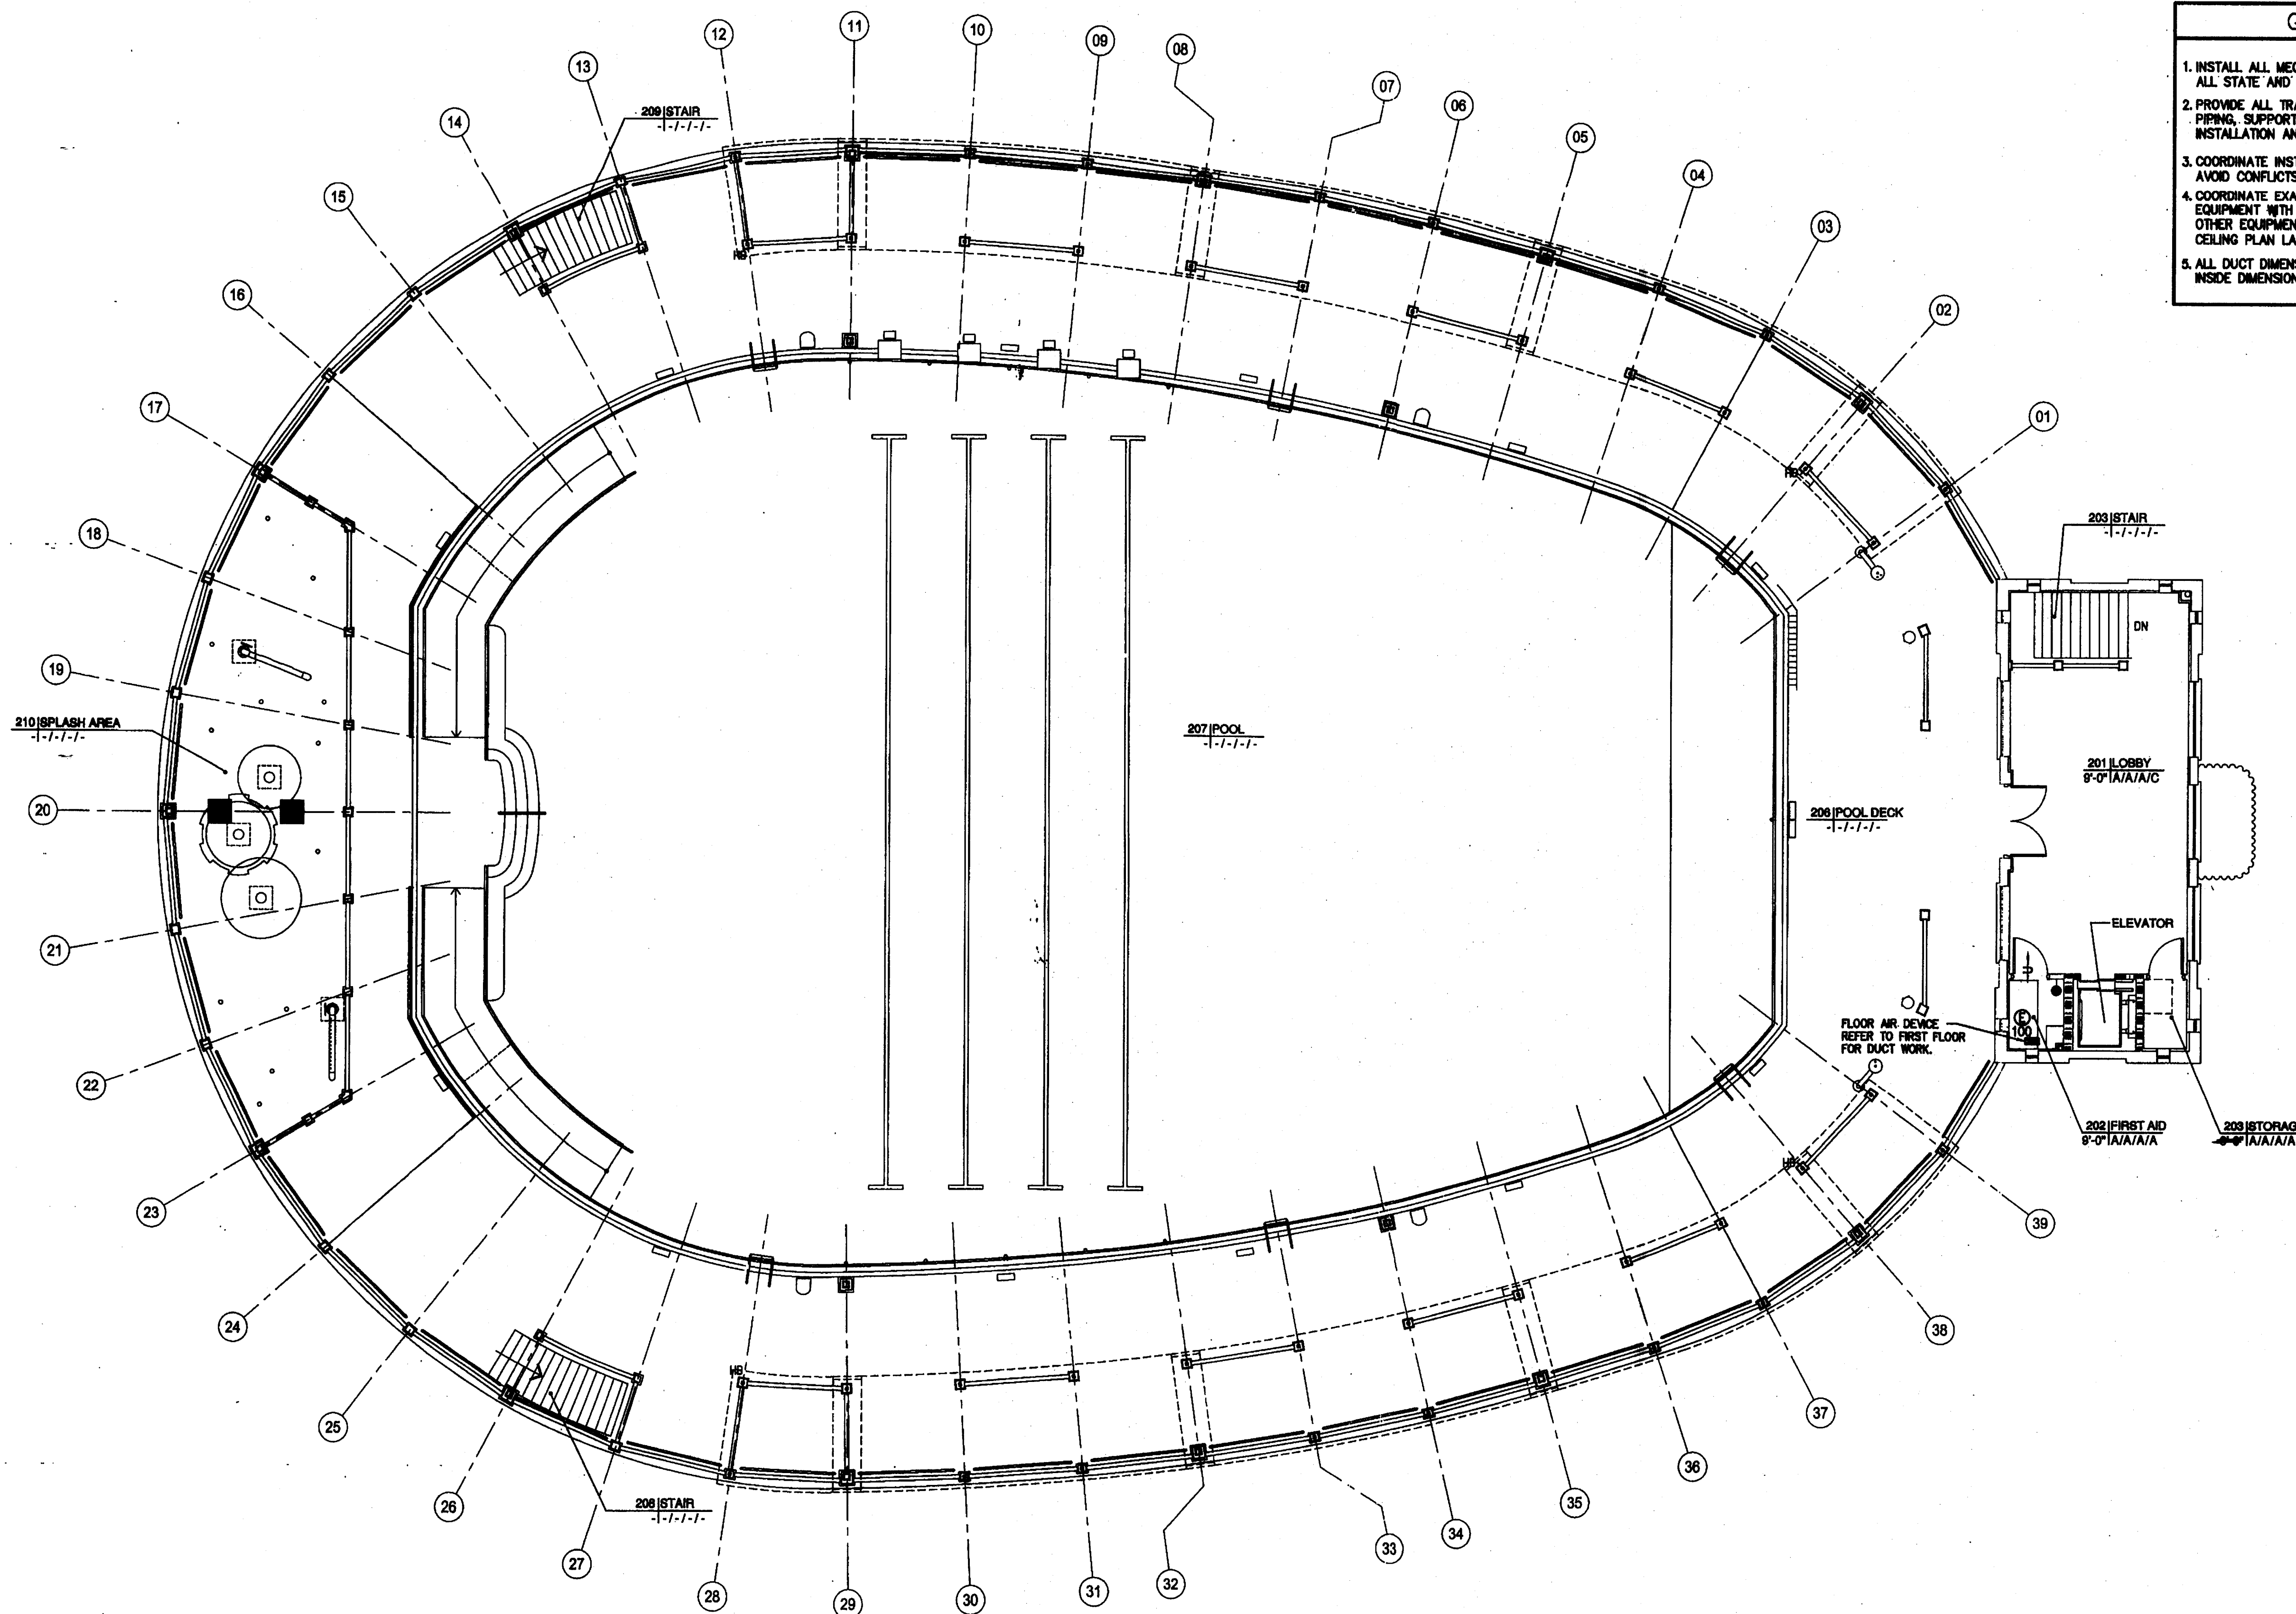

CUSCADEN POOL RENOVATION

CITY OF TAMPA
306 East Jackson Street
Tampa, Florida 33602

Project No. 0202.00

Distribution	Date
BID DOCUMENTS	02.02.04

Second Floor Pool Deck - Mechanical


RECORD
DATE 2/26

PROJECT NORTH
TRUE NORTH
RECEIVED
FEB 23 2004


Second Floor Pool Deck - Mechanical

1/8"=1'-0"

M202

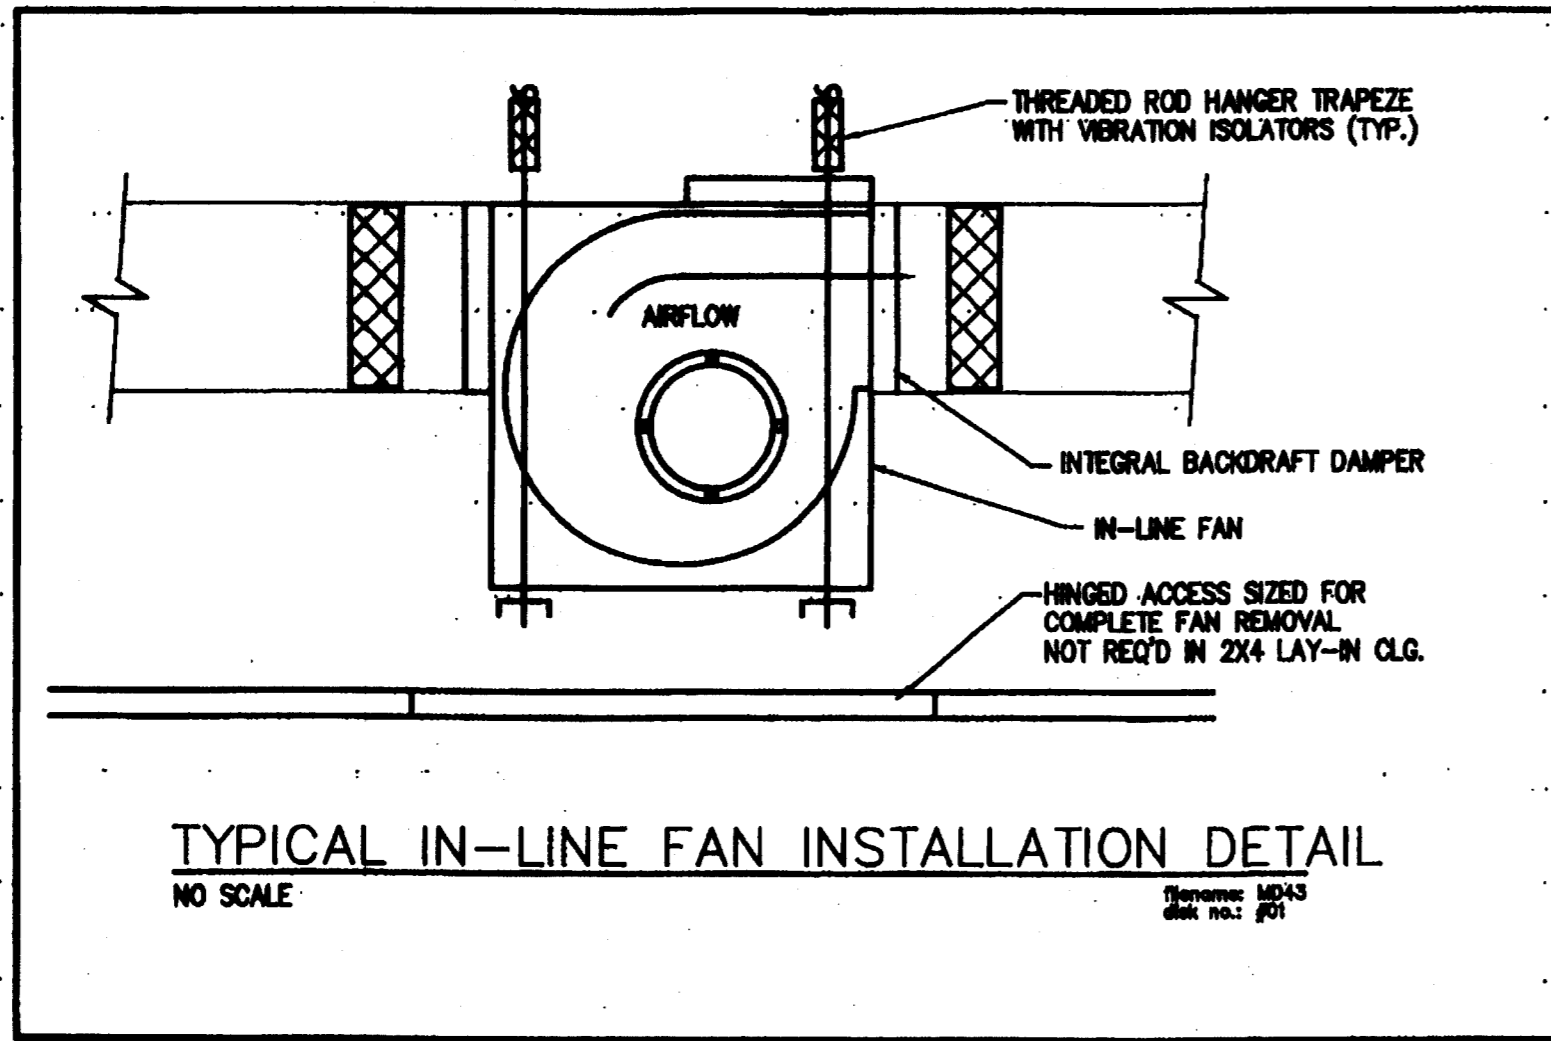


TYPICAL IN-LINE FAN INSTALLATION DETAIL
NO SCALE




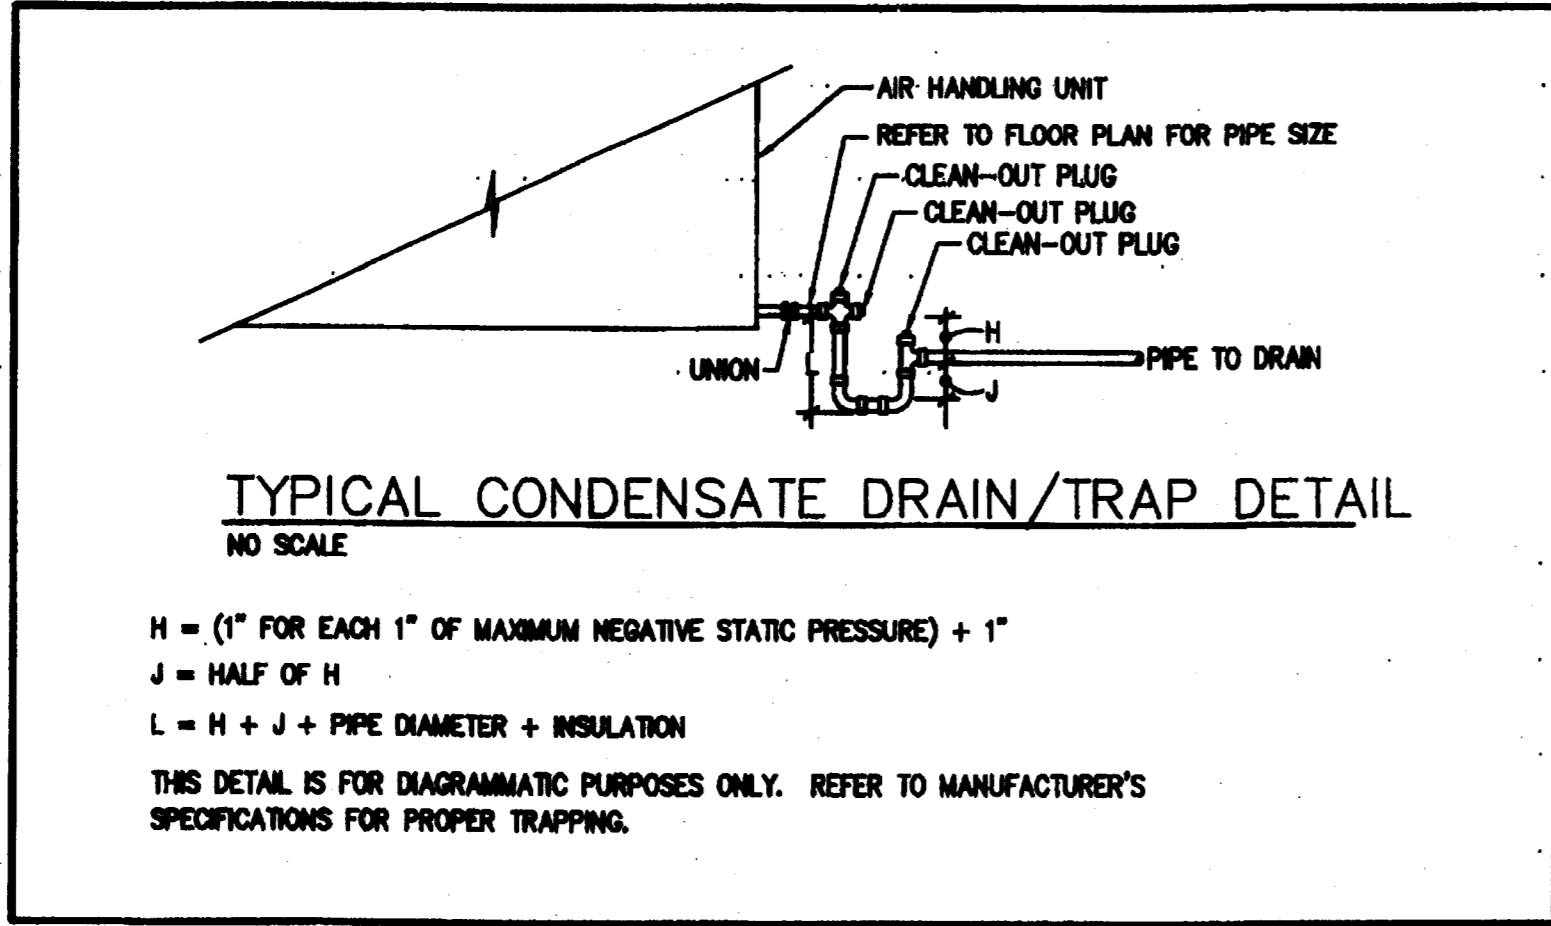


TYPICAL CONDENSATE DRAIN/TRAP DETAIL
NO SCALE


$H = (1" \text{ FOR EACH } 1" \text{ OF MAXIMUM NEGATIVE STATIC PRESSURE}) + 1"$
 $J = \text{HALF OF } H$
 $L = H + J + \text{PIPE DIAMETER} + \text{INSULATION}$
 THIS DETAIL IS FOR DIAGRAMMATIC PURPOSES ONLY. REFER TO MANUFACTURER'S SPECIFICATIONS FOR PROPER TRAPPING.

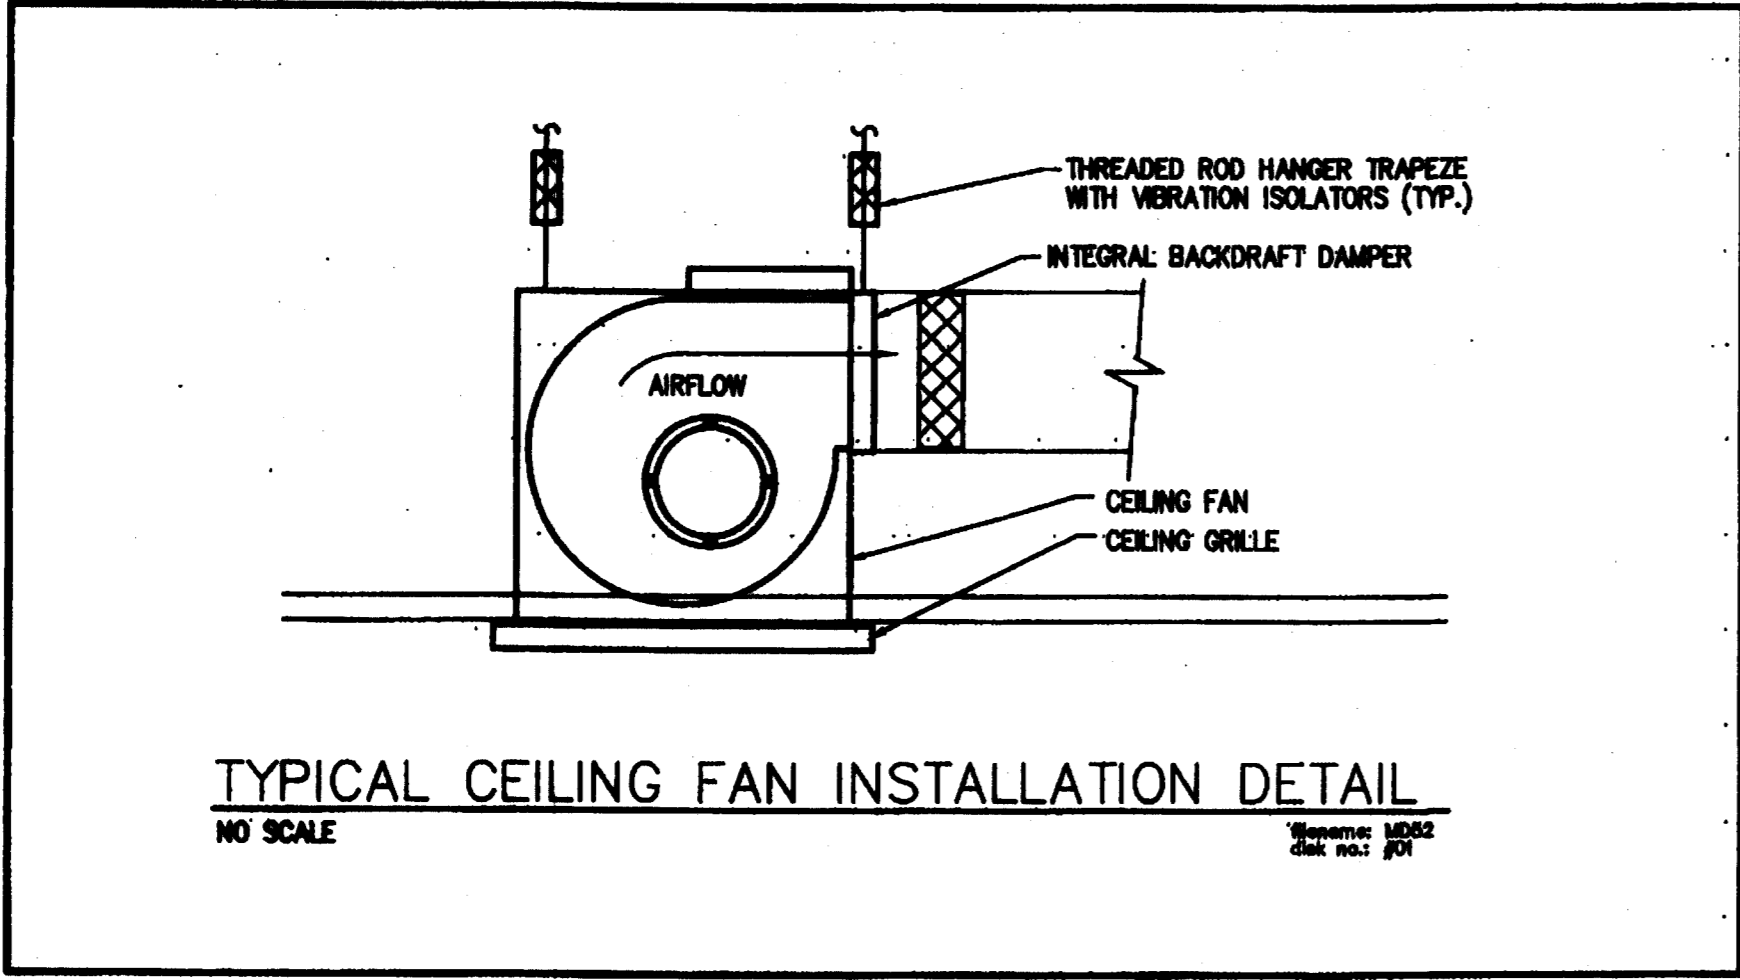


TYPICAL CEILING FAN INSTALLATION DETAIL
NO SCALE

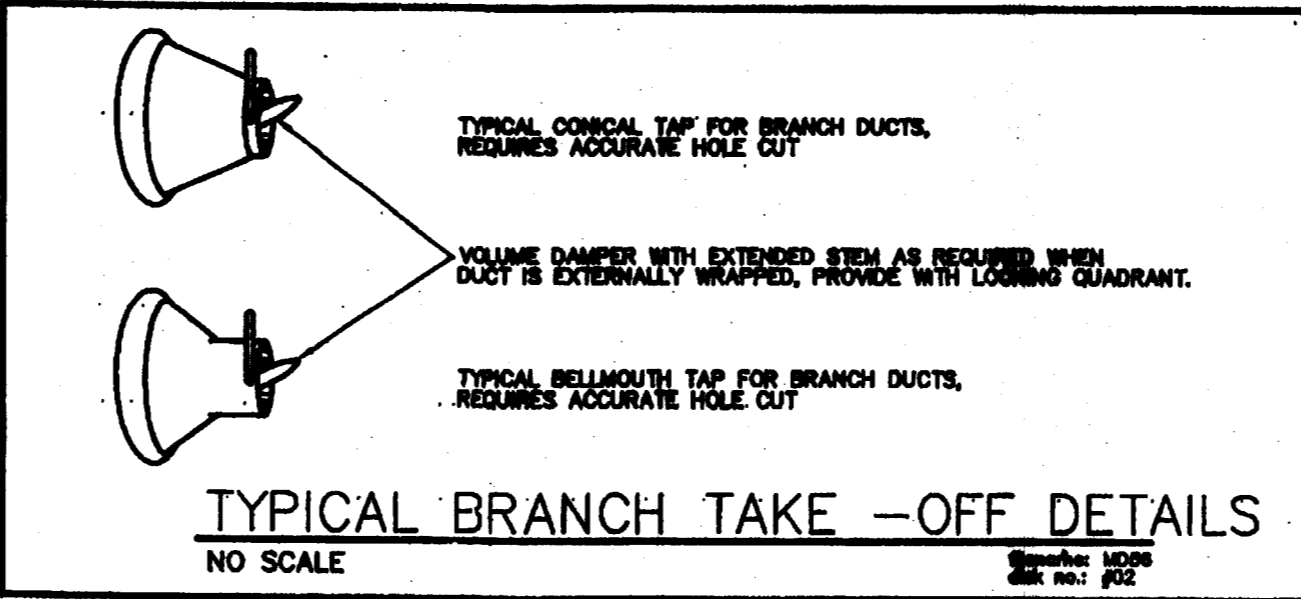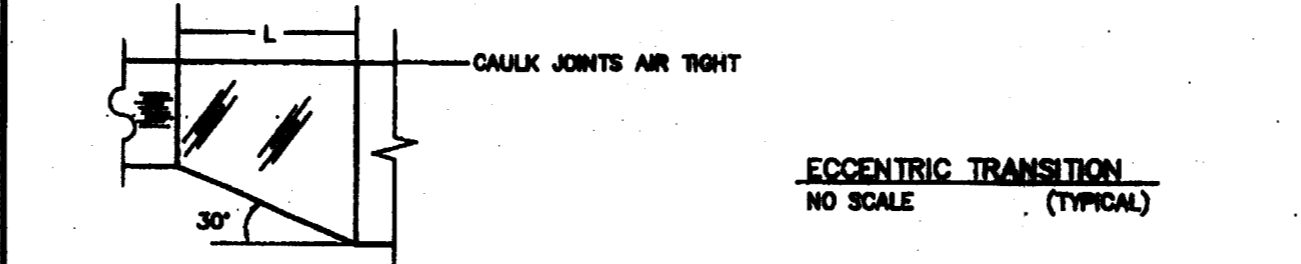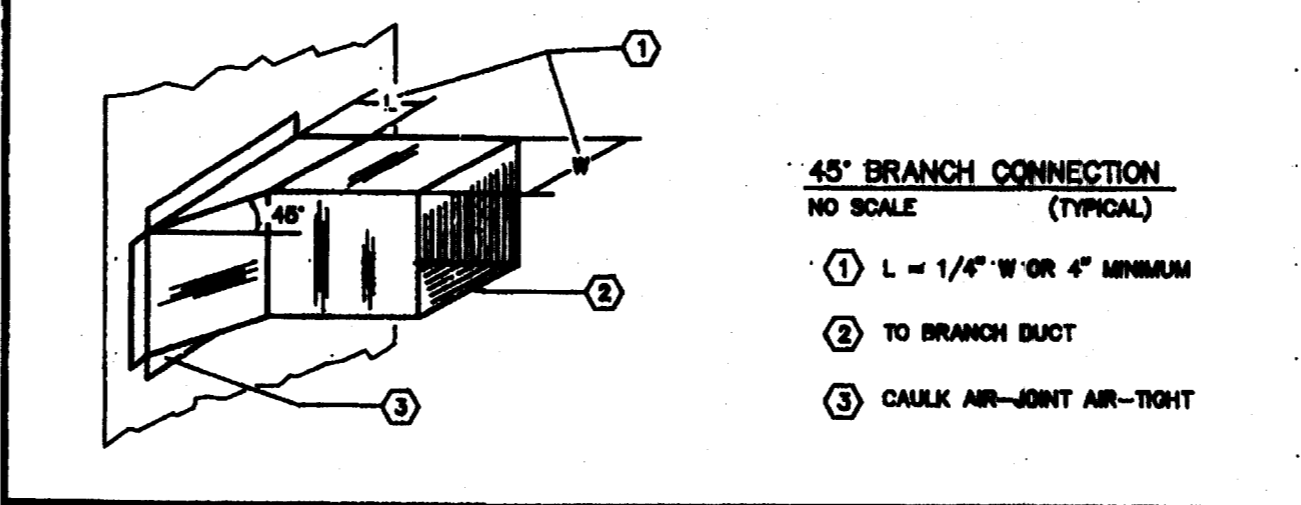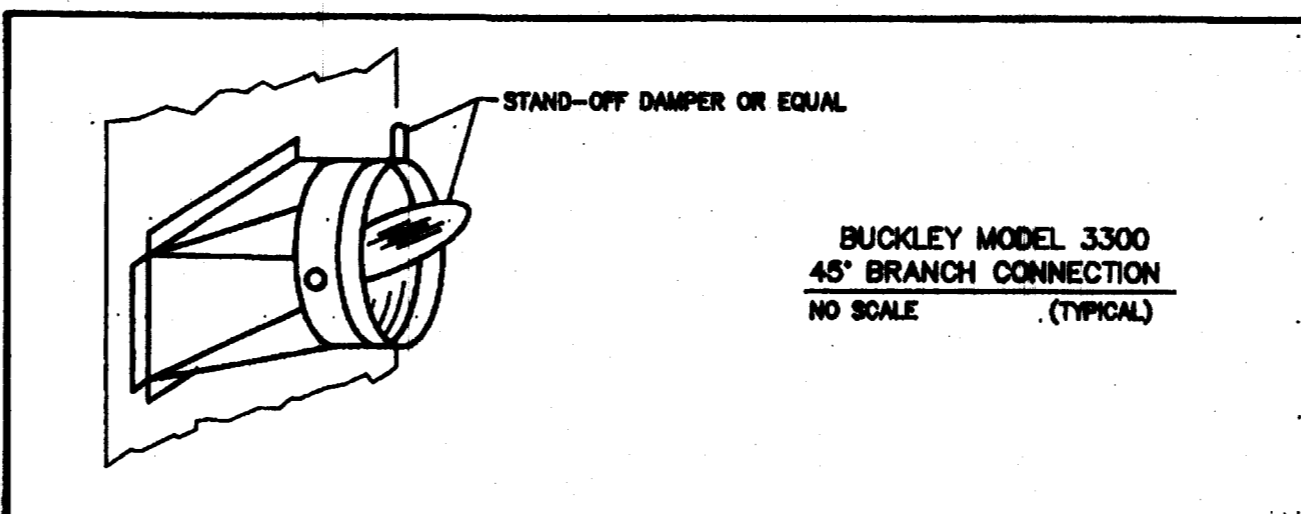

TYPICAL BRANCH TAKE-OFF DETAILS
NO SCALE

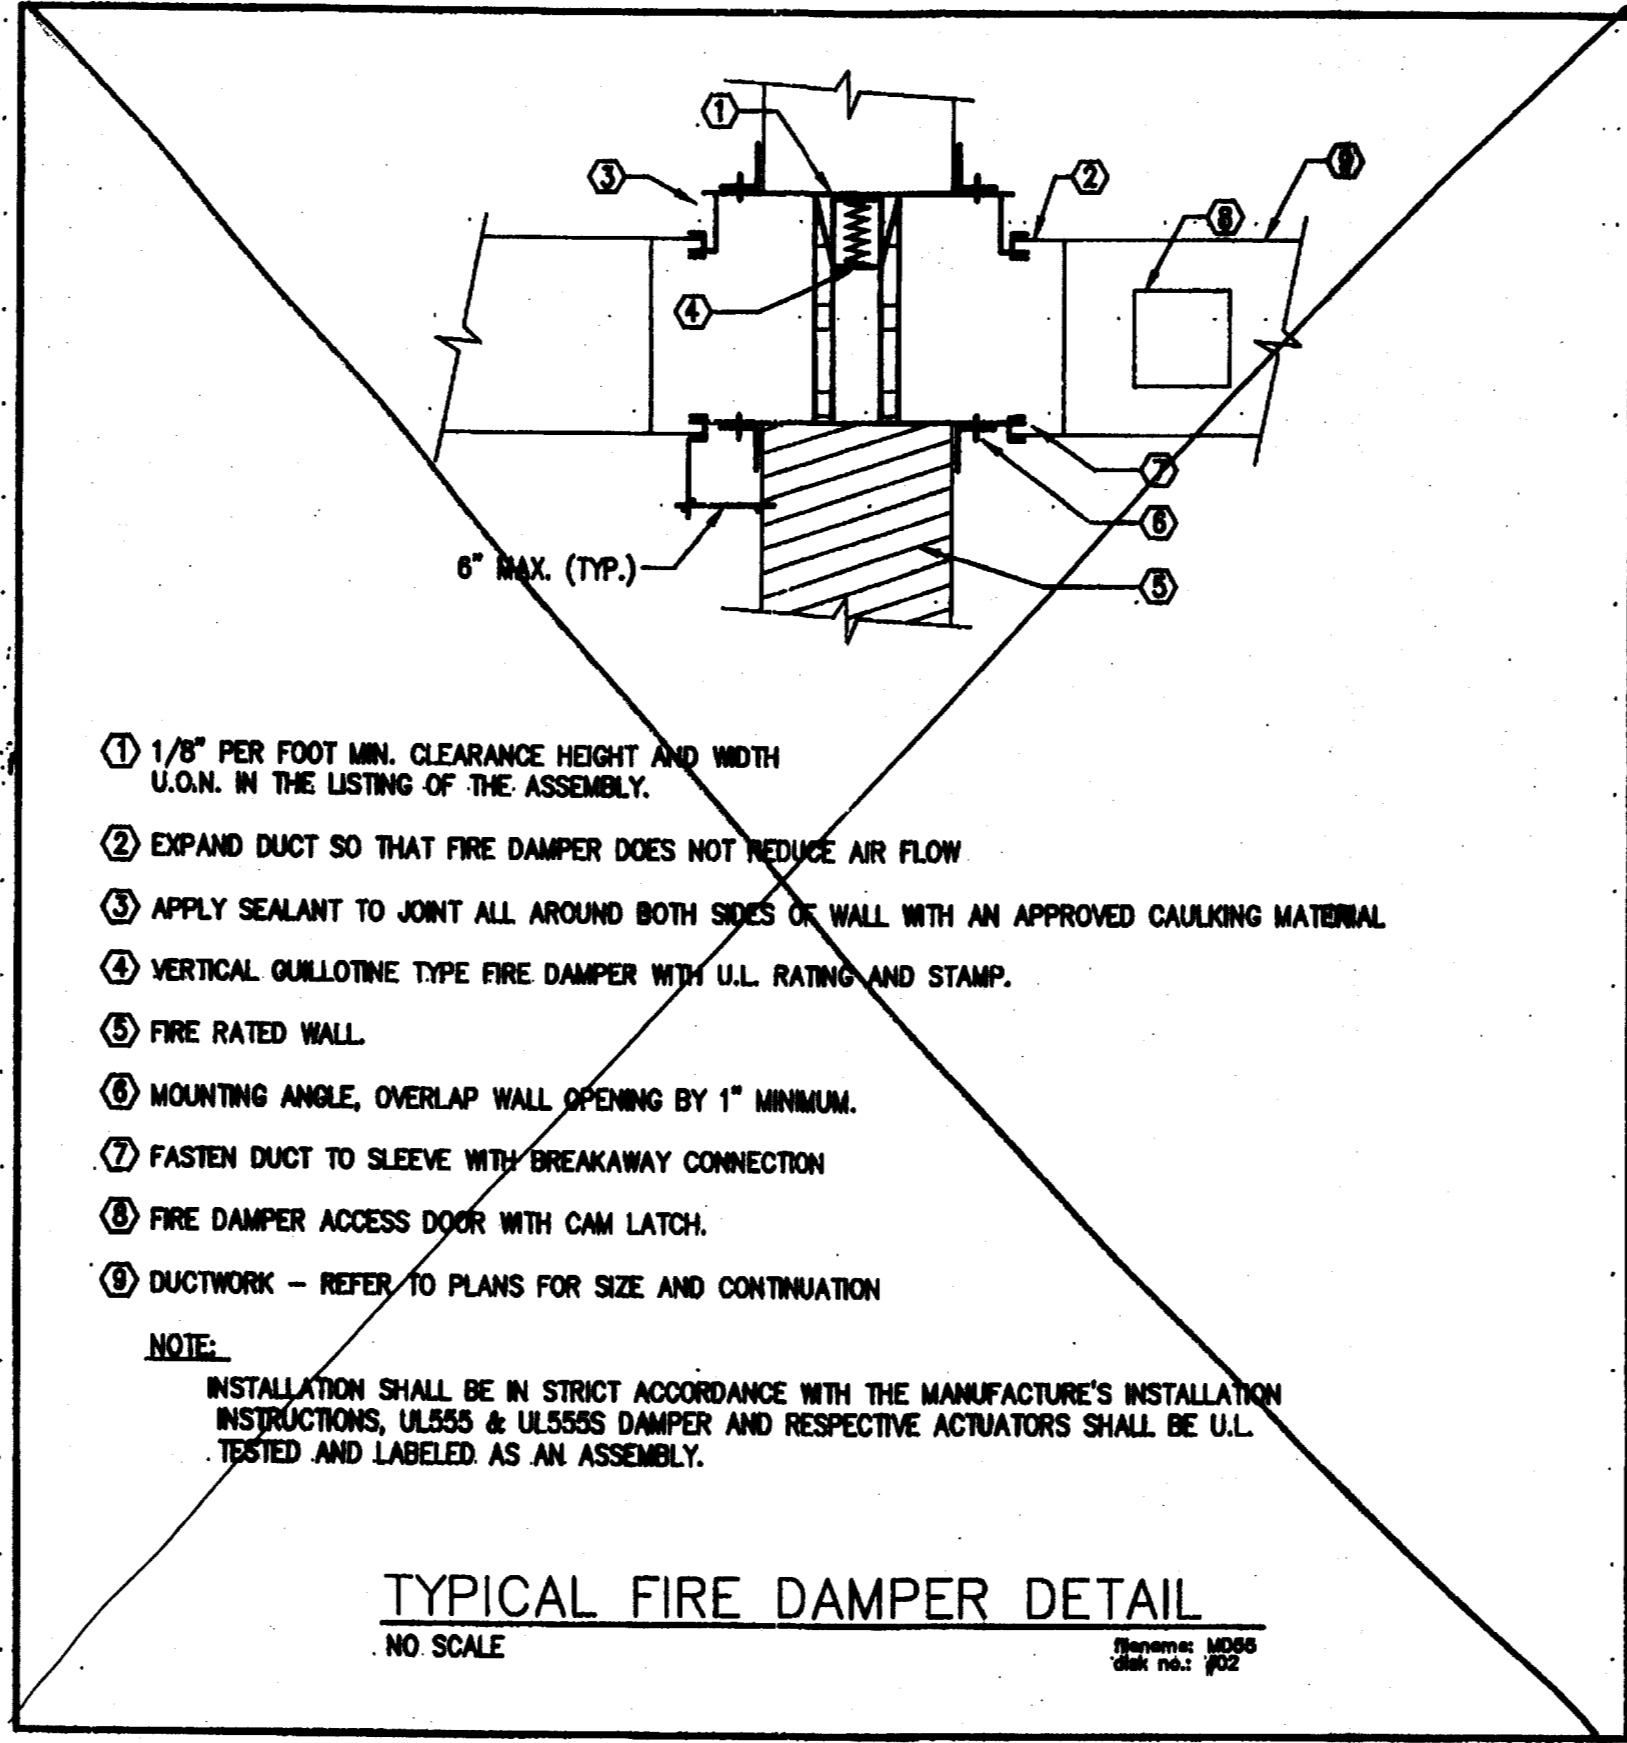


TYPICAL FIRE DAMPER DETAIL
NO SCALE

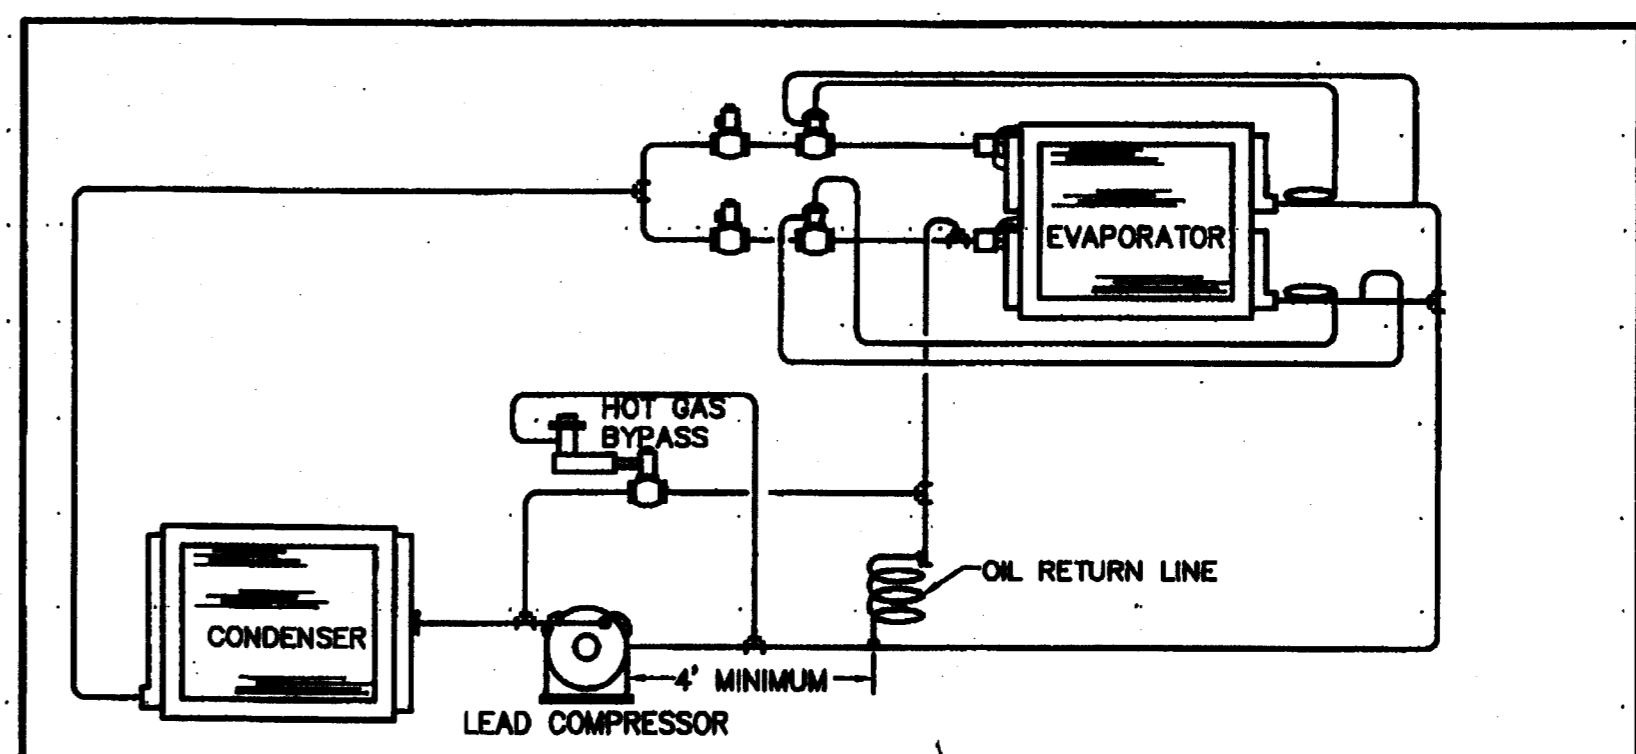


HOT GAS BYPASS TO EVAPORATOR INLET DETAIL
NO SCALE

- NOTES:**
- INSULATE THE FULL LENGTH OF THE HOT GAS BYPASS LINE.
 - THE BYPASS LINE MUST BE ROUTED IN A MANNER THAT WILL NOT PERMIT OIL TRAPPING.
 - HOT GAS LINE SHALL BE A MAXIMUM OF 35 FEET IN LENGTH. RUNS OF OVER 35 FEET SHALL BE INSTALLED IN ACCORDANCE WITH MANUFACTURER'S INSTRUCTIONS.
 - SIZE ALL REFRIGERANT LINES PER MANUFACTURER'S RECOMMENDED SIZES.

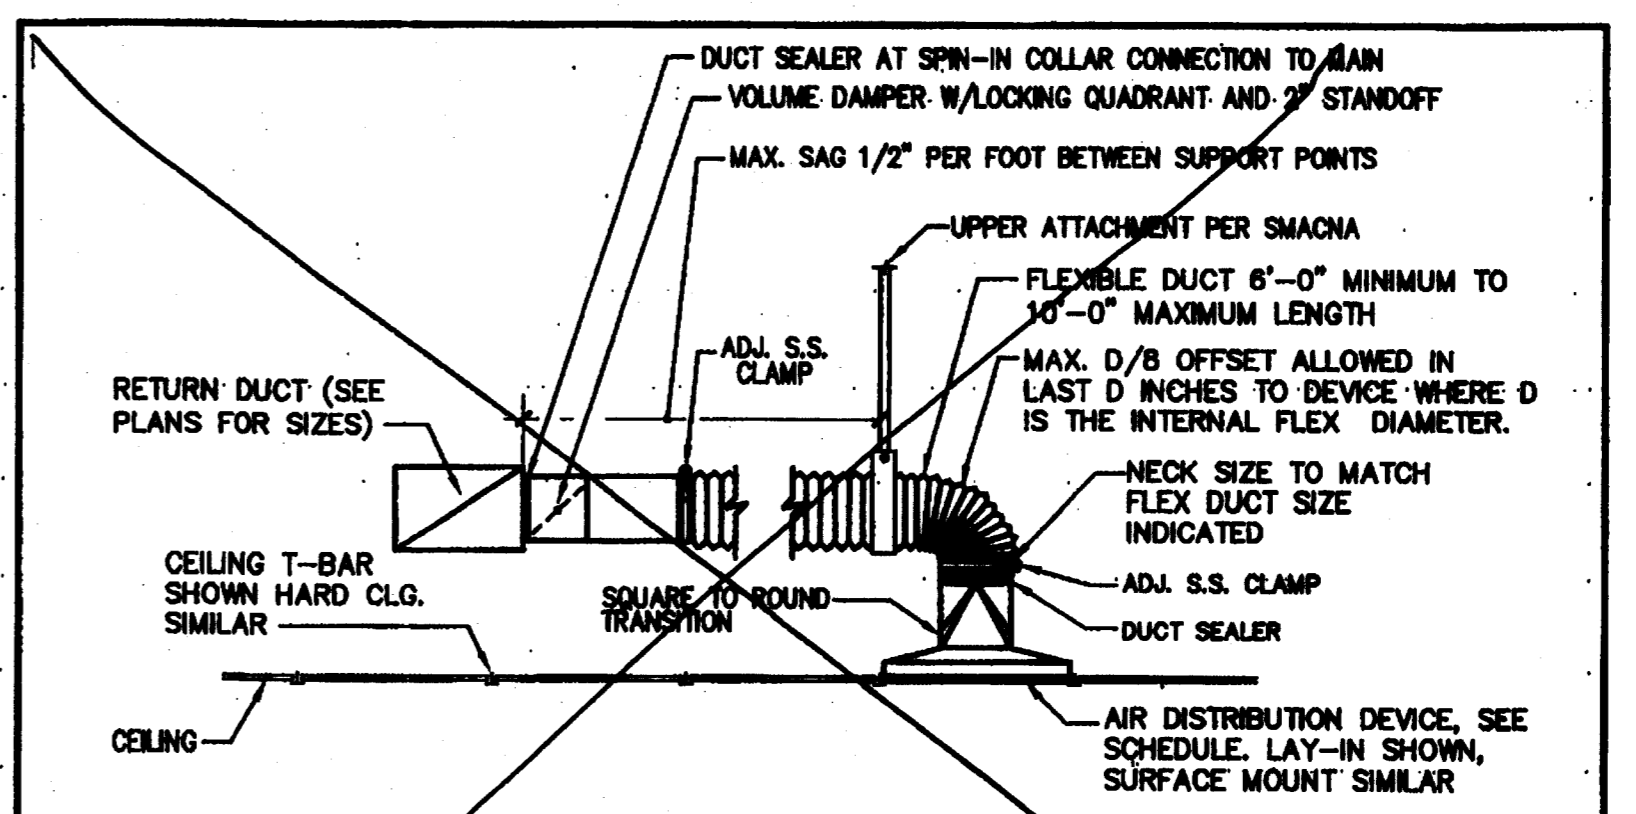

TYPICAL RETURN FLEXIBLE DUCT DETAIL
NO SCALE

- FLEXIBLE DUCT NOTES:**
- FLEXIBLE DUCTS SHALL BE ONE-PIECE AND SHALL NOT BE SPLICED TOGETHER.
 - EXTEND FLEXIBLE DUCT INSULATION TO DUCT/DIFFUSER PANEL INSULATION AND SEAL WITH MASTIC.
 - MIN. 1" WIDE 22 GALV. STRAP HANGER WITH HEMMED EDGES PER SMACNA FIGURE 3-10.
 - FLEXIBLE AIR DUCT SHALL BE FULLY EXTENDED AND NOT COMPRESSED WITH ELBOW RADIUS NO LESS THAN $R/D = 1.0$

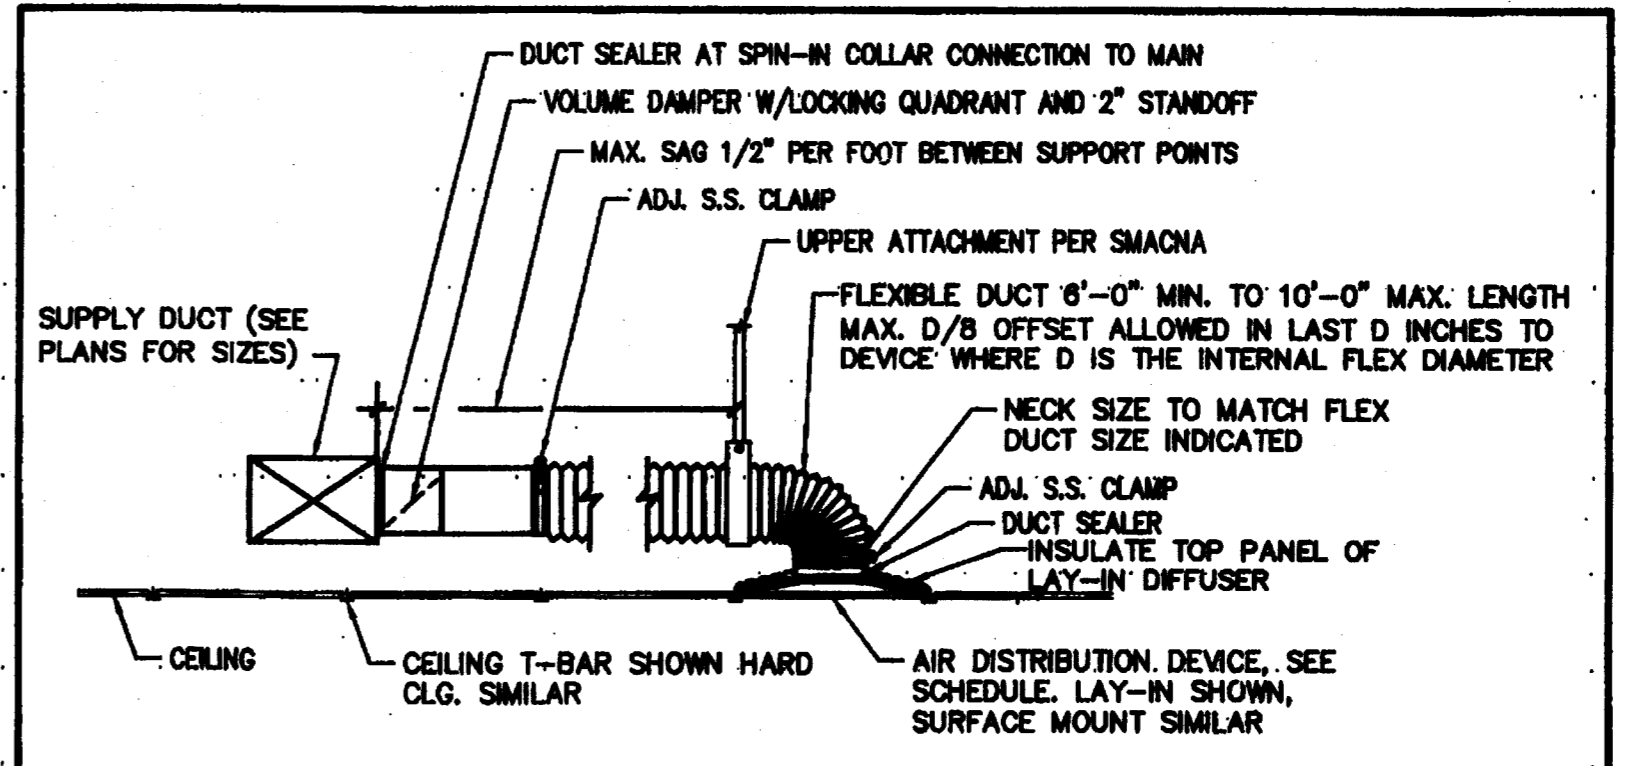


TYPICAL SUPPLY FLEXIBLE DUCT DETAIL
NO SCALE

- FLEXIBLE DUCT NOTES:**
- FLEXIBLE DUCTS SHALL BE ONE-PIECE AND SHALL NOT BE SPLICED TOGETHER.
 - EXTEND FLEXIBLE DUCT INSULATION TO DUCT/DIFFUSER PANEL INSULATION AND SEAL WITH MASTIC.
 - MIN. 1" WIDE 22 GALV. STRAP HANGER WITH HEMMED EDGES PER SMACNA FIGURE 3-10.
 - FLEXIBLE AIR DUCT SHALL BE FULLY EXTENDED AND NOT COMPRESSED WITH ELBOW RADIUS NO LESS THAN $R/D = 1.0$

ROME ARCHITECTS
INCORPORATED
100 Madison Street, Suite 200
Tampa, Florida 33602-4704
www.RomeArchitects.com
Fax: 813.221.8154
813.221.8771
AAC002172

ENGINEERING MATRIX, INC.
CONSULTING ENGINEERS
2800 GORHAM STREET, SUITE 200
TAMPA, FLORIDA 33604
(813) 988-8888 (813) 988-8888 FAX
www.matrixinc.com
DATE OF PREPARATION: 02.02.04

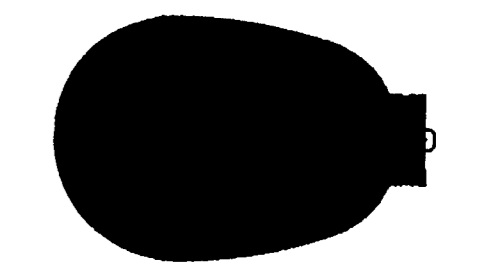

CUSCADEN
POOL
RENOVATION

CITY OF TAMPA
306 East Jackson Street
Tampa, Florida 33602

Project No. 0202.00
Distribution Date
BID DOCUMENTS 02.02.04

Details -
Mechanical






RECORD DWG.
DATE 8/26/05

RECEIVED
FEB 23 2004
CONSTR. TECH. GROUP INC.
2/17/04

M301

Details - Mechanical

None

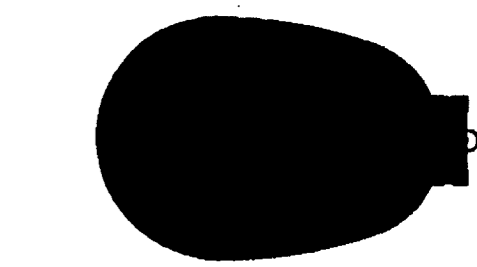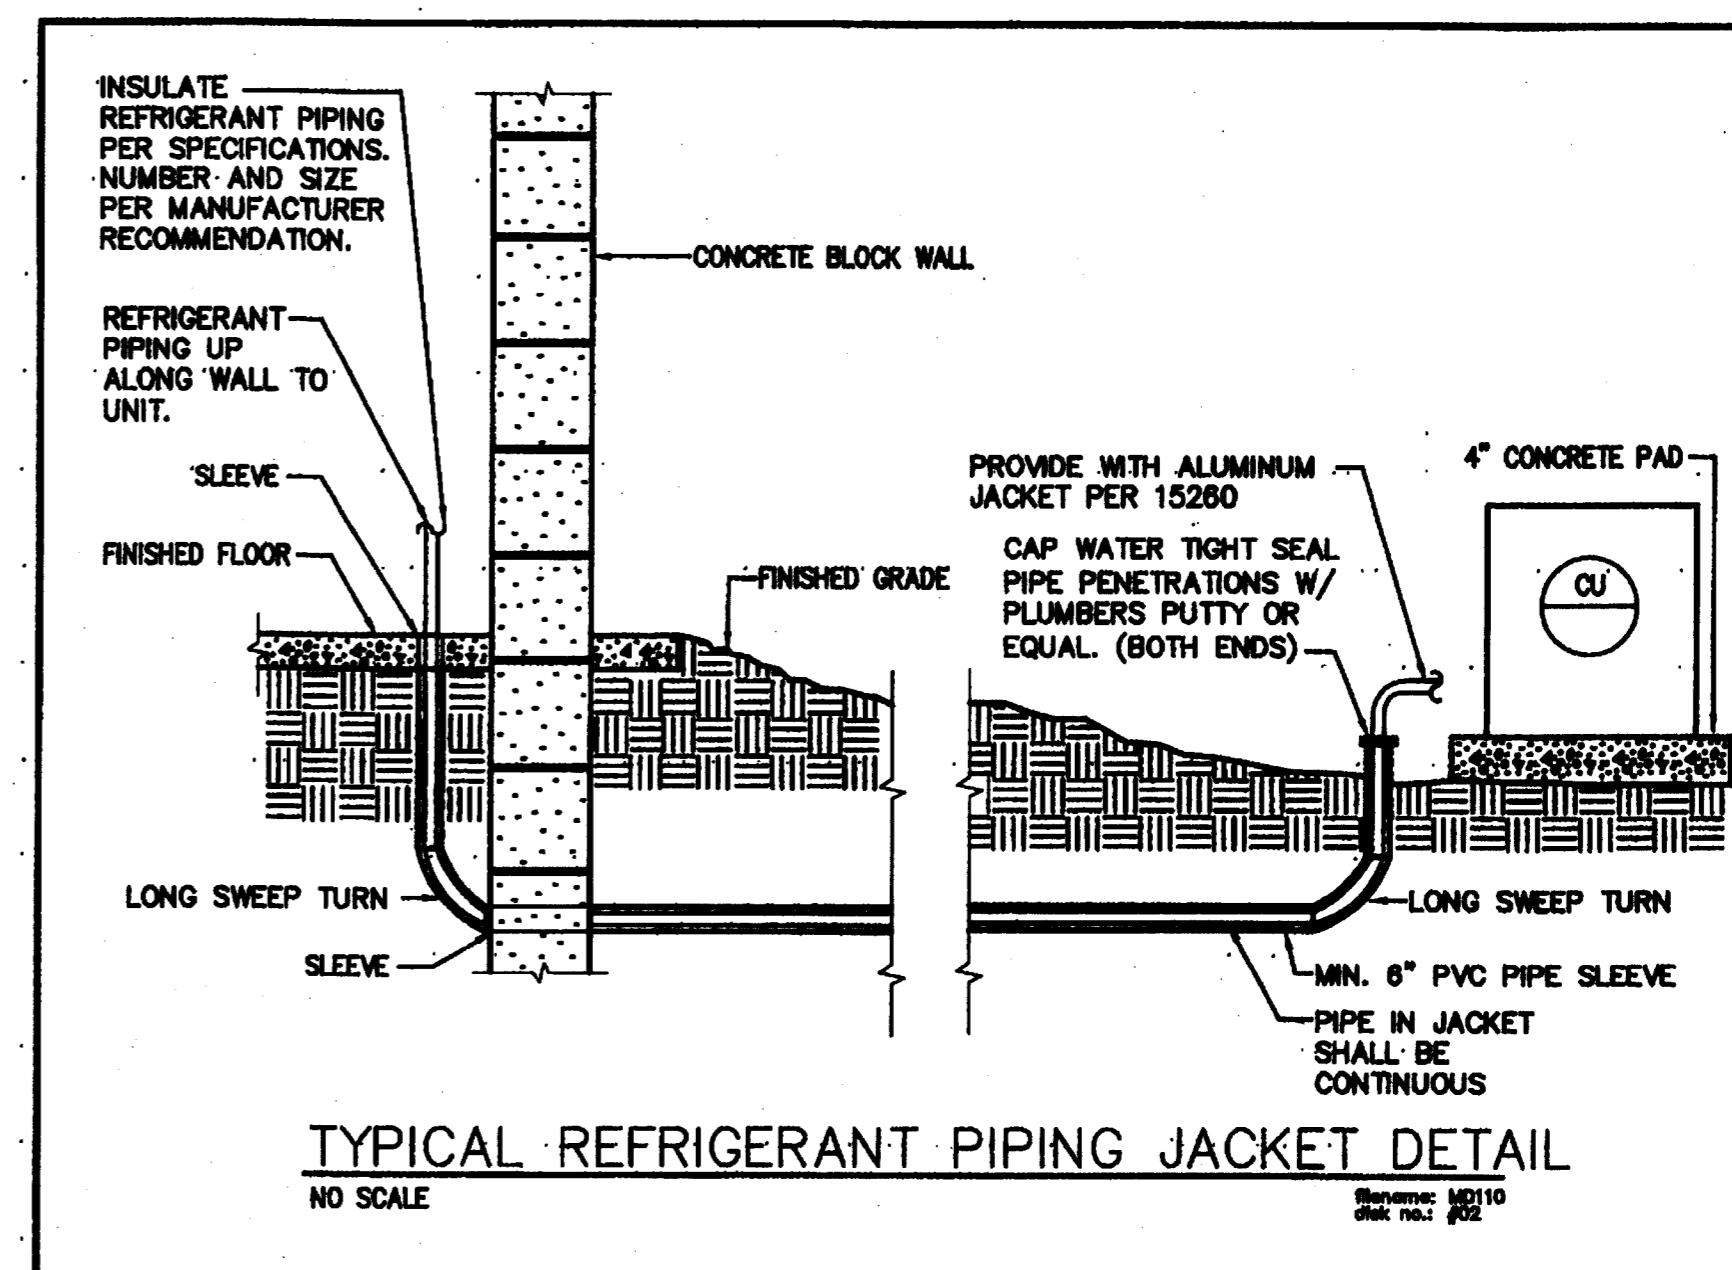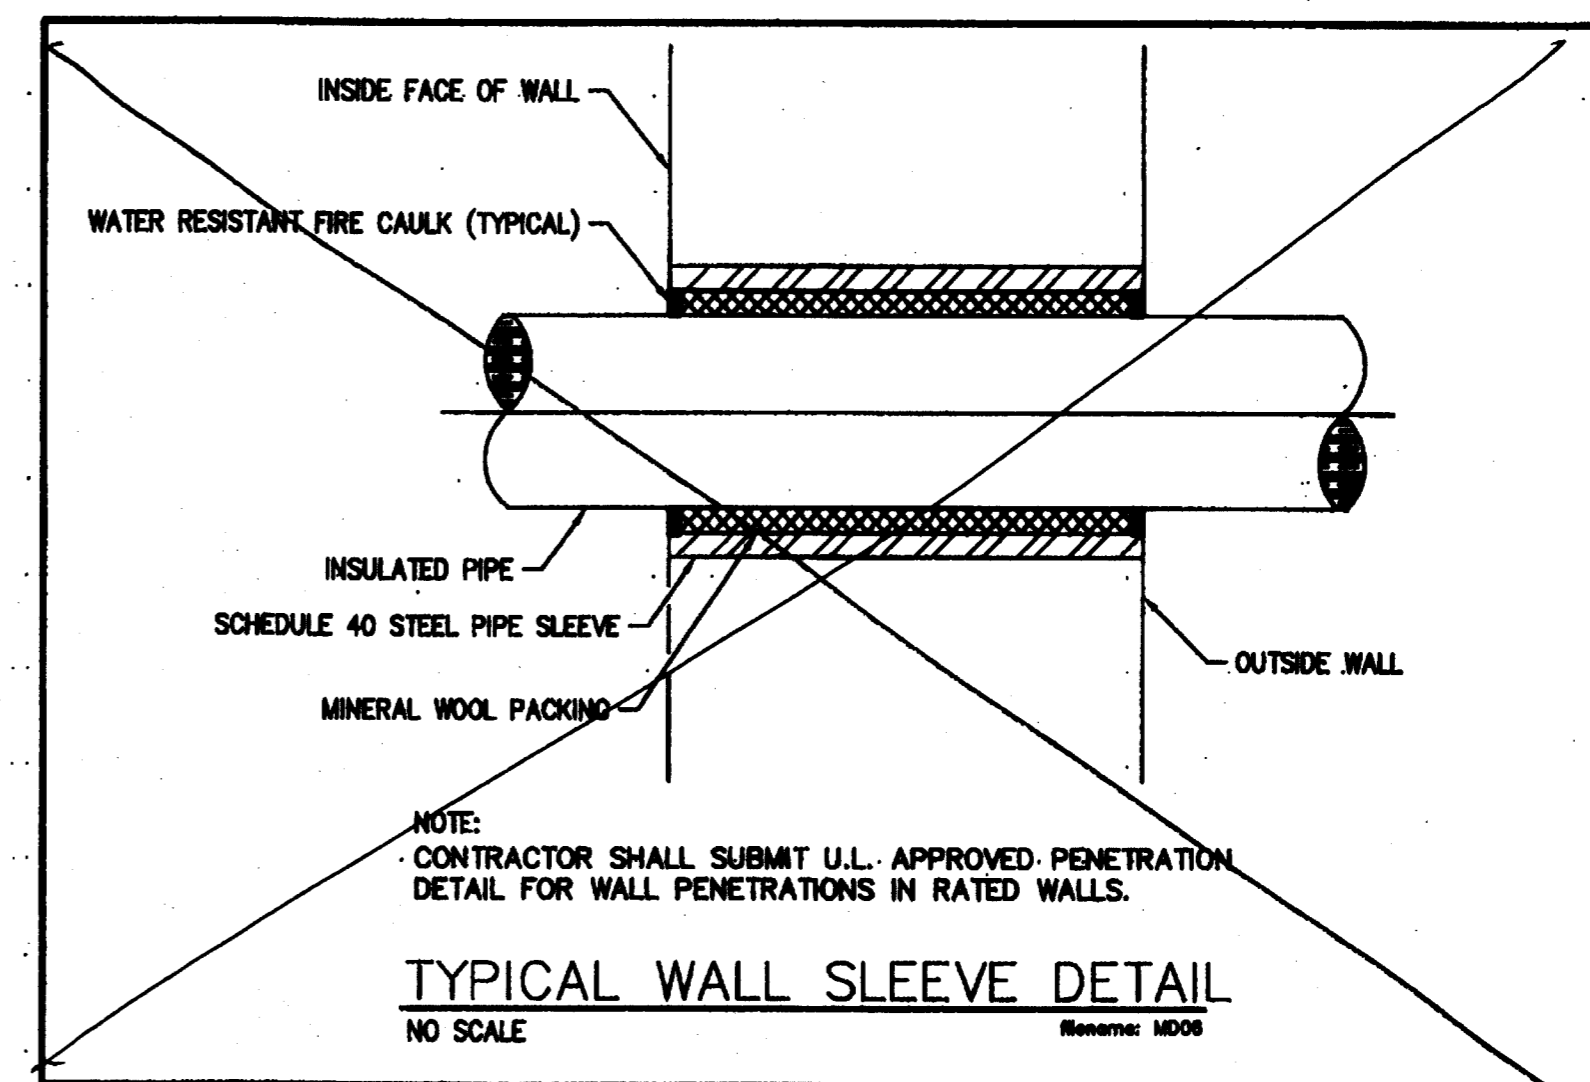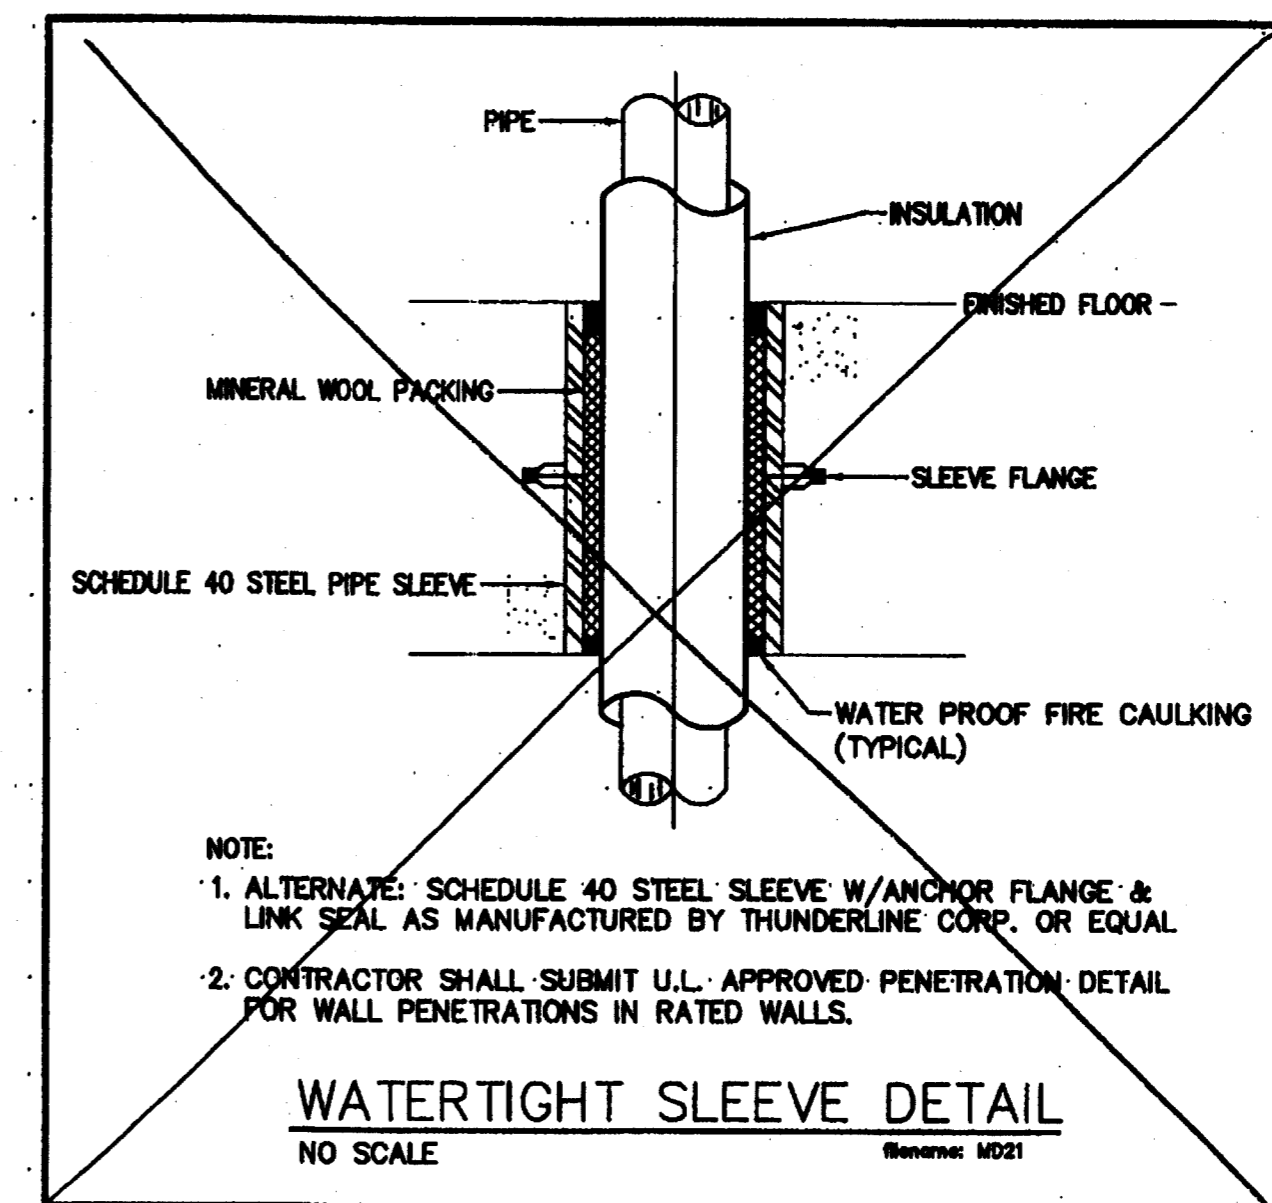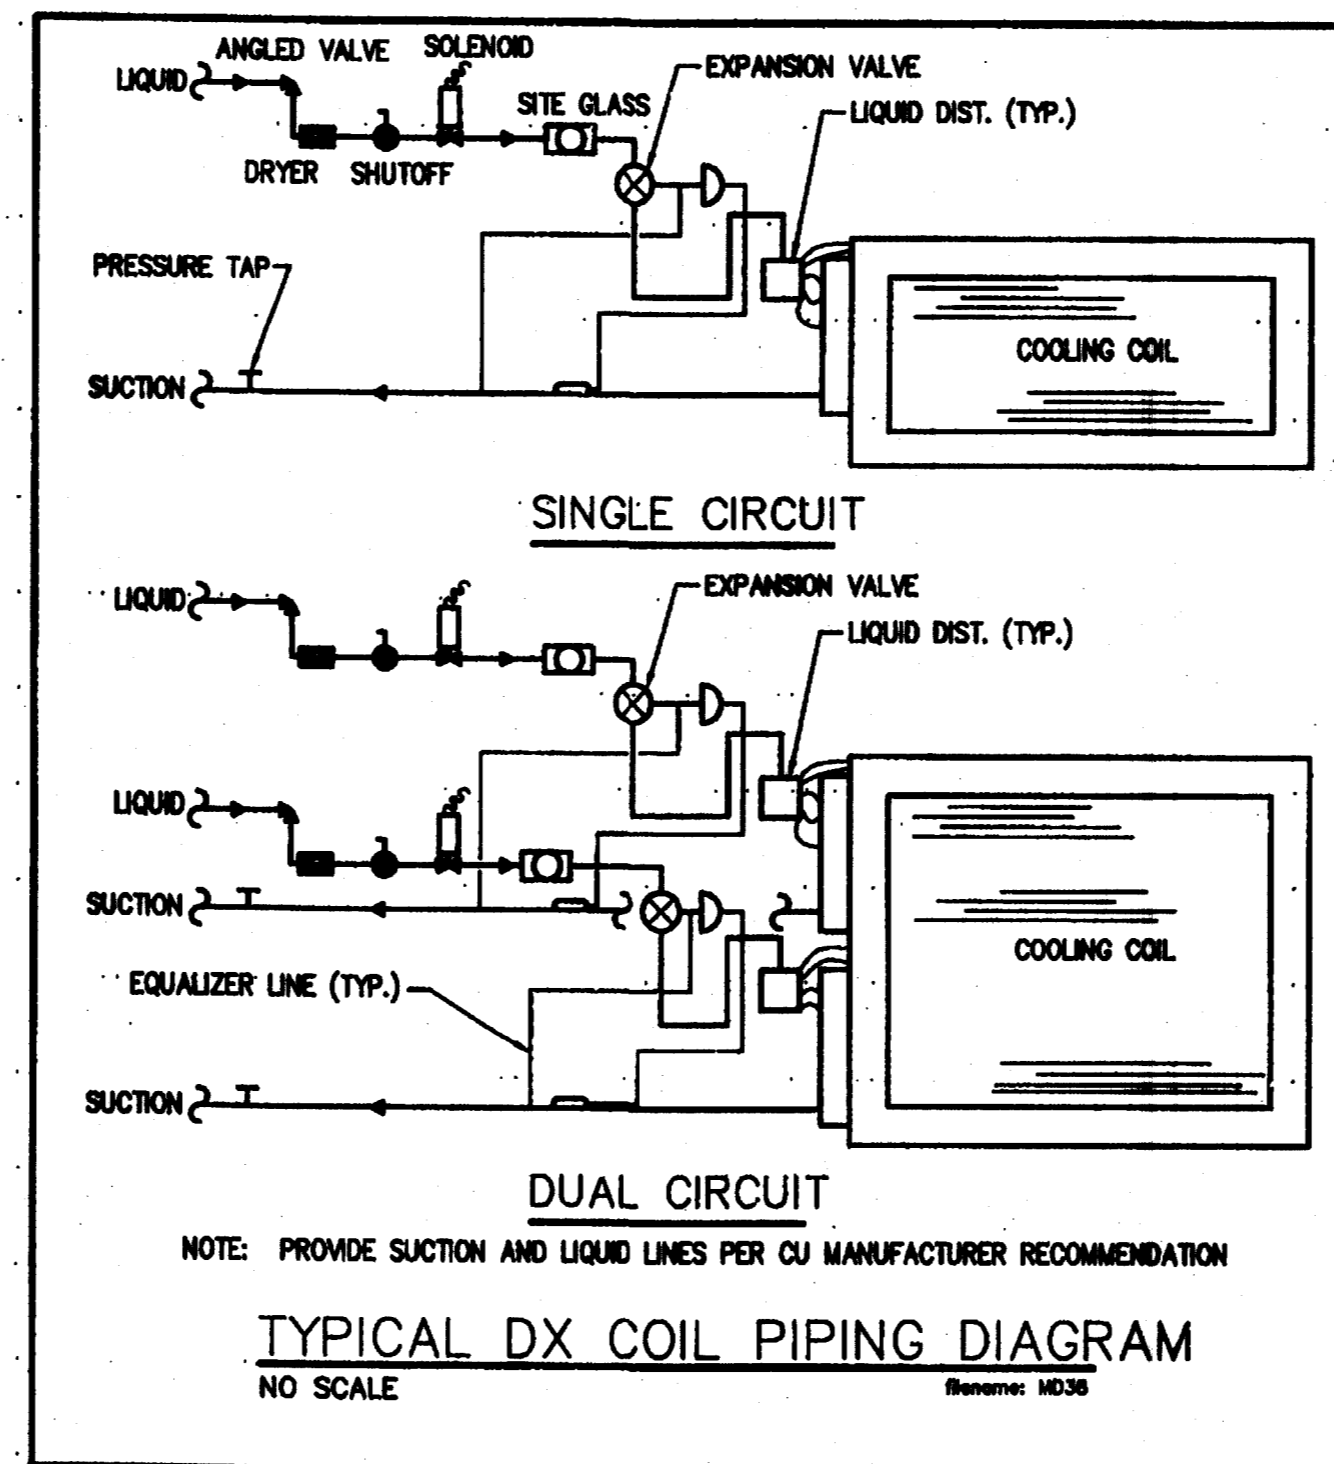

CUSCADEN POOL RENOVATION

CITY OF TAMPA
306 East Jackson Street
Tampa, Florida 33602

Project No. 0202.00

Distribution	Date
BID DOCUMENTS	02.02.04

Details - Mechanical

RECORD DWG
DATE 8/26/03



M302

Details - Mechanical

None

FAN SCHEDULE

MARK		EF 1-1	EF 1-2	EF 1-3	EF 1-5	EF 1-6	EF 1-7	EF 1-8	EF 1-9
MANUFACTURER		GREENHECK	GREENHECK	GREENHECK	GREENHECK	GREENHECK	GREENHECK	GREENHECK	GREENHECK
MODEL NUMBER		CSP-A200	CSP-A1410	SP-A290	CSP-A700	CSP-A250	CSP-A200	SEI-18-429-84	CSP-B110
SERVICE		EXHAUST	EXHAUST	EXHAUST	EXHAUST	EXHAUST	EXHAUST	EXHAUST	EXHAUST
AIR QUANTITY	CFM	50	700	135	350	100	50	1590	70
EXT. STATIC PRESSURE	IN H ₂ O	.42	.52	.4	.47	.46	.44	.1	.4
FAN TYPE		FC	FC	FC	FC	FC	FC	PROP	FC
DRIVE TYPE		DIRECT	DIRECT	DIRECT	DIRECT	DIRECT	DIRECT	DIRECT	DIRECT
MAXIMUM GENERATED NOISE	SONES	.2	3.6	2	.9	1	.3	3.9	.2
MAXIMUM FAN SPEED	RPM	900	1480	829	785	1000	900	1180	727
MOTOR SIZE		48 W	822 W	81 W	350 W	83 W	48 W	1/4 HP	80 W
CONTROLS		INTERLOCK W/ AH-1	INTERLOCK W/ AH-2	INTERLOCK W/ AH-2	INTERLOCK W/ AH-2	INTERLOCK W/ AH-3	INTERLOCK W/ AH-3	INTERLOCK W/ THERMOSTAT	INTERLOCK W/ AH-2
LOCATION		ABOVE CEILING	ABOVE CEILING	ABOVE CEILING	ABOVE CEILING	ABOVE CEILING	ABOVE CEILING	MOUNTED IN WALL	ABOVE CEILING
ELECTRICAL CHARACTERISTICS	V/Φ/HZ	115/1/60	115/1/60	115/1/60	115/1/60	115/1/60	115/1/60	115/1/60	115/1/60
NOTES		①②③④	①②③④	①②③④	①②③④	①②③④	①②③④	①②③④⑤	①②③④

NOTE:

- PROVIDE FLEXIBLE CONNECTORS AT ALL DUCT CONNECTIONS TO FAN.
- PROVIDE FAN WITH GRAVITY BACKDRAFT DAMPER. REFER TO STANDARD MECHANICAL DETAILS FOR FURTHER DETAILS.
- PROVIDE WITH FACTORY MOUNTED DISCONNECT SWITCH.
- PROVIDE FAN WITH SPEED CONTROLLER. MOUNT SPEED CONTROLLER IN 2X4 METALLIC BOX ADJACENT TO FAN IN CEILING. TEST AND BALANCE CONTRACTORS SHALL ADJUST FAN PERFORMANCE THROUGH USE OF SPEED CONTROLLER.
- PROVIDE WITH CHLORINE RESISTANT FINISH, AND OSHA GUARD.

SPLIT SYSTEM A/C SCHEDULE

AIR HANDLING UNIT DATA				
MARK		AH-1	AH-2	AH-3
MANUFACTURER		TRANE	TRANE	TRANE
MODEL		TWE090A3	TME120B3	TWE090A
TOTAL COOLING CAPACITY	MBH	83.02	120.0	105.2
SENSIBLE CAPACITY	MBH	48.28	64.01	69.3
SUPPLY AIR QUANTITY	CFM	2800	4200	2460
OUTSIDE AIR QUANTITY	CFM	410	1060	490
MOTOR SIZE	HP	2	3	2
ELECTRICAL	V/Φ/HZ	208/3/60	208/3/60	208/3/60
E.E.R.		11.8	11.5	-
ENTERING AIR TEMP. DB/WB	F / F	70.25/83.3	68.8/84.6	79.8/87.0
LEAVING AIR TEMP. DB/WB	F / F	53.14/62.35	55.75/65.24	64.8/53.1
EXT. STATIC PRESSURE	IN. W.C.	1.5	1.5	1.5
FILTER		1" PLEATED	1" PLEATED	1" PLEATED
WEIGHT		435	485	435
ELECTRIC HEAT	KW	11.25	28.2	18.71
CONDENSING UNIT DATA				
MARK		CU-1	CU-2	CU-3
MANUFACTURER		TRANE	TRANE	TRANE
MODEL		TTA090A3	TTA120B3	TTA120C
OUTDOOR TEMPERATURE	F	95	95	95
ELECTRICAL CHARACTERISTICS	V/Φ/HZ	208/3/60	208/3/60	208/3/60
MIN. CKT. AMPS		34.5	47.8	48.4
NOTES		①②	①②	①

Filename: sch-28

KEYED NOTE:

- PROVIDE WITH NECESSARY CONTROLS TO CONNECT TO MAIN BUILDING MANAGEMENT SYSTEM; AUTO CHANGEOVER TO COOLING MODE; REMOTE THERMOSTAT SETPOINT; ROOM TEMPERATURE SENSOR.
- PROVIDE HOT GAS BYPASS ON THE LEAD COMPRESSOR.

VENTILATION SCHEDULE

UNIT NUMBER	NUMBER OF PEOPLE	CFM/PERSON	TOTAL	EXHAUST AIR	PRESSURIZATION	TOTAL	TOTAL DESIGN VALUE
AH-1	12	20	240	170	240	410	410
AH-2	2	20	40	770	290	1060	1060
AH-3	32	15	480	315	175	490	490

Filename: sch37

PRESSURE TABLE

UNIT NUMBER	VENTILATION AIR	TOTAL EXHAUST	MAKE UP FROM OTHER SYSTEM	RELATIVE PRESSURE
AH-1	410	50	-120	+240
AH-2	1060	485	+285	+290
AH-3	480	150	-185	+175

AIR DEVICE SCHEDULE

MARK	FACE SIZE	NECK SIZE	MATERIAL	ACCESSORIES	FINISH	MANUFACTURER AND MODEL	NOTES
A	24X24	6"	ALUMINUM	-	-	TITUS-TMS	①②
B	24X24	6"	ALUMINUM	-	-	TITUS-TMS	①②
C	24X24	10"	ALUMINUM	-	-	TITUS-TMS	①②
D	24X24	12"	ALUMINUM	-	-	TITUS-TMS	①②
E	14X8	12X4	ALUMINUM	⑥	-	TITUS-CT-PP-0	⑤
F	12X12	10X10	ALUMINUM	-	-	TITUS-TDC-AA	①②
G	10X10	8X8	ALUMINUM	O.B.D. AG-15-AA	-	TITUS-300FL	②
H	14X10	12X8	ALUMINUM	O.B.D. AG-15-AA	-	TITUS-300FL	②
I	20X8	18X8	ALUMINUM	O.B.D. AG-15-AA	-	TITUS-300FL	②
J	14X8	12X8	ALUMINUM	O.B.D. AG-15-AA	-	TITUS-300FL	②
L	24X24	22X22	ALUMINUM	-	-	TITUS-50F	③④⑤
M	12X12	10X10	ALUMINUM	-	-	TITUS-50F	③④⑤
N	20X12	18X10	ALUMINUM	O.B.D. AG-15-AA	-	TITUS-350FL	②④
P	28X14	24X12	ALUMINUM	O.B.D. AG-15-AA	-	TITUS-350FL	②④
Q	36X16	32X14	ALUMINUM	-	-	TITUS-350FL	②④
R	20X14	18X12	ALUMINUM	O.B.D. AG-15-AA	-	TITUS-350FL	②④
S	44X38	42X36	ALUMINUM	-	-	TITUS-350FL	②④
U	48"X15L0T	8"	ALUMINUM	MP-39-LP MITER CORNER	-	TITUS-ML-39	②④⑤
W	38X8	36X8	ALUMINUM	-	-	TITUS-350FL	④
X	24X12	22X10	ALUMINUM	-	-	TITUS-50F	④⑤

KEY NOTES:

- FLEX DUCT SIZE TO MATCH NECK SIZE. MINIMUM LENGTH OF FLEX SHALL BE 6'-0" TO MAXIMUM LENGTH OF 10'-0". BALANCE OF DUCT SHOWN ON PLAN SHALL BE RIGID STEEL DUCT SAME SIZE AS NECK SIZE, EXTERNALLY INSULATED.
- PROVIDE RUNOUT BRANCH DUCT TO AIR DEVICE SAME SIZE AS AIR DEVICE NECK UNLESS OTHERWISE NOTED ON PLANS. PROVIDE O.B.D MODEL # AG-15-AA FOR AIR DEVICES IN HARD CEILING.
- ALUMINUM 1 X 1 X 1 GRID
- AIR DEVICES USED FOR THE TRANSFER OF AIR DO NOT REQUIRE O.B.D. OR FILTER. PROVIDE O.B.D MODEL # AG-15-AA FOR AIR DEVICES IN HARD CEILING.
- PROVIDE WITH SHEETMETAL PLENUM 12 INCHES DEEP X FACE DIMENSION FOR TRANSITION OF LOUVER TO DUCT.
- HORIZONTAL RUNOUT BRANCH DUCTS SERVING A SINGLE AIR DEVICE WITH 200 CFM OR LESS SHALL BE 8" RIGID STEEL DUCT AND TRANSITION TO 8" FLEX DUCT PRIOR TO AIR DEVICE; 200 TO 600 C.F.M. SHALL BE 12" RIGID STEEL DUCT AND TRANSITION TO 12" FLEX DUCT PRIOR TO AIR DEVICE, UNLESS OTHERWISE NOTED. MINIMUM LENGTH OF FLEX SHALL BE 6'-0" TO MAXIMUM LENGTH OF 10'-0".
- HORIZONTAL RUNOUT BRANCH DUCT SHALL BE 6" RIGID STEEL DUCT AND TRANSITION TO 6" FLEX PRIOR TO AIR DEVICE. MINIMUM LENGTH OF FLEX SHALL BE 6'-0" TO MAXIMUM LENGTH OF 10'-0".
- PROVIDE FRAME TYPE 5 WITH C2 MOUNTING CONFIGURATION.
- PROVIDE FACTORY SUPPLIED LOW PROFILE PLENUM. WRAP EXTERIOR OF PLENUM WITH TYPE A INSULATION. PROVIDE FILLER PANELS AS INDICATED IN ARCHITECTURAL DRAWINGS. COLOR SHALL BE DETERMINED BY ARCHITECT.

GENERAL NOTES:

- ALL UNITS FOR LAY-IN T-BAR GRILLE SHALL BE PROVIDED WITH TYPE 3 BORDER CEILING MODULE (24X24).
- ALL AIR DEVICES SHALL HAVE PAINTED WHITE FINISH UNLESS COLOR COORDINATED WITH ARCHITECT.
- ALL 24X24 FACE AIR DEVICES INSTALLED IN HARD CEILINGS SHALL BE PROVIDED WITH T-BAR FRAME FOR PLASTER OR GYPSUM CEILINGS.
- PROVIDE SQUARE TO ROUND TRANSITIONS AS REQUIRED FOR COORDINATION OF DUCT AND AIR DEVICE NECK.
- COORDINATE FRAME TYPE WITH LATEST ARCHITECTURAL REFLECTED CEILING PLAN.
- INSULATE THE TOPS OF ALL SUPPLY AIR DEVICES, REFER TO SPECIFICATIONS.
- AIR DEVICES LOCATED IN HARD CEILINGS SHALL BE EQUIPPED WITH AN OPPOSED BLADE DAMPER ADJUSTABLE FROM FACE OF DEVICE.

ROWE ARCHITECTS INCORPORATED

100 Madison Street, Suite 200
Tampa, Florida 33602.4704
www.RoweArchitects.com
Fax: 813.221.9154
813.221.8771
AAC002172

ENGINEERING MATRIX, INC.
CONSULTING ENGINEERS
10000 W. BRADSHAW BLVD., SUITE 100
FORT MYERS, FLORIDA 33919
(813) 938-0000 FAX (813) 938-0000
www.matrixeng.com



CUSCADEN POOL RENOVATION

CITY OF TAMPA
308 East Jackson Street
Tampa, Florida 33602

Project No. 0202.00

Distribution Date
BID DOCUMENTS 02.02.04

Schedules - Mechanical

RECORD DWG.
DATE 2/26/05

RECEIVED
FEB 23 2004
COMM. TECH. GROUP, INC.

M401


217
009

Schedules - Mechanical

None

Bldg./Ftr.	Room No.	Name	System Name	Ref. dwg.	Pt Sched	Room Controller/Sensor				Reheat Valve				Box Information				Actuator Information									
						N30 Addr	N2 Addr	N2 Trunk	N2 Addr	CS Model	Code No.	Device Code	Valve Style	Valve In.	Valve Cv	Flow GPM	Delta P	Box ID	Box Type	K Factor	Inlet Size (Inches)	Inlet Area (Area)	Clg Min Flow	Clg Max Flow	VMA Box Config	Code No.	Range
MECH RM	159	AHU-1	AHU-1	M201	1	AS-UNT140	1	1	1																		
MECH RM	105	AHU-2	AHU-2	M201	2	AS-UNT140	1	1	2																		
MECH RM	115	AHU-3	AHU-3	M201	3	AS-UNT140	1	1	3																		
MECH RM		LIGHTING/BOILER	LIGHTING/BOILER	M501	4	AS-UNT140	1	1	4																		

Network Riser Diagram

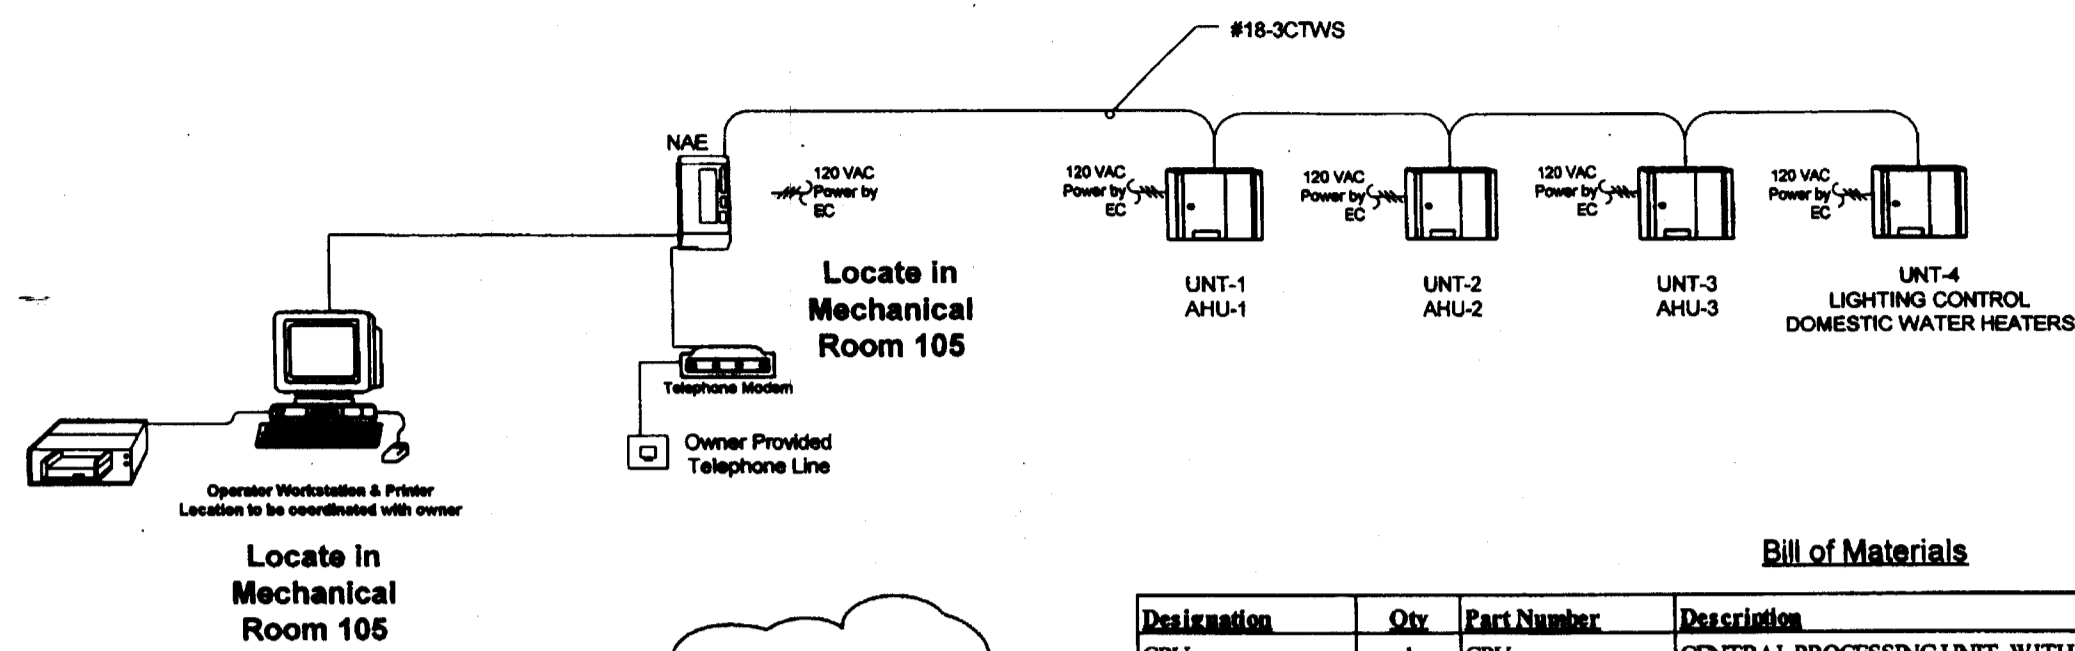

Bill of Materials

Designation	Qty	Part Number	Description
CPU	1	CPU	CENTRAL PROCESSING UNIT, WITH KEY BOARD, MOUSE AND MONITOR
MS-NAE3510-1	1	MS-NAE3510-1	NETWORK AUTOMATION ENGINE (MAIN CONTROLLER)
ENCLOSURE	1	EN-EWC35-0	MASTER CONTROL ENCLOSURE
MODEM	1	ZOOM-2949	EXTERNAL MODEM 56K

- INSTALLATION NOTES:**
- N2 BUS shall be daisy chained. T-Tapping is absolutely unacceptable.
 - All 120 volt wiring by Div. 16. QBC to field coordinate with electrician exact location of 120VAC for controls.

- NOTES:**
- Coordinate the location of N30 with electrician and owner.
 - A single enclosure shall house DDC controllers for each air handling Unit unless noted otherwise.
 - The owner shall provide a phone line adjacent to the master control panel (N30).
 - All wiring shall be in twisted shielded pairs.

Instrument and Control Color Codes

Type:	Color:
24 + VAC Power	White
24 - VAC Common	Black
Sensor Signal	White
Sensor Common	Black
Sensor Power	Red


Drawing Title: Network Riser Diagram

Project Title: Cuscaden Pool Renovations

QBC Quality Building Controls
6000 Jones Rd. Suite 4
Tampa, FL 33634
Phone: (813) 885-0005
Fax: (813) 243-4405

2004-40



Lighting Control & Domestic Hot water Boiler

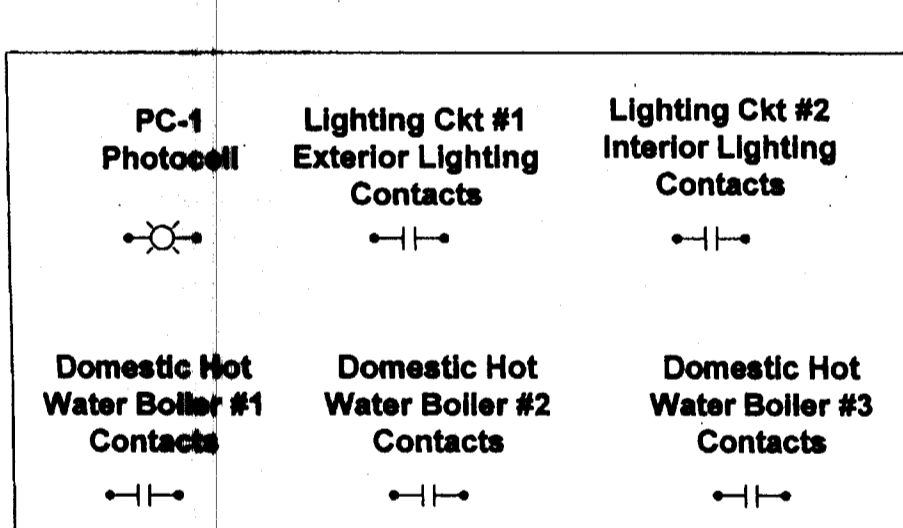

BILL OF MATERIALS

Designation	Qty	Part Number	Description
PC-1	1	MKT-B-CR	PHOTOCELL SENSOR
RL-15	5	MR-801/T	SPST 24VAC RELAY W/LED
UNT	1	AS-UNT140-101	CNTRLR.DIG.UNIT.8A1.4B1.8B0.SCR.ENCL.50VA

Notes: Field verify location of interior and exterior lighting contactors.
Coordinate location with electrical contractor/owner. Exterior lighting to operate on a time of day schedule.

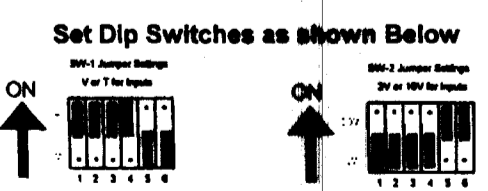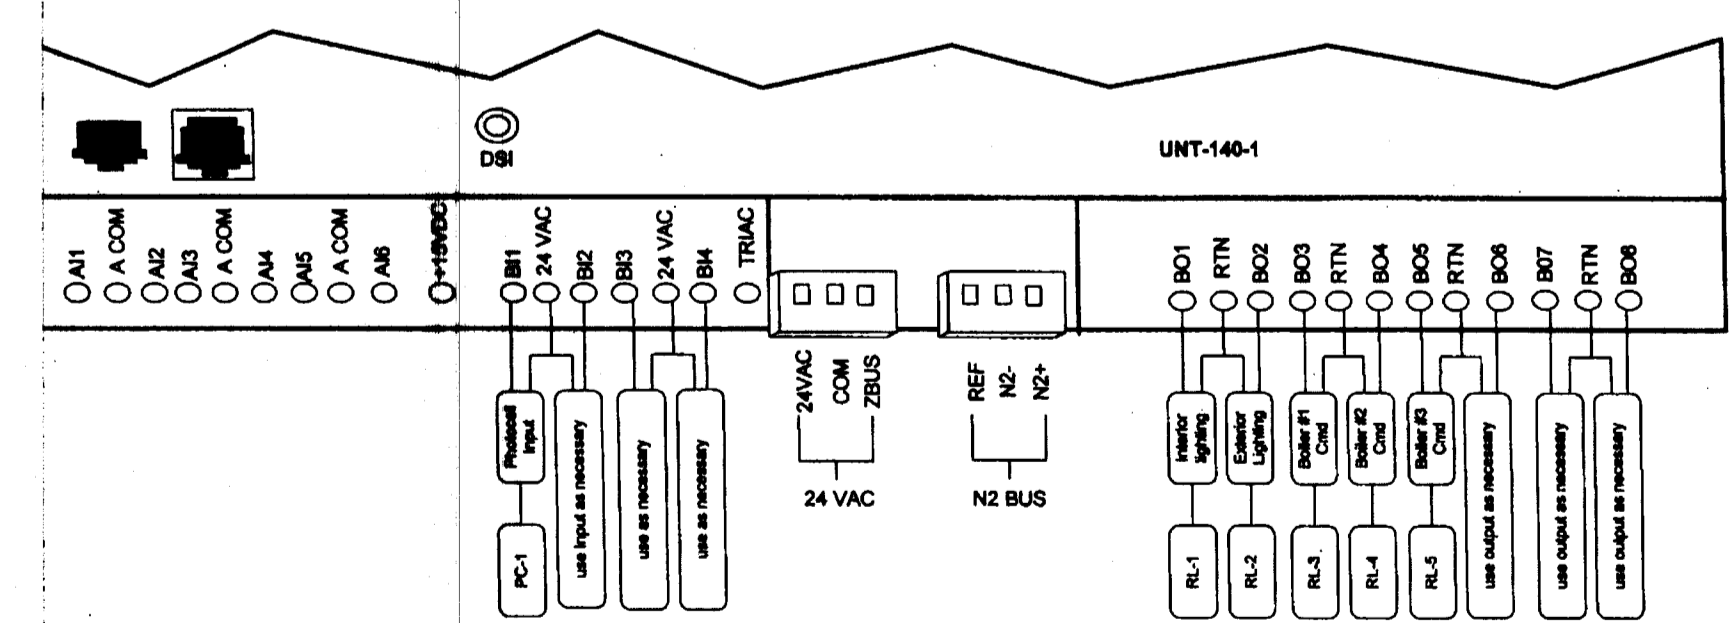

AS-BUILT 6/2/2005


Drawing Title: Miscellaneous Control

Project Title: Cuscaden Pool Renovations

QBC Quality Building Controls
6000 Jones Rd. Suite 4
Tampa, FL 33634
Phone: (813) 885-0005
Fax: (813) 243-4405

2004-40

Air Handling Units AHU-1,2,3

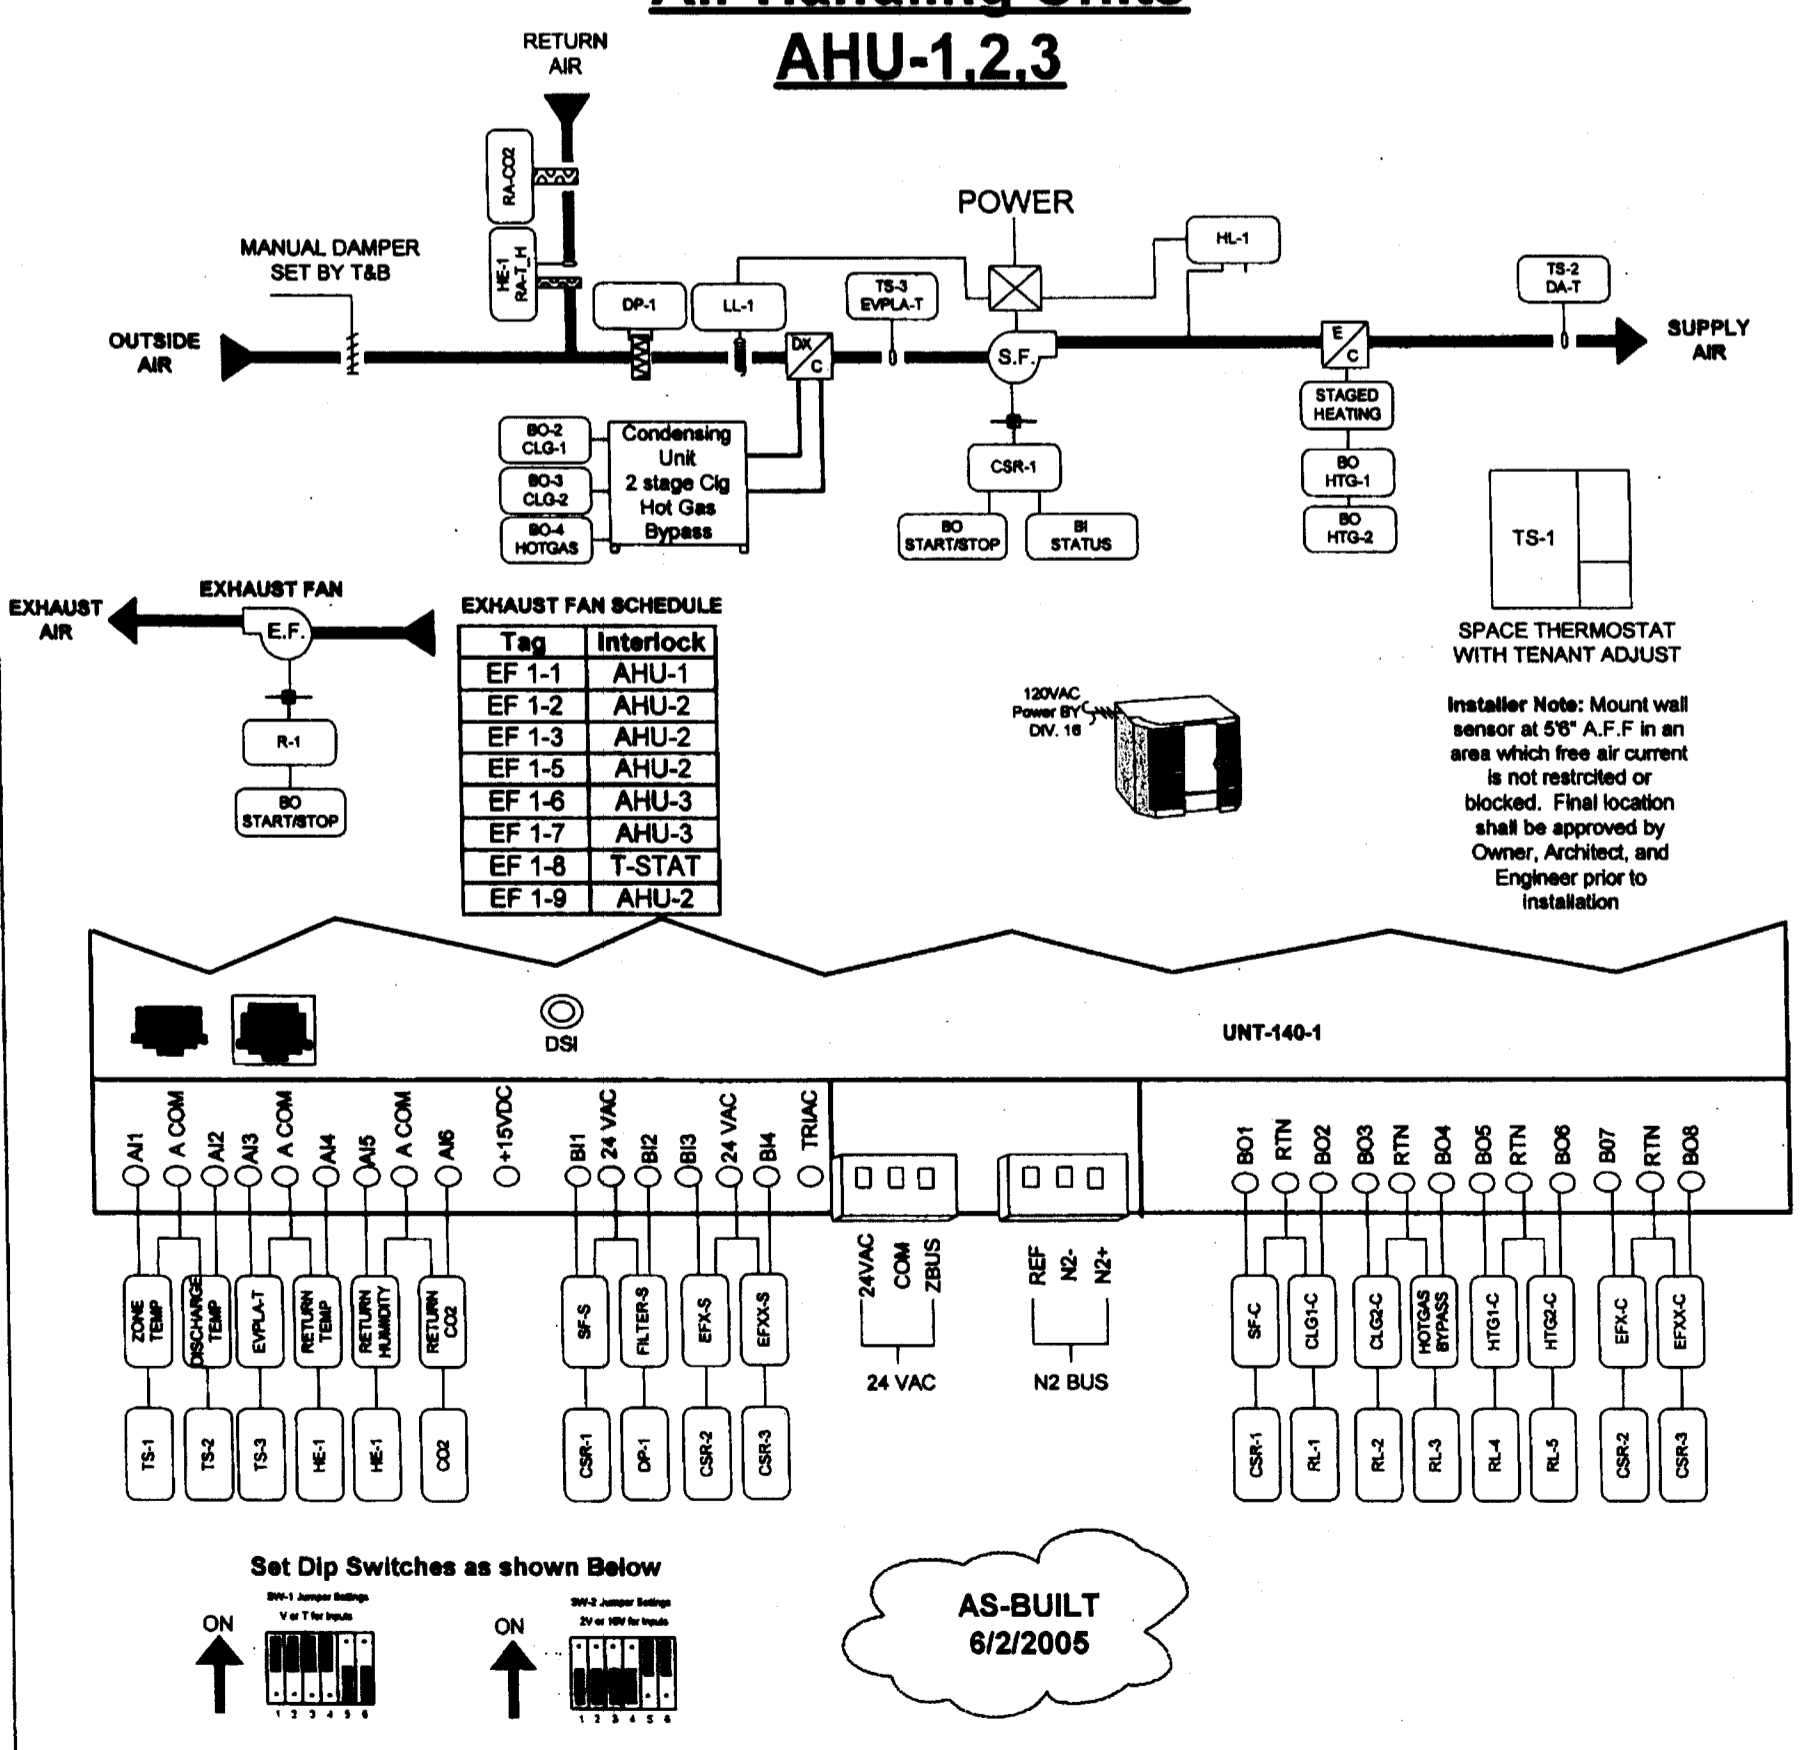

Bill of Materials

Designation	Qty	Part Number	Description
CSR-1	3	H-938	SENS.CURR.1A @30V.1/2HP.CMND.RELAY.SPLI SWITCH.CURRENT.RELAY.COMB.SPST
CSR-2,3	7	H120	VERIS SENSOR.CO2.0-200PPM.DUCT.MOUNT
CO2	3	CDLSX0	SENSOR.21MRH & 1K NI TEMP.DUCT-PROBE
HE-1	3	HE-07N2-0ND0P	AIR FLOW SW.SPST.MC.RESET.0.05-12N
HL-1	3	A1848C-14C	STAT.AFT.CAP.SPOT.30100P. MANUAL.RESET
LL-1	3	FTG13A-800R	PACKIN G.NUT.WELL.1/2IN.NPT
RL-1,5	15	MR-801/T	SPDT.RELAY.LED.120/24 VAC
TS-1	3	AP-TM21600-0	ROOM SENSOR.W/LED.DISPLAY
TS-2,3	6	TS-8311P-1	SENSOR.T.M.0.1% .8IN.DUCT
UNT	3	AS-UNT140-101	CNTRLR.DIG.UNIT.8A1.4B1.8B0.SCR.ENCL.50VA

Sequence of Operations

AHU-1,2,3 Control

Occupied Mode:
Weekly Schedule will be accomplished by the supervisory network controller with a Operator Workstation.
The AHU supply fan shall start on the weekly schedule times as provided by the owner. Upon supply fan status, the temperature control sequences shall commence. The stages of cooling shall be controlled to maintain a space temperature set point of (75 deg F adj.), and heating shall be controlled to maintain a space temperature set point of (68 deg F adj.).
A high limit and a low limit sensor will be provided as safeties to shutdown the AHU in case of an alarm condition.

Unoccupied Mode:
The AHU fan shall remain off, stages of cooling and heating shall remain off, and exhaust fan(s) off. If the space temperature served by an individual AHU exceeds the unoccupied cooling set point (62 deg F adj.), or drop below the unoccupied heating set point (62 deg F adj.), the AHU shall run until the unoccupied differential (4 deg F adj.) is satisfied.

AHU-1 MECH RM 159
AHU-2 MECH RM 105
AHU-3 MECH RM 115

Drawing Title: Air Handling Unit Control

Project Title: Cuscaden Pool Renovations

QBC Quality Building Controls
6000 Jones Rd. Suite 4
Tampa, FL 33634
Phone: (813) 885-0005
Fax: (813) 243-4405

2004-40

SCADEN
OL
NOVATION

TAMPA
Jackson Street
oride 33602

0202.00

Date

MENTS 02.02.04

Is -
rical

RECORD DWG.
DATE 2/26/05

RECEIVED
FEB 23 2004

M501


PLUMBING SYMBOL LEGEND		
SYMBOL	DESCRIPTION	ABBREV.
TP	TRAP PRIMER	
A.F.F.	ABOVE FINISHED FLOOR	
CONT.	CONTINUATION	
DW	DISHWASHER	
DWG	DRAWING	
HC	HANDICAPPED	
N.I.C.	NOT IN CONTRACT	
N.T.S.	NOT TO SCALE	
RWL	RAIN WATER LEADER	
VTR	VENT THROUGH ROOF	
PC	PLUMBING CONTRACTOR	
GC	GENERAL CONTRACTOR	
FB	FROM BELOW	
FA	FROM ABOVE	
BF	BELOW FLOOR	
BG	BELOW GRADE	
I.E.	INVERT ELEVATION	
W.F.U.	WATER FIXTURE UNIT	
D.F.U.	DRAINAGE FIXTURE UNIT	
(E)	EXISTING CONDITION	
(N)	NEW CONDITION	

PLUMBING SYMBOL LEGEND		
SYMBOL	DESCRIPTION	ABBREV.
—OF—	OVERFLOW DRAIN ABOVE CEILING	OF
—CD—	CONDENSATE DRAIN ABOVE CEILING	CD
—CD—	CONDENSATE DRAIN	CD
—ST—	STORM ABOVE CEILING	ST
—ST—	STORM BELOW SLAB	ST
—S—	SANITARY SEWER ABOVE CEILING	SAN
—S—	SANITARY SEWER BELOW SLAB	SAN
—GW—	GREASE WASTE	GW
—V—	VENT PIPING	V
—C.W.—	COLD WATER PIPING	C.W.
—H.W.—	HOT WATER PIPING	H.W.
—140°—	HOT WATER PIPING (140°F)	H.W.
—H.W.R.—	HOT WATER RECIRCULATING	H.W.R.
←	DIRECTION OF FLOW	
—G—	GAS PIPING	G.
—Z—	SWING CHECK VALVE	C.V.
—X—	SHUTOFF VALVE	
—S.V.—	SOLENOID VALVE	
—B.V.—	BALANCING VALVE	B.V.
—P.R.V.—	PRESSURE REGULATING VALVE	P.R.V.
—DN.—	ELBOW TURNED DOWN	DN.
—UP.—	ELBOW TURNED UP	UP
—UP.—	TEE TURNED UP	UP
—DN.—	TEE TURNED DOWN	DN.
—W.C.O.—	WALL CLEANOUT	F.C.O.
—F.C.O.—	FLOOR CLEANOUT	F.C.O.
—E.C.O.—	EXTERIOR CLEANOUT	EXT. C.O.
—P.T.V.—	PRESSURE & TEMPERATURE RELIEF VALVE (AGA RATED)	P.T.V.
—VTR.—	VENT THROUGH ROOF	VTR
—FD.—	FLOOR DRAIN	FD
—AD.—	AREA DRAIN	
—RD.—	ROOF DRAIN	RD
—RD.—	ROOF DRAIN ABOVE	RD
—H.B.—	HOSE BIB	HB
—C.—	CONNECT TO EXISTING UTILITIES	
—W.H.A.—	WATER HAMMER ARRESTOR	
—I.—	INSERT INDICATES DETAIL NUMBER INSERT INDICATES SHEET NUMBER	
—I.—	INSERT INDICATES RISER NUMBER INSERT INDICATES SHEET NUMBER	
—S.V.—	SHUTOFF VALVE IN VALVE BOX	
—00.00°—	INVERT ELEVATION	
—SF.—	SQUARE FOOTAGE	

- ### PLUMBING GENERAL NOTES
- RESPONSIBLE FOR PROVIDING ALL NECESSARY FITTINGS AS REQUIRED BY ALL APPLICABLE CODES AND GOVERNING AUTHORITIES.
 - VERIFY AND CORRECT AS REQUIRED TO MEET ALL CODES AND REGULATIONS ANY POSSIBLE DISCREPANCIES BETWEEN TYPE AND SIZE OF CONNECTION SPECIFIED IN PLUMBING FIXTURE SCHEDULE AND FIXTURES ACTUALLY INSTALLED ON THE SITE.
 - SANITARY PIPING 2" SHALL HAVE A 1/4" PER FT. SLOPE. PIPING 3" & LARGER SHALL HAVE A 1/8" PER FT. SLOPE MINIMUM.
 - COORDINATE SANITARY VENTS WITH HVAC O.A. INTAKES. PROVIDE AT LEAST 10'-0" DISTANCE FROM VENT STACKS AND INTAKE VENTS.
 - VALVES AND FITTINGS SHALL BE OF SAME SIZE OF LINE ON WHICH THEY ARE LOCATED, UNLESS OTHERWISE INDICATED ON DRAWINGS.
 - COORDINATE ALL WORK WITH OTHER TRADES.
 - FIELD VERIFY ALL GIVEN MEASUREMENTS PRIOR TO LAYING AND CONNECTING ALL SANITARY AND WASTE PIPING AND NOTIFY ARCHITECT OF ANY DISCREPANCIES.
 - AIR CHAMBERS SHALL NOT BE CONSIDERED AN EQUAL TO WATER ARRESTORS AS SPECIFIED. SHOCK ARRESTORS SHALL BE INSTALLED ON ALL TOILET ROOM GROUPS IN THE BRANCH SUPPLY FOR HOT AND COLD WATER PIPE AS PER STANDARD PDI-WH201 AND AS DESCRIBED ON THE FIXTURE SCHEDULE. PROVIDE ISOLATION VALVE, INSTALL IN CEILING AND PROVIDE ACCESS PANELS IN THE CEILING AS REQUIRED FOR ACCESSABILITY AND MAINTENANCE.
 - RESPONSIBLE FOR MAINTAINING FIRE RATING AND WEATHERPROOFING INTEGRITY OF ALL PIPING AND PENETRATIONS. REFER TO DETAILS.
 - ALL WATER SUPPLY AND SANITARY LINES SHALL BE RUN AS CLOSE TO PLANS AS POSSIBLE WITH NO CHANGES IN SIZING.
 - RESPONSIBLE FOR PROVIDING ALL NECESSARY SUPPORTING DEVICES FOR ALL FIXTURES INCLUDED IN CONTRACT OR HEREIN SPECIFIED OR OTHERWISE.
 - ALL DRAINAGE PIPING SHALL BE MARKED WITH THE SEAL OF APPROVAL OF THE NATIONAL SANITATION FOUNDATION.
 - ROUTE ALL PIPING CONCEALED ABOVE CEILINGS, WITHIN WALLS, OR IN CHASES EXCEPT AS SPECIFICALLY NOTED, OR IN MECHANICAL ROOMS.
 - PROVIDE ACCESS PANELS TO ALL VALVES WITHIN CHASES OR ABOVE NON-ACCESSIBLE CEILINGS. REFER TO ARCHITECTURAL DRAWINGS FOR CEILING TYPES.
 - SEE ARCHITECTURAL DRAWINGS FOR EXACT LOCATIONS OF PLUMBING FIXTURE LOCATIONS, MOUNTING HEIGHTS, AND DIMENSIONS.
 - PROVIDE A PRE MANUFACTURED DRAIN INSULATING COVER ON ALL SINKS AND LAVATORIES DESIGNATED AS A HANDICAP FIXTURE. REFER TO PLUMBING DRAWINGS AND THE ARCHITECTS DRAWINGS FOR DESIGNATIONS.
 - VERIFY INVERT ELEVATIONS OF SEWERS TO WHICH NEW SEWER LINES ARE TO BE CONNECTED BEFORE INSTALLATION OF NEW SEWER LINE.
 - INSTALL DIELECTRIC UNIONS AT CONNECTIONS OF DISSIMILAR METALS.
 - ROUGH-IN ALL WASTES AND SUPPLIES TO SPECIAL EQUIPMENT ACCORDING TO MANUFACTURER'S SHOP DRAWINGS AND MAKE FINAL CONNECTIONS. ALL SUPPLIES SHALL BE VALVED. INSTALL VACUUM BREAKERS WHERE REQUIRED BY CODE.
 - PROVIDE REDUCED PRESSURE BACKFLOW PREVENTERS FOR DOMESTIC WATER SUPPLIES AS REQUIRED BY LOCAL WATER PURVEYORS.
 - DO NOT PENETRATE WALL FOOTINGS WITH PIPING. COORDINATE WITH GENERAL CONTRACTOR TO DROP FOOTINGS AS REQUIRED TO CLEAR PLUMBING SERVICES WHERE ABSOLUTELY NECESSARY. ANY PIPING PENETRATING A BEARING WALL OR FOOTING MUST BE SLEEVED AND LOCATION APPROVED BY STRUCTURAL ENGINEER.
 - MAKE ALL FINAL CONNECTIONS TO FIXTURES.

ROME ARCHITECTS
INCORPORATED
100 Madison Street, Suite 200
Tampa, Florida 33602-4704
www.RomeArchitects.com
Fax: 813.221.9154
813.221.8771
AAC002172

ENGINEERING MATRIX INC.
CONSULTING ENGINEERS
2000 N. W. 13th Ave., Suite 100
Fort Lauderdale, Florida 33304
(954) 575-1100
CERT. OF REGISTRATION NO. 1288

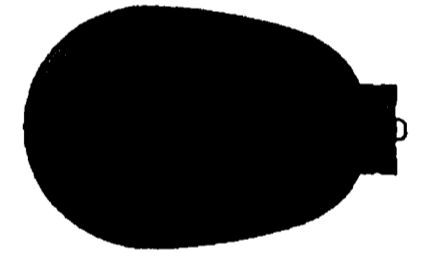

CUSCADEN POOL RENOVATION

CITY OF TAMPA
306 East Jackson Street
Tampa, Florida 33602

Project No.	0202.00
Distribution	Date
BID DOCUMENTS	02.02.04

Legend - Plumbing
RECORD DWG.
DATE 2/26/05



P001

Legend - Plumbing


NOT TO SCALE

KEYED NOTES


- 1 MAIN SHUT-OFF VALVE IN RISE. INSTALL AT 4'-0" A.F.F.
- 2 PROVIDE SHUT-OFF VALVE IN RISE FOR HOSE BIBB.

ROWE ARCHITECTS
INCORPORATED
100 Madison Street, Suite 200
Tampa, Florida 33602-4704
www.RoweArchitects.com
Fax: 813.221.9154
813.221.8771
AAC002172

ENGINEERING MATRIX, INC.
CONSULTING ENGINEERS
2001 W. W. WOODS BLVD., SUITE 100
TAMPA, FLORIDA 33607
TEL: 813-221-8771
FAX: 813-221-8771
www.EngineeringMatrix.com
Professional Engineer
Stanley P. Newton, P.E.
Florida License # 28071

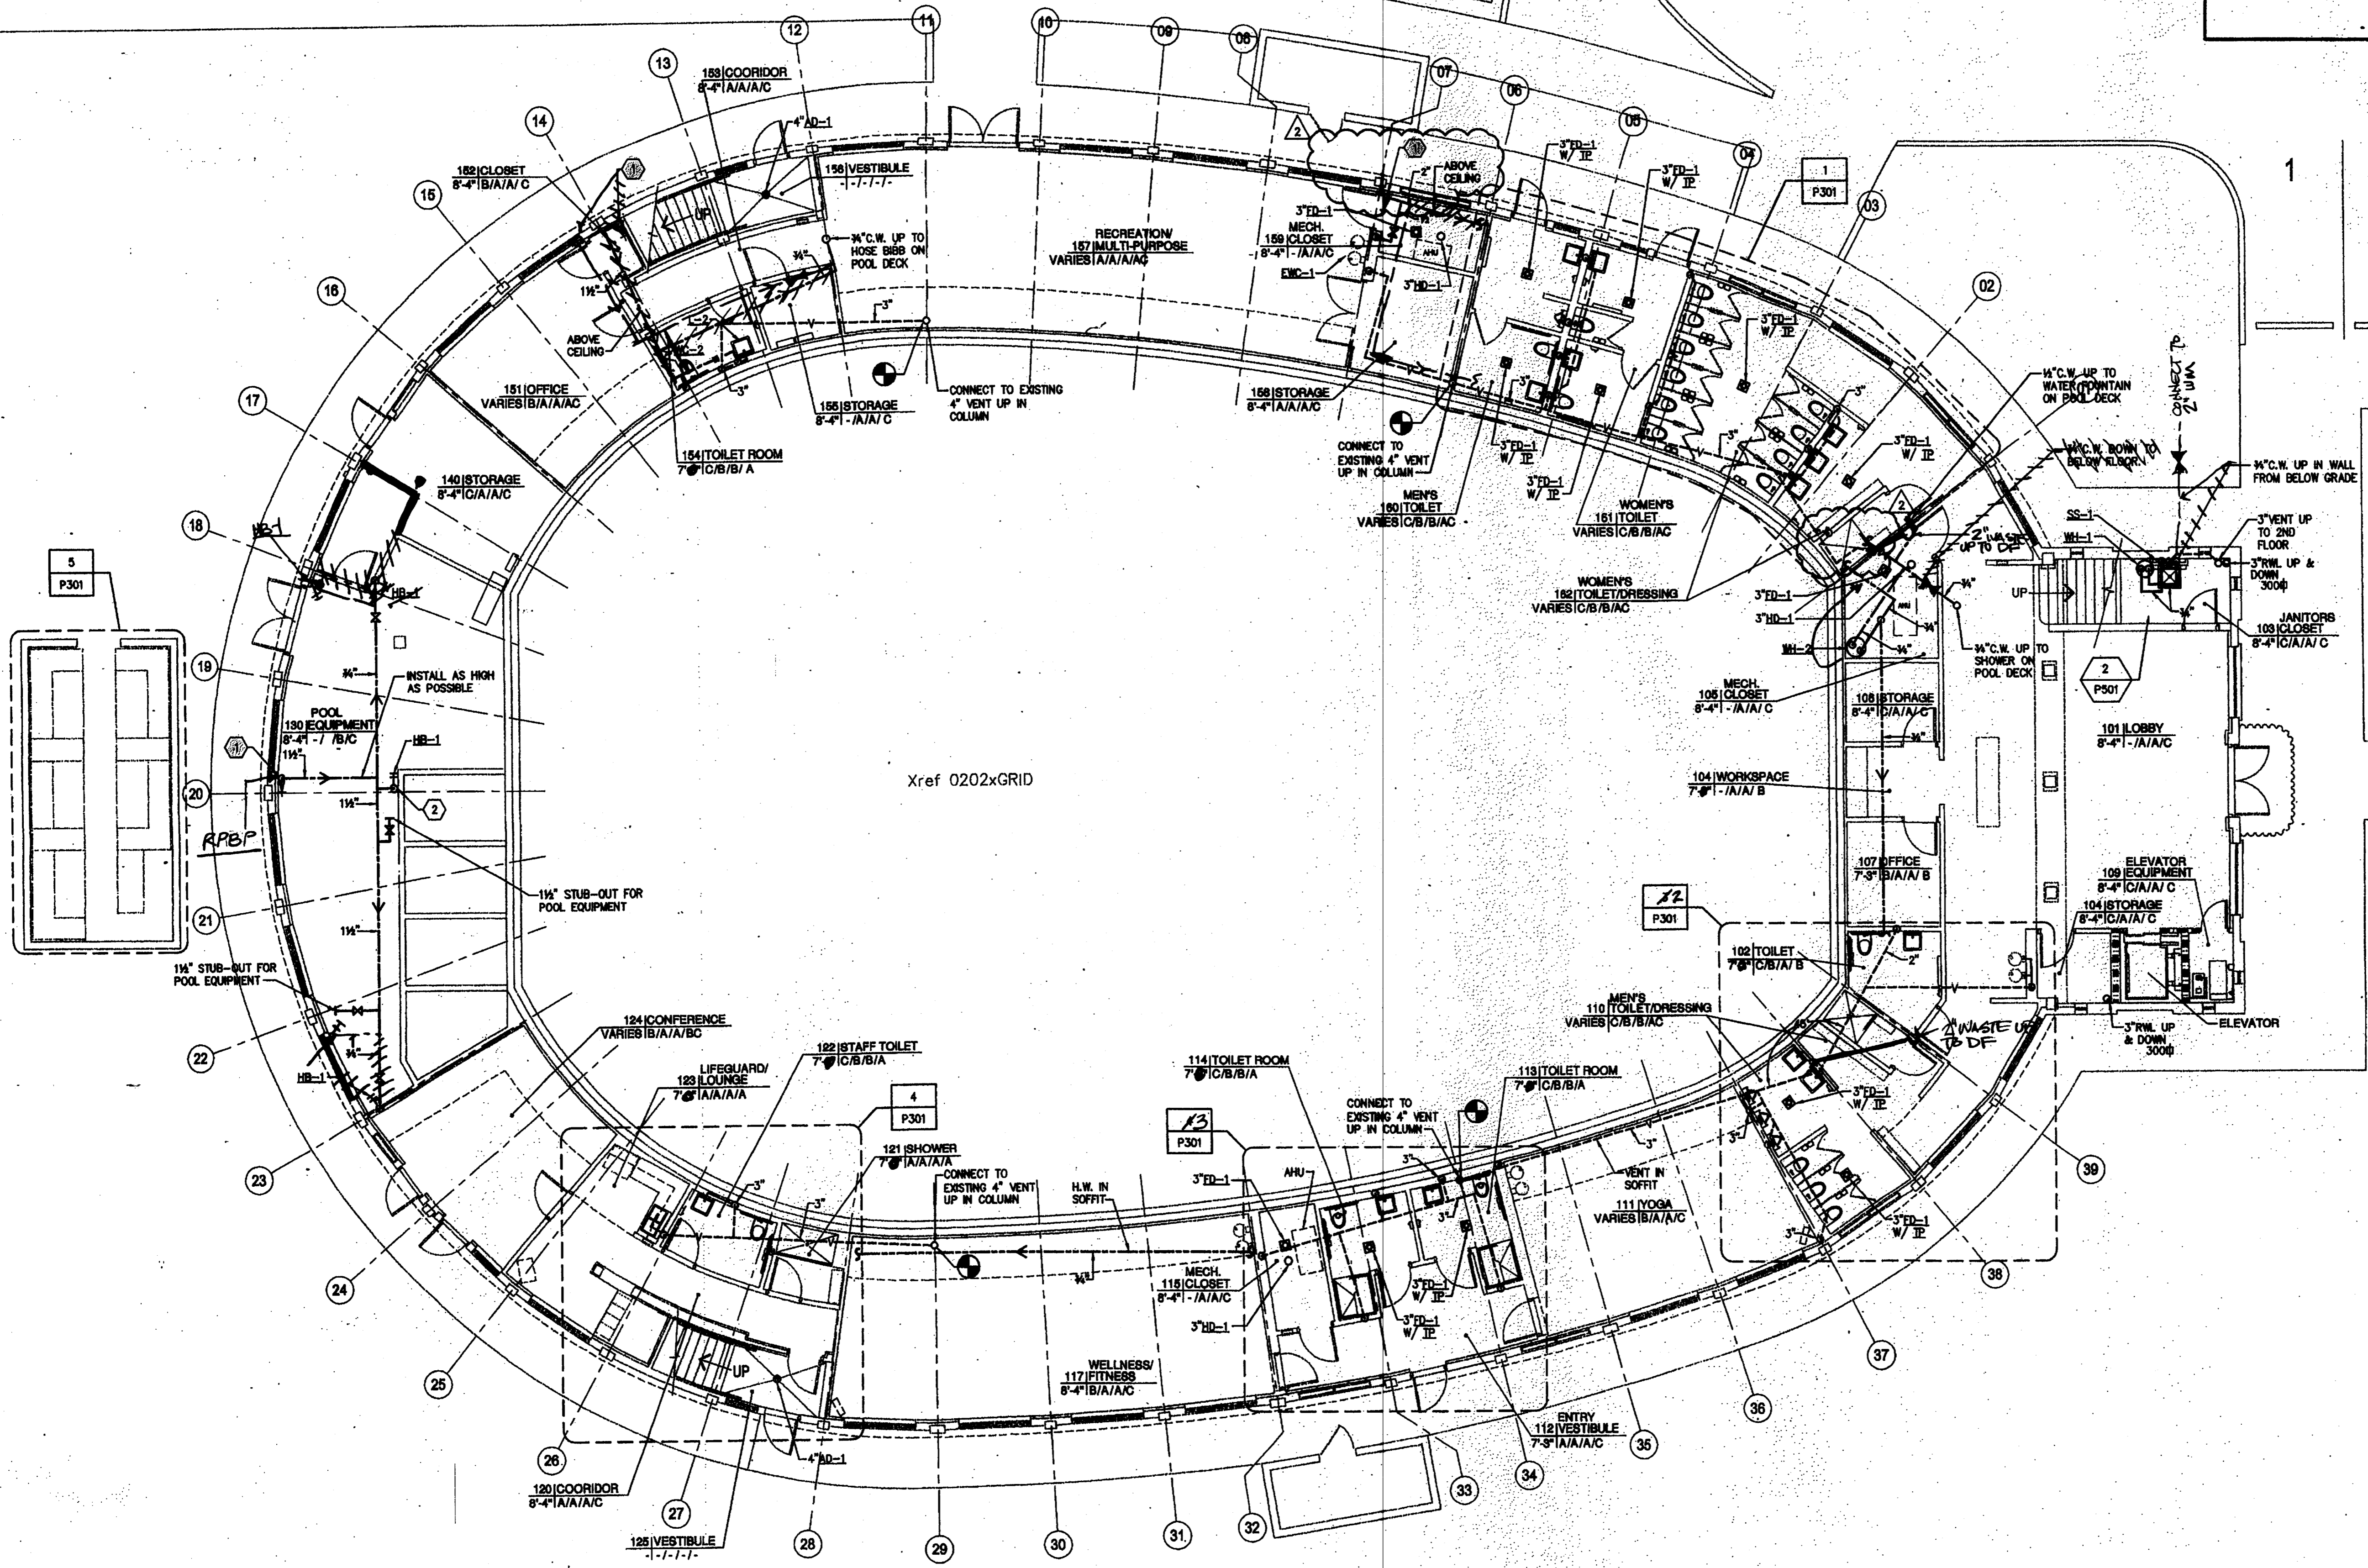

Xref 0202xGRID

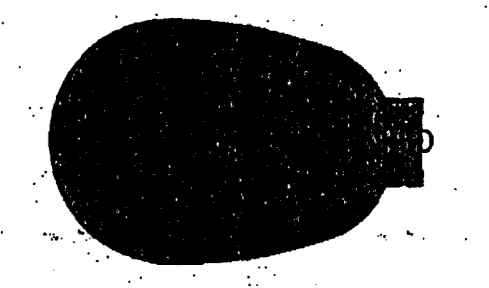


**CUSCADEN
POOL
RENOVATION**

CITY OF TAMPA
306 East Jackson Street
Tampa, Florida 33602



Project No.	0202.00
Distribution	Date
BID DOCUMENTS	02.02.04
REVISION A	05.07.04

First Floor
Plumbing
RECORD DWG.
DATE 8/26/05

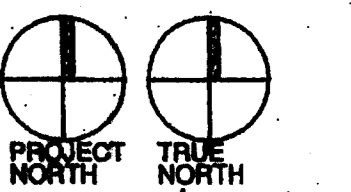

FLOOR PLAN - First Floor PLUMBING

1/8"=1'-0"

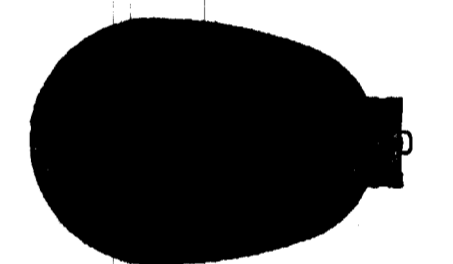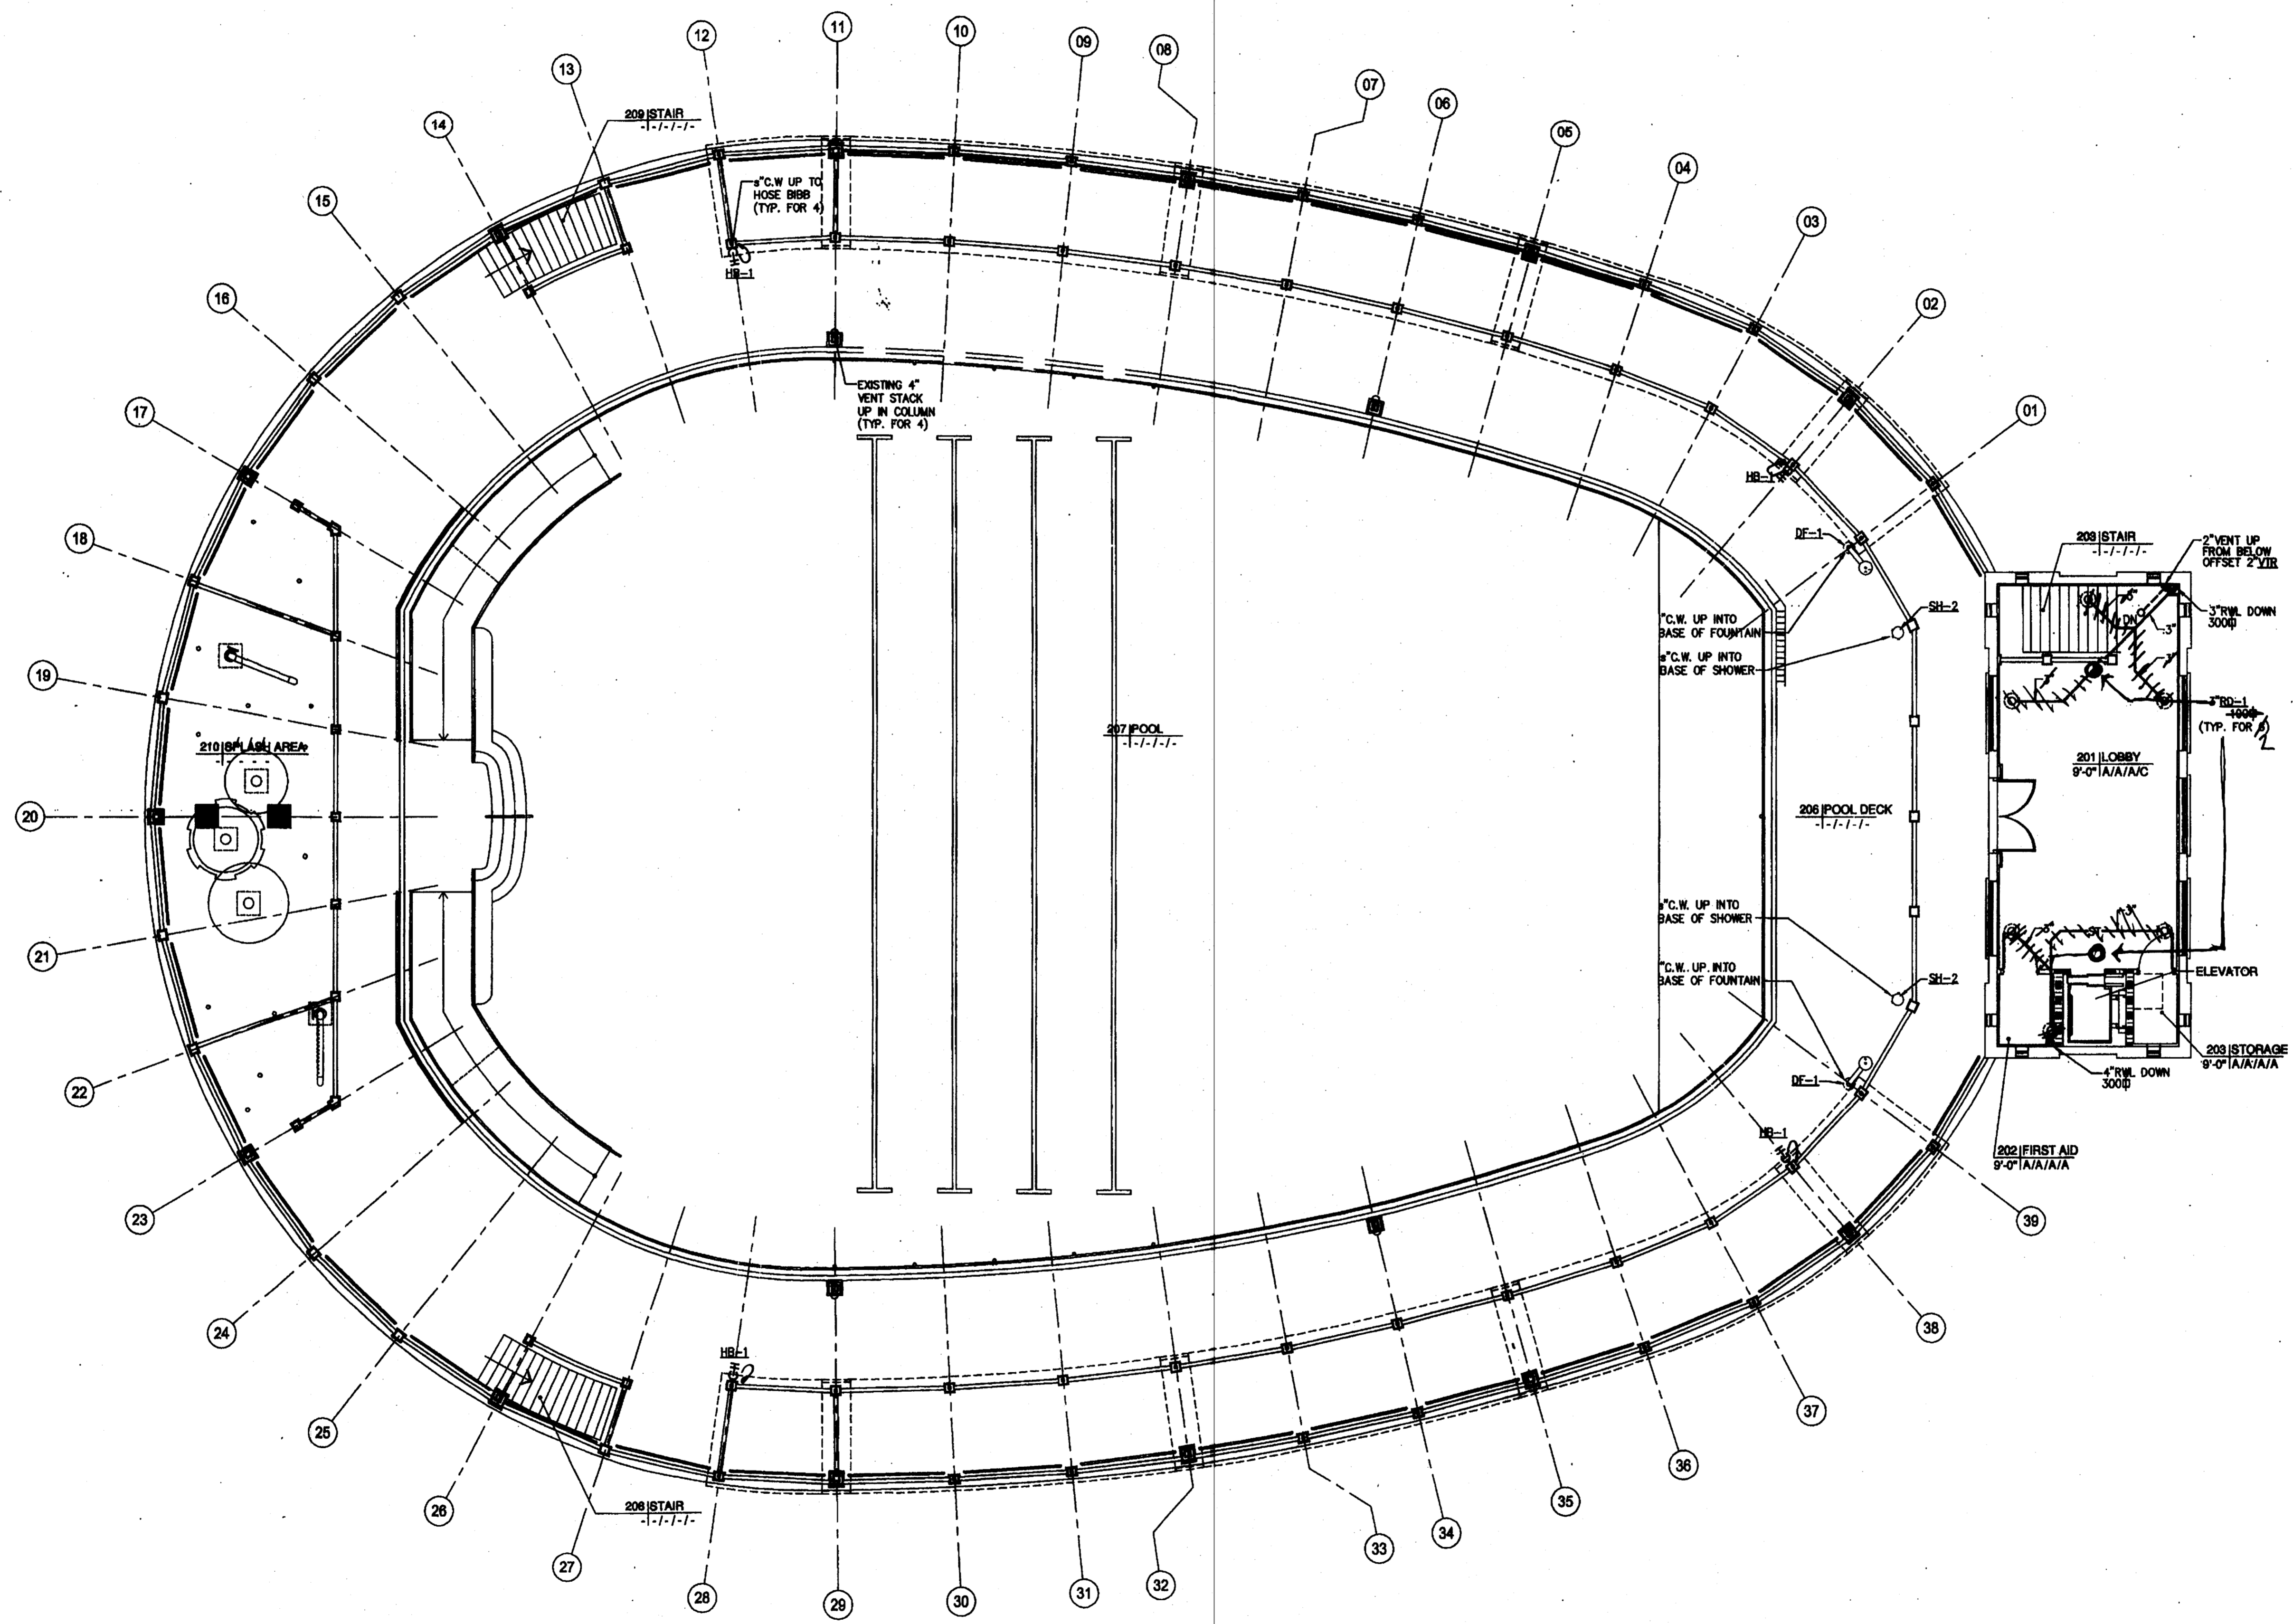

**CUSCADEN
POOL
RENOVATION**

CITY OF TAMPA
306 East Jackson Street
Tampa, Florida 33602

Project No.	0202.00
Distribution	Date
BID DOCUMENTS	02.02.04

Second Floor Pool Deck
Plumbing





RECORD DWG.
DATE 2/26/05

REGISTERED PROFESSIONAL ENGINEER

P202 FEB 23 2004

Floor Plan - Second Floor Pool Deck - Plumbing

1/8"=1'-0"

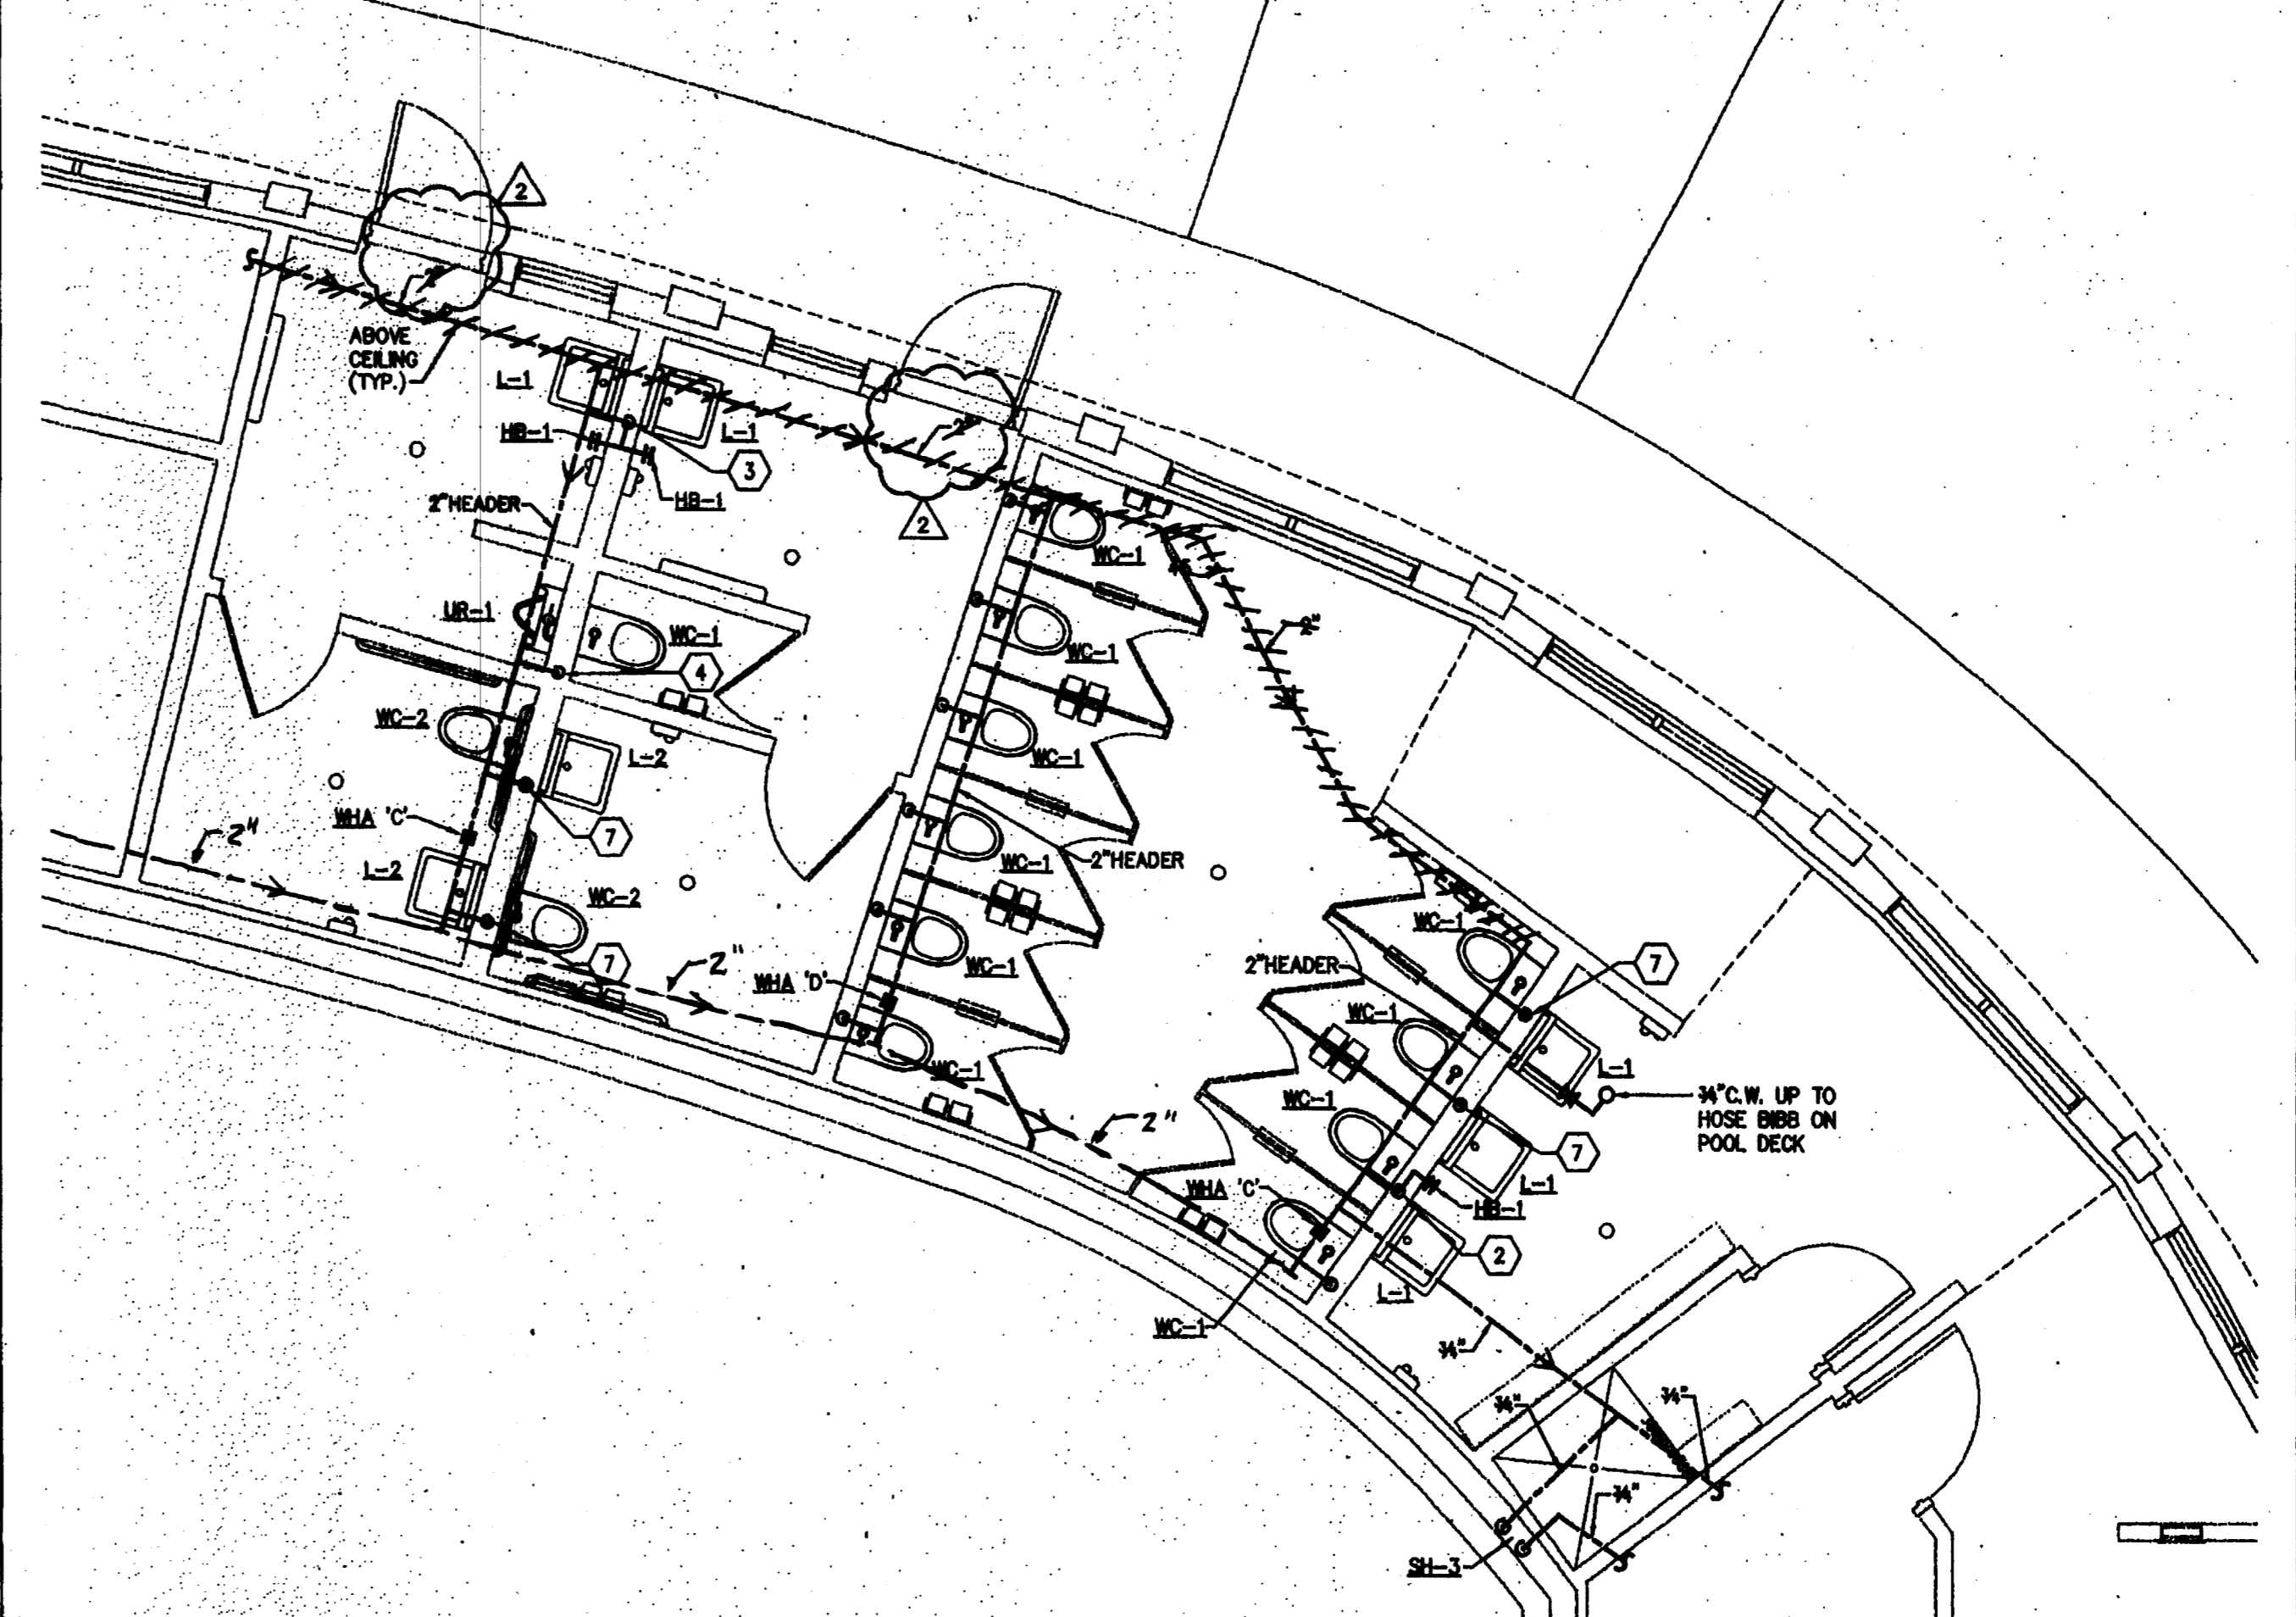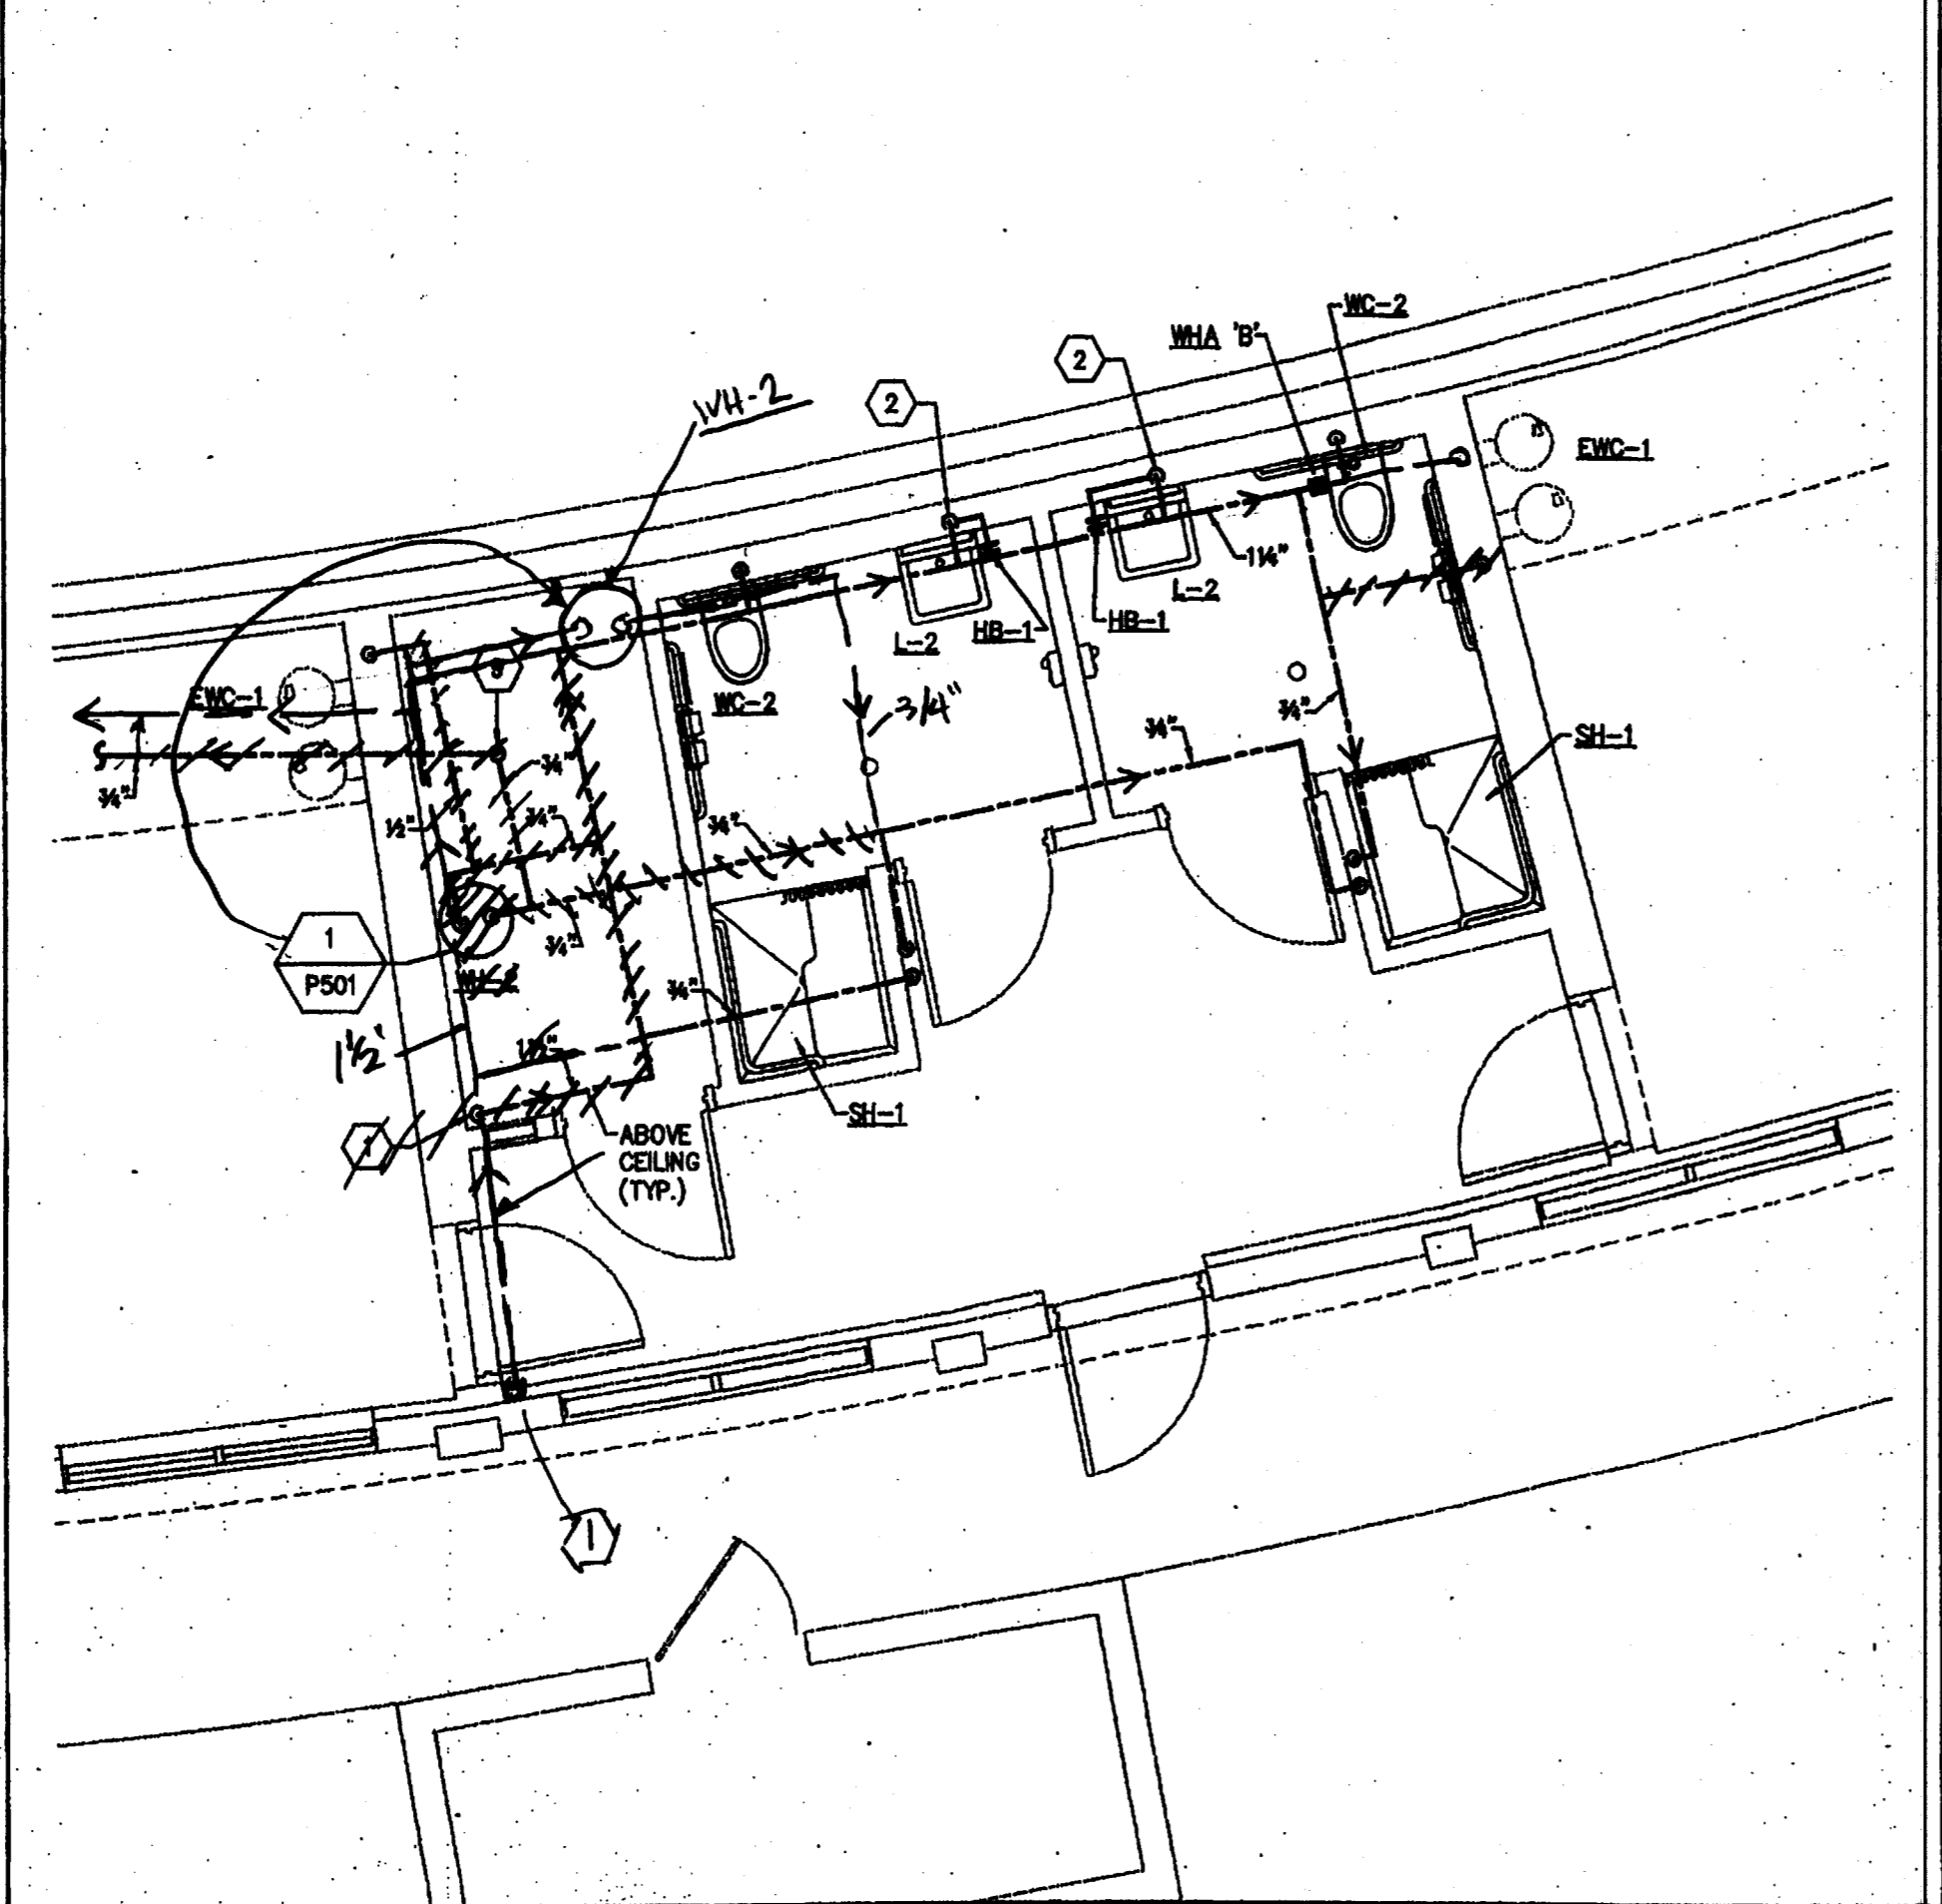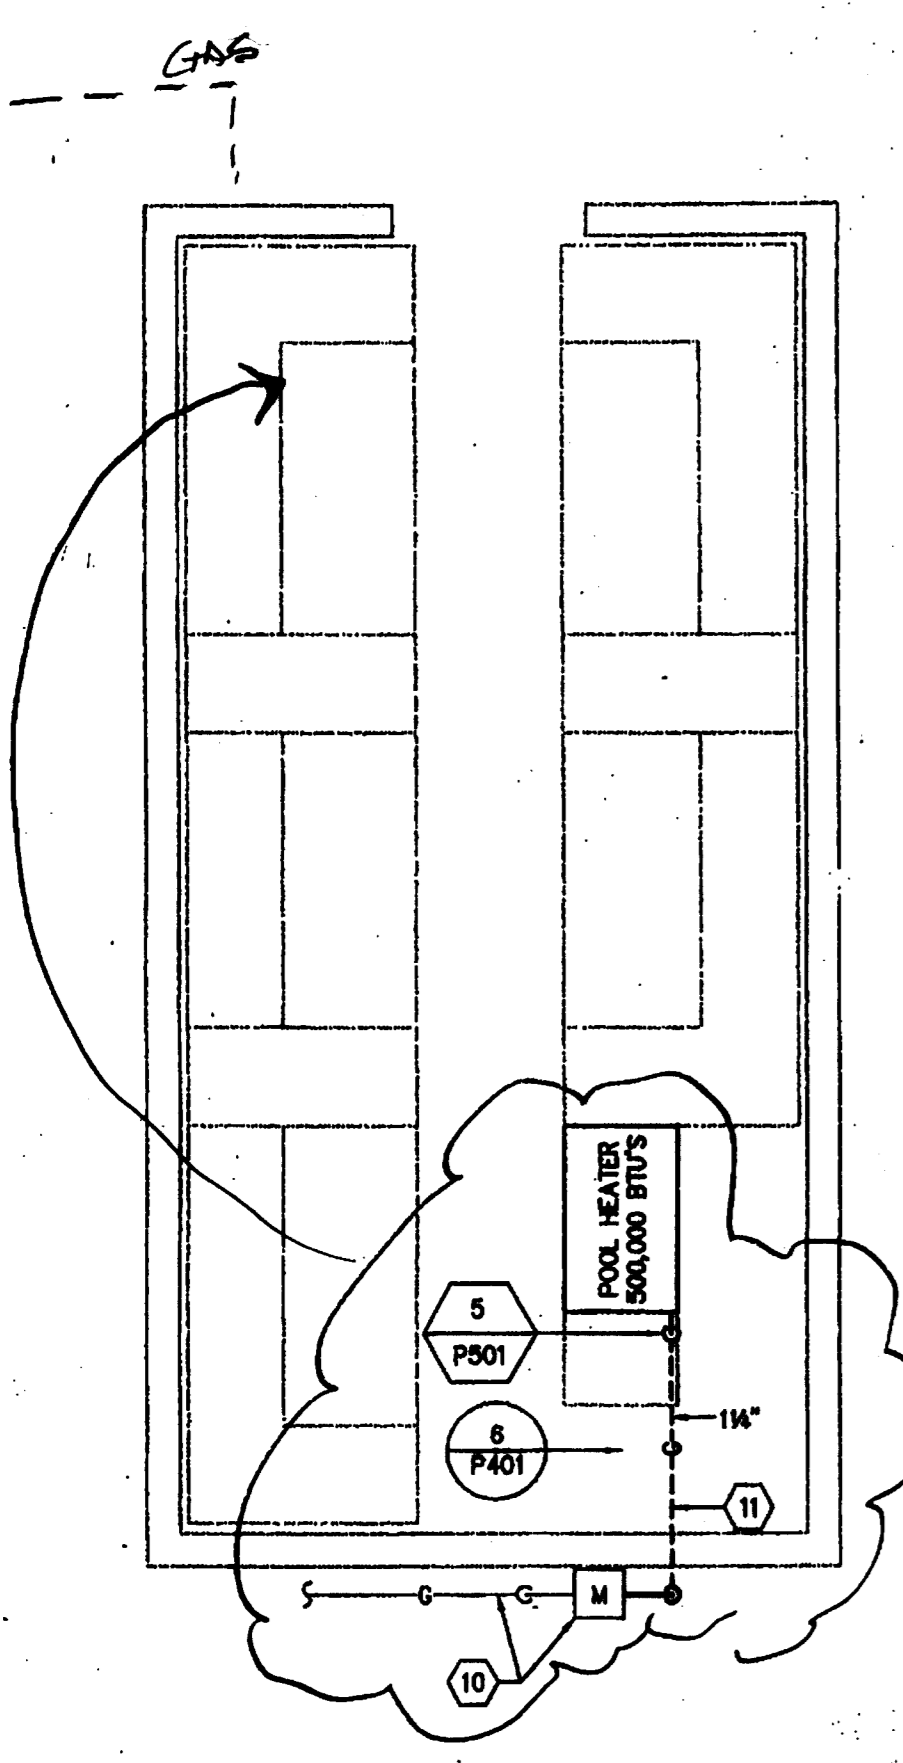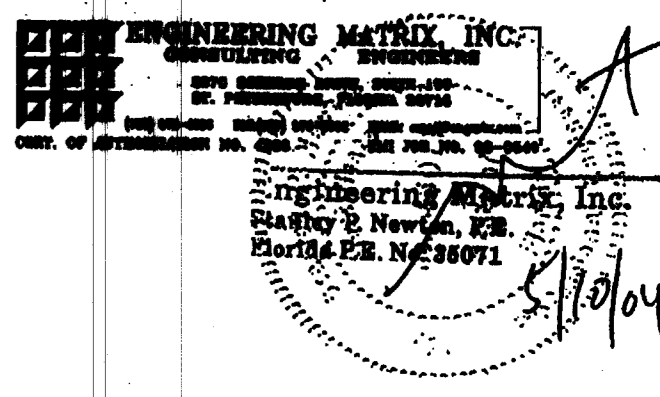

5 Pool Equipment Plan



3 Toilet's 113 AND 114

1 Men's and Women's Toilet

1/4"=1'-0"

1/4"=1'-0"

1/4"=1'-0"

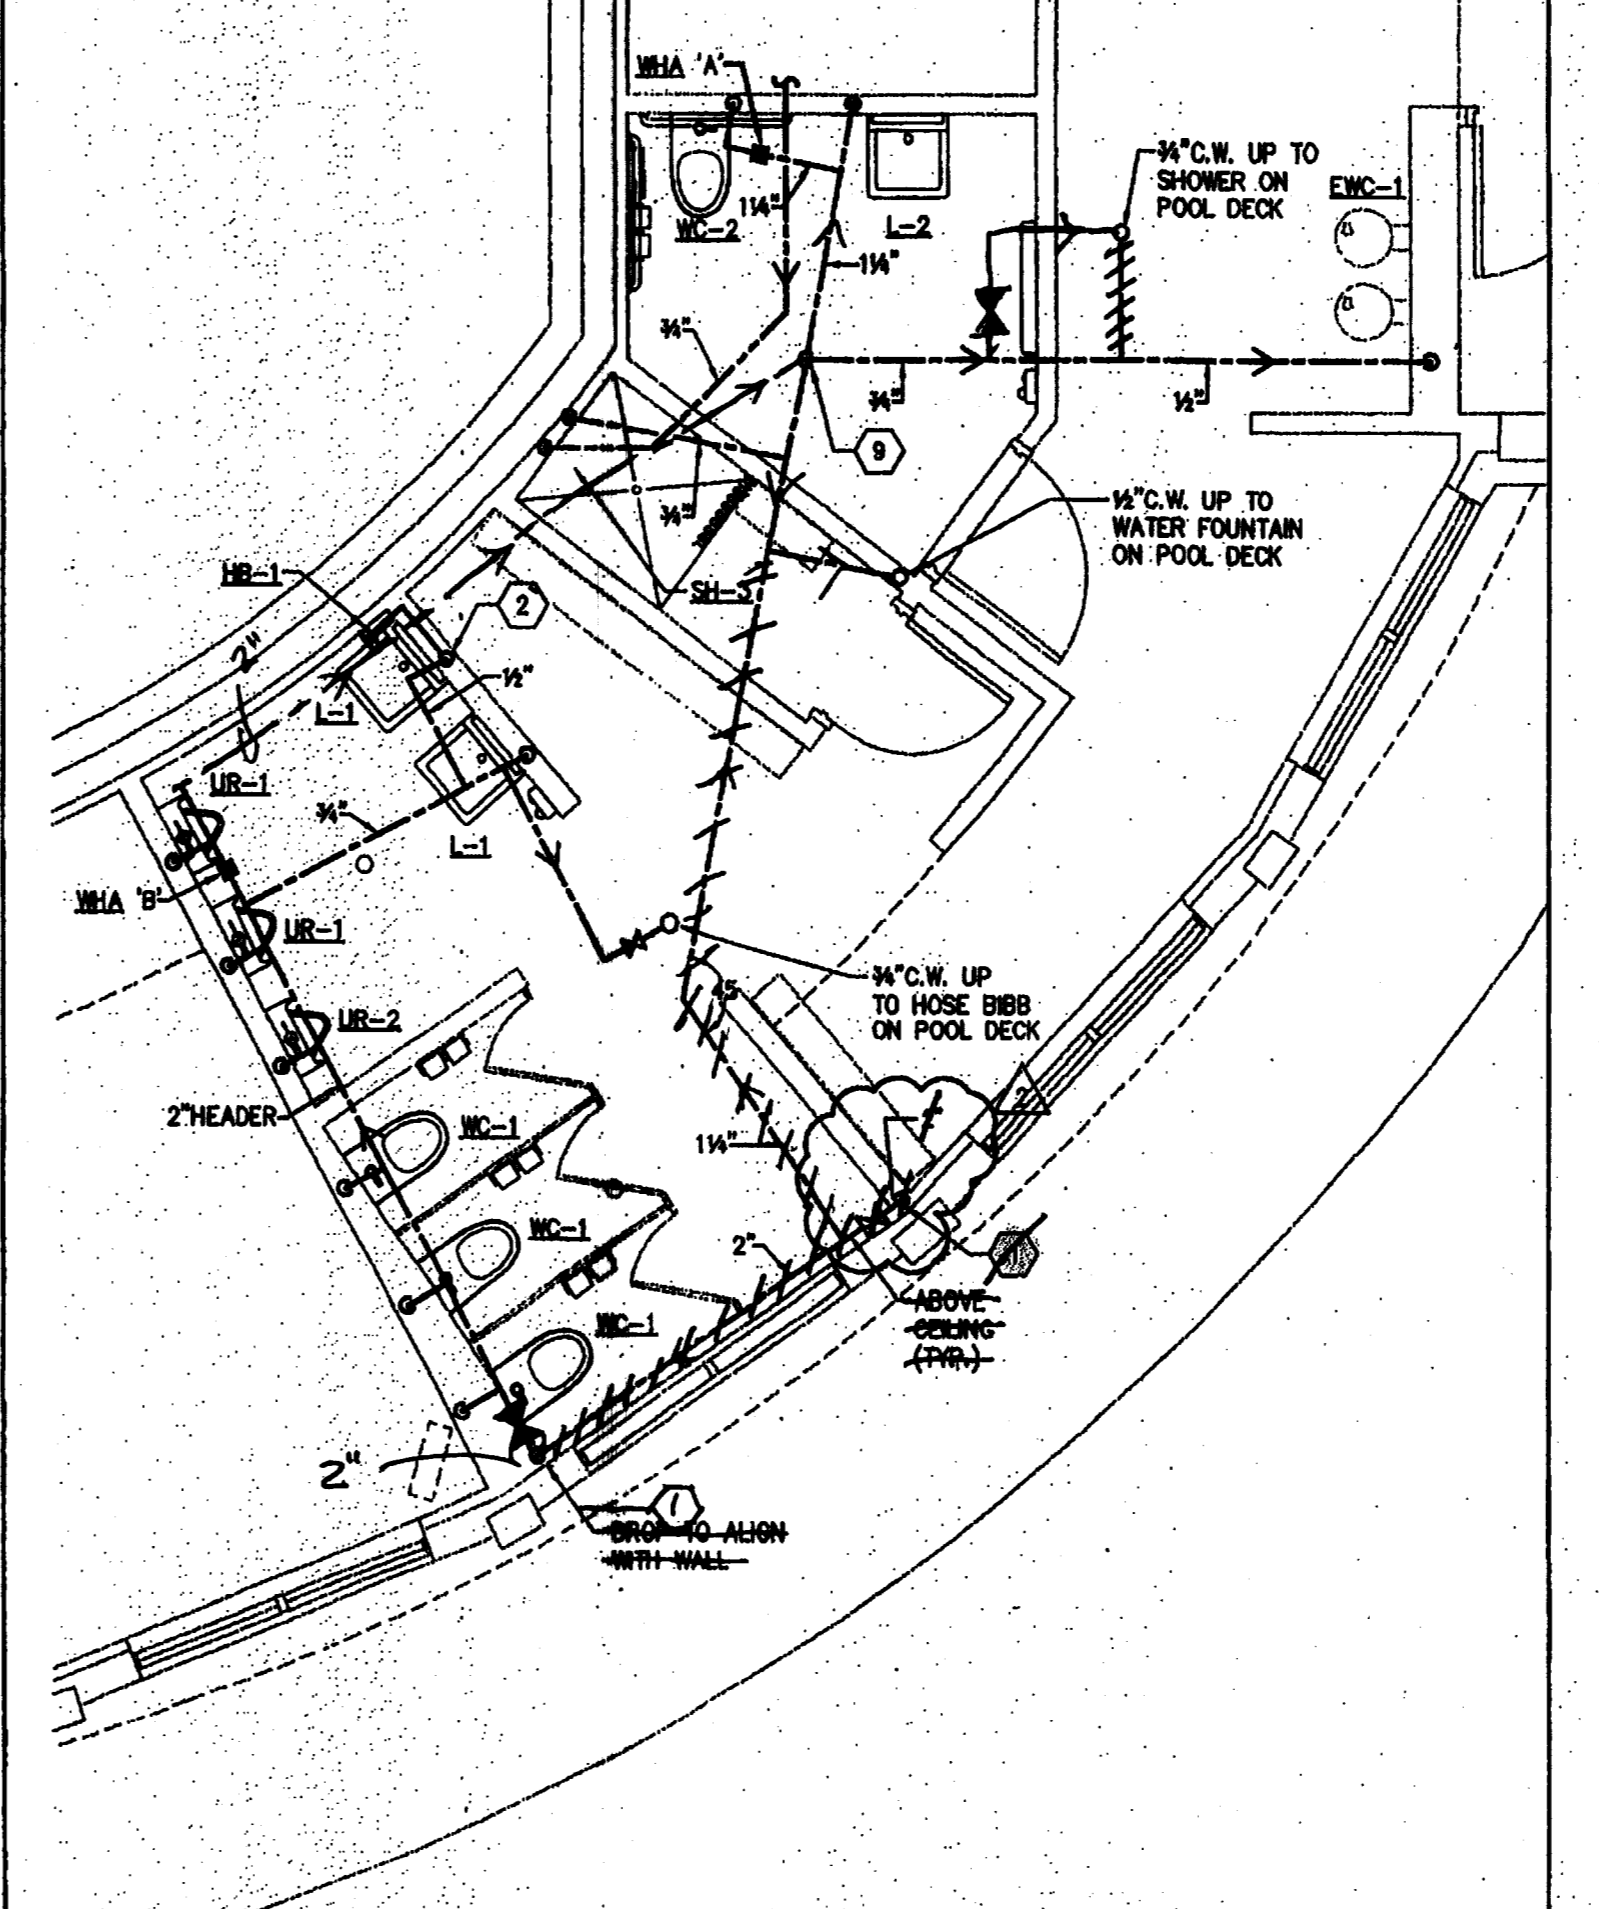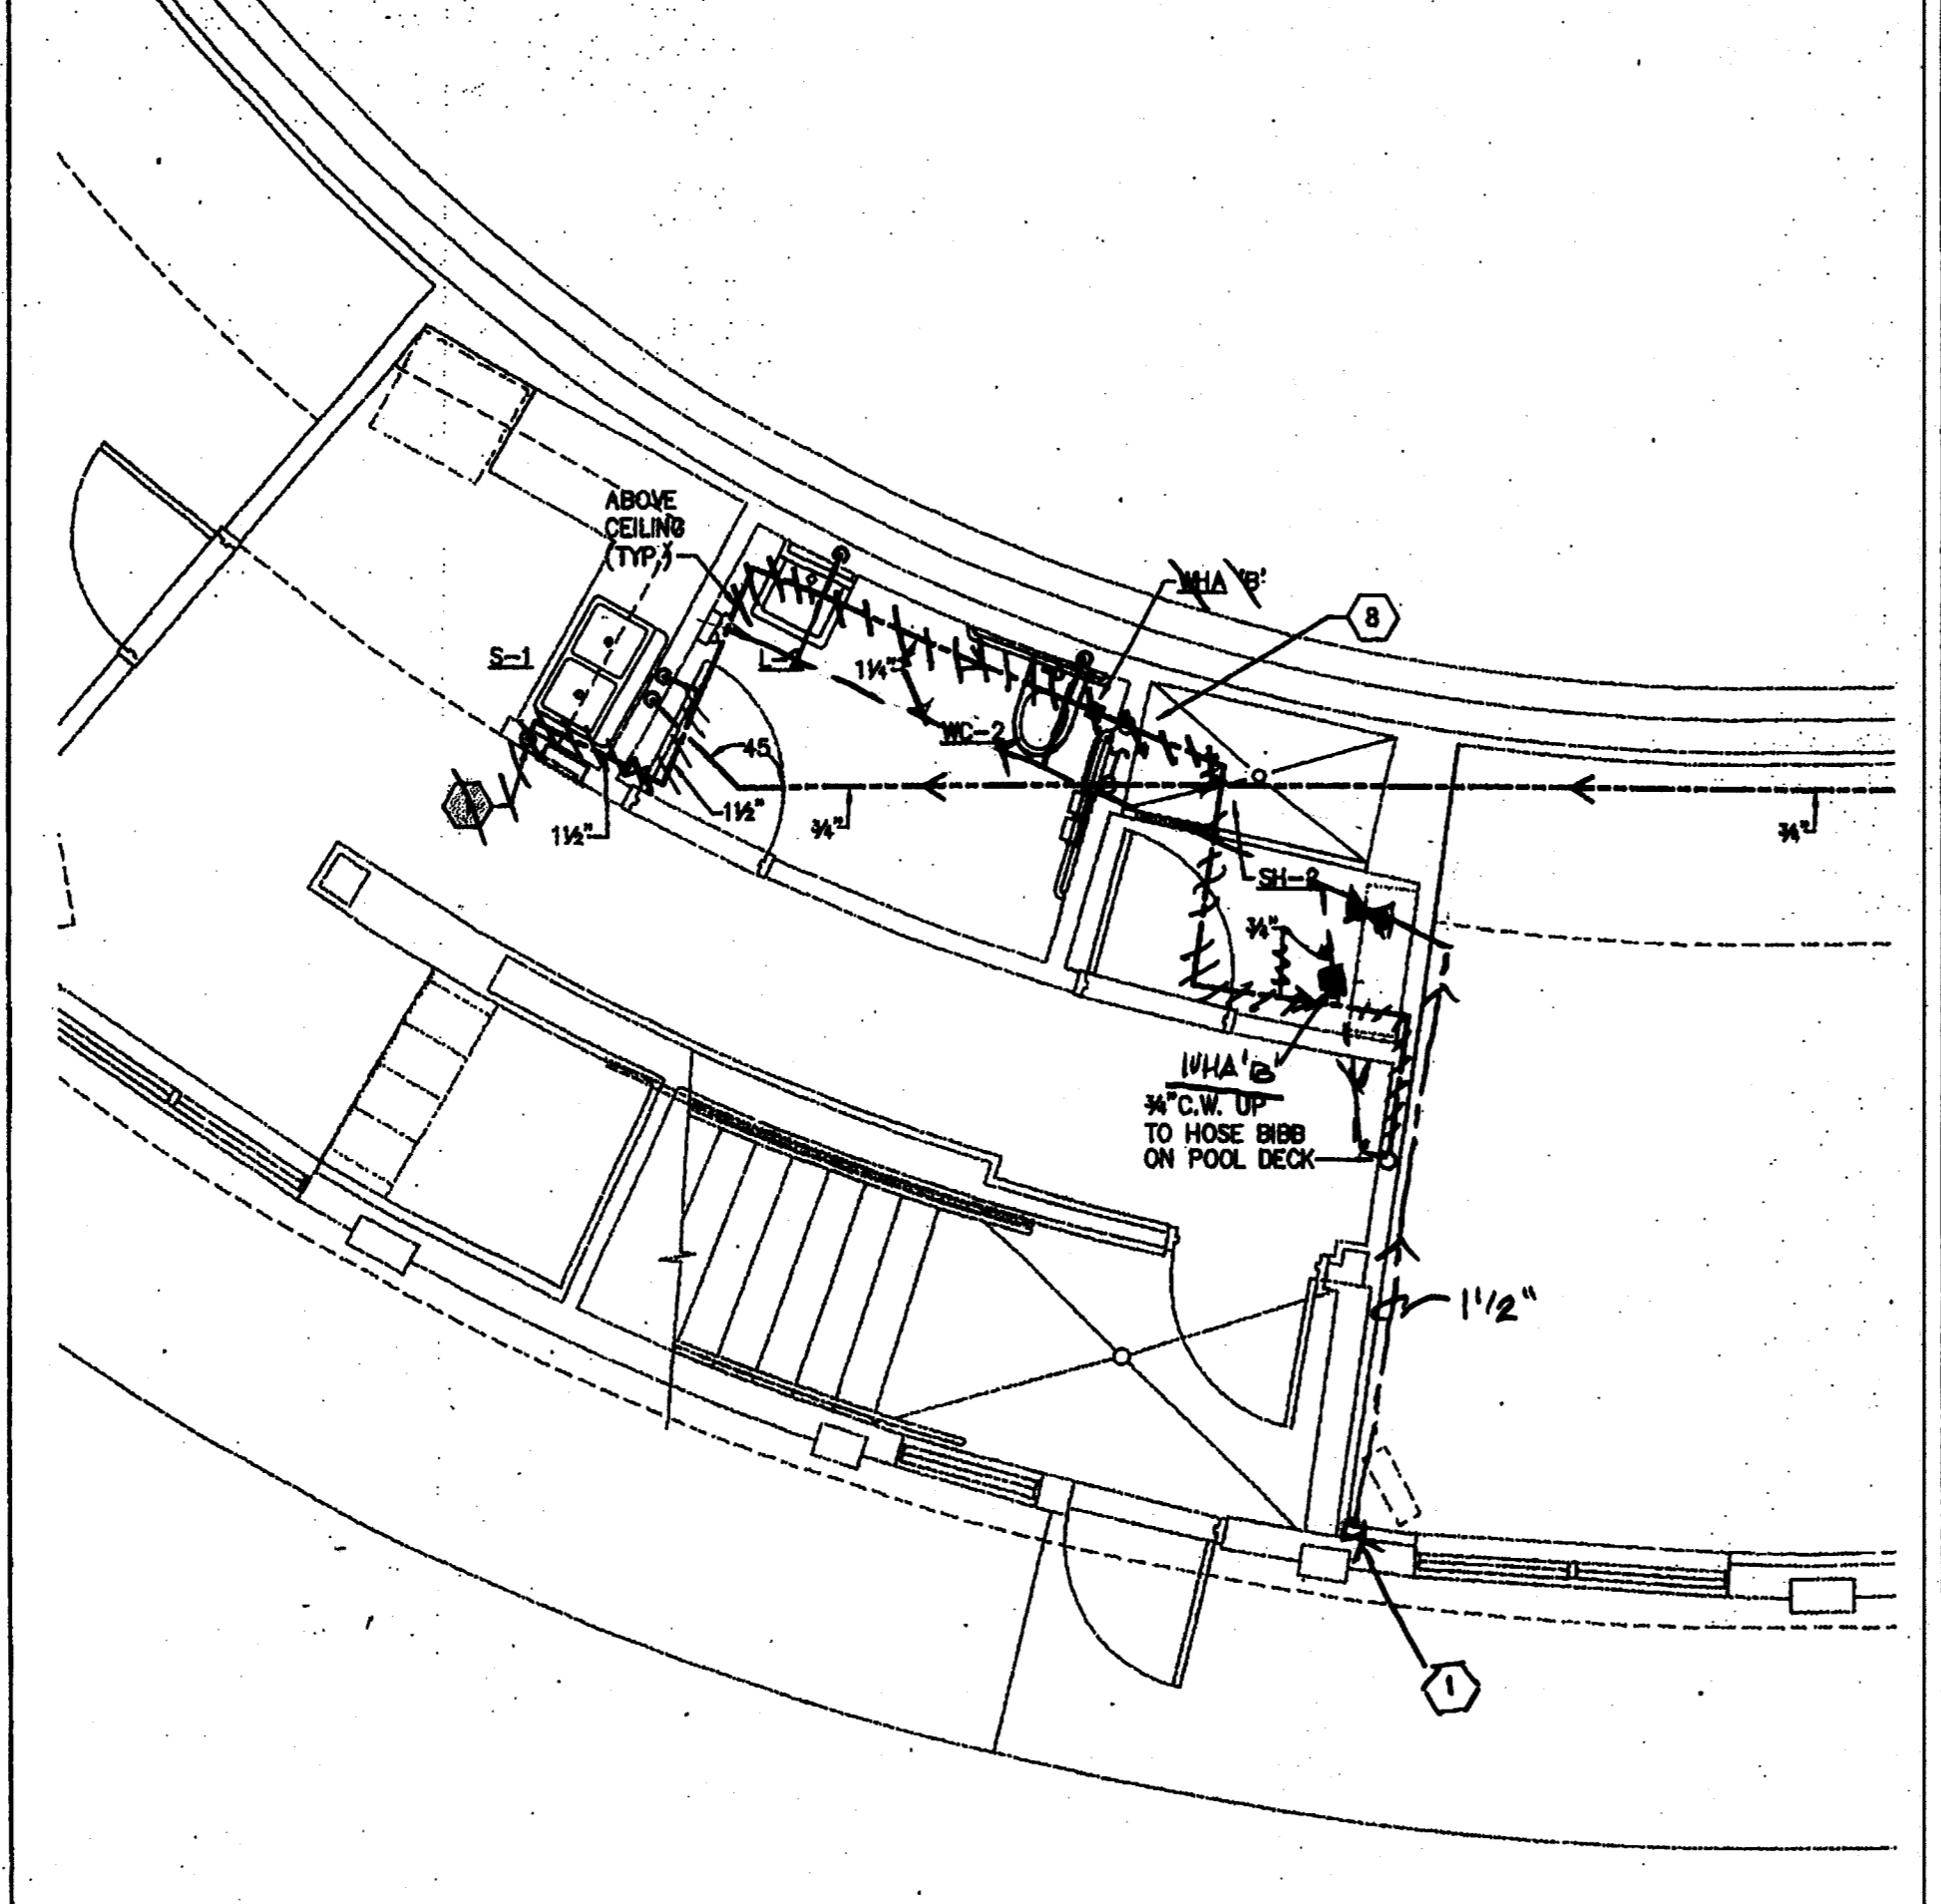

- GENERAL NOTES**
- REFER TO SANITARY RISER DIAGRAMS FOR PIPE SIZES NOT SHOWN ON PLAN.
 - REFER TO FIXTURE SCHEDULE FOR ALL WATER BRANCH SIZE CONNECTIONS, UNLESS OTHERWISE NOTED ON THIS PLAN.
 - REFER TO 1/4" PLAN FOR CONTINUATION OF ALL PIPING.
- KEYED NOTES**
- WATER SUPPLY UP FROM BELOW FLOOR. RISE UP TO ABOVE CEILING.
 - 3/4" DOWN. BRANCH 1/2" TO LAVATORY AND 3/4" TO HOSE BIBB.
 - 3/4" DOWN. BRANCH 1/2" TO EACH LAVATORY AND 3/4" TO EACH HOSE BIBB.
 - 1 1/4" DOWN. BRANCH 1" TO URINAL & 1 1/4" TO WATER CLOSET.
 - 1 1/4" DOWN. BRANCH 1 1/4" TO EACH WATER CLOSET.
 - 3/4" DOWN. BRANCH 1/2" TO EACH LAVATORY.
 - 1 1/4" DOWN. BRANCH 1 1/4" TO WATER CLOSET AND 1/2" TO LAVATORY.
 - 3/4" C.W. AND H.W. DOWN TO SHOWER VALVE.
 - DROP OR RISE TO ALIGN PIPING WITH STRUCTURE, WALLS OR SOFFIT.
 - GAS SERVICE AND GAS METER SHALL BE INSTALLED BY LOCAL GAS SUPPLIER. GAS METER SHALL BE SIZED TO DELIVER 1/2 LB. PSI TO POOL HEATER.
 - INSTALL GAS PIPING BELOW SLAB TO POOL HEATER. DO NOT INSTALL PIPING IN FOOTING OR CONCRETE SLAB.

4 Lifeguard Lounge and Staff Toilet

2 Men's Toilet and Toilet 102

1/4"=1'-0"


1/4"=1'-0"


CUSCADEN POOL RENOVATION

CITY OF TAMPA
308 East Jackson Street
Tampa, Florida 33602

Project No.	0202.00
Distribution	Date
BID DOCUMENTS	02.02.04
REVISION A	05.07.04

Enlarged Plans -
Plumbing
RECORD DWG.
DATE 02/26/05

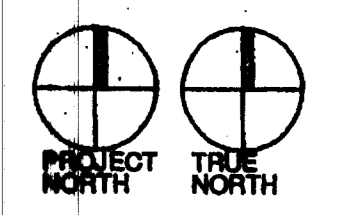

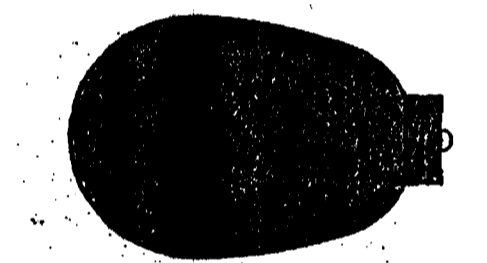

**CUSCADEN
POOL
RENOVATION**


CITY OF TAMPA
306 East Jackson Street
Tampa, Florida 33602

Project No. 0802.00

Distribution	Date
BID DOCUMENTS	02.02.04
REVISION A	05.07.04

RISERS
PLUMBING


RECORD DWG.
DATE 8/26/05

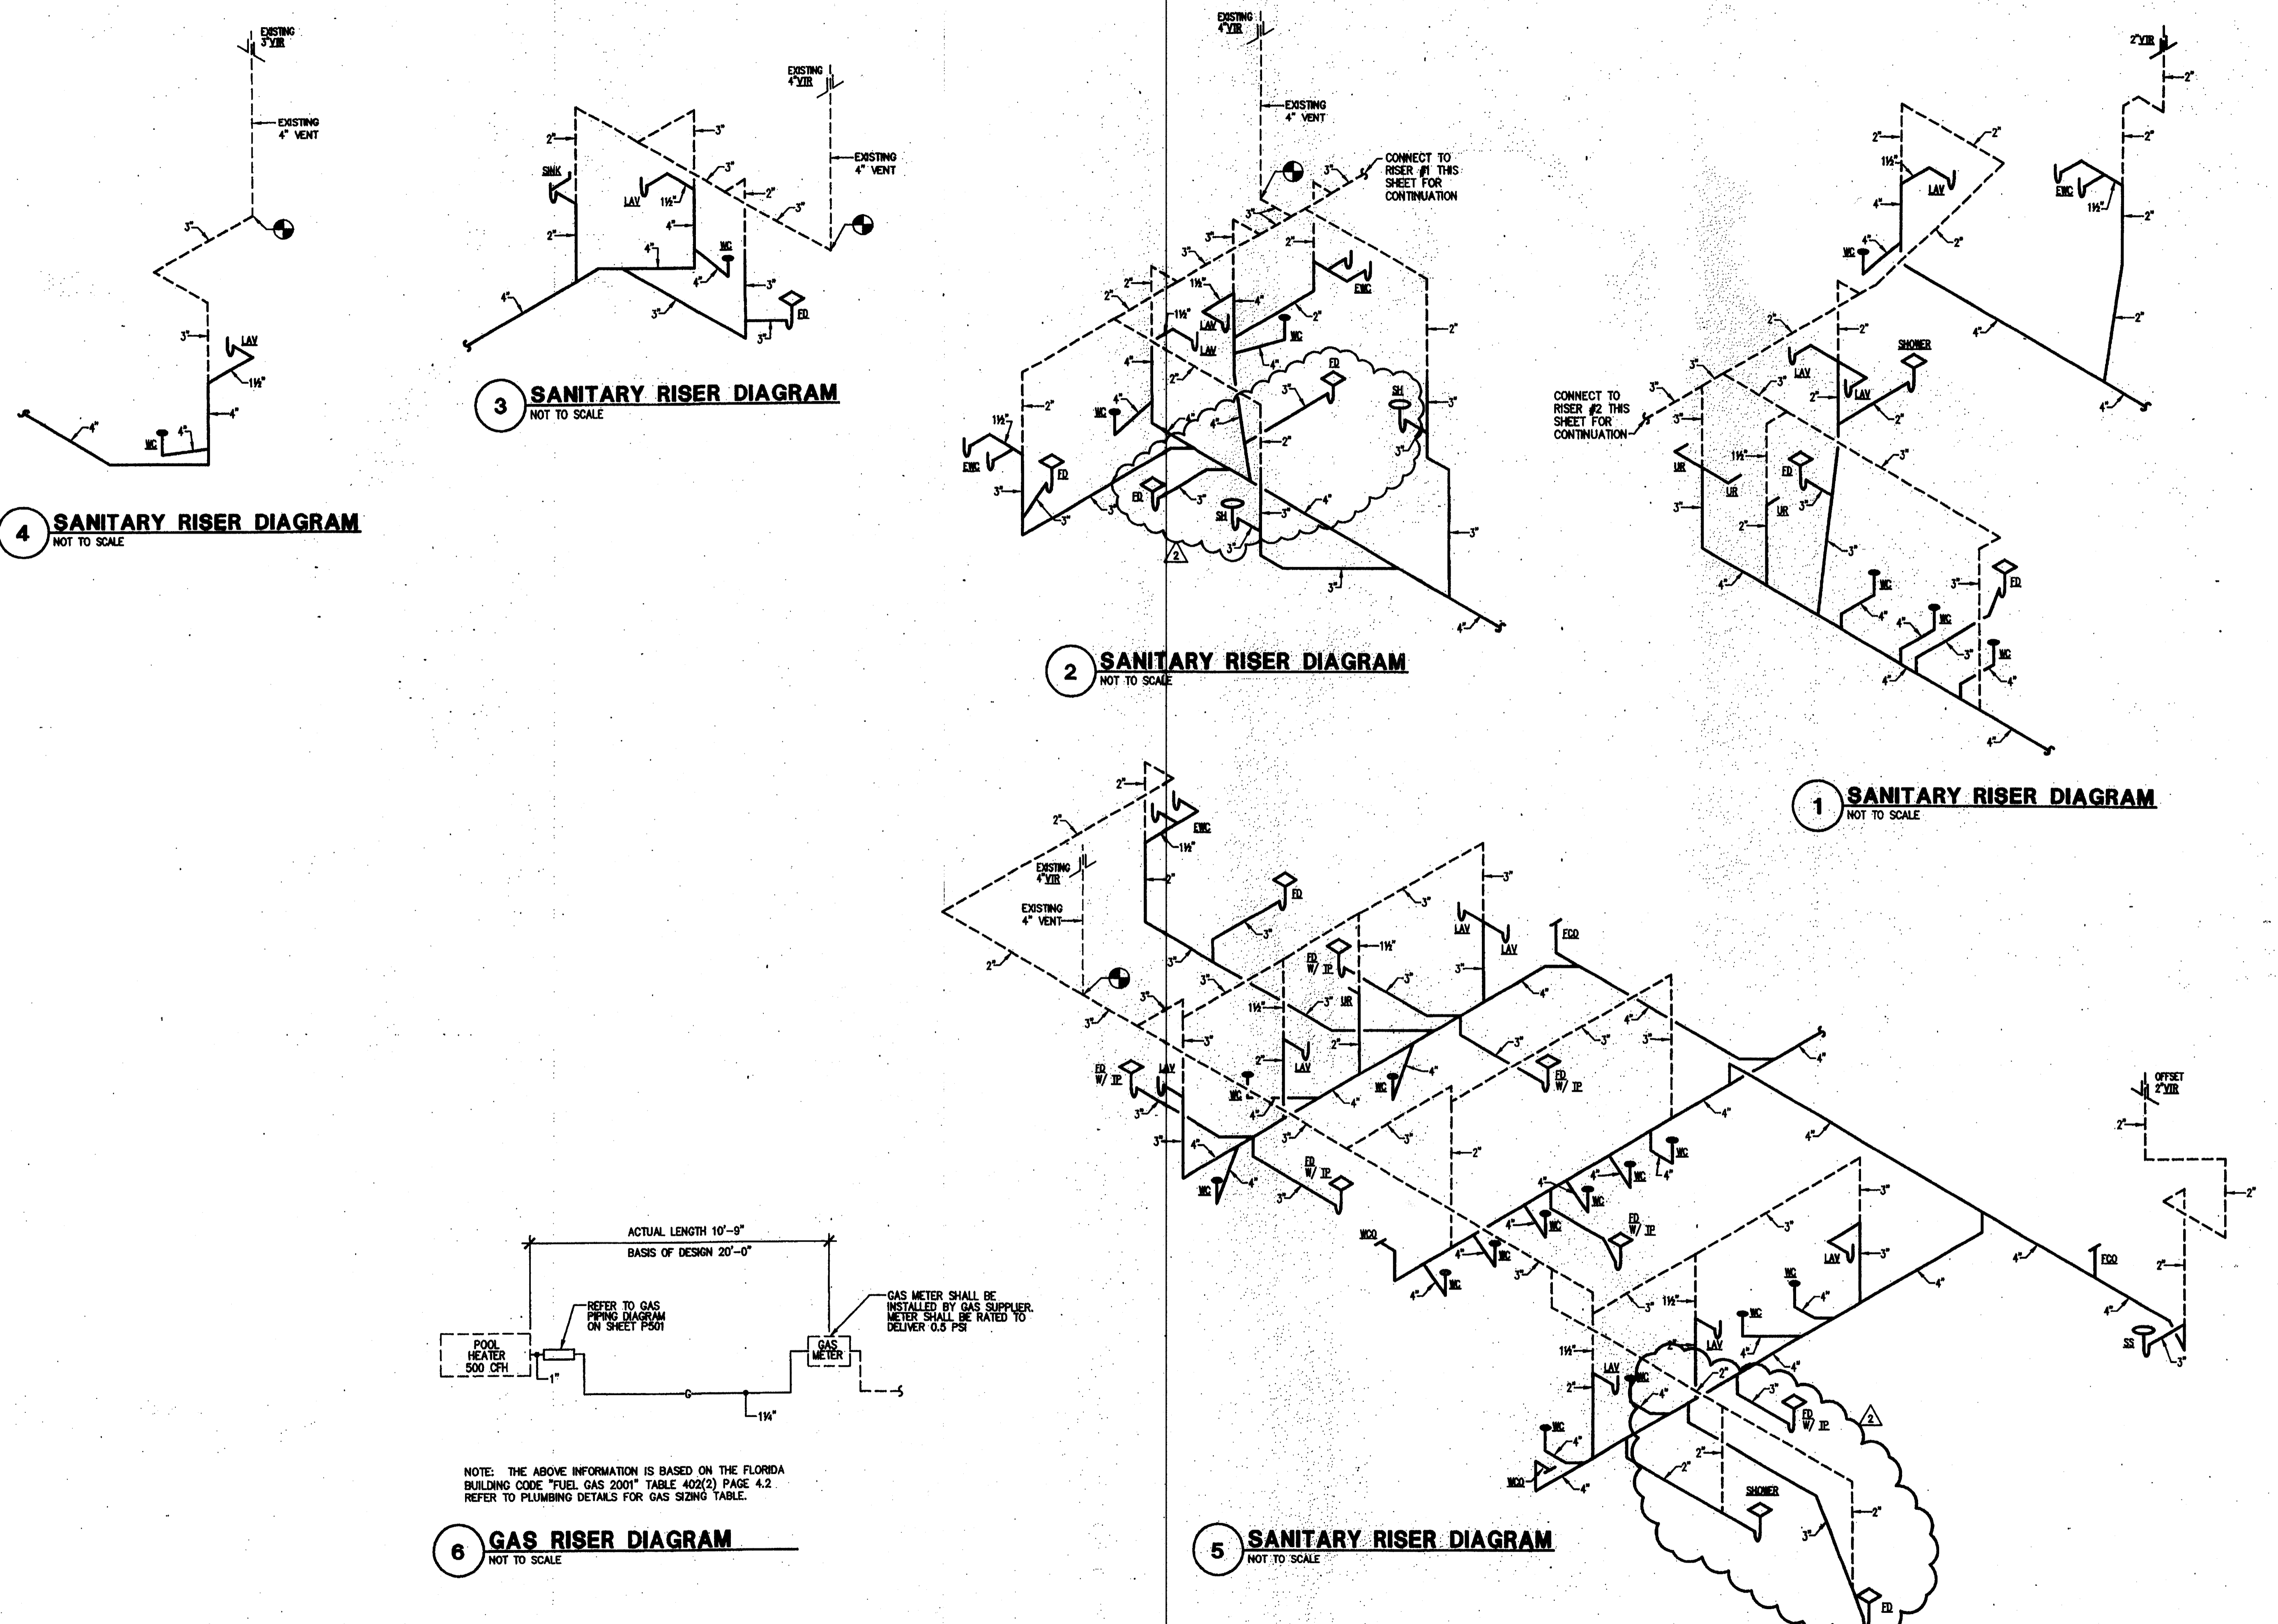

3 SANITARY RISER DIAGRAM
NOT TO SCALE

2 SANITARY RISER DIAGRAM
NOT TO SCALE

1 SANITARY RISER DIAGRAM
NOT TO SCALE

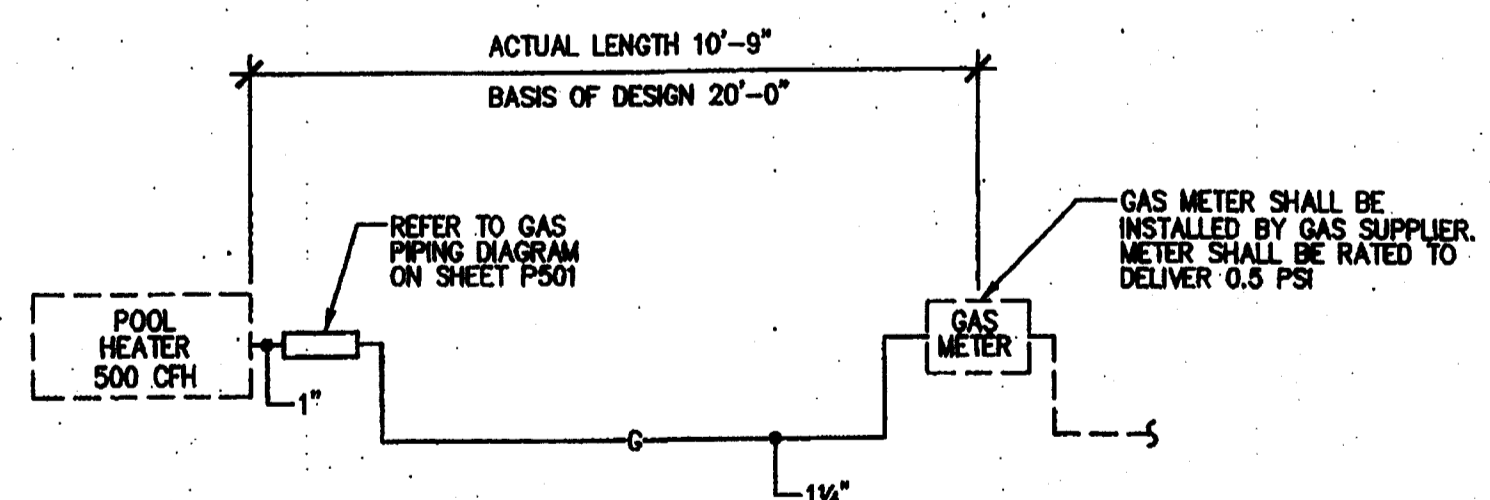

6 GAS RISER DIAGRAM
NOT TO SCALE

5 SANITARY RISER DIAGRAM
NOT TO SCALE

4 SANITARY RISER DIAGRAM
NOT TO SCALE


RISERS - PLUMBING

NOT TO SCALE

TABLE 402(2)
MAXIMUM CAPACITY OF PIPE IN CUBIC FEET OF GAS PER HOUR FOR GAS PRESSURES OF 0.5 PSI AND A PRESSURE DROP OF 0.5 INCH WATER COLUMN
(BASED ON A 0.60 SPECIFIC GRAVITY GAS)


NOMINAL PIPE SIZE	LENGTH OF PIPE, FEET															
	10	20	30	40	50	60	70	80	90	100	125	150	175	200		
1/4	43	29	24	20	18	16	15	14	13	12	11	10	9	8		
3/8	85	57	48	40	36	33	31	29	27	25	23	21	19	17		
1/2	127	86	72	60	54	49	46	43	40	37	34	31	28	25		
3/4	170	114	96	80	72	66	61	57	53	50	46	42	38	34		
1	213	141	120	100	90	84	78	73	69	65	60	56	51	47		
1 1/4	256	168	144	120	108	100	93	88	83	78	73	68	63	58		
1 1/2	300	196	168	140	126	116	108	101	95	90	84	79	74	69		
2	384	252	216	180	162	150	141	133	125	118	111	104	97	91		
2 1/2	468	308	264	220	198	184	173	164	155	147	139	131	123	115		
3	552	364	312	260	234	216	203	192	183	174	165	156	147	138		
3 1/2	636	420	360	300	270	248	233	221	211	201	191	182	173	164		
4	720	476	408	340	306	280	263	250	239	228	217	207	197	187		
POOL HEATER	500 CFH															

NOTE: THE ABOVE TABLE REFERENCES FLORIDA BUILDING CODE "FUEL GAS 2001" PAGE 4.2

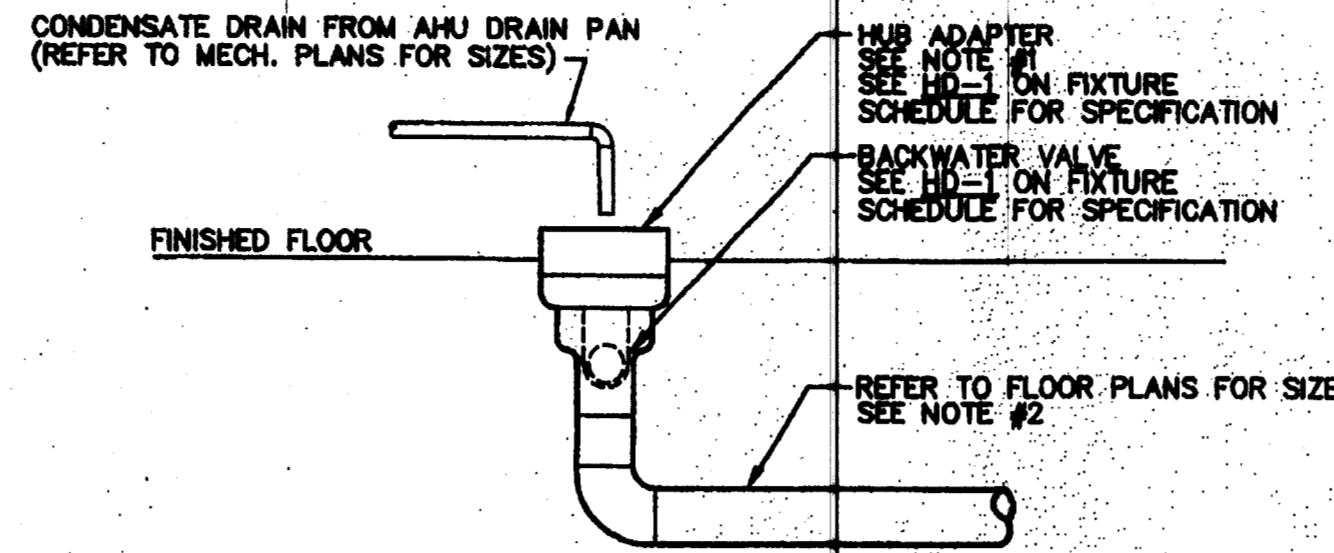


NOTES:
1. LOCATE HUB DRAIN AS CLOSE AS POSSIBLE TO HOUSEKEEPING PAD FOR MECHANICAL EQUIPMENT. COORDINATE WITH MECHANICAL CONTRACTOR FOR LOCATION OF HOUSEKEEPING PAD PRIOR TO FINAL ROUGH-IN OF HUB DRAIN.


3 TYPICAL HUB DRAIN DETAIL
NO SCALE

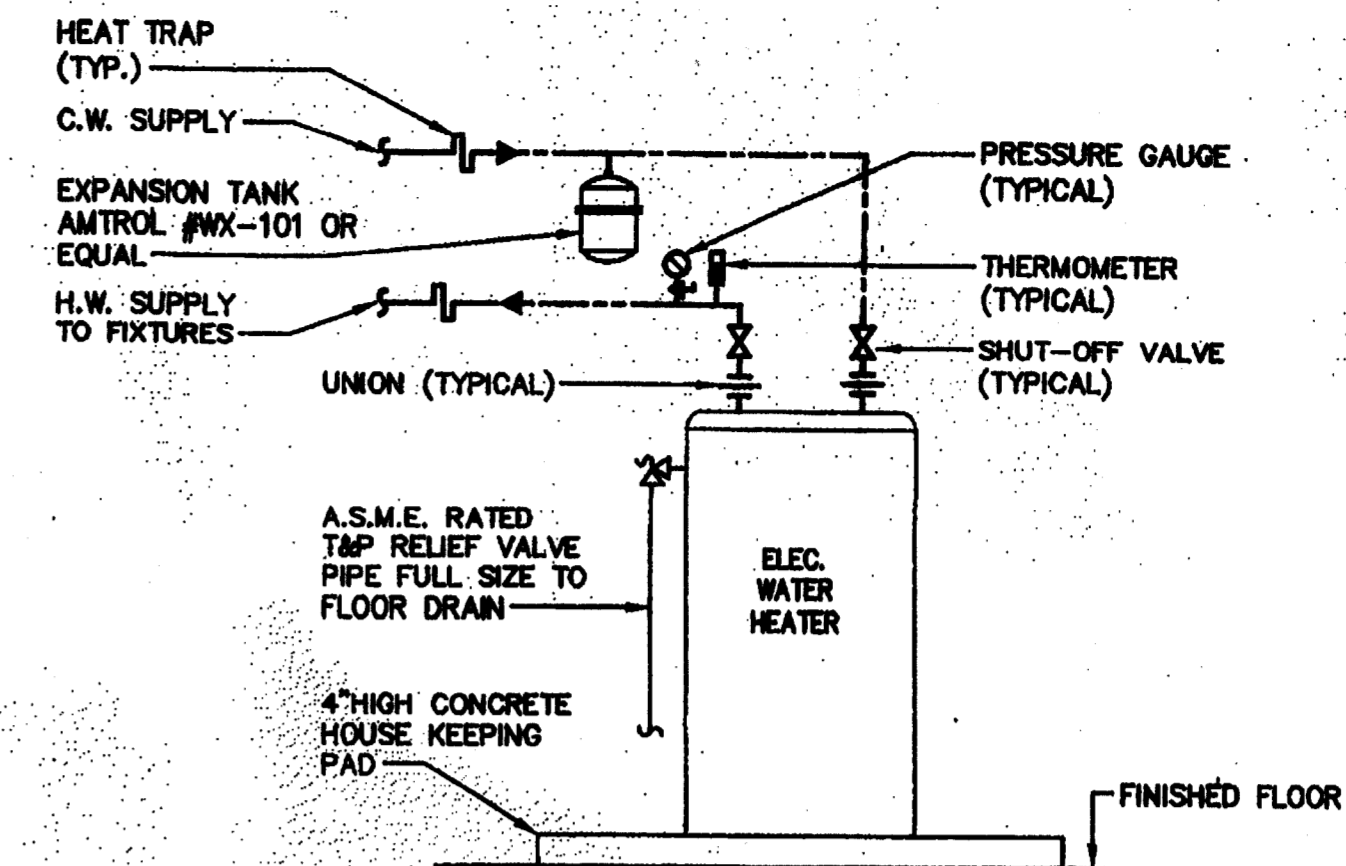


1 WATER HEATER DIAGRAM
NO SCALE

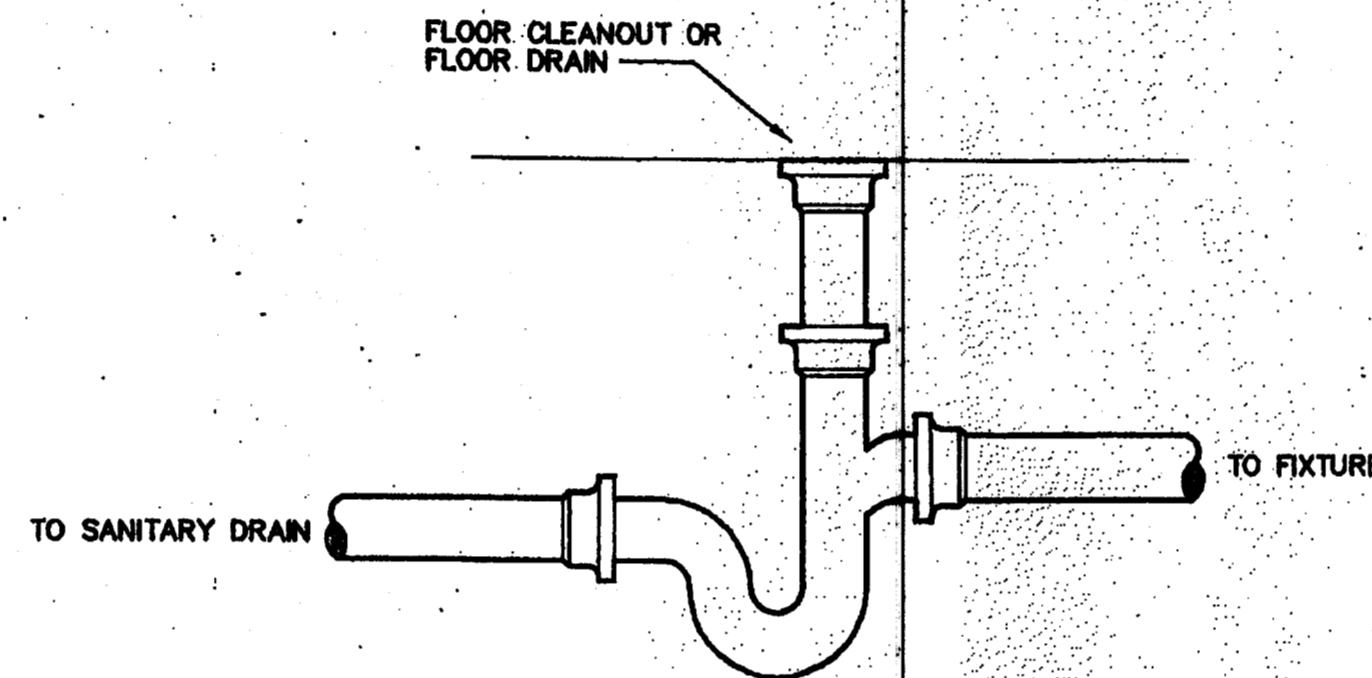

4 RUNNING P-TRAP DETAIL
NO SCALE

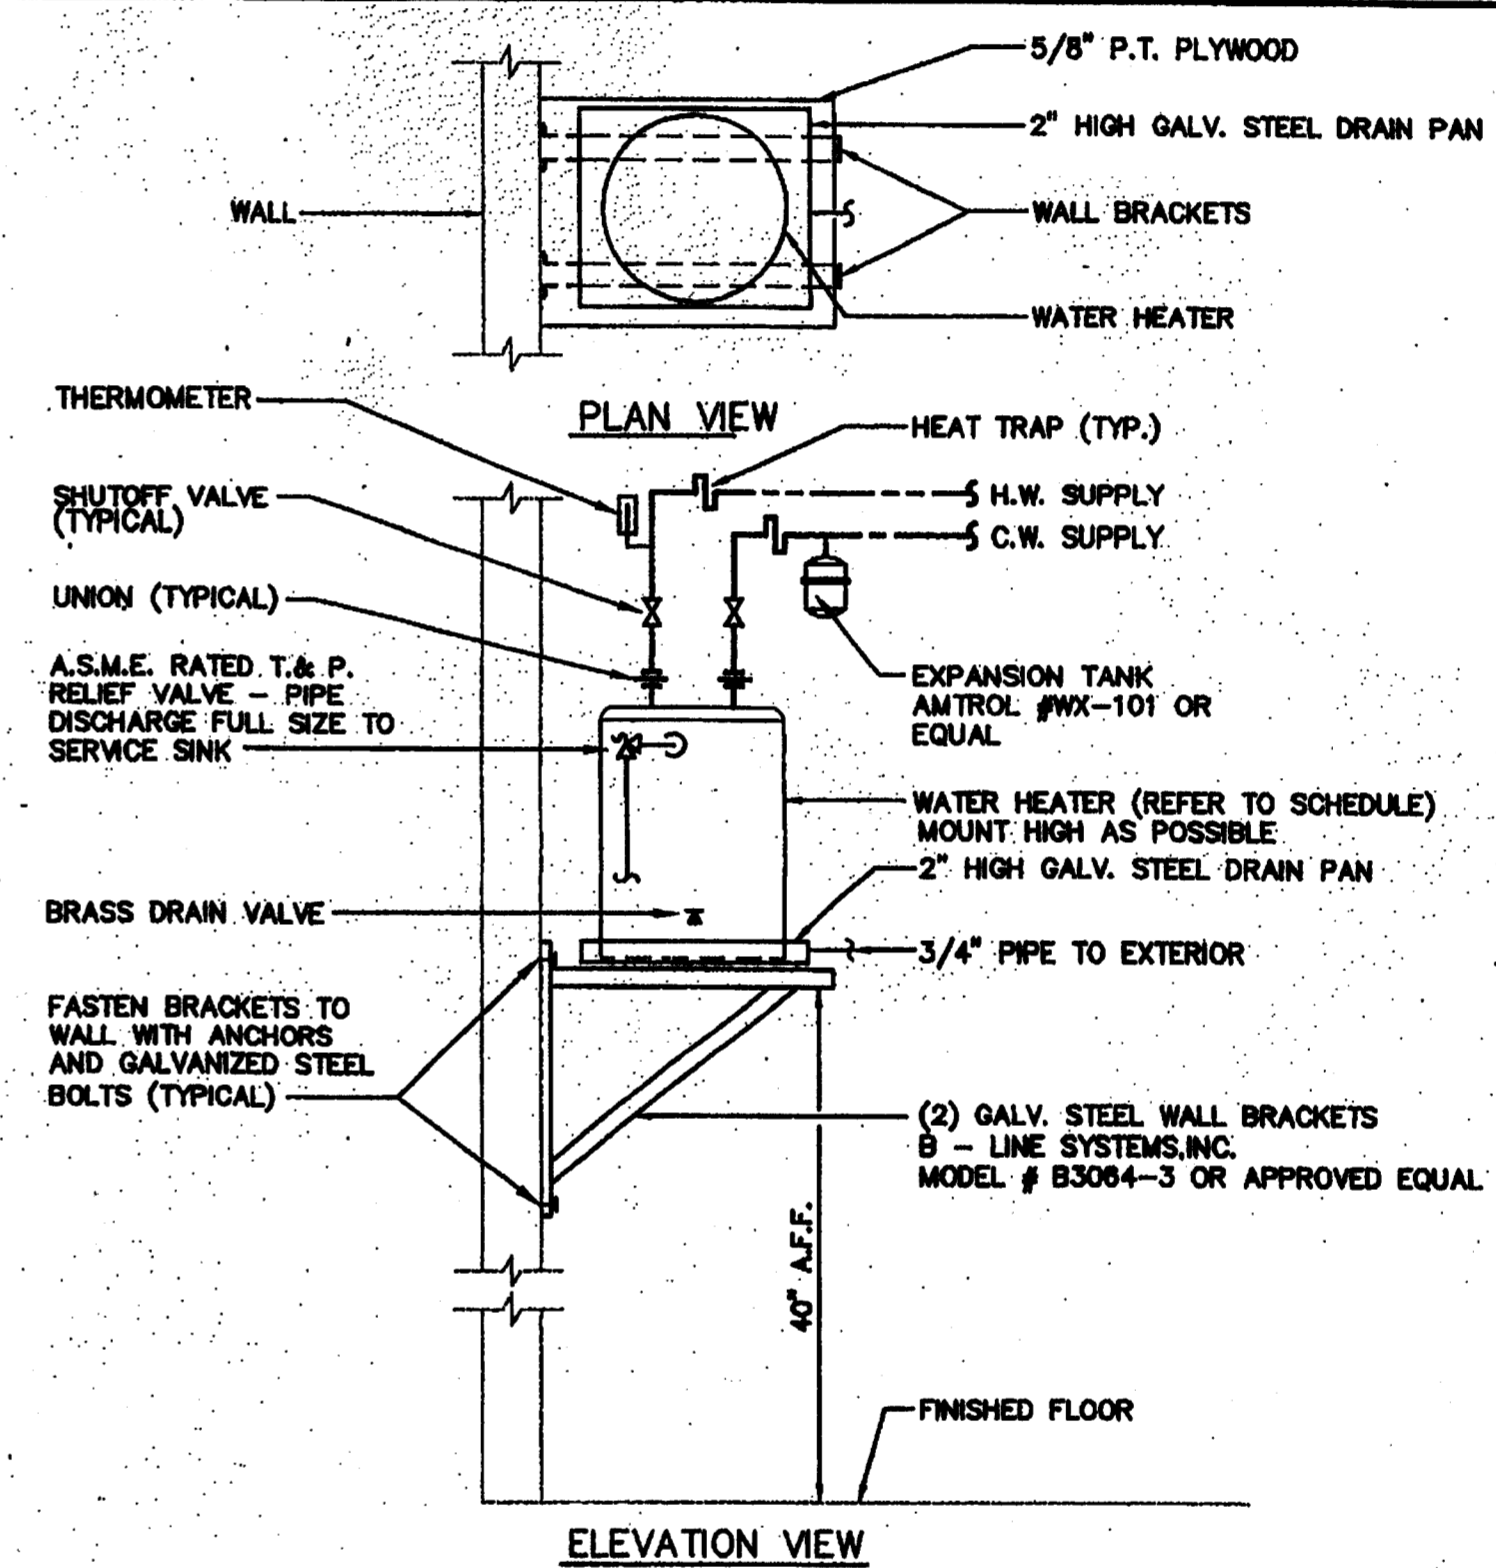

2 WALL HUNG WATER HEATER DETAIL
NO SCALE

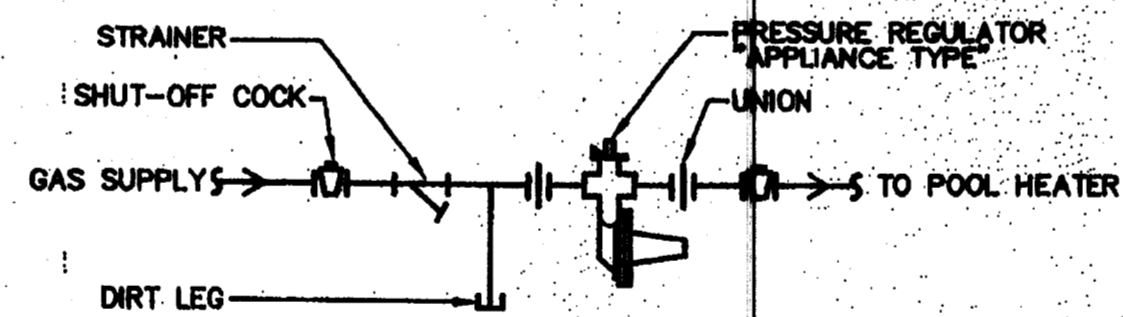


5 GAS PIPING DIAGRAM FOR POOL HEATER
NO SCALE

ROWE ARCHITECTS
INCORPORATED
100 Madison Street, Suite 200
Tampa, Florida 33602-4704
www.RoweArchitects.com
Fax: 813.221.9184
813.221.8771
AAC002172

ENGINEERING MATRIX INC.
CONSULTING ENGINEERS
2905 SCHEIDT BLVD., SUITE 100
ST. PETERSBURG, FLORIDA 33716
(813) 921-1100 (LOCAL) (813) 921-1100 (TOLL FREE)
CERT. OF AUTHORIZATION NO. 0000

Engineering Matrix, Inc.
State of Florida License No. 88071
Florida License No. 88071

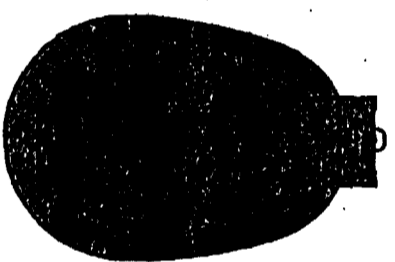

CUSCADEN
POOL
RENOVATION

CITY OF TAMPA
300 East Jackson Street
Tampa, Florida 33602

Project No. 0202.00

Distribution Date
BID DOCUMENTS 02.02.04
REVISION A 05.07.04

DETAILS
PLUMBING

RECORD DWG


DATE 8/26/05

DETAILS - PLUMBING

NOT TO SCALE

P501

217
029

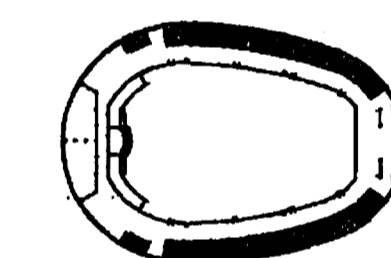

CUSCADEN POOL RENOVATION


CITY OF TAMPA
308 East Jackson Street
Tampa, Florida 33602

Project No.0202.00

Distribution	Date
BID DOCUMENTS	02.02.04
DOH PERMIT SUBMITTAL	07.12.04


PLUMBING LAYOUT
SCALE 3/8" = 1'-0"

RECORD DWG.
DATE 8/26/05

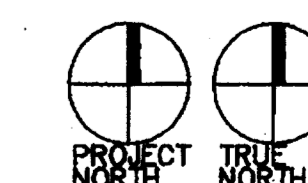

Q101

APPROVED
HILLSBOROUGH COUNTY HEALTH DEPARTMENT

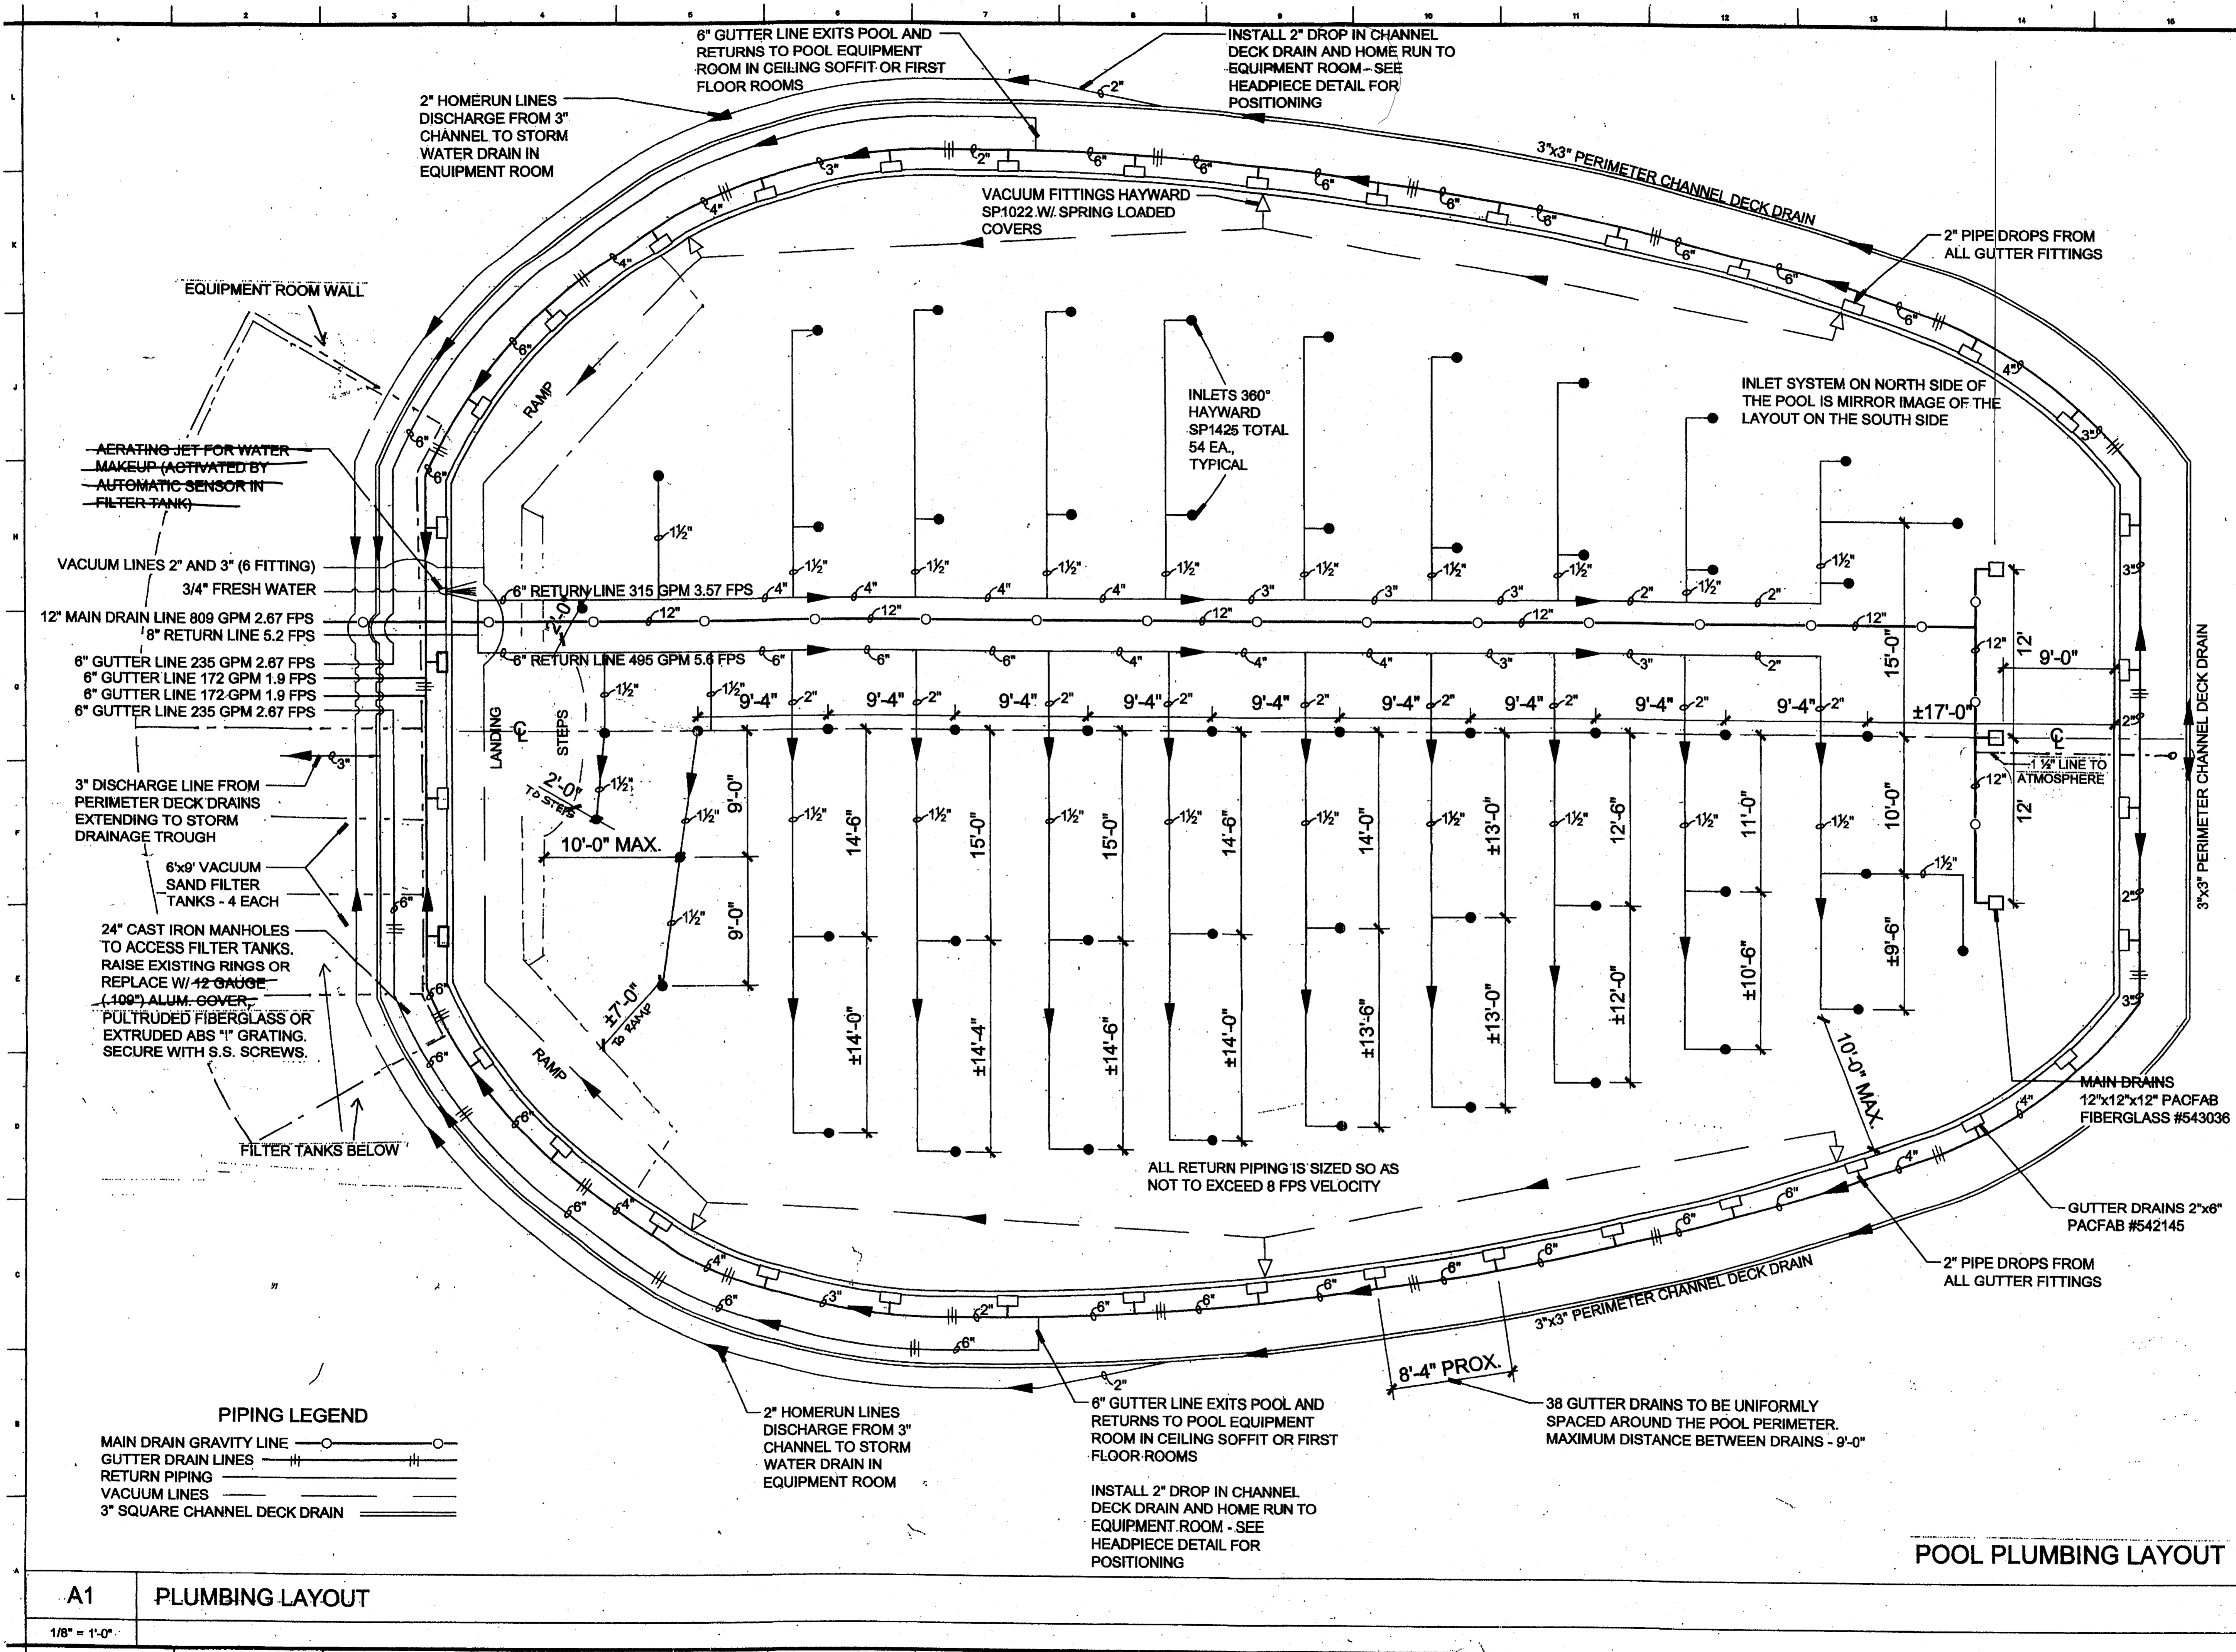


PIPING LEGEND

- MAIN DRAIN GRAVITY LINE
- GUTTER DRAIN LINES
- RETURN PIPING
- VACUUM LINES
- 3" SQUARE CHANNEL DECK DRAIN

A1 PLUMBING LAYOUT

1/8" = 1'-0"


2/7 009

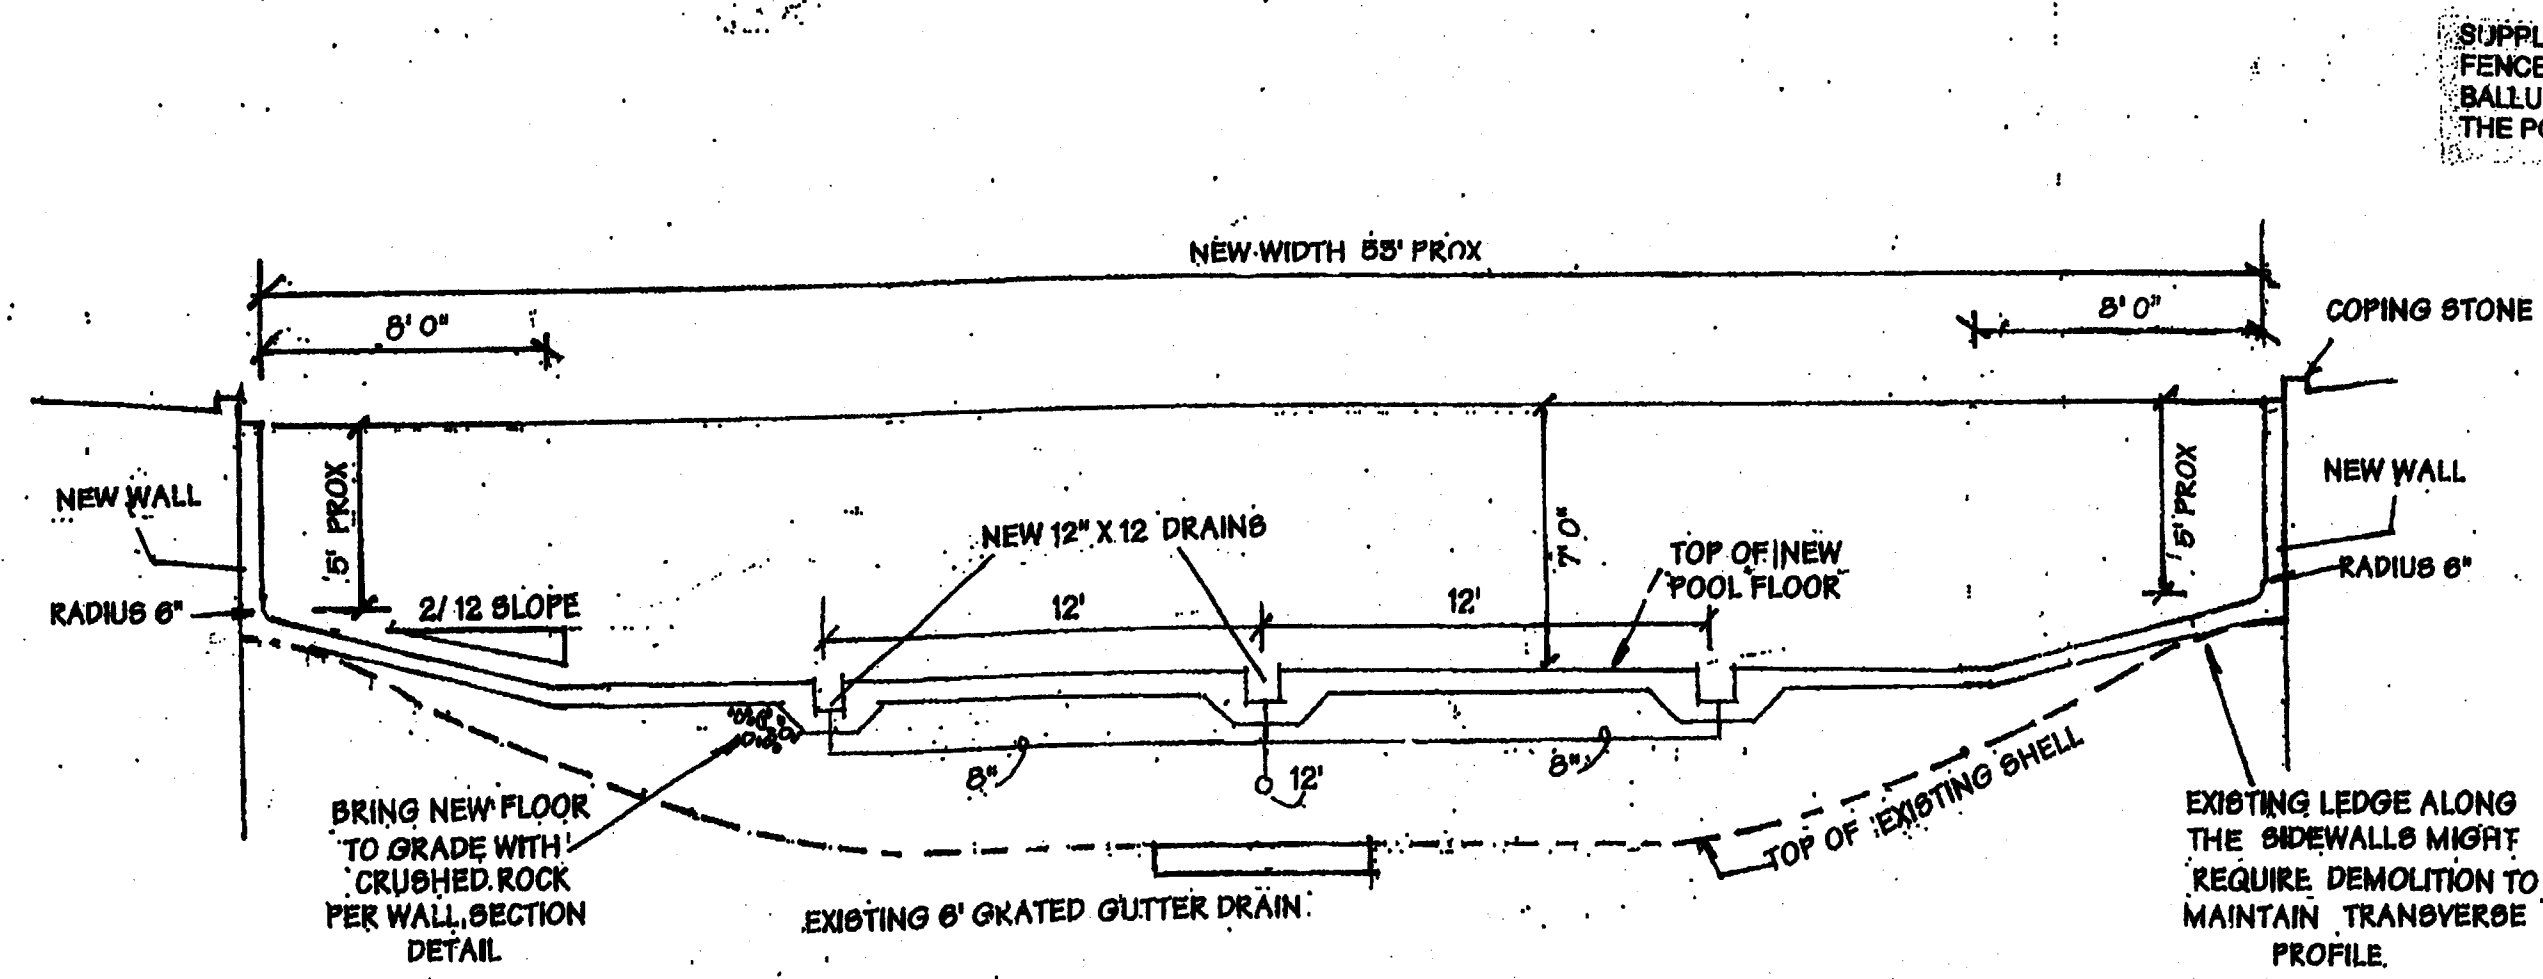

TRANSVERSE SECTION @ DEEP POINT

SCALE 3/16" = 1'-0"

SUPPLEMENTARY CHILD PROOF FENCE NOT REQUIRED BEHIND BALLUSTRADE FENCE SEPARATE THE POOL FROM THE SPLASH PAD.

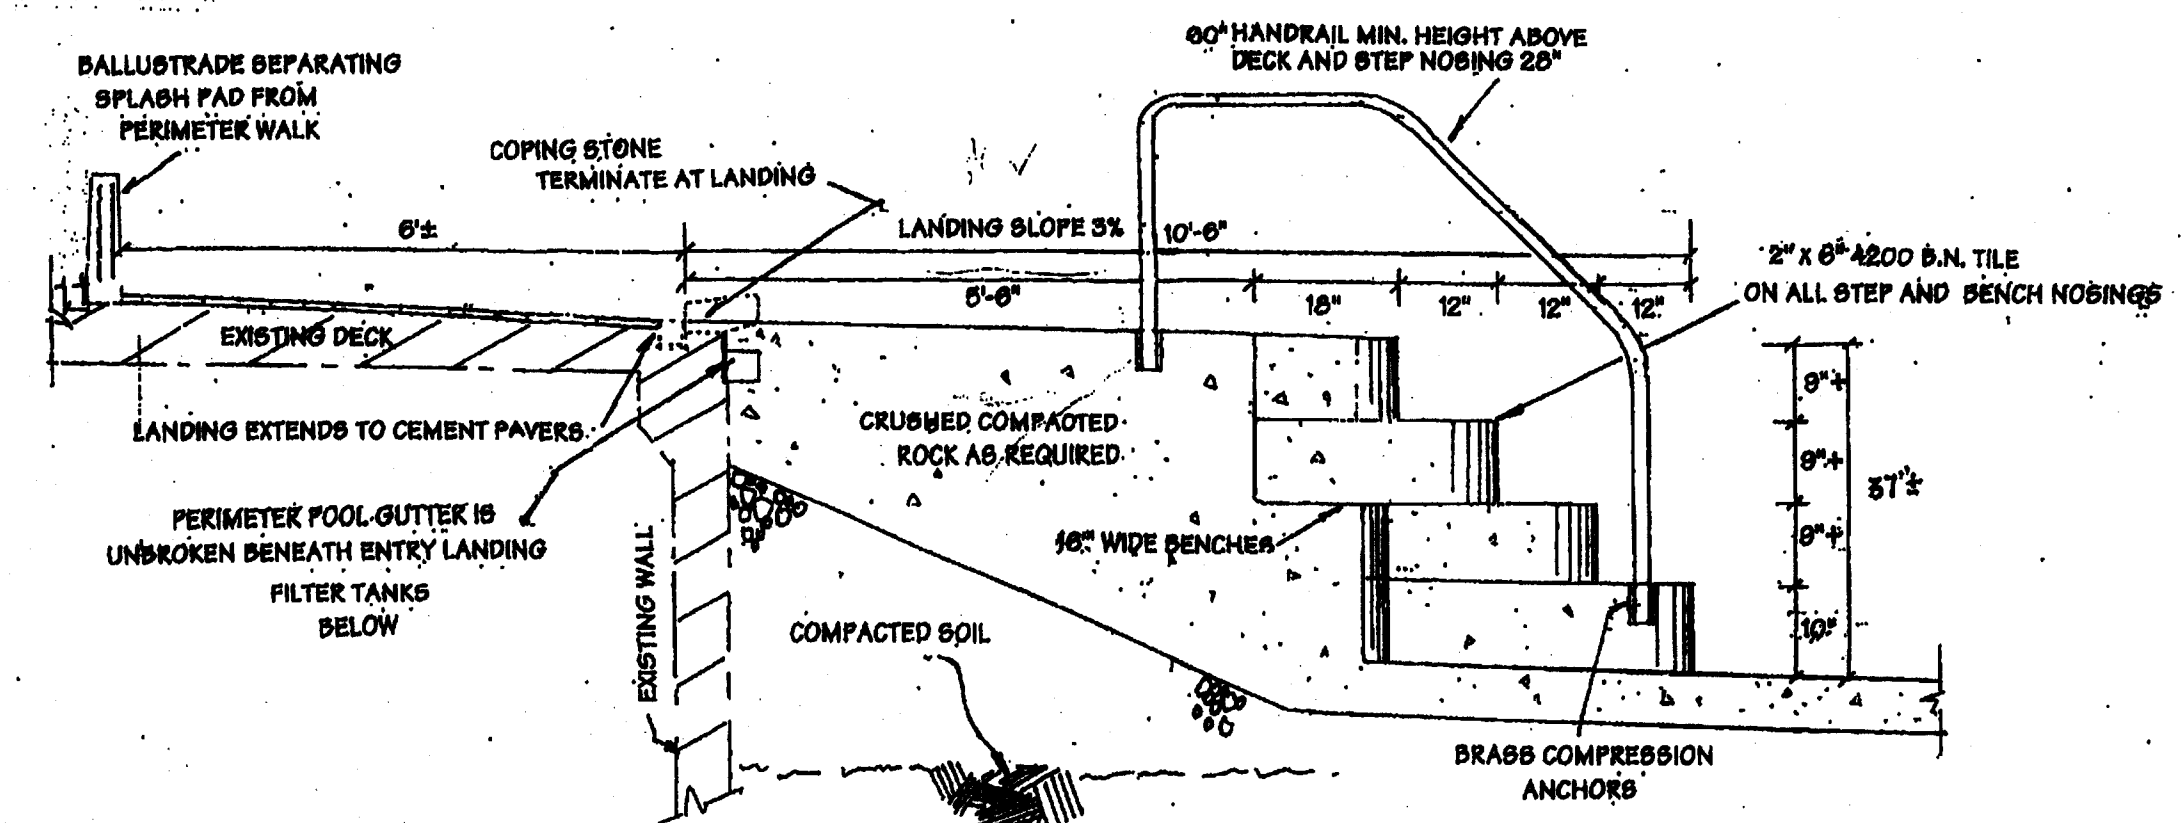


SECTION THRU ENTRY LANDING AND STEP

SCALE 1/4" = 1'-0"

STAIRS SHALL HAVE A MINIMUM TREAD WIDTH OF 10 INCHES FOR A MINIMUM TREAD LENGTH OF 24 INCHES AND A MAXIMUM RISER HEIGHT OF 10 INCHES. TREADS AND RISERS BETWEEN THE TOP AND BOTTOM TREADS SHALL BE UNIFORM IN WIDTH AND HEIGHT.

Silcox Engineering, Inc. Civil Engineering
 ERNEST S. SILCOX P.E. #0008161
 Post Office Box 8374
 Tampa, FL 33674 813920-9192

Handwritten initials and date: E.S. 11-4-05

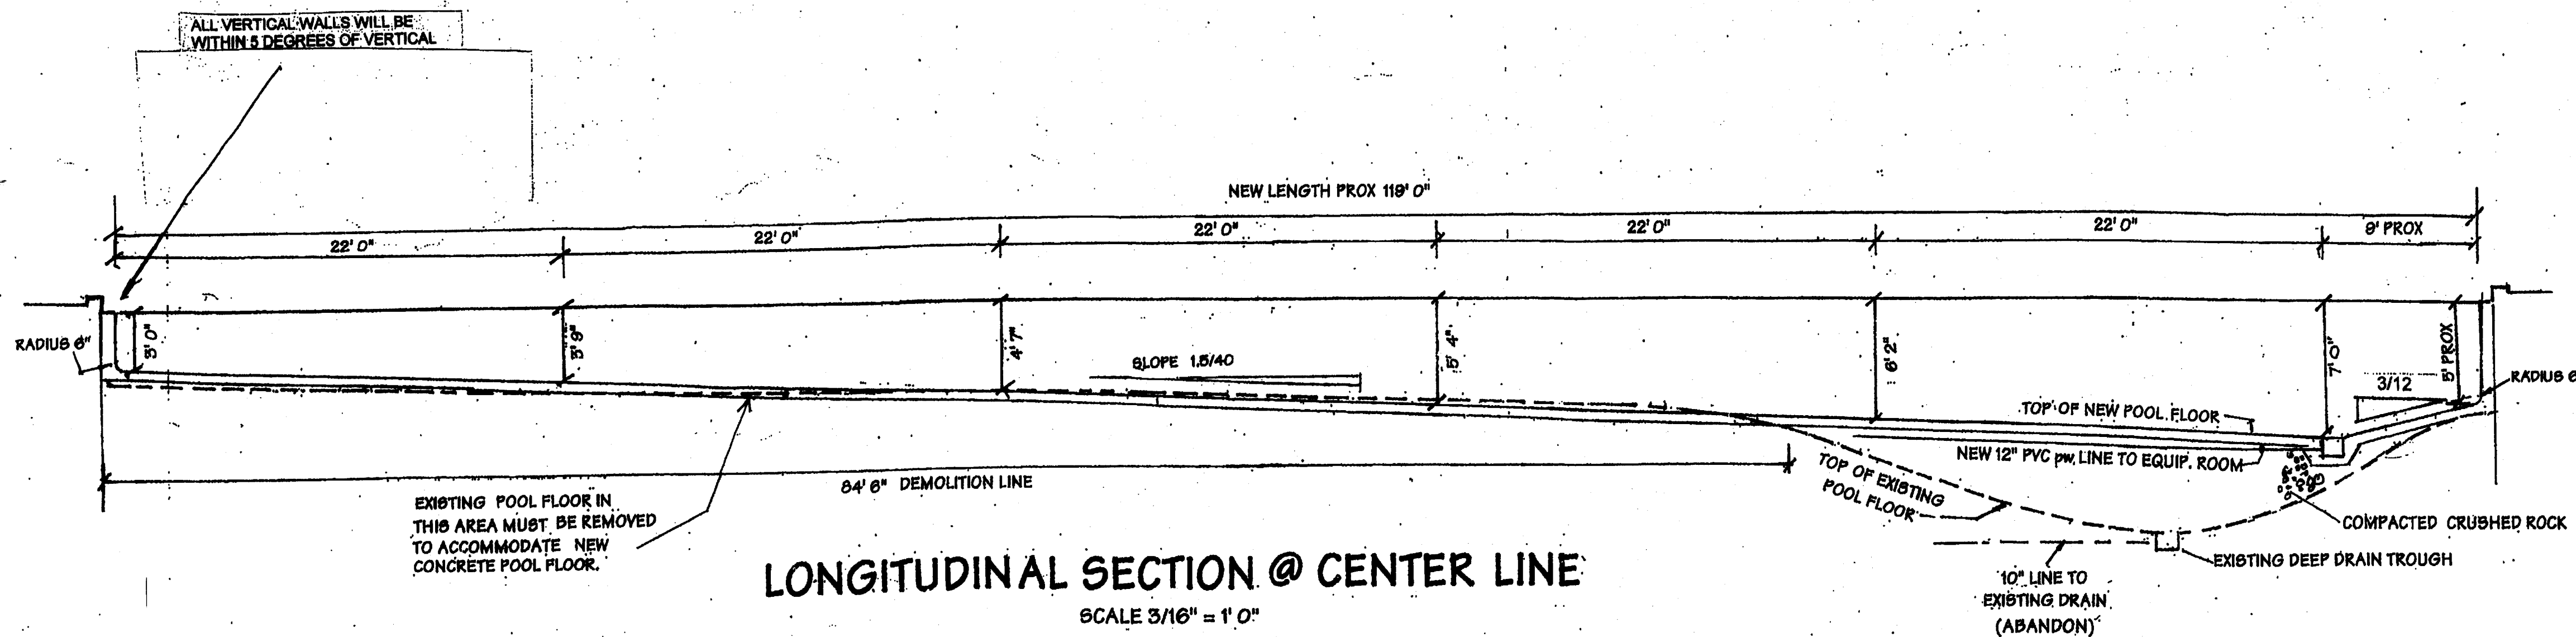

LONGITUDINAL SECTION @ CENTER LINE

SCALE 3/16" = 1'-0"


POOL SECTIONS AND STEP DETAIL

RECORD DWG.
 DATE 8/26/05

SHEET Q301

APPROVED
 HILLSBOROUGH COUNTY HEALTH DEPARTMENT

2/7
 009

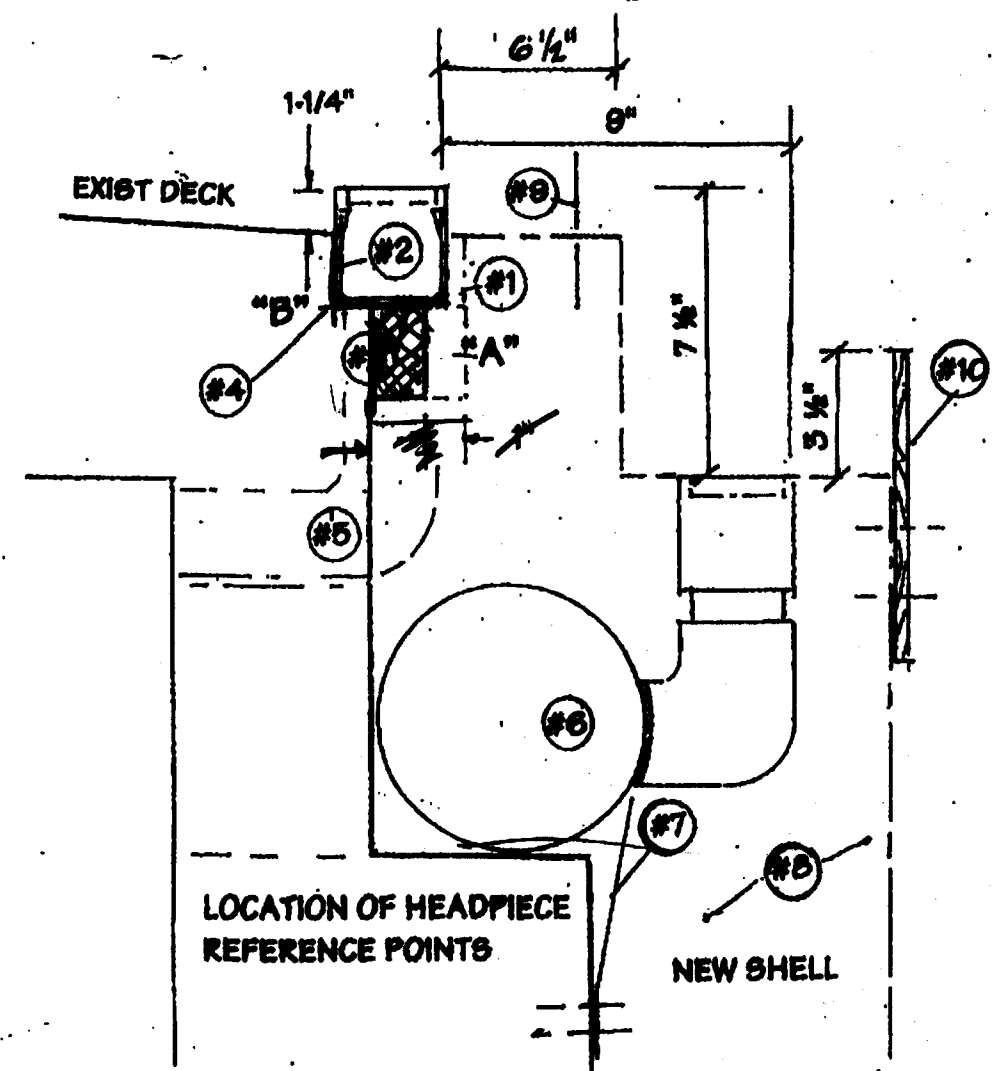

RECOMMENDED PROCEDURE FOR CONSTRUCTING NEW PERIMETER HEADPIECE DETAIL ON THE EXISTING POOL

(SEE REDUCED NUMBERED KEY ABOVE)


- 1) SHORTEN EXISTING DECK CANTILEVER (A) BY 1" WITH A VERTICAL CUT THRU THE 4" FACE.
- 2) THEN CUT VERTICAL REBATE INTO EXISTING DECK AT "B" PROX 2 1/4" FROM THE NEWLY EXPOSED VERTICAL FACE. THIS WILL RECEIVE THE NDS PERIMETER DECK DRAIN AS SHOWN.
- 3) IDENTIFY THE HIGH POINT IN THE POOL DECK. MAKE HORIZONTAL CUT INTO THE NEWLY EXPOSED DECK FACE COMMENCING AT 1 3/4" FROM THE TOP OF DECK AT THE HIGH POINT AROUND THE ENTIRE POOL. THIS CUT MUST BE LEVEL SINCE IT WILL CREATE A "PLATFORM" FOR PLACEMENT OF THE NDS PERIMETER DRAIN.

SAWCUTS MUST BE ACCURATE, LEVEL AND STRAIGHT OR MUST MATCH EXISTING DECK CONTOUR RADI.

- 4) POSITION NDS DRAIN IN PLACE TO THE HORIZONTAL CUT AND POSITIONED TIGHTLY AGAINST THE VERTICAL CUT. SECURE IN PLACE WITH MASONRY FASTENERS SUCH AS 1/4" X 3/4" S.S. PIN GRIP THROUGH BOTTOM OF THE DRAIN. THE NDS DRAIN WILL THEN BECOME A "GROUND" FOR THE CONSTRUCTION OF THE NEW SWIMMING POOL HEADPIECE AND WALL.
- 5) 2" DRAIN LINE FROM THE NDS CHANNEL DRAIN (4 EA.) ARE TO BE INSTALLED, EXTENDED THROUGH THE EXISTING POOL WALL, AND PIPED TO WASTE AS SHOWN ON THE PLUMBING DETAIL.
- 6) INSTALL 6" SCH. 40 PVC PW DRAIN LINE TOGETHER WITH 8" SUB-UPS AND 2" X 6" PENTAIR GUTTER DRAINS AS SHOWN ON THIS DETAIL. DRAINS MUST BE PRECISELY THE RIGHT ELEVATION, LEVEL, AND MUST PARALLEL THE EXISTING POOL WALL.

THE TOP OF THE GUTTER DRAINS SHOULD THEN BE CAREFULLY MASKED WITH SUN-PROOF MARKING TAPE TO PROTECT THEM DURING THE GUNNING.

GUTTER DRAINS EXIT THE SWIMMING POOL AT FOUR POINTS AS SHOWN ON THE PLUMBING SHEET. CORE THE EXISTING WALL AND INSTALL 6" THIMBLES AS SHOWN.

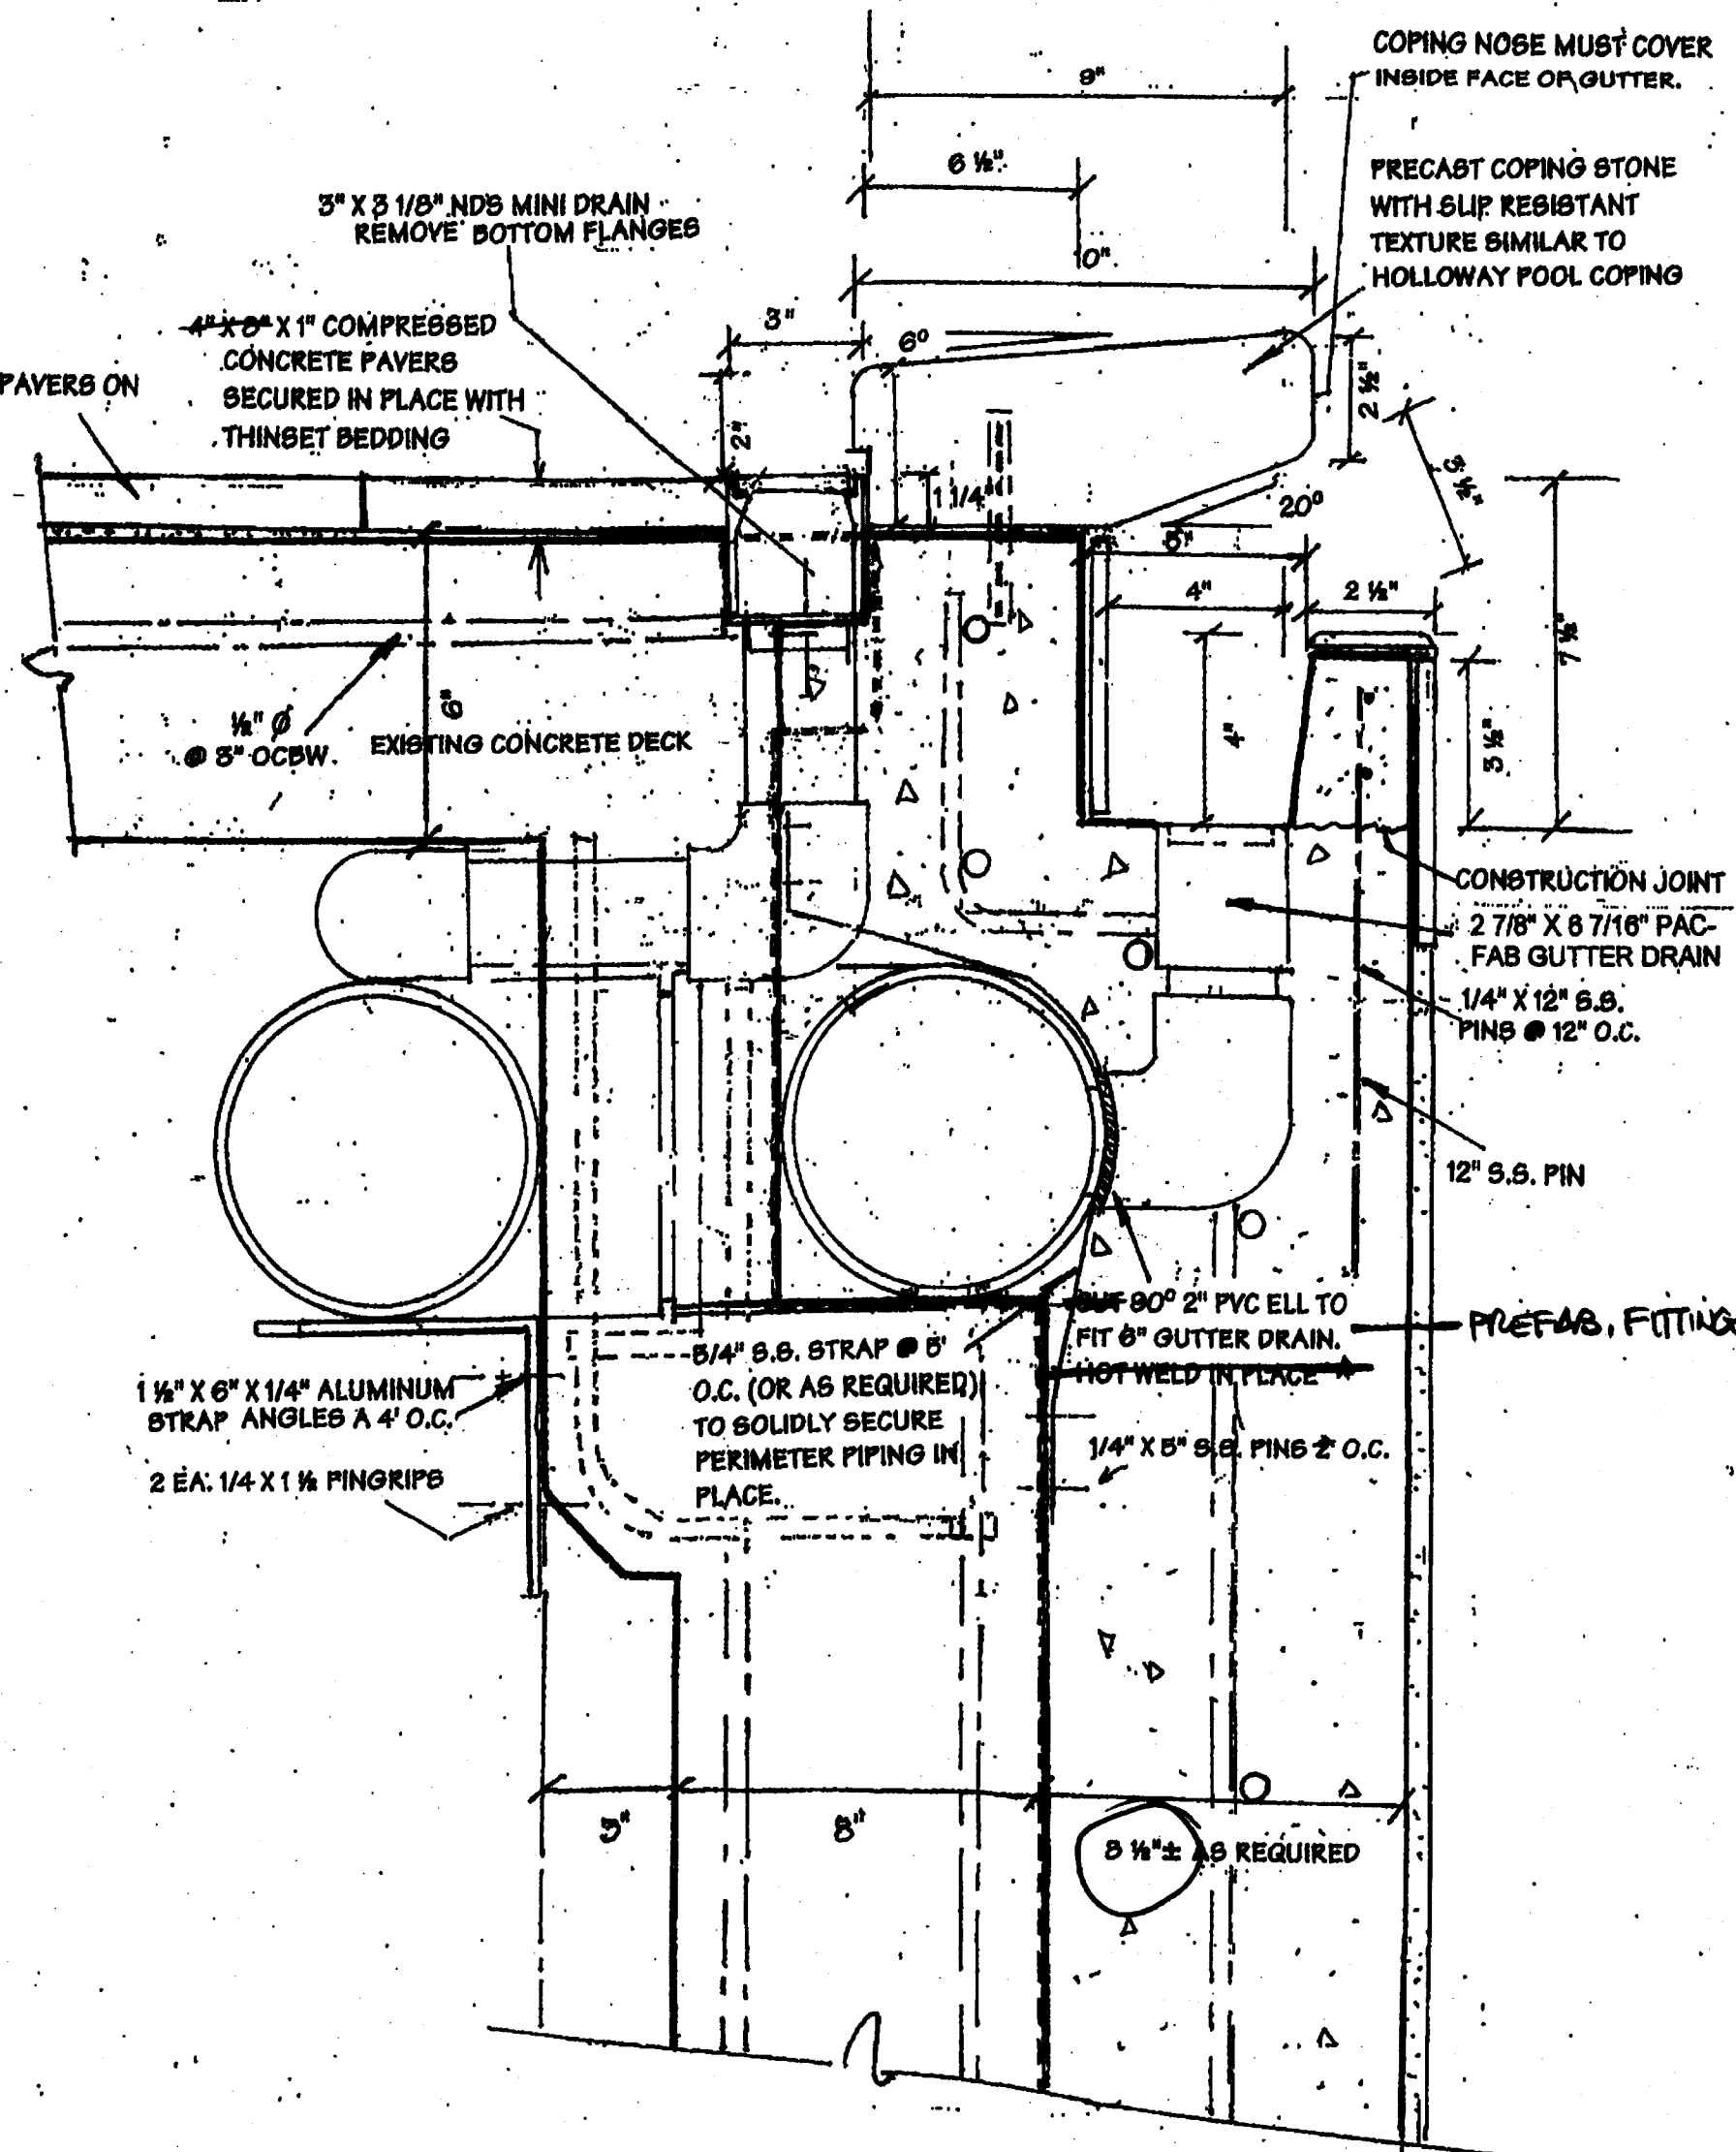

DIMENSIONING FOR MODIFICATION OF THE EXISTING POOL HEADPIECE

SCALE 3" = 1'-0"

- 7) SECURE THE 6" GUTTER LINE FIRMLY IN PLACE WITH 3/4" S.S. STRAP AS REQUIRED.
- 8) AFTER 1/4" REBAR IS IN PLACE AND THE PERIMETER DECK DRAIN IS TIGHTLY MARKED, THE WALL AND HEADPIECE IS READY FOR GUNITE (SHOTCRETE) APPLICATION. (THE GUTTER LIP IS TO BE POST APPLIED.)
- 9) S.S. PINS FOR SECURING THE COPING STONE IN PLACE AND FOR PROVIDING SUPPORT FOR THE 3" X 4" GUTTER LIP MUST BE ACCURATELY POSITIONED BEFORE THE PNEUMATICALLY PLACED CONCRETE TAKES INITIAL HYDRATION.
- 10) TO FORM AND CONSTRUCT THE GUTTER LIP, SECURE A VERTICAL FORM PROX. 8" TO 10" IN HEIGHT TO THE GUNITE WALL SO THAT 3 1/2" OF THIS FORM PROJECTS ABOVE THE TOP OF THE POOL SHELL AT THE GUTTER LIP. SECURE TWO EACH 1/4" S.S. RODS TO THE EXPOSED 1/4" PIN PROJECTING ABOVE THE SHELL AT THIS POINT. THE SAND/CEMENT GROUT MIX (4500#) FOR BUILDING THE GUTTER LIP MAY NOW BE CAREFULLY HANDPACKED AND TIGHTLY CONSOLIDATED TO FORM THE NEW CONCRETE GUTTER LIP.

- 11) THE HEADPIECE IS NOW READY FOR THE TWO VERTICAL COURSES OF 2" X 6" TILE AND THE CERAMIC TILE BINK CAP ON TOP OF THE GUTTER LIP ALONG WITH EPOXY COATING OF THE GUTTER BOTTOM AND INSIDE FACE.
- 12) COPING STONE MAY BE SET AT THE CONTRACTOR'S CONVENIENCE.



FINAL NOTE: SINCE THE NDS GUTTER DRAIN IS SHIPPED IN 6' STRAIGHT SECTION, THE WORK ON THIS HEADPIECE MIGHT BE SIMPLIFIED BY MITRING OR QUARTER CUTTING THE GUTTER AT 24" OR 30" CENTERS WHEN POSITIONING IT AS DESCRIBED ABOVE.

IF THE PRECAST COPING WERE MANUFACTURED IN MATCHING LENGTHS, 24"/30", THEN THE COPING COULD BE SET 80 AS TO REGISTER WITH THE DECK DRAINS.

THIS PROCEDURE WOULD REQUIRE THAT THE S.S. PINS FOR LOCKING THE COPING STONE IN PLACE WOULD NEED TO BE POSITIONED AT MIDPOINT IN THE STRAIGHT SECTIONS OF THE PERIMETER DRAINS.


HANDRAIL/ROPE AND STANCHION HEADPIECE BARRIER AT RAMP ACCESS TO POOL.

BASE BID 6. STEEL 1.25" HANDRAIL, 28" HIGH WITH INTERMEDIATE RAIL. HALF RAIL AT 12" OD S.S. STEEL STANCHIONS WITH 3/4" POLYETHYLENE ROPE BARRIER.

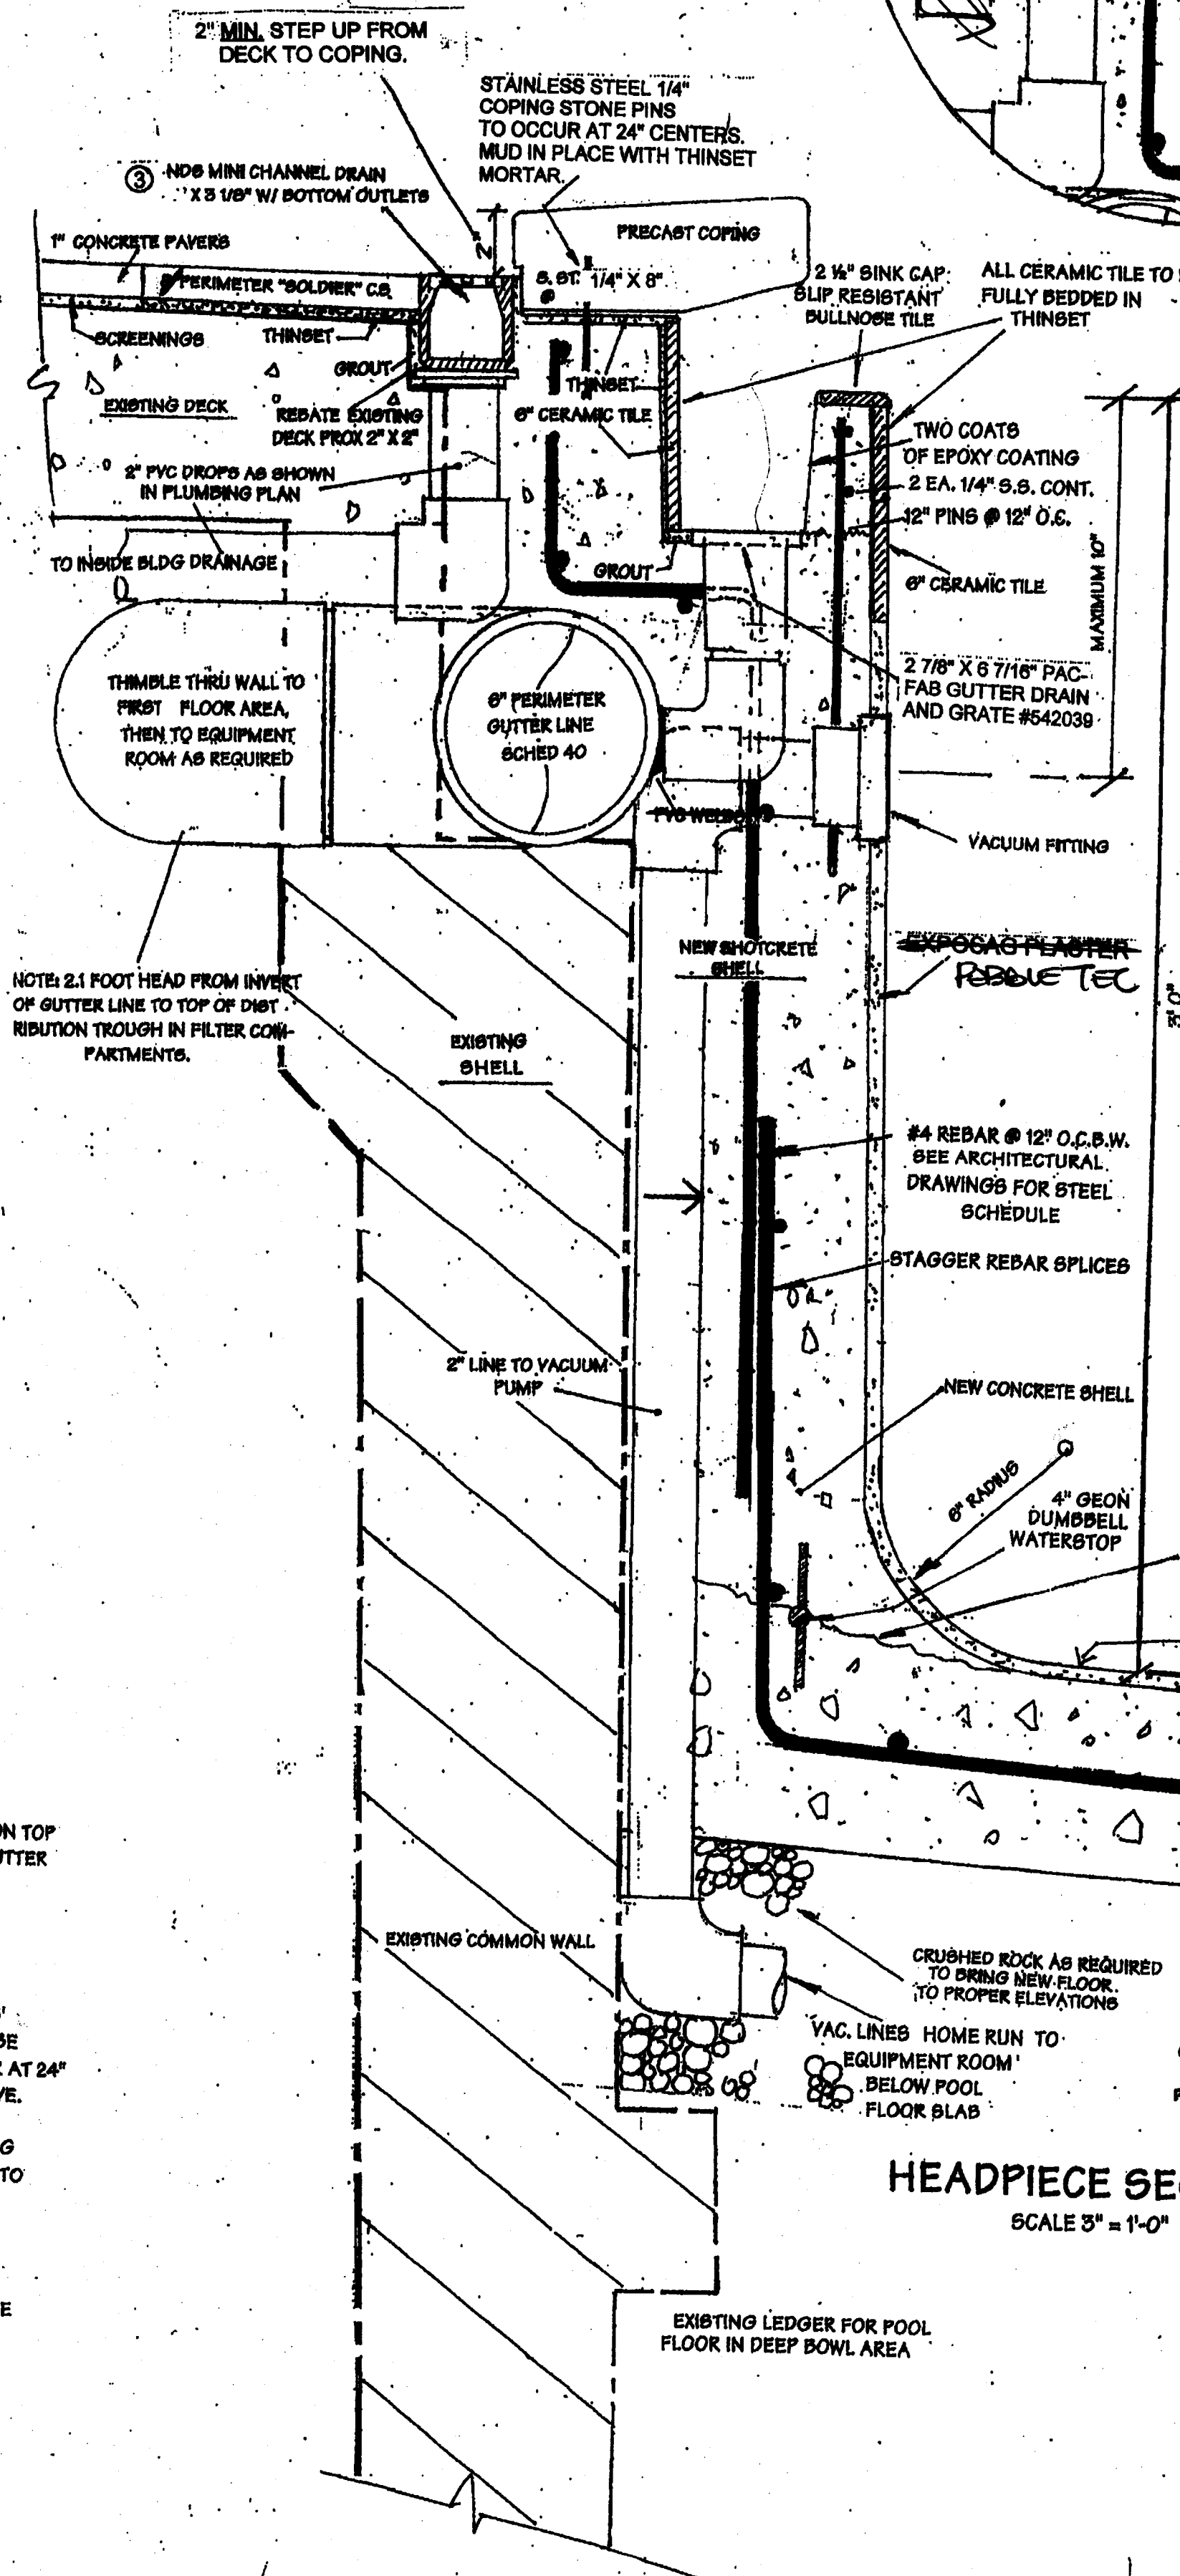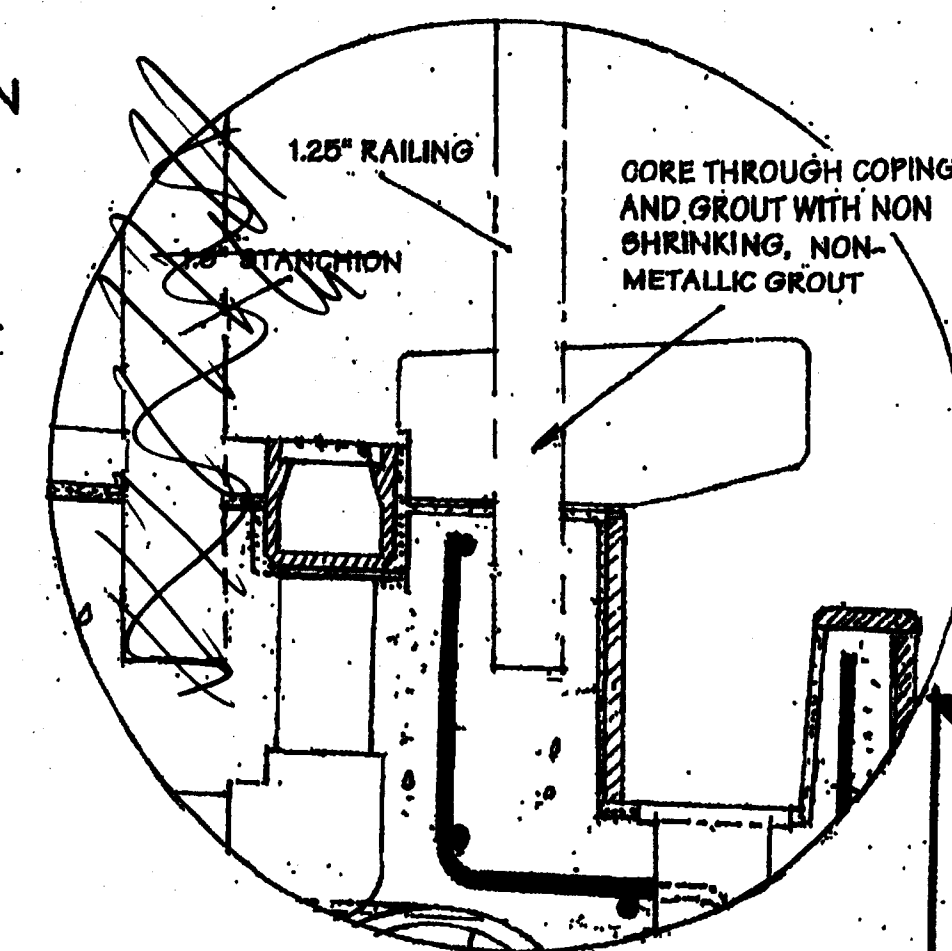

HEADPIECE SECTION

SCALE 3" = 1'-0"

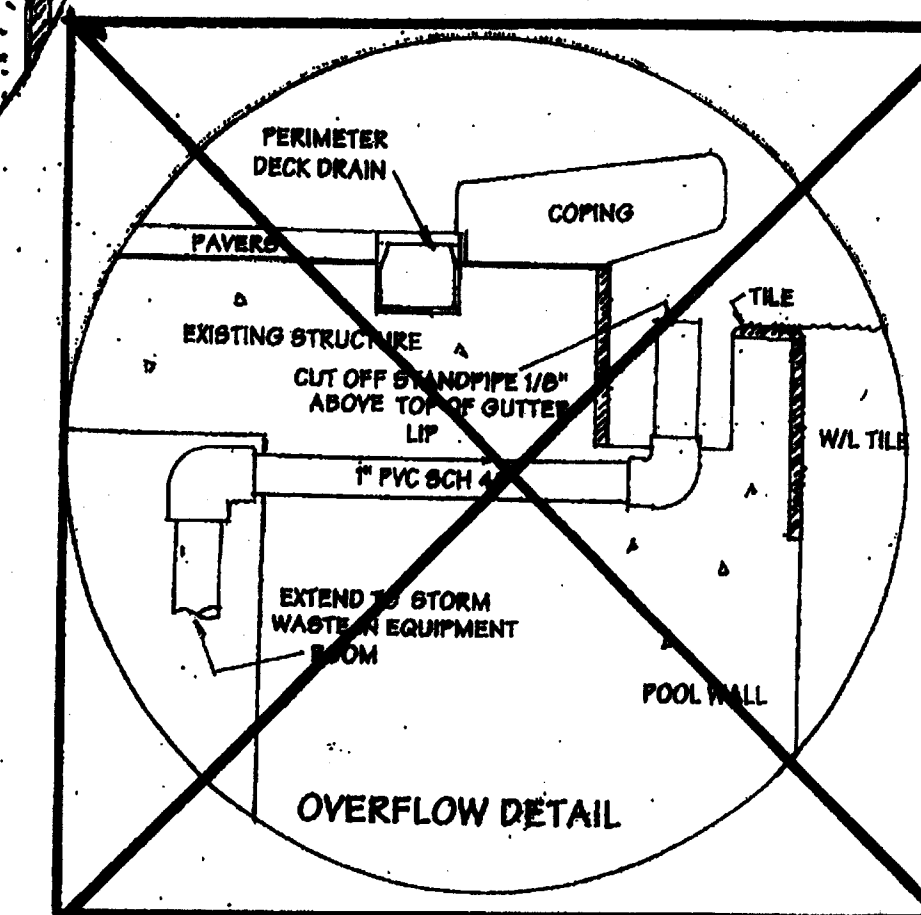

WALL SECTIONS

SHEET Q401




Silcox Engineering, Inc. Civil Engineering
 ERNEST S. SILCOX P.E. #008161
 Post Office Box 4374
 Tampa, FL 33674 813920-9192

RECORD DWG.

DATE 8/26/05


217
009

APPROVED
 HILLSBOROUGH COUNTY HEALTH DEPARTMENT

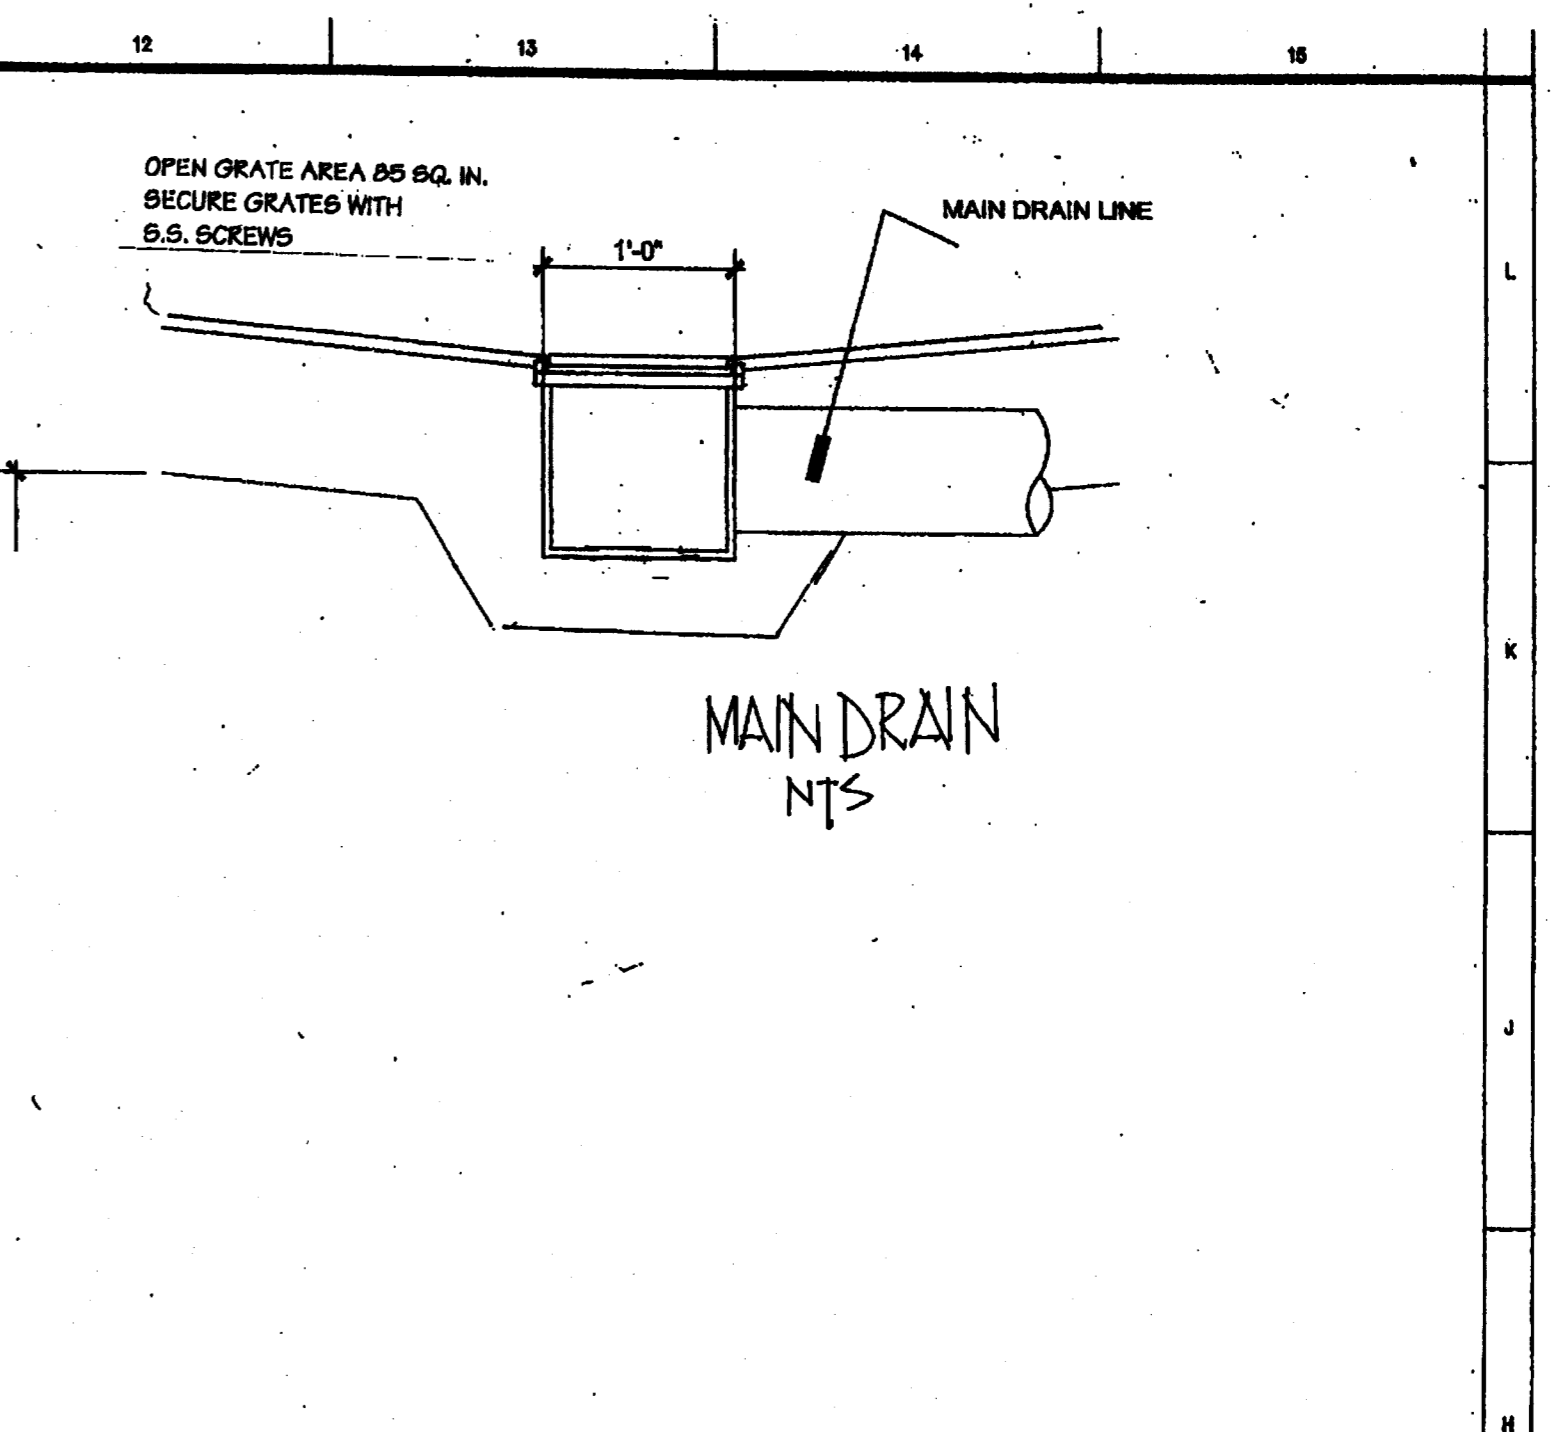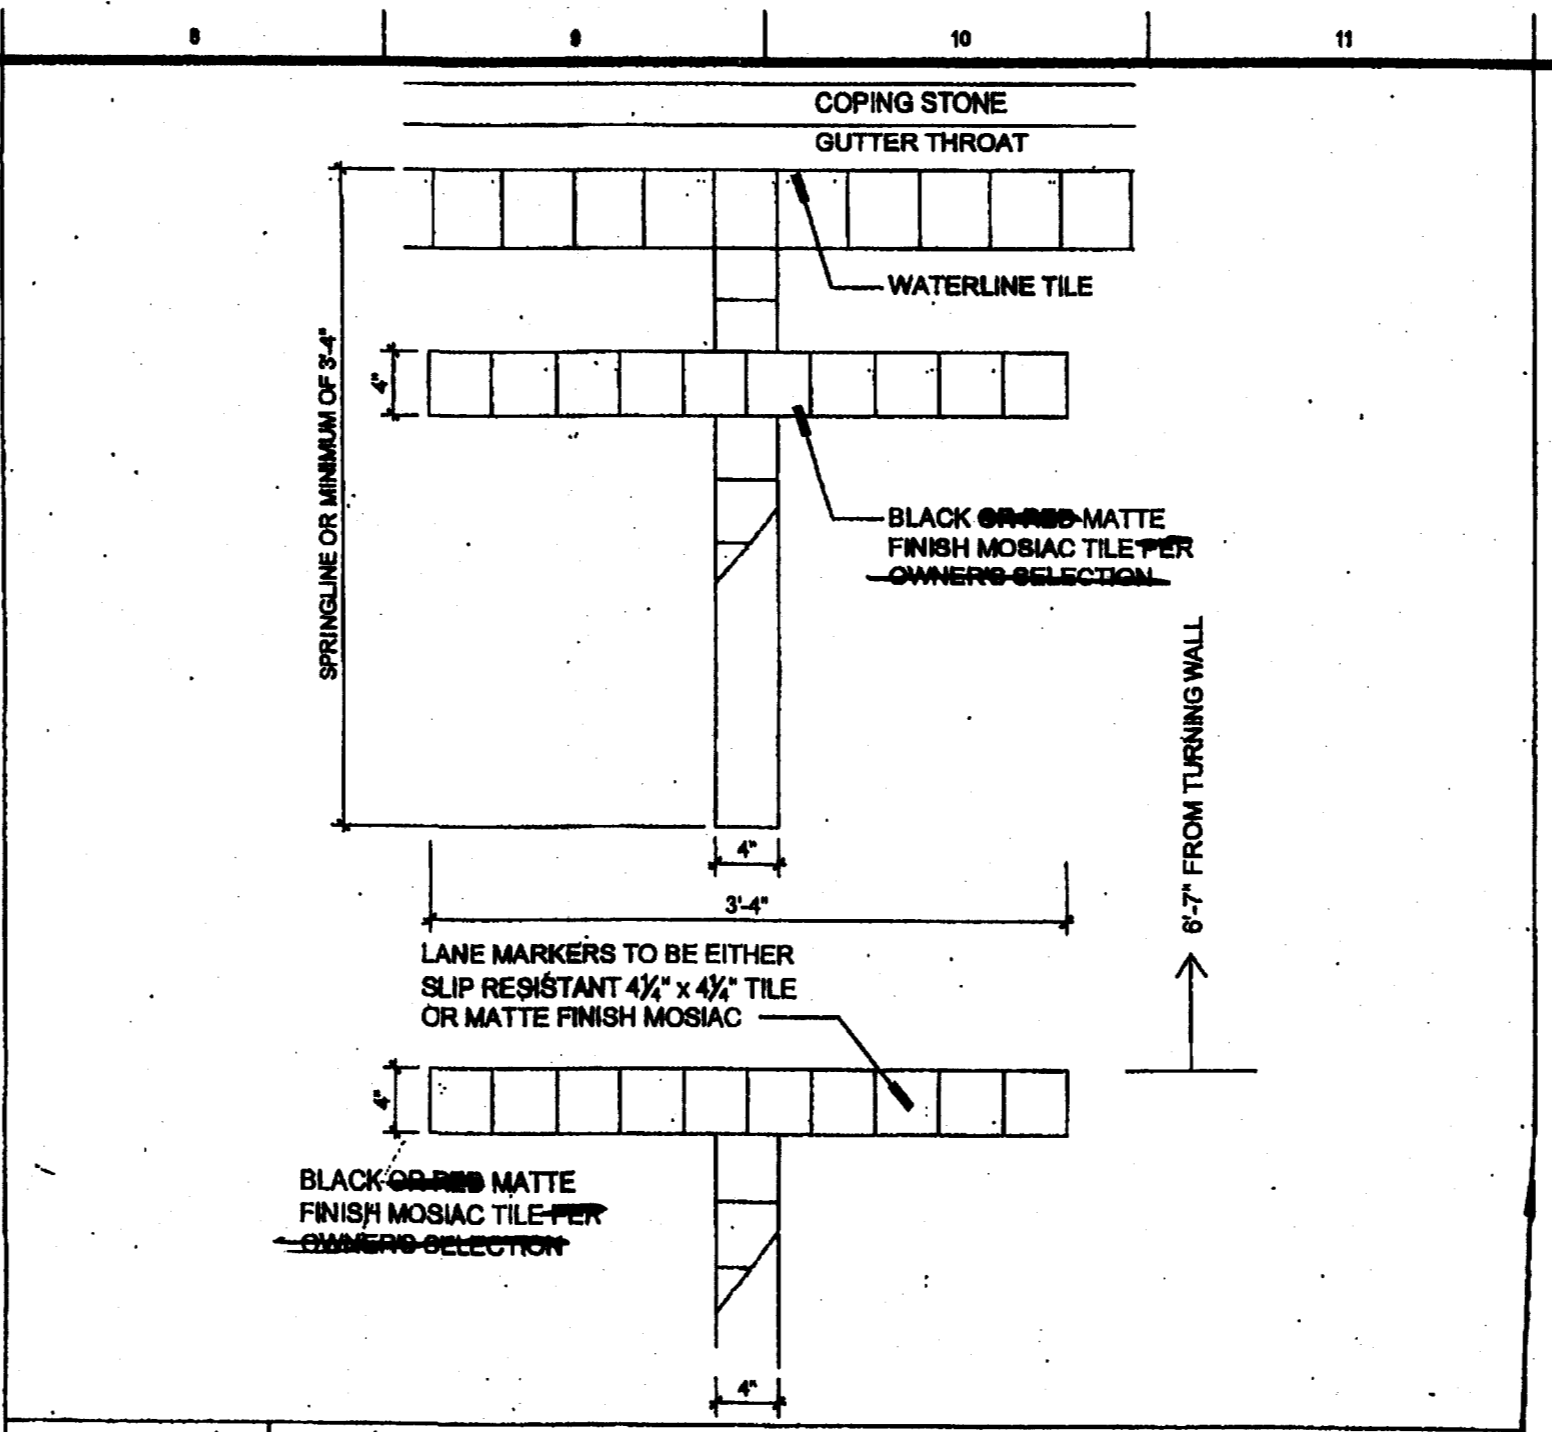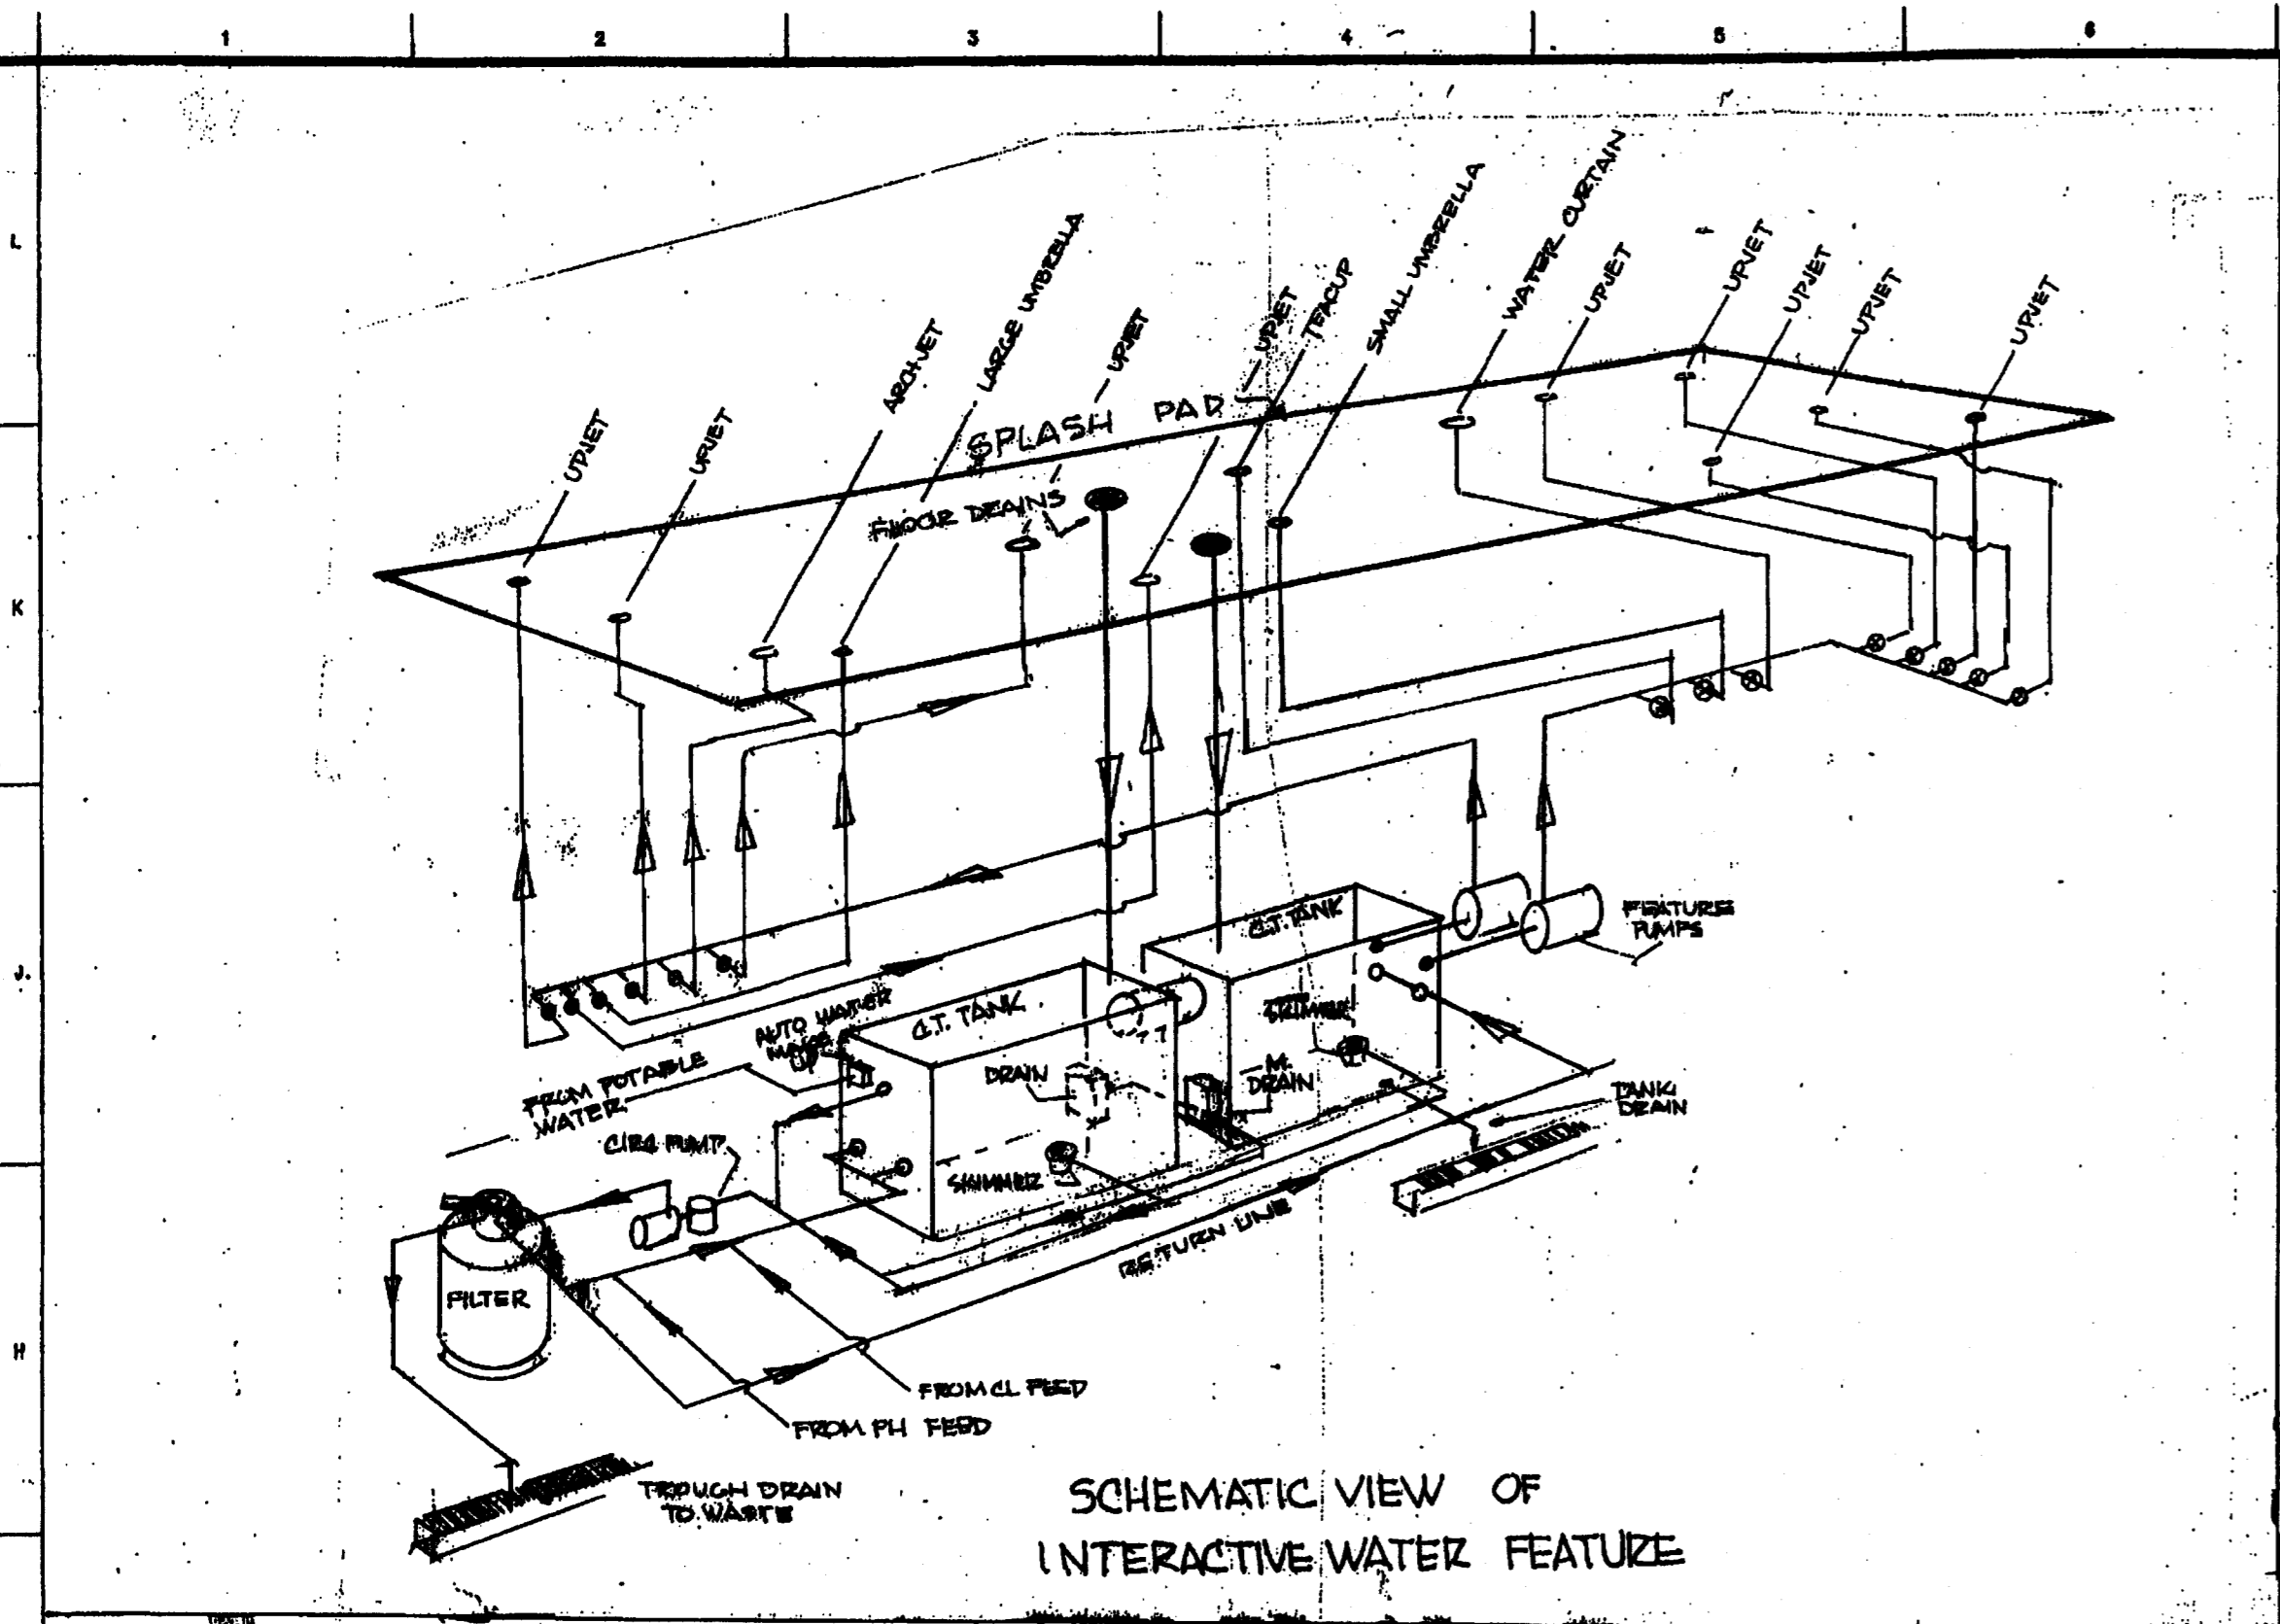


H8 WALL TARGET & RACING LANE TERMINUS
 NO SCALE


NO SCALE

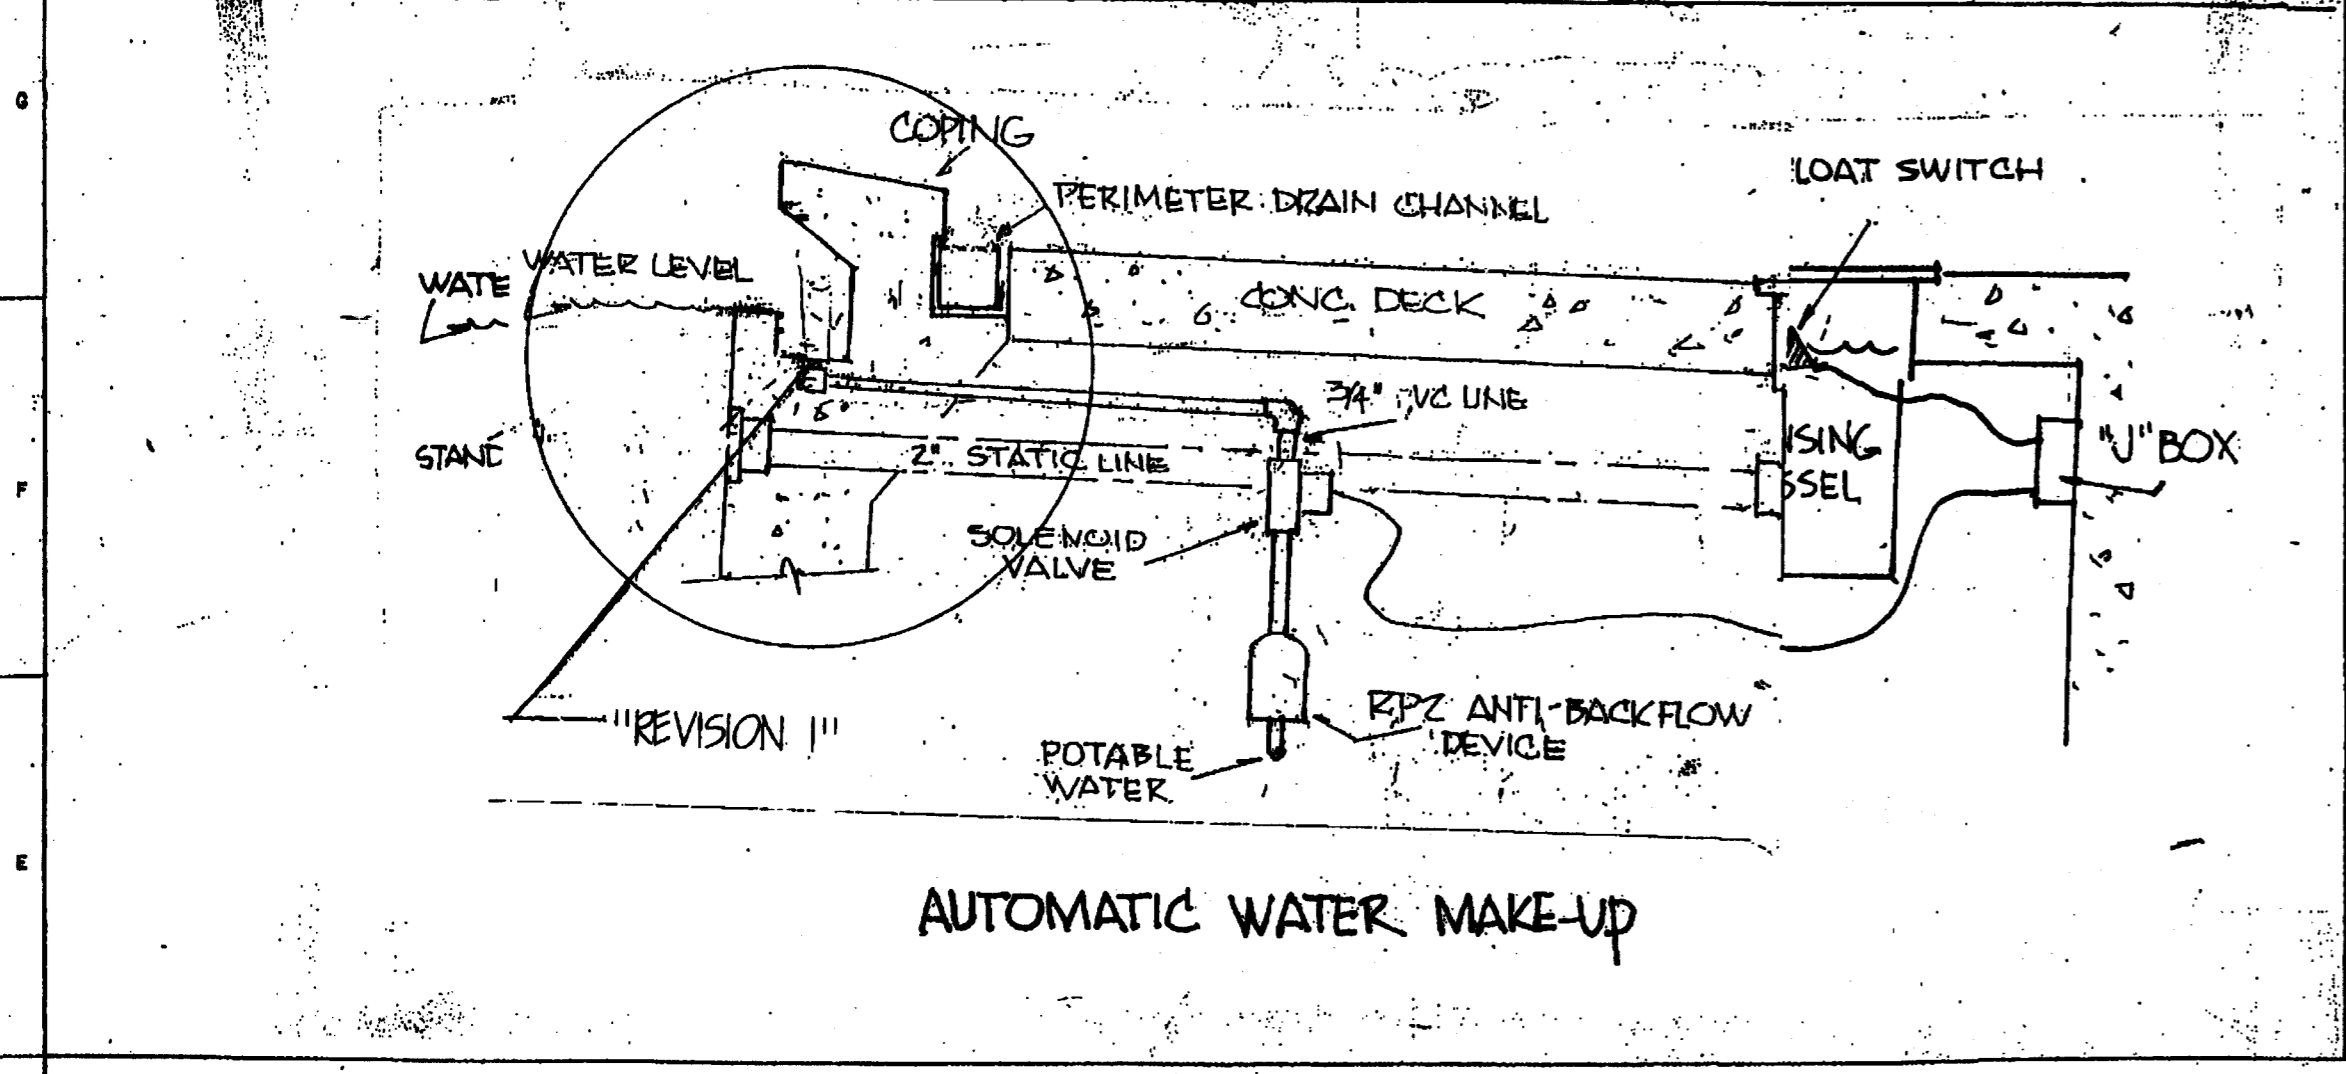


AUTOMATIC WATER MAKE-UP
 NO SCALE

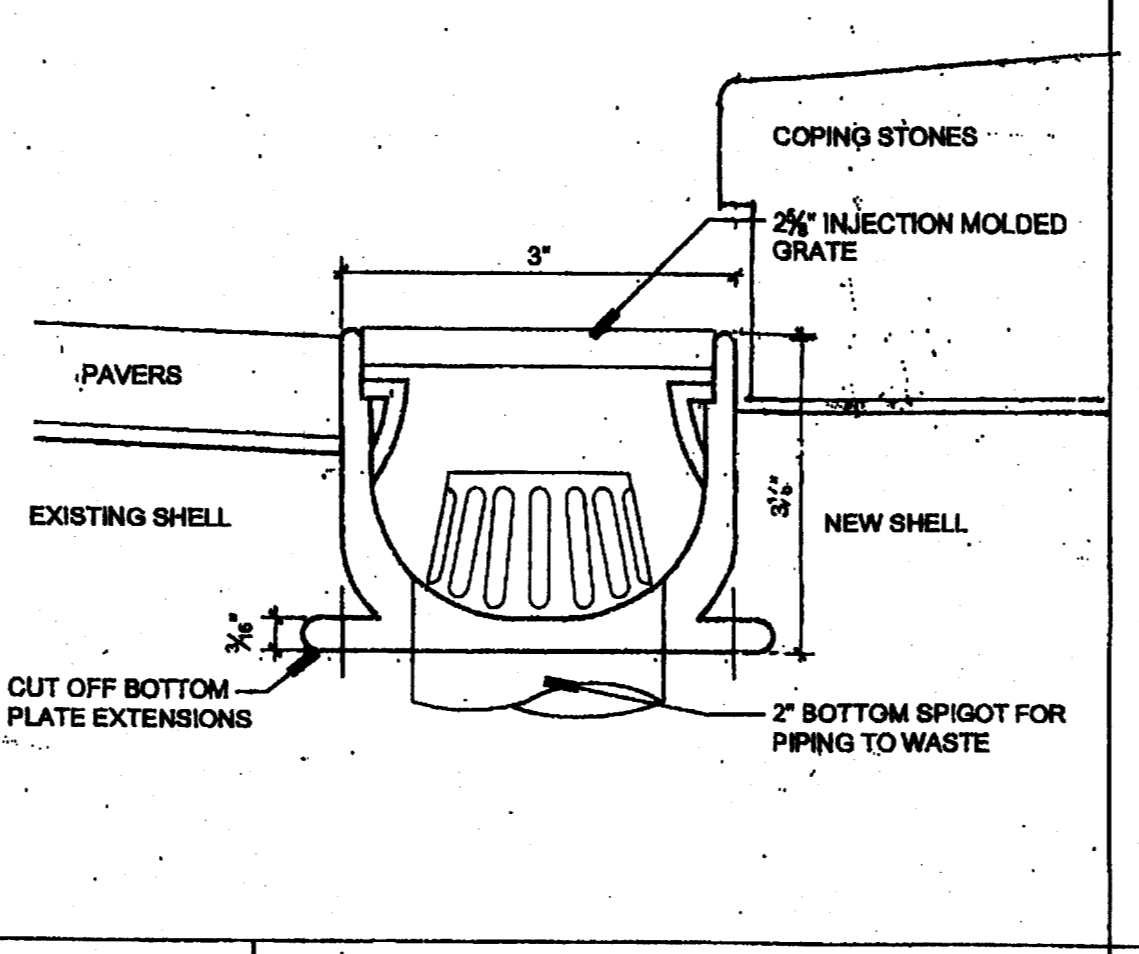


E7 NDS MINI CHANNEL DRAIN
 NO SCALE

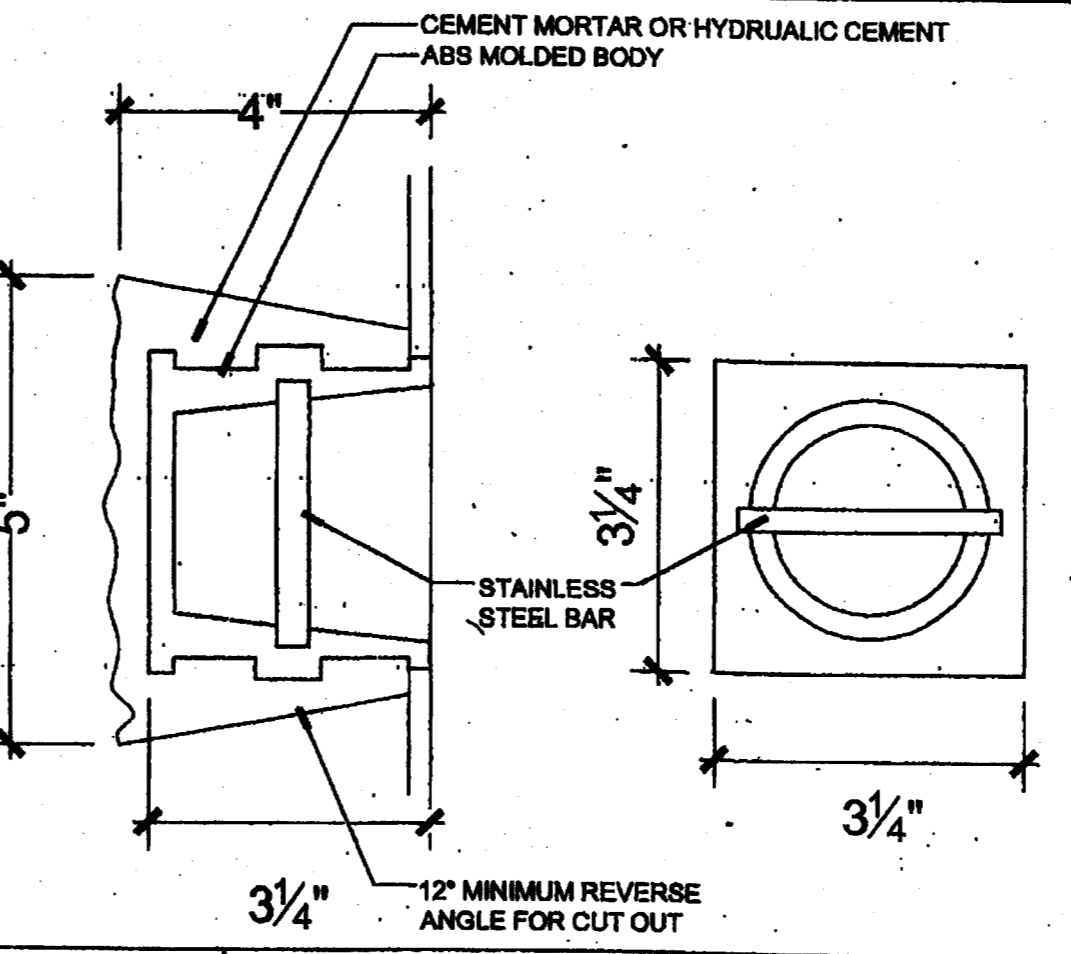


E10 ROPE ANCHORS
 NO SCALE

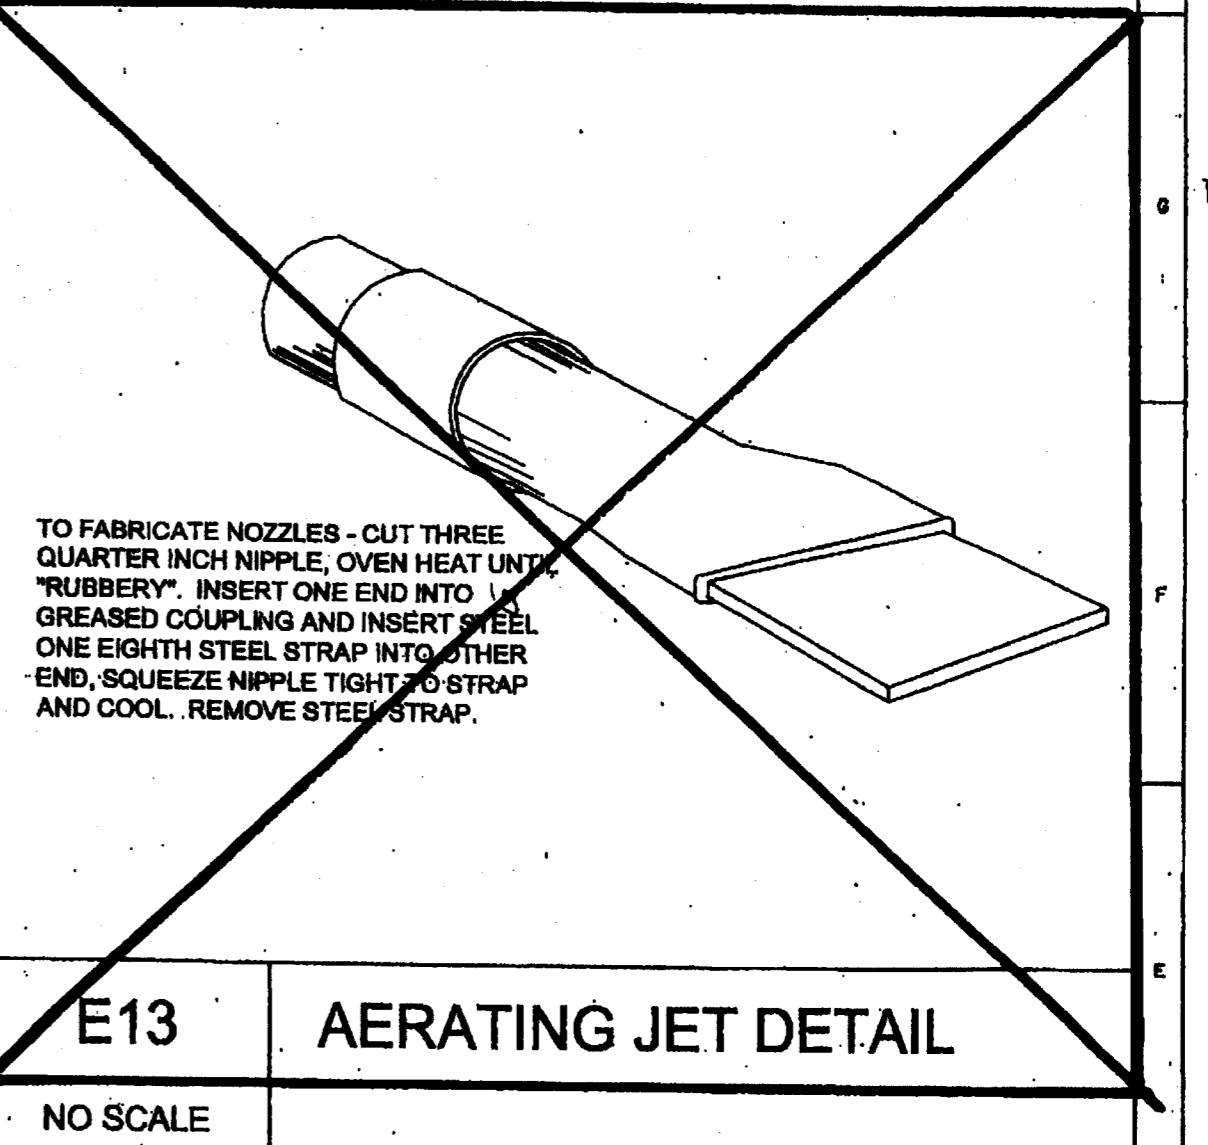

E13 AERATING JET DETAIL
 NO SCALE

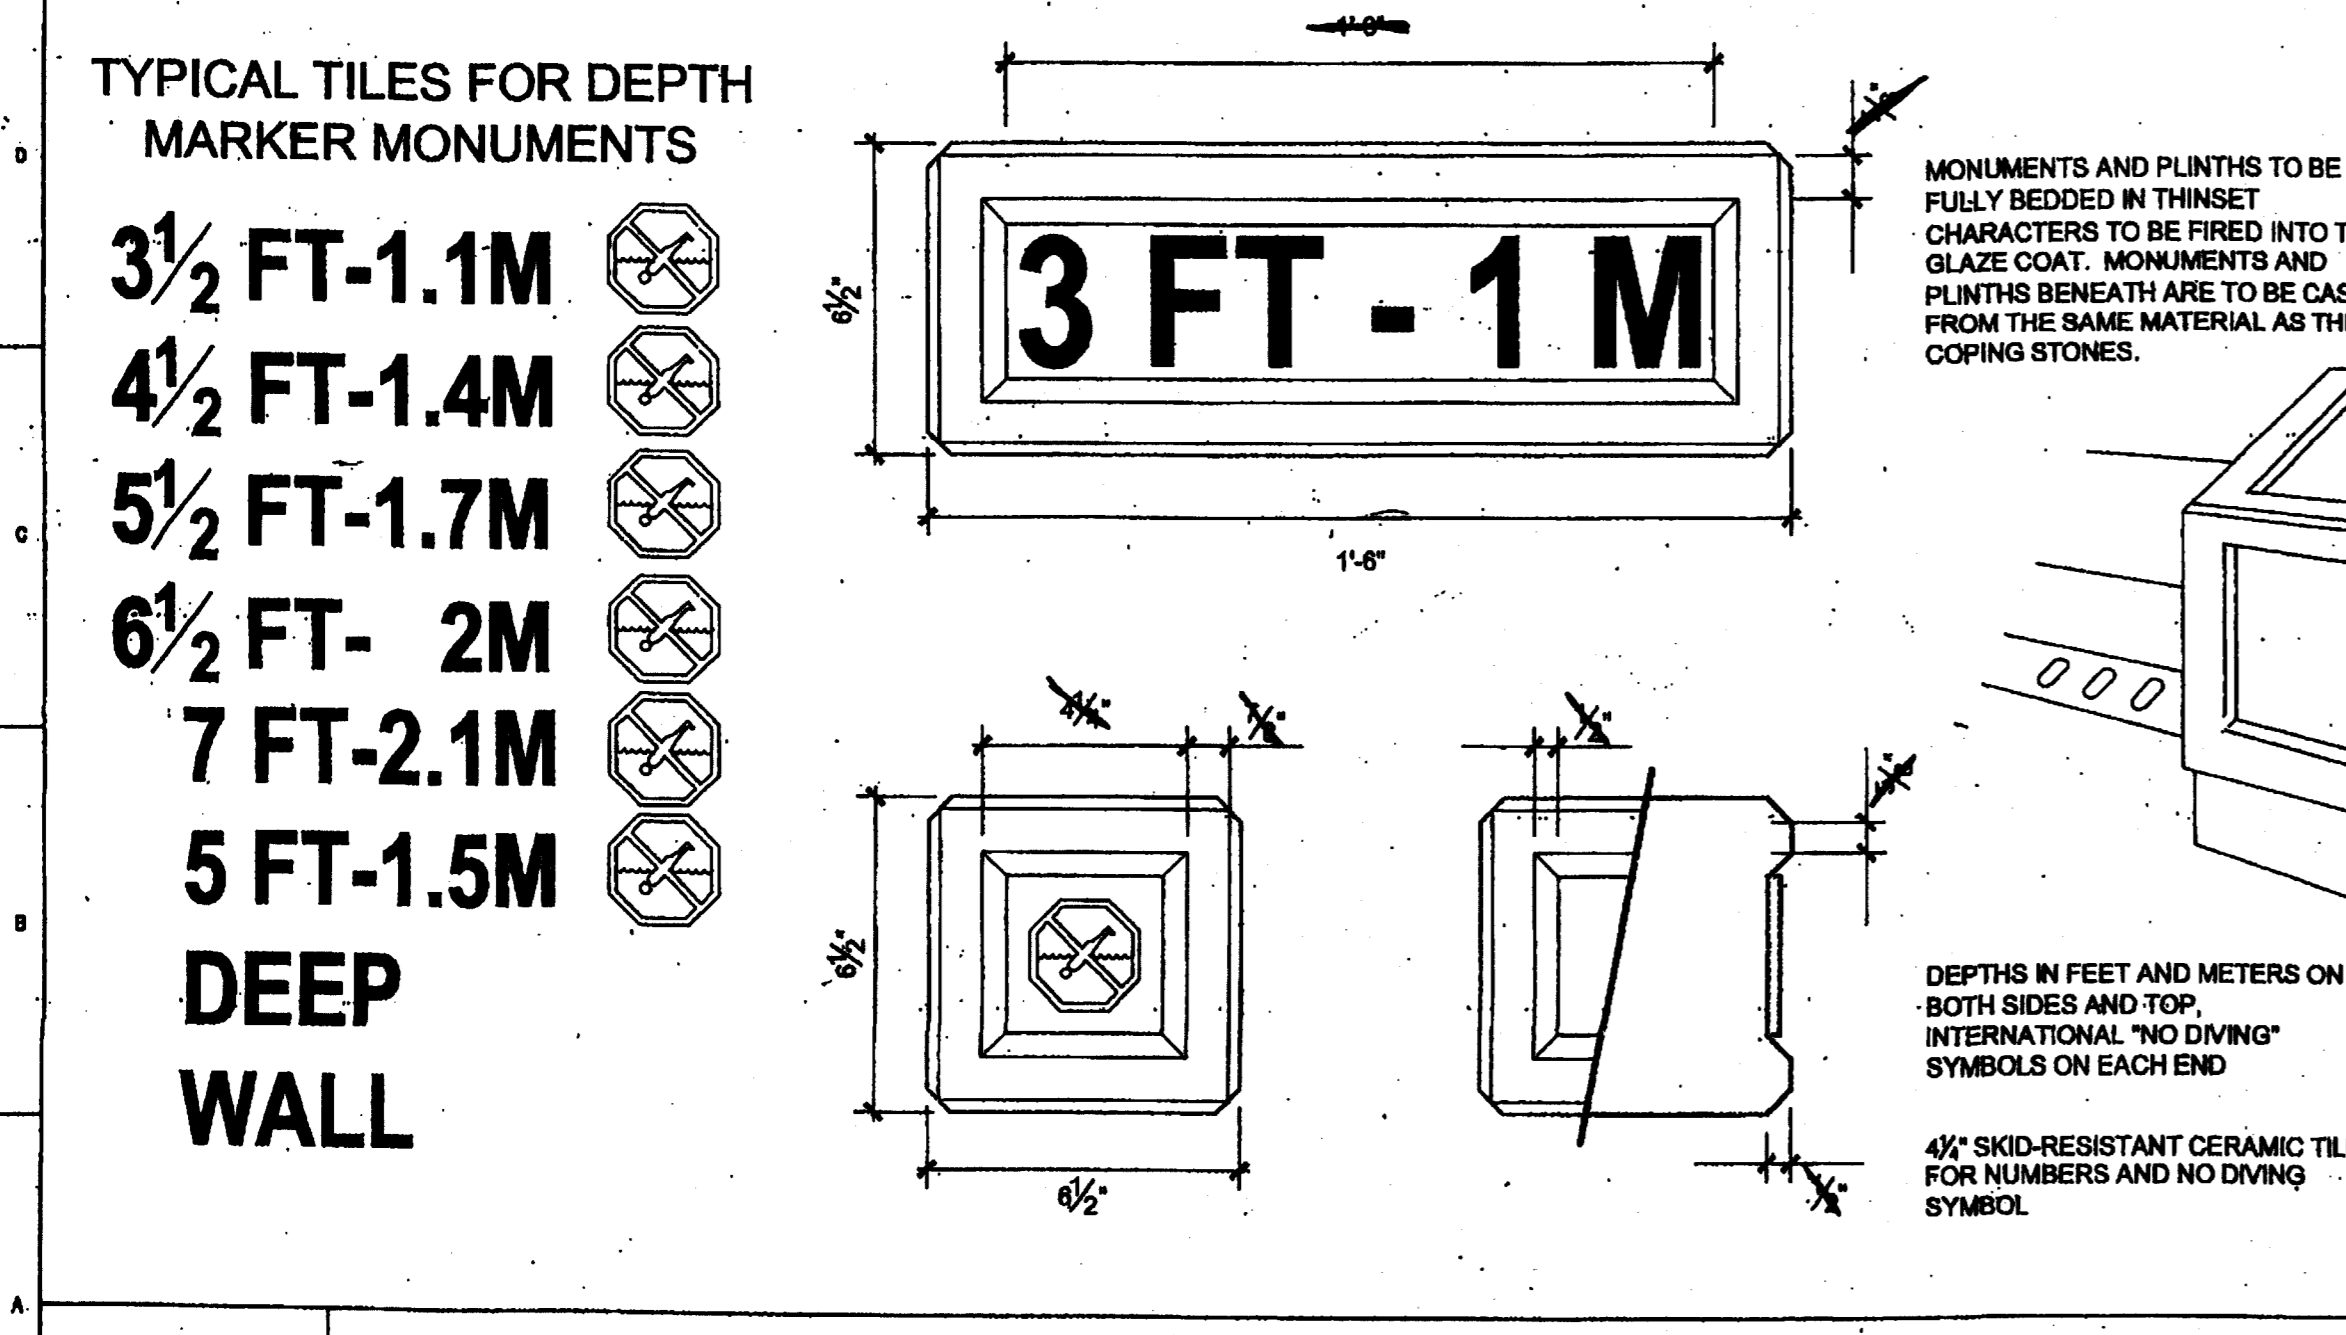


A1 DEPTH MONUMENT DETAILS
 NO SCALE



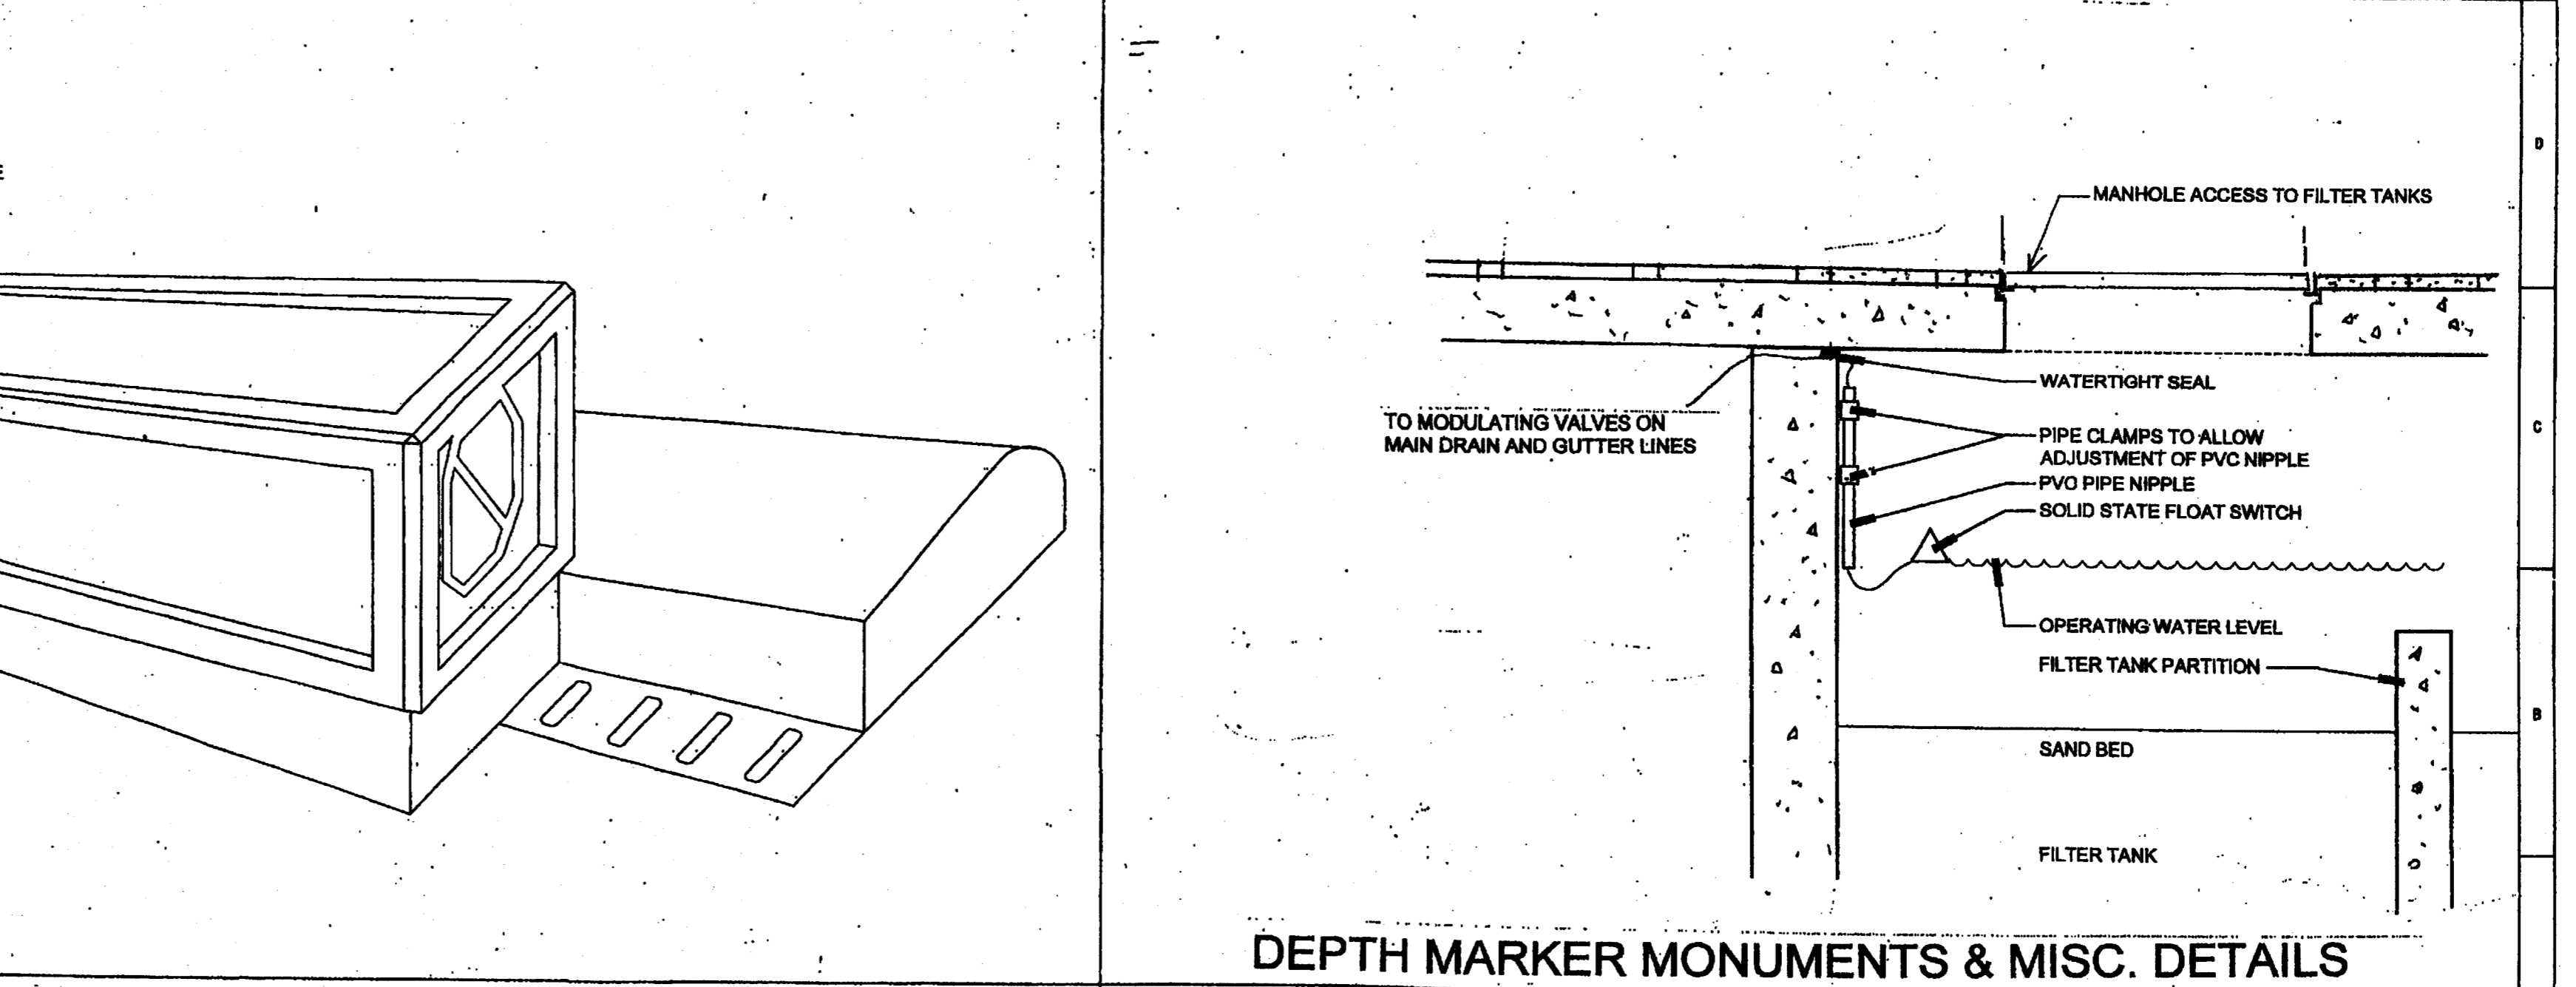


A11 AUTOMATIC WATER LEVEL CONTROLS
 NO SCALE

DEPTH MARKER MONUMENTS & MISC. DETAILS

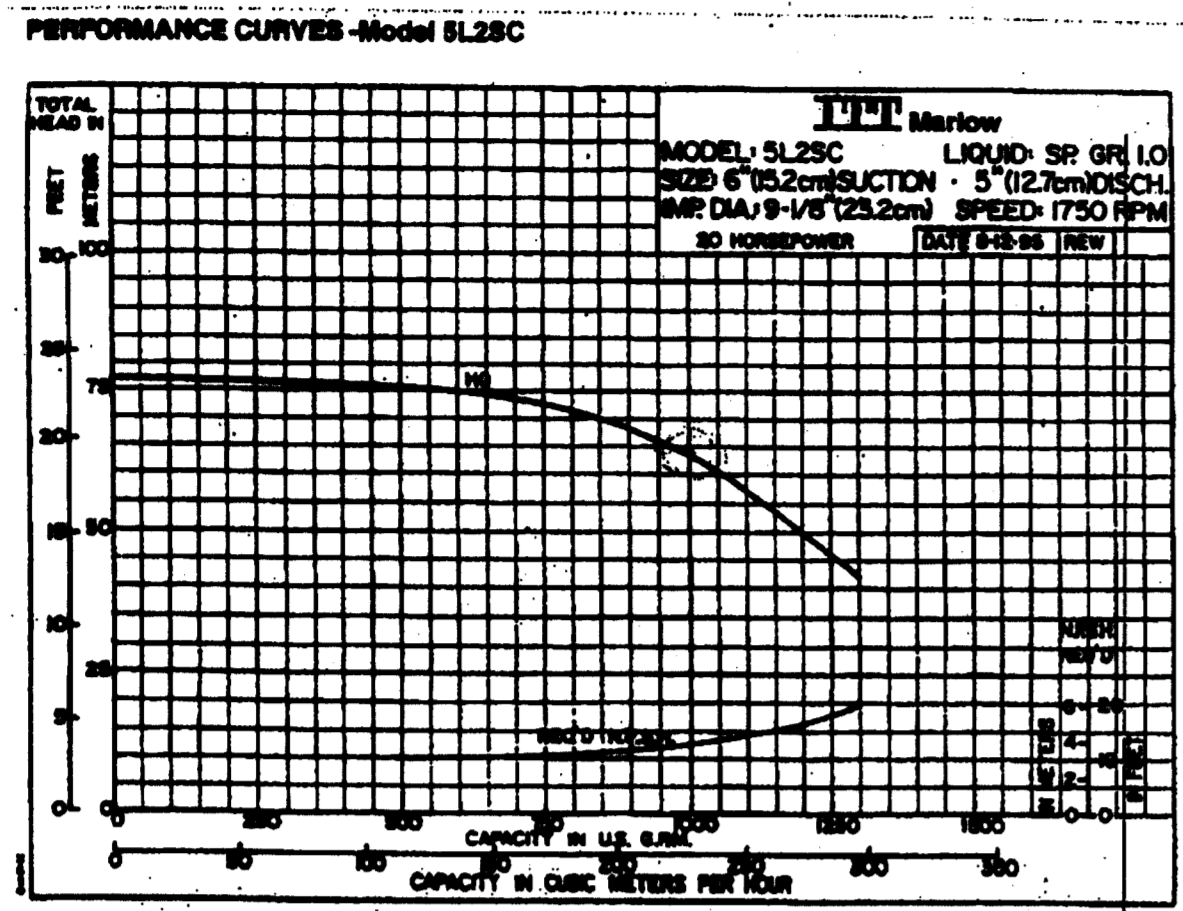

FLOW RESERVES THE RIGHT TO MAKE CHANGES IN DESIGN, MATERIAL, AND PRICES WITHOUT NOTICE

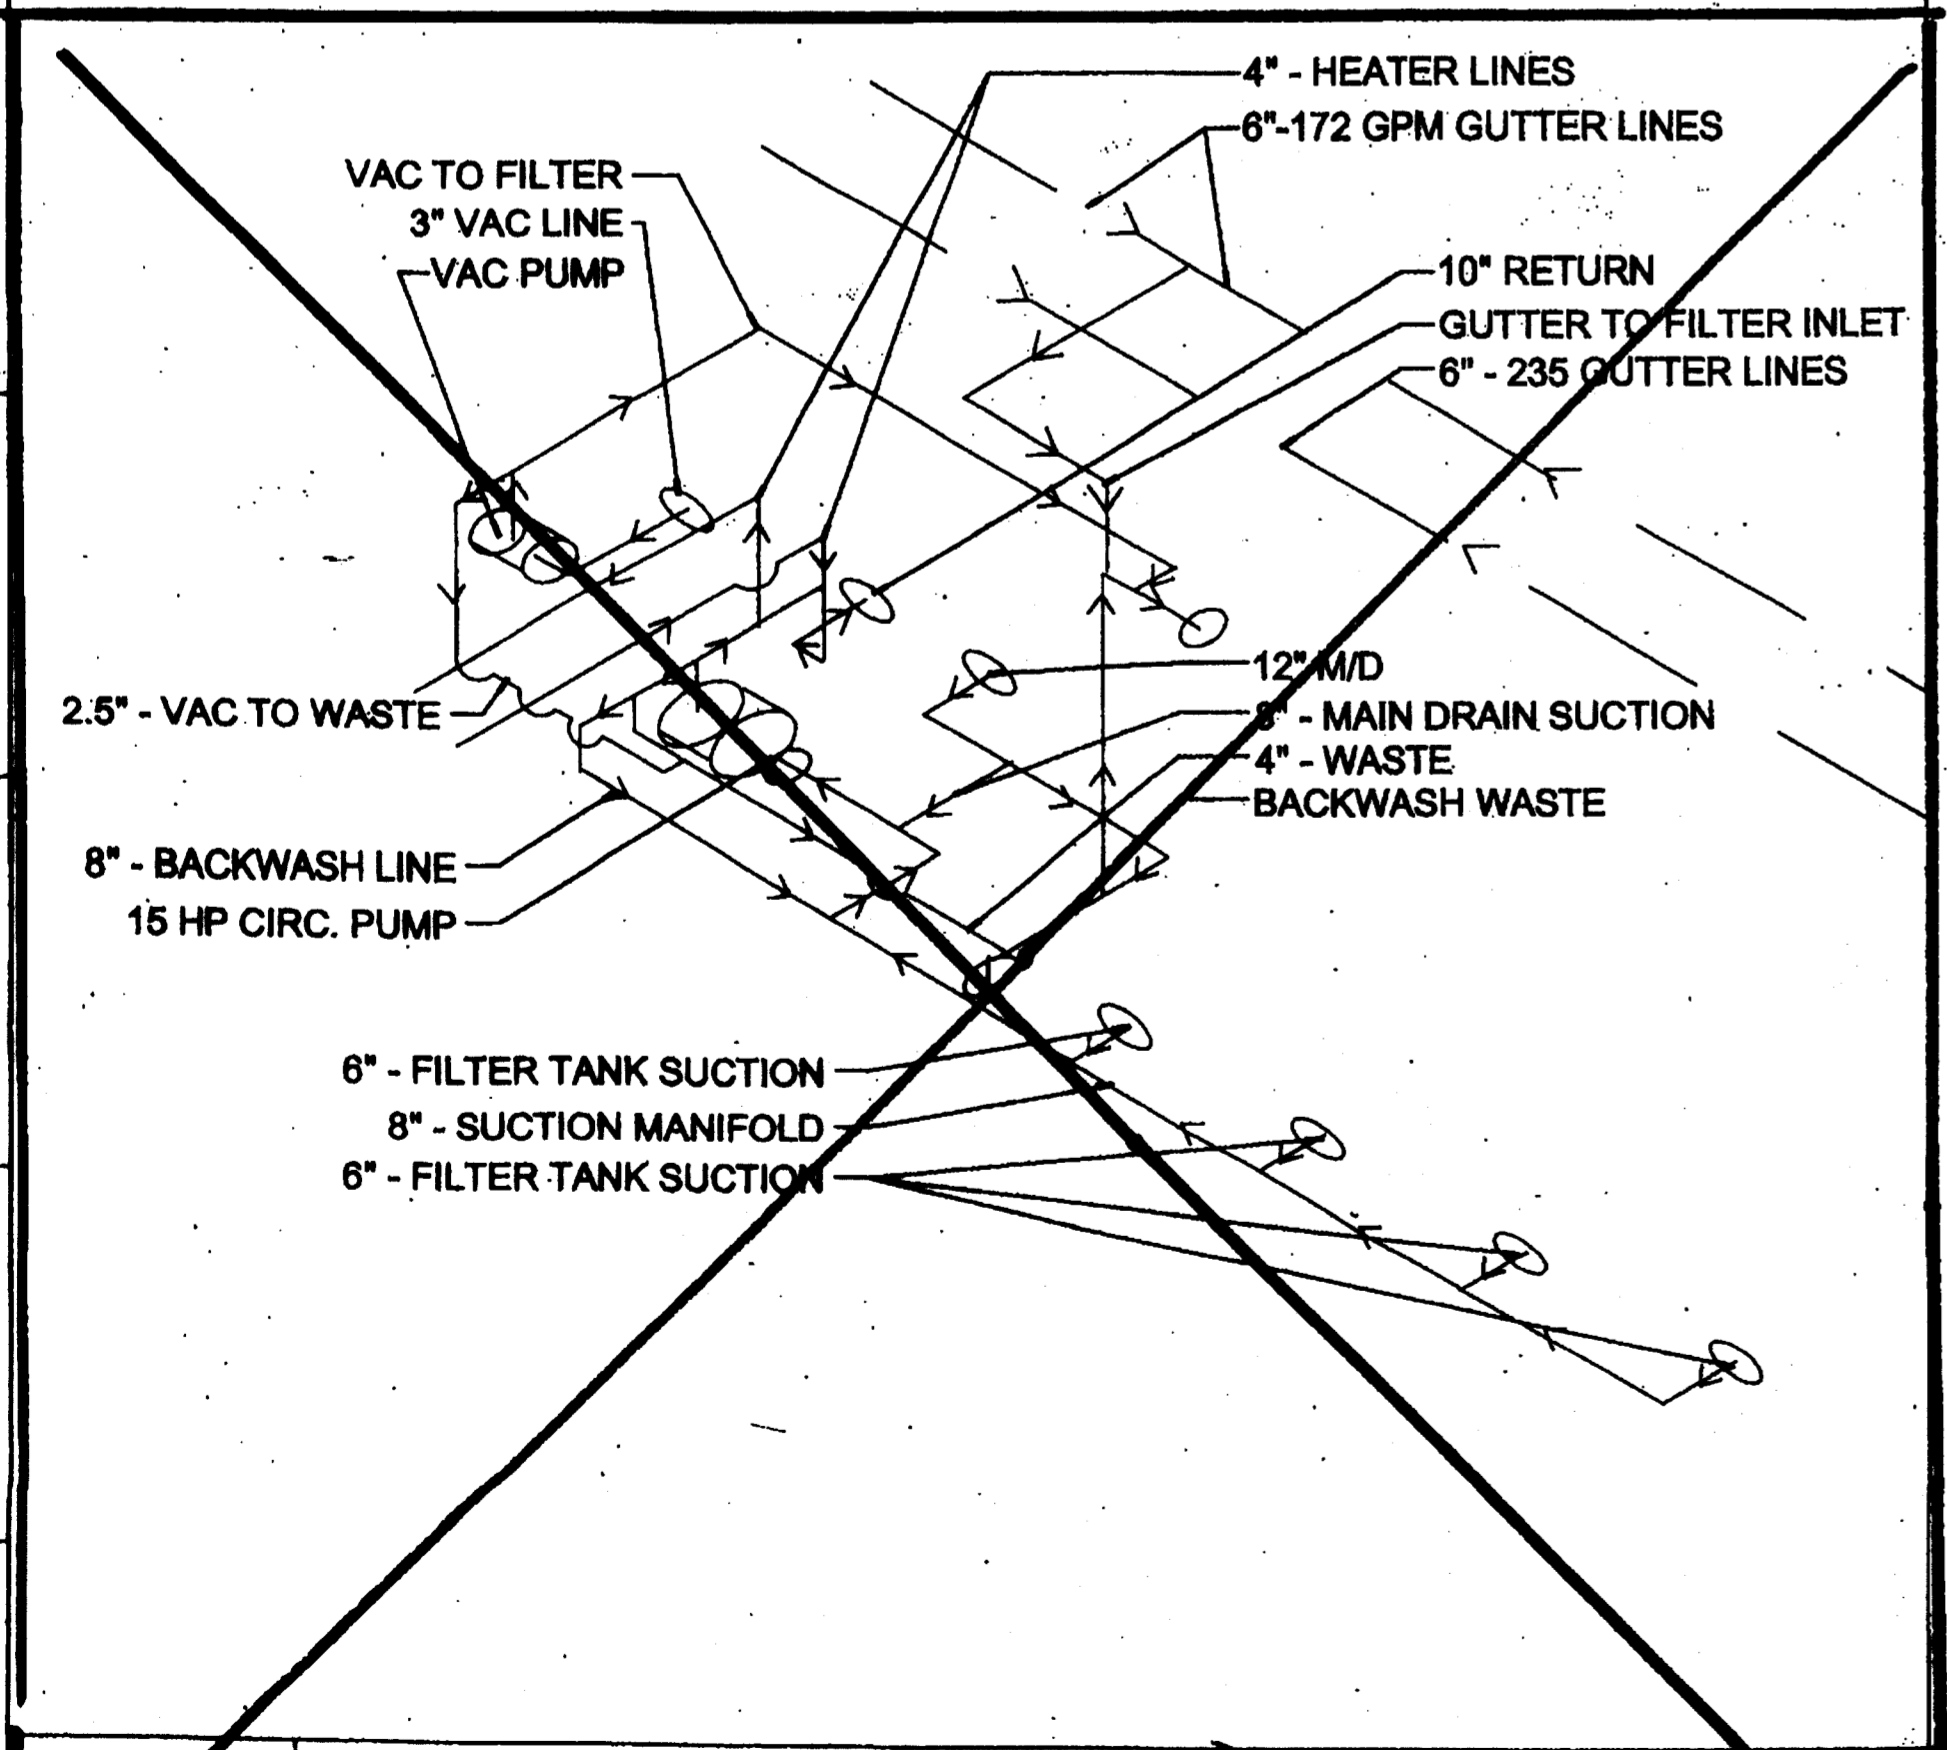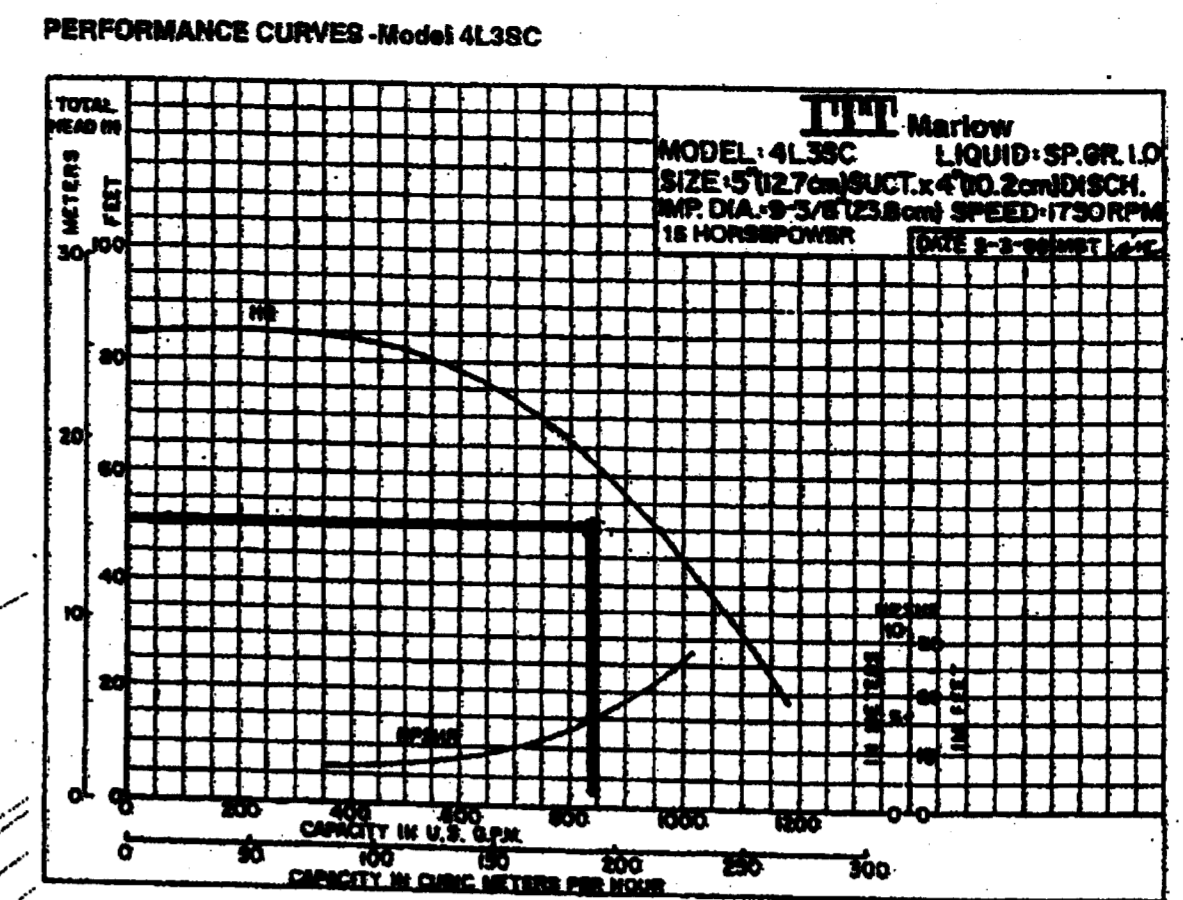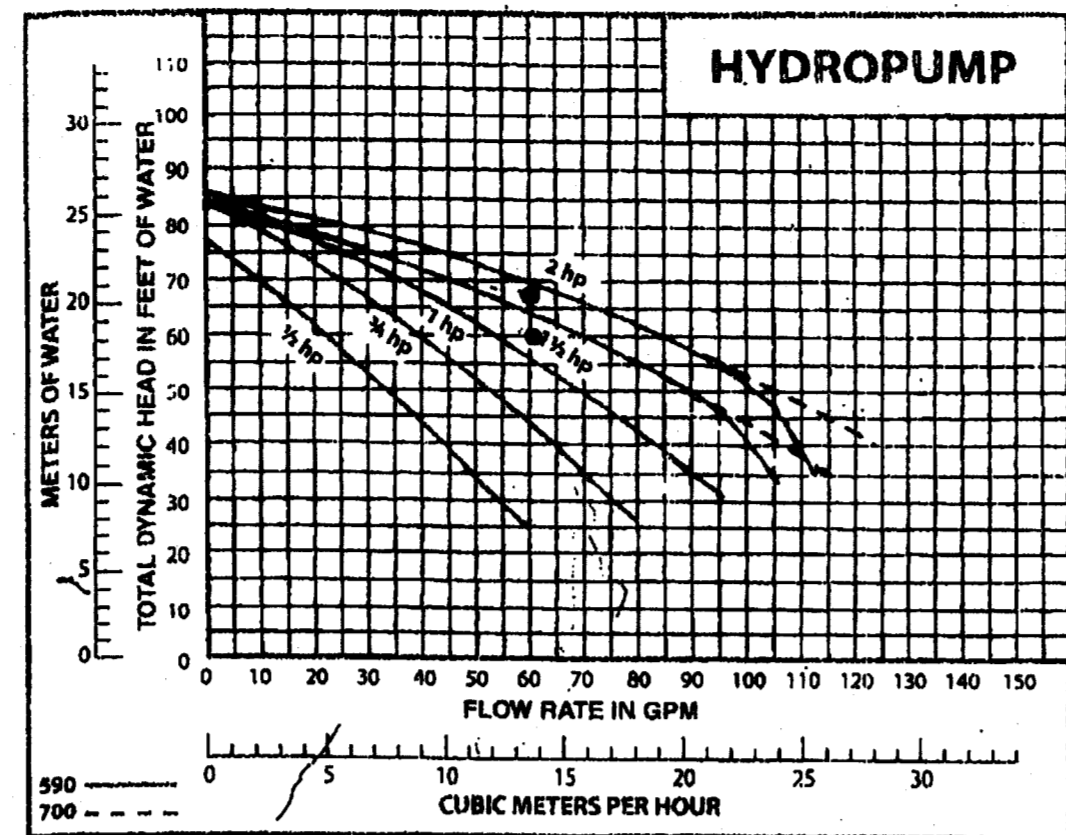

HEATER LINES MUST HAVE ISOLATING VALVES ON SUPPLY AND RETURN. IF HEATERS ARE PLACED IN SERVICE THERMOMETER MUST BE INSTALLED IN RETURN LINE DOWNSTREAM.

HEATER LINES EXIT ROOM HERE

SPLASH PAD EQUIPMENT AREA - OVERHEAD PIPING IS IN THE MAIN EQUIPMENT ROOM AND IN ROOM 140 TO THE NORTH

POOL EQUIPMENT 130 8'-4" - / - / B/C

CONCRETE PARTITIONS IN TANKS ARE 5' HIGH


FILTER TANK VOLUME 20
TOTAL SQUARE FOOT AREA OF THE 4 TANKS IS 216 SF. TANK HEIGHT IS 8 FT. 1,718 CF @ 7.48 GALLONS PER CF = 12,925 GALLONS.

FILTER MEDIA SEE 8/17/05 LETTER FROM STU
- 6 FT COVER ON LATERALS 406 CF
- 30# RIVER GRAVEL @ 165# = 17,520# = 8.9 TONS
- 1.5 FT FILTER BED 324 CF
- 20# DAVENPORT SAND @ 120# = 36,800# = 16.4 TONS

FILTER TANK INTERSECTIONS FLOOR TO WALL AND WALL TO WALL ARE TO HAVE MIN. 2" RADII.

NOTE: FILTRATION FOR SWIMMING POOL AND SPLASH PAD IS TO BE OPERATED 24/7 (CONTINUOUS)

A1 MAIN POOL EQUIPMENT RISER
3/16" = 1'-0"

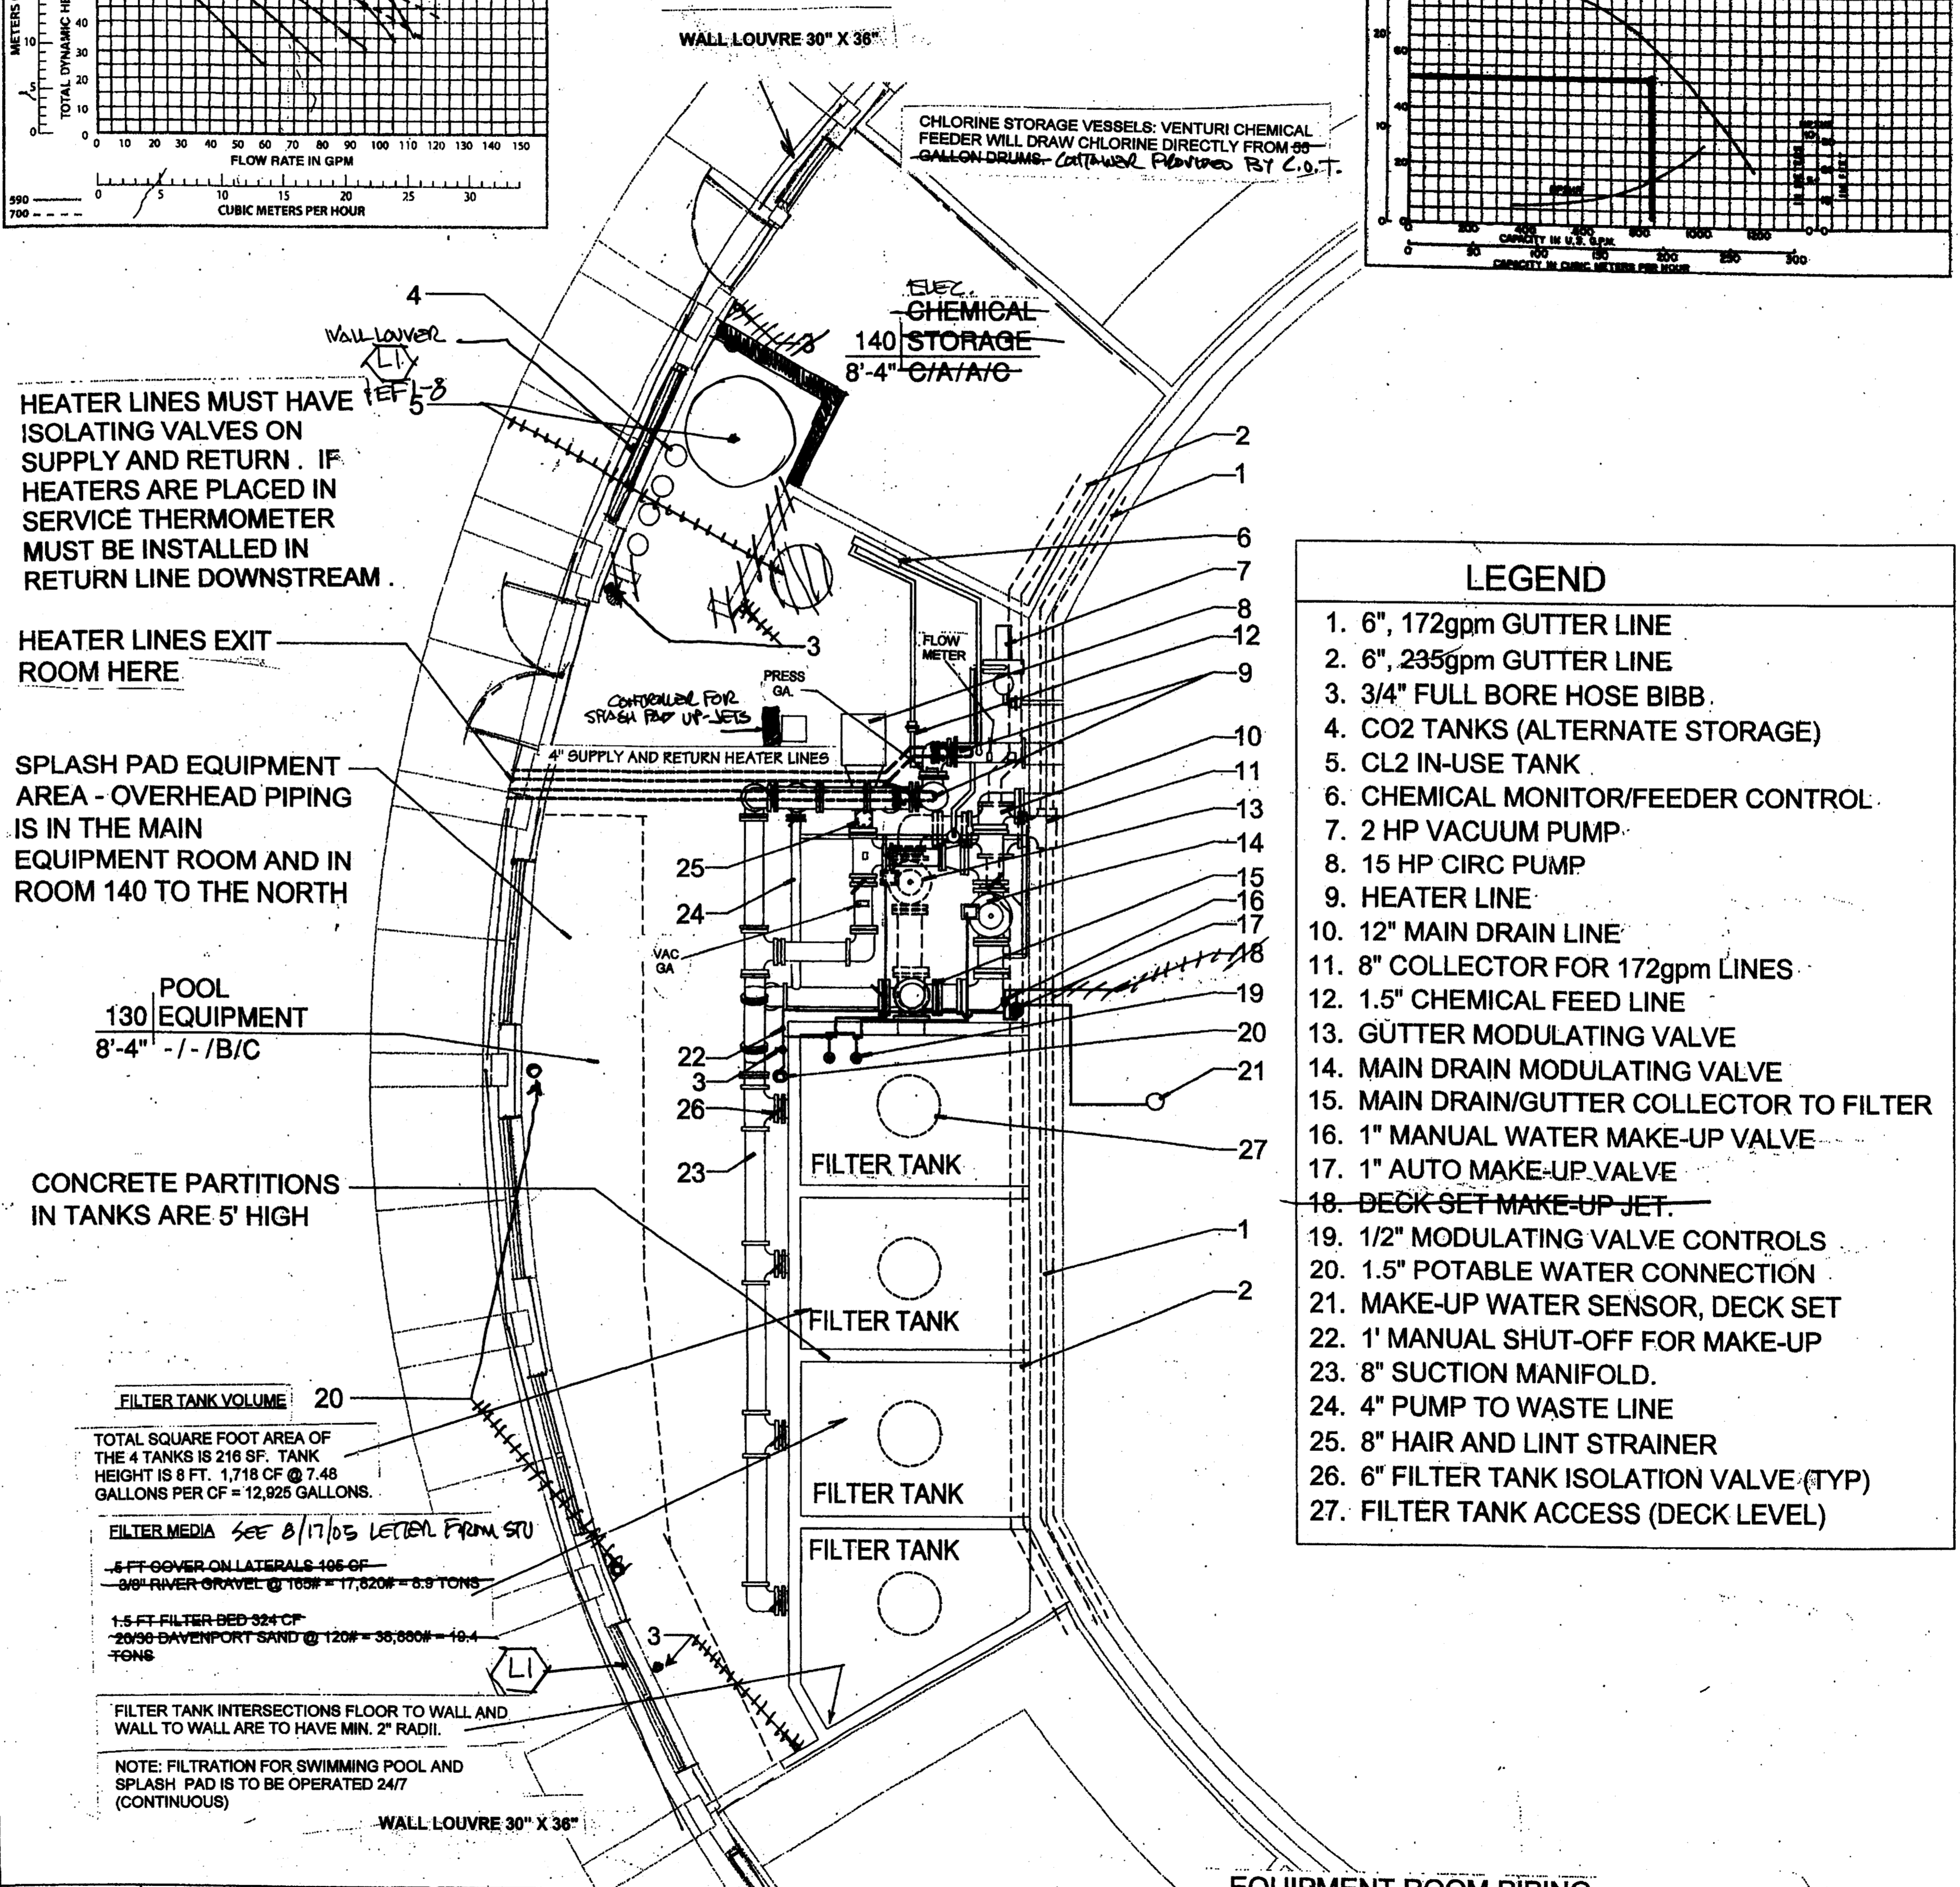


- LEGEND**
- 6", 172gpm GUTTER LINE
 - 6", 235gpm GUTTER LINE
 - 3/4" FULL BORE HOSE BIBB
 - CO2 TANKS (ALTERNATE STORAGE)
 - CL2 IN-USE TANK
 - CHEMICAL MONITOR/FEEDER CONTROL
 - 2 HP VACUUM PUMP
 - 15 HP CIRC PUMP
 - HEATER LINE
 - 12" MAIN DRAIN LINE
 - 8" COLLECTOR FOR 172gpm LINES
 - 1.5" CHEMICAL FEED LINE
 - GUTTER MODULATING VALVE
 - MAIN DRAIN MODULATING VALVE
 - MAIN DRAIN/GUTTER COLLECTOR TO FILTER
 - 1" MANUAL WATER MAKE-UP VALVE
 - 1" AUTO MAKE-UP VALVE
 - DECK SET MAKE-UP JET
 - 1/2" MODULATING VALVE CONTROLS
 - 1.5" POTABLE WATER CONNECTION
 - MAKE-UP WATER SENSOR, DECK SET
 - 1' MANUAL SHUT-OFF FOR MAKE-UP
 - 8" SUCTION MANIFOLD
 - 4" PUMP TO WASTE LINE
 - 8" HAIR AND LINT STRAINER
 - 6" FILTER TANK ISOLATION VALVE (TYP)
 - FILTER TANK ACCESS (DECK LEVEL)

A5 EQUIPMENT ROOM PIPING FOR SWIMMING POOL
3/16" = 1'-0"

ROWE ARCHITECTS
INCORPORATED
100 Madison Street, Suite 200
Tampa, Florida 33602-4704
www.RoweArchitects.com
Fax: 813.221.9154
813.221.8771
AAC002172

Silcox Engineering, Inc. Civil Engineering
ERNEST S. SILCOX P.E. #0008161
Post Office Box 8374
Tampa, FL 33674 813/920-9192

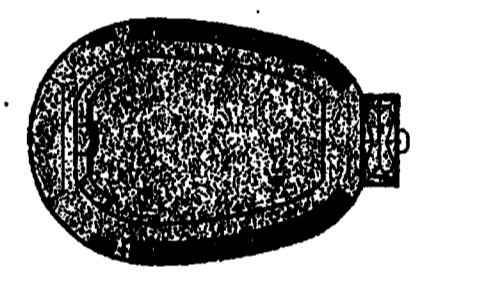


CUSCADEN POOL RENOVATION

CITY OF TAMPA
306 East Jackson Street
Tampa, Florida, 33602

Project No.	0202.00
Distribution	Date
50% Contract Documents	03.31.03
Contract Documents	04.25.03
90% Contract Documents	09.05.03

ENLARGED POOL EQUIPMENT ROOM PLANS
SCALE 1/4" = 1'-0"


RECORD DWG
DATE 8/26/05

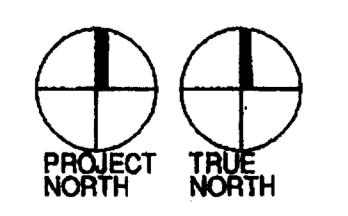

Q701




APPROVED
HILLSBOROUGH COUNTY HEALTH DEPARTMENT

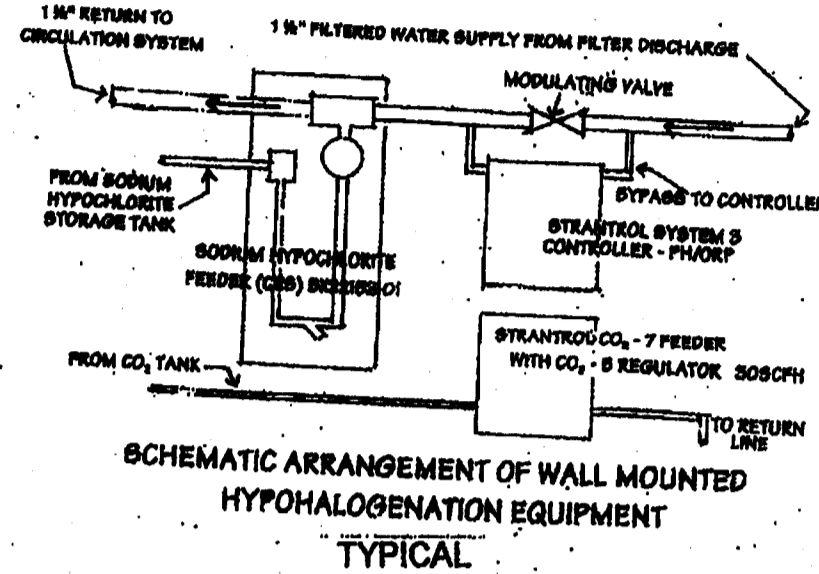

VELOCITY IN SPLASH PAD PLUMBING MUST NOT EXCEED 20 FPS.

BACKWASHING PROCEDURE: BACKWASHING WILL BE DONE WHEN THE FACILITY IS CLOSED. WATER FOR BACKWASHING THE FILTERS WILL BE DRAWN FROM THE 2000 GALLON COLLECTOR TANK SERVING THE SPLASH PAD FILTERING SYSTEM. BACKWASH RATE IS 809 GPM AND BACKWASH TIME IS MAXIMUM TWO MINUTES. AFTER BACKWASHING IS COMPLETE THE POOL AND SPLASH PAD MAY BE PLACED BACK IN OPERATION AND THE AUTOMATIC WATER MAKE-UP DEVICE IN THE SPLASH PAD COLLECTOR TANK WILL REPLENISH THE WATER DRAWN OUT FOR BACKWASHING THE SAND FILTERS.

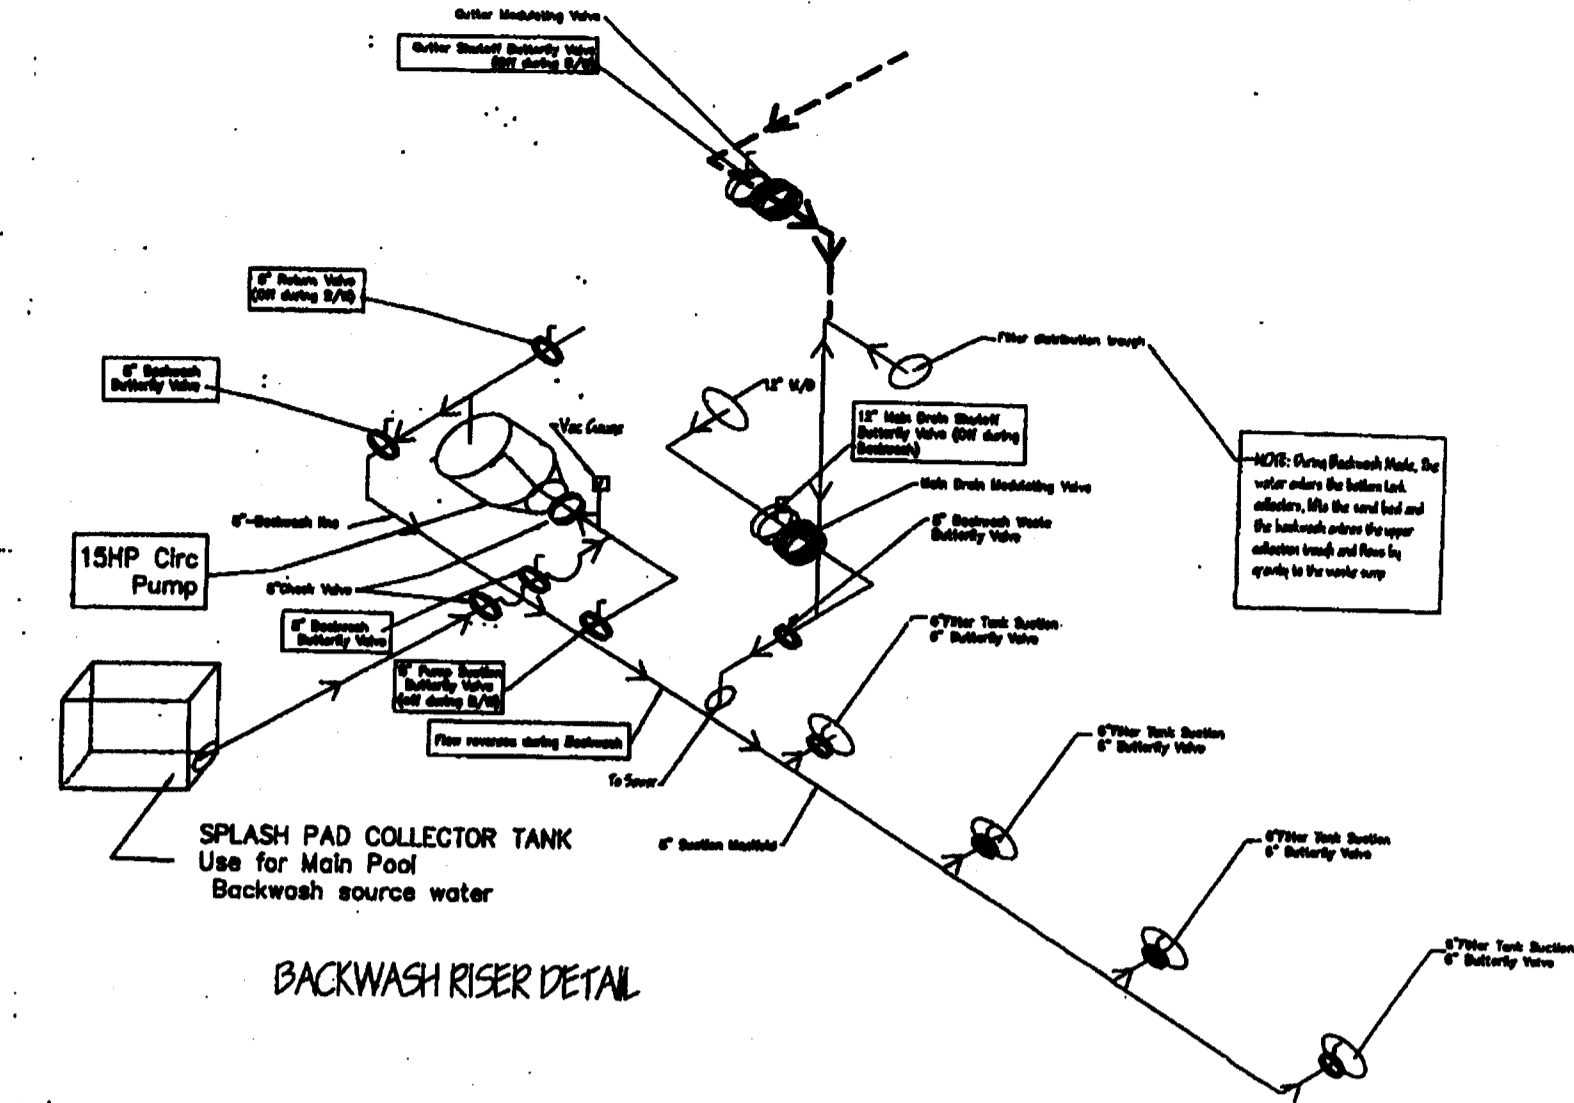


ALL ELECTRICAL WORK SHALL COMPLY WITH NFPA 70 NATIONAL CODE 1996 EDITION

NOTE FEATURE PIPING TO BE SUSPENDED FROM THE EQUIPMENT ROOM CEILING WITH HOT DIPPER ADJUSTABLE HANGARS AS FOLLOWS:
 1 1/2\"/>

● DENOTES CEILING PENETRATIONS TO SPLASH PAD

ELECTRICAL NOTE:
 3 EA. 15 HP PUMPS
 3 PHASE 240 VOLTS
 ALL OTHER PUMPS
 2 HP DOWN SINGLE
 PHASE 208/230 VOLTS

Silcox Engineering, Inc. Civil Engineering
 ERNEST S. SILCOX P.E. #0008161
 Post Office Box 8574
 Tampa, FL 33674 813/920-9192

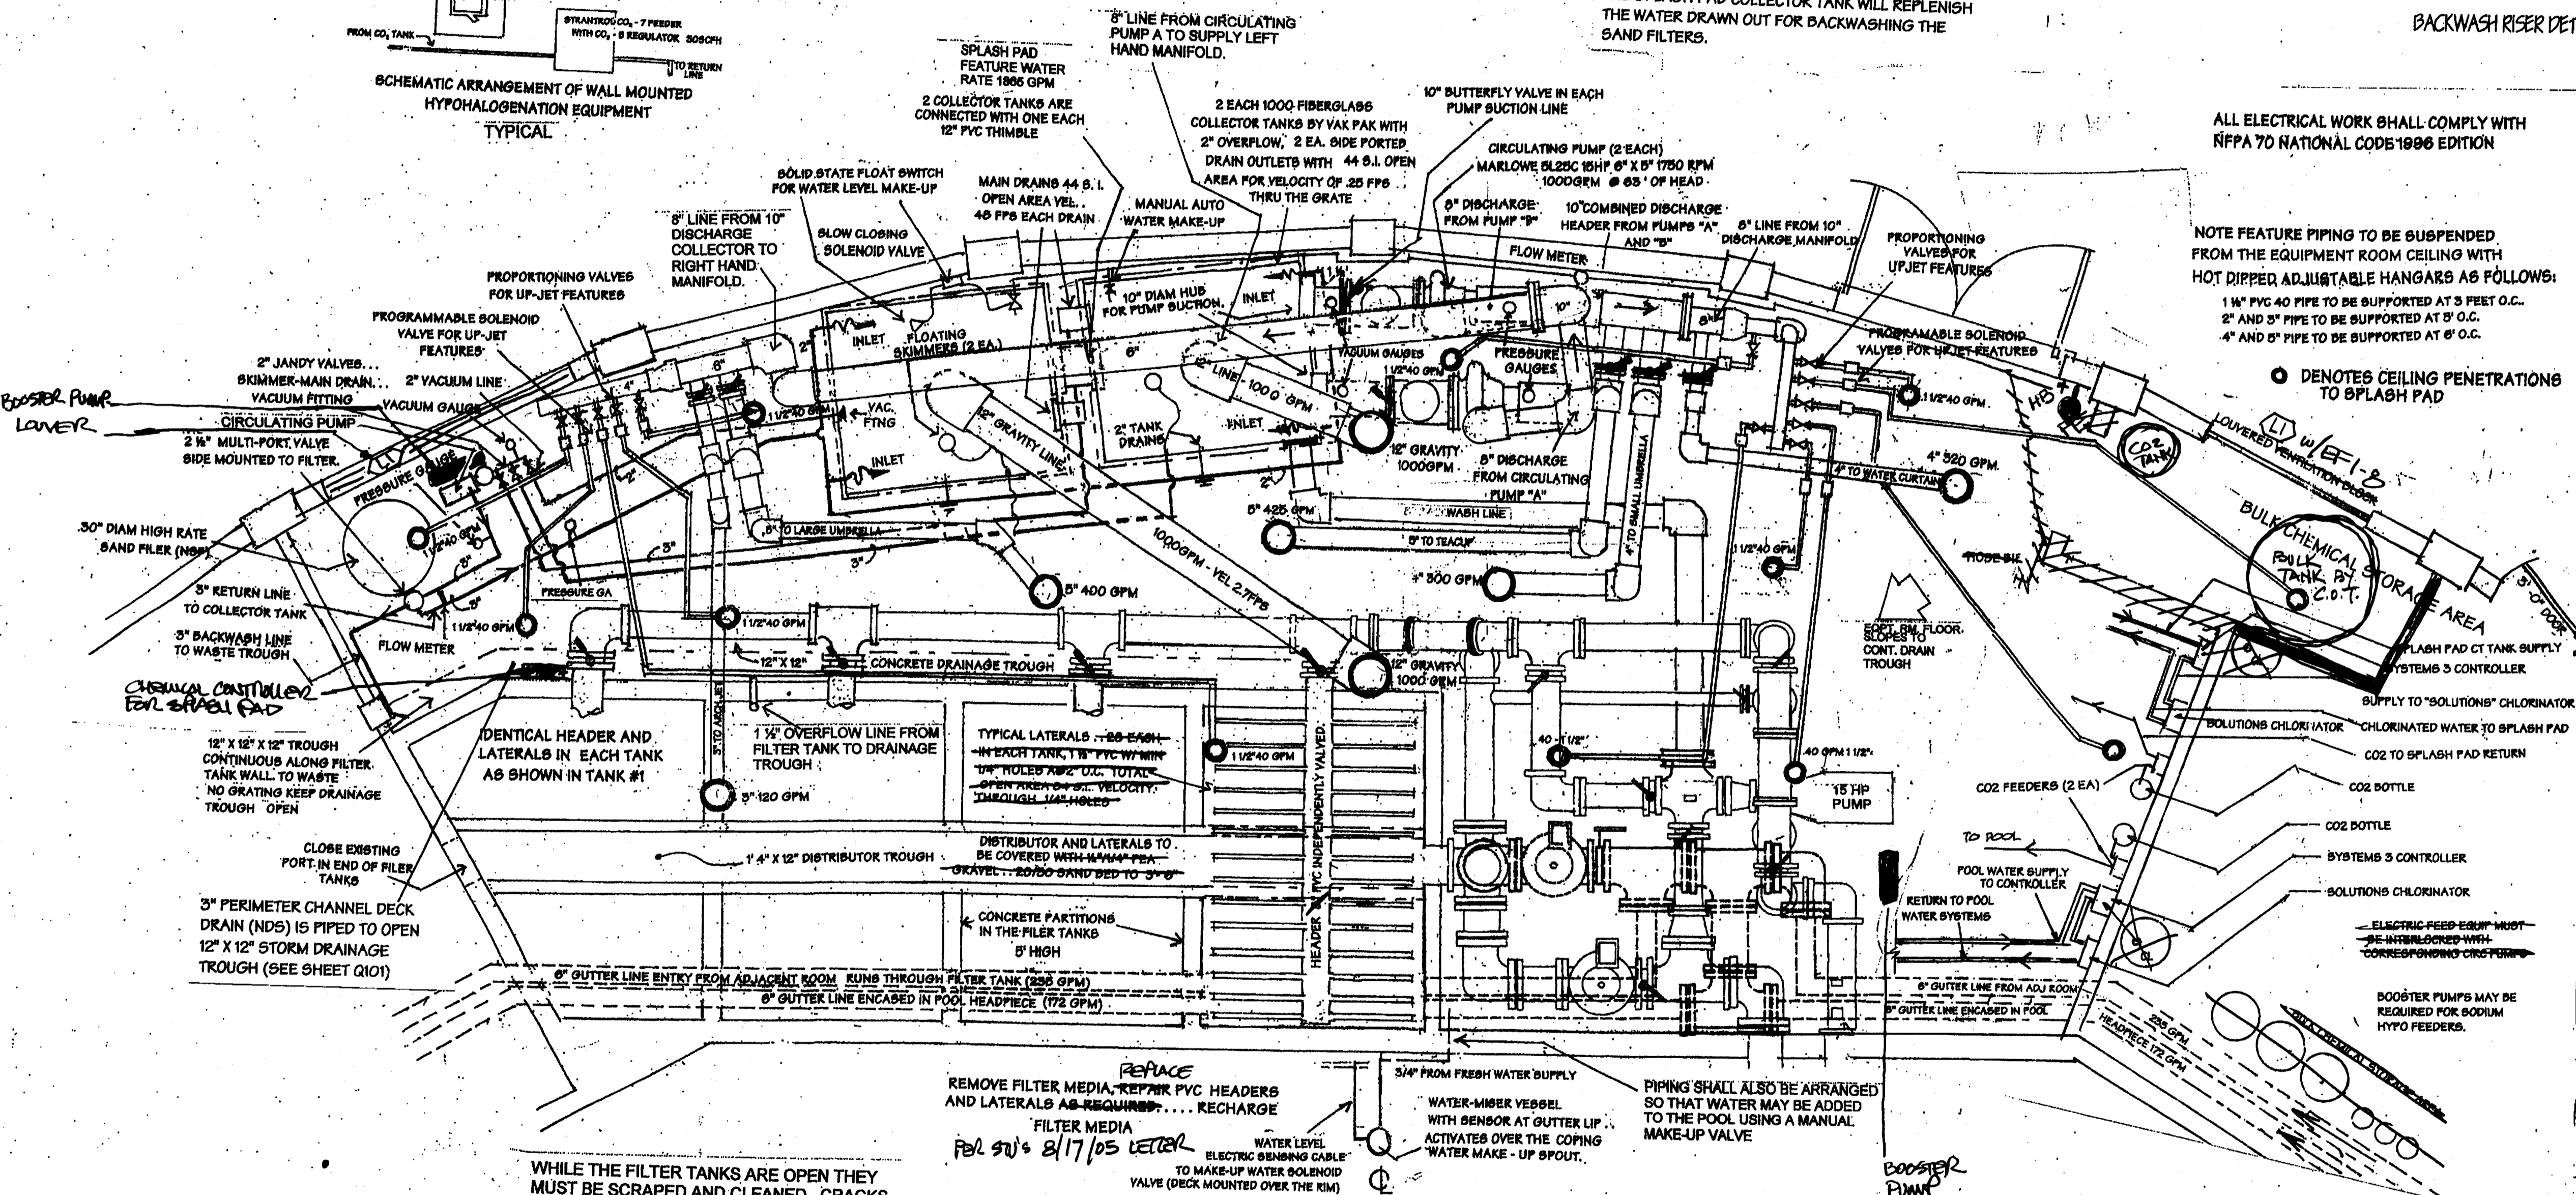

WHILE THE FILTER TANKS ARE OPEN THEY MUST BE SCRAPPED AND CLEANED. CRACKS AND FISSURES ARE TO BE REPAIRED WITH VULKEM SEALANT #116. ANY VOIDS IN THE POURED CONCRETE WALLS AND FLOOR ARE TO BE PATCHED WITH HYDRAULIC CEMENT.

REPLACE REMOVE FILTER MEDIA, REPAIR PVC HEADERS AND LATERALS AS REQUIRED. RECHARGE FILTER MEDIA
 FEB 90'S 8/17/05 LETTER
 WATER LEVEL ELECTRIC SENSING CABLE TO MAKE-UP WATER SOLENOID VALVE (DECK MOUNTED OVER THE RIM)

PIPING SHALL ALSO BE ARRANGED SO THAT WATER MAY BE ADDED TO THE POOL USING A MANUAL MAKE-UP VALVE

PLUMBING LAYOUT FOR SPLASH PAD

SCALE 3/8" = 1'-0"

SEE SHEET 1 FOR POOL SYSTEM OPERATION NARRATIVE

ALL EQUIPMENT ROOM DRAINAGE SLOPES TO 12" X 12" OPEN DRAINAGE TROUGH 30' LONG.

EQUIPMENT SHALL BE INSTALLED SO THAT CLEARANCE SHALL BE PROVIDED FOR ALL EQUIPMENT AS PRESCRIBED BY THE MANUFACTURER TO ALLOW NORMAL MAINTENANCE AND REMOVAL WITHOUT DISTURBING OTHER PIPING OR EQUIPMENT.

NON-HAMMERING CHECK VALVES TO BE INSTALLED ON THE DISCHARGE SIDE OF BOTH FEATURE PUMPS
 ALL FLANGES TO HAVE STAINLESS STEEL BOLTS
 VACUUM GAUGES TO BE INSTALLED ON THE SUCTION SIDE OF EACH PUMP. PRESSURE GAUGES ON DISCHARGE SIDE OF PUMP
 SPLASH PAD C.T. TANKS AND POOL FILTER TANKS MUST HAVE 2" MINIMUM COVE AT ALL INSIDE CORNERS.

FILTER RATE THROUGH HI-RATE SAND SPLASH PAD FILTER IS 13.7 GPM PER SQUARE FOOT OF FILTER AREA. FILTER RATE THROUGH VACUUM SAND FILTER IS 3.75 GPM PER SQ. FOOT OF FILTER AREA.


PRESSURE SAND FILTER TO HAVE AUTOMATIC AIR RELIEF VALVE

VACUUM AND CIRC PUMPS TO BE EQUIPPED WITH VACUUM GAUGES (0-30") AND PRESSURE GAUGES (0-60#)

AUTOMATIC WATER MAKE-UP ON POOL IS REGULATED BY A 'WATER MISER' TANK MOUNTED IN DECK AT POOL SIDE WHICH WILL ACTIVATE AN OVER-THE-COPING WATER MAKE-UP SPOUT.

EQUIPMENT ROOM PIPING FOR POOL AND SPLASH PAD

RECORD DWG.
 DATE 8/26/05

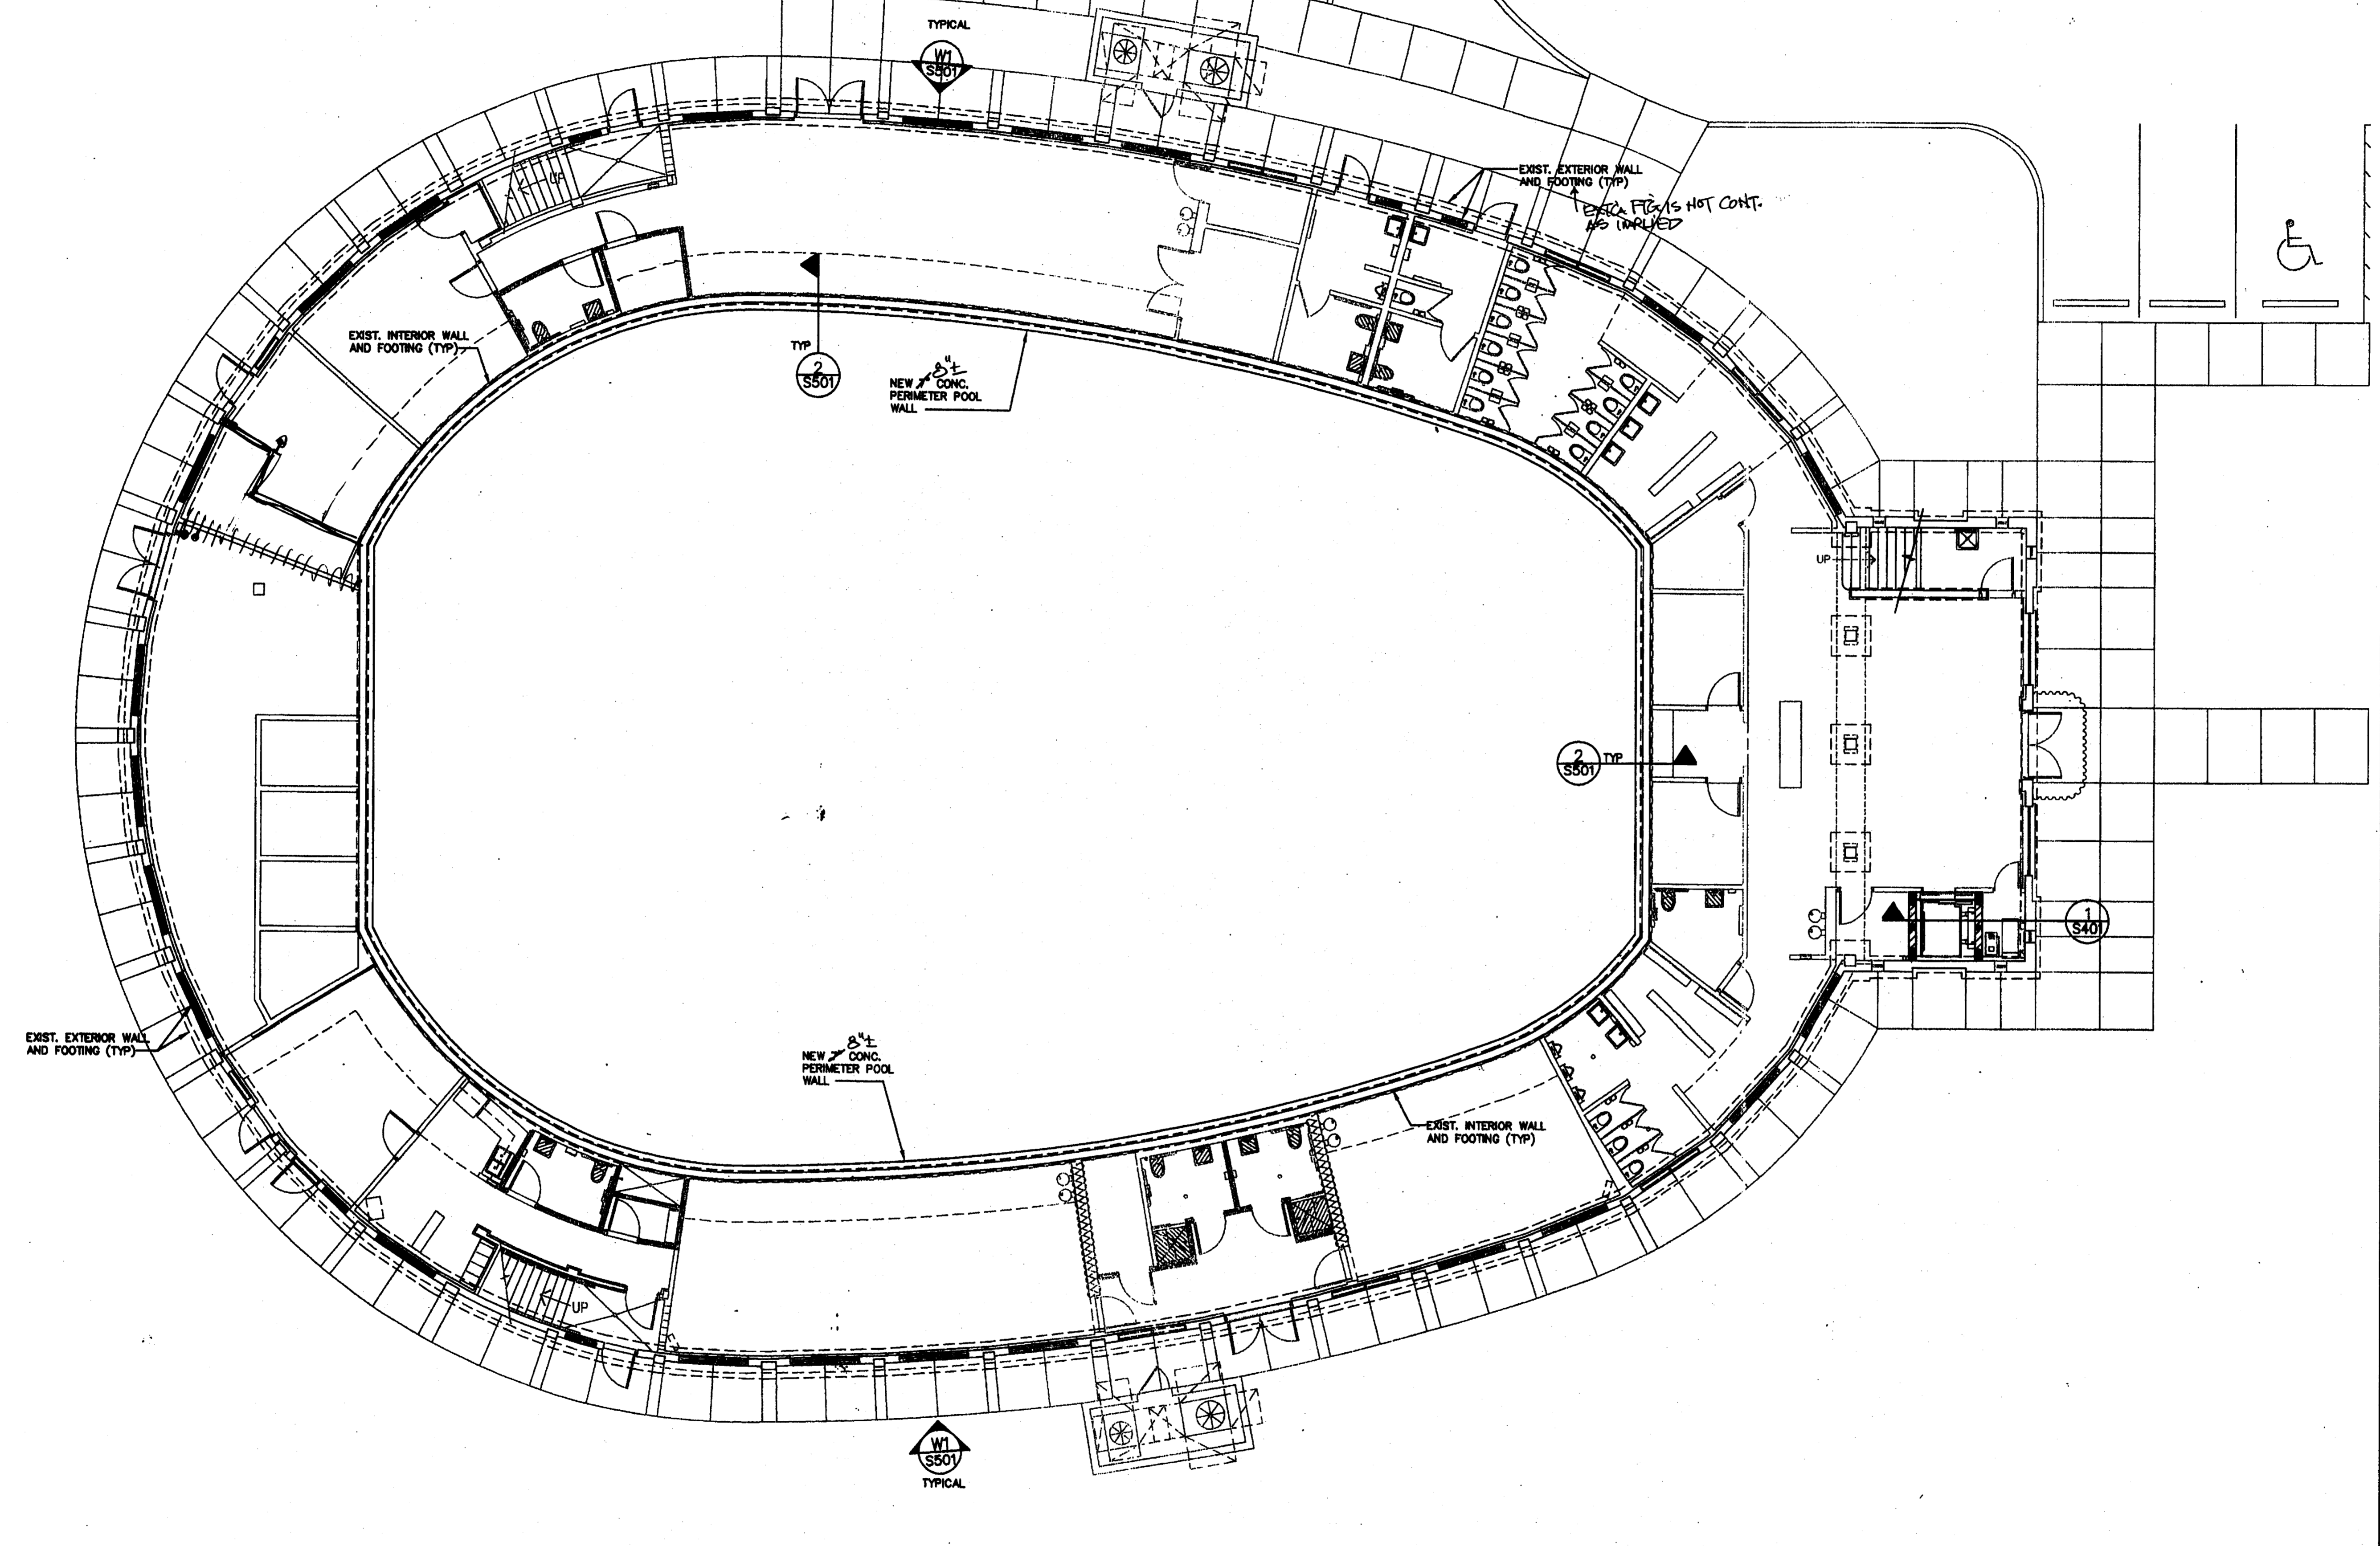

FOUNDATION PLAN
 SCALE: 1/8"=1'-0"

JAMES R. MEHLTRETTER, P.E.
 FL. LIC. No. 33860

MASTER CONSULTING ENGINEERS, INC.
 2807 W. BAY TO BAY BOULEVARD, #201
 TAMPA, FLORIDA 33629-8181
 813.896.4886 FAX 813.896.8228
 MCE@mcengineers.com
 EB: 8428 PROJ. NO.

CUSCADEN POOL RENOVATION

CITY OF TAMPA
 306 East Jackson Street
 Tampa, Florida 33602

Project No.	0202.00
Distribution	Date
Bld Documents	02.02.04

FOUNDATION PLAN
RECORD DWG.


DATE 8/26/05

0 4 8 16 FT

S101

RECEIVED
 FEB 23 2004
 CON. TECH. GROUP, INC.

217
 009

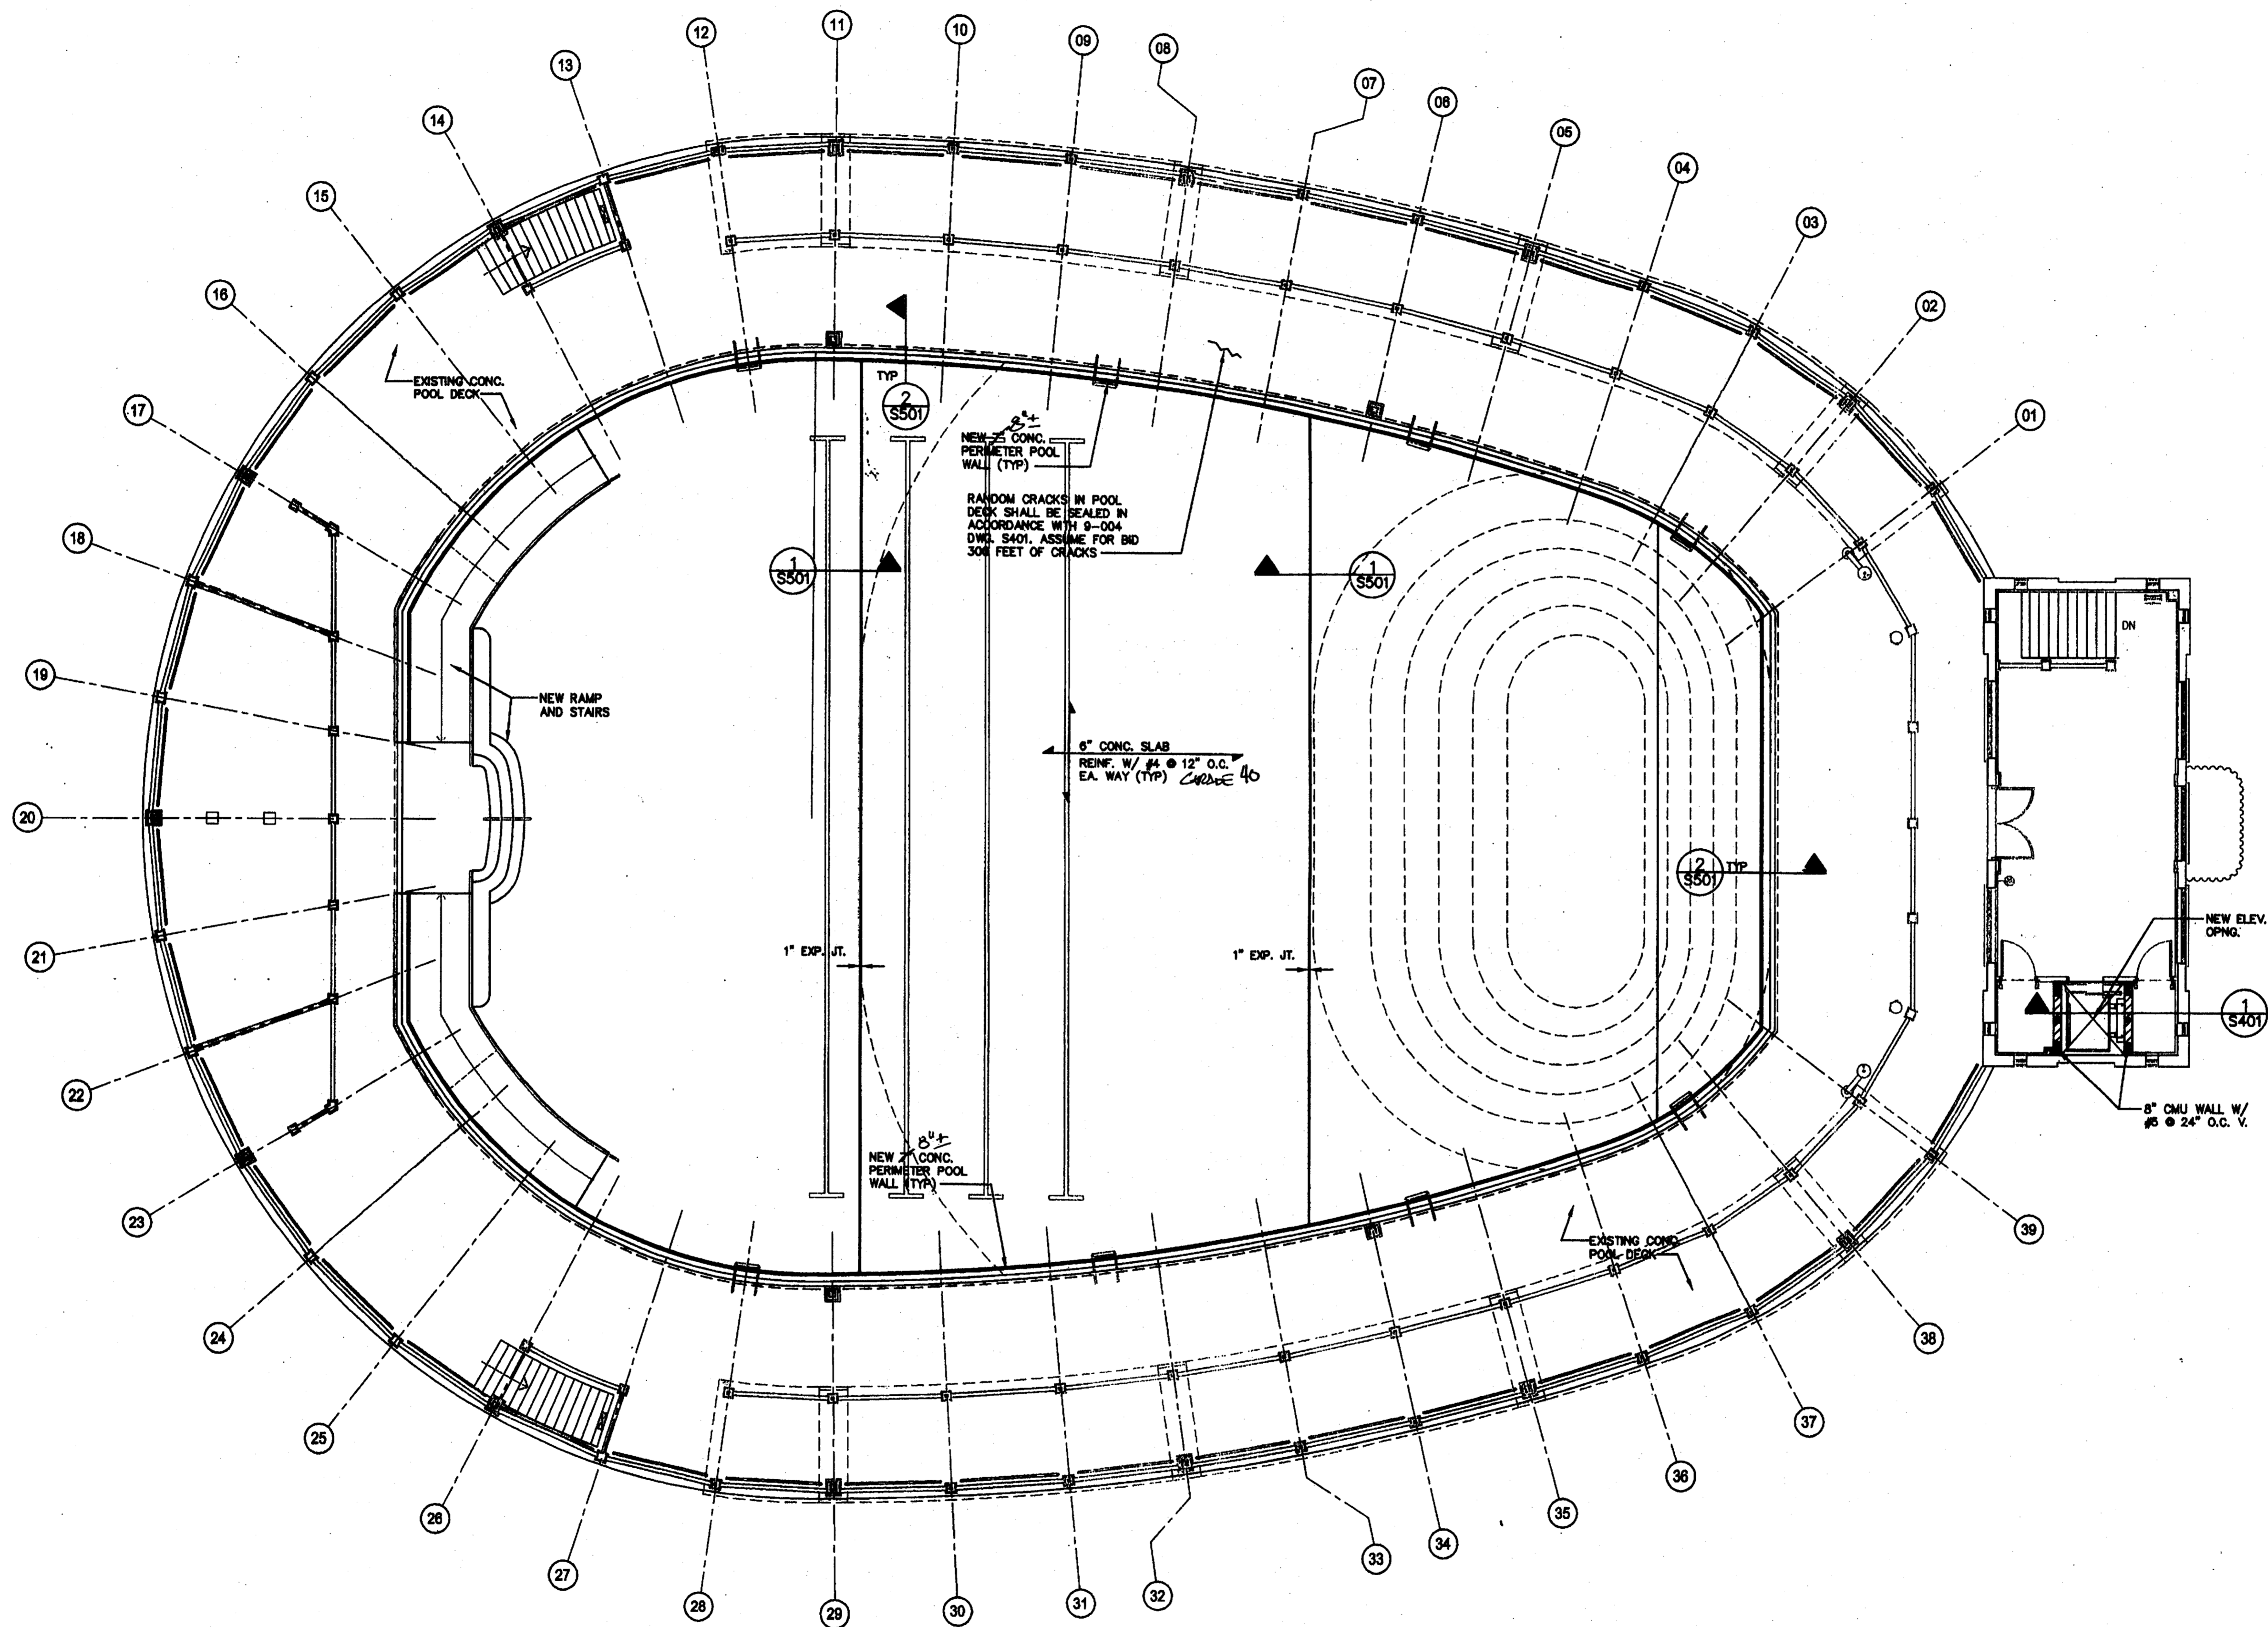

TOP DECK PLAN
SCALE: 1/8"=1'-0"

JAMES R. MEHLTRETTER, P.E.
FL. LIC. No. 33860

Signature _____ Date _____

MASTER CONSULTING ENGINEERS, INC.
2907 W. BAY TO BAY BOULEVARD, #201
TAMPA, FLORIDA 33629-9181
813.838.4998 FAX 813.838.8228
MOE@moengineers.com
EB: 8486 PROJ. NO.



CUSCADEN POOL RENOVATION

CITY OF TAMPA
306 East Jackson Street
Tampa, Florida 33602


Project No.	0202.00
Distribution	Date
Bld Documents	02.02.04

TOP DECK PLAN
RECORD DWG.

DATE 8/26/05



RECEIVED
FEB 23 2004
S201
217
009

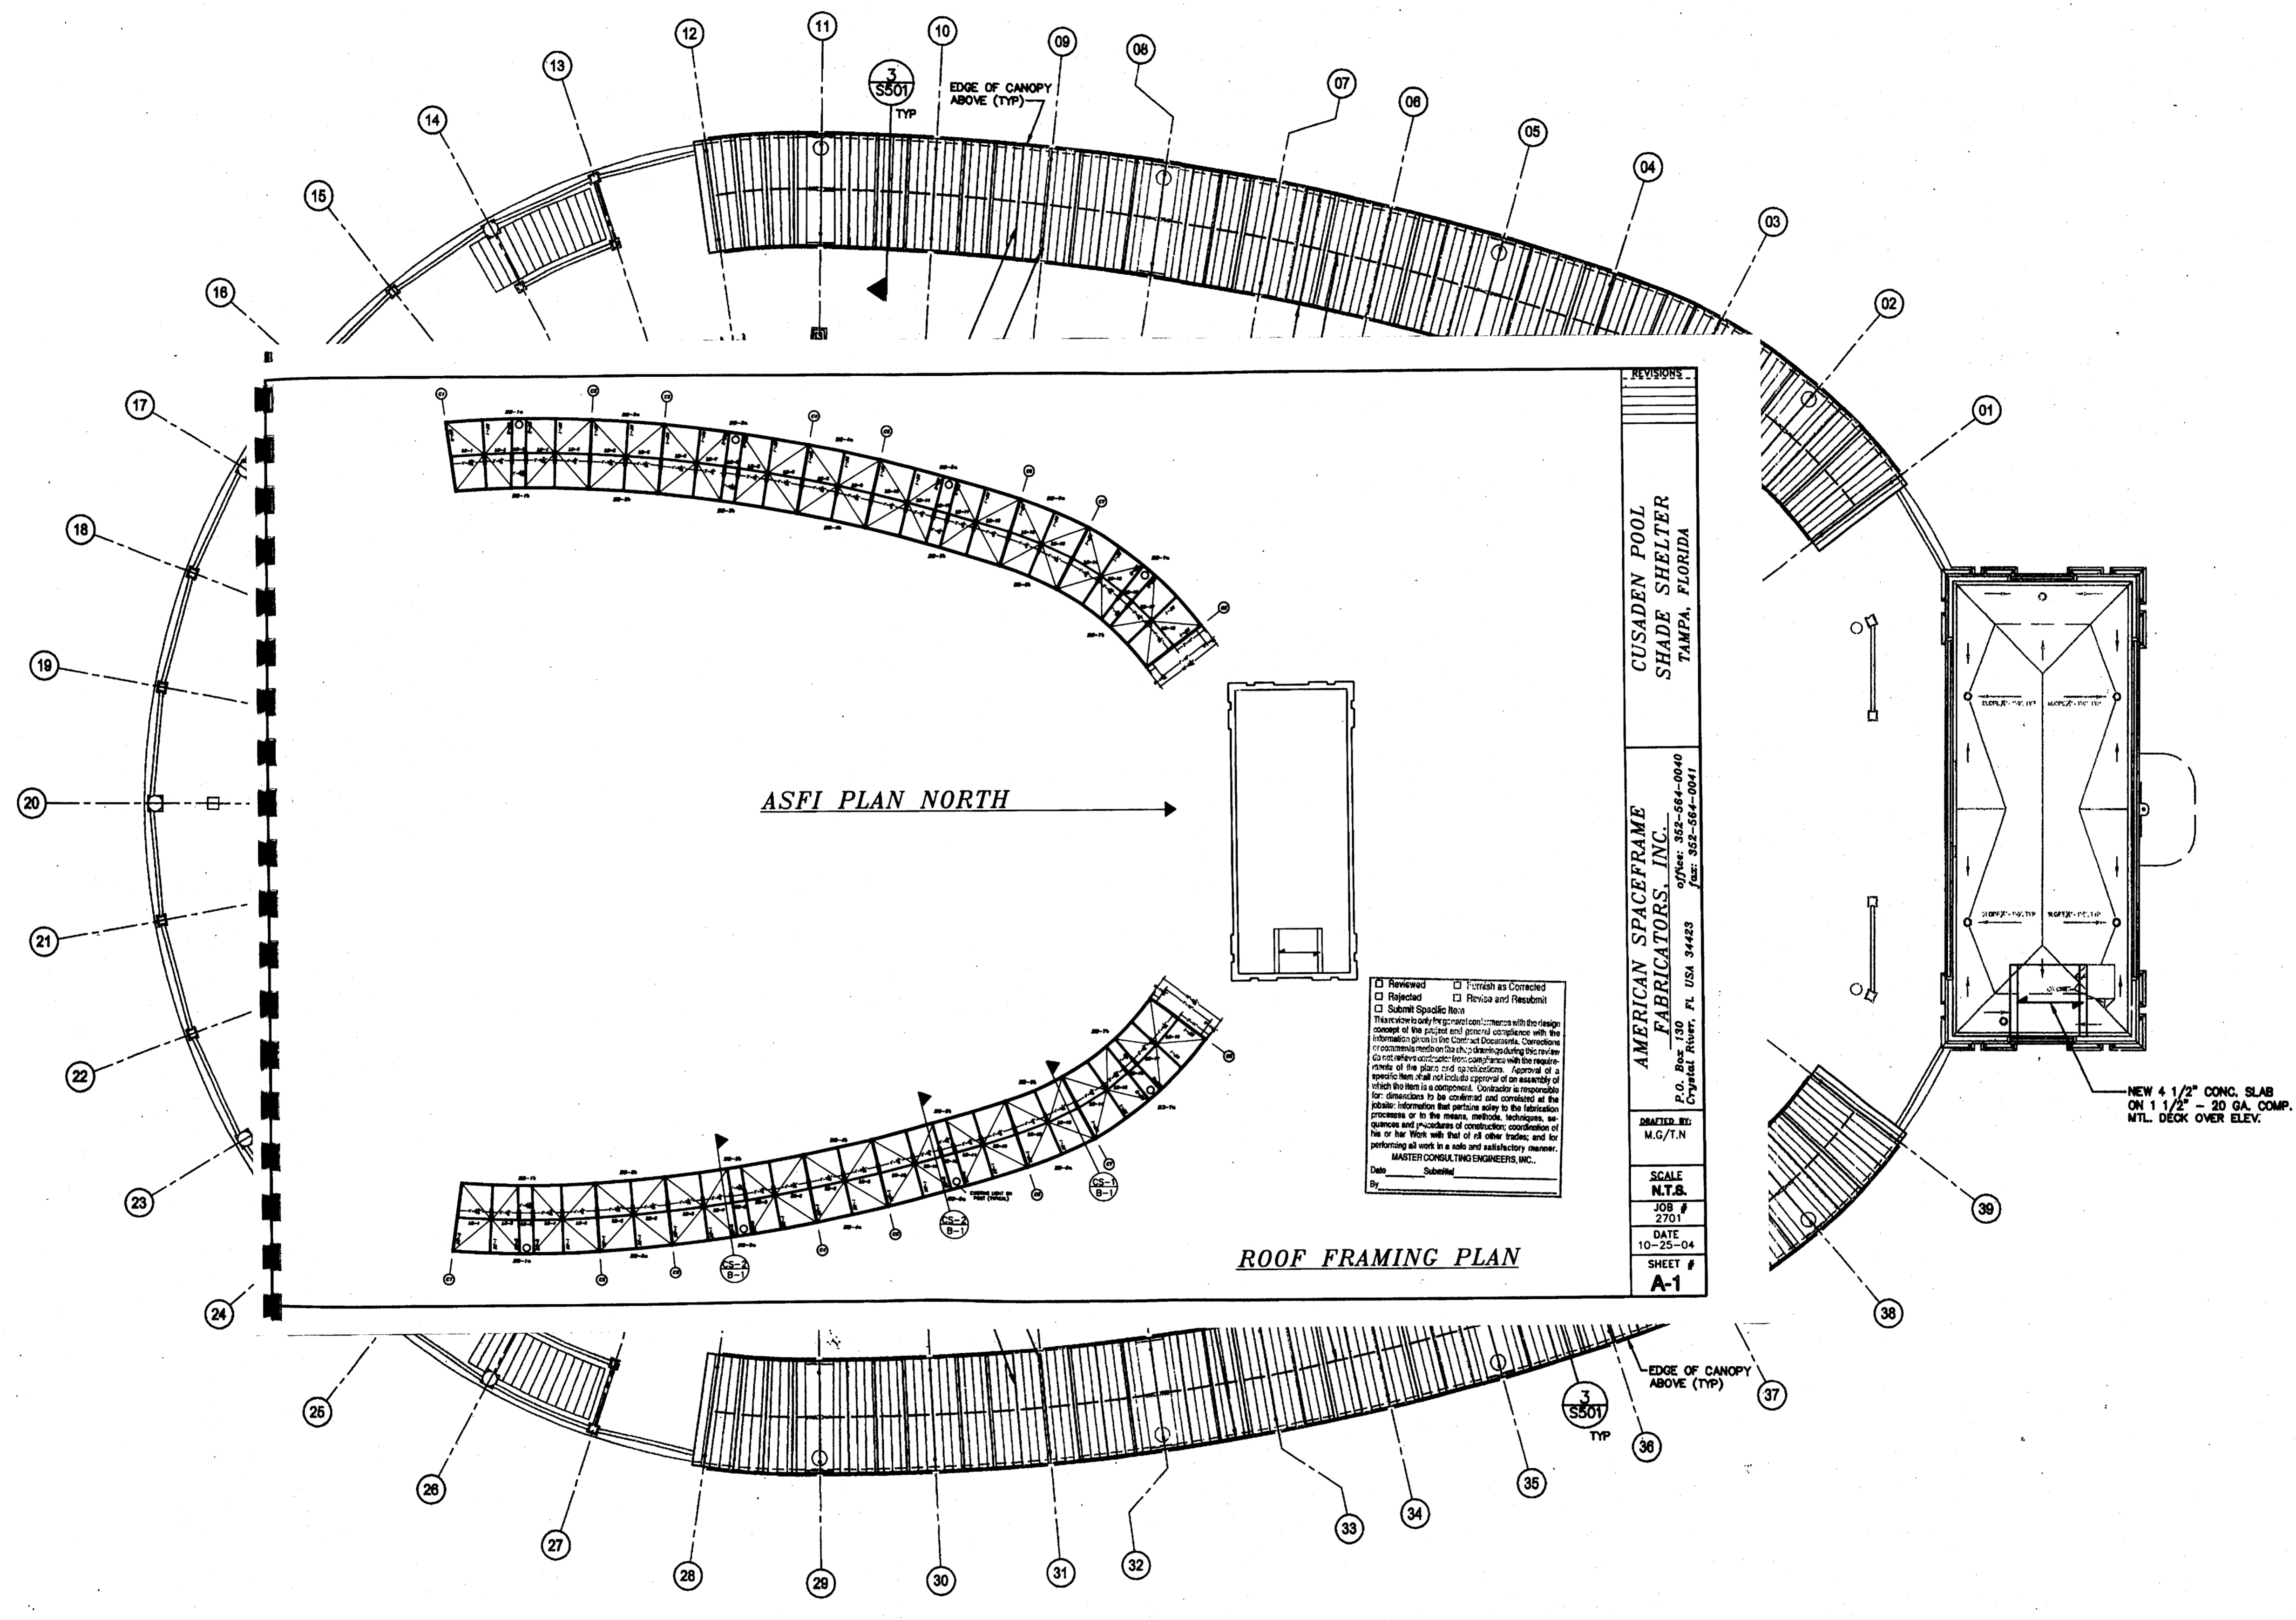

Reviewed Revised as Constructed
 Rejected Revised and Resubmit
 Submit Specific Note
 This review is only for general compliance with the design concept of the project and general compliance with the information provided in the Contract Documents. Construction or occupancy inspections shall be conducted by the reviewer or other qualified personnel. Approval of a specific item shall not constitute approval of the assembly of which this item is a component. Contractor is responsible for dimensions to be confirmed and controlled at the job site. Information that pertains solely to the fabrication processes or to the means, methods, techniques, sequences and procedures of construction; coordination of the work with that of all other trades; and for the performance of all work in a safe and satisfactory manner.
 MASTER CONSULTING ENGINEERS, INC.
 Date: _____
 By: _____

AMERICAN SPACEFRAME FABRICATORS, INC.
 9090 W. Bay to Bay Blvd., Suite 200
 Cypress Flats, FL USA 34423
 Phone: 813-884-0040
 Fax: 813-884-0041
 P.O. Box 1000
 Cypress Flats, FL USA 34423
 M.C./T.N.
 SCALE: N.T.S.
 JOB #: 2701
 DATE: 10-25-04
 SHEET #: A-1

ROOF PLAN
 SCALE: 1/8"=1'-0"

JAMES R. MEHLTRETTER, P.E.
 FL. LIC. No. 33860
 Signature: _____ Date: _____

MASTER CONSULTING ENGINEERS, INC.
 2907 W. BAY TO BAY BOULEVARD, #201
 TAMPA, FLORIDA 33609-8181
 813.886.1686 FAX 813.886.8225
 MCE@mceengineers.com
 EB: 8426 PROJ. NO.

CUSCADEN POOL RENOVATION

CITY OF TAMPA
 306 East Jackson Street
 Tampa, Florida 33602

Project No.	0202.00
Distribution	Date
Bid Documents	02.02.04

TOP DECK PLAN
RECORD DWG.

DATE: 8/26/05
 1/8" = 1'-0"
 0 4 8 16 FT

RECEIVED
 FEB 23 2004
S301
 CONF. ENCL. GROUP INC.

TENSION LAP SPLICES

BAR SIZE	LAP CLASS	TOP BARS				OTHER BARS				COMPRESSION LAP SPLICES
		1	2	3	4	1	2	3	4	
#4	A	12	12	12	12	12	12	12	12	12
#5	A	12	12	12	12	12	12	12	12	12
NOTES:


1. DIMENSIONS 1 THROUGH 4, WHICH DEPEND ON THE STRUCTURAL ELEMENT, CONCRETE COVER, AND THE CENTER-TO-CENTER SPACING OF THE BARS, AS SHOWN IN THE TABLE BELOW THE TABLE.
2. TOP BARS ARE HORIZONTAL BARS WITH BARS WITH 12 INCHES OF CONCRETE CAST OVER THEM.
3. USE LAP CLASS "A" UNLESS OTHERWISE NOTED.
4. ALL BARS SHALL BE SPACED WITH CENTER-TO-CENTER SPACING NOT LESS THAN 16 TIMES THE DIAMETER OF THE BARS, UNLESS OTHERWISE SPECIFIED BY THE ARCHITECT.
5. CONCRETE COVER SHALL BE MINIMUM 1.5 INCHES ABOVE BY 1.5 INCHES BELOW BY 1.5 INCHES.
6. FOR SPOT COATED REINFORCING BARS, MINIMUM COVER SHALL BE IN THE SPICE TABLE AS SHOWN ON THIS DRAWING BY ONE OF THE VALUES IN THE SPICE TABLE AND SPACING TABLE THIS DRAWING.
7. FOR SLABS OF BARS WITH DIFFERENT SIZE AND SPACING TABLE THIS DRAWING.
8. ALL 90-DEGREE CORNER BARS SHALL BE LAP SPICED FOR LARGER BARS. ALL 90-DEGREE CORNER BARS SHALL BE LAP SPICED FOR LARGER BARS.
9. ALL 90-DEGREE CORNER BARS SHALL BE LAP SPICED FOR LARGER BARS.

COMPRESSION LAP SPLICES

BAR SIZE	LAP CLASS	TOP BARS				OTHER BARS			
		1	2	3	4	1	2	3	4
#4	A	12	12	12	12	12	12	12	12
#5	A	12	12	12	12	12	12	12	12
TENSION AND COMPRESSION LAP SPLICES W/ F_c = 4000 PSI

REINFORCING ELEMENT	CONCRETE COVER	COVER TO CENTER-TO-CENTER SPACING	COVER TO CENTER-TO-CENTER SPACING	COVER TO CENTER-TO-CENTER SPACING	COVER TO CENTER-TO-CENTER SPACING
		1	2	3	4
SLAB, WALLS, AND OTHER LAMINAR OF CONCRETE	1.5	1	1	1	1
ALL OTHERS	2.5	1	1	1	1

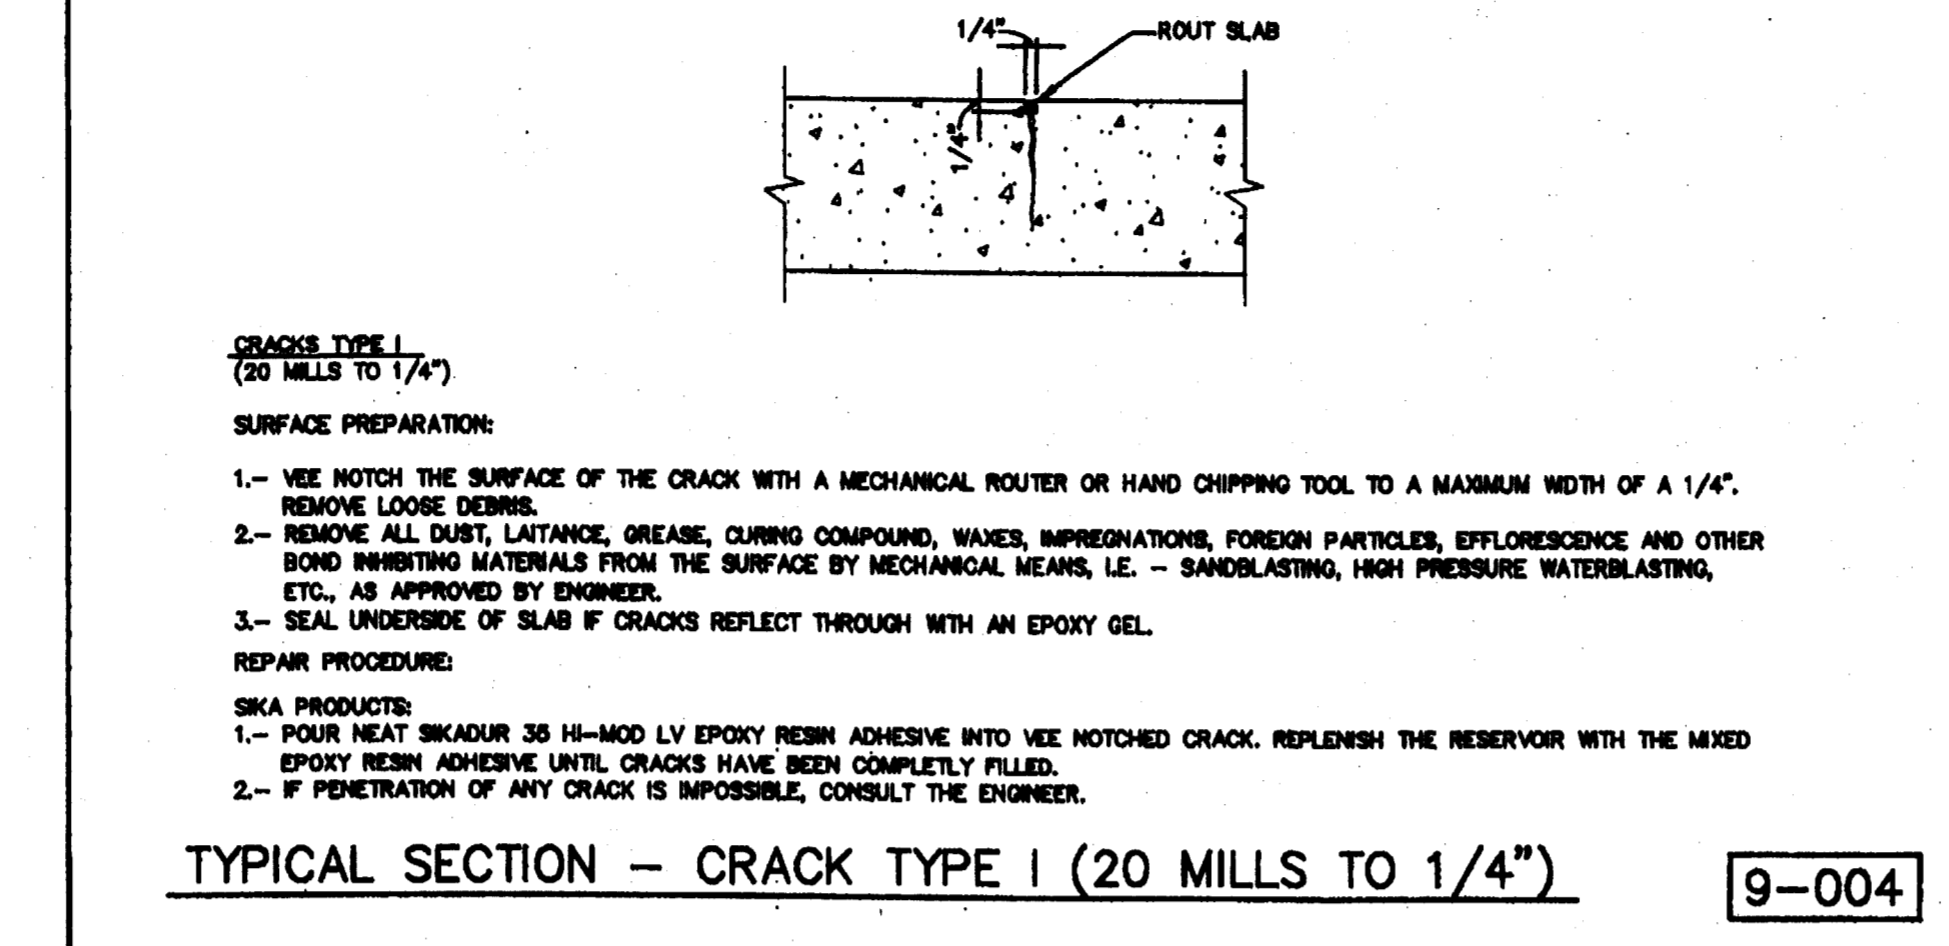

- GENERAL NOTES:**
1. CONTRACTOR IS RESPONSIBLE FOR AND SHALL VERIFY AND COORDINATE ALL DIMENSIONS AND DETAILS BEFORE PROCEEDING WITH WORK. ANY DISCREPANCIES SHALL BE BROUGHT TO THE IMMEDIATE ATTENTION OF THE ARCHITECT.
 2. DETAILS SHOWN IN ANY SECTION APPLY TO ALL SIMILAR SECTIONS AND CONDITIONS UNLESS OTHERWISE NOTED.
 3. CONTRACTOR SHALL FULLY BRACE AND OTHERWISE PROTECT ALL WORK IN PROGRESS UNTIL THE BUILDING IS COMPLETED.
 4. ALL STRUCTURAL ITEMS FOR THIS PROJECT HAVE BEEN DESIGNED IN ACCORDANCE WITH APPROPRIATE PROVISIONS OF EACH OF THE FOLLOWING:
 - A. THE FLORIDA BUILDING CODE, 2001 EDITION.
 - B. ACI STANDARD 318-99 BUILDING CODE REQUIREMENTS FOR REINFORCED CONCRETE.
 - C. BUILDING CODE REQUIREMENTS FOR MASONRY STRUCTURES (ACI 530-99/ASCE 5-99).
 - D. ALSO "SPECIFICATION FOR THE DESIGN, FABRICATION AND ERECTION OF STRUCTURAL STEEL FOR BUILDINGS" LATEST EDITION.
 5. THE STRUCTURAL DRAWINGS SHALL BE USED IN CONJUNCTION WITH THE SPECIFICATIONS AND THE ARCHITECTURAL AND MECHANICAL DRAWINGS. IF THERE IS A DISCREPANCY BETWEEN DRAWINGS, IT IS THE CONTRACTOR'S RESPONSIBILITY TO NOTIFY THE ARCHITECT PRIOR TO PERFORMING WORK.



- FOUNDATION NOTES:**
1. FOUNDATIONS FOR THIS PROJECT HAS BEEN DESIGNED ASSUMING THE SOIL IS SUITABLE TO SUPPORT 2 KIP/SQ FOOT FOOTINGS. CONTRACTOR MUST VERIFY SOIL CONDITIONS AND BEARING CAPACITY.
 2. COMPACT FILL TO 96 % MOIST PROCTOR.
 3. ALL COLUMN FOOTINGS SHALL BE CENTERED UNDER COLUMN CENTRLINES UNLESS OTHERWISE NOTED.
 4. BACKFILLING AGAINST FOUNDATION WALLS SHALL BE DONE CAREFULLY WITH SMALL COMPACTION EQUIPMENT. AFTER SLABS ON GRADE ARE IN PLACE AND CONCRETE HAS SET, NO TRUCKS, BUILDINGZERS, ETC. SHALL BE ALLOWED CLOSER THAN 8'-0" TO ANY FOUNDATION WALL.
 5. FOOTINGS SHALL BE PLACED ABOVE A VERTICAL ON 2 HORIZONTAL SLABS EXTENDING TO THE EDGE OF ANY UNFINISHED SOIL OR OTHER FOUNDATION STRUCTURE. BOTTOM OF FOOTINGS SHALL NOT BE LESS THAN 1'-0" BELOW EXISTING GRADE (U.L.O.).
 6. CONCRETE SLABS ON GRADE TO BE 8" THICK STONE CONCRETE REINFORCED WITH #4@2' O.C. ON PROPERLY COMPACTED SUBBASE. TOP OF FOOTING SHALL BE 1" ON PLAN OR SECTION IS REFERENCE TOP OF FOOTING ELEVATION.
 7. ELEVATOR PIT DIMENSIONS - VERIFY WITH ELEVATOR MANUFACTURERS' APPROVED SHOP DRAWINGS.
 8. WATER PROOFING MATERIALS SHALL BE PROVIDED ON ALL SIDES AND BOTTOM OF ELEVATOR.

- CONCRETE AND REINFORCING:**
1. ALL CONCRETE WORK SHALL CONFORM TO THE LATEST ACI "BUILDING CODE REQUIREMENTS FOR REINFORCED CONCRETE, ACI 318-99". ALL CONCRETE SHALL HAVE A MINIMUM 28-DAY COMPRESSIVE STRENGTH AS INDICATED BELOW:
 2. CONCRETE STRENGTH TYPE AGGREGATE WHERE USED:
 - 4000 PSI STONE CONCRETE, U.N.O.
 3. ALL REINFORCING STEEL SHALL BE INTERMEDIATE GRADE, NEW BILLET STEEL, DEFORMED BARS, CONFORMING TO ASTM A-615, GRADE 60. ALL BARS SHALL BE SECURELY SUPPORTED AND WIRED IN PLACE PRIOR TO POURING CONCRETE.
 4. ALL WELDED WIRE FABRIC (W.W.F.) SHALL CONFORM TO ASTM A-185, UNLESS NOTED. ALL BARS MARKED CONT. SHALL BE SPICED AT ALL LAP POINTS AND DEVELOPED AT DISCONTINUOUS ENDS AS PER TYPICAL DETAILS. SPICE CONTINUOUS TOP BARS AT CENTER BETWEEN SUPPORTS AND SPICE CONTINUOUS BOTTOM BARS AT SUPPORTS.
 5. CONCRETE COVER FOR REINFORCING BARS SHOWN IN TYPICAL DETAILS.
 6. UNLESS NOTED, TEMPERATURE REINFORCING (ASTM A-615-80) TO BE 0.0018 X CONCRETE AREA.
 7. PROVIDE #4 @ 12" O.C. TOP BARS IN ALL SLABS AT DISCONTINUOUS ENDS UNLESS OTHERWISE NOTED ON PLANS. LENGTH OF BARS 1/4 OF SPAN, MINIMUM 3'-0".
 8. WHERE PIPE SLEEVES (UP TO 2" IN DIAMETER) PASS THROUGH CONCRETE BEAMS, PROVIDE ADDITIONAL STIRRUP EACH SIDE OF STEEL SLEEVES FOR PIPES 2" IN DIAMETER OR LARGER MUST BE SLEEVED ON CAST IRON, AND THE LOCATION MUST BE APPROVED BY THE STRUCTURAL ENGINEER.
 9. ALL CONSTRUCTION JOINTS SHALL BE THOROUGHLY CLEANED JUST BEFORE PLACING NEW CONCRETE.
 10. FOR CHAMFER OF EXPOSED CORNERS OF BEAMS AND/OR COLUMNS, SEE ARCHITECTURAL DRAWINGS.
 11. CONTRACTOR SHALL COORDINATE PLACEMENT OF, OR BOX OUT FOR, ALL PIPE SLEEVES, OPENINGS, ETC. REQUIRED FOR VARIOUS TRADES.
 12. CONTRACTOR SHALL COORDINATE AND NOTIFY OTHER TRADES IN SUFFICIENT TIME TO ALLOW THEM TO SET ANCHORS, INSERTS, BOLTS, HAMMERS, ETC., AS REQUIRED FOR THEIR USE.
 13. SEE ARCHITECTURAL DRAWINGS FOR DETAILS OF FLASHING REGLETS, FASCIA DETAILS, ETC.
 14. UNDER NO CIRCUMSTANCES SHALL CONCRETE BE PUMPED THROUGH ALUMINUM PIPES. CONCRETE SHALL NOT BE PLACED IN CONTACT WITH ALUMINUM, ALUMINUM MIXING DRUMS, TRUCK MIXERS, BUCKETS, CHUTES, CONVEYORS, TRUCK PIPES, AND OTHER EQUIPMENT MADE OF ALUMINUM SHALL NOT BE USED ON THIS PROJECT.
 15. SLIMPS OF OVER 4 INCHES WILL NOT BE PERMITTED UNLESS THE HWY ADMIXTURE (SUPER PLASTICIZER) IS USED. MAXIMUM SLIMP IS THEN 8 INCHES UNLESS OTHERWISE DIRECTED BY THE ENGINEER. IN ANY CASE, THE MAXIMUM WATER-CEMENT RATIO SHALL BE 0.42 FOR 4000 PSI CONCRETE.
 16. NO ADMIXTURE SHALL BE USED IN CONCRETE EXCEPT WITH THE APPROVAL OF THE ENGINEERS AND AFTER LABORATORY DESIGN MIX APPROVAL. ALL ADMIXTURES SHALL CONTAIN NO MORE CHLORIDE IONS THAN ARE PRESENT IN MUNICIPAL DRINKING WATER.
 17. WATER REDUCING ADMIXTURE SHALL CONFORM TO ASTM C-494, TYPE A, AND SHALL BE USED IN ALL CONCRETE.
 18. AIR ENTRAINING ADMIXTURE SHALL CONFORM TO ASTM C260. AIR CONTENT OF CONCRETE SHALL BE AS FOLLOWS:
 - A. FOR CONCRETE EXPOSED TO SOIL AND/OR WEATHER, SK. B.
 - B. FOR INTERIOR WALLS, COLUMNS, AND SLABS, SK. B.


- MASONRY:**
1. DESIGN AND CONSTRUCTION SHALL CONFORM TO BUILDING CODE REQUIREMENTS FOR MASONRY STRUCTURES (ACI 530-99/ASCE 5-99).
 2. MINIMUM NET AREA COMPRESSIVE STRENGTH OF CONCRETE MASONRY UNITS SHALL BE 1900 PSI (F_m = 1900 PSI).
 3. MORTAR FOR MASONRY SHALL BE TYPE S OR M.
 4. FOR LOAD BEARING WALLS, ALL BED JOINTS ARE TO COVER 100% OF THE MASONRY SURFACES AND ALL HEAD JOINTS ARE TO COVER 100% OF THE PROJECTED AREA OF THE FACE SHELLS.
 5. MINIMUM JOINT REINFORCING SHALL BE TYPE S OR M.
 6. FOR LOAD BEARING WALLS, ALL BED JOINTS ARE TO COVER 100% OF THE MASONRY SURFACES AND ALL HEAD JOINTS ARE TO COVER 100% OF THE PROJECTED AREA OF THE FACE SHELLS.
 7. MINIMUM VERTICAL REINFORCING SEE PLAN & SECTION.
 8. ALL CELLS AS REQUIRED WITH HARDENED WASHERS UNDER THE TURNED ELEMENT (NUT OR BOLT HEAD).
 9. INSTALLATION AND TIGHTENING OF ALL HIGH STRENGTH BOLTS SHALL CONFORM TO THE "SPECIFICATION FOR STRUCTURAL JOINTS USING ASTM A325 BOLTS", TURN OF THE NUT METHOD.
 10. SHOP CONNECTIONS MAY BE WELDED OR HIGH STRENGTH BOLTED. ALL BOLTS SHALL BE 3/4" DIAMETER MIN. ALL CONNECTIONS SHALL CONFORM TO THE TYPICAL CONNECTION DETAILS SHOWN ON THE PLANS UNLESS SPECIFICALLY APPROVED BY THE ENGINEER.
 11. ALL FIELD CONNECTIONS SHALL BE WELDED WITH HIGH STRENGTH BOLTS, SLIP-CRITICAL (FRICTION) TYPE.
 12. ALL WELDING SHALL CONFORM TO THE AMERICAN WELDING SOCIETY (AWS) D1.1 FOR ARC AND GAS WELDING IN BUILDING CONSTRUCTION.
 13. STEEL CONTRACTOR SHALL PROVIDE STEEL FRAMING AS SHOWN IN TYPICAL DETAILS FOR ALL ROOF OPENINGS OR SLUMP PAN OPENINGS OR CUTS.
 14. CUTS, HOLES, CORNERS, ETC. REQUIRED IN STRUCTURAL STEEL MEMBERS FOR THE WORK OF OTHER TRADES SHALL BE SHOWN IN THE STRUCTURAL STEEL SHOP DRAWINGS AND SHALL BE MADE IN THE SHOP. HOLES SHALL BE REINFORCED AS REQUIRED BY THE ENGINEER.
 15. BURNING OF HOLES, CUTS, ETC. IN STRUCTURAL STEEL MEMBERS IN THE FIELD WILL NOT BE PERMITTED, EXCEPT WITH THE SPECIFIC APPROVAL OF THE ENGINEER.
 16. UNLESS OTHERWISE NOTED, METAL DECK WOULD NOT OTHERWISE BE SUPPORTED, PROVIDED 3 X 3 X 1/4" THICK MINIMUM BENT PLATES OR ANGLES FOR METAL DECK SUPPORTS (MAY BE FIELD WELDED).
 17. ALL STEEL MEMBERS EXPOSED TO WEATHER (SUCH AS LANTERS, DOOR JAMBES, CANOPIES, ETC.) SHALL BE GALVANIZED.
 18. FOR MISCELLANEOUS STEEL SEE ARCHITECTURAL DRAWINGS.
 19. PROVIDE HOLES FOR WOOD BLAGS AS SHOWN ON DRAWINGS.
 20. ANY STEEL MEMBERS REQUIRED BY THE ELECTRICAL OR MECHANICAL TRADES FOR THE SUPPORT OF THEIR EQUIPMENT, WHICH ARE NOT SHOWN ON ARCHITECTURAL OR STRUCTURAL DRAWINGS, SHALL BE PROVIDED BY THE TRADE REQUIRING SUCH SUPPORT.
 21. ALL STEEL TUBES AND PIPE COLUMNS SHALL HAVE 1/4" THICK MIN. CLOSURE PLATES AND 1/4" DIA. HEEP HOLE @ LOWEST POINT.
 22. SEE SPECIFICATIONS FOR PAINTING OF STRUCTURAL STEEL. ALL FABRICATION AND ERECTION MARKS SHALL BE COVERED DURING FIELD TOUCH-UP PAINTING.

- STRUCTURAL STEEL:**
1. ALL STRUCTURAL STEEL WORK SHALL BE FABRICATED AND ERECTED IN ACCORDANCE WITH THE LATEST A.I.S.C. SPECIFICATIONS.
 2. ALL STRUCTURAL STEEL SHALL BE NEW, CLEAN AND STRAIGHT, AND SHALL CONFORM TO ASTM SPECIFICATIONS A572, F_y = 50/60 KSI, EXCEPT AS NOTED. ALL STEEL TUBES SHALL CONFORM TO ASTM A500, GRADE "B", NOTED BY 48 KSI. PLATES AND OTHER SHAPES SHALL CONFORM TO ASTM A36, F_y = 36 KSI.
 3. ALL HIGH STRENGTH BOLTS SHALL CONFORM TO ASTM SPECIFICATION A325. ALL BOLTS SHALL BE PROVIDED WITH HARDENED WASHERS UNDER THE TURNED ELEMENT (NUT OR BOLT HEAD).
 4. INSTALLATION AND TIGHTENING OF ALL HIGH STRENGTH BOLTS SHALL CONFORM TO THE "SPECIFICATION FOR STRUCTURAL JOINTS USING ASTM A325 BOLTS", TURN OF THE NUT METHOD.
 5. SHOP CONNECTIONS MAY BE WELDED OR HIGH STRENGTH BOLTED. ALL BOLTS SHALL BE 3/4" DIAMETER MIN. ALL CONNECTIONS SHALL CONFORM TO THE TYPICAL CONNECTION DETAILS SHOWN ON THE PLANS UNLESS SPECIFICALLY APPROVED BY THE ENGINEER.
 6. ALL FIELD CONNECTIONS SHALL BE WELDED WITH HIGH STRENGTH BOLTS, SLIP-CRITICAL (FRICTION) TYPE.
 7. ALL WELDING SHALL CONFORM TO THE AMERICAN WELDING SOCIETY (AWS) D1.1 FOR ARC AND GAS WELDING IN BUILDING CONSTRUCTION.
 8. STEEL CONTRACTOR SHALL PROVIDE STEEL FRAMING AS SHOWN IN TYPICAL DETAILS FOR ALL ROOF OPENINGS OR SLUMP PAN OPENINGS OR CUTS.
 9. CUTS, HOLES, CORNERS, ETC. REQUIRED IN STRUCTURAL STEEL MEMBERS FOR THE WORK OF OTHER TRADES SHALL BE SHOWN IN THE STRUCTURAL STEEL SHOP DRAWINGS AND SHALL BE MADE IN THE SHOP. HOLES SHALL BE REINFORCED AS REQUIRED BY THE ENGINEER.
 10. BURNING OF HOLES, CUTS, ETC. IN STRUCTURAL STEEL MEMBERS IN THE FIELD WILL NOT BE PERMITTED, EXCEPT WITH THE SPECIFIC APPROVAL OF THE ENGINEER.
 11. UNLESS OTHERWISE NOTED, METAL DECK WOULD NOT OTHERWISE BE SUPPORTED, PROVIDED 3 X 3 X 1/4" THICK MINIMUM BENT PLATES OR ANGLES FOR METAL DECK SUPPORTS (MAY BE FIELD WELDED).
 12. ALL STEEL MEMBERS EXPOSED TO WEATHER (SUCH AS LANTERS, DOOR JAMBES, CANOPIES, ETC.) SHALL BE GALVANIZED.
 13. FOR MISCELLANEOUS STEEL SEE ARCHITECTURAL DRAWINGS.
 14. PROVIDE HOLES FOR WOOD BLAGS AS SHOWN ON DRAWINGS.
 15. ANY STEEL MEMBERS REQUIRED BY THE ELECTRICAL OR MECHANICAL TRADES FOR THE SUPPORT OF THEIR EQUIPMENT, WHICH ARE NOT SHOWN ON ARCHITECTURAL OR STRUCTURAL DRAWINGS, SHALL BE PROVIDED BY THE TRADE REQUIRING SUCH SUPPORT.
 16. ALL STEEL TUBES AND PIPE COLUMNS SHALL HAVE 1/4" THICK MIN. CLOSURE PLATES AND 1/4" DIA. HEEP HOLE @ LOWEST POINT.
 17. SEE SPECIFICATIONS FOR PAINTING OF STRUCTURAL STEEL. ALL FABRICATION AND ERECTION MARKS SHALL BE COVERED DURING FIELD TOUCH-UP PAINTING.

- SHOP DRAWINGS:**
1. NO STRUCTURAL DRAWINGS SHALL BE REPRODUCED FOR USE AS SHOP DRAWINGS.
 2. ALL DIMENSIONAL COORDINATION SHALL BE DONE BY THE CONTRACTOR AND/OR HIS DETAILER.
 3. DETAILER SHALL CHECK ALL ARCHITECTURAL AND MECHANICAL DRAWINGS FOR ALL ATTACHMENTS, CLIPS, OPENINGS, OR DUOT WORK AFFECTING STRUCTURAL MEMBERS. ALL ITEMS SHALL BE SHOWN ON SHOP DRAWINGS.
 4. SHOP DRAWINGS SHALL BE SUBMITTED TO ALLOW SUFFICIENT TIME FOR PROCESSING.
 5. ALL SHOP DRAWINGS SHALL BE SUBMITTED ON TRANSPARENTS FOR DIRECT REPRODUCTION WITH TWO PRINTS ONLY. DISTRIBUTION AS PER ARCHITECT INSTRUCTIONS.
 6. PROVIDE SUFFICIENT SPACE ON SHOP DRAWINGS NEAR TITLE BOX (ABOUT 40 SQUARE INCHES) FOR STAMPS AND ENGINEERS COMMENTS.
 7. THE SHOP DRAWINGS SHALL BE CHECKED BY DETAILER, CHECKER AND CONTRACTOR PRIOR TO SUBMISSION.
 8. COMPLETED DETAILING PLANS SHALL BE SUBMITTED PRIOR TO OR IN CONJUNCTION WITH DETAILING PLANS BUT IN NO CASE SHALL DETAIL DRAWINGS BE SUBMITTED PRIOR TO ERECTION PLANS.
 9. DETAILER SHALL SUBMIT AN INDEX OF THE DETAIL DRAWINGS WITH EACH SHOP DRAWING SUBMITTAL.
 10. SHOP DRAWINGS NOT COMPLYING WITH ALL THE ABOVE ITEMS SHALL BE RETURNED FOR CORRECTIONS WITHOUT PROCESSING.
 11. RESUBMITTED SHOP DRAWINGS SHALL HAVE THE FOLLOWING CHANGES INCORPORATED:
 - A. FIRST RESUBMISSION TO HAVE LETTER "A" ADDED TO DRAWING NUMBER AND ANY CHANGES MARKED ON THE DRAWING MARKED 1 AT EACH ITEM CHANGED. ALL ITEMS TO BE NOTED IN REVISION BOX.
 - B. SUBSEQUENT RESUBMISSION SHALL BEAR CHANGES "B" AND 2 AND 3 ETC. AS IN 11A.
 12. CONTRACTOR SHALL HAVE SHOP DRAWINGS WHICH HAVE BEEN SATISFACTORILY REVIEWED BY THE ARCHITECT AND/OR ENGINEER AND CONFIRMED BY THE CONTRACTOR BEFORE PROCEEDING WITH ANY WORK.
 13. DETAILER SHALL USE THE SAME COLUMN NUMBERS IN HIS DETAILS AS THOSE SHOWN ON CONTRACT DRAWINGS.

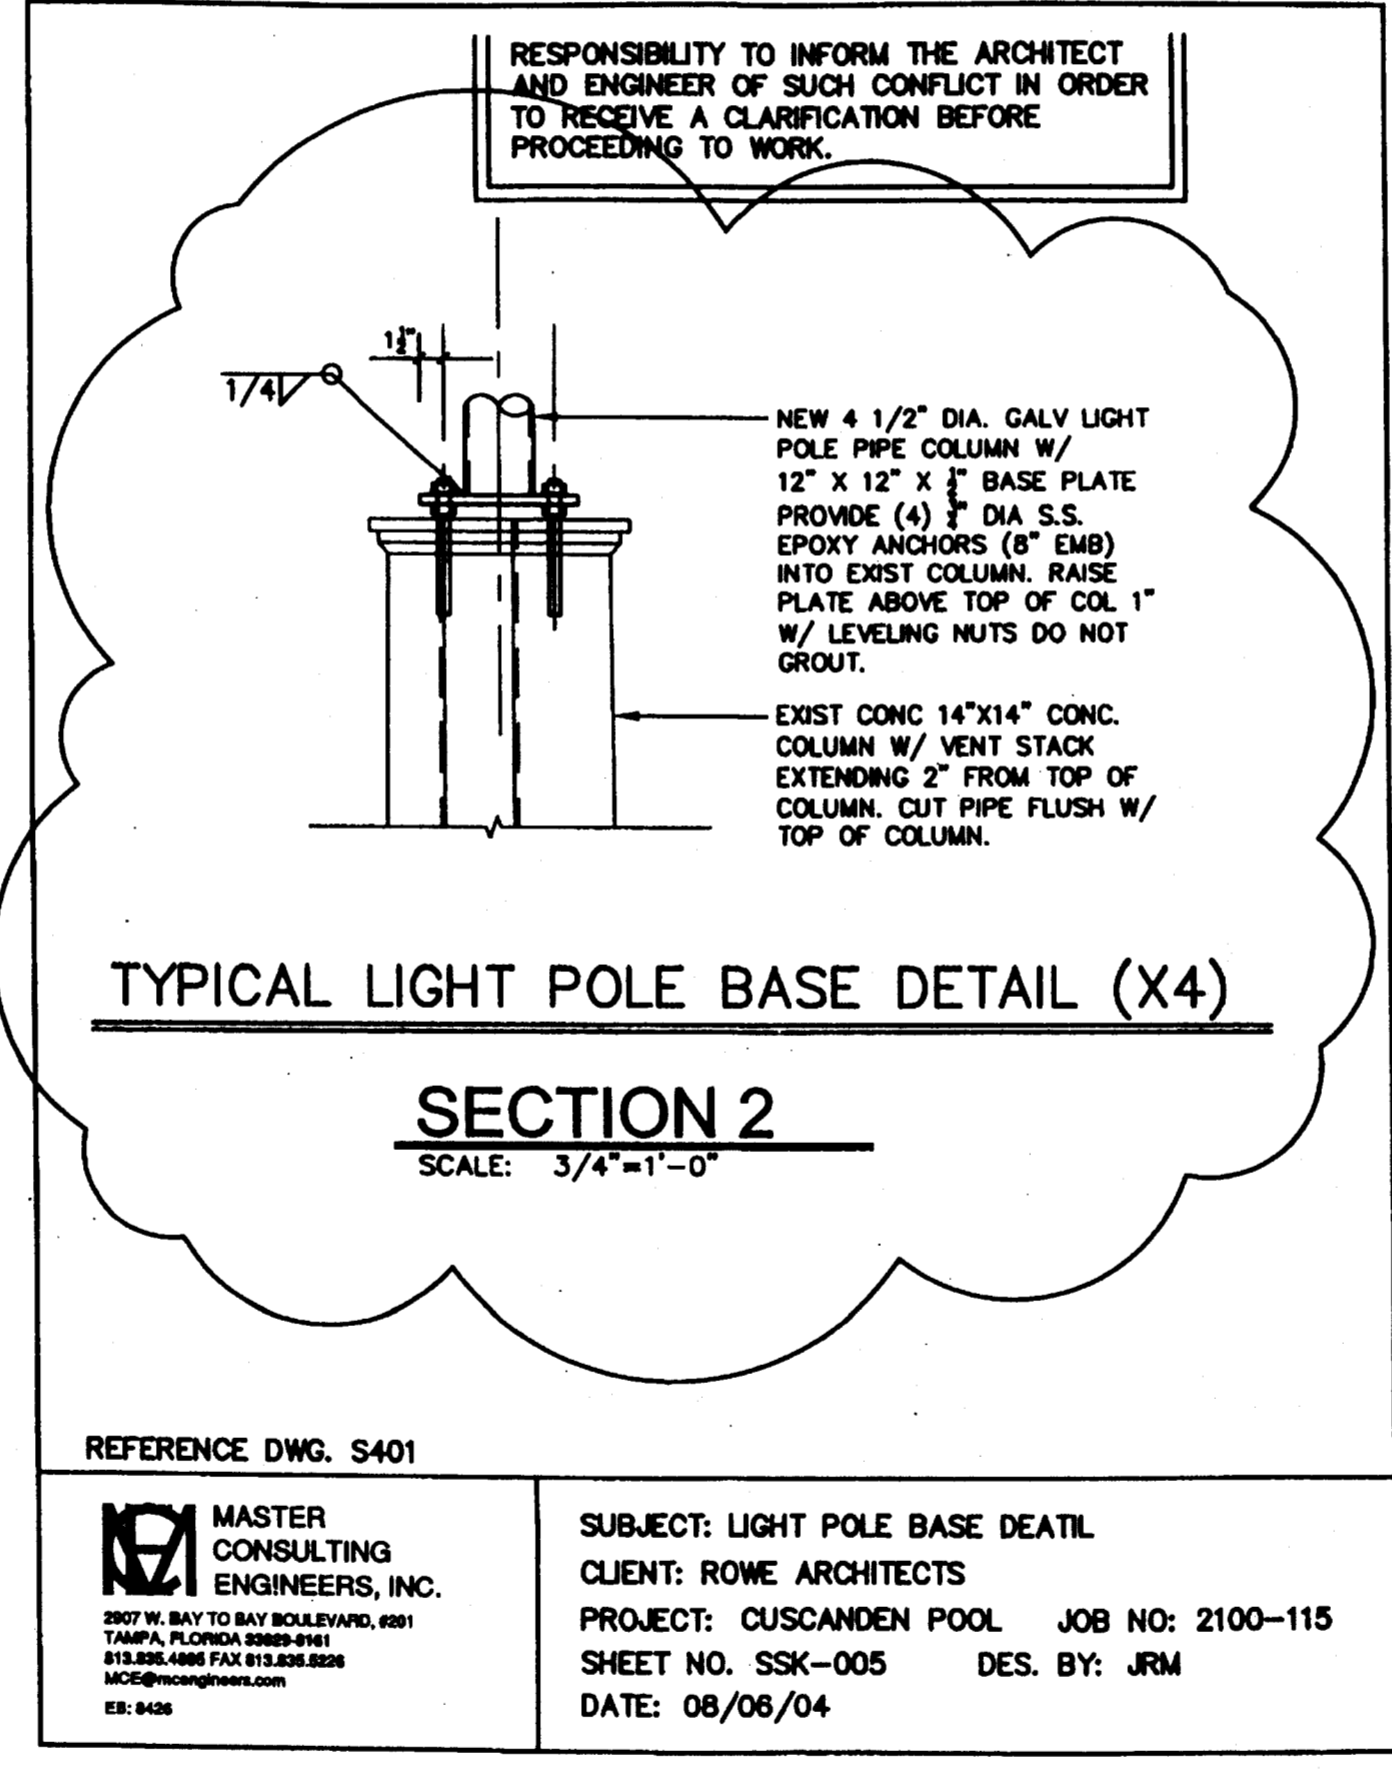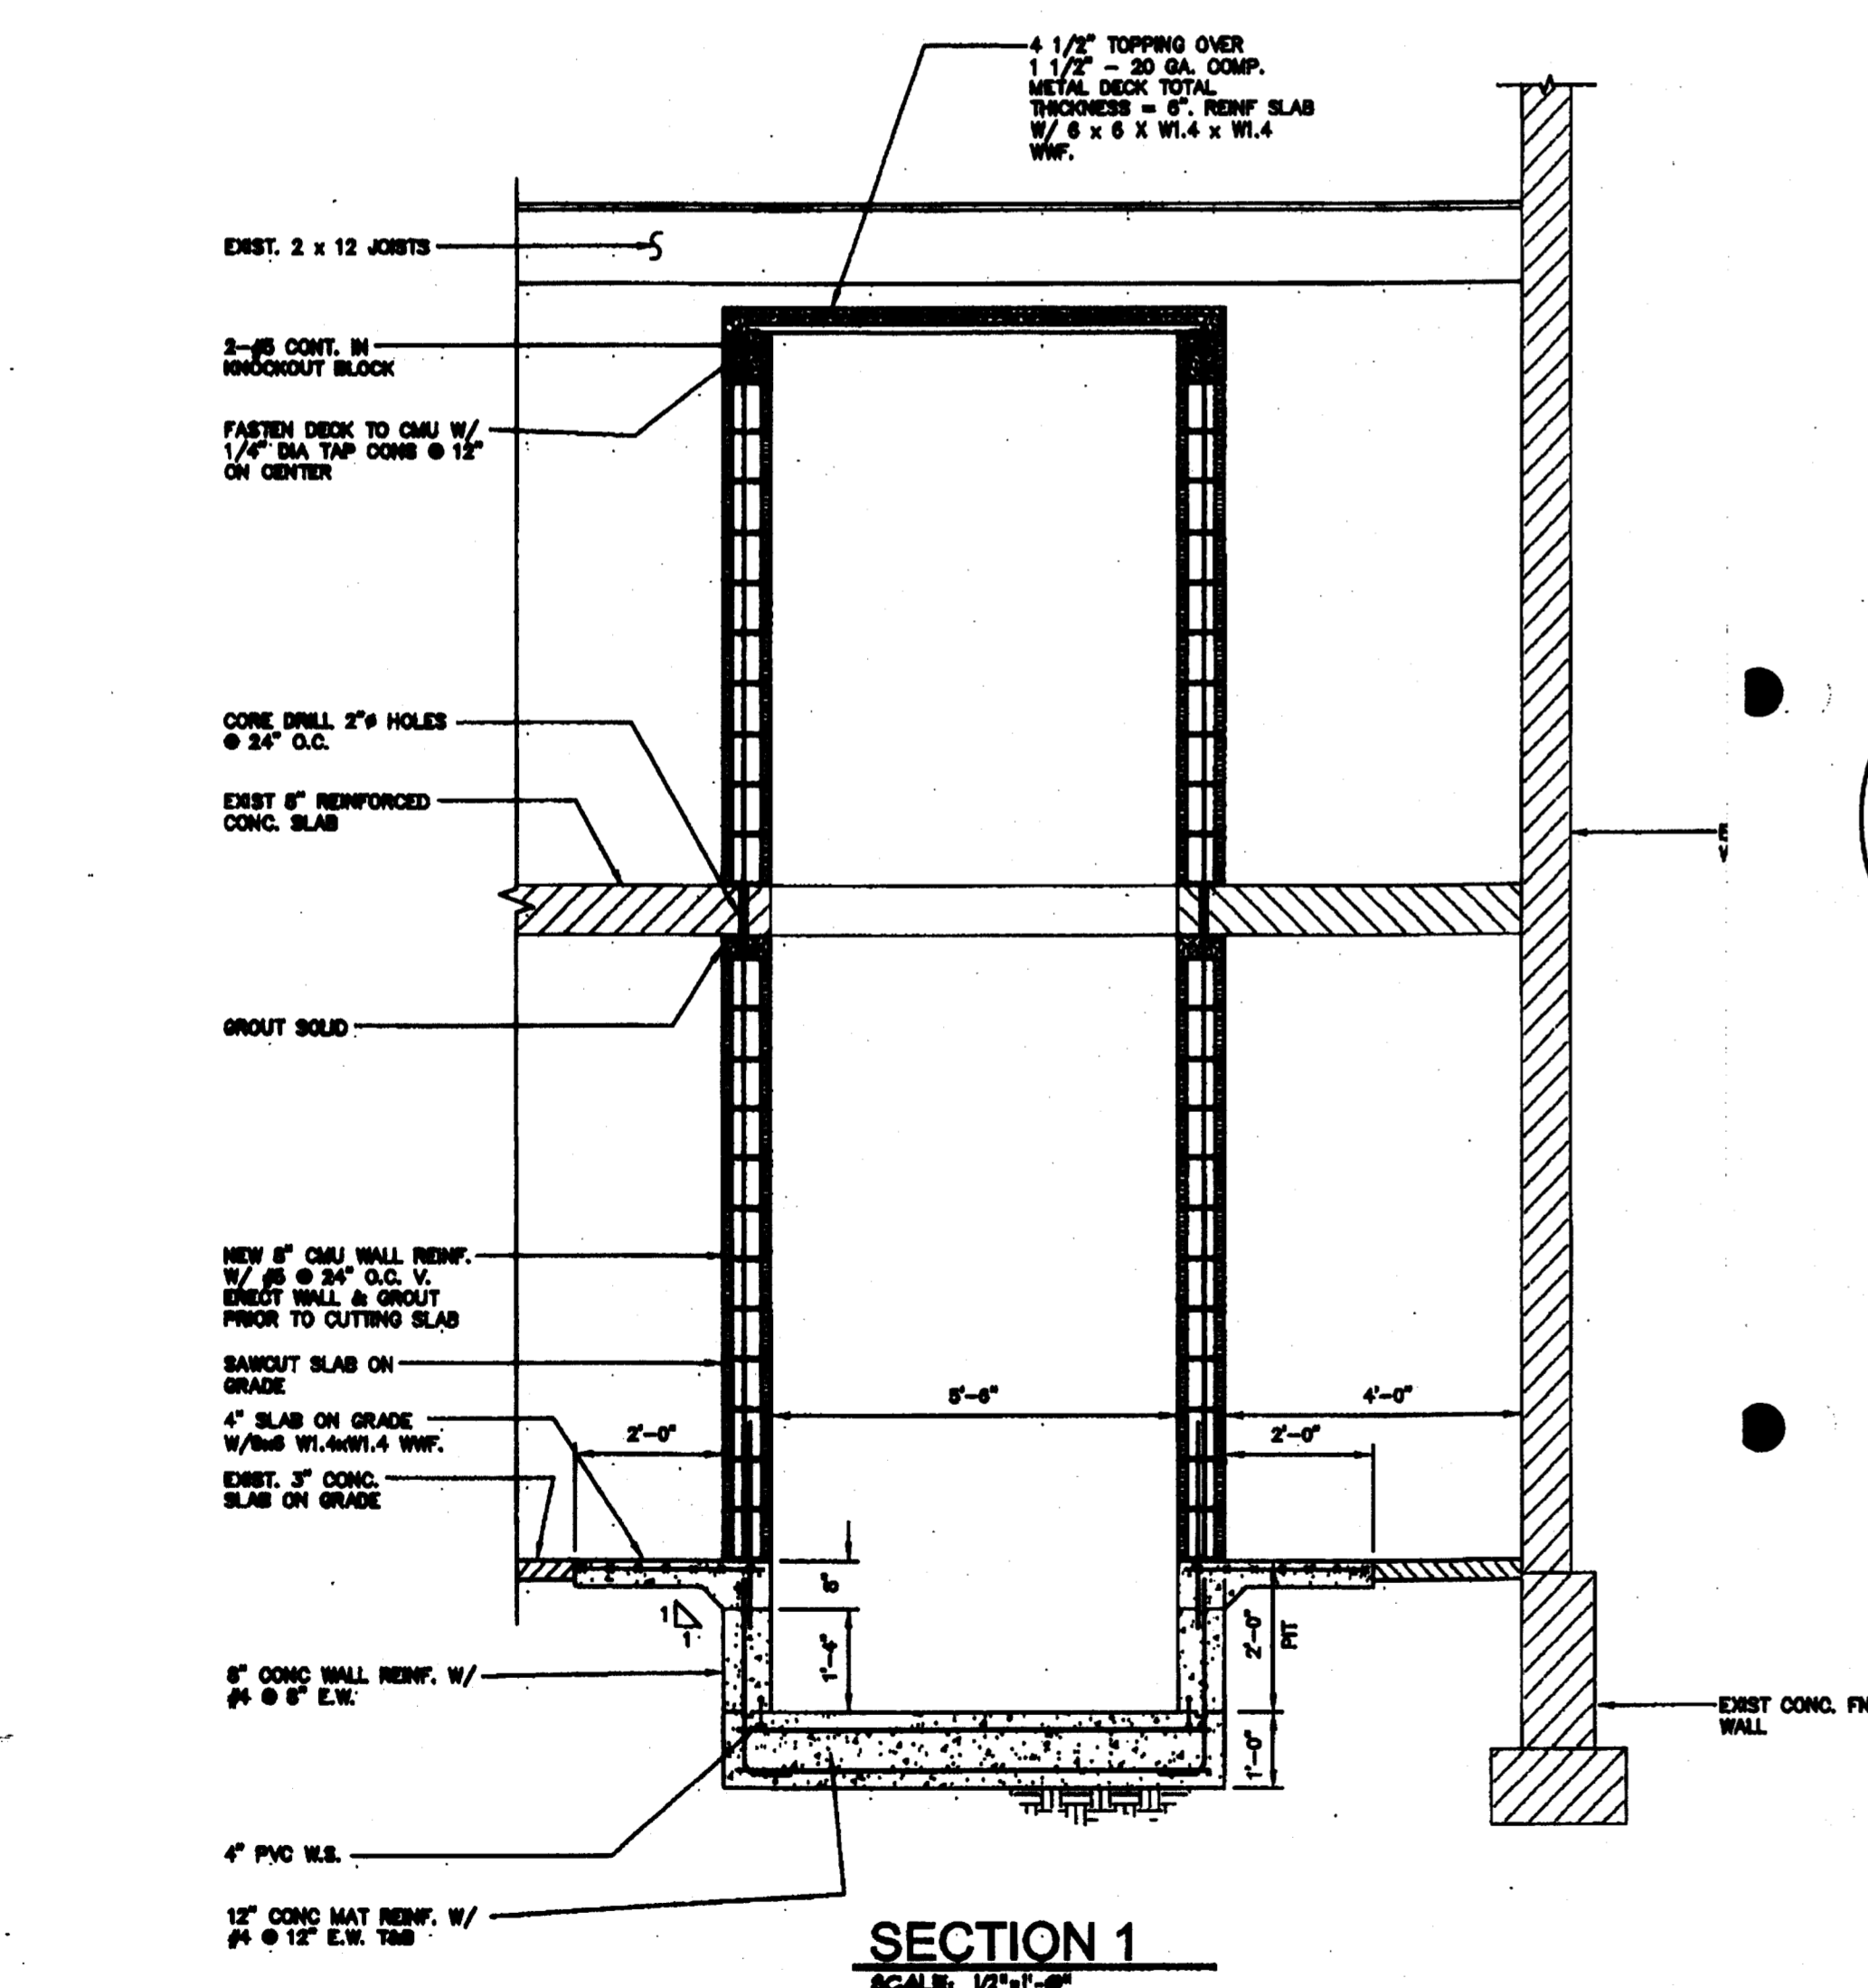

- RESPONSIBILITY TO INFORM THE ARCHITECT AND ENGINEER OF SUCH CONFLICT IN ORDER TO RECEIVE A CLARIFICATION BEFORE PROCEEDING TO WORK.**
- NOTE:**
- IN CASE OF CONFLICT BETWEEN INFORMATION SHOWN ON THIS DRAWING, SECTION DRAWINGS OR ARCHITECTURAL DRAWINGS, IT IS THE CONTRACTOR'S RESPONSIBILITY TO INFORM THE ARCHITECT AND ENGINEER OF SUCH CONFLICT IN ORDER TO RECEIVE A CLARIFICATION BEFORE PROCEEDING TO WORK.
- REFERENCE DWG. S401
- MASTER CONSULTING ENGINEERS, INC.**
2807 W. BAY TO BAY BOULEVARD, #201
TAMPA, FLORIDA 33609-6161
813.896.4888 FAX 813.896.8228
MOE@mcengr.com
EB: 8428
- SUBJECT: LIGHT POLE BASE DETAIL**
CLIENT: ROWE ARCHITECTS
PROJECT: CUSCADEN POOL JOB NO: 2100-115
SHEET NO. SSK-005 DES. BY: JRM
DATE: 08/06/04

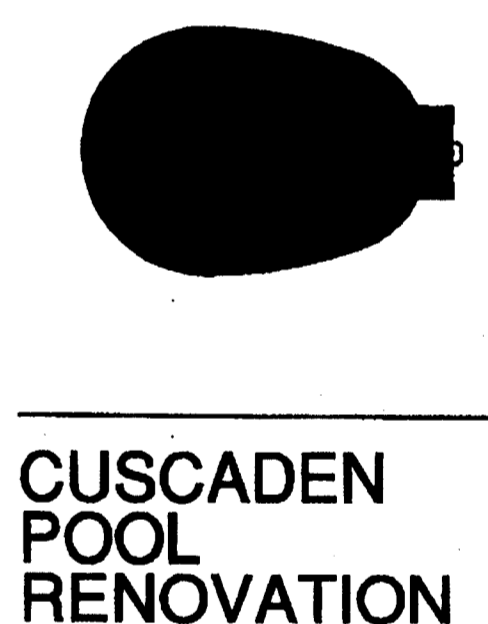

CUSCADEN POOL RENOVATION


CITY OF TAMPA
305 East Jackson Street
Tampa, Florida 33602

Project No. 0202.00

Distribution	Date
Bld Documents	02.02.04

TYPICAL DETAIL AND GENERAL NOTES SECTIONS

RECORD DWG.
DATE 8/26/05

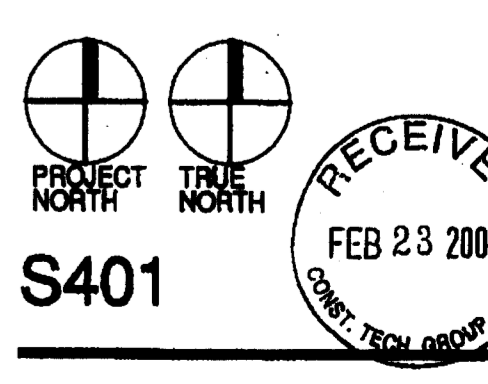

MASTER CONSULTING ENGINEERS, INC.
2807 W. BAY TO BAY BOULEVARD, #201
TAMPA, FLORIDA 33609-6161
813.896.4888 FAX 813.896.8228
MOE@mcengr.com
EB: 8428 PROJ. NO.

JAMES R. MEHLTRETTER, P.E.
FL. LIC. No. 33860

Signature _____ Date _____

CUSCADEN POOL RENOVATION


CITY OF TAMPA
 305 East Jackson Street
 Tampa, Florida 33602

Project No.	0202.00
Distribution	Date
Bid Documents	02.02.04

WALL ELEVATION/DETAIL
RECORD DWG.

DATE 8/20/05
 1/8" = 1'-0"
 0 4 8 16 FT

PROJECT NORTH RECEIVED
 FEB 23 2004
S501
 2/17/07

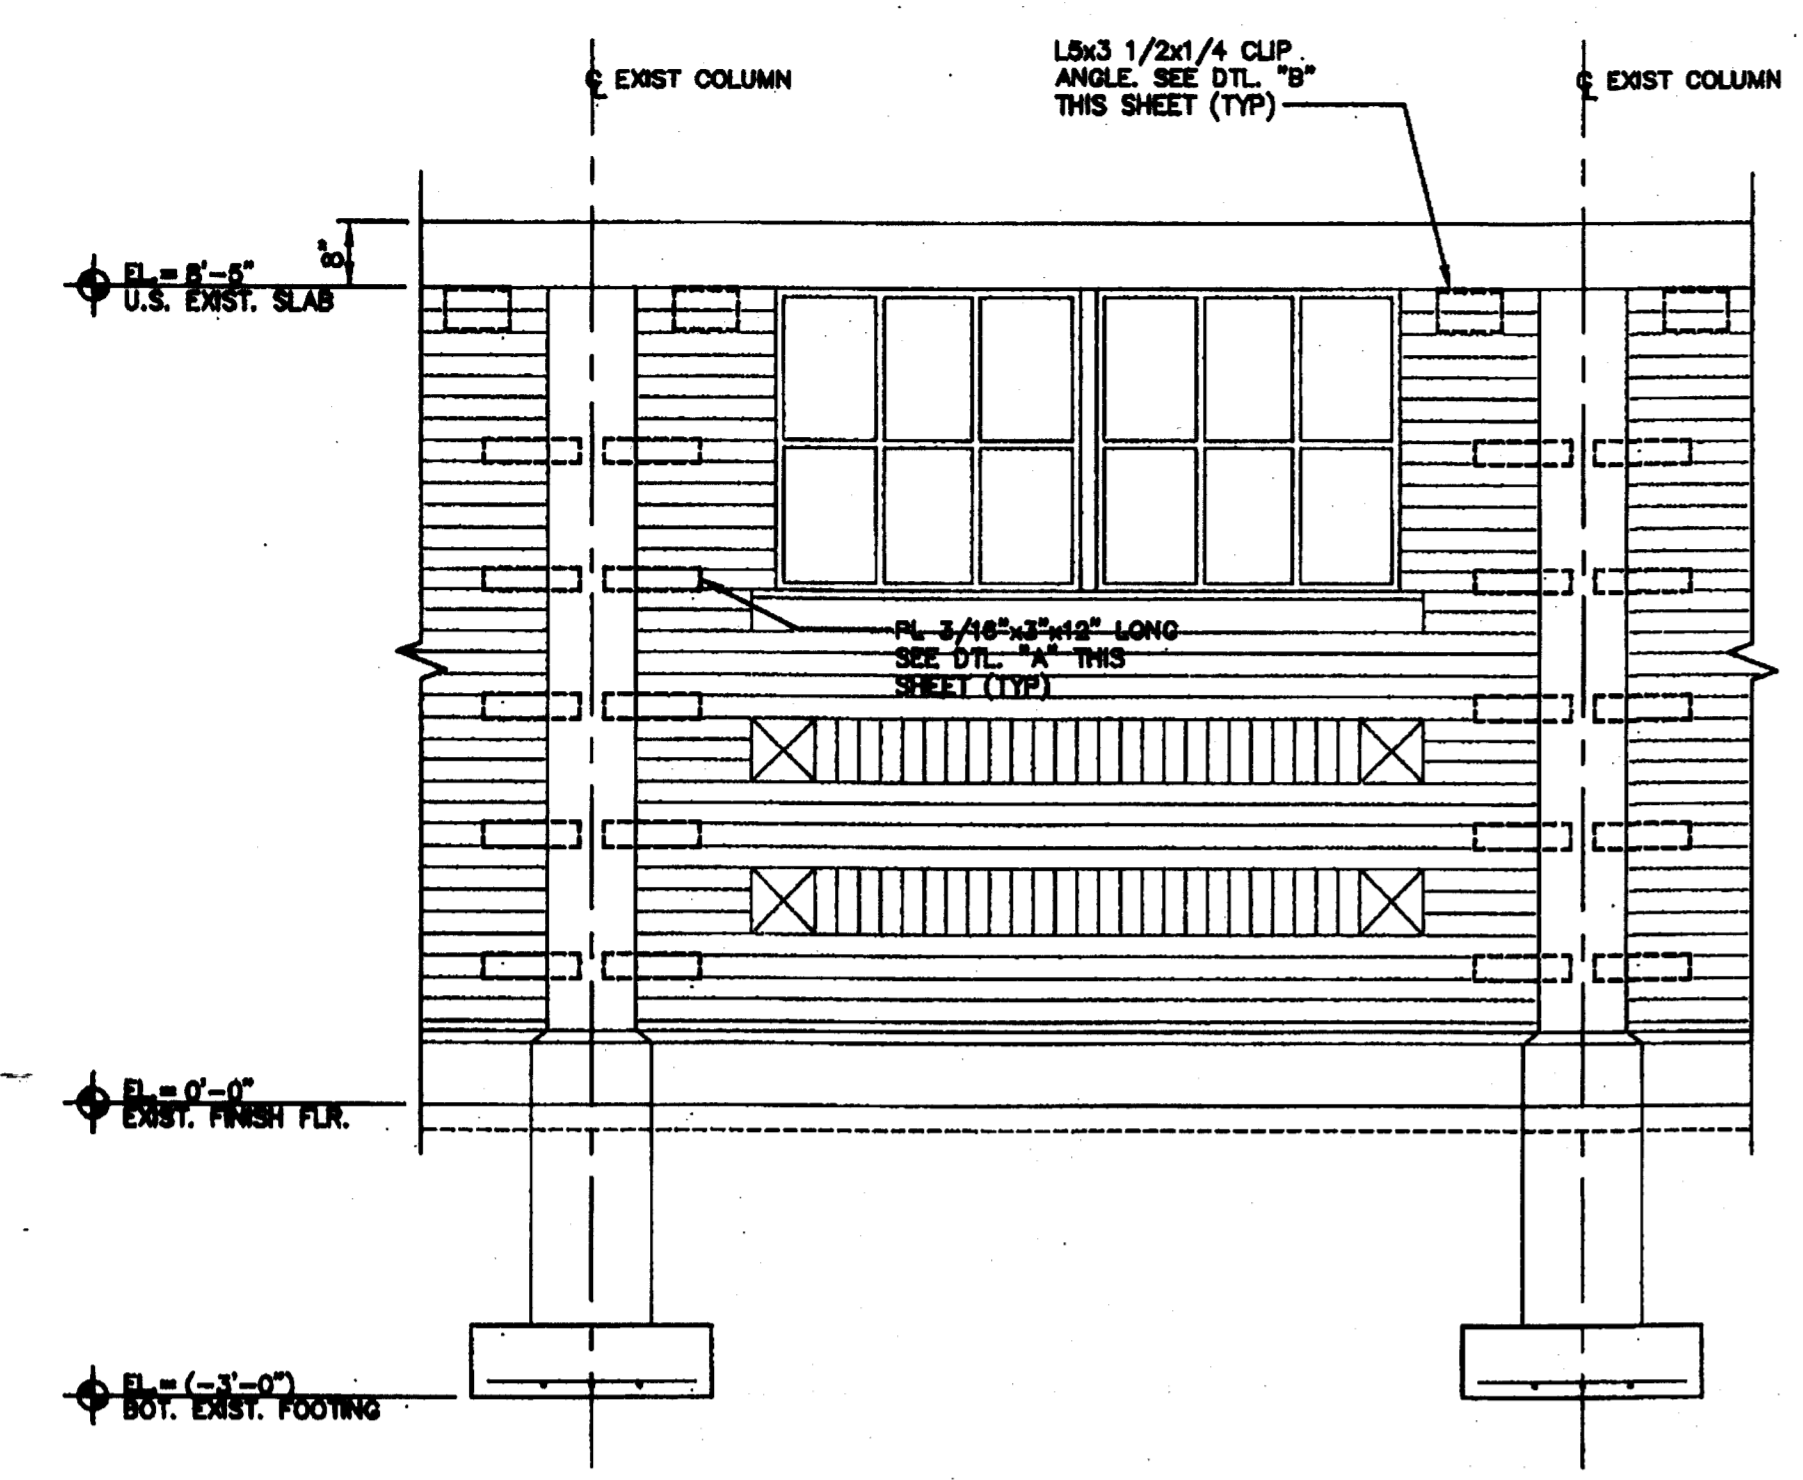

TYPICAL WALL REPAIR ELEVATION
WALL ELEVATION W1
 SCALE: 1/2"=1'-0" (OUTSIDE VIEW)



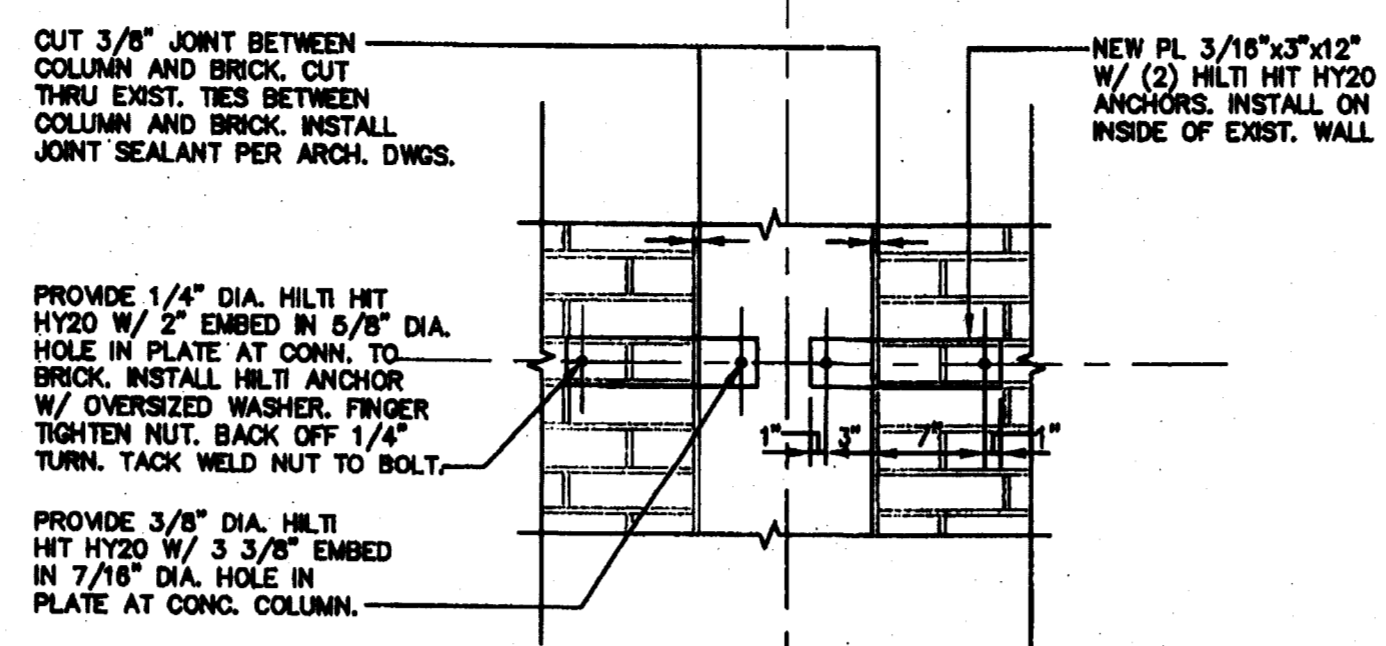


PLATE DETAIL "A"
 SCALE: 1"=1'-0" (INSIDE VIEW)

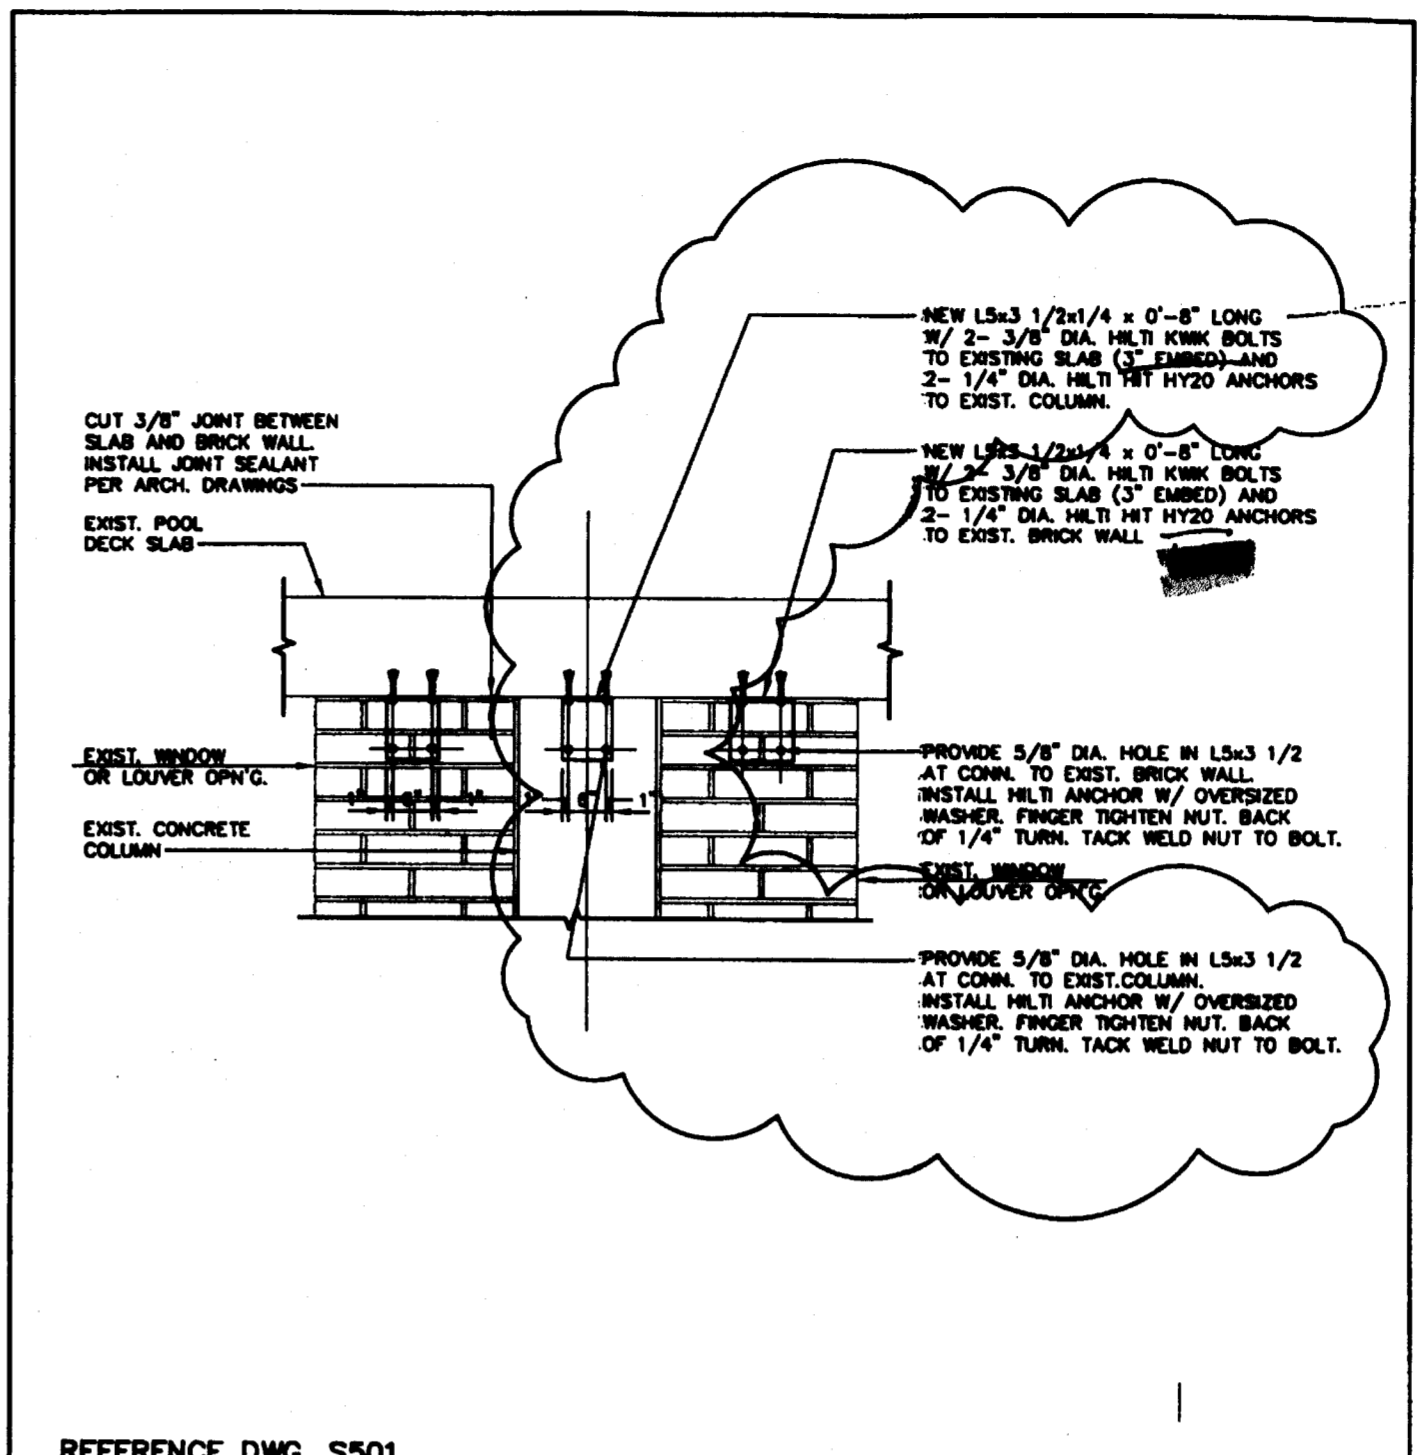


REFERENCE DWG. S501
MASTER CONSULTING ENGINEERS, INC.
 2907 W. BAY TO BAY BOULEVARD, #801
 TAMPA, FLORIDA 33609-8151
 813.836.4865 FAX 813.836.8226
 MCE@mcengineers.com
 EB: 8498


SUBJECT: ANGLE DETAIL W/ COLUMN CONNECTION
 CLIENT: ROME ARCHITECTS
 PROJECT: CUSCADEN POOL JOB NO: 2100-115
 SHEET NO. SSK-008 DES. BY: JRM
 DATE: 08.25.04

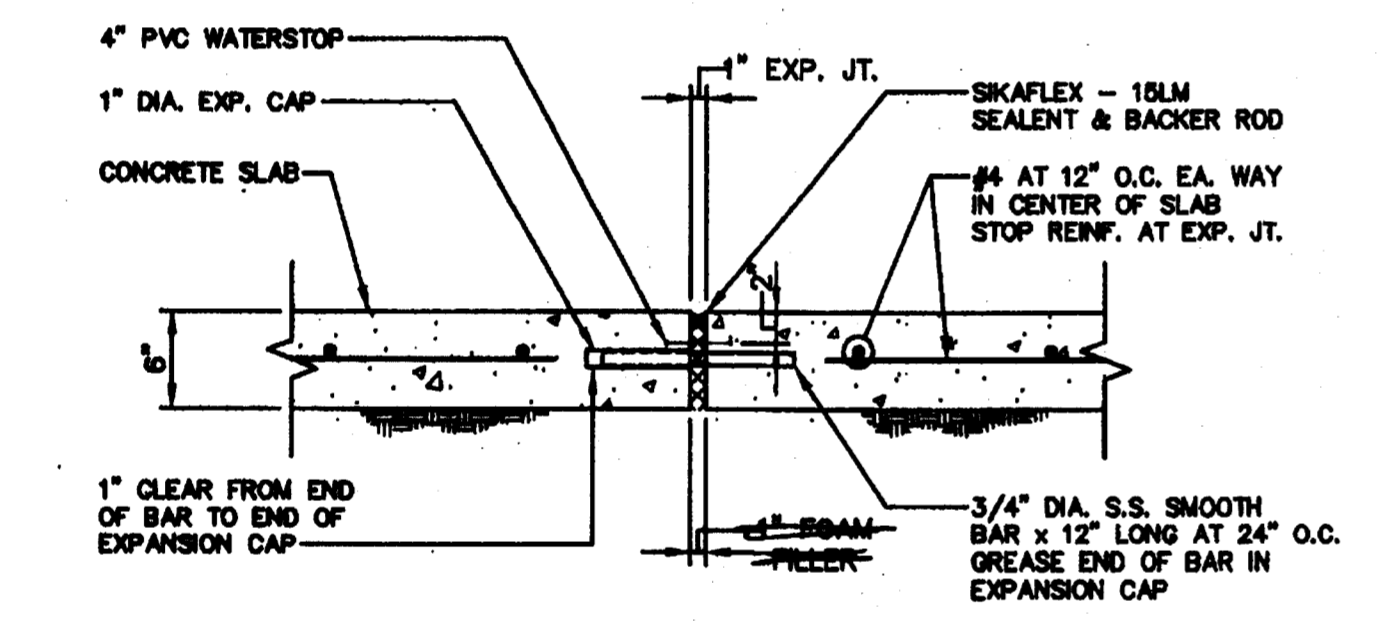


(SLAB EXP. JOINT DETAIL)
SECTION 1
 SCALE: 1"=1'-0"

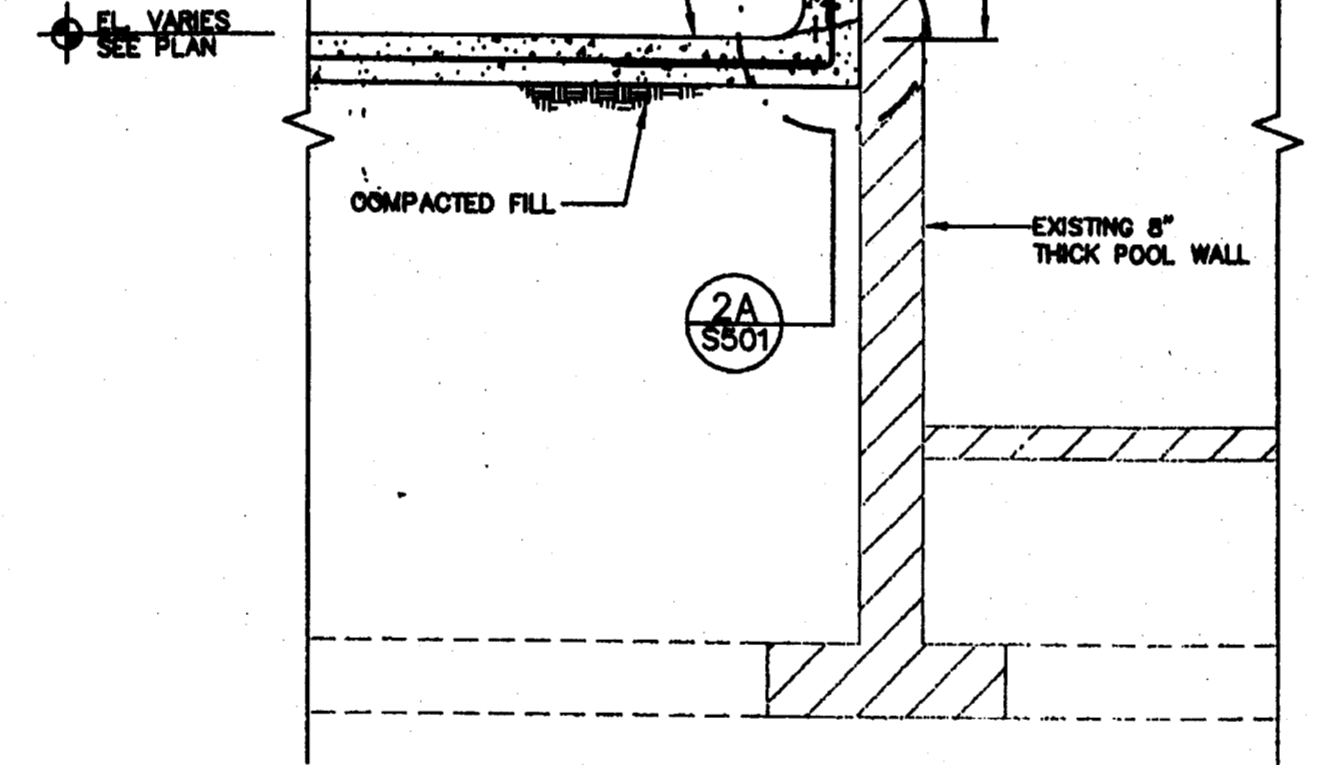


SECTION 2
 SCALE: 1/2"=1'-0"

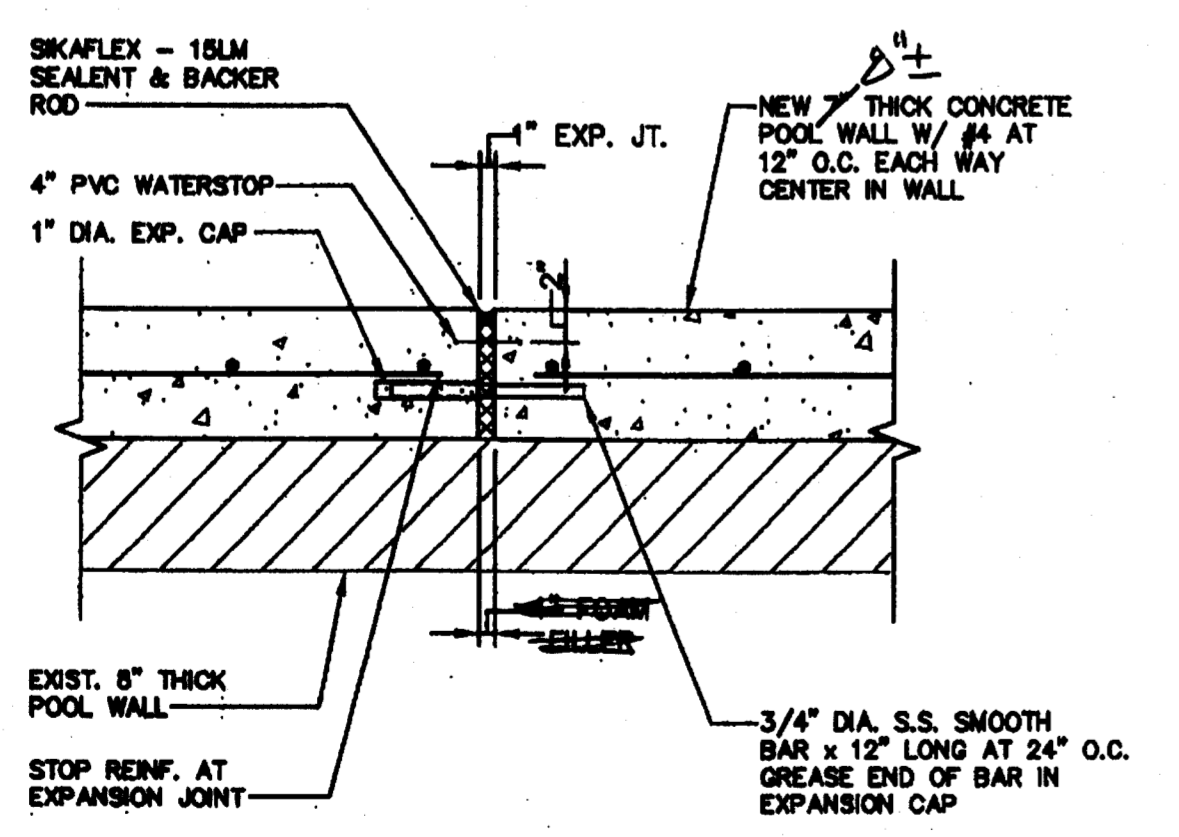



WALL EXP. JOINT DETAIL (PLAN)

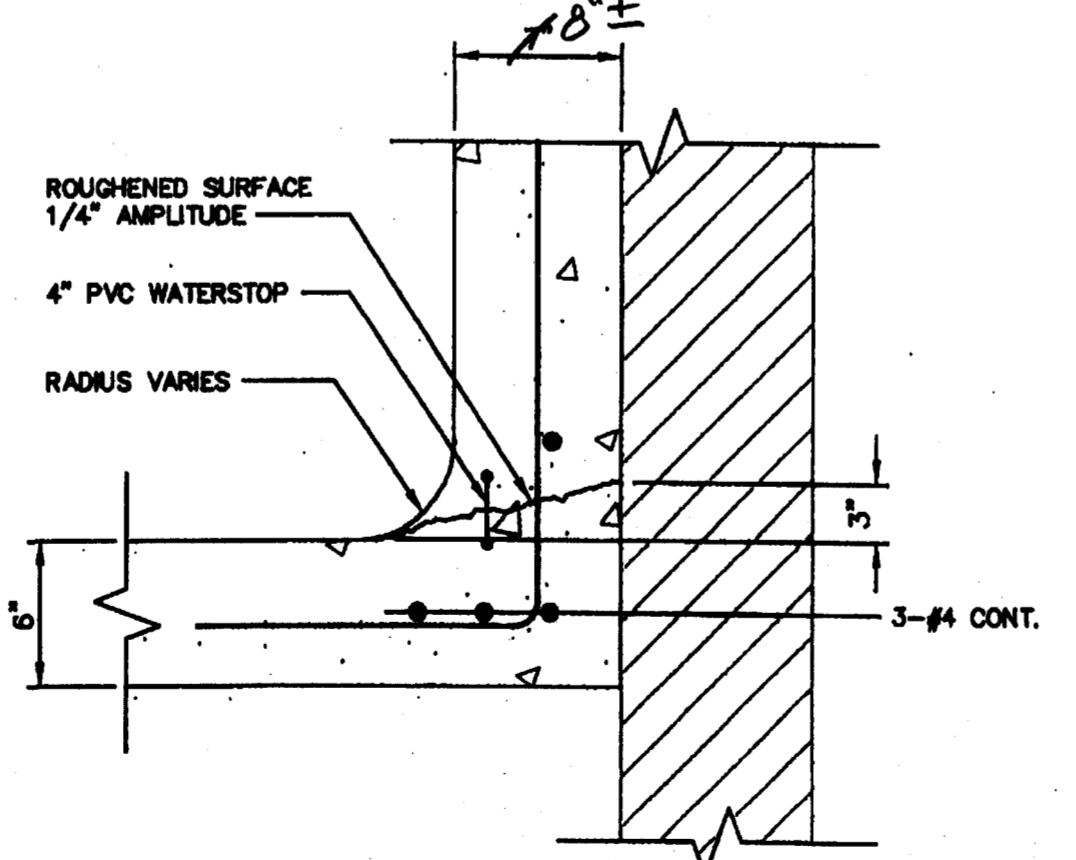

DETAIL 2A
 SCALE: 1 1/2"=1'-0"

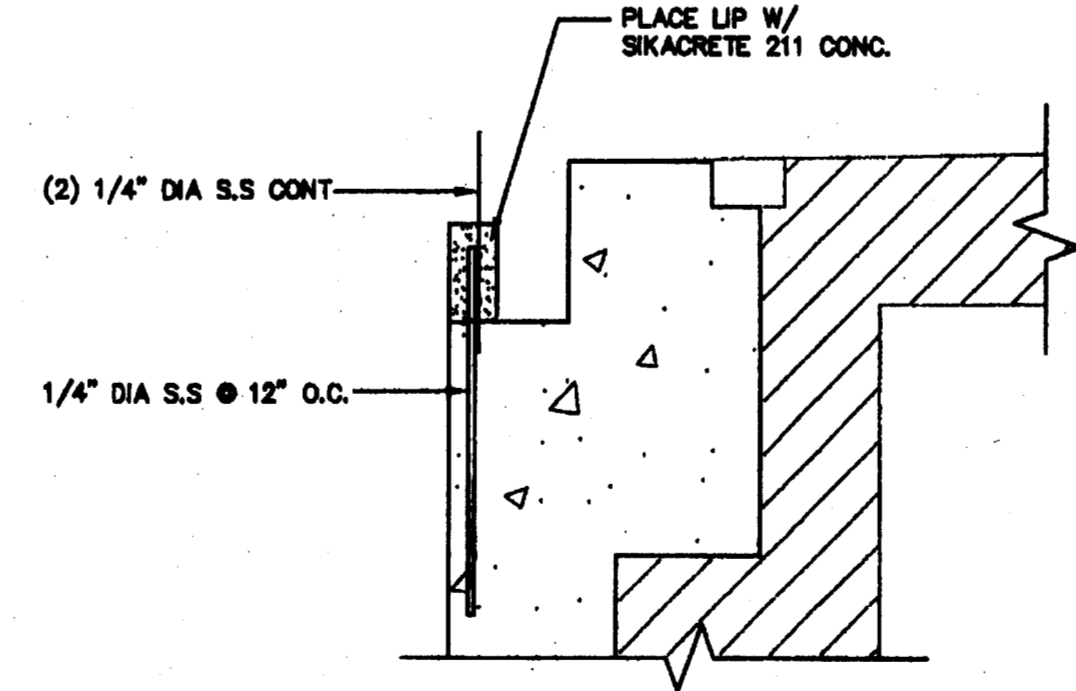


DETAIL 2B
 SCALE: 1 1/2"=1'-0"

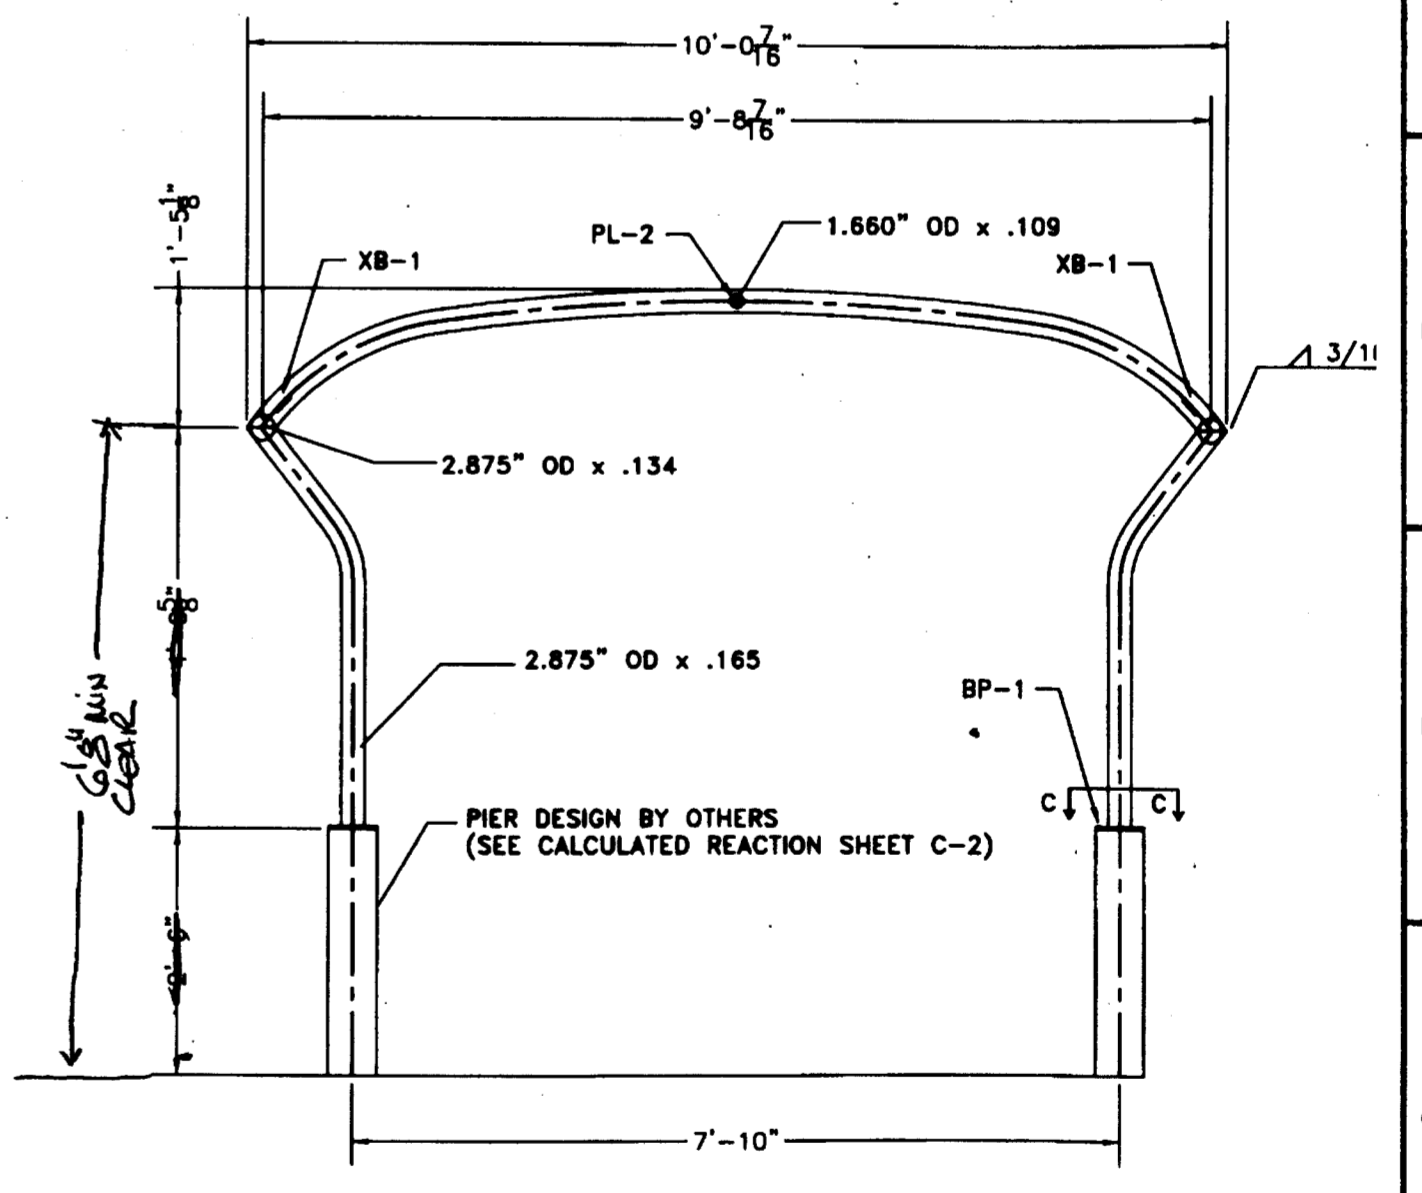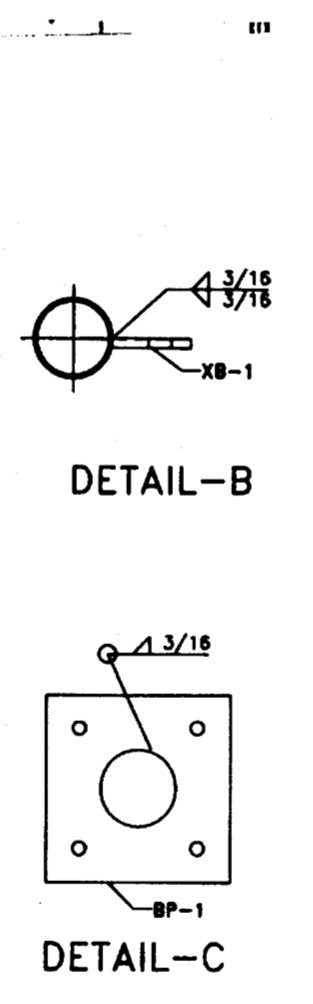

CS-1

JAMES R. MEHLTRETTER, P.E.
 FL. LIC. No. 33860
 Signature _____ Date _____

MASTER CONSULTING ENGINEERS, INC.
 2907 W. BAY TO BAY BOULEVARD, #801
 TAMPA, FLORIDA 33609-8151
 813.836.4865 FAX 813.836.8226
 MCE@mcengineers.com
 EB: 8498 PROJ. NO. _____

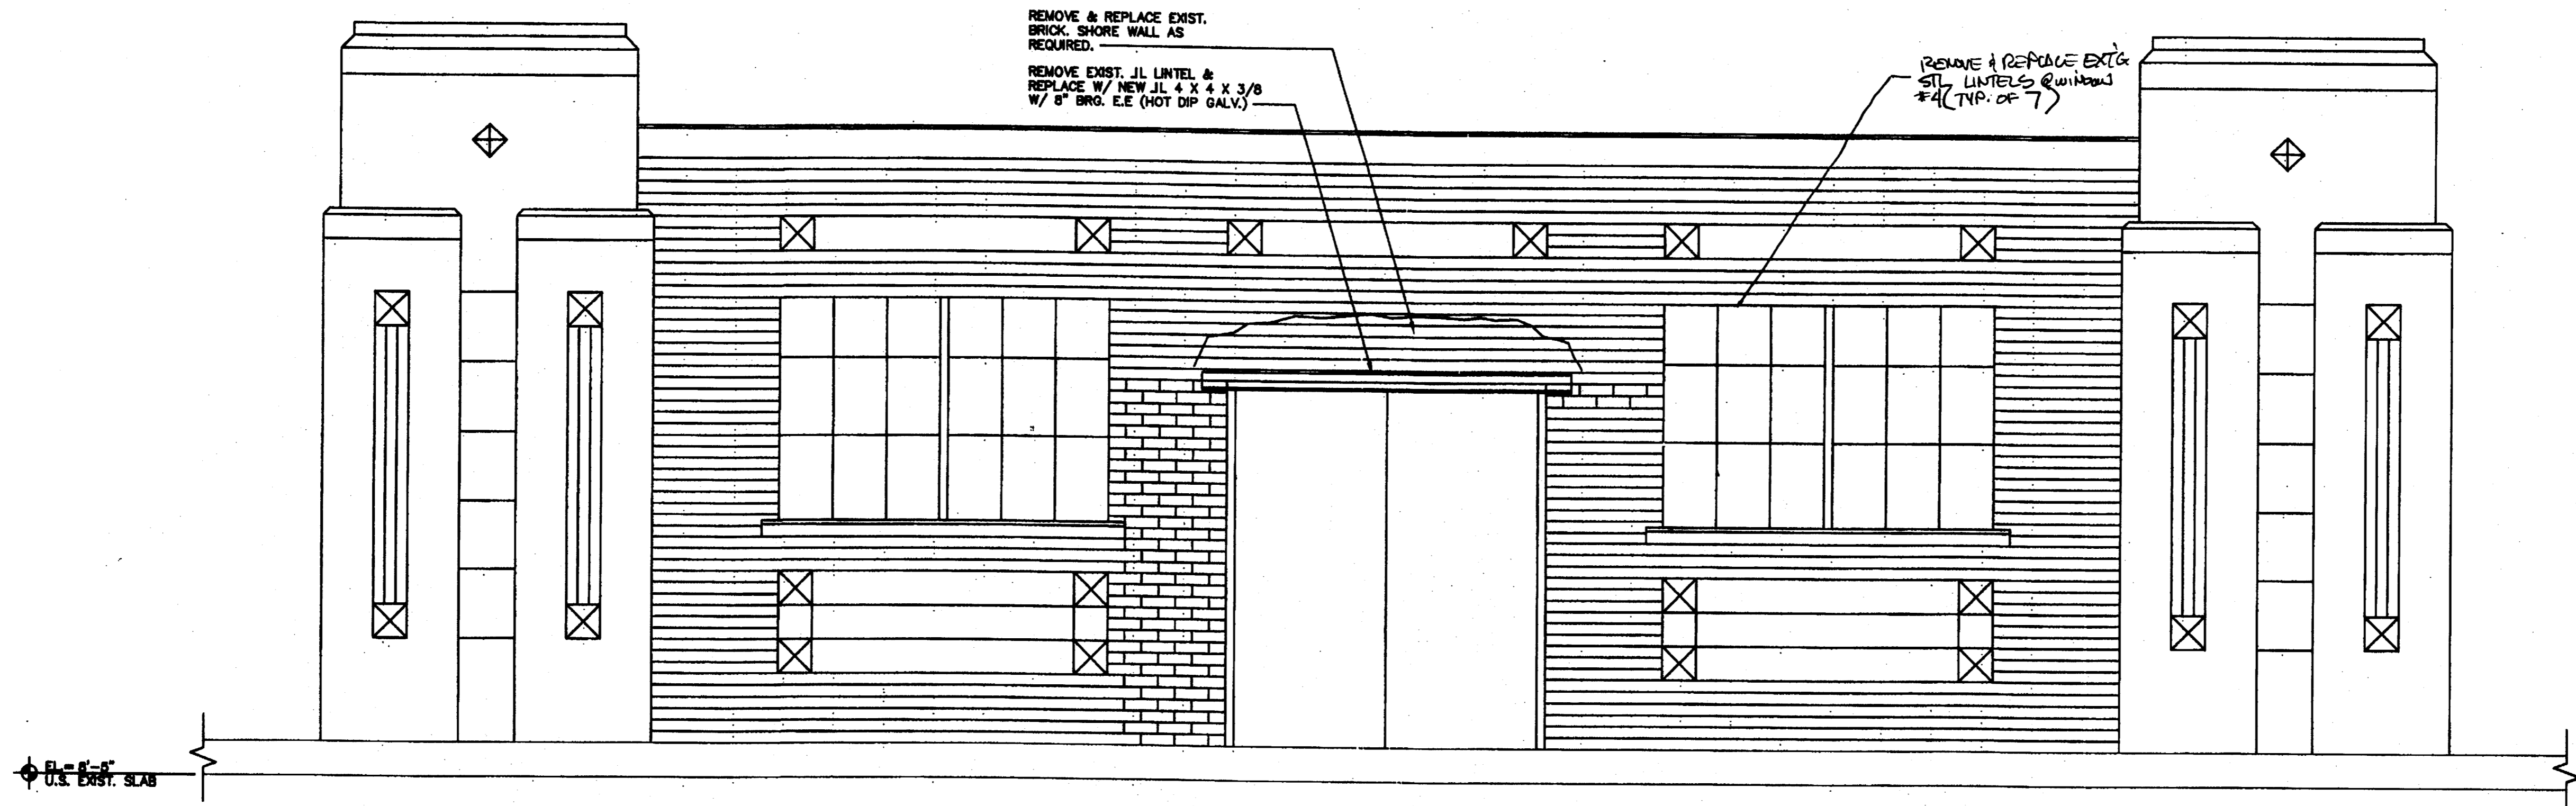

**EXISTING REAR
 WALL ELEVATION**
 SCALE: 1/2"=1'-0"

U.S. EXIST. SLAB

**CUSCADEN
 POOL
 RENOVATION**

CITY OF TAMPA
 306 East Jackson Street
 Tampa, Florida 33602

Project No.	0202.00
Distribution	Date
Bid Documents	02.02.04

WALL ELEVATION
RECORD DWG.
 DATE 02/26/05
 1/8" = 1'-0"
 0 4 8 16 FT

MASTER CONSULTING ENGINEERS, INC.
 JAMES R. MEHLTRETTER, P.E.
 FL. LIC. No. 33860
 2907 W. BAY TO BAY BOULEVARD, #201
 TAMPA, FLORIDA 33629-9161
 813.835.4865 FAX 813.835.5229
 MCE@moengh.com
 EB: 8428 PROJ. NO.

RECEIVED
 FEB 23 2004
 S502
 2/17 009

NO.	DATE	BY	REVISIONS

AS-BUILT SURVEY

CUSCADEN POOL RENOVATION



DRAWN BY:	TGD
PARTY CHIEF:	DLS
CHECKED BY:	BLA
SCALE:	DATE:
1"=20'	9/01/05
SEC-TWP-RNG	7-29S-19E
FIELDBOOK:	PAGE:
JOB NUMBER:	CUS5501.04
SHEET NUMBER:	1 OF 1

HCP 1 F.R. 172
 WITNESS CORNER LB 6113
 N: 5037.37
 E: 4543.86



HCP 2
 FOUND NAIL IN S/W
 N: 5044.55
 E: 4841.92

TIM A
 FOUND NAIL IN POLE
 ELEV: 48.85

TIM B
 FOUND NAIL IN POLE
 ELEV: 48.72

AVENIDA REPUBLICA DE CUBA
 (14th STREET)

NORTH 15th STREET

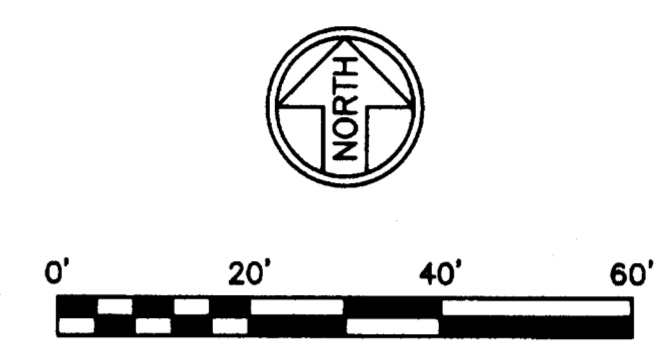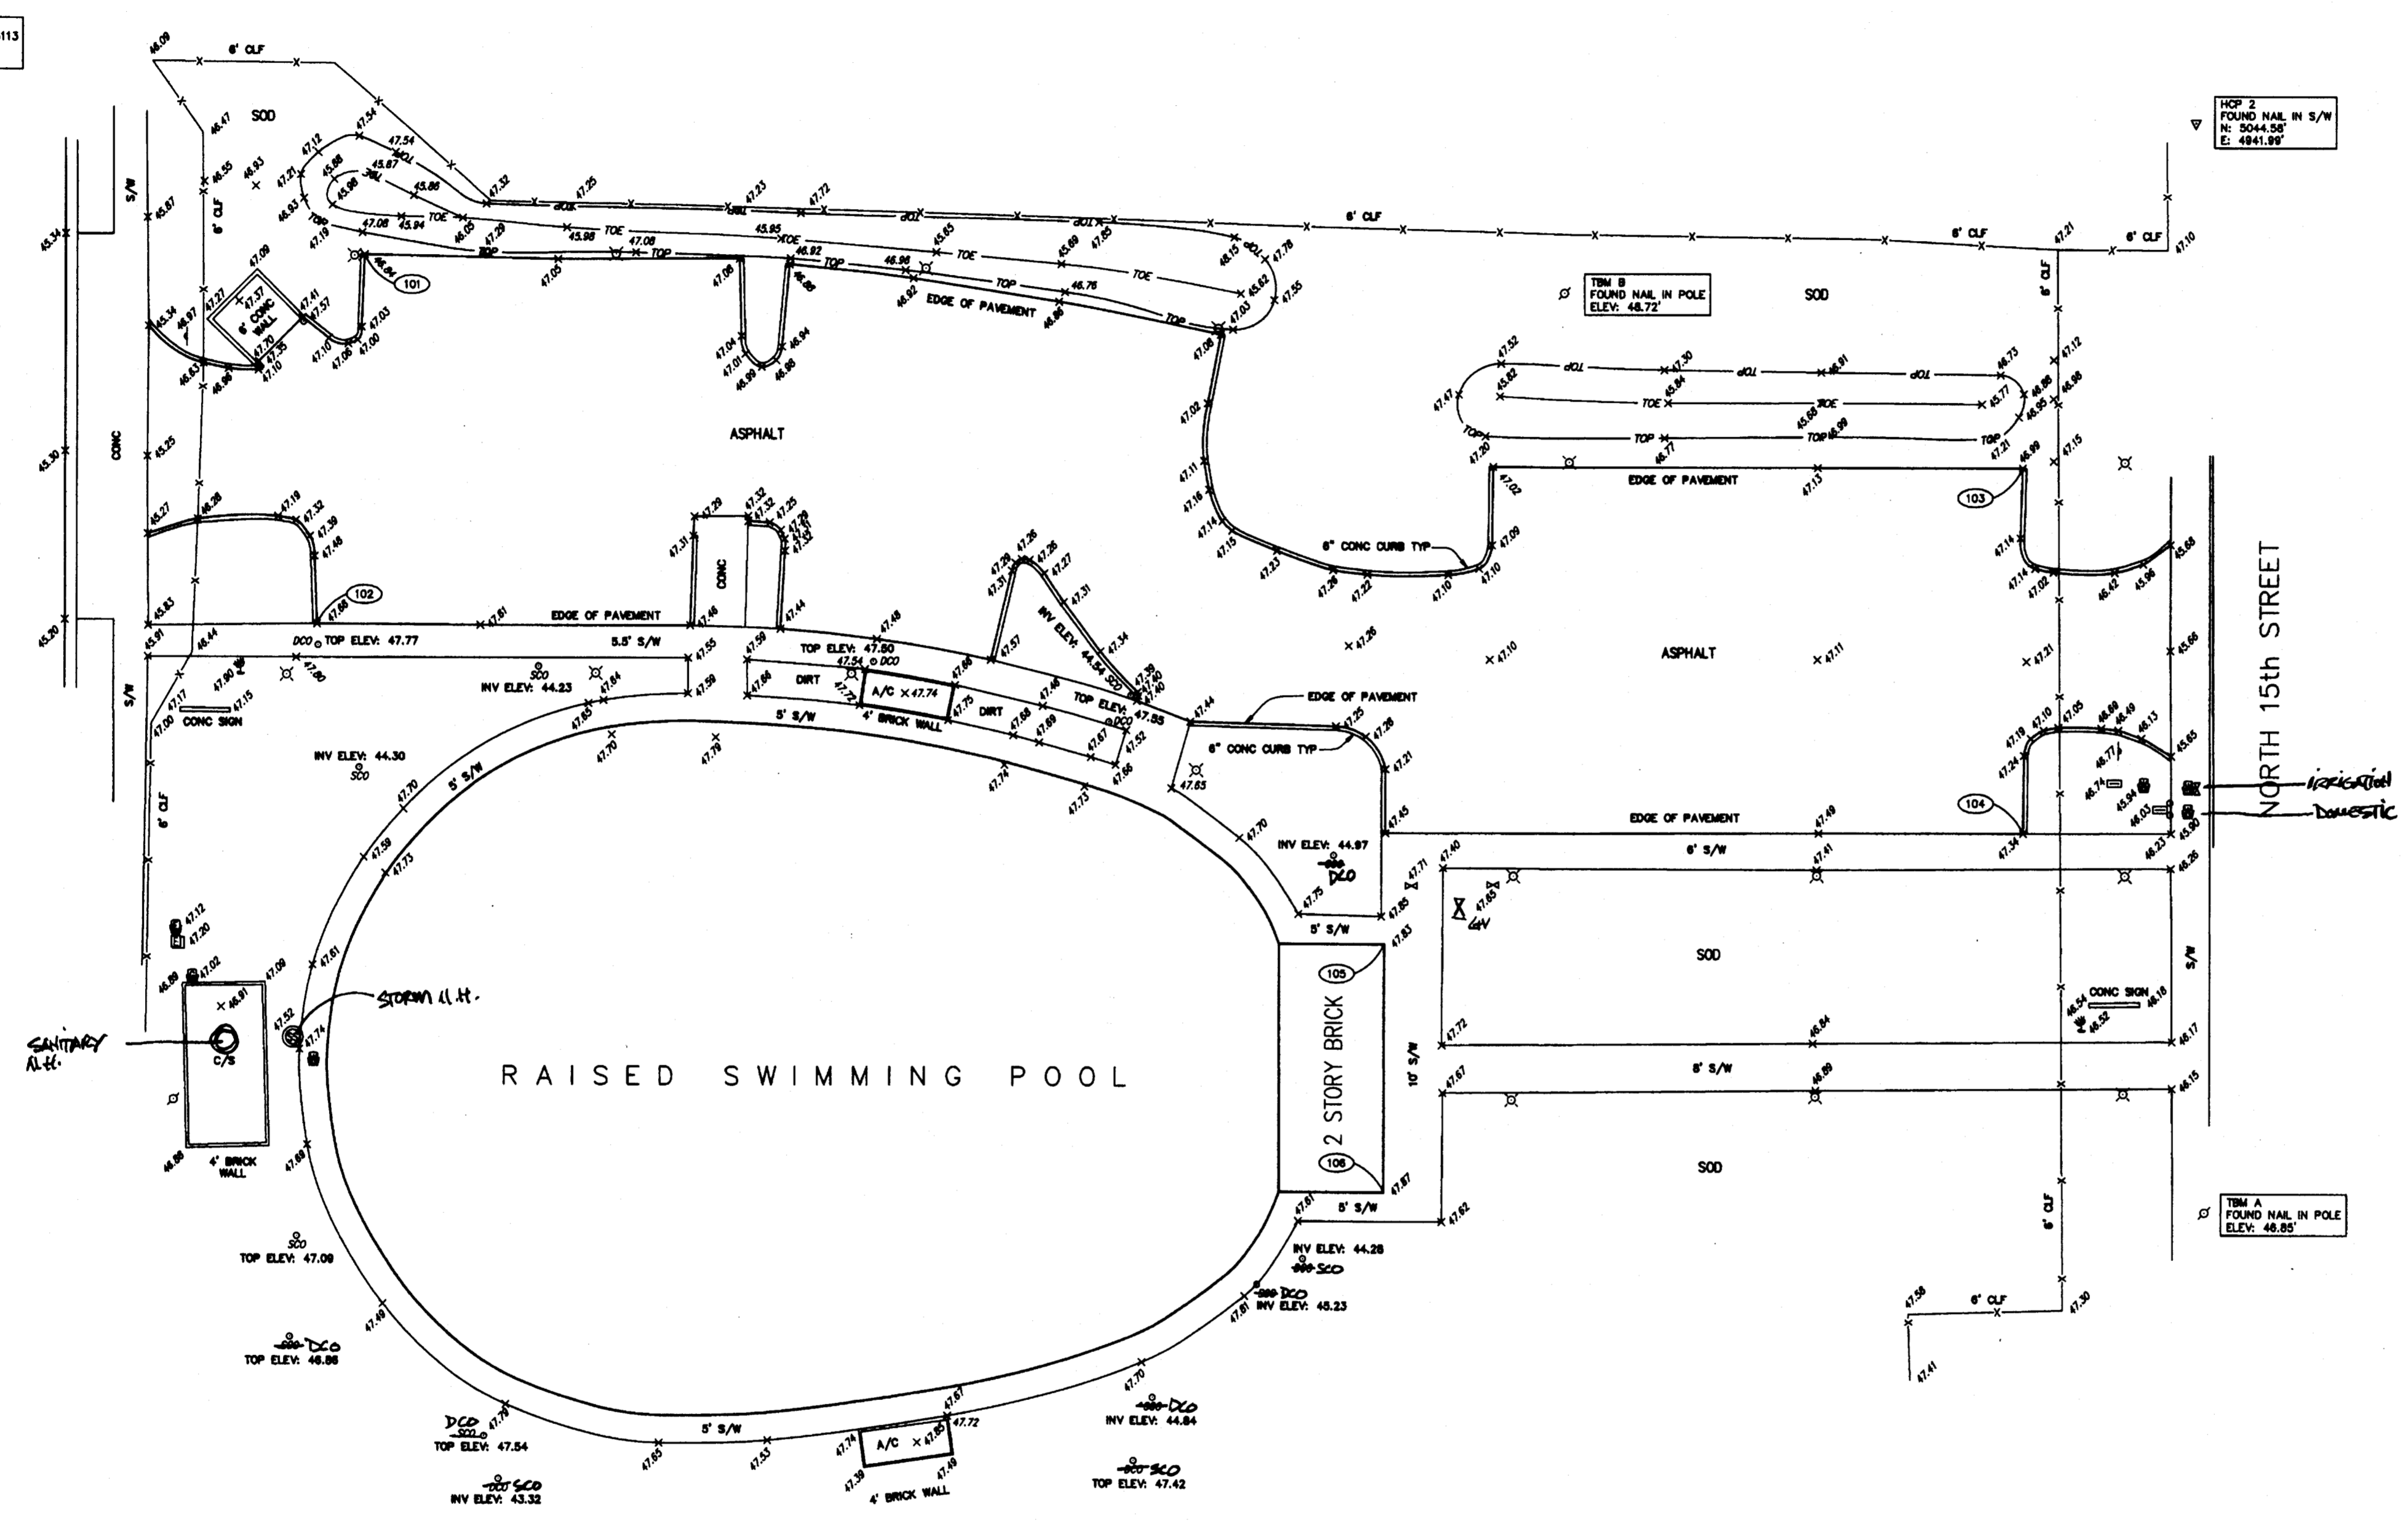

LEGEND

- HCP HORIZONTAL CONTROL POINT
- TBM TEMPORARY BENCH MARK
- FR FOUND IRON ROD
- S/W CONCRETE SIDEWALK
- TOP TOP OF SLOPE
- TOE TOE OF SLOPE
- CLF CHAIN LINK FENCE
- CONC CONCRETE
- TYP TYPICAL
- A/C AIR CONDITIONER SLAB
- C/S CONCRETE SLAB
- INV INVERT
- ELEV ELEVATION
- SCD SANITARY CLEANOUT
- DOB STORM DRAIN CLEANOUT
- LB LICENSED BUSINESS
- S/M SANITARY SEWER MANHOLE
- BOLLARD
- GAS METER
- ELECTRIC SPUCE BOX
- ELECTRIC METER
- POWER POLE
- LIGHT POLE
- STOP SIGN
- ELEVATION
- WATER VALVE
- WATER METER
- BACKFLOW PREVENTER
- SURFACE MOUNTED LIGHT

POINT	NORTHING	EASTING
101	5021.63	4631.00
102	4959.22	4623.04
103	4986.42	4912.76
104	4924.75	4912.97
105	4905.56	4804.34
106	4863.49	4804.41

IMPROVEMENTS NOT SHOWN

SURVEYOR'S NOTES

- This is an as-built survey, the purpose of which is to show the horizontal and vertical location of Cuscaden Pool renovations constructed by Construction Technology Group, Inc. as of August 26 2005.
- All elevations shown hereon are based on temporary bench marks A and B as shown on Rowe Architects, Inc. Site Plan 0202.00 dated 02/02/04.
- All horizontal coordinates shown hereon are based on information provided by Polaris Associates, Inc. for horizontal control points 1 and 2.
- Any reuse of this survey for purposes other than which it was intended, without written verification, will be at the reuser's sole risk and without liability to the surveyor.
- Not valid without the signature and the original raised seal of a Florida licensed Surveyor and Mapper.

Thomas G. Dove
 Professional Surveyor and Mapper
 State of Florida No. 5177
 Date Signed: 9/01/05
 Last Date of Field Survey: 8/26/05

RECORD DWG.
 DATE 9/26/05

INSTALLATION NOTES:

1. NO PARALLEL BRANCHING OF WIRE IS ALLOWED IN SIGNAL CIRCUIT.
2. PARALLEL BRANCHING OF INITIATION CIRCUIT IS ALLOWED, BUT MUST NOT EXCEED 63 BRANCHES PER DATA LINE.
3. WHEN SPADE CRIMP CONNECTORS ARE USED FOR TERMINATION AT THE DEVICES, UNDER NO CIRCUMSTANCES SHOULD MORE THAN ONE WIRE BE CRIMPED IN A CONNECTOR.

CONTRACTOR/INSTALLER NOTE:

YOUR INSTALLATION OF WIRING AND EQUIPMENT MUST BE IN ACCORDANCE WITH NFPA 70 - THE NATIONAL ELECTRIC CODE - ARTICLE 760 - FIRE PROTECTIVE SIGNALING SYSTEMS, NFPA 72 - CURRENT EDITION AND MAY ALSO BE SUBJECT TO REVIEW AND ACCEPTANCE OF LOCAL AUTHORITIES HAVING JURISDICTION. INSTALLATION SHALL ALSO BE IN COMPLIANCE WITH THE FLORIDA FIRE CODE 2001 EDITION.

NOTE:

ELECTRICAL CONTRACTOR SHALL PULL, BUT NOT CONNECT A/C POWER TO CONTROL PANEL. THIS WILL BE CONNECTED BY AN SAI TECHNICIAN. ALL OTHER FIELD WIRES ARE TO BE CONNECTED BY ELECTRICAL CONTRACTOR AFTER CHECKING FOR CONTINUITY AND GROUNDS.

NOTE:

THESE FIRE ALARM WIRING AND CONNECTION DIAGRAMS ARE PROVIDED TO INDICATE WIRING REQUIREMENTS AND SUGGESTED CONDUIT RUNS. FOR EXACT LOCATION AND PLACEMENT OF FIRE ALARM DEVICES REFER TO CONSTRUCTION DOCUMENTS.

△ NOTE:

PER NFPA REGULATION, MONITORING OF ELEVATOR SHUNT TRIP POWER SHALL BE ACCOMPLISHED THRU THE USE OF A SIGA-CTI INPUT MODULE AND AN MR-101/C HEAVY DUTY RELAY. SEE CONNECTION DIAGRAM FOR TYPICAL WIRING.

SYMBOL LEGEND

SYMBOL	DESCRIPTION
[F]	ADDRESSABLE MANUAL PULL STATION (SIGA-278)
[F] WP	ADDRESSABLE MANUAL PULL STATION/WEATHERPROOF COVER (SIGA-278/STI-3150)
[H]	ADDRESSABLE 135° HEAT DETECTOR/BASE (SIGA-HFS/SIGA-SB)
[H] WP	WEATHERPROOF HEAT DET./MONTOR MODULE (WPBMP508/SIGA-CT1)
[S]	ADDRESSABLE PHOTO. SMOKE DETECTOR/BASE (SIGA-PS/SIGA-SB)
[S] S/R	ADDRESSABLE PHOTO. SMOKE DETECTOR/BASE/HOUSING/AIR SAMPLING TUBE (SIGA-PS/SIGA-SB/SIGA-DH/6261-006)
[S] TL	REMOTE INDICATOR LIGHT (SIGA-LED)
[R]	ADDRESSABLE CONTROL RELAY (SIGA-CR)
[F]	MULTI-CANDELA SPEAKER-STROBE (G4RF-S7VM)
[F] WP	SPEAKER-STROBE/WEATHERPROOF BACKBOX (757-7A-RS70/757A-WB)
[H]	MULTI-CANDELA STROBE (G1RF-VM)
[M]	HEAVY DUTY RELAY/ENCLOSURE (MR-101/C)
[M]	MONITOR MODULE (SIGA-CT1)
[BPS]	BOOSTER POWER SUPPLY (BPS10)
[VDP]	VOICE EVACUATION PANEL (DVS-25P)
[FACP]	FIRE ALARM CONTROL PANEL (EST2)
[E.O.L.]	END OF LINE RESISTOR (E.O.L.)

WIRING LEGEND

ABRV	SIZE	COLOR	CIRCUIT
A	2 - #16	ORANGE/BLUE	ADDRESSABLE DATA CIRCUIT
B	2 - #16	WEST PENN 990 TWISTED PAIR CABLE	SPEAKER CIRCUITS
C	2 - #12	RED/BLACK	STROBE CIRCUITS
G	2 - #16	WHITE/BLACK	REMOTE INDICATORS

BATTERY CALCULATIONS EST2

TOTAL SUPV. CURRENT	HOURS OF SUPV.	TOTAL ALARM CURRENT	HOURS IN ALARM
((.251 X 24) + (.515 X .083)) X 1.2			
6.024 + .048 = 6.067			
			X 1.2
			7.280 APH (12 APH SUPPLIED)

BATTERY CALCULATIONS DVS-25P


TOTAL SUPV. CURRENT	HOURS OF SUPV.	TOTAL ALARM CURRENT	HOURS IN ALARM
((.080 X 24) + (1.920 X .25)) X 1.2			
1.920 + .480 = 2.400			
			X 1.2
			2.880 APH (7 APH SUPPLIED)

BATTERY CALCULATIONS BPS10

TOTAL SUPV. CURRENT	HOURS OF SUPV.	TOTAL ALARM CURRENT	HOURS IN ALARM
((.070 X 24) + (5.082 X .083)) X 1.2			
1.680 + .424 = 2.104			
			X 1.2
			2.524 APH (7 APH SUPPLIED)

ELEVATOR CONTROL RELAYS

DEVICE 02-04 (PRL ELEVATOR RECALL)
 DEVICE 02-05 (ALT. ELEVATOR RECALL)
 DEVICE 02-06 (ELEVATOR WARNING LIGHT)
 DEVICE 02-07 (ELEVATOR SHUNT TRIP)

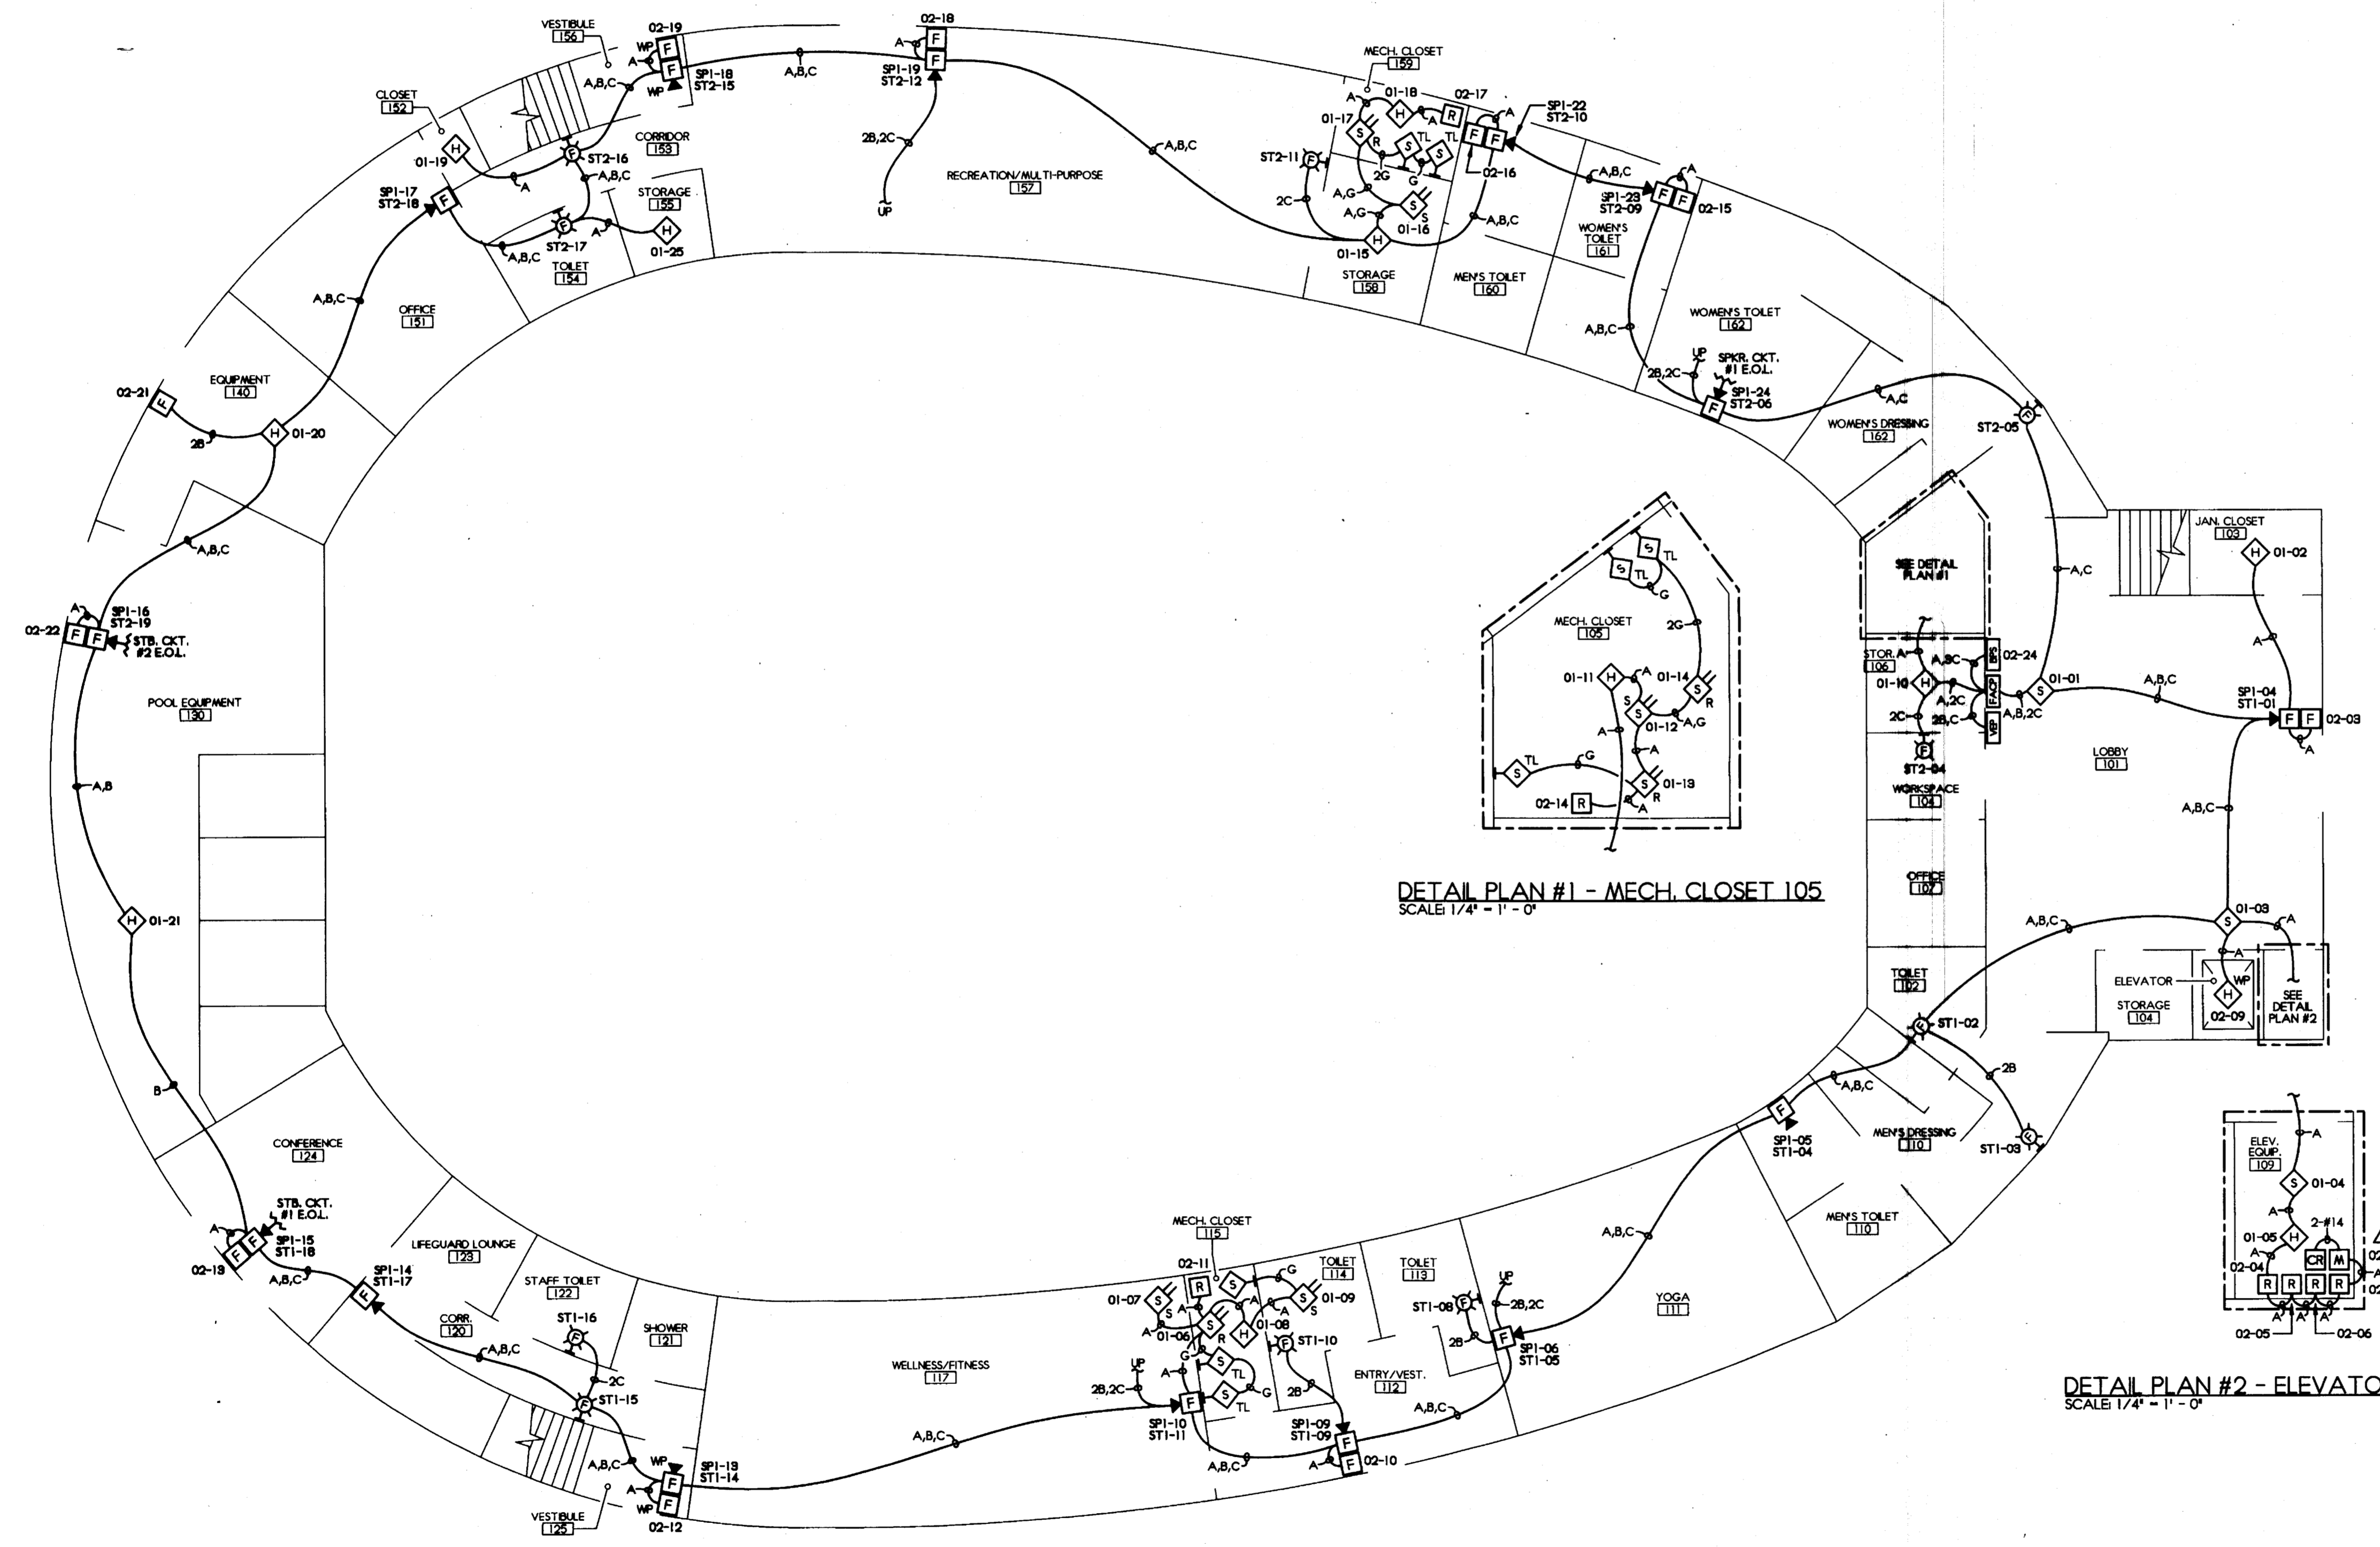

DETAIL PLAN #1 - MECH. CLOSET 105
SCALE 1/4" = 1' - 0"

DETAIL PLAN #2 - ELEVATOR EQUIP. 109
SCALE 1/4" = 1' - 0"

FIRE ALARM PLAN - 1ST FLOOR
SCALE 1/8" = 1' - 0"

RECORD DWG.
DATE 8/26/05

AS-BUILT DRAWINGS

SAI inc. SYSTEMS DIVISION
 2995 24TH AVE NORTH
 SAINT PETERSBURG, FL 33713
 TEL: 727-592-0000
 FLA STATE LIC. #E-0000293, EFC0001045
 CONTRACTOR: AMERICAN ELEC. SERVICES - TAMPA, FL

CUSCADEN POOL RENOVATION
 TAMPA, FLORIDA
FIRE ALARM SYSTEM PLAN


RECEIVED
 SEP 02 2005
 SMART TECH. GROUP, INC.

REVISIONS
 REVISED 11/00/04 - PER FIRE MARSHALS COMMENTS
 REVISED 03/09/05 - PER MATREX 11/23/04 COMMENTS

SCALE: AS NOTED
 DRAWN BY: BK
 APPROVED BY: RJS
 DRAWING DATE: 08/31/04
 REF. DWG. DATE: 02/02/04

STAMP

SHEET 1 OF 3
 04J-0078-W1

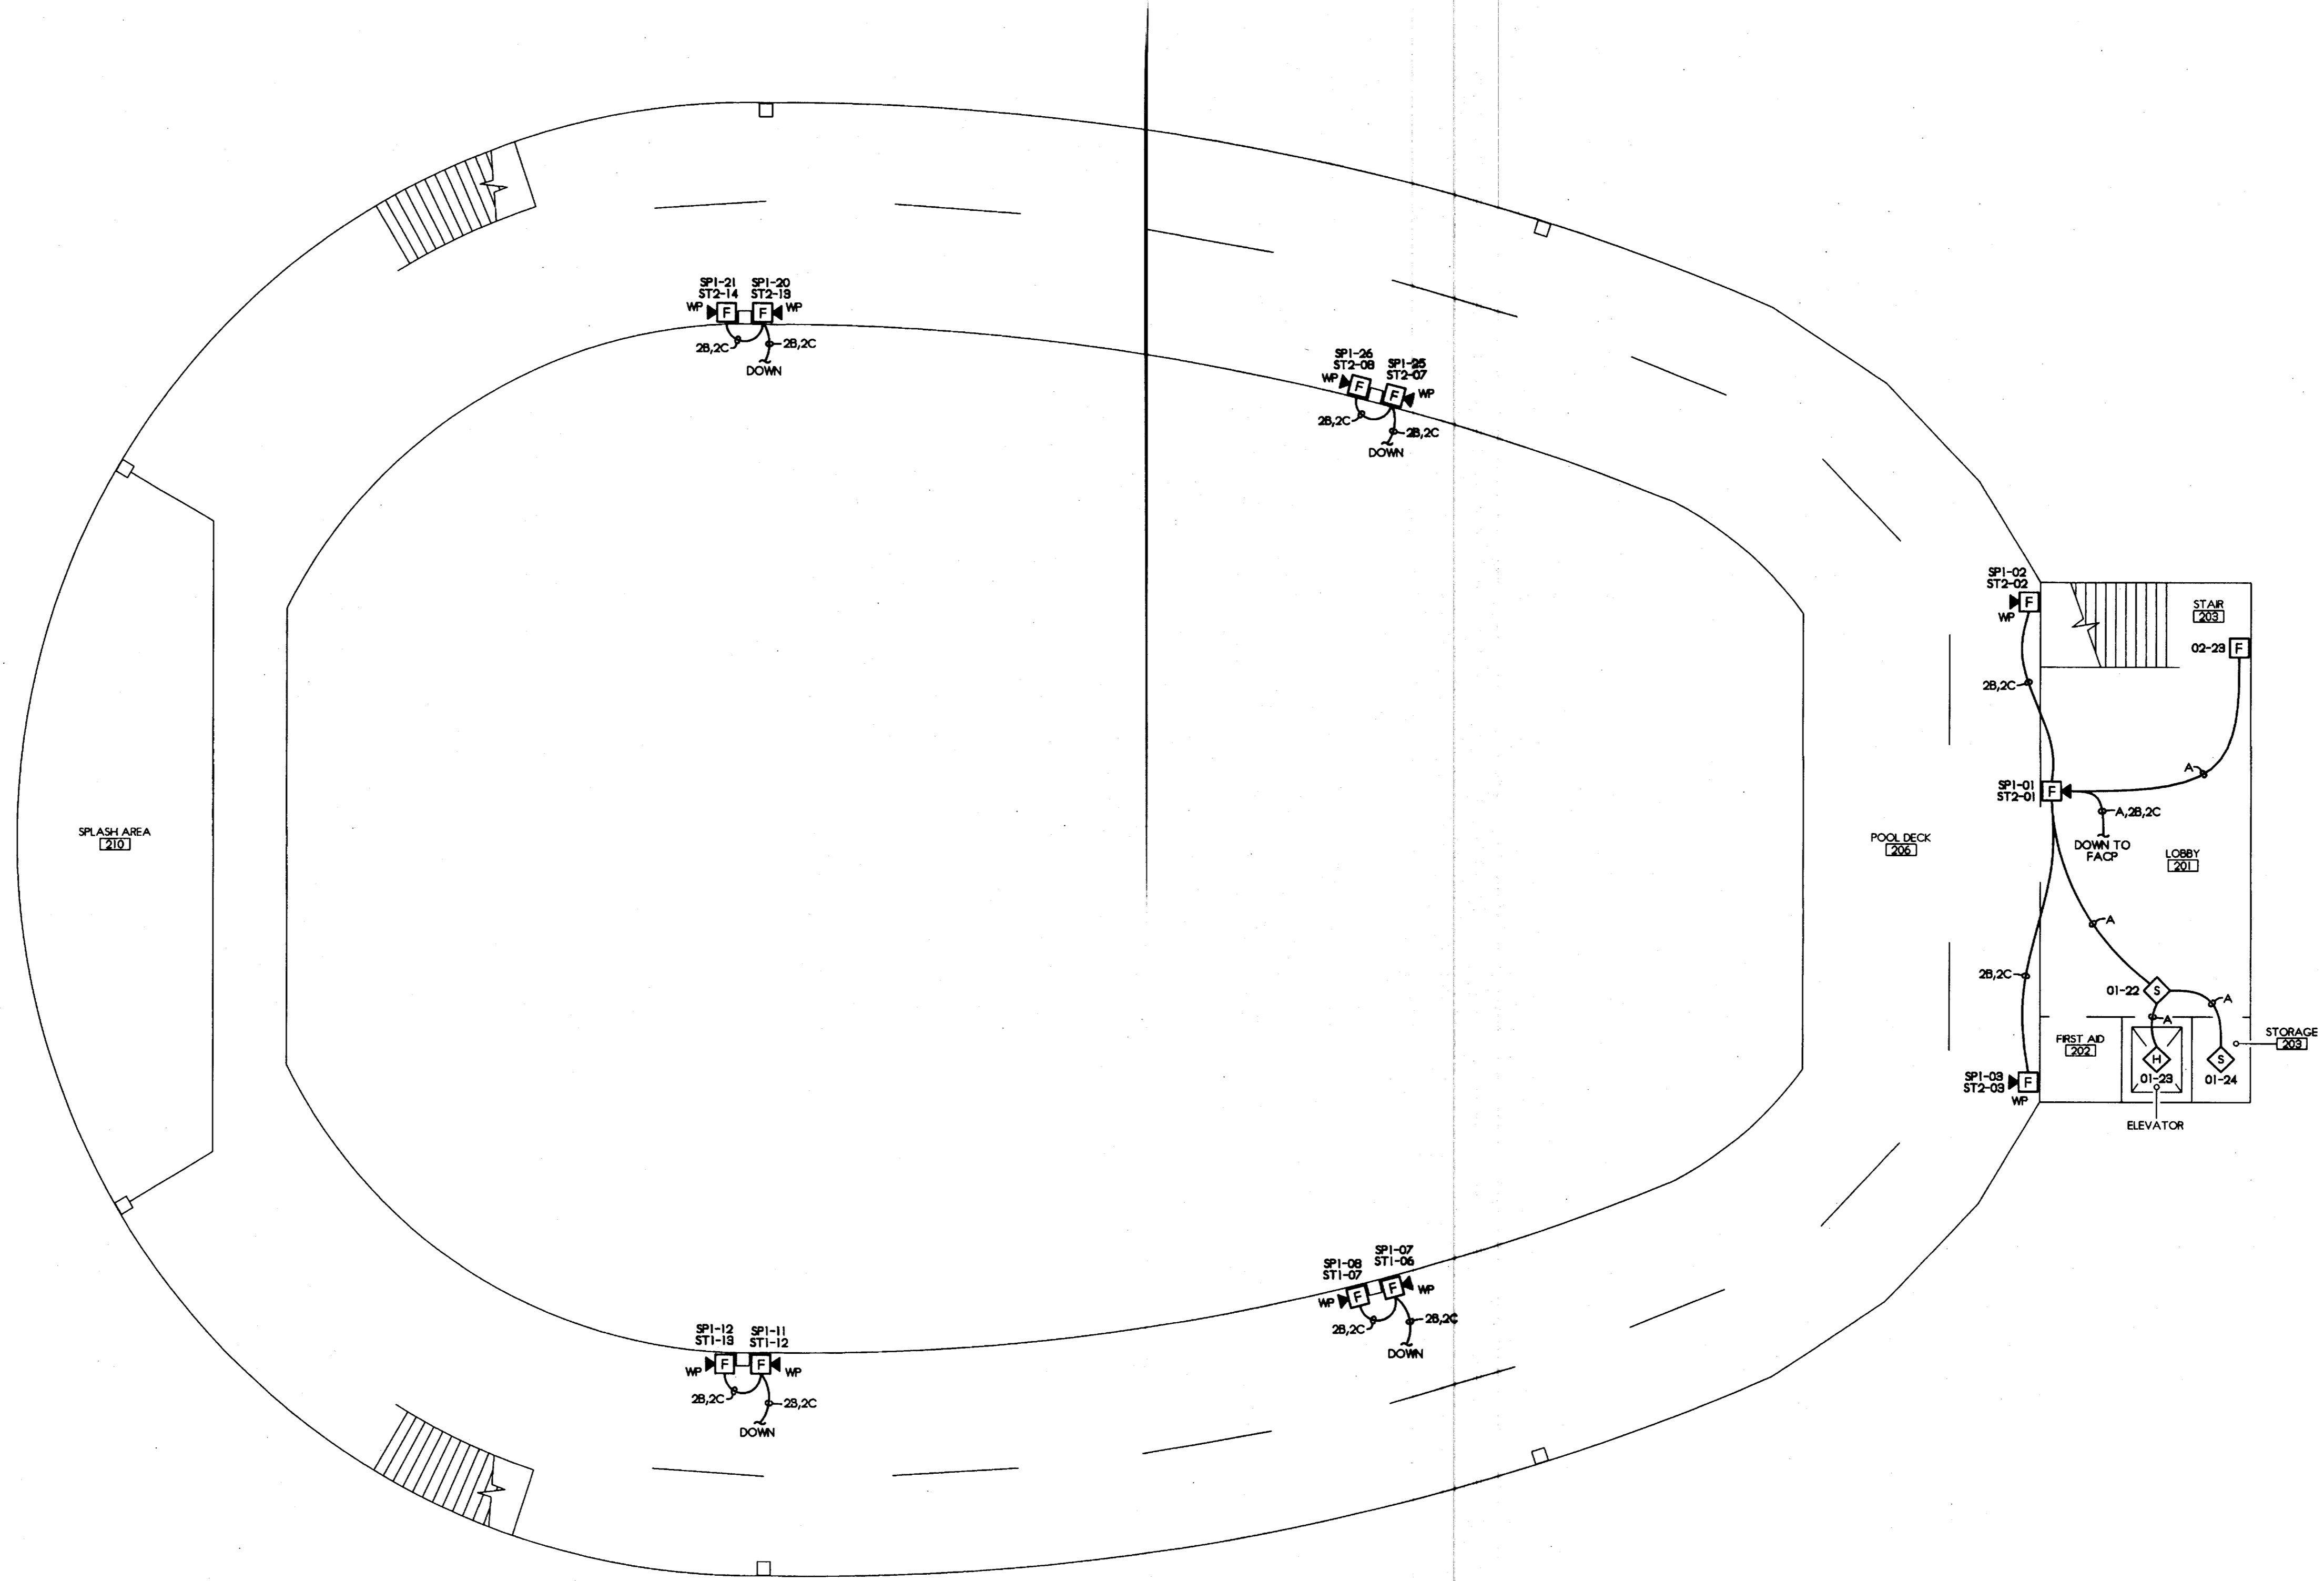


FIRE ALARM PLAN - 2ND FLOOR
 SCALE: 1/8" = 1' - 0"

SAI inc. SYSTEMS DIVISION
 2595 24TH AVE NORTH
 SAINT PETERSBURG, FLORIDA 33713
 TELEPHONE: (772) 323-4300
 FLA STATE LIC. EF-000295, EF-0001945
 CONTRACTOR: AMERICAN ELEC. SERVICES - TAMPA, FL

CUSCADEN POOL RENOVATION
TAMPA, FLORIDA
FIRE ALARM SYSTEM PLAN

REVISIONS
REVISED 11/7/04 - PER FIRE MARSHAL'S COMMENTS
REVISED 03/09/05 - PER MATRIX 11/23/04 COMMENTS

SCALE: AS NOTED
 DRAWN BY: BK
 APPROVED BY: RJS
 DRAWING DATE: 08/31/04
 REF. DWG. DATE: 02/02/04

STAMP

RECORD DWG.
 DATE 01/26/05

SHEET 2 OF 3
 04J-0078-W2