


LOCATION MAP

SCALE: 1" = 8,000'

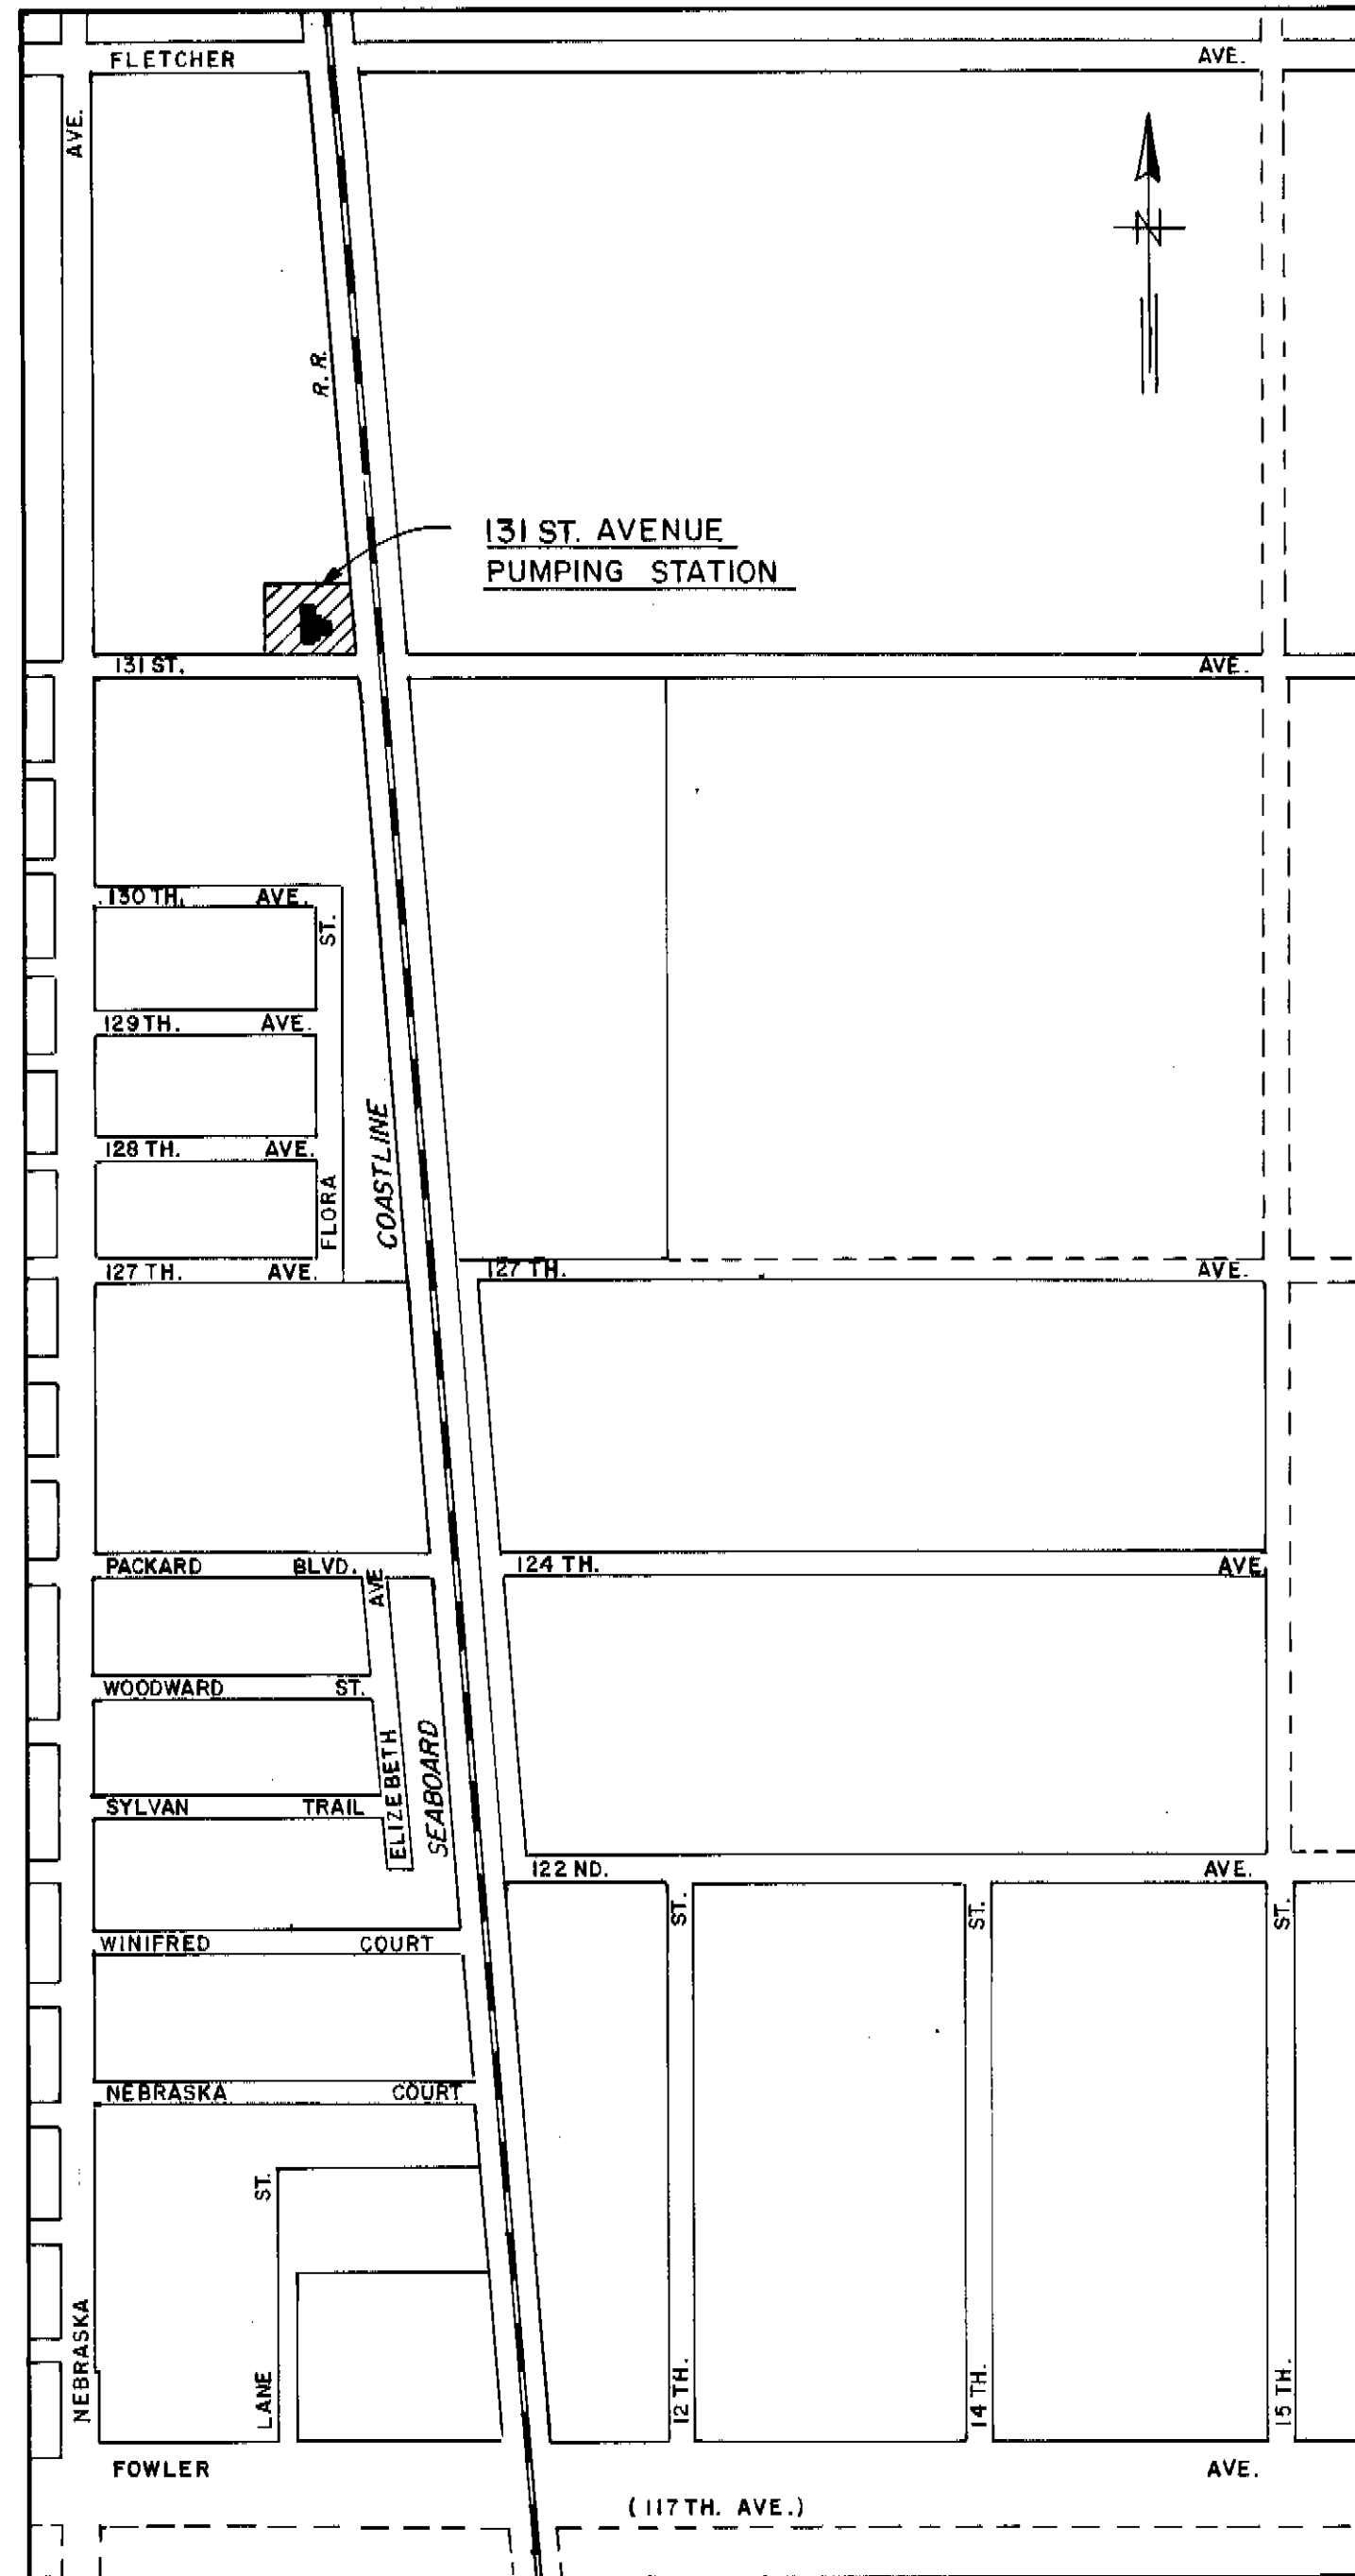

AREA MAP

SCALE: 1" = 400'

INDEX


SHEET NO.	TITLE
1.	LOCATION MAP, AREA MAP AND INDEX
EQUIPMENT	
2.	SITE PLAN, TOP FLOOR PLAN
3.	INTERMEDIATE FLOOR PLAN, DETAILS
4.	LOWER FLOOR PLAN, SECTIONS AND DETAILS
5.	SECTIONS AND DETAILS
6.	PIPING DIAGRAMS
STRUCTURAL	
7.	LOWER FLOOR PLAN, SECTIONS
8.	INTERMEDIATE FLOOR PLAN, SECTIONS
9.	TOP FLOOR PLAN, SECTIONS
10.	ROOF FRAMING PLAN, CRANE GIRDER PLAN AND DETAILS
11.	SECTION
12.	FRAME ELEVATION AND DETAILS, SECTIONS
13.	SECTIONS
14.	SECTIONS
15.	GENERAL NOTES AND TYPICAL DETAILS
16.	TYPICAL DETAILS
ARCHITECTURAL	
17.	TOP FLOOR PLAN
18.	ROOF PLAN, DETAILS
19.	ELEVATIONS AND DETAILS
20.	DETAILS
VENTILATING	
21.	TOP FLOOR PLAN
22.	INTERMEDIATE AND LOWER FLOOR PLANS
23.	SECTION
24.	SECTION, EQUIPMENT SCHEDULES
ELECTRICAL	
25.	SITE PLAN AND LEGEND
26.	ONE LINE DIAGRAMS
27.	SEWAGE PUMP NO. 1 CONTROL
28.	SEWAGE PUMP NO. 3 CONTROL
29.	MISCELLANEOUS CONTROL DIAGRAMS
30.	TOP AND INTERMEDIATE FLOOR PLANS
31.	LOWER FLOOR PLAN, LIGHTING SCHEDULE
32.	SECTION, CONDUIT AND WIRE SCHEDULE
LANDSCAPING	
33.	131 ST. AVENUE PUMPING STATION LANDSCAPING PLAN
34.	13TH STREET PUMPING STATION LANDSCAPING PLAN
35.	25TH STREET PUMPING STATION LANDSCAPING PLAN
AD-3-I.	GROUT HOLES LOCATION PLAN AND DETAIL

NOTE:

ALL ELEVATIONS SHOWN ARE REFERENCED TO CITY OF TAMPA DATUM. TO CONVERT TO NATIONAL OCEAN SURVEY (NOS) DATUM, SUBTRACT 0.15 FEET (0'-1 13/16").

RECORD DRAWING

THIS RECORD DRAWING IS NOT WARRANTED BUT IS BELIEVED TO REPRESENT CONDITIONS UPON COMPLETION OF CONSTRUCTION, WITHIN REASONABLE TOLERANCES, BASED UPON THE INFORMATION FURNISHED TO THE ENGINEER PERTAINING TO CHANGES MADE DURING CONSTRUCTION.

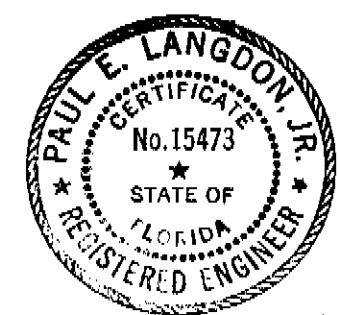


GREELEY AND HANSEN
ENGINEERS
222 S. RIVERSIDE PLAZA
CHICAGO, ILLINOIS 60606

DESIGNED JBV
DRAWN KZK
CHECKED JBV

APPROVED
Paul E. Langdon, Jr. DATE 4-3-74
Supt., Dept. of Sanitary Sewers
DATE 4-3-74
Greeley and Hansen, Engineers

NO.	DATE	APP.	REVISION
1	Mar 78	JRP	Plans Updated

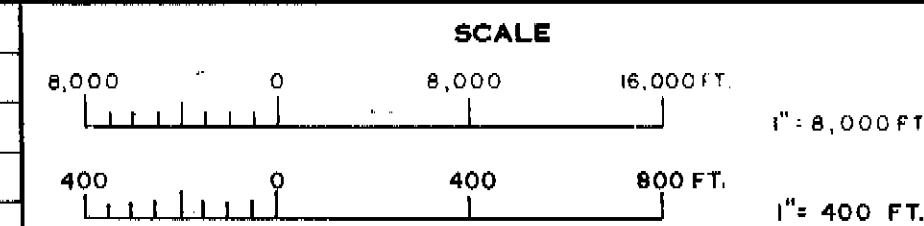



CITY OF TAMPA, FLORIDA
SEWAGE DISPOSAL SYSTEM
DIVISION 4G3
131ST. AVENUE PUMPING STATION

LOCATION MAP, AREA MAP
AND INDEX



PROJ. NO. S 202-70-30D-7-4G3

SHEET 1 OF 35

DATE AUGUST, 1972 REV 0

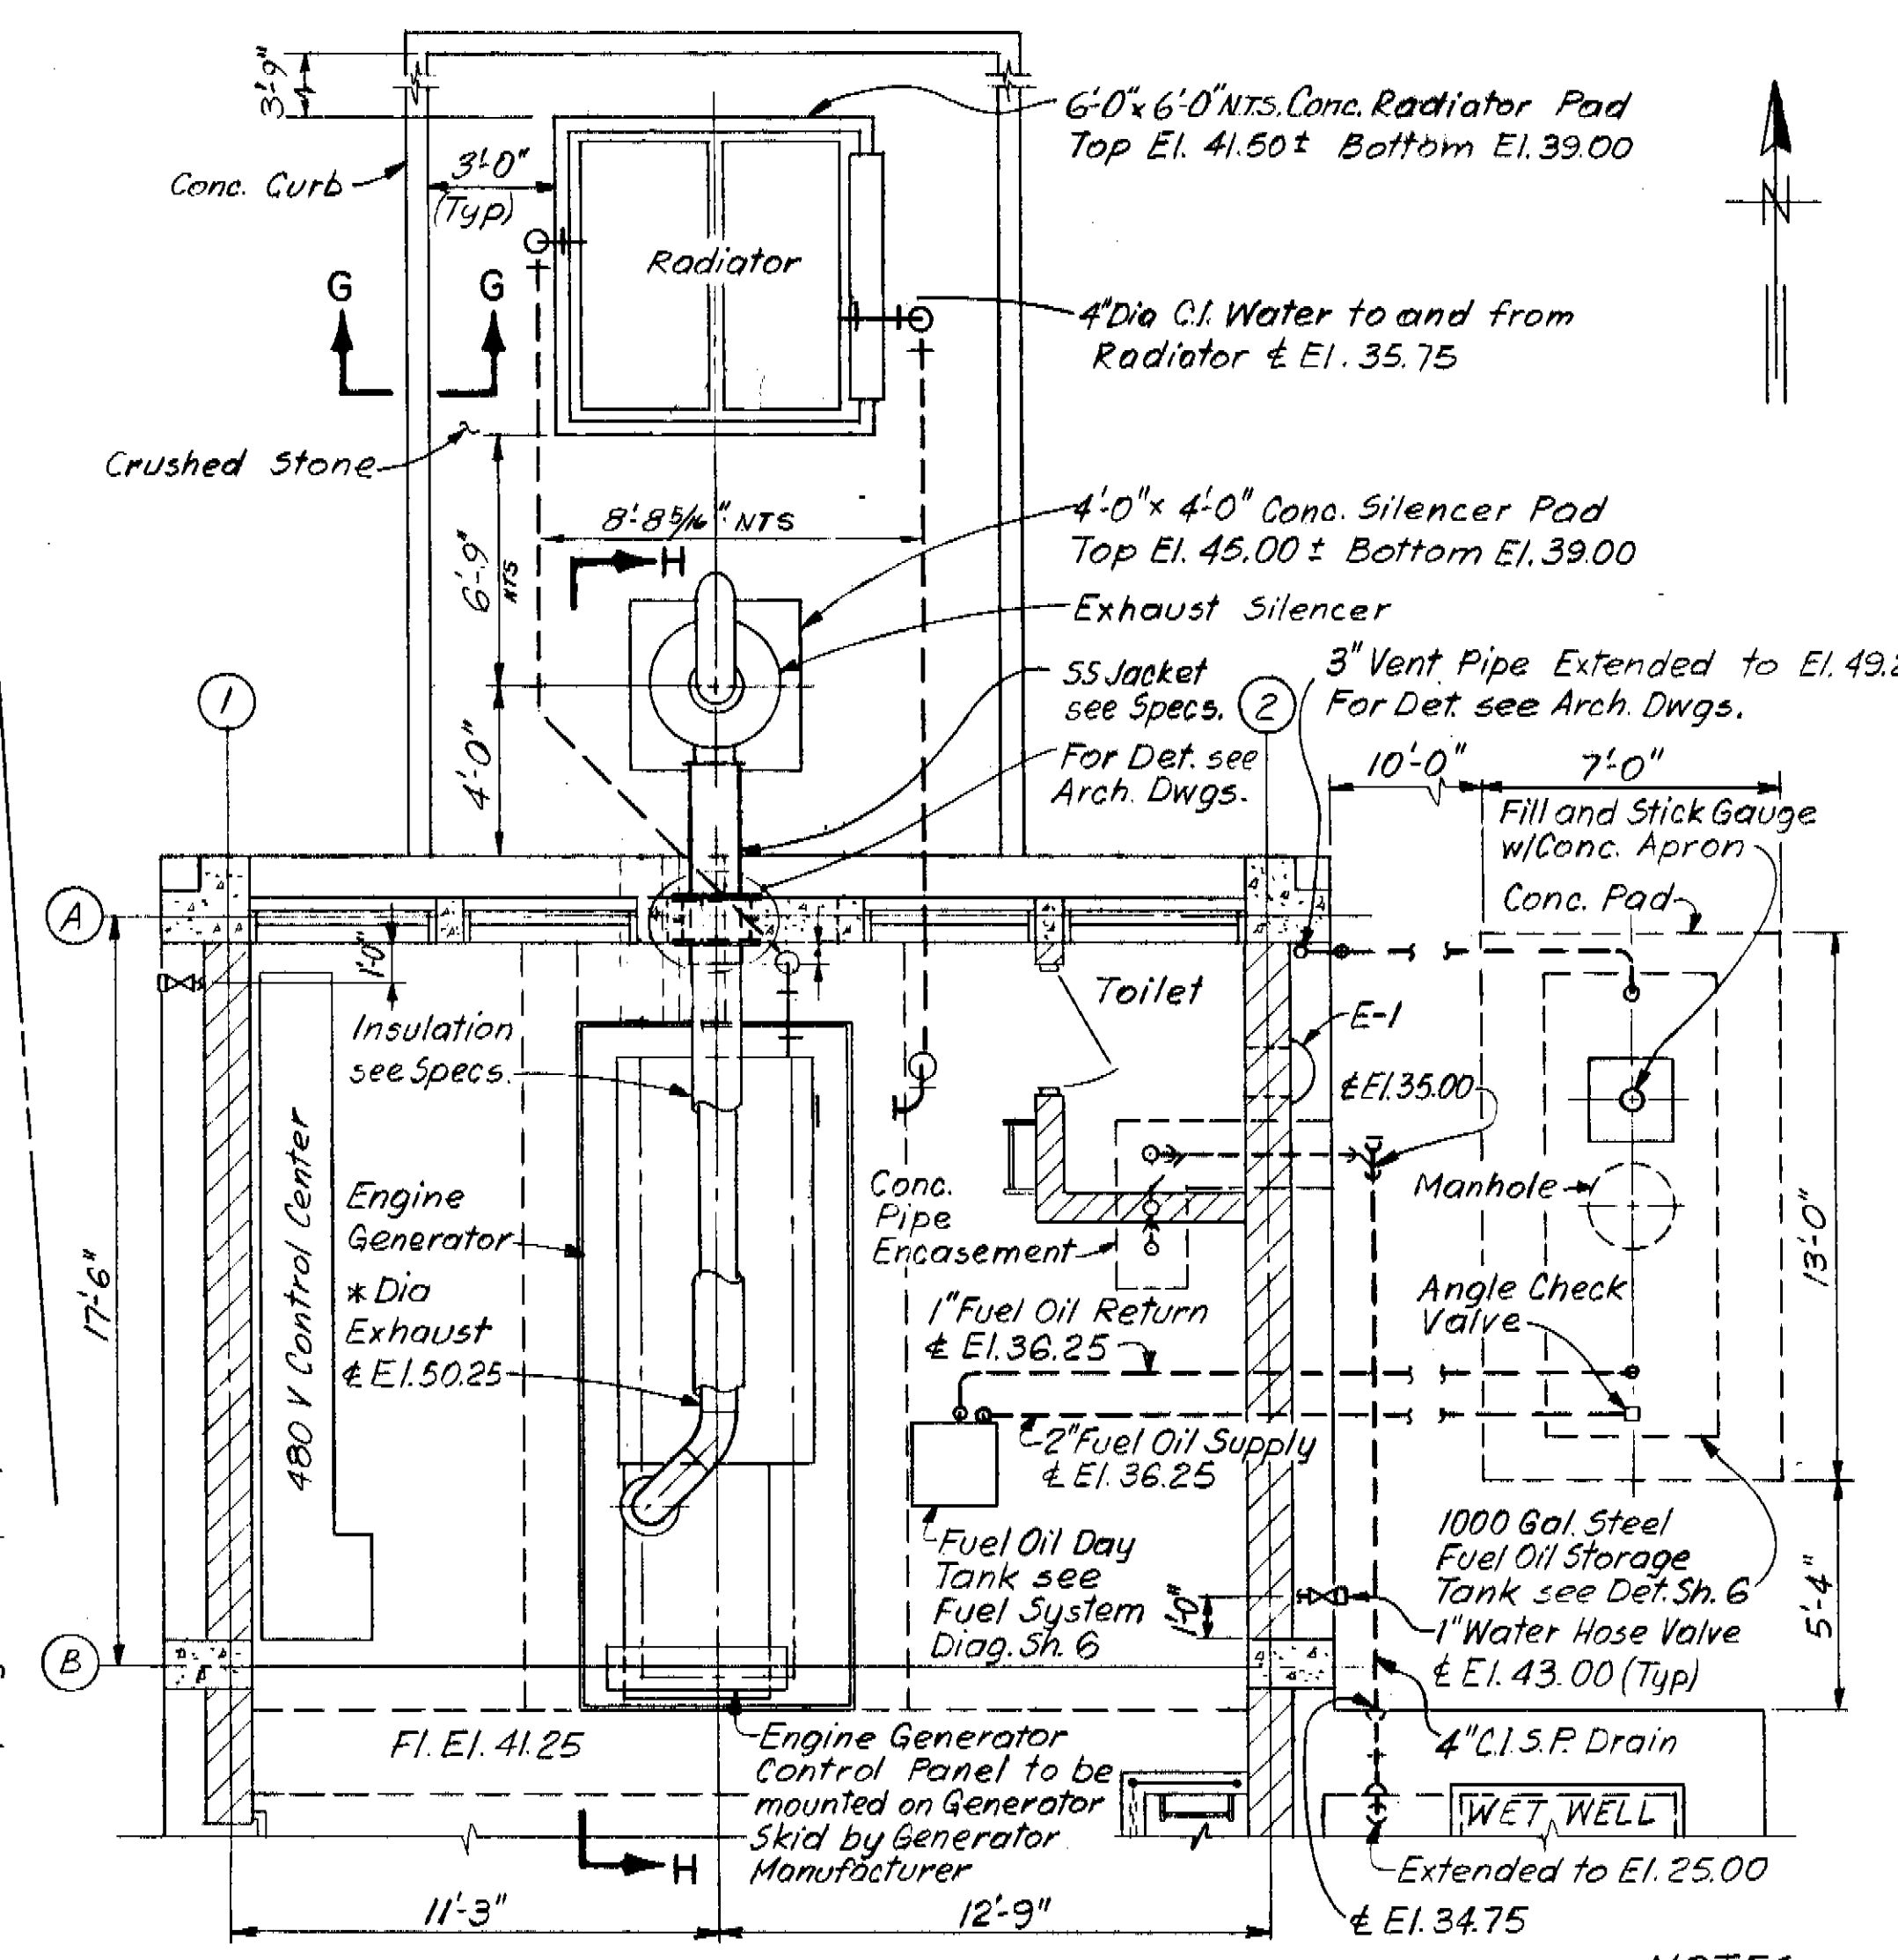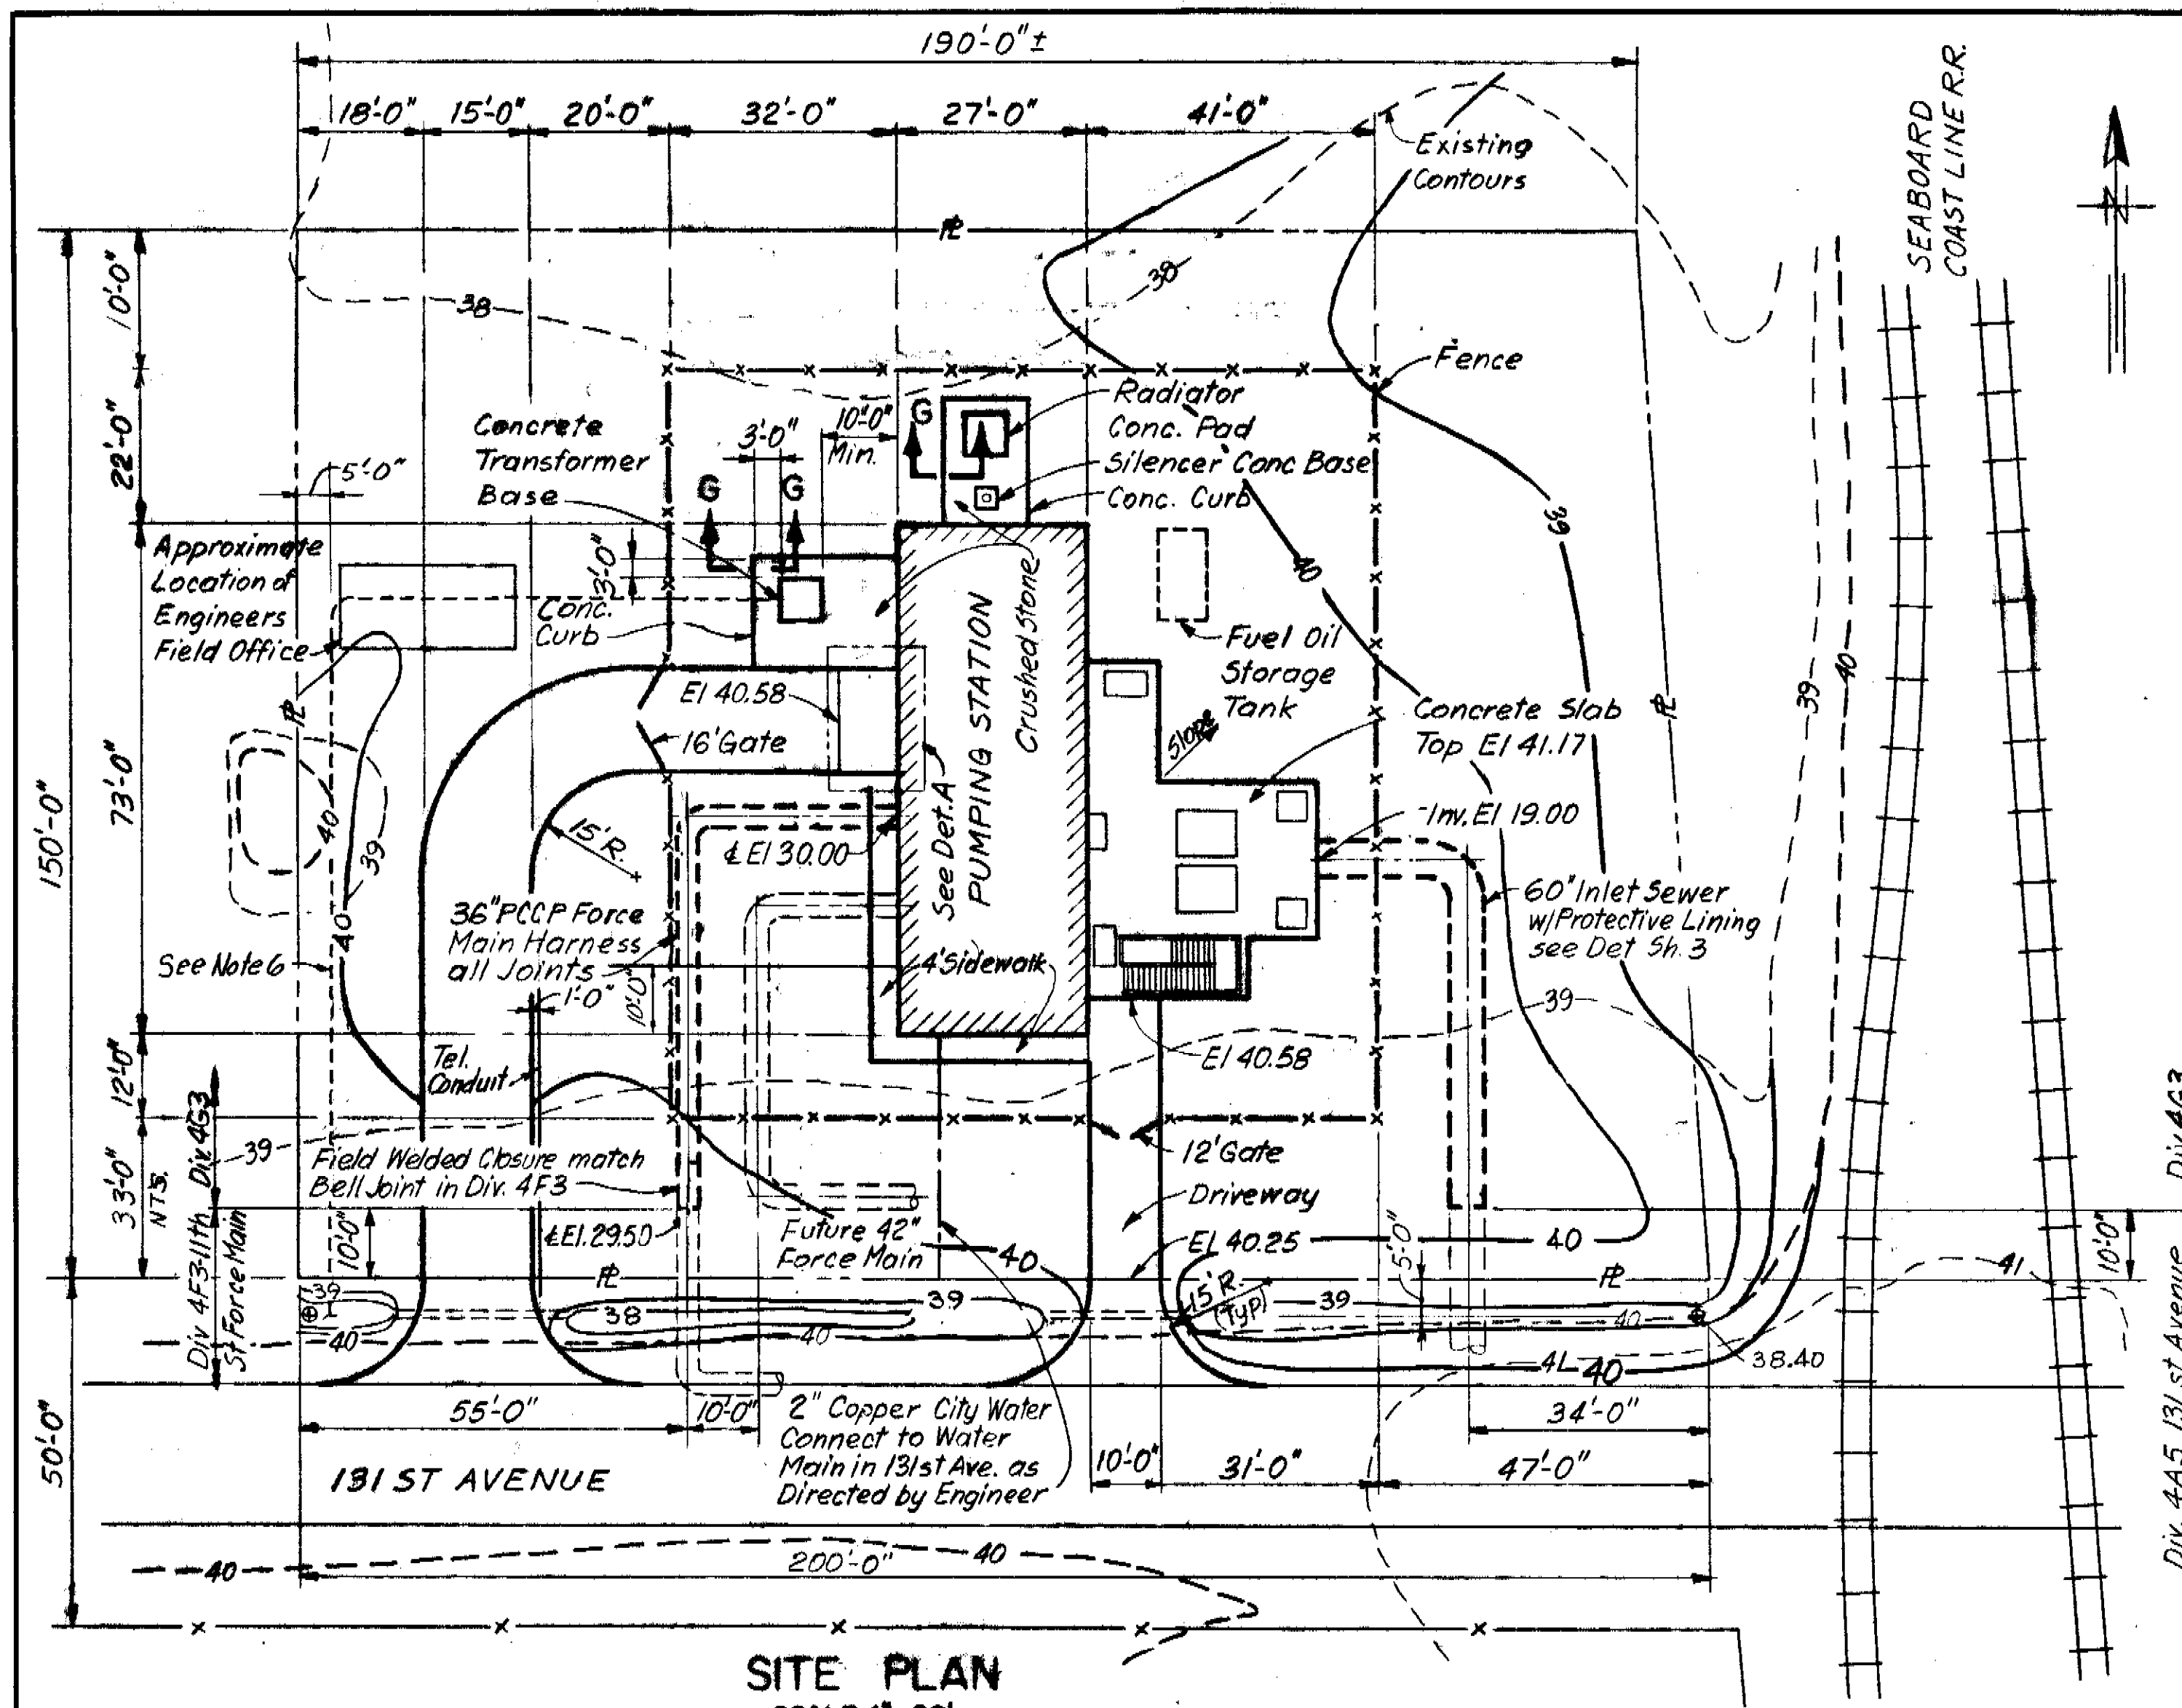

- NOTES:**
1. Finish Grade at Building to be EI. 40.58 with Uniform Slopes to South & at EI. 40.00 and to match Existing Grades at East, North and West & except as noted.
 2. Existing and Future Facilities to be constructed under Other Divisions shown in Light Lines. Facilities included in this Division are shown in heavy Lines.
 3. Locations, Elevations and Dimensions of Existing Utilities, Conduits, Process Piping, Other Underground Piping Structures and other Features are shown according to the best information available at the time of the preparation of these Plans but Do Not purport to be absolutely correct. The Contractor shall verify the Locations, Elevations and Dimensions of All Existing Utilities, Structures and other Features affecting His Work prior to Construction.
 4. The Contractor shall provide at least 48 Hours Notice to the City in order to permit the Location of Existing Underground Utilities, Conduits, Process Piping and other Underground Piping and Structures in advance of Construction.
 5. Site Dimensions are to Outside of Structure Walls.
 6. Location of Power Line to be established in the Field by the Engineer based on TECO requirements.

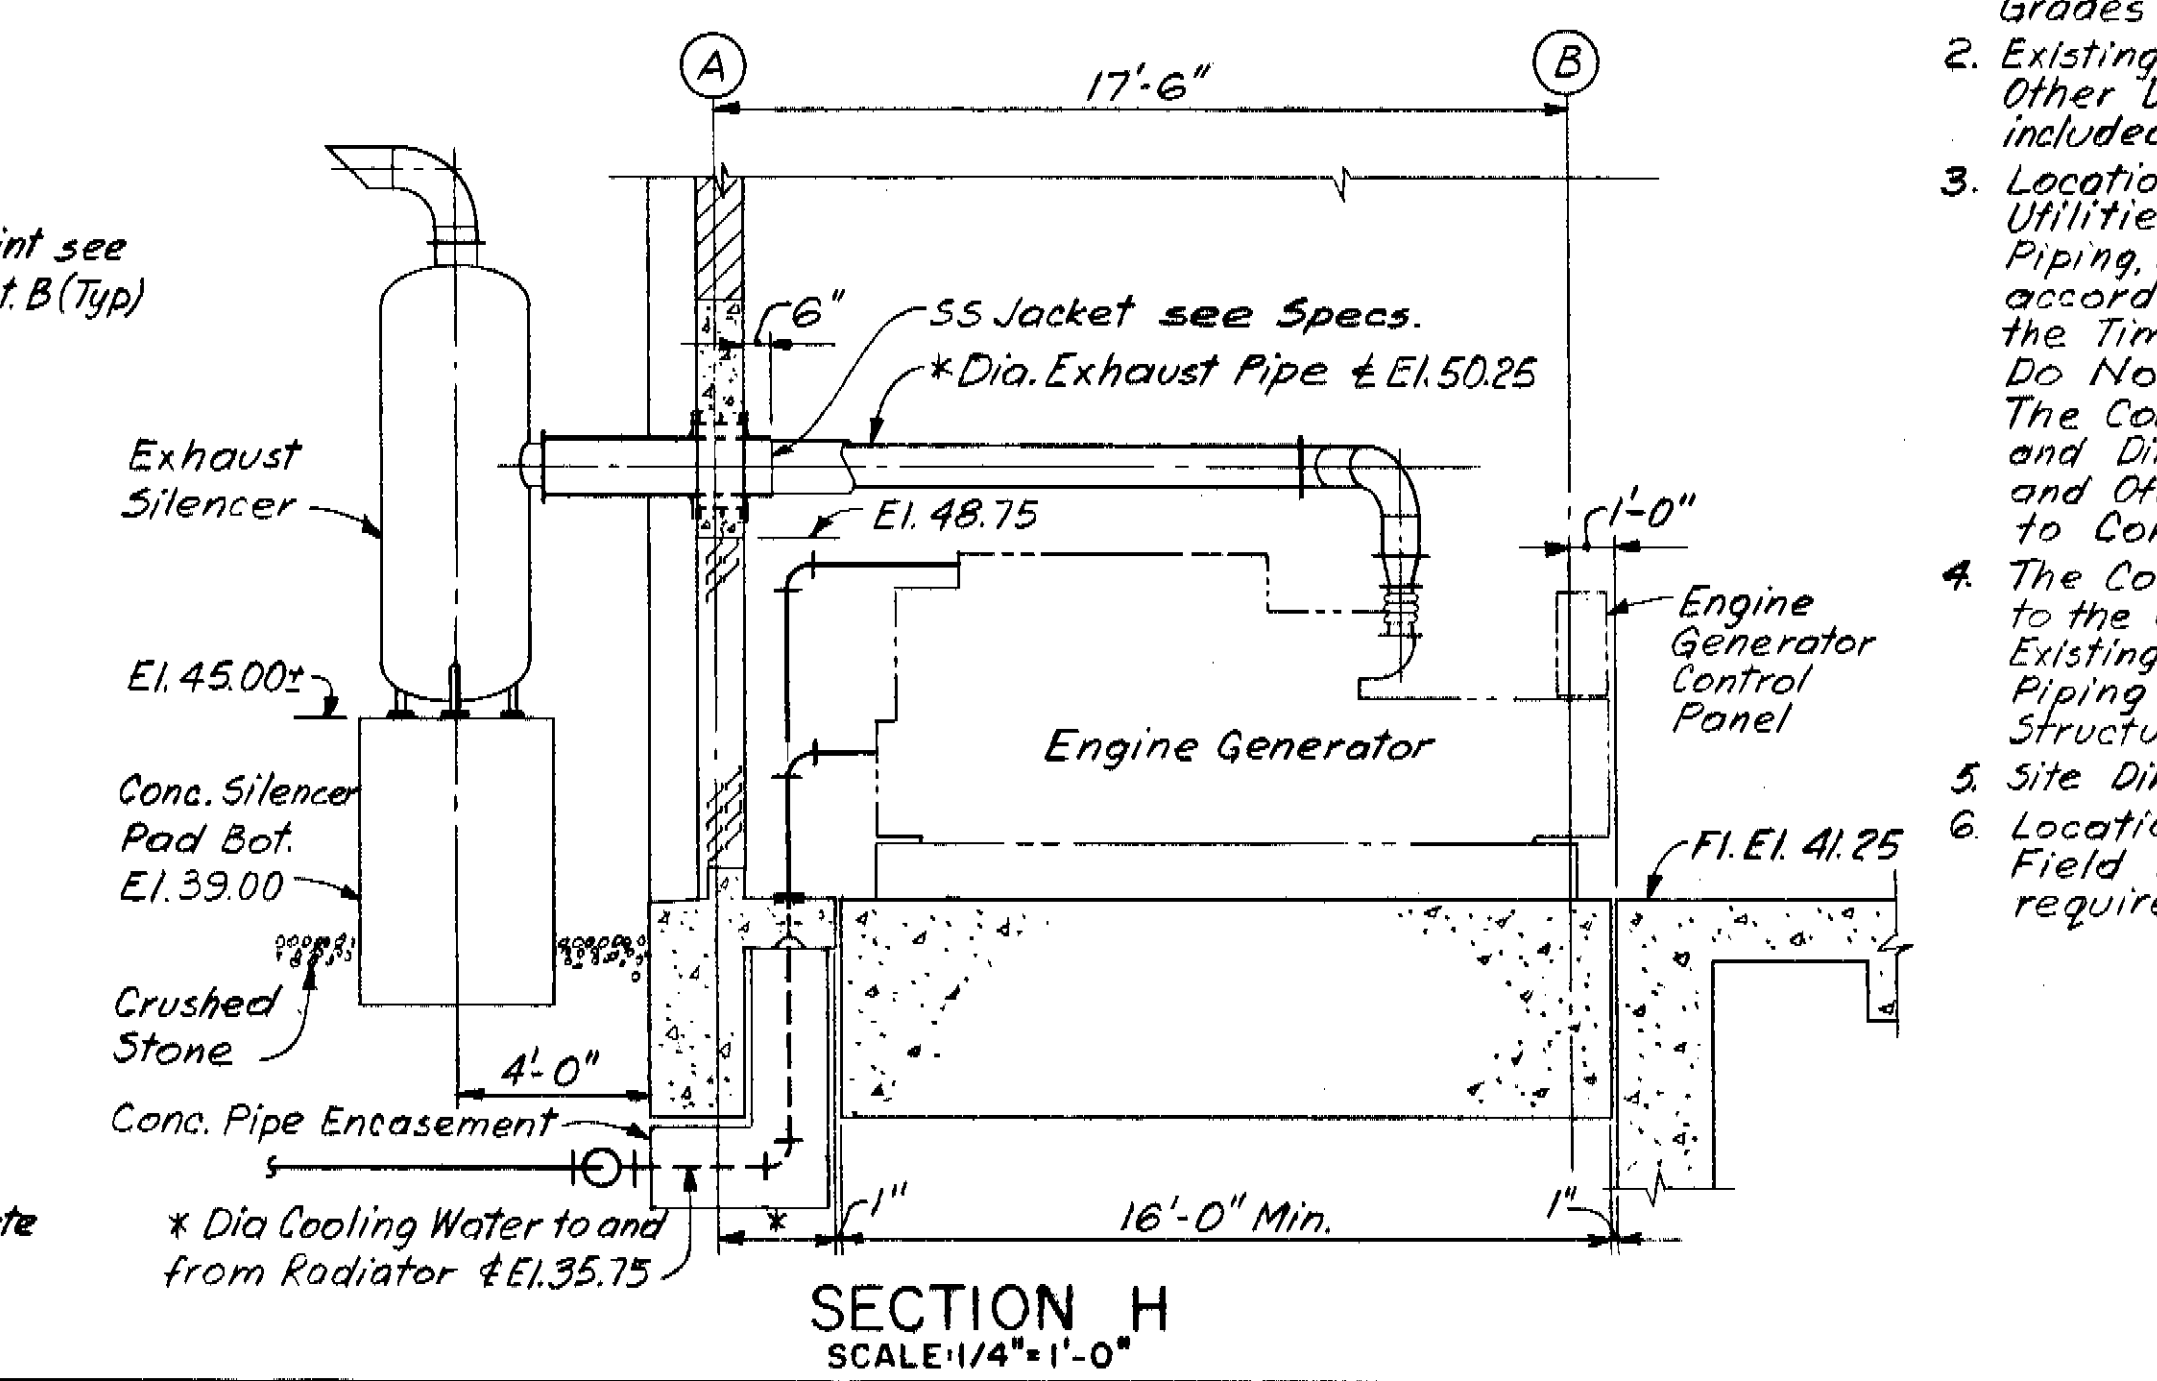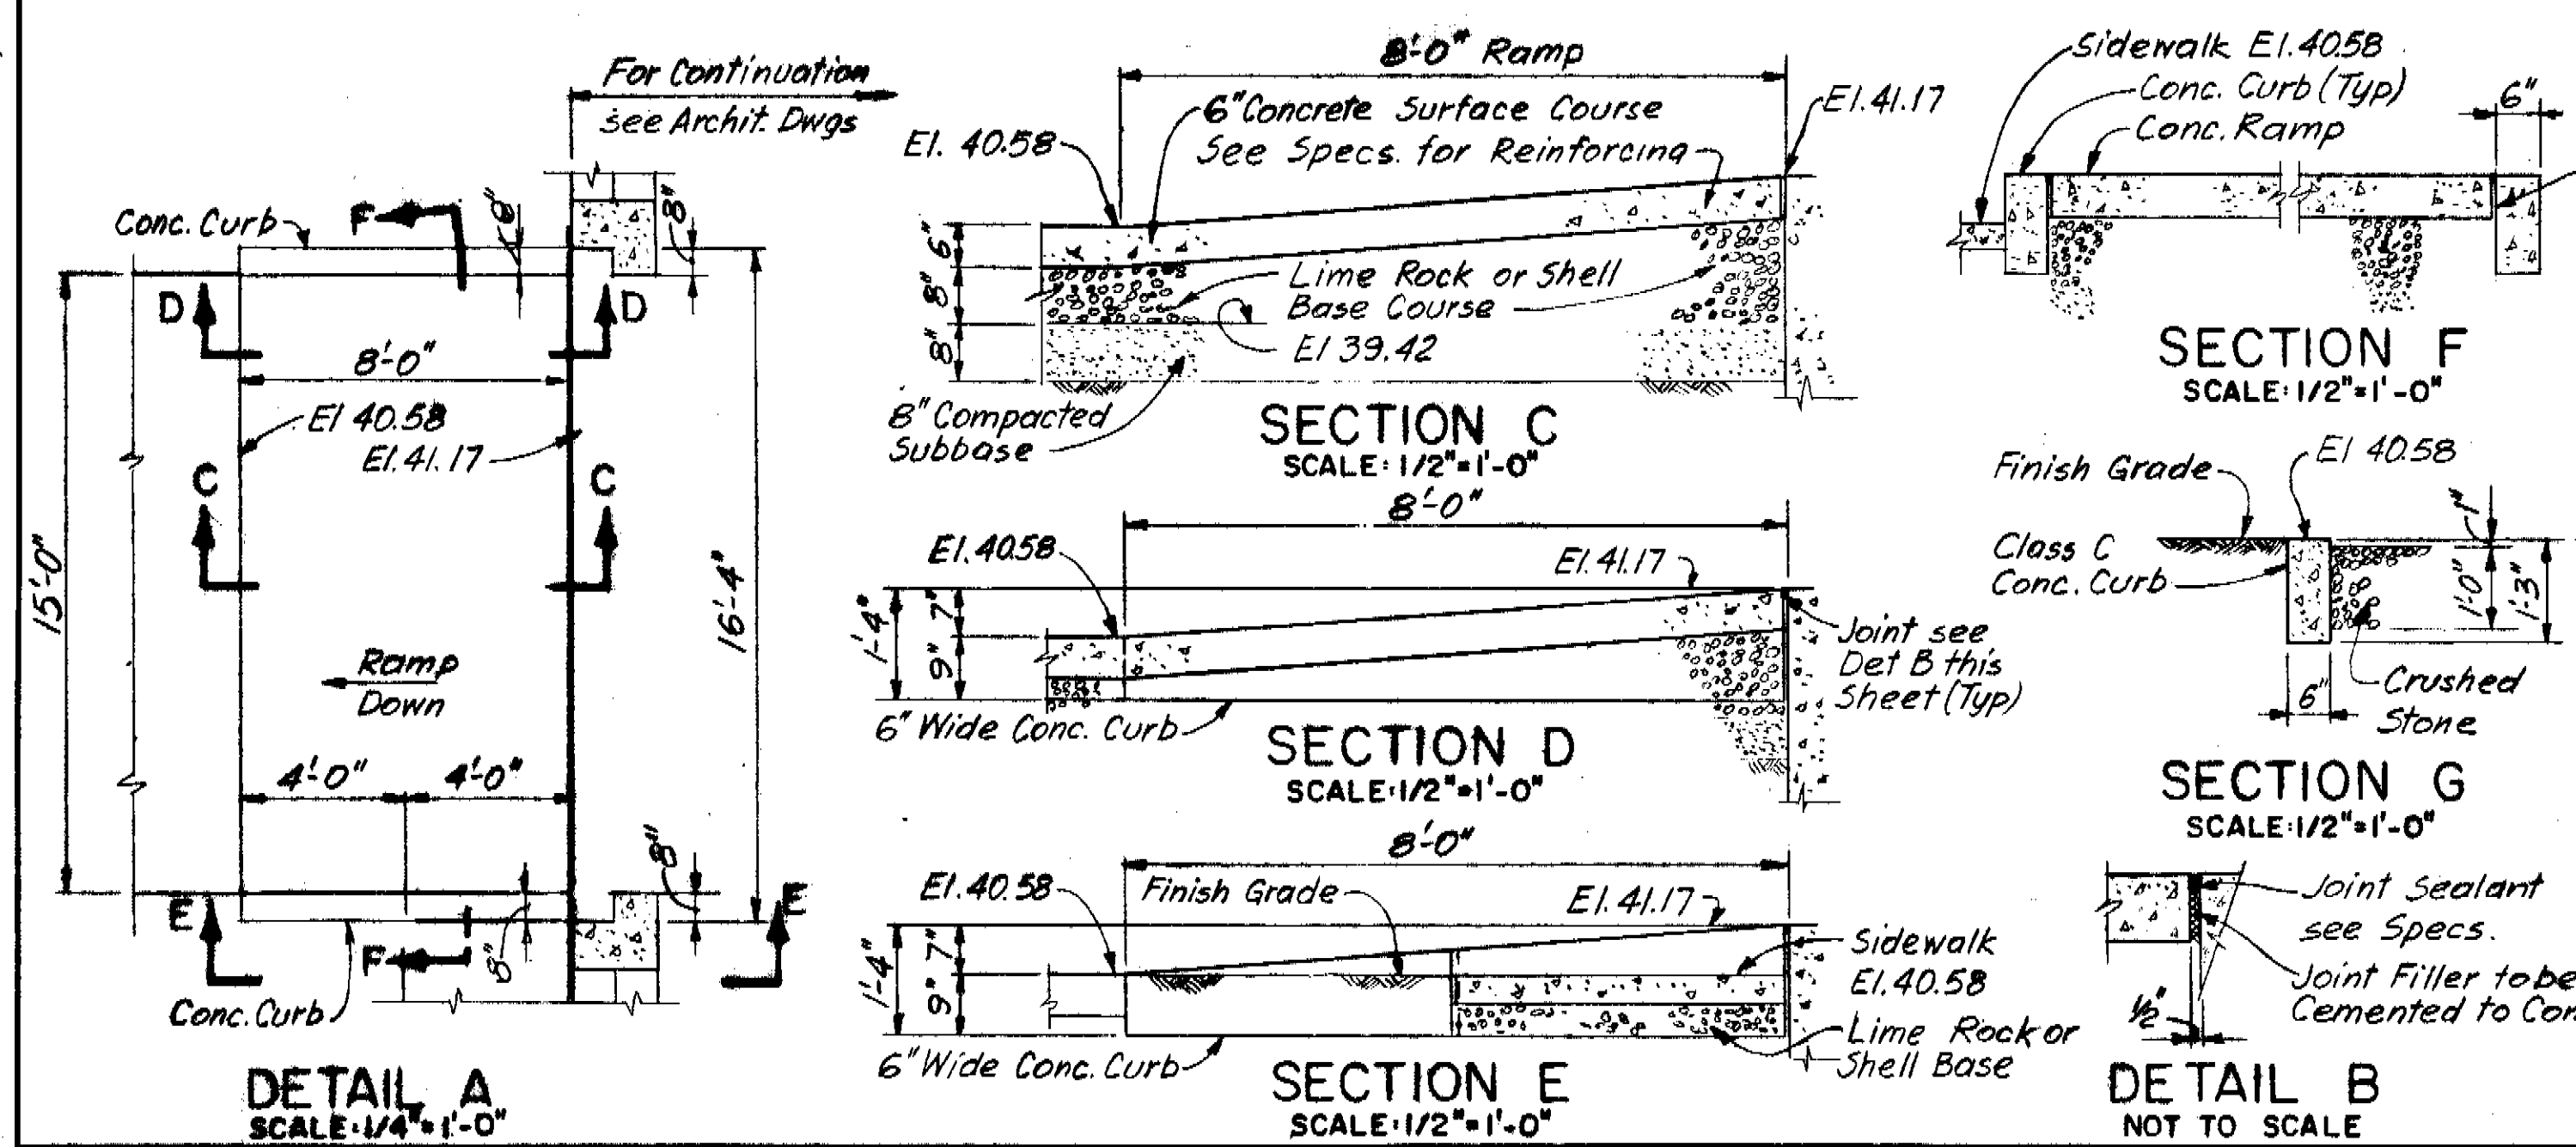

NOTE:


ALL ELEVATIONS SHOWN ARE REFERENCED TO CITY OF TAMPA DATUM. TO CONVERT TO NATIONAL OCEAN SURVEY (NOS) DATUM, SUBTRACT 0.15 FEET (0'-1 13/16").

RECORD DRAWING


THIS RECORD DRAWING IS NOT WARRANTED BUT IS BELIEVED TO REPRESENT CONDITIONS UPON COMPLETION OF CONSTRUCTION. WITHIN REASONABLE TOLERANCES BASED UPON THE INFORMATION FURNISHED TO THE ENGINEER PERTAINING TO CHANGES MADE DURING CONSTRUCTION.

GREELEY AND HANSEN ENGINEERS 222 S. RIVERSIDE PLAZA CHICAGO, ILLINOIS 60606	DESIGNED JBV	APPROVED	2 9/81 DSH Rec. Dwg. Revisions Δ Dec 78 Kel Added Addendum No. 1 Mar 78 JRP Plans Updated	SCALE 0 20 40 FT 1" = 20' 0 2 4 8 FT 1/4" = 1'-0" 0 1 2 3 4 5 FT 1/2" = 1'-0"	CITY OF TAMPA, FLORIDA SEWAGE DISPOSAL SYSTEM DIVISION 463 131 ST. AVENUE PUMPING STATION	EQUIPMENT SITE PLAN TOP FLOOR PLAN	PROJ. NO. 5 202-70-30D-7-463
	DRAWN KZK	DATE					SHEET 2 OF 35
	CHECKED JBV	DATE					DATE AUGUST, 1972 REV. 1

173-34

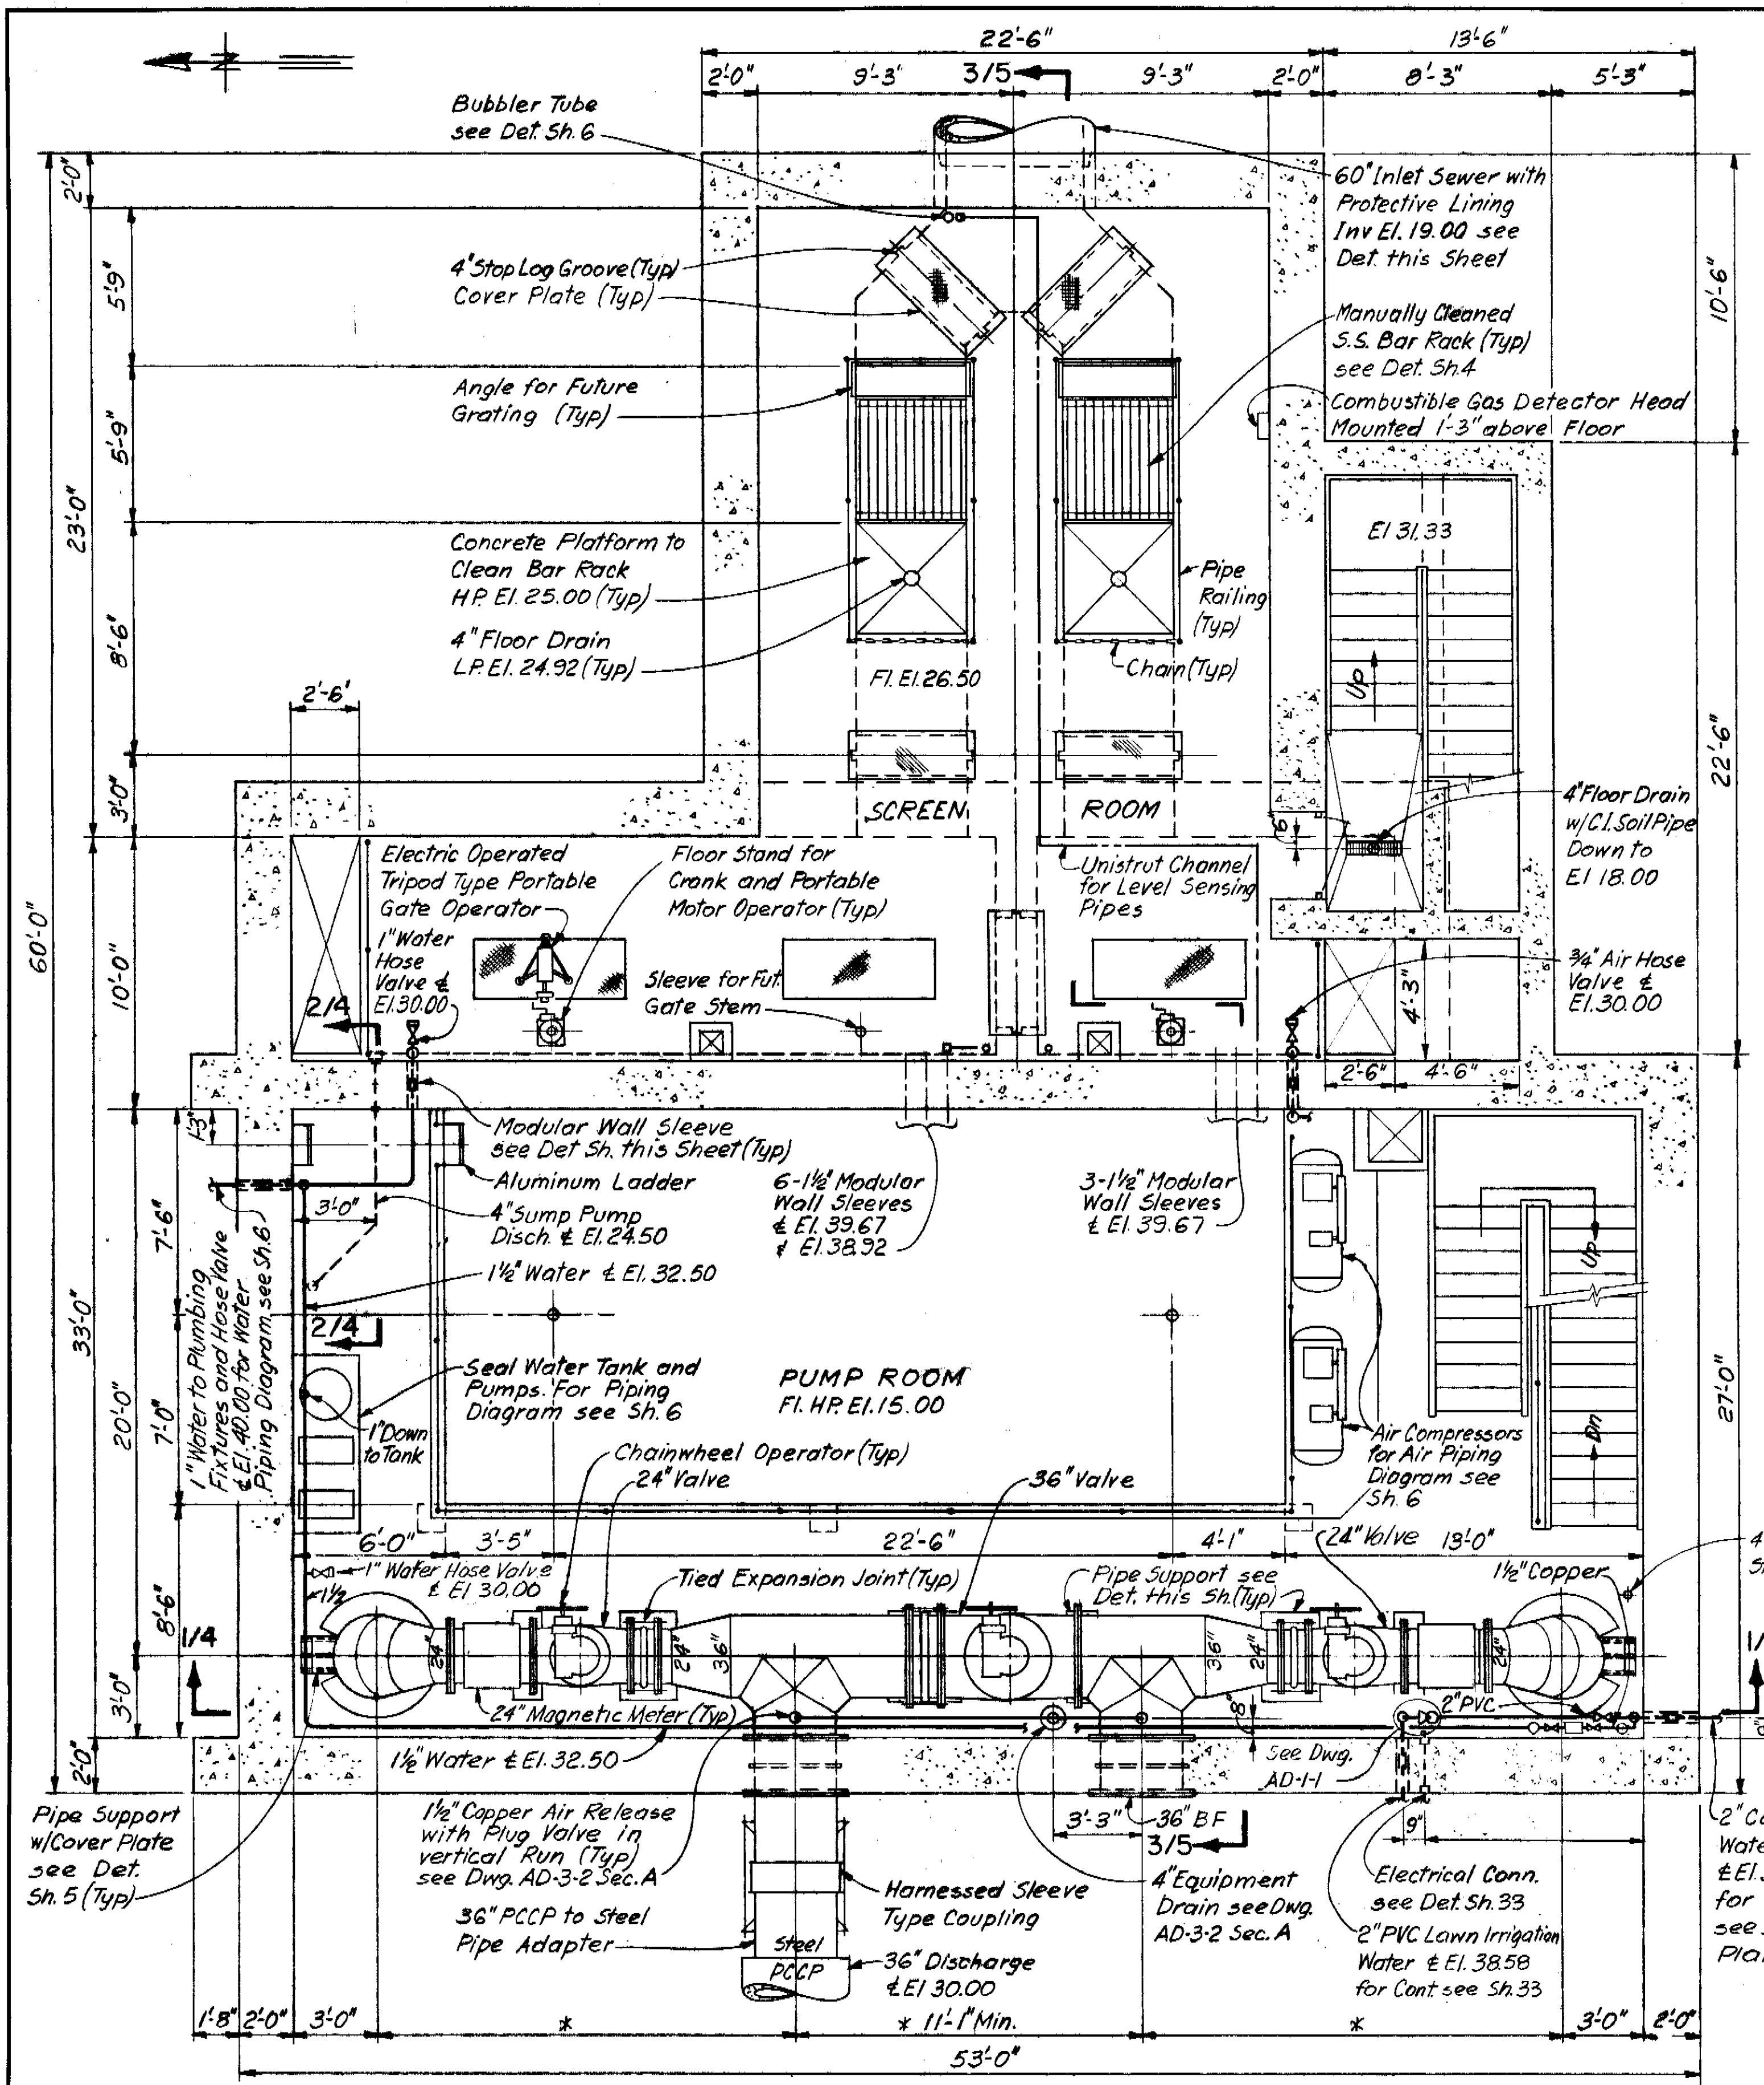

PLAN AT EL. 26.50
SCALE: 1/4" = 1'-0"

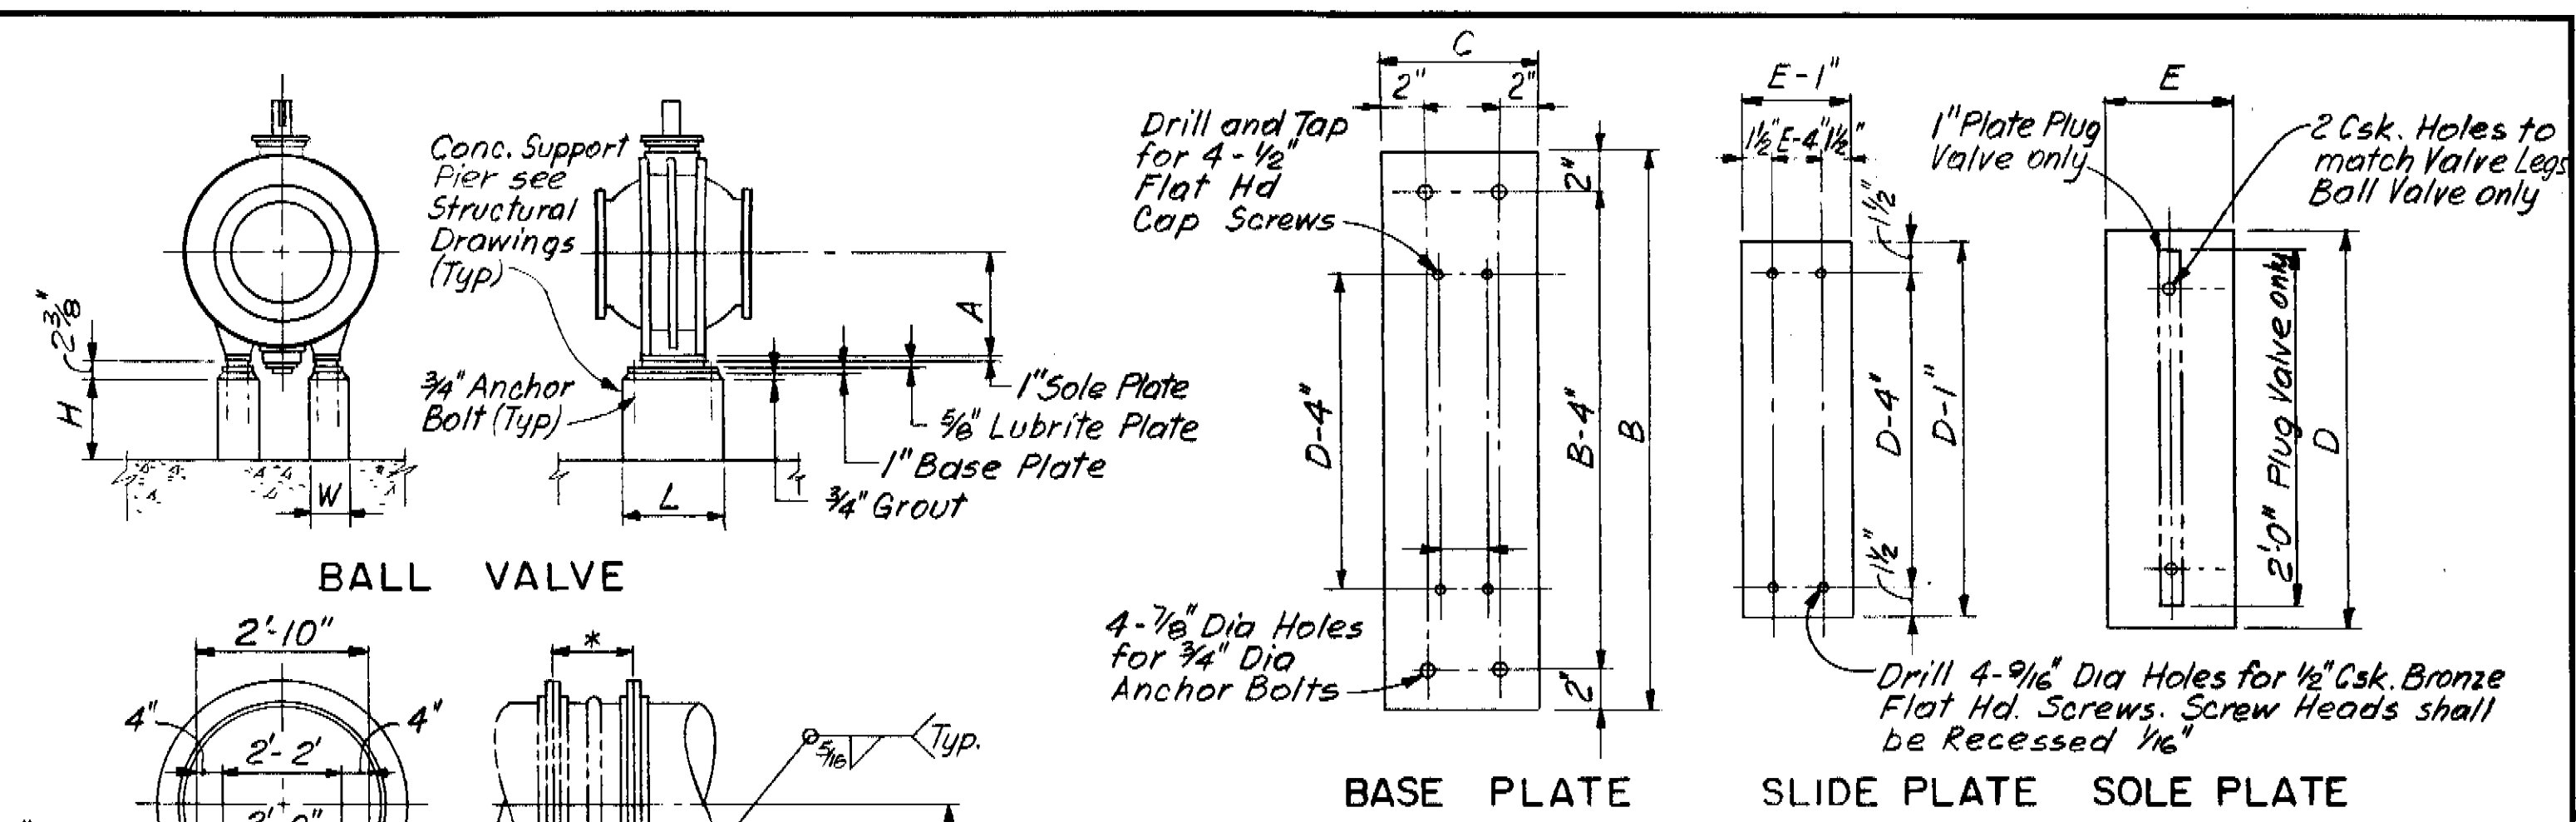



BALL VALVE SUPPORT DIMENSIONS

Valve size	±EI	Floor EI	Location	A	B	C	D	E	W	L	H	
24"	30.00	26.50	Top Disch. Header	2'-0 1/2"	1'-10 3/8"	6 1/2"	1'-2 3/8"	5 1/2"	1'-0"	-	2'-2 3/8"	1'-2 1/2"
30"	18.50	15.00	Low Disch. Hdr. & Pumps	2'-5 3/4"	2'-1 1/8"	7 1/2"	1'-5 1/8"	6 1/2"	1'-0"	-	2'-5 1/8"	1'-5 1/4"
36"	30.00	26.50	Top Disch. Header	2'-10 3/4"	2'-3 3/4"	7 1/2"	1'-7 1/8"	6 1/2"	1'-0"	-	2'-7 3/4"	3 3/8"

PLUG VALVE AND EXP. JOINT SUPPORT DIMENSIONS


Valve size	±EI	Floor EI	Location	A	B	C	D	E	W	L	H	
24"	30.00	26.50	Top Disch. Header	1'-6"	2'-1 1/2"	10"	2'-2"	10"	1'-2"	*	3'-2"	1'-8 5/8"
30"	18.50	15.00	Low Disch. Hdr. & Pumps	1'-9 3/8"	2'-10"	10"	2'-2"	10"	1'-2"	*	3'-2"	1'-5 1/4"
36"	18.50	15.00	Low Disch. Hdr. & Pumps	2'-1"	2'-10"	10"	2'-2"	10"	-	*	3'-2"	1'-1 3/4"
36"	30.00	26.50	Top Disch. Header	2'-1"	2'-10"	10"	2'-2"	10"	1'-2"	*	3'-2"	1'-1 3/8"

NOTES: 1. * Dimensions shall be determined after Final Selection of Equipment.
2. Plug Valves, Ball Valves or Cone Valves may be used. Ball Valves shall have Single Seats unless shown otherwise.
3. For Cone Valve Support Details see Sh. 5

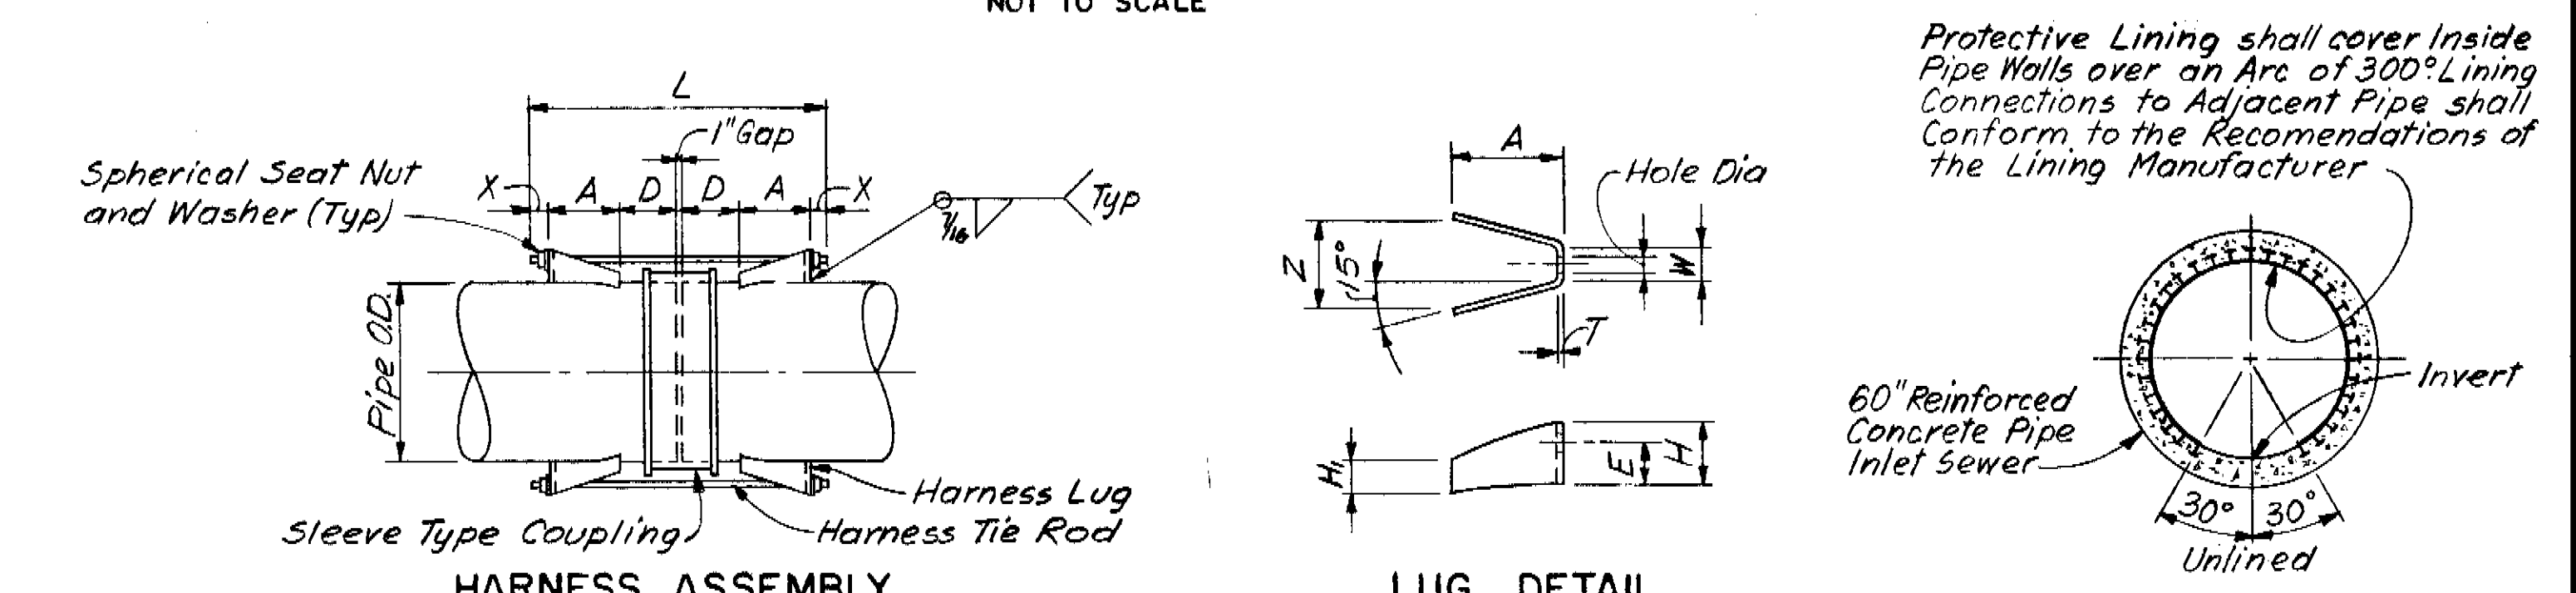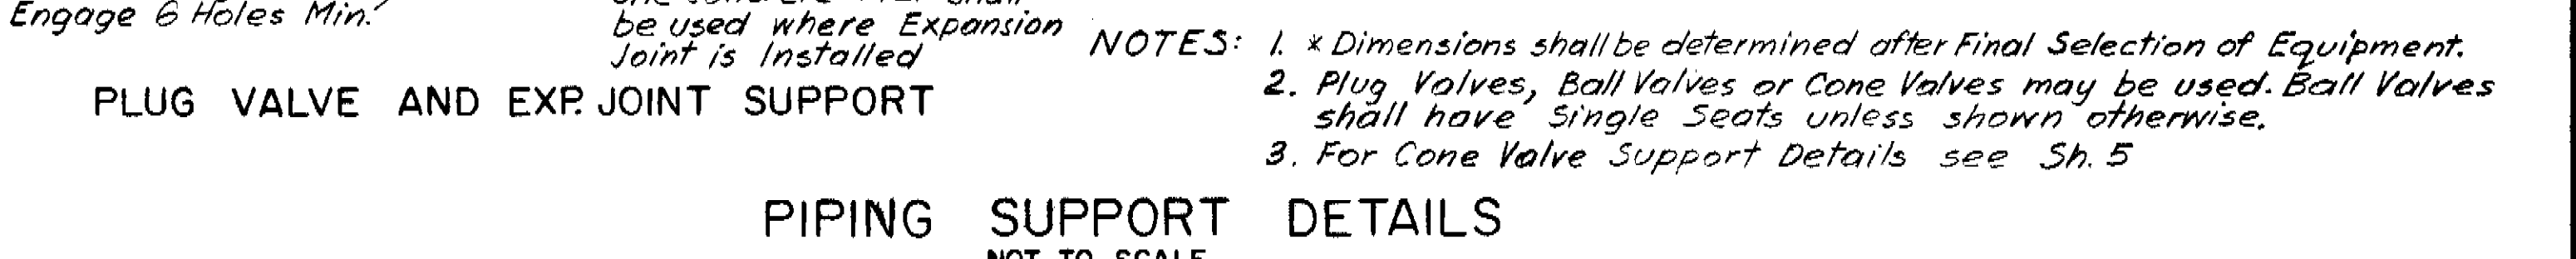

MODULAR WALL SLEEVE SEALING SCHEDULE

SERVICE	NOM. SIZE	PIPE OD, IN.	NOM. SLEEVE I.D., IN.	SLEEVE L, IN.	LINK SEAL MODEL	LINKS PER FEET	CARRIER PIPE MATERIAL
Lawn Irrigation Supp.	2"	2.375"	4"	4.026"	LS300C	6	PVC
Level Sensing	3/8"	0.5"	1 1/8"	1.610"	LS200C	3	Copper
Air	3/4"	0.875"	2"	2.067"	LS200C	4	Copper
Water Hose Pipe	1"	1.125"	2 1/2"	2.469"	LS200C	5	Copper
Fuel Oil Return	1"	1.315"	2 1/2"	2.469"	LS200C	5	Steel
Fuel Oil Supply	2"	2.375"	4"	4.026"	LS300C	6	Steel
City Water Main	2"	2.125"	3 1/2"	3.549"	LS300C	5	Copper

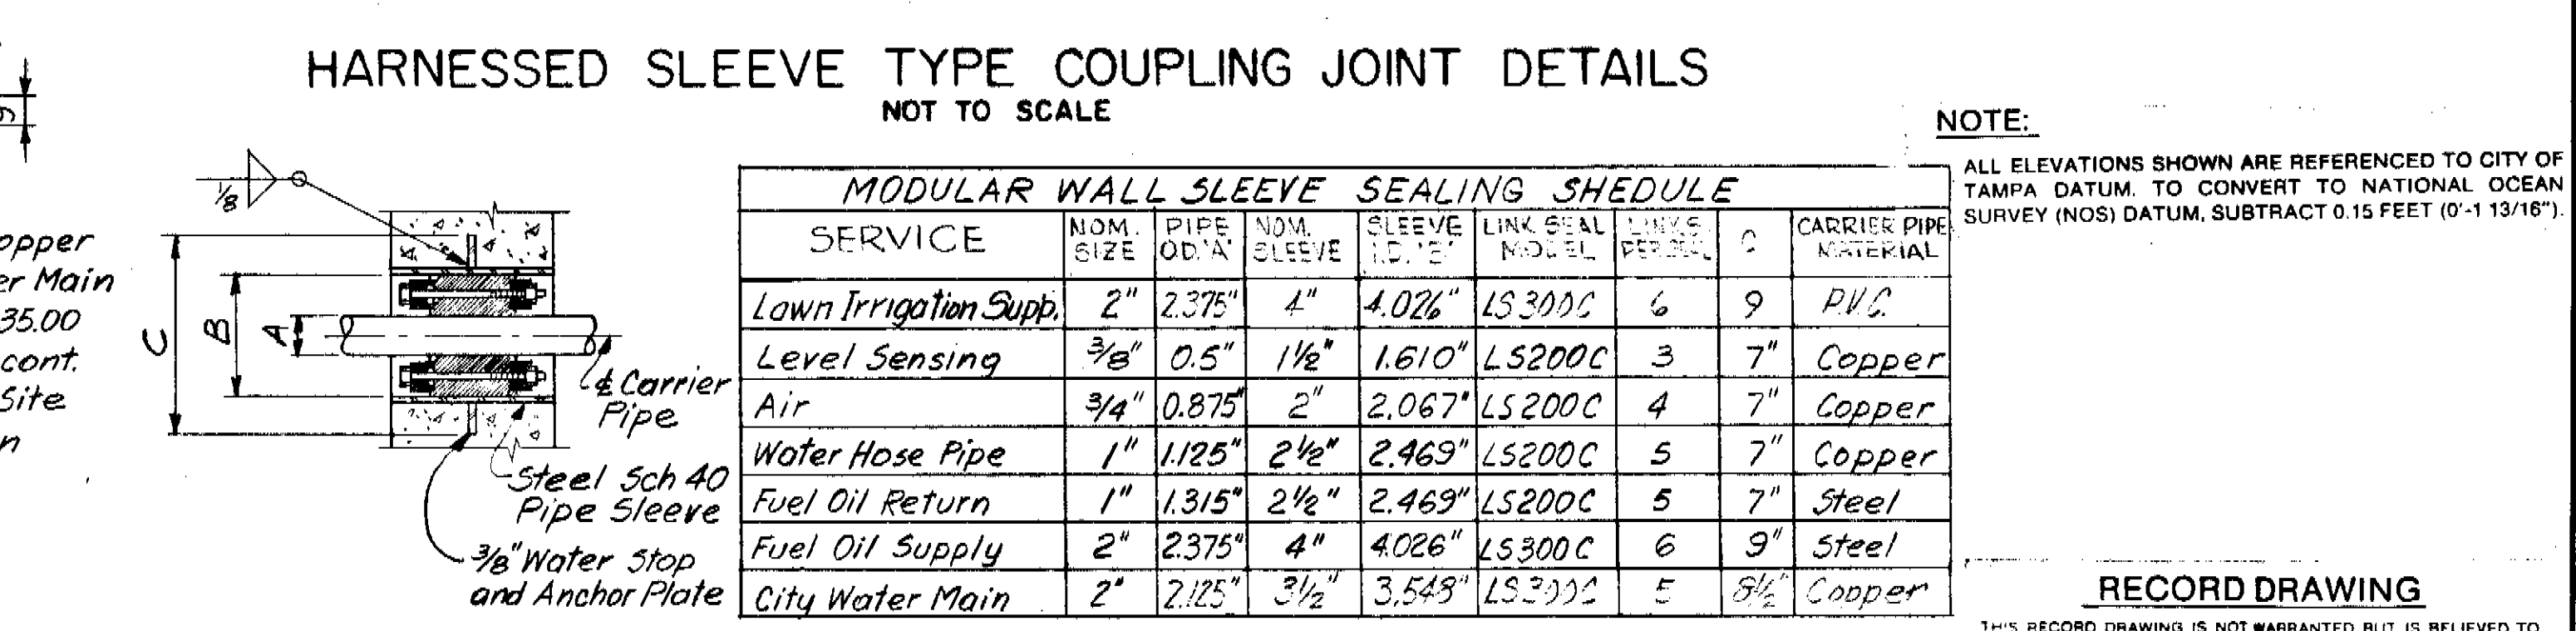

RECORD DRAWING


THIS RECORD DRAWING IS NOT WARRANTED BUT IS BELIEVED TO REPRESENT CONDITIONS UPON COMPLETION OF CONSTRUCTION WITHIN REASONABLE TOLERANCES BASED UPON THE INFORMATION FURNISHED TO THE ENGINEER PERTAINING TO CHANGES MADE DURING CONSTRUCTION.

GREELEY AND HANSEN ENGINEERS
222 S. RIVERSIDE PLAZA
CHICAGO, ILLINOIS 60606

DESIGNED JBV
DRAWN LPD, KZK
CHECKED JBV

APPROVED

NO.	DATE	APP.	REVISION
2	9/81	DSH	Rec. Dwg. Revisions
1	Dec 78	KEV	Added Addendum No. 1 & 3
	Mar 78	JRP	Plans Updated

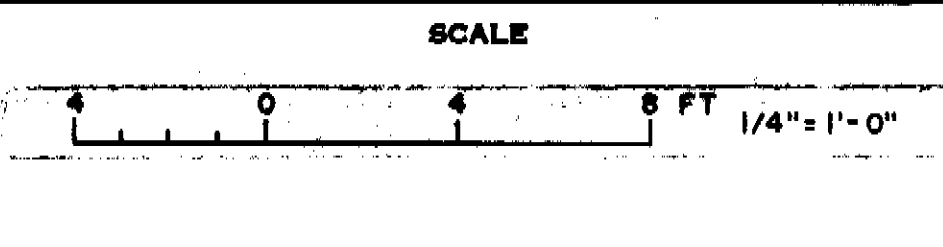


CITY OF TAMPA, FLORIDA
SEWAGE DISPOSAL SYSTEM
DIVISION 4G3
131 ST. AVENUE PUMPING STATION


EQUIPMENT INTERMEDIATE FLOOR PLAN DETAILS

PROJ. NO. 5 202-70-300-7-463
SHEET 3 OF 35
DATE: AUGUST, 1972 REV. 1


173-140

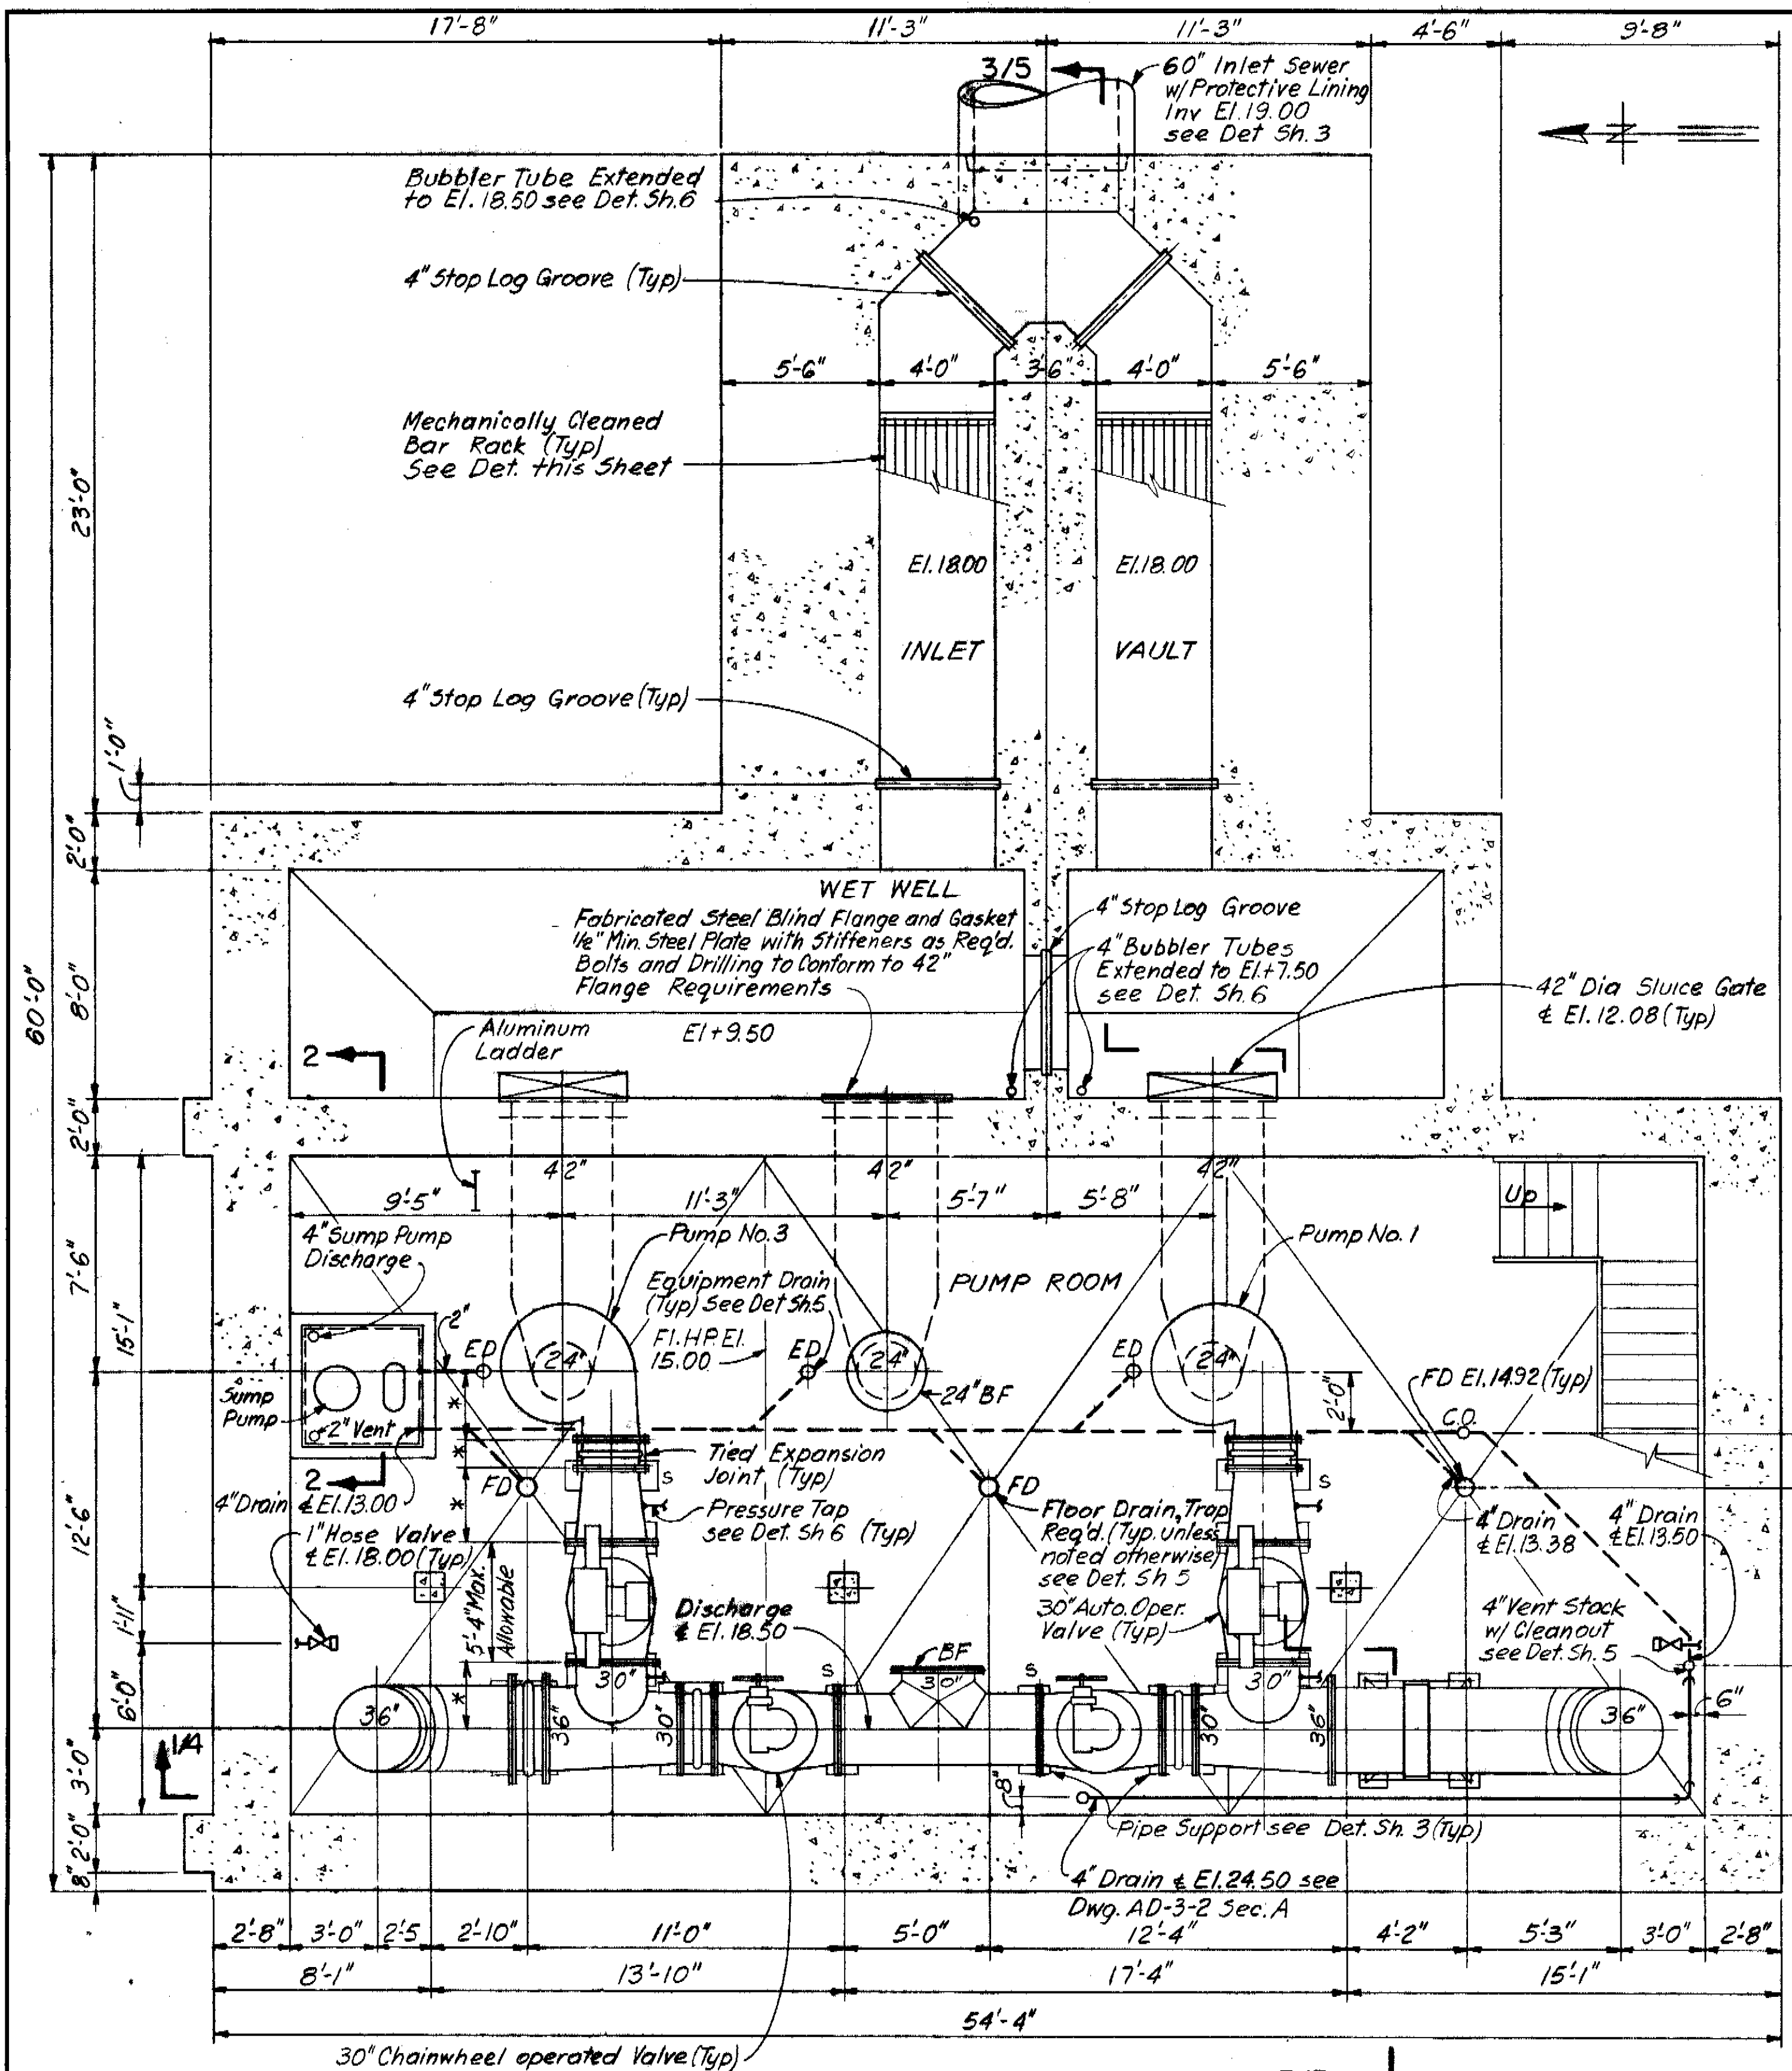

PLAN AT EL 15.00
SCALE: 1/4" = 1'-0"

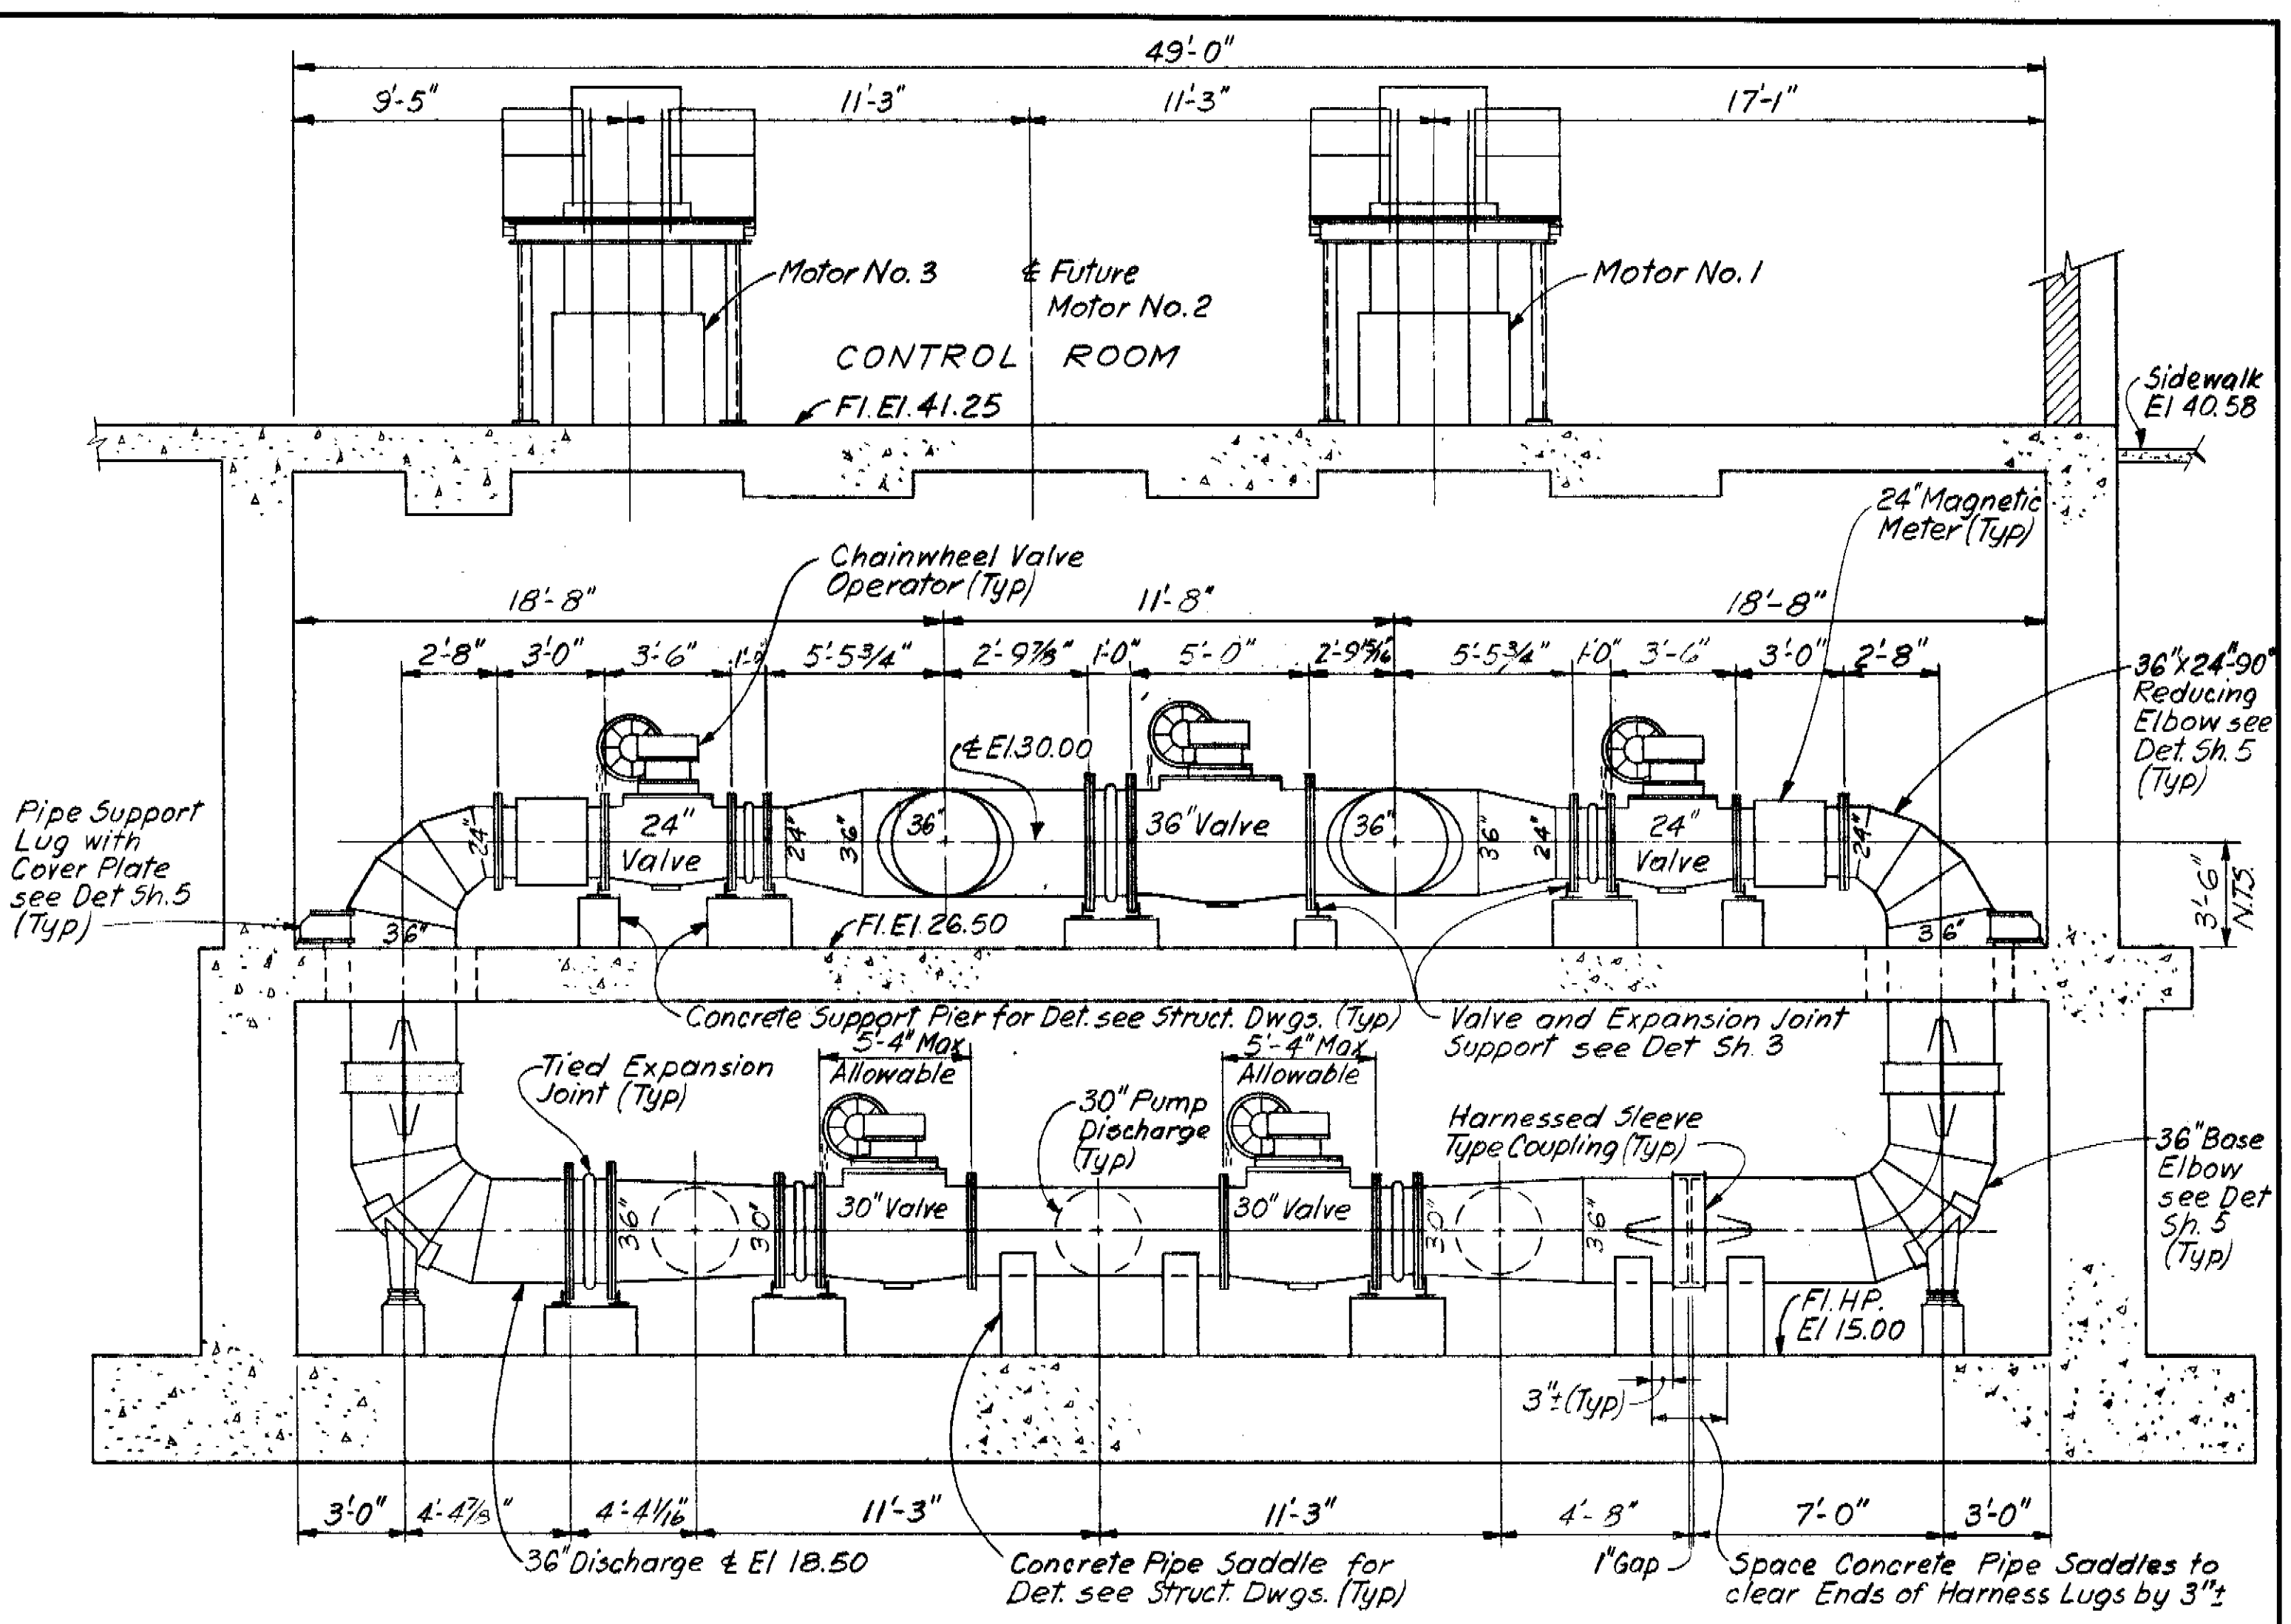

SECTION 1/3,4
SCALE: 1/4" = 1'-0"

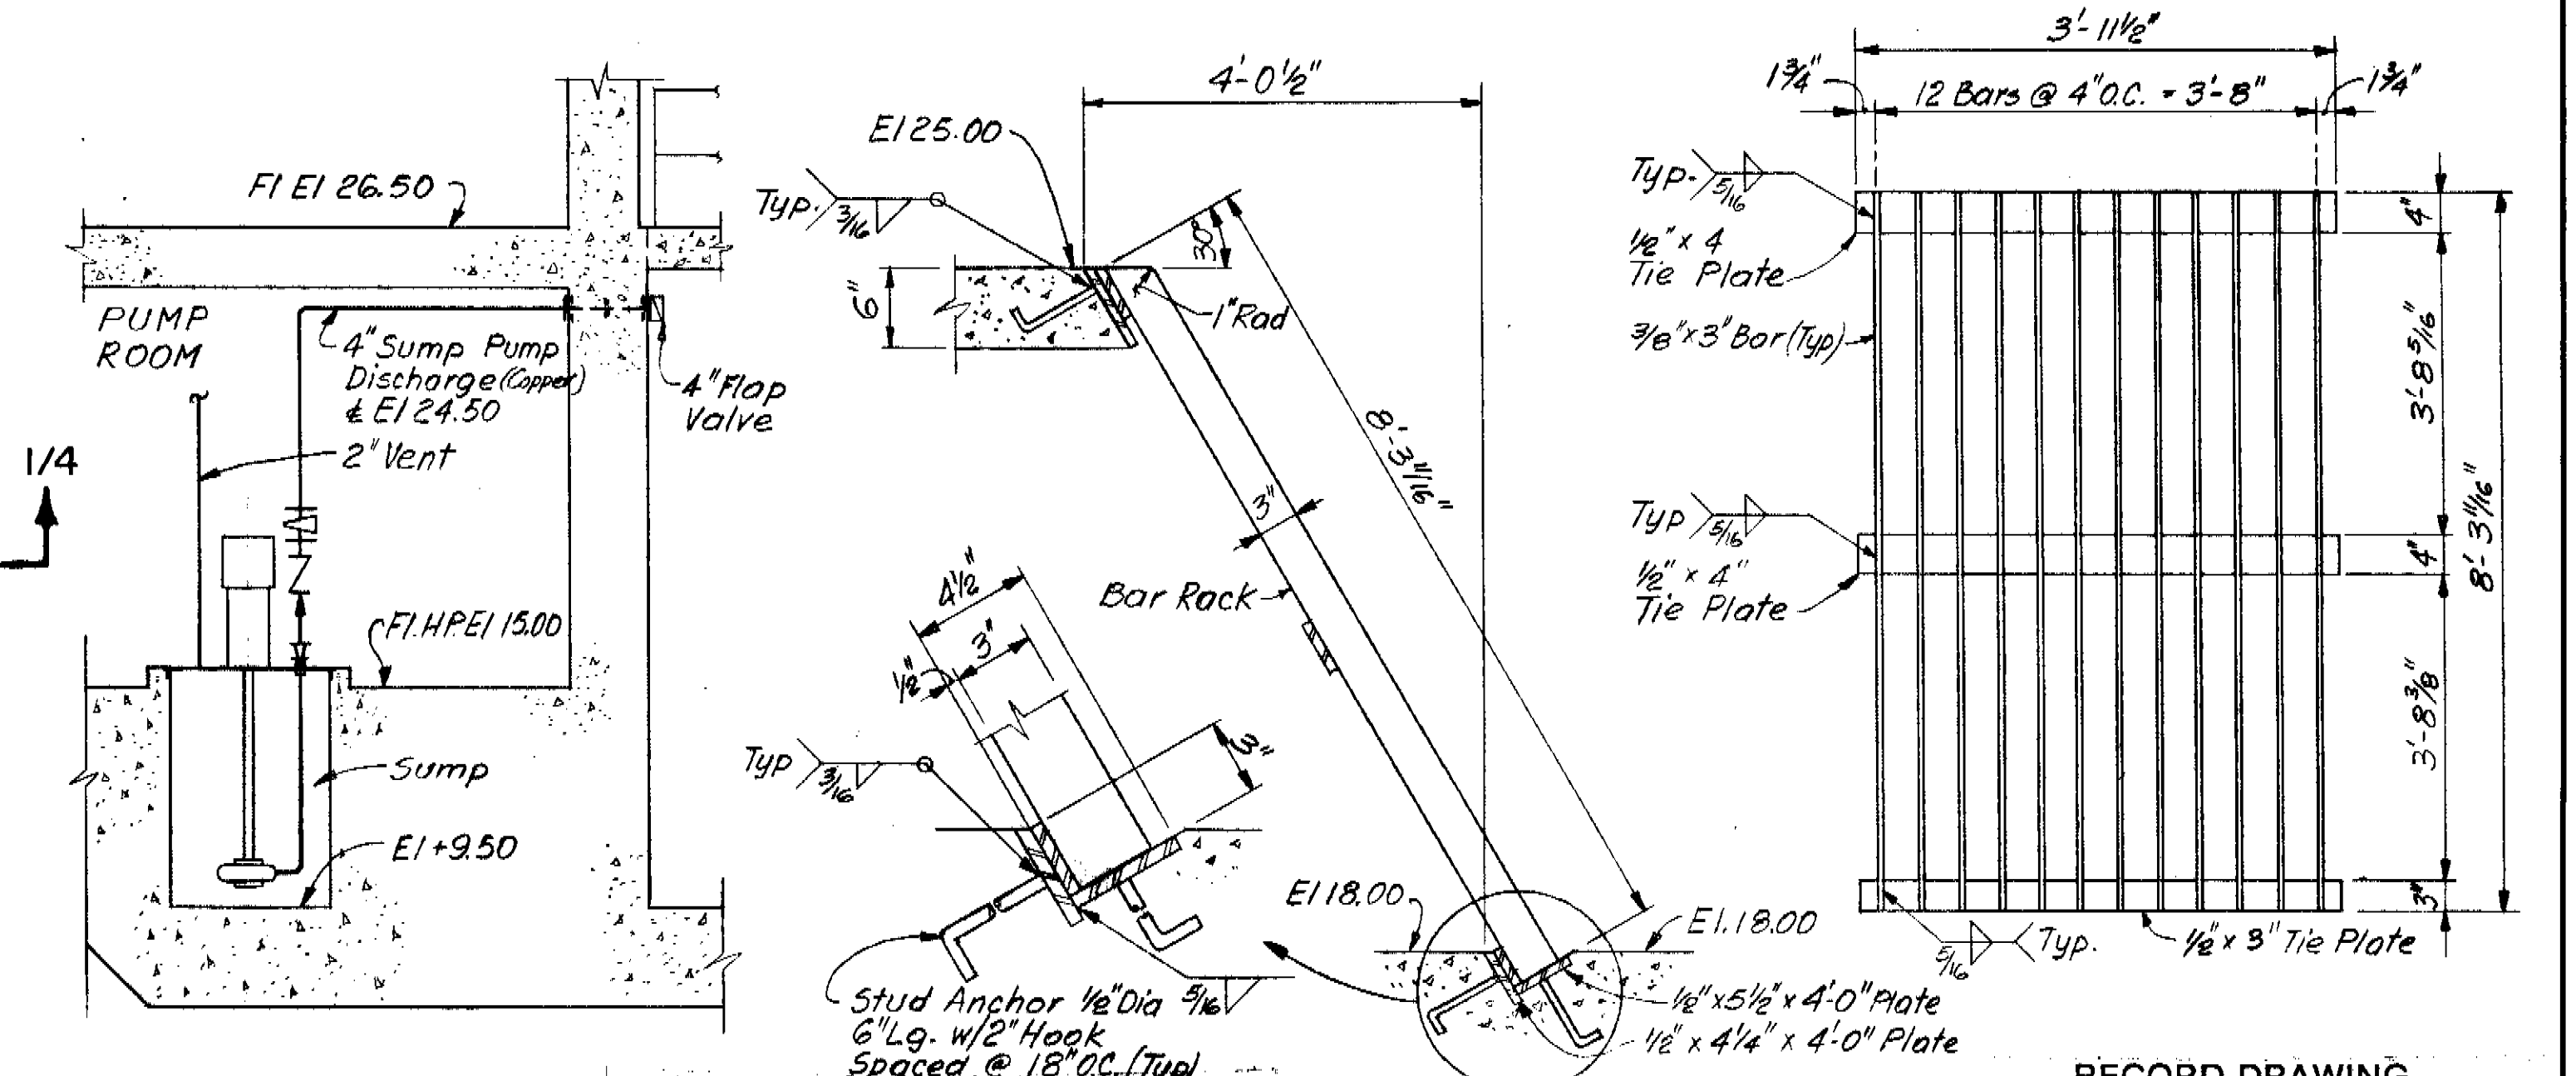

SECTION 2/3,4
SCALE: 1/4" = 1'-0"

BAR RACK DETAILS
NOT TO SCALE


NOTE: ALL ELEVATIONS SHOWN ARE REFERENCED TO CITY OF TAMPA DATUM. TO CONVERT TO NATIONAL OCEAN SURVEY (NOS) DATUM, SUBTRACT 0.15 FEET (0'-1 13/16").

GREELEY AND HANSEN
ENGINEERS
222 S. RIVERSIDE PLAZA
CHICAGO, ILLINOIS 60606

DESIGNED JBV
DRAWN LPD, KZK
CHECKED JBV

APPROVED
DATE
Supt., Dept. of Sanitary Sewers
DATE
GREELEY AND HANSEN, ENGINEERS

NO.	DATE	APP.	REVISION
2	9/81	DSH	Rec. Dwg. Revisions
1	Dec 78	ve	Added Addendum No. 3
	Mar 79	JRP	Plans Updated



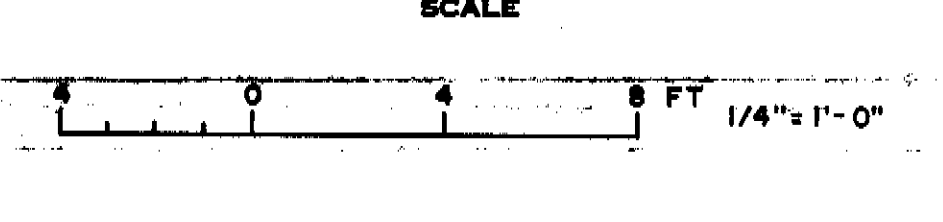


CITY OF TAMPA, FLORIDA
SEWAGE DISPOSAL SYSTEM
DIVISION 463
131 ST. AVENUE PUMPING STATION

EQUIPMENT
LOWER FLOOR PLAN
SECTIONS AND DETAILS

PROJ. NO. S 202-70-30D-7-463
SHEET 4 OF 35
DATE AUGUST, 1972 REV. 1







173-141

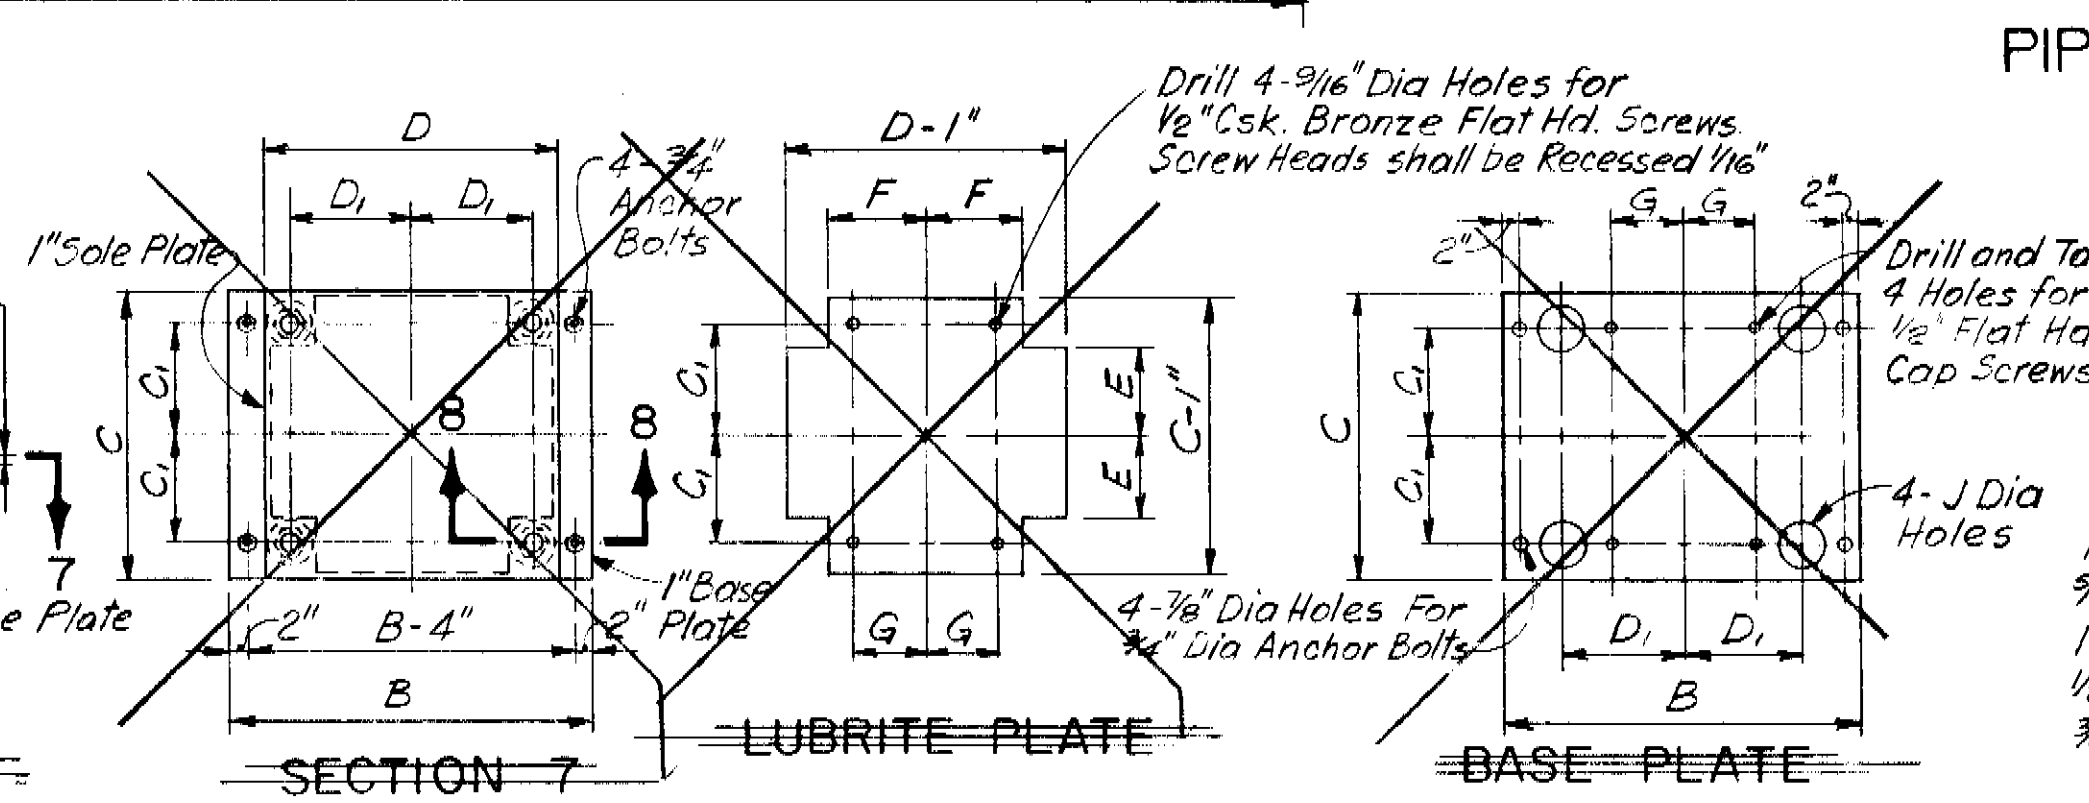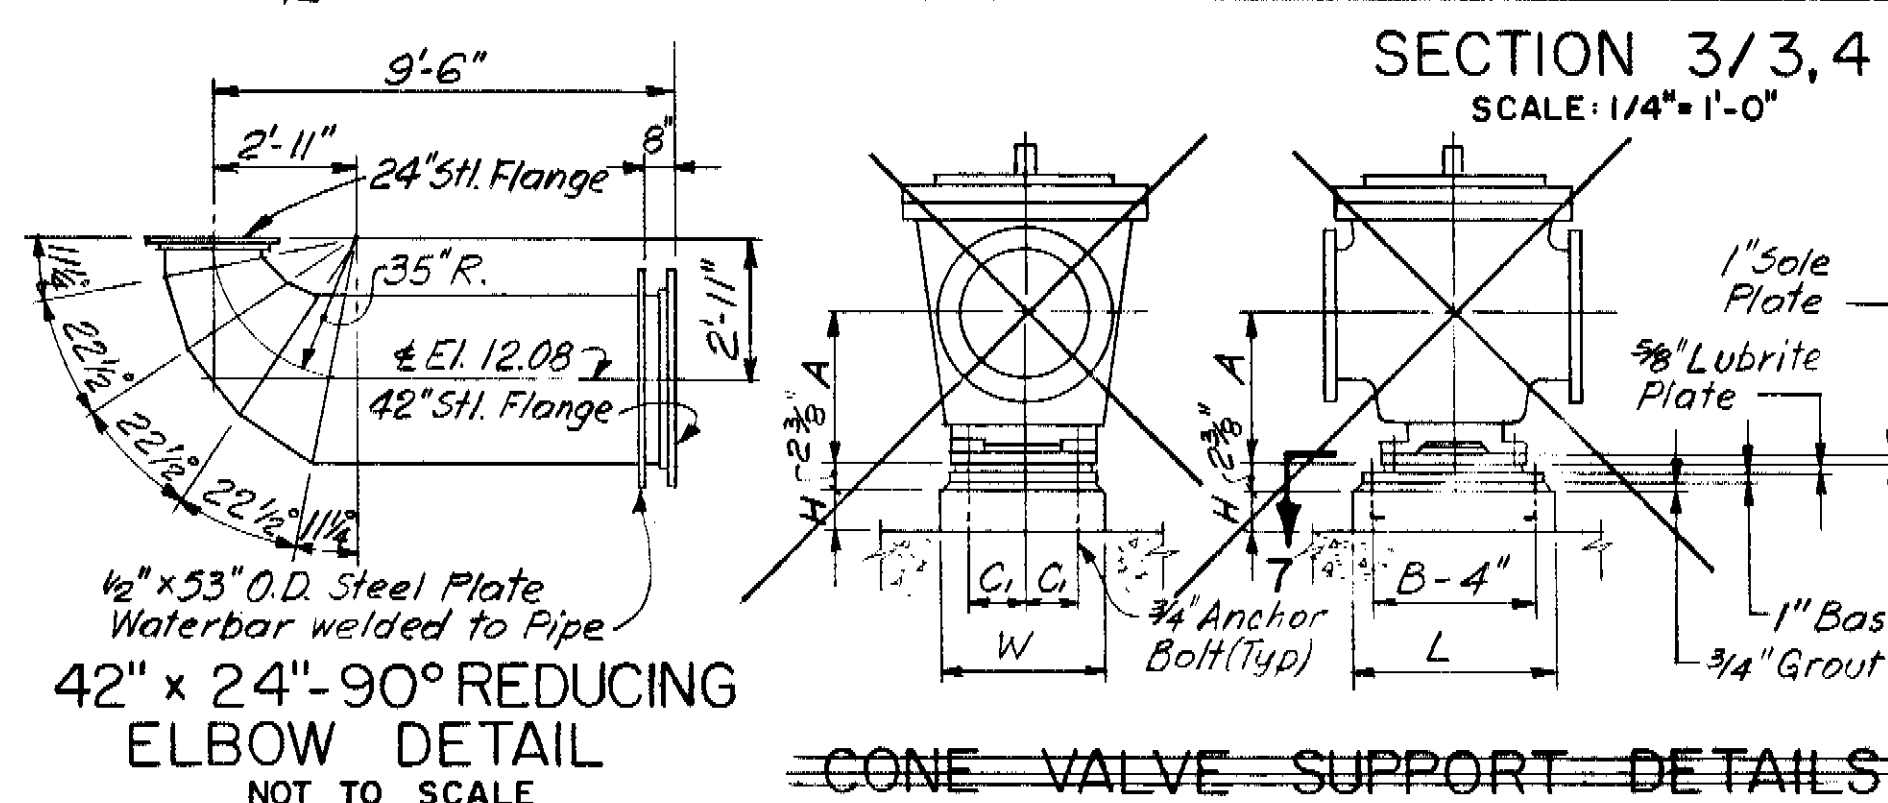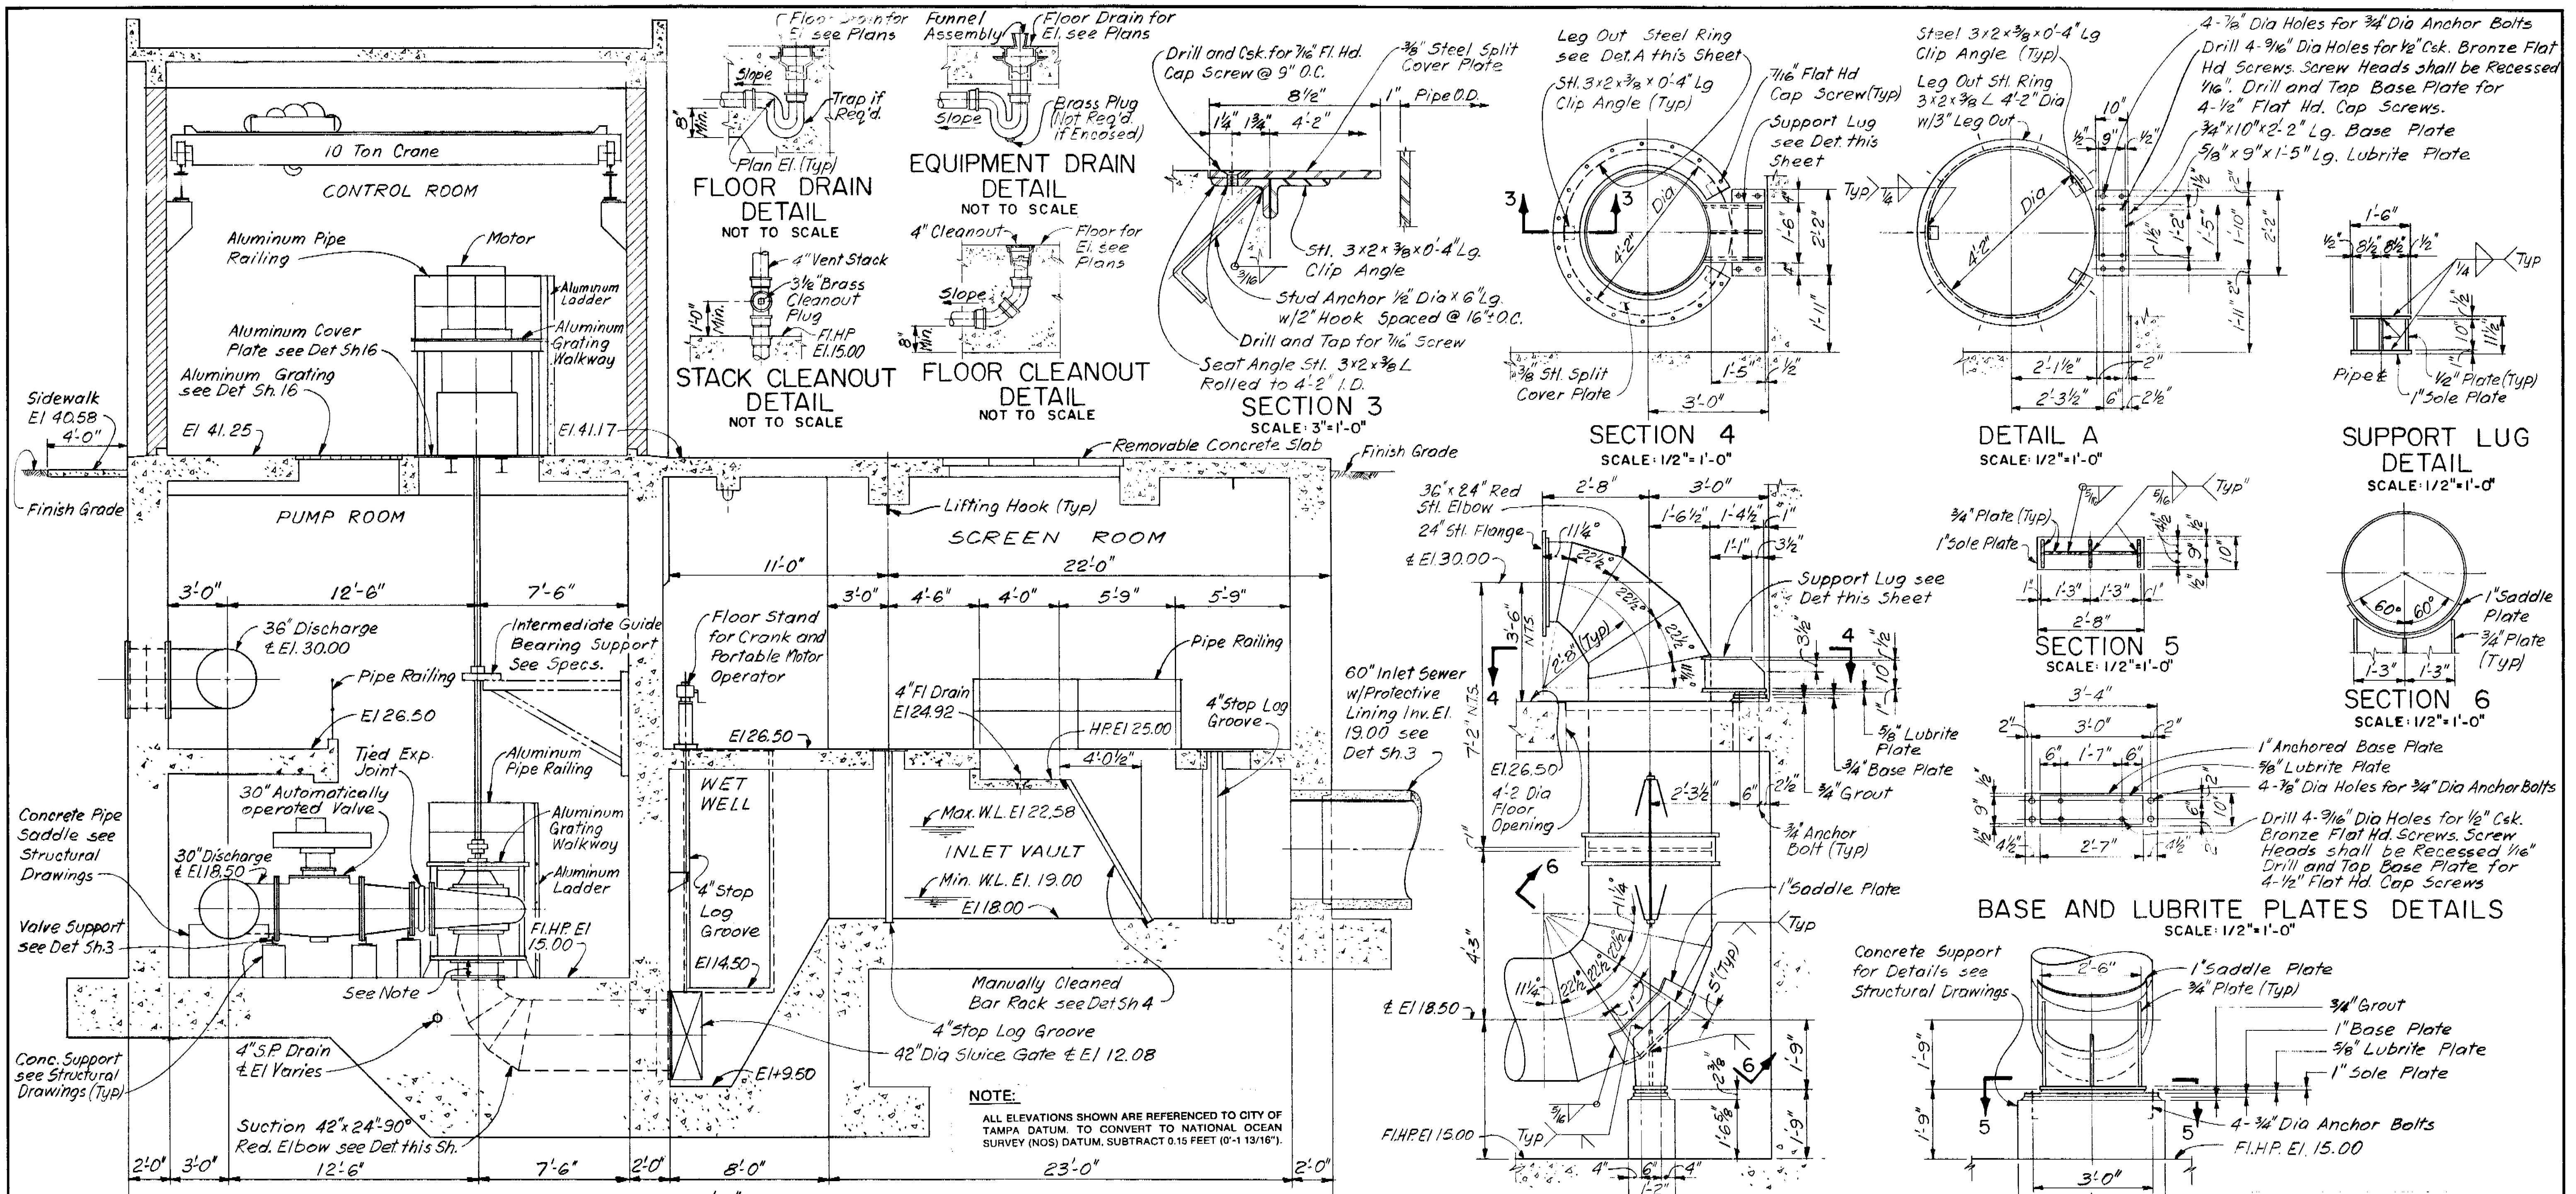


CONE VALVE SUPPORT DIMENSIONS Deleted see Dwg AD-3-3

Valve Size	£ EI	Floor EI	Location	A	B	C	C ₁	D	D ₁	E	F	G	W	L	H	J Hole	K Bolt
24"	30.00	26.50	Top Disch. Header	2'-0"	3'-4"	1'-5"	8"	2'-7 1/2"	1'-2"	5 1/2"	11 1/2"	3"	2'-0"	4'-0"	1'-2"	4"	1 1/2"
30"	18.50	15.00	Low Disch. Hdr & Pumps	2'-10"	3'-2"	2'-6"	10"	2'-6"	1'-0 1/2"	7"	9 1/2"	6 1/2"	2'-10"	3'-10"	4 3/8"	5"	2"
36"	30.00	26.50	Top Dish. Header	2'-11 1/2"	3'-3"	2'-11 1/2"	1'-11 1/2"	3'-0"	1'-3"	10 1/2"	1'-0"	9"	3'-4"	4'-4"	3 1/8"	5"	2"

173-42

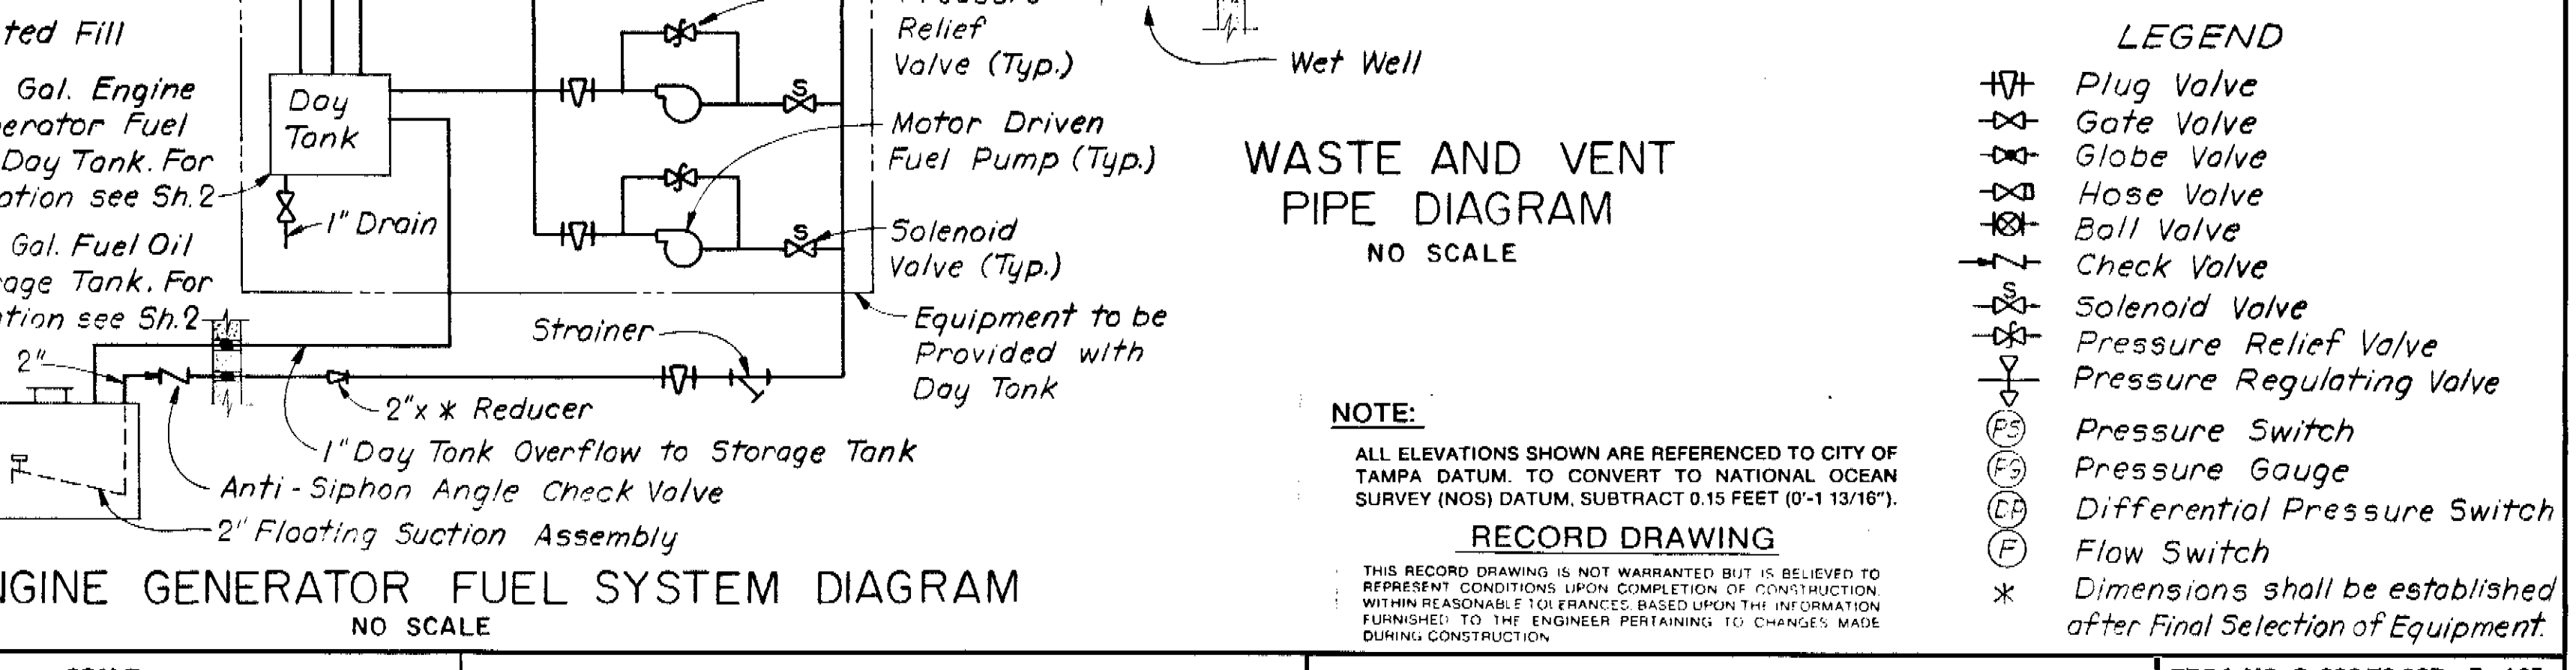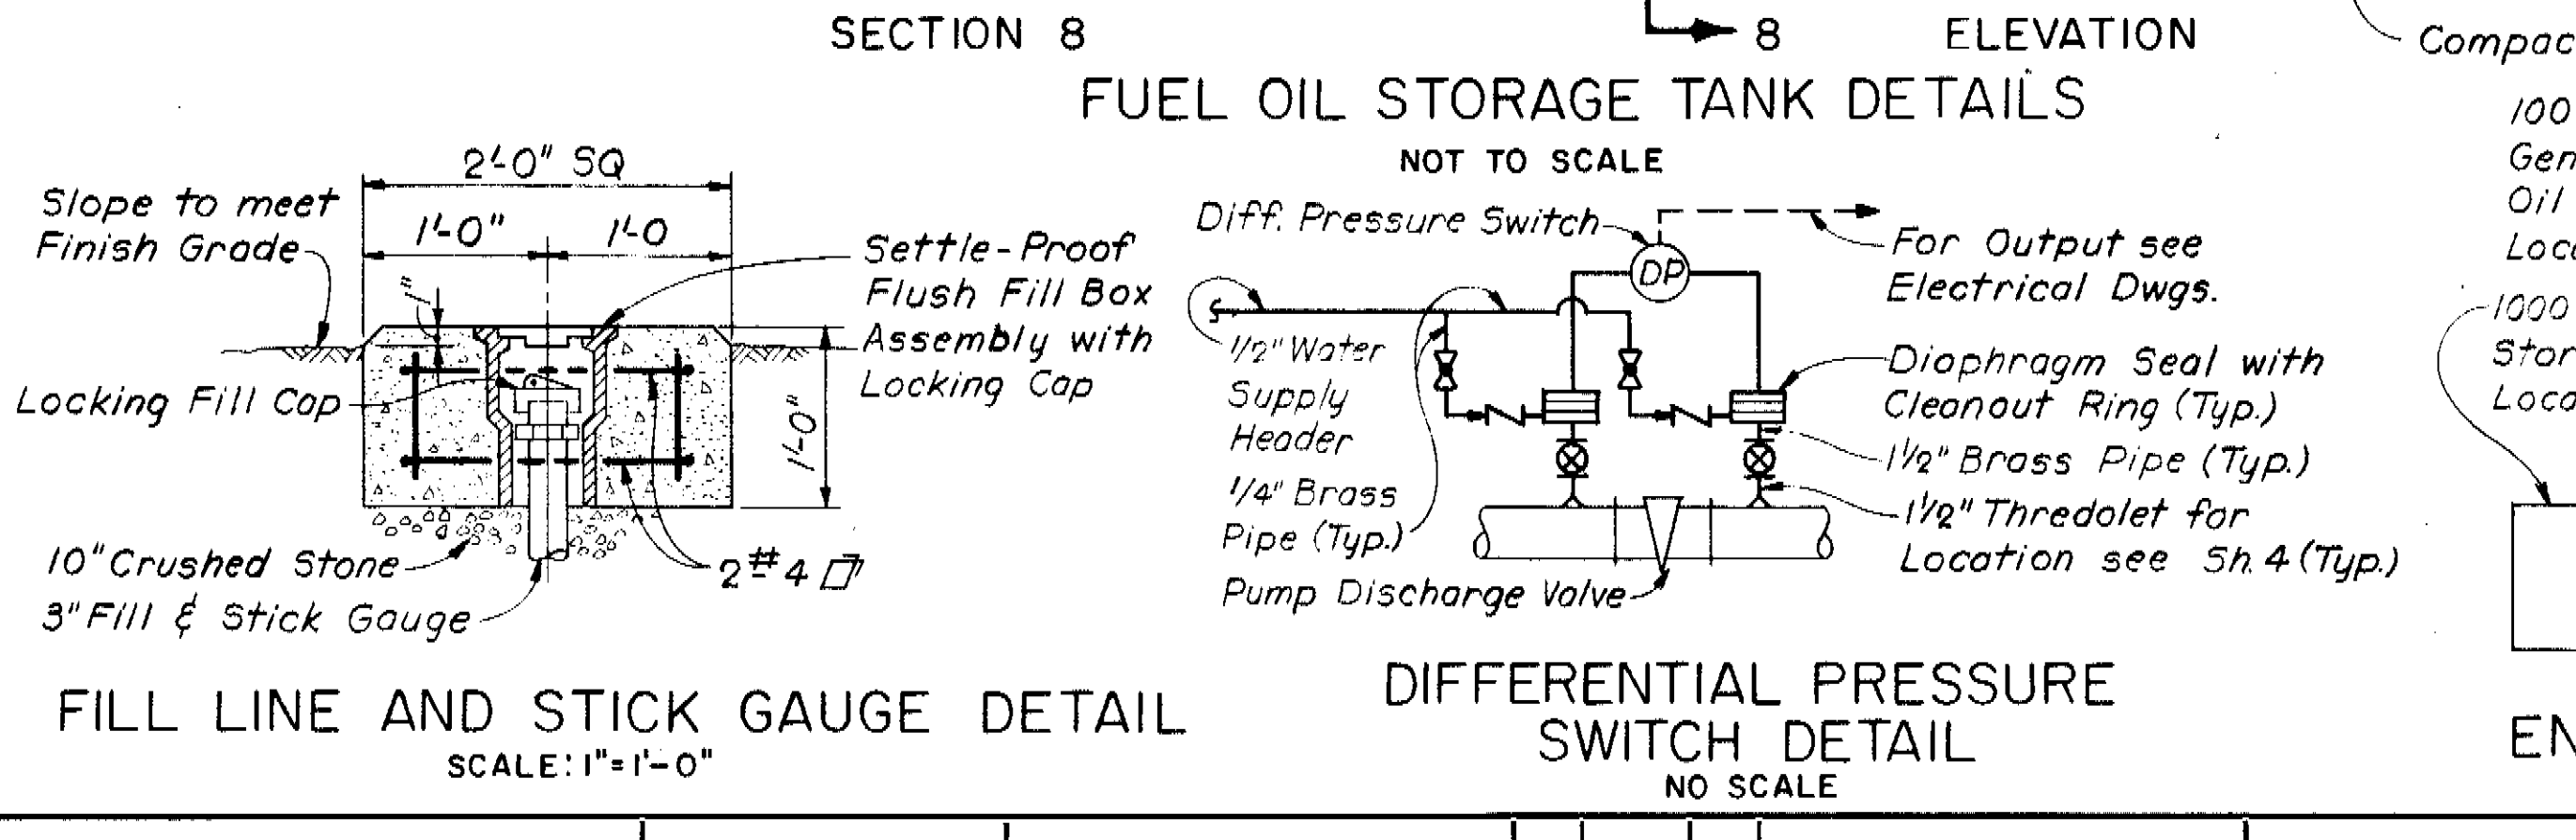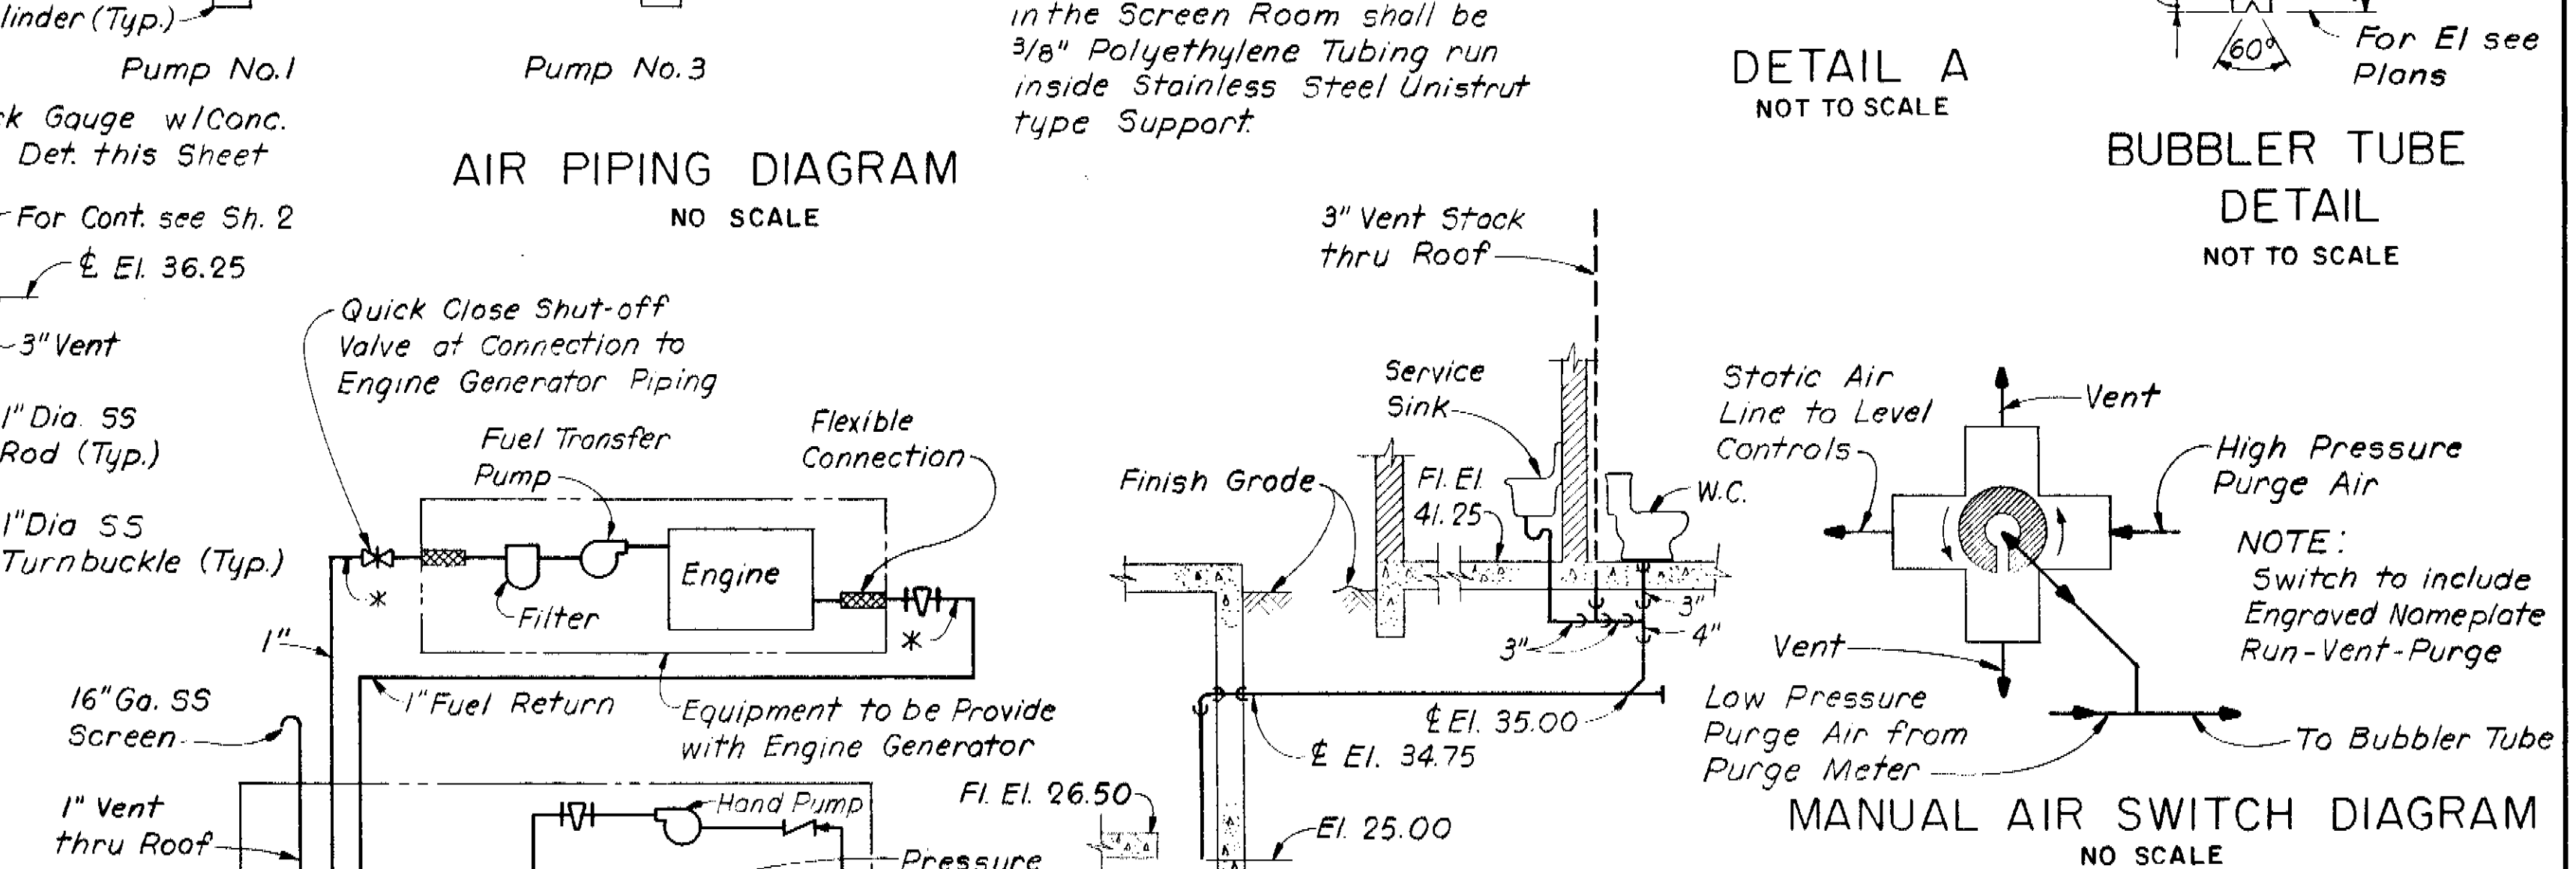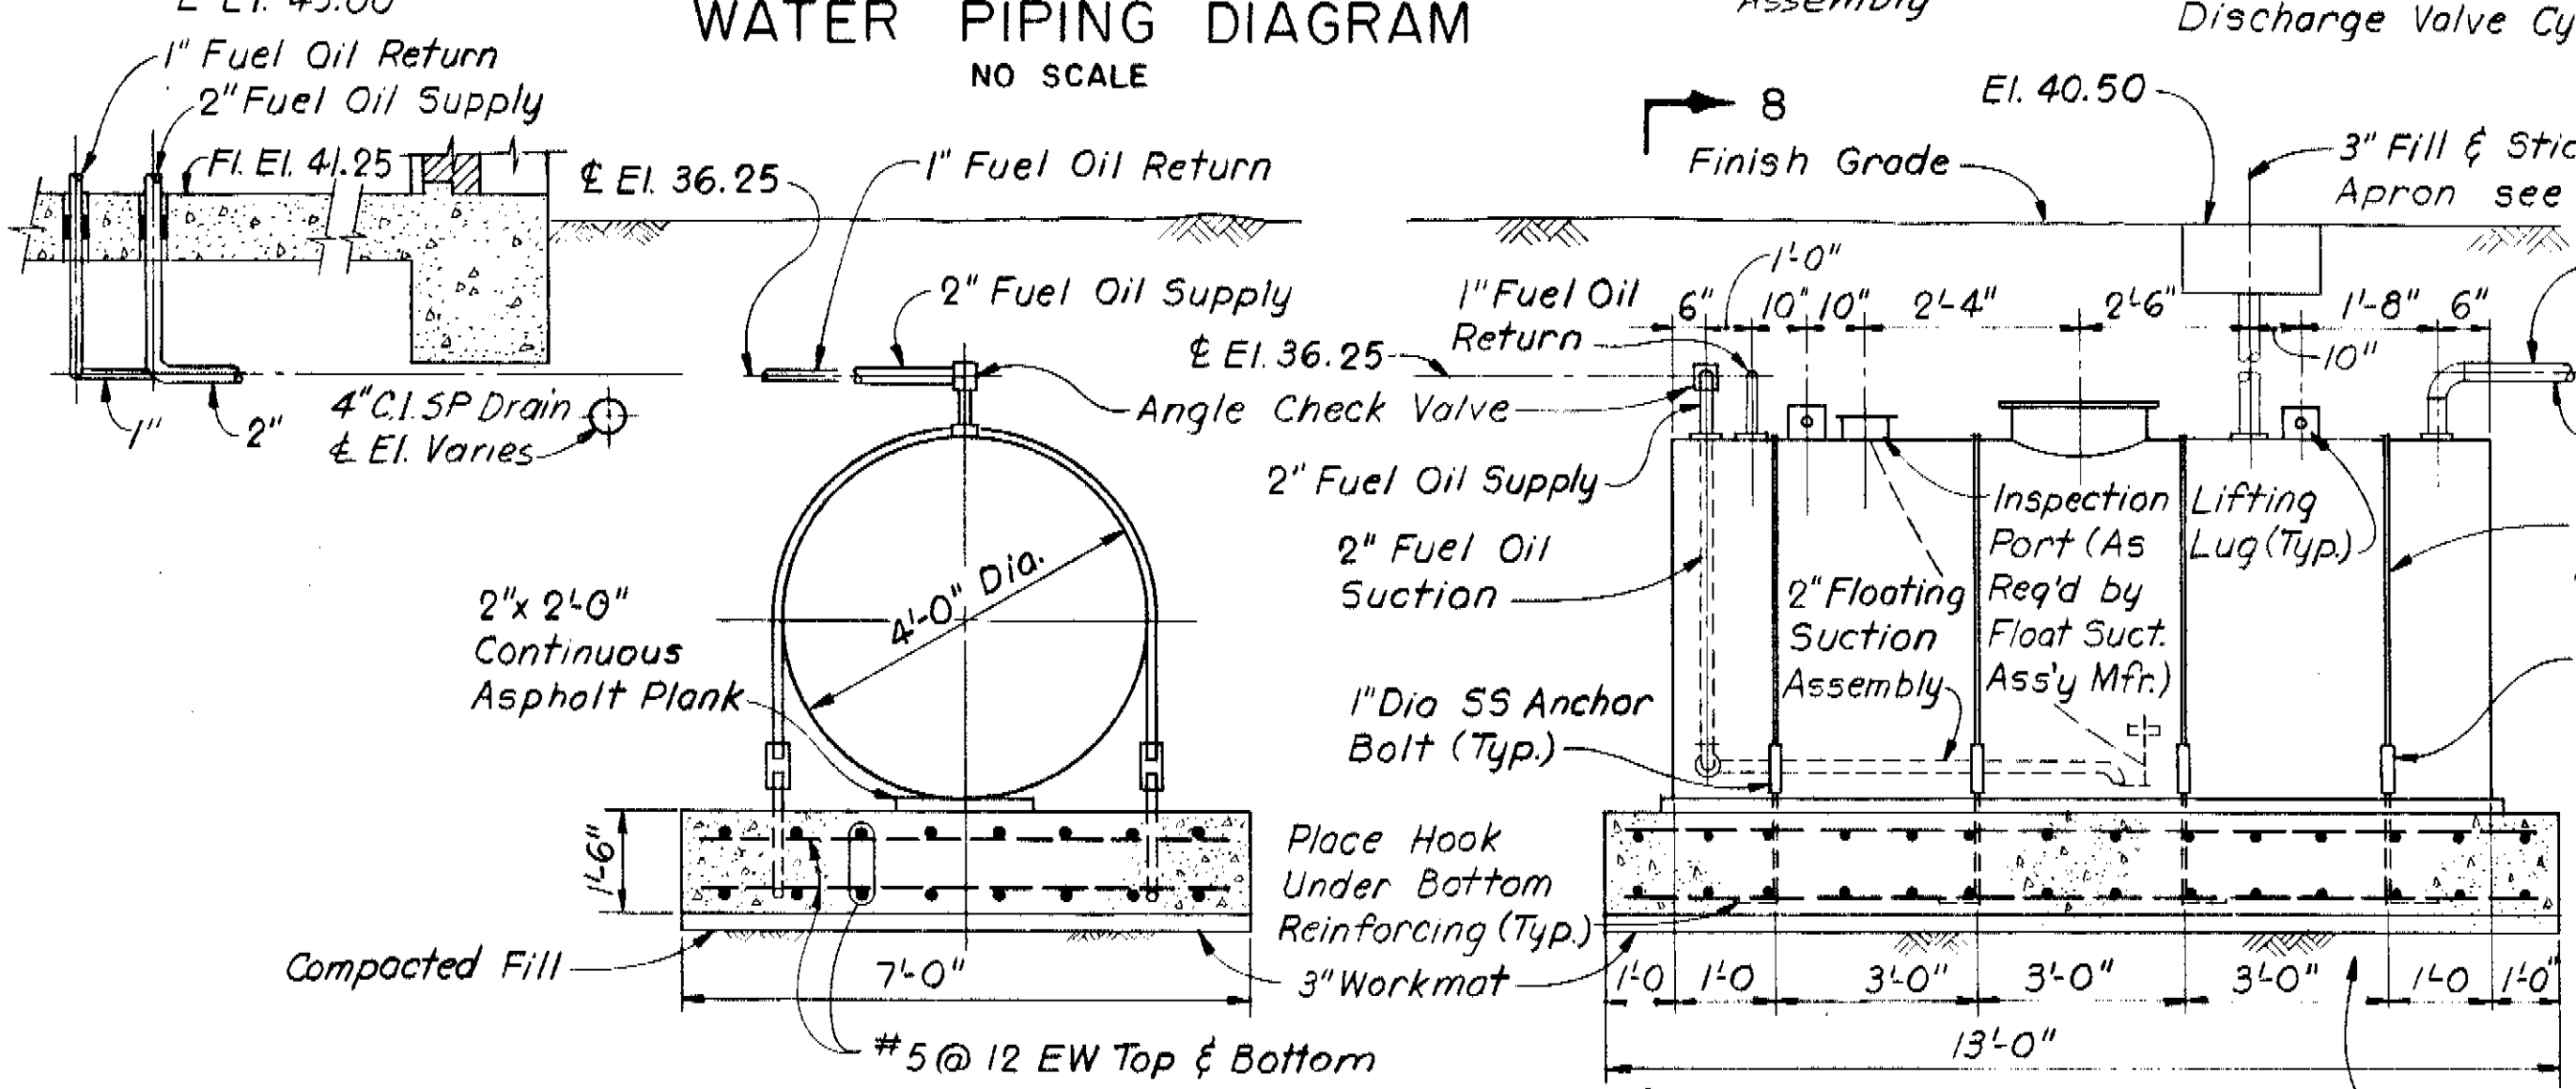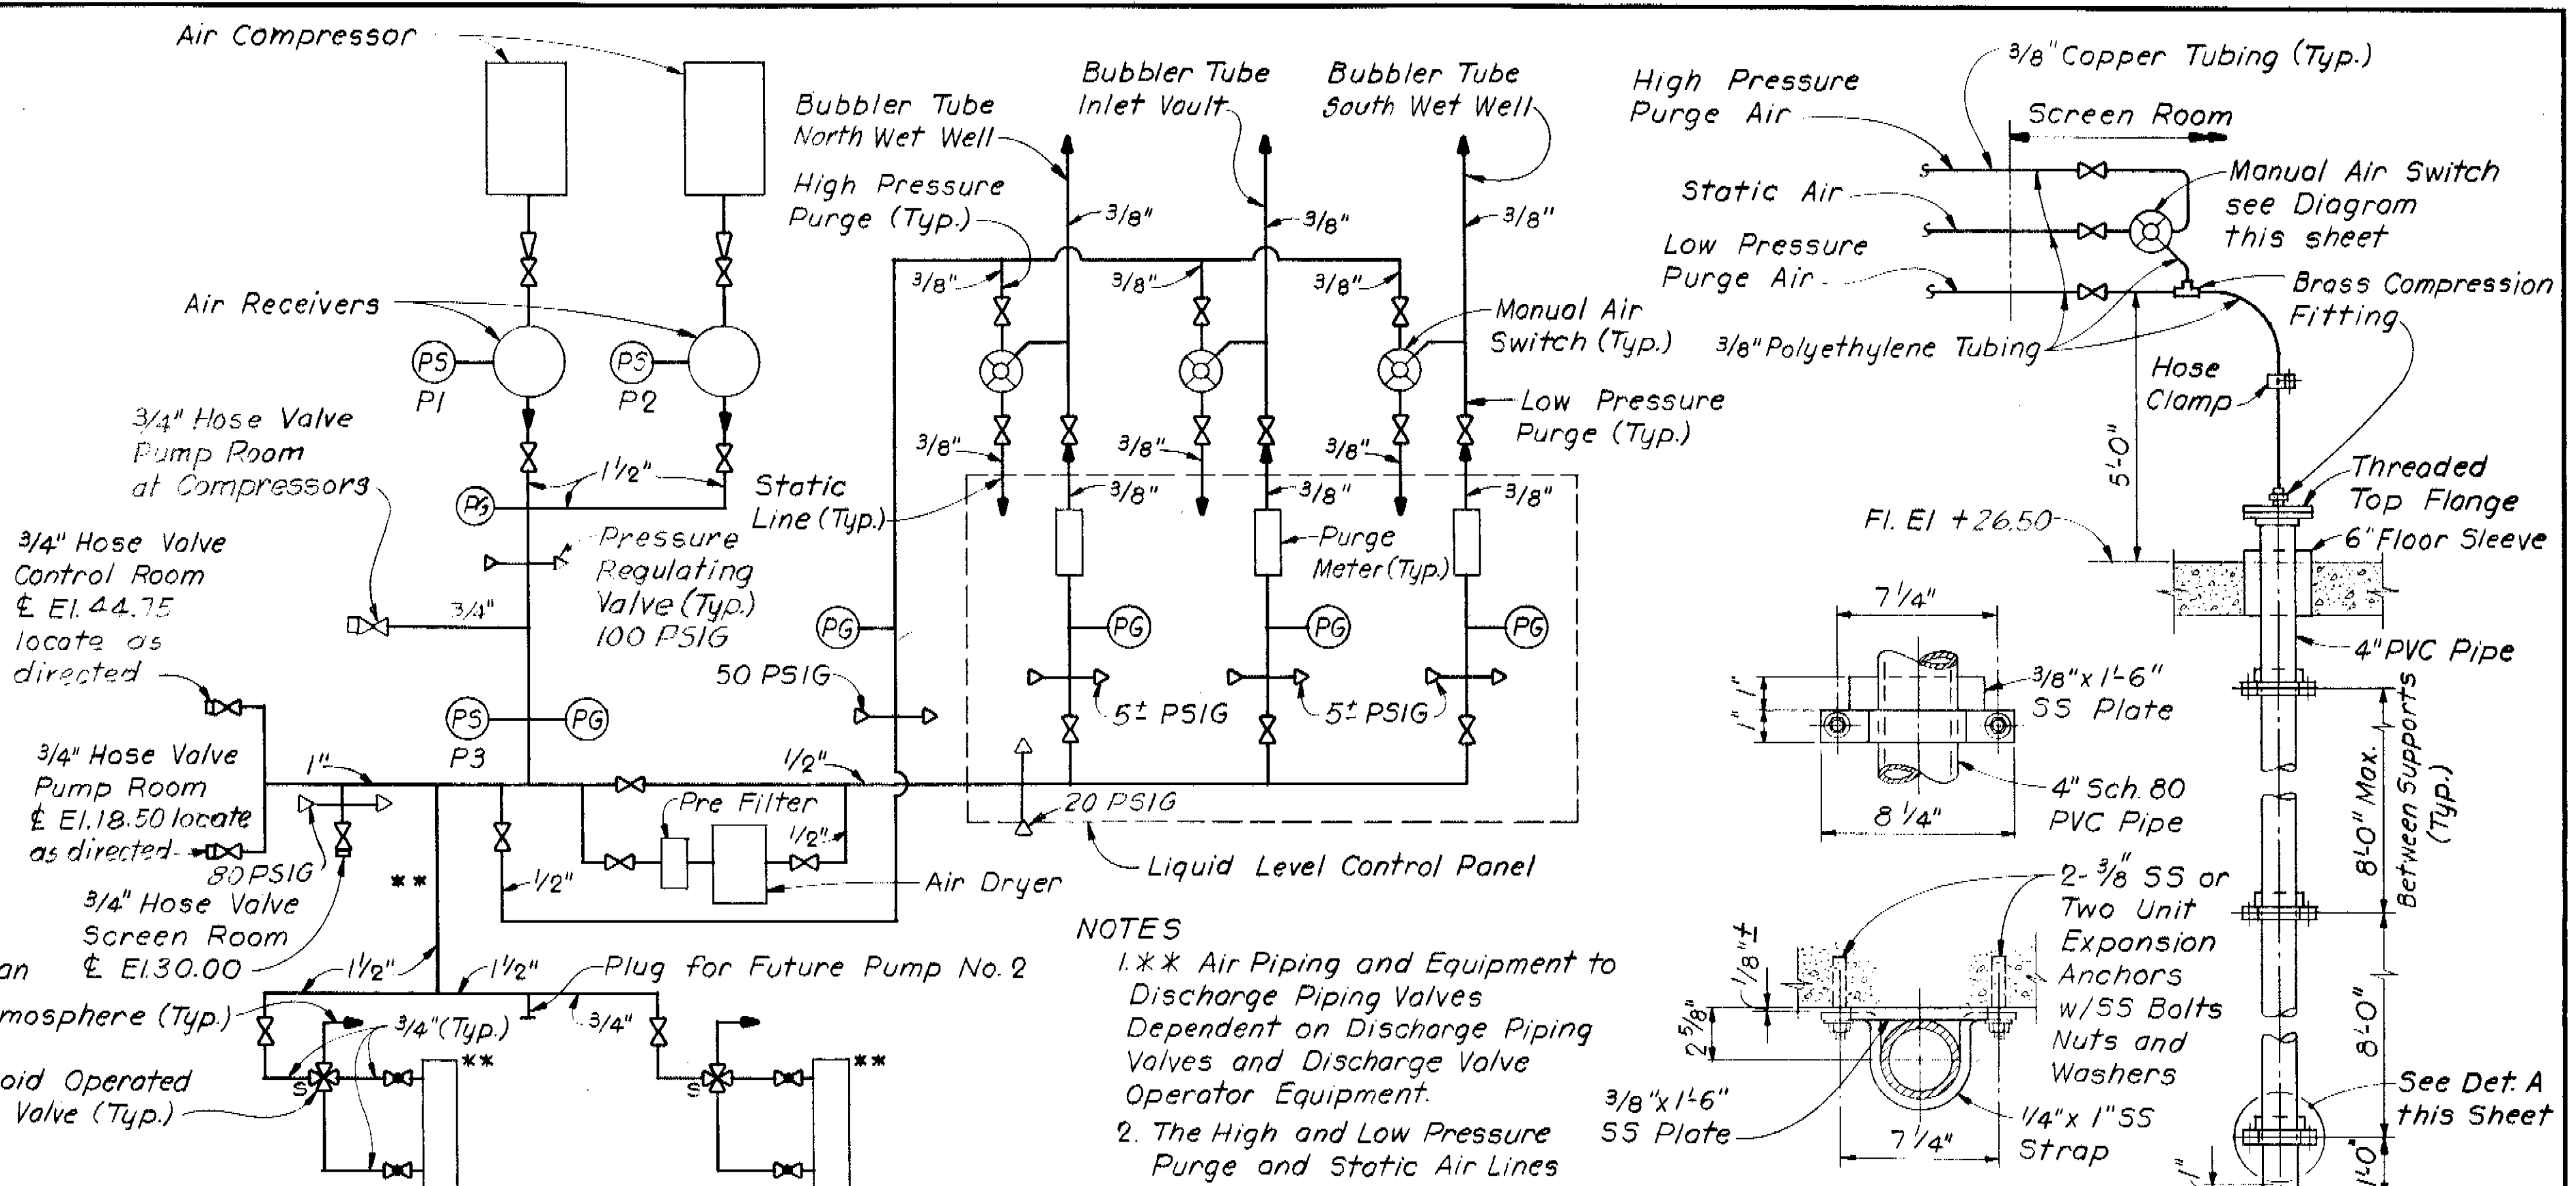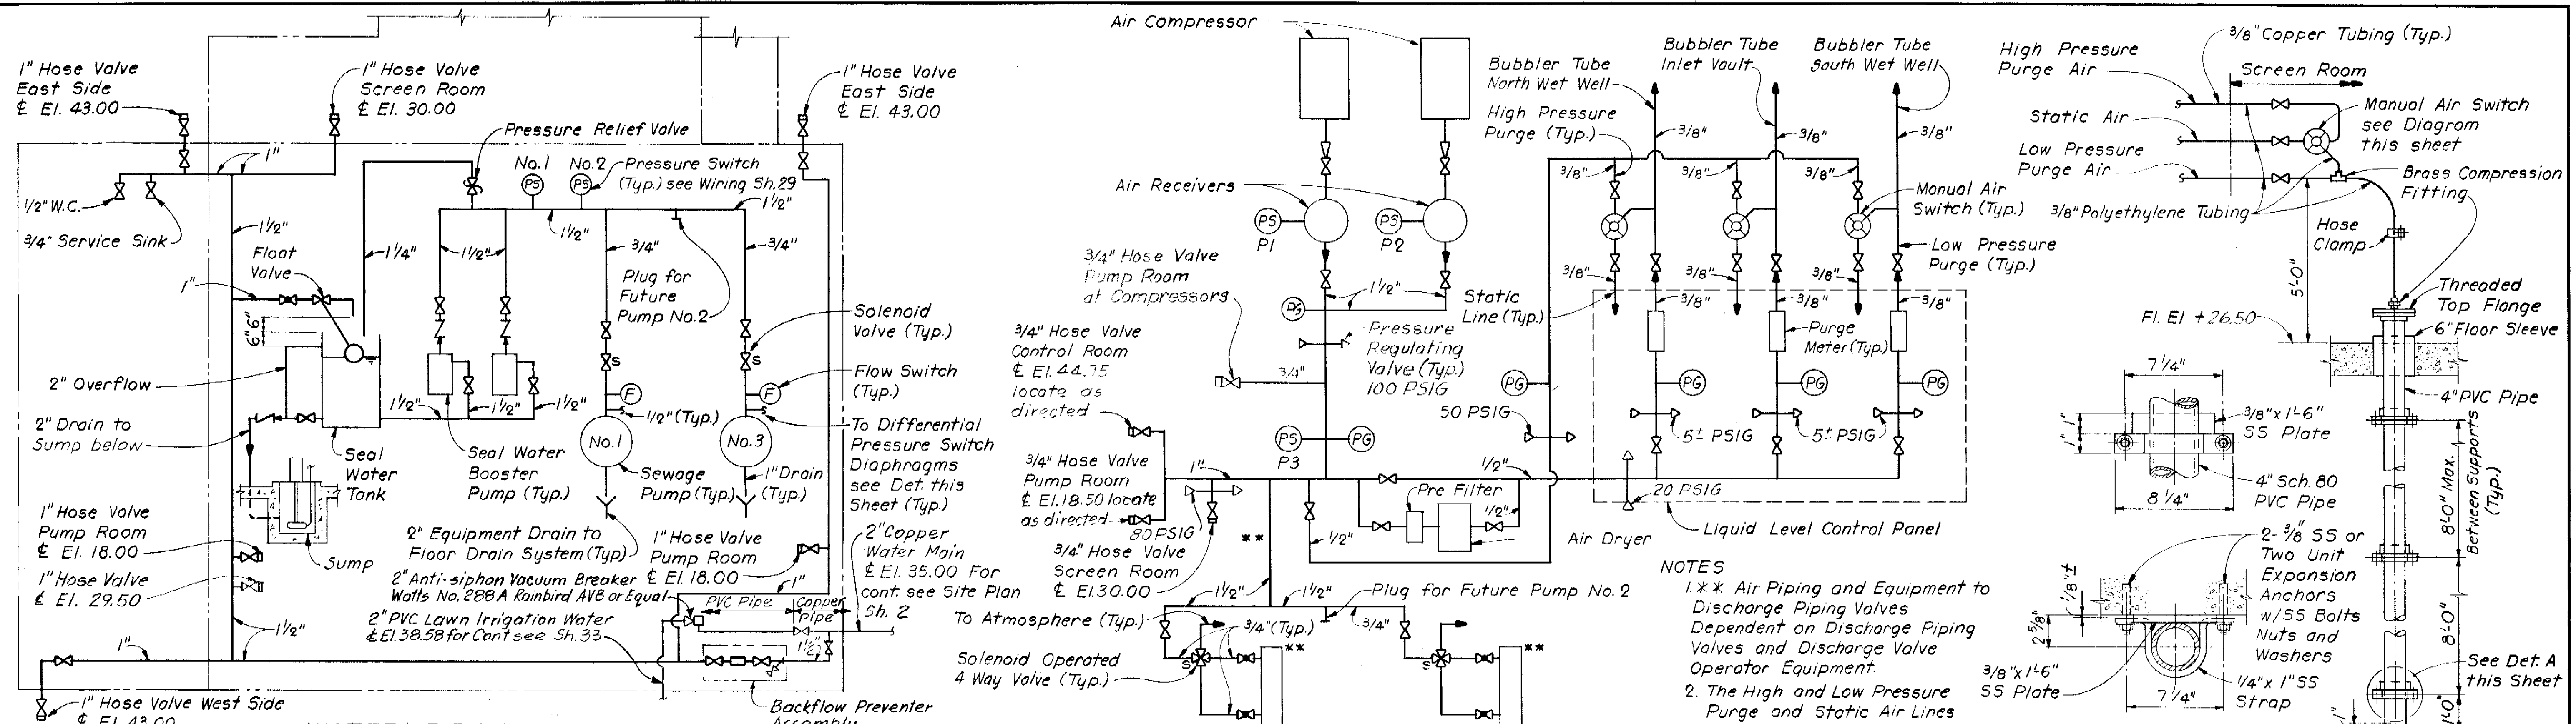


GREELEY AND HANSEN ENGINEERS 222 S. RIVERSIDE PLAZA CHICAGO, ILLINOIS 60606	DESIGNED JBV	APPROVED	SCALE	CITY OF TAMPA, FLORIDA SEWAGE DISPOSAL SYSTEM DIVISION 4G3 131ST AVENUE PUMPING STATION	EQUIPMENT PIPING DIAGRAMS	PROJ. NO. S 202-70-30D-7-4G3
	DRAWN LPD,KZK	DATE	NO. DATE APP. REVISION			SHEET 6 OF 35
	CHECKED JBV	SUPT., DEPT. OF SANITARY SEWERS	NO. DATE APP. REVISION			DATE AUGUST, 1972 REV. 1

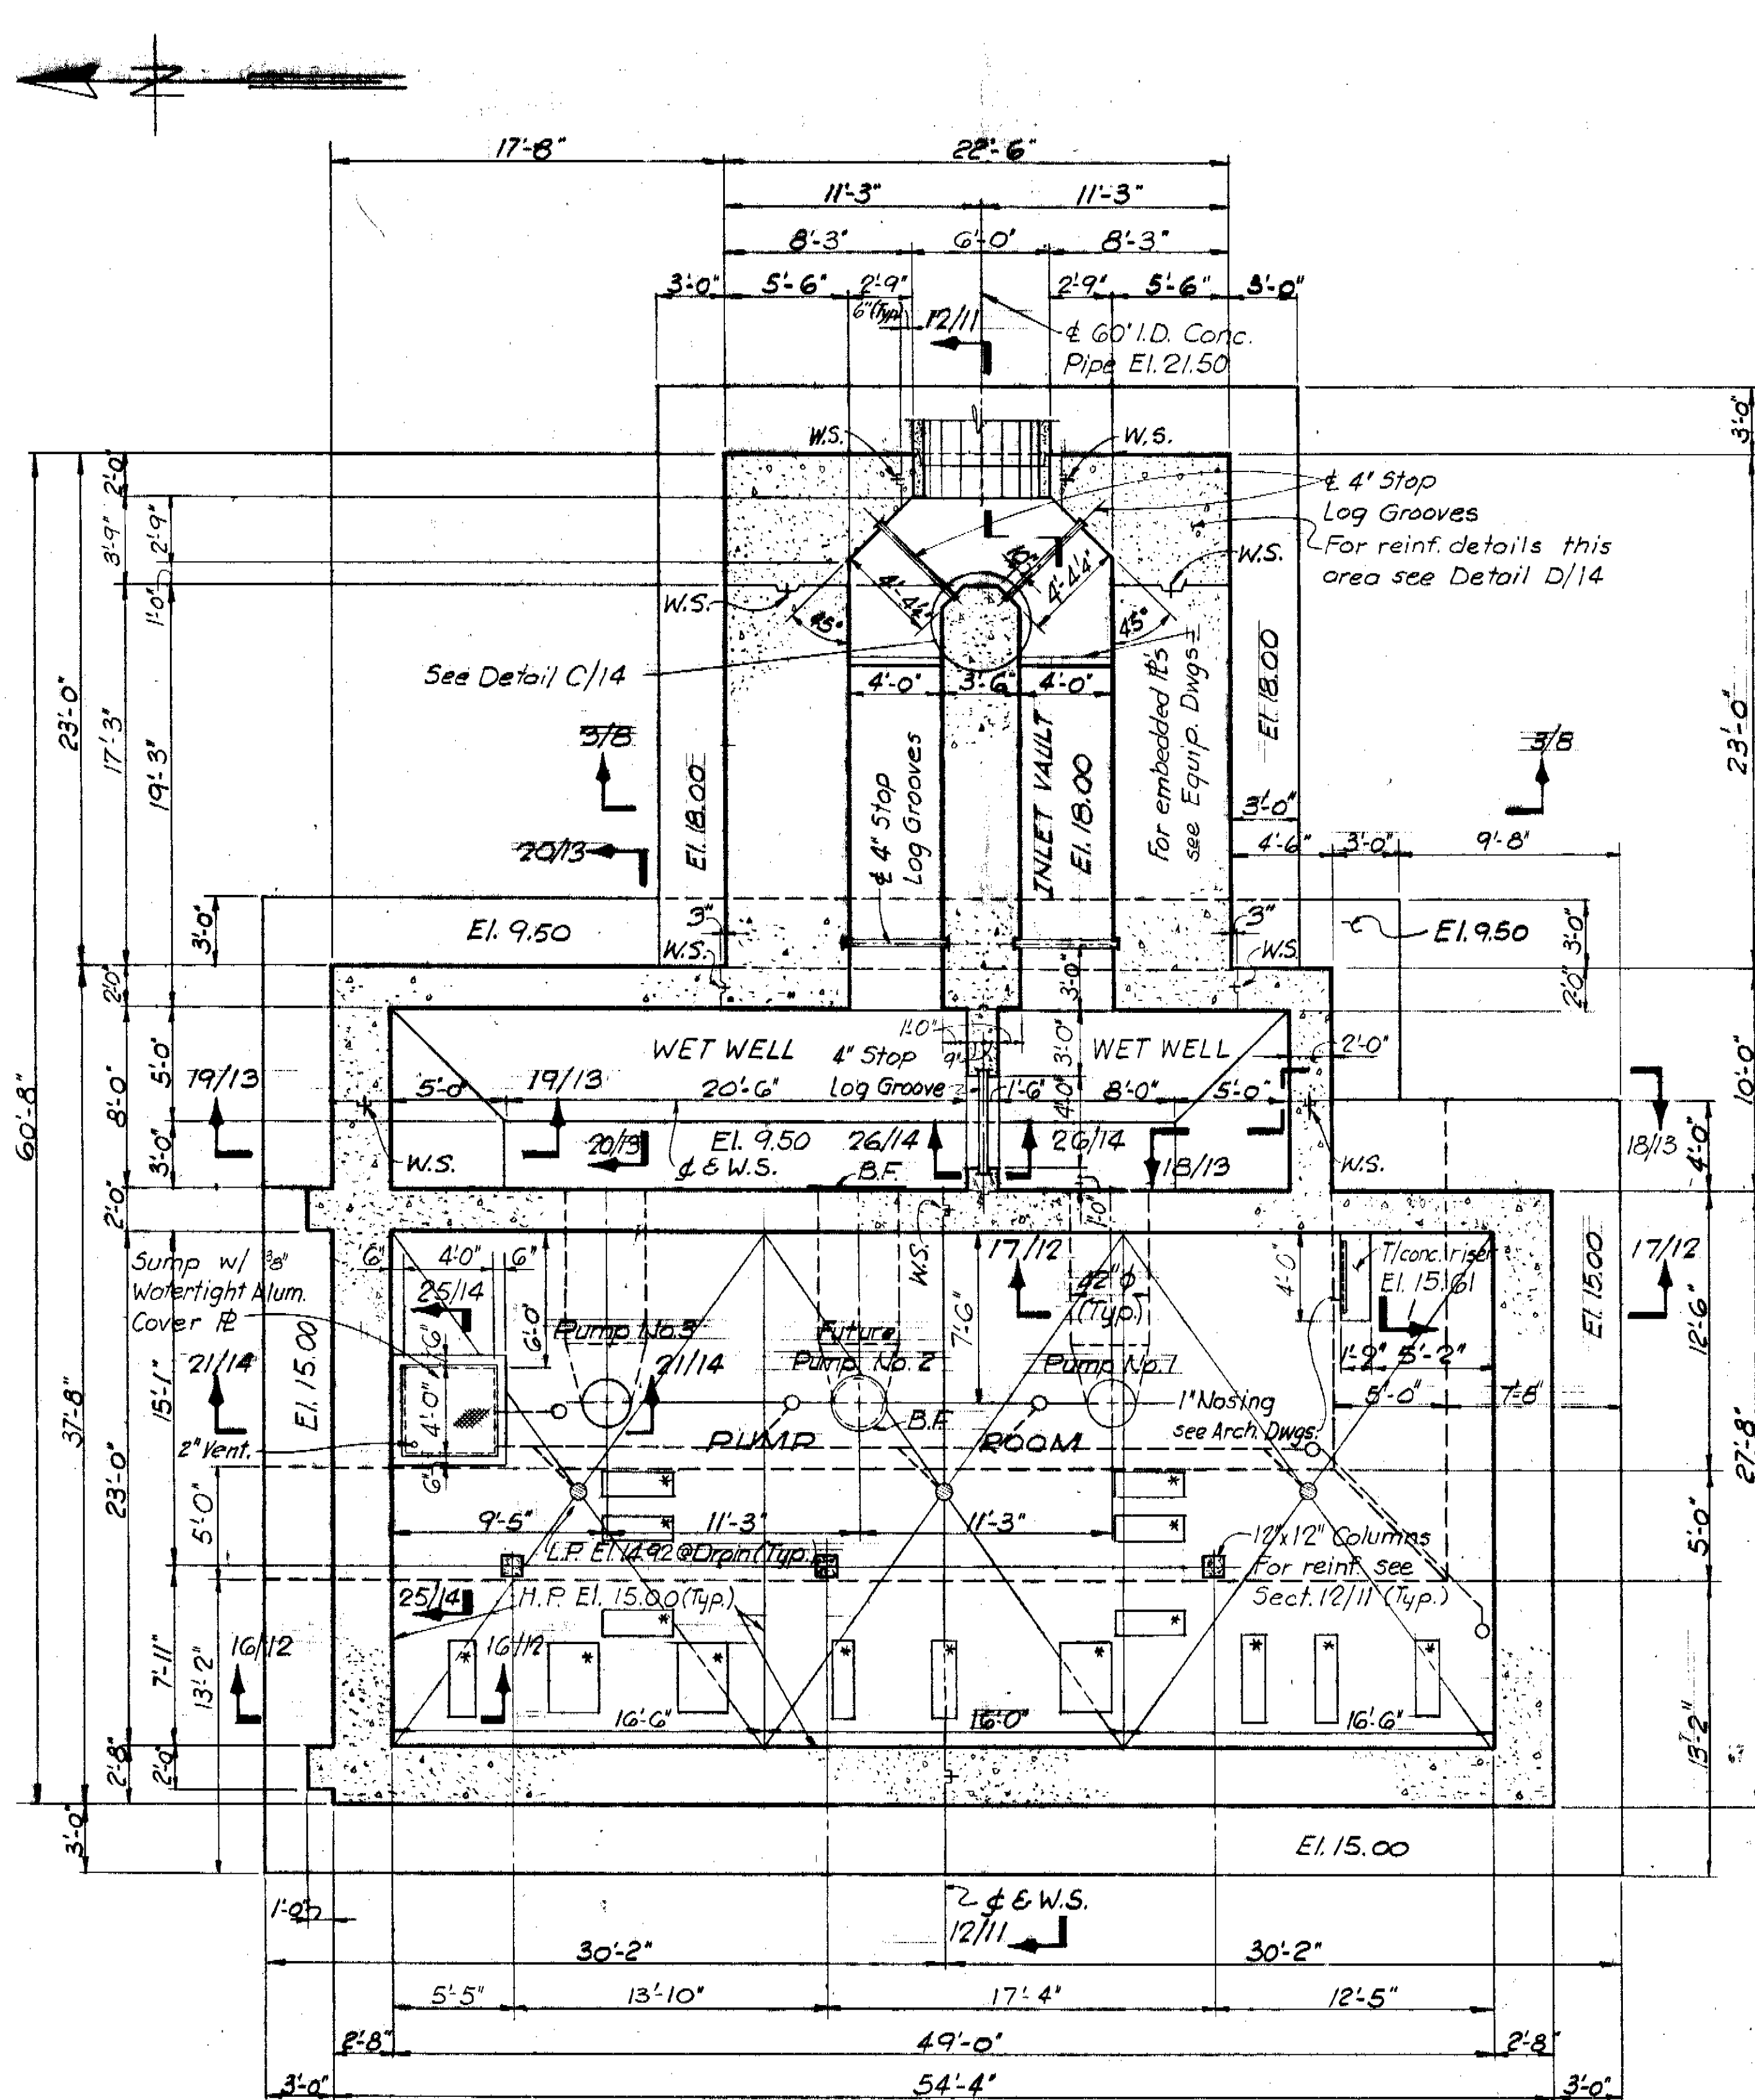


SECTIONAL PLAN AT EL. 22.00
 Scale: 3/8" = 1'-0"
 T/Conc. El. as noted or shown
 † denotes Construction Joint
 W.S. denotes Waterstop

- NOTES:**
- The Substructure is stable against hydrostatic uplift with floor at El. 41.25 in place with ground water at grade.
 - See AD3-1 for location of foundation grout holes.

* Size and location of equipment pads and dimensions shown thus (*) to be determined after selection of equipment. See also Equipment Dwg.

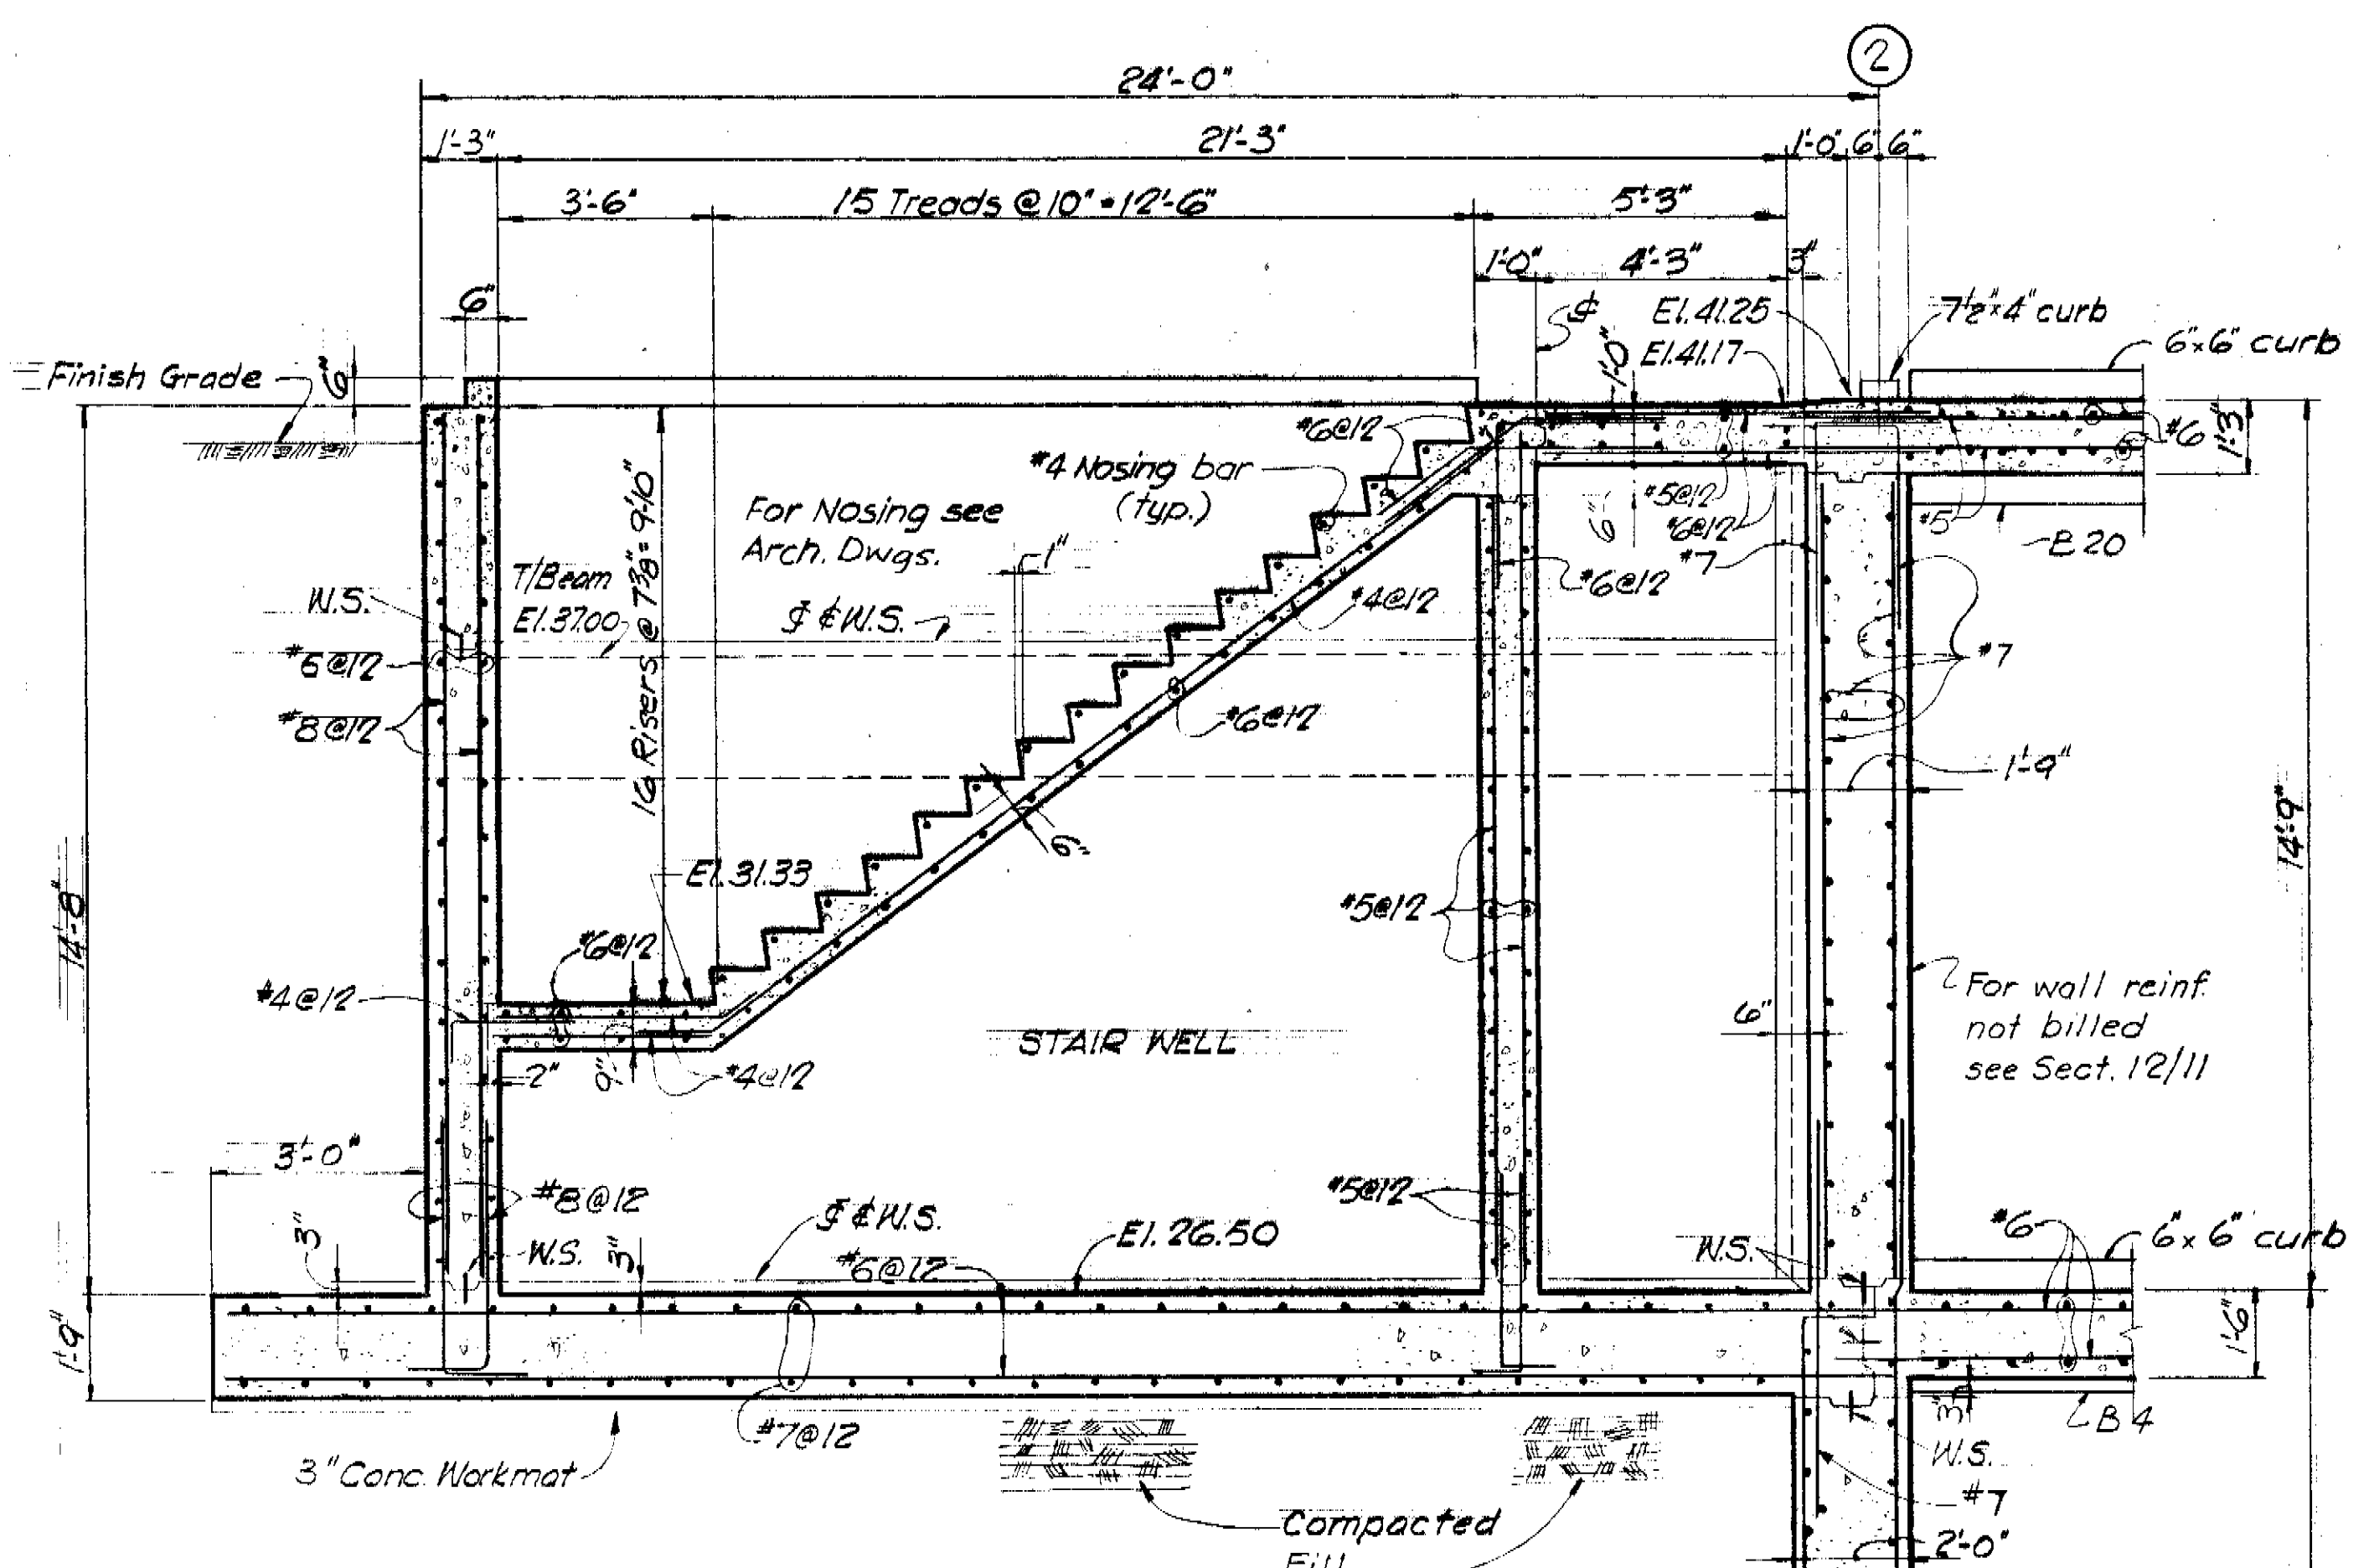

SECTION 1/7,8,9
 Scale: 3/8" = 1'-0"

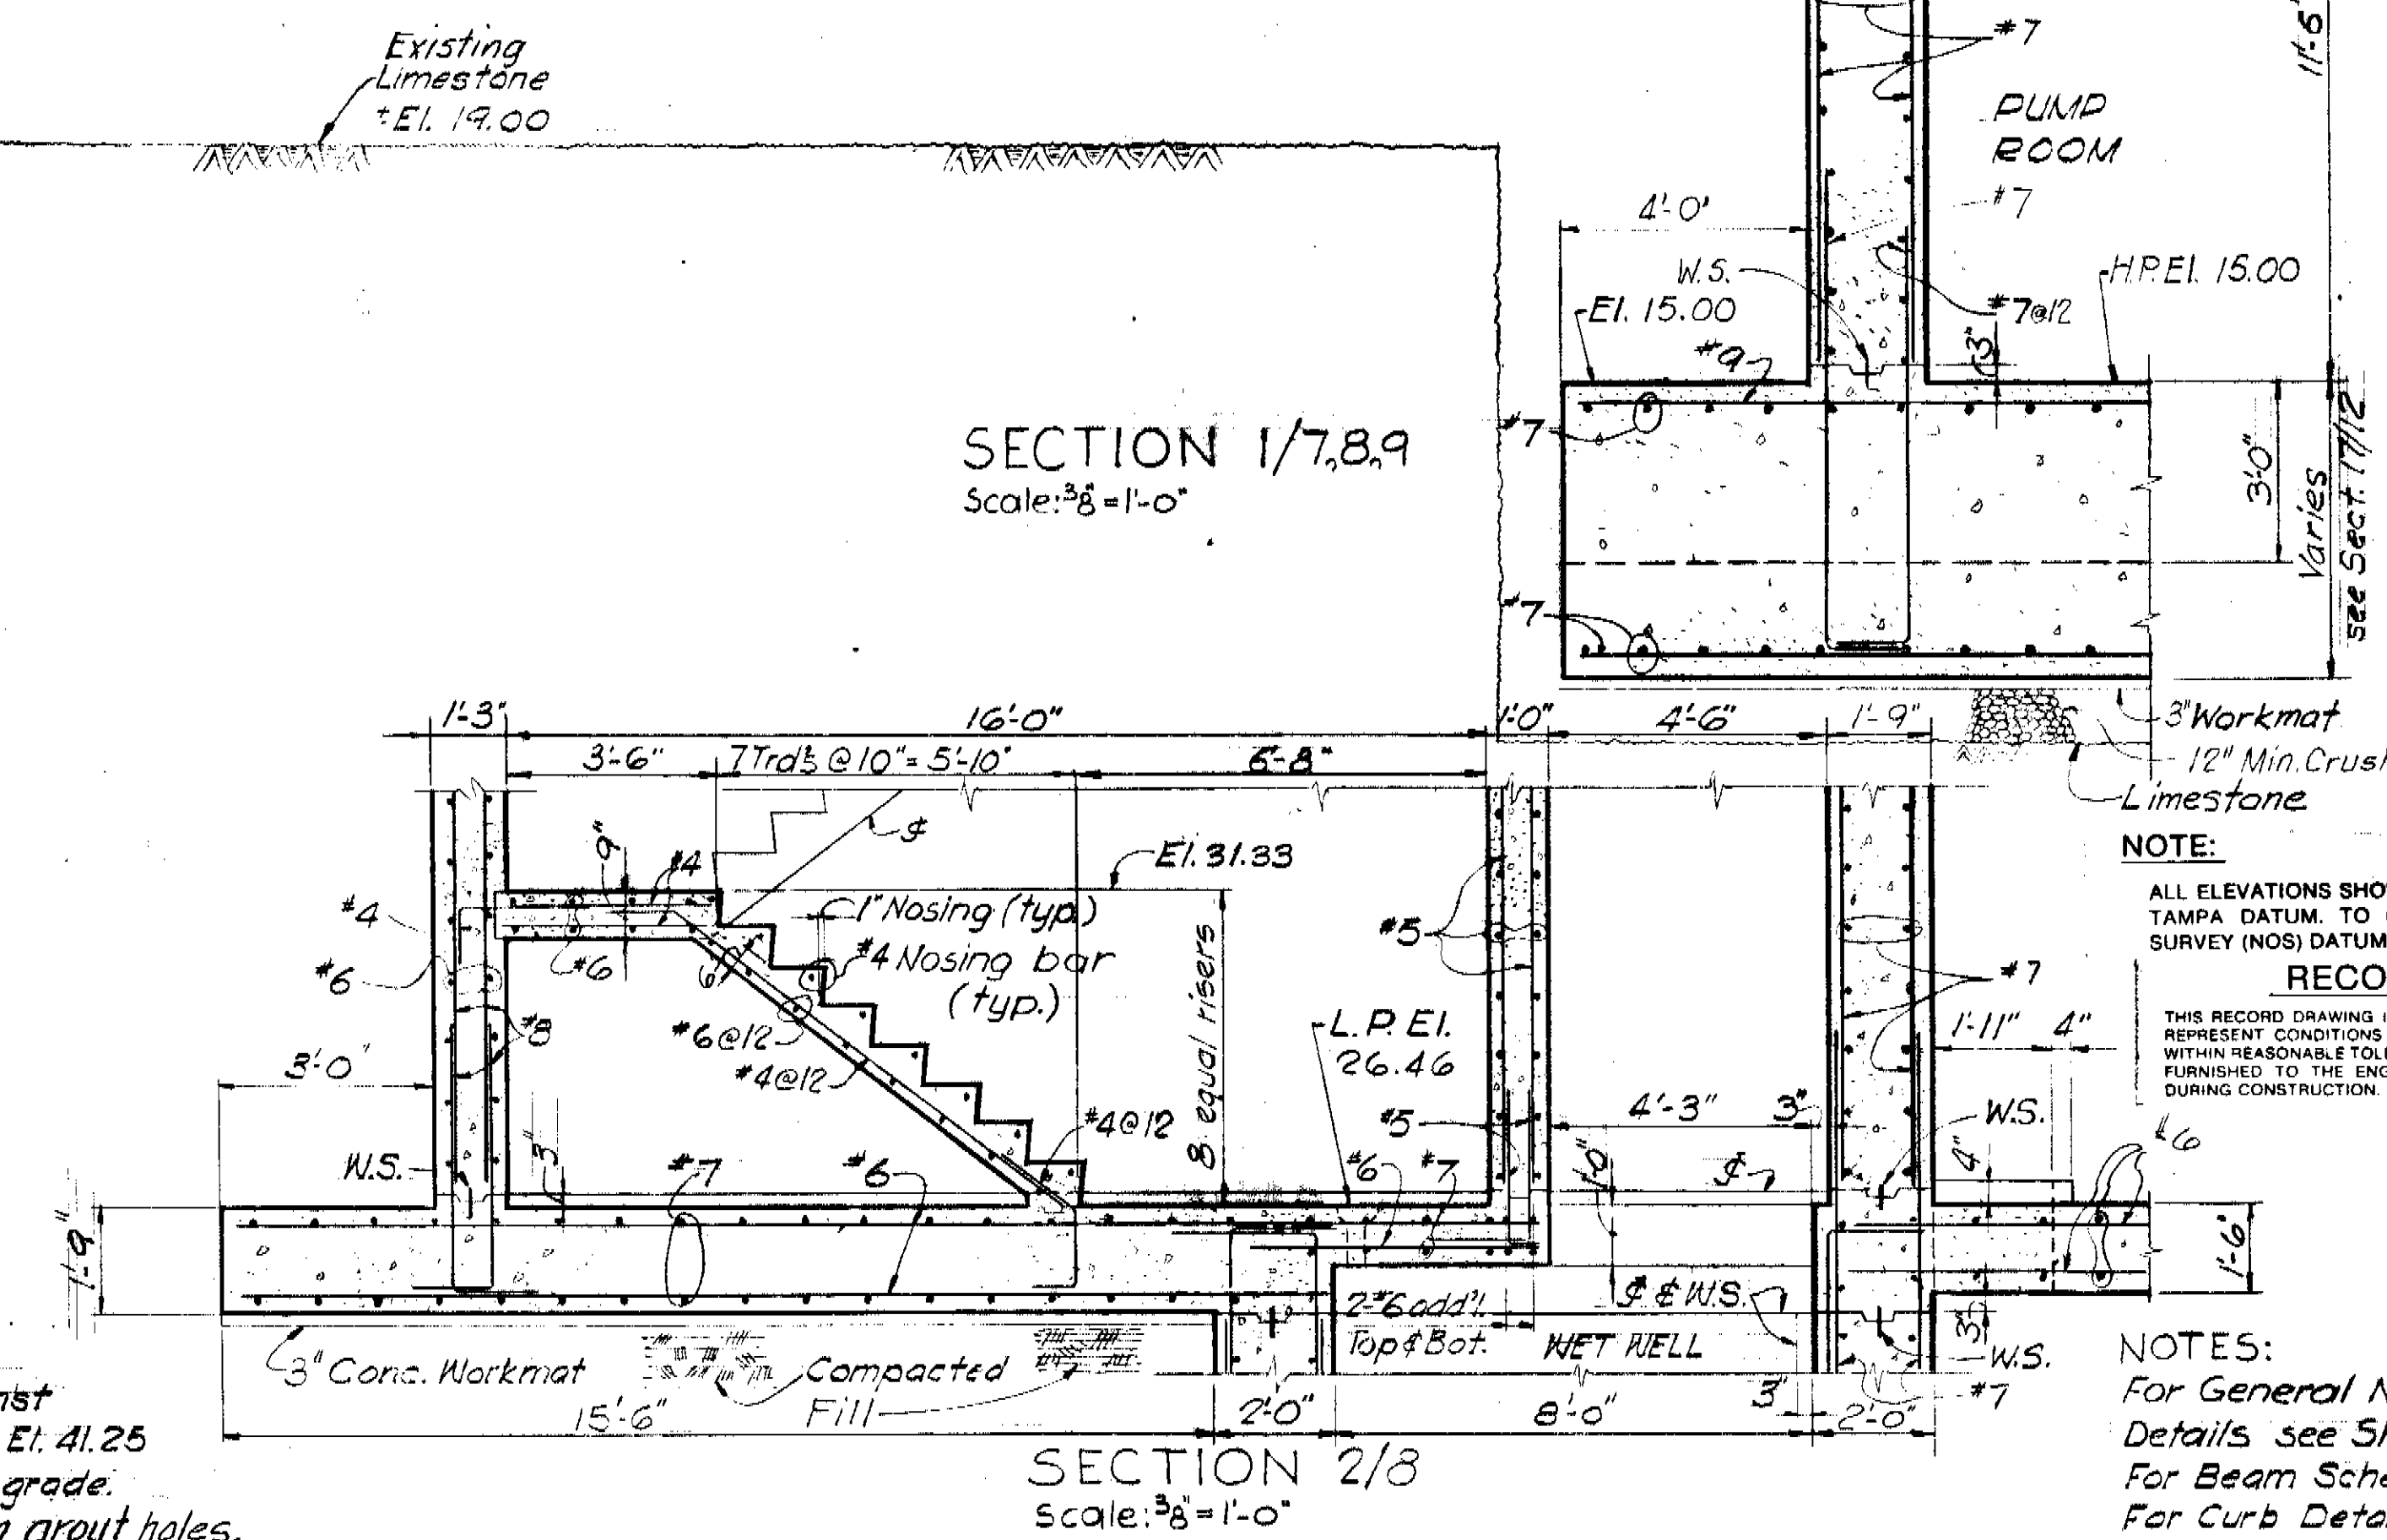

SECTION 2/8
 Scale: 3/8" = 1'-0"

NOTE:
 ALL ELEVATIONS SHOWN ARE REFERENCED TO CITY OF TAMPA DATUM. TO CONVERT TO NATIONAL OCEAN SURVEY (NOS) DATUM, SUBTRACT 0.15 FEET (0'-1 13/16").

RECORD DRAWING
 THIS RECORD DRAWING IS NOT WARRANTED BUT IS BELIEVED TO REPRESENT CONDITIONS UPON COMPLETION OF CONSTRUCTION, WITHIN REASONABLE TOLERANCES, BASED UPON THE INFORMATION FURNISHED TO THE ENGINEER PERTAINING TO CHANGES MADE DURING CONSTRUCTION.


- NOTES:**
- For General Notes and Typical Details see Sh. 15 & 16
 - For Beam Schedule see Sh. 9
 - For Curb Details see Arch. Dwg.

GREELEY AND HANSEN ENGINEERS
 222 S. RIVERSIDE PLAZA
 CHICAGO, ILLINOIS 60606

DESIGNED PYL, JJF
 DRAWN LT, PYL
 CHECKED SST

APPROVED
 SUPT., DEPT. OF SANITARY SEWERS
 DATE 9/81 DSH
 DATE 10/78 JRP
 GREELEY AND HANSEN, ENGINEERS

NO.	DATE	APP.	REVISION
1	9/81	DSH	Rec. Dwg. Revisions
2	10/78	JRP	Plans Updated


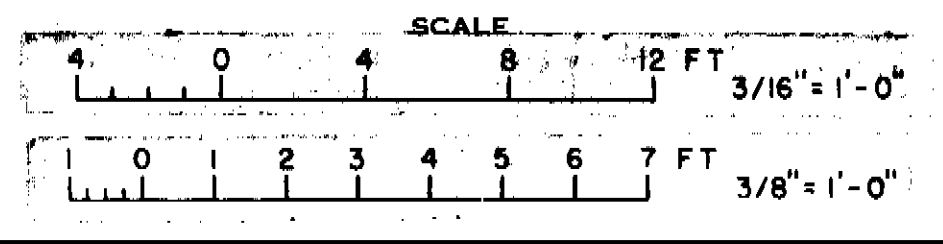


CITY OF TAMPA, FLORIDA
 SEWAGE DISPOSAL SYSTEM
 DIVISION 4G3
 131 ST. AVENUE PUMPING STATION


STRUCTURAL LOWER FLOOR PLAN SECTIONS

PROJ. NO. S202-70-30D-7-4G3
 SHEET 7 OF 35
 DATE AUGUST, 1972 REV. 0


173-44

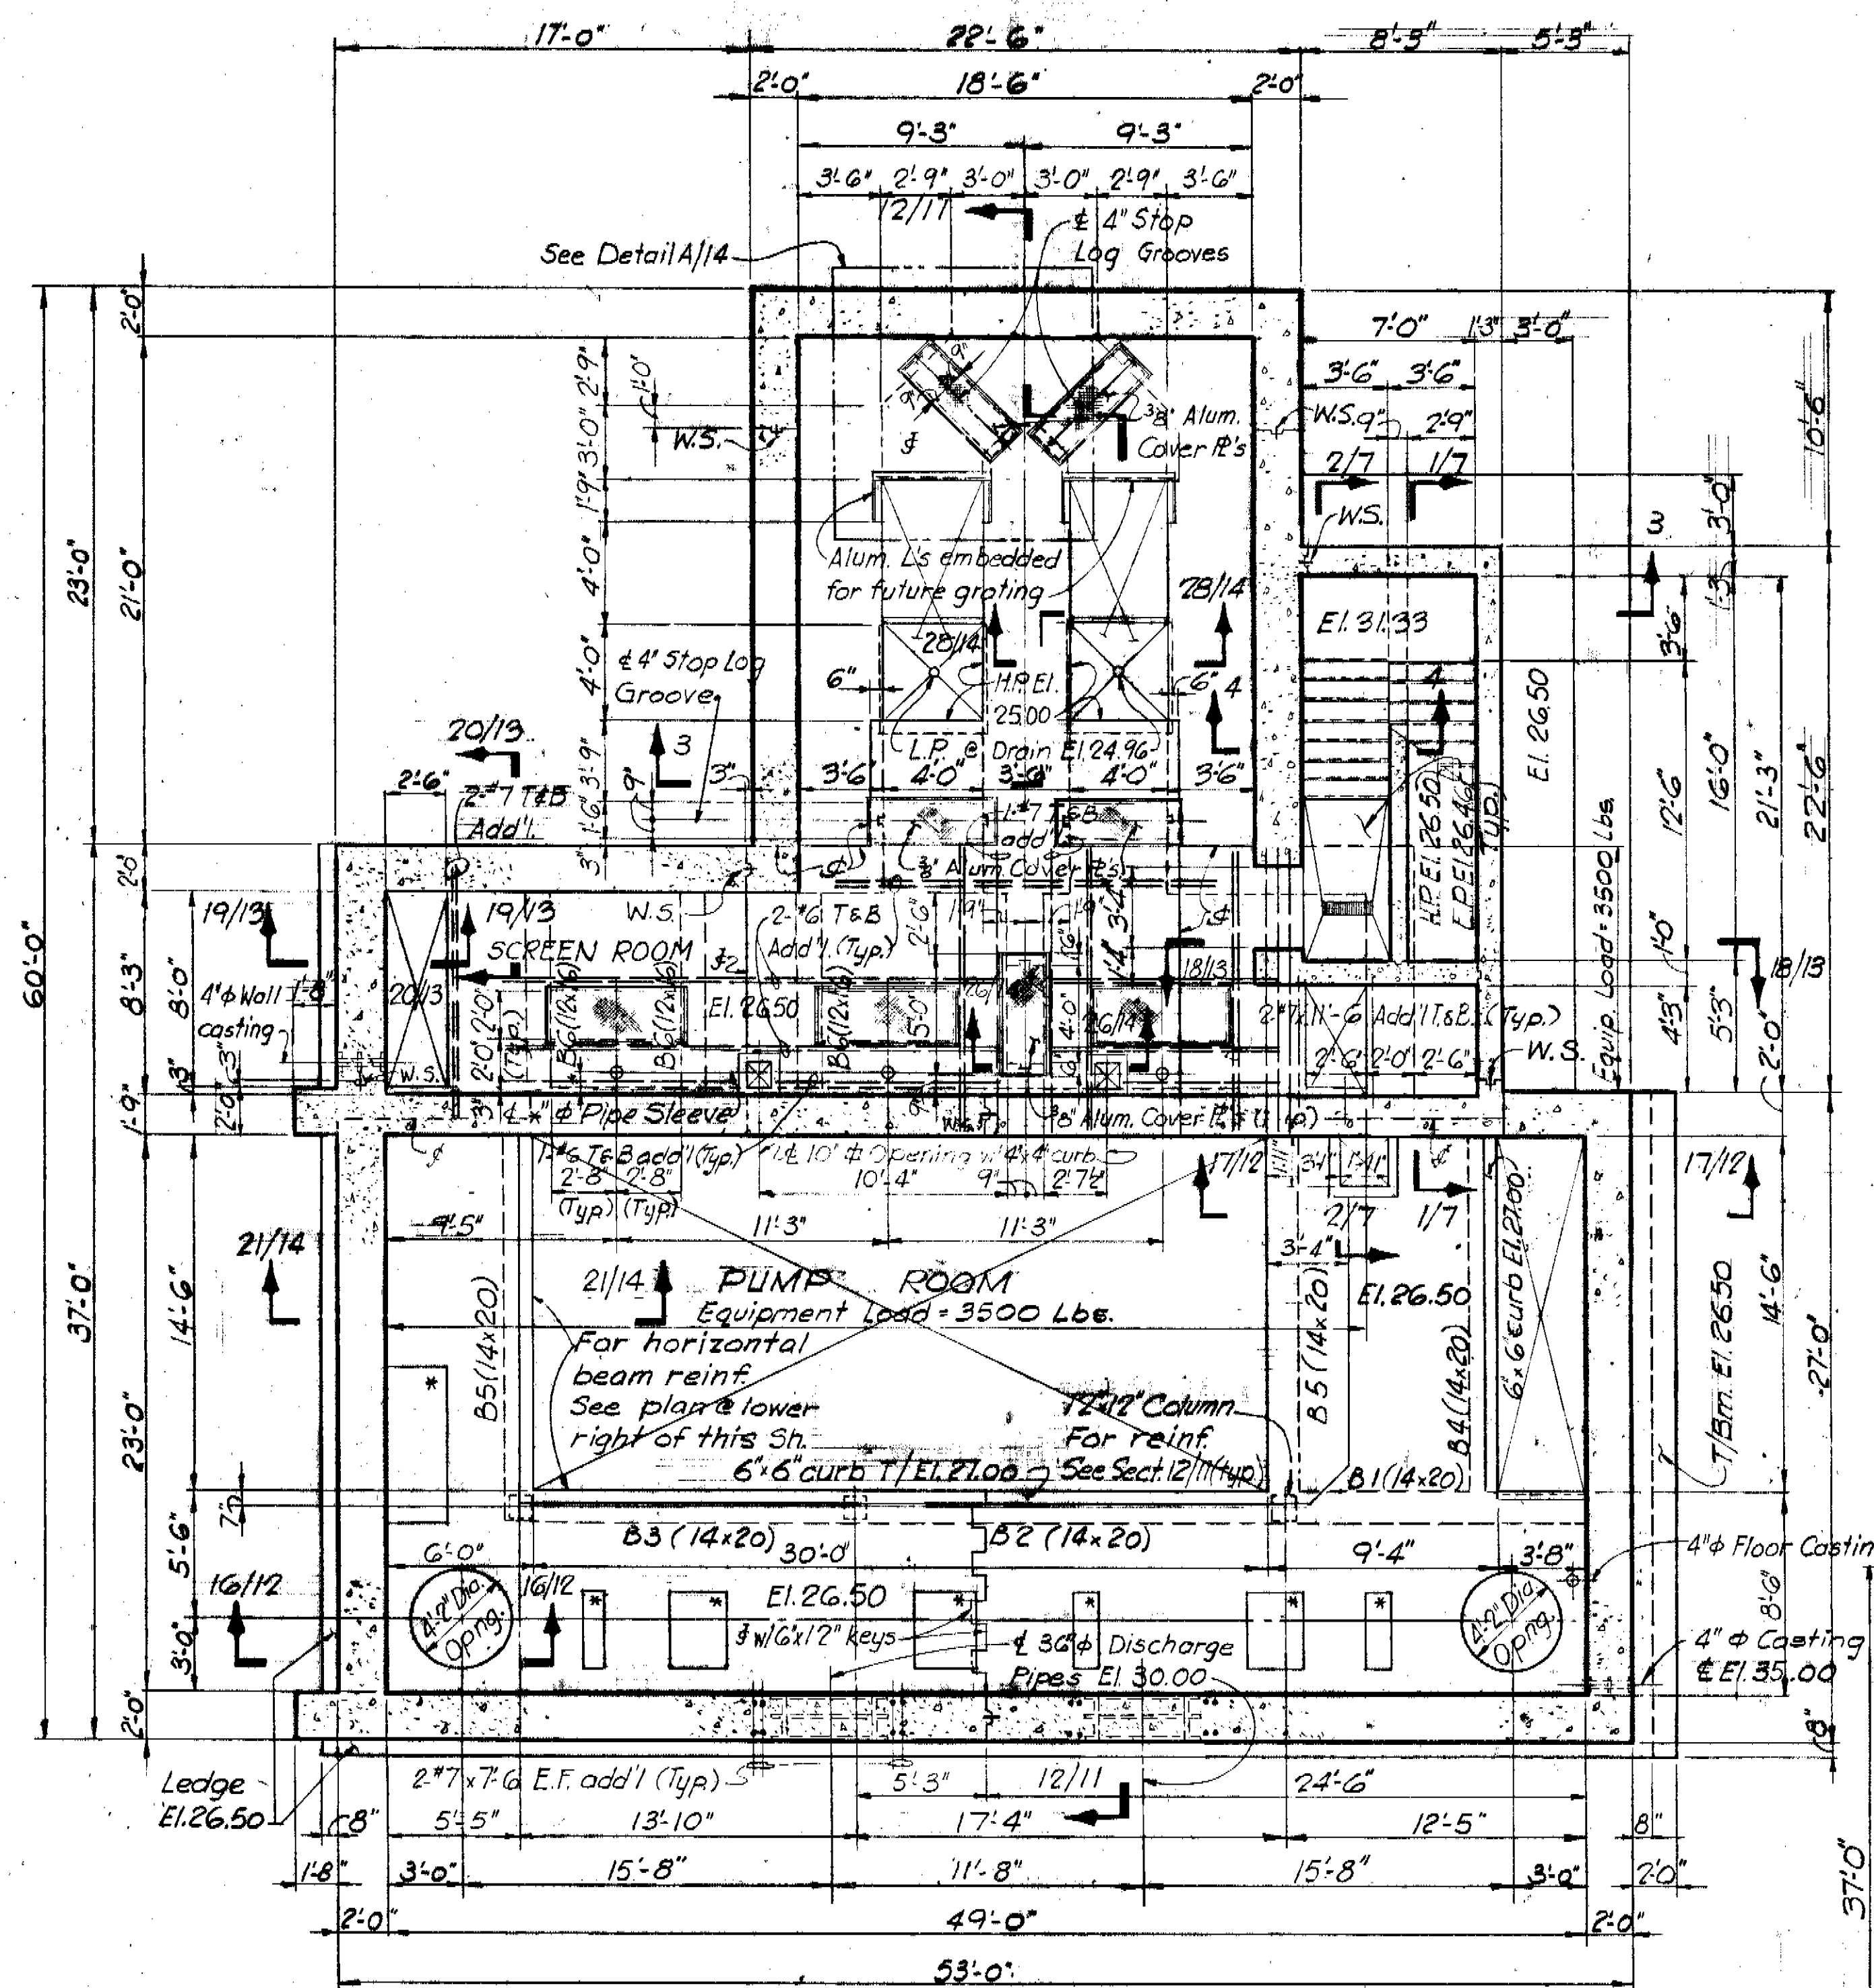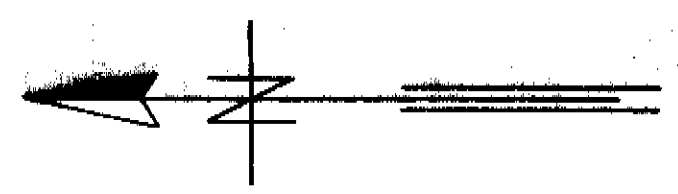


Live Load = 150 P.S.F. unless otherwise shown
SECTIONAL PLAN AT EL. 34.00
 Scale: 3/16" = 1'-0"
 T/conc. El. 26.50 unless shown or noted
 † denotes Construction Joint
 * Size and location of equipment pods and dimensions shown thus (N) to be determined after selection of equipment. See also Equip. Dwgs.

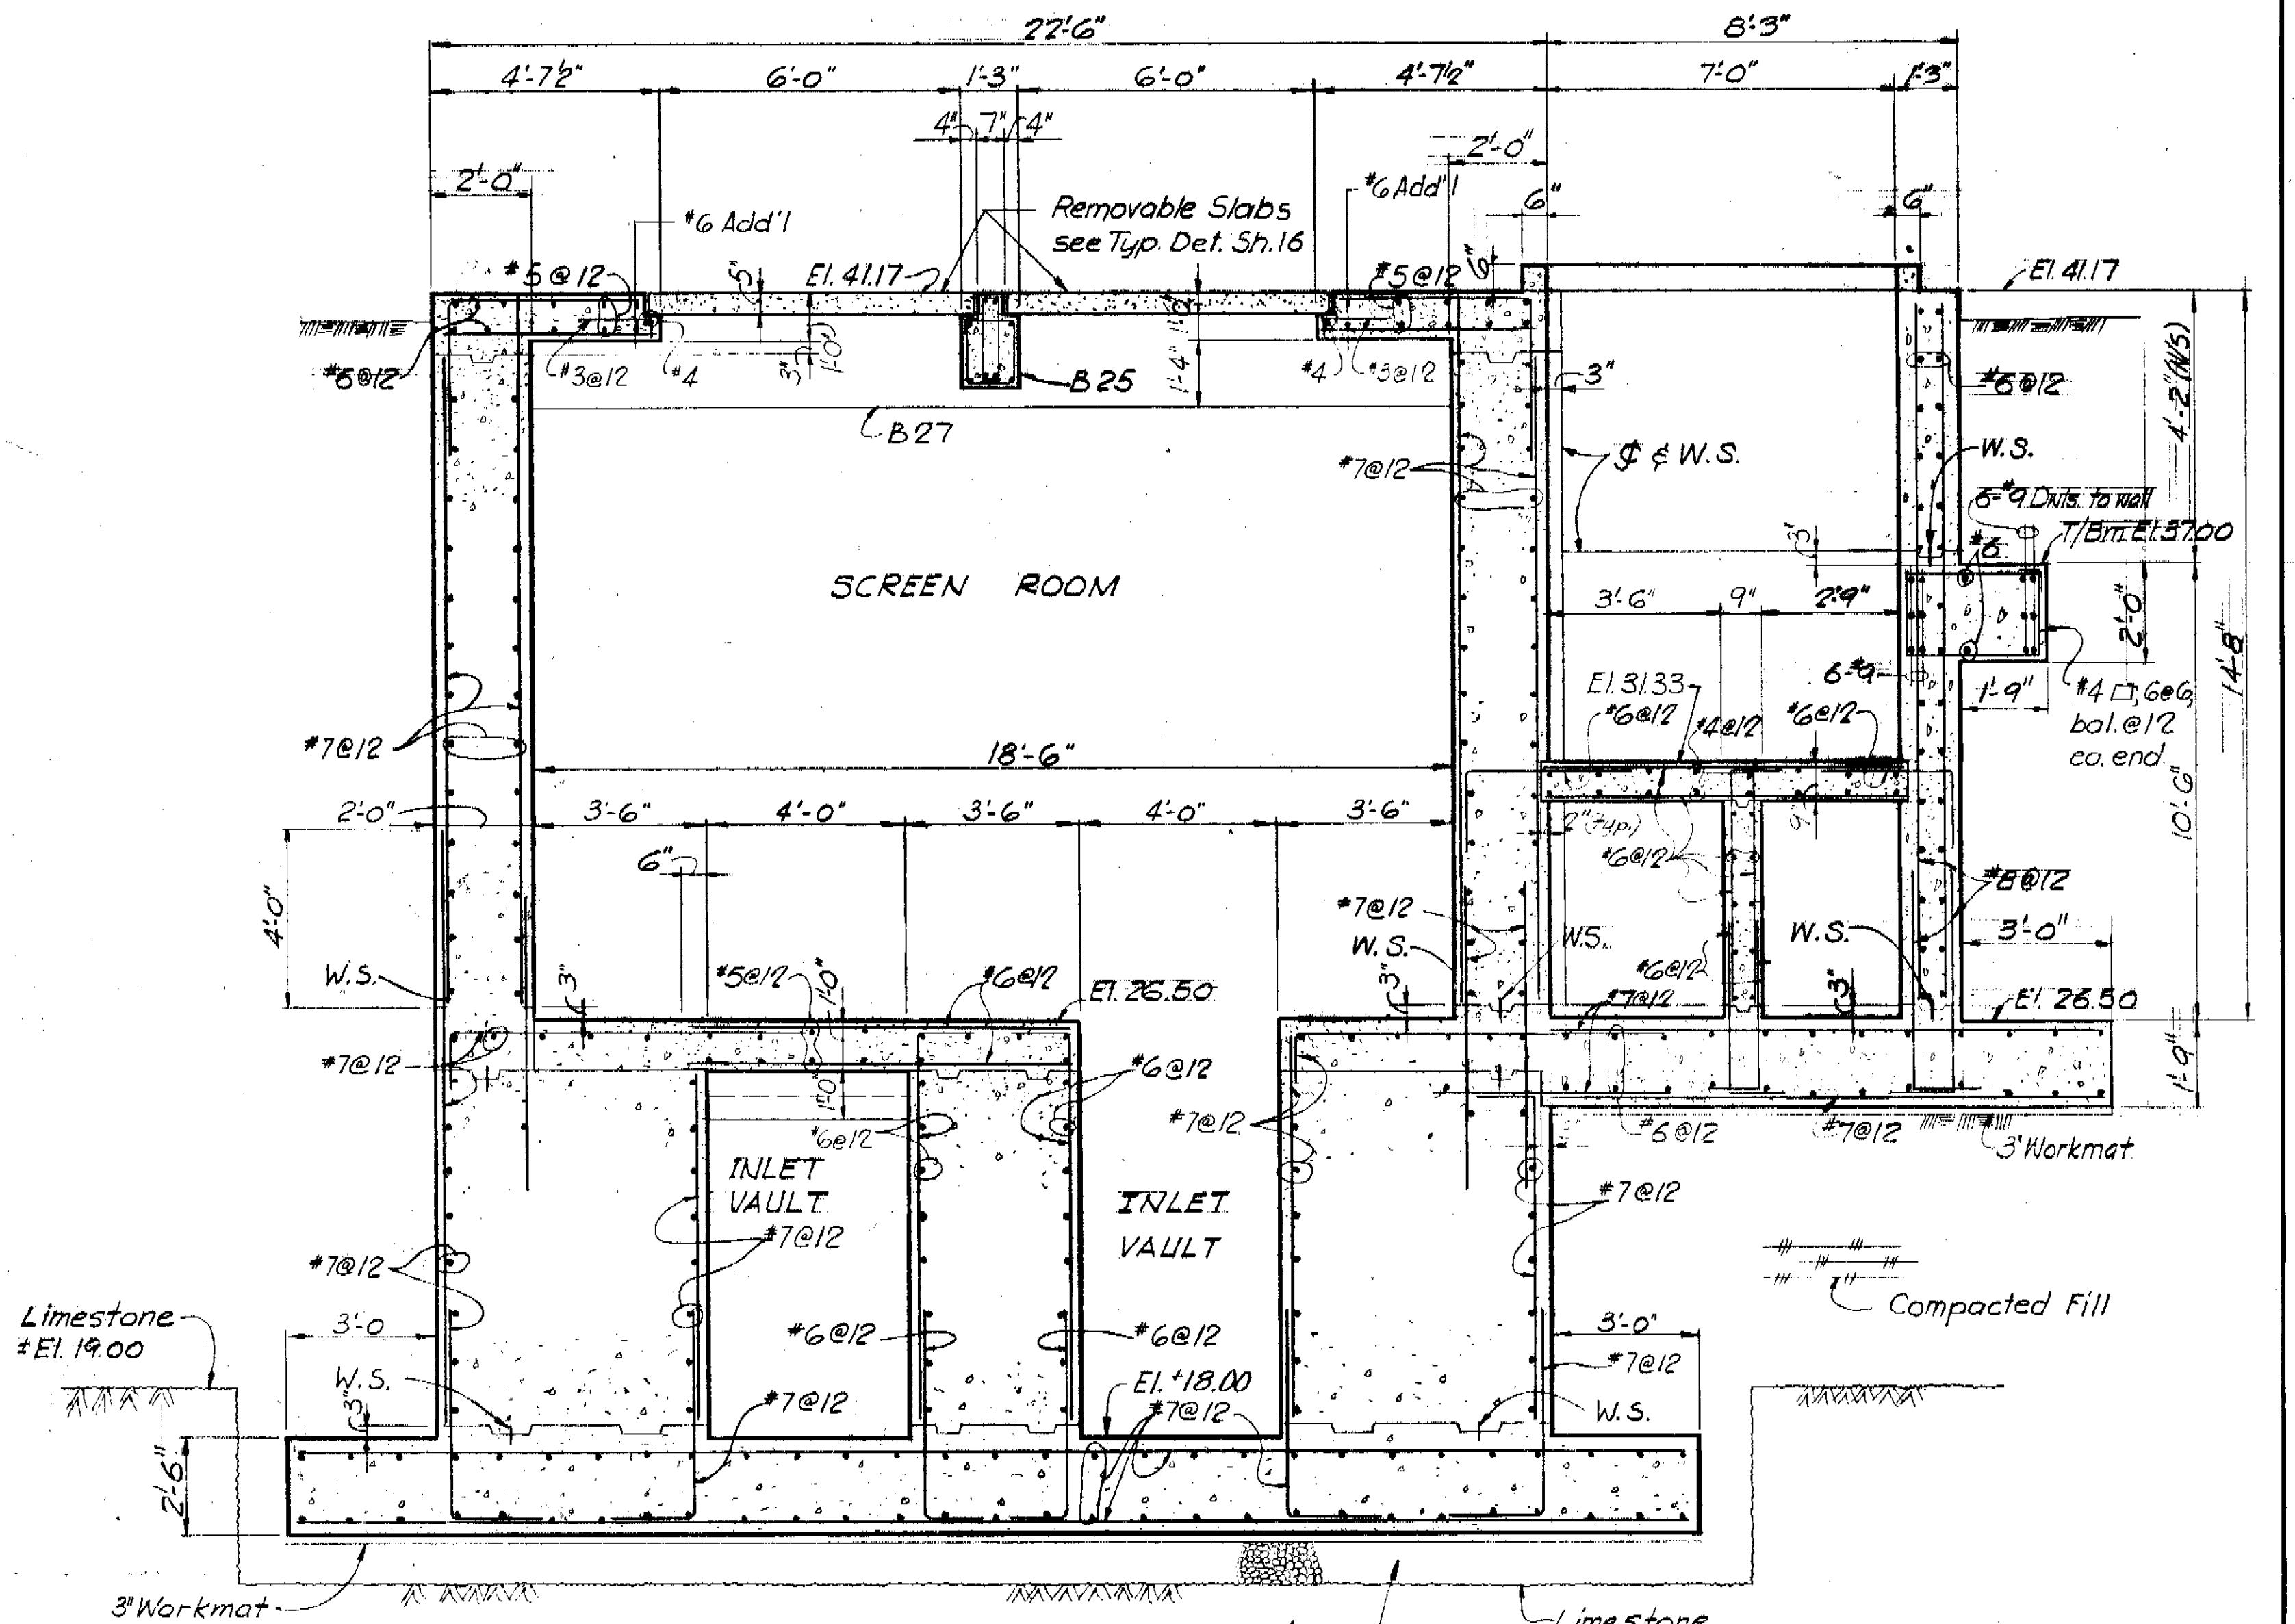

SECTION 3/7,8,9
 Scale: 3/8" = 1'-0"
 12" Min. Crushed Stone Fill

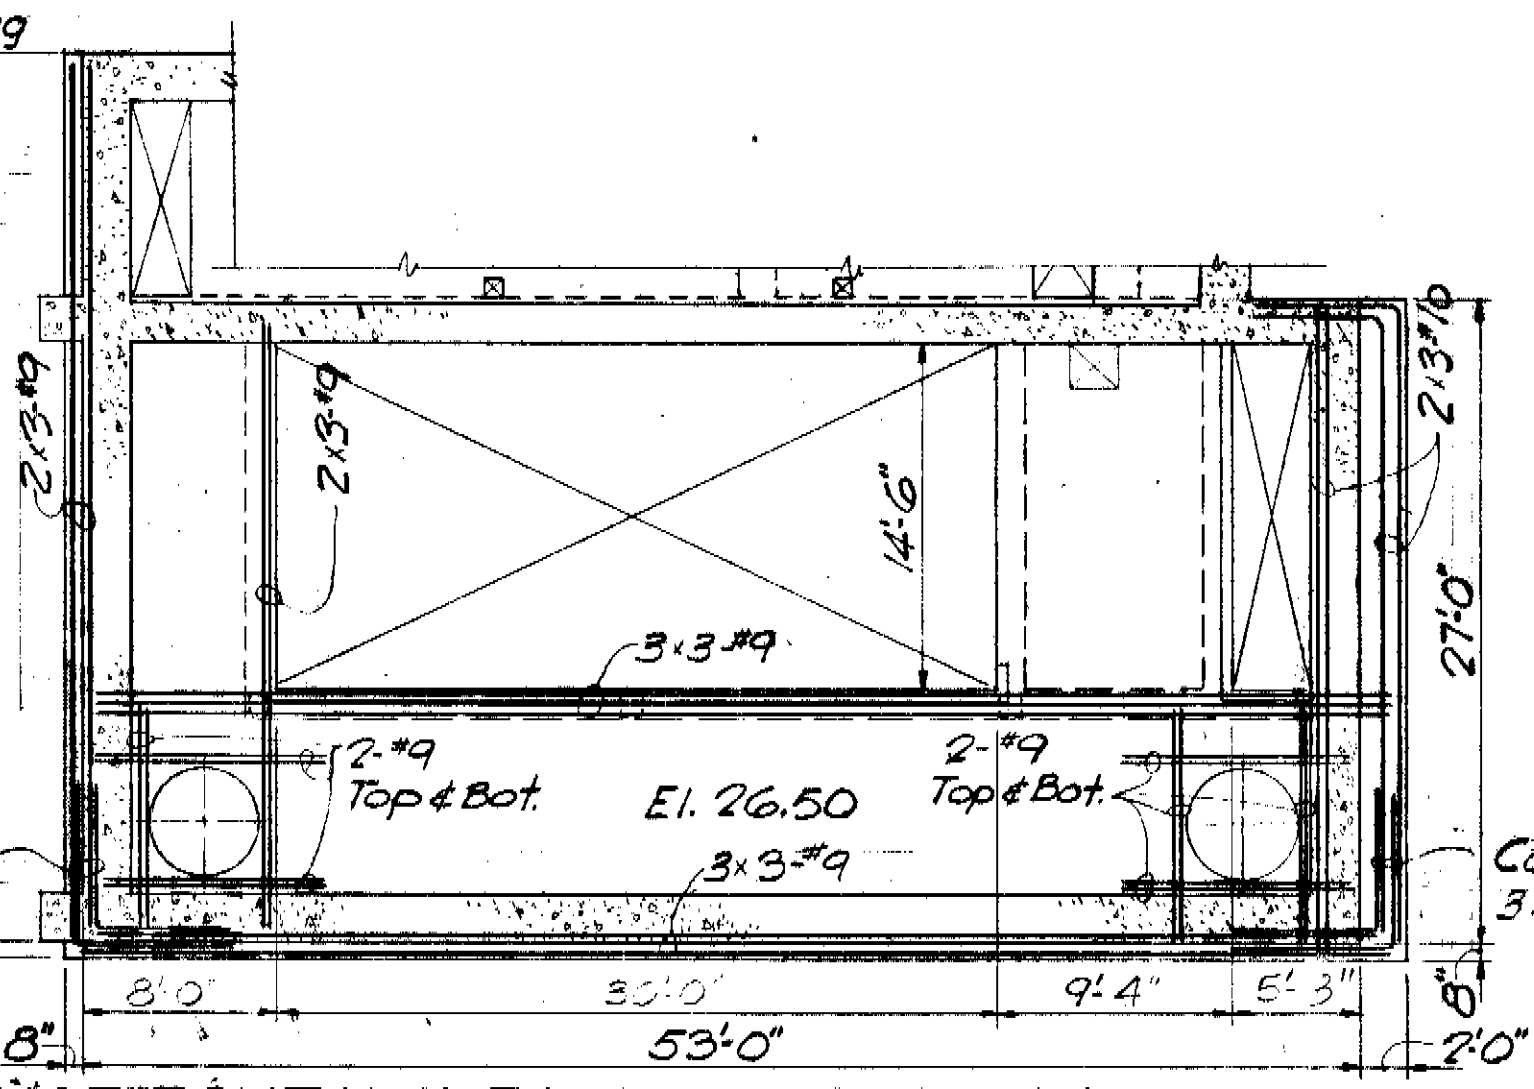

HORIZONTAL BEAM REINFORCEMENT AT EL. 26.50
 No Scale

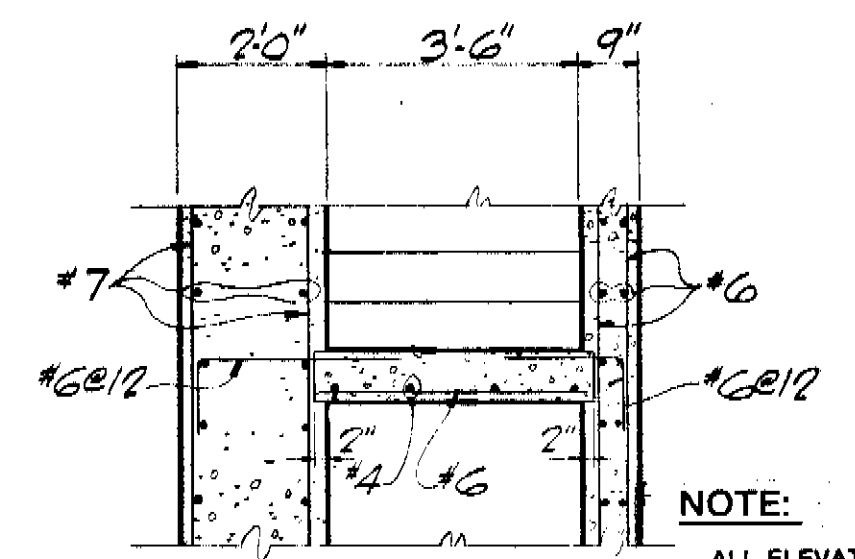

SECTION 4
 Scale: 3/8" = 1'-0"


NOTE:
 ALL ELEVATIONS SHOWN ARE REFERENCED TO CITY OF TAMPA DATUM TO CONVERT TO NATIONAL OCEAN SURVEY (NOS) DATUM, SUBTRACT 0.15 FEET (0'-1.1316").

NOTES:
 For General Notes and Typical Details see Sheets 15 & 16
 For Beam Schedule see Sh. 9
 For Curb Details see Arch. Dwgs.

RECORD DRAWING
 THIS RECORD DRAWING IS NOT WARRANTED BUT IS BELIEVED TO REPRESENT CONDITIONS UPON COMPLETION OF CONSTRUCTION WITHIN REASONABLE TOLERANCES, BASED UPON THE INFORMATION FURNISHED TO THE ENGINEER PERTAINING TO CHANGES MADE DURING CONSTRUCTION.

GREELEY AND HANSEN ENGINEERS 222 S. RIVERSIDE PLAZA CHICAGO, ILLINOIS 60606	DESIGNED PYL	APPROVED	SCALE 0 4 8 12 FT 3/16" = 1'-0" 0 2 3 4 5 6 7 FT 3/8" = 1'-0"	CITY OF TAMPA, FLORIDA SEWAGE DISPOSAL SYSTEM DIVISION 4G3 131 ST. AVENUE PUMPING STATION	STRUCTURAL INTERMEDIATE FLOOR PLAN SECTIONS	PROJ. NO. S202-70-30D-7-463
	DRAWN LT, PYL	DATE				SHEET 8 OF 35
	CHECKED SSP	DATE				DATE AUGUST, 1972 REV. 0
		REVISION				

173-45

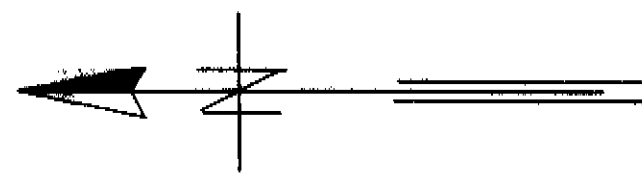


NOTE:
ALL ELEVATIONS SHOWN ARE REFERENCED TO CITY OF TAMPA DATUM. TO CONVERT TO NATIONAL OCEAN SURVEY (NOS) DATUM, SUBTRACT 0.15 FEET (0'-1.13/16").

BEAM SCHEDULE

Location	Mark	Size W x D	Bot. Bars	Top Bars			Stirrups	Width of support	Remarks
				A	B	C			
Floor Beams at El. 26.50	B1	14x20	3-#9	3-#9	3-#8	4-#4	8@6, bal. @12		
	B2	14x20	3-#8	3-#8	3-#7	4-#4	8@6, bal. @12		Extend "C" bars into slab.
	B3	14x20	3-#9	3-#8	3-#8	4-#4	8@6, bal. @12		Extend "C" bars into B1
	B4	14x20	3-#7	3-#8	3-#7	4-#4	8@6, bal. @12		Extend "C" bars into B1 or B3
	B5	14x20	3-#7	3-#8	3-#7	4-#4	8@6, bal. @12		
	B6	12x16	3-#6	2-#6			3-#4 @12		"A" bars ea. end
Floor Beams at El. 41.25	B18	18x19	3-#9	3-#9	3-#9	3-#4	8@6		Extend "B" bars into B21
	B19	12x24	3-#7		3-#6	3-#4	8@6, bal. @12		Extend "C" bars into supports
	B20	22x19	4-#9	4-#9	3-#9	4-#4	8@6, bal. @12		Extend "C" bars into B23
	B21	57x24	6-#10	6-#7	6-#6	3-#4	4@6, bal. @12		"A" bars E.E.
Floor Beams at El. 41.17	B22	36x30	6-#10	6-#7	6-#6	3-#4	4@6, bal. @12		"A" bars E.E.
	B23	14x20	4-#7	2-#7		3-#4	8@6		
Floor Beams at El. 41.17	B24	14x20	4-#8	2-#8A		3-#4	8@6		"A" bars ea. end
	B25	15x24	4-#8	4-#8	4-#8	3-#4	8@6, bal. @10		Extend "C" bars past support. See Sect 3/8
Roof Grade Beams at El. 61.75	B26	24x30	6-#10	5-#8	5-#8	3-#4	8@6, bal. @12		"A" bars E.E.
	B27	24x28	5-#11	5-#8	5-#8	4-#4	4@6, bal. @12		"A" bars E.E.
	B28	15x27	3-#9	3-#6	3-#6	4-#4	@12		"A" bars E.E.
	B29	24x42	3-#9	3-#7	3-#7	4-#4	@12		Extend bot. bars over support
	B30	24x42	4-#11	4-#7		4-#4	@12		Extend bot. bars over support
	B31	12x23 1/2	3-#6	3-#6	3-#6	3-#4	@12		Extend bot. bars over support
	B32	12x23 1/2	3-#6	3-#6	3-#6	3-#4	@12		Extend bot. bars over support
	B33	12x24 1/2	3-#9	3-#8	3-#8	3-#4	@12		"A" bars E.E.
	B34	12x24 1/2	3-#6	3-#6	3-#6	3-#4	@12		"A" bars E.E.
	B35	12x24 1/2	3-#6	3-#6	3-#6	3-#4	@12		"A" bars E.E.


**Note: B28, B29, B30 are grade beams; the depths listed are from the bottom of slab (El. 40.25)

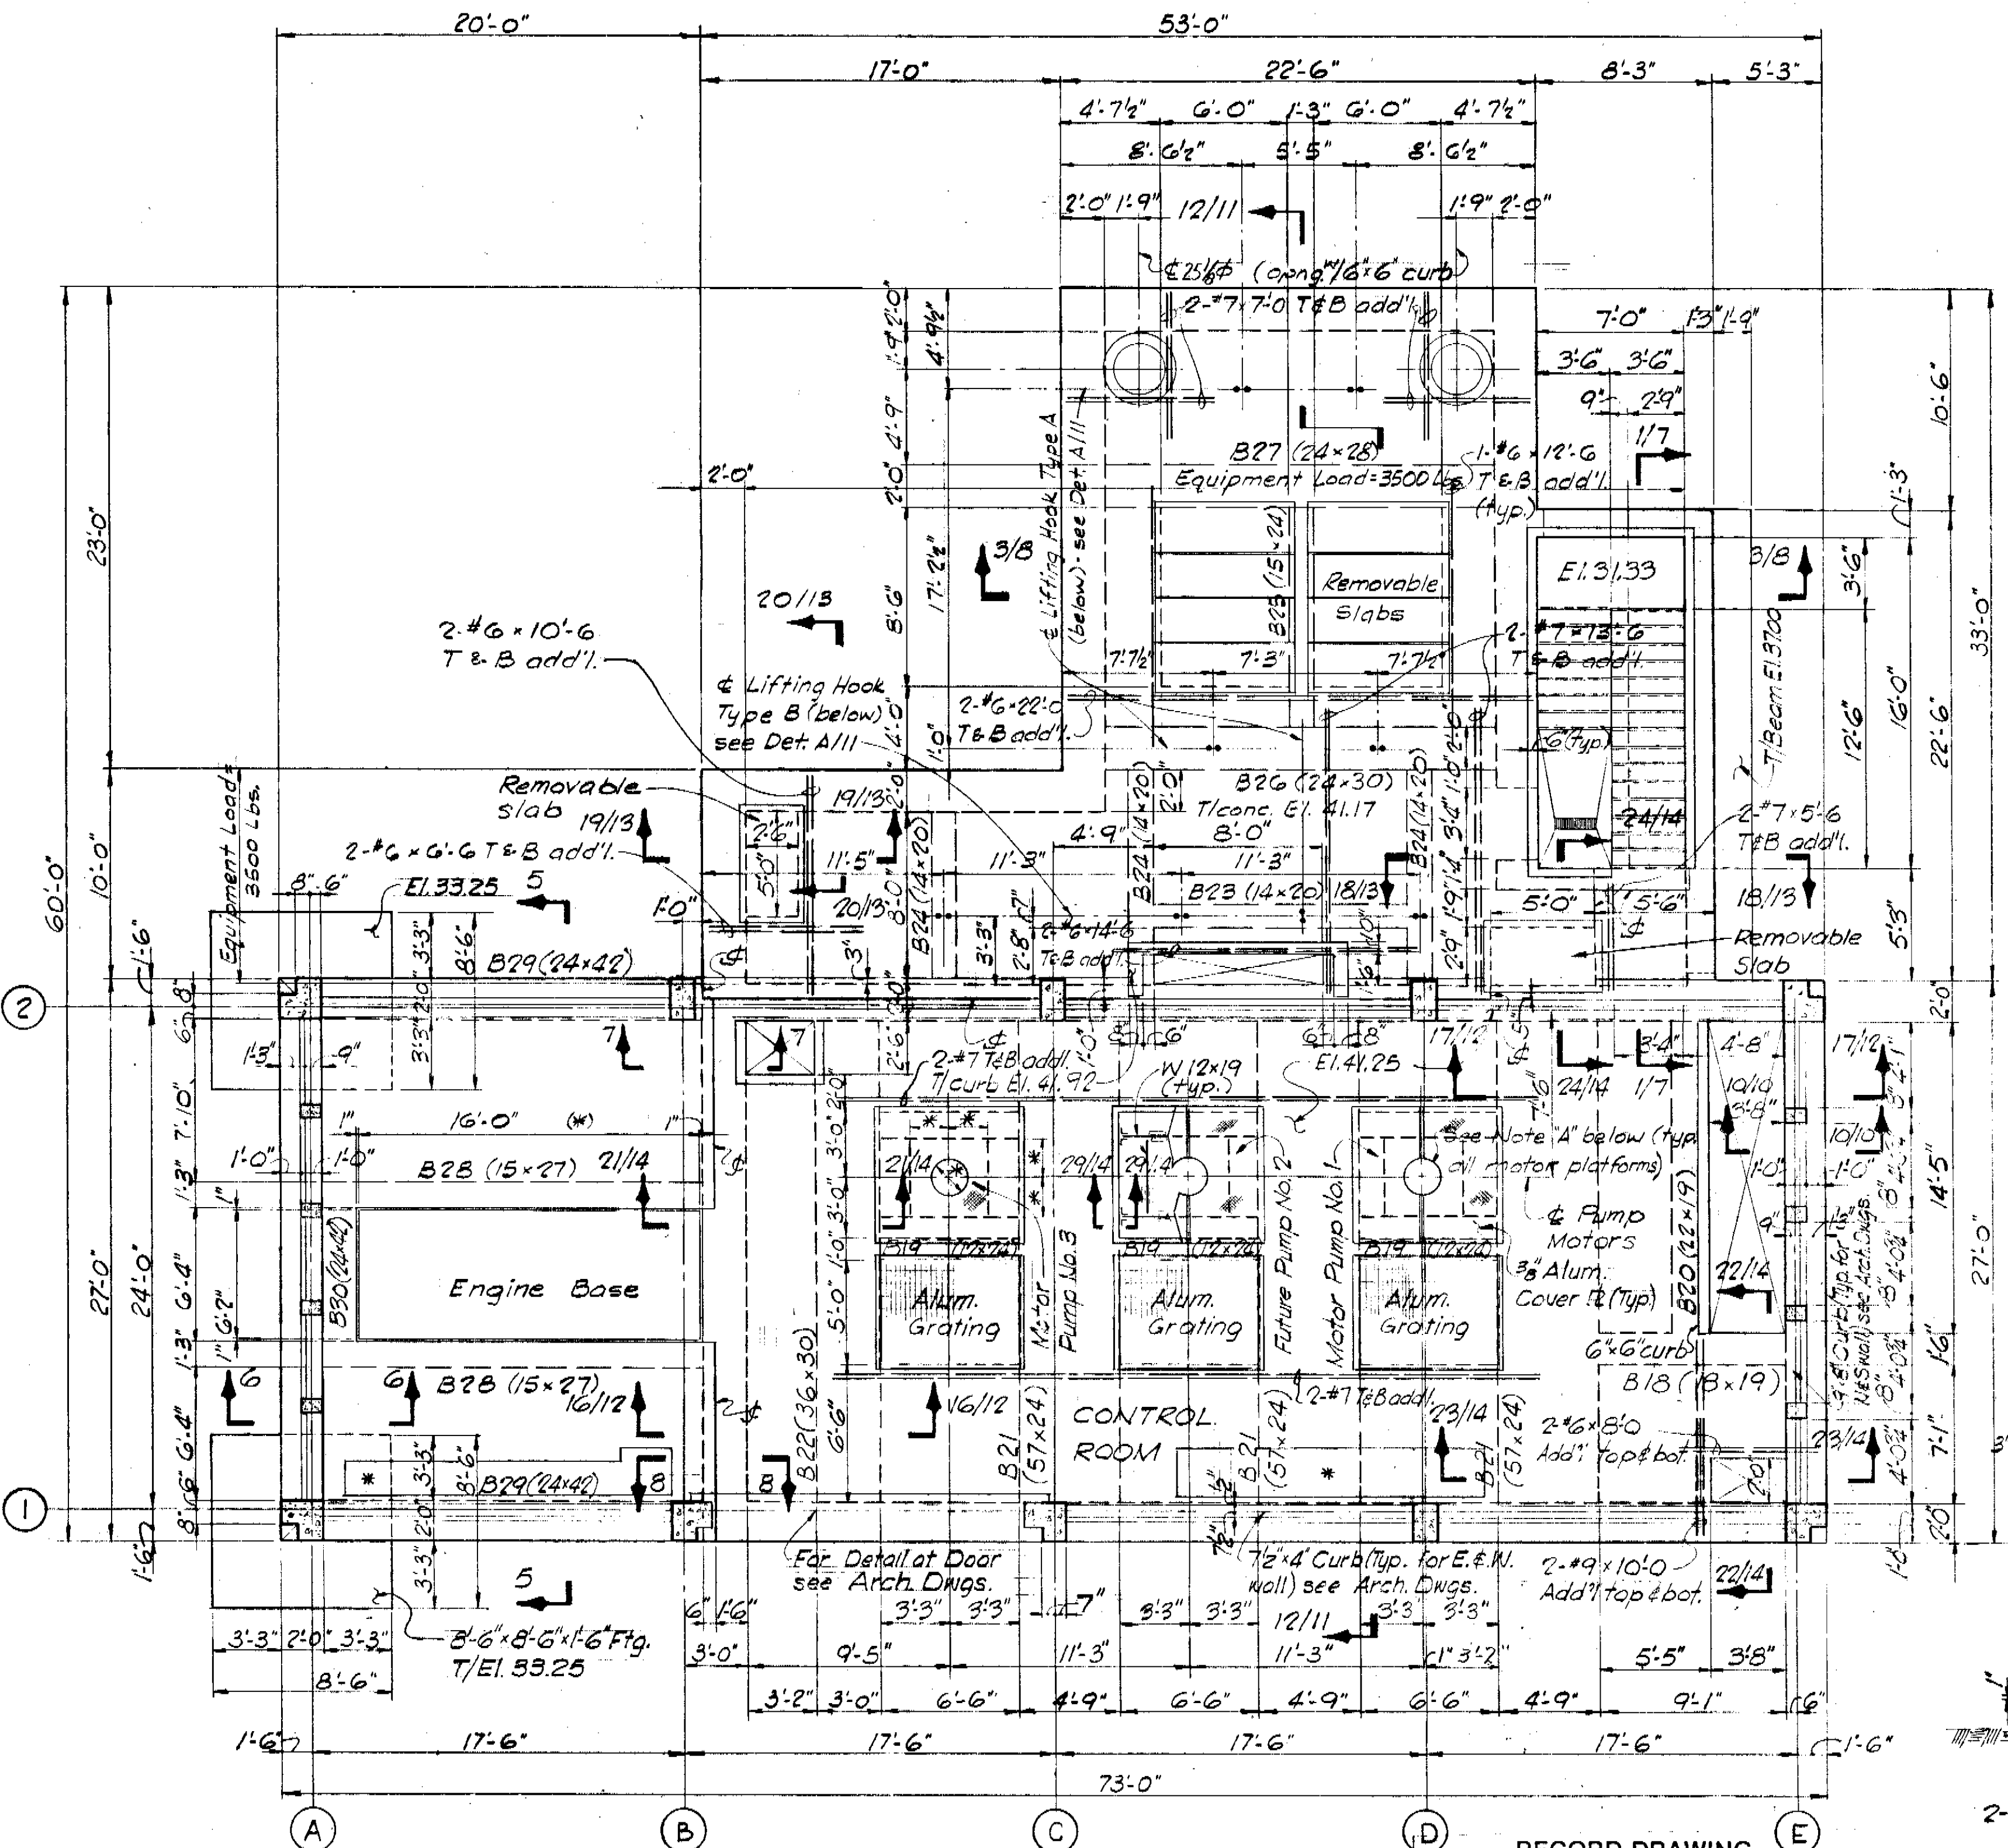

Live Load = 150 P.S.F. unless otherwise shown
FLOOR PLAN AT EL. 41.25
Scale: 3/16" = 1'-0"
T/conc. El. 41.25 unless shown or noted & denotes Construction Joint

Note "A":
Arrangement of plates and supports around motors shall be modified as required to accommodate proposed motor platform construction.

RECORD DRAWING
THIS RECORD DRAWING IS NOT WARRANTED. IT IS BELIEVED TO REPRESENT CONDITIONS UPON COMPLETION OF CONSTRUCTION WITHIN REASONABLE TOLERANCES. BASED UPON THE INFORMATION FURNISHED TO THE ENGINEER PERTAINING TO CHANGES MADE DURING CONSTRUCTION.
* Size & location of equipment pads & dimensions shown thus (*) to be determined after selection of equip. See also Equipment Dwg.

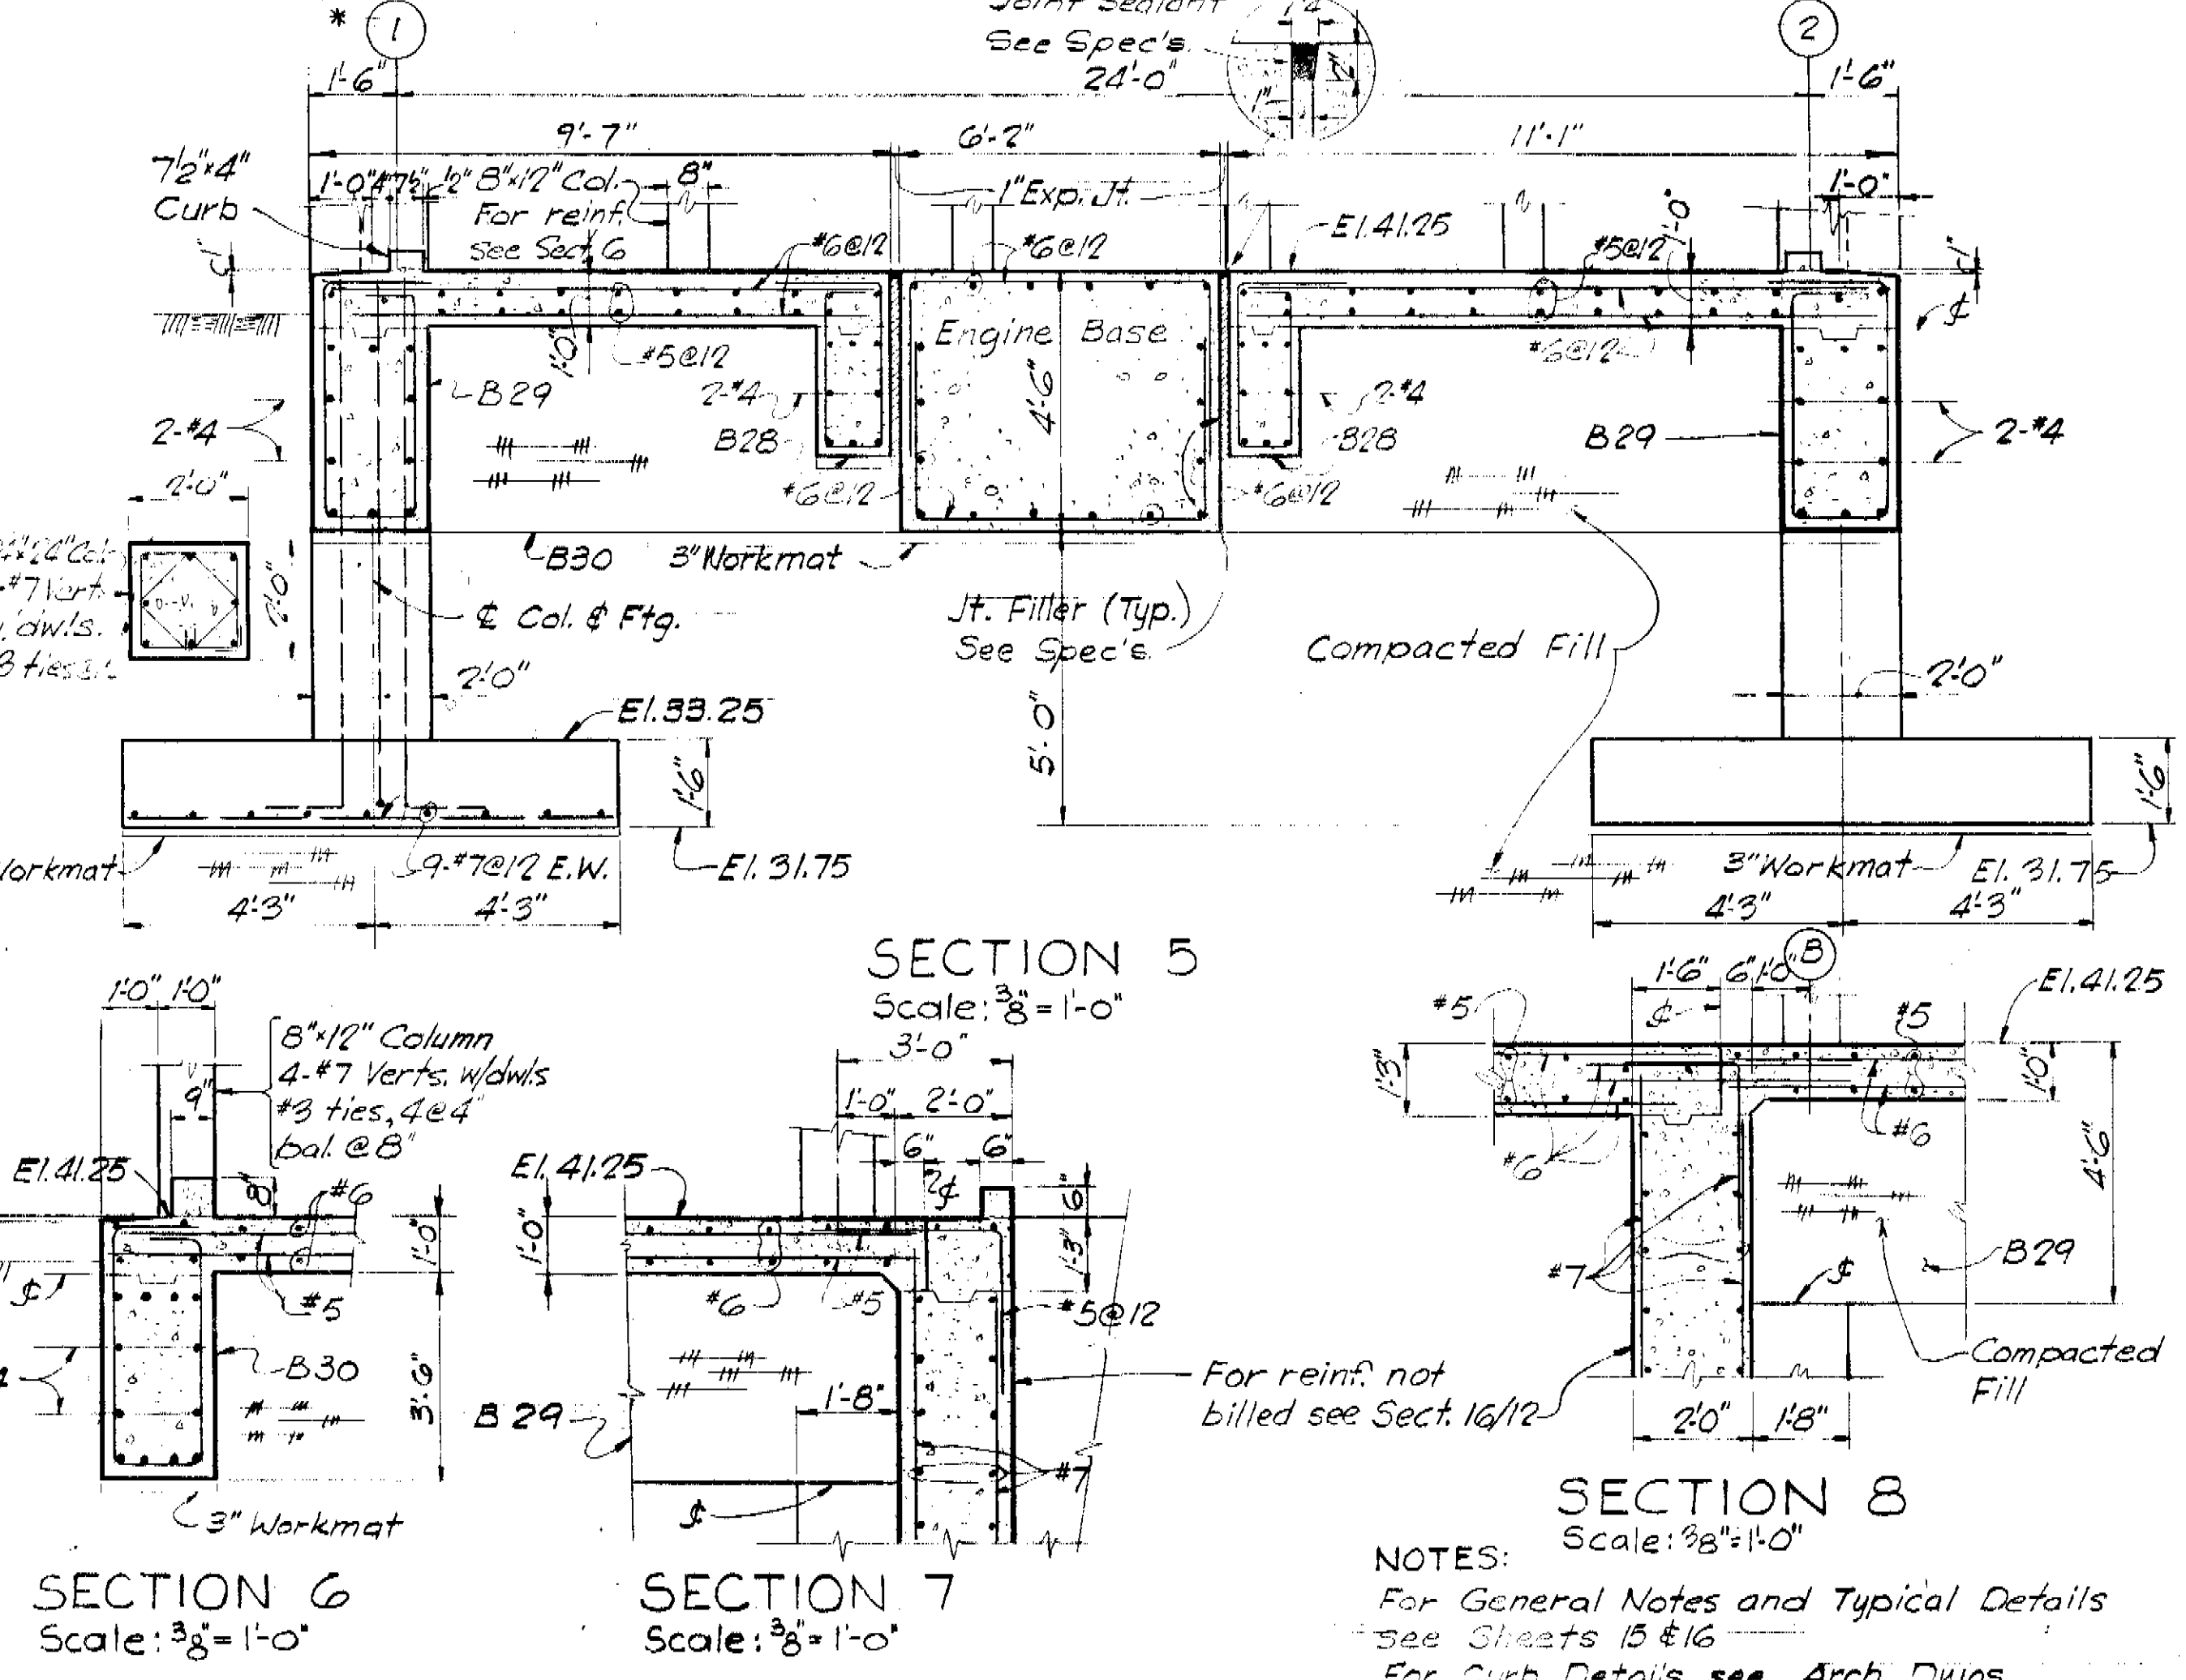

SECTION 6
Scale: 3/8" = 1'-0"

SECTION 7
Scale: 3/8" = 1'-0"

SECTION 5
Scale: 3/8" = 1'-0"

SECTION 8
Scale: 3/8" = 1'-0"


NOTES:
For General Notes and Typical Details see Sheets 15 & 16
For Curb Details see Arch. Dwg.

GREELEY AND HANSEN ENGINEERS
222 S. RIVERSIDE PLAZA
CHICAGO, ILLINOIS 60606

DESIGNED EP, JFJ
DRAWN LT, PYL
CHECKED SSP

APPROVED
Supt., Dept. of Sanitary Sewers
DATE
Greeley and Hansen, Engineers

NO.	DATE	APP.	REVISION
1	9/81	DSH	Rec. Dwg. Revisions
	Mar 78	JRP	Plans Updated

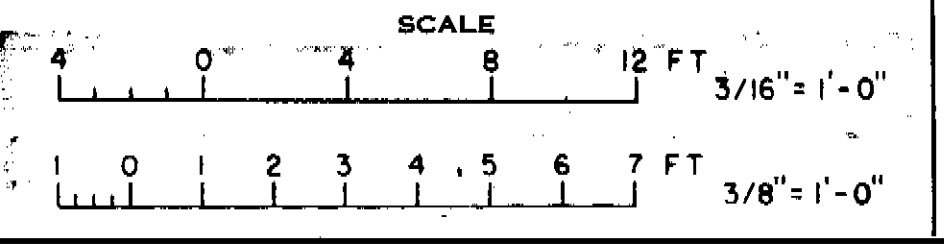


CITY OF TAMPA, FLORIDA
SEWAGE DISPOSAL SYSTEM
DIVISION 463
131 ST. AVENUE PUMPING STATION


STRUCTURAL TOP FLOOR PLAN SECTIONS

PROJ. NO. S202-70-300-7-463
SHEET 9 OF 35
DATE AUGUST, 1972 REV. 0

173-446

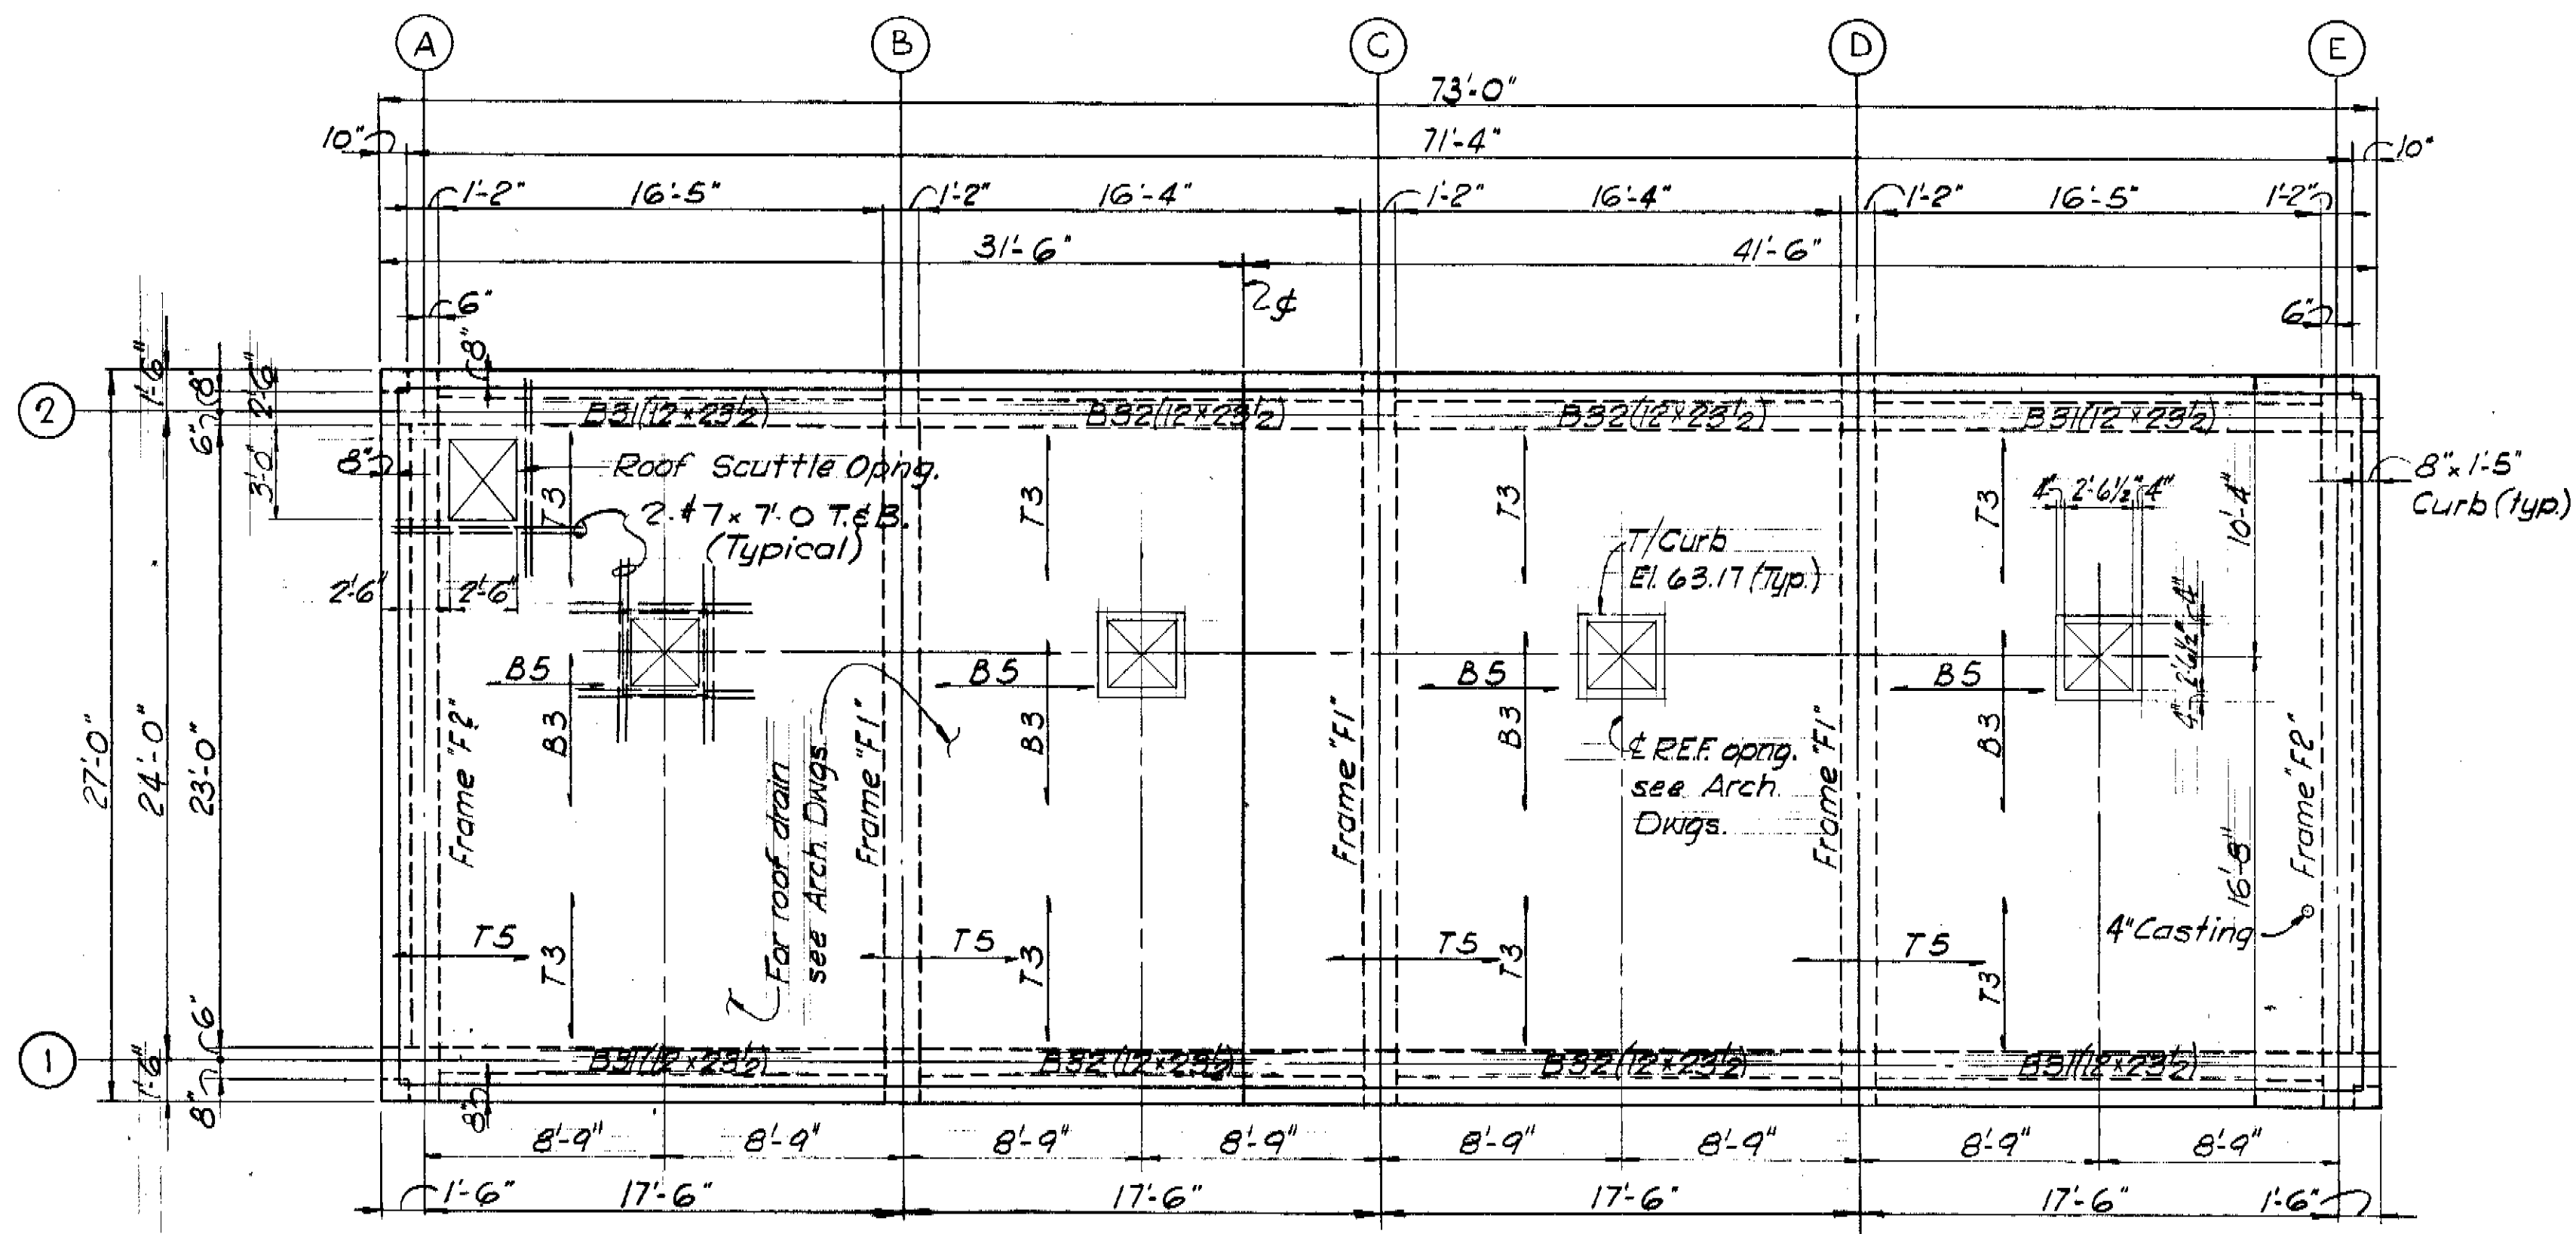


Live Load 30 P.S.F.
ROOF FRAMING PLAN
 Scale: 3/16" = 1'-0"
 T/conc. El. 61.75
 Slab thickness 8" unless shown or noted
 & designates Construction Joint

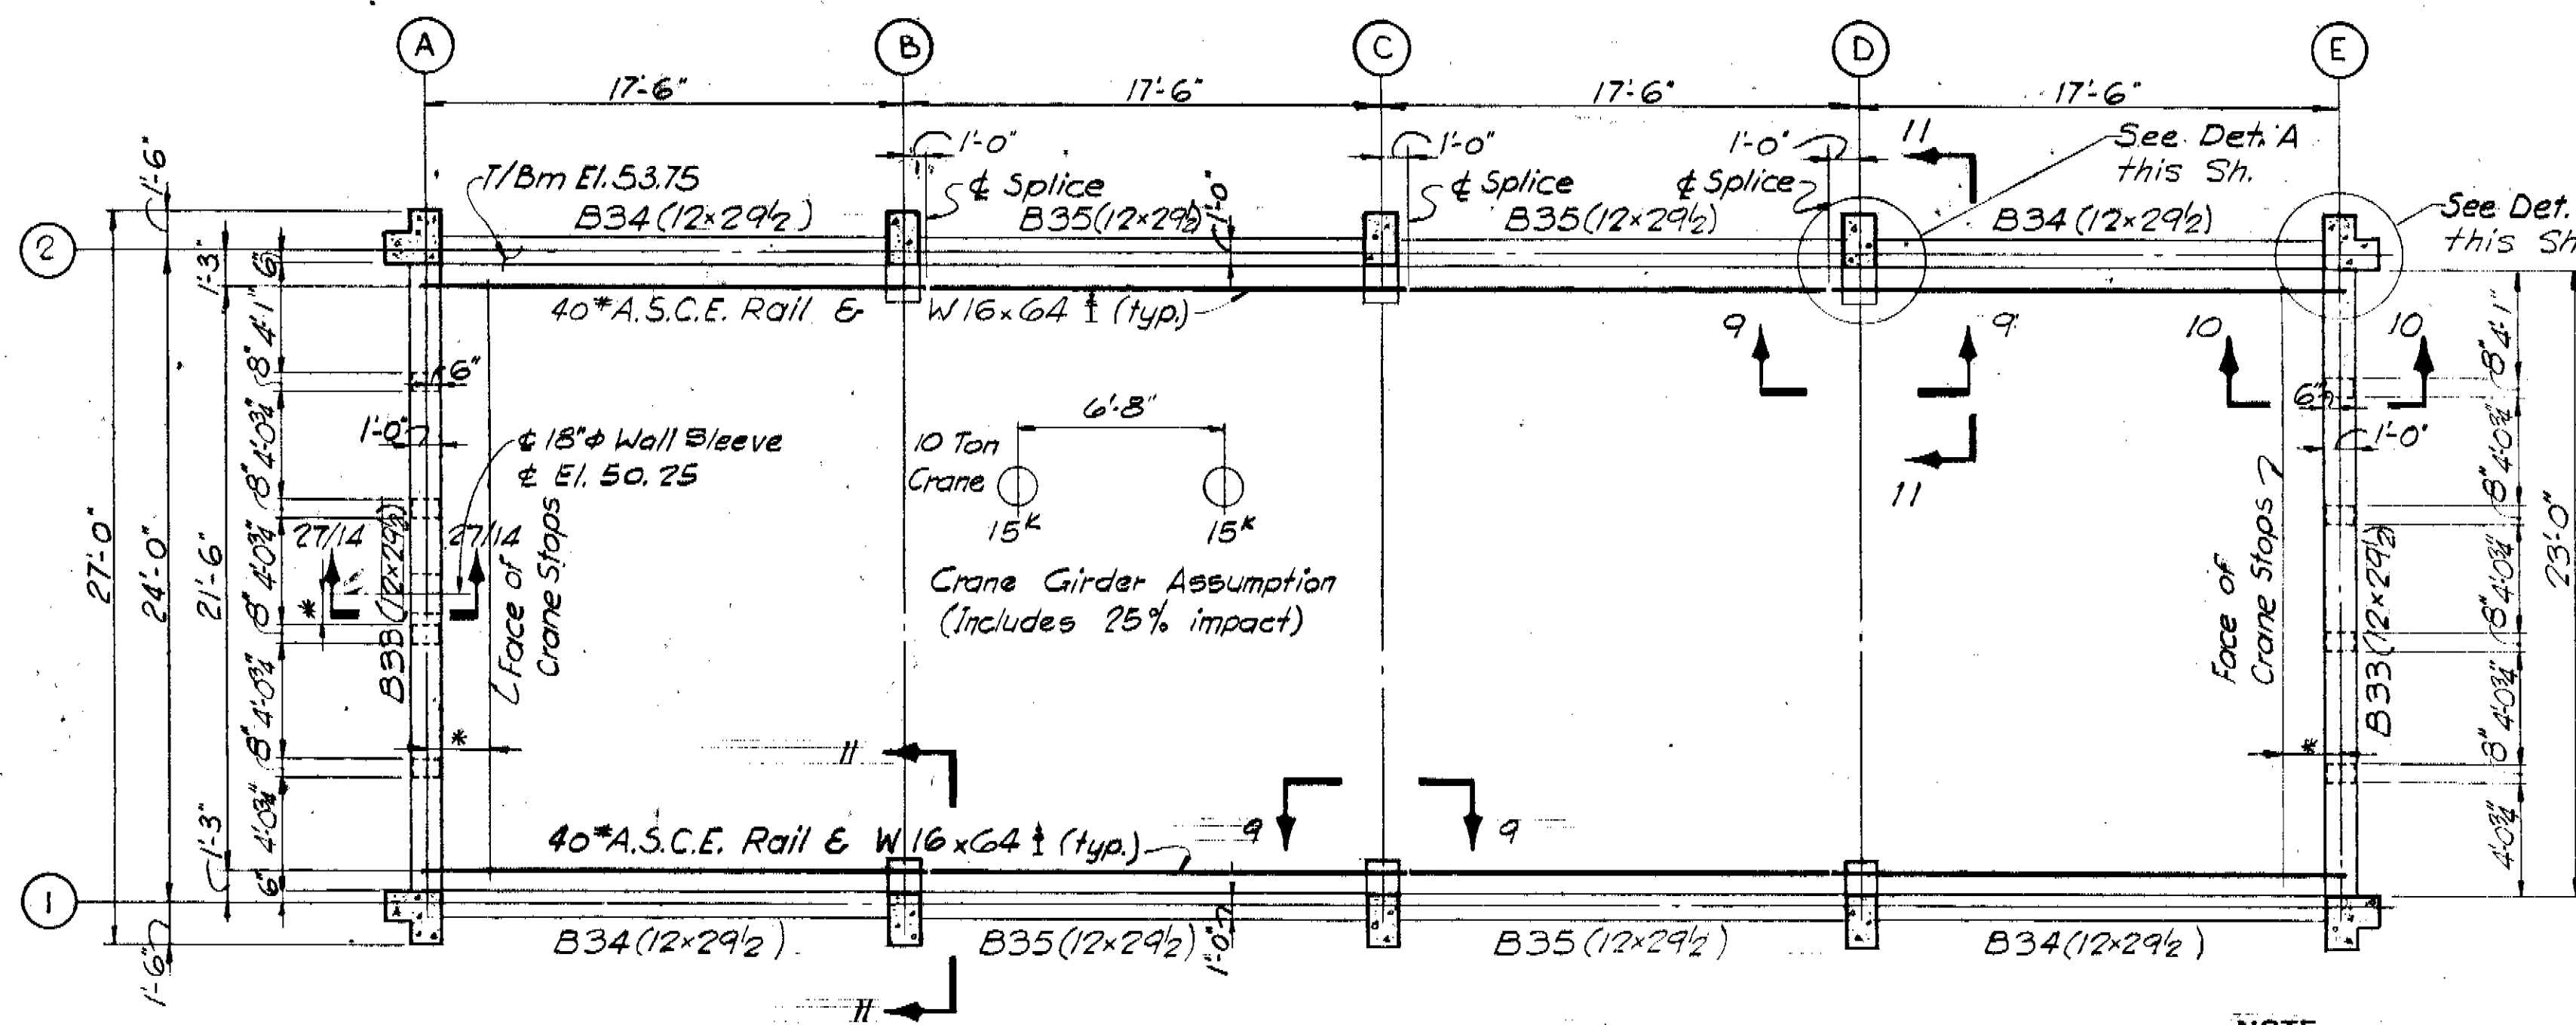


CRANE GIRDER PLAN
 Scale: 3/16" = 1'-0"
 T/Crane Rail El. 55.75
 Crane Stops by Crane Mfg.

NOTE:
 ALL ELEVATIONS SHOWN ARE REFERENCED TO CITY OF TAMPA DATUM. TO CONVERT TO NATIONAL OCEAN SURVEY (NOS) DATUM, SUBTRACT 0.15 FEET (0-1 13/16").
 Dimensions shown thus (*) to be determined after selection of equipment.

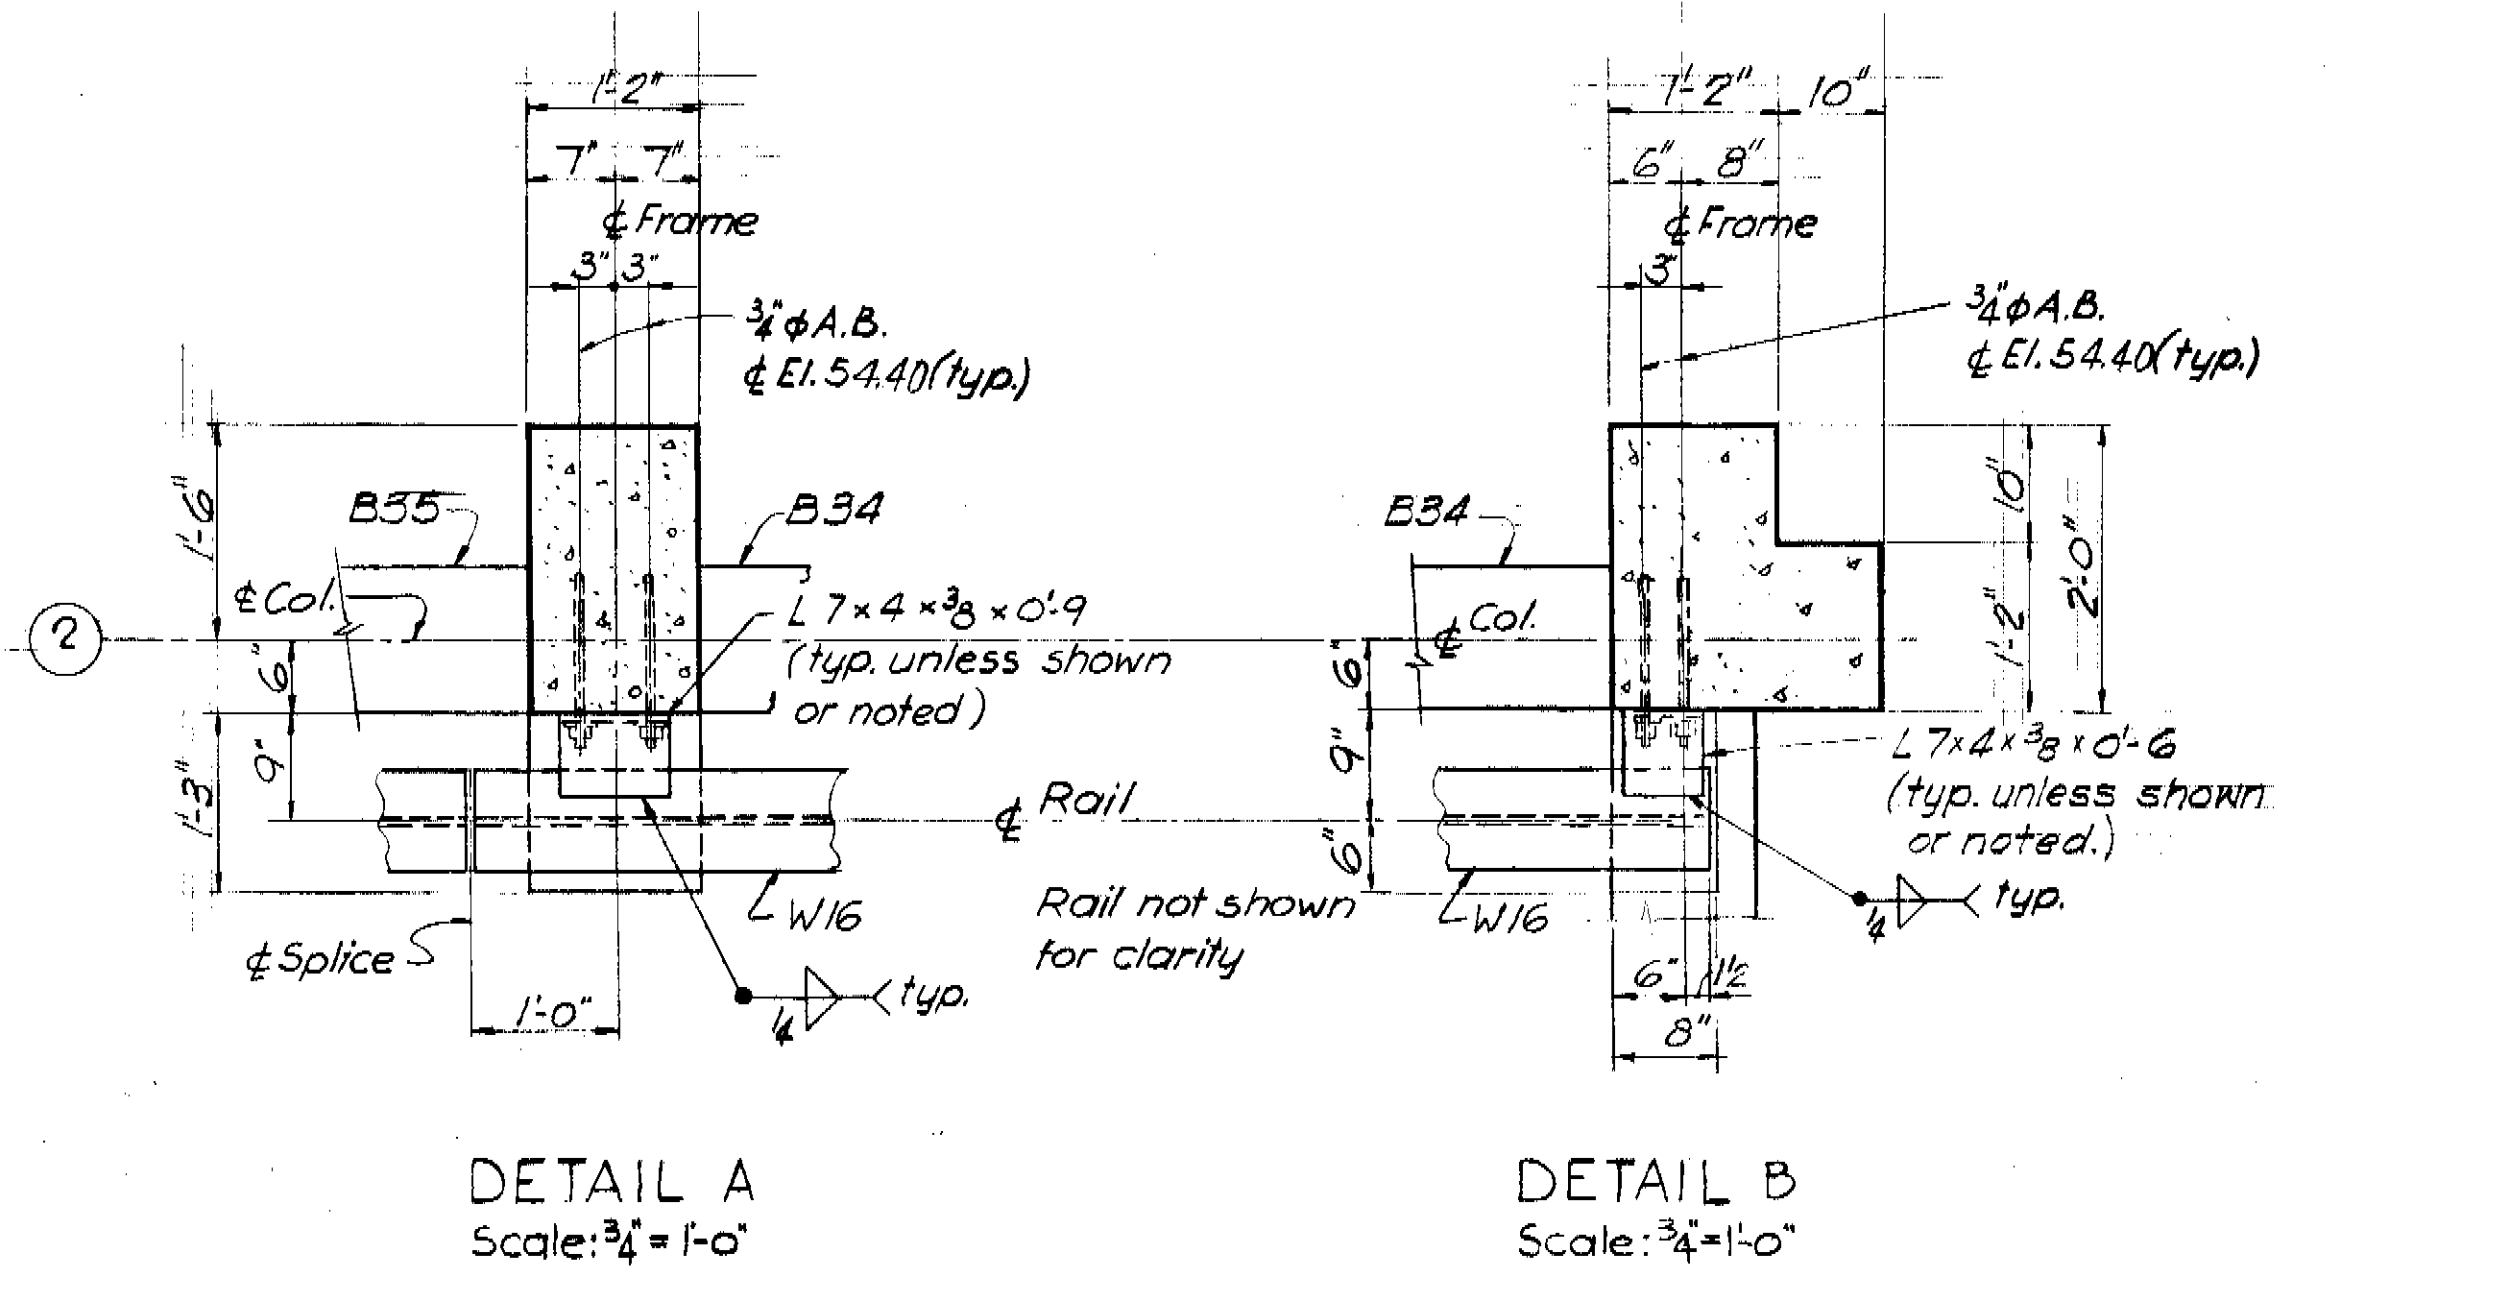

DETAIL A
 Scale: 3/4" = 1'-0"
DETAIL B
 Scale: 3/4" = 1'-0"

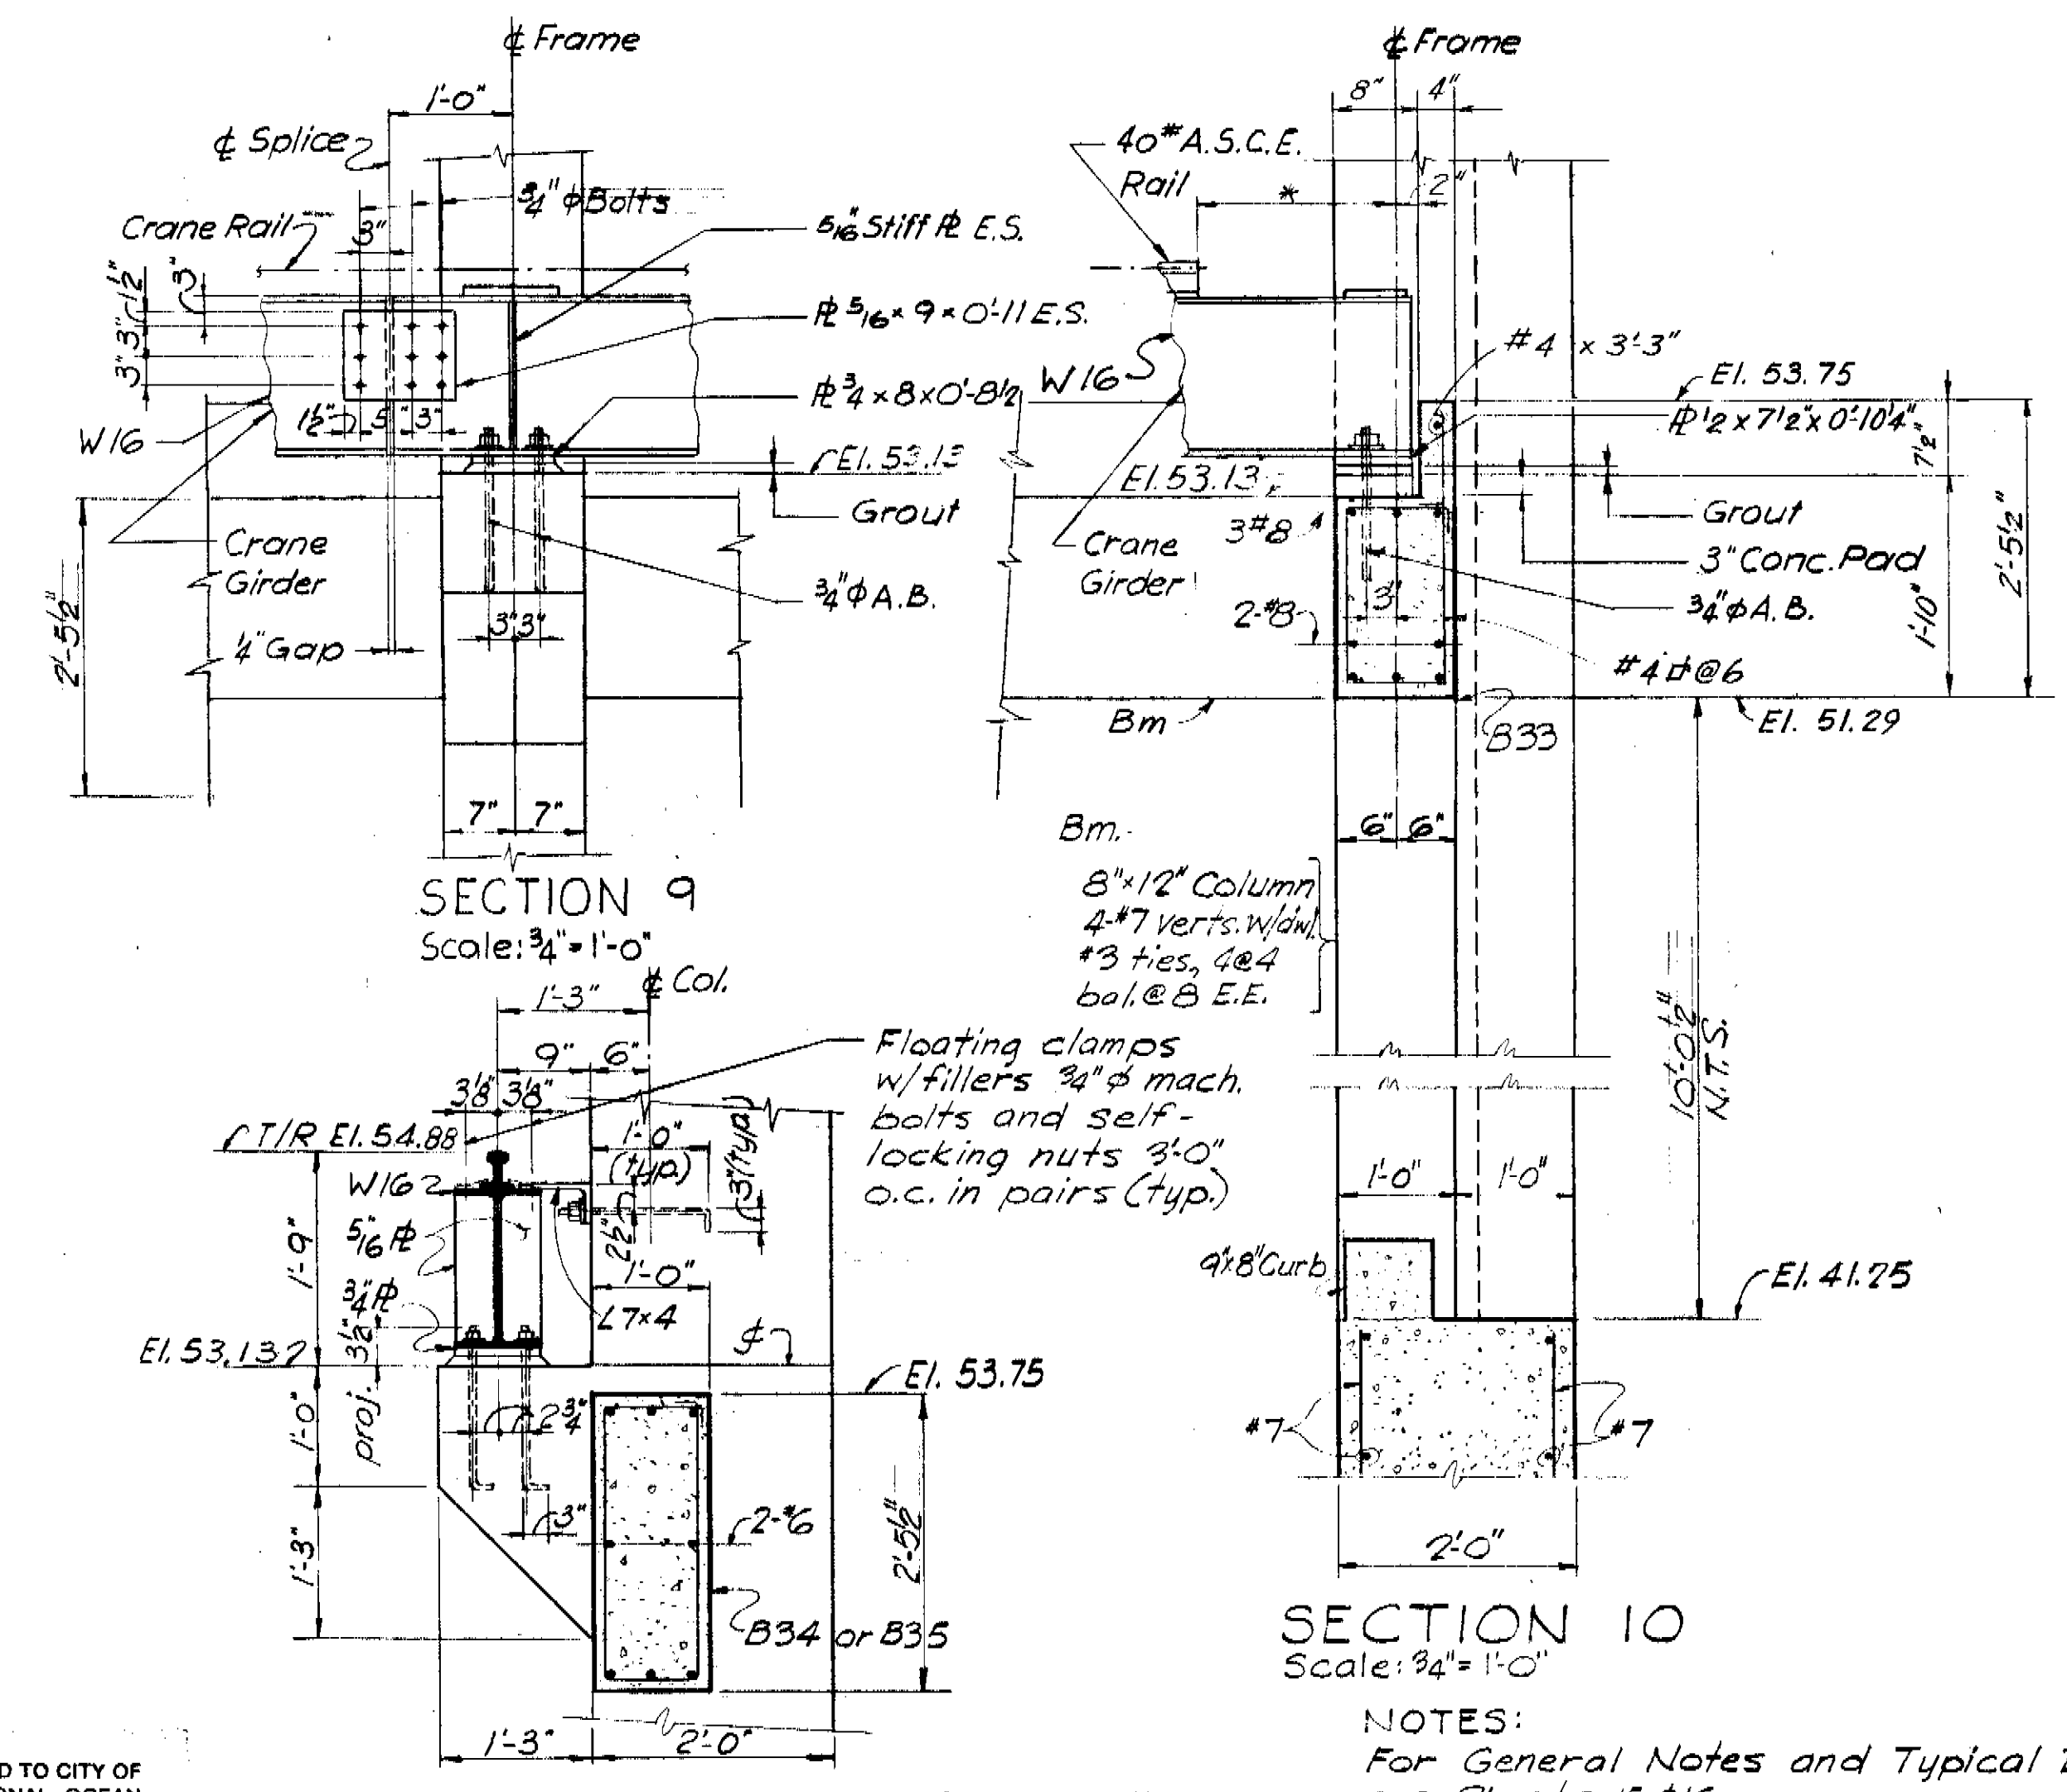


SECTION 9
 Scale: 3/4" = 1'-0"
SECTION 10
 Scale: 3/4" = 1'-0"

NOTES:
 For General Notes and Typical Details see Sheets 15 & 16
 For Beam Schedule see Sh. 9

GREELEY AND HANSEN ENGINEERS
 222 S. RIVERSIDE PLAZA
 CHICAGO, ILLINOIS 60606

DESIGNED EP
 DRAWN LT
 CHECKED SSP

APPROVED		DATE	
SUPT., DEPT. OF SANITARY SEWERS	1	9/81	DSH
GREELEY AND HANSEN, ENGINEERS	2	Mar 78	JFP

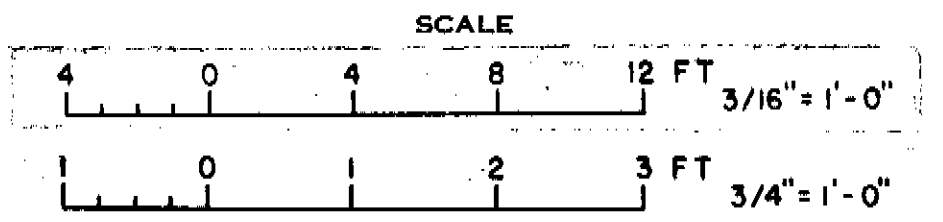


CITY OF TAMPA, FLORIDA
 SEWAGE DISPOSAL SYSTEM
 DIVISION 4G3
 131 ST. AVENUE PUMPING STATION

STRUCTURAL
ROOF FRAMING PLAN
CRANE GIRDER PLAN AND DETAILS


PROJ. NO. S202-70-300-7-463
 SHEET 10 OF 35
 DATE AUGUST, 1972 REV. 0

173-47

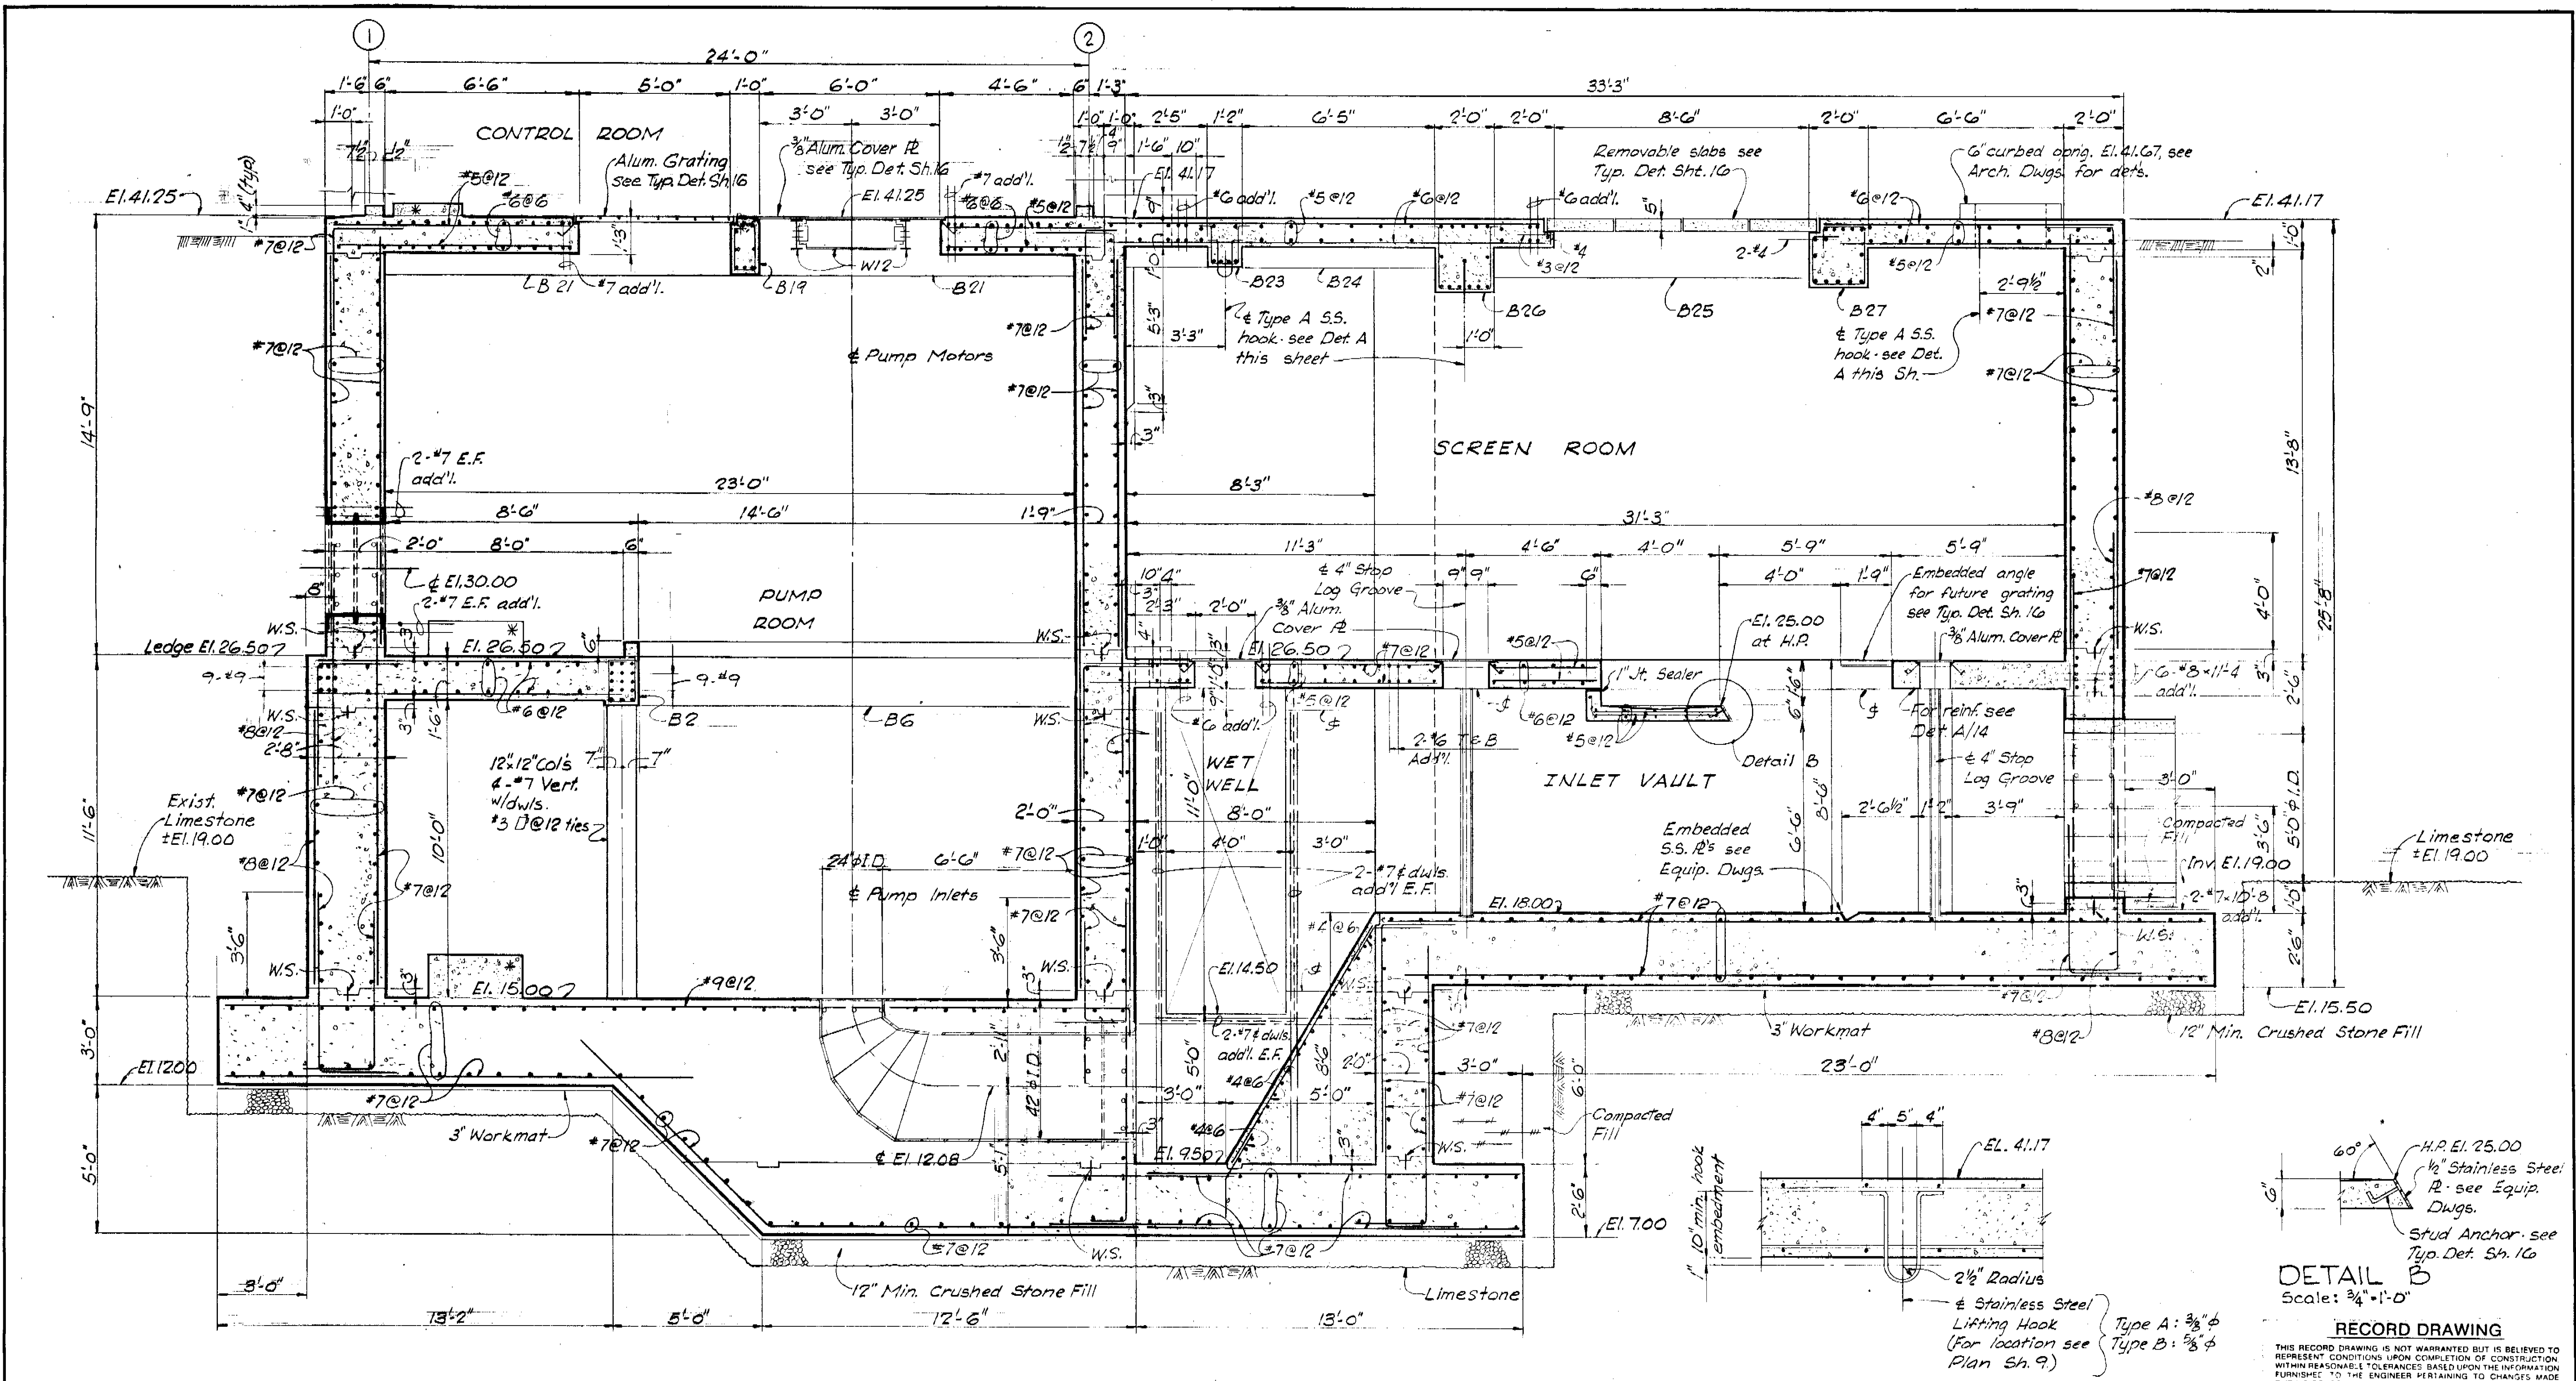

SECTION T2/78,9
Scale: 3/8"=1'-0"

DETAIL A/9
Scale: 1"=1'-0"

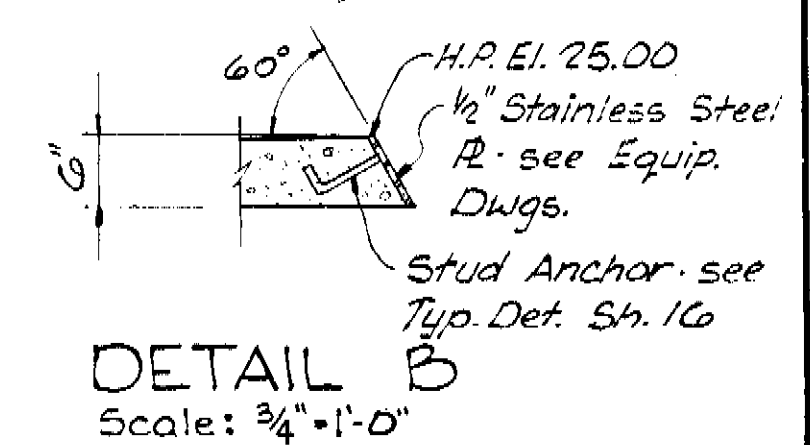

RECORD DRAWING
THIS RECORD DRAWING IS NOT WARRANTED BUT IS BELIEVED TO REPRESENT CONDITIONS UPON COMPLETION OF CONSTRUCTION WITHIN REASONABLE TOLERANCES BASED UPON THE INFORMATION FURNISHED TO THE ENGINEER PERTAINING TO CHANGES MADE DURING CONSTRUCTION.

NOTE:
ALL ELEVATIONS SHOWN ARE REFERENCED TO CITY OF TAMPA DATUM TO CONVERT TO NATIONAL OCEAN SURVEY (NOS) DATUM, SUBTRACT 0.15 FEET (0'-1.13/16").

NOTES:
For General Notes and Typical Details see Sh. 15 & 16
For Beam Schedule see Sh. 9


* Size and location of equipment pads and dimensions shown thus (*) to be determined after selection of equipment.

GREELEY AND HANSEN ENGINEERS
222 S. RIVERSIDE PLAZA
CHICAGO, ILLINOIS 60606

DESIGNED PYL, JJF
DRAWN LT, PYL
CHECKED SSP

APPROVED
DATE
Supt., Dept. of Sanitary Sewers
DATE
GREELEY AND HANSEN, ENGINEERS


NO.	DATE	APP.	REVISION
1	9/81	DSH	Rec. Dwg. Revisions
	Mar 78	JRP	Plans Updated

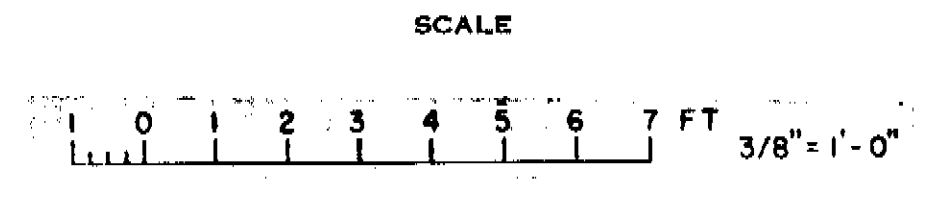


CITY OF TAMPA, FLORIDA
SEWAGE DISPOSAL SYSTEM
DIVISION 4G3
131 ST. AVENUE PUMPING STATION

STRUCTURAL SECTION
PROJ. NO. S202-70-300-7-463
SHEET 11 OF 35
DATE AUGUST, 1972 REV. 0


173-48

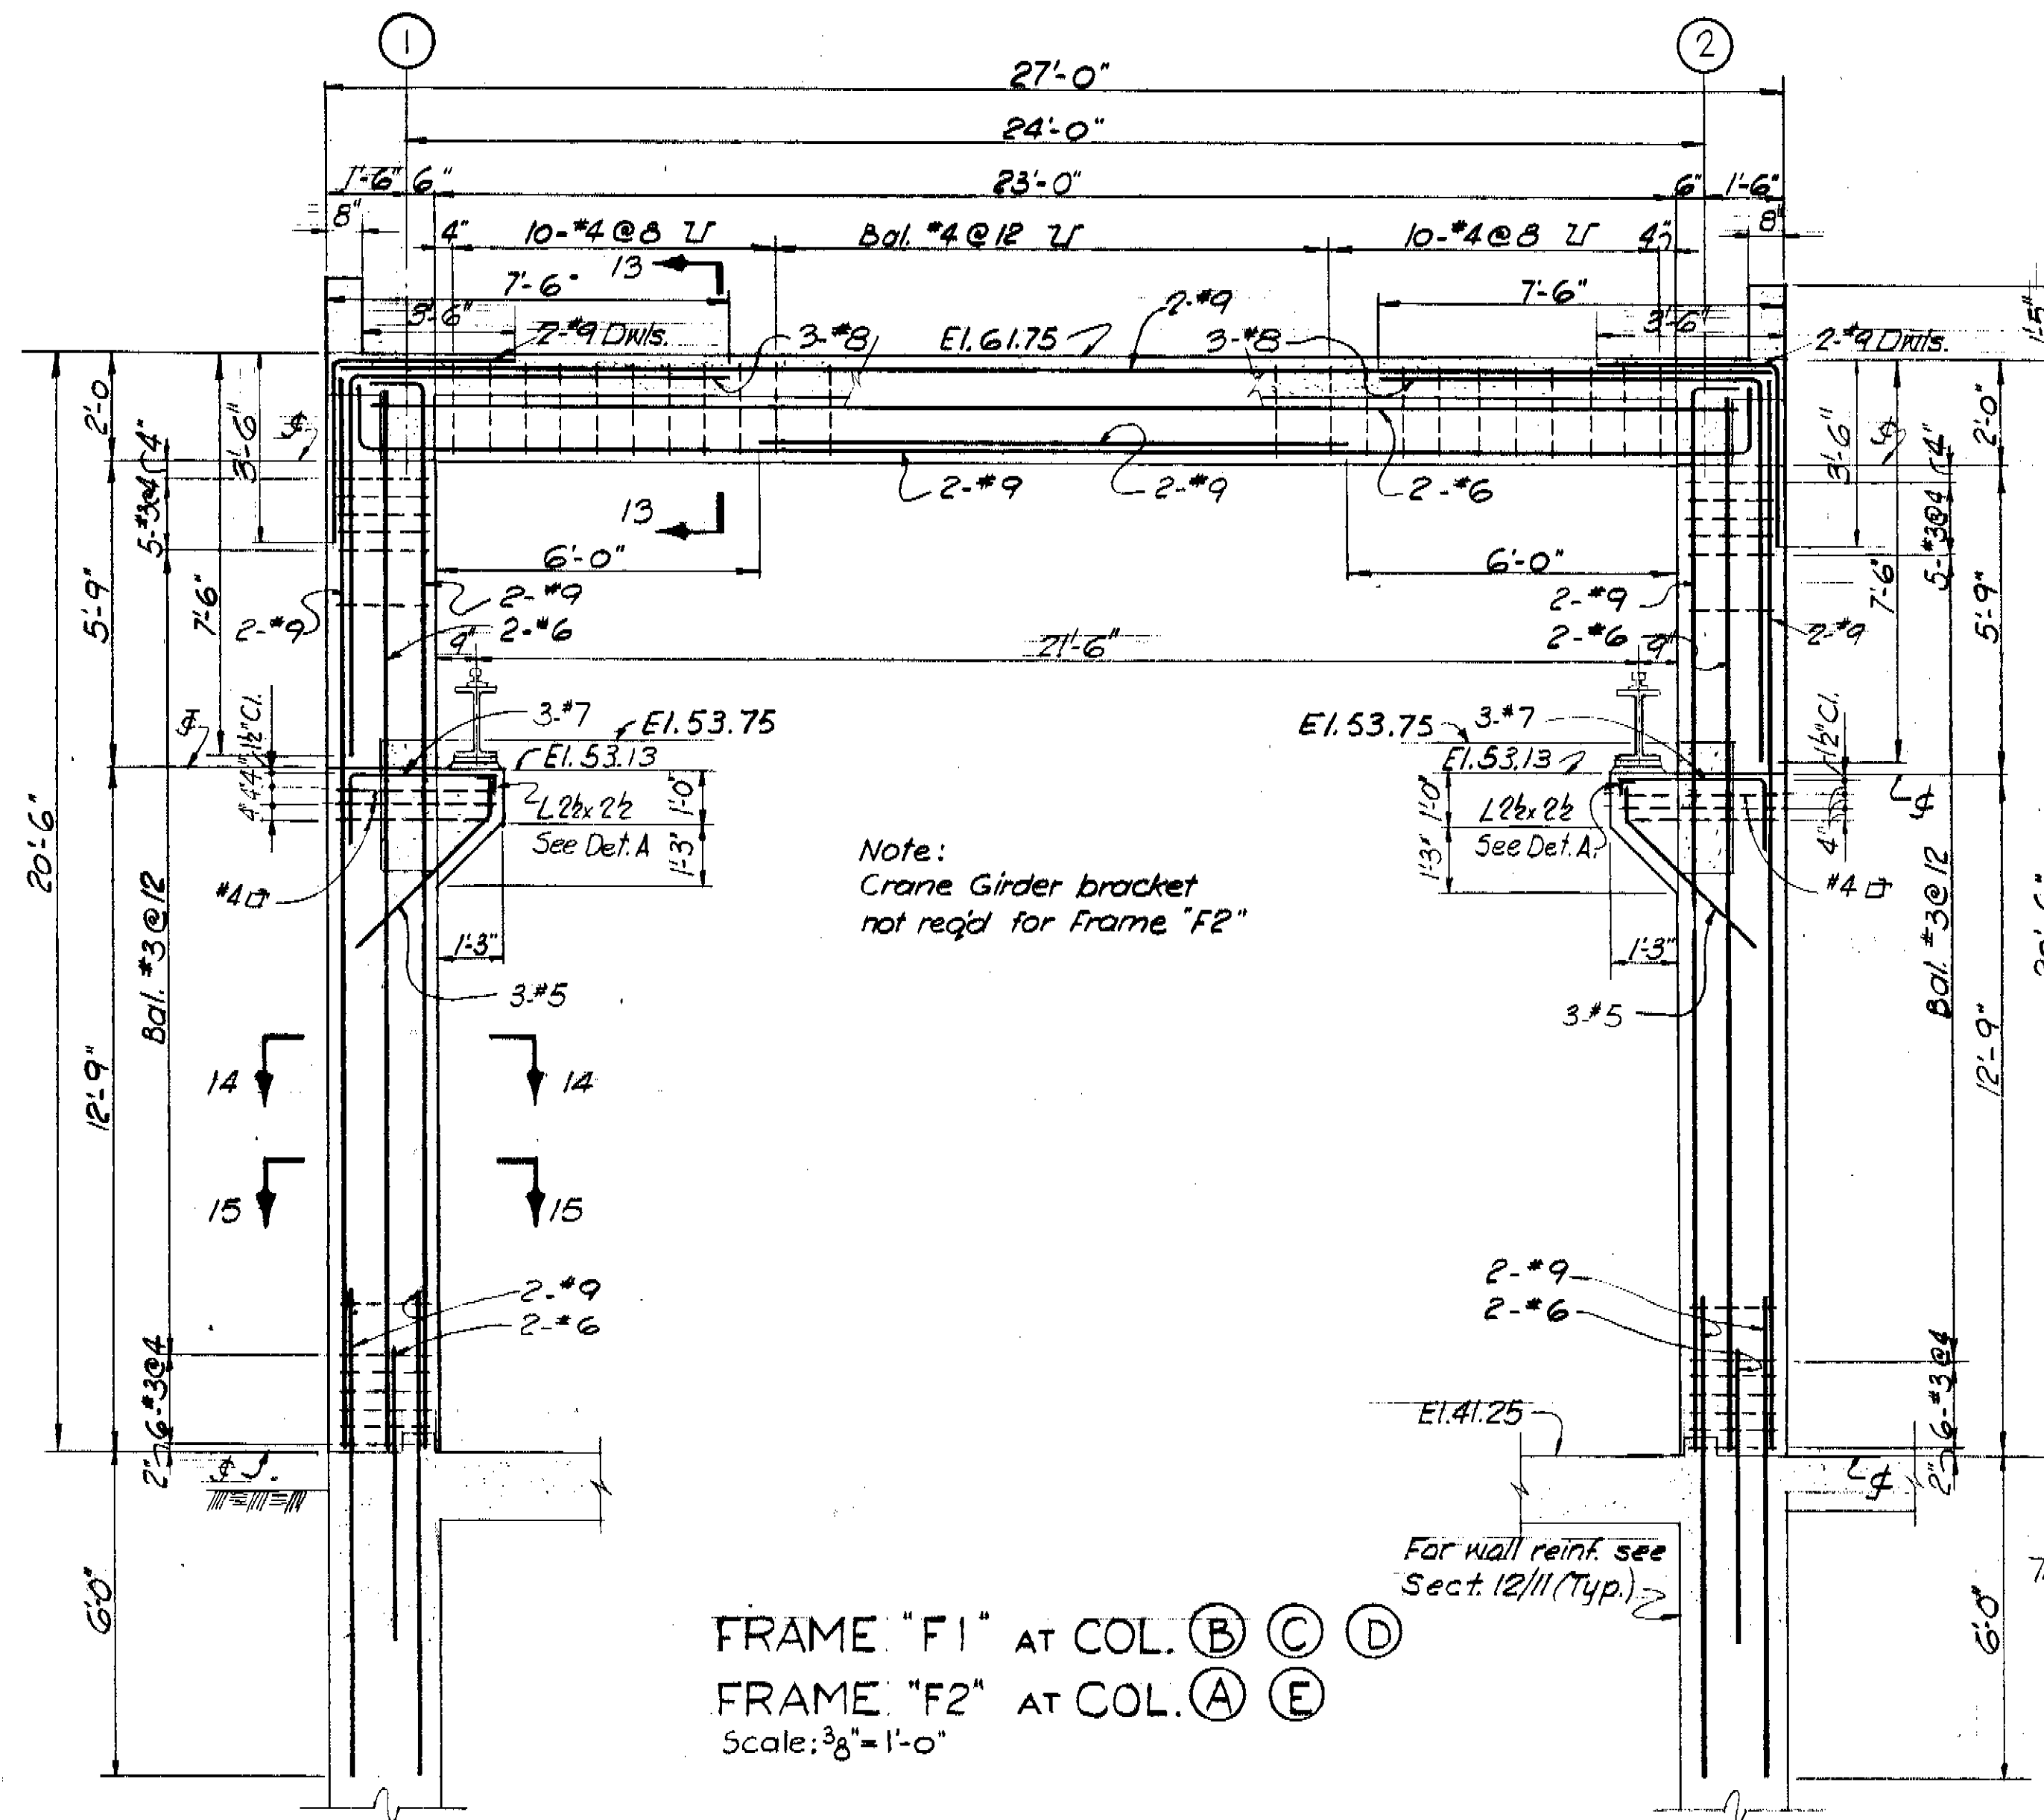


FRAME "F1" AT COL. B C D
 FRAME "F2" AT COL. A E
 Scale: 3/8" = 1'-0"

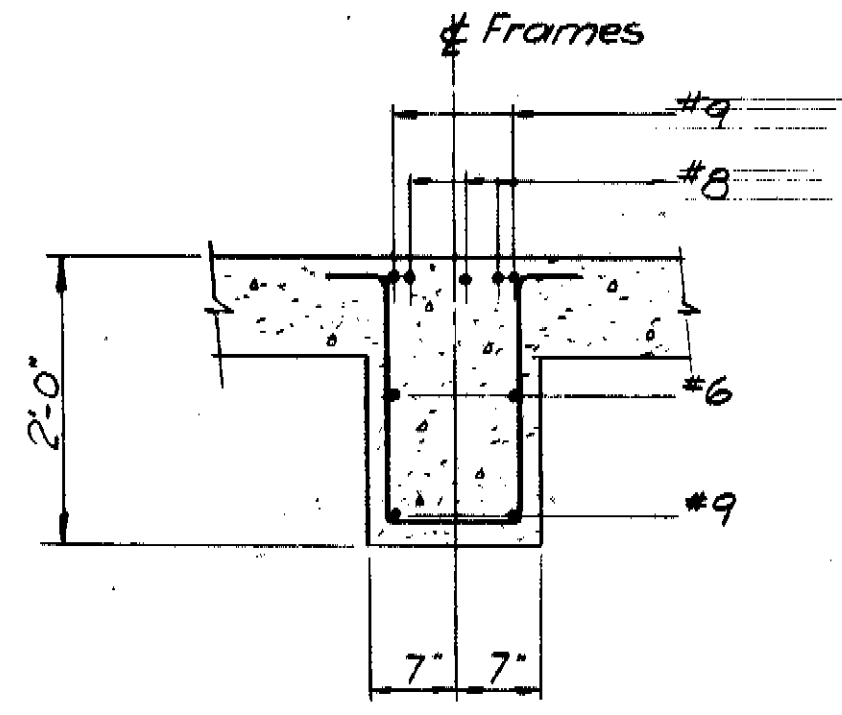


SECTION 13
 Scale: 3/4" = 1'-0"

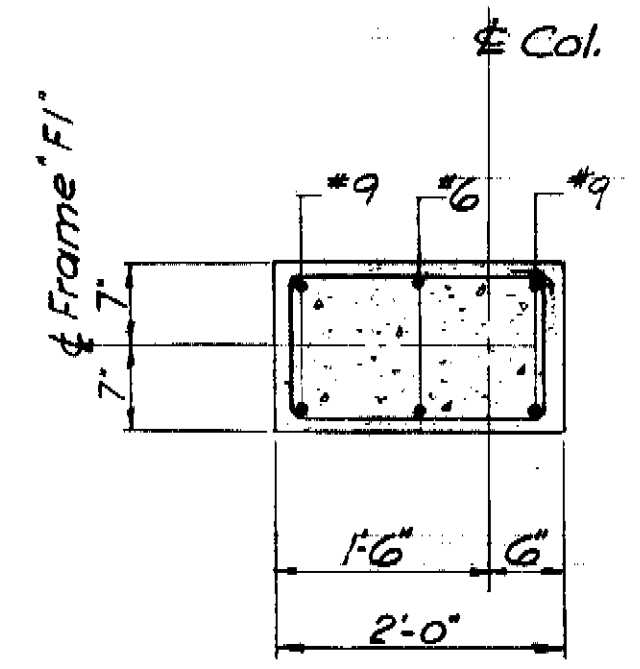

SECTION 14
 Scale: 3/4" = 1'-0"

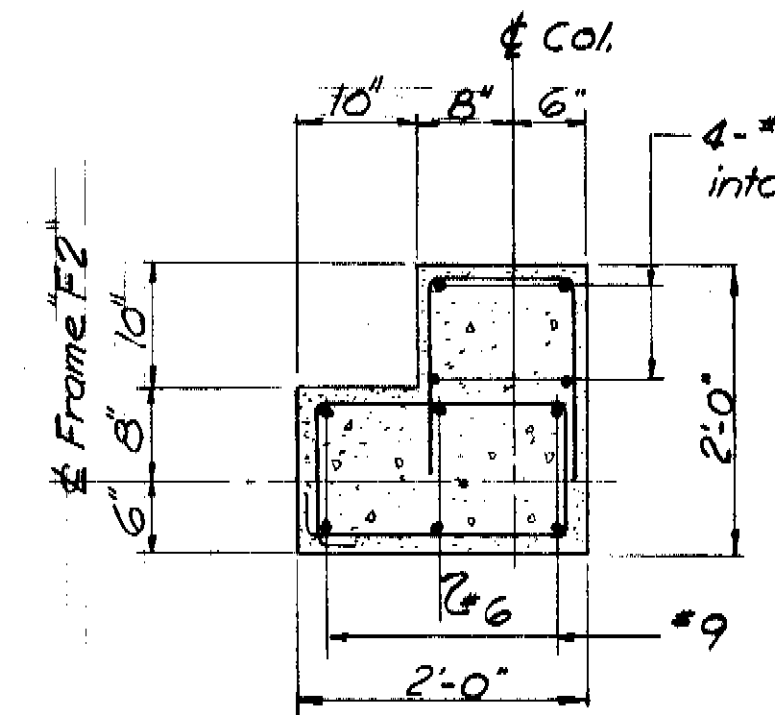


SECTION 15
 Scale: 3/4" = 1'-0"

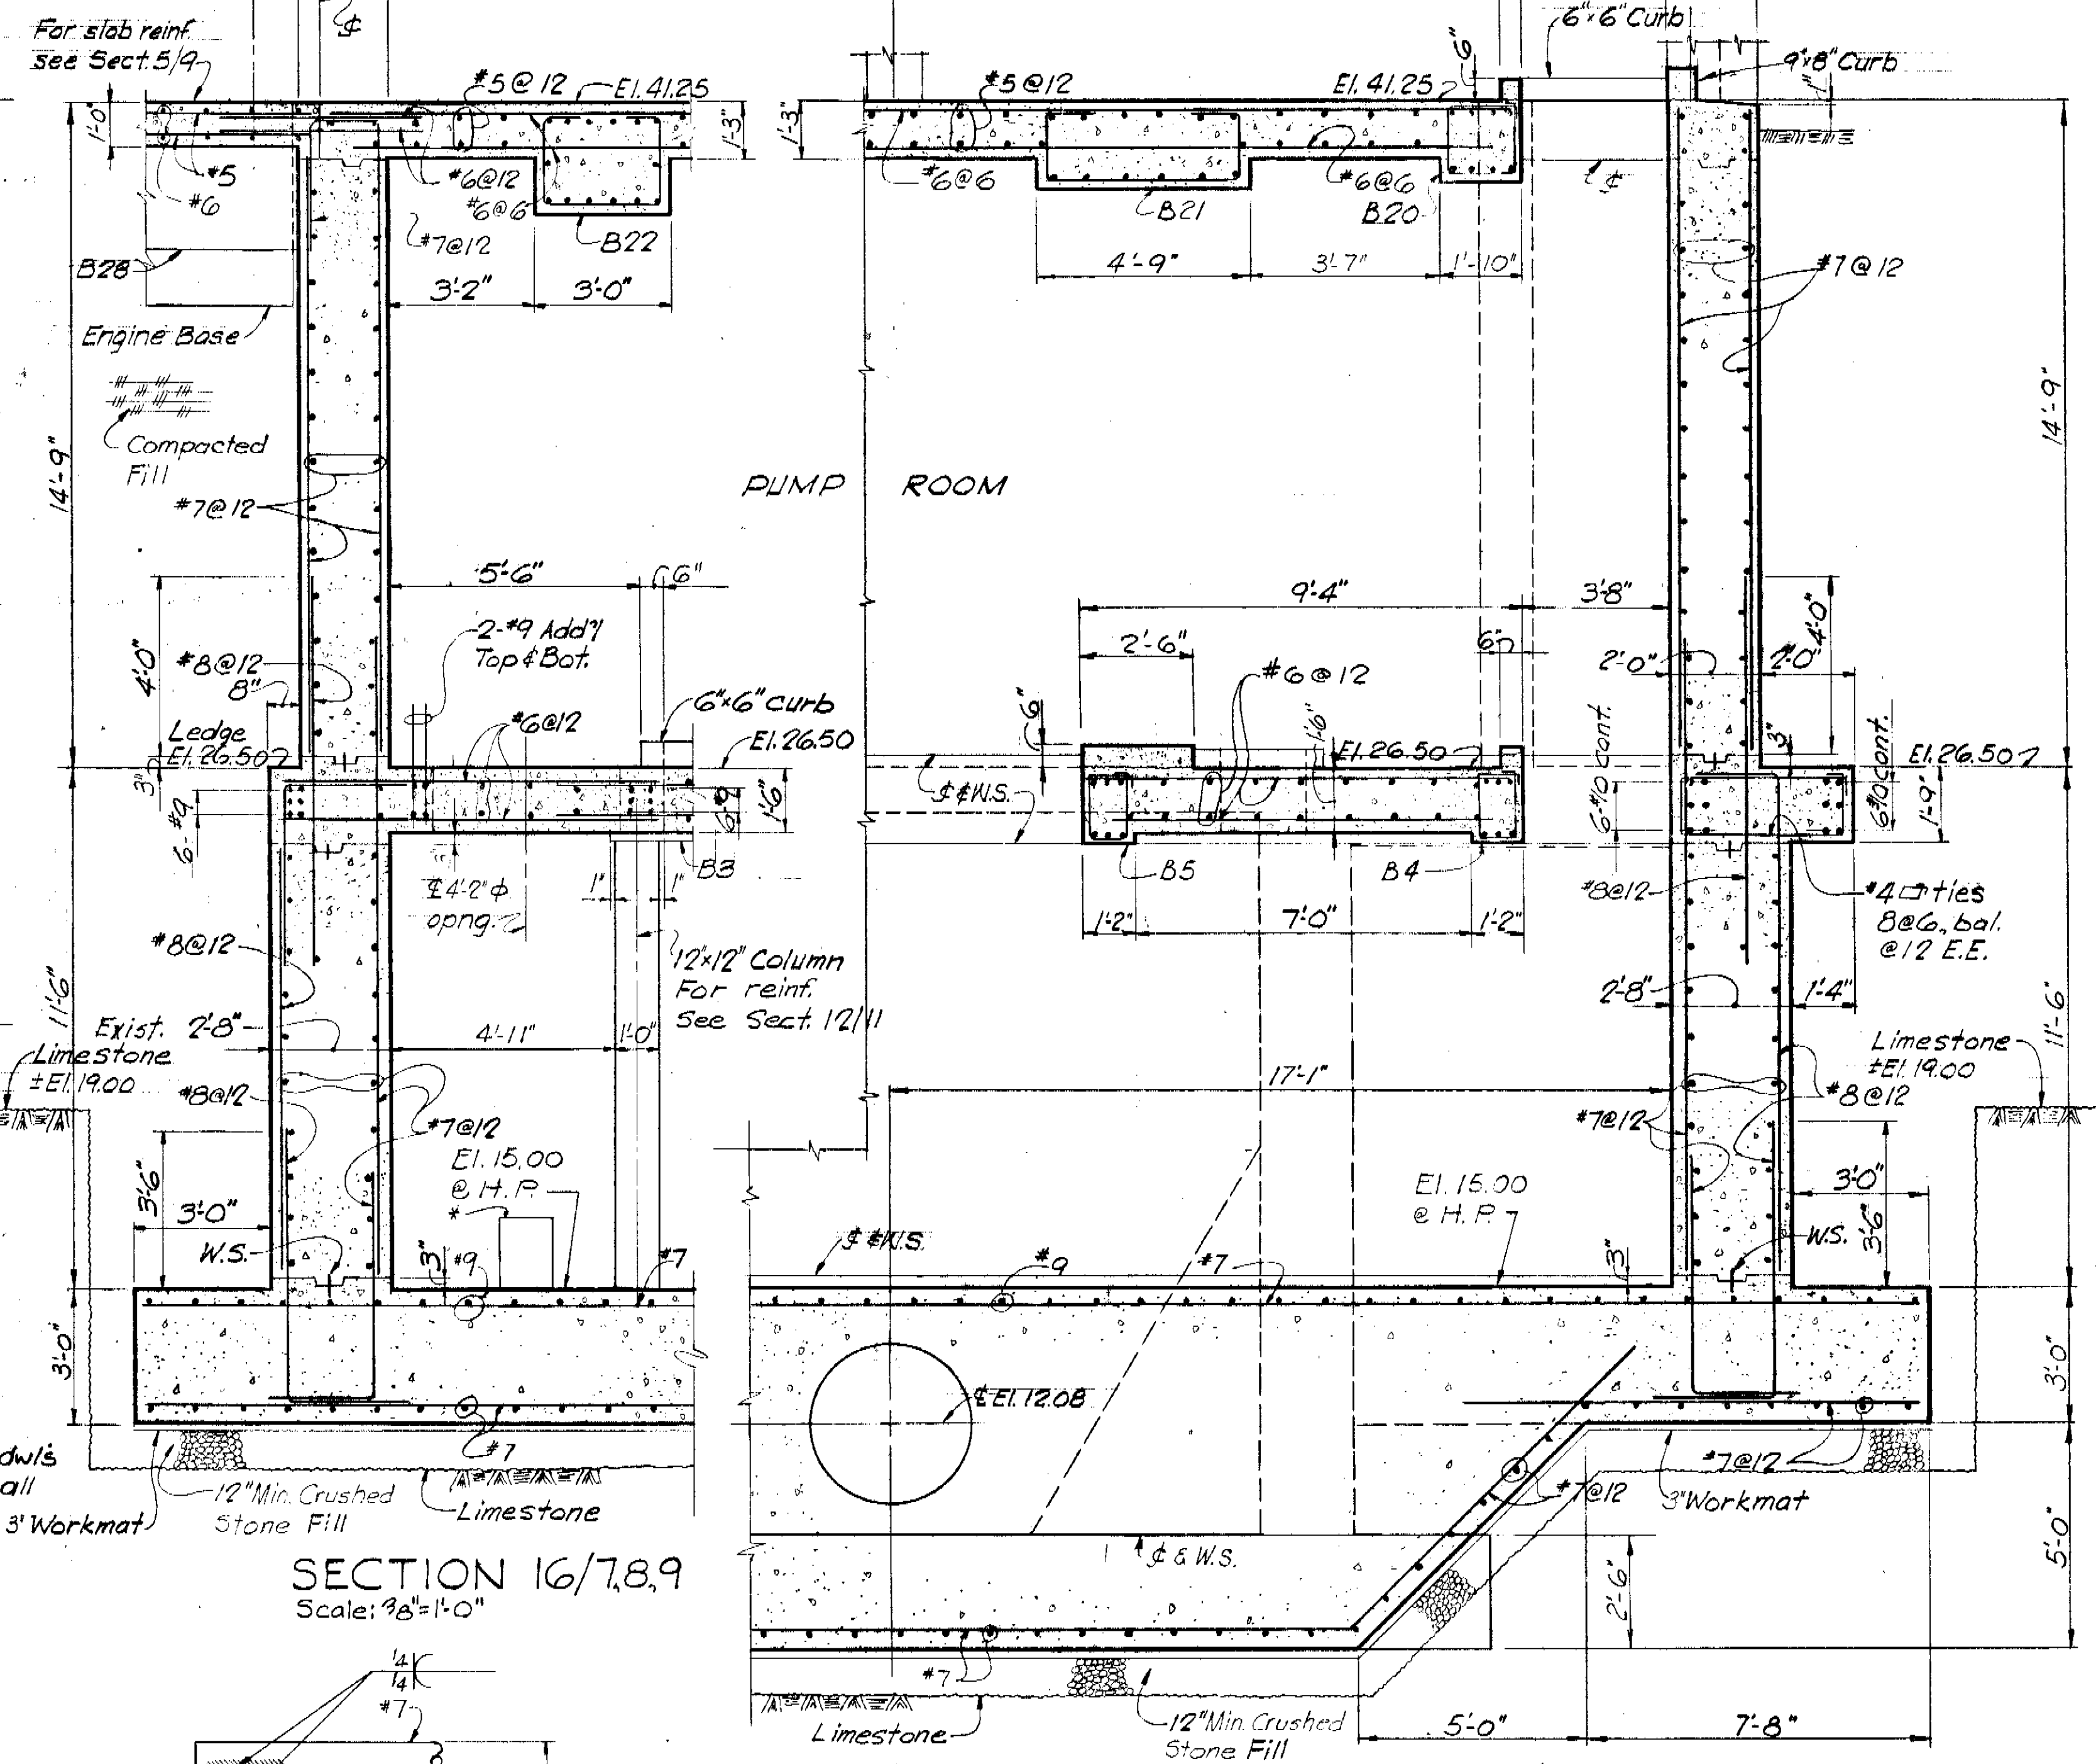

SECTION 16/7.8.9
 Scale: 3/8" = 1'-0"

SECTION 17/7.8.9
 Scale: 3/8" = 1'-0"

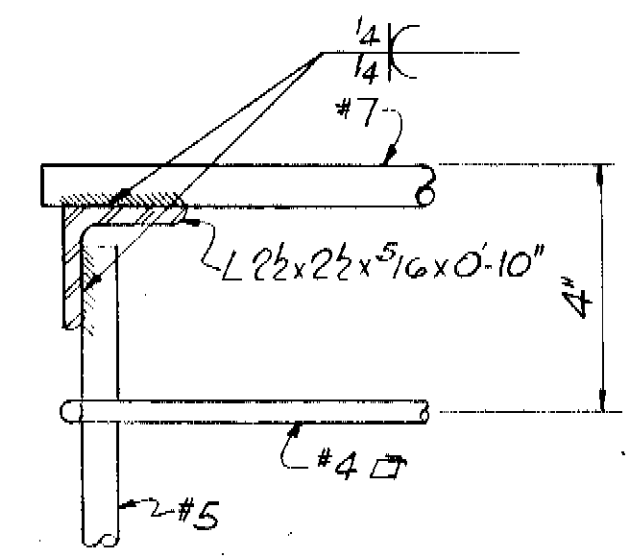

DETAIL A
 No scale

RECORD DRAWING
 THIS RECORD DRAWING IS NOT WARRANTED BUT IS BELIEVED TO REPRESENT CONDITIONS UPON COMPLETION OF CONSTRUCTION WITHIN REASONABLE TOLERANCES, BASED UPON THE INFORMATION FURNISHED TO THE ENGINEER PERTAINING TO CHANGES MADE DURING CONSTRUCTION.

NOTES:
 For General Notes and Typical Details see Sheets 15 & 16
 For Beam Schedule see Sh. 9


NOTE:
 ALL ELEVATIONS SHOWN ARE REFERENCED TO CITY OF TAMPA DATUM. TO CONVERT TO NATIONAL OCEAN SURVEY (NOS) DATUM, SUBTRACT 0.15 FEET (0'-1 13/16").

GREELEY AND HANSEN ENGINEERS
 222 S. RIVERSIDE PLAZA
 CHICAGO, ILLINOIS 60606

DESIGNED PYL, CYC
 DRAWN LT, PYL
 CHECKED SSP

APPROVED
 DATE
 SUPT. DEPT. OF SANITARY SEWERS
 DATE
 GREELEY AND HANSEN ENGINEERS

NO.	DATE	APP.	REVISION
1	9/81	DSH	Rec. Dwg. Revisions
	10/78	JRP	Plans Updated



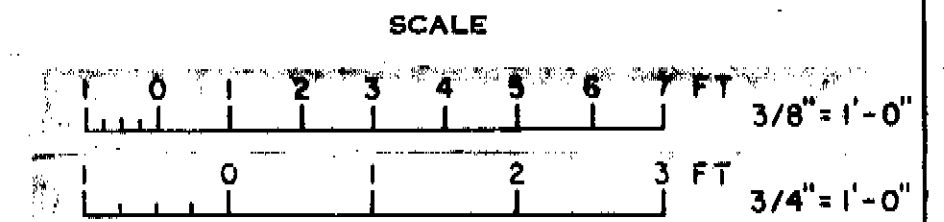


CITY OF TAMPA, FLORIDA
 SEWAGE DISPOSAL SYSTEM
 DIVISION 4G3
 131 ST. AVENUE PUMPING STATION

STRUCTURAL
 FRAME ELEVATION AND DETAILS
 SECTIONS

PROJ. NO. S202-70-300-7-463
 SHEET 12 OF 35
 DATE AUGUST, 1972 REV. 0

173-40

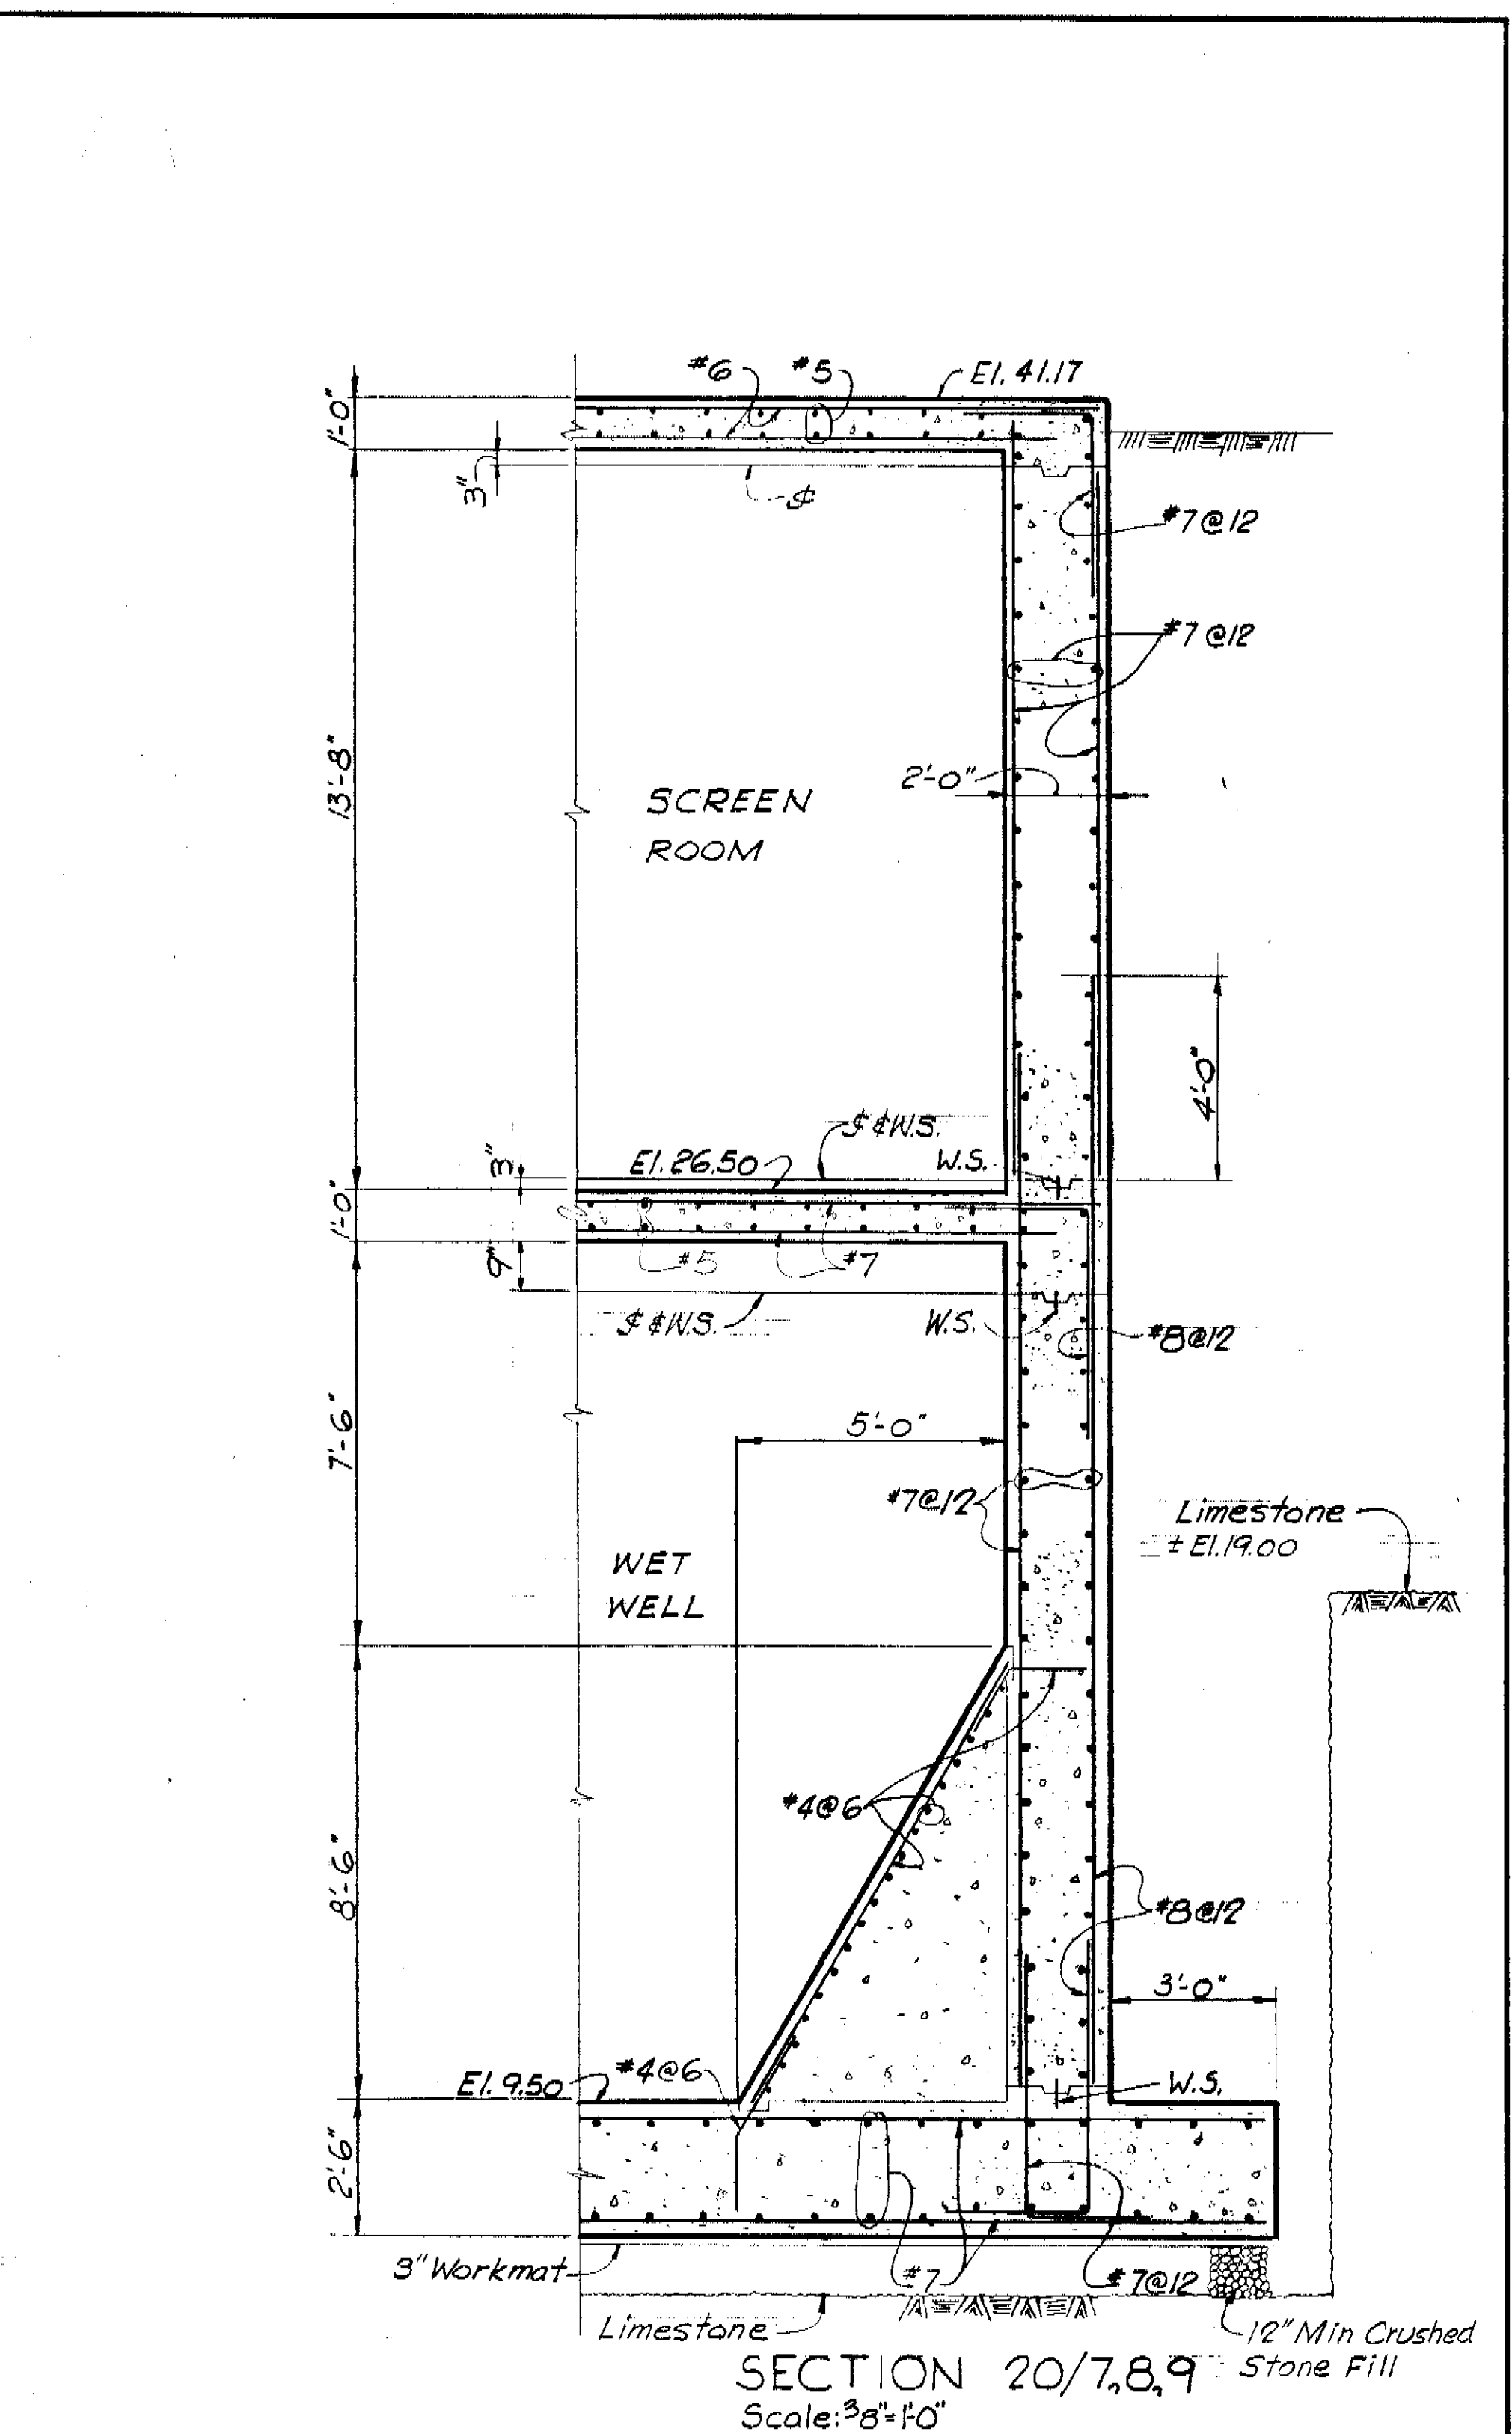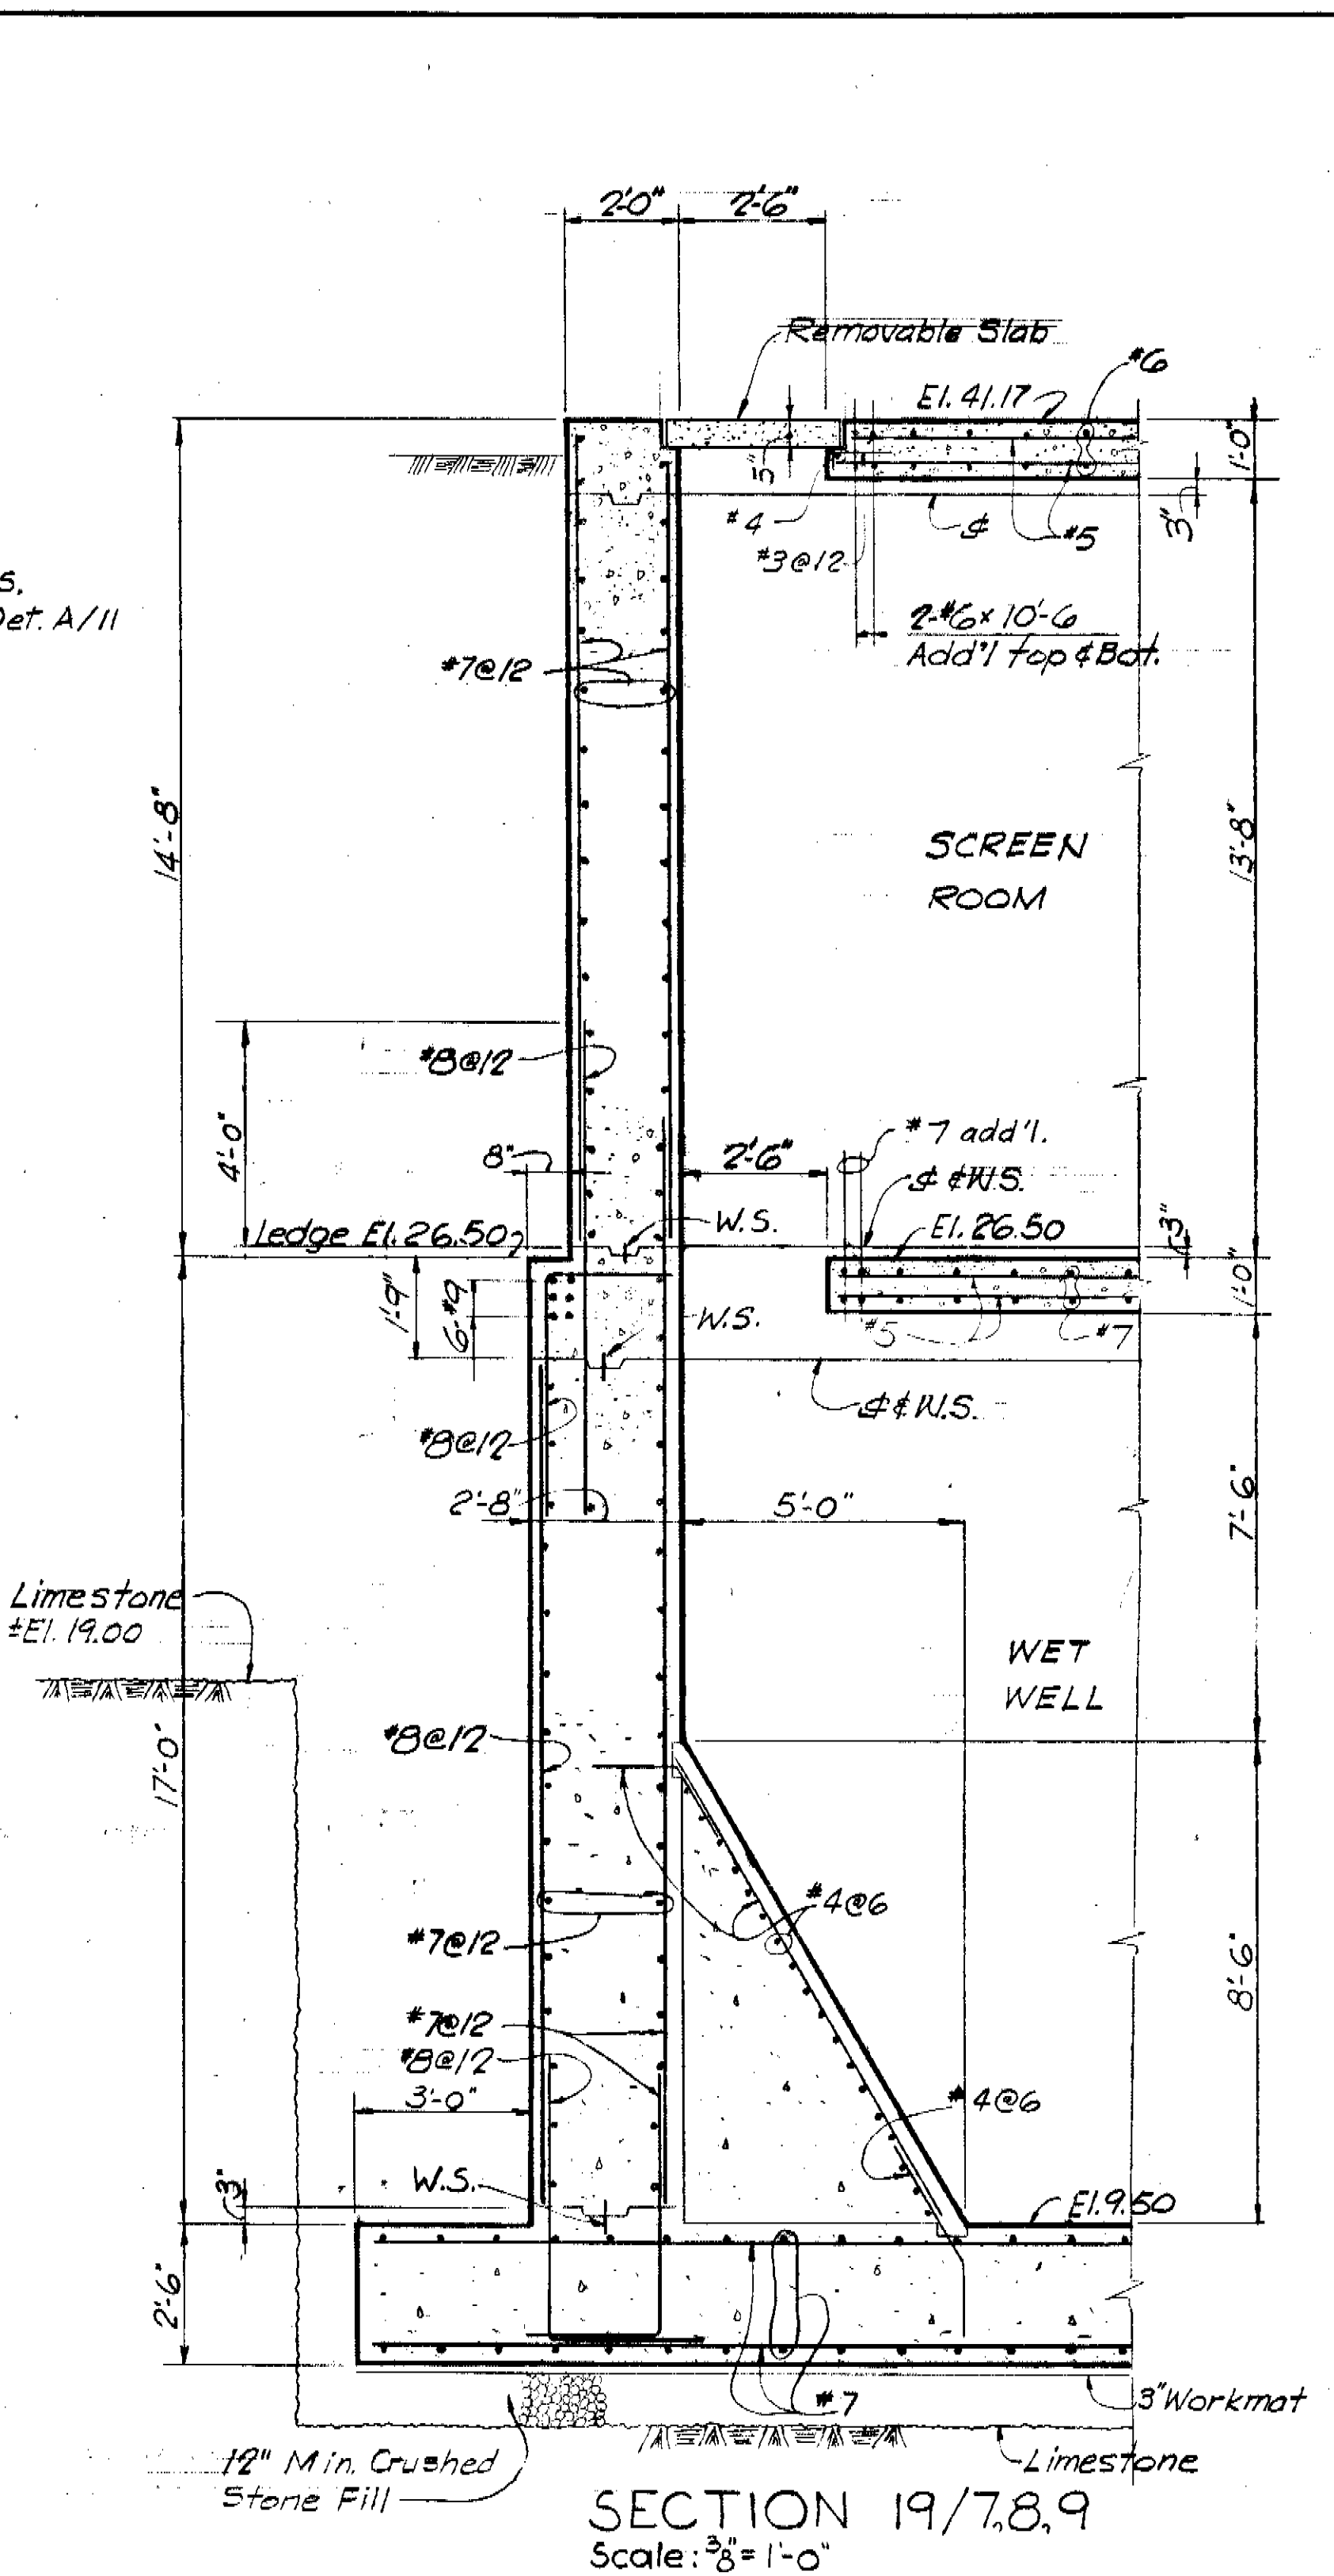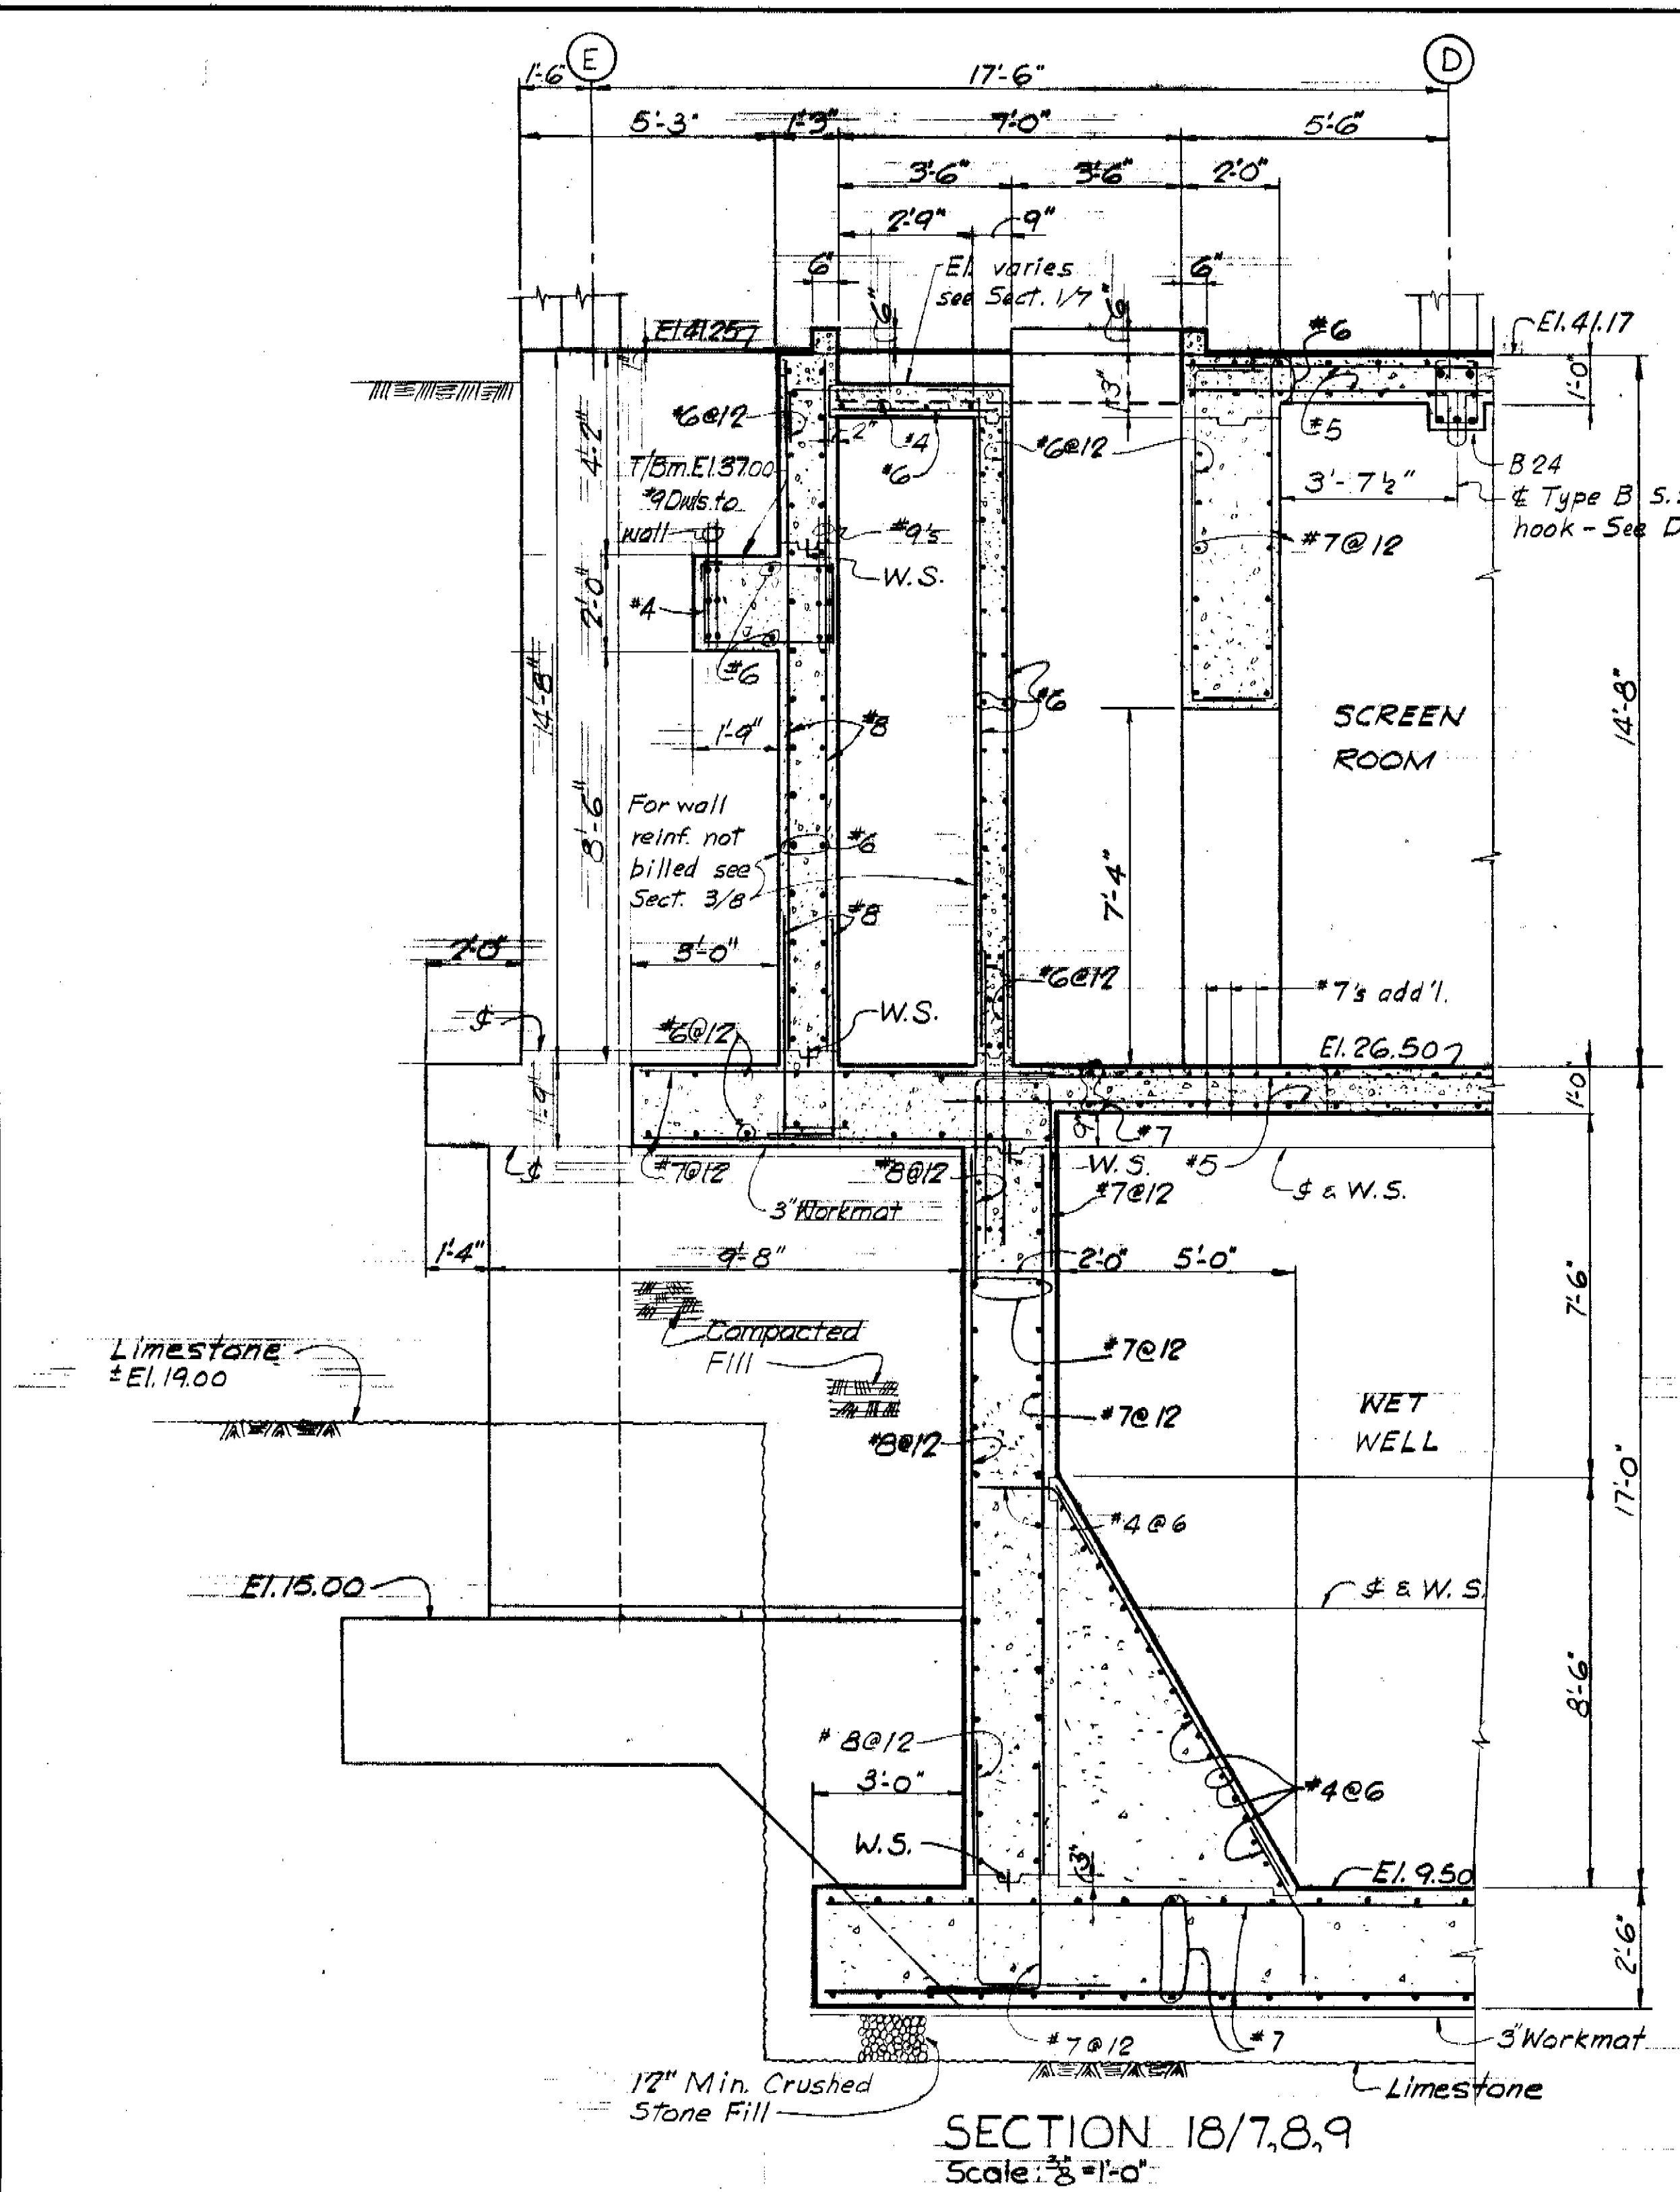

NOTE:
ALL ELEVATIONS SHOWN ARE REFERENCED TO CITY OF TAMPA DATUM. TO CONVERT TO NATIONAL OCEAN SURVEY (NOS) DATUM, SUBTRACT 0.15 FEET (0'-1 13/16").


NOTE:
For General Notes and Typical Details see Sheets 15 & 16.
For Beam Schedule see Sh. 9

RECORD DRAWING
THIS RECORD DRAWING IS NOT WARRANTED BUT IS BELIEVED TO REPRESENT CONDITIONS UPON COMPLETION OF CONSTRUCTION, WITHIN REASONABLE TOLERANCES, BASED UPON THE INFORMATION FURNISHED TO THE ENGINEER PERTAINING TO CHANGES MADE DURING CONSTRUCTION.

GREELEY AND HANSEN
ENGINEERS
222 S. RIVERSIDE PLAZA
CHICAGO, ILLINOIS 60606

DESIGNED PYL, JJF
DRAWN PYL, LT
CHECKED SSP

APPROVED		DATE	
SUPT., DEPT. OF SANITARY SEWERS	DATE	SUPT., DEPT. OF SANITARY SEWERS	DATE
GREELEY AND HANSEN, ENGINEERS			

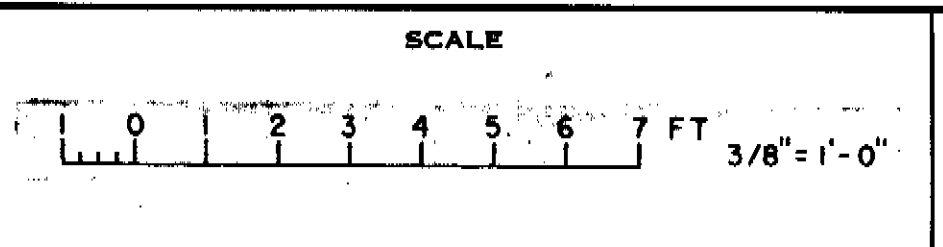


CITY OF TAMPA, FLORIDA
SEWAGE DISPOSAL SYSTEM
DIVISION 463
131 ST. AVENUE PUMPING STATION


STRUCTURAL SECTIONS

PROJ. NO. S 202-70-30D-7-4G3
SHEET 13 OF 35
DATE AUGUST, 1972 REV. 0


173-50

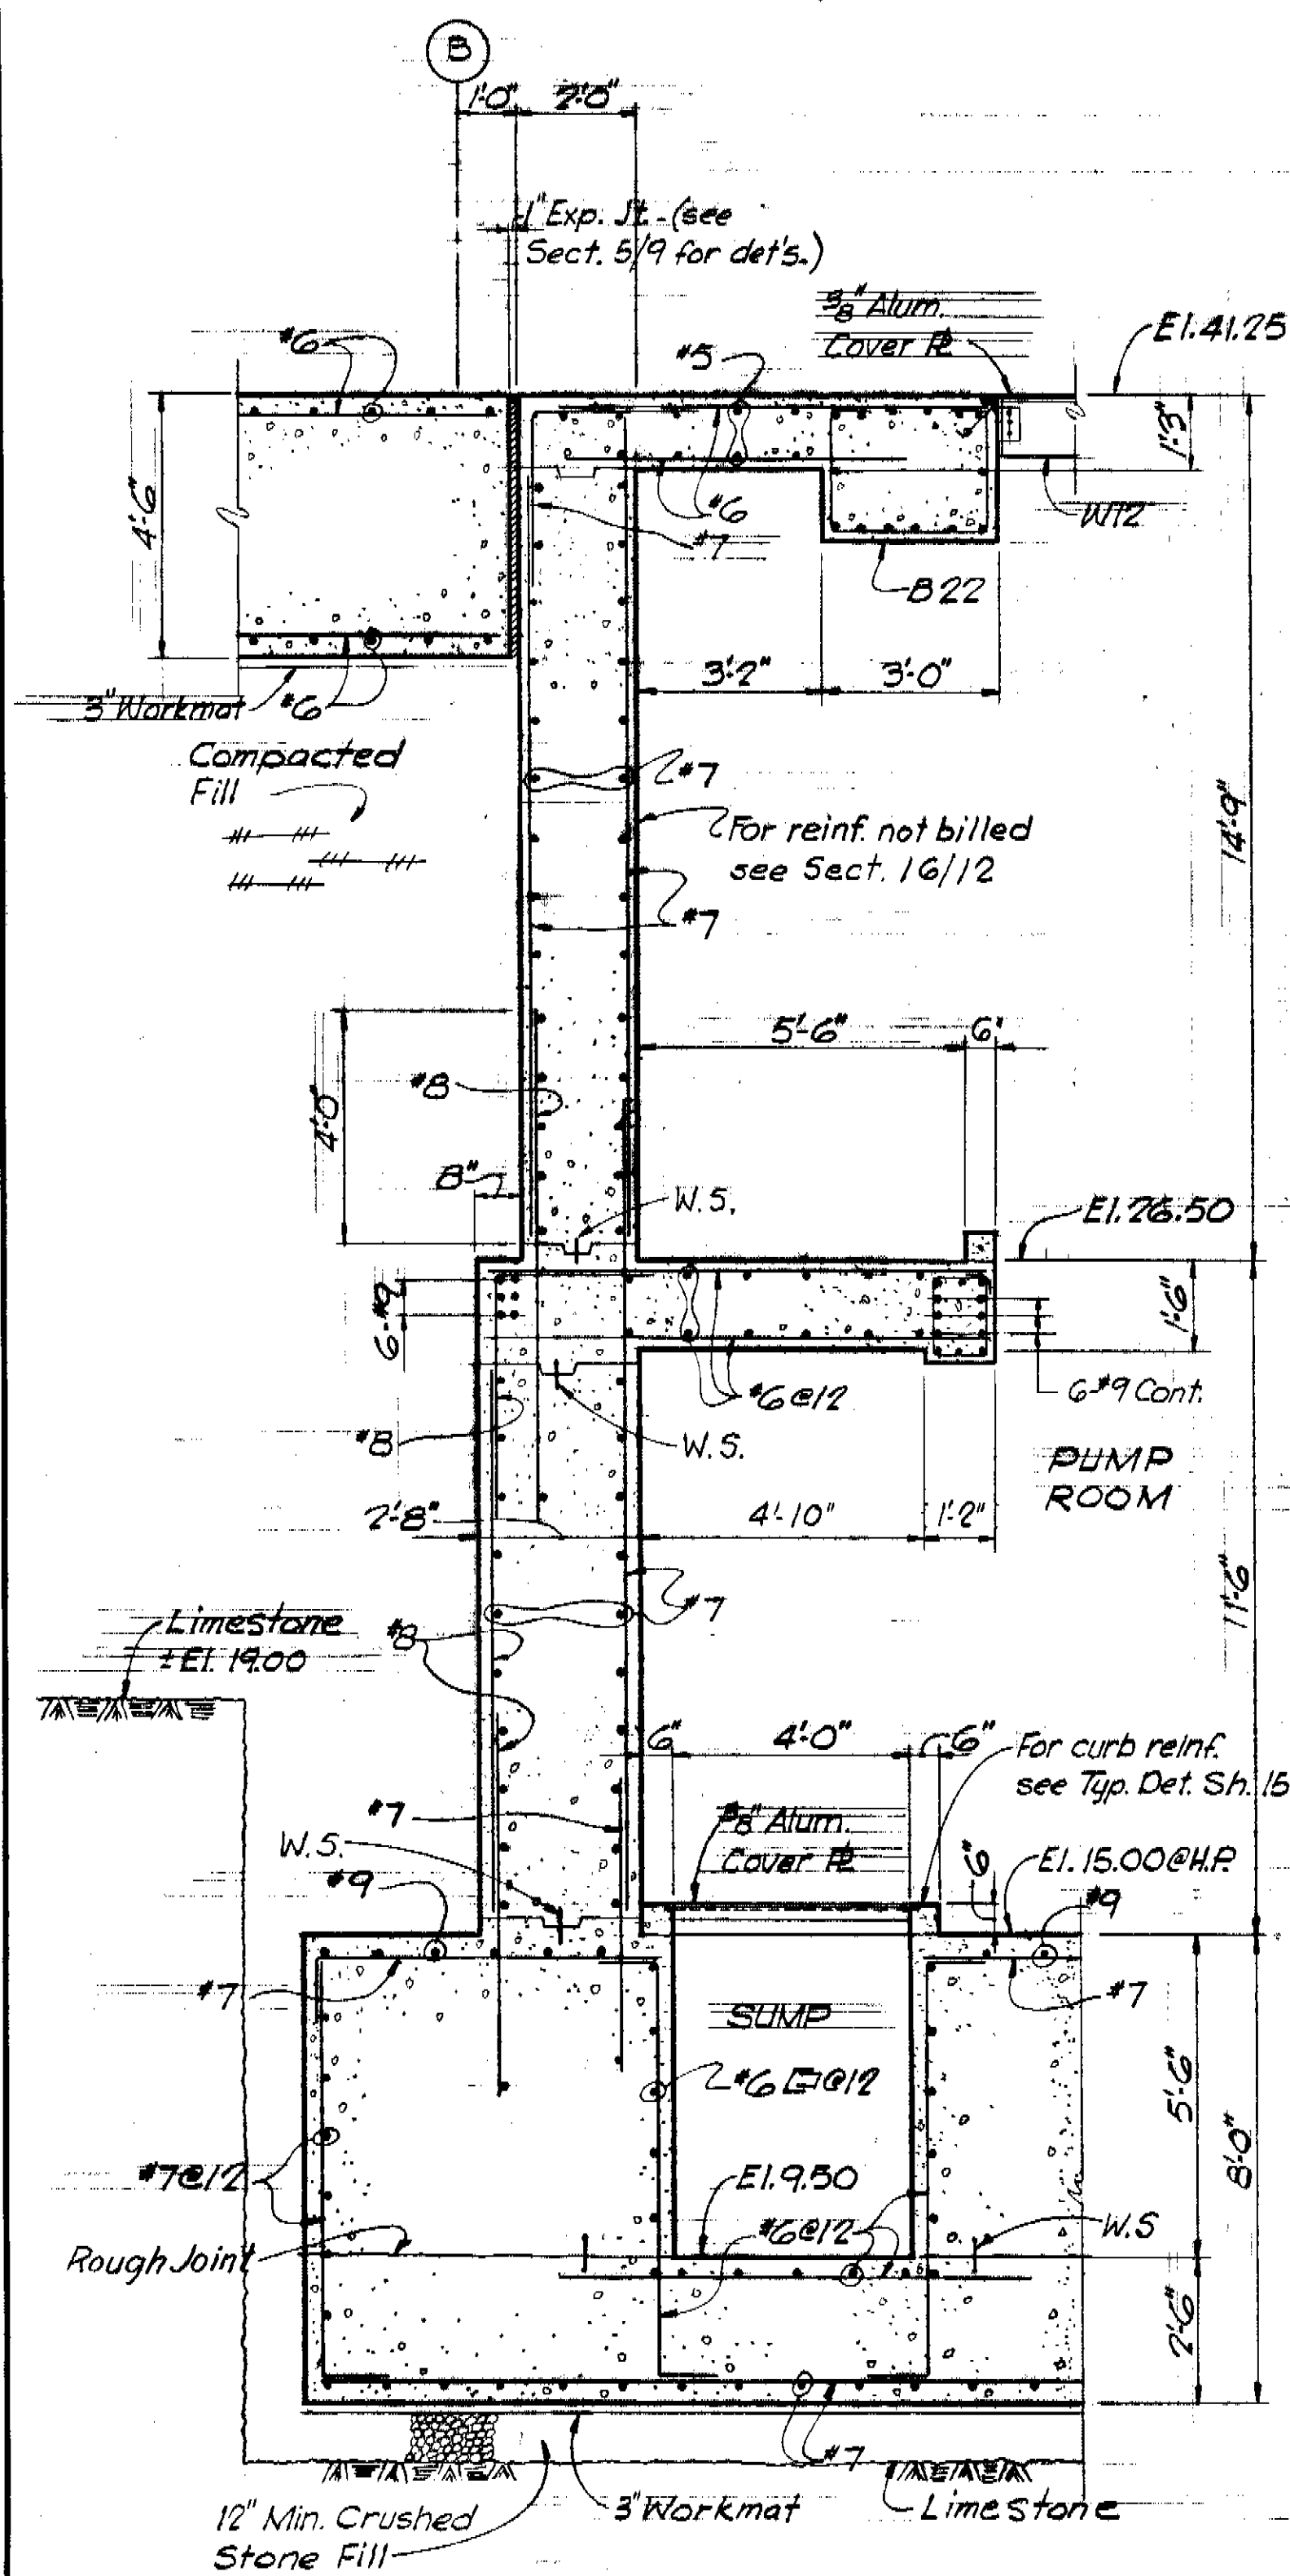


SECTION 21/7,8,9
Scale: 3/8"=1'-0"

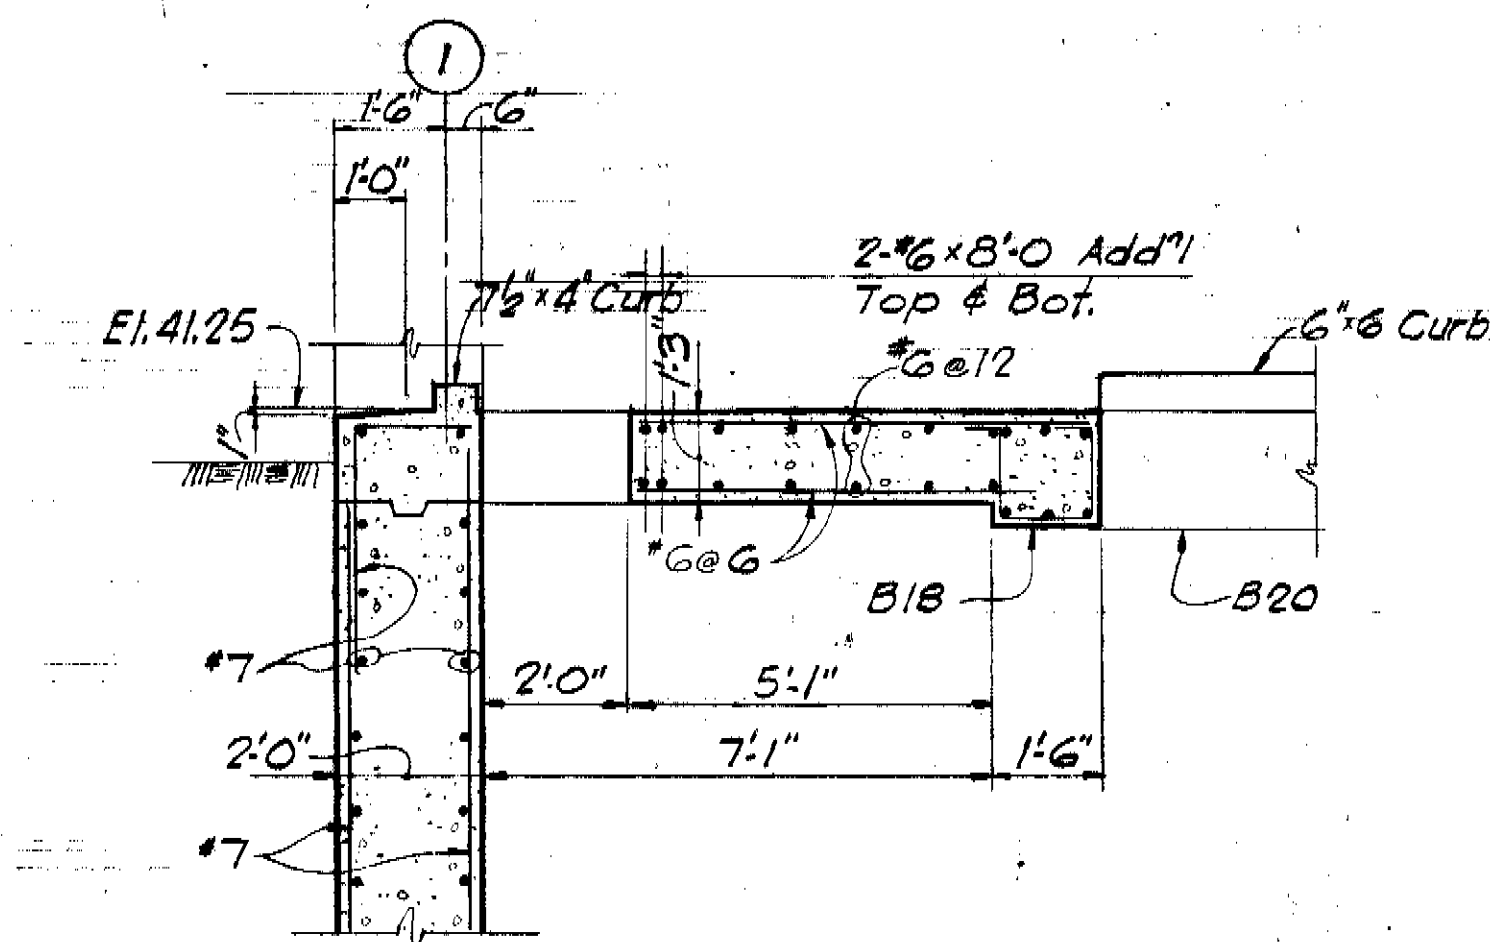


SECTION 22/9
Scale: 3/8"=1'-0"

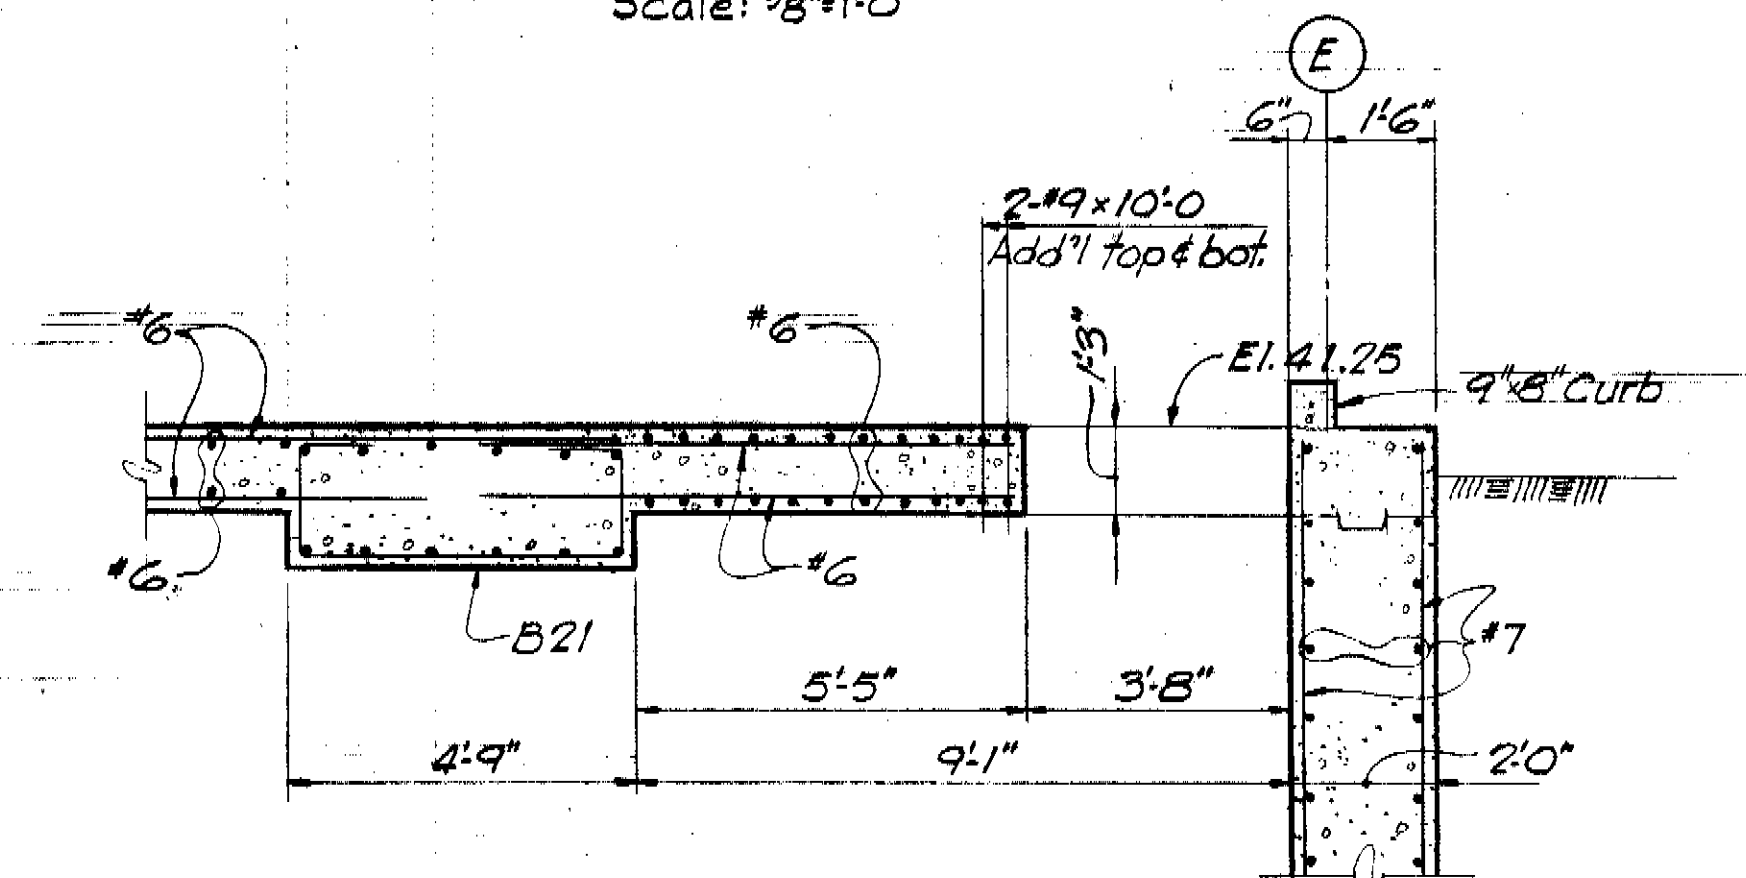


SECTION 23/9
Scale: 3/8"=1'-0"

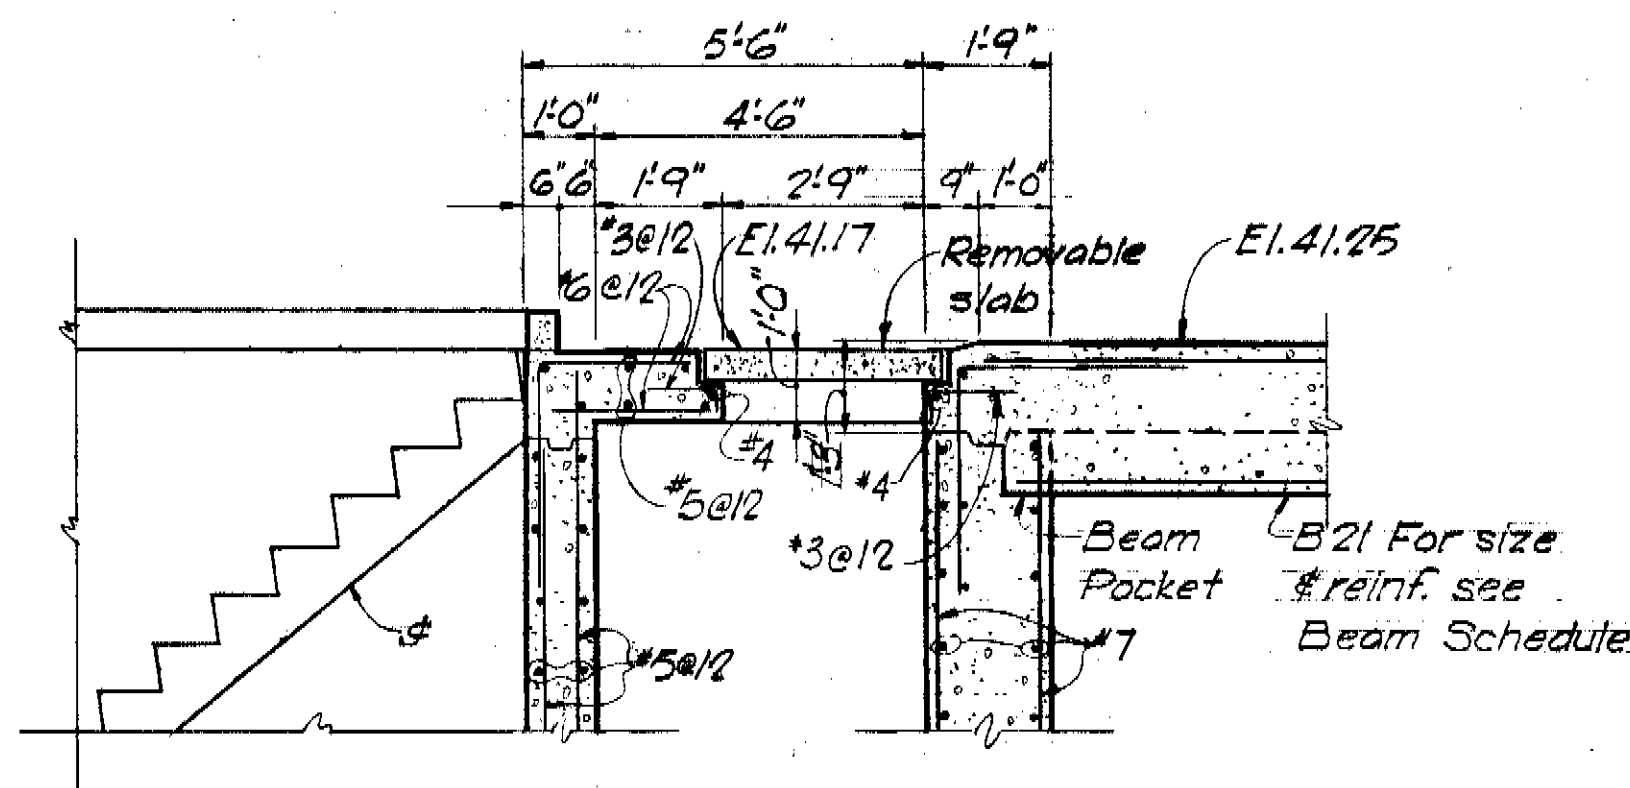


SECTION 24/9
Scale: 3/8"=1'-0"

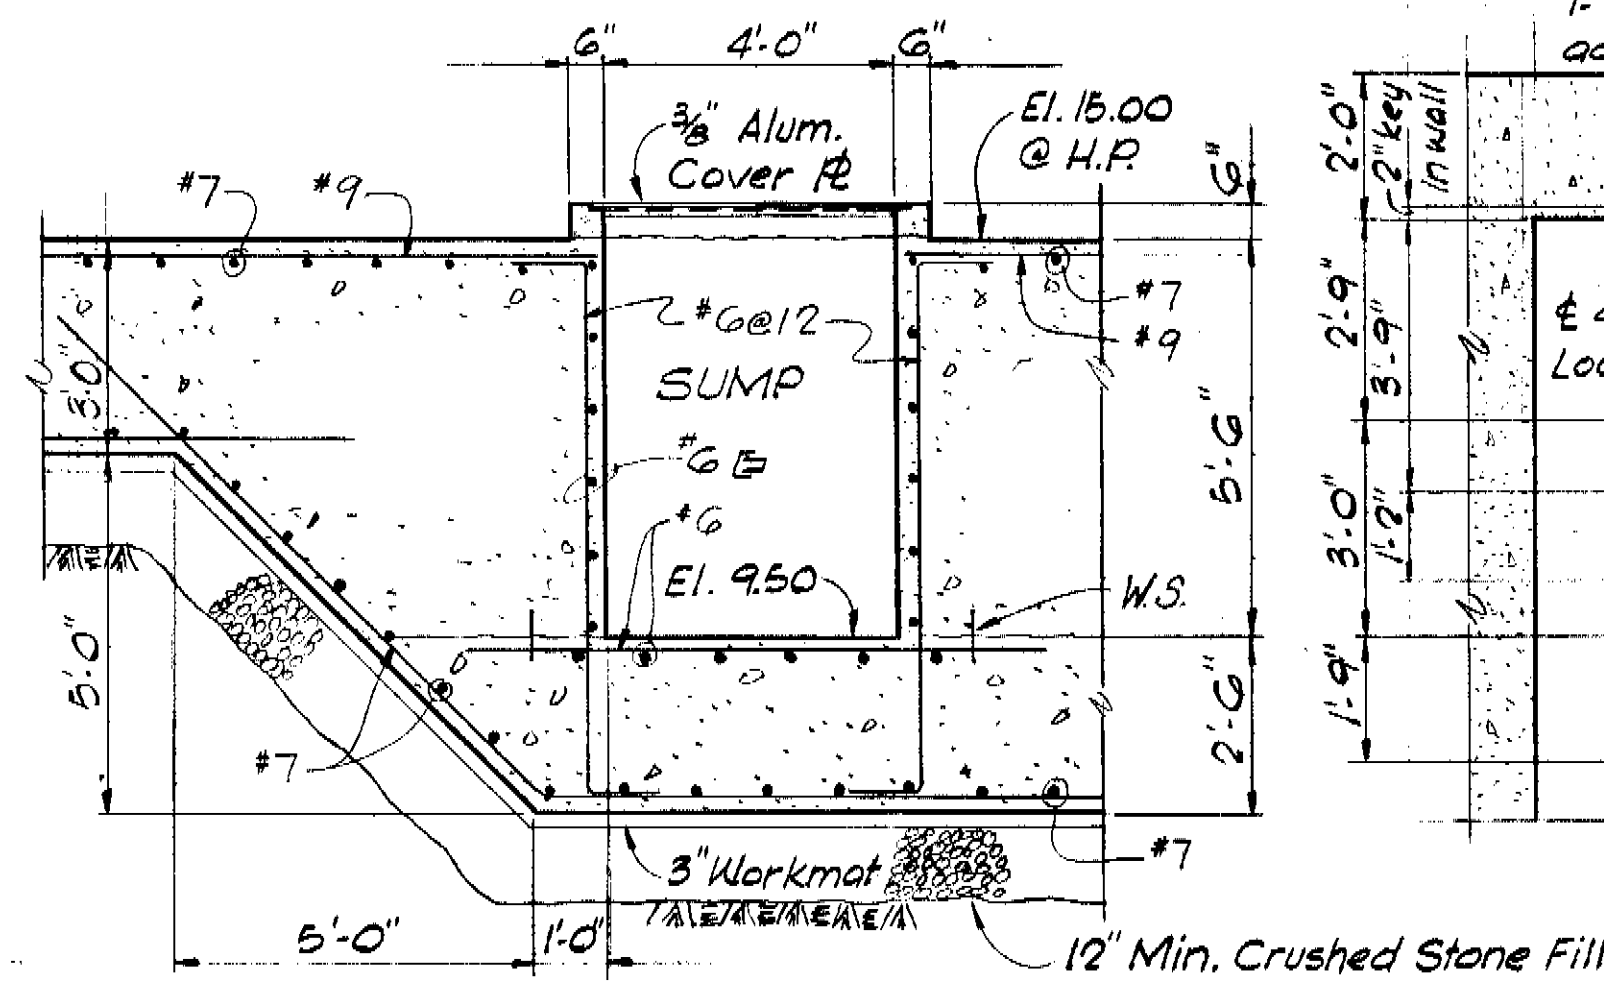


SECTION 25/7
Scale: 3/8"=1'-0"

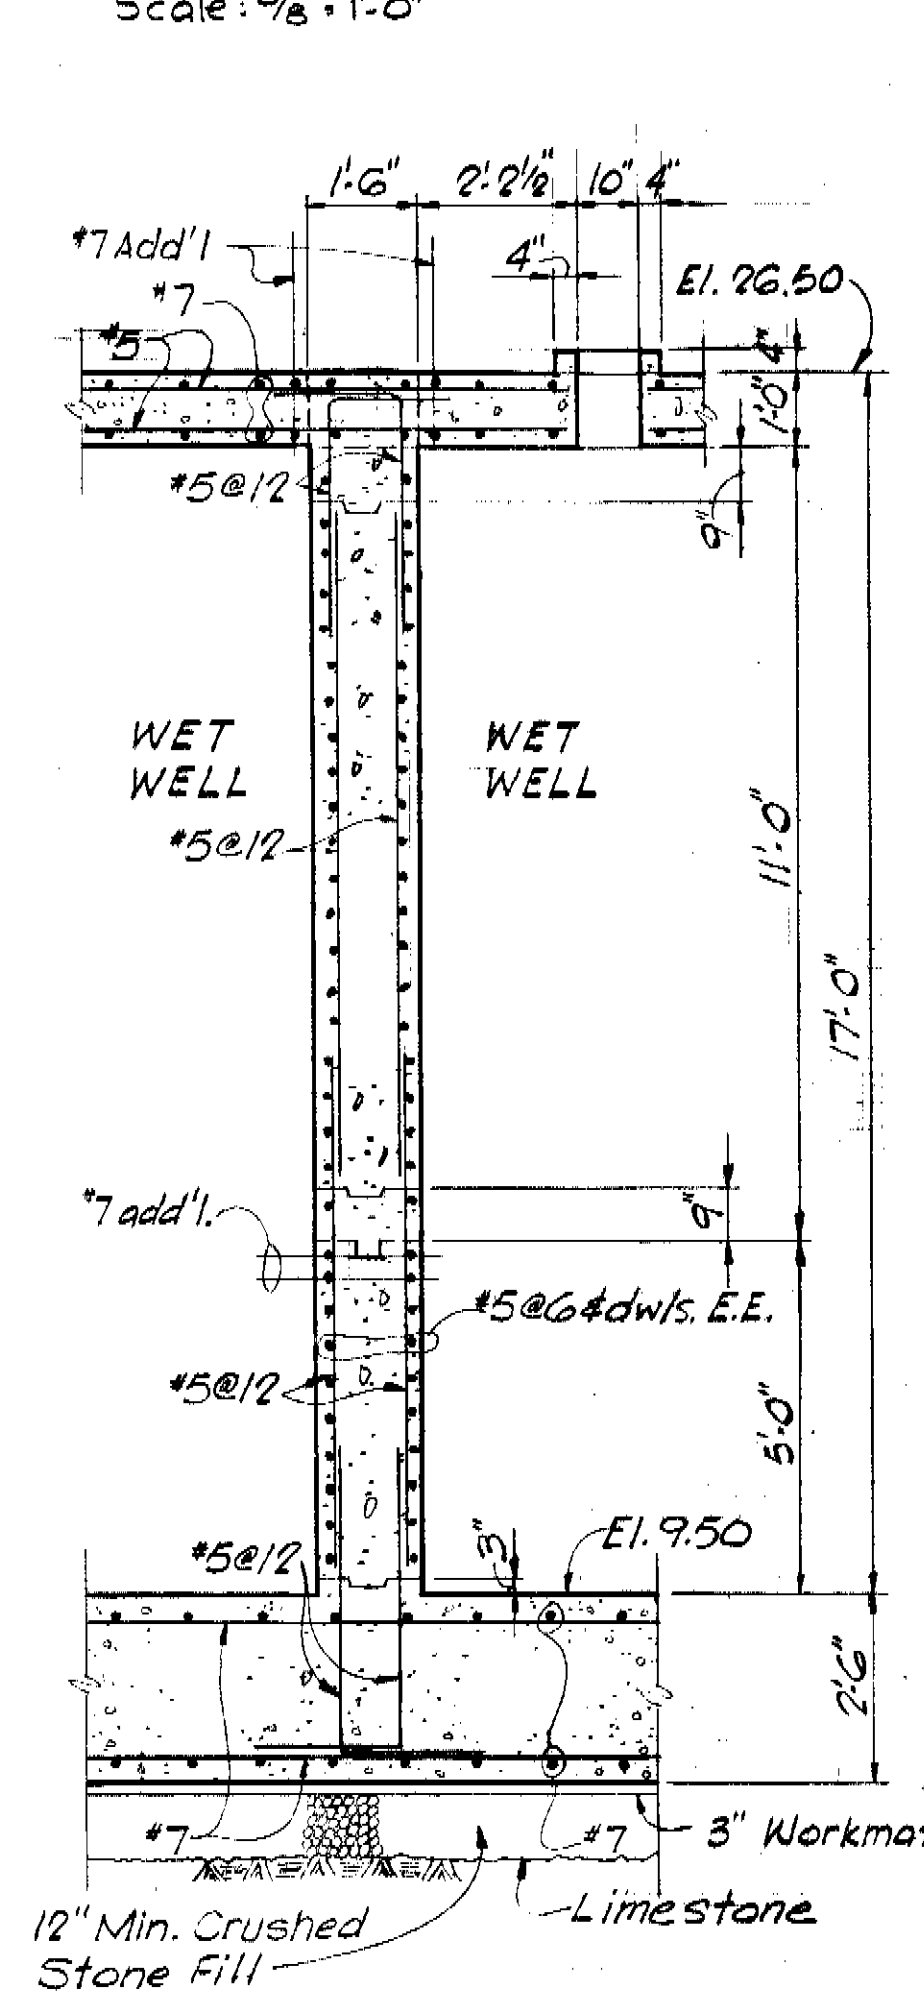


SECTION 26/7,8
Scale: 3/8"=1'-0"

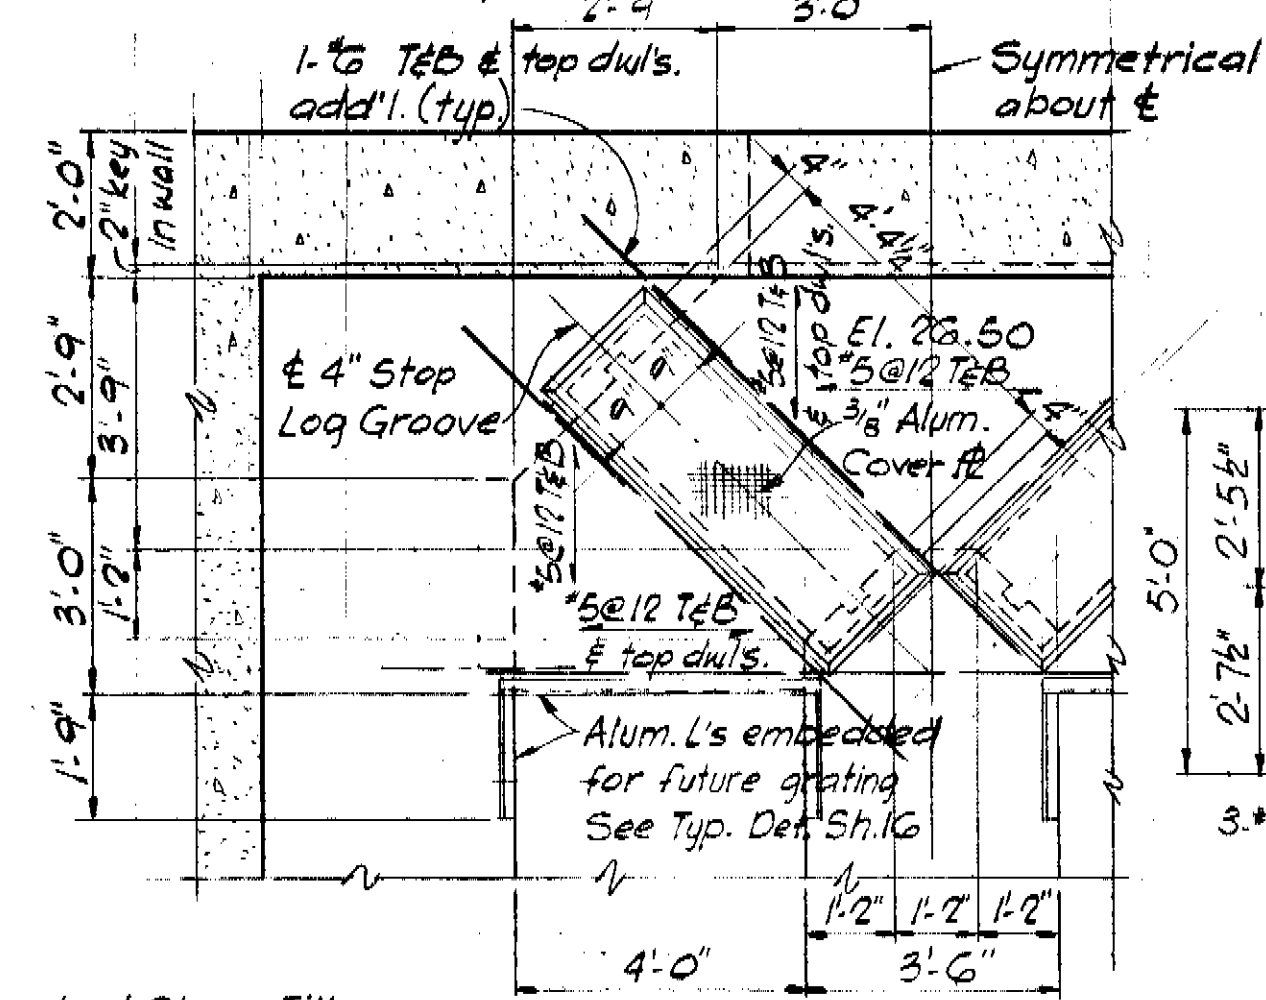


DETAIL A/8
Scale: 3/8"=1'-0"

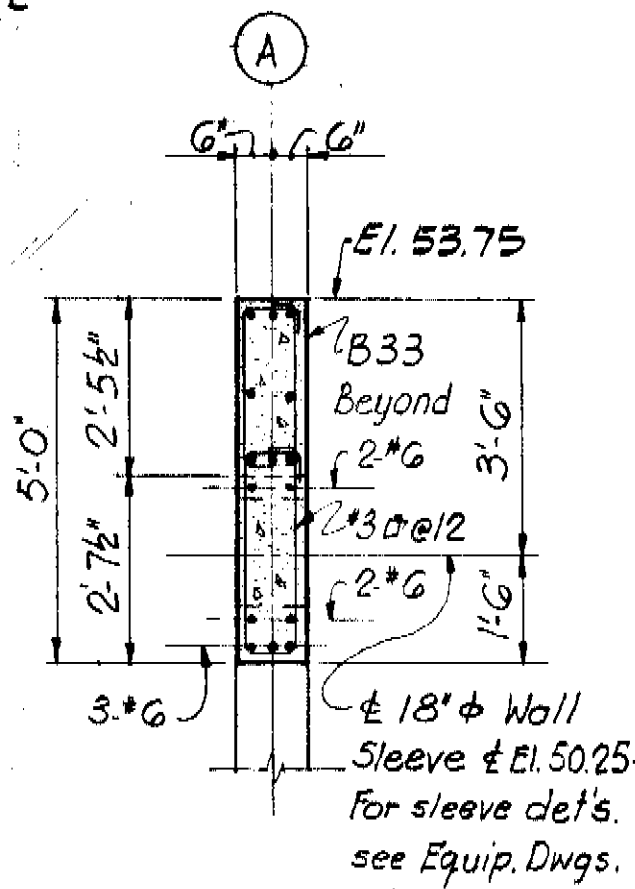


SECTION 27/10
Scale: 3/8"=1'-0"

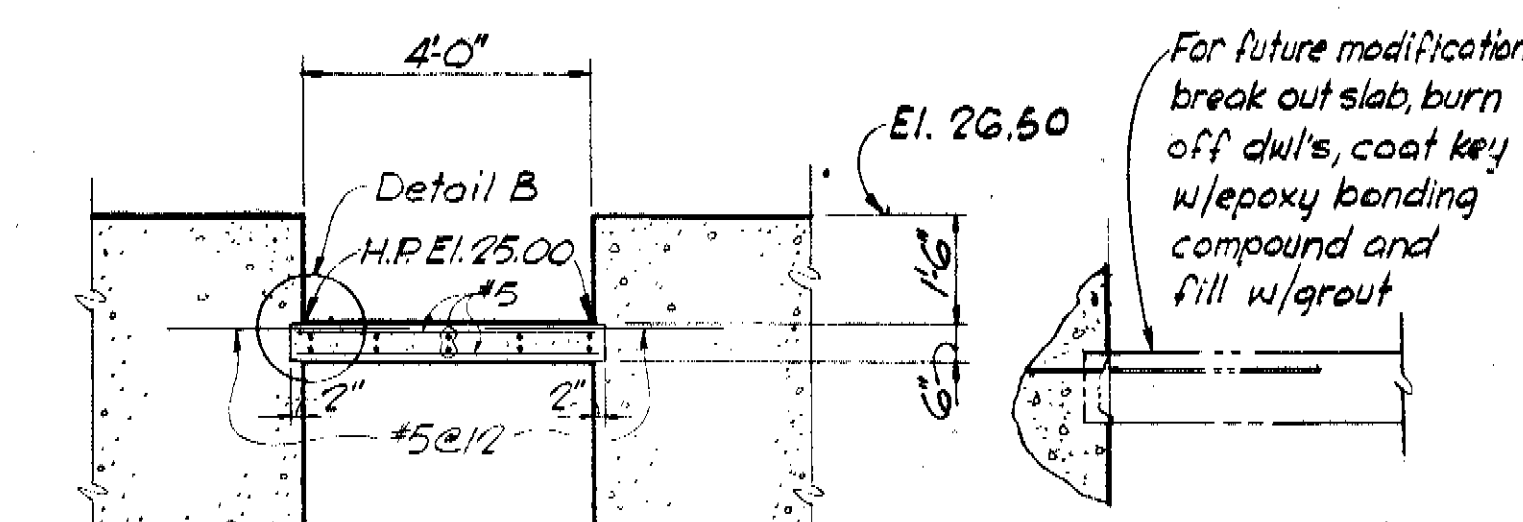


SECTION 28/8
Scale: 3/8"=1'-0"

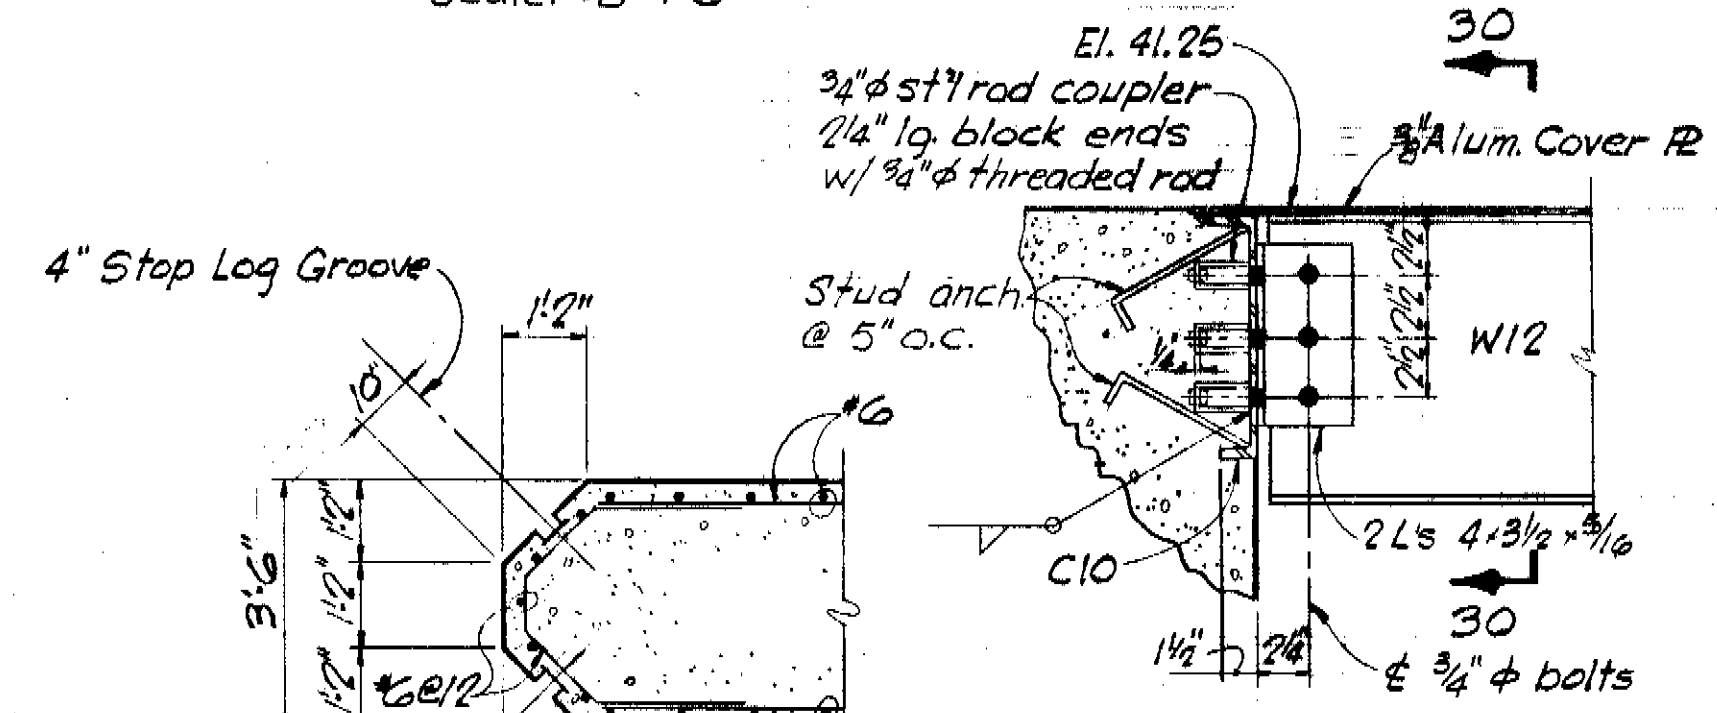

SECTION 29/9
Scale: 1/2"=1'-0"

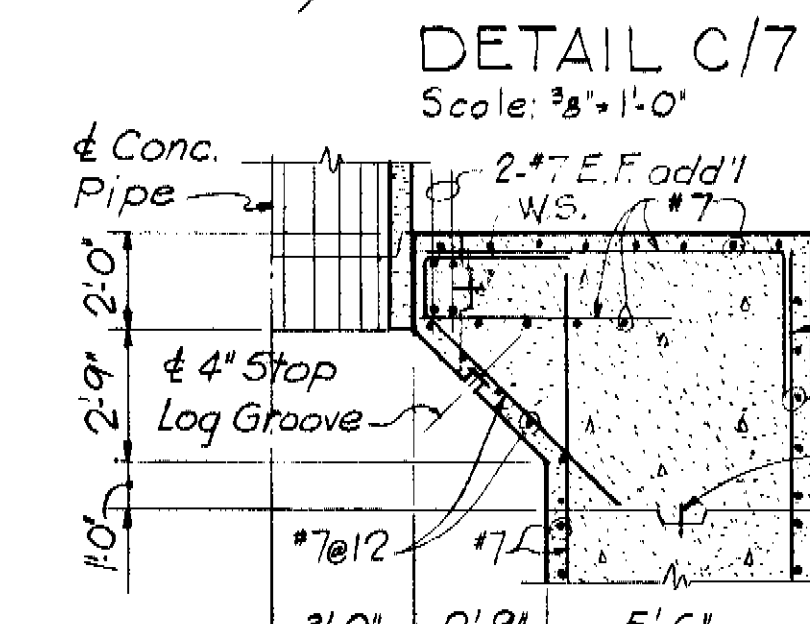

DETAIL D/7
Scale: 1/4"=1'-0"

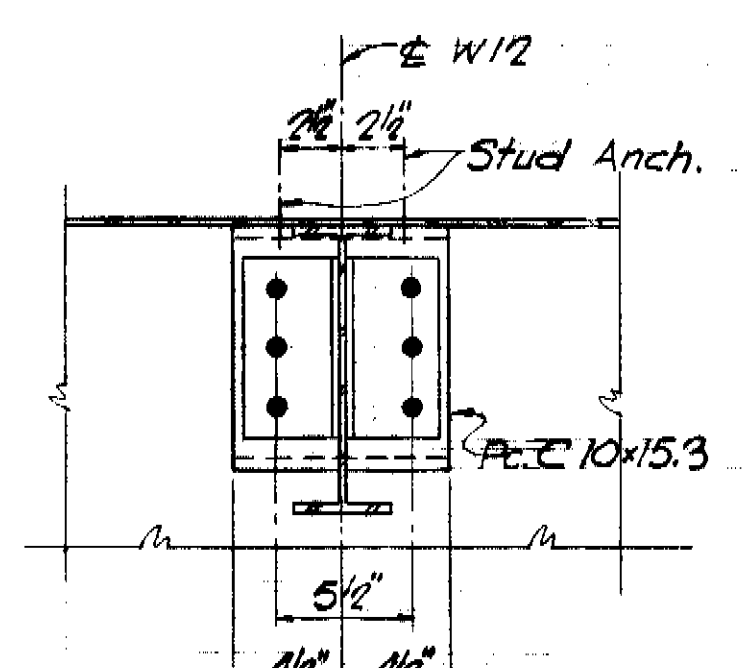

SECTION 30
Scale: 1/2"=1'-0"

NOTE:
ALL ELEVATIONS SHOWN ARE REFERENCED TO CITY OF TAMPA DATUM. TO CONVERT TO NATIONAL OCEAN SURVEY (NOS) DATUM, SUBTRACT 0.15 FEET (0'-1 13/16").

RECORD DRAWING

THIS RECORD DRAWING IS NOT WARRANTED BUT IS BELIEVED TO REPRESENT CONDITIONS UPON COMPLETION OF CONSTRUCTION, WITHIN REASONABLE TOLERANCES, BASED UPON THE INFORMATION FURNISHED TO THE ENGINEER PERTAINING TO CHANGES MADE DURING CONSTRUCTION.


NOTES:
For General Notes and Typical Details see Sheets 15 #16
For Beam Schedule see Sh. 9

GREELEY AND HANSEN
ENGINEERS
222 S. RIVERSIDE PLAZA
CHICAGO, ILLINOIS 60606

DESIGNED PYL
DRAWN PYL
CHECKED SSP

APPROVED
DATE
Supt., Dept. of Sanitary Sewers
DATE
GREELEY AND HANSEN, ENGINEERS

NO.	DATE	APP.	REVISION
1	10/81	DSH	Rec. Dwg. Revisions
	Mar. 78	JRP	Plans Updated

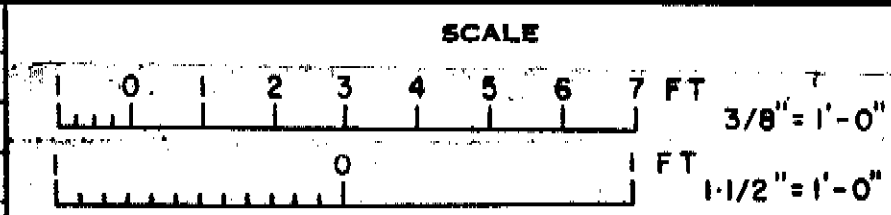


CITY OF TAMPA, FLORIDA
SEWAGE DISPOSAL SYSTEM
DIVISION 4G3
131 ST. AVENUE PUMPING STATION

STRUCTURAL
SECTIONS

PROJ. NO. S 202-70-300-7-463
SHEET 14 OF 35
DATE AUGUST, 1972 REV. 0

173-51

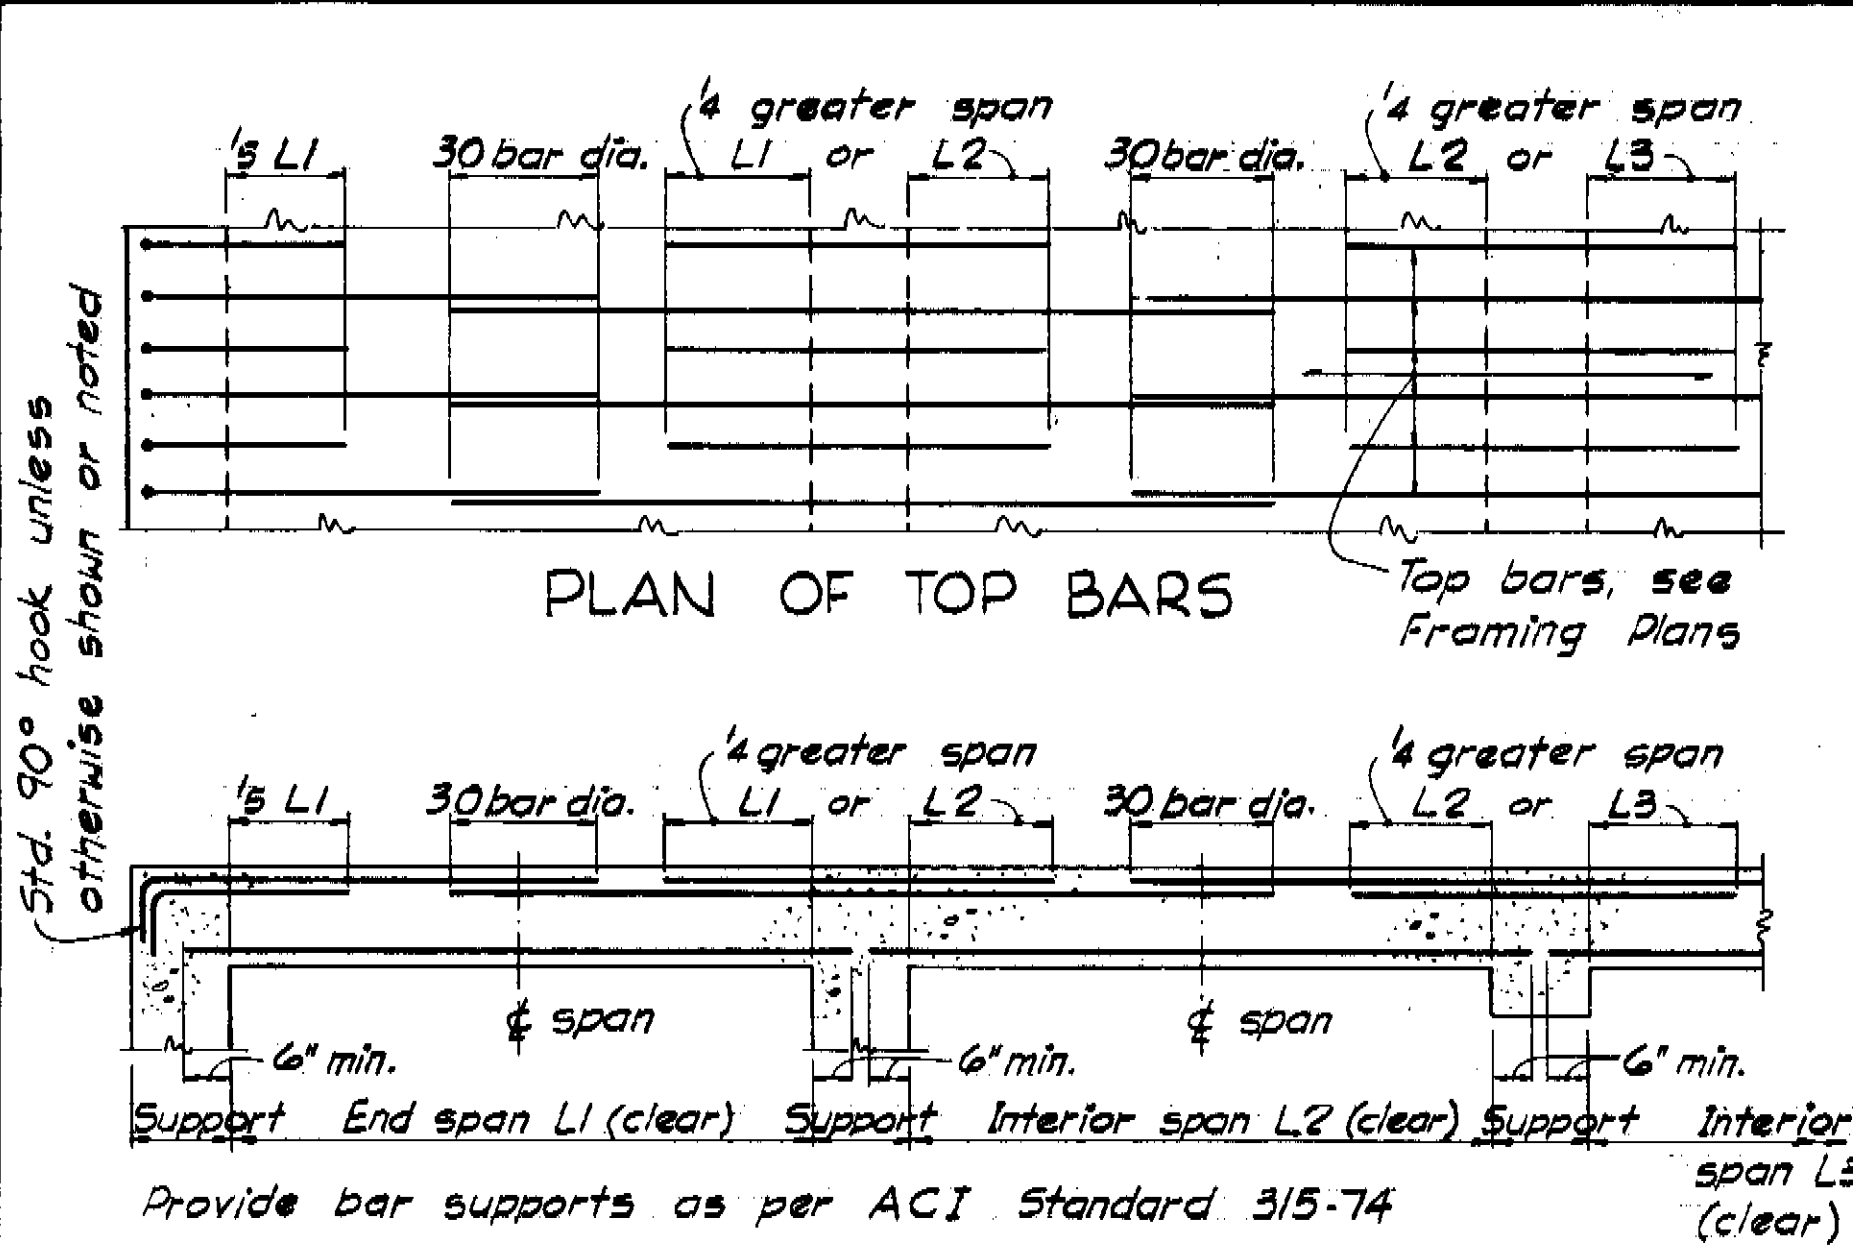


SLAB REINFORCING SCHEDULE












Top bars	Bottom bars	Size & spacing
T1	B1	#4@12
T2	B2	#4@9
T3	B3	#5@12
T4	B4	#5@9
T5	B5	#6@12
T6	B6	#7@12
T7	B7	#8@12
T8	B8	#6@6
T9	B9	#8@9
T10	B10	#7@6
T11	B11	#8@6
T12	B12	#5@6
T13	B13	#4@6

TEMPERATURE REINFORCING SCHEDULE

Thickness of slab	Size & Spacing Ed. Face
6"	#4@12
7"	#4@12
8"	#4@12
9"	#5@12
10"	#5@12
11"	#5@12
12"	#6@12

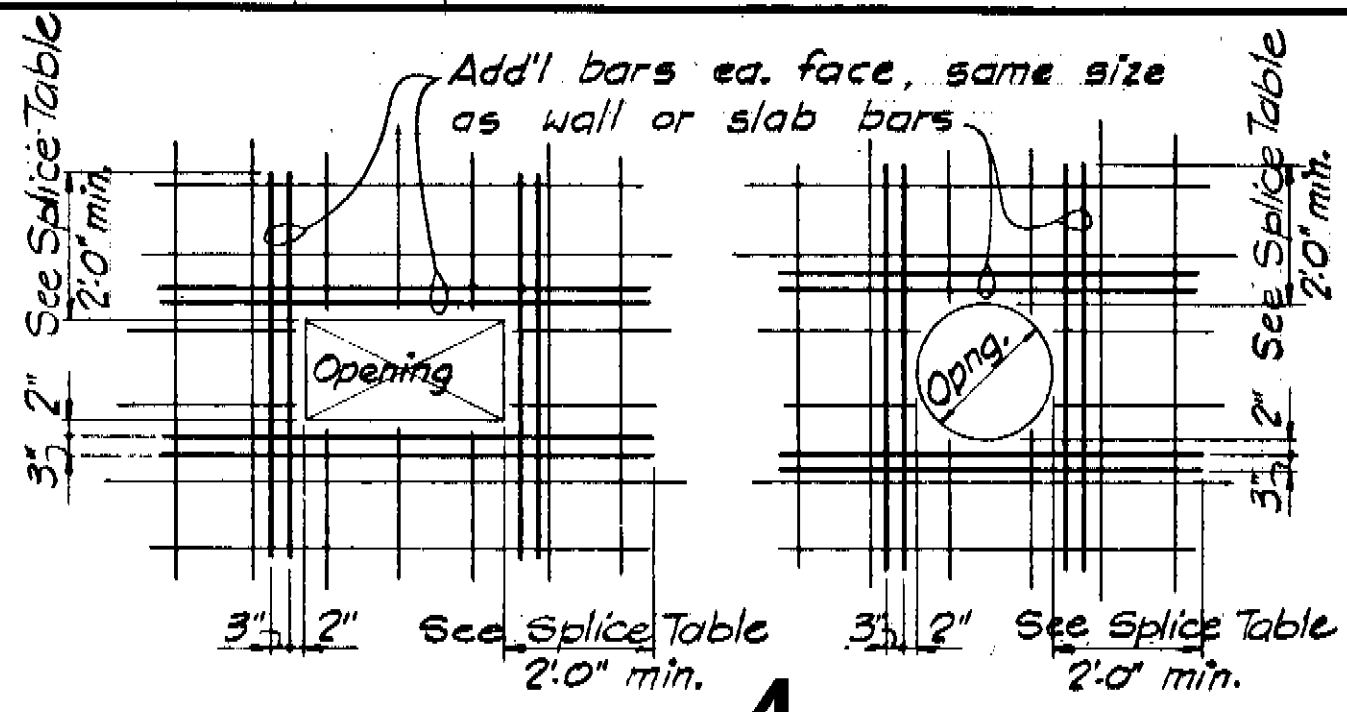

Note: Openings in walls and slabs with a dimension in excess of 24 inches shall be built as detailed on the drawings or as directed. Bars to be hooked where 2.0' minimum embedment is not possible.

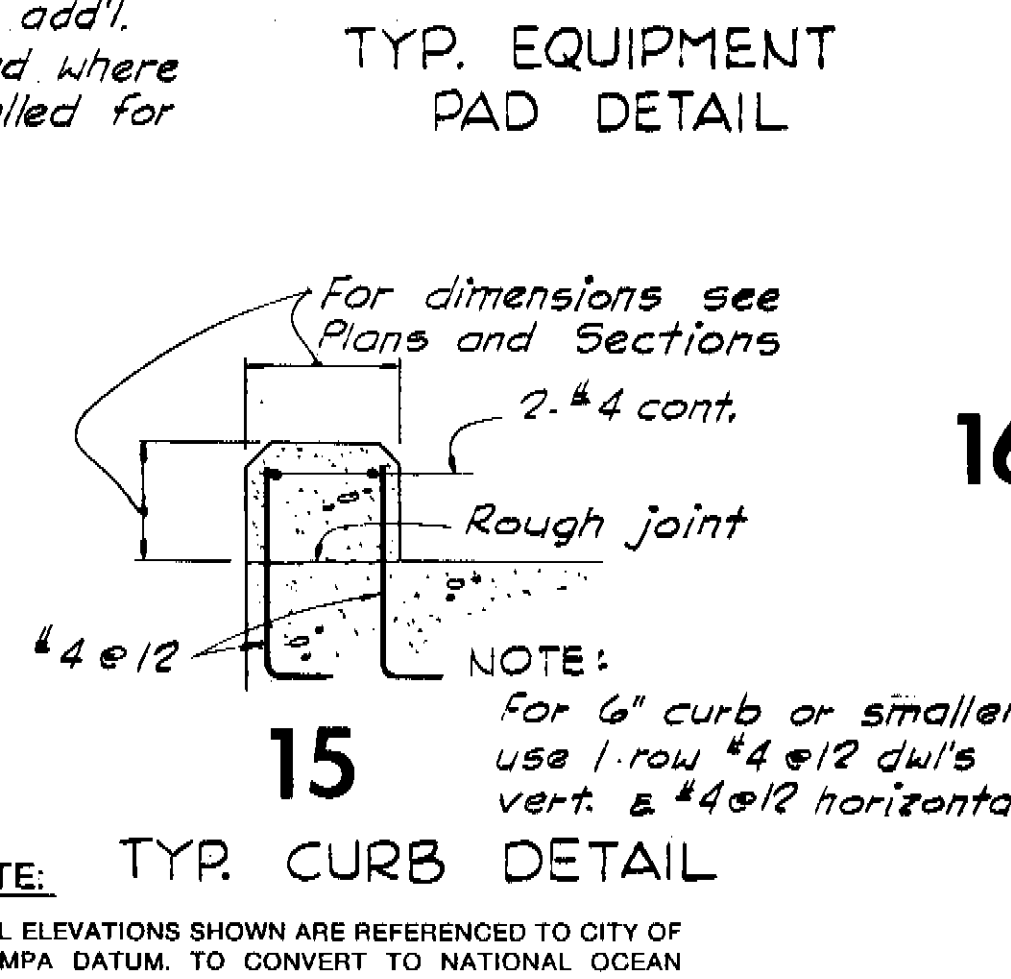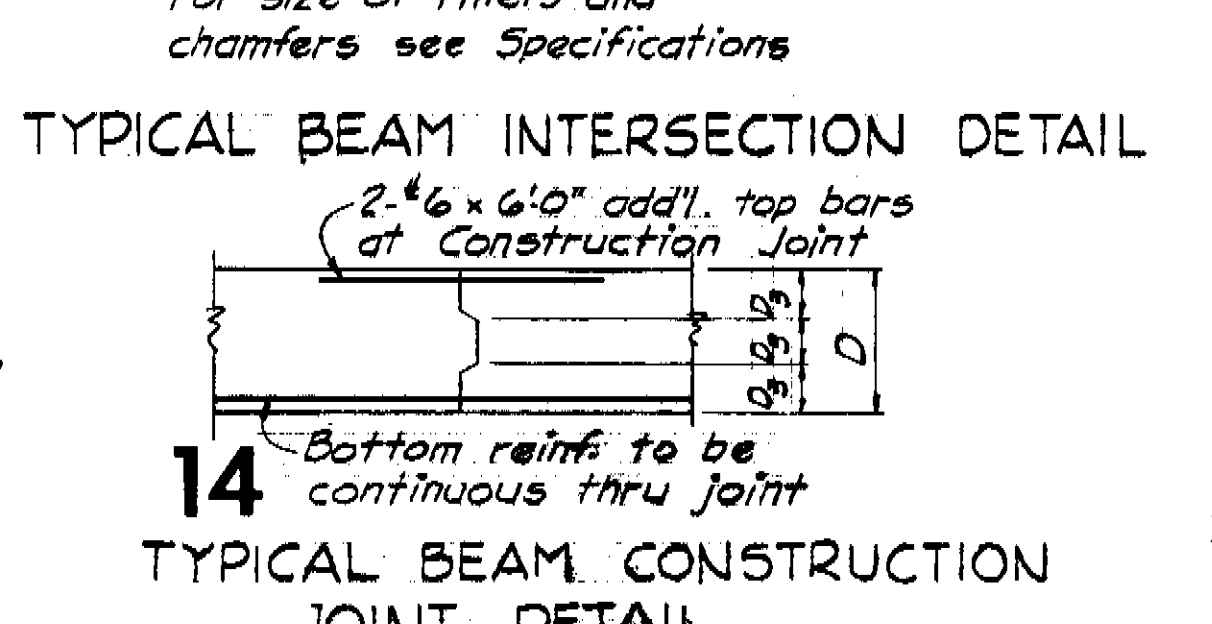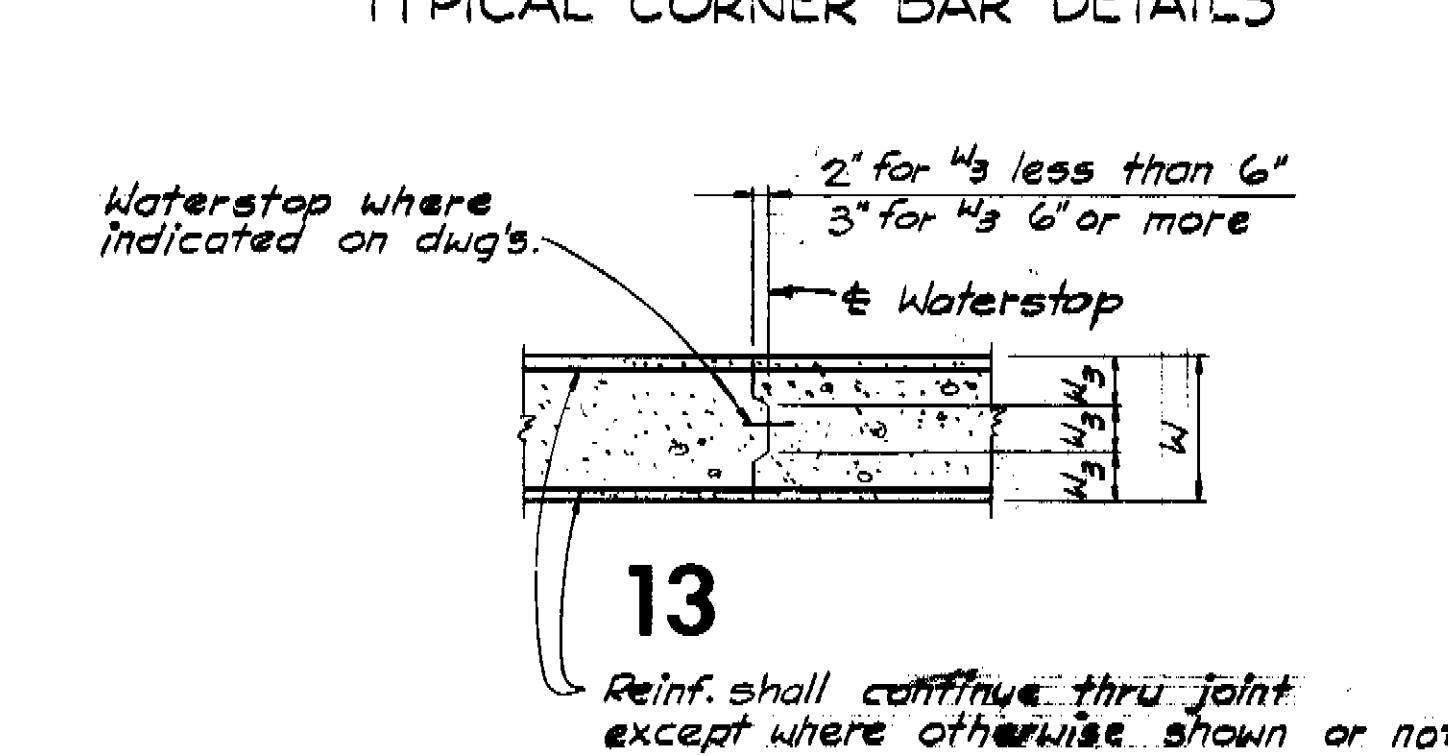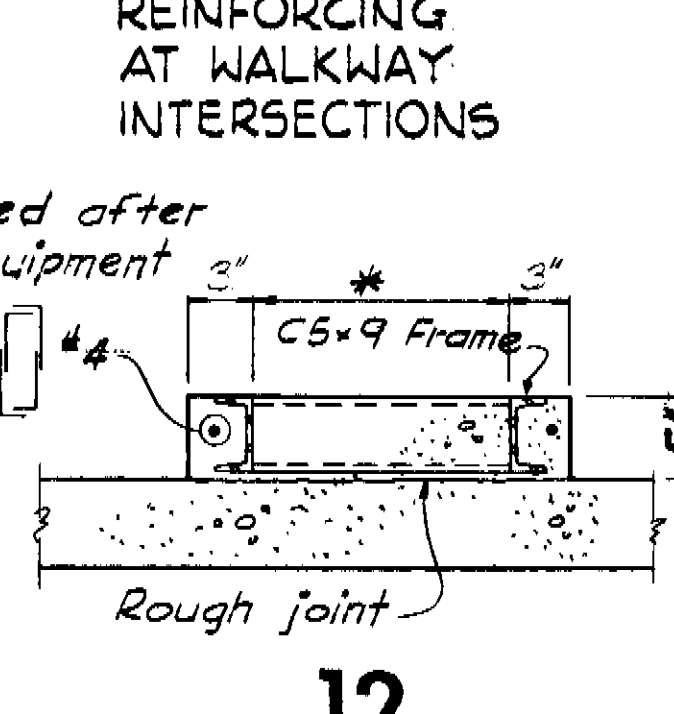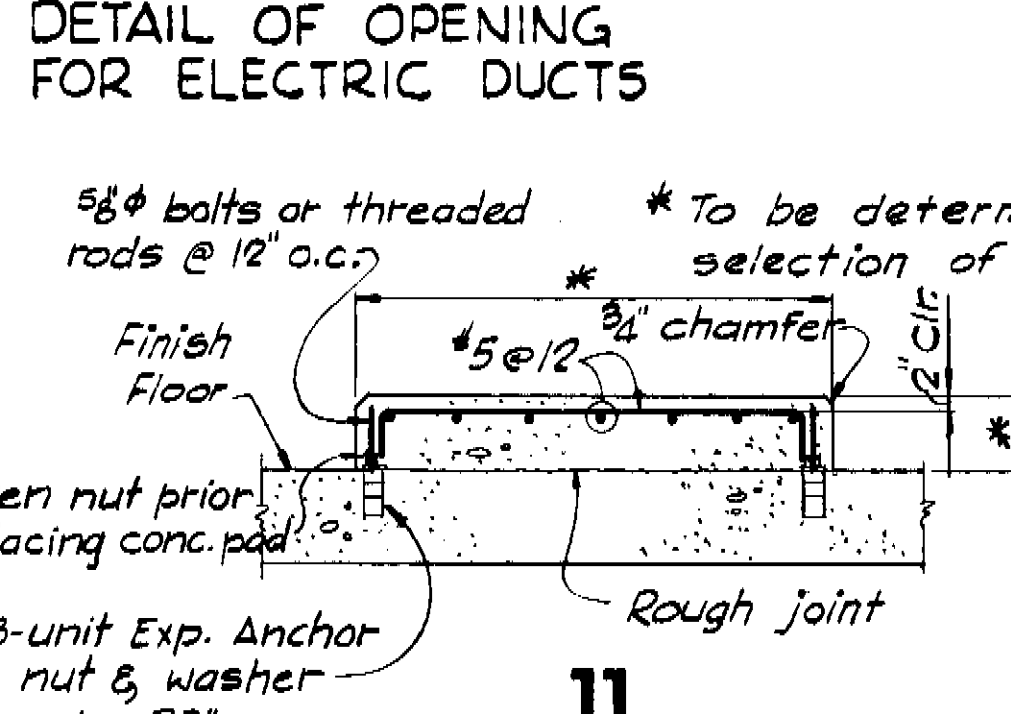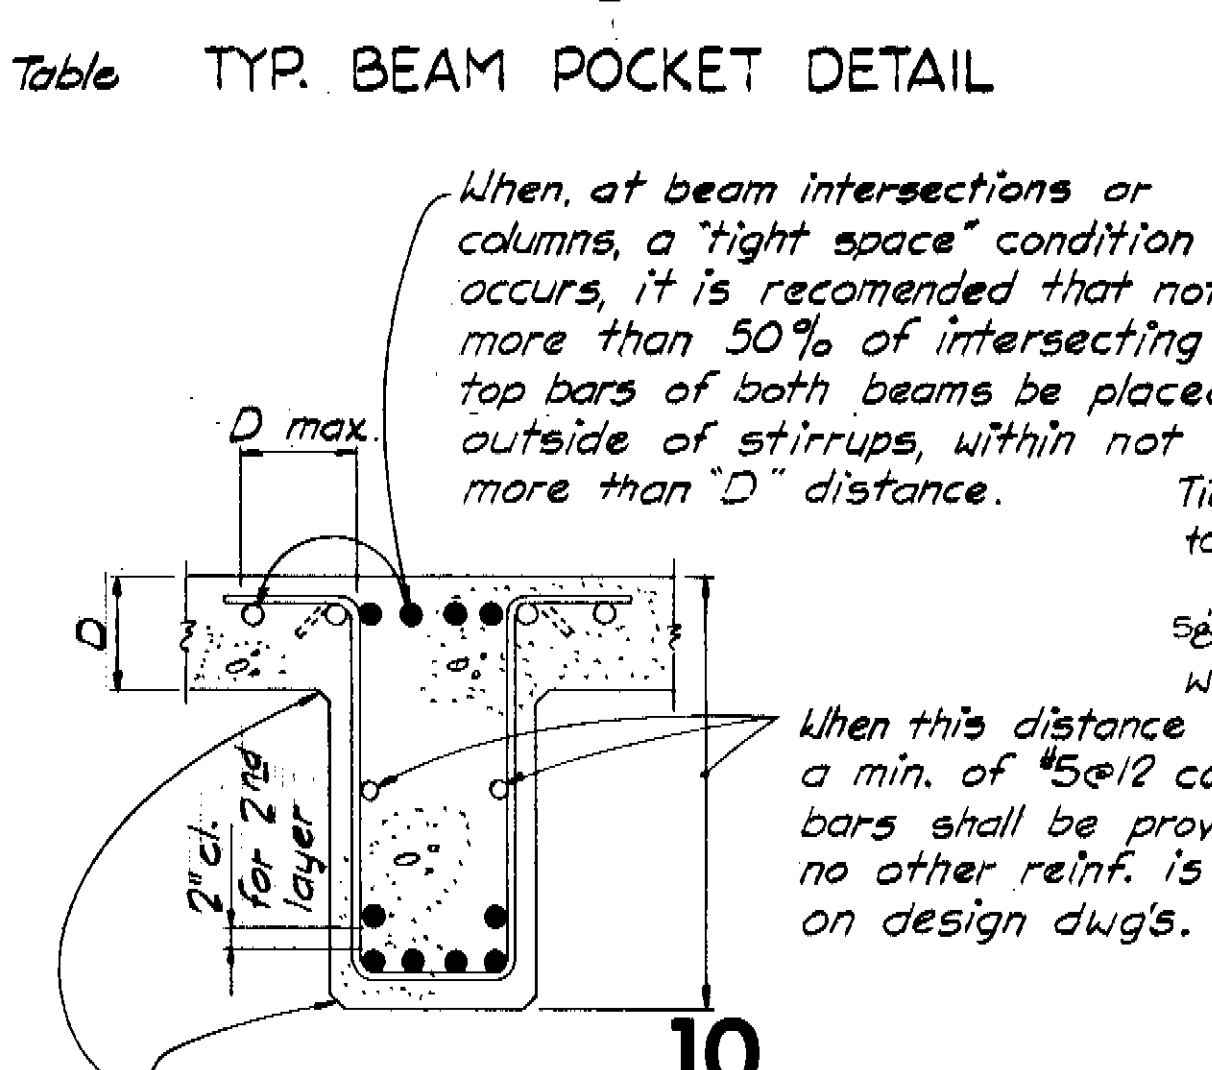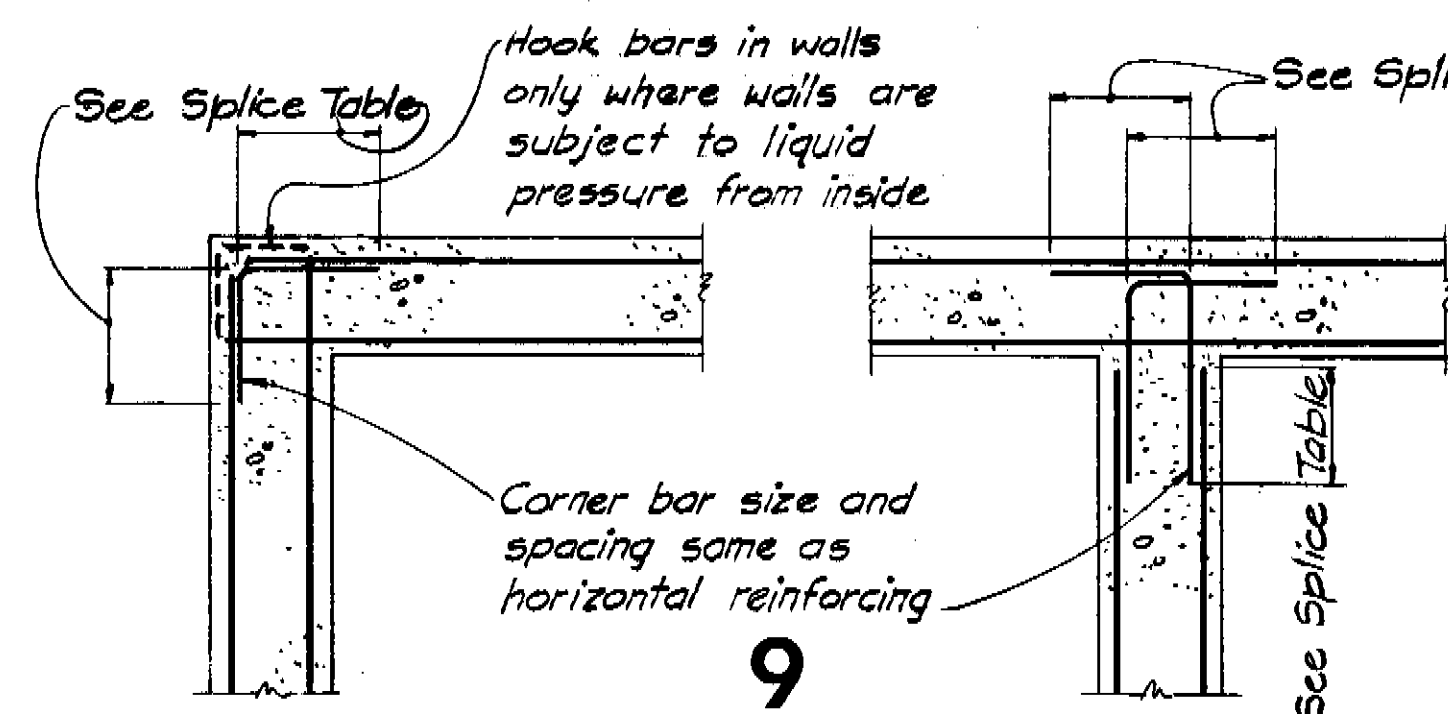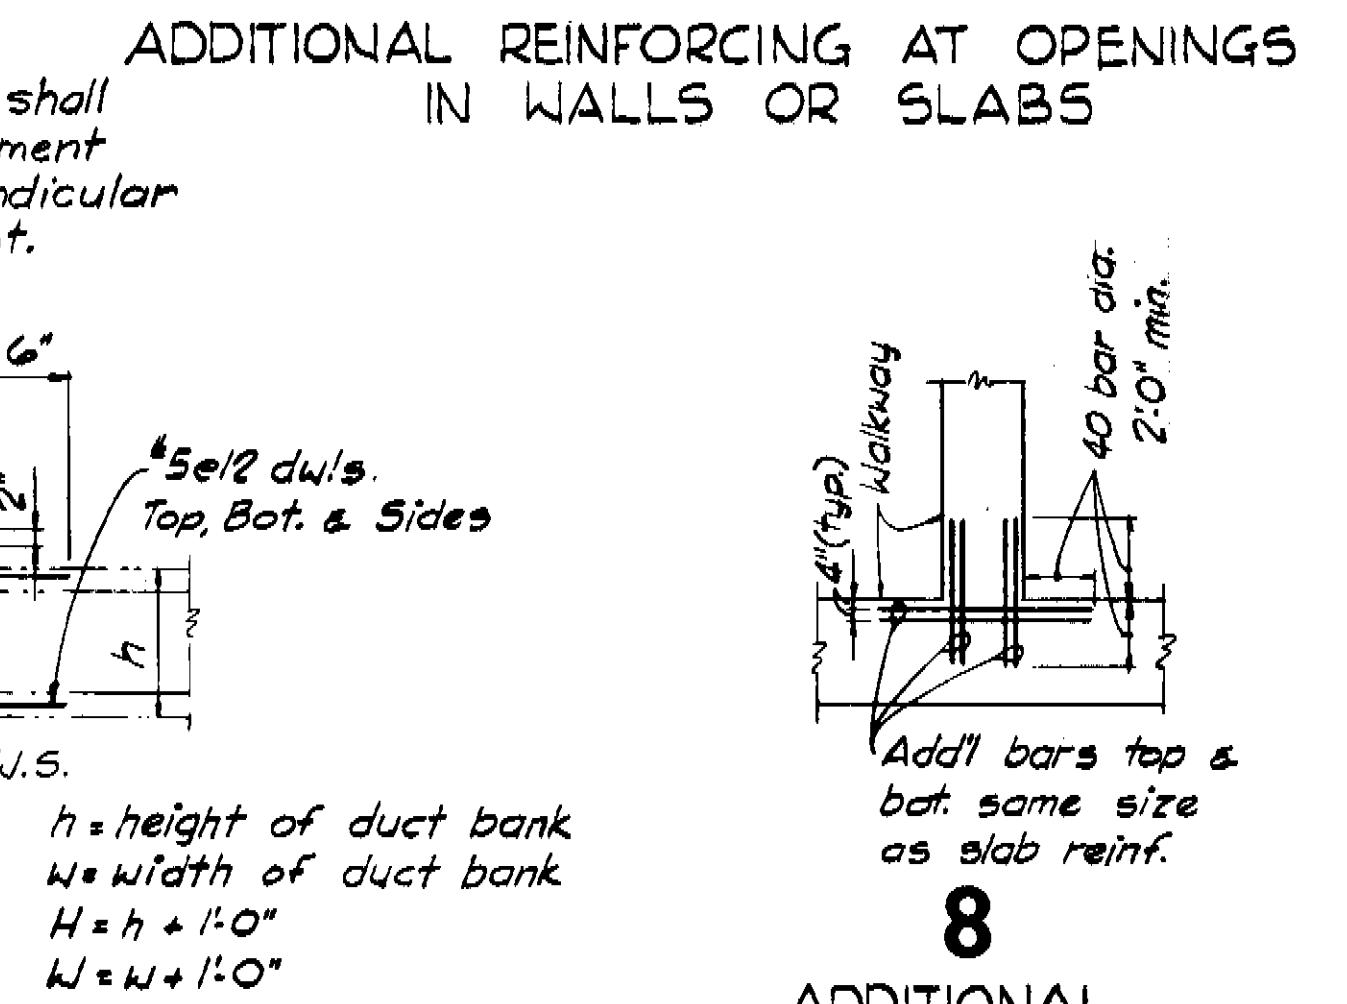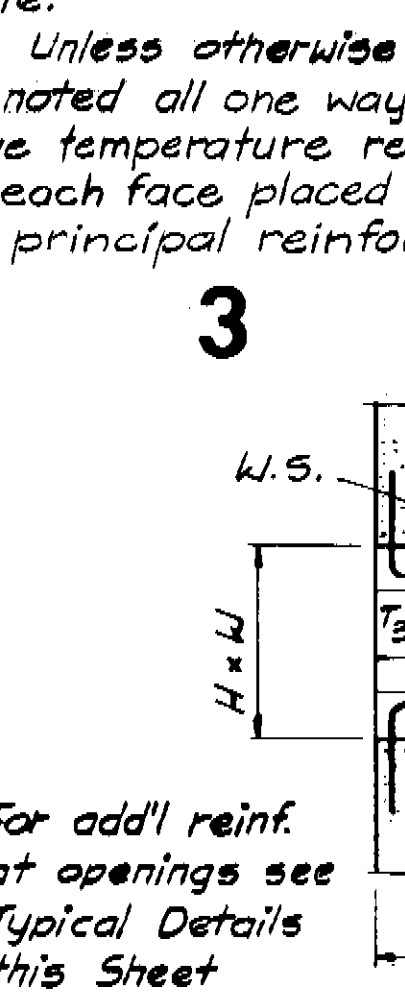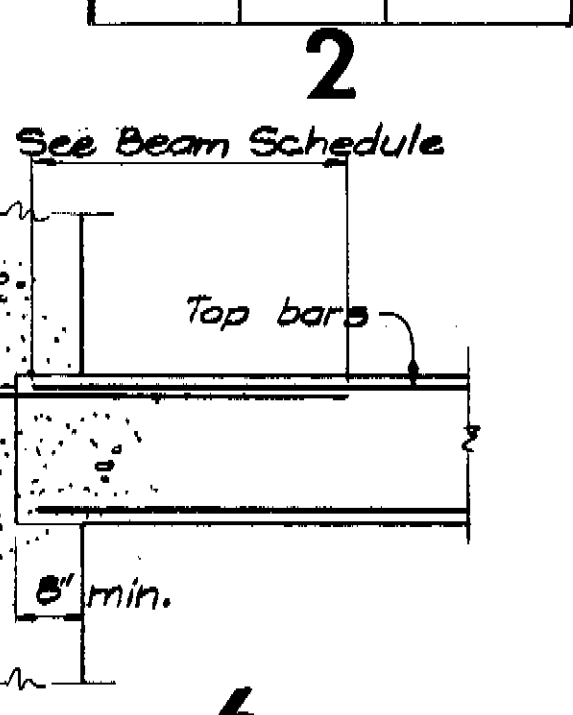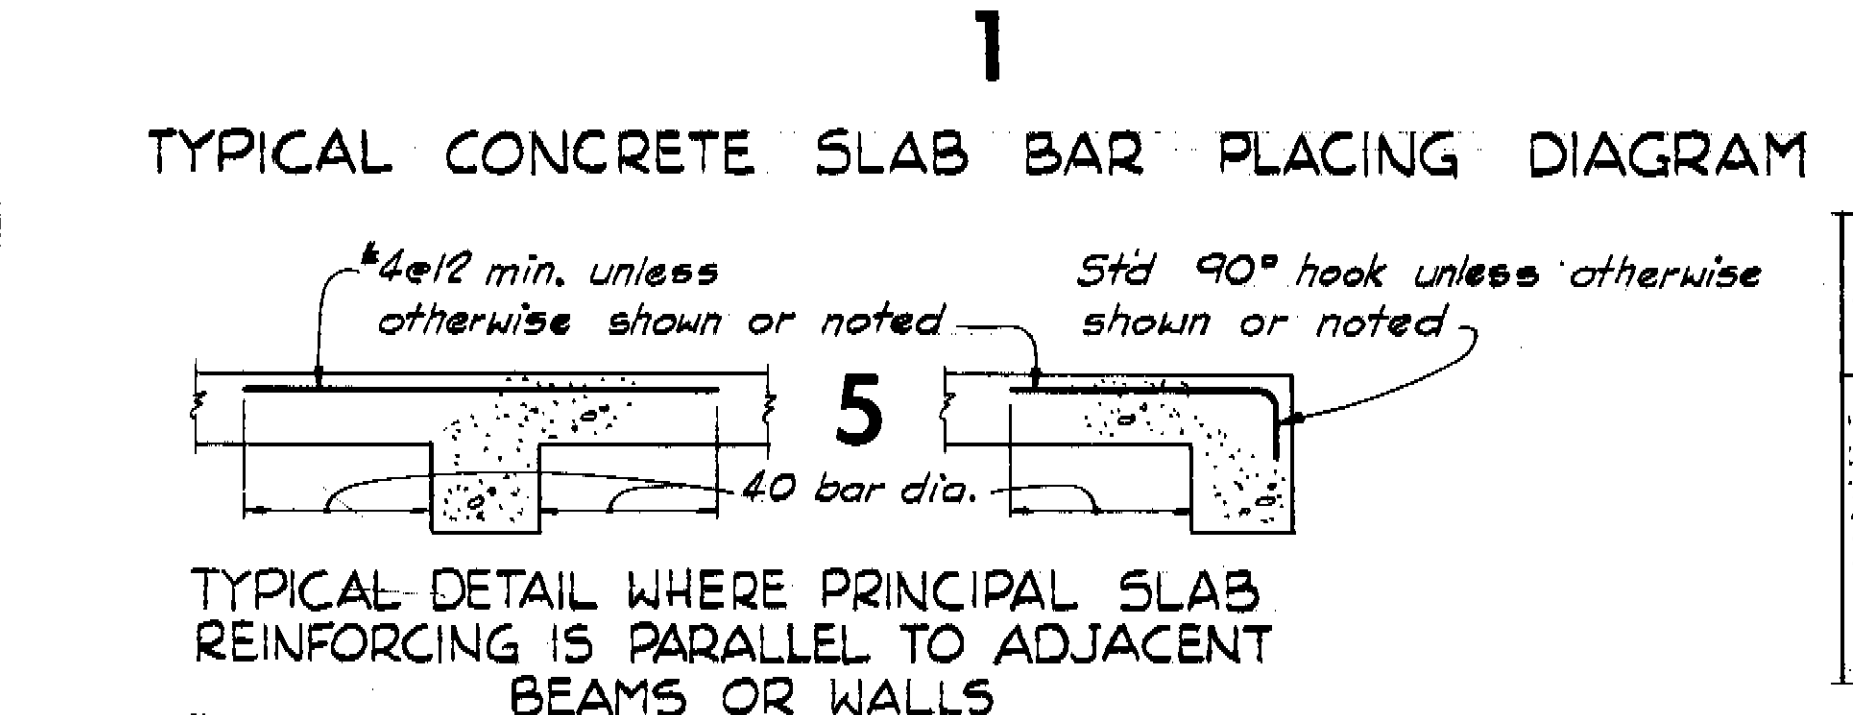

RECORD DRAWING

THIS RECORD DRAWING IS NOT WARRANTED BUT IS BELIEVED TO REPRESENT CONDITIONS UPON COMPLETION OF CONSTRUCTION WITHIN REASONABLE TOLERANCES BASED UPON THE INFORMATION FURNISHED TO THE ENGINEER PERTAINING TO CHANGES MADE DURING CONSTRUCTION.


- GENERAL NOTES**
1. Mortar to be expanded to space 1/2" minimum below the bottom of wall - and the space filled with compacted crushed stone.
 2. For compacted fill, backfill and crushed stone fill, see Specs.
 3. Backfill shall not be placed against any substructure wall until forms have been stripped from adjacent slab or unless walls have been properly braced, and in no case sooner than 28 days after placing of wall concrete.
 4. For compressive strength of concrete see specifications.
 5. Exposed corners shall have 3/4" chamfer and re-entrant corners shall have 3/4" flat fillet unless otherwise noted.
 6. All reinforcing shall meet as a minimum the requirements of A.S.T.M. Des: A615, Grade 40.
 7. All reinforcing shall be detailed according to the Manual of Standard Practice for Detailing Reinforced Concrete Structures" (ACI Standard 315-74).
 8. Concrete cover for reinforcing bars:
 - a. Concrete deposited directly against soil and footings (bottom, sides & ends) - 3". Concrete deposited against concrete workmat - 2".
 - b. Slab - Troweled surface - 1/2" Elsewhere - 1"
 - c. Beams and Columns - 2" (see f)
 - d. Walls 12" or more thick - 2" (see f) Less than 12": #6 bars or larger - 2" (see f) #5 bars or smaller - 1 1/2" (see f)
 - e. Footings (top surface) and base slabs - 2 1/2"
 - f. Add 1/2" for surfaces contacting or exposed to water or sewage.
 9. All reinforcing shall be lapped in accordance with the lap splice table given below unless otherwise shown or noted.
 10. The actual placement of reinforcing shall be as shown on the approved shop drawings.
 11. For sleeves, wall castings, openings in walls and slabs; and other items embedded in concrete and not shown; and equipment bases, see Architectural, Equipment, Electrical, Plumbing and Ventilating Drawings.
 12. All structural steel shall be detailed, fabricated and erected in accordance with the latest A.I.S.C. specifications.
 13. Structural steel shall conform to ASTM A36. Bolts shall be 3/4" friction type high strength bolts conforming to ASTM A325. Electrodes for welding shall be E70XX.
 14. All details and sections shown on drawings are intended to be typical and shall be construed to apply to any similar situation elsewhere.
 15. Size and location of concrete bases and anchor bolts shall be arranged for equipment furnished and in accordance with approved shop drawings.
 16. All curbed and other openings in floors, roofs, walls and equipment bases for duct work, piping and other equipment shall be in accordance with approved shop drawings.

REINFORCING BAR LAP SPLICE TABLE

Bar Size	SPLICE LENGTH - INCHES*									
	#3	#4	#5	#6	#7	#8	#9	#10	#11	
Top Bars**	"B"	12	12	15	21	28	37	47	59	78
	"C"	12	12	14	20	27	34	43	52	65
Other Bars	"B"	12	12	12	15	20	27	34	43	52
	"C"	12	12	14	20	27	35	44	56	68

* For splices spaced closer than 6", increase lap length 25%.
 ** Top bars are all horizontal reinforcing placed so that more than 12 inches of concrete is cast in the member below the bar.

1. Unless specified otherwise, all lap splices shall conform to the table above.
2. Unless specified otherwise, the length of lap for splices shall be length "B" where no more than 1/2 of the bars are lap spliced and length "C" where more than 1/2 of the bars are lap spliced.
3. Construction joints with or without waterstops shall be installed where shown on drawings. No such joint shall be added or omitted without prior approval of the Engineer. Such joints shall be installed as shown on any view even if they are not shown on all views of any particular area.

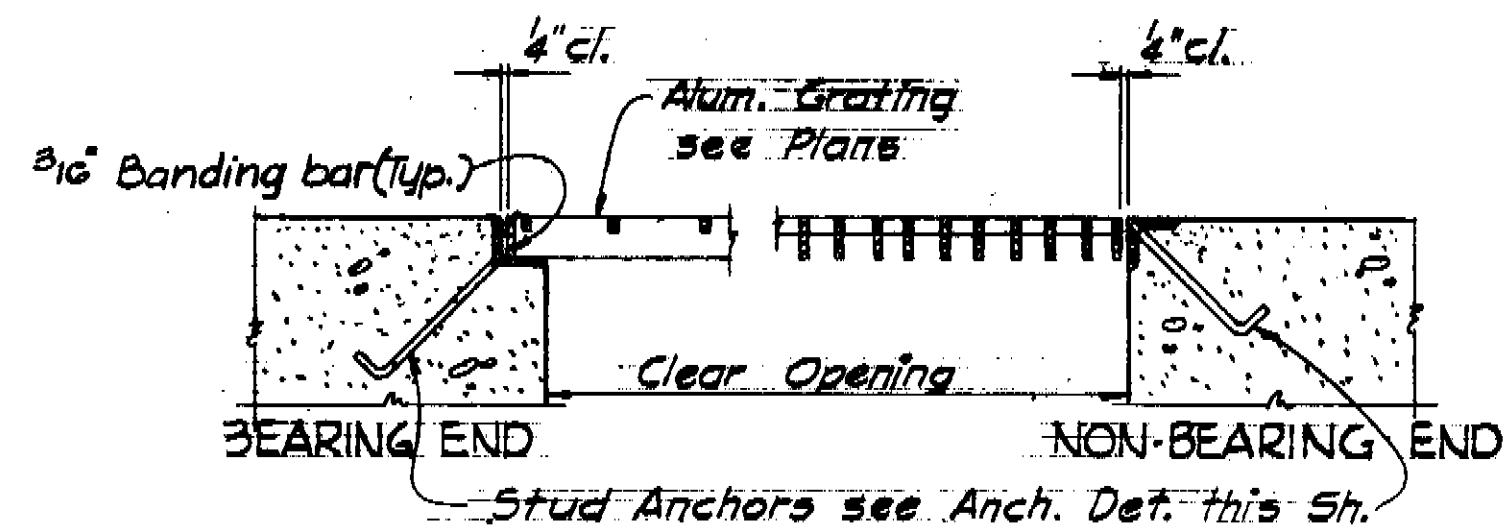


ALUMINUM GRATING		
Bearing bars spaced 1\"/>		
Span	Size *	Frame Angle Aluminum
Less than 4'-1"	1 3/4" x 3/16"	2 x 2 x 1/4
4'-1" thru 5'-0"	2 1/4" x 3/16"	2 x 2 1/2 x 1/4
5'-1" thru 6'-0"	2 3/4" x 3/16"	3 x 3 x 1/4
6'-1" thru 7'-6"	3 1/4" x 3/16"	3 1/2 x 3 1/2 x 1/4

20

ALUMINUM GRATING DETAILS


Notes:
Vertical leg to be flush with fin. floor, cut if req'd.
Aluminum surfaces in contact with conc. to be painted - see Specs.

* Or equivalent extruded section of the depth shown

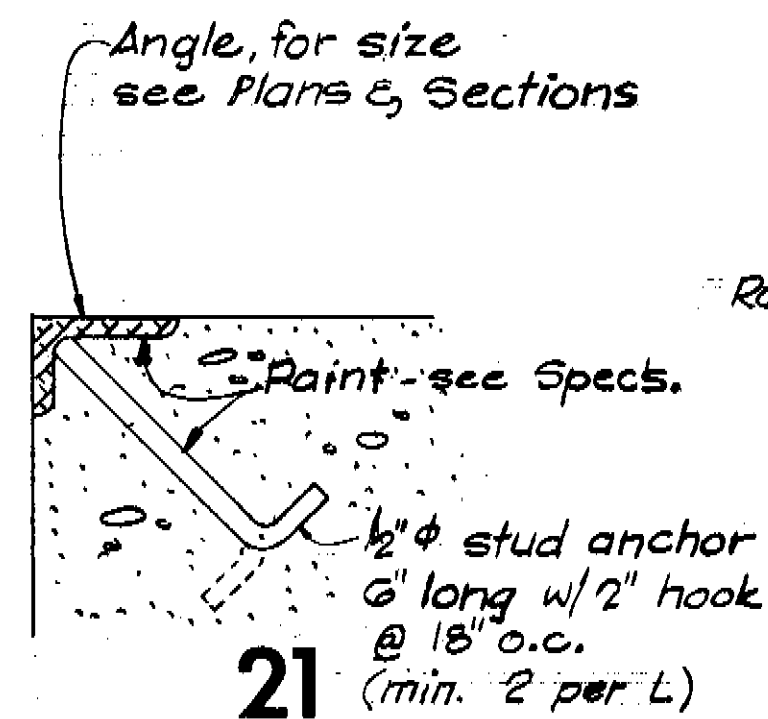


21

TYPICAL ANGLE ANCHORAGE DETAIL

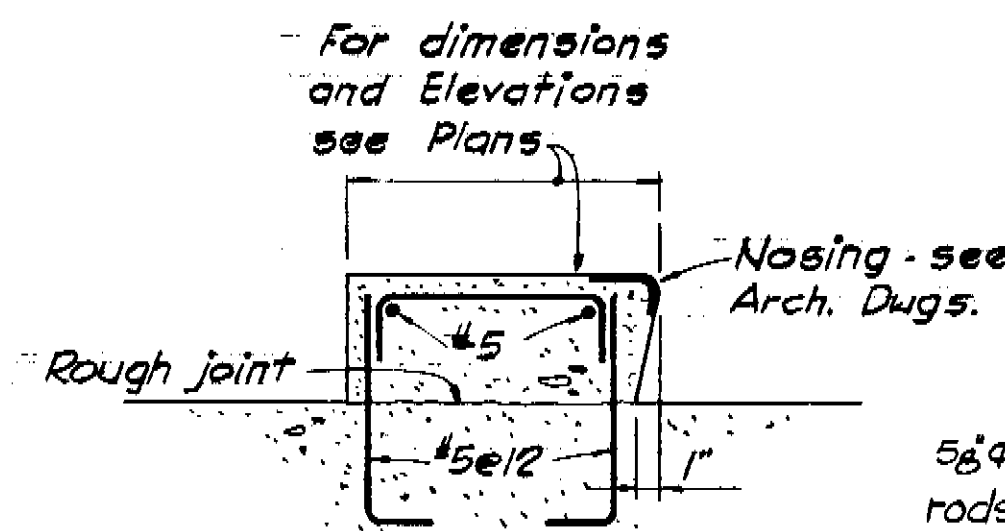


22

TYP. CONCRETE RISER DETAIL

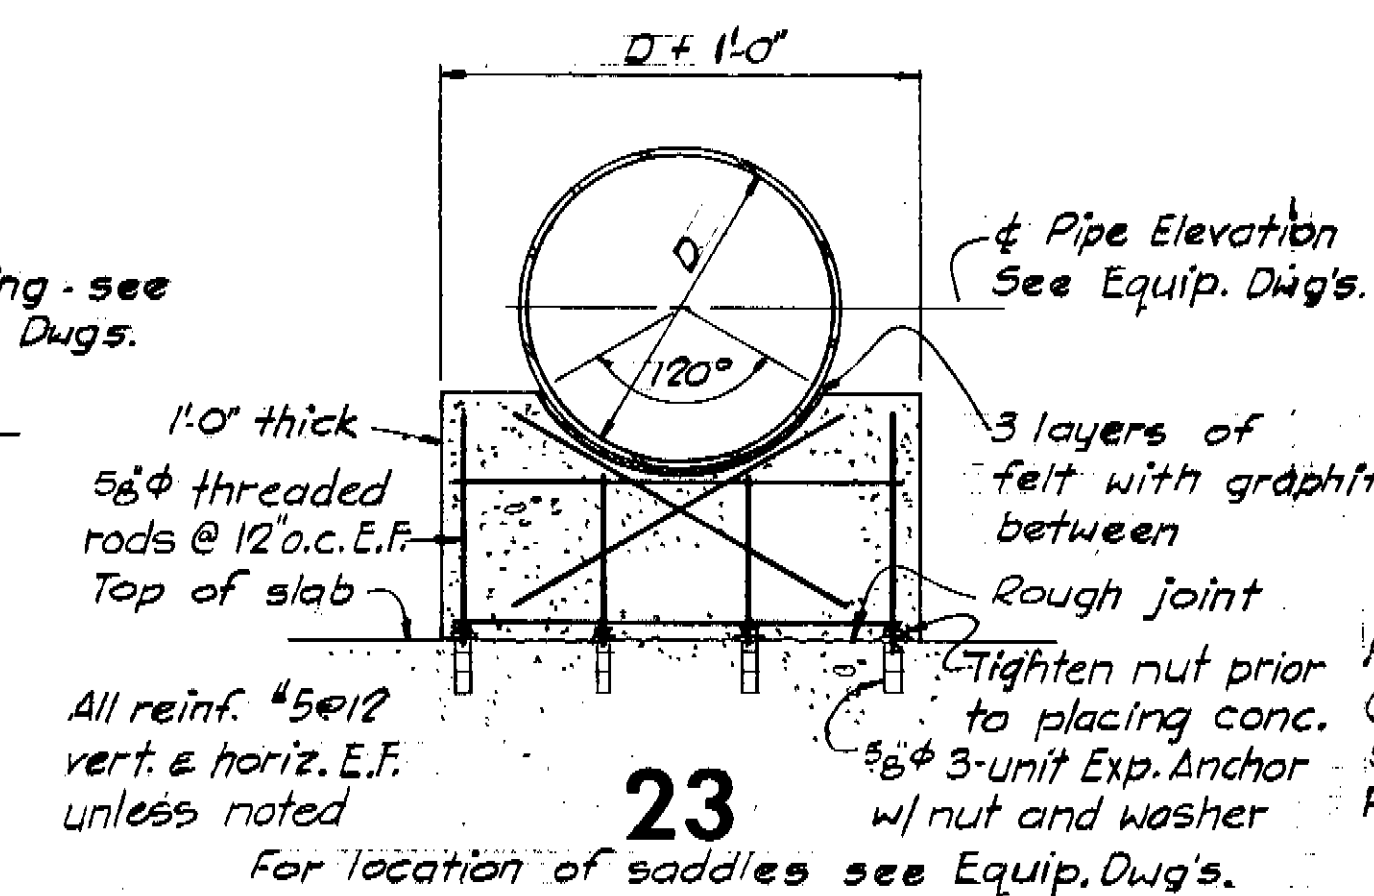


23

TYP. CONCRETE SADDLE DETAIL

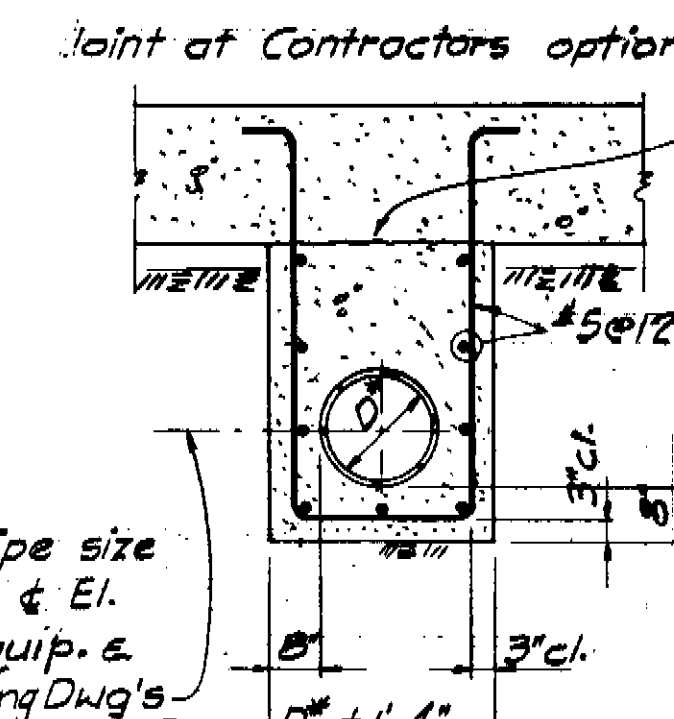


24

TYPICAL PIPE ENCASEMENT DETAIL

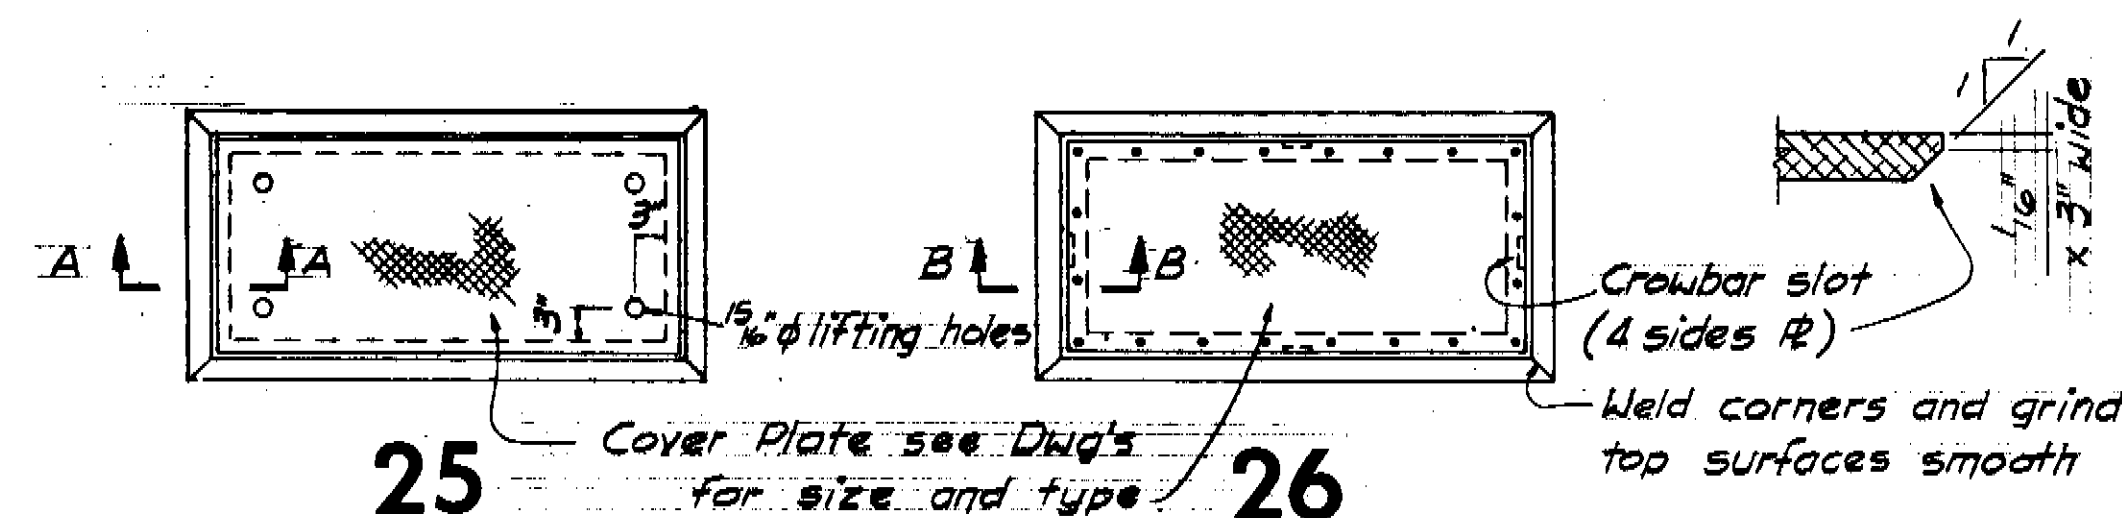


25

TYPICAL COVER PLATE

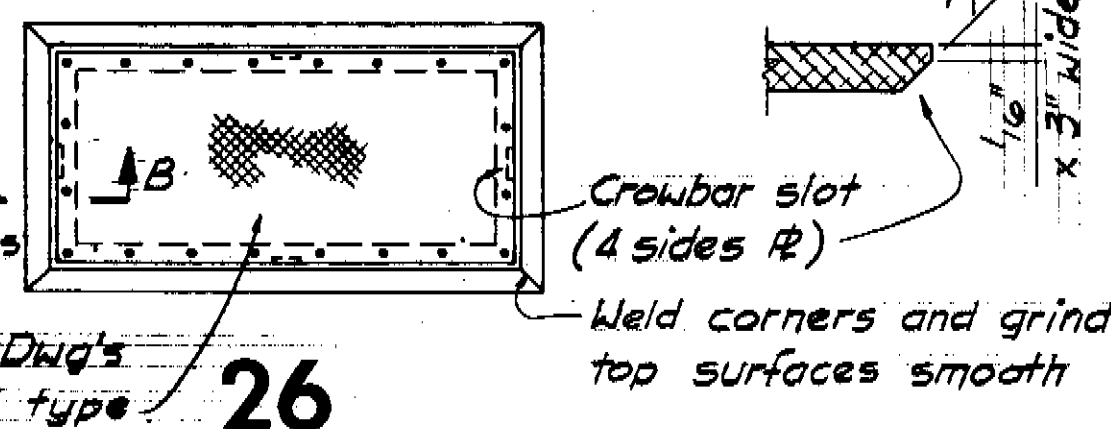


26

WATERTIGHT COVER PLATE

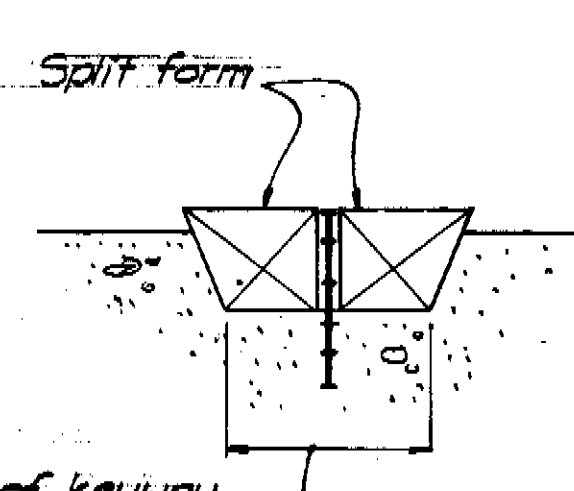


27

KEYWAY AT WATERSTOP

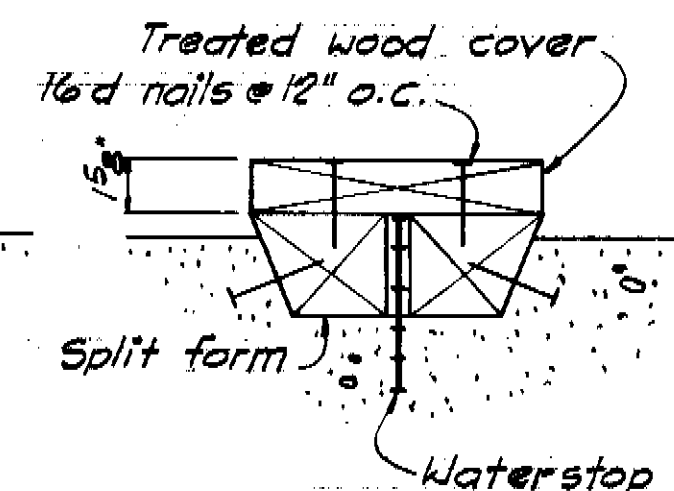


28

WATERSTOP PROTECTION DETAIL

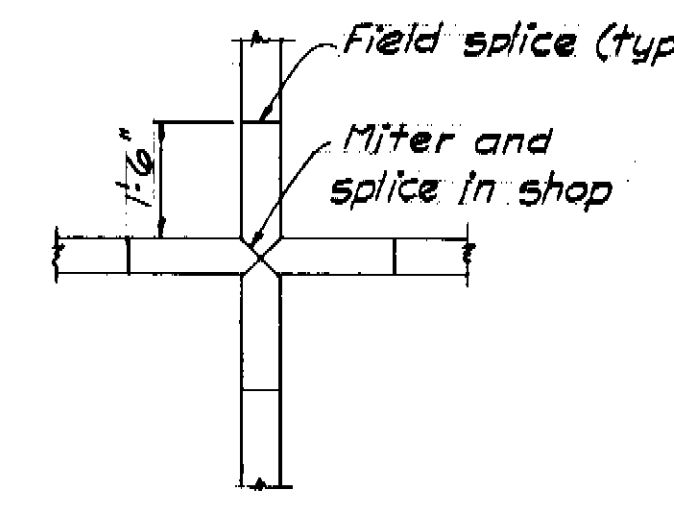


29

WATERSTOP DETAIL AT INTERSECTIONS

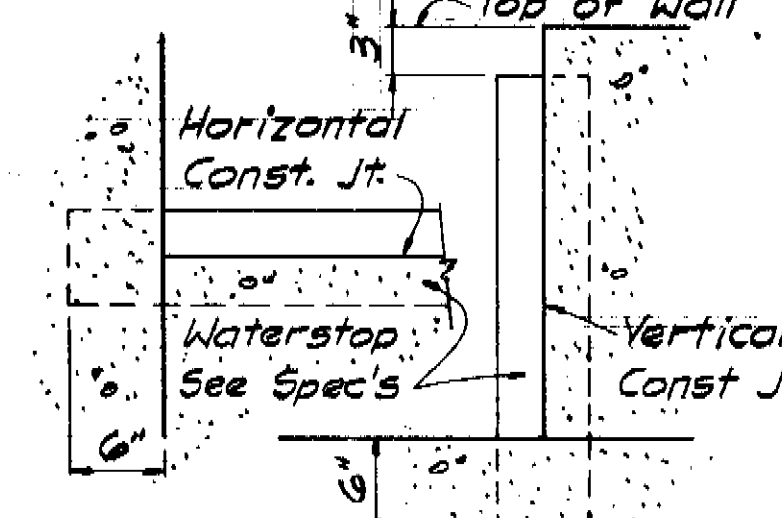


30

EMBEDMENT OF WATERSTOP AT TERMINATION OF CONST. JOINT

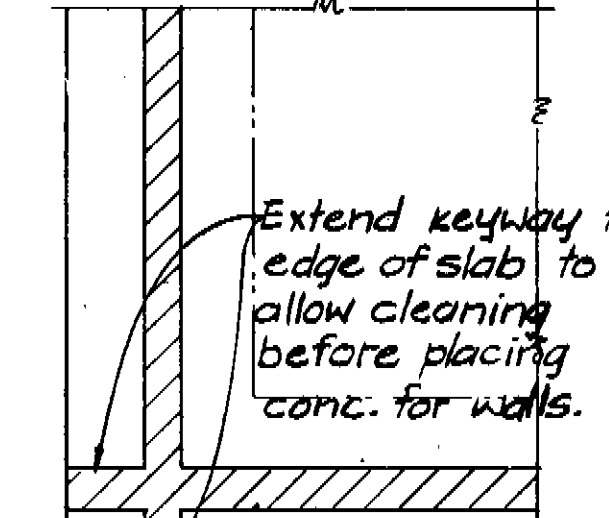


31

TYPICAL KEYWAY IN SLABS

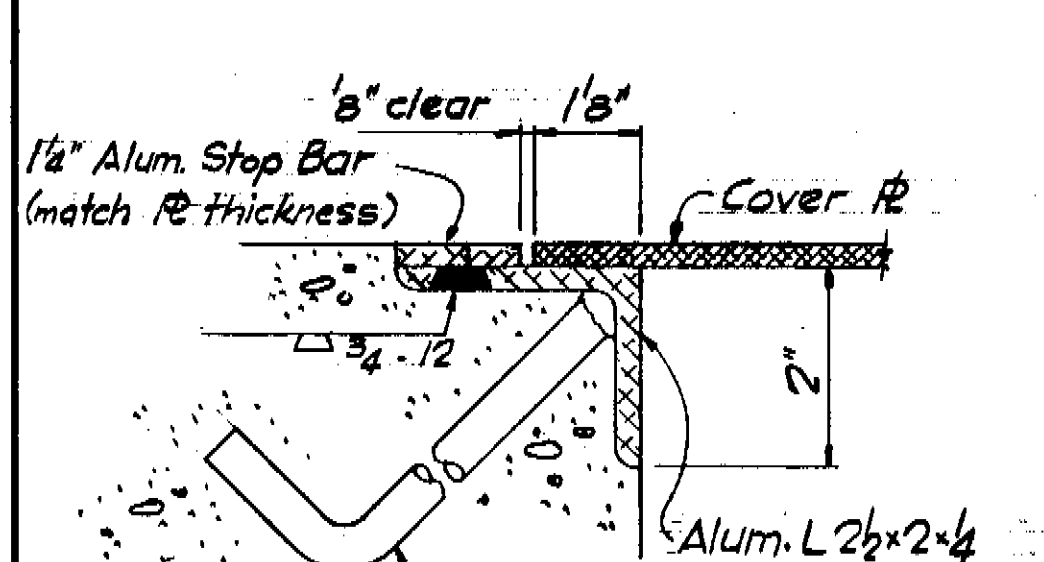


32

SECTION A-A

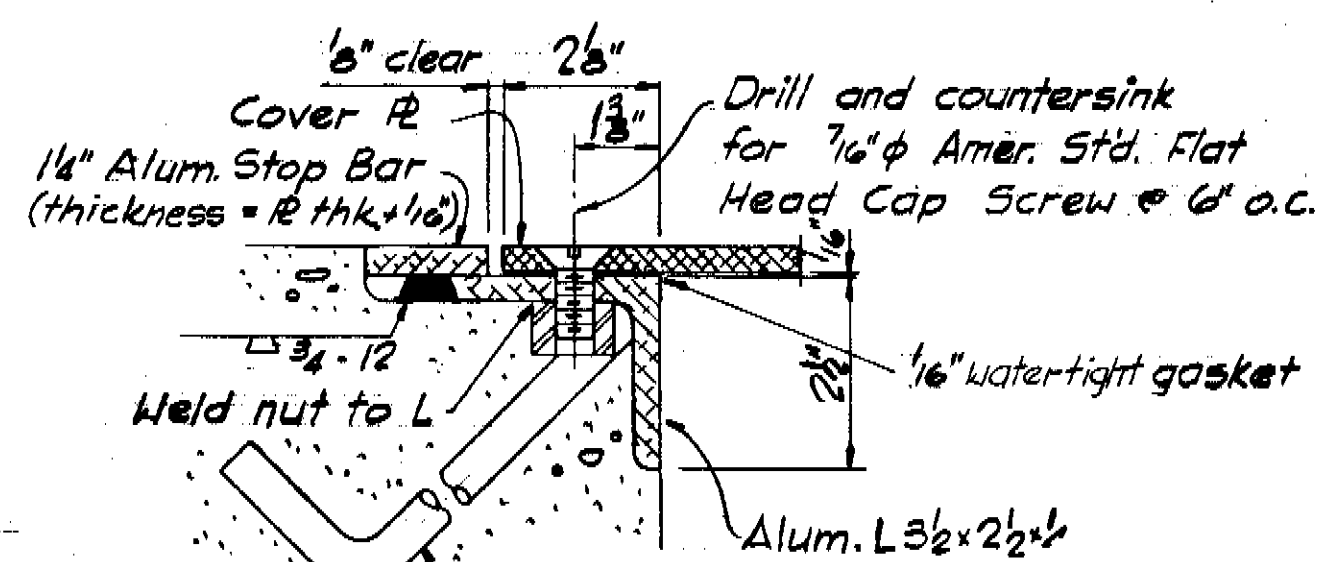


33

SECTION B-B

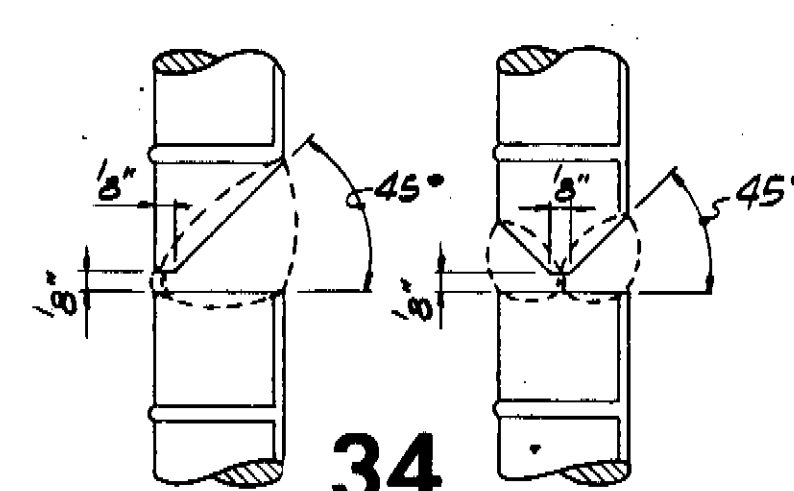


34

BUTT SPLICES - VERTICAL

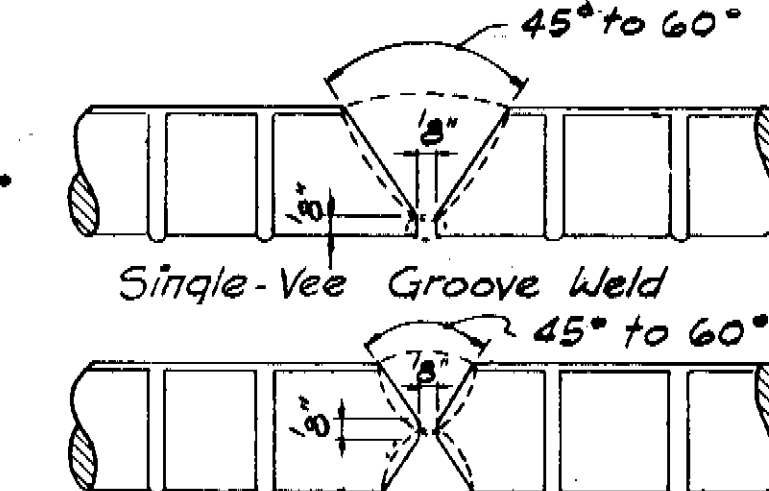

BUTT SPLICES - HORIZONTAL

DIRECT BUTT SPlice WELDING DETAILS FOR REINFORCING BARS

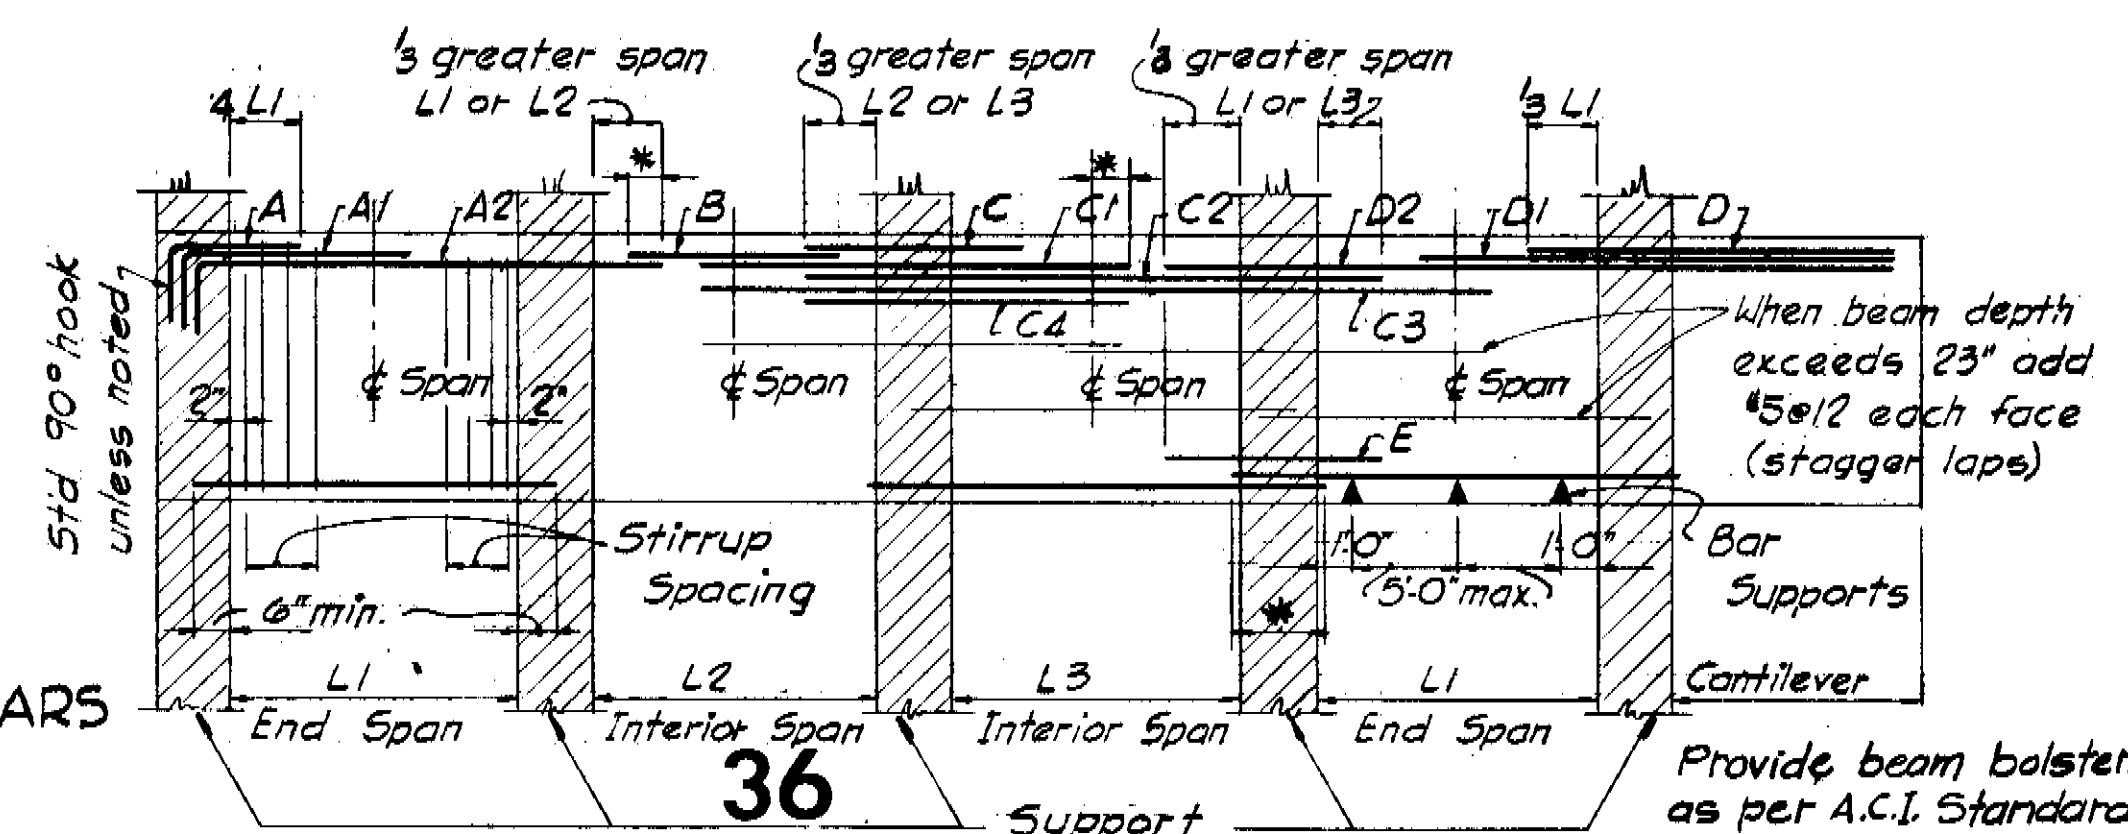

BEAM BAR PLACING DIAGRAM


* For splice length see Lap Splice Table on Sht. 15

NOTE:
ALL ELEVATIONS SHOWN ARE REFERENCED TO CITY OF TAMPA DATUM. TO CONVERT TO NATIONAL OCEAN SURVEY (NOS) DATUM, SUBTRACT 0.15 FEET (0'-1 13/16").

RECORD DRAWING


THIS RECORD DRAWING IS NOT WARRANTED BUT IS BELIEVED TO REPRESENT CONDITIONS UPON COMPLETION OF CONSTRUCTION WITHIN REASONABLE TOLERANCES BASED UPON THE INFORMATION FURNISHED TO THE ENGINEER PERTAINING TO CHANGES MADE DURING CONSTRUCTION.

41 Numbers shown thus on this Sheet are for reference only, and do not designate Details identified on other Contract Drawings.

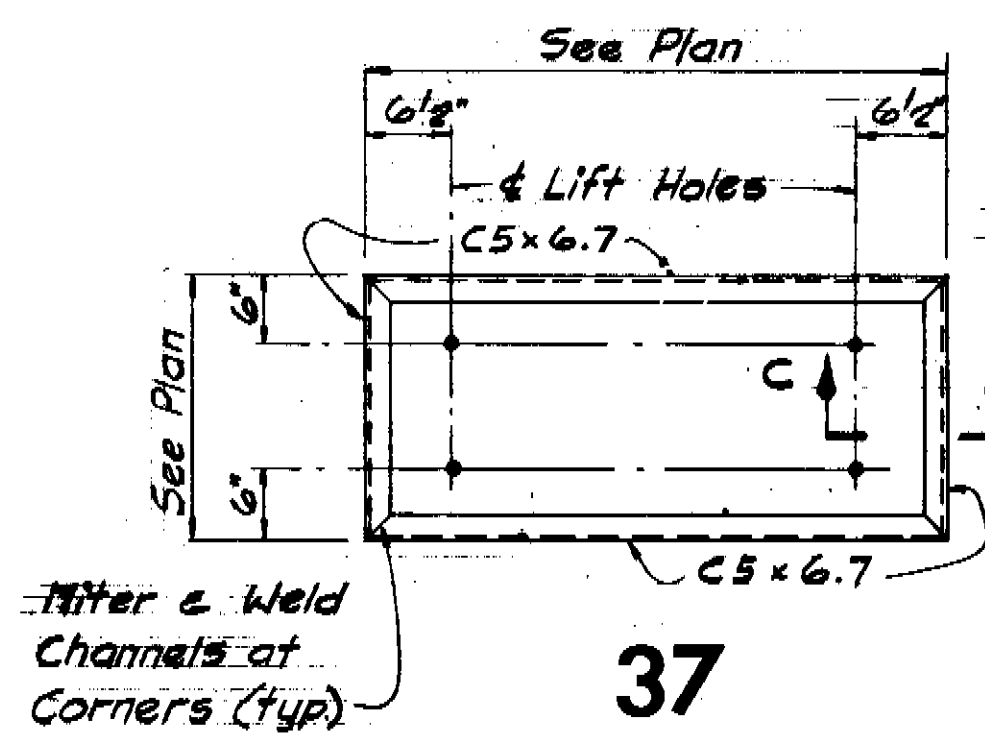


37

REMOVABLE SLAB

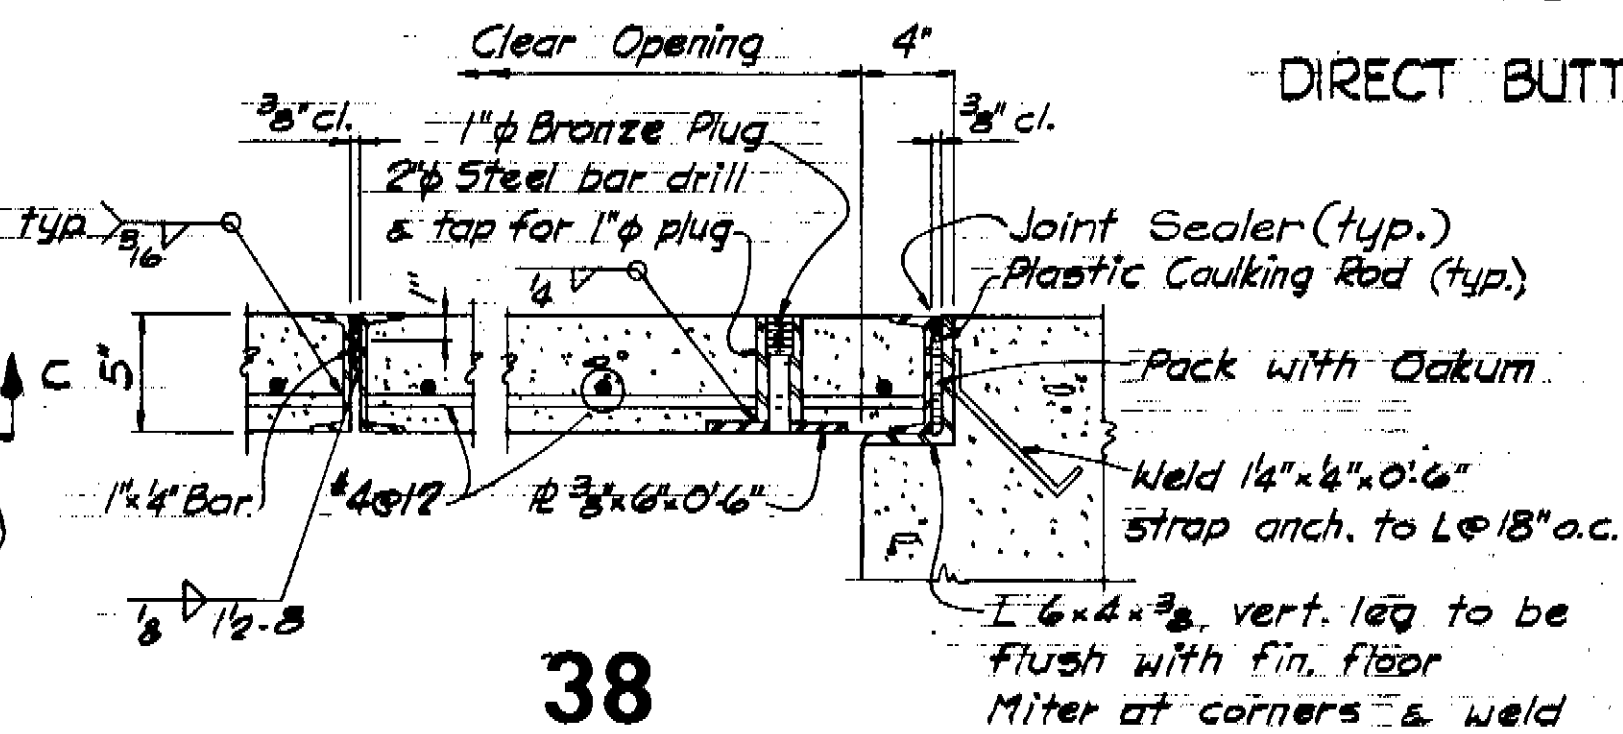


38

SECTION C-C

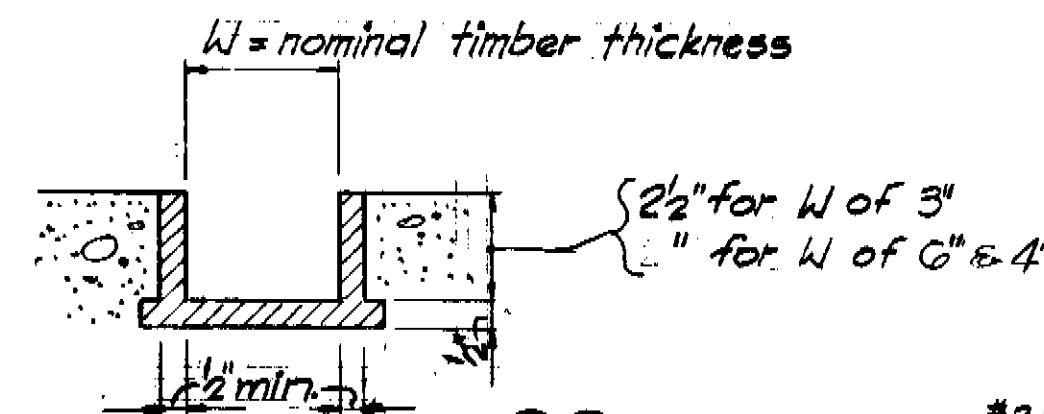

39

CAST IRON STOP LOG GROOVE DETAIL

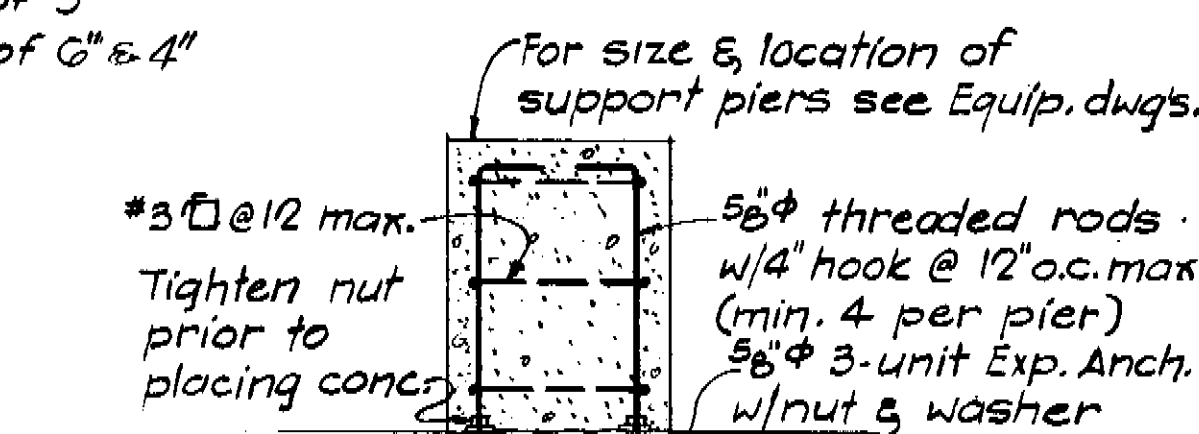


40

CONCRETE SUPPORT PIERS

Greeley and Hansen Engineers 222 S. Riverside Plaza Chicago, Illinois 60606	DESIGNED B.N.	APPROVED	SCALE NONE	CITY OF TAMPA, FLORIDA SEWAGE DISPOSAL SYSTEM DIVISION 4G3 131ST AVENUE PUMPING STATION	STRUCTURAL TYPICAL DETAILS	PROJ. NO. S202-70-30D-7-463
	DRAWN J.B.	SUPT., DEPT. OF SANITARY SEWERS DATE 10/91 Greeley and Hansen, Engineers				
CHECKED E.P.	Greeley and Hansen, Engineers	DATE				DATE AUGUST, 1972 REV. 0

173-9

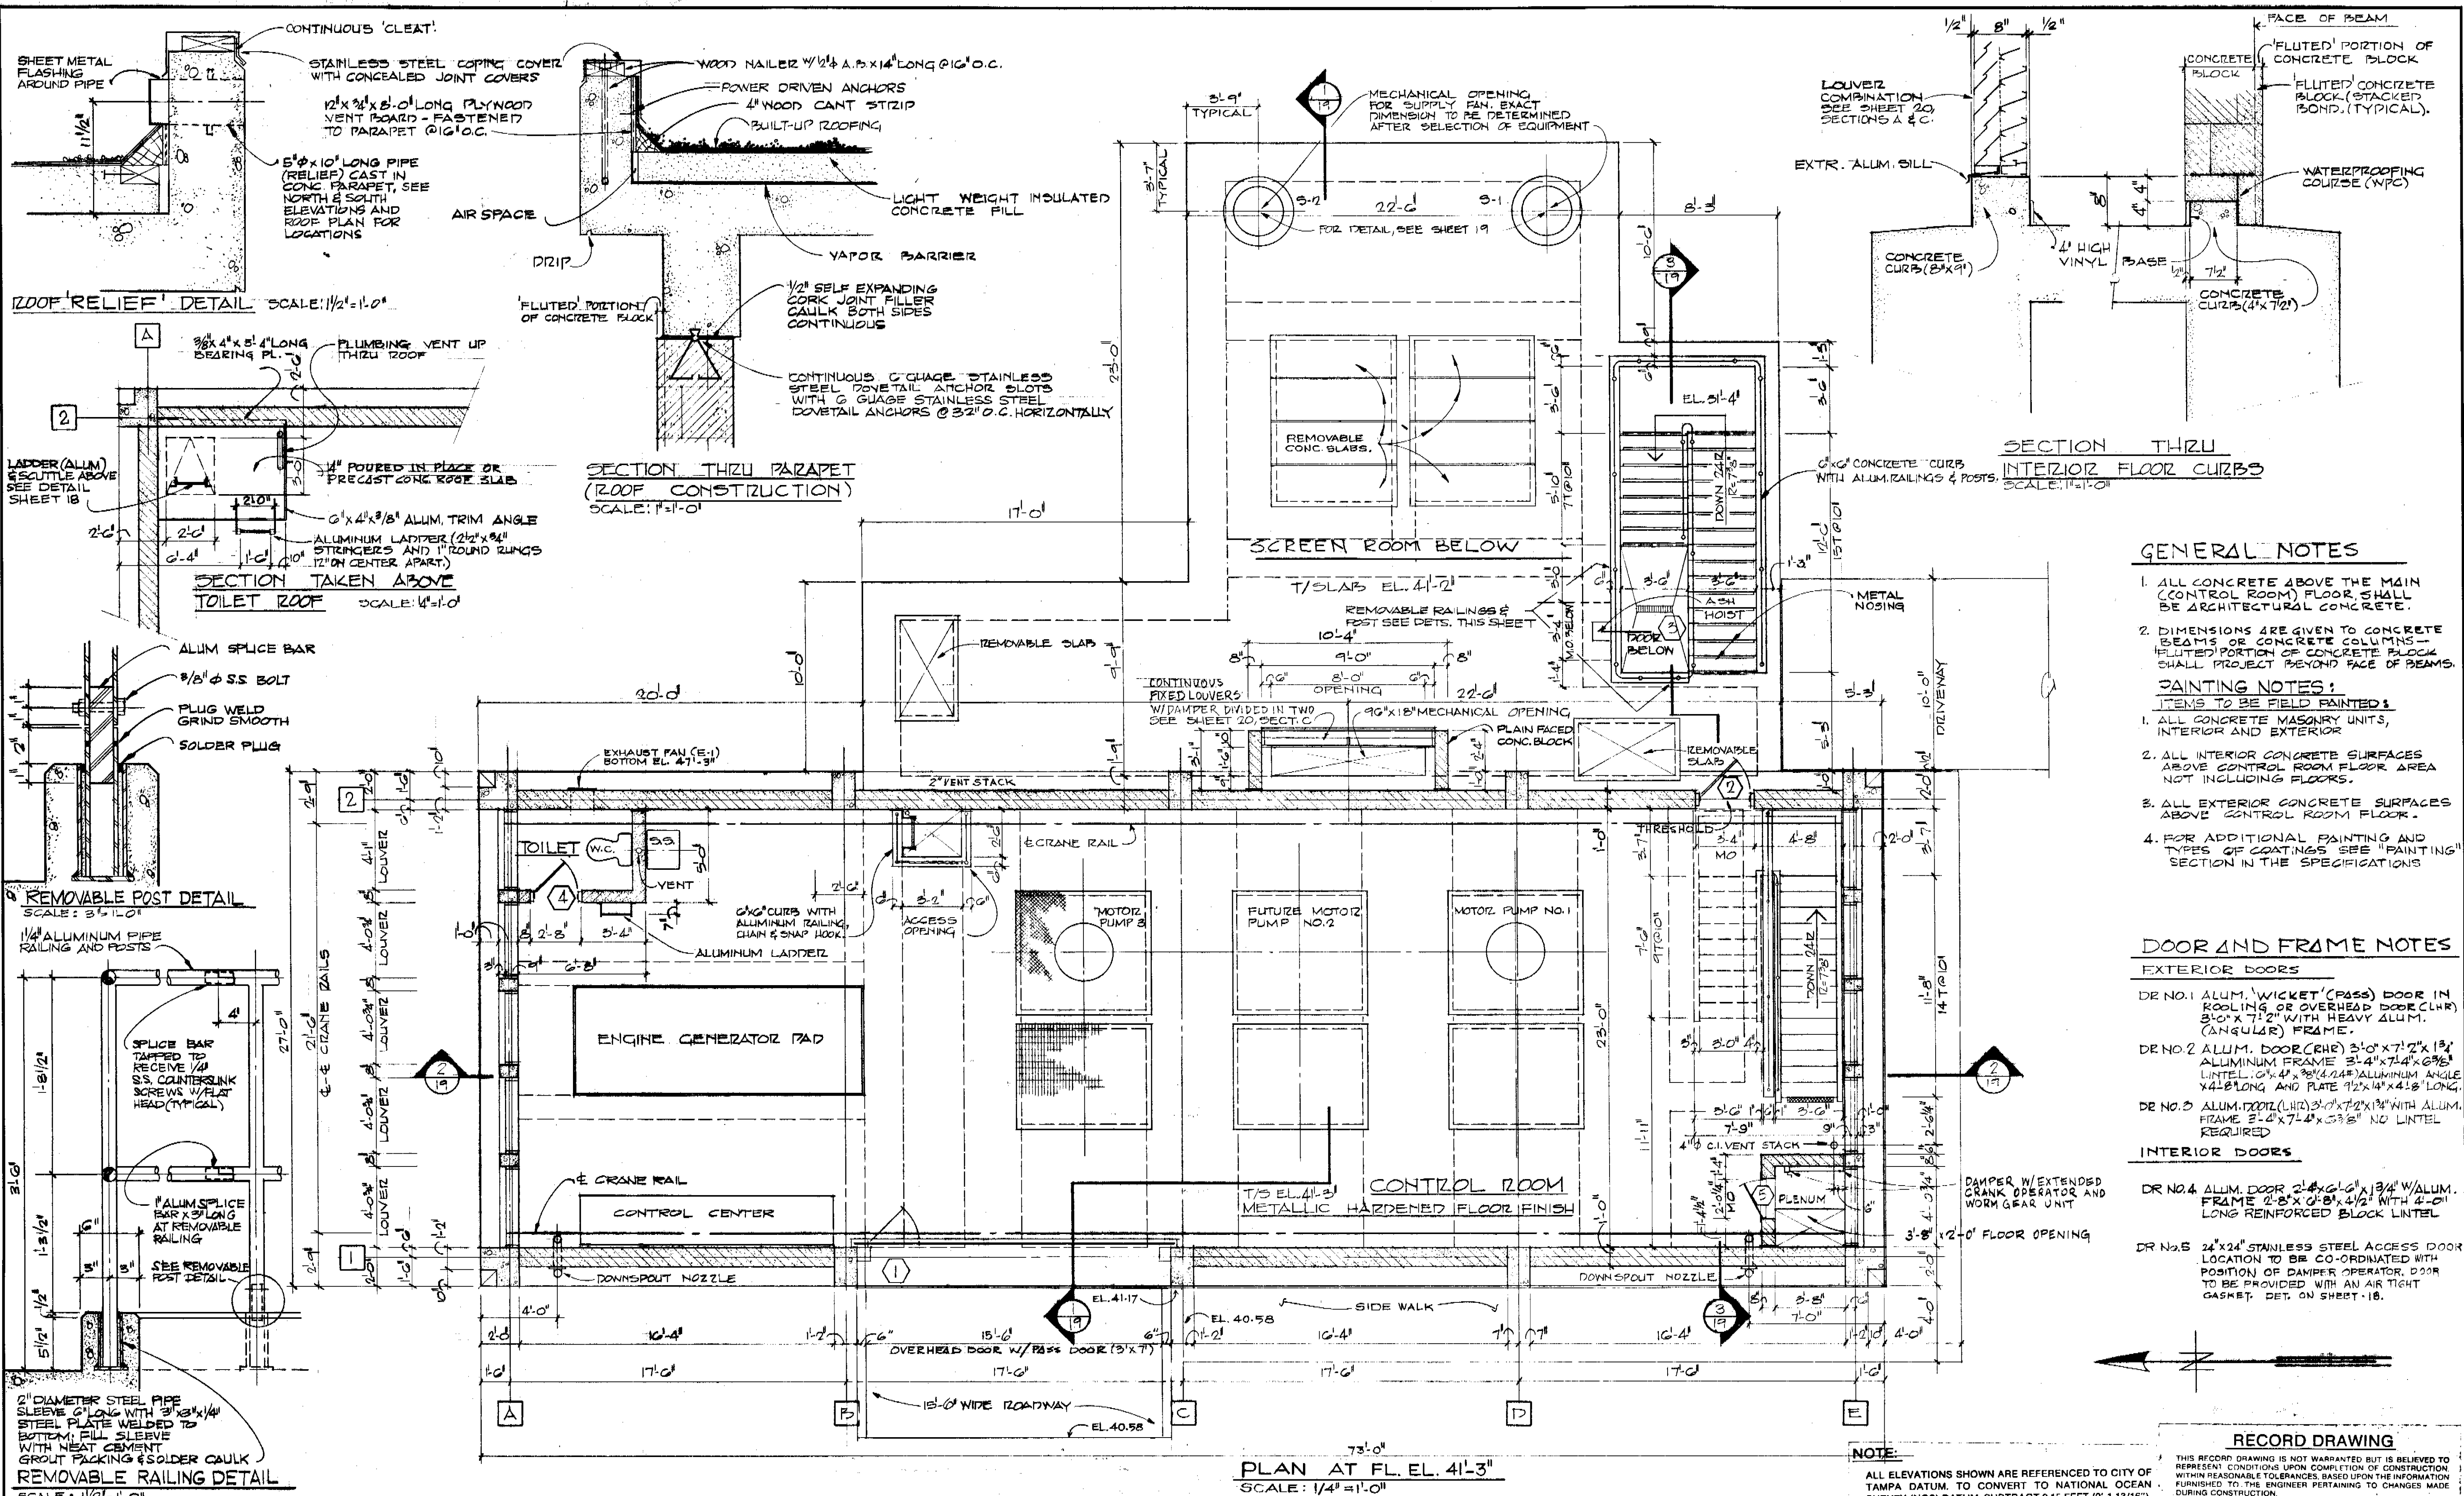

- GENERAL NOTES**
1. ALL CONCRETE ABOVE THE MAIN (CONTROL ROOM) FLOOR SHALL BE ARCHITECTURAL CONCRETE.
 2. DIMENSIONS ARE GIVEN TO CONCRETE BEAMS OR CONCRETE COLUMNS - FLUTED PORTION OF CONCRETE BLOCK SHALL PROJECT BEYOND FACE OF BEAMS.
- PAINTING NOTES:**
- ITEMS TO BE FIELD PAINTED:
1. ALL CONCRETE MASONRY UNITS, INTERIOR AND EXTERIOR
 2. ALL INTERIOR CONCRETE SURFACES ABOVE CONTROL ROOM FLOOR AREA NOT INCLUDING FLOORS.
 3. ALL EXTERIOR CONCRETE SURFACES ABOVE CONTROL ROOM FLOOR.
 4. FOR ADDITIONAL PAINTING AND TYPES OF COATINGS, SEE "PAINTING" SECTION IN THE SPECIFICATIONS

- DOOR AND FRAME NOTES**
- EXTERIOR DOORS**
- DR NO. 1 ALUM. WICKET (PASS) DOOR IN ROOFLING OR OVERHEAD DOOR (LHR) 3'0" x 7'0" WITH HEAVY ALUM. (ANGULAR) FRAME.
 - DR NO. 2 ALUM. DOOR (RHR) 3'0" x 7'0" x 1 1/2" ALUMINUM FRAME 3'4" x 7'4" x 1 1/2" LINTEL 6" x 4" x 3/4" ALUMINUM ANGLE 1/2" x 1/2" x 1/2" x 1/2" LONG.
 - DR NO. 3 ALUM. WOOD (LHR) 3'0" x 7'0" x 1 1/2" WITH ALUM. FRAME 3'0" x 7'0" x 1 1/2" NO LINTEL REQUIRED
- INTERIOR DOORS**
- DR NO. 4 ALUM. DOOR 2'0" x 6'0" x 1 1/2" W/ALUM. FRAME 2'0" x 6'0" x 1 1/2" WITH 2'-0" LONG REINFORCED BLOCK LINTEL
 - DR NO. 5 24" x 24" STAINLESS STEEL ACCESS DOOR LOCATION TO BE CO-ORDINATED WITH POSITION OF DAMPER OPERATOR. DOOR TO BE PROVIDED WITH AN AIR TIGHT GASKET. DET. ON SHEET 18.

RECORD DRAWING

THIS RECORD DRAWING IS NOT WARRANTED BUT IS BELIEVED TO REPRESENT CONDITIONS UPON COMPLETION OF CONSTRUCTION WITHIN REASONABLE TOLERANCES BASED UPON THE INFORMATION FURNISHED TO THE ENGINEER PERTAINING TO CHANGES MADE DURING CONSTRUCTION.

NOTE: ALL ELEVATIONS SHOWN ARE REFERENCED TO CITY OF TAMPA DATUM. TO CONVERT TO NATIONAL OCEAN SURVEY (NOS) DATUM, SUBTRACT 0.15 FEET (0'-1 1/16").

GREELEY AND HANSEN ENGINEERS
 222 S. RIVERSIDE PLAZA
 CHICAGO, ILLINOIS 60606

DESIGNED	JFK	APPROVED	
DRAWN	MRN	DATE	
CHECKED	JFK	SUPT., DEPT. OF SANITARY SEWERS	
		DATE	
		GREELEY AND HANSEN, ENGINEERS	


NO.	DATE	APP.	REVISION
2	10/81	DSH	Rec. Dwg. Revisions
1	Dec. 78	JEP	Added Addendum No. 1
	Mar. 78	JEP	Plans Updated

CITY OF TAMPA, FLORIDA
 SEWAGE DISPOSAL SYSTEM
 DIVISION 463
 131 ST. AVENUE PUMPING STATION

ARCHITECTURAL TOP FLOOR PLAN

PROJ. NO. S 202-70-30D-7-463
 SHEET 17 OF 35
 DATE AUGUST, 1972 REV. 1

178-54

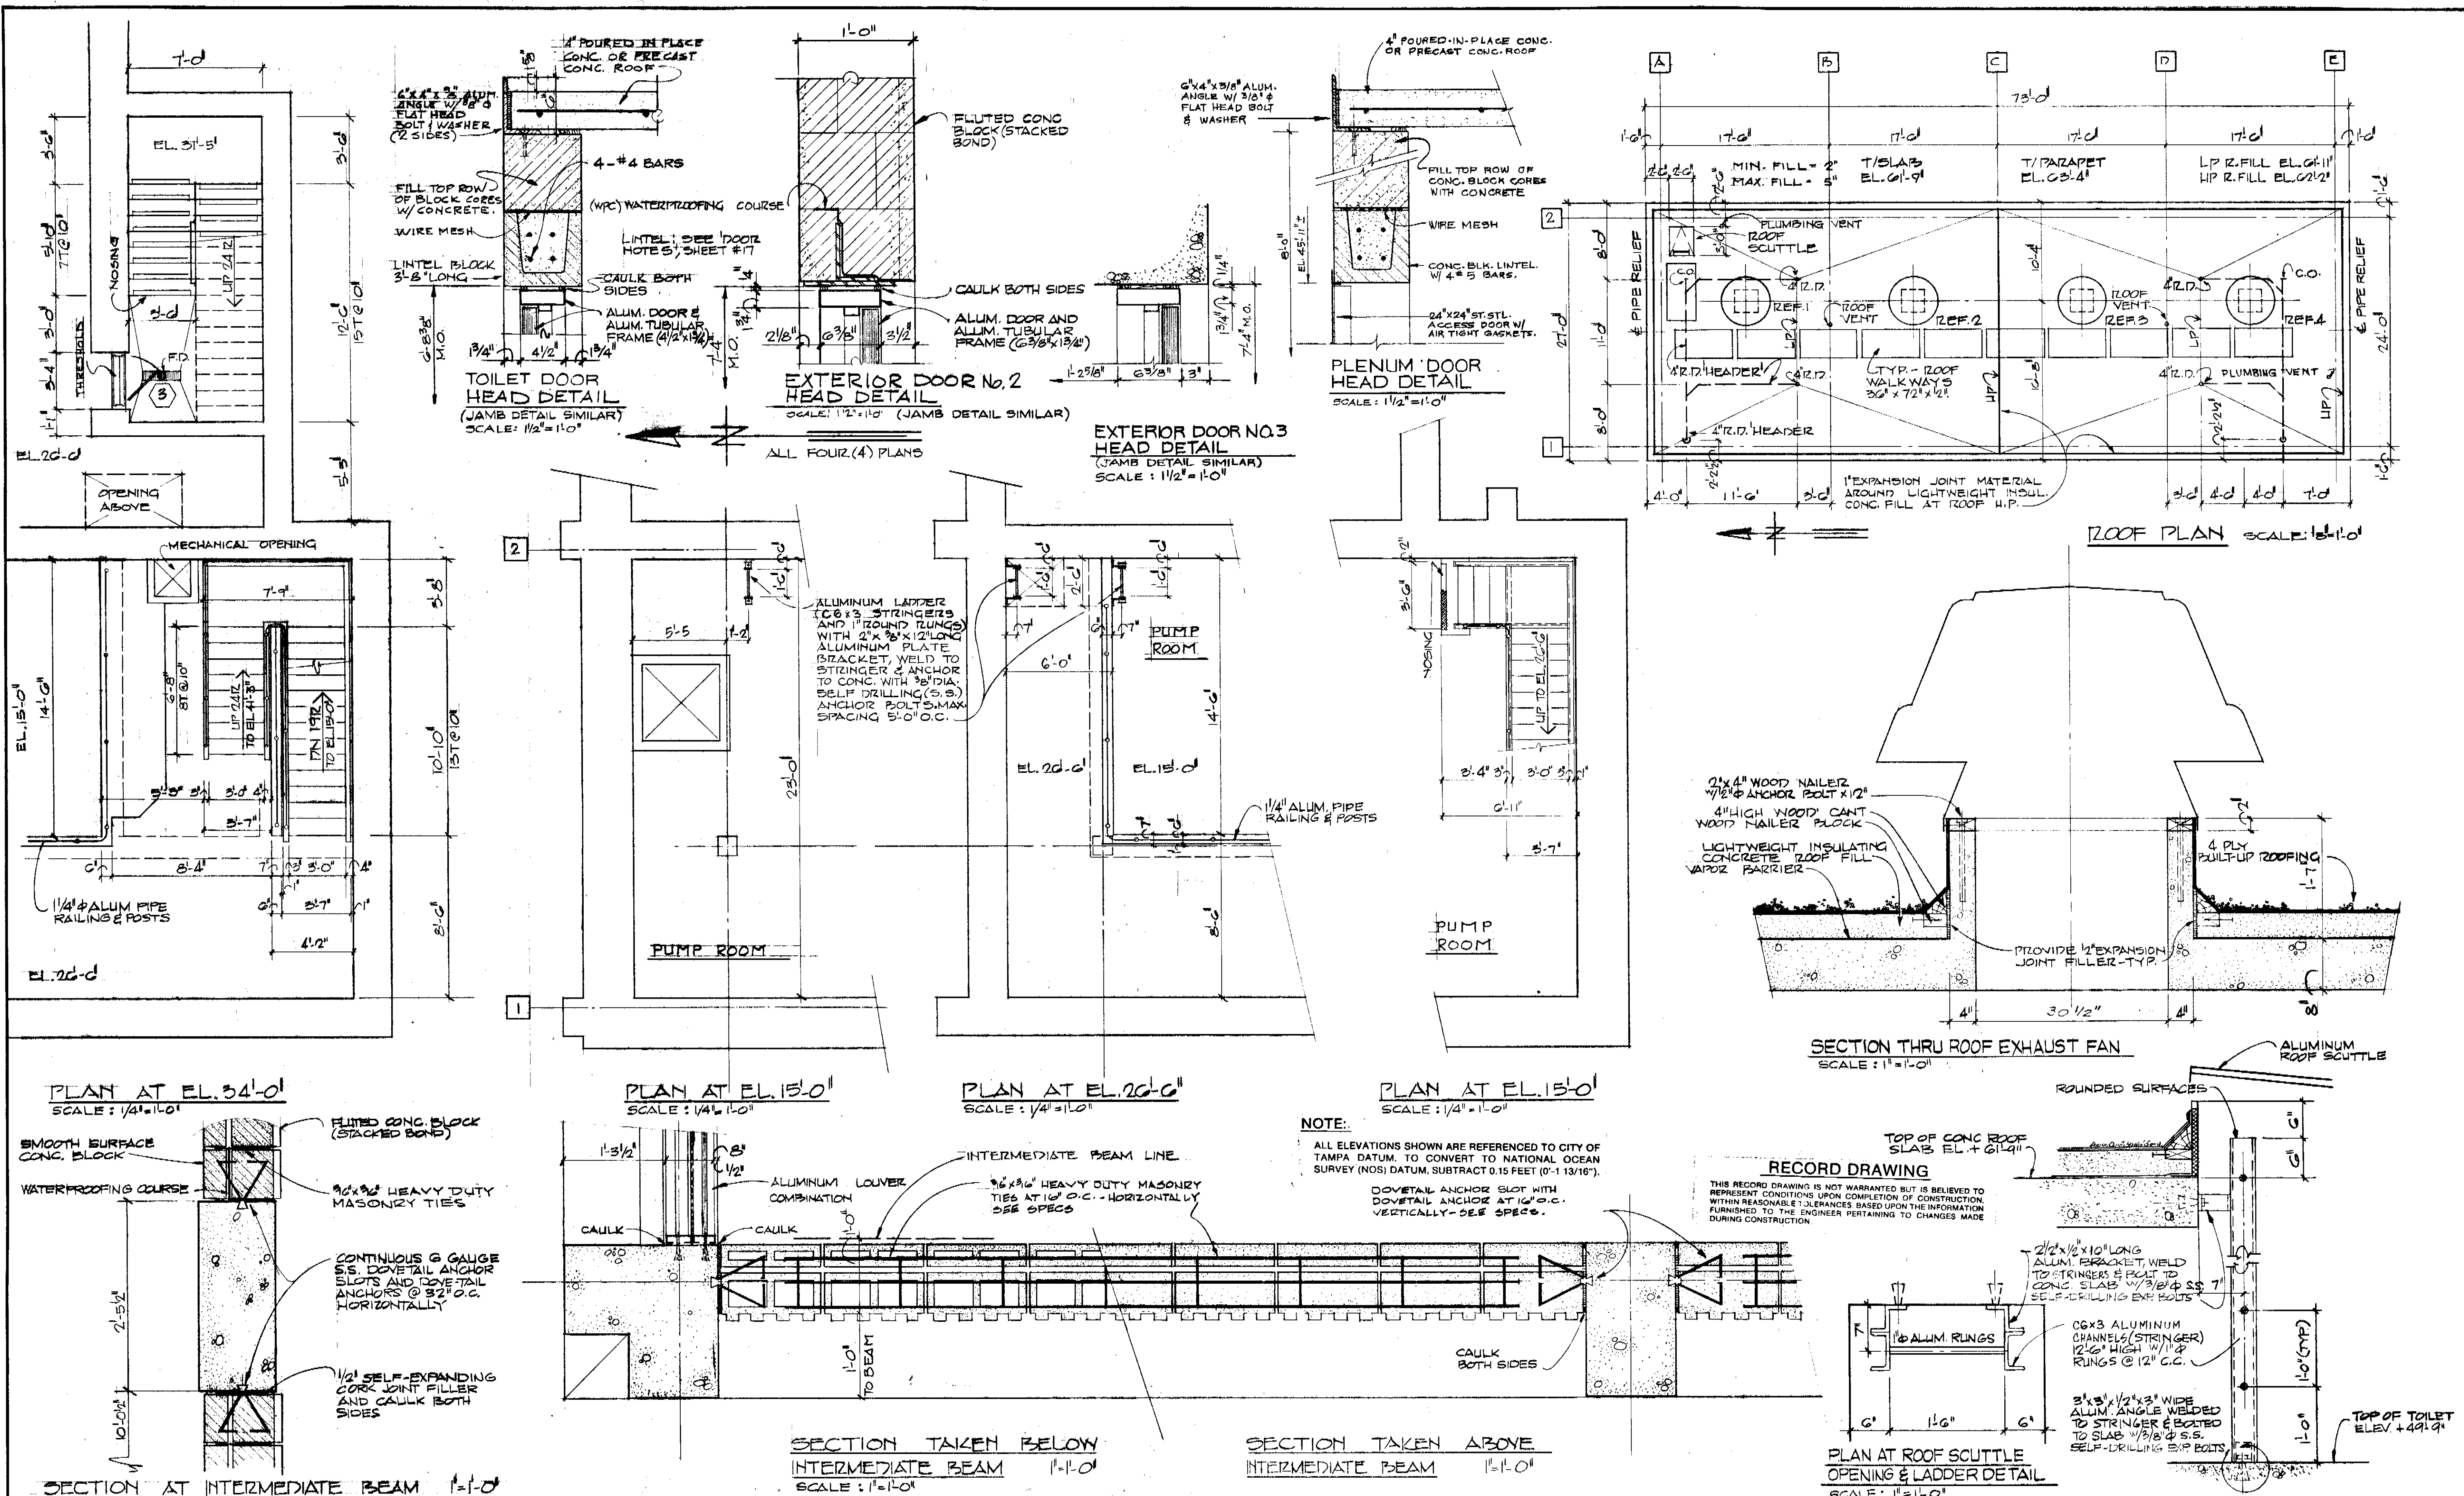


GREELEY AND HANSEN ENGINEERS
 222 S. RIVERSIDE PLAZA
 CHICAGO, ILLINOIS 60606

DESIGNED JFK
 DRAWN MRN
 CHECKED JFK

APPROVED _____
 Supt., Dept. of Sanitary Sewers
 DATE _____
 GREELEY AND HANSEN, ENGINEERS

NO.	DATE	APP.	REVISION
2	10/81	DSH	Rec Dwg. Revisions
1	Dec 78	YSL	Added Addendum No. 1
	Mar 78	JRP	Plans Updated



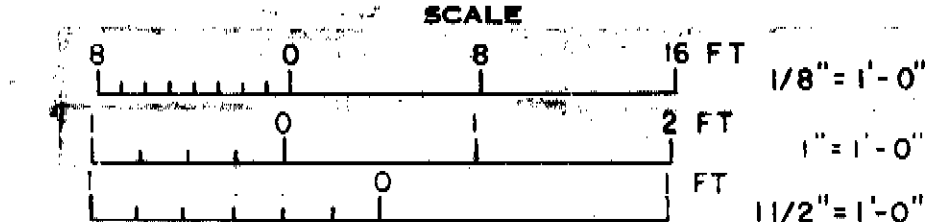


CITY OF TAMPA, FLORIDA
 SEWAGE DISPOSAL SYSTEM
 DIVISION 463
 131 ST. AVENUE PUMPING STATION

ARCHITECTURAL ROOF PLAN DETAILS

PROJ. NO. S 202-70-30D-7-463
 SHEET 18 OF 35
 DATE AUGUST, 1972 REV. 1

173-55

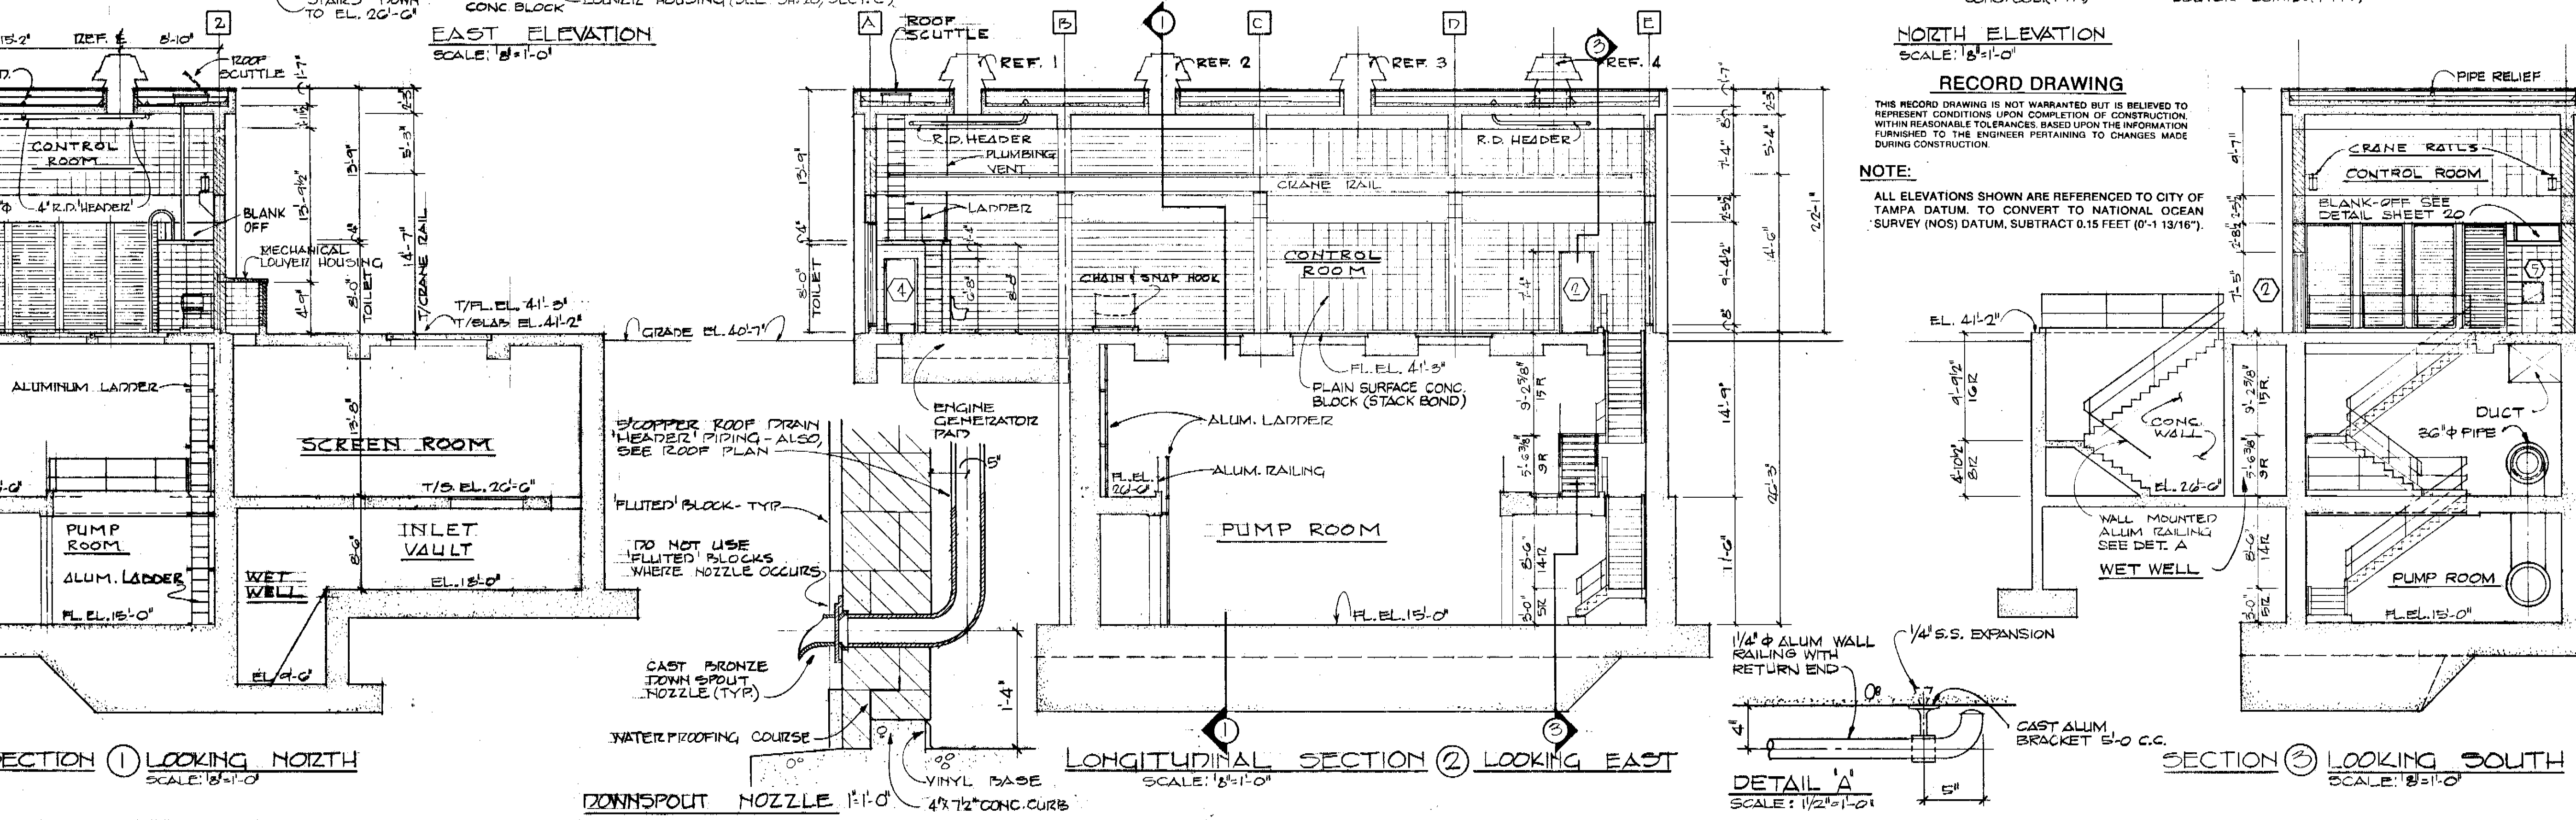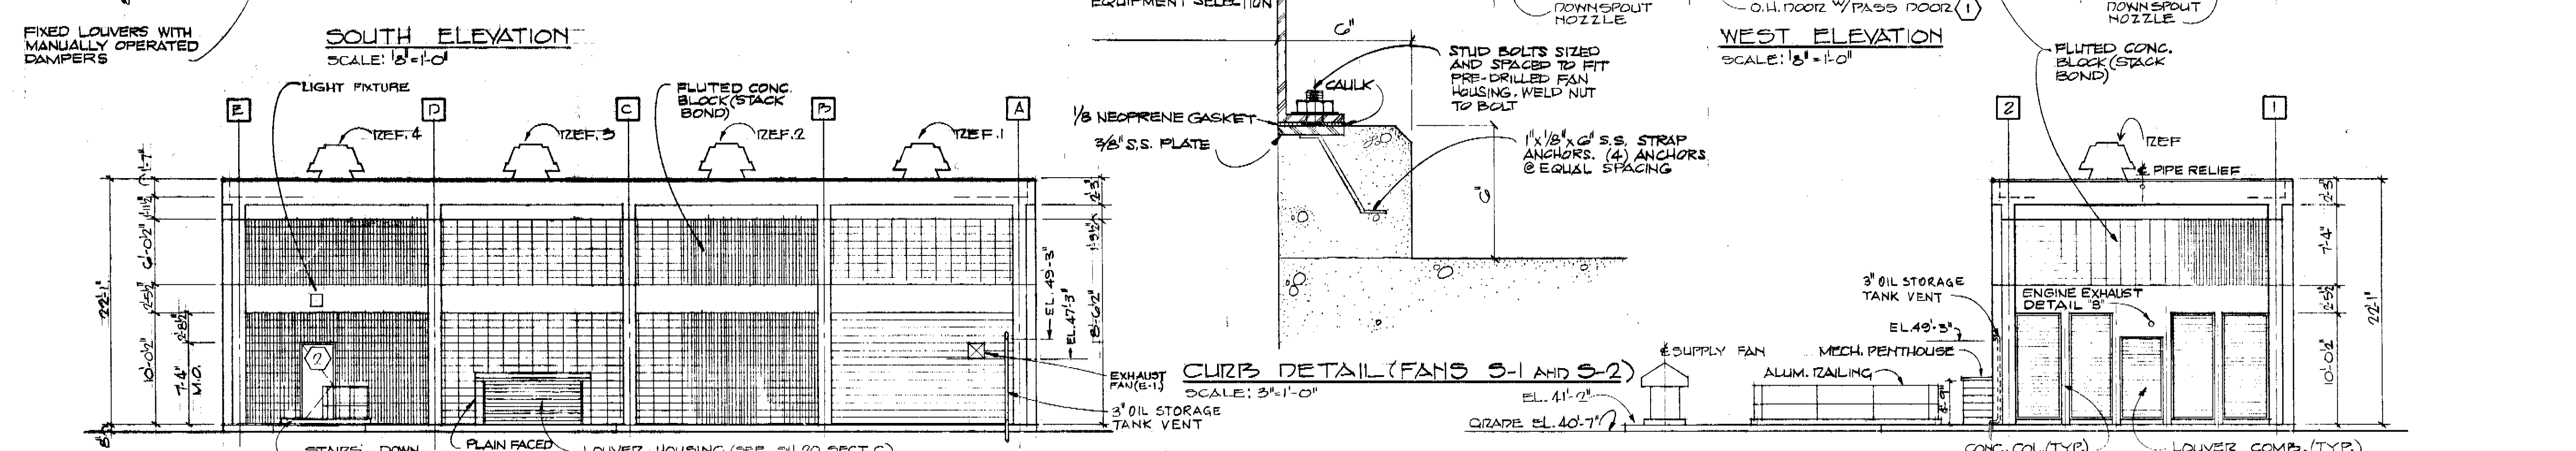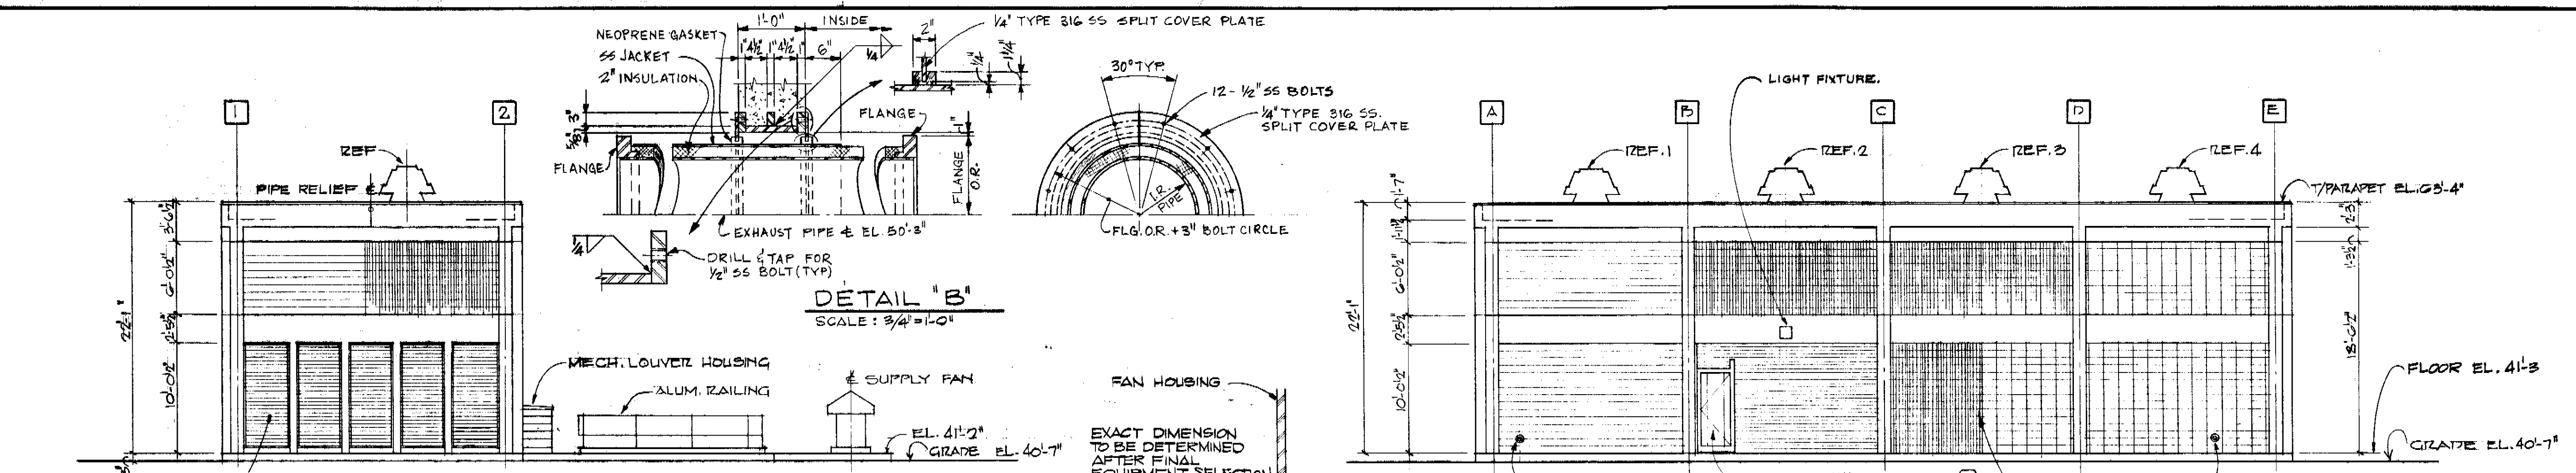


RECORD DRAWING
 THIS RECORD DRAWING IS NOT WARRANTED BUT IS BELIEVED TO REPRESENT CONDITIONS UPON COMPLETION OF CONSTRUCTION WITHIN REASONABLE TOLERANCES, BASED UPON THE INFORMATION FURNISHED TO THE ENGINEER PERTAINING TO CHANGES MADE DURING CONSTRUCTION.


NOTE:
 ALL ELEVATIONS SHOWN ARE REFERENCED TO CITY OF TAMPA DATUM. TO CONVERT TO NATIONAL OCEAN SURVEY (NOS) DATUM, SUBTRACT 0.15 FEET (0'-1 13/16").

GREELEY AND HANSEN ENGINEERS 222 S. RIVERSIDE PLAZA CHICAGO, ILLINOIS 60606	DESIGNED JFK DRAWN MRN CHECKED JFK	APPROVED _____ DATE _____ SUPT., DEPT. OF SANITARY SEWERS DATE _____ GREELEY AND HANSEN, ENGINEERS	<table border="1"> <tr> <th>NO.</th> <th>DATE</th> <th>APP.</th> <th>REVISION</th> </tr> <tr> <td>2</td> <td>10/81</td> <td>DJH</td> <td>Rec. Dwg. Revisions</td> </tr> <tr> <td>1</td> <td>Dec. 78</td> <td>YEL</td> <td>Added Addendum No. 1</td> </tr> <tr> <td></td> <td>Mar. 78</td> <td>JRP</td> <td>Plans Updated</td> </tr> </table>	NO.	DATE	APP.	REVISION	2	10/81	DJH	Rec. Dwg. Revisions	1	Dec. 78	YEL	Added Addendum No. 1		Mar. 78	JRP	Plans Updated	SCALE 1/8" = 1'-0"	CITY OF TAMPA, FLORIDA SEWAGE DISPOSAL SYSTEM DIVISION 463 131 ST. AVENUE PUMPING STATION	ARCHITECTURAL ELEVATIONS AND DETAILS	PROJ. NO. S 202-70-30D-7-463 SHEET 19 OF 35 DATE AUGUST, 1972 REV. I
	NO.	DATE	APP.	REVISION																			
2	10/81	DJH	Rec. Dwg. Revisions																				
1	Dec. 78	YEL	Added Addendum No. 1																				
	Mar. 78	JRP	Plans Updated																				
173-56																							


SECTION ABOVE CRANE
RAIL THRU ROOF DRAIN
SCALE: 1/2"=1'-0"

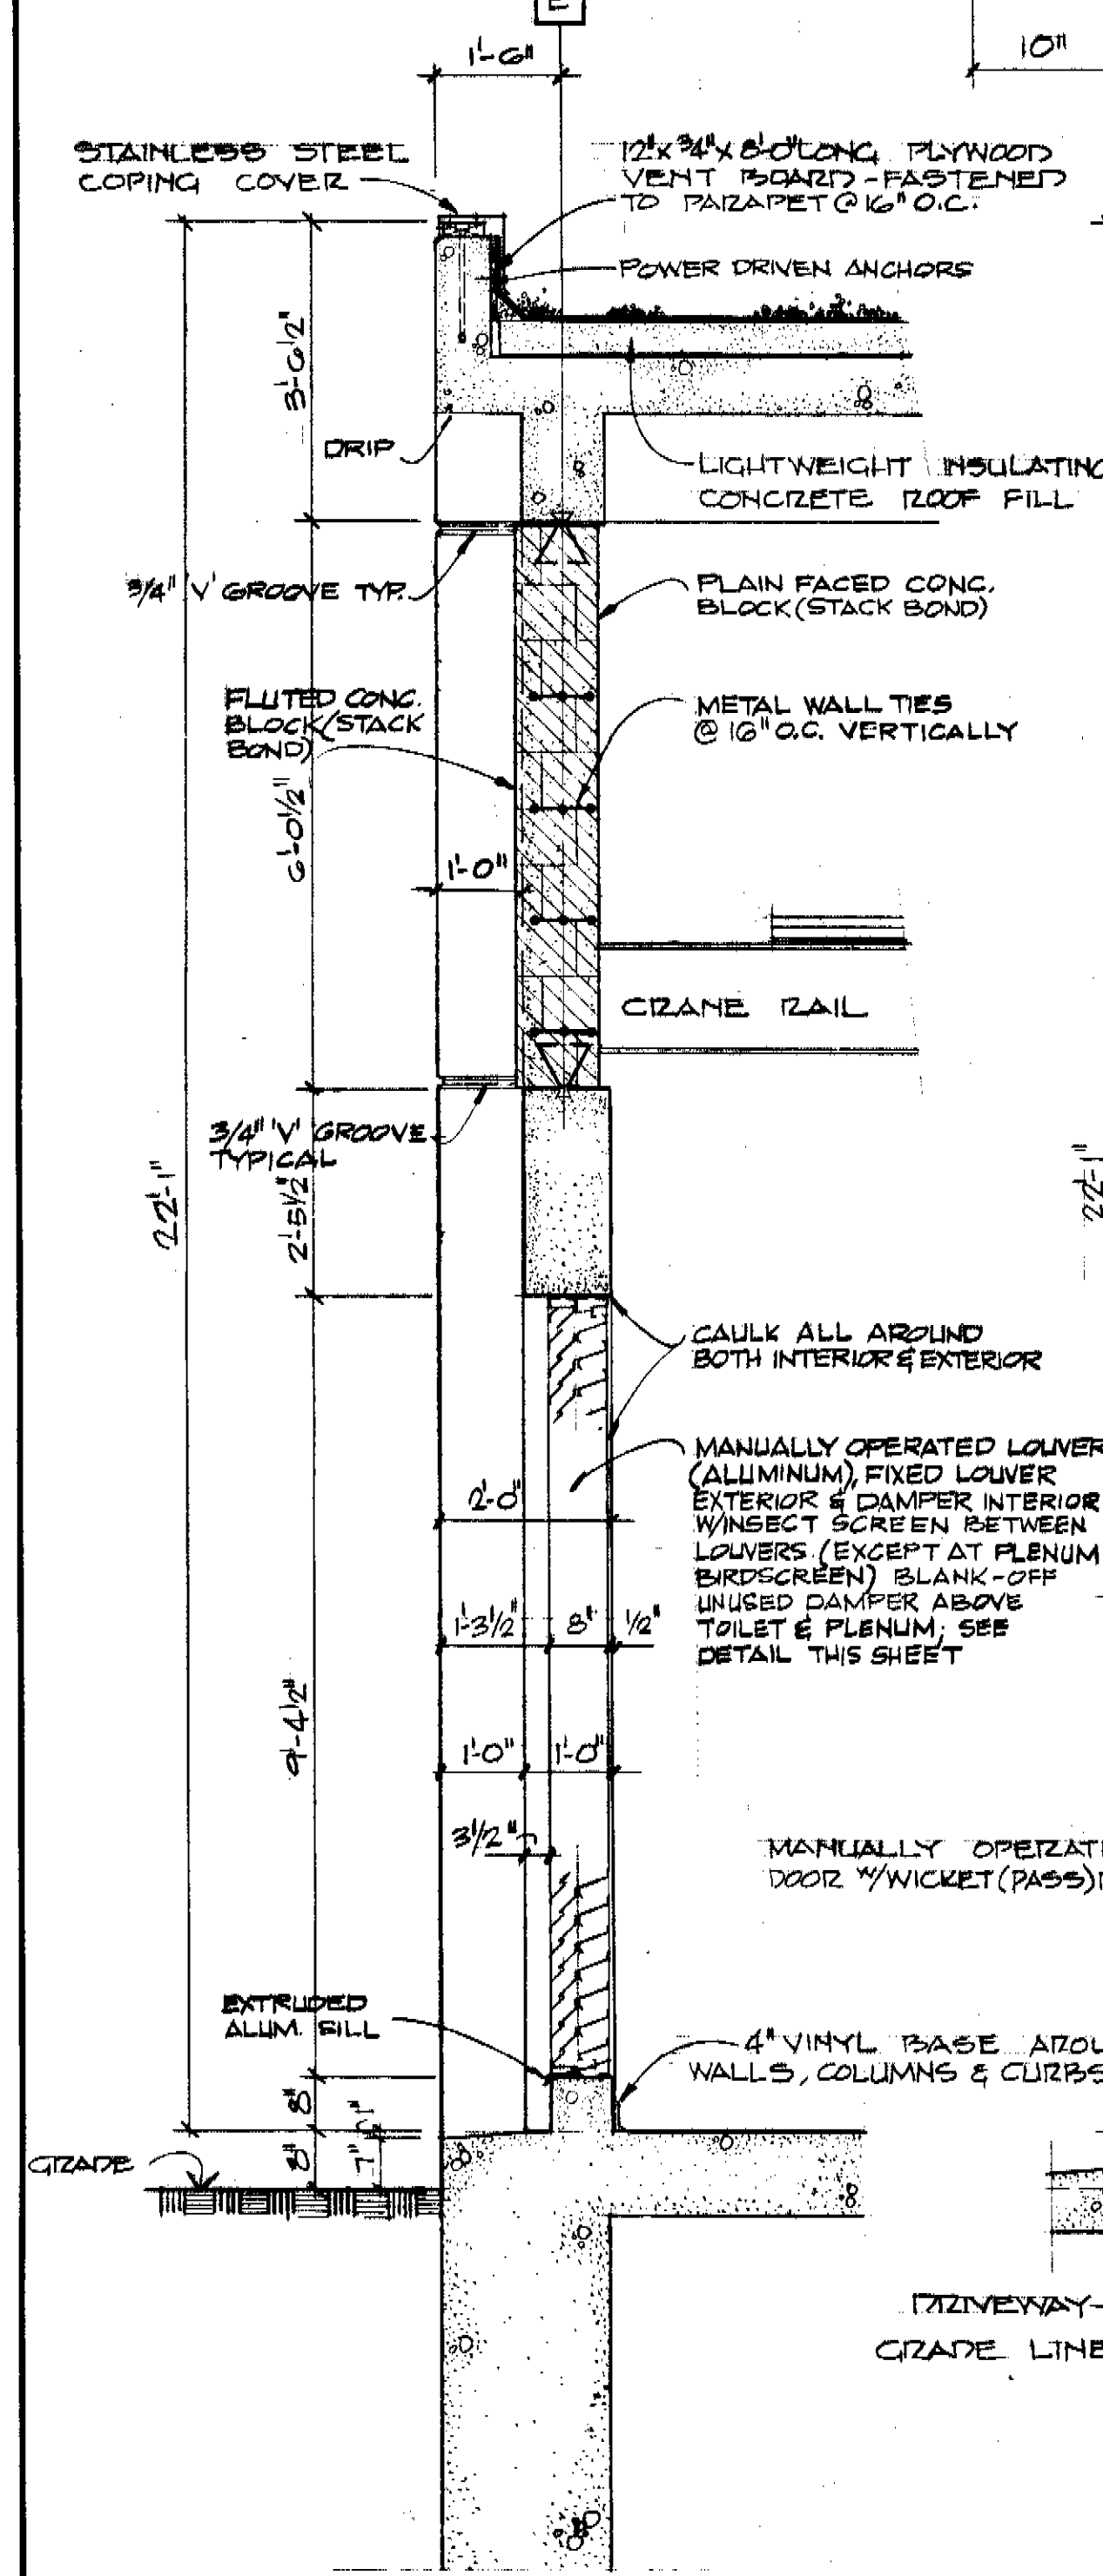


SECTION THRU LOUVERS
SCALE: 1'-1'-0"

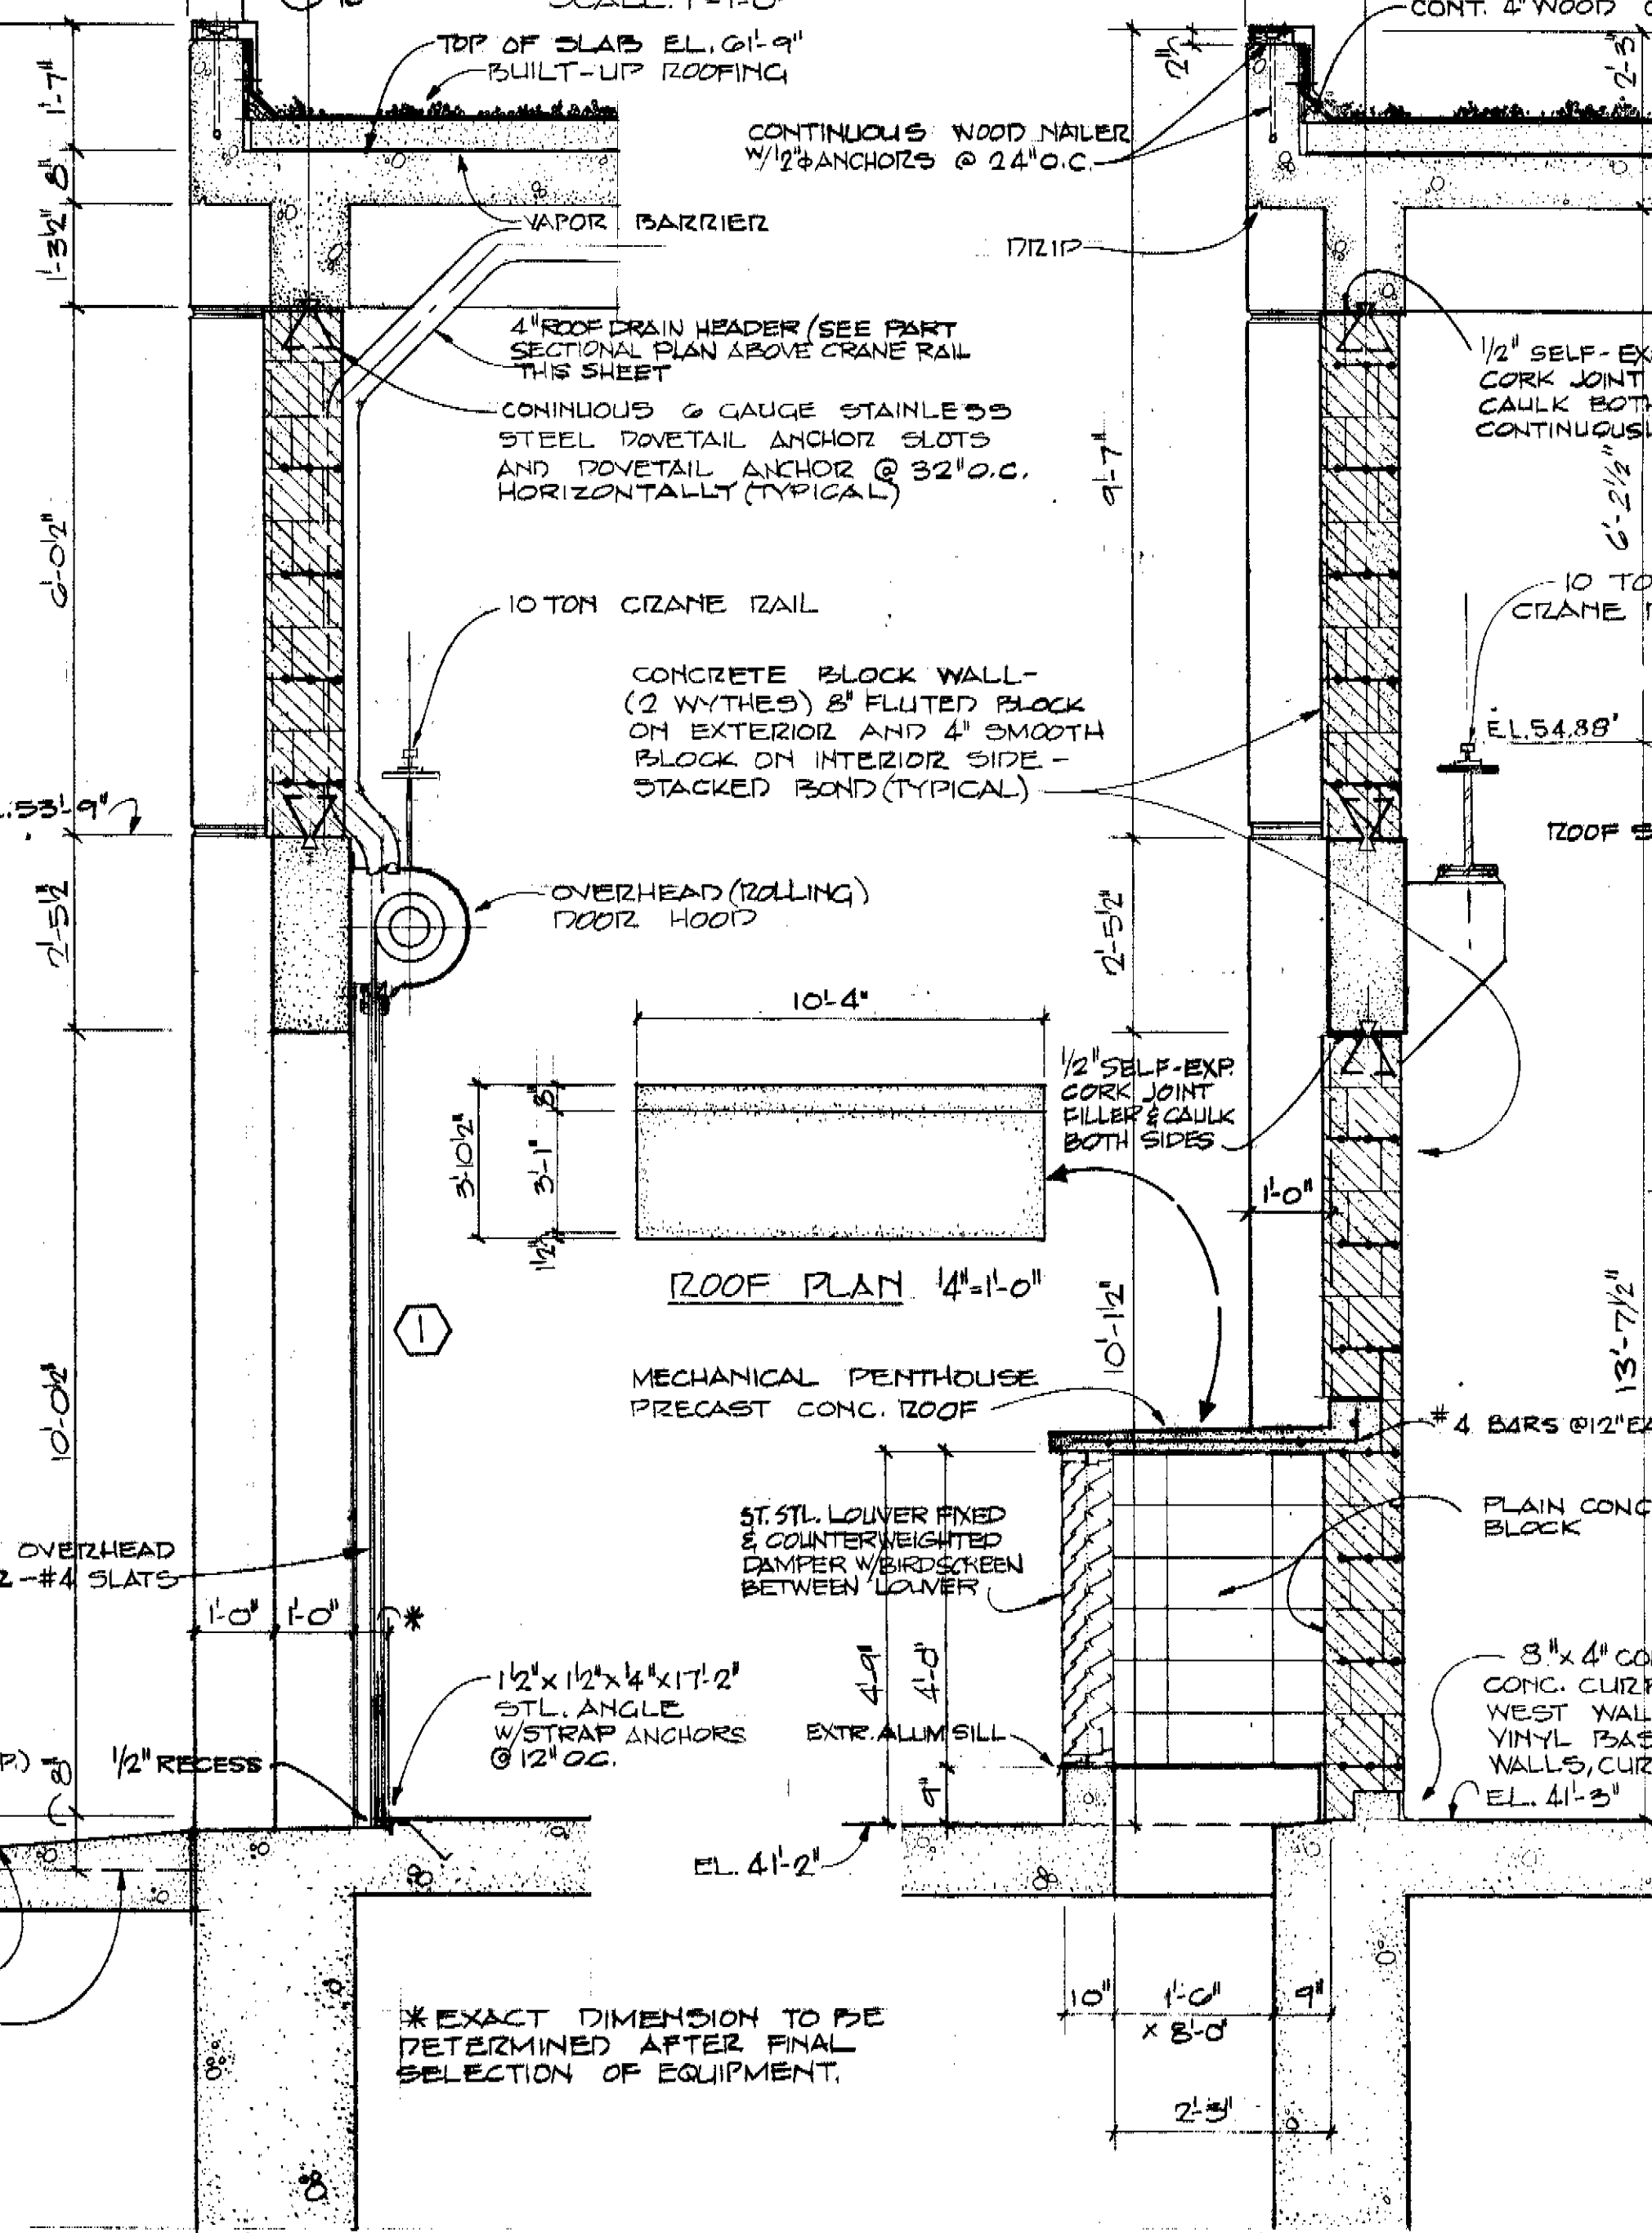


PIPE RAILING AND SLEEVE DETAIL
SCALE: 1'-1'-0"

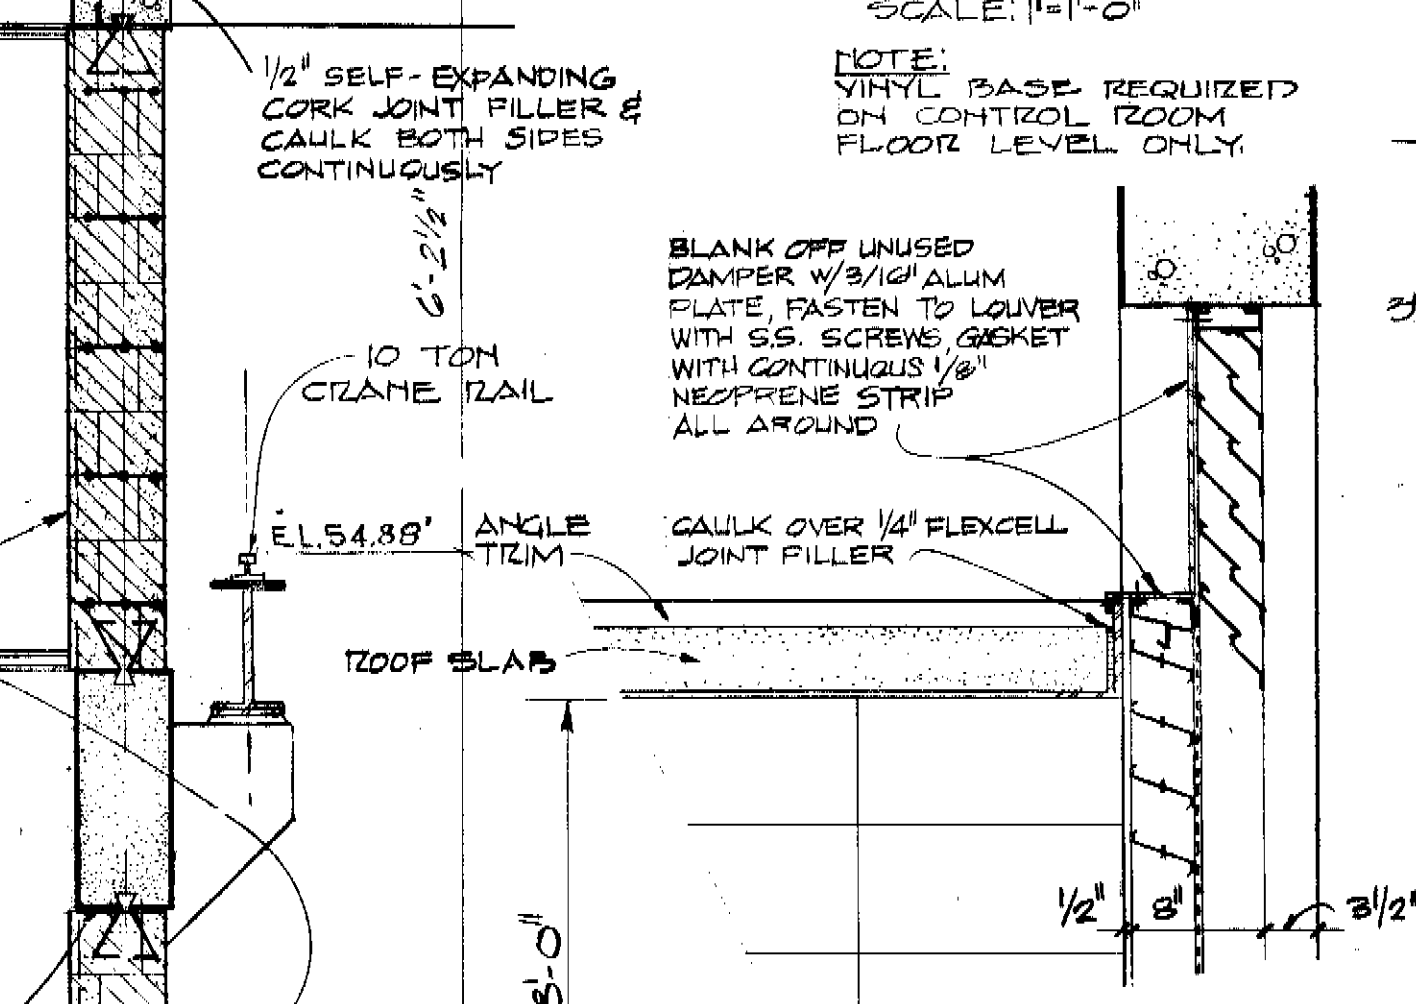

SECTION THRU ACCESS OPENING
SCALE: 1'-1'-0"

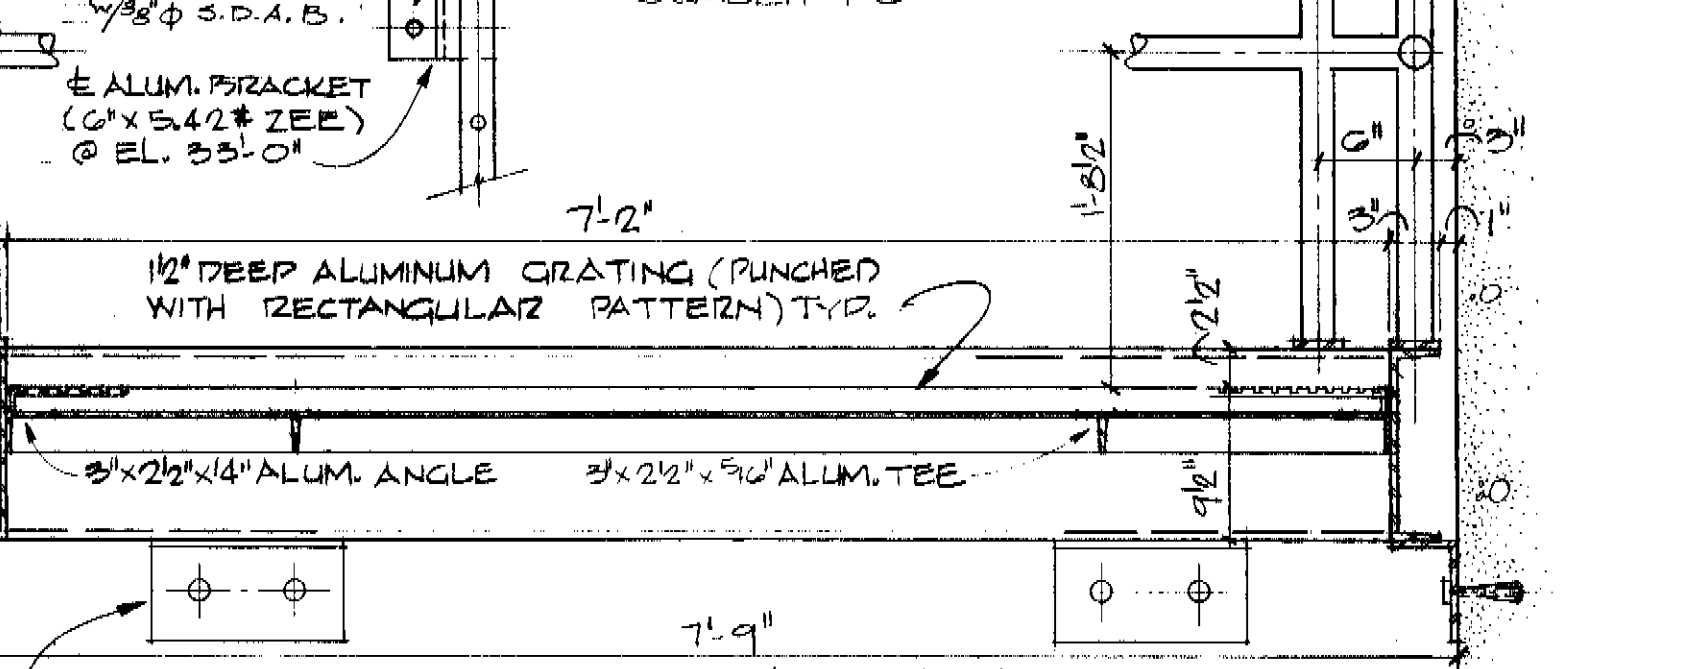

SECTION THRU PLATFORM
SCALE: 1'-1'-0"

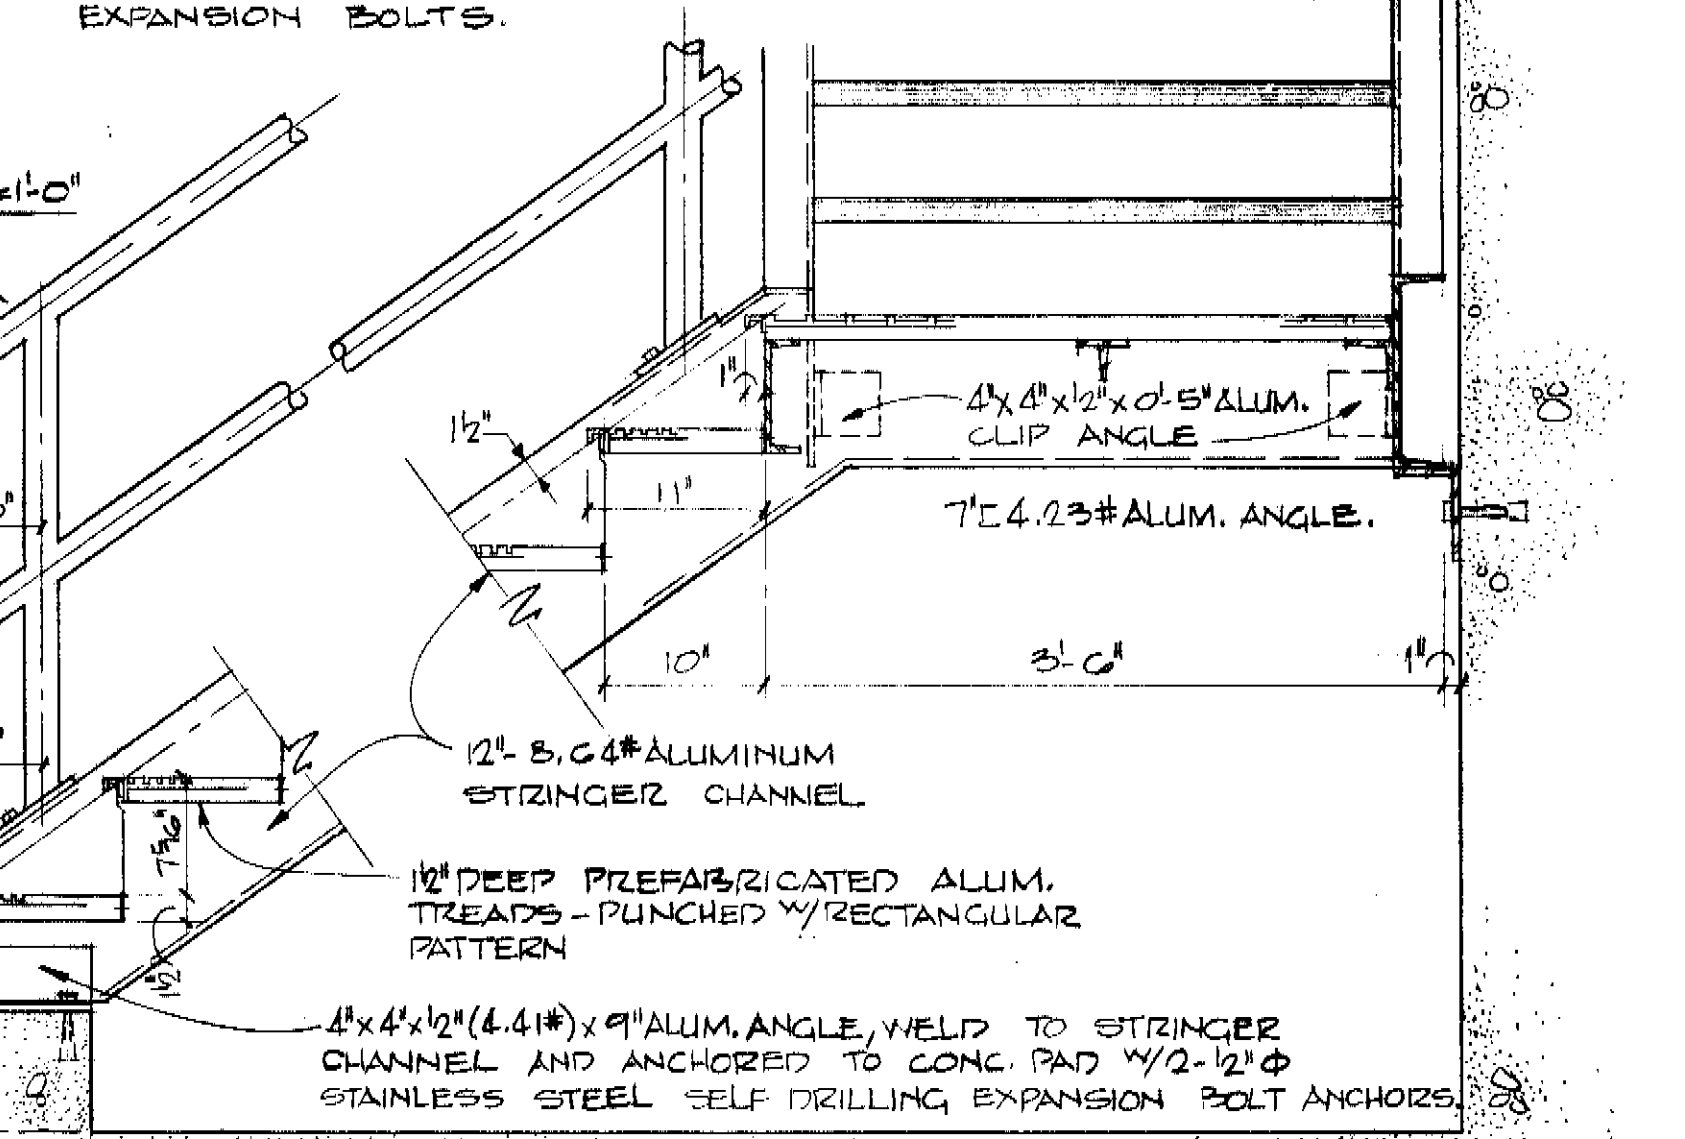

SECTION A THRU NORTH WALL
(SOUTH WALL SIMILAR)
SCALE: 1/2"=1'-0"

SECTION B THRU WEST WALL
(TAKEN AT OVERHEAD DOOR)
SCALE: 1/2"=1'-0"

SECTION C THRU EAST WALL
AT MECH. PENTHOUSE
SCALE: 1/2"=1'-0"

SECTION THRU STAIRS
SCALE: 1'-1'-0"

RECORD DRAWING
THIS RECORD DRAWING IS NOT WARRANTED BUT IS BELIEVED TO REPRESENT CONDITIONS UPON COMPLETION OF CONSTRUCTION, WITHIN REASONABLE TOLERANCES, BASED UPON THE INFORMATION FURNISHED TO THE ENGINEER PERTAINING TO CHANGES MADE DURING CONSTRUCTION.
NOTE:
ALL ELEVATIONS SHOWN ARE REFERENCED TO CITY OF TAMPA DATUM. TO CONVERT TO NATIONAL OCEAN SURVEY (NOS) DATUM, SUBTRACT 0.15 FEET (0'-1 13/16").


STAIR DETAILS

GREELEY AND HANSEN
ENGINEERS
222 S. RIVERSIDE PLAZA
CHICAGO, ILLINOIS 60606

DESIGNED JFK
DRAWN MRN
CHECKED JFK

APPROVED _____
DATE _____
Supt., Dept. of Sanitary Sewers
DATE _____
GREELEY AND HANSEN, ENGINEERS

NO.	DATE	APP.	REVISION
2	10/81	DSH	Rec. Dwg. Revisions
1	Dec. 78	KE	Added Addendum No. 1
	Mar. 78	JRP	Plans Updated


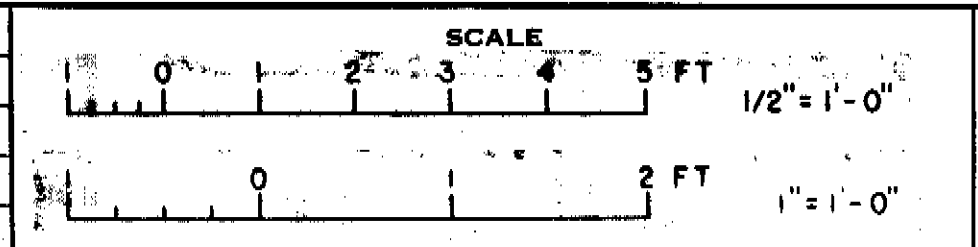


CITY OF TAMPA, FLORIDA
SEWAGE DISPOSAL SYSTEM
DIVISION 463
131 ST. AVENUE PUMPING STATION

ARCHITECTURAL
DETAILS

PROJ. NO. S 202-70-30D-7-463
SHEET 20 OF 35
DATE AUGUST, 1972 REV. 1

173-57

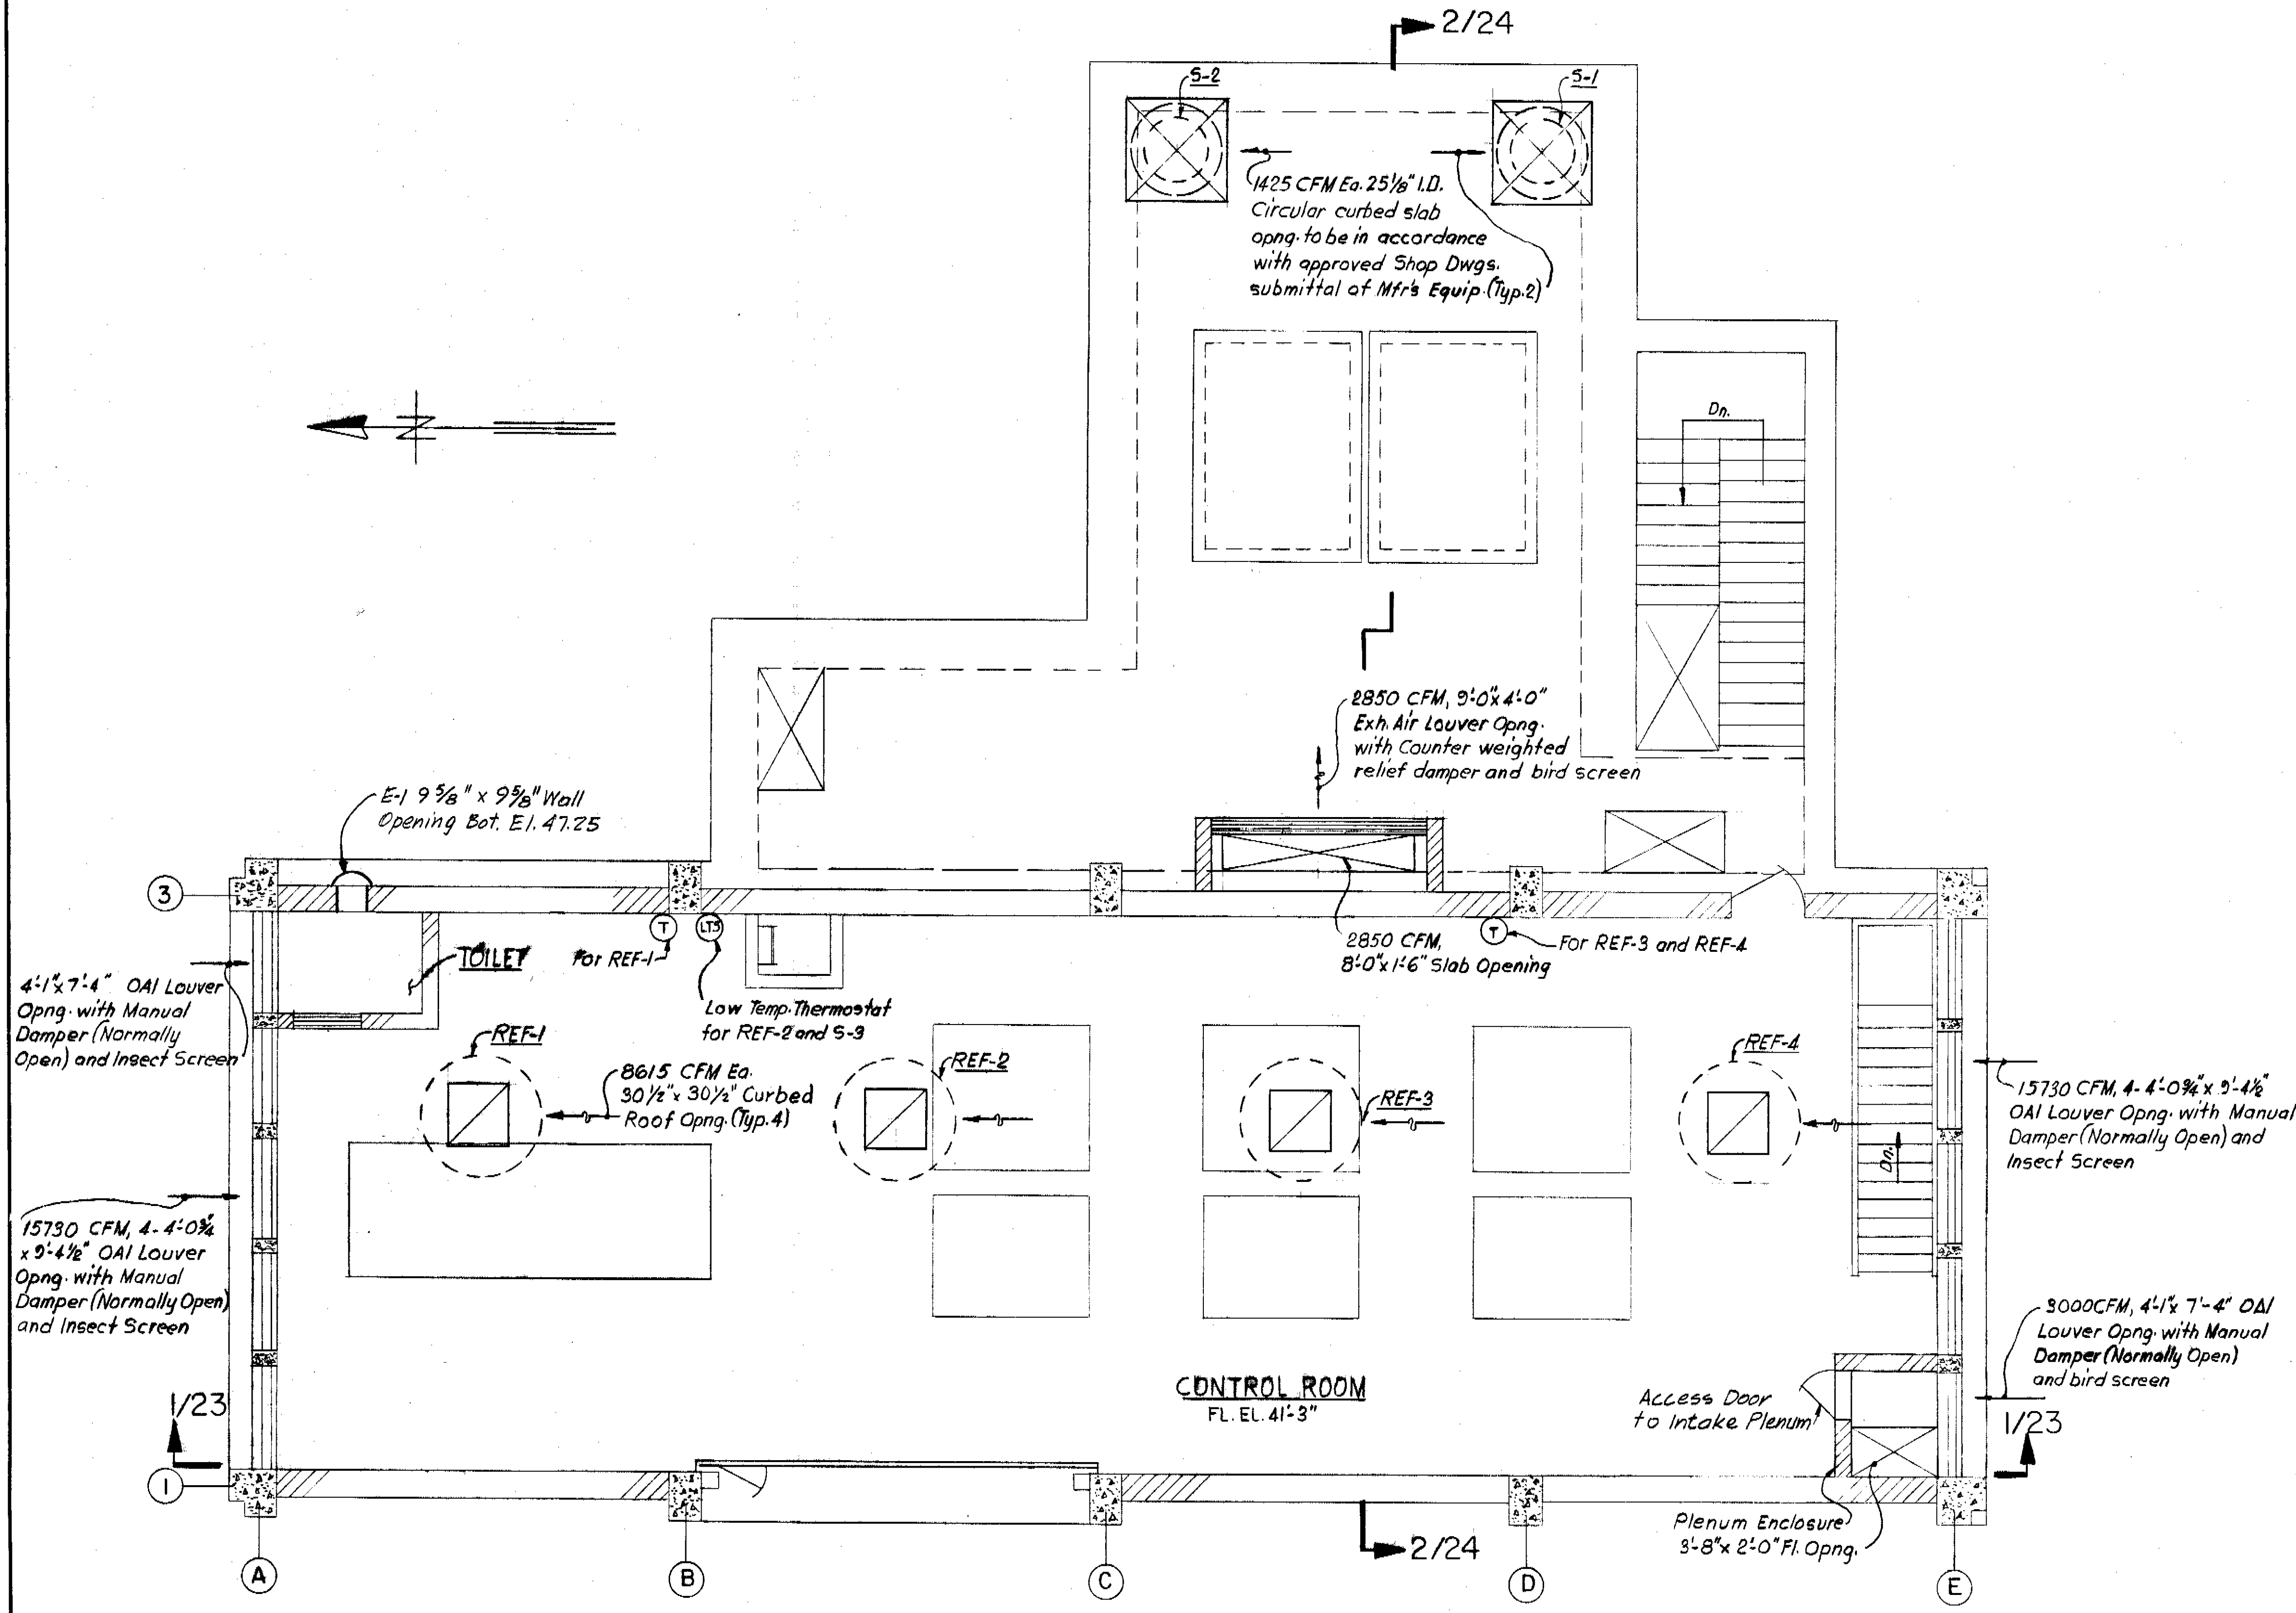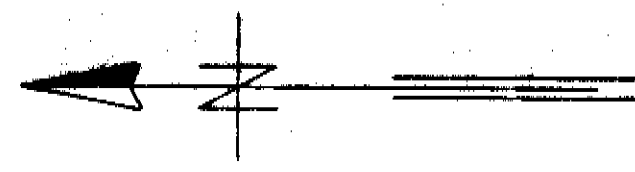

TOP FLOOR PLAN-FL. EL. 41'-3"
SCALE: 1/4"=1'-0"

NOTE:

ALL ELEVATIONS SHOWN ARE REFERENCED TO CITY OF TAMPA DATUM. TO CONVERT TO NATIONAL OCEAN SURVEY (NOS) DATUM, SUBTRACT 0.15 FEET (0'-1 13/16").

RECORD DRAWING

THIS RECORD DRAWING IS NOT WARRANTED BUT IS BELIEVED TO REPRESENT CONDITIONS UPON COMPLETION OF CONSTRUCTION, WITHIN REASONABLE TOLERANCES, BASED UPON THE INFORMATION FURNISHED TO THE ENGINEER PERTAINING TO CHANGES MADE DURING CONSTRUCTION.

GREELEY AND HANSEN
ENGINEERS
222 S. RIVERSIDE PLAZA
CHICAGO, ILLINOIS 60606

DESIGNED FSS, RV
DRAWN DUG
CHECKED FSS

APPROVED _____ DATE _____
Supt., Dept. of Sanitary Sewers
Greeley and Hansen Engineers


NO.	DATE	APP.	REVISION
1	10/81	ISH	Rec. Dwg. Revisions
	Mar. 78	JRP	Plans Updated



CITY OF TAMPA, FLORIDA
SEWAGE DISPOSAL SYSTEM
DIVISION 4G3
131 ST. AVENUE PUMPING STATION

VENTILATING
TOP FLOOR PLAN

PROJ. NO. S202-70-30D-7-4G3
SHEET 21 OF 35
DATE AUGUST, 1972 REV. 0

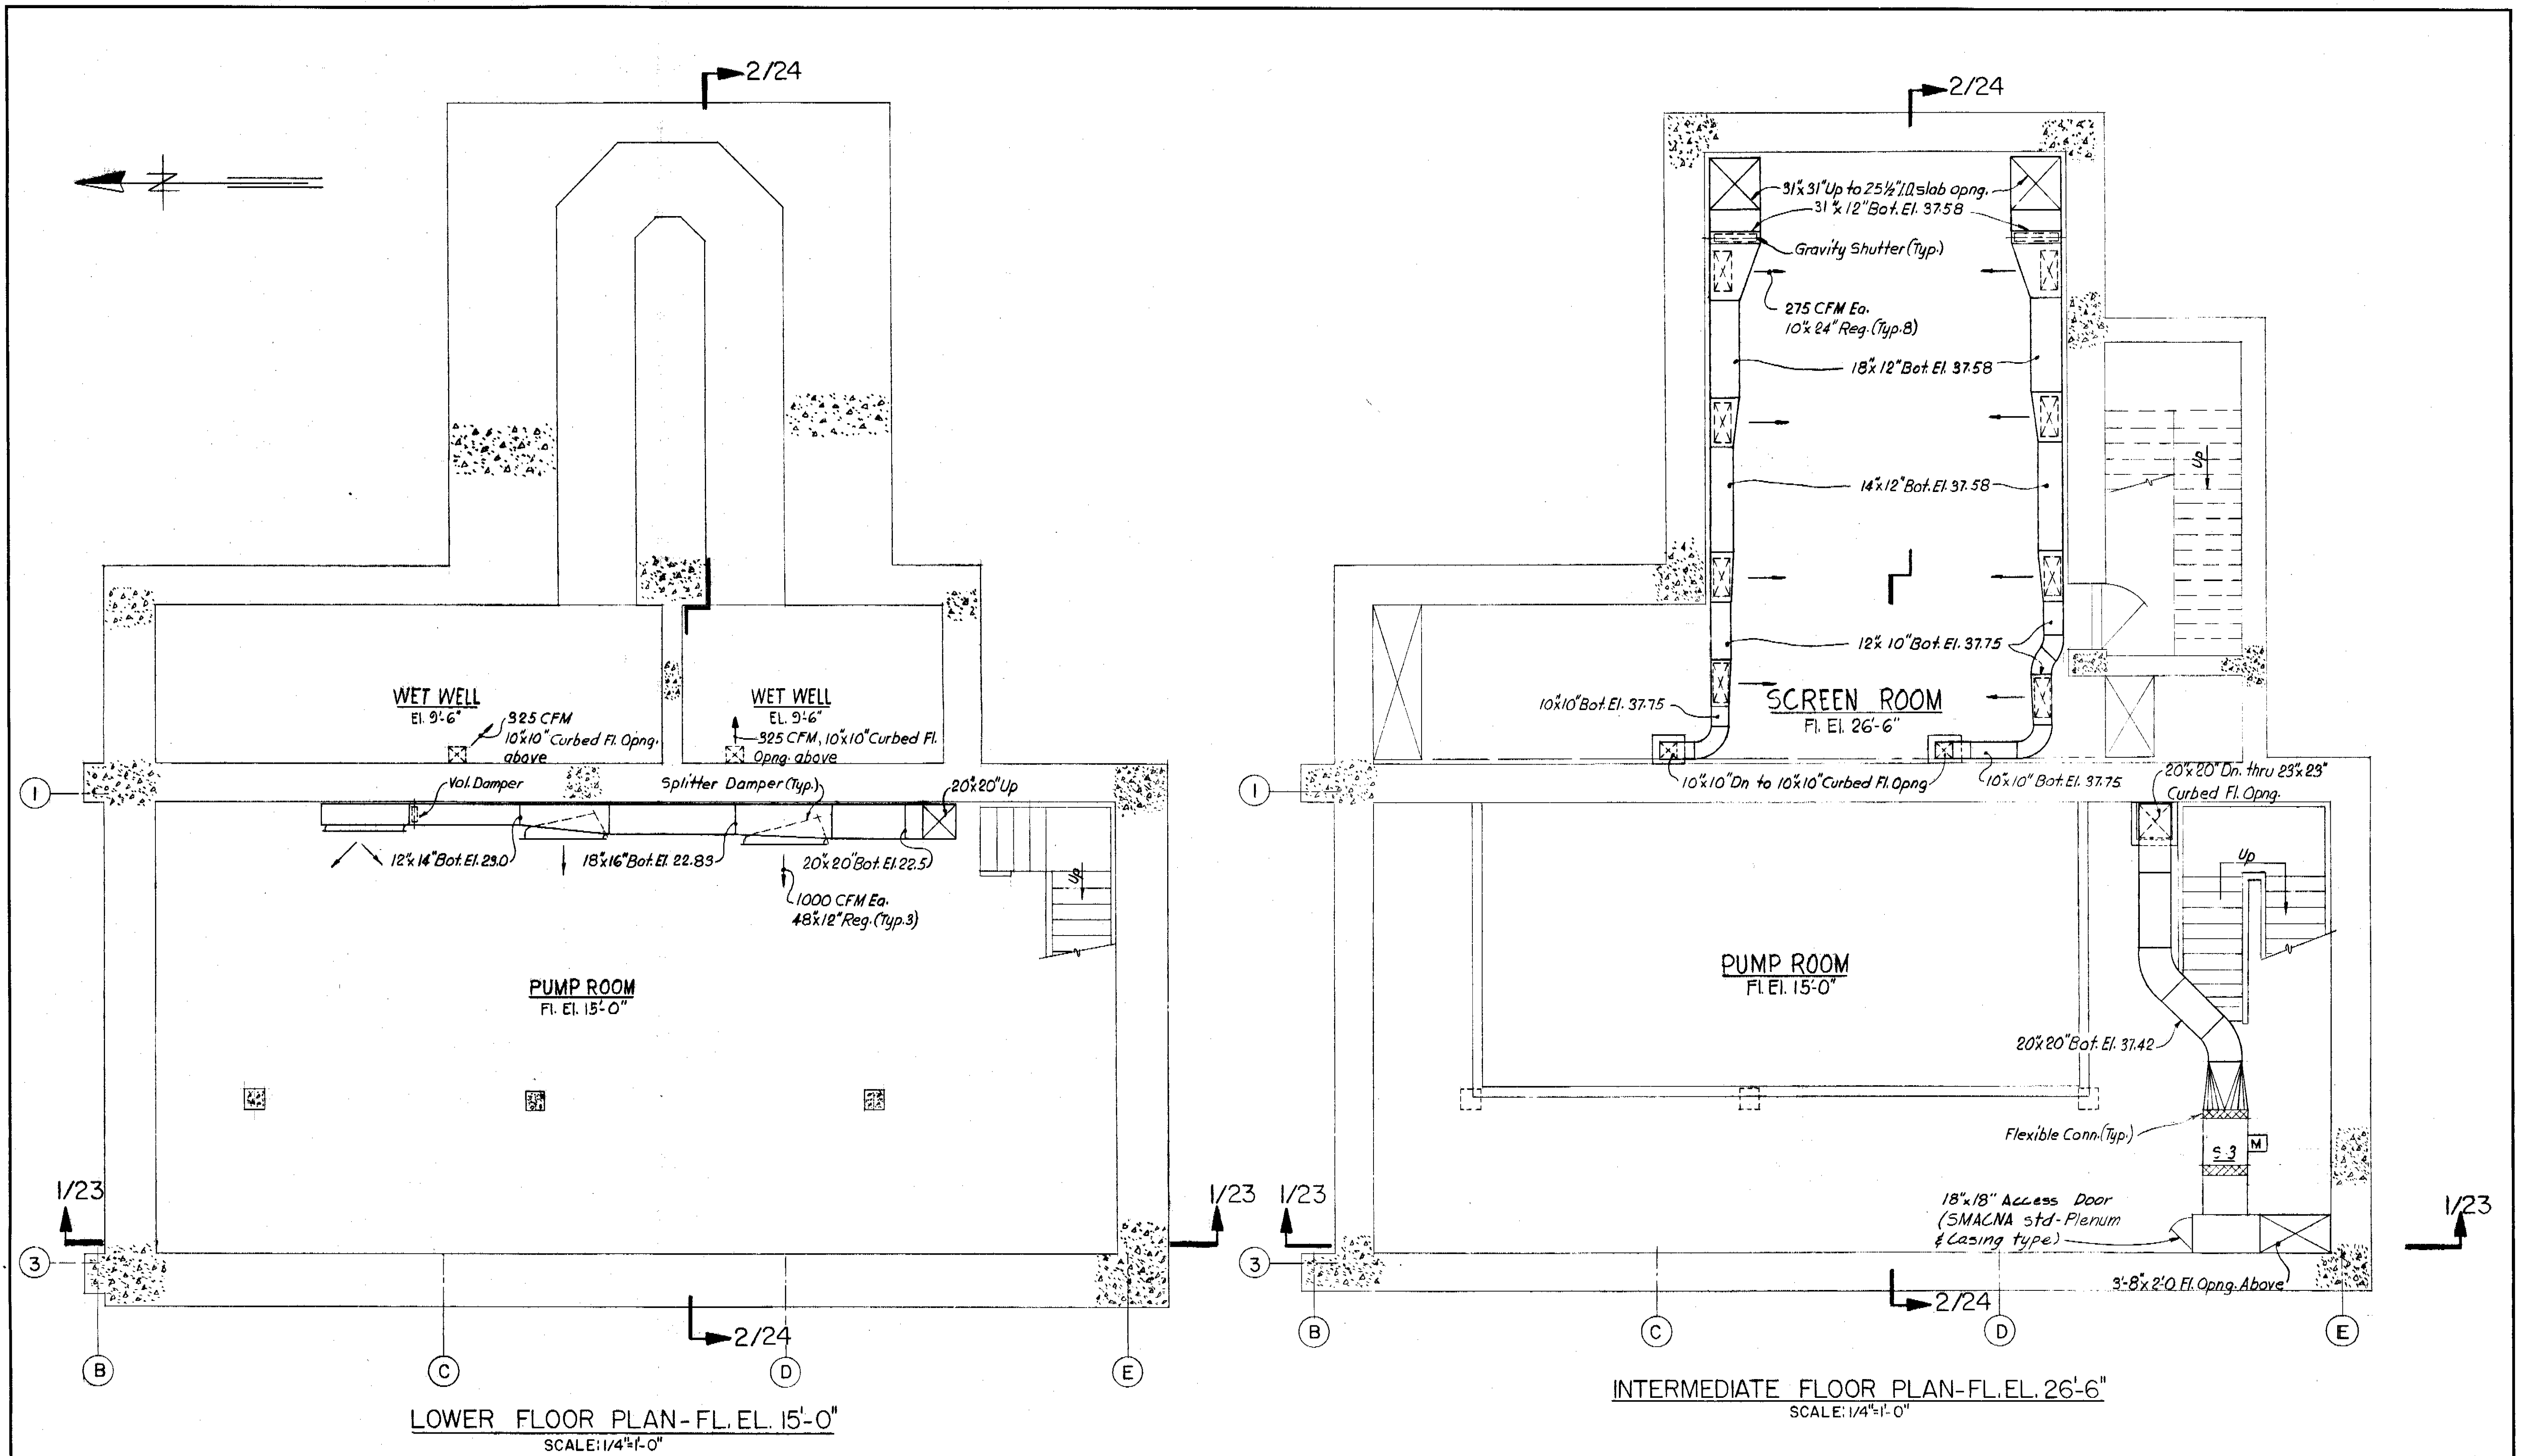

LOWER FLOOR PLAN-FL. EL. 15'-0"
SCALE: 1/4"=1'-0"

INTERMEDIATE FLOOR PLAN-FL. EL. 26'-6"
SCALE: 1/4"=1'-0"

NOTE:
ALL ELEVATIONS SHOWN ARE REFERENCED TO CITY OF TAMPA DATUM. TO CONVERT TO NATIONAL OCEAN SURVEY (NOS) DATUM, SUBTRACT 0.15 FEET (0'-1 13/16").


RECORD DRAWING
THIS RECORD DRAWING IS NOT WARRANTED BUT IS BELIEVED TO REPRESENT CONDITIONS UPON COMPLETION OF CONSTRUCTION WITHIN REASONABLE TOLERANCES BASED UPON THE INFORMATION FURNISHED TO THE ENGINEER PERTAINING TO CHANGES MADE DURING CONSTRUCTION.

GREELEY AND HANSEN ENGINEERS
222 S. RIVERSIDE PLAZA
CHICAGO, ILLINOIS 60606

DESIGNED FSS, RV
DRAWN DUG
CHECKED FSS

APPROVED _____ DATE _____
Supt., Dept. of Sanitary Sewers
DATE _____
GREELEY AND HANSEN ENGINEERS

NO.	DATE	APP.	REVISION
1	10/31	ASH	Rec. Dwg. Revisions
	Mar. 78	JRP	Plans Updated

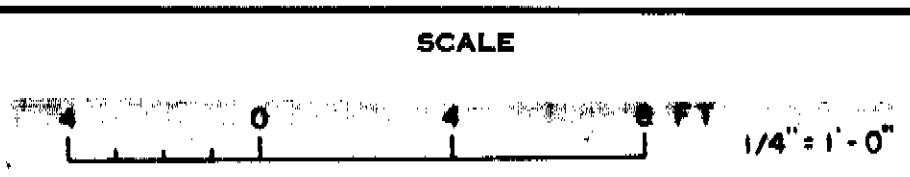


CITY OF TAMPA, FLORIDA
SEWAGE DISPOSAL SYSTEM
DIVISION 463
131 ST. AVENUE PUMPING STATION

VENTILATING
INTERMEDIATE AND
LOWER FLOOR PLAN

PROJ. NO. S202-70-30D-7-463
SHEET 22 OF 35
DATE AUGUST, 1972 REV. 0

173-59

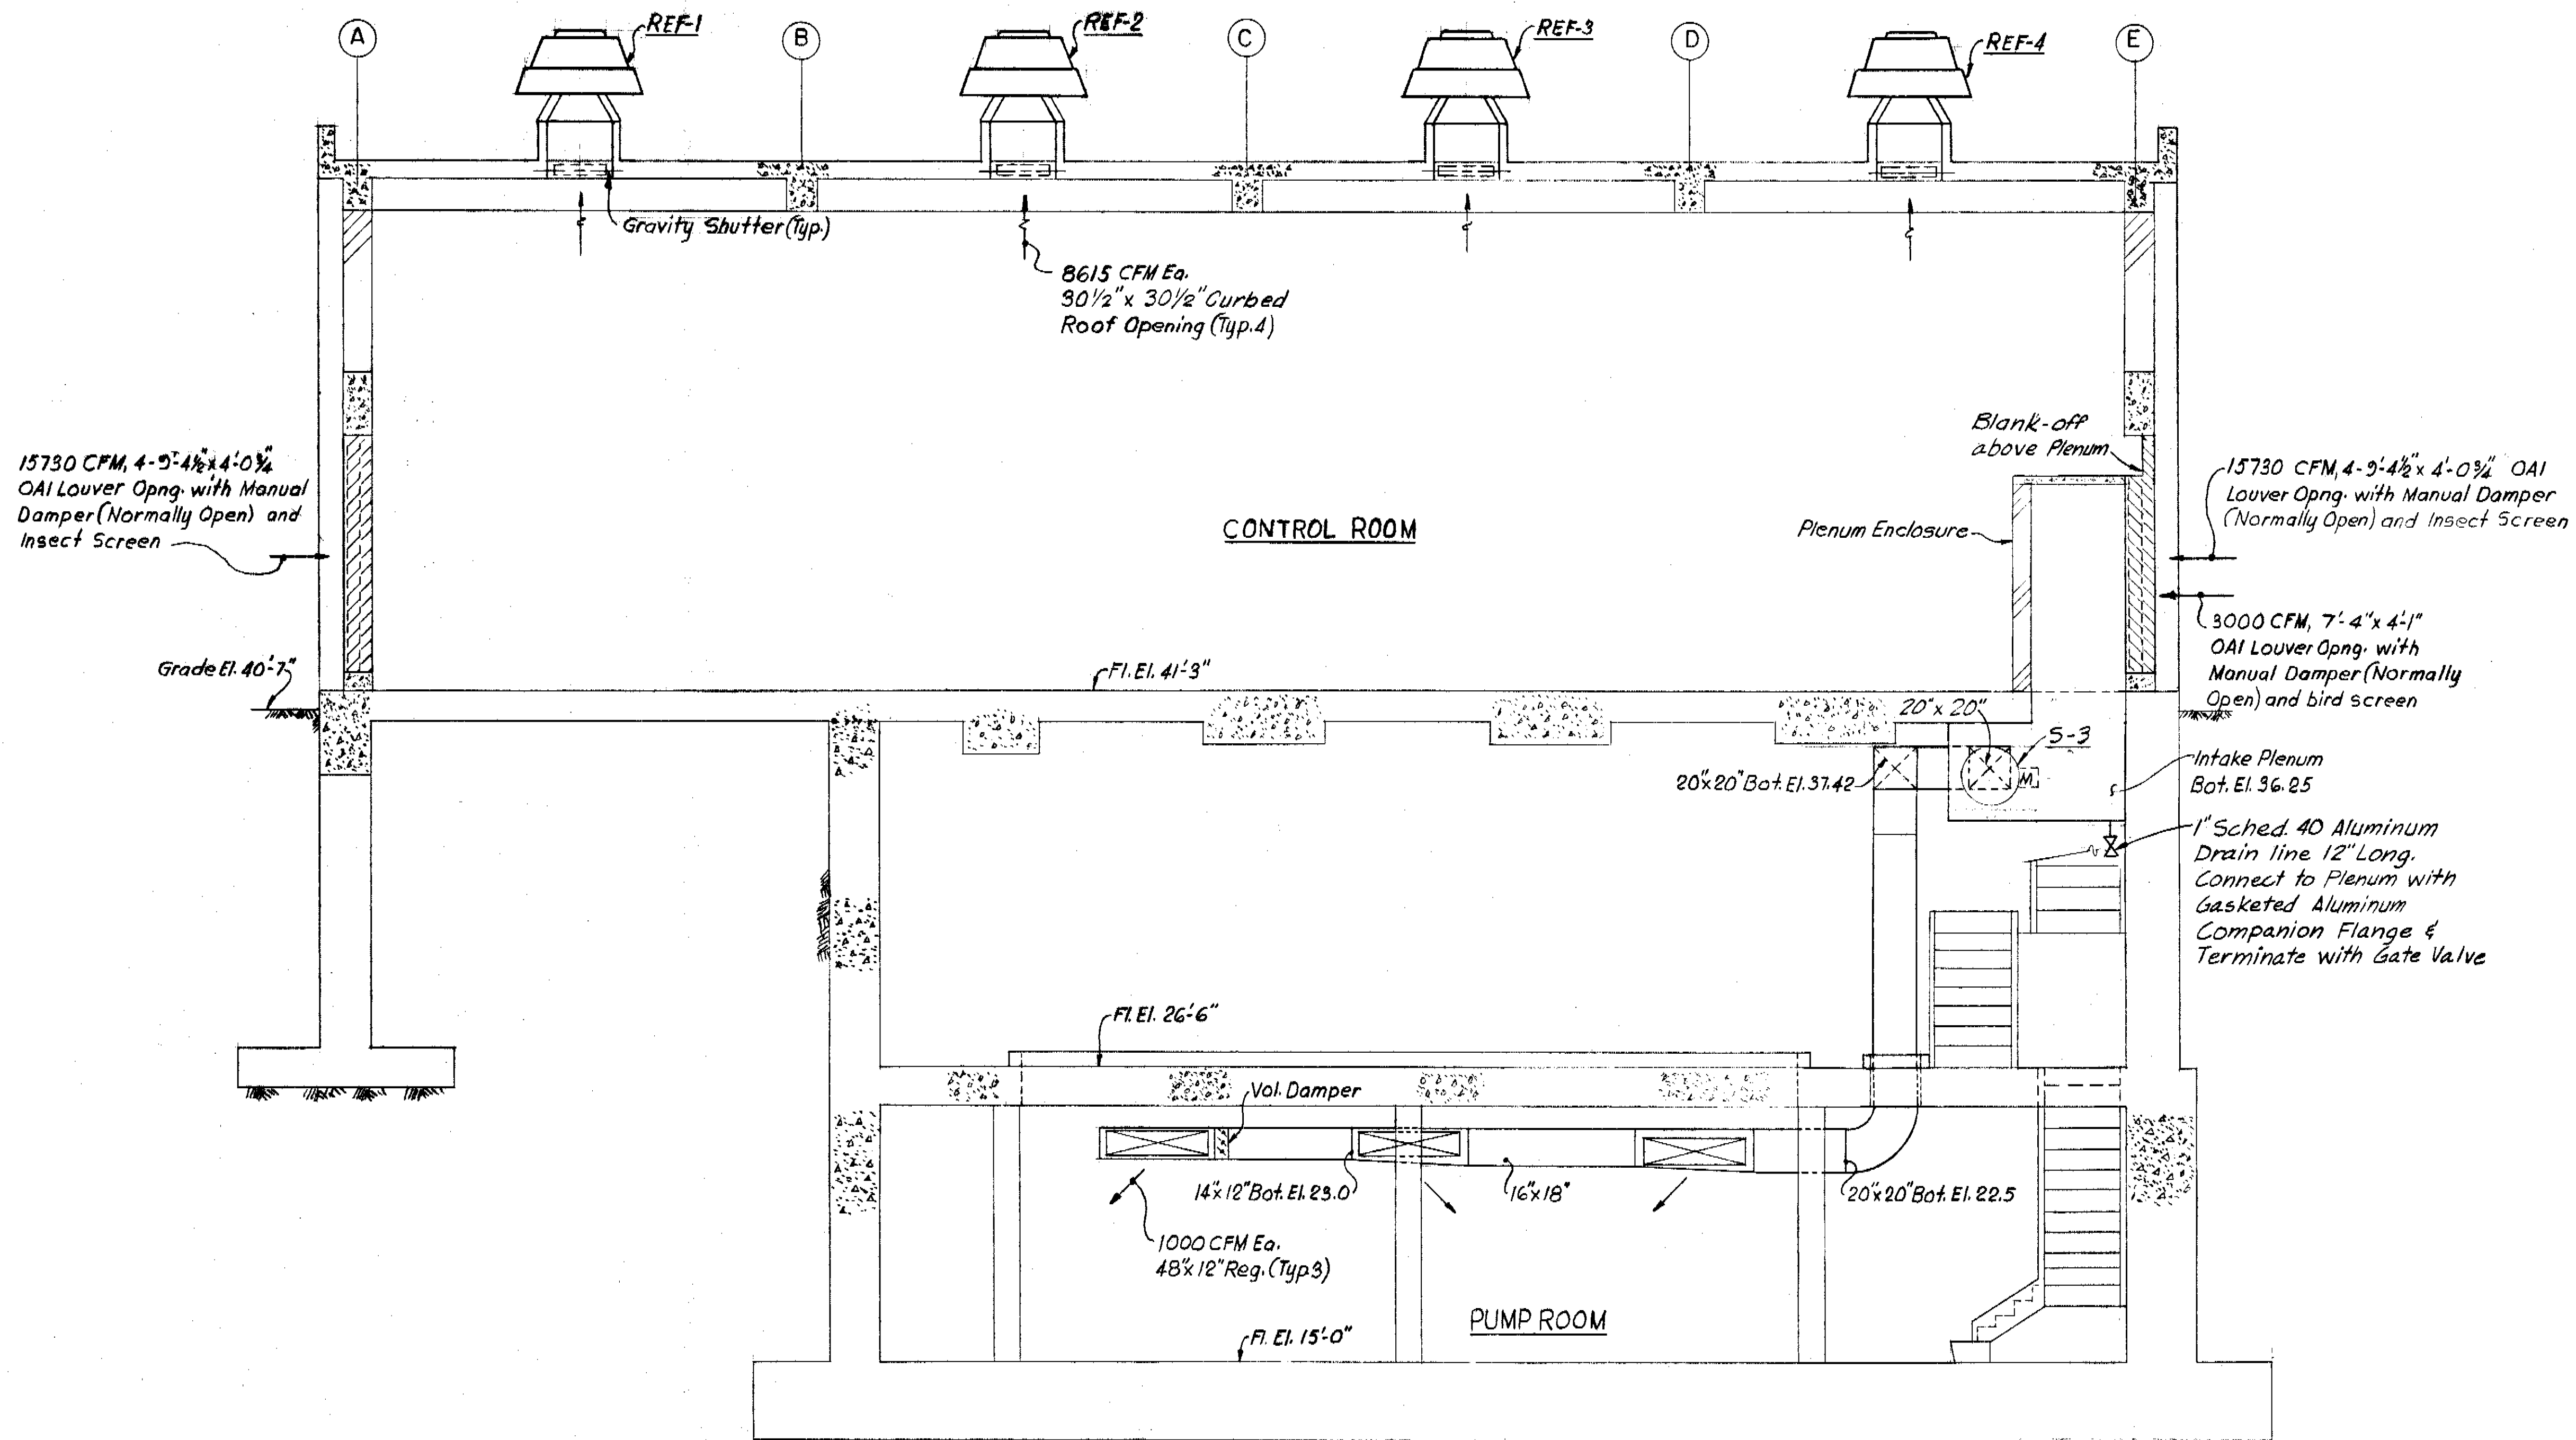

SECTION 1/21,22
SCALE: 1/4" = 1'-0"


NOTE:

ALL ELEVATIONS SHOWN ARE REFERENCED TO CITY OF TAMPA DATUM. TO CONVERT TO NATIONAL OCEAN SURVEY (NOS) DATUM, SUBTRACT 0.15 FEET (0'-1 13/16").

RECORD DRAWING


THIS RECORD DRAWING IS NOT WARRANTED BUT IS BELIEVED TO REPRESENT CONDITIONS UPON COMPLETION OF CONSTRUCTION, WITHIN REASONABLE TOLERANCES, BASED UPON THE INFORMATION FURNISHED TO THE ENGINEER PERTAINING TO CHANGES MADE DURING CONSTRUCTION.

GREELEY AND HANSEN ENGINEERS 222 S. RIVERSIDE PLAZA CHICAGO, ILLINOIS 60606	DESIGNED FSS, RV	APPROVED	SCALE		CITY OF TAMPA, FLORIDA SEWAGE DISPOSAL SYSTEM DIVISION 4G3 131 ST. AVENUE PUMPING STATION	VENTILATING SECTIONS	PROJ. NO. S202-70-30D-7-463
	DRAWN DUG	DATE	1/4" = 1'-0"				SHEET 23 OF 35
	CHECKED FSS	DATE	10/81 DSH Rec Dwg. Revisions				DATE AUGUST, 1972
		DATE	Mar. 78 JRP Plans Updated				REV. 0
		NO.	DATE	APP.	REVISION		

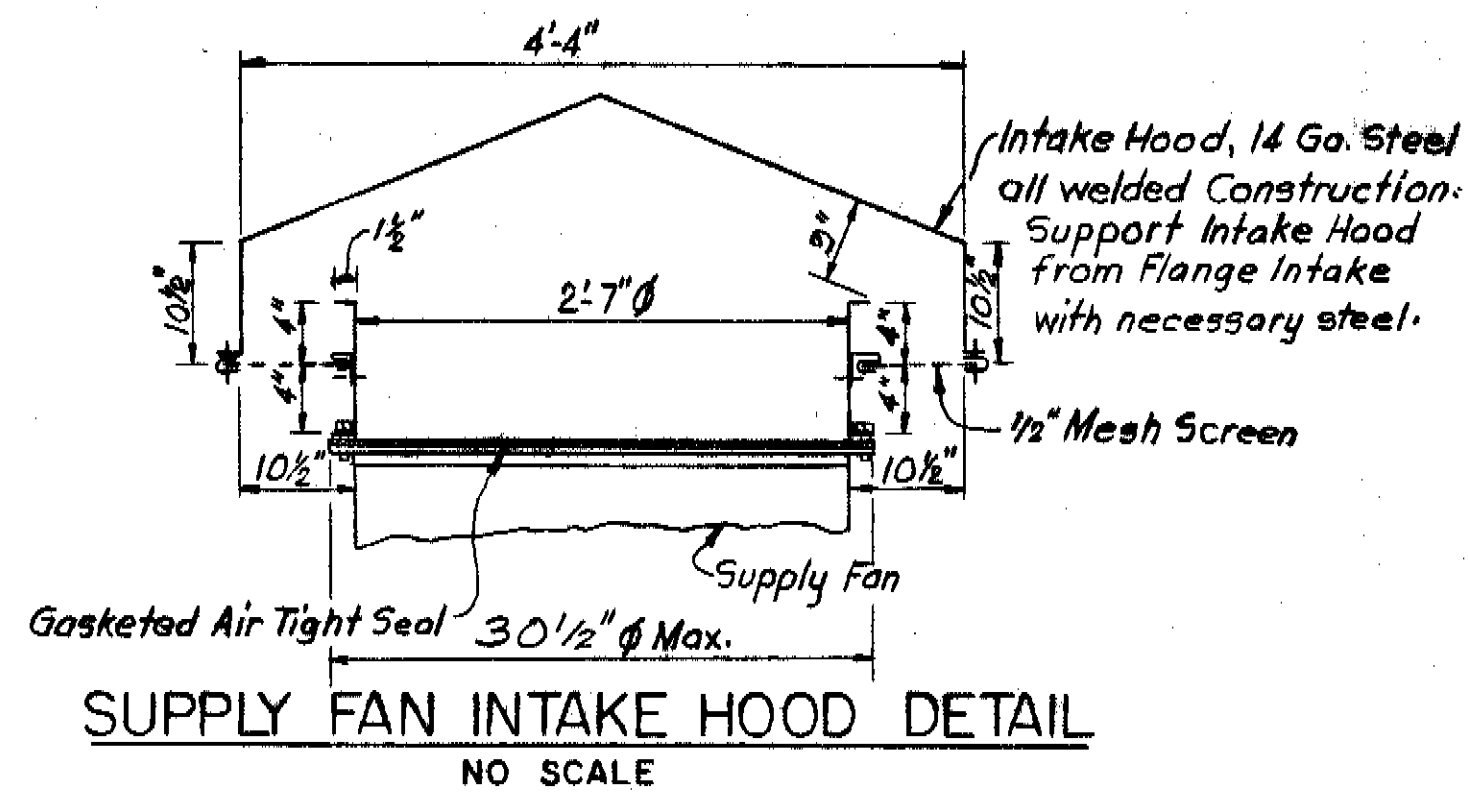

NOTE:

1. All welds ground for smooth finish.

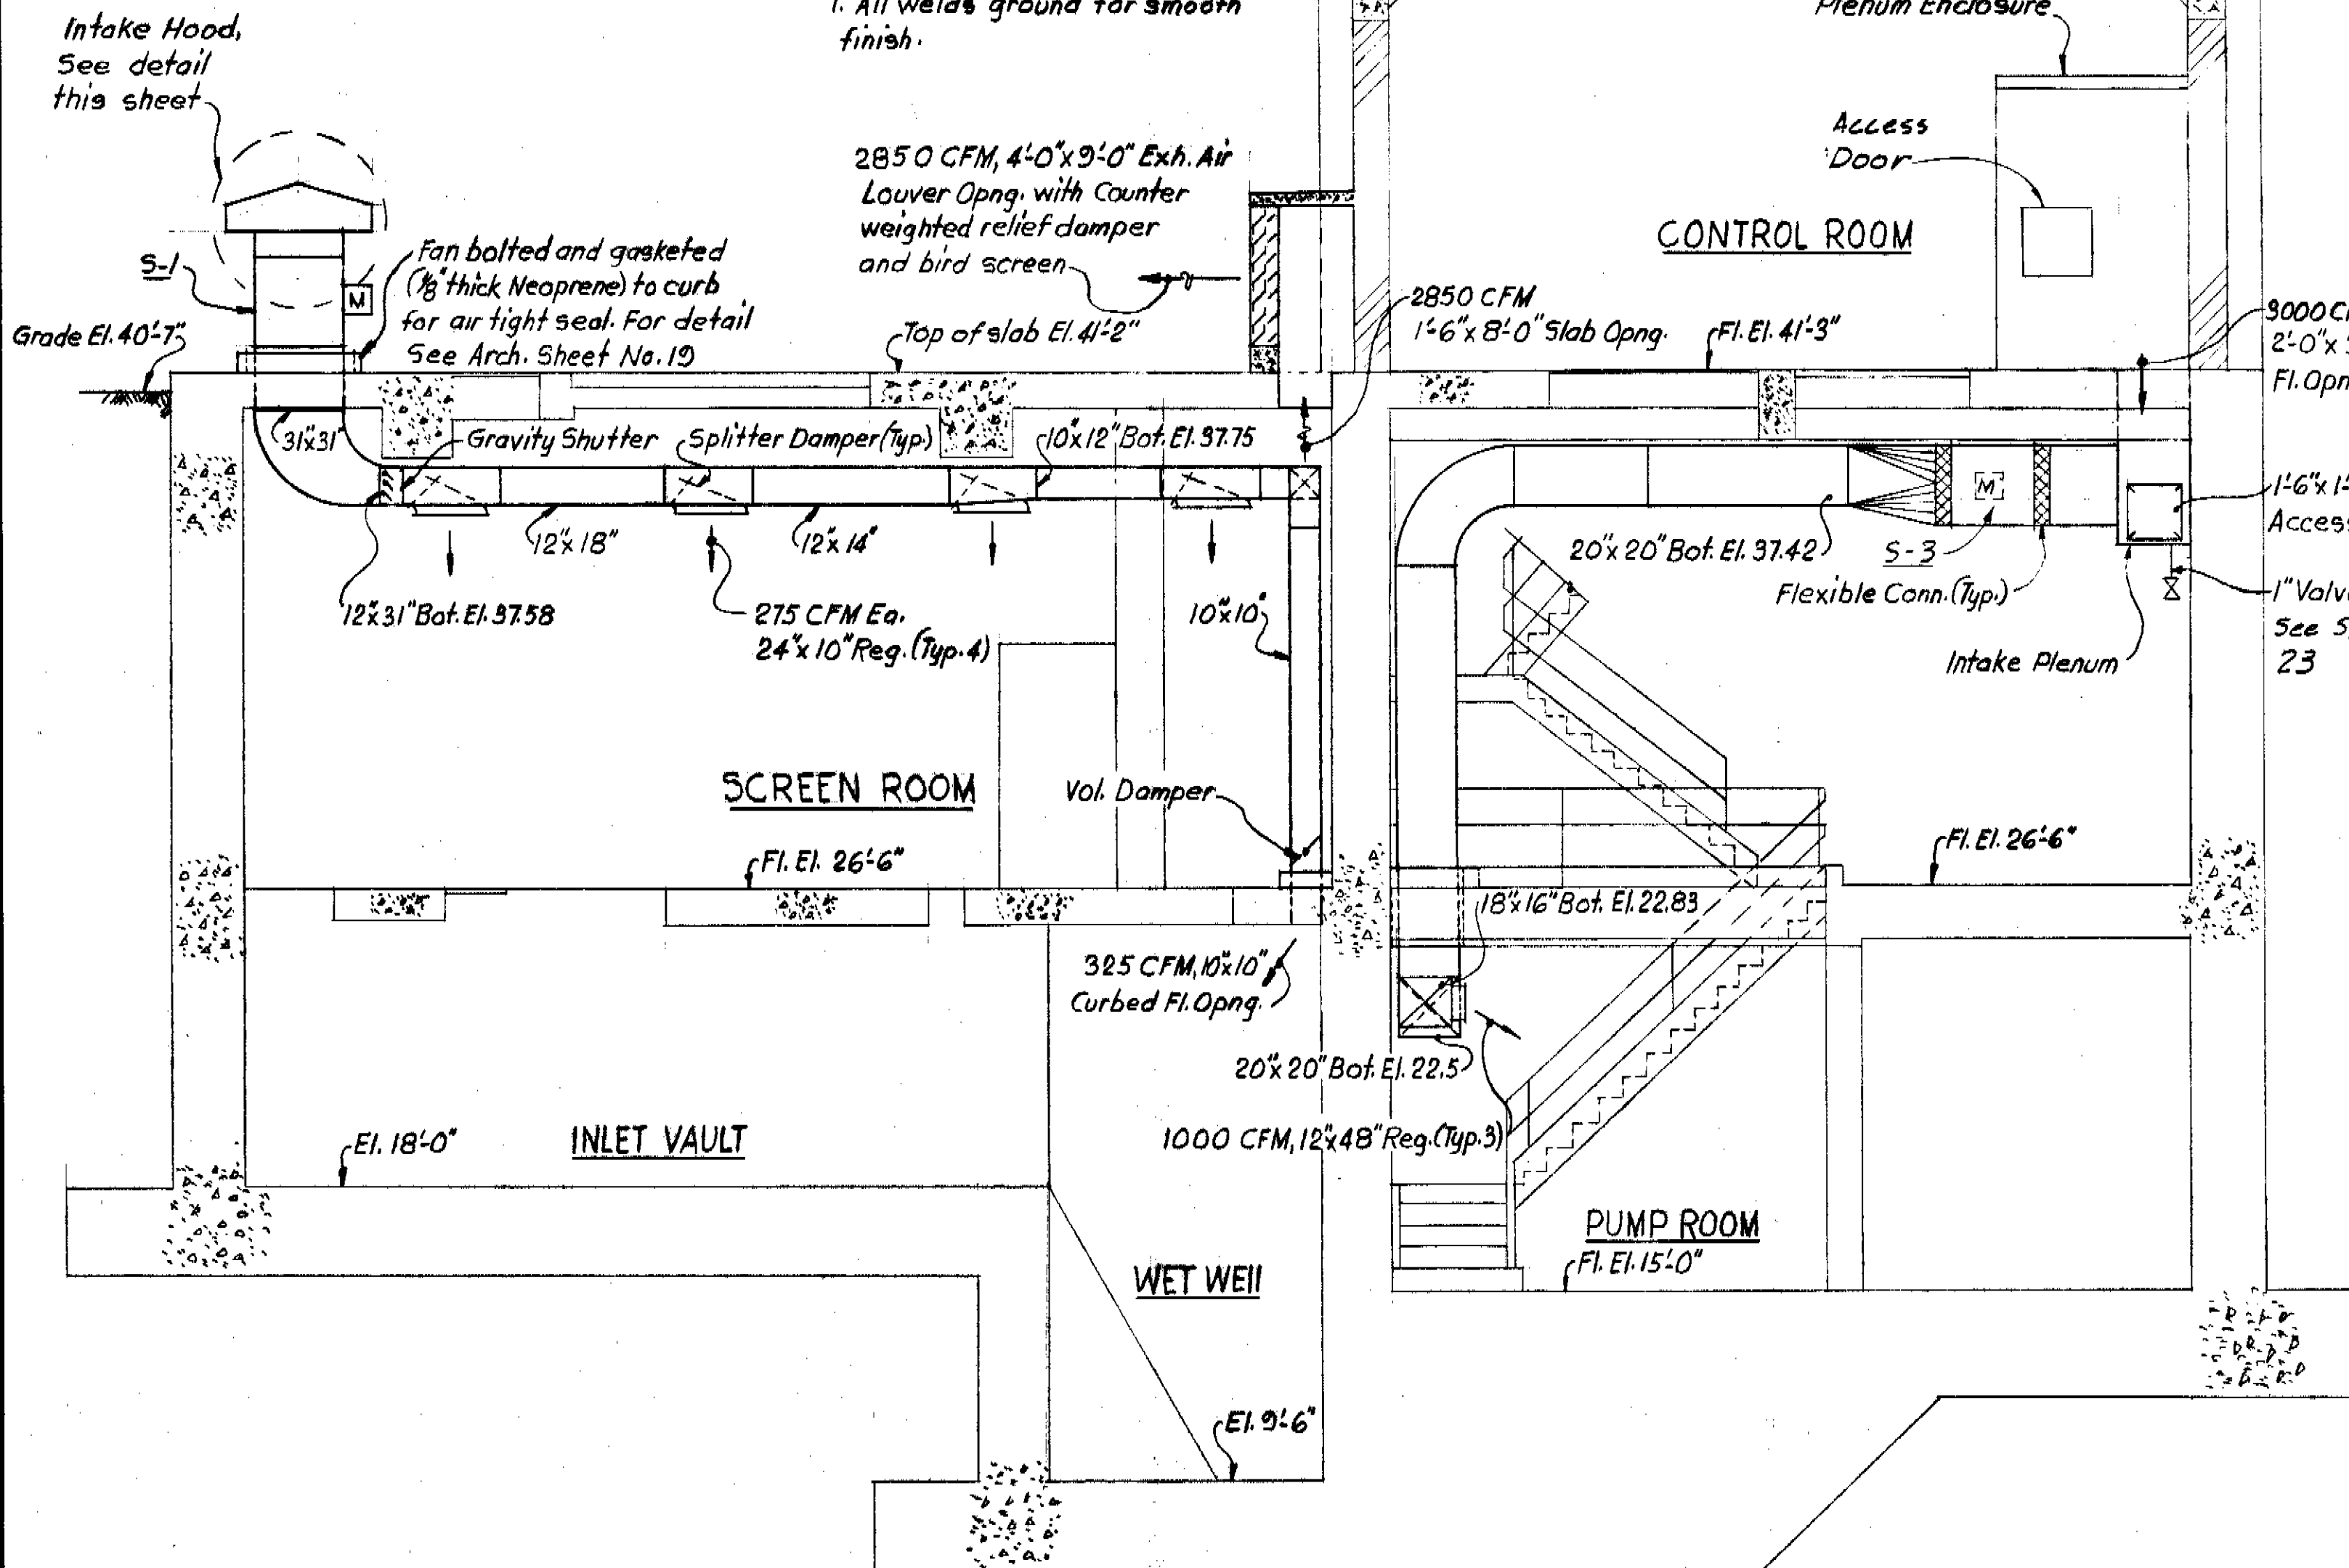

SECTION 2/21,22
SCALE: 1/4" = 1'-0"

No. Item	Regd	Location	Area Served	* Equipment Identification	Type	CFM	Static Press. In. (H ₂ O)	Max Fan RPM	Drive	Motor Data					Remarks
										HP	RPM	V	φ	~	
S-1	1	Roof Slab Screen Rm.	Screen Rm. and Wet Well	CTB-20	Centrifugal In-Line	3190	2 1/2	at High Speed 1510	V-Belt	3	1800 900	460	3	60	2 Speed, single winding motor. Fan rating based on high speed
S-2	1	Roof Slab Screen Rm.	Screen Rm. and Wet Well	CTB-20	Centrifugal In-Line	3190	2 1/2	at High Speed 1510	V-Belt	3	1800 900	460	3	60	2 Speed, single winding motor. Fan rating based on high speed.
S-3	1	Pump Room	Pump Room	CTB-18	Centrifugal In-Line	3407	3/4	1322	V-Belt	1 1/2	1725	460	3	60	

* * * E-1 Toilet Exhaust Fan shall be Model No. CWF-67, 150 CFM @ 1/4" S.P., Direct driven by 1/10 Hp. Motor, 1550 RPM, 1 φ 60 Cy 115 V, 2740 FPM Tip speed with Gravity Shutter and Disconnect Switch

* * * REF-1, REF-2, REF-3 and REF-4 Roof Exhaust Fans shall be Model No. CRF-300, 8615 CFM each @ 1/4 S.P. driven by 1 1/2 HP Motor, 570 RPM, 3 φ 60 ~, 460 V, 4477 FPM Tip Speed with Gravity Shutter and Disconnect Switch.

Roof curbed openings to be in accordance with approved Shop Drawings submittal of Manufacturer's Equipment. See Arch. Drawings for Curb details.

* Equipment identification model number is based on ILG Industries, Inc. and the equipment shall be as manufactured by ILG Industries, Inc., HK Porter Company Inc., "Centrifan", or equal.

* * * Equipment identification Model No. is based on ILG Industries, Inc. and the equipment shall be as manufactured by ILG Industries, Inc.; Penn Ventilator Company, Inc., "Domex"; Swartwout Division, Zurn Industries, Inc., "Fiber-Aire", or equal.

NOTE:

ALL ELEVATIONS SHOWN ARE REFERENCED TO CITY OF TAMPA DATUM. TO CONVERT TO NATIONAL OCEAN SURVEY (NOS) DATUM, SUBTRACT 0.15 FEET (0'-1 13/16").

RECORD DRAWING

THIS RECORD DRAWING IS NOT WARRANTED BUT IS BELIEVED TO REPRESENT CONDITIONS UPON COMPLETION OF CONSTRUCTION WITHIN REASONABLE TOLERANCES BASED UPON THE INFORMATION FURNISHED TO THE ENGINEER PERTAINING TO CHANGES MADE DURING CONSTRUCTION.

GREELEY AND HANSEN ENGINEERS 222 S. RIVERSIDE PLAZA CHICAGO, ILLINOIS 60606	DESIGNED: FSS, RV	APPROVED:	DATE:	2 10/81 DSH Rec. Dwg. Revisions 1 Dec. 78 JRP Added Addendum No. 1 Mar. 78 JRP Plans Updated	SCALE 	CITY OF TAMPA, FLORIDA SEWAGE DISPOSAL SYSTEM DIVISION 4G3 131 ST. AVENUE PUMPING STATION	VENTILATING SECTIONS EQUIPMENT SCHEDULES	PROJECT NO. S 202-70-30D-7-4G3
	DR: DUG	SUPT., DEPT. OF SANITARY SEWERS	DATE:					SHEET 24 OF 35
	CHECKED: FSS	GREELEY AND HANSEN, ENGINEERS	DATE:					DATE AUGUST, 1972 REV. 1

L E G E N D

- TECO - Tampa Electric Company
- M - Contactor Operating Coil
- PSR - Phase Sequence and Undervoltage Relay
- SAL - MD Drive Alarm Contact (Closes on TG Failure)
- SS - Selector Switch
- ES - Emergency Stop Push Button
- SI - Speed Indicator
- GSR - Ground Fault Sensing Relay
- ETM - Elapsed Time Meter
- TMR - Timer

- FU - Fuse
- LS - Limit Switch
- LSS - Suction Sluice Gate Limit Switch
- OL - Overload Relay
- LLC - Liquid Level Control
- DPS - Differential Pressure Switch
- DVS - Pump Discharge Valve Solenoid Control Valve
- SWS - Seal Water Solenoid Valve
- LEL - Lower Explosion Limit
- AR, CR - Control Relay

- PDT - Pump Transfer Duty Switch
- TR - Timing Relay
- TO - Time Opening
- TC - Time Closing

- LI - Liquid Level Indicator
- DT - Transfer Duty Switch
- VIB - Vibration Sensing Switch
- POT - Manual Speed Adjusting Potentiometer
- Ψ - Thermistors
- SF - Seal Water Flow Switch
- LTS - Low Temperature Thermostat
- TG - Tachometer Generator
- MG - Controller for Thermal Protection
- MDC - Magnetic Drive Contactor
- MD - Magnetic Drive
- MCP - Motor Circuit Protector
- ES - Emergency Stop

- △ - Located remotely from Control Center
- ⊠ - Start-Stop/Lockout P.B. Station
- SL — Exposed Conduit
- --- Embedded Conduit, or under Slab
- — — — — Grounding Conductor
- ⊕ — Duplex Receptacle
- ⊙ — Single Receptacle
- ⊙ — Clock Outlet
- ⊙ — 480 Volt - 3 Phase-Receptacle
- ⊗ — Indicating Light, R-red, G-green, B-blue, A-amber
- ⊗ — Mercury Vapor Light Fixture

- — Fluorescent Light Fixture
- ⌘ — Light Switch
- ⌘³ — Light Switch 3 Way
- ⌘^{PL} — Light Switch with Pilot Light

- Y — Furnished with Equipment
- ⊙ — Ground Rod


- X — Explosion-Proof
- P — Pressure Switch
- F — Float Switch
- T — Thermostat
- SV — Solenoid Valve

- WP — Weatherproof
- PC — Photo Cell
- ALT — Alternator
- HL — High Water Level Switch
- 50A — Circuit Breaker with Thermal-Magnetic Trip rated 50 A.
- 1200A / 1000A — 1200A Frame Circuit Breaker with Solid State Sensor, rated to monitor 1000 A
- MCP — Across the Line Motor Circuit Protector (MCP) Combination Starter with Control Transformer and Overload Relays (M-Operating Coil)
- MCP — Combination two Speed Motor Starter with Control Transformer and Overload Relays


- NOTES:**
- 1 - Transformer Concrete Base, Underground Conduit & Grounding shall be in Accordance with TECO Requirements.
 - 2 - Terminate in Accordance with TECO Requirements.
 - 3 - Conduit for the Telephone Line shall be installed and terminated in accordance with the Telephone Co. Requirements.

NOTE: THIS RECORD DRAWING IS NOT WARRANTED BUT IS BELIEVED TO REPRESENT CONDITIONS UPON COMPLETION OF CONSTRUCTION WITHIN REASONABLE TOLERANCES BASED UPON THE INFORMATION FURNISHED TO THE ENGINEER PERTAINING TO CHANGES MADE DURING CONSTRUCTION.


RECORD DRAWING

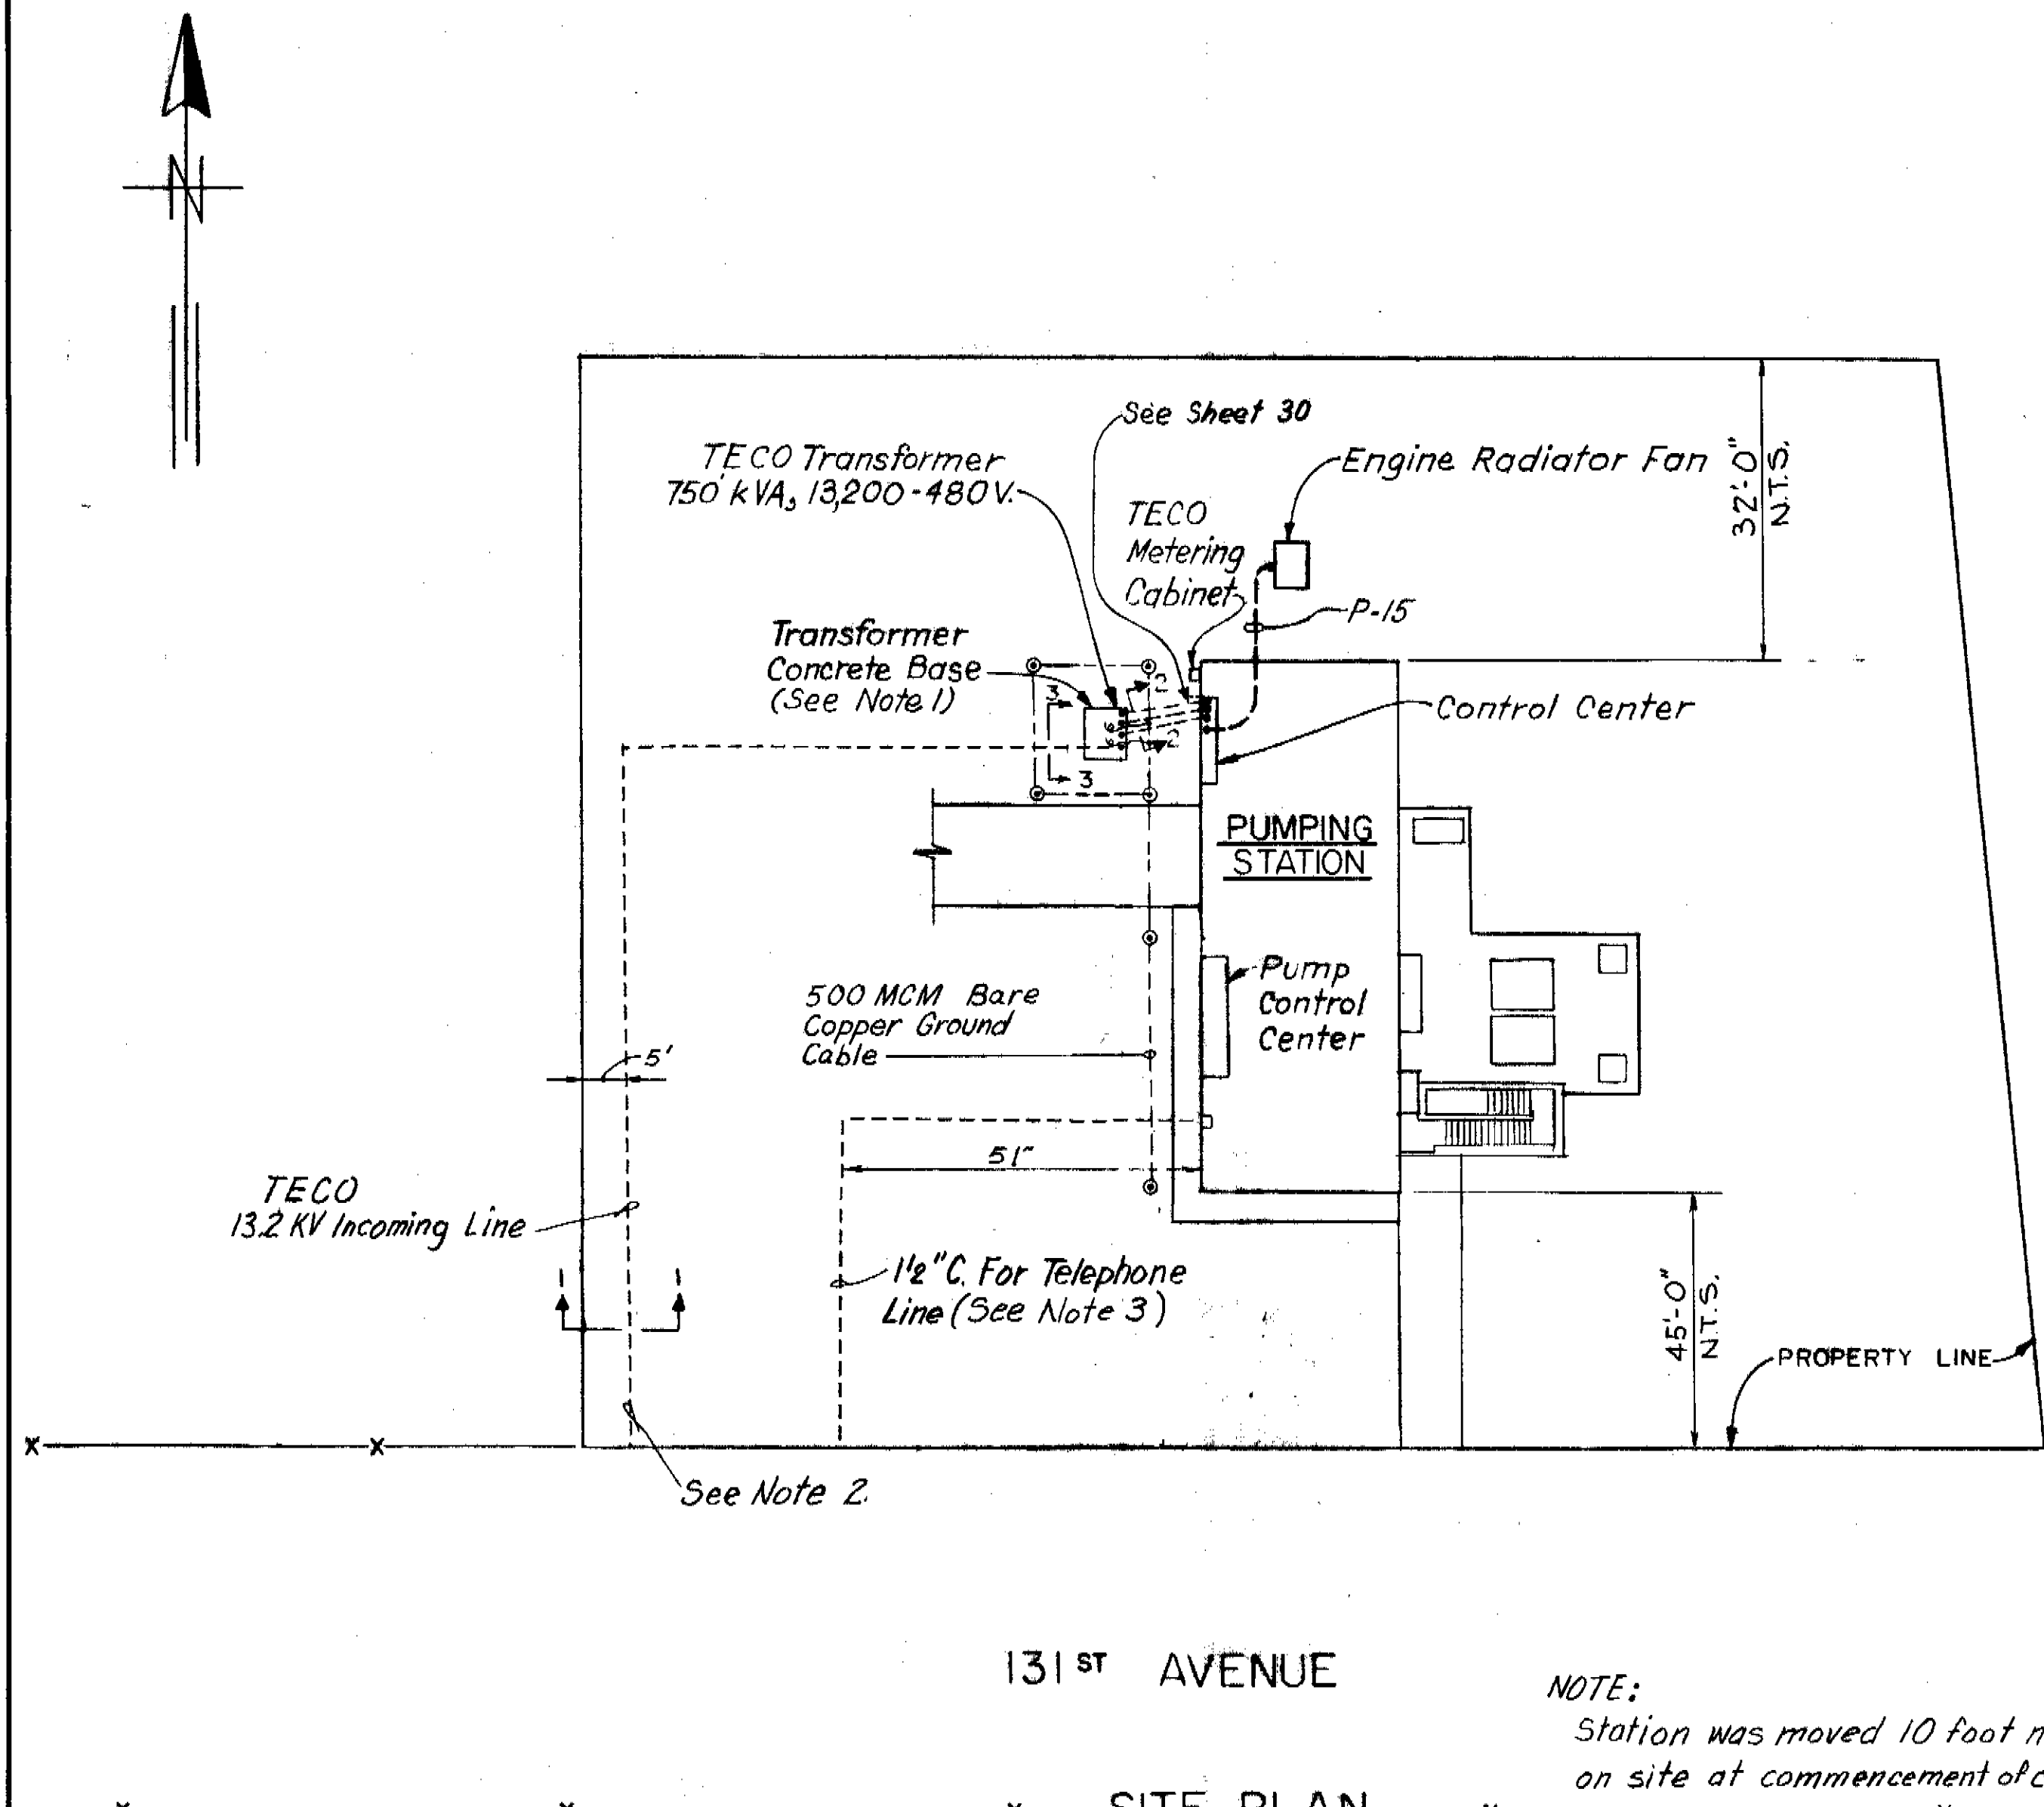


131 ST AVENUE
SITE PLAN
SCALE: 1" = 20'-0"

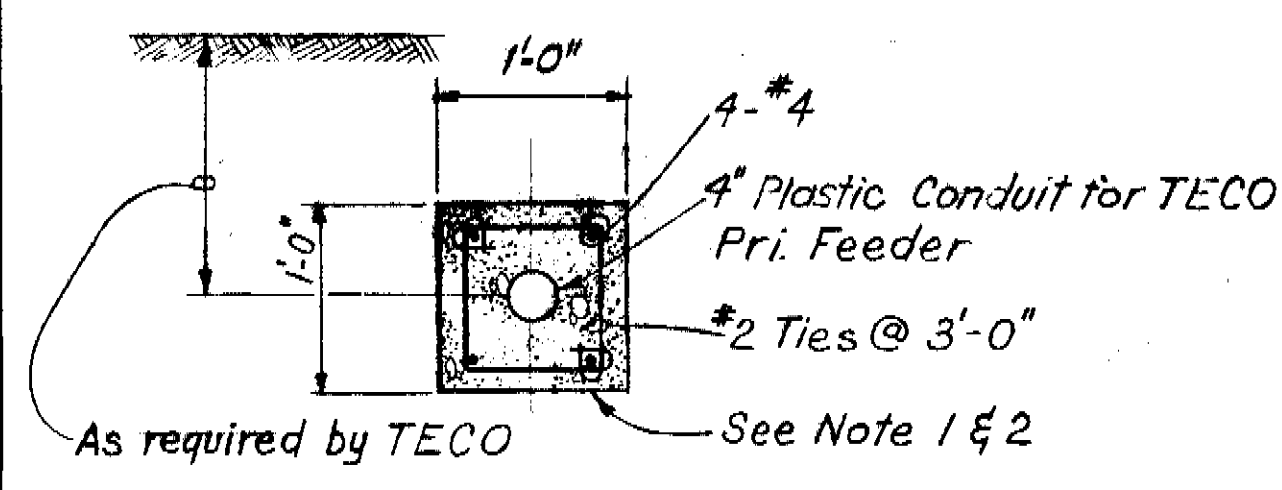


SECTION I
NOT TO SCALE

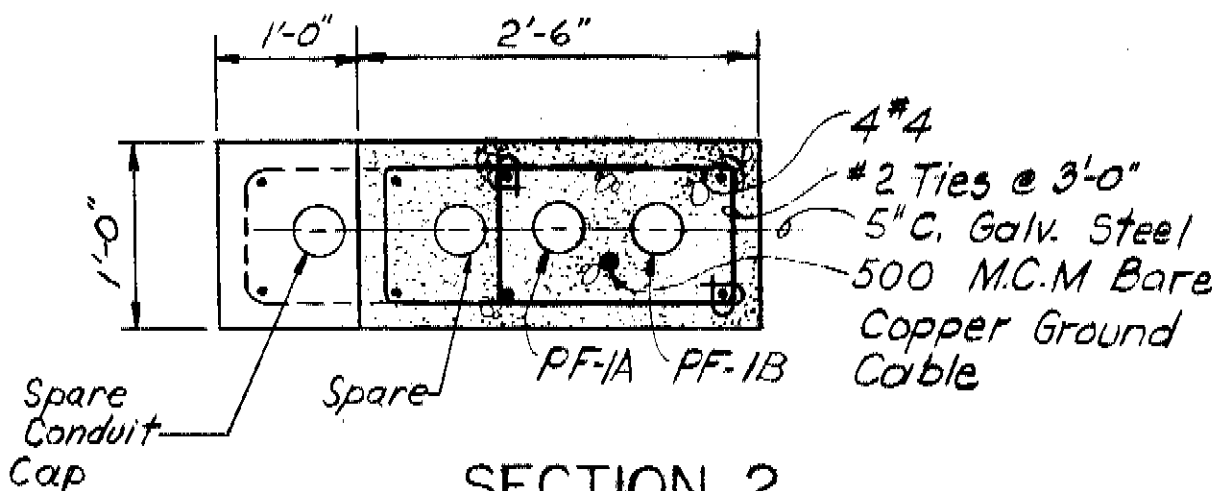


SECTION 2
NOT TO SCALE

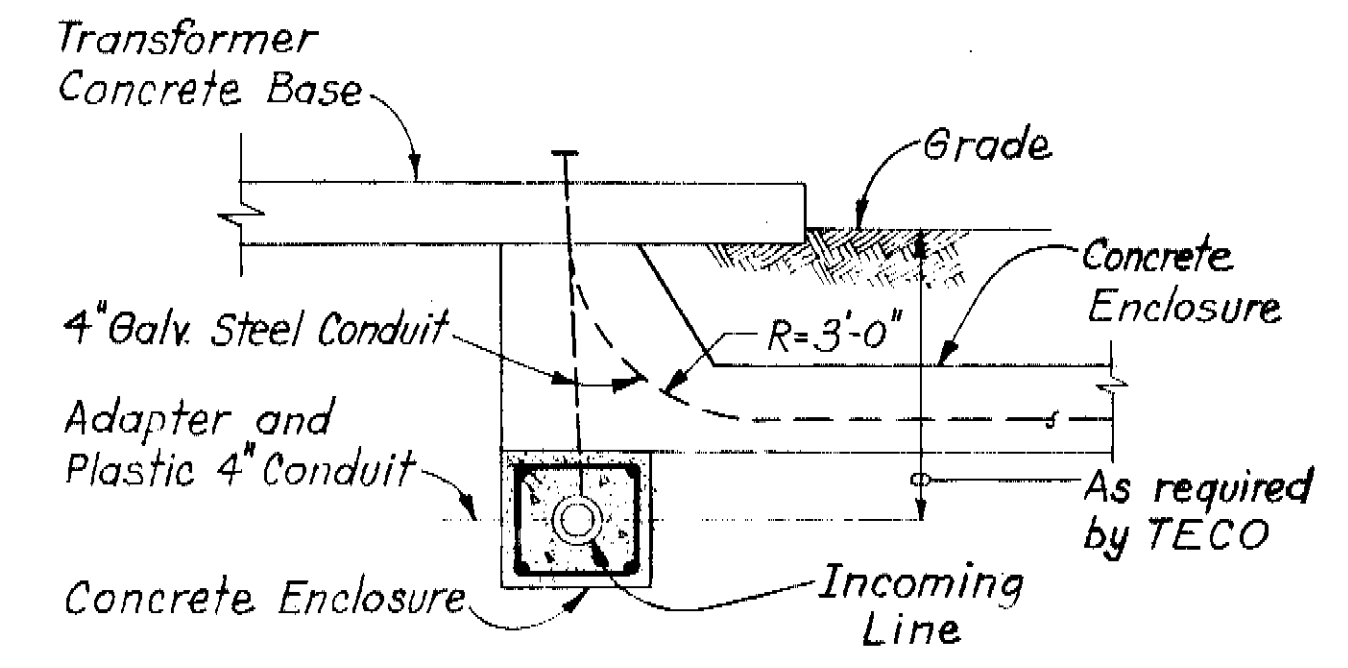

SECTION 3
NOT TO SCALE

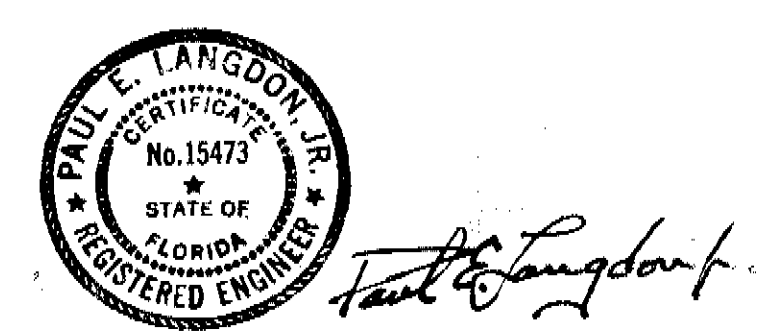

GREELEY AND HANSEN ENGINEERS 222 S. RIVERSIDE PLAZA CHICAGO, ILLINOIS 60606	DESIGNED KK	APPROVED					
	DRAWN FS	SUPT., DEPT. OF SANITARY SEWERS	1	10/81	USH	Rec Dwg. Revisions	
	CHECKED OA	GREELEY AND HANSEN, ENGINEERS		Mar 78	JRP	Plans Updated	
			NO.	DATE	APP.	REVISION	

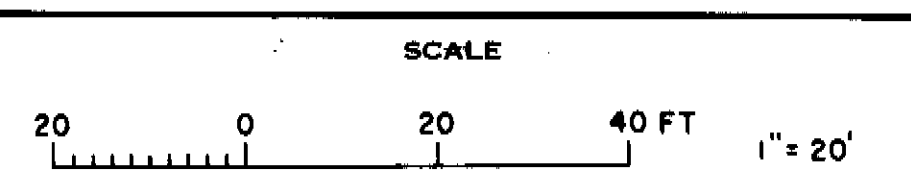


CITY OF TAMPA, FLORIDA
SEWAGE DISPOSAL SYSTEM
DIVISION 4G3
131 ST. AVENUE PUMPING STATION

ELECTRICAL
SITE PLAN AND LEGEND

PROJ. NO. S202-70-300-7-4 G3
SHEET 25 OF 35
DATE AUGUST, 1972 REV. 0


173-4

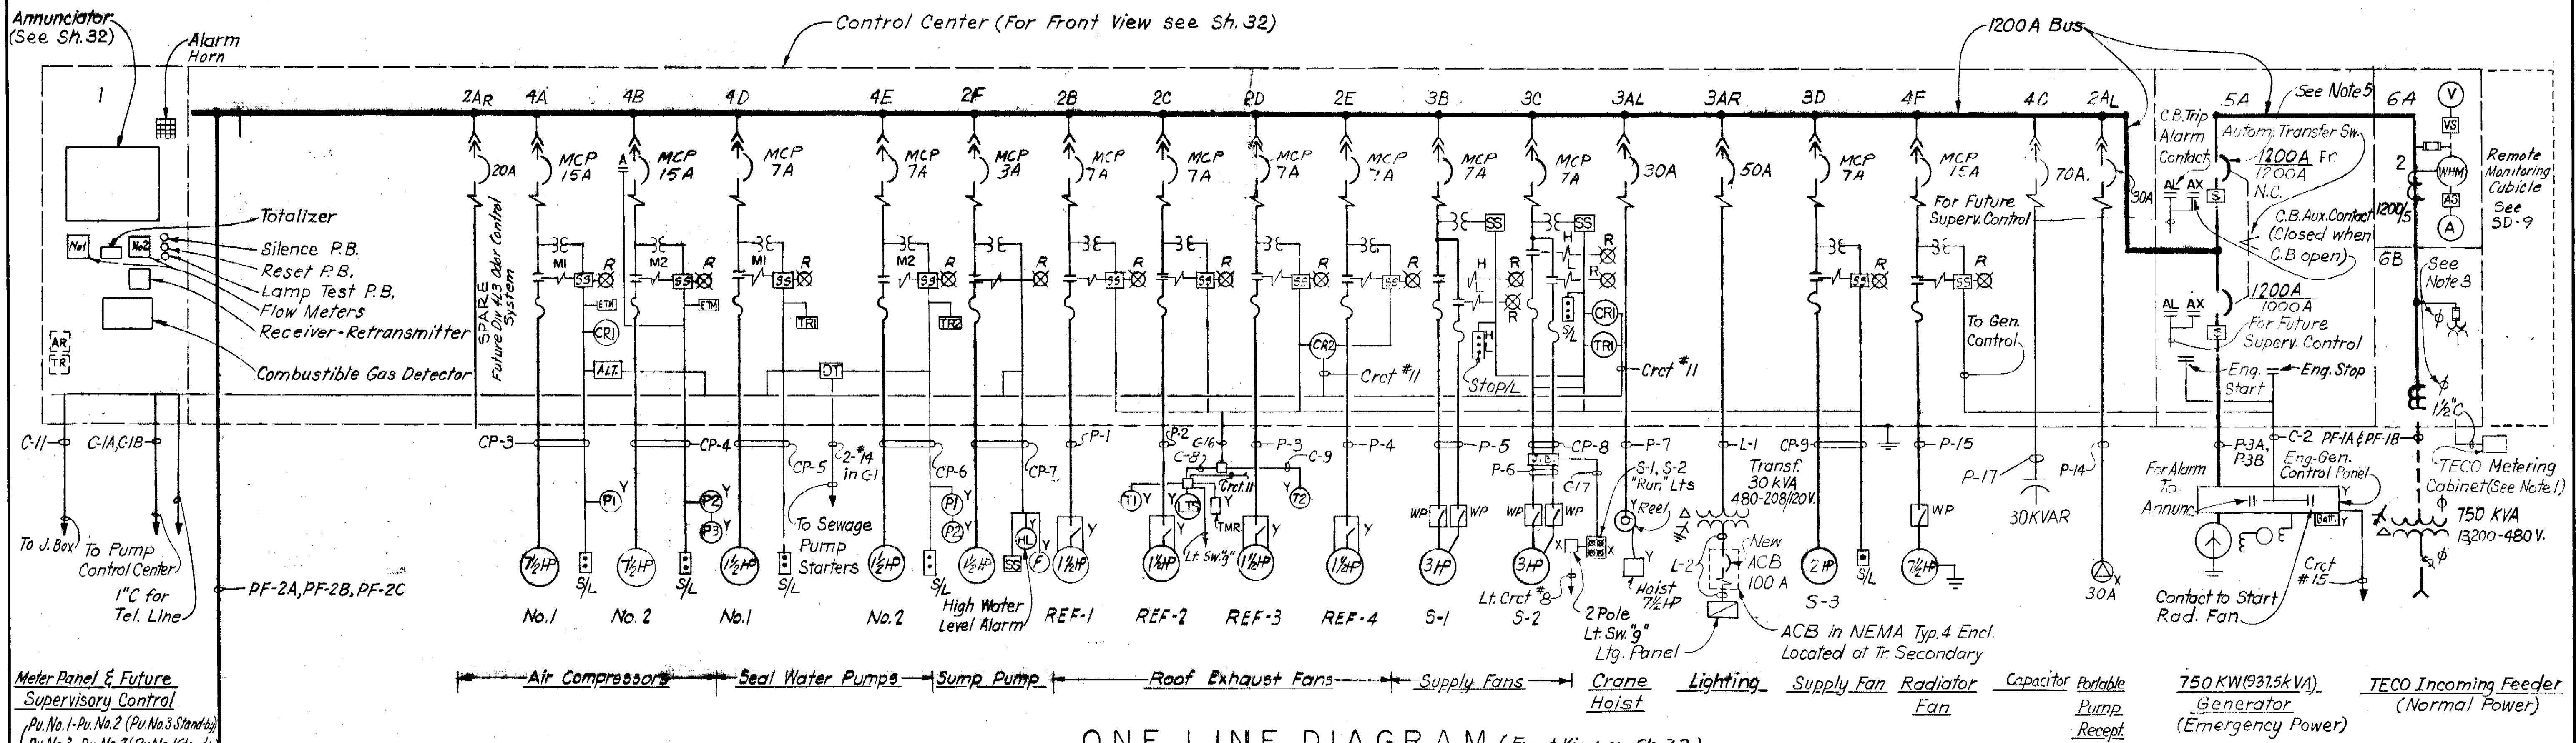

ONE LINE DIAGRAM (Front View on Sh. 32)

480 VOLT - 3 PHASE - 60 Hz

Meter Panel & Future Supervisory Control
 Pu. No. 1 - Pu. No. 2 (Pu. No. 3 Stand-by)
 Pu. No. 3 - Pu. No. 2 (Pu. No. 1 Stand-by)
 Pu. No. 1 - Pu. No. 3 (Pu. No. 2 Stand-by)

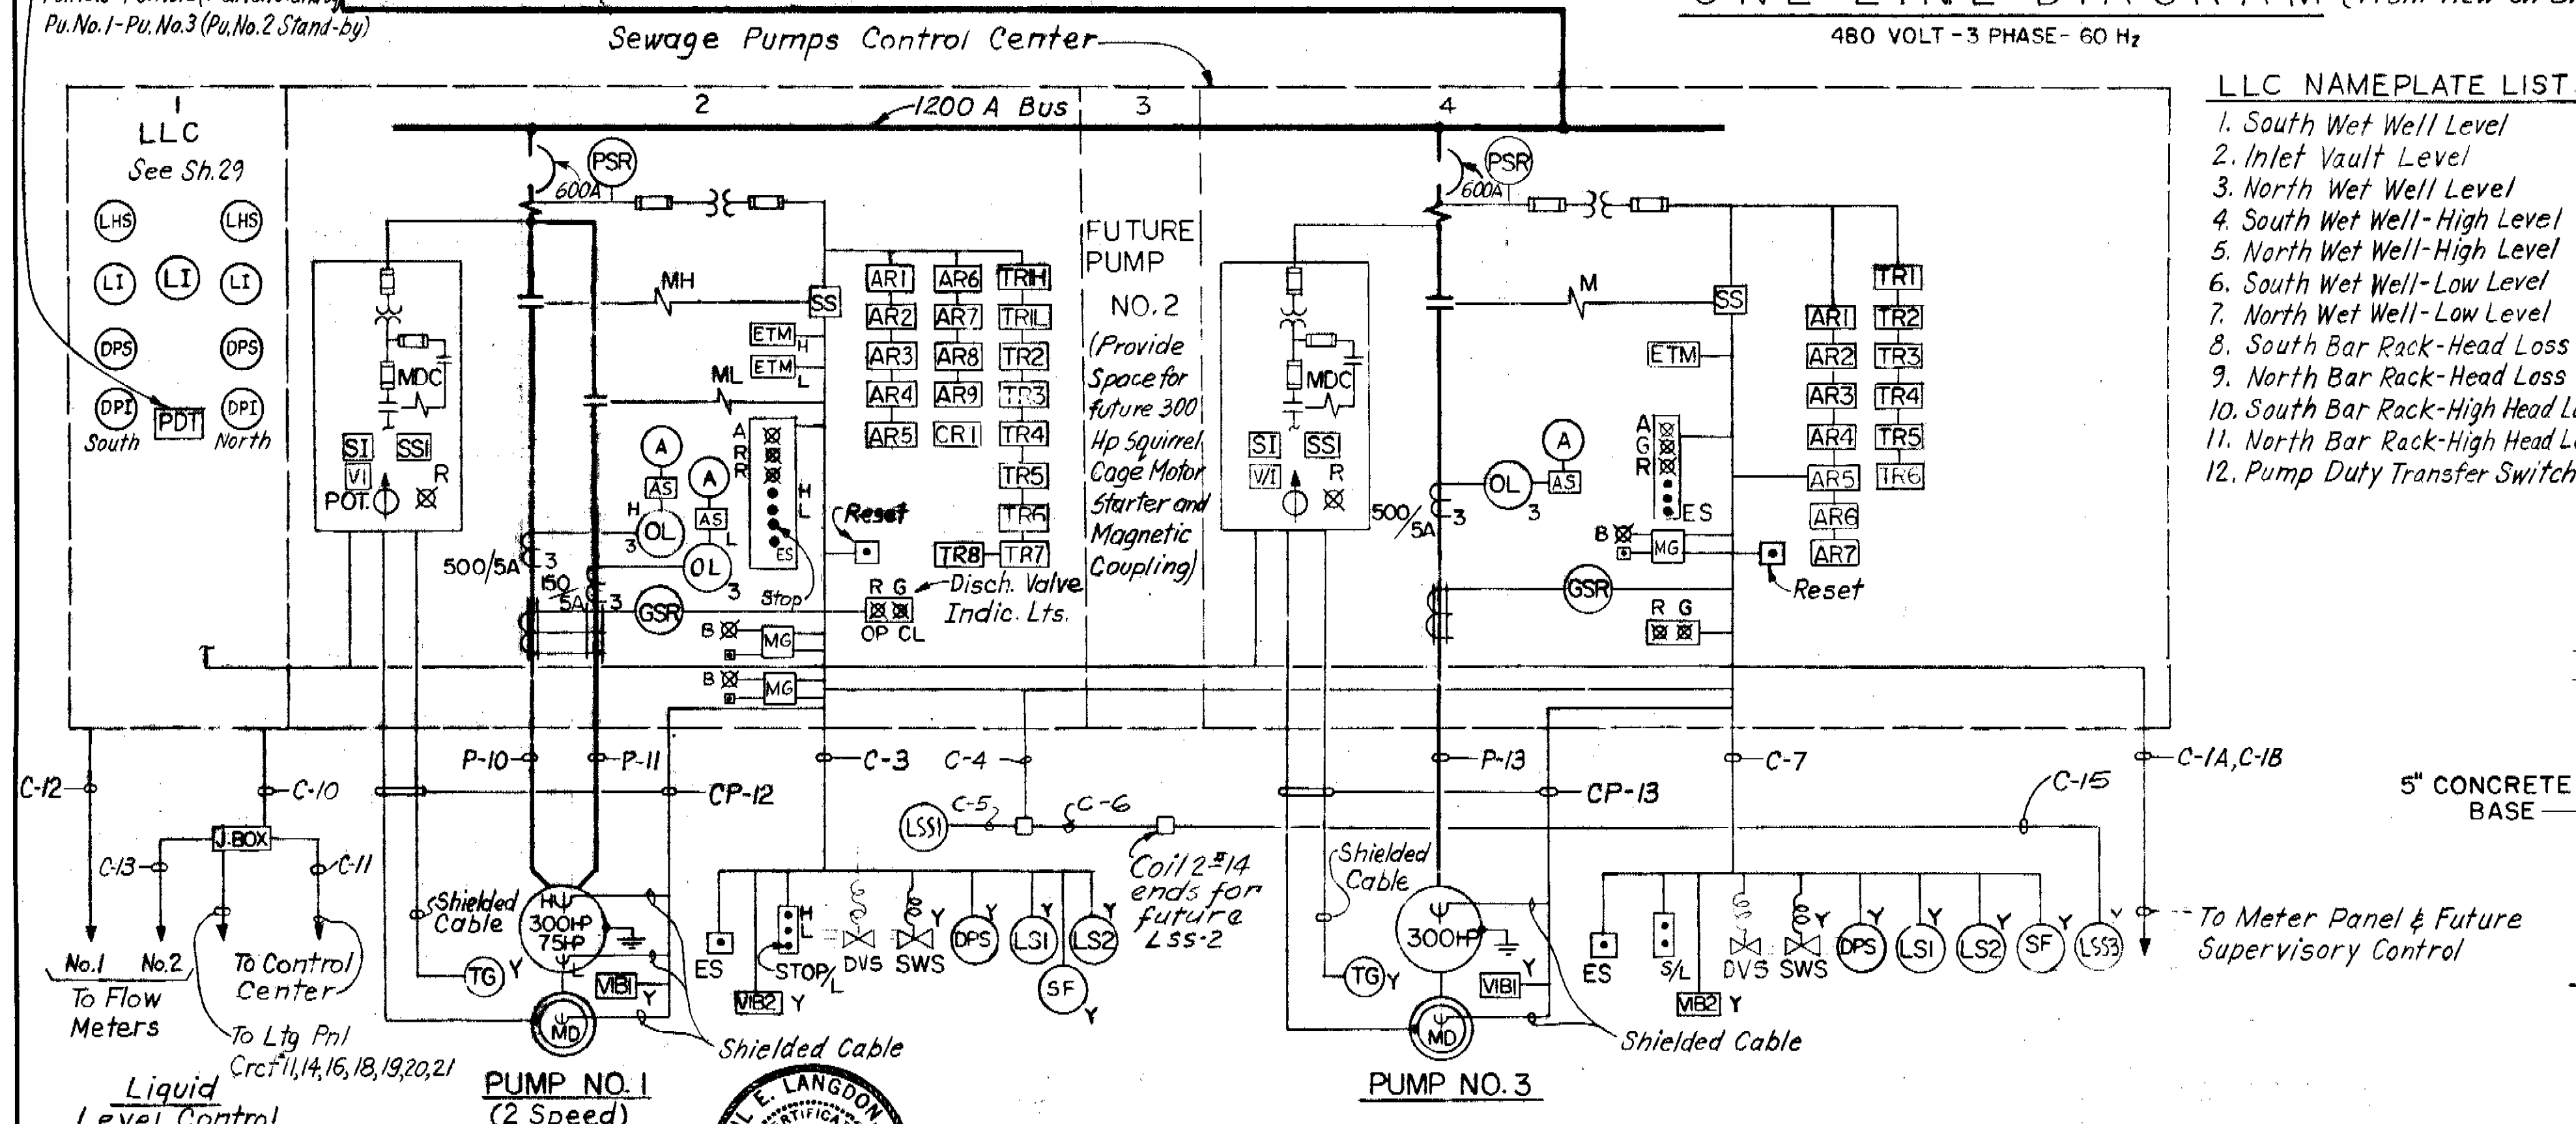


ONE LINE DIAGRAM

480 VOLT - 3 PHASE - 60 Hz

LLC NAMEPLATE LIST

1. South Wet Well Level
2. Inlet Vault Level
3. North Wet Well Level
4. South Wet Well - High Level
5. North Wet Well - High Level
6. South Wet Well - Low Level
7. North Wet Well - Low Level
8. South Bar Rack - Head Loss
9. North Bar Rack - Head Loss
10. South Bar Rack - High Head Loss
11. North Bar Rack - High Head Loss
12. Pump Duty Transfer Switch

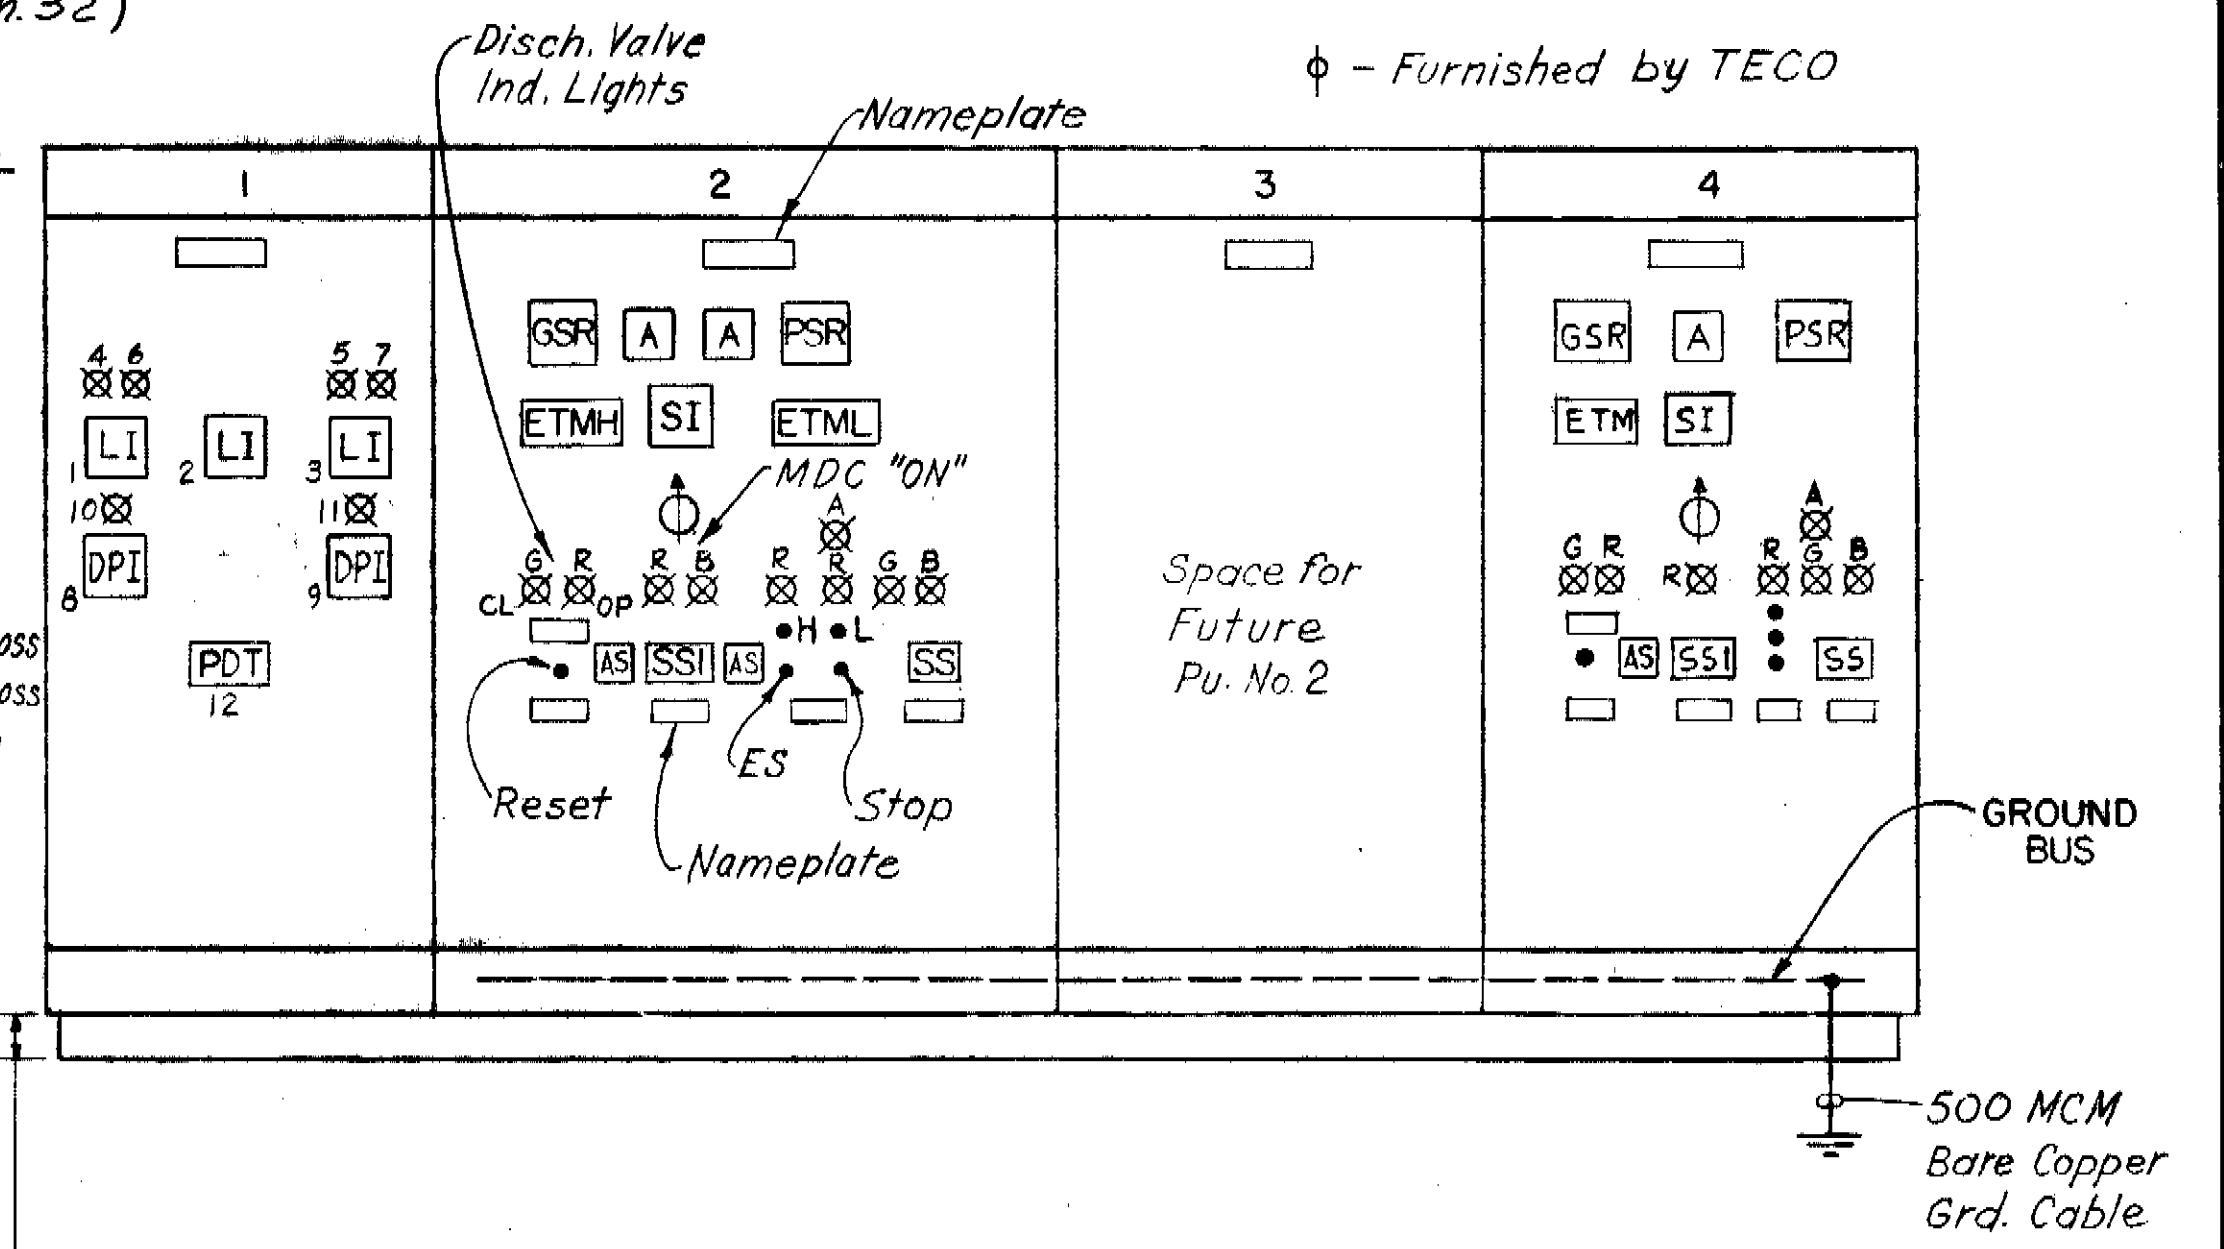

SEWAGE PUMPS CONTROL CENTER (Furnished with the Pumping Equipment)

FRONT VIEW NOT TO SCALE

NOTES:

1. Metering Cabinet furnished by TECO, installed on outdoor Wall by Contractor as shall be required by TECO.
2. Metering Compartment shall be in accordance with TECO Requirements and shall be approved by TECO.
3. Metering Instruments furnished by TECO for shop installation as directed by TECO. in outdoor Transformer and installed.
4. P-16 & C-19 required if Plug Valve is supplied.
5. ACB Rated 1200 A with 30,000 A Interrupting Rating at 480V

RECORD DRAWING

THIS RECORD DRAWING IS NOT WARRANTED BUT IS BELIEVED TO REPRESENT CONDITIONS UPON COMPLETION OF CONSTRUCTION, WITHIN REASONABLE TOLERANCES, BASED UPON THE INFORMATION FURNISHED TO THE ENGINEER PERTAINING TO CHANGES MADE DURING CONSTRUCTION.

GREELEY AND HANSEN ENGINEERS
 222 S. RIVERSIDE PLAZA
 CHICAGO, ILLINOIS 60606

DESIGNED KK
 DRAWN FS
 CHECKED OA, KK


3	10/81	DSH	Rec. Dwg. Revision
2	Dec. 78	SBV	Added Addendum No. 1
1	Aug. 78	JRP	Added ACB & Note 5
	Mar. 78	JRP	Plans Updated
NO.	DATE	APP.	REVISION

SCALE
 NO SCALE

CITY OF TAMPA, FLORIDA
 SEWAGE DISPOSAL SYSTEM
 DIVISION 463
 131 ST. AVENUE PUMPING STATION


ELECTRICAL
 ONE LINE DIAGRAMS

PROJ. NO. S202-70-30D-7-463
 SHEET 26 OF 35
 DATE: AUGUST, 1972 REV. 3

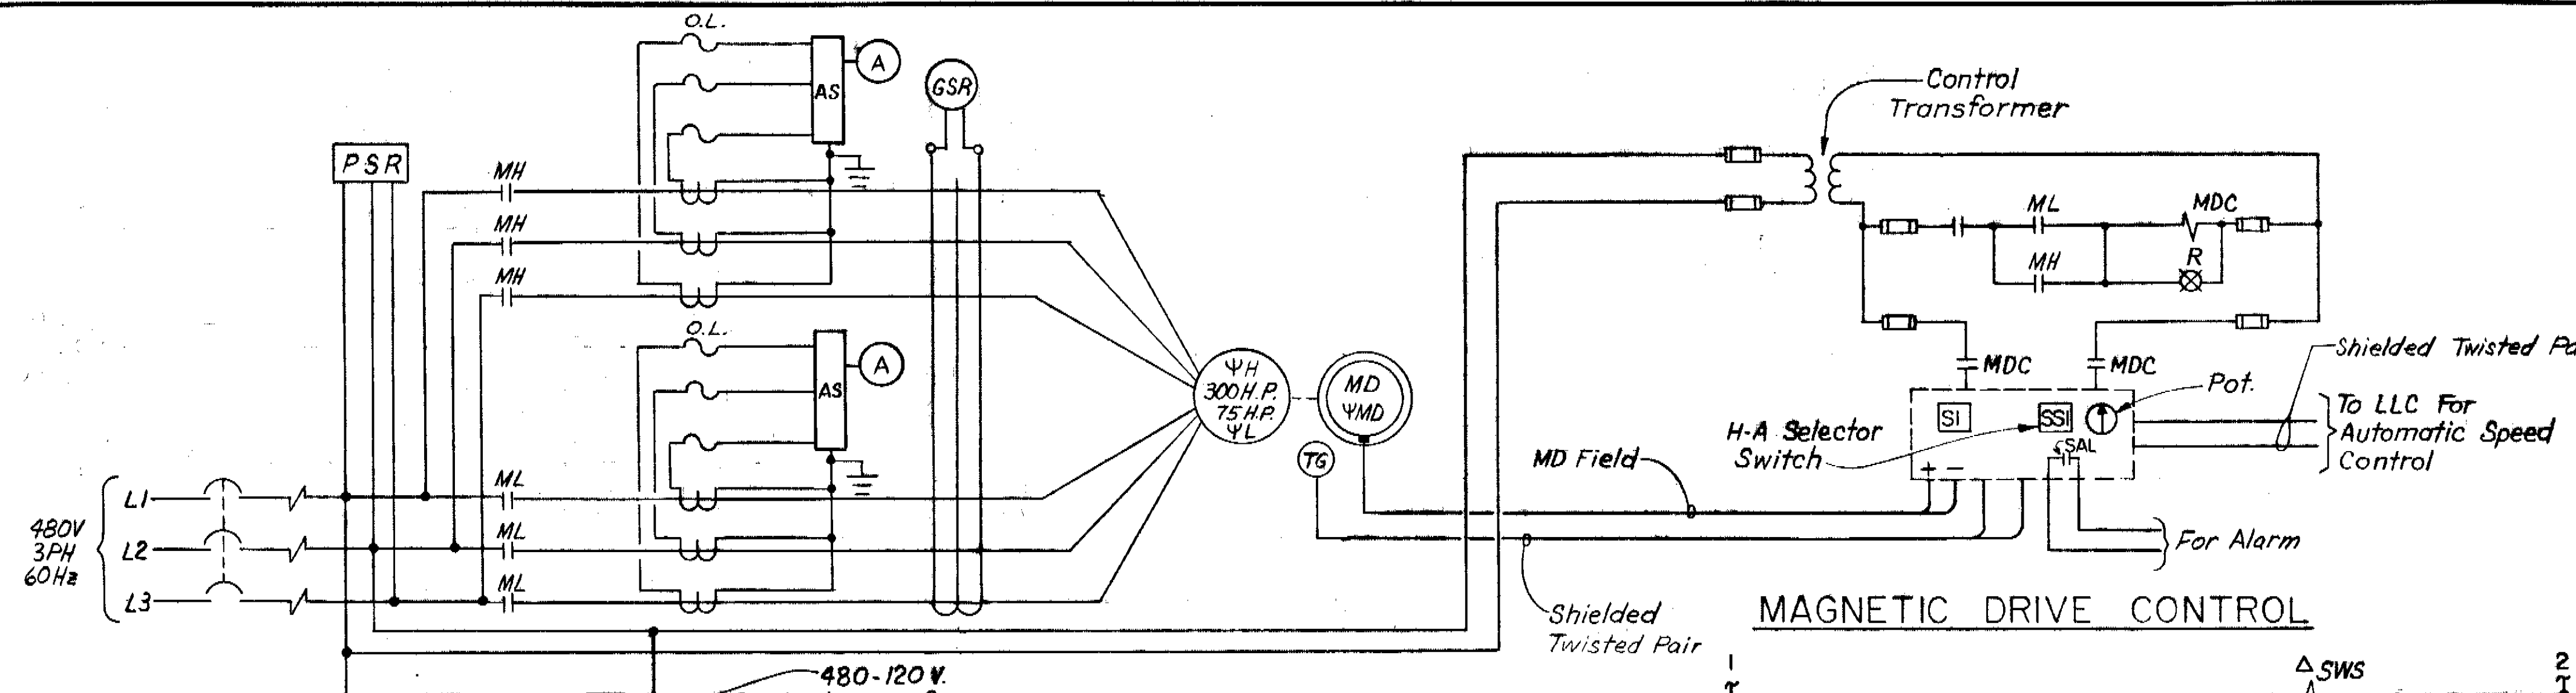


SS DEVELOPMENT		
Contact	Hand	Auto.
1	x	
2		x
3	x	
4		x
5	x	
6		x
7	x	
8		x

MAGNETIC DRIVE CONTROL

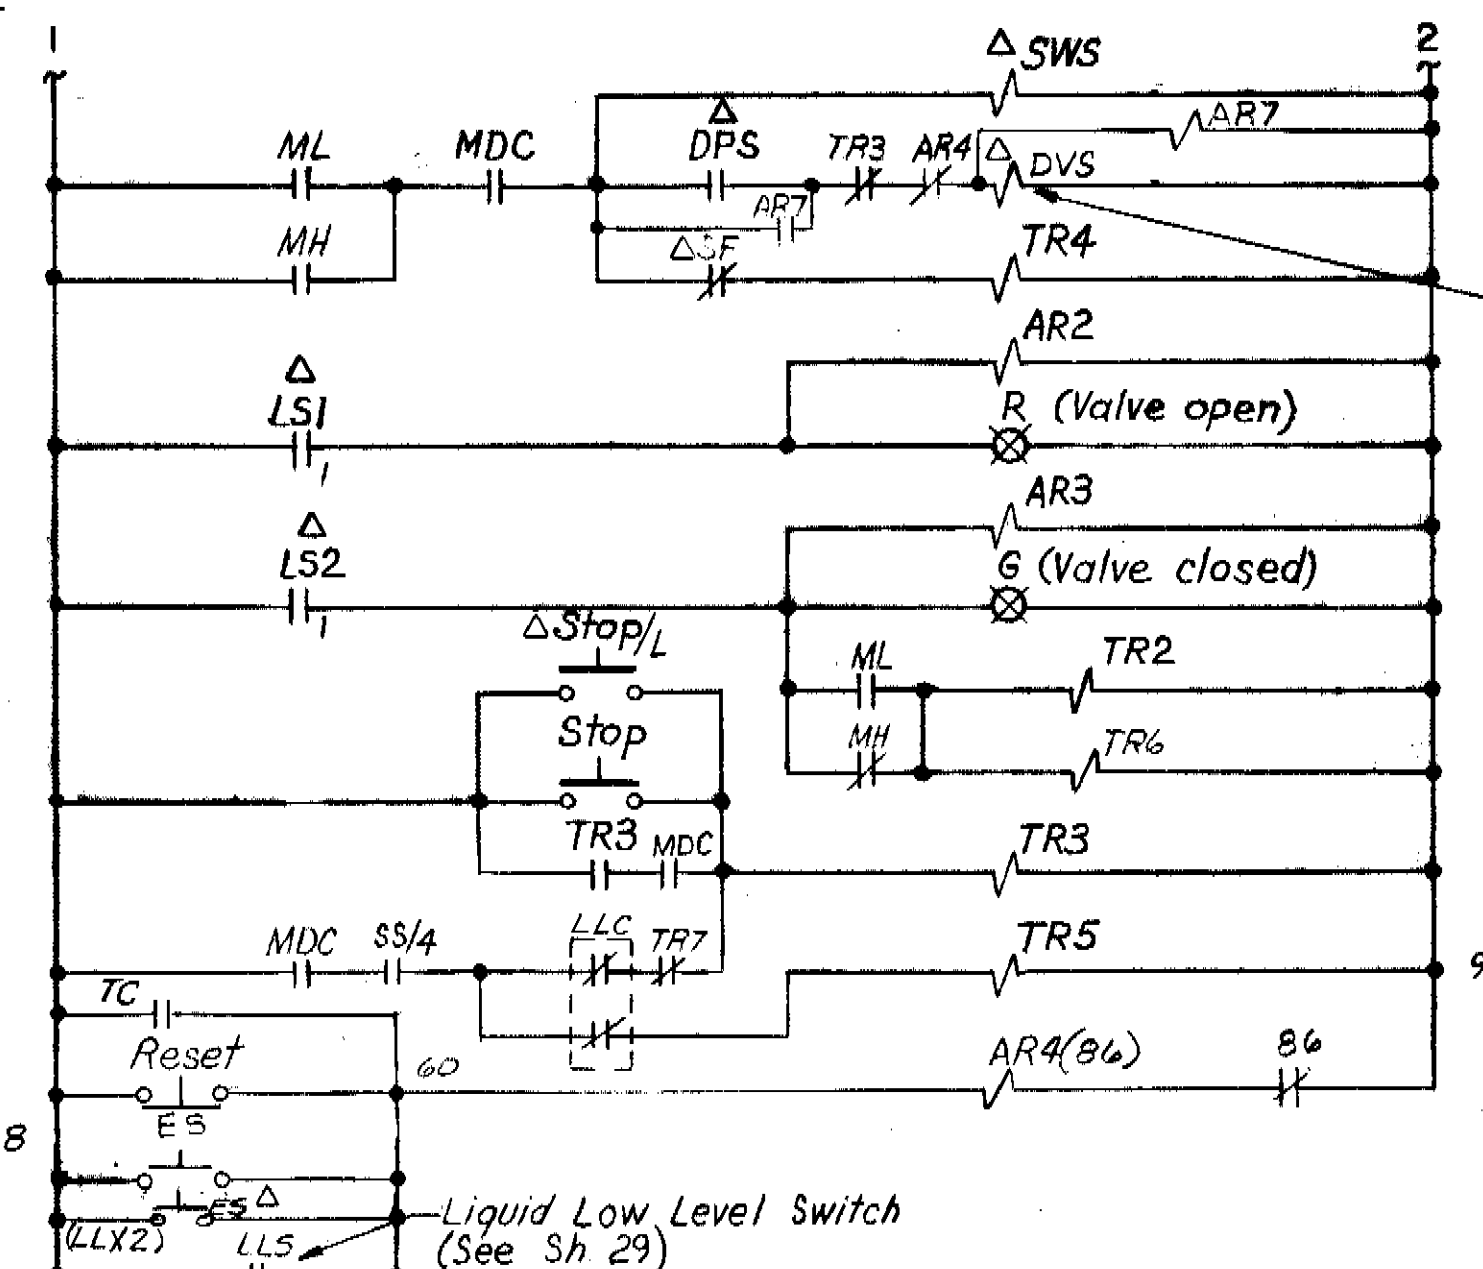

LS	Contact	DISCHARGE VALVE POSITION		
		Fully Closed	Intermed. Position	Fully Open
LS1	1		x	x
	2	x		
	3		x	x
	4	x		
LS2	1	x	x	
	2			x
	3	x	x	
	4			x

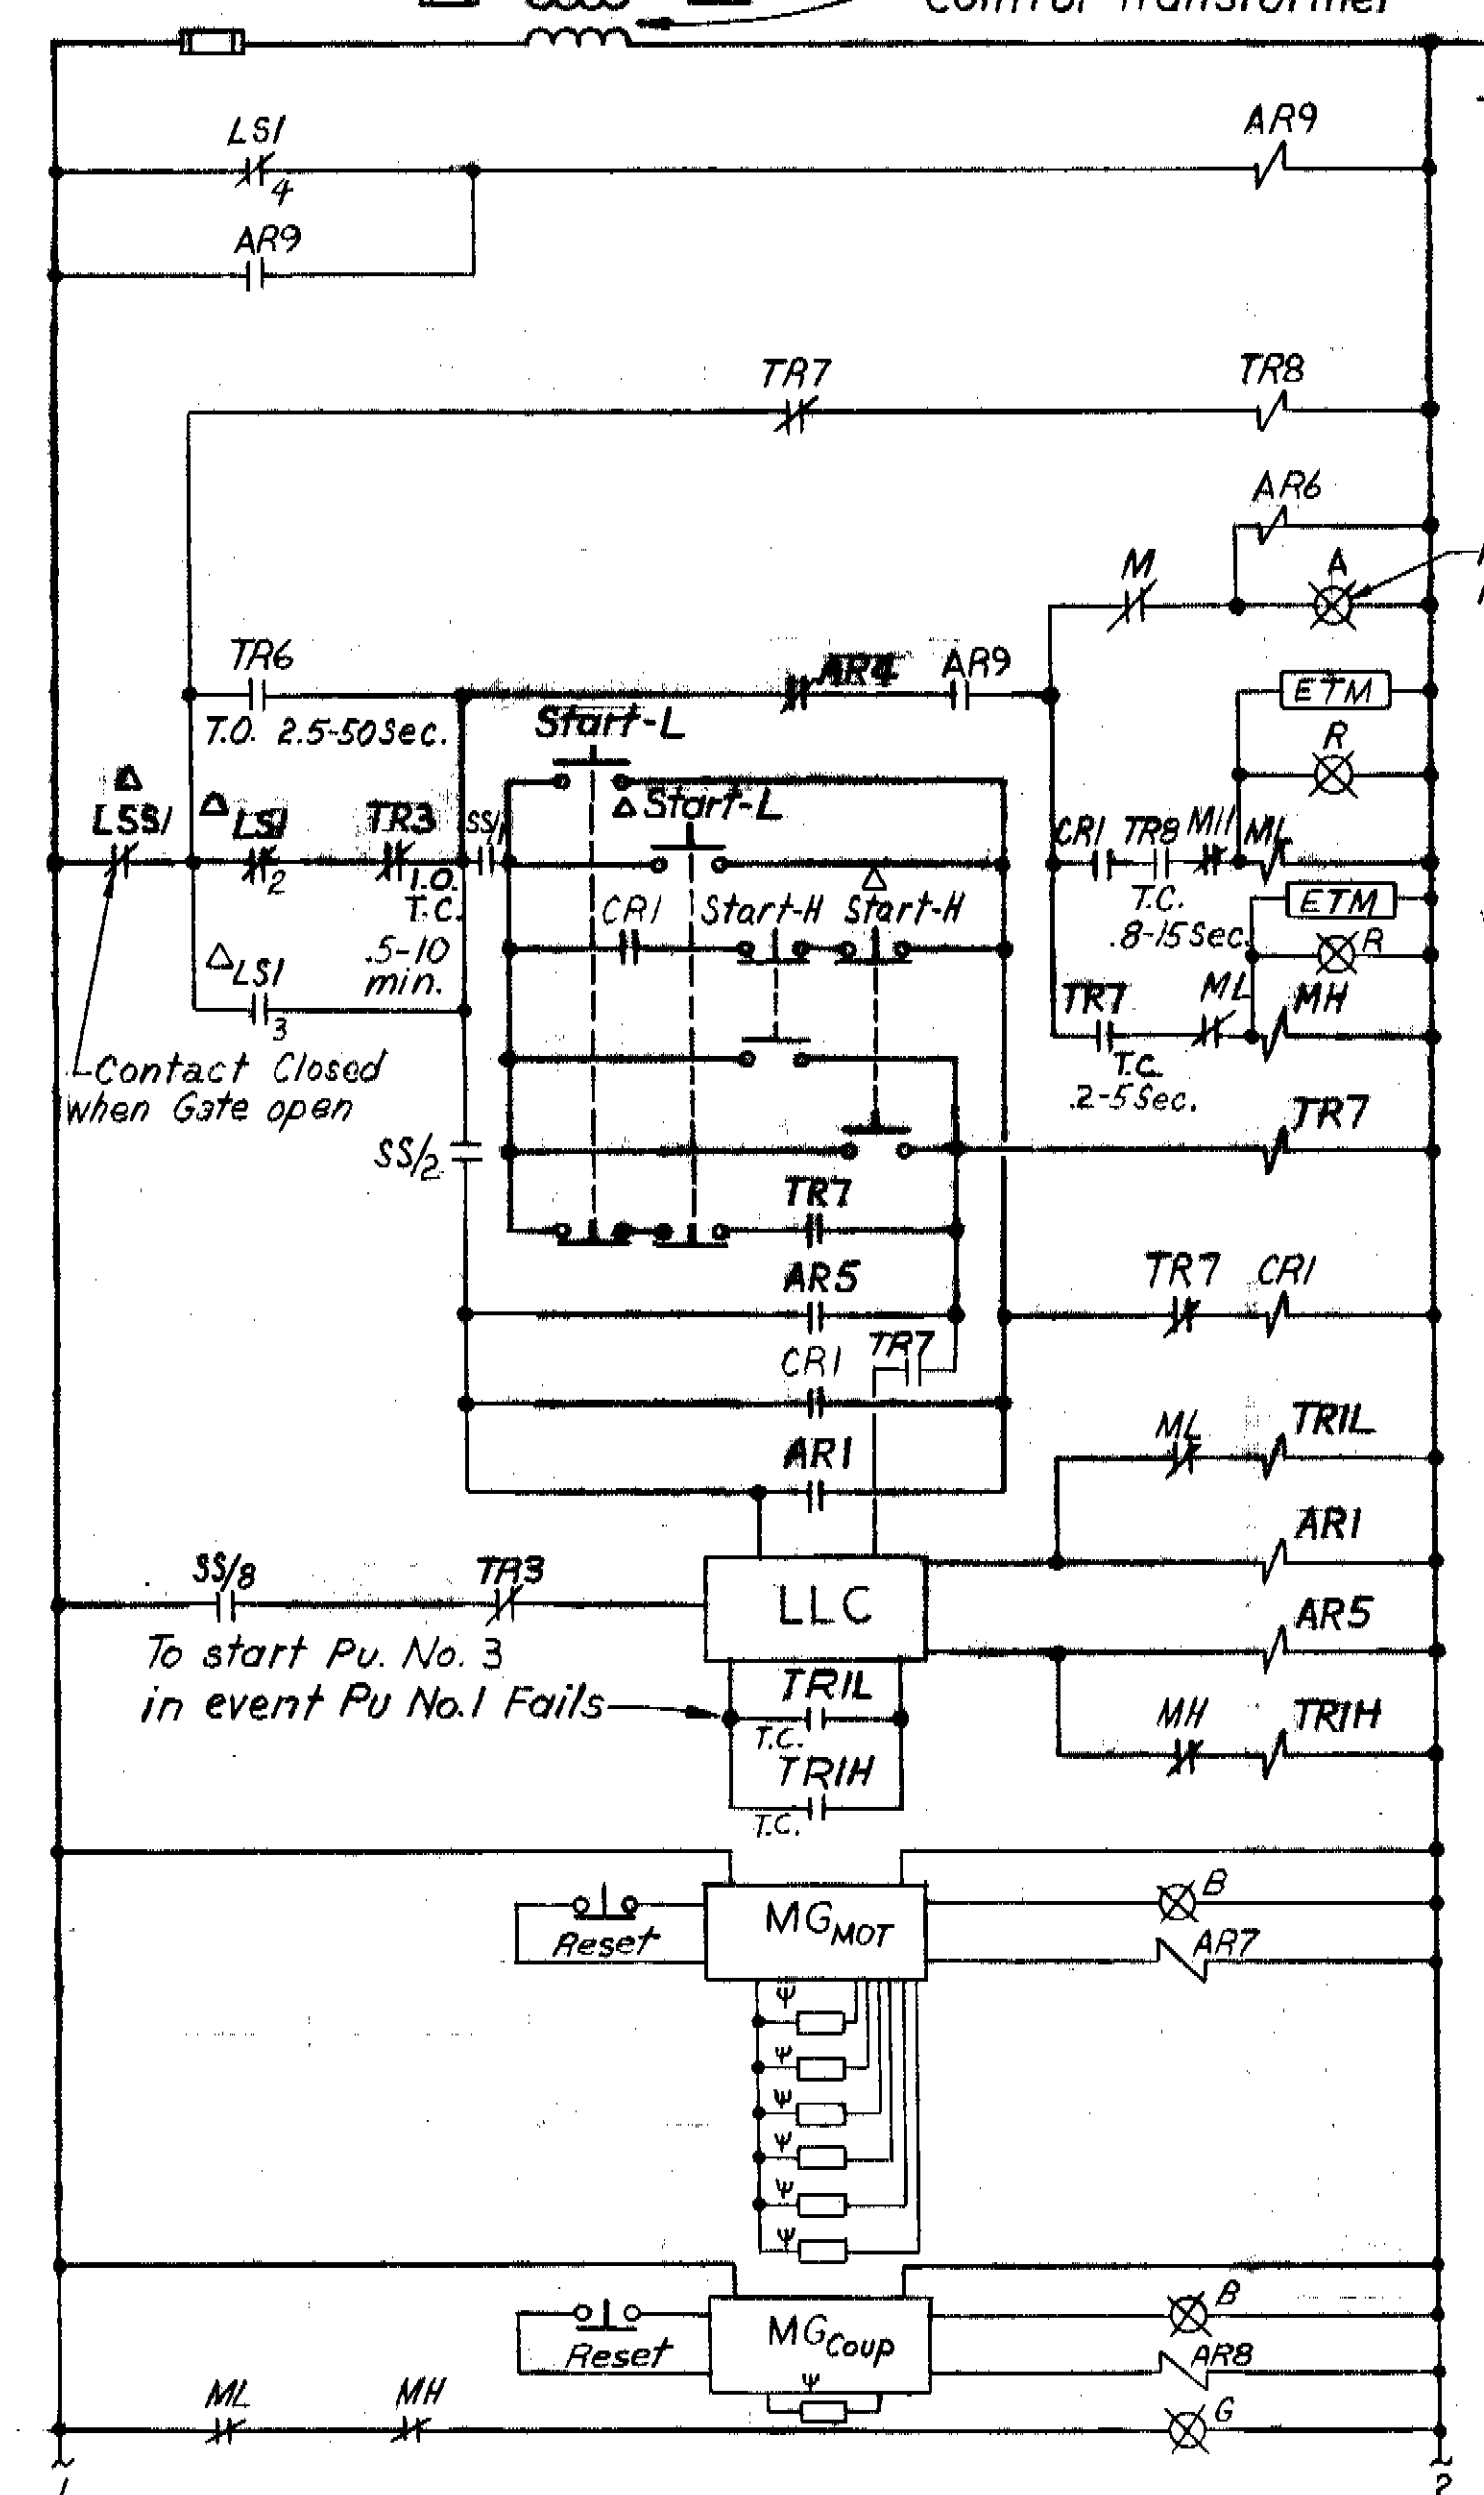


- TR4 T.C. 2.5-50 Sec. Seal Water Failure to Annunciator
- MDC To Seal Water Pump Control
- TR2 T.C. 5-10 Min. Pump Discharge Valve Failure to Annunciator
- SAL = AR4 = TRIL = TRIH T.C. 0.8-1.5 Sec. 0.8-1.5 Sec. Pump Failure to Annunciator


PUMP NO. 1 SCHEMATIC CONTROL DIAGRAM

- OLL(3) * C9
- OLH(3) * C10
- AR7(STX) C11
- AR8(DAT) * C17
- PSR C12
- (GFR) GSR * C12
- TR2 (T7) T.C. 5-10 Min. (Valve Closed)
- TR5(T4) T.C. 5-10 Min. Coupling Failure
- VIB1(MOT) * C18
- VIB2 PU * C19

Contacts Noted (*), Individually wired to Remote Mounting Cubicle and back to Trouble Contact (TC) via Meter Panel.

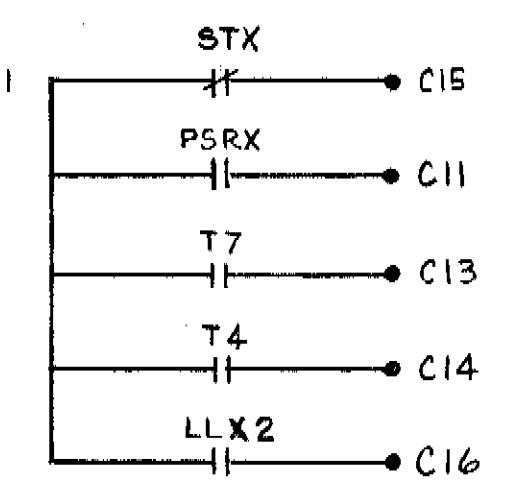


To Remote Monitoring Unit for Annunciation of Pump Shut Down Alarms.

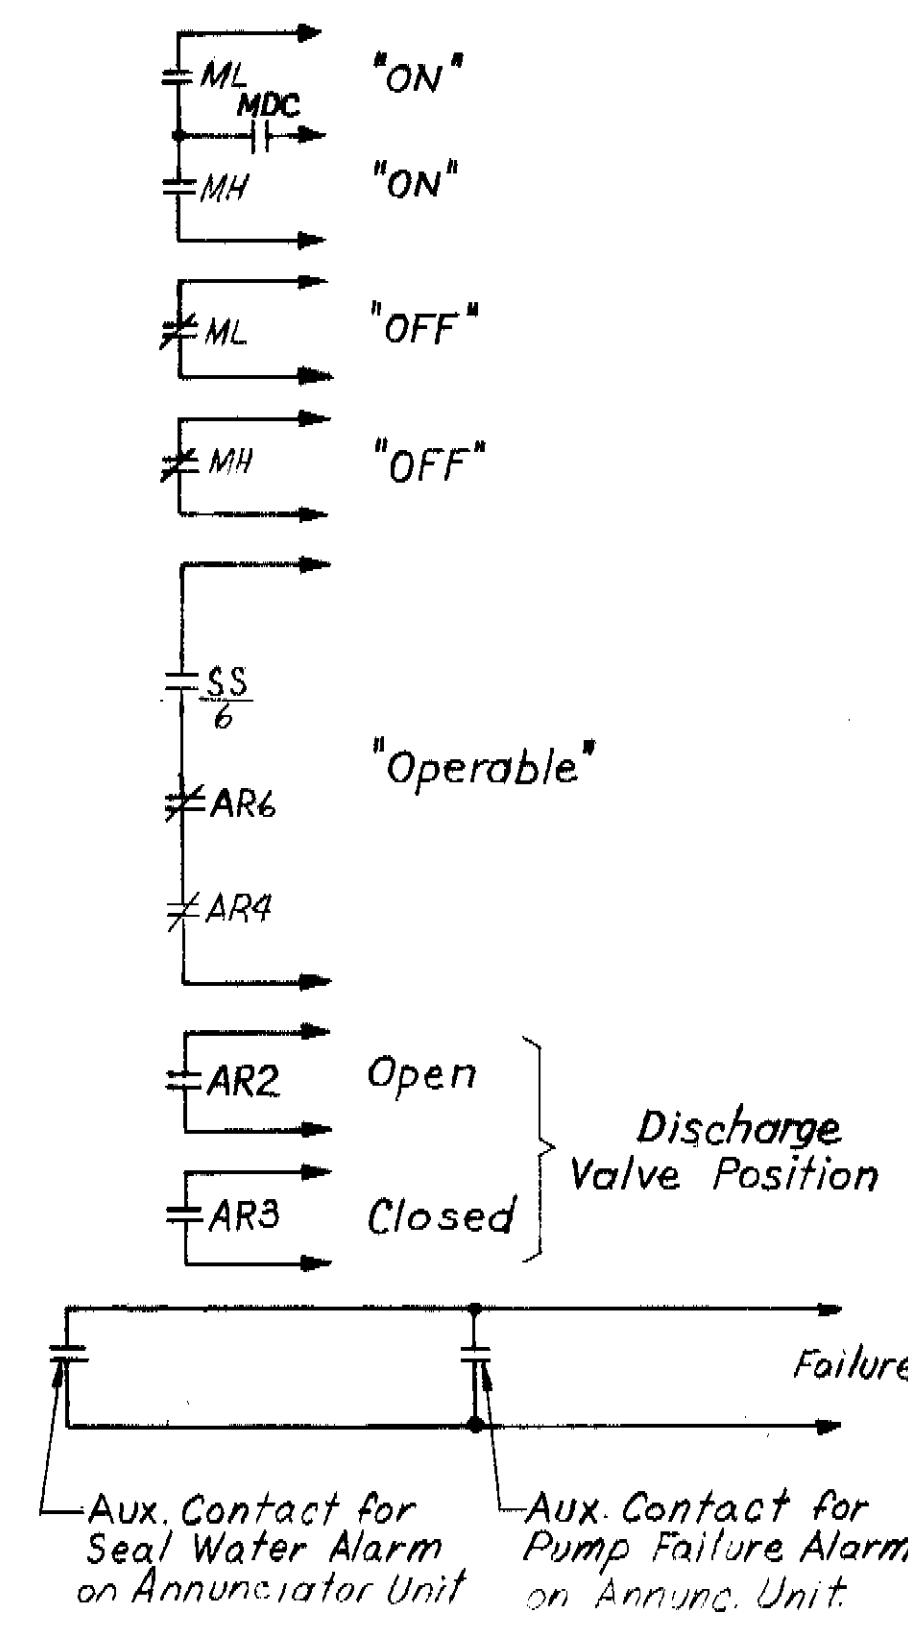

Δ - Located at the Pump

Continuation at Right

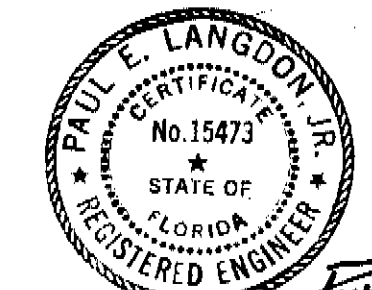

NOTE: ALL ELEVATIONS SHOWN ARE REFERENCED TO CITY OF TAMPA DATUM. TO CONVERT TO NATIONAL OCEAN SURVEY (NOS) DATUM, SUBTRACT 0.15 FEET (0'-1 13/16").

RECORD DRAWING THIS RECORD DRAWING IS NOT WARRANTED BUT IS BELIEVED TO REPRESENT CONDITIONS UPON COMPLETION OF CONSTRUCTION WITHIN REASONABLE TOLERANCES, BASED UPON THE INFORMATION FURNISHED TO THE ENGINEER PERTAINING TO CHANGES MADE DURING CONSTRUCTION.

GREELEY AND HANSEN ENGINEERS
222 S. RIVERSIDE PLAZA
CHICAGO, ILLINOIS 60606

DESIGNED KK OA
DRAWN FS
CHECKED OA

APPROVED
DATE
Supt., Dept. of Sanitary Sewers
DATE
GREELEY AND HANSEN, ENGINEERS

NO.	DATE	APP.	REVISION
1	10/31	DSH	Rec. Dwg. Revisions
	Mar 18	JRP	Plans Updated


SCALE
NO SCALE

CITY OF TAMPA, FLORIDA
SEWAGE DISPOSAL SYSTEM
DIVISION 463
131 ST. AVENUE PUMPING STATION



**ELECTRICAL
SEWAGE PUMP NO. 1 CONTROL**

PROJ. NO. S 202-70-30D-7-463
SHEET 27 of 35
DATE AUGUST, 1972 REV. 1

173-64

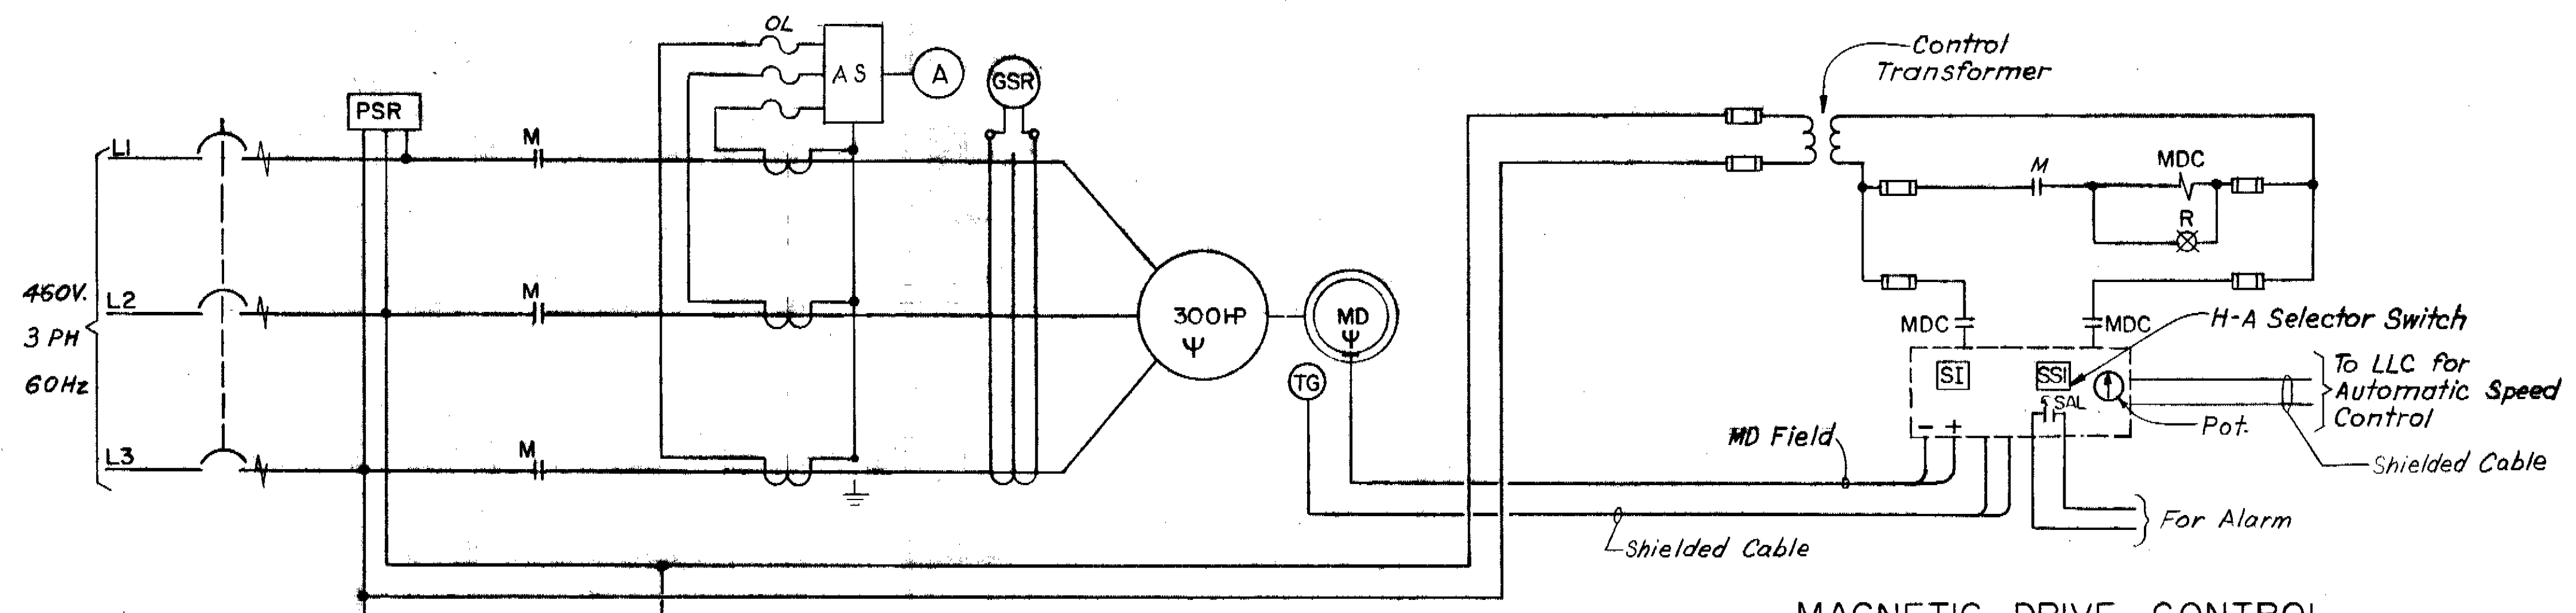


MAGNETIC DRIVE CONTROL

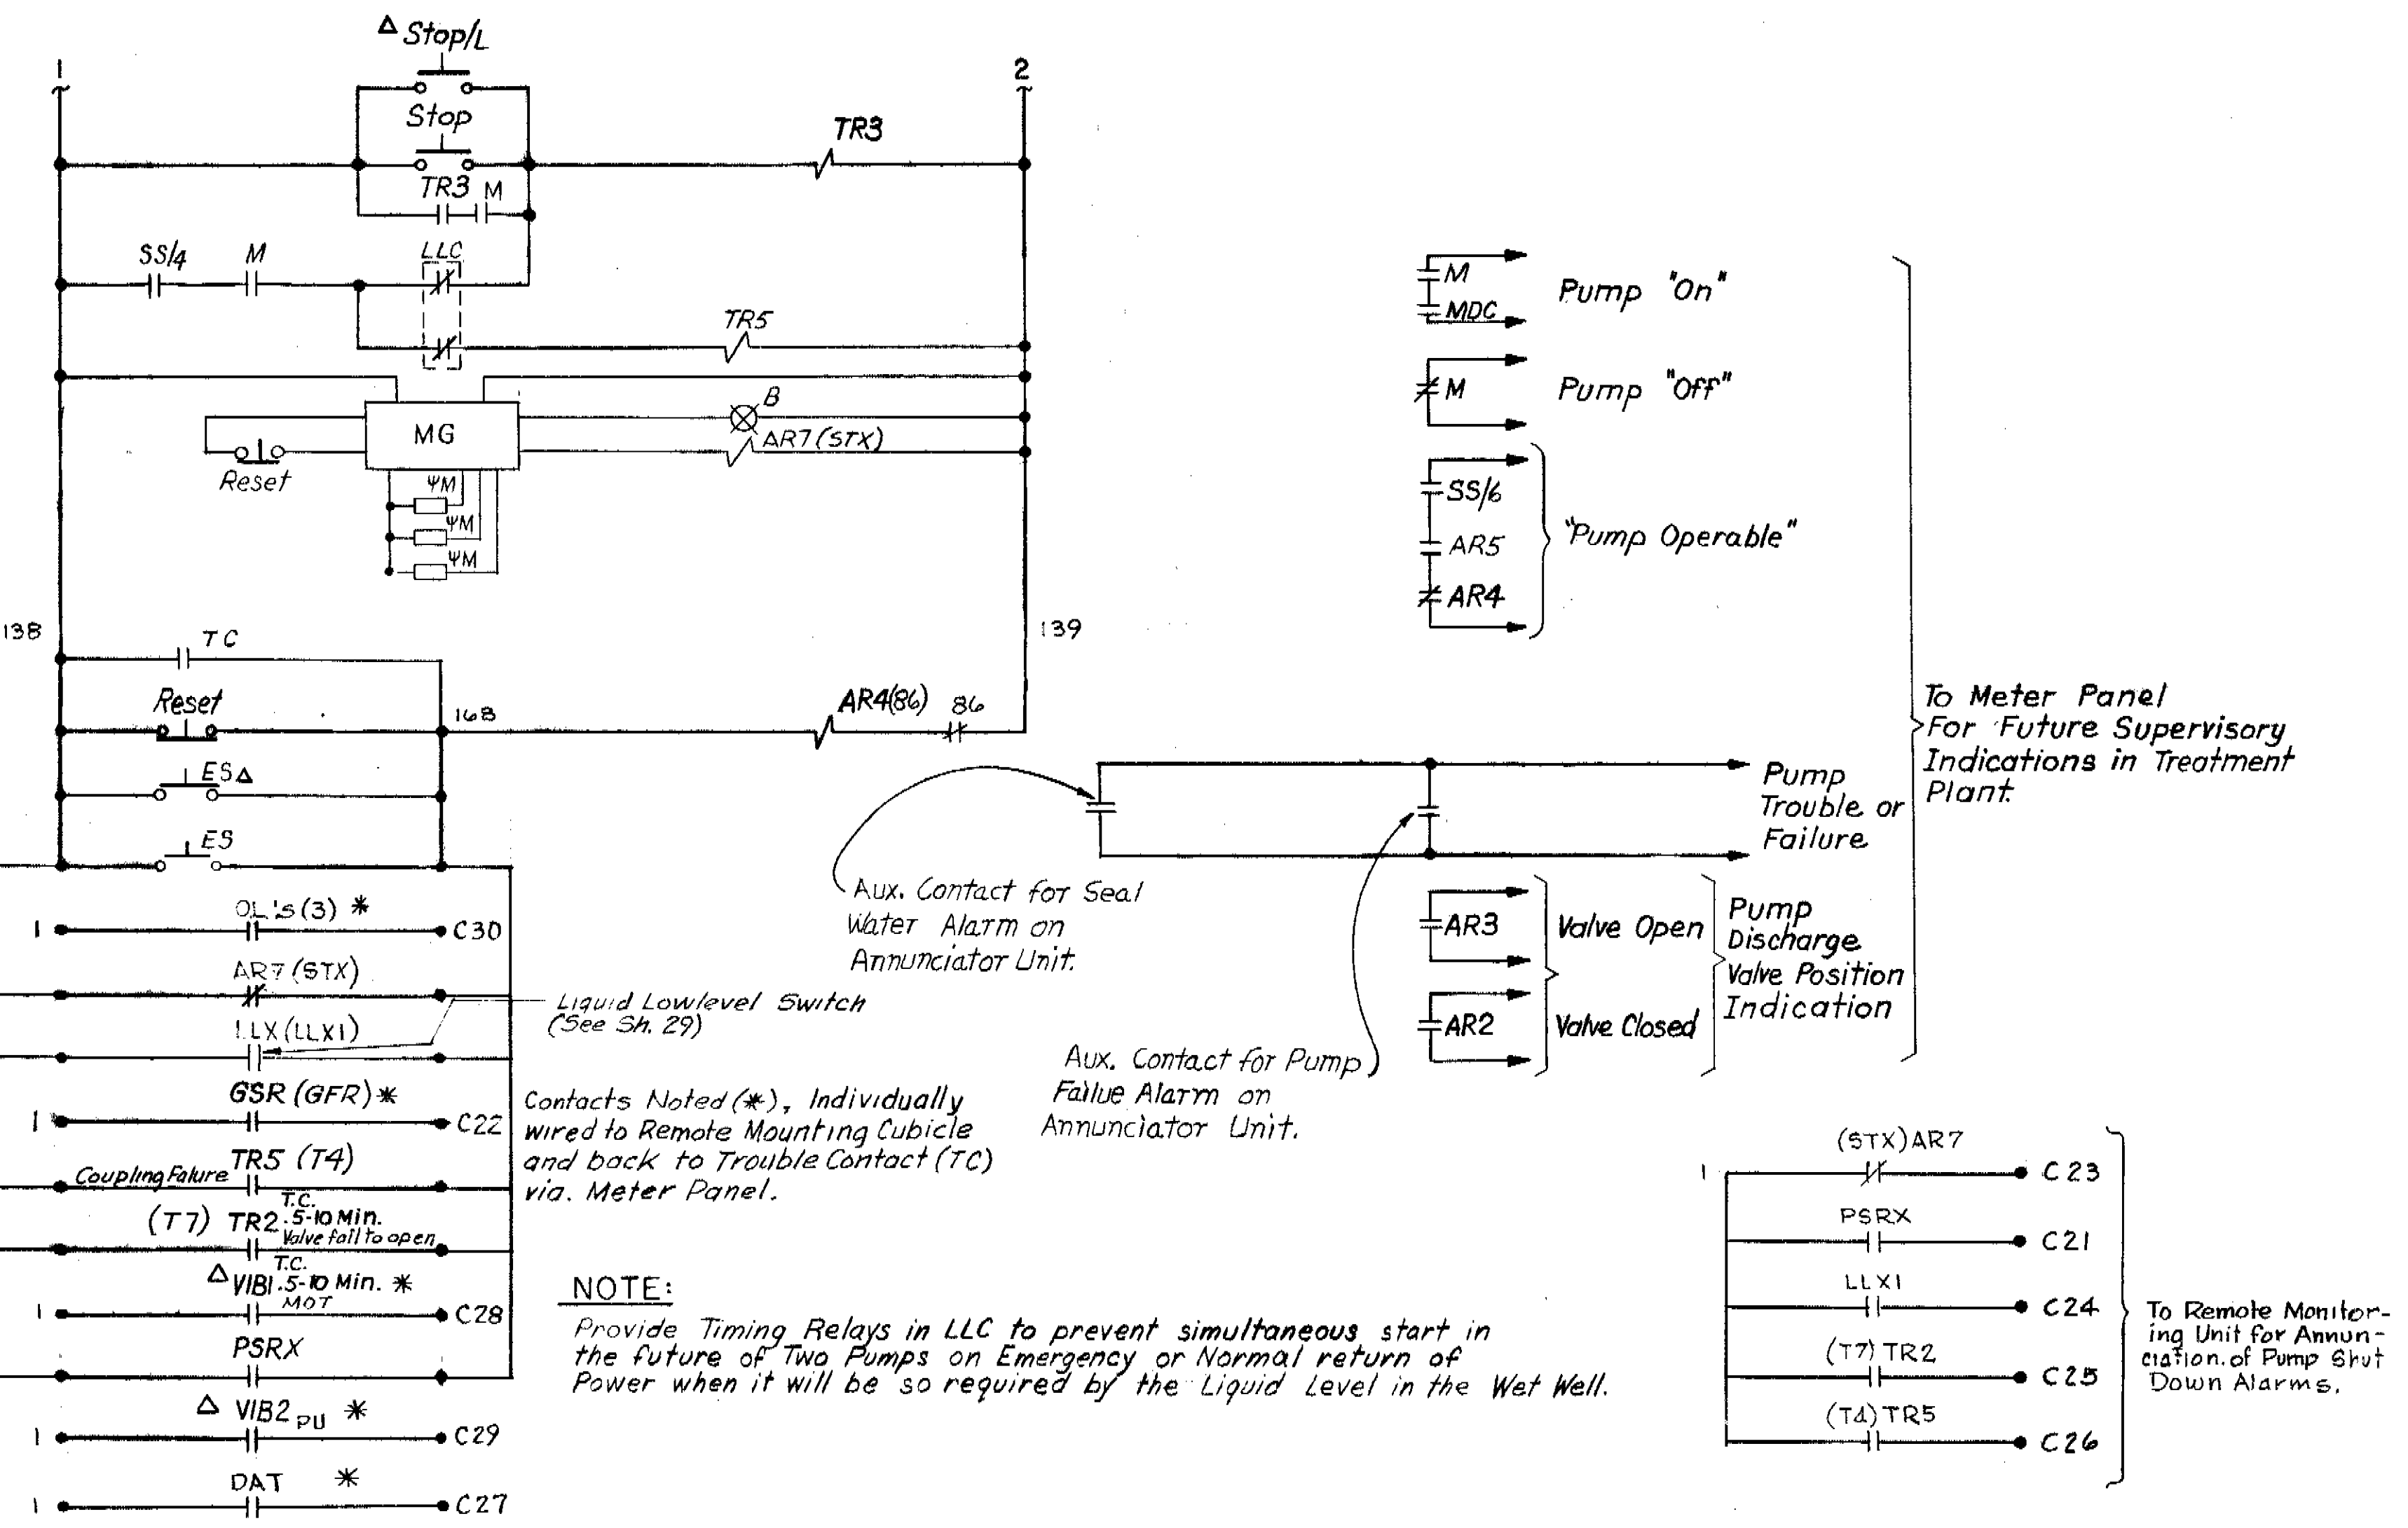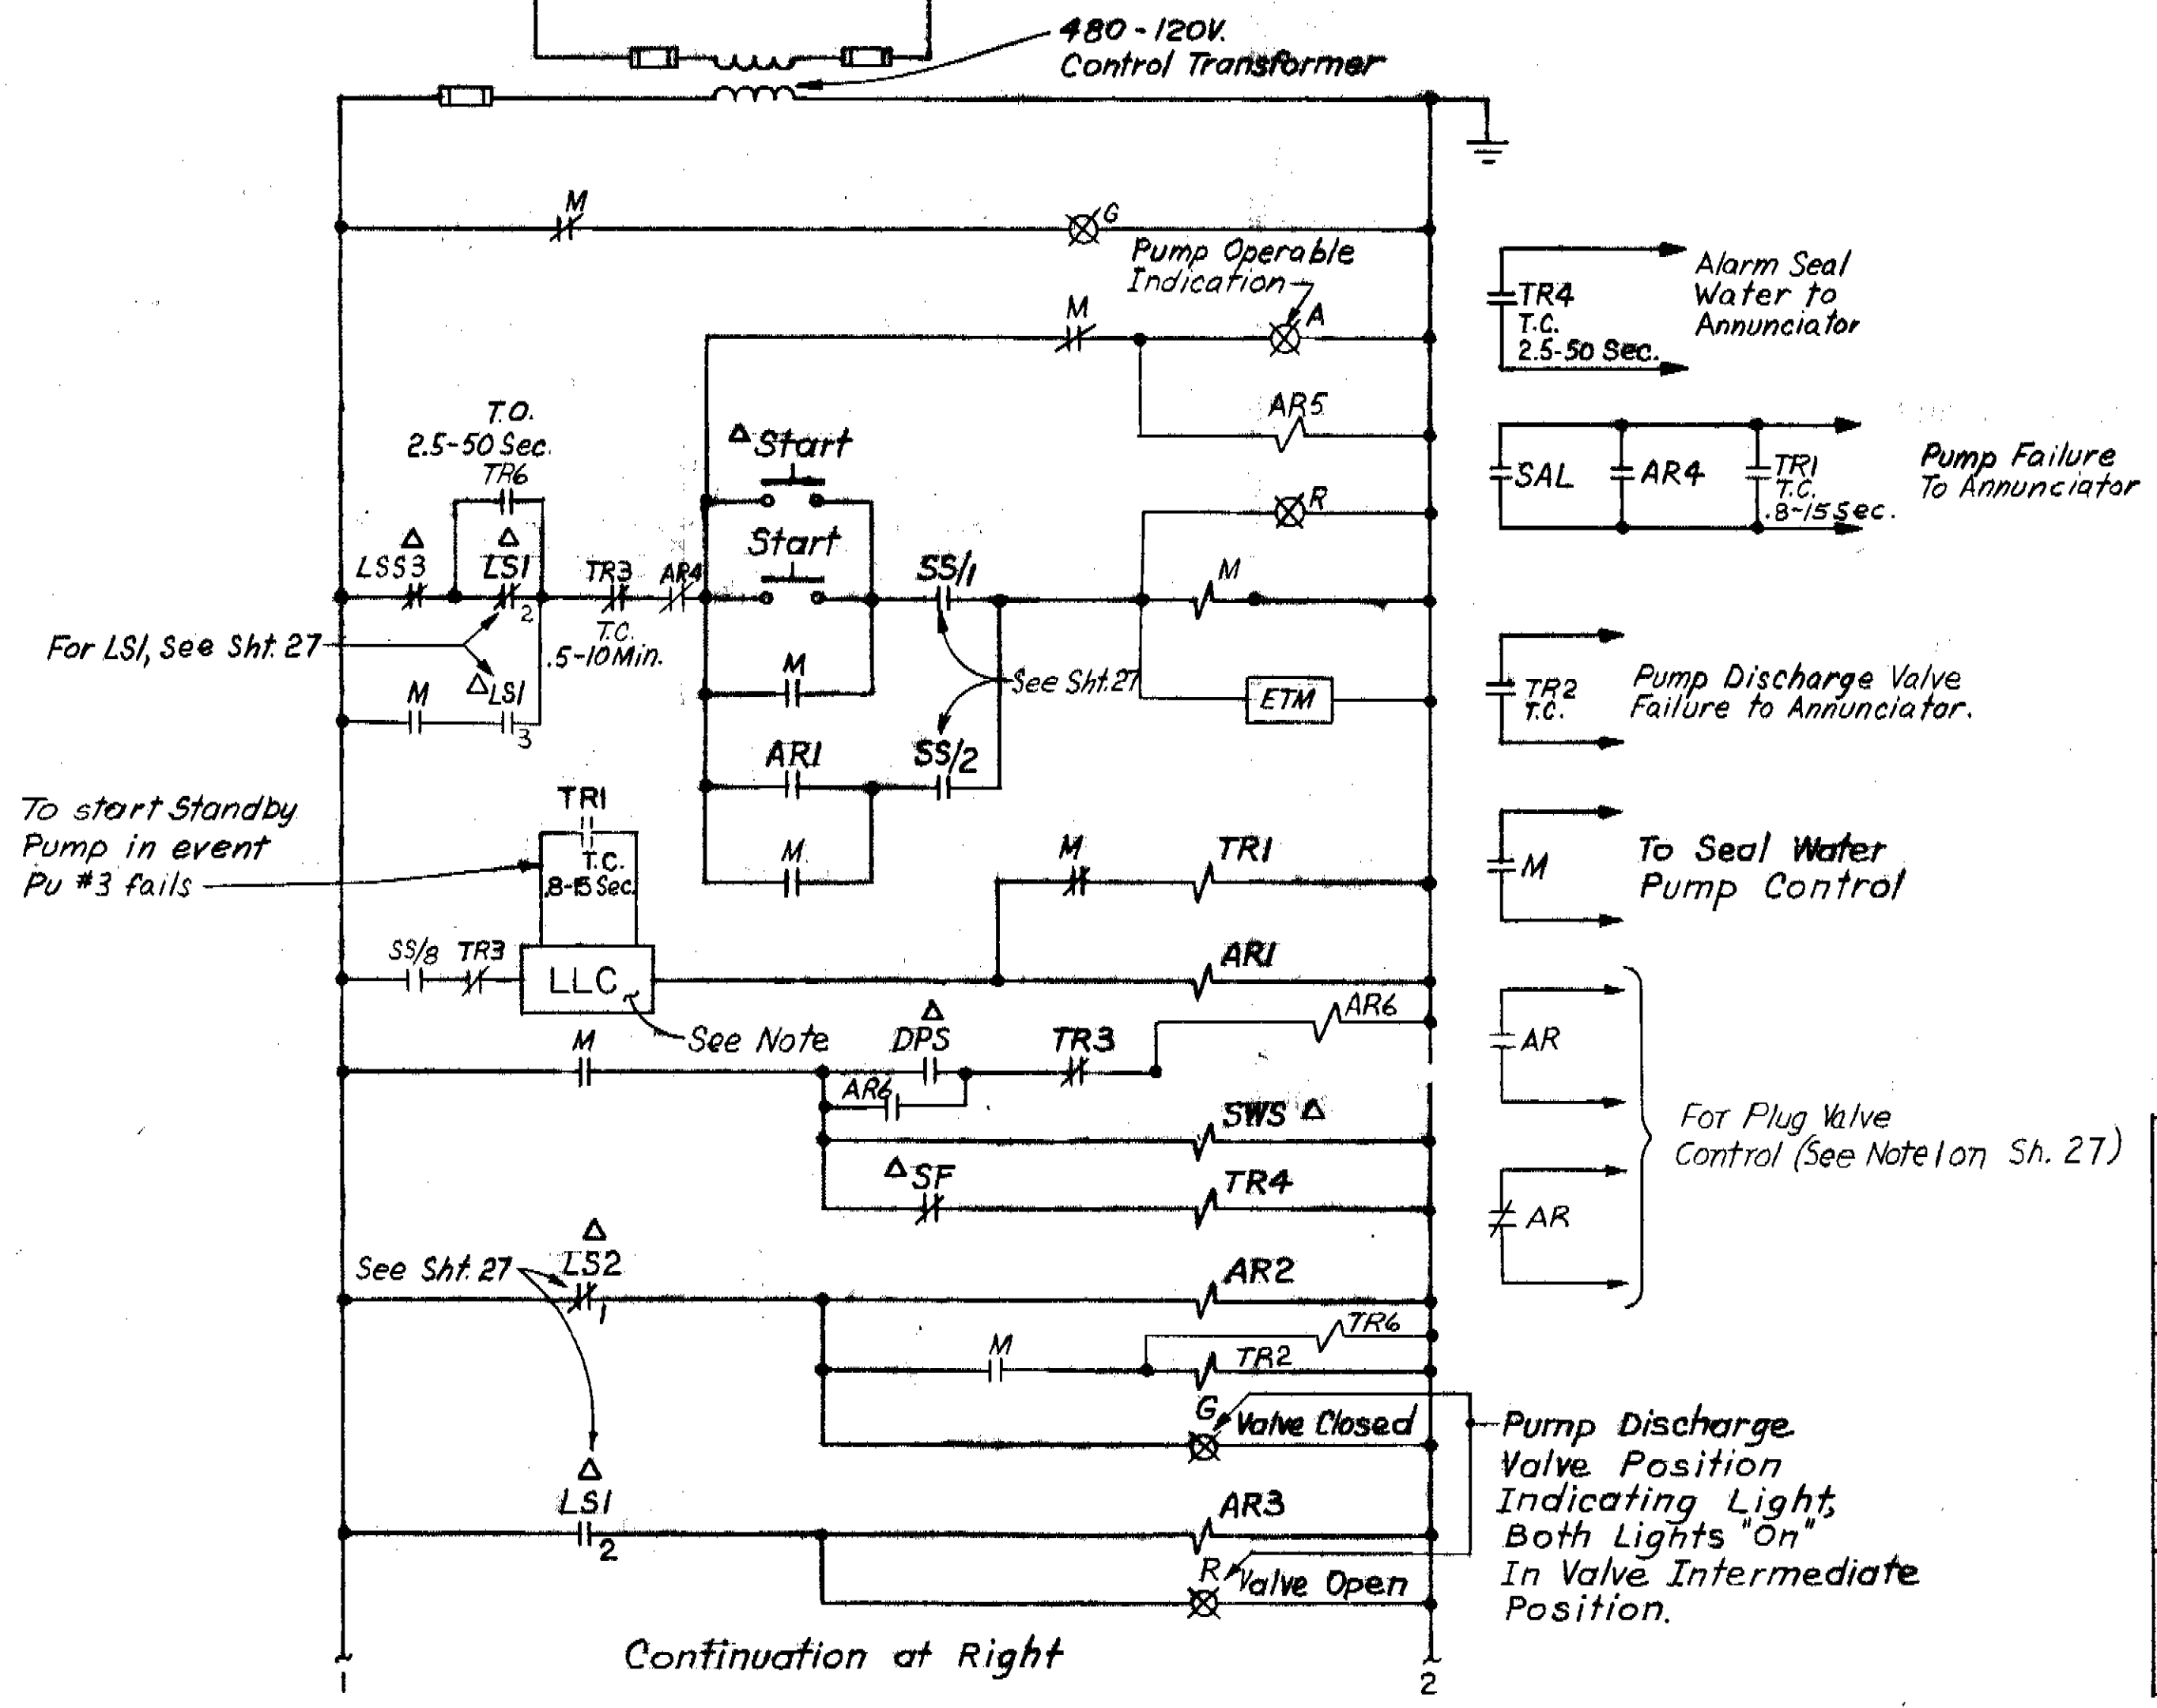

NOTE: Provide Timing Relays in LLC to prevent simultaneous start in the future of Two Pumps on Emergency or Normal return of Power when it will be so required by the Liquid Level in the Wet Well.

PUMP NO.3 SCHEMATIC CONTROL DIAGRAM

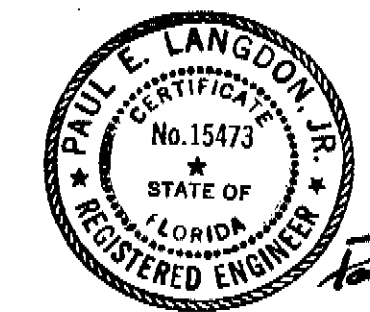

Paul C. Langdon

NOTE: ALL ELEVATIONS SHOWN ARE REFERENCED TO CITY OF TAMPA DATUM. TO CONVERT TO NATIONAL OCEAN SURVEY (NOS) DATUM, SUBTRACT 0.15 FEET (0'-1 13/16").

RECORD DRAWING

THIS RECORD DRAWING IS NOT WARRANTED BUT IS BELIEVED TO REPRESENT CONDITIONS UPON COMPLETION OF CONSTRUCTION, WITHIN REASONABLE TOLERANCES, BASED UPON THE INFORMATION FURNISHED TO THE ENGINEER PERTAINING TO CHANGES MADE DURING CONSTRUCTION.

GREELEY AND HANSEN ENGINEERS
222 S. RIVERSIDE PLAZA
CHICAGO, ILLINOIS 60606

DESIGNED K.K., O.A.
DRAWN FS
CHECKED O.A.

APPROVED _____
DATE _____
Supt., Dept. of Sanitary Sewers
GREELEY AND HANSEN, ENGINEERS

NO.	DATE	APP.	REVISION
2	10/91	D.S.H.	Rec. Dwg. Revisions
1	Dec. 78	J.P.V.	Added Addendum No. 1
	Mar. 78	J.R.P.	Plans Updated











SCALE
NO SCALE

CITY OF TAMPA, FLORIDA
SEWAGE DISPOSAL SYSTEM
DIVISION 463
131 ST. AVENUE PUMPING STATION

ELECTRICAL
SEWAGE PUMP NO. 3 CONTROL

PROJ. NO. S 202-70-30D-7-463
SHEET 28 of 35
DATE AUGUST, 1972 REV. 2

173-45

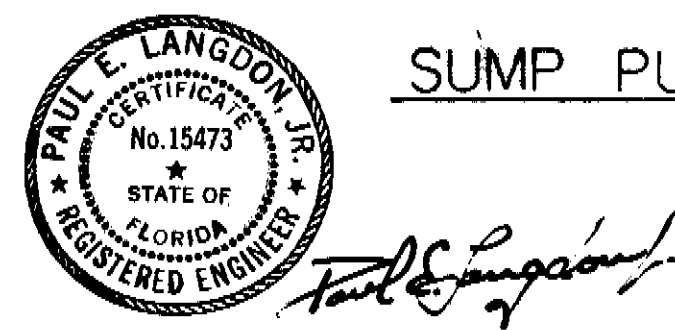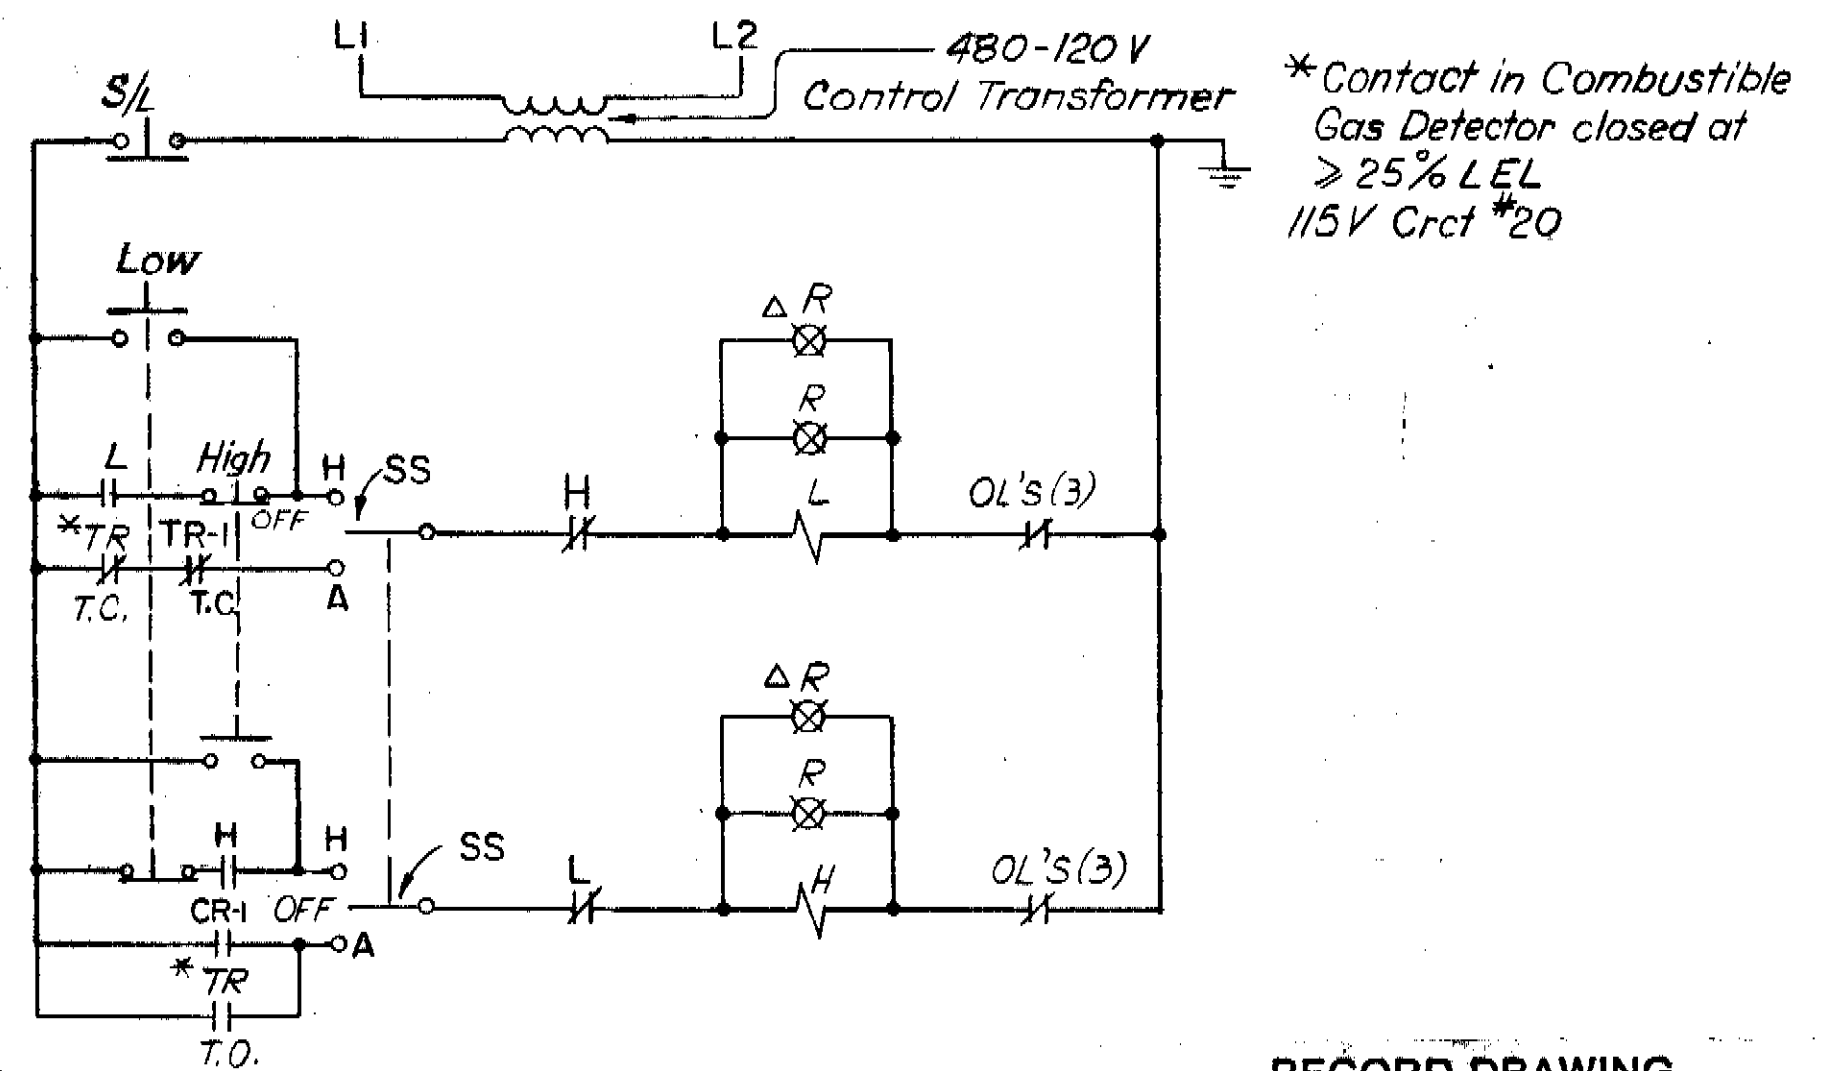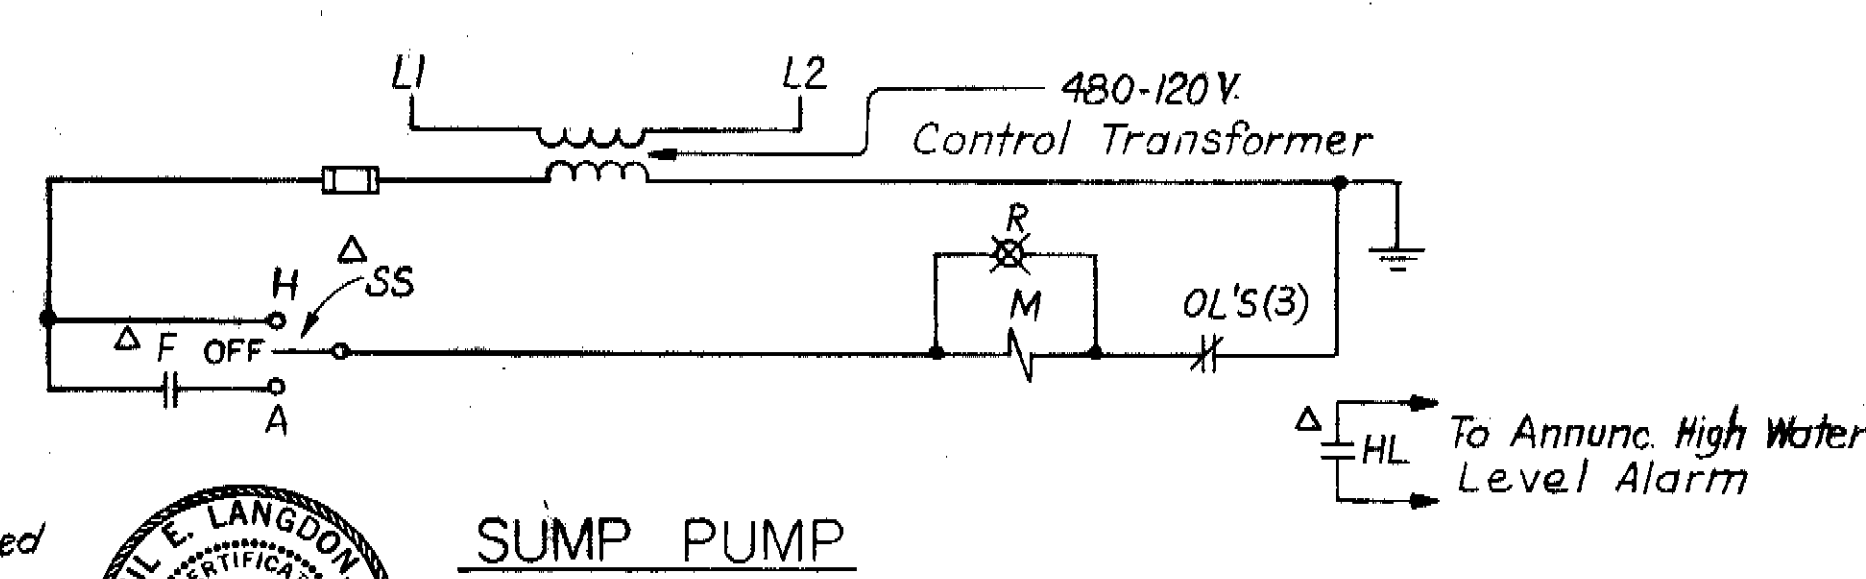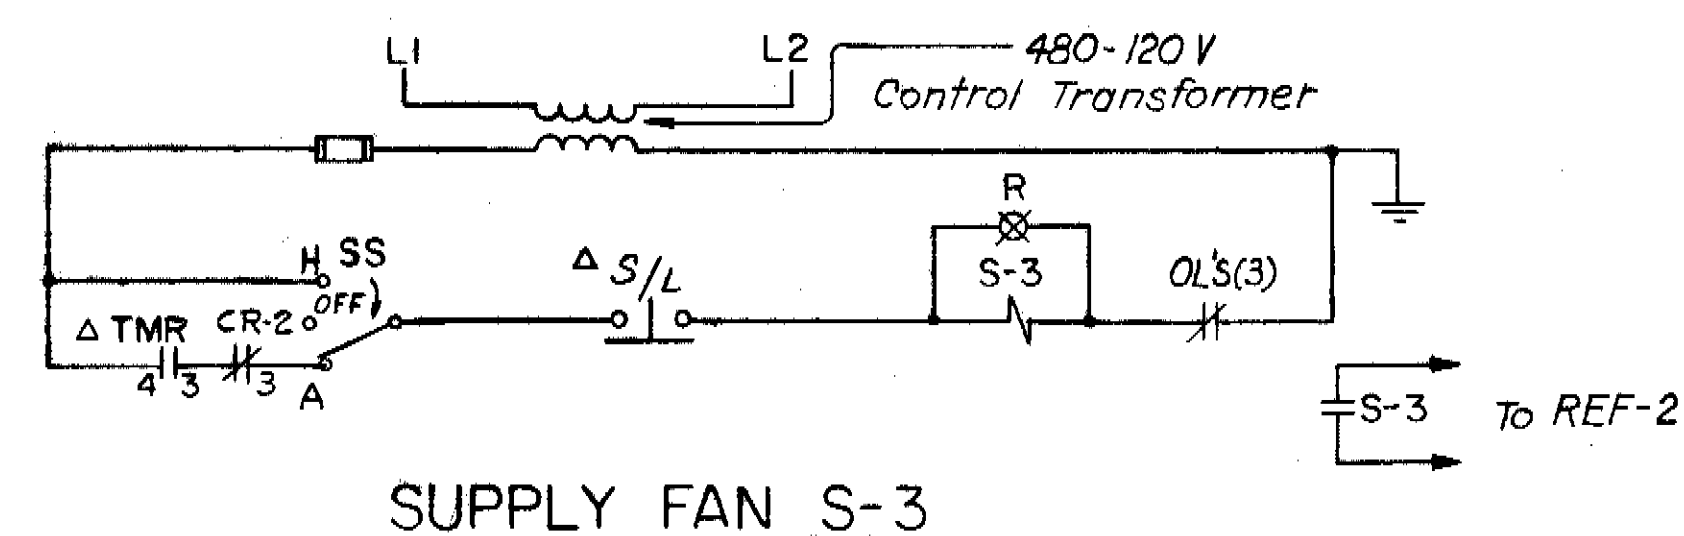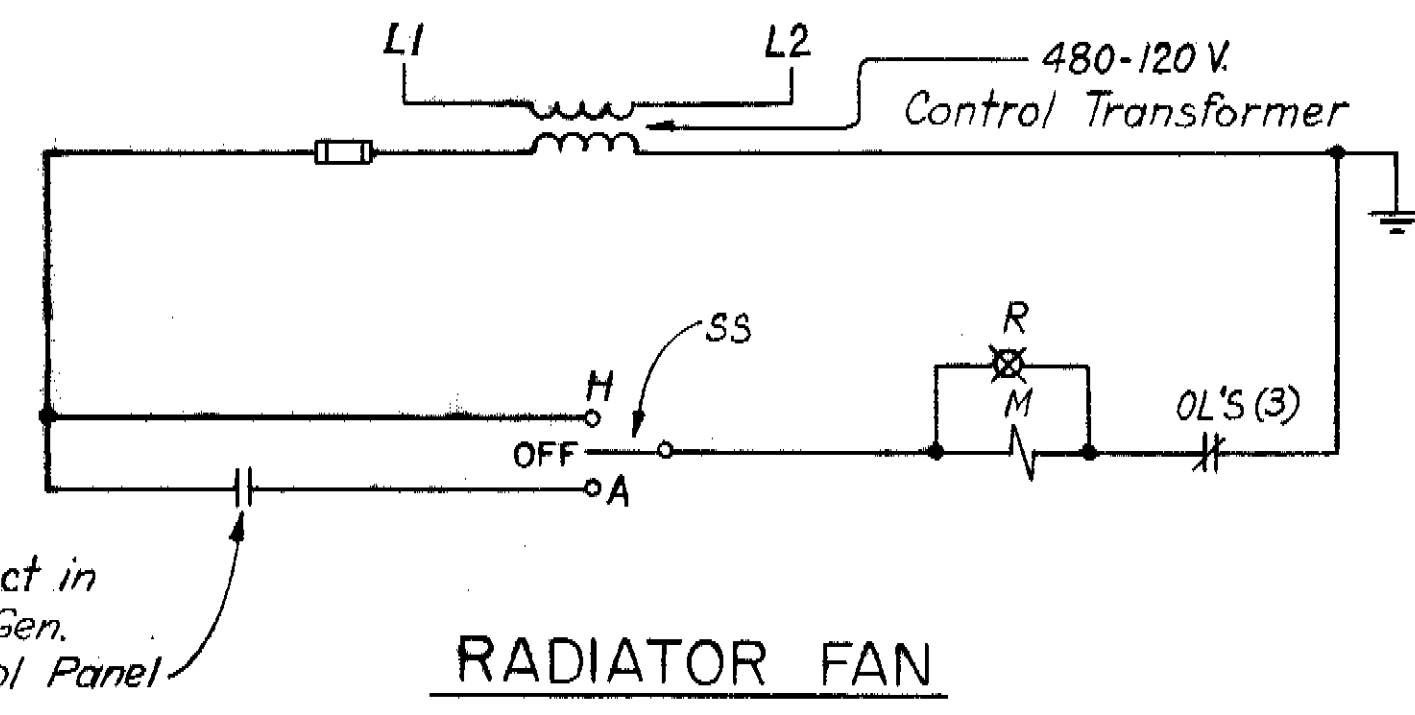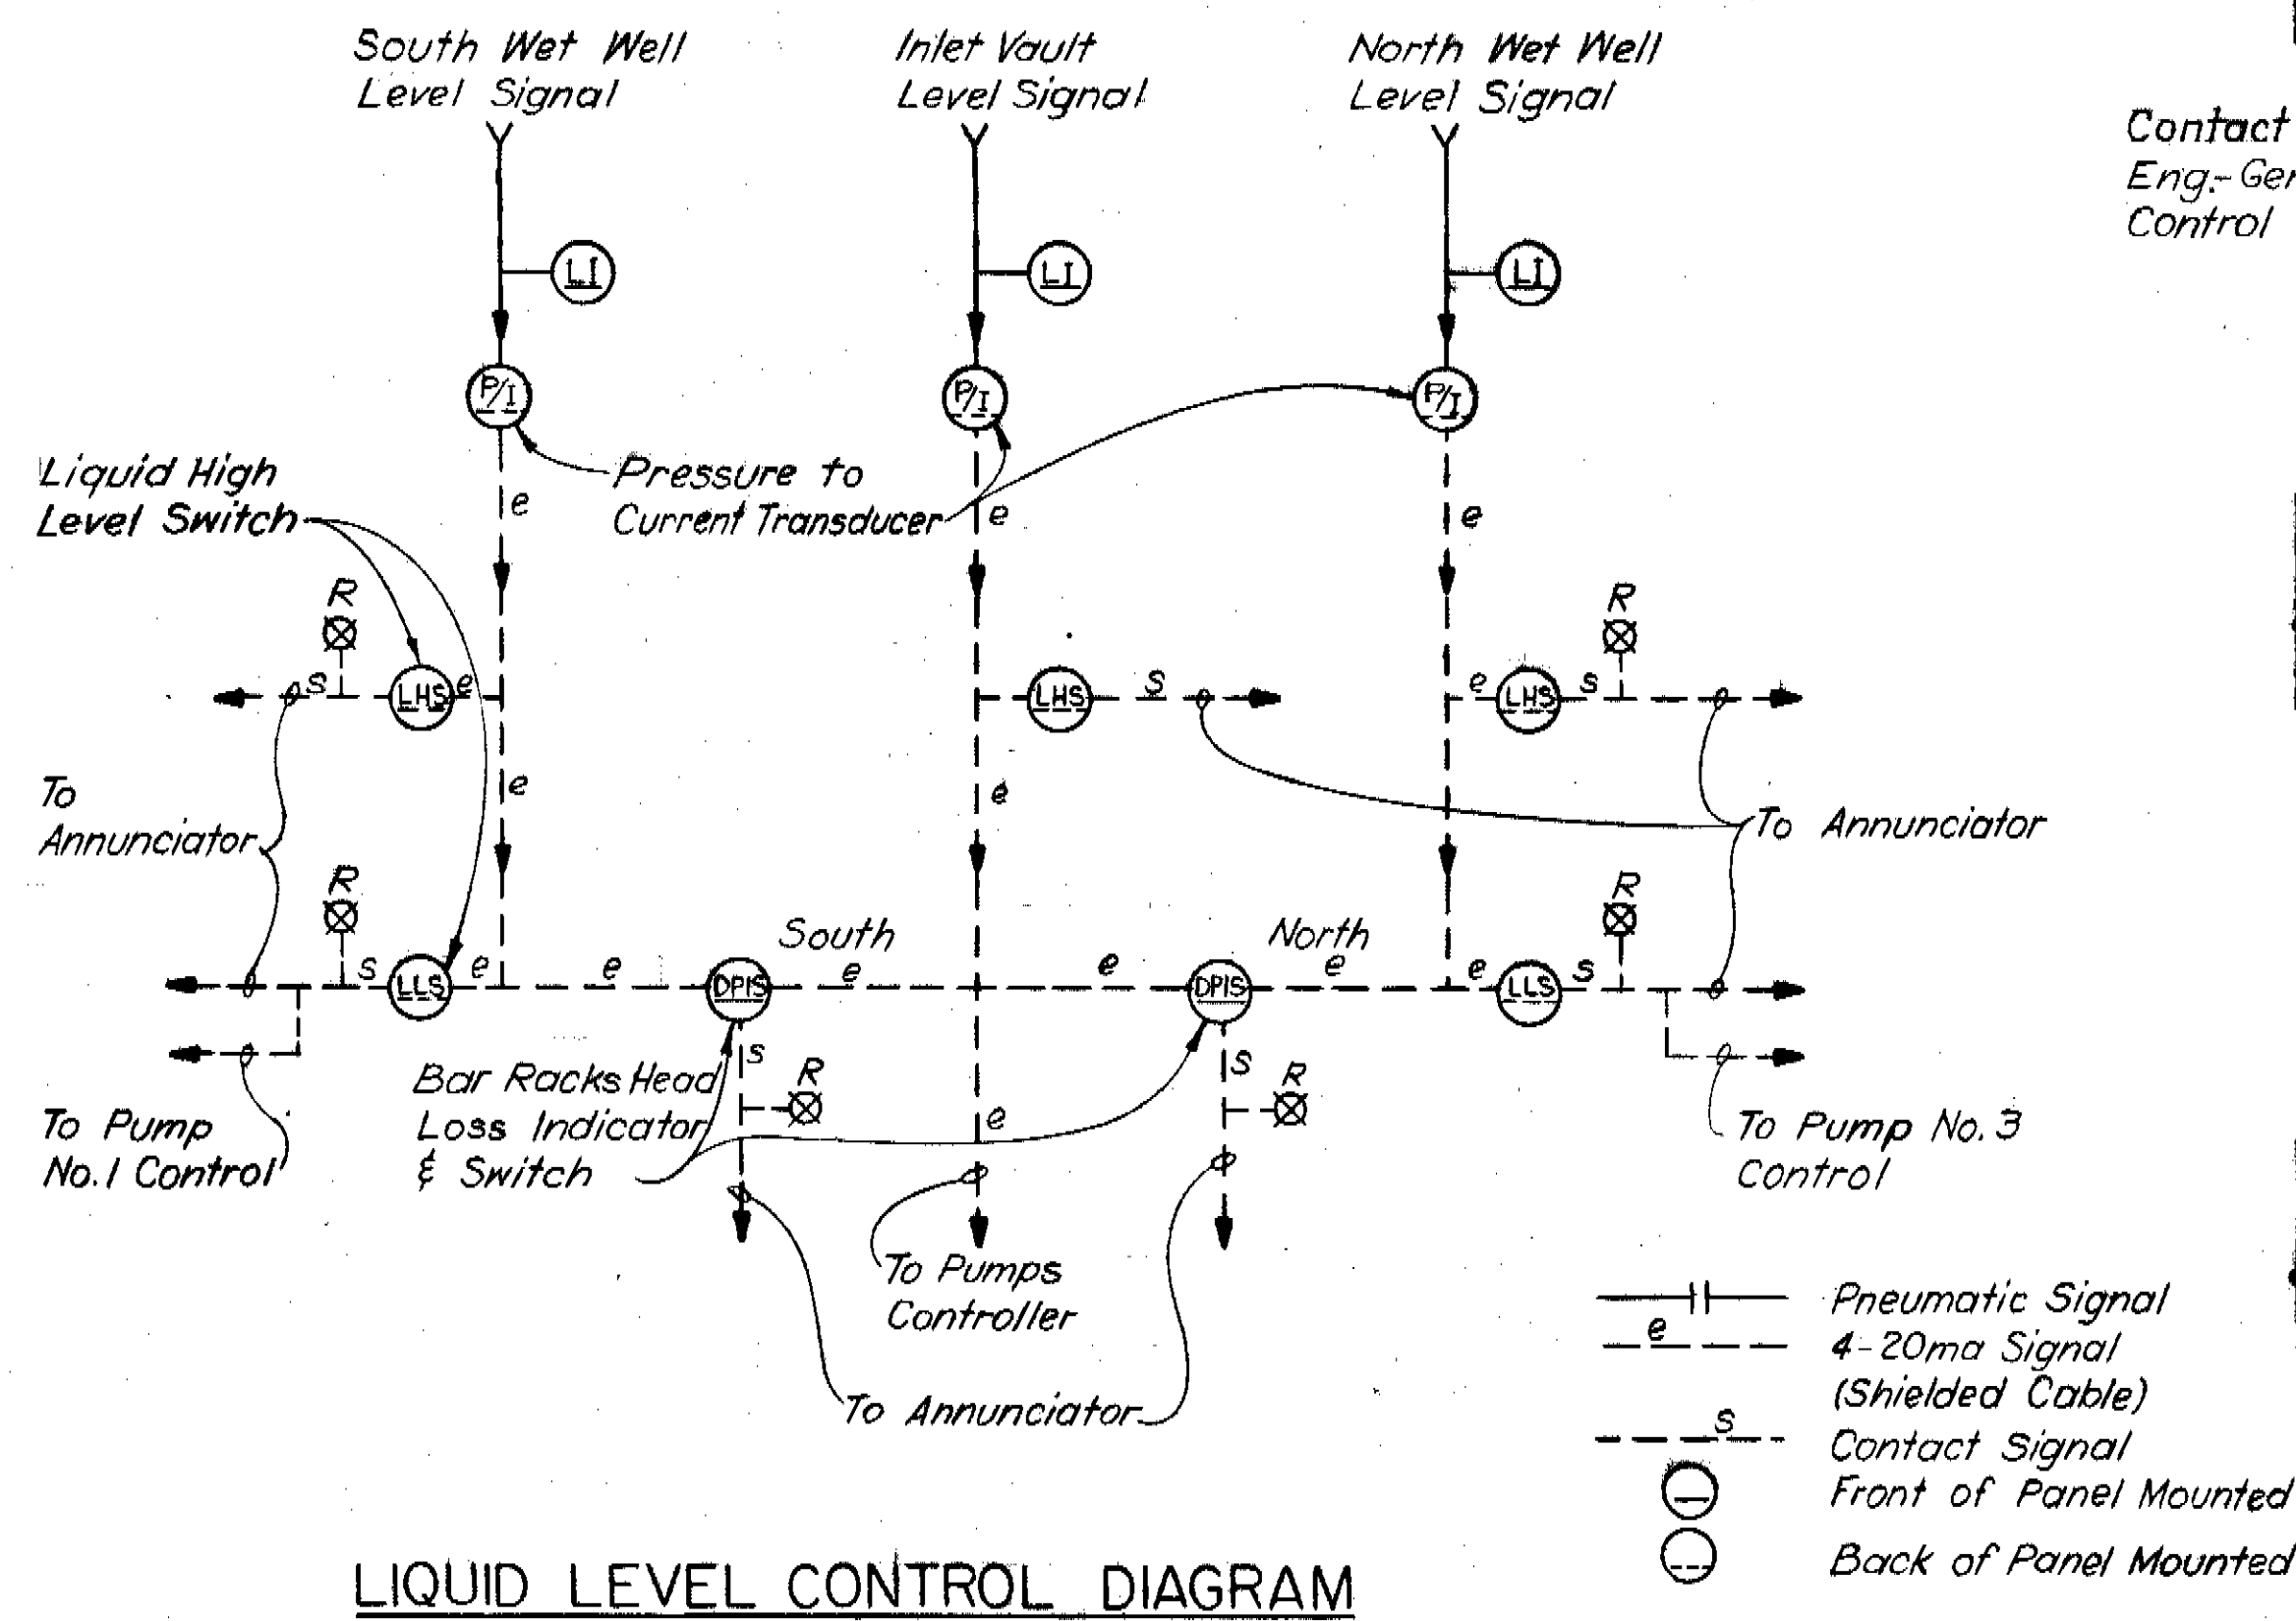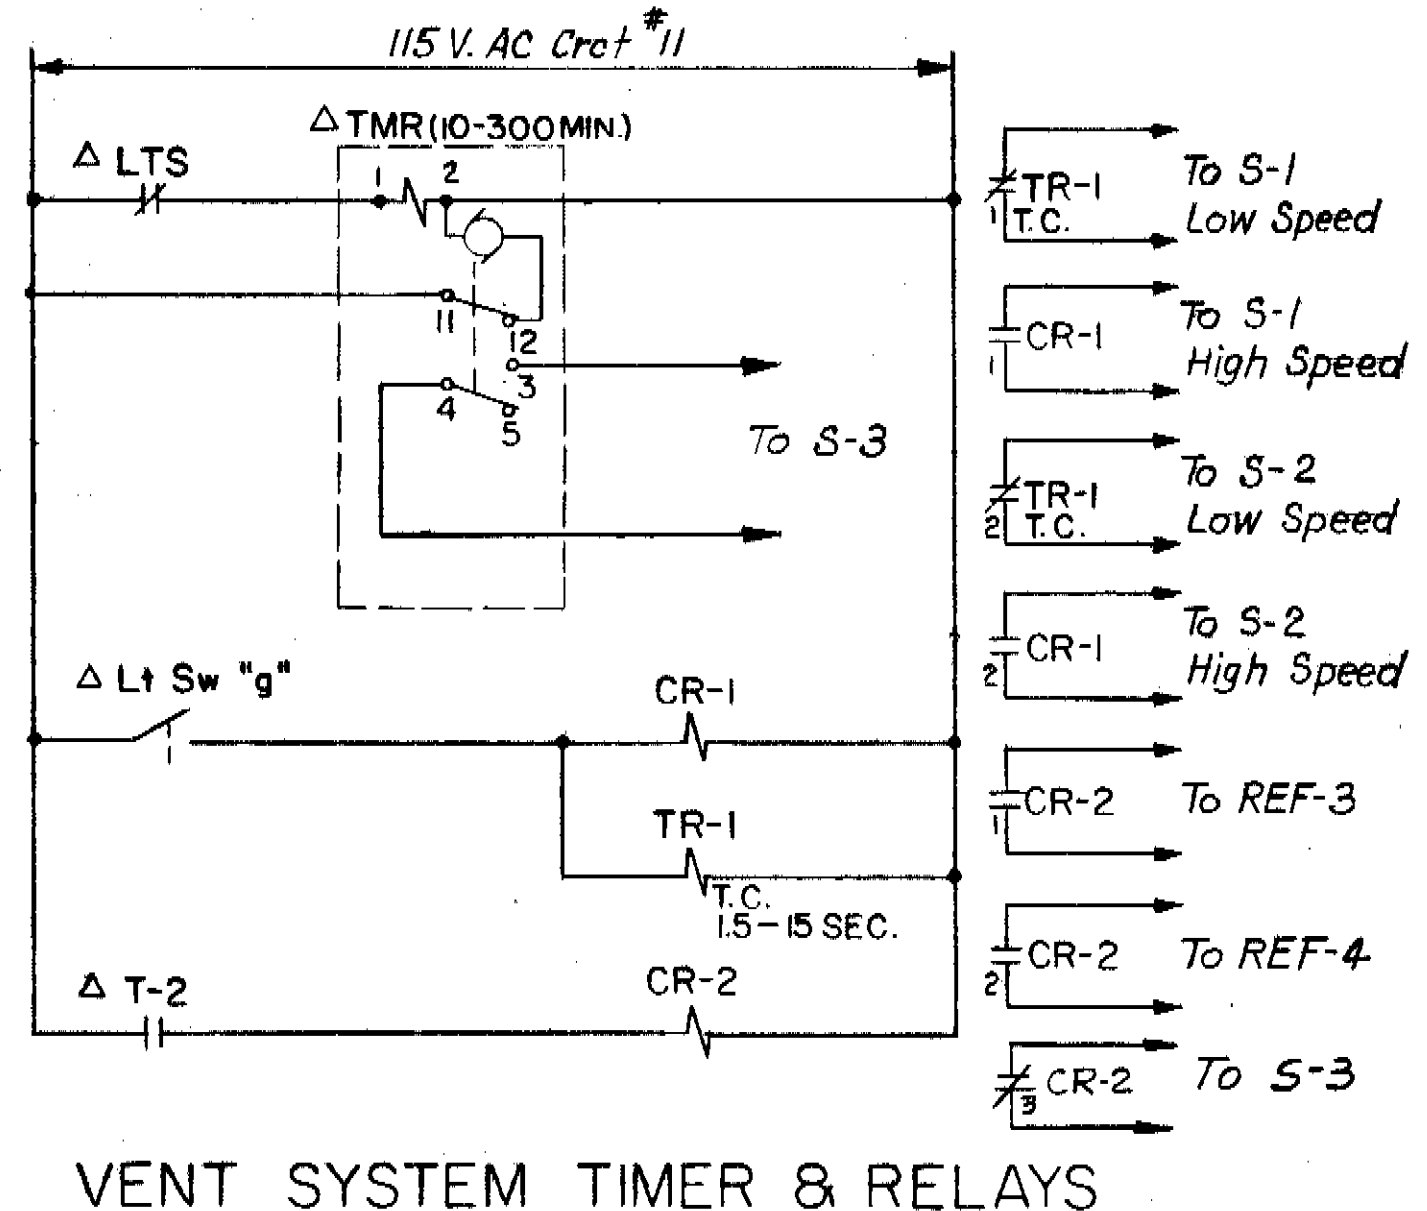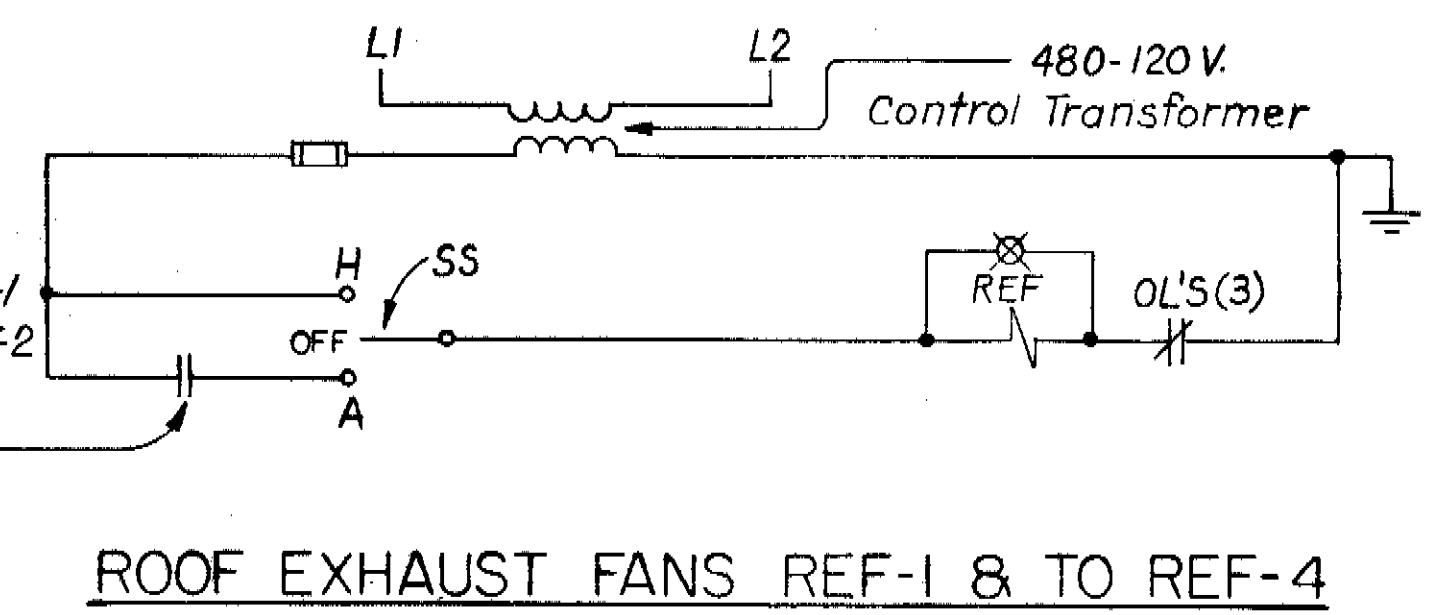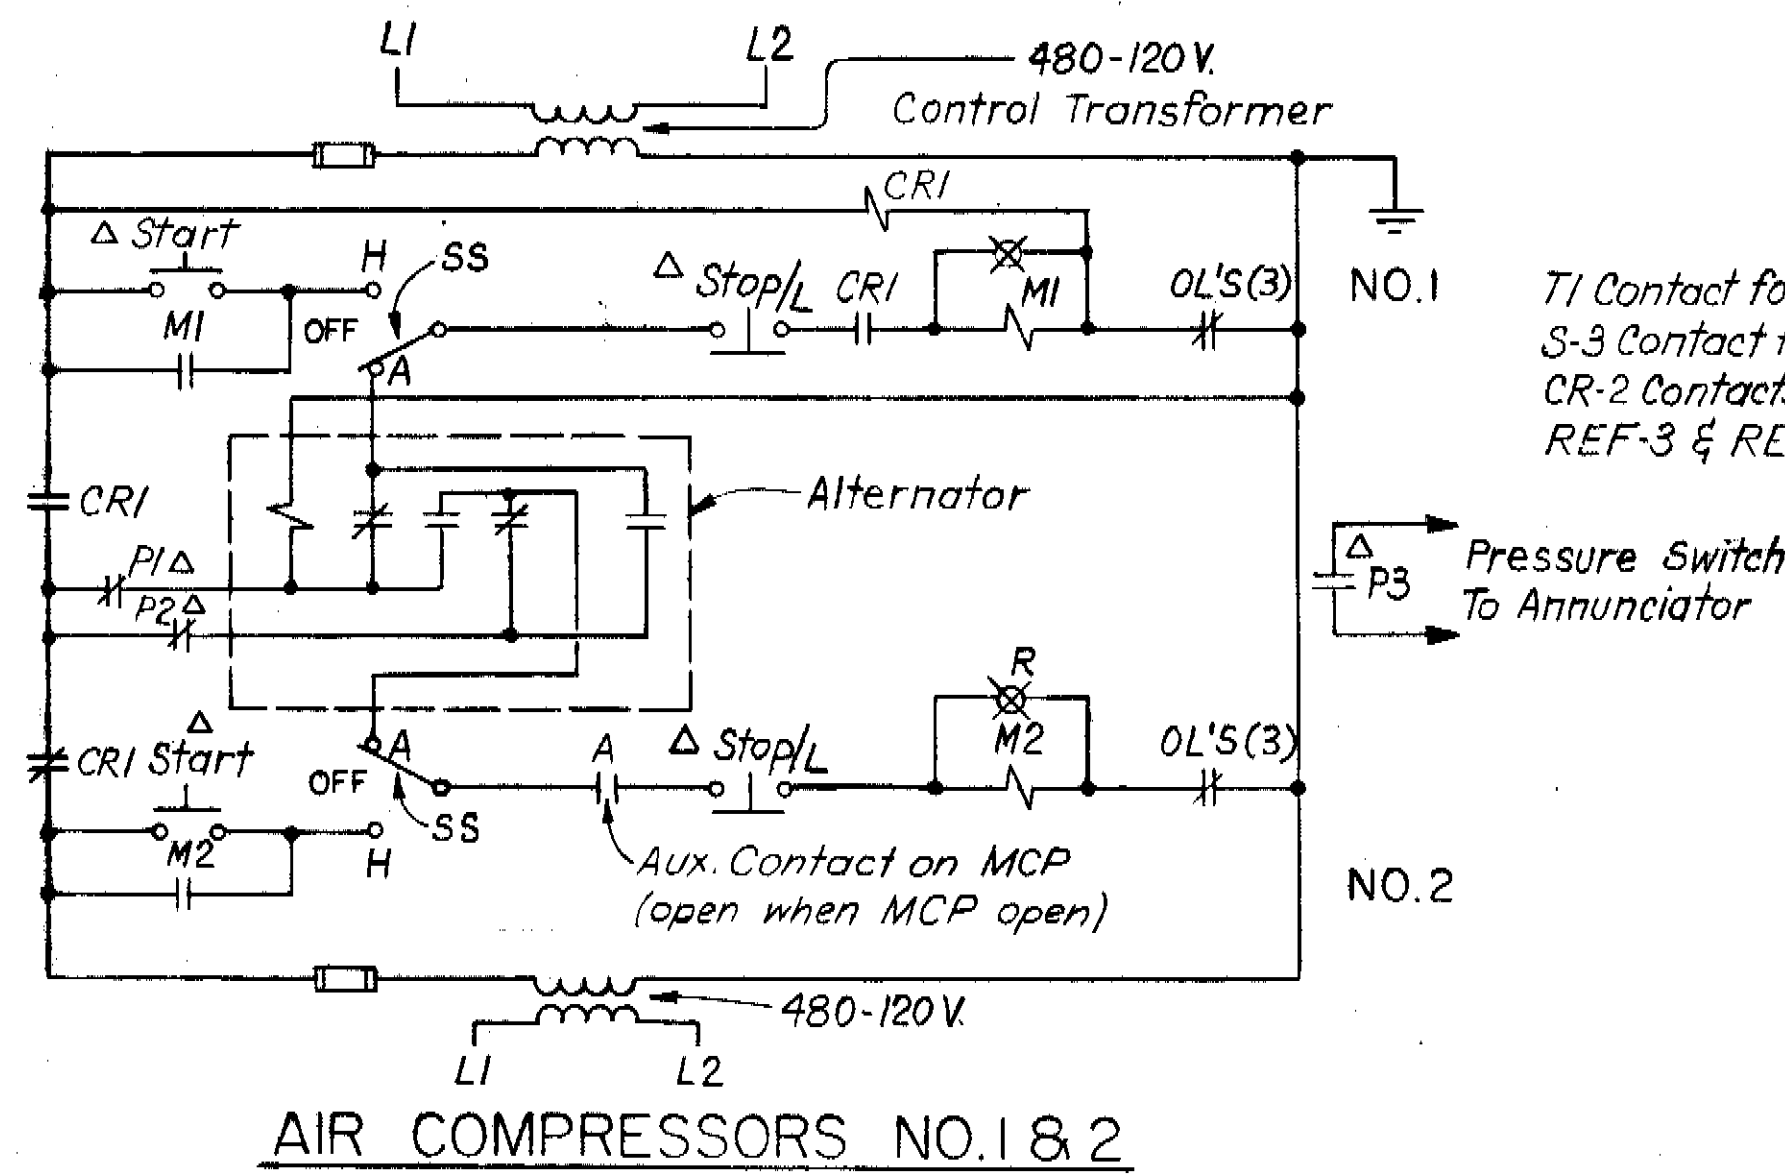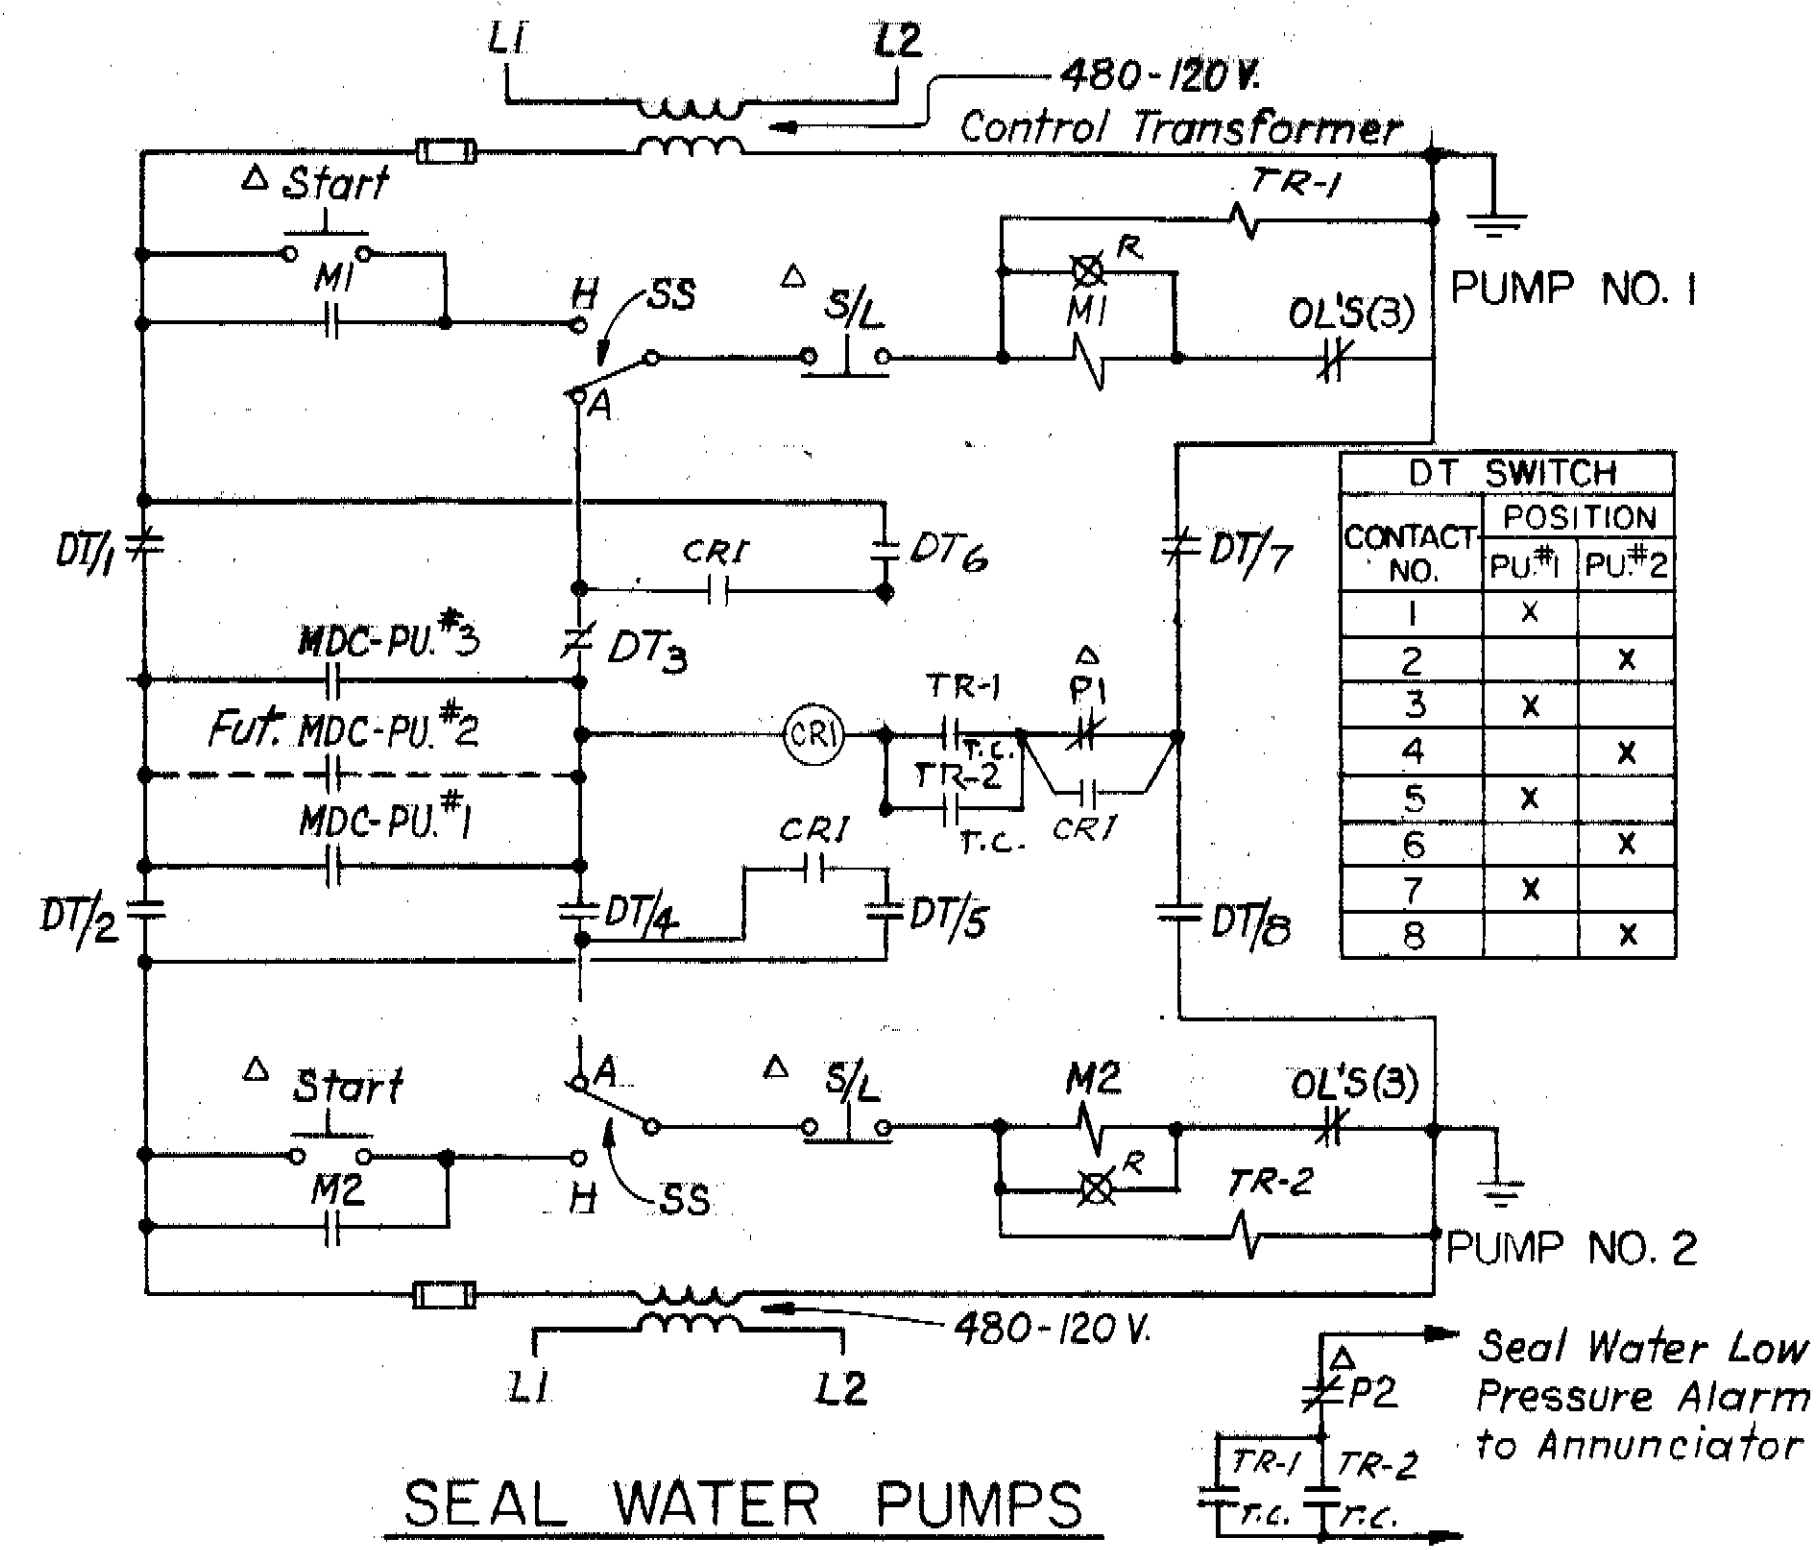


NOTE:
ALL ELEVATIONS SHOWN ARE REFERENCED TO CITY OF TAMPA DATUM. TO CONVERT TO NATIONAL OCEAN SURVEY (NOS) DATUM, SUBTRACT 0.15 FEET (0'-1 13/16").

RECORD DRAWING
THIS RECORD DRAWING IS NOT WARRANTED BUT IS BELIEVED TO REPRESENT CONDITIONS UPON COMPLETION OF CONSTRUCTION WITHIN REASONABLE TOLERANCES, BASED UPON THE INFORMATION FURNISHED TO THE ENGINEER PERTAINING TO CHANGES MADE DURING CONSTRUCTION.

GREELEY AND HANSEN ENGINEERS 222 S. RIVERSIDE PLAZA CHICAGO, ILLINOIS 60606	DESIGNED	KK	APPROVED	DATE	SCALE NO SCALE	CITY OF TAMPA, FLORIDA SEWAGE DISPOSAL SYSTEM DIVISION 463 131 ST. AVENUE PUMPING STATION	ELECTRICAL MISCELLANEOUS CONTROL DIAGRAMS	PROJ. NO. S202-70-30 D-7-463 SHEET 29 OF 35 DATE AUGUST, 1972 REV. 1
	DRAWN	FS	1 10/81 JSH Rec. Dwg. Revisions Mar. 78 JRP Plans Updated					
	CHECKED	OA, KK	GREELEY AND HANSEN, ENGINEERS					
	NO. DATE APP. REVISION							

178

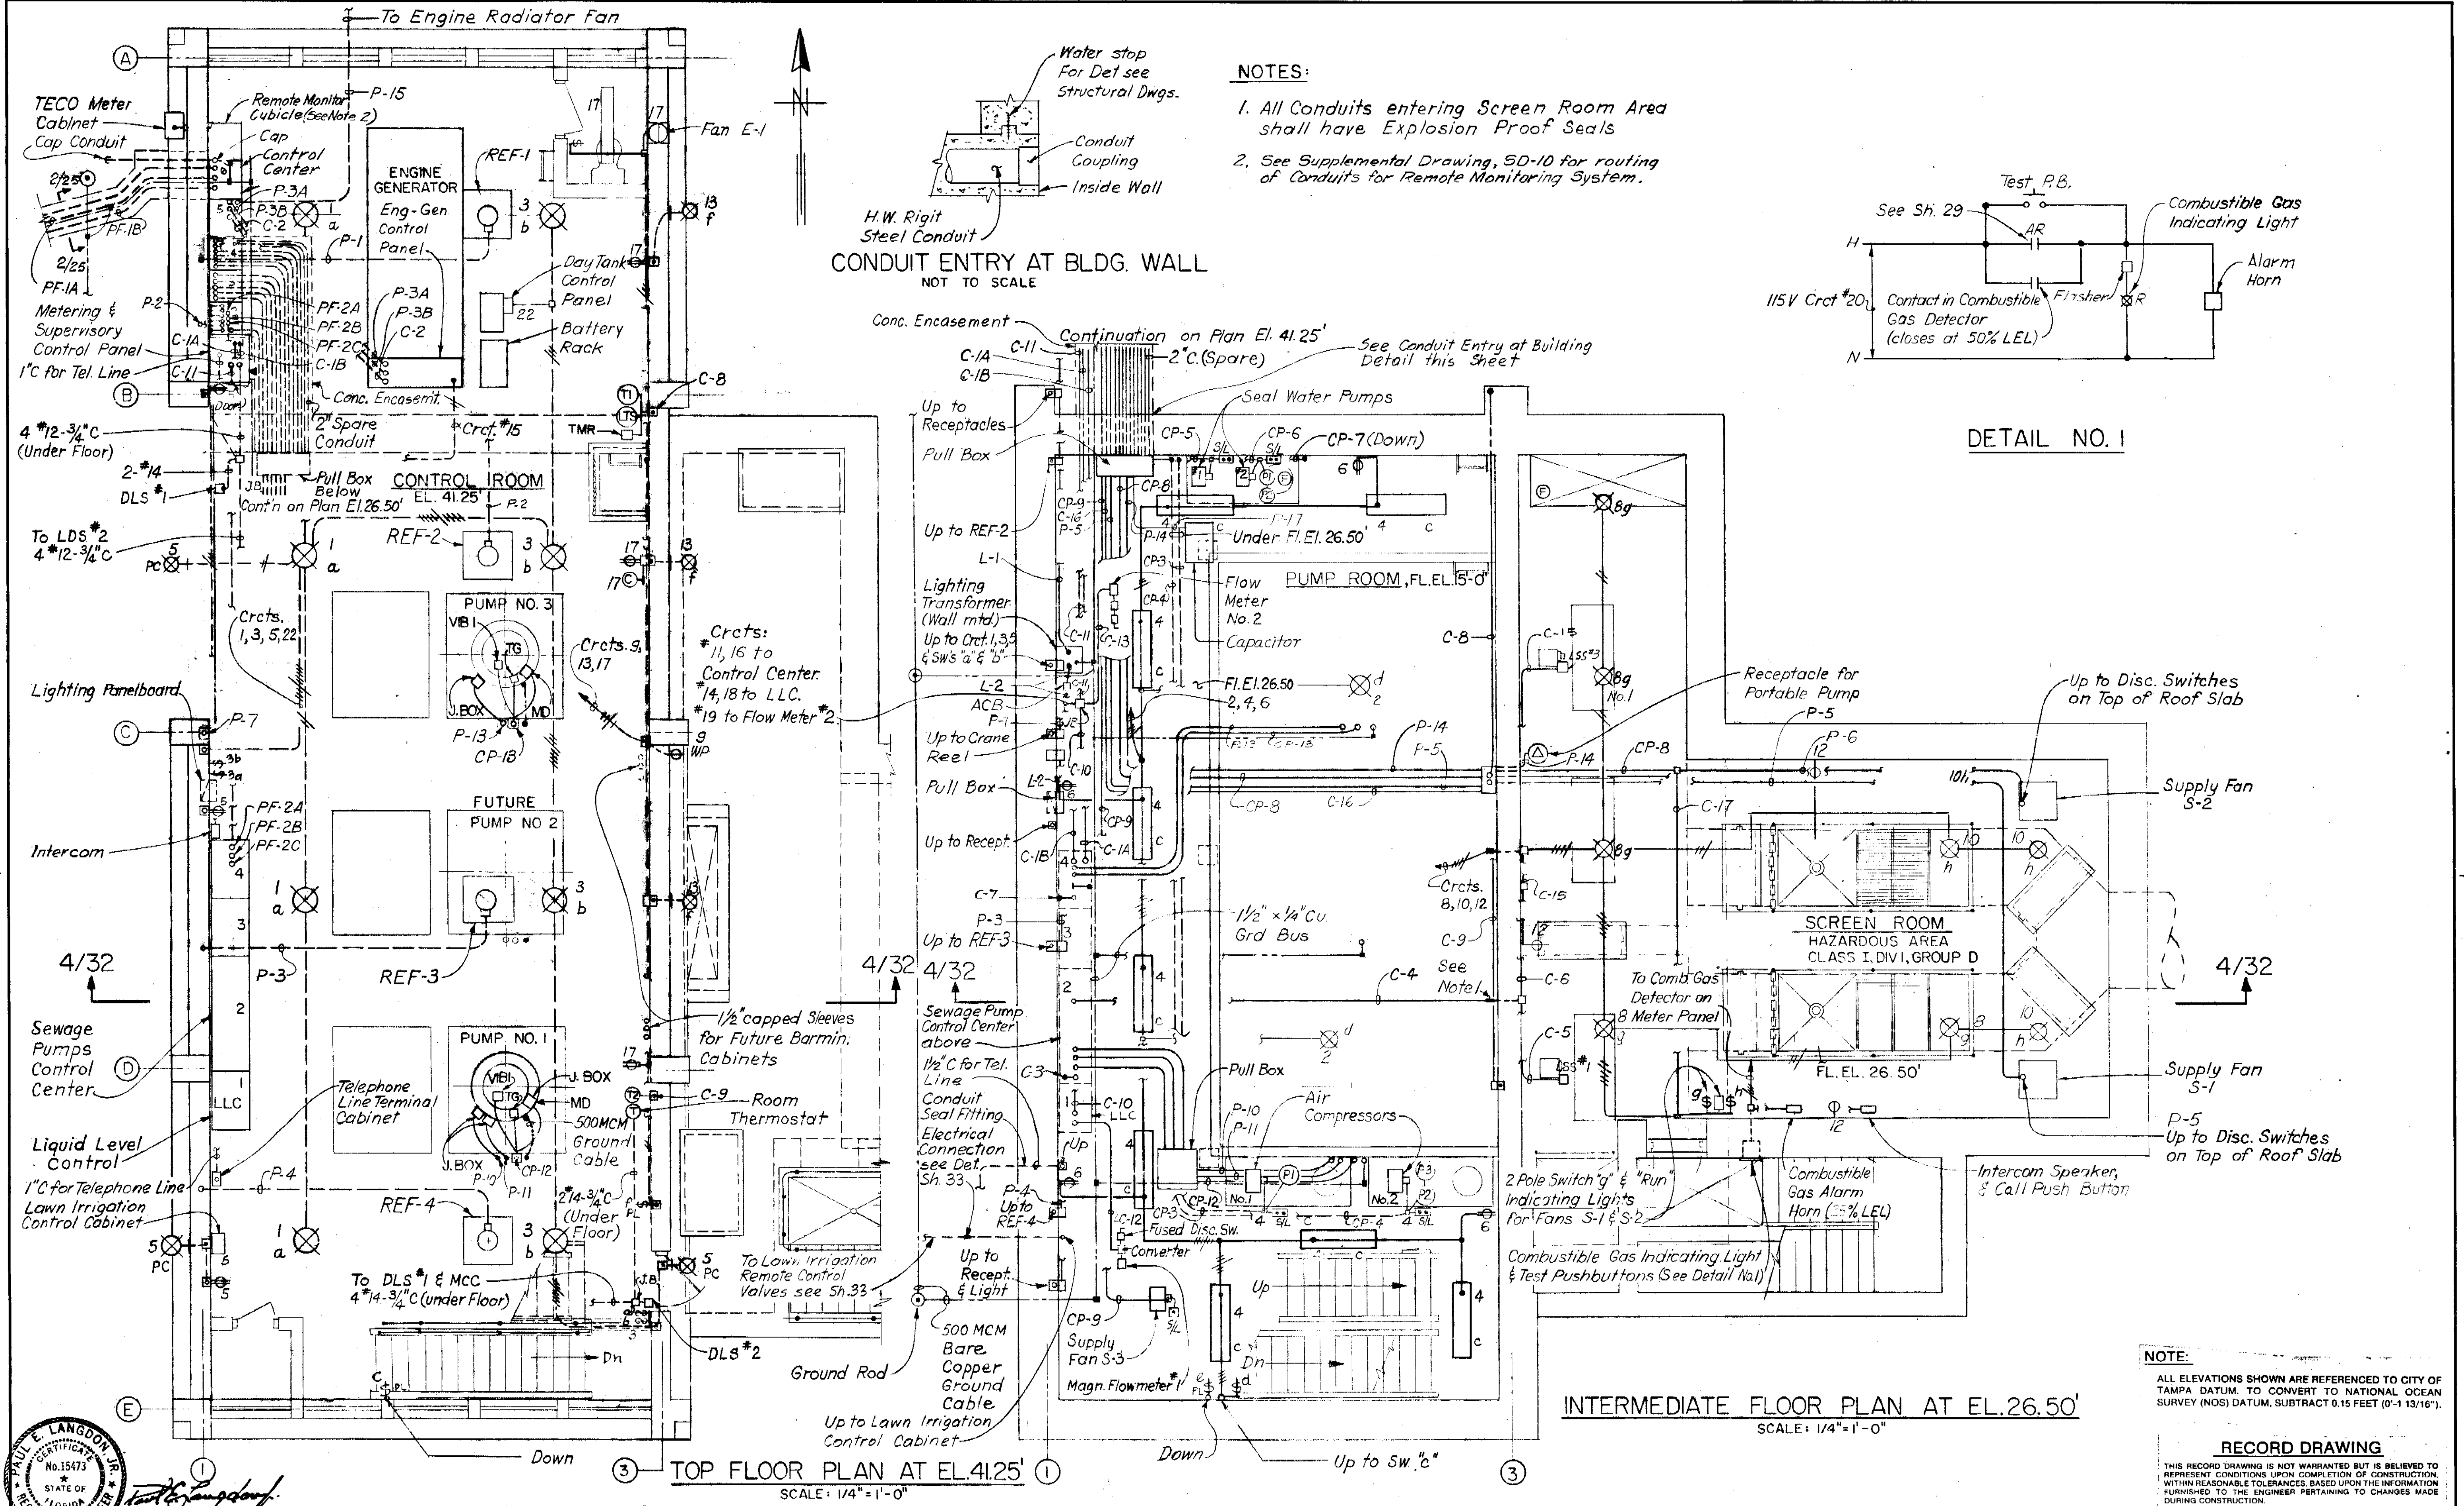


PAUL E. LANGBOON
 CERTIFICATE NO. 15473
 STATE OF ILLINOIS
 REGISTERED ENGINEER

GREELEY AND HANSEN ENGINEERS
 222 S. RIVERSIDE PLAZA
 CHICAGO, ILLINOIS 60606

DESIGNED	KK	APPROVED	
DRAWN	FS	DATE	
CHECKED	OA, KK	SUPT., DEPT. OF SANITARY SEWERS	
		DATE	
		GREELEY AND HANSEN, ENGINEERS	

NO.	DATE	APP.	REVISION
3	10/31/81	DSH	Rec. Draw Revisions
2	Aug 78	JRP	Added ACB
1	7-14-78	JRP	Revised Conduits & Wiring
	Mar 78	JRP	Plans Updated

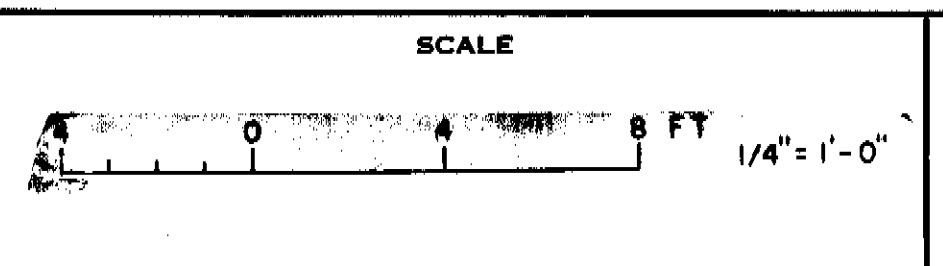

CITY OF TAMPA, FLORIDA
 SEWAGE DISPOSAL SYSTEM
 DIVISION 4G3
 131 ST. AVENUE PUMPING STATION



ELECTRICAL
TOP AND INTERMEDIATE FLOOR PLANS

PROJ. NO. S202-70-30D-7-463
 SHEET 30 OF 35
 DATE AUGUST, 1972 REV. 3

NOTE:
 ALL ELEVATIONS SHOWN ARE REFERENCED TO CITY OF TAMPA DATUM. TO CONVERT TO NATIONAL OCEAN SURVEY (NOS) DATUM, SUBTRACT 0.15 FEET (0'-1 1/16").

RECORD DRAWING
 THIS RECORD DRAWING IS NOT WARRANTED BUT IS BELIEVED TO REPRESENT CONDITIONS UPON COMPLETION OF CONSTRUCTION WITHIN REASONABLE TOLERANCES BASED UPON THE INFORMATION FURNISHED TO THE ENGINEER PERTAINING TO CHANGES MADE DURING CONSTRUCTION.

173-677-9

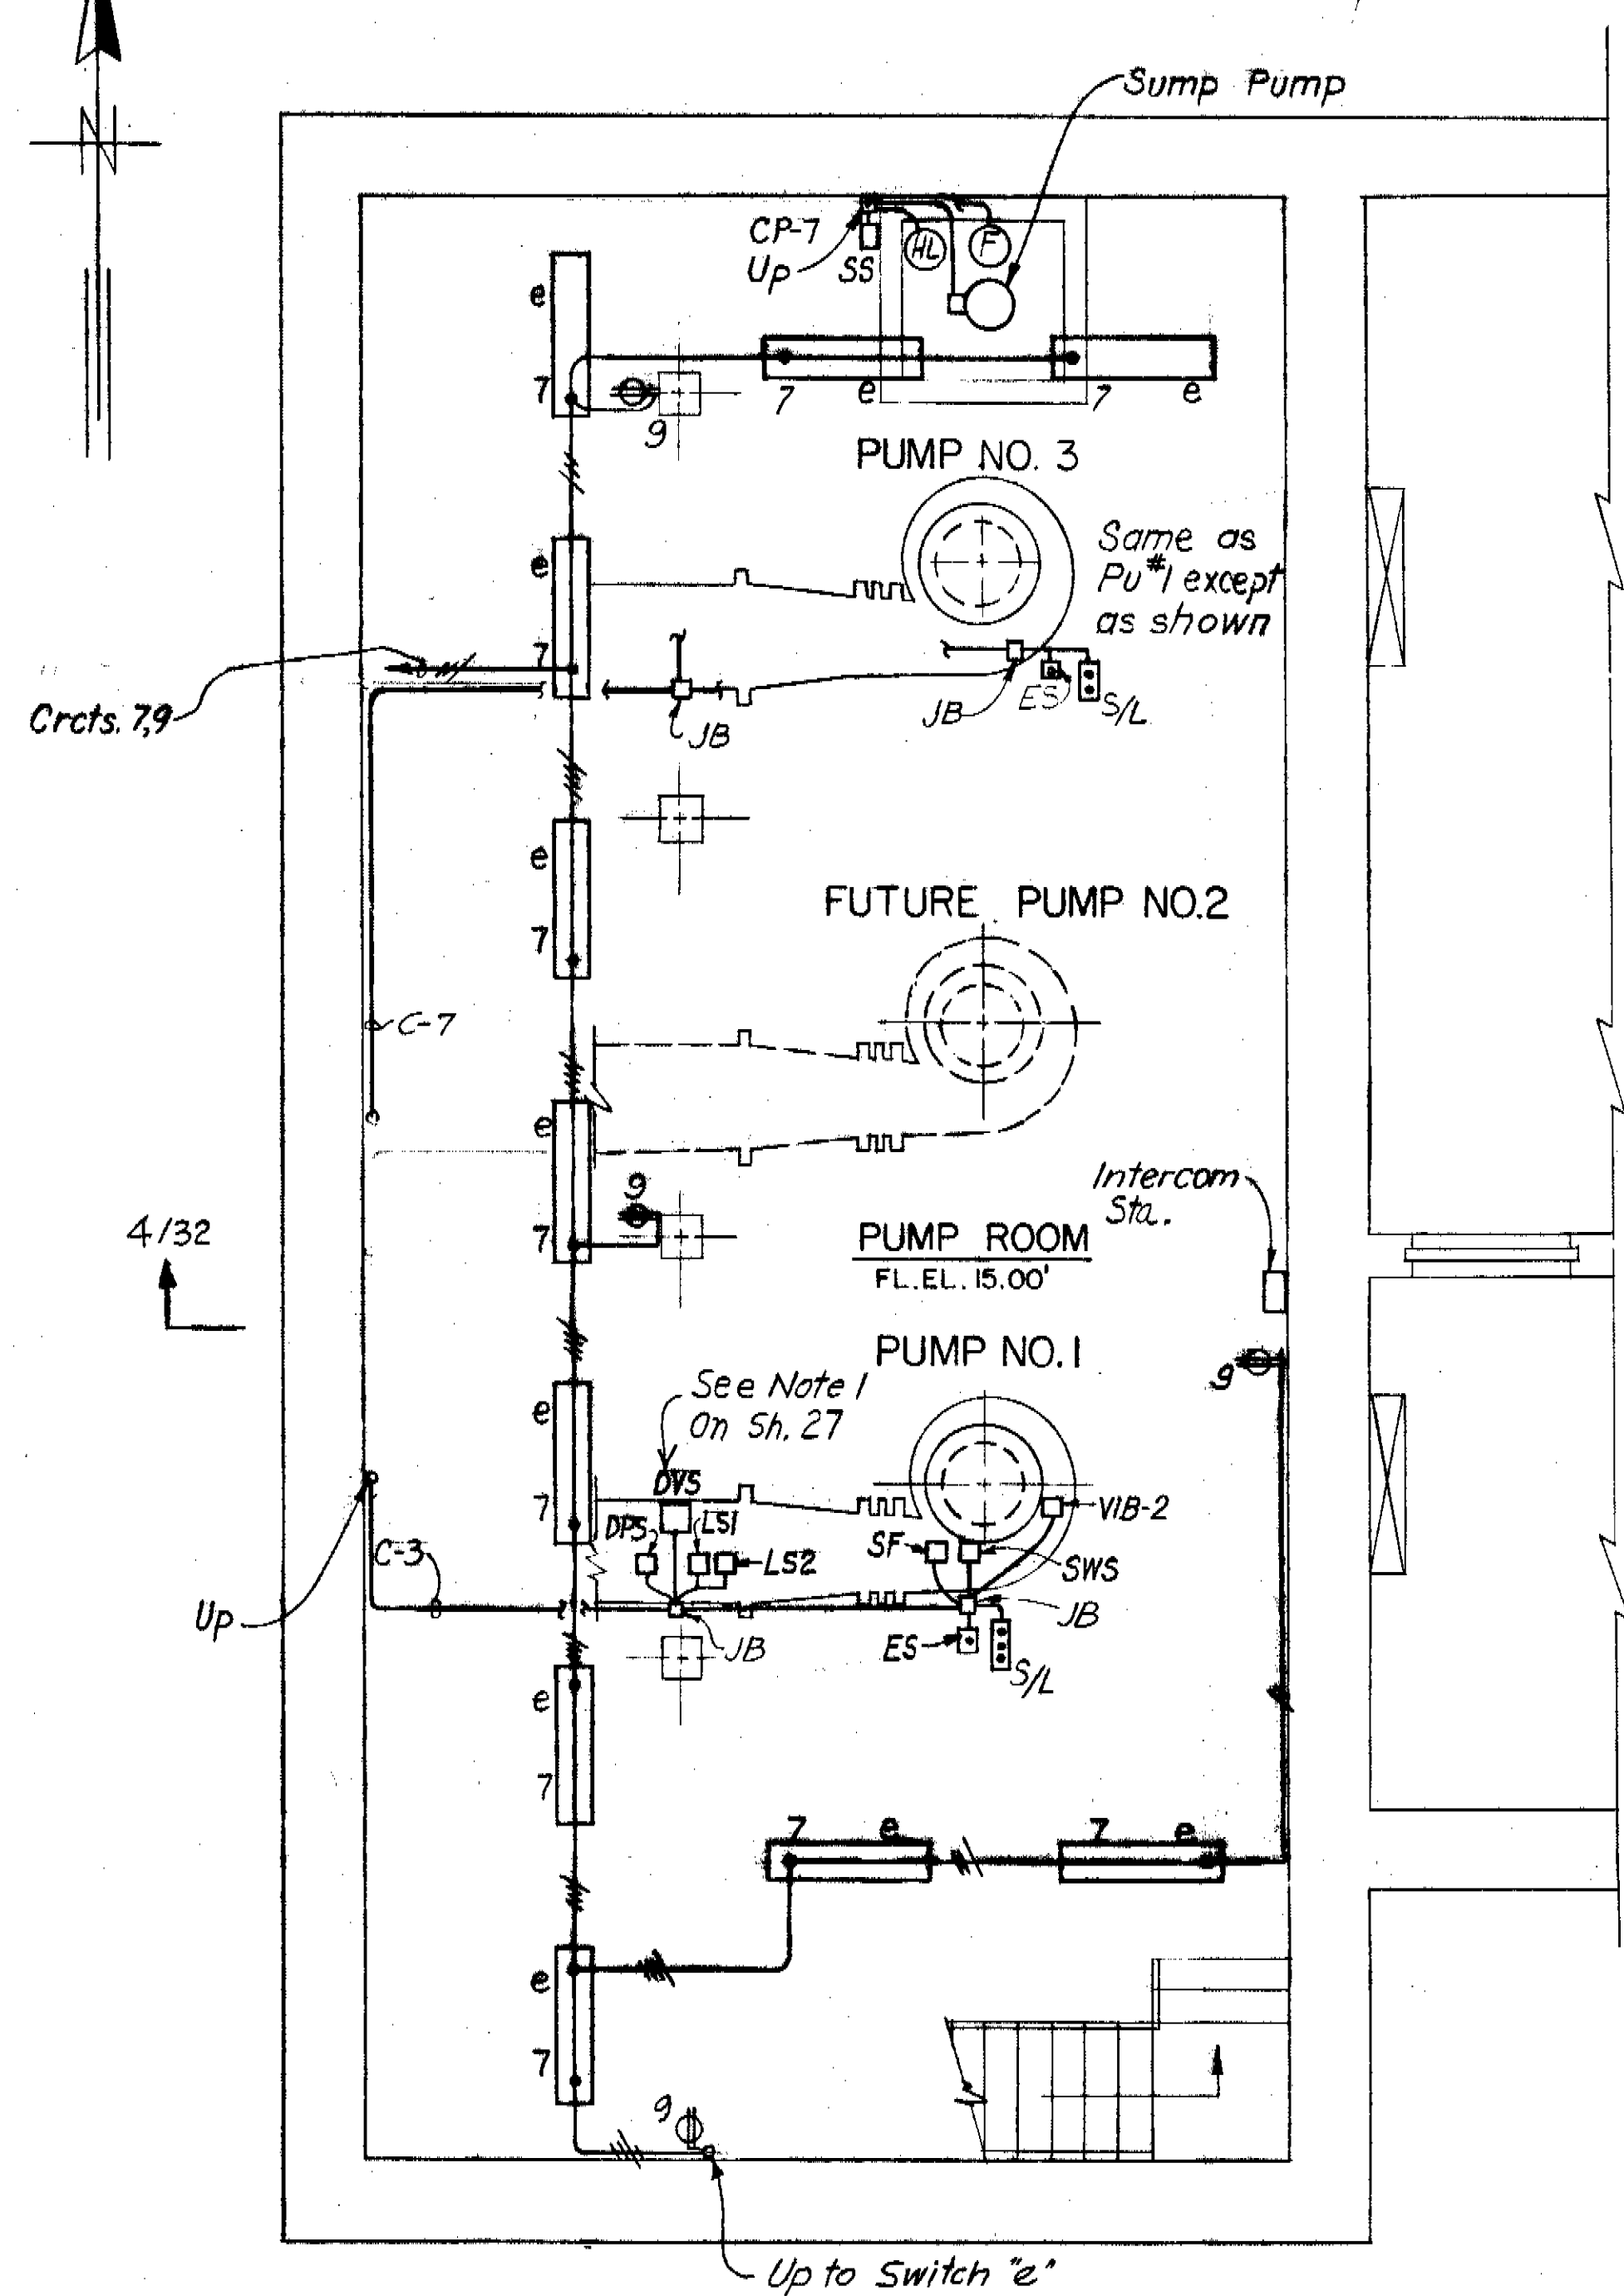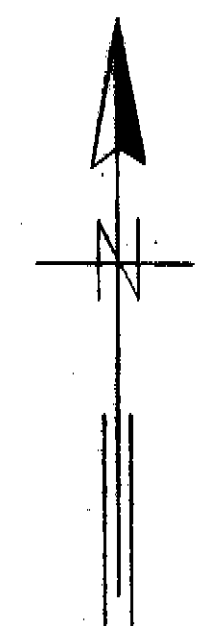

REMOTE MONITORING CUBICLE	
NO.	ANNUNCIATOR NAMEPLATE
1A	PUMP No. 1 OVERLOAD RELAY - LOW SPEED
1B	PUMP No. 1 OVERLOAD RELAY - HIGH SPEED
1C	PUMP No. 1 PHASE SEQUENCE RELAY
1D	PUMP No. 1 GROUND FAULT RELAY
2A	PUMP No. 1 PUMP DISCHARGE VALVE FAIL TO OPEN
2B	PUMP No. 1 E.C.C. FAILURE
2C	PUMP No. 1 MOTOR STATOR HIGH TEMPERATURE
2D	PUMP No. 1 SOUTH WET WELL LOW LEVEL
3A	PUMP No. 1 E.C.C. HIGH DISCHARGE AIR TEMPERATURE
3B	PUMP No. 1 MOTOR EXCESSIVE VIBRATION
3C	PUMP No. 1 PUMP EXCESSIVE VIBRATION
3D	PUMP No. 3 OVERLOAD RELAY
4A	PUMP No. 3 PHASE SEQUENCE RELAY
4B	PUMP No. 3 GROUND FAULT RELAY
4C	PUMP No. 3 MOTOR STATOR HIGH TEMPERATURE
4D	PUMP No. 3 NORTH WET WELL LOW LEVEL
5A	PUMP No. 3 PUMP DISCHARGE VALVE FAIL TO OPEN
5B	PUMP No. 3 E.C.C. FAILURE
5C	PUMP No. 3 E.C.C. HIGH DISCHARGE AIR TEMPERATURE
5D	PUMP No. 3 MOTOR EXCESSIVE VIBRATION
6A	PUMP No. 3 PUMP EXCESSIVE VIBRATION
6B-6D	SPARE

SCHEDULE OF LIGHTING PANEL 208/120 V, 3 PHASE, 60 Hz								
CRCT. NO.	LOCATION	FLOOR EL.	MTG. HT.	FIXT. TYPE	LIGHTS MOTORS	REC.	TOTAL WATTS	REMARKS
1	Control Room	4'-3"	Ceiling	H-1	4@450		1800	3 Way Switches
2	Pump Room	15'-0"	20'-0"	H-1	2@450		900	
3	Control Room	4'-3"	Ceiling	H-1	4@450		1800	3 Way Switches
4	Intermediate Floor	26'-6"	9'-0"	B-1	9@100		900	
5	Exterior Lights - West	4'-3"	10'-6"	H-3	2@200			With Photo Cell
	Exterior Lights - East	4'-3"	10'-6"	H-4	1@235			With Photo Cell
	Control Room	4'-3"	2'-0"			3		
	Control Room	4'-3"	5'-0"				100	Lawn Irrig. Contr. Cab.
6	Intermediate Floor	26'-6"	3'-0"			4	800	
7	Lower Floor	15'-0"	9'-0"	B-1	11@100		1100	
8	Screen Room	26'-6"	11'-0"	A-1	5@200		1000	Explosion Proof
9	Pump Room	15'-0"	3'-0"			4		
	Exterior - East	4'-3"	3'-0"			1	1000	Weatherproof
10	Screen Room	26'-6"	11'-0"	A-1	3@200		600	Explosion Proof
11	Control Room	4'-3"					150	Vent. Relays
12	Screen Room	26'-6"	3'-0"			3	600	Explosion Proof
13	Exterior Lgts. - East	4'-3"	10'-6"	H-2	3@285		855	
14	Control Room	4'-3"					1000	Liquid Level Cont. Panel LLC
15	Control Room	4'-3"					1000	Battery Charger
16	Control Room	4'-3"					500	Annunciator and future Superv. System
17	Toilet Room	4'-3"	Ceiling	B-2	1@50			Fan E-1
	Control Room	4'-3"	2'-0"			4	750	(1) Clock outlet mtd 80.
18	Control Room	4'-3"					800	Flowmeter No. 1
19	Control Room	4'-3"					800	Flowmeter No. 2
20	Control Room	4'-3"					300	Combustible Gas Detector
21	Control Room	4'-3"					200	Intercom
22	Control Room	4'-3"					1200	Day Tank Control Panel
23	Spare							
24	Intermediate Floor	26'-6"						Air Dryer
25	Spare							
26	Control Room	4'-3"						D.S.S. installed lights MCC
27/30	Spares							


~ - Handle "Lock-In" device
 □ - Circuit Breaker with ground fault Interrupter

NOTE: Minimum Conductor size for Lighting shall be size 12. Minimum Conduit size for Lighting shall be 3/4-in

NOTE: THIS RECORD DRAWING IS NOT WARRANTED BUT IS BELIEVED TO REPRESENT CONDITIONS UPON COMPLETION OF CONSTRUCTION, WITHIN REASONABLE TOLERANCES, BASED UPON THE INFORMATION FURNISHED TO THE ENGINEER PERTAINING TO CHANGES MADE DURING CONSTRUCTION.

RECORD DRAWING
 CITY OF TAMPA, FLORIDA
 SEWAGE DISPOSAL SYSTEM
 DIVISION 4G3
 131 ST. AVENUE PUMPING STATION

ELECTRICAL
 LOWER FLOOR PLAN
 LIGHTING SCHEDULE

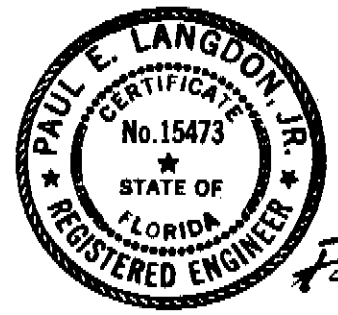


Paul E. Langdon

GREELEY AND HANSEN ENGINEERS
 222 S. RIVERSIDE PLAZA
 CHICAGO, ILLINOIS 60606

DESIGNED KK
 DRAWN LPF, FS
 CHECKED OA

NO.	DATE	APP.	REVISION
3	10/81	SSJ	Rec. Dwg. Revisions
2	Dec. 78	LRP	Added Addendum No. 1
1	Aug. 78	JRP	Added Note
	Mar. 78	JRP	Plans Updated

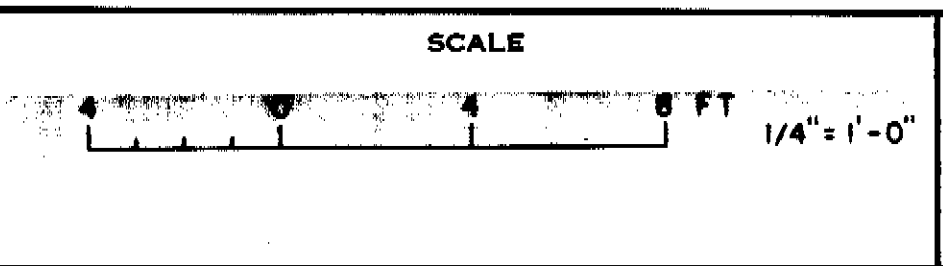

CITY OF TAMPA, FLORIDA
 SEWAGE DISPOSAL SYSTEM
 DIVISION 4G3
 131 ST. AVENUE PUMPING STATION

ELECTRICAL
 LOWER FLOOR PLAN
 LIGHTING SCHEDULE



PROJ. NO. S202-70-300-7-4G3
 SHEET 31 OF 35
 DATE AUGUST, 1972 REV. 3

ANNUNCIATOR NAMEPLATE LIST

(LOCATED IN MOTOR CONTROL CENTER)


- | | |
|--------------------------------------|---|
| 1. Sewage Pump No.1 | 17. Sump High Water Level |
| 2. Spare | 18. Spare |
| 3. Sewage Pump No.3 | 19. Engine- Generator |
| 4. Seal Water Low Pressure | 20. Door Security Switches |
| 5. Seal Water PU#1 | 21. Engine Generator Day Tank |
| 6. Spare | 22. North Wet Well- High Level |
| 7. Seal Water Pu#3 | 23. North Wet Well- Low Level |
| 8. Compressed Air Low Pressure | 24. North Bar Rack High Differential |
| 9. Pump No.1 Discharge Valve | 25. Combustible Gas in Screen Room- Warning Low(25%LEL) |
| 10. Spare | 26. Combustible Gas in Screen Room-Warning High(50%LEL) |
| 11. Pump No. 3 Discharge Valve | 27. Combustible Gas Detector |
| 12. Inlet Vault -High Level | 28. Automatic Transfer Switch |
| 13. Room High Temperature | 29-35 Spares |
| 14. South Bar Rack High Differential | |
| 15. South Wet Well- High Level | |
| 16. South Wet Well- Low Level | |

SCHEDULE OF CONDUIT AND WIRE			
CONDUIT NUMBERS	COND. SIZE	WIRE NO & GAUGE	REMARKS
P-10, P-13	4"	3-750 MCM	
PF-1A, PF-1B	5"	3-750 MCM	
P-11	3"	3-350 MCM	
C-11	2"	12-#12, 12-#14, 2P-#16	2P-#16 twisted shielded
C-10	1 1/2"	4-#12, 12-#14, 1P-#16	1P-#16 twisted shielded
C-3, C-7	1 1/2"	24-#14	
C-2	1 1/2"	12-#14	2P-25 required
C-1A, C-1B	1 1/2"	30-#14	
PF-2A, PF-2B, PF-2C	3"	3-500 MCM	
C-6	3/4"	7-#14	
CP-4, CP-6	1"	3-#12, 8-#14	
L-2	1 1/2"	4-#2	
CP-12	2 1/2"	2-#6, 2-#14, 2-#16	3P-#16 shielded
CP-13	2"	2-#6, 2-#14, 2-#16	3P-#16 shielded
C-8, C-4	3/4"	6-#14	
C-17	3/4"	10-#14	
P-15	3/4"	4-#10	1#-10 Gtd.
CP-8	1 1/2"	6-#12, 10-#14	
C-19	1"	12-#14	
L-1, P-17	1"	3-#6	
CP-3	3/4"	3-#12, 6-#14	
CP-5, CP-7	3/4"	3-#12, 4-#14	
C-16	3/4"	8-#14	
P-5, P-6	3/4"	6-#12	
P-14	3/4"	3-#3	
C-12, C-13	3/4"	2-#12, 1/6-#16	1/6-#16 twisted
C-5, C-15	3/4"	2-#14	
P-1, P-2, P-3, P-4, P-7, P-16	3/4"	3-#12	
C-9	3/4"	2-#14	
CP-9	3/4"	3-#12, 2-#14	
P-3A, P-3B	2"	3-750 MCM	

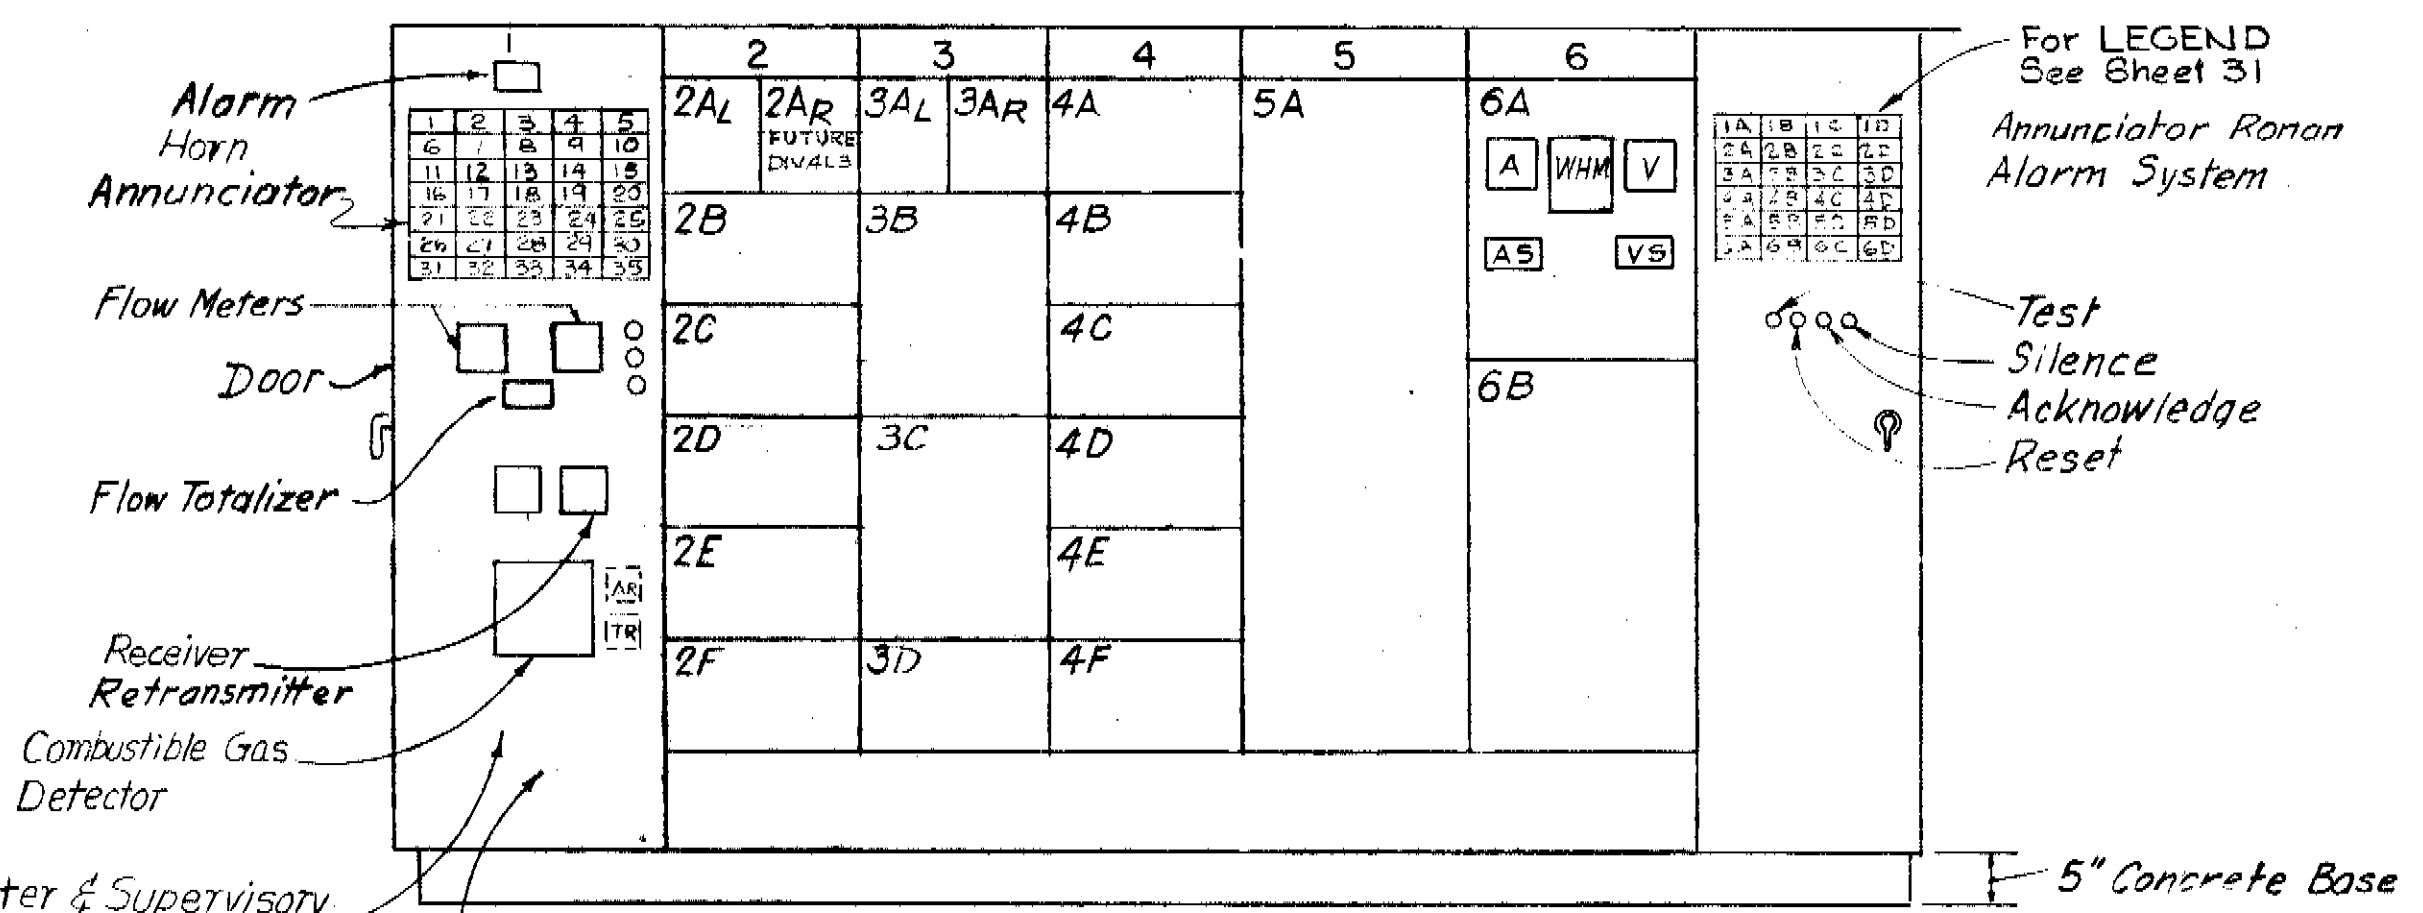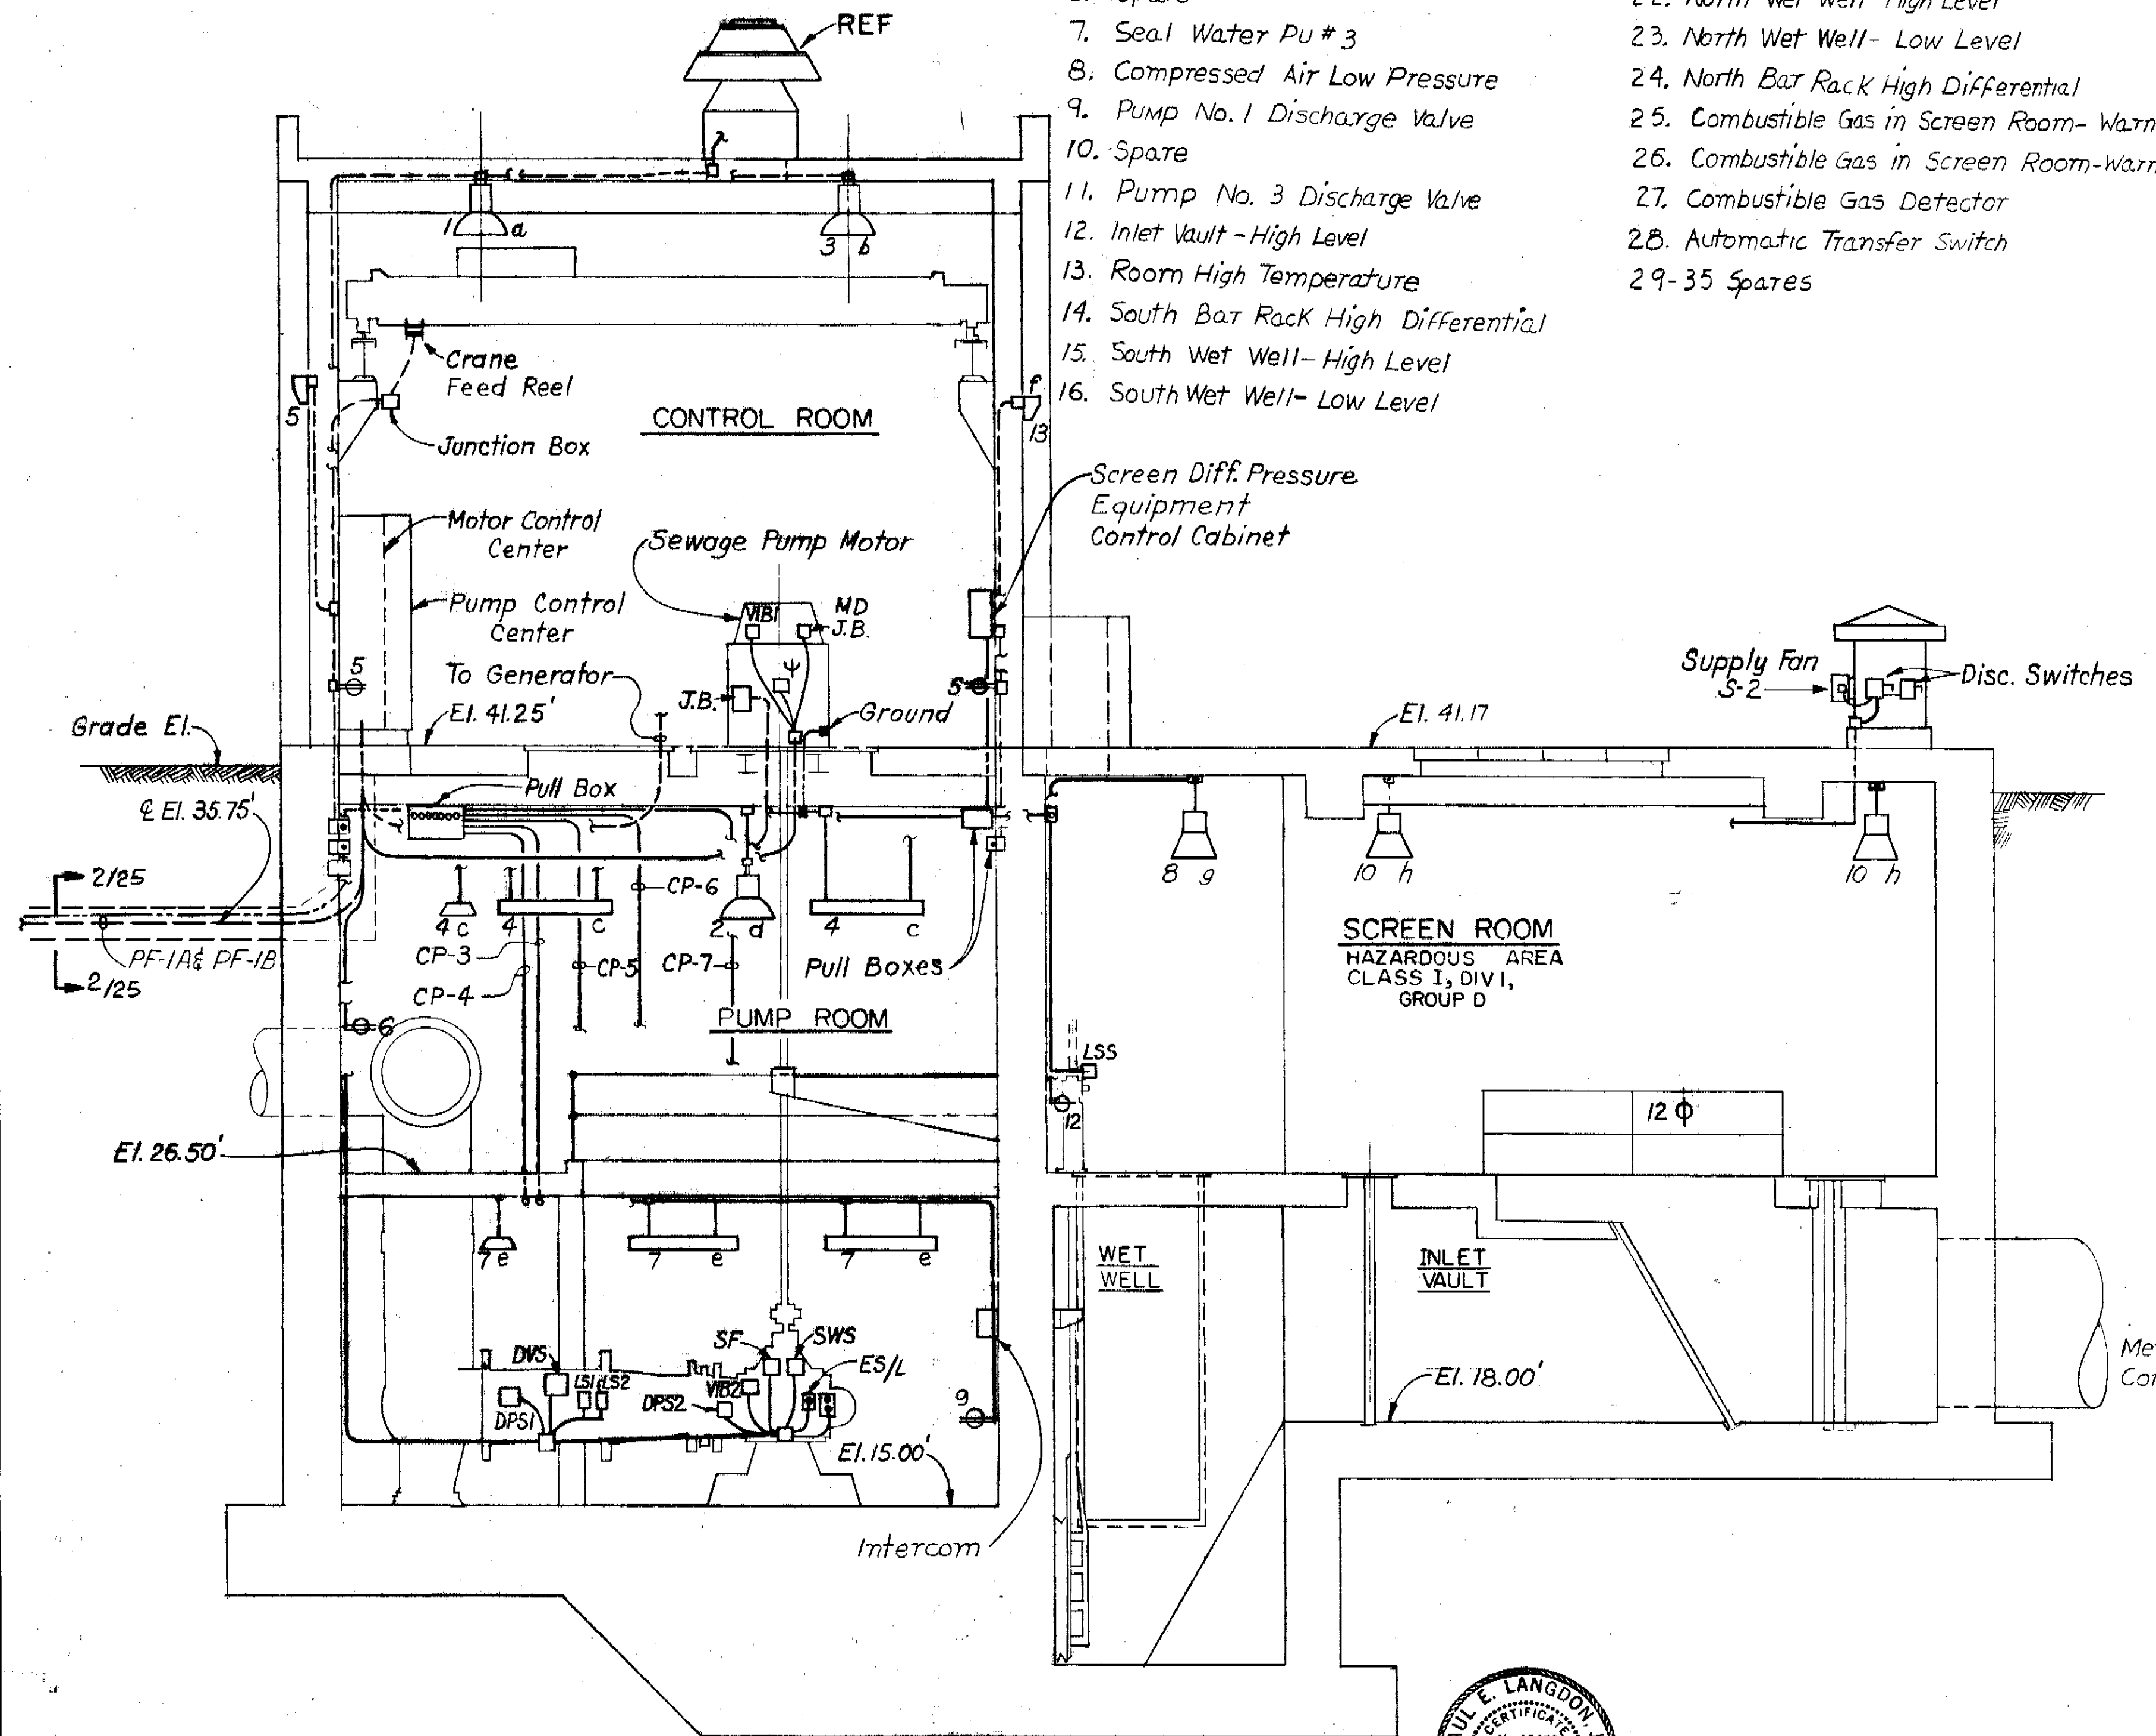

CONTROL CENTER
FRONT VIEW
NOT TO SCALE

SECTION 4/30, 31
SCALE 1/4"=1'-0"




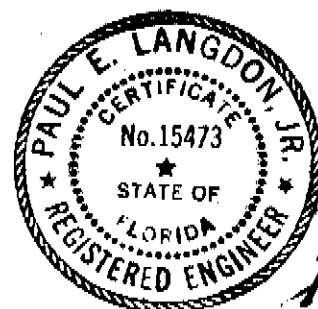


NOTE:
ALL ELEVATIONS SHOWN ARE REFERENCED TO CITY OF TAMPA DATUM. TO CONVERT TO NATIONAL OCEAN SURVEY (NOS) DATUM, SUBTRACT 0.15 FEET (0'-1 13/16").

RECORD DRAWING
THIS RECORD DRAWING IS NOT WARRANTED BUT IS BELIEVED TO REPRESENT CONDITIONS UPON COMPLETION OF CONSTRUCTION WITHIN REASONABLE TOLERANCES BASED UPON THE INFORMATION FURNISHED TO THE ENGINEER PERTAINING TO CHANGES MADE DURING CONSTRUCTION.

GREELEY AND HANSEN ENGINEERS 222 S. RIVERSIDE PLAZA CHICAGO, ILLINOIS 60606	DESIGNED KK	APPROVED	2 10-81 GSH Rec Dwg. Revisions 1 Dec. 78 JEP Added Addendum No. 1 Mar. 78 JEP Plans Updated	SCALE 1/4"=1'-0"	CITY OF TAMPA, FLORIDA SEWAGE DISPOSAL SYSTEM DIVISION 4G3 131 ST. AVENUE PUMPING STATION	ELECTRICAL SECTION AND CONDUIT AND WIRE SCHEDULE	PROJ. NO. S 202-70-30D-7-463
	DRAWN FS	DATE					SHEET 32 OF 35
CHECKED OA, KK	DATE	DATE	NO. DATE APP. REVISION				DATE AUGUST, 1972 REV. 2

173-69

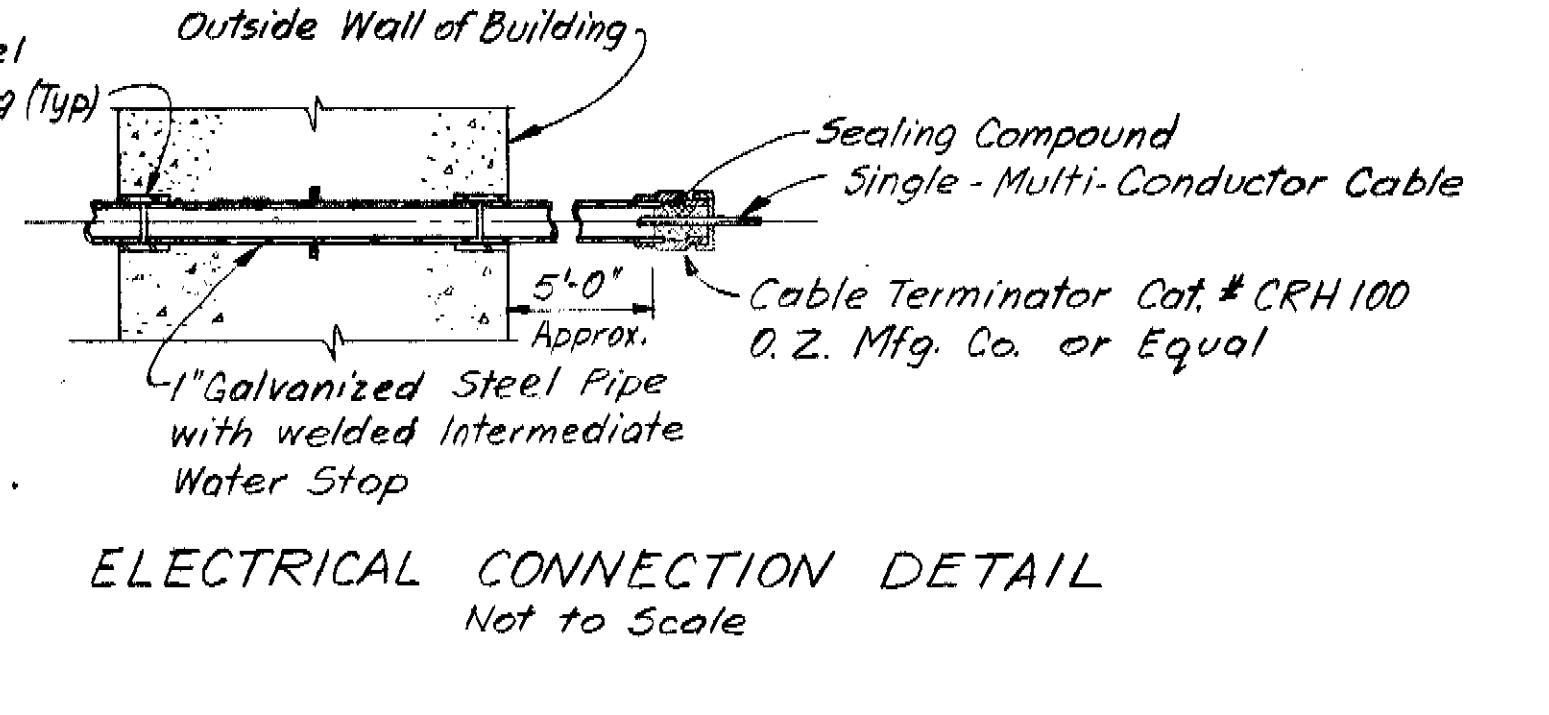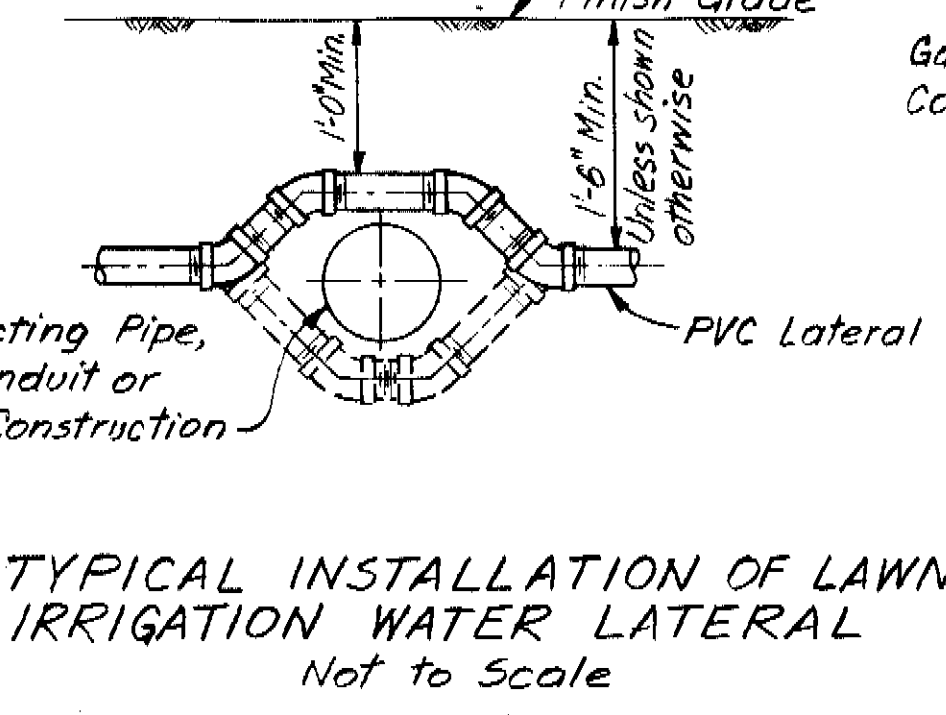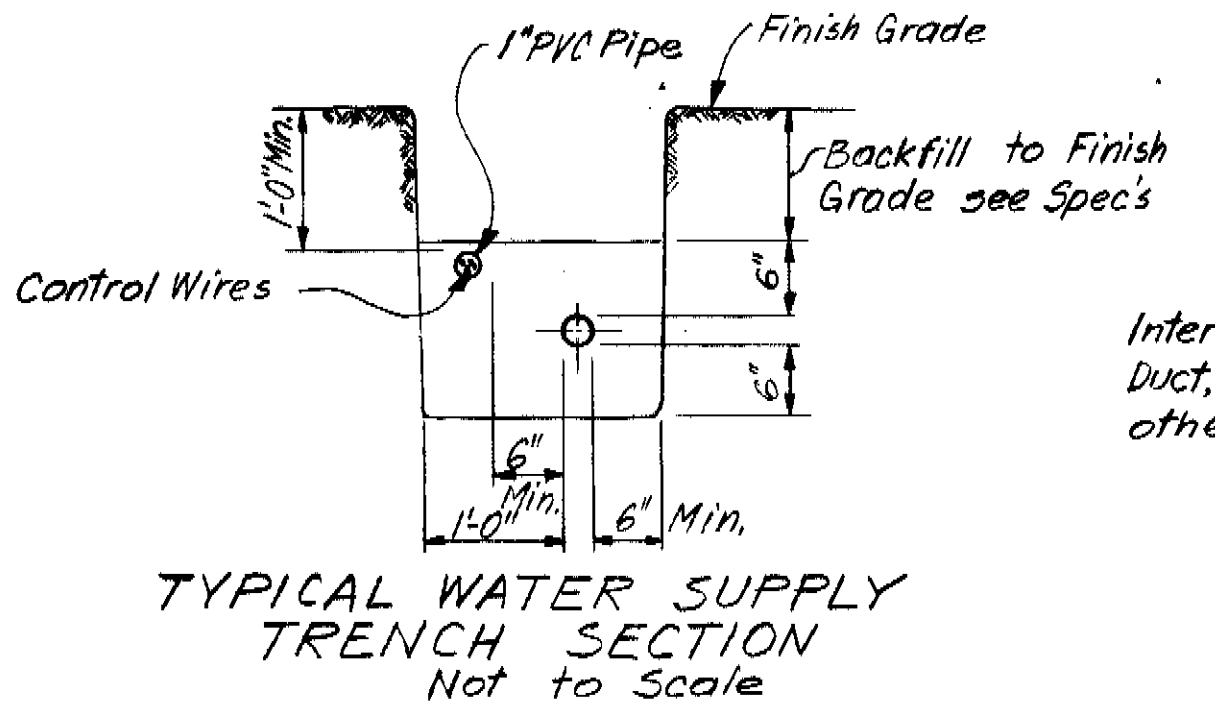
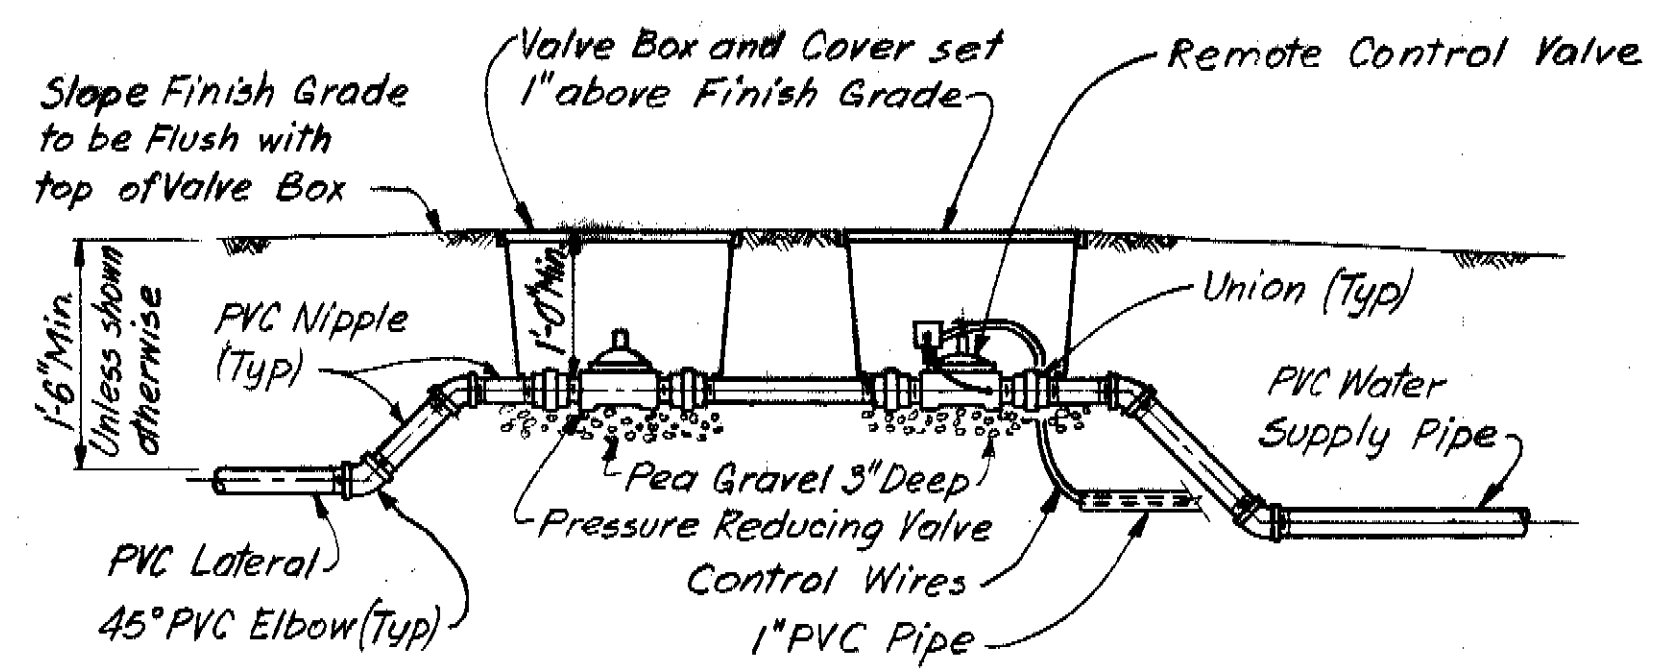


REMOTE CONTROL & PRESSURE REDUCING VALVES CONNECTION DETAILS
Not to Scale

TYPICAL WATER SUPPLY TRENCH SECTION
Not to Scale

TYPICAL INSTALLATION OF LAWN IRRIGATION WATER LATERAL
Not to Scale


ELECTRICAL CONNECTION DETAIL
Not to Scale

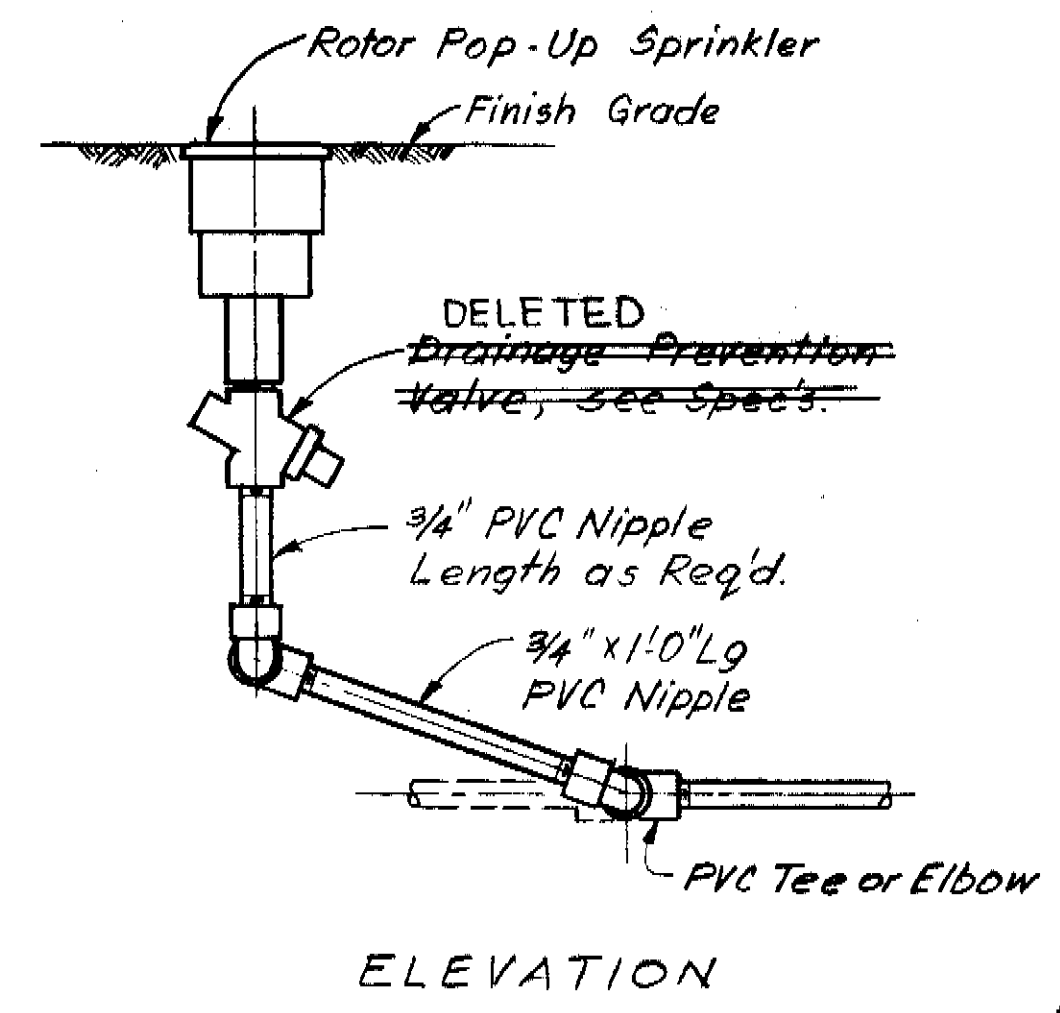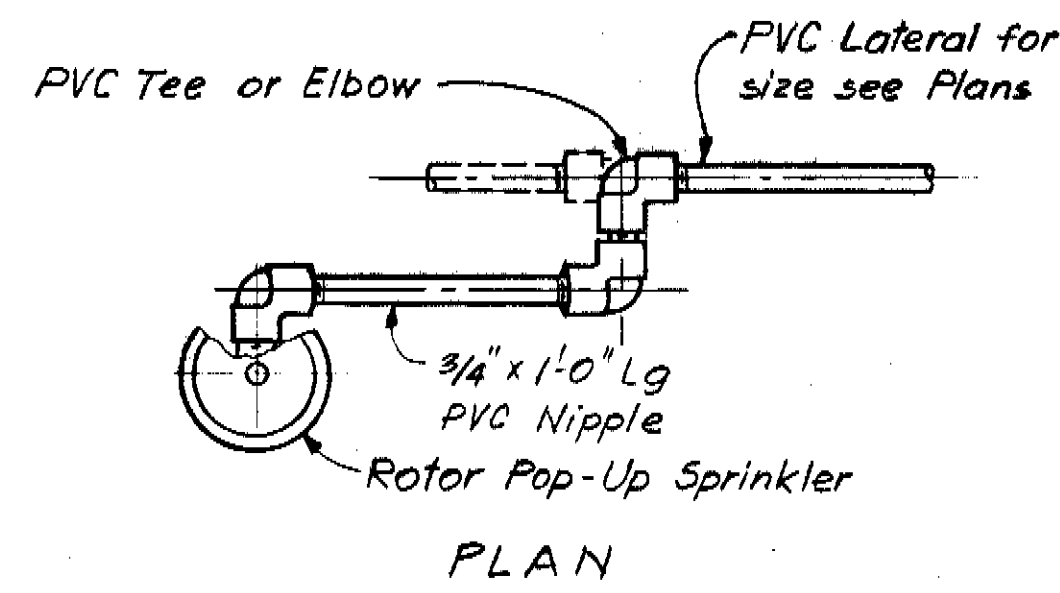


PLAN

ELEVATION

ROTOR POP-UP SPRINKLER SWING JOINT RISER DETAIL
Not to Scale

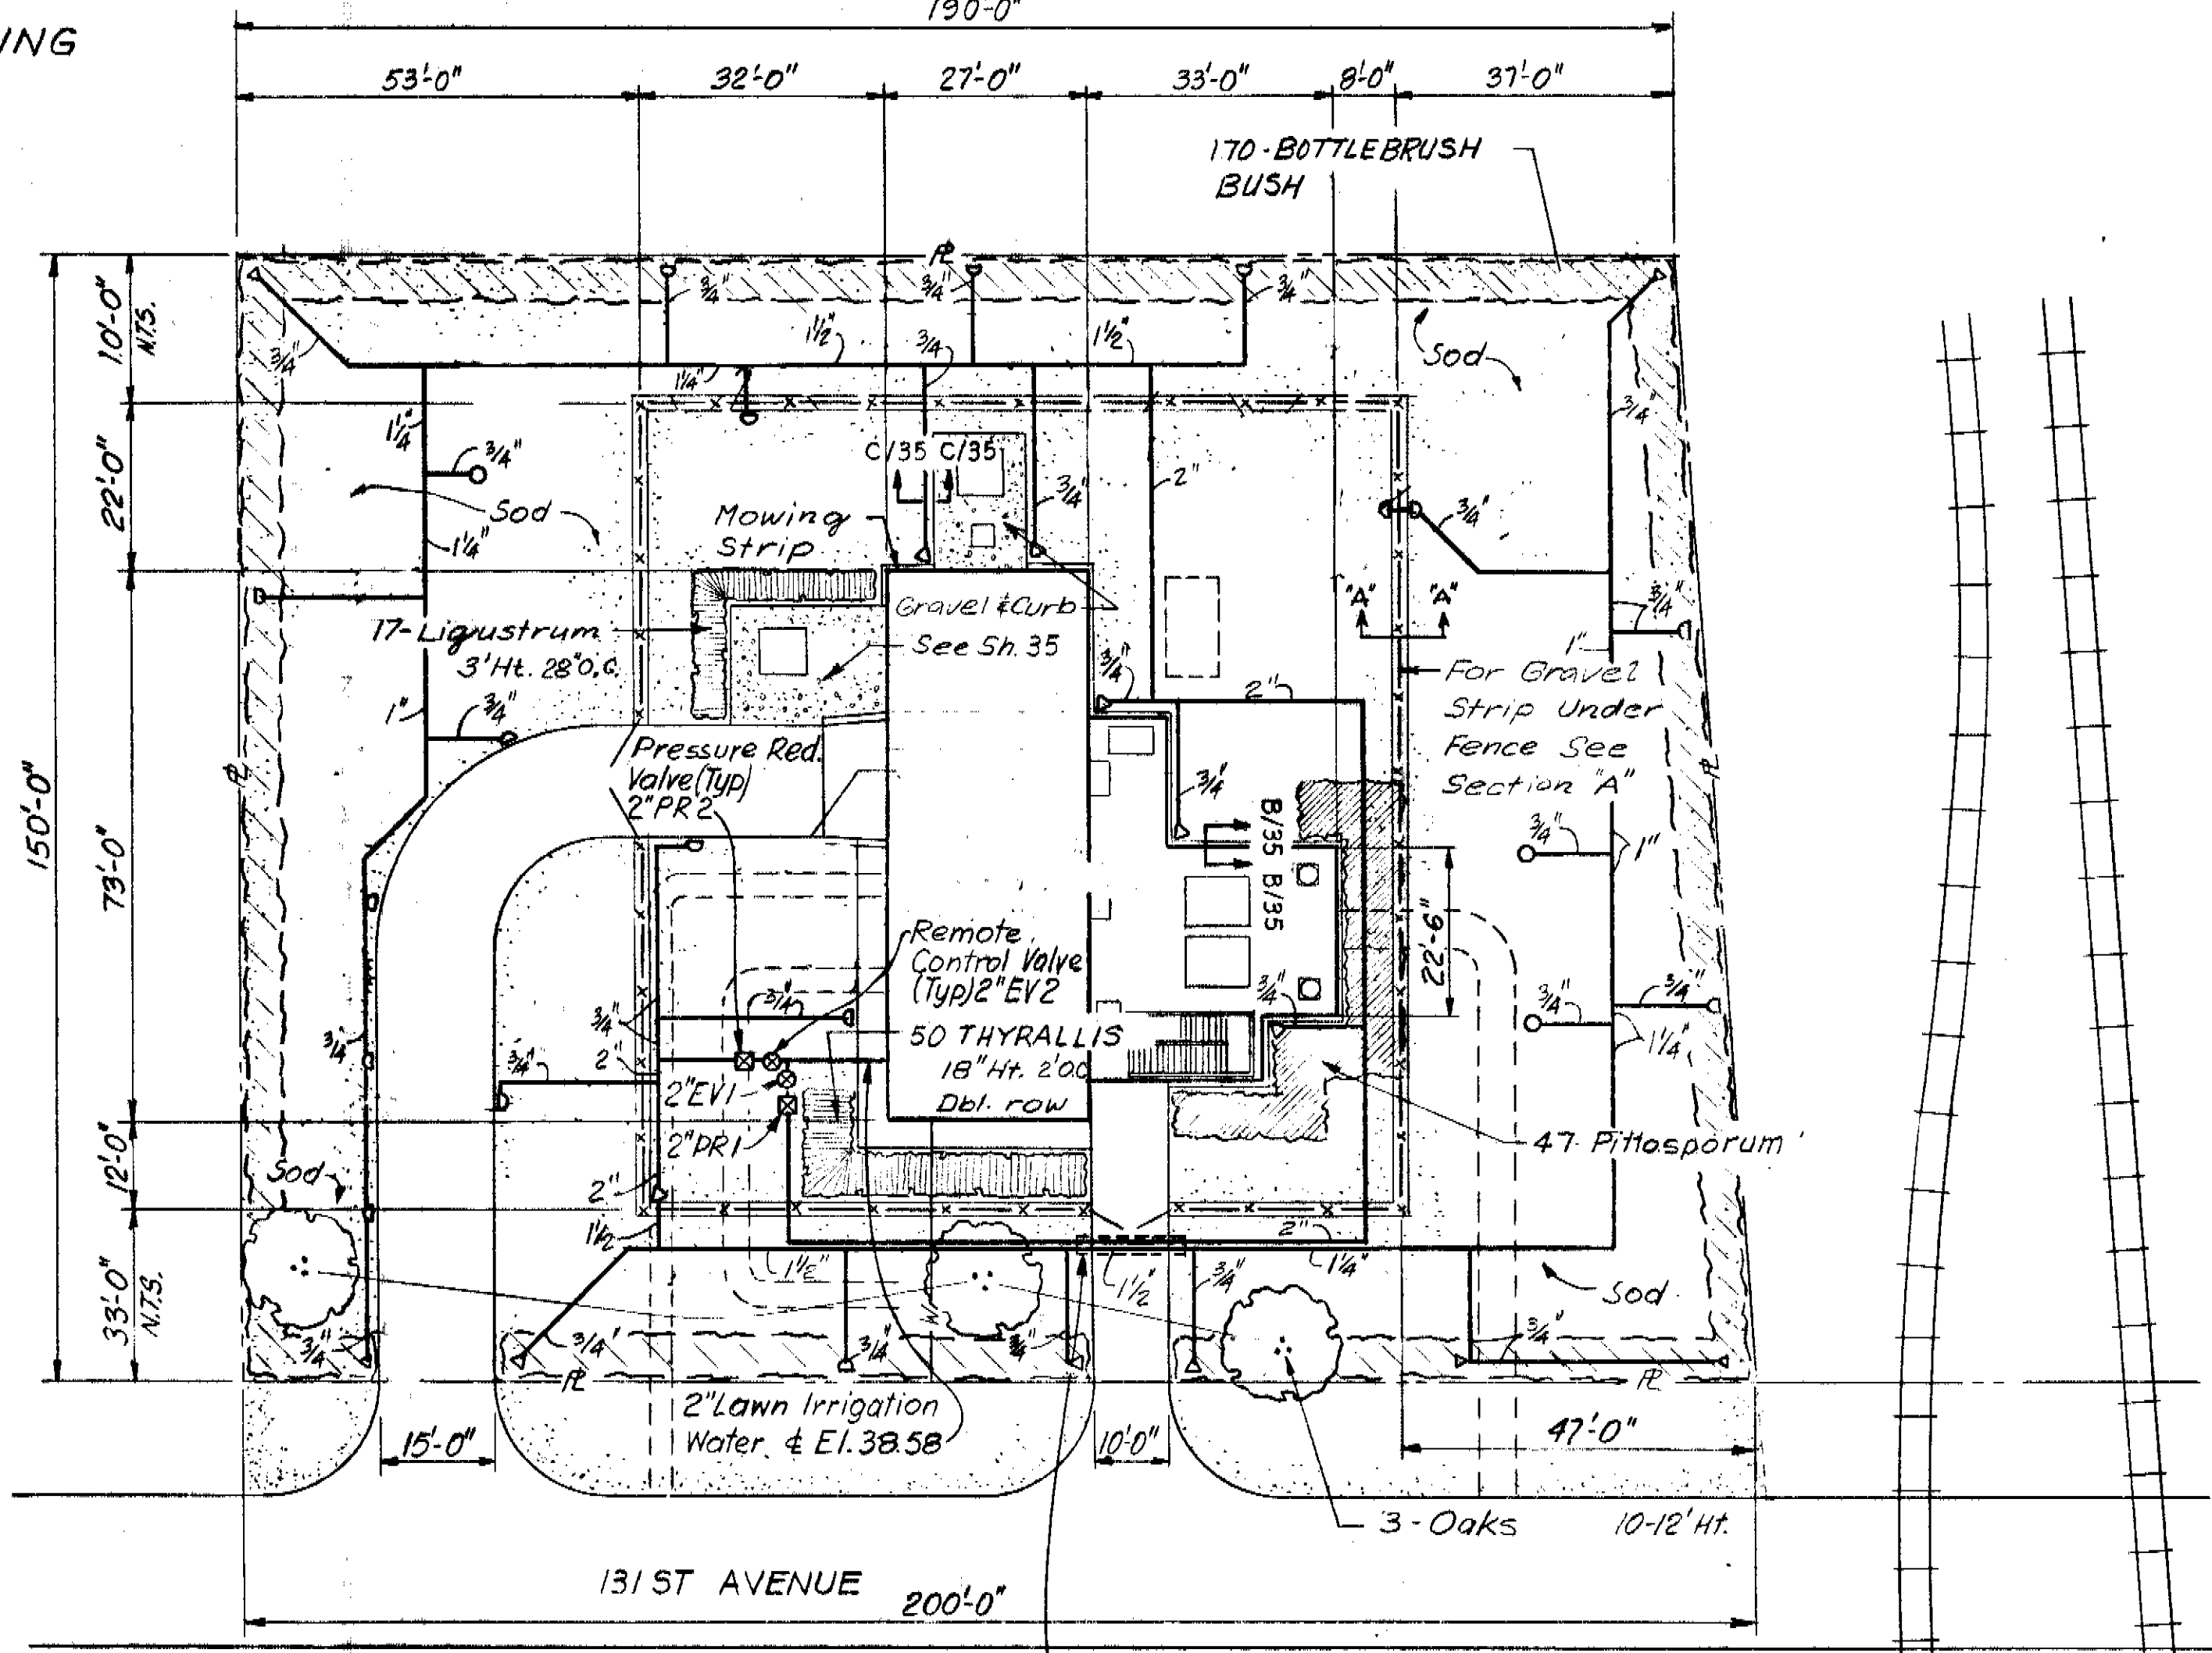

LANDSCAPE DEVELOPMENT PLAN
Scale: 1"=20'

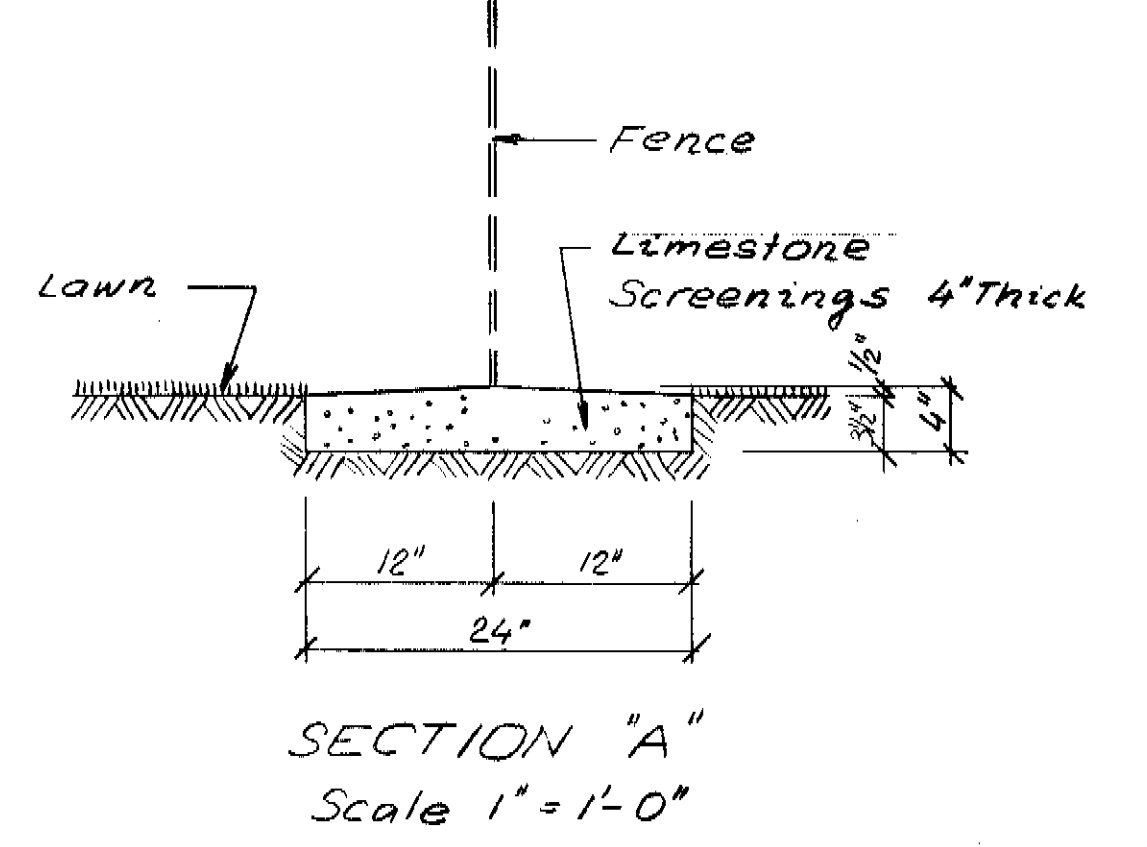

SECTION "A"
Scale 1"=1'-0"

NOTE:
For Typical Tree Planting Details see Sheet 34.

LAWN IRRIGATION SCHEDULE									
Station No.	GPM per Station	Valve Size & No. Remote Control	Press. Reducing	Sprinkler				Remarks	
				Symbol	Pattern	Qty	Min. Rad.		Max. Rad.
1	52.7	2"EV1	2"PR1	○	Full Circle	1	15'	38'	3.1
				◐	1/2 Circle	9			
				◑	1/4 Circle	7			
				◒	1/4 Circle	6			
2	52.7	2"EV2	2"PR2	○	Full Circle	2	15'	38'	3.1
				◐	1/2 Circle	9			
				◑	1/4 Circle	7			
				◒	1/4 Circle	6			

PLANT MATERIAL LIST				
COMMON NAME	BOTANICAL NAME	SIZE	QUANTITY	REMARKS
Australian Pine	Casuarina Equisetifolia	5' Ht.	26	
Weeping Fig	Ficus Benjamina	10-12'Ht.	4	Multi Stem
Schefflera	Brassia Actinophylla	18'Ht.	1	Multi Stem
Bottlebrush	Callistemon rigidus	8-9'Ht.	3	
Ligustrum	Ligustrum Lucidum	3'Ht.	17	
Confederate Jasmine	Trachelospermum Jas.	3 Gal.	50	
Pittosporum	Pittosporum Tobira	18" Ht.	47	

NOTE:
ALL ELEVATIONS SHOWN ARE REFERENCED TO CITY OF TAMPA DATUM. TO CONVERT TO NATIONAL OCEAN SURVEY (NOS) DATUM, SUBTRACT 0.15 FEET (0'-1.13/16").


RECORD DRAWING
THIS RECORD DRAWING IS NOT WARRANTED BUT IS BELIEVED TO REPRESENT CONDITIONS UPON COMPLETION OF CONSTRUCTION WITHIN REASONABLE TOLERANCES BASED UPON THE INFORMATION FURNISHED TO THE ENGINEER PERTAINING TO CHANGES MADE DURING CONSTRUCTION.

GREELEY AND HANSEN ENGINEERS
222 S. RIVERSIDE PLAZA
CHICAGO, ILLINOIS 60606

DESIGNED MW
DRAWN MW
CHECKED MW

APPROVED
DATE
Supt., Dept. of Sanitary Sewers
DATE
Greeley and Hansen, Engineers

NO.	DATE	APP.	REVISION
2	10/81	DSH	Rec. Dwg. Revisions
1	Jul. 78	JRP	Lawn Irrigation Piping Added

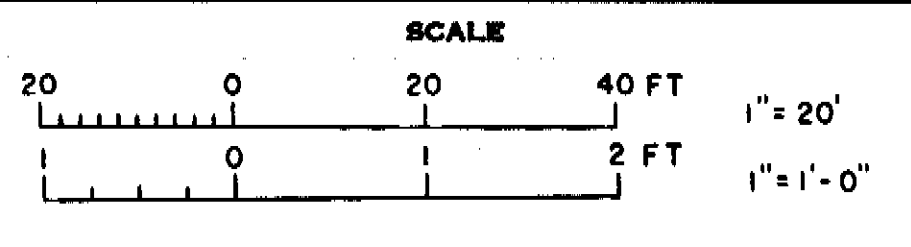


CITY OF TAMPA, FLORIDA
SEWAGE DISPOSAL SYSTEM
DIVISION 4G3
131ST AVENUE PUMPING STATION


LANDSCAPING
131 ST. AVENUE PUMPING STATION
LANDSCAPING PLAN

PROJ. NO. S 202-70-30D-7-463
SHEET 33 OF 35
DATE MARCH, 1978 REV. 2


173-7011

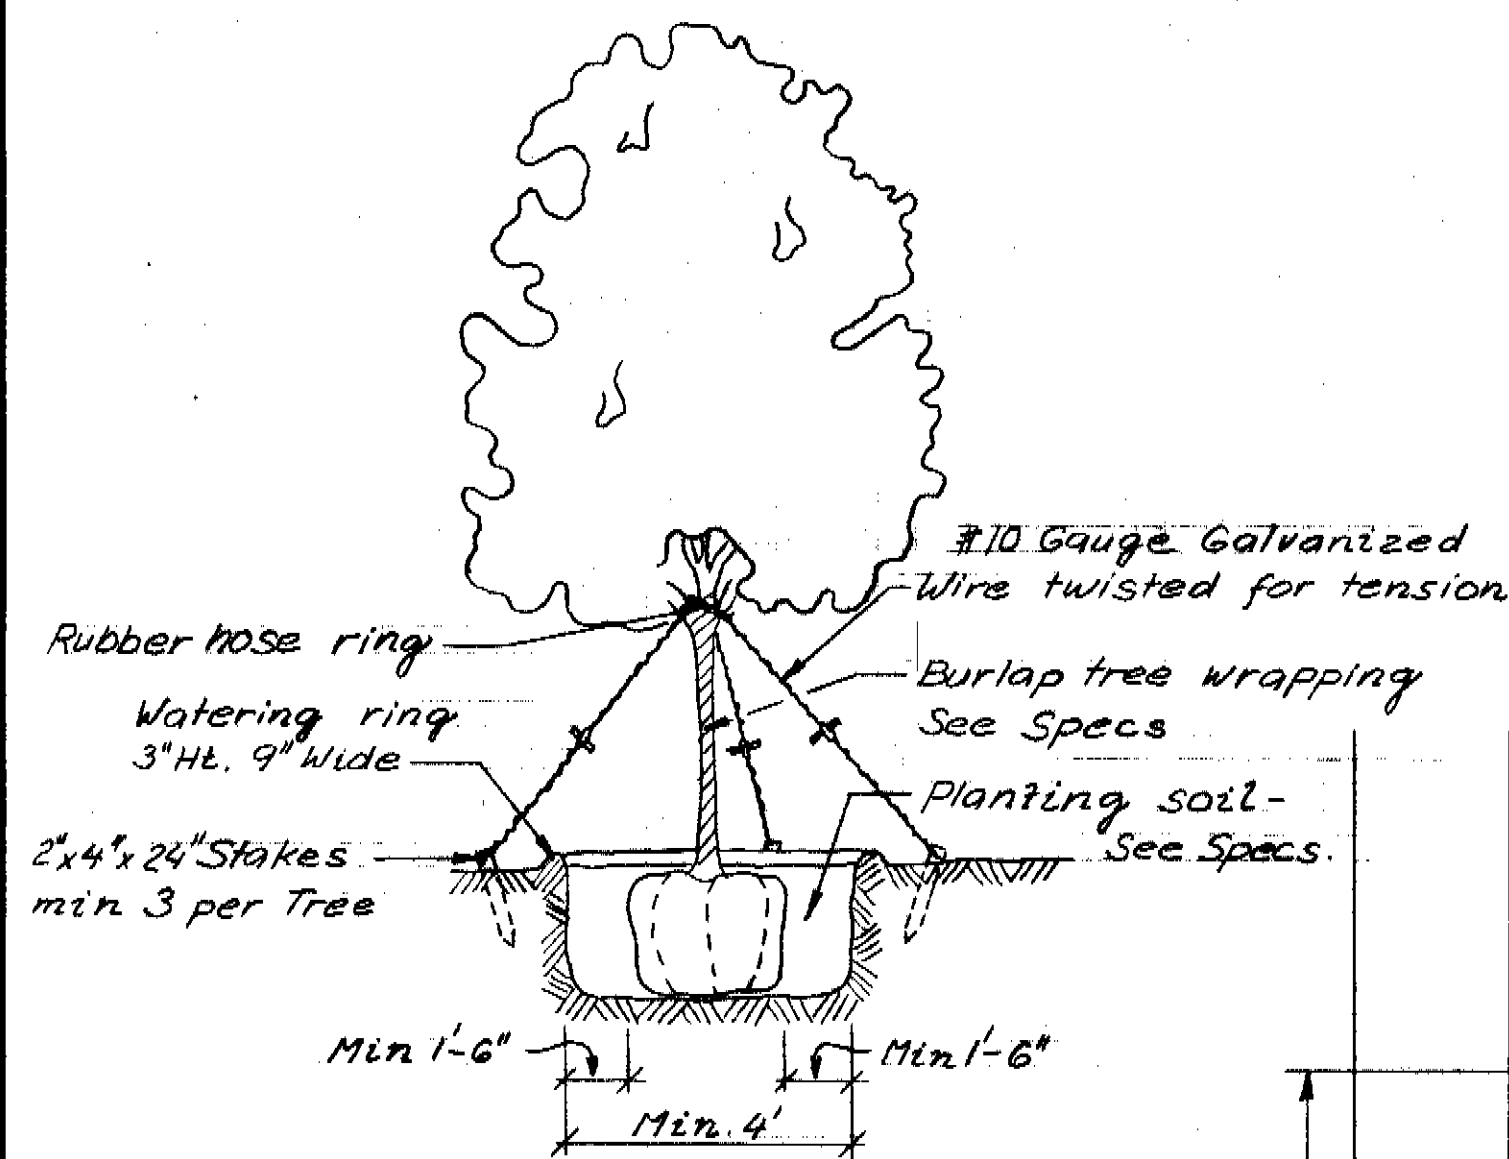


TYPICAL TREE PLANTING DETAIL
Scale 1/4" = 1'-0"

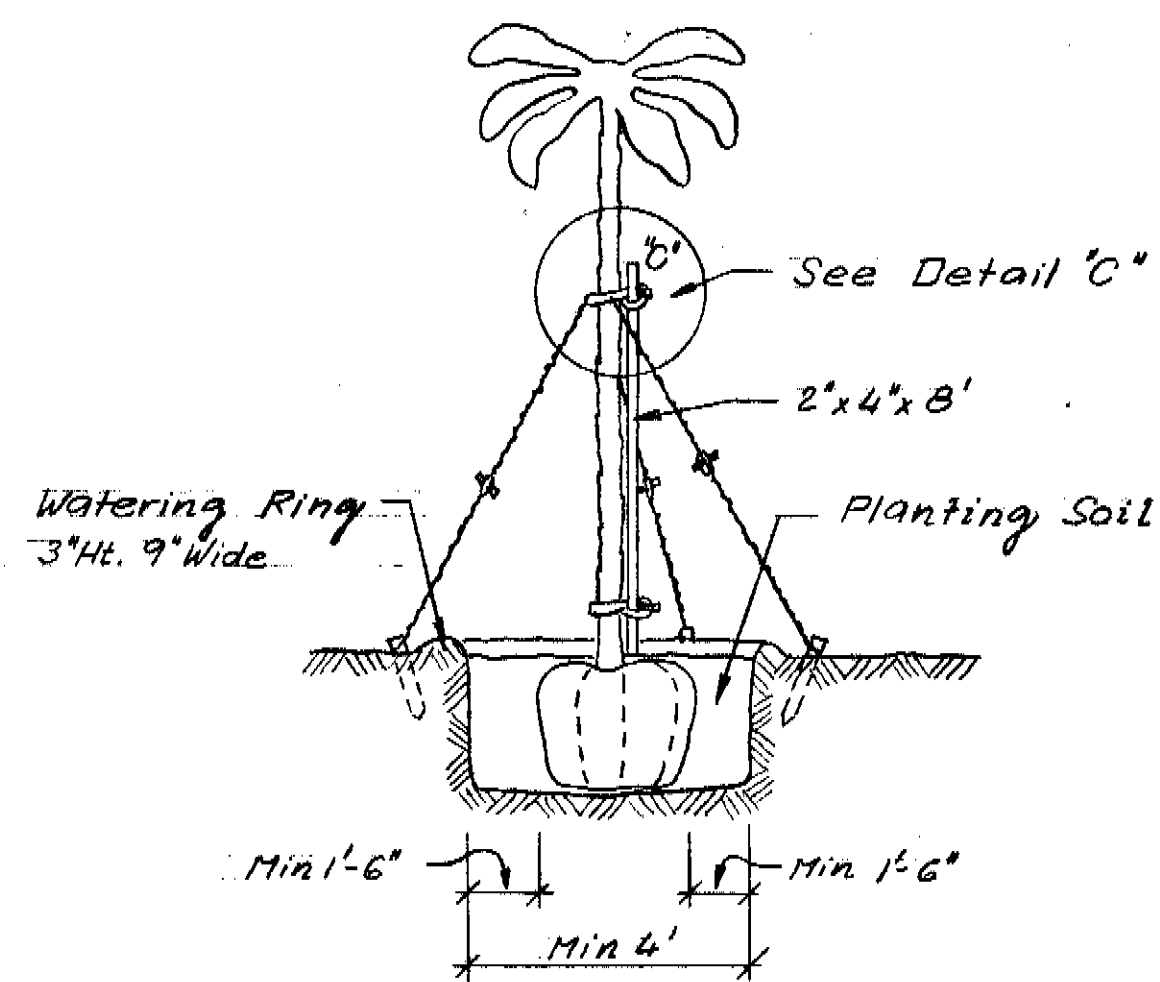


TYPICAL PALM PLANTING DETAIL
Scale 1/4" = 1'-0"

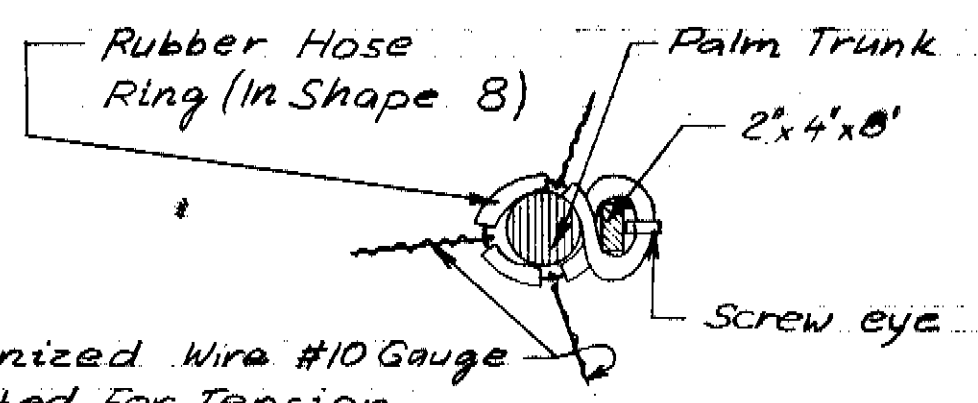

DETAIL "C"
No scale

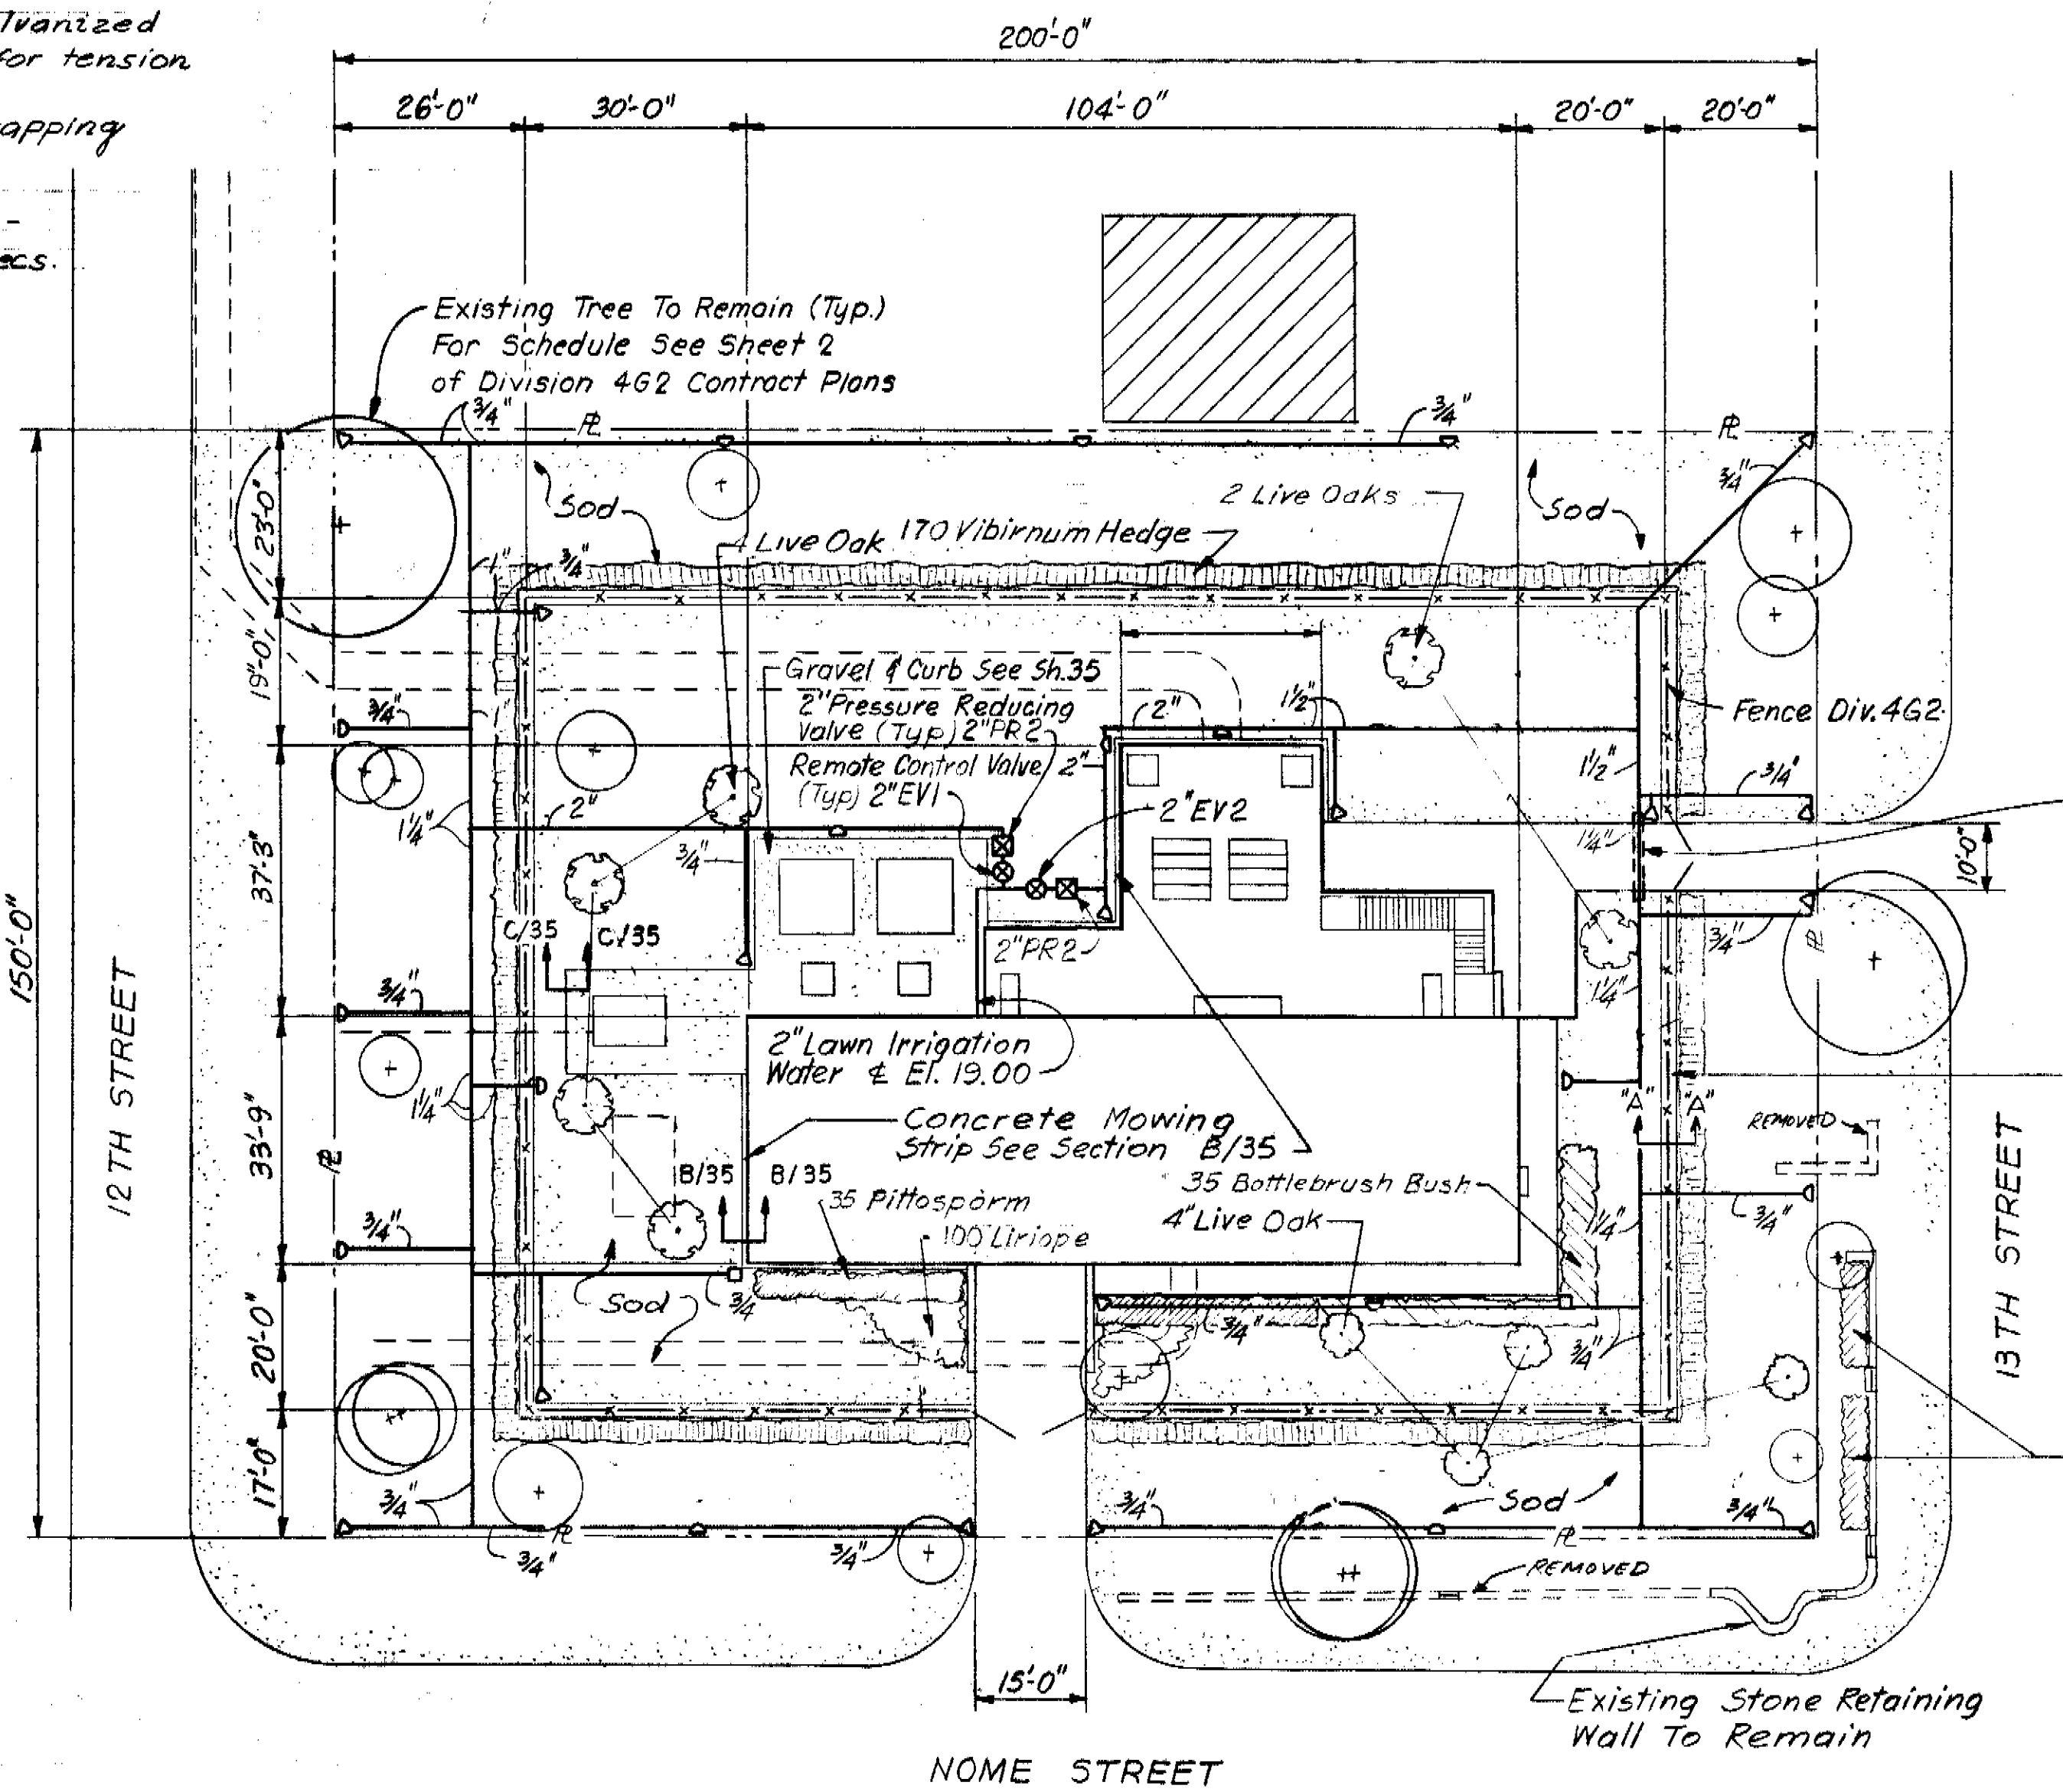

LANDSCAPE DEVELOPMENT PLAN
scale 1" = 20'

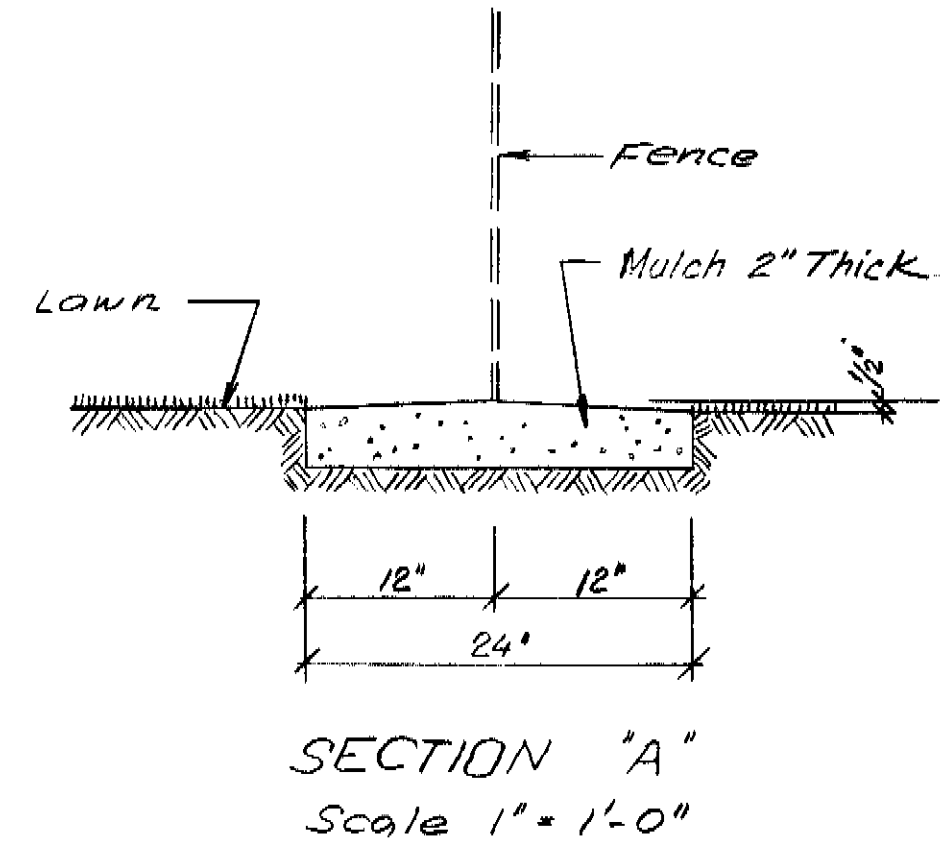

SECTION "A"
Scale 1" = 1'-0"

3" Sch 40 x 14'-0" Lg Black Welded Steel Casing Pipe ASTM Des: A-53 Gr. B Provide 6" Grout Seal at Each End.

For Mulch Strip Under Fence See Section "A"

Existing Shrubs To Remain

Existing Stone Retaining Wall To Remain

- NOTES:
1. For Typical Details of Lawn Irrigation Sprinkler, Valve, Piping and Control Wiring Installation see Sheet 33
 2. For Details of Site Work for 13th Street Pumping Station see Contract Drawings for Division 462

LAWN IRRIGATION SCHEDULE									
Station No.	GPM per Station	Valve Size & No.	Sprinkler				GPM @ 30 PSI	Remarks	
			Remote Control	Press. Reducing	Symbol	Pattern Qty.			
1	49.6	2" EV1	2" PR1	△	1/2 Circle	9	15' 38'	3.1	
				□	1/4 Circle	6			
				□	3/8 Circle	1			
2	49.6	2" EV2	2" PR2	△	1/2 Circle	5			
				△	1/4 Circle	9			
				□	3/8 Circle	2			





PLANT MATERIAL LIST				
COMMON NAME	BOTANICAL NAME	SIZE	QUANTITY	REMARKS
Senegal Date Palm	Phoenix Reclinata	14' Ct.	1	5- Stem
Palatka Holly	Ilex Opaca Var. Pal	8-9' Ht.	13	
Native Sabal Palm	Sabal Palmetto	12' Ct.	3	
Native Sabal Palm	Sabal Palmetto	10' Ct.	3	
Native Sabal Palm	Sabal Palmetto	8' Ct.	4	
Confederate Jasmine	Trachelospermum Jas.	3 Gal.	30	

NOTE: ALL ELEVATIONS SHOWN ARE REFERENCED TO CITY OF TAMPA DATUM. TO CONVERT TO NATIONAL OCEAN SURVEY (NOS) DATUM, SUBTRACT 0.15 FEET (0'-1 13/16").

RECORD DRAWING
THIS RECORD DRAWING IS NOT WARRANTED BUT IS BELIEVED TO REPRESENT CONDITIONS UPON COMPLETION OF CONSTRUCTION, WITHIN REASONABLE TOLERANCES, BASED UPON THE INFORMATION FURNISHED TO THE ENGINEER PERTAINING TO CHANGES MADE DURING CONSTRUCTION.

GREELEY AND HANSEN ENGINEERS 222 S. RIVERSIDE PLAZA CHICAGO, ILLINOIS 60606	DESIGNED MW	APPROVED	SCALE 0 20 40 FT 1" = 20' 0 4 8 FT 1/4" = 1'-0" 0 2 FT 1" = 1'-0"	CITY OF TAMPA, FLORIDA SEWAGE DISPOSAL SYSTEM DIVISION 4G3 131 ST. AVENUE PUMPING STATION	LANDSCAPING 13TH STREET PUMPING STATION LANDSCAPING PLAN	PROJ. NO. 5 202-70-30D -7- 4G3
	DRAWN MW	DATE				SHEET 34 OF 35
	CHECKED MW	DATE				DATE MARCH, 1978 REV. 2

173-71

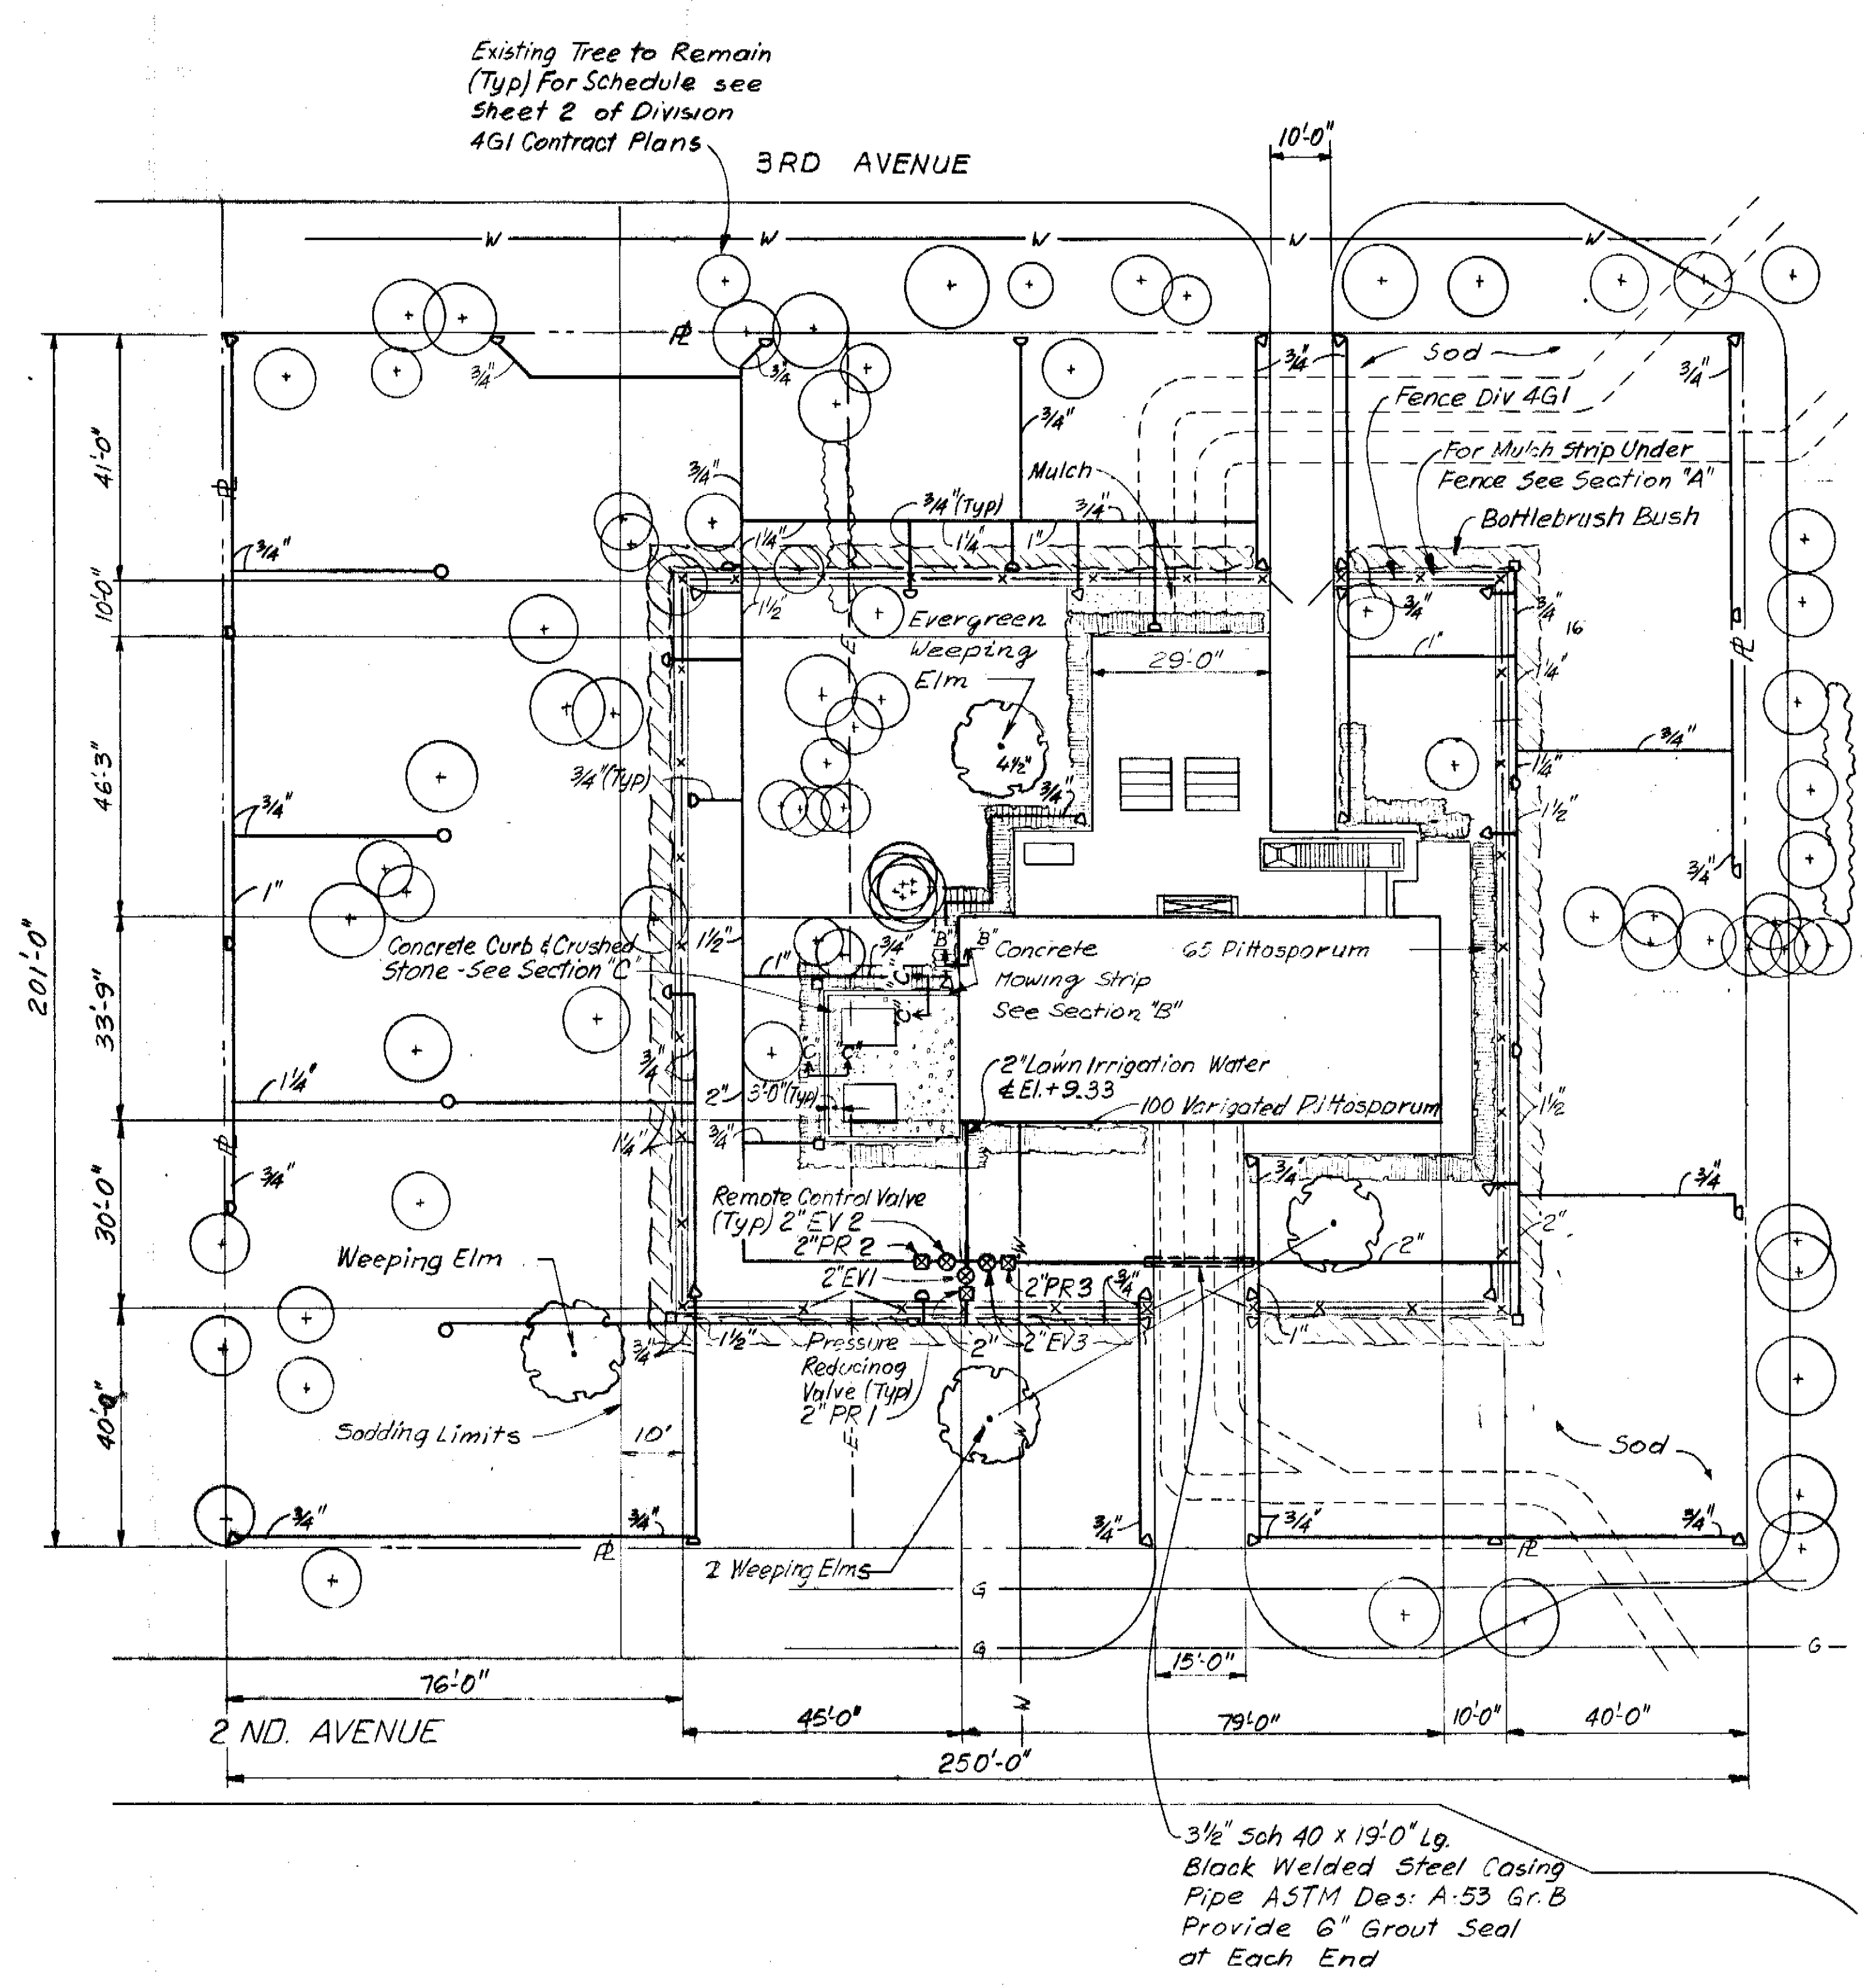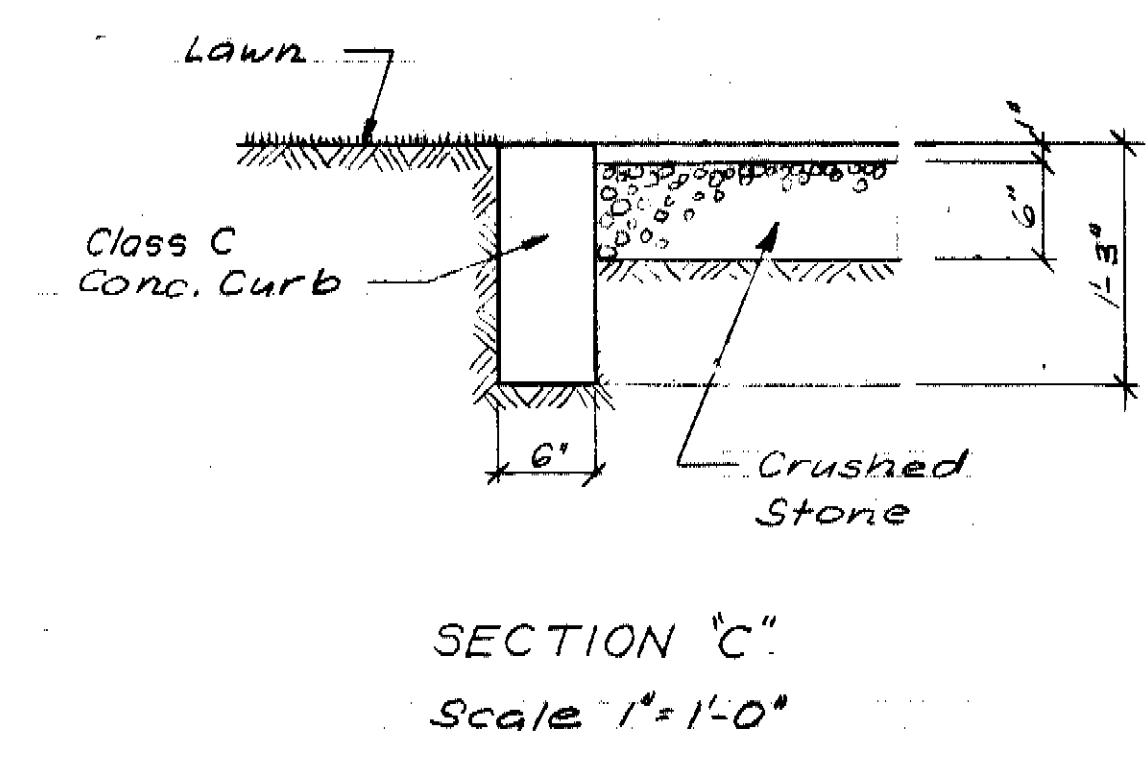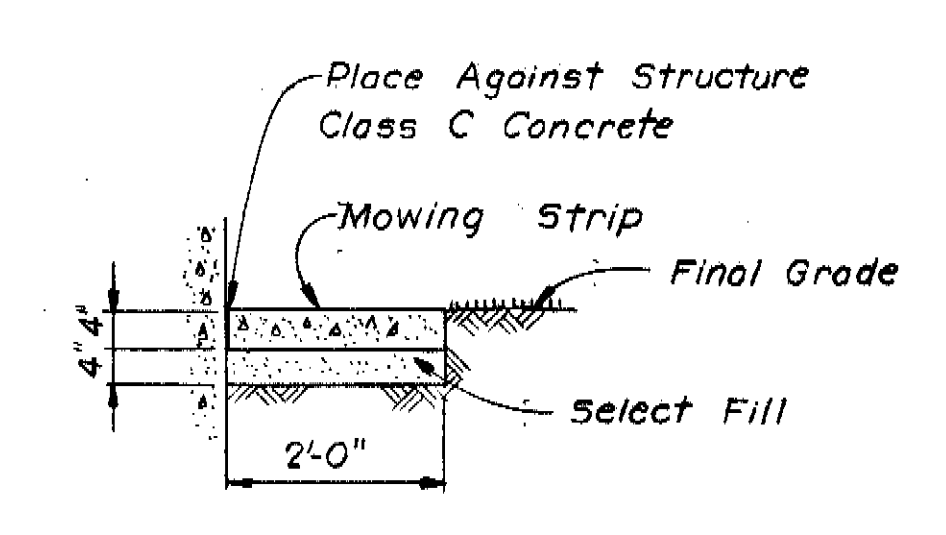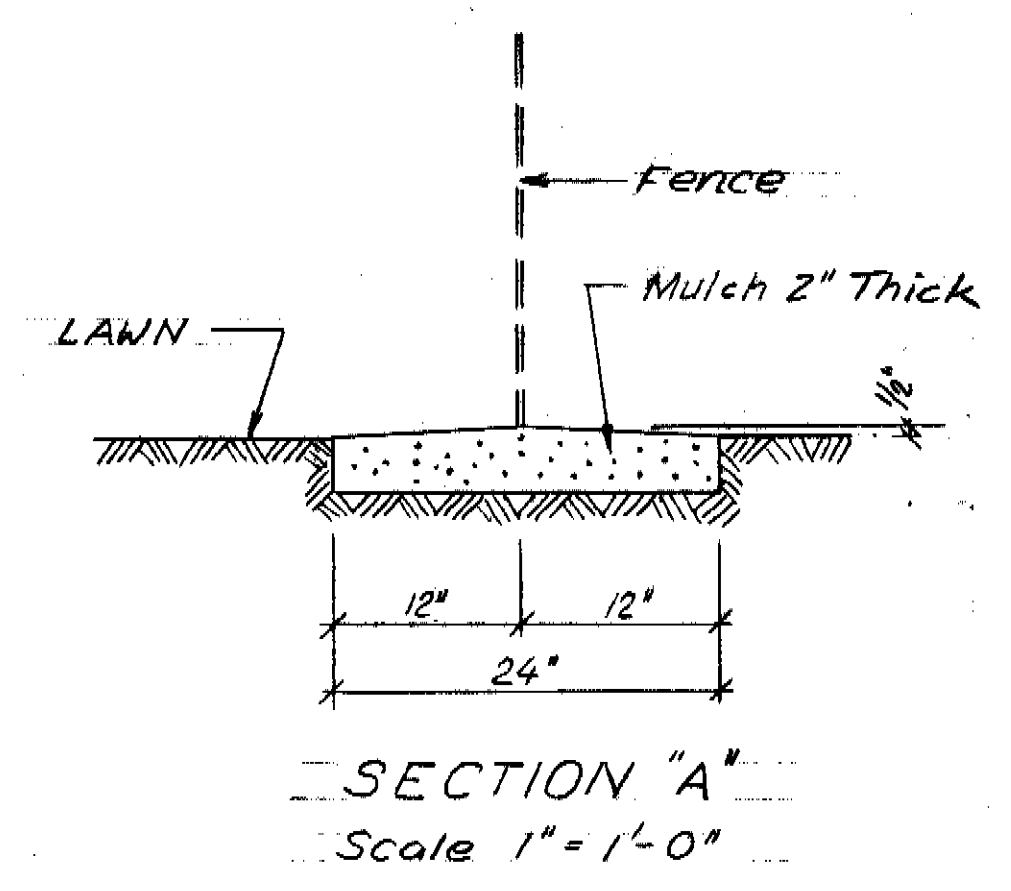

- NOTES:
1. For Typical Tree Planting Details see Sheet 34.
 2. For Typical Details of Lawn Irrigation Sprinkler, Valve, Piping and Control Wiring Installation see Sheet 33.
 3. For Details of Site Work for 25th Street Pumping Station see Contract Drawings for Division 4G1.

LAWN IRRIGATION SCHEDULE									
Station No.	GPM per Station	Valve Size & No.	Sprinkler				GPM @ 30 PSI	Remarks	
			Symbol	Pattern	Qty.	Min. Rad.			
1	58.9	2"EV1 2"PR1	○	Full Circle	4				
			△	1/2 Circle	8				
			□	1/4 Circle	6				
			◇	3/4 Circle	1				
2	55.8	2"EV2 2"PR2	○	1/2 Circle	9	15'	38'	3.1	
			△	1/4 Circle	7				
			□	3/4 Circle	2				
			◇	1/2 Circle	6				
3	68.2	2"EV3 2"PR3	○	1/2 Circle	6				
			△	1/4 Circle	14				
			□	3/4 Circle	2				
			◇	1/2 Circle	2				


PLANT MATERIAL LIST				
COMMON NAME	BOTANICAL NAME	SIZE	QUANTITY	REMARKS
Evergreen Weeping Elm	Ulmus Parv. Sempervirens	4 1/2" Cal.	1	For Detail at Top
Punk Tree	Melaleuca Quinquenervia	16' Ht.	1	Multi Stem
Punk Tree	Melaleuca Quinquenervia	14' Ht.	3	Multi Stem
Punk Tree	Melaleuca Quinquenervia	12' Ht.	4	Multi Stem
Punk Tree	Melaleuca Quinquenervia	10' Ht.	1	Multi Stem
Schefflera	Brassia Actinophylla	18' Ht.	1	Multi Stem
Schefflera	Brassia Actinophylla	16' Ht.	1	Multi Stem
Schefflera	Brassia Actinophylla	15' Ht.	1	Multi Stem
Schefflera	Brassia Actinophylla	12' Ht.	2	Multi Stem
Weeping Fig	Ficus Benjaminia	7-8' Ht.	11	
Red Maple	Acer Rubrum	7" Cal.	1	
Red Maple	Acer Rubrum	6" Cal.	2	
Confederate Jasmine	Trachelospermum Jas.	3 Gal.	100	
Dwarf Yaupon Holly	Ilex Vomitoria Nana	18" Ht.	65	

NOTE:
ALL ELEVATIONS SHOWN ARE REFERENCED TO CITY OF TAMPA DATUM. TO CONVERT TO NATIONAL OCEAN SURVEY (NOS) DATUM, SUBTRACT 0.15 FEET (0'-1 13/16").


RECORD DRAWING
THIS RECORD DRAWING IS NOT WARRANTED BUT IS BELIEVED TO REPRESENT CONDITIONS UPON COMPLETION OF CONSTRUCTION WITHIN REASONABLE TOLERANCES, BASED UPON THE INFORMATION FURNISHED TO THE ENGINEER PERTAINING TO CHANGES MADE DURING CONSTRUCTION.

GREELEY AND HANSEN ENGINEERS 222 S. RIVERSIDE PLAZA CHICAGO, ILLINOIS 60606	DESIGNED MW	APPROVED	SCALE 0 20 40 FT 1" = 20' 0 2 FT 1" = 1'-0"	CITY OF TAMPA, FLORIDA SEWAGE DISPOSAL SYSTEM DIVISION 4G3 131ST AVENUE PUMPING STATION	LANDSCAPING 25TH STREET PUMPING STATION LANDSCAPING PLAN	PROJ. NO. 5 202-70-SOD-7-4G3
	DRAWN MW	DATE				SHEET 35 OF 35
	CHECKED MW	DATE				DATE MARCH, 1978 REV. 2

173-72

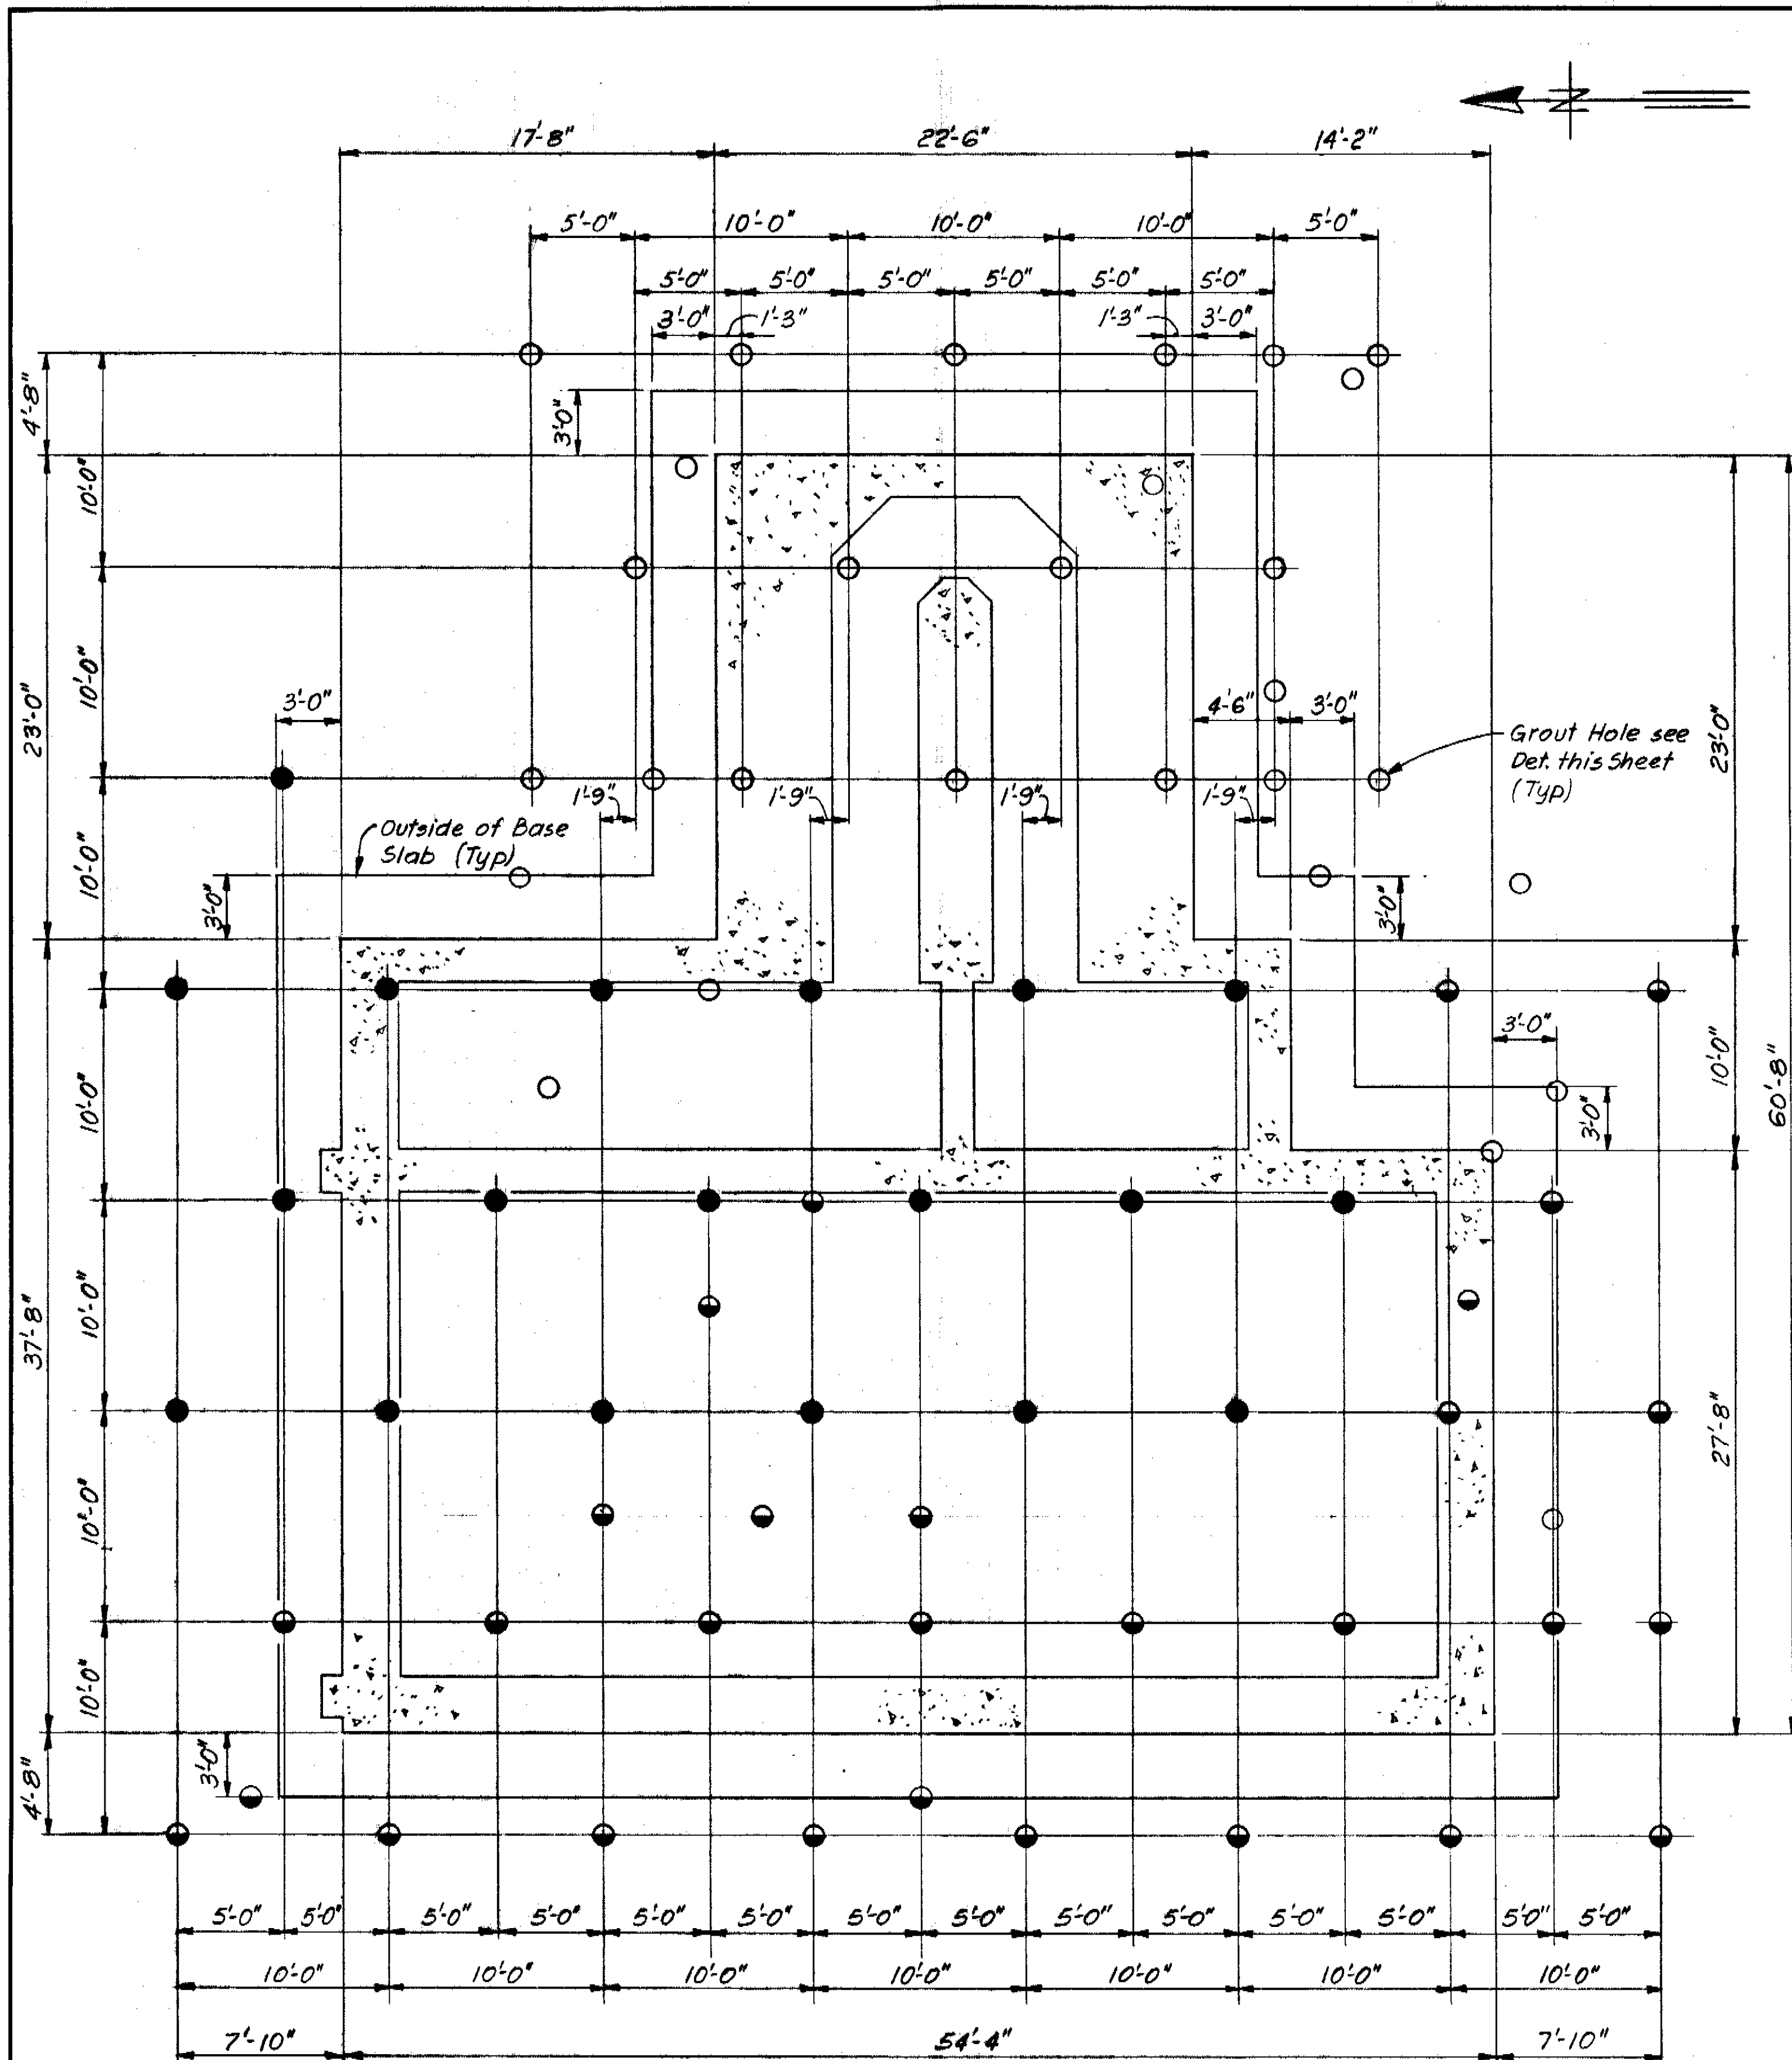

GROUT HOLES LOCATION PLAN
SCALE: 3/16" = 1'-0"

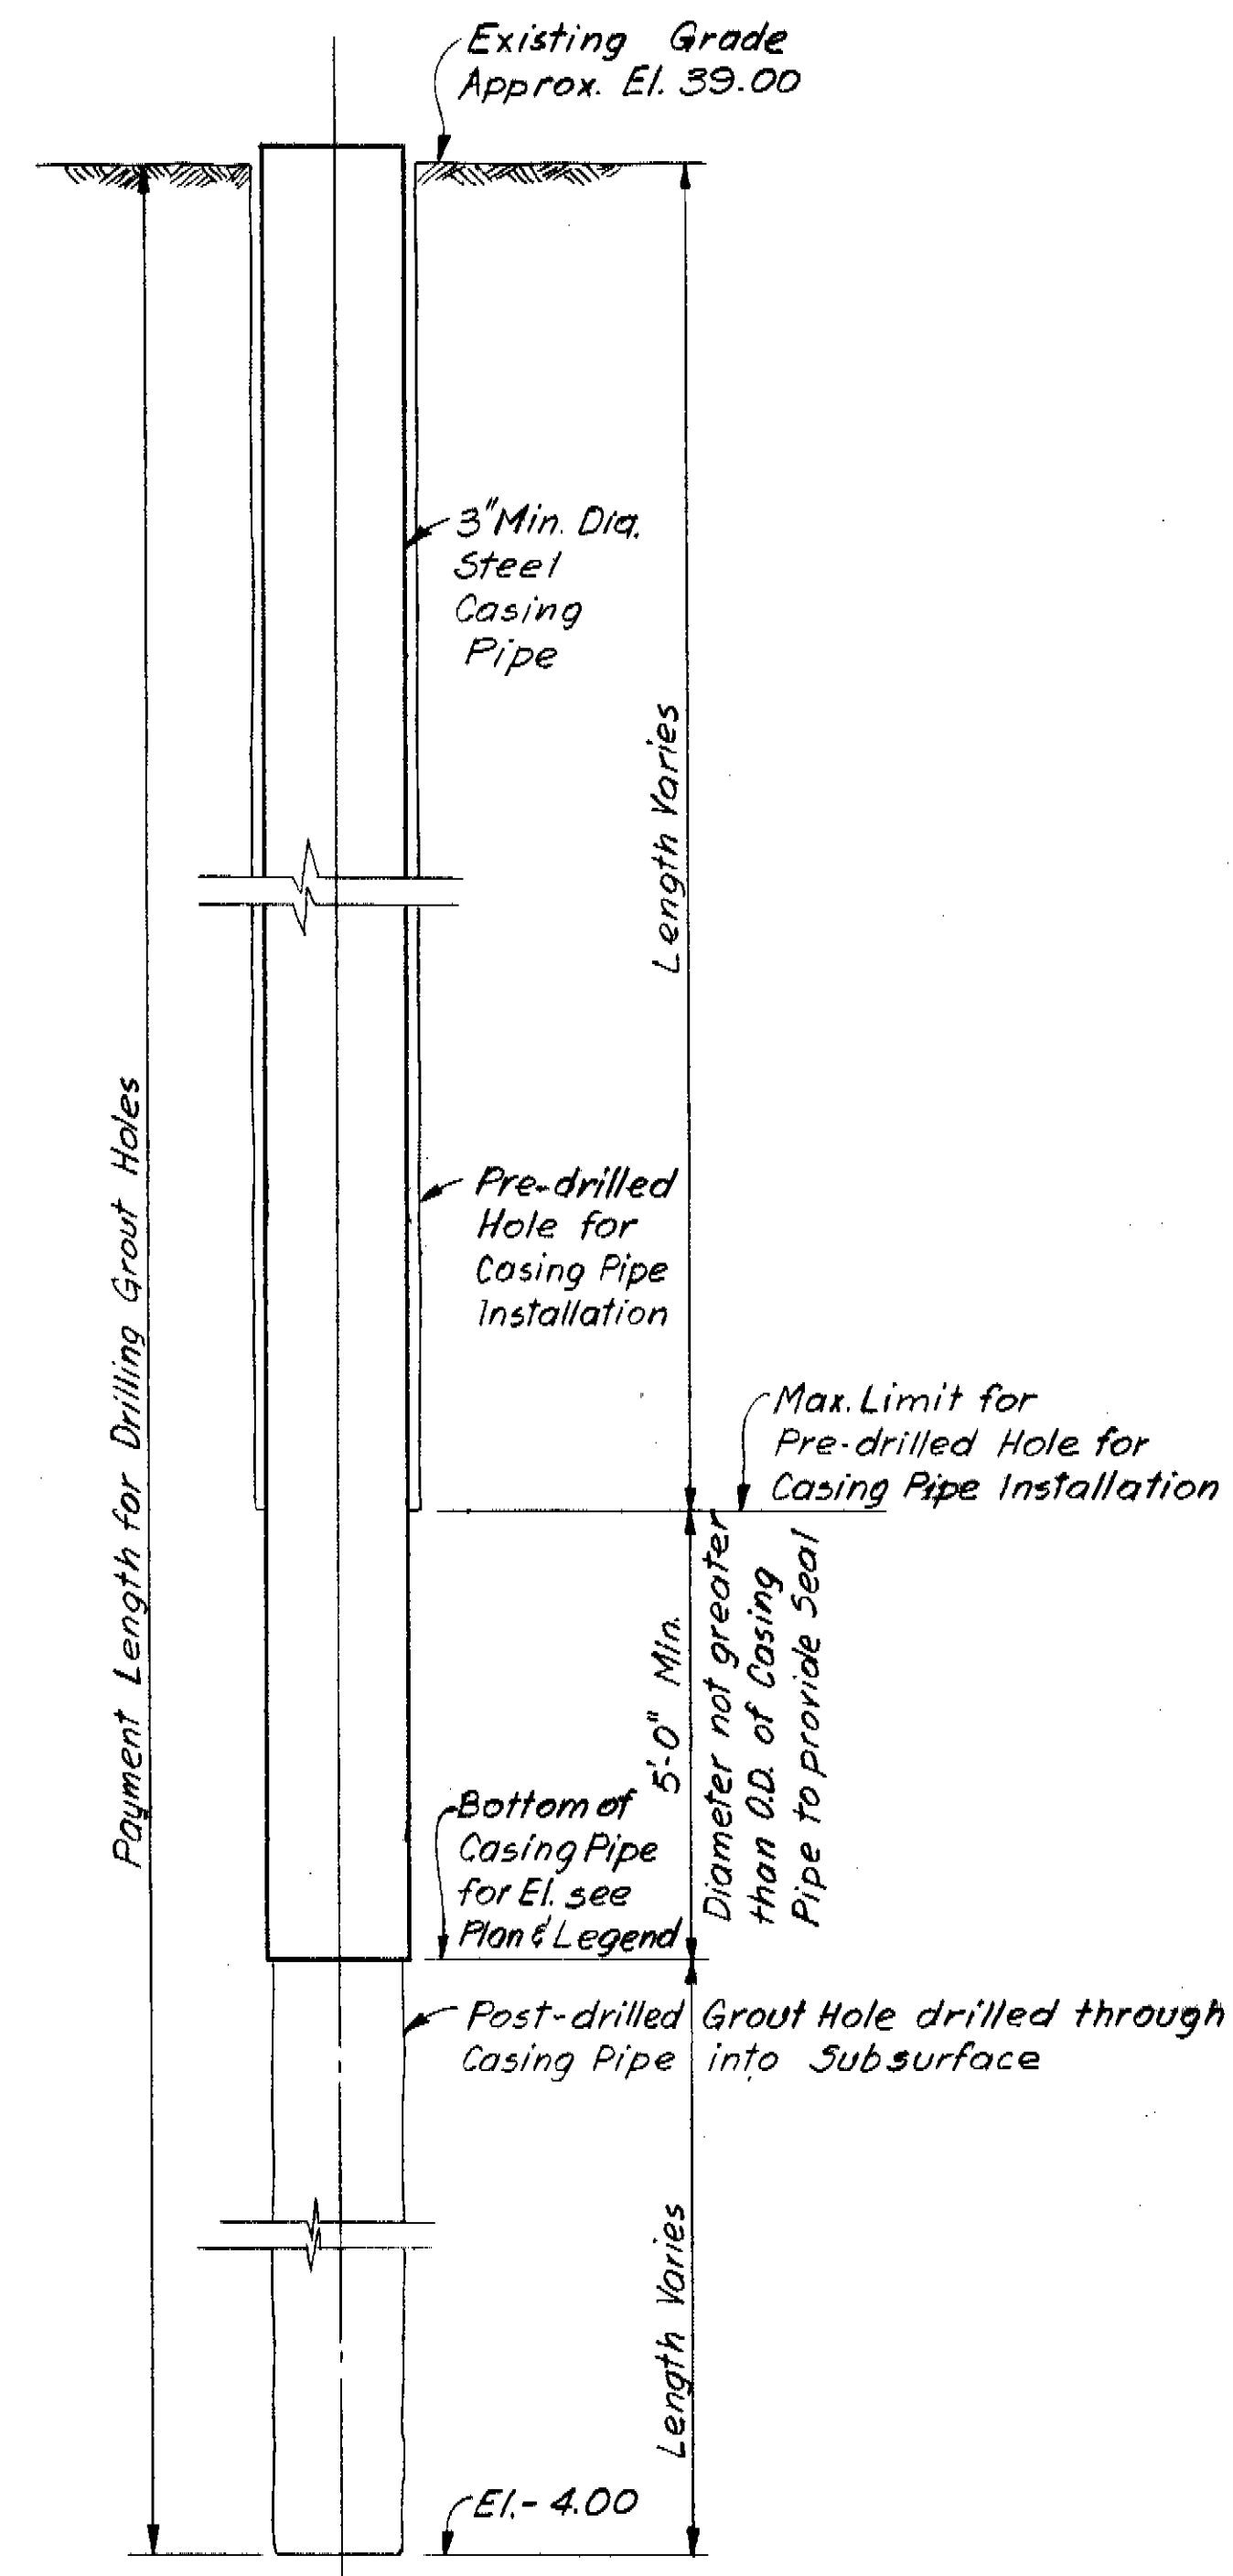

GROUT HOLE DETAIL
NOT TO SCALE

- LEGEND
- Bottom of Casing Pipe El. 14.25
 - Bottom of Casing Pipe El. 10.75
 - Bottom of Casing Pipe El. 5.75

NOTE:
ALL ELEVATIONS SHOWN ARE REFERENCED TO CITY OF TAMPA DATUM. TO CONVERT TO NATIONAL OCEAN SURVEY (NOS) DATUM, SUBTRACT 0.15 FEET (0'-1 13/16").


RECORD DRAWING
THIS RECORD DRAWING IS NOT WARRANTED BUT IS BELIEVED TO REPRESENT CONDITIONS UPON COMPLETION OF CONSTRUCTION WITHIN REASONABLE TOLERANCES BASED UPON THE INFORMATION FURNISHED TO THE ENGINEER PERTAINING TO CHANGES MADE DURING CONSTRUCTION.

GREELEY AND HANSEN
ENGINEERS
222 S. RIVERSIDE PLAZA
CHICAGO, ILLINOIS 60606

DESIGNED JRP
DRAWN RN
CHECKED JRP

APPROVED _____
DATE _____
SUPT., DEPT. OF SANITARY SEWERS
DATE _____
GREELEY AND HANSEN, ENGINEERS

NO.	DATE	APP.	REVISION
1	10/81	DSH	Rec. Dwg Revisions


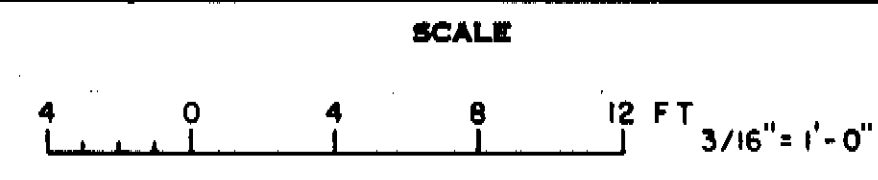


CITY OF TAMPA, FLORIDA
SEWAGE DISPOSAL SYSTEM
DIVISION 4G3
131 ST. AVENUE PUMPING STATION


GROUT HOLES LOCATION PLAN
AND DETAIL

PROJ. NO. 5 202-70-30D-7-4G3
AD-3-1
DATE AUGUST, 1978 REV. 0

173-123

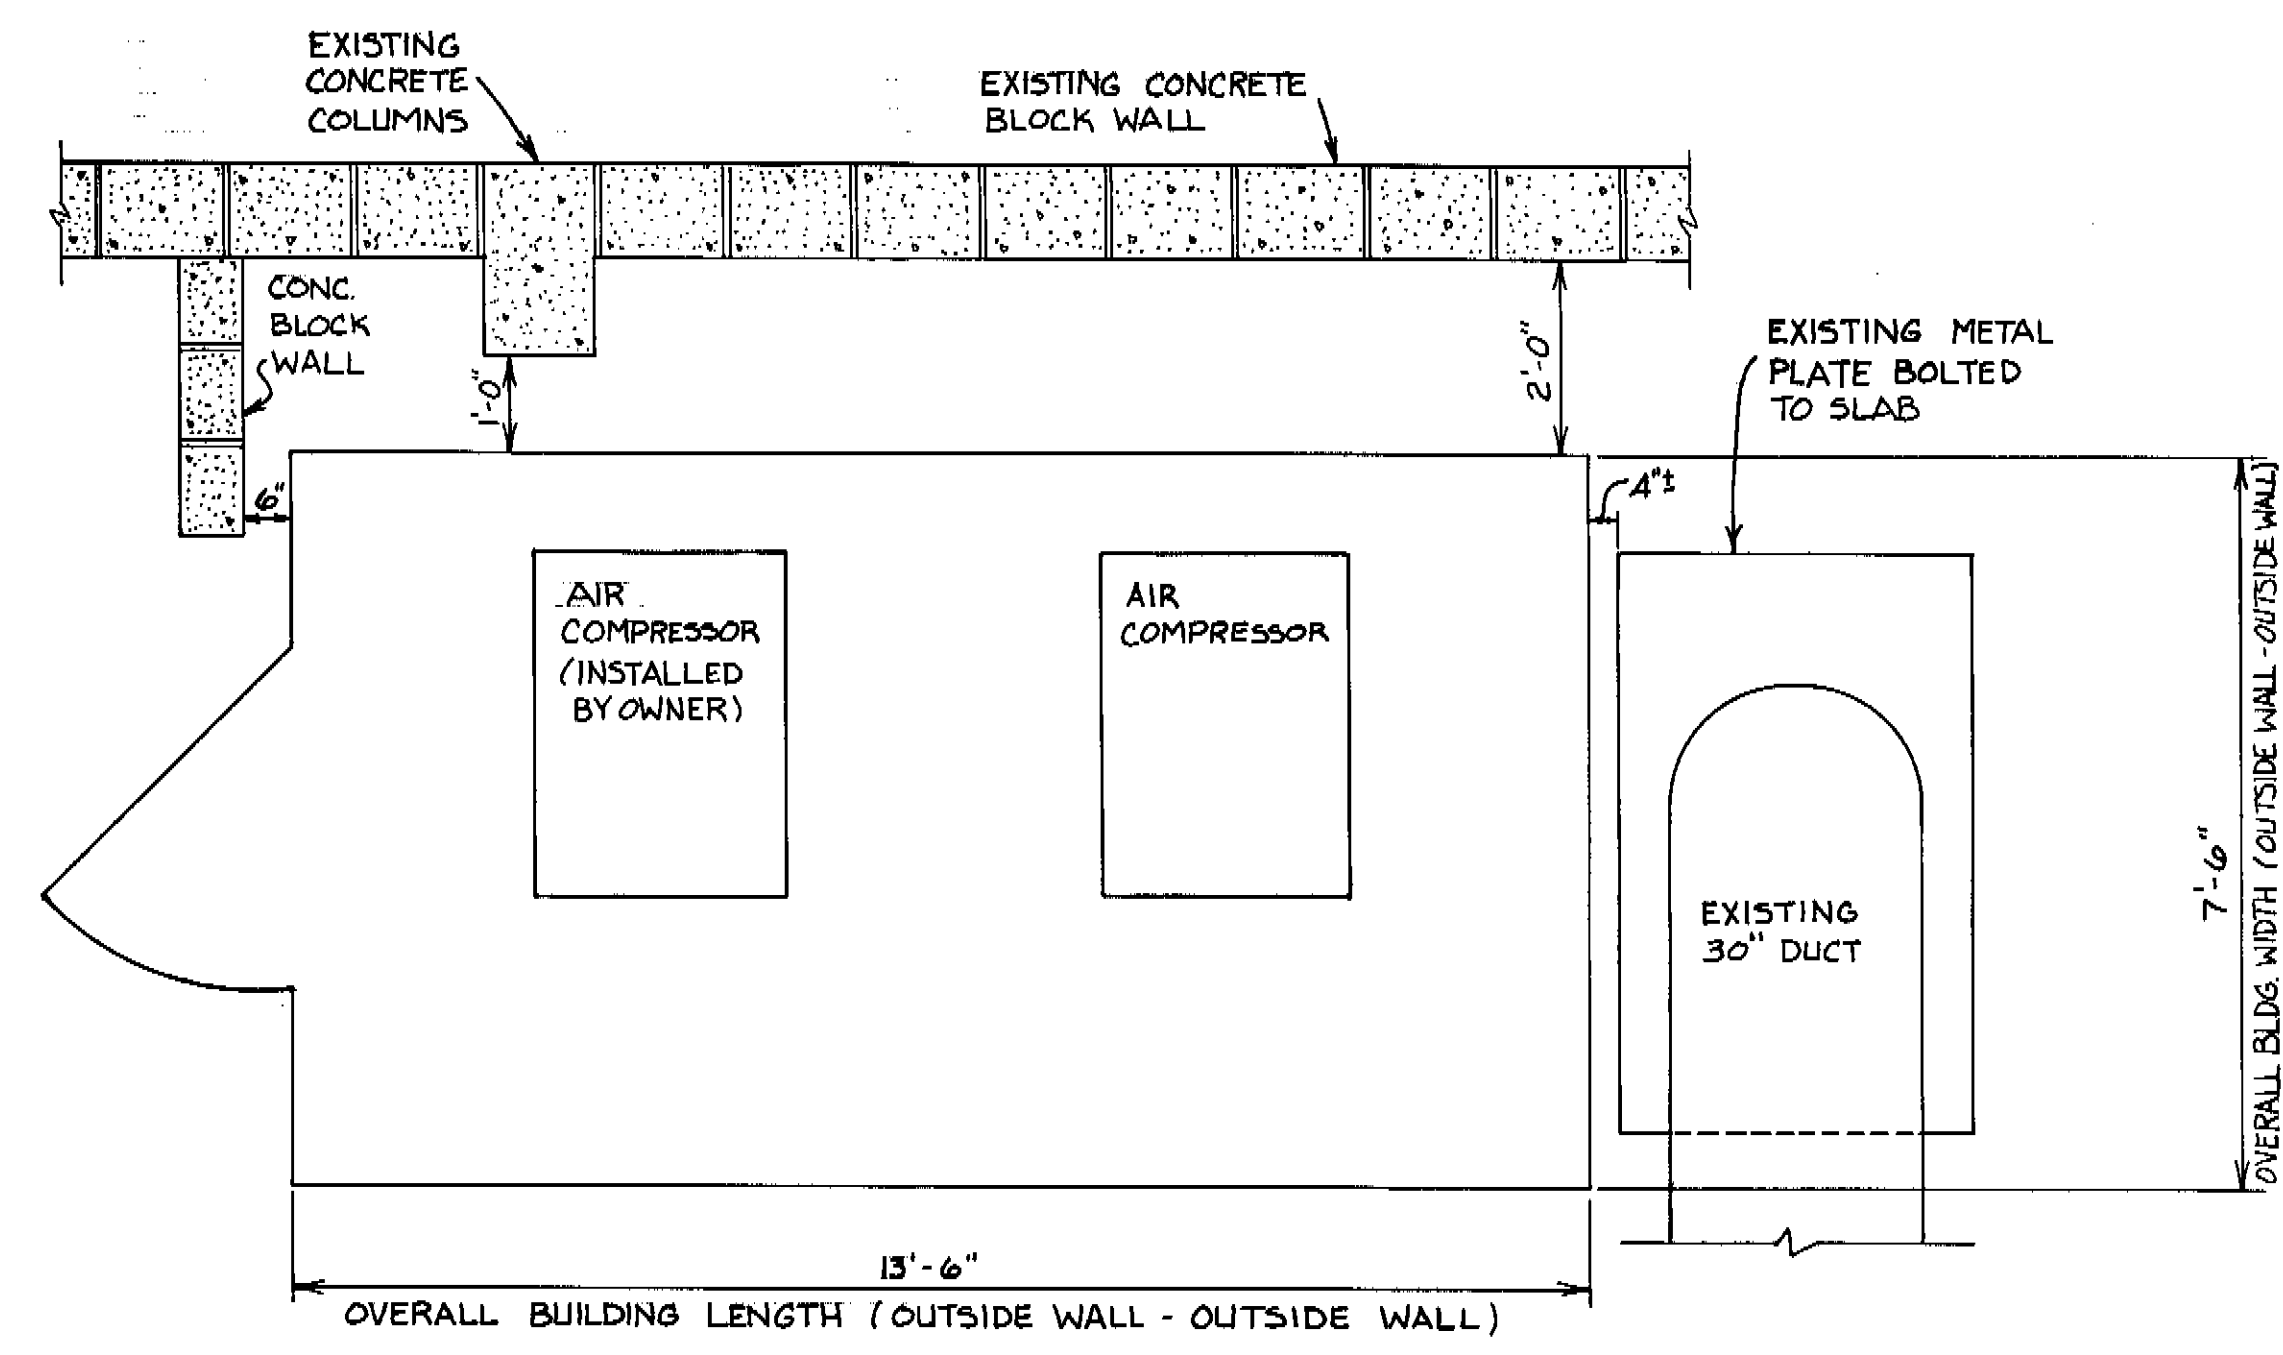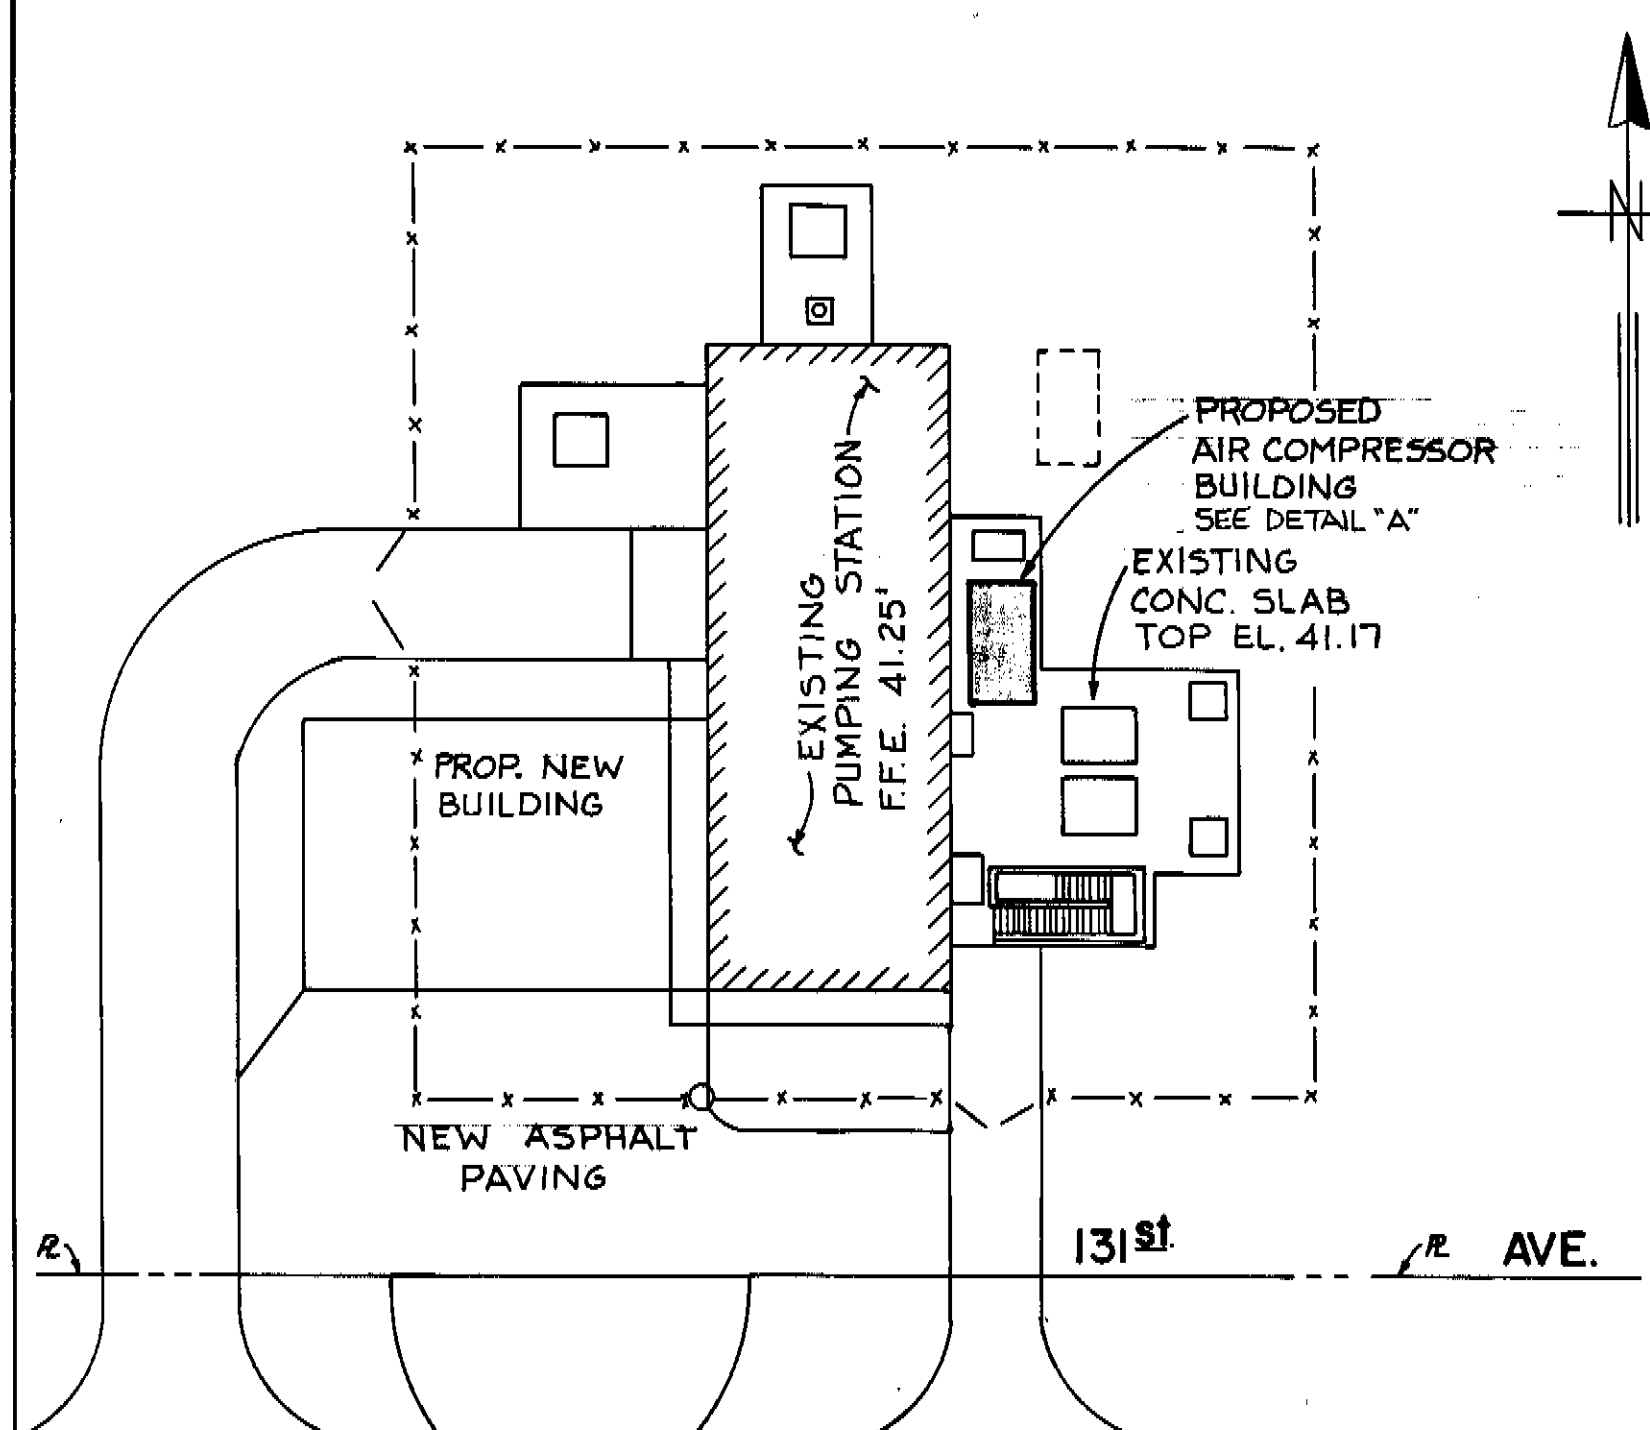


COMPRESSOR BLDG. FLOOR PLAN
 1/2" = 1' - 0"

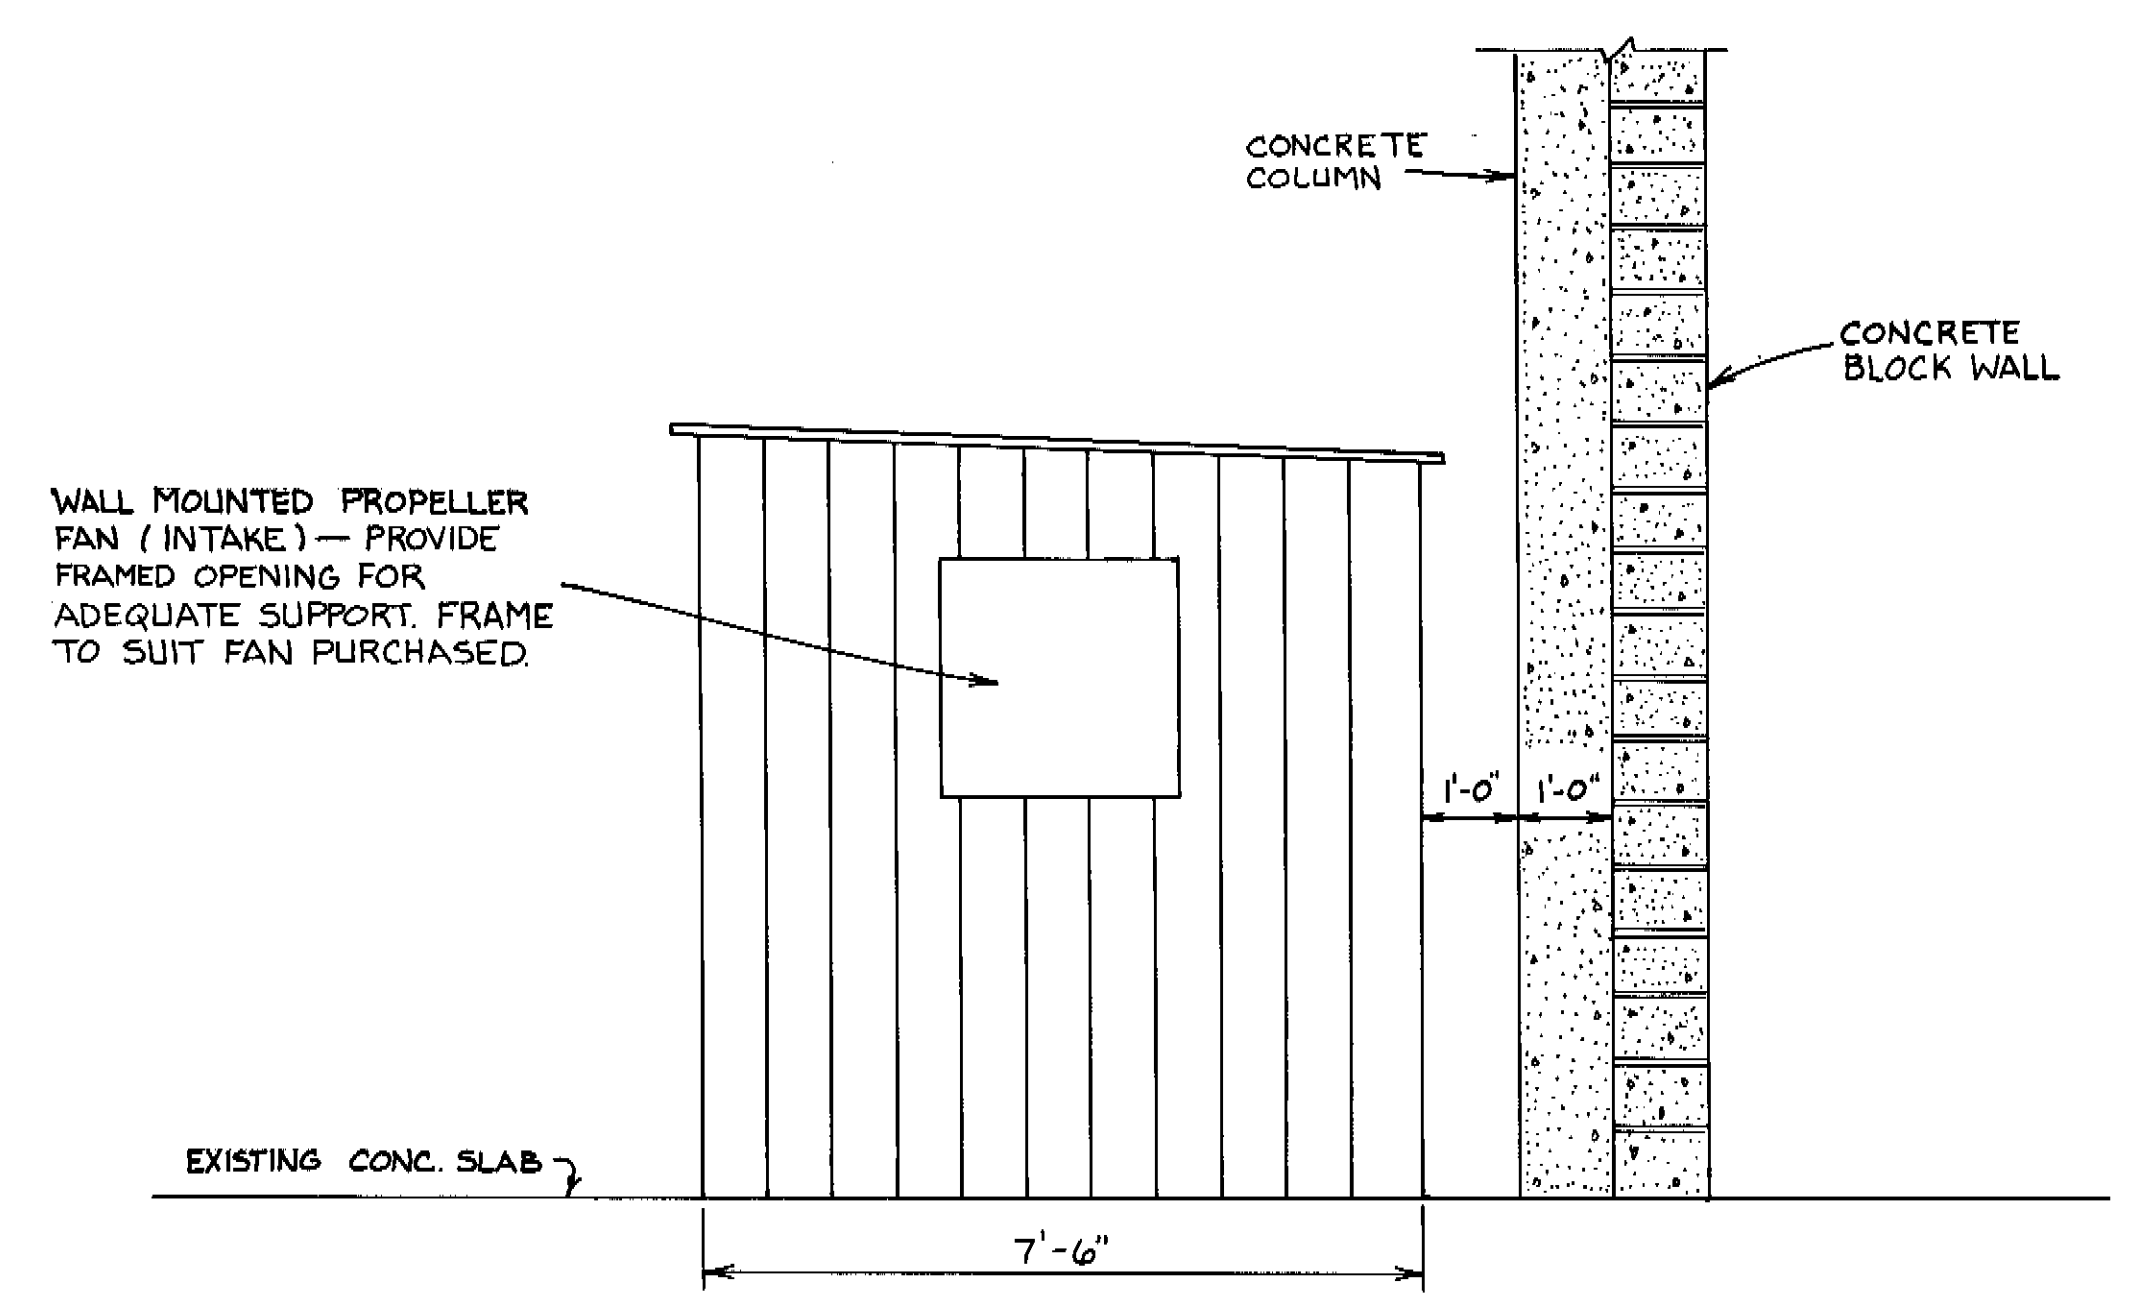


NORTH ELEVATION
 1/2" = 1' - 0"


SITE PLAN
 NOT TO SCALE

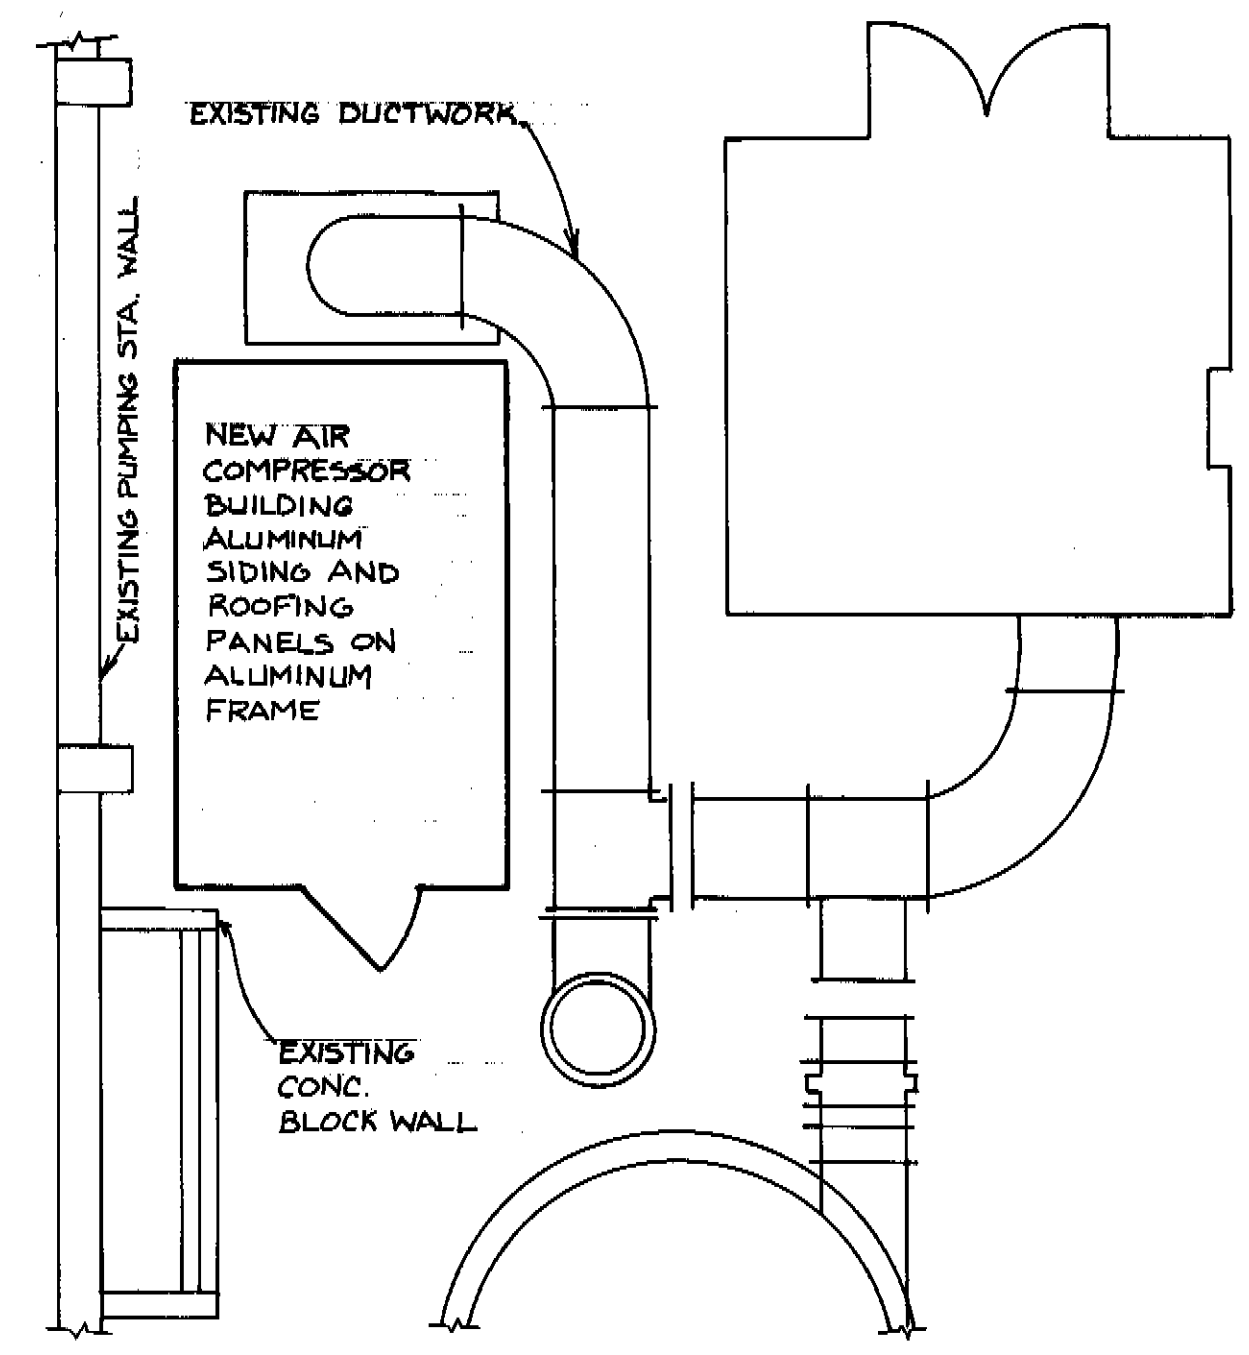

DETAIL "A"
 NOT TO SCALE

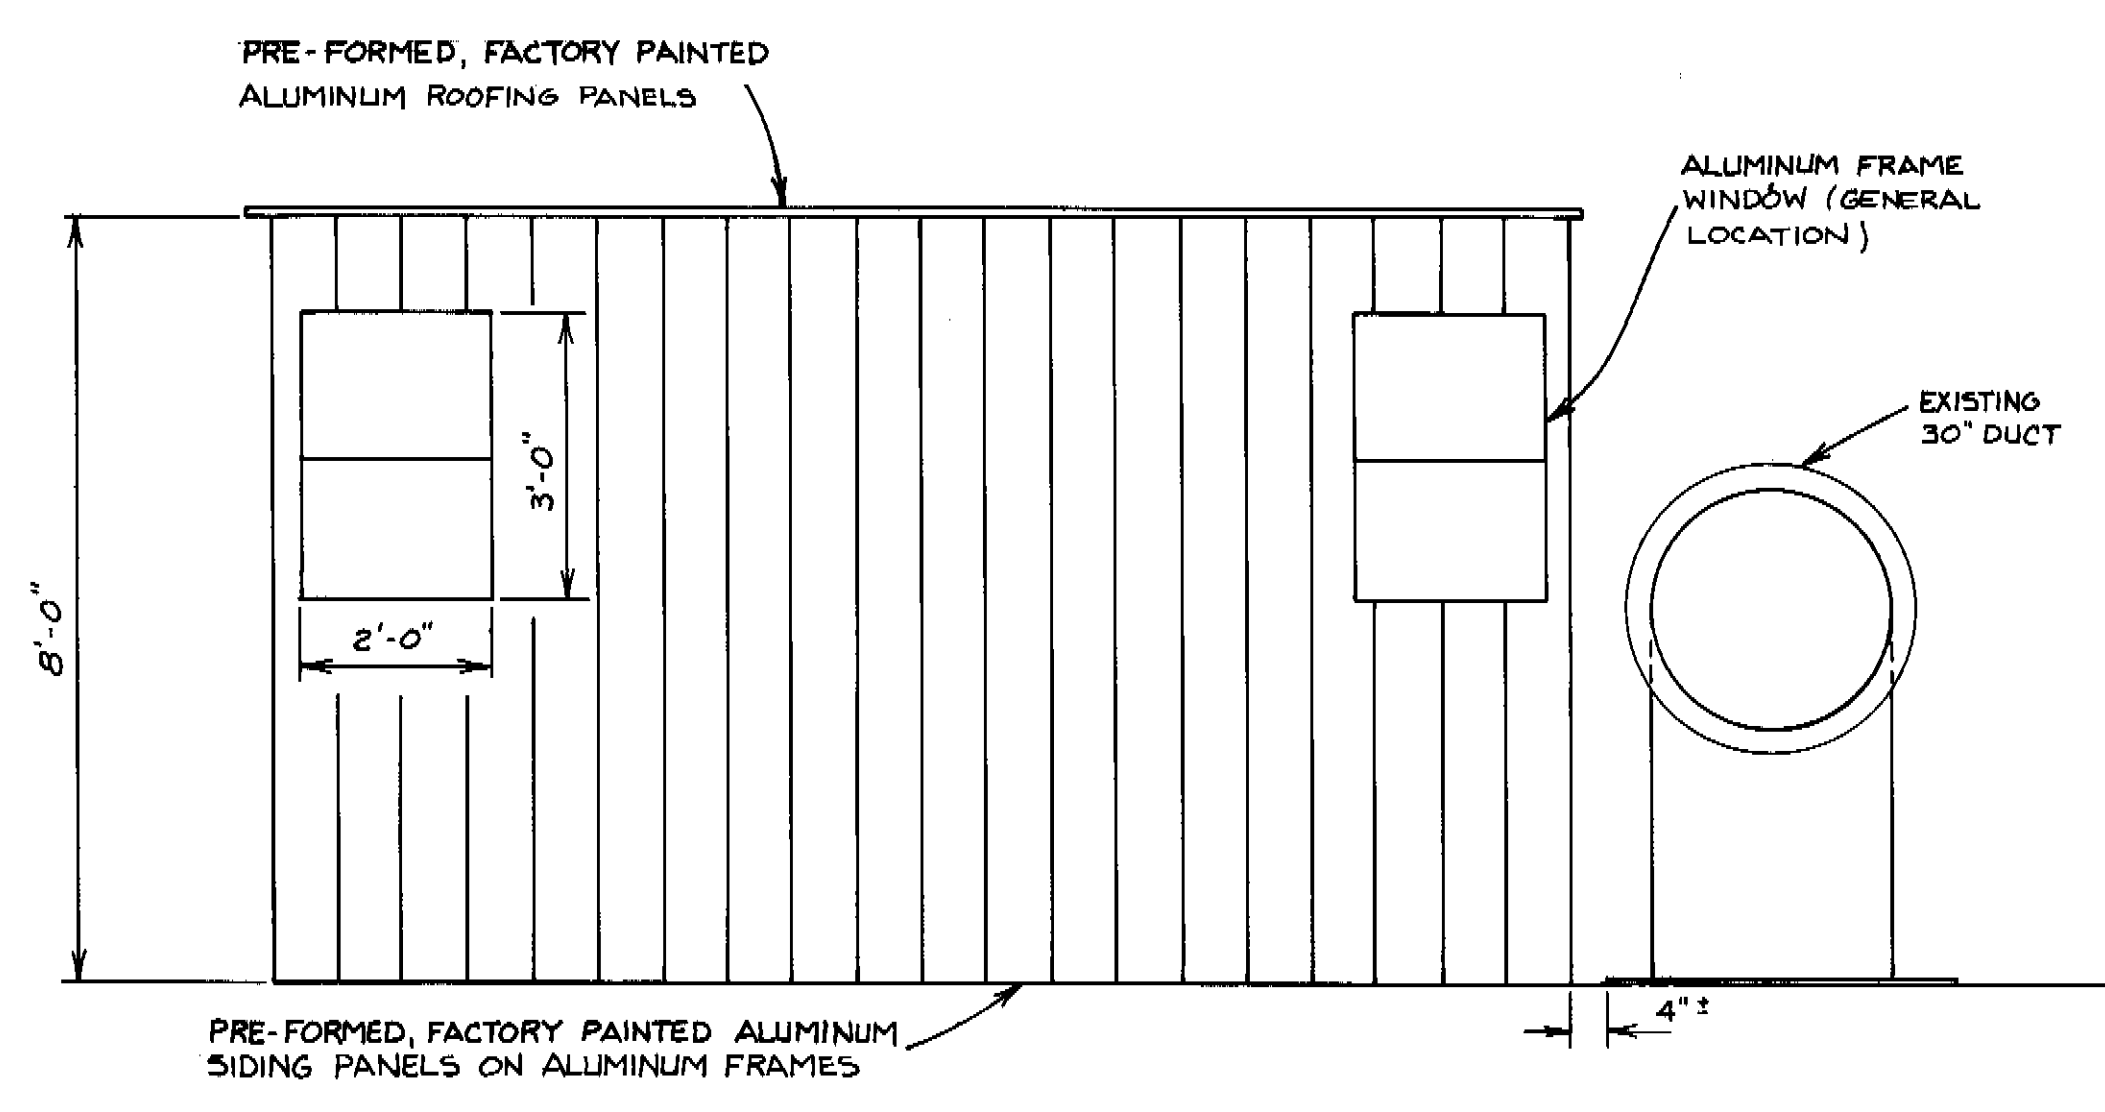

EAST ELEVATION
 (WEST ELEVATION SIMILAR W/O WINDOWS)
 1/2" = 1' - 0"

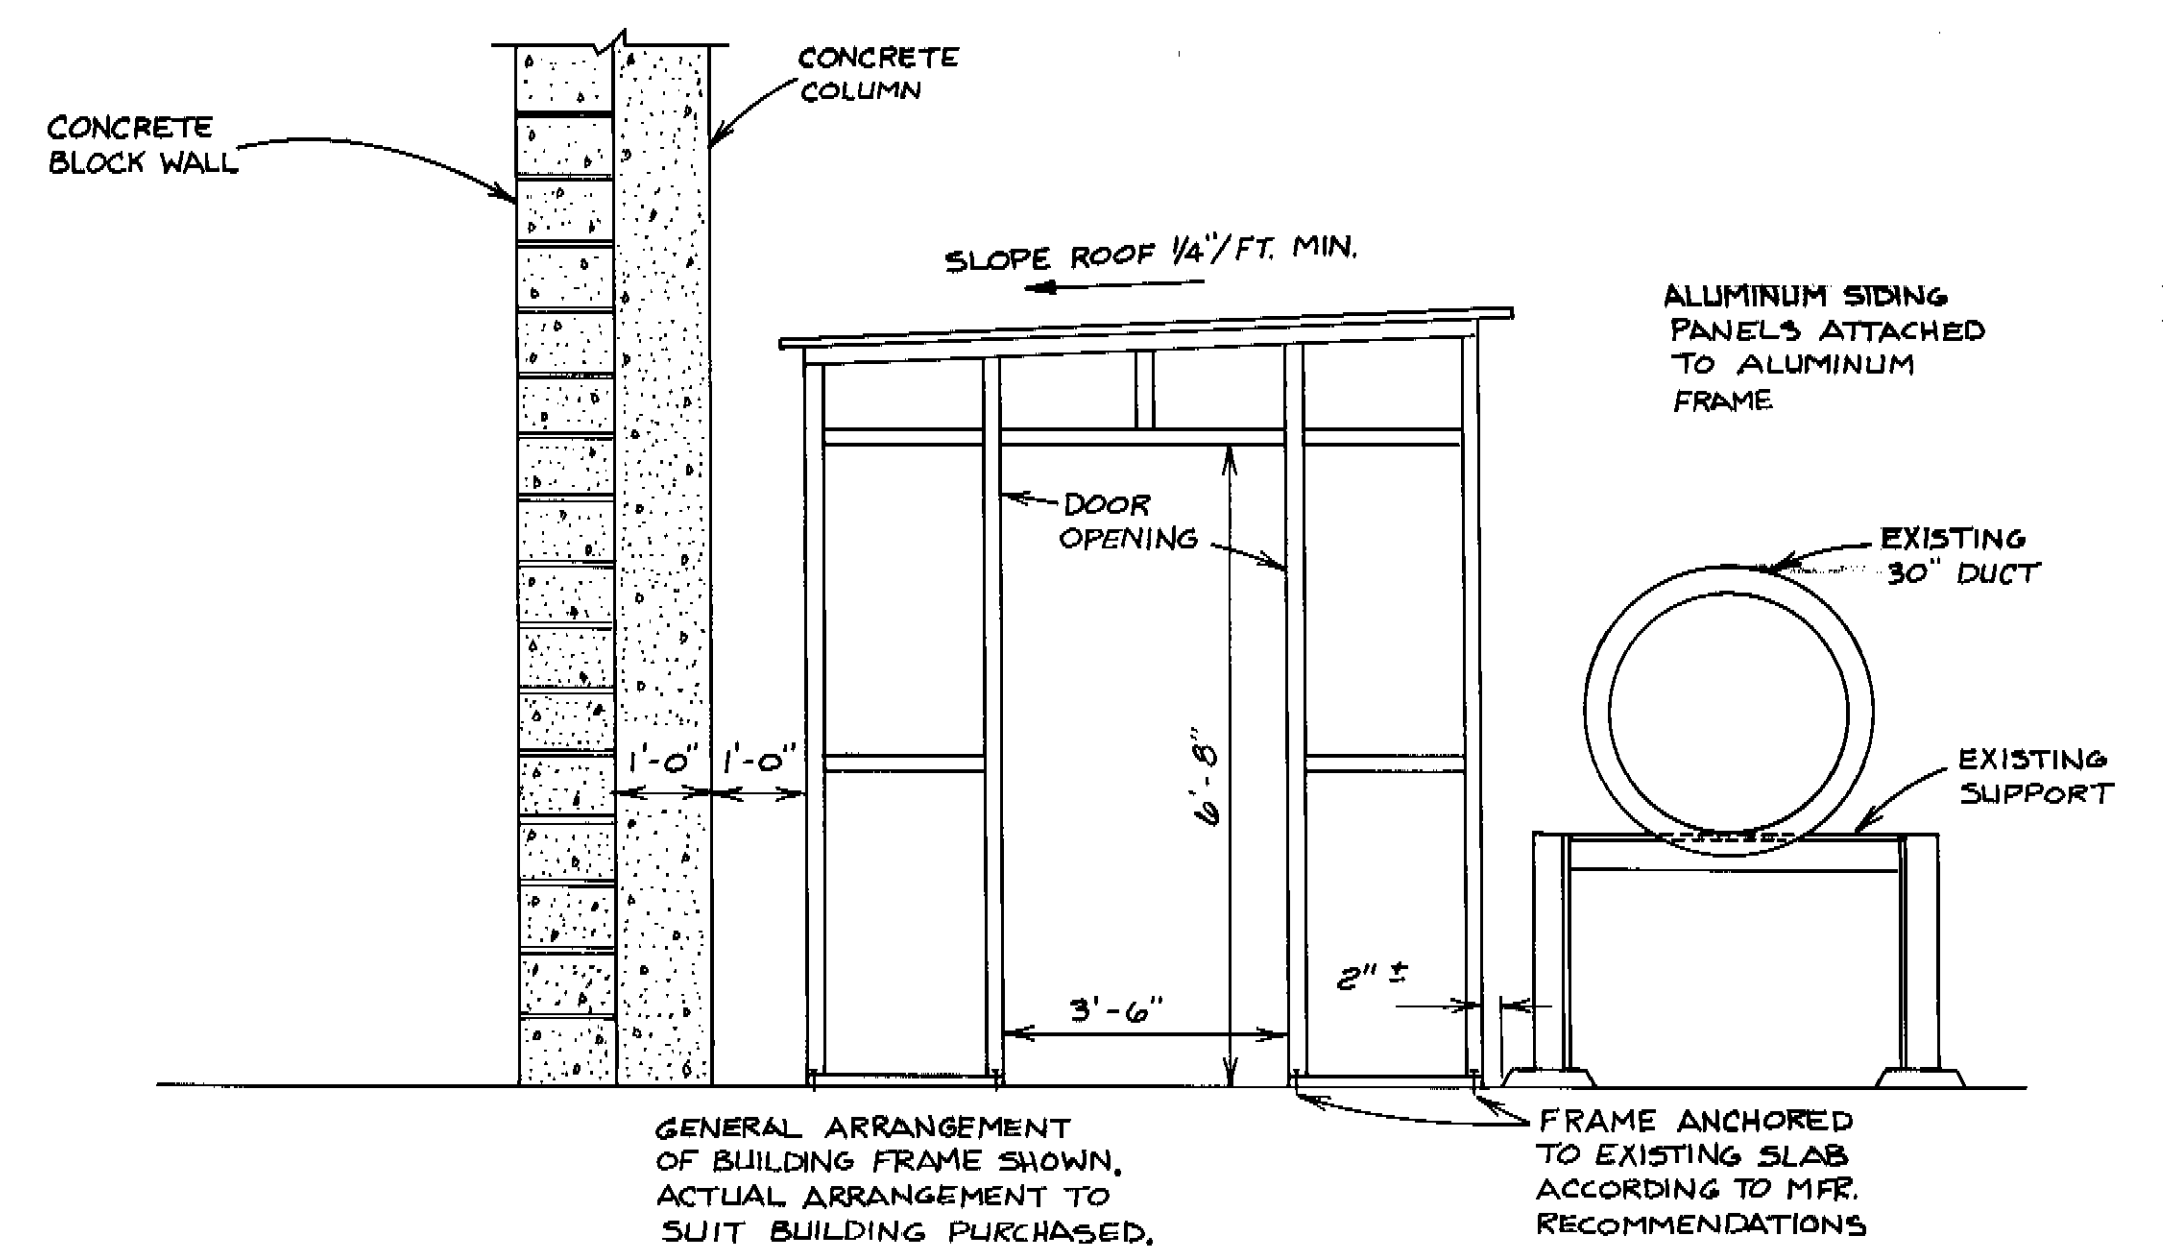

SOUTH ELEVATION (FRAMEWORK)
 1/2" = 1' - 0"

DES: B.G.
 DRN: R.A.R.
 CKD:
 DATE:

APPROVED BY
 JACK P. MORRIS, P.E.
 DIRECTOR
 DEPARTMENT OF SANITARY SEWERS

NO	DATE	REVISIONS
1		
2		
3		
4		
5		


SCALE
 AS SHOWN

DEPARTMENT of SANITARY SEWERS
 CITY of TAMPA, FLORIDA


AIR COMPRESSOR BUILDING
 131st AVE. PUMPING STATION

SHEET
SD-1
 OF


C173-73d

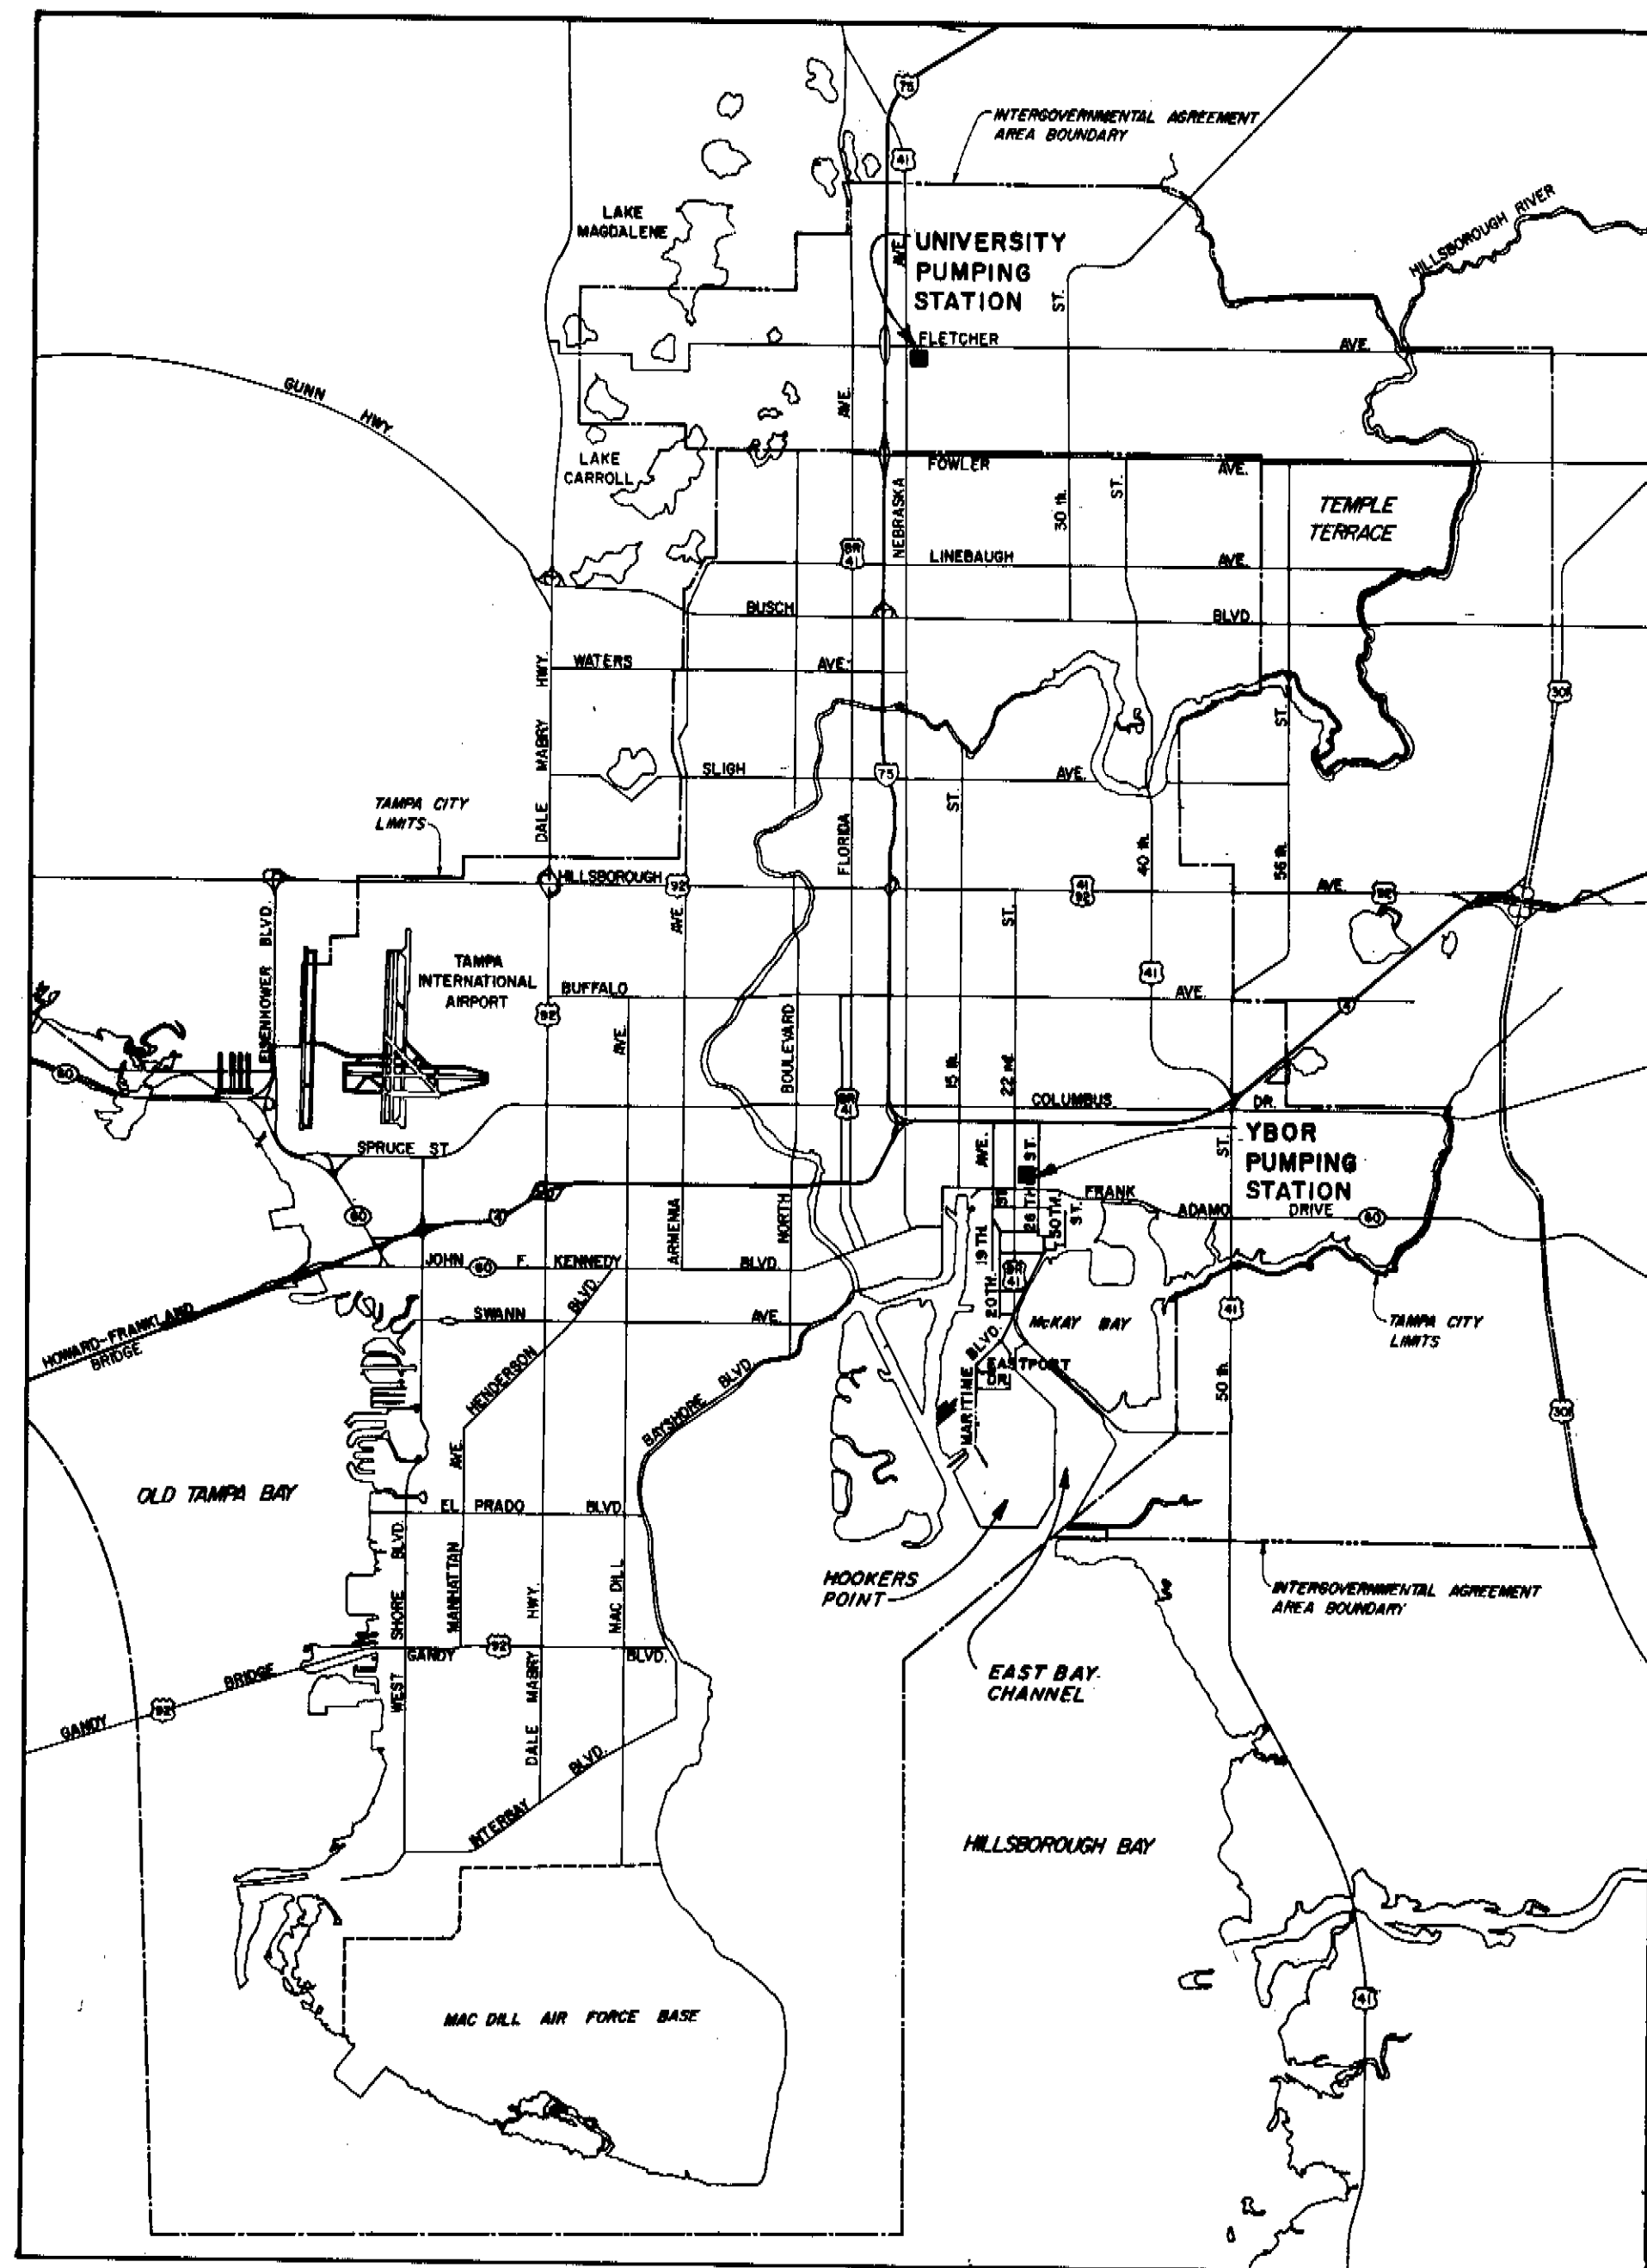

LOCATION MAP
SCALE: 1" = 8000'

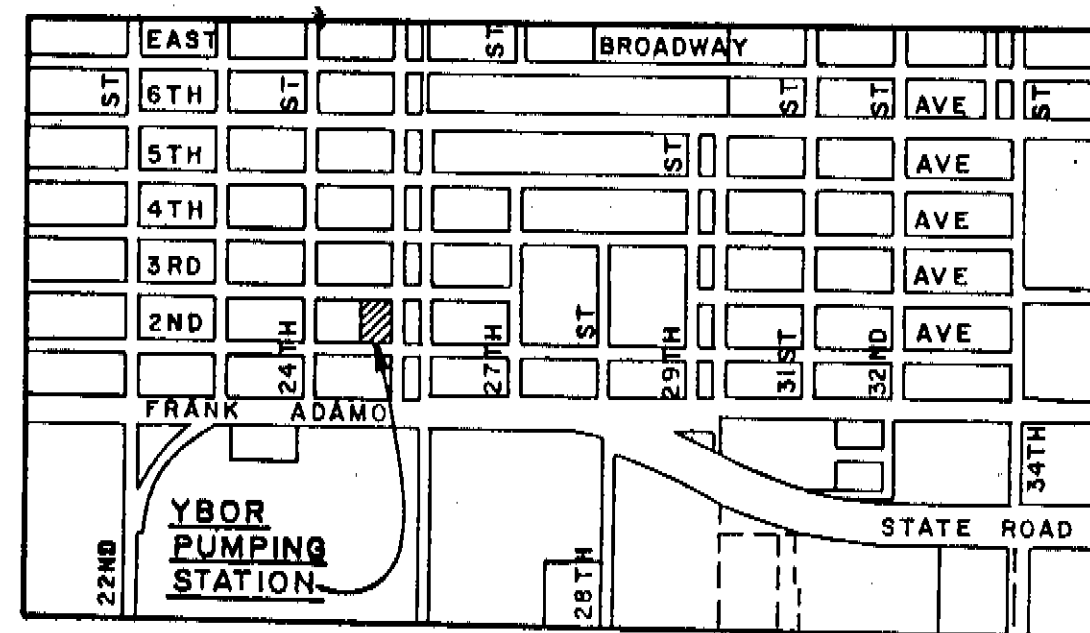

YBOR PUMPING STATION

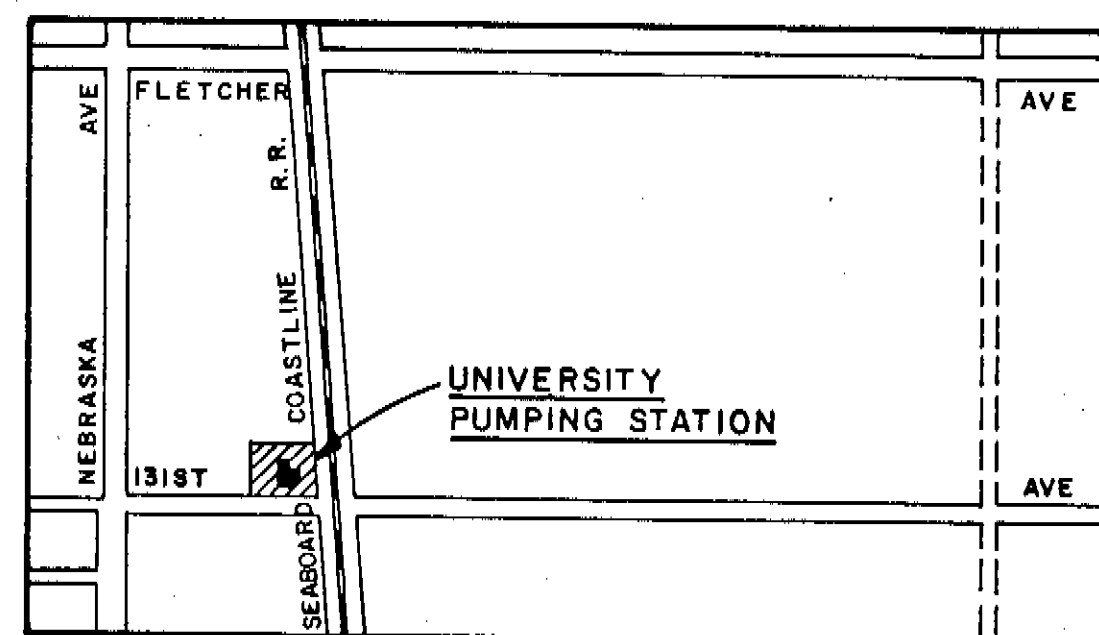


UNIVERSITY PUMPING STATION

AREA MAPS
NOT TO SCALE

INDEX

SHEET NO.	TITLE
1.	LOCATION MAP, AREA MAPS AND INDEX
2.	SYMBOL LEGEND AND GENERAL DETAILS
3.	ODOR CONTROL FACILITIES - PLATFORM AND LADDER DETAILS
4.	YBOR PUMPING STATION - PLANS, SECTIONS AND DIAGRAMS
5.	YBOR PUMPING STATION - PLANS, SECTIONS AND DIAGRAMS
6.	YBOR PUMPING STATION - SECTIONS
7.	YBOR PUMPING STATION - SECTIONS
8.	UNIVERSITY PUMPING STATION - PLANS, SECTIONS, DETAILS AND DIAGRAMS
9.	UNIVERSITY PUMPING STATION - PLANS, SECTIONS, DETAILS AND DIAGRAMS
10.	YBOR AND UNIVERSITY PUMPING STATIONS - ELECTRICAL

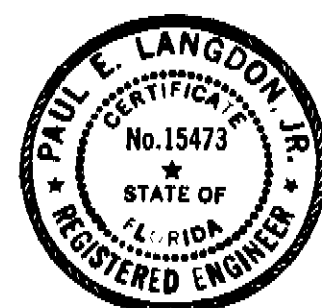

GREELEY AND HANSEN ENGINEERS
222 S. RIVERSIDE PLAZA
CHICAGO, ILLINOIS 60606

DESIGNED JRP
DRAWN ATK
CHECKED JRP

APPROVED
DATE
Supt., Dept. of Sanitary Sewers
DATE 8/2/85
Greeley and Hansen, Engineers

NO.	DATE	APP.	REVISION

SCALE
AS SHOWN



CITY OF TAMPA, FLORIDA
SEWAGE DISPOSAL SYSTEM
DIVISION 4L5
PUMPING STATIONS
ODOR CONTROL MODIFICATIONS

LOCATION MAP, AREA MAPS
AND INDEX

PROJ. NO.	
SHEET	1 of 10
DATE	JULY 1985
REV.	0

173-37a

PIPING SYMBOL	DESCRIPTION	PIPING SYMBOL	DESCRIPTION
	Gate valve (1)		Cross
	Gate valve (2)		Cross (Branch up)
	Butterfly valve (1)		Tee
	Butterfly valve (2)		Tee (Branch up)
	Plug valve (1)		Tee (Branch down)
	Plug valve (2)		45° Elbow
	Ball valve (1)		45° Elbow (Up)
	Ball valve (2)		45° Elbow (Down)
	Globe valve (1)		90° Elbow
	Globe valve (2)		90° Elbow (Up)
	Angle globe valve (1)		90° Elbow (Down)
	Angle globe valve (2)		Side outlet elbow (Up)
	Diaphragm valve (1)		Side outlet elbow (Down)
	Diaphragm valve (2)		Lateral
	Three way valve (1)		Reducer concentric-plan and elevation
	Three way valve (2)		Reducer eccentric-plan
	Four way valve (1)		Union (Screwed)
	Four way valve (2)		Sleeve type coupling
	Pressure relief valve (1)		Sleeve type coupling (Harnessed)
	Pressure relief valve (2)		Expansion joint-metal bellows type
	Check valve		Expansion joint-rubber bellows type
	Pressure reducing valve		Strainer
	Hose valve		Blind flange
	Flanged joint		Bell and spigot joint
	Mechanical joint		Venturi meter

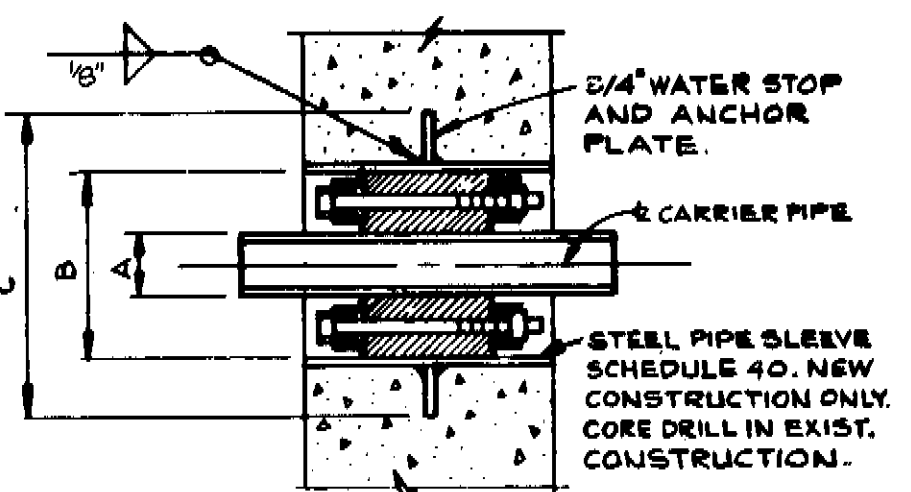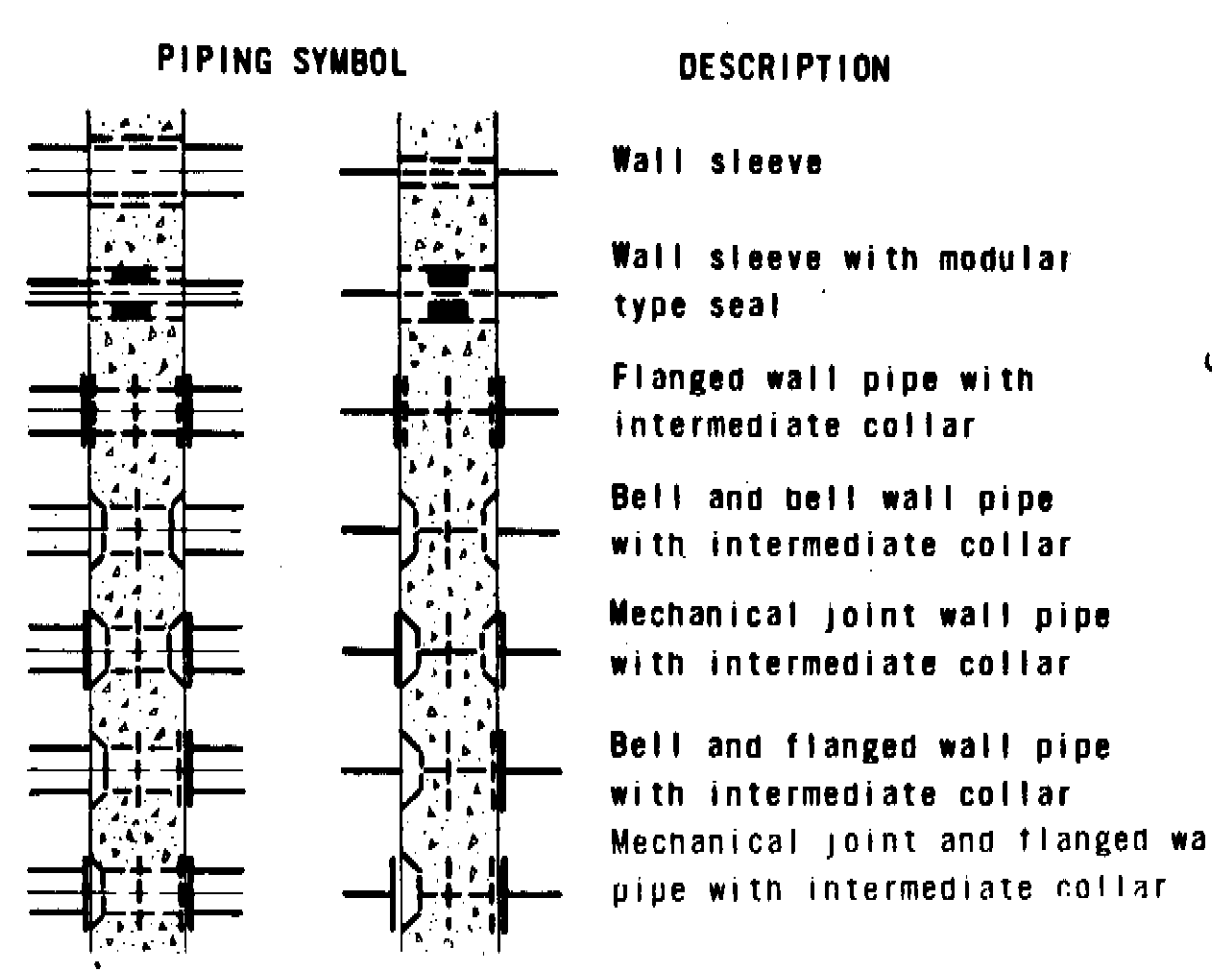

DUCTILE IRON DISCHARGE PIPE		CORE DRILL DIA.	STEEL PIPE AND WATERSTOP		MODULAR WALL SLEEVE (SEE NOTE)	
NOM. I.D.	O.D.		PIPE I.D.	WATERSTOP O.D.	LINK SEAL MOD. NO.	NO. OF LINKS
4"	4.5"	3.0"	-	-	LS-475-C	7
2"	2.375"	4.0"	-	-	LS-300-C	6

NOTE:
MODULAR WALL SLEEVE SHALL BE LINK SEAL OR EQUAL.

VALVE OPERATOR

TYPE	SYMBOL *
Manual	None
Chainwheel	C
Motor (Electric)	M
Pneumatic Cylinder	P

NOTES:
(1) Valve stem perpendicular to paper.
(2) Valve stem parallel to paper.


Where the symbol * is shown on the drawings in place of dimensions or elevations determine these dimensions or elevations after selection of equipment.

Where the symbol ** is shown on the drawings adjacent to dimensions or elevations, the Contractor must verify such dimensions or elevations by field measurement.

LEGEND

EXISTING OR OTHER DIVISIONS	NEW	
		Superstructure
		Tank and other structures
		Pavement with curb
		Pavement without curb
		Property line
		Fence
		Easement line
		Railroad tracks
		Contour
		Graded swale
		Spot elevation
		Small piping
		Storm sewer
		Large pipes and conduits
		High and/or low voltage electrical duct
		Direct burial valve * B.V.-Butterfly valve G.V.-Gate valve P.V.-Plug valve
		Concrete thrust block
		Fire hydrant
		Manhole
		Storm water inlet (lawn or pavel area type)
		Storm water inlet - curb
		Plant coordinates
		Coordinates
		Top of curb elevation arrow side only
		Top of curb elevation top of pavement elevation at the curb and plant coordinate
		Top of pavement elevation

173-37b

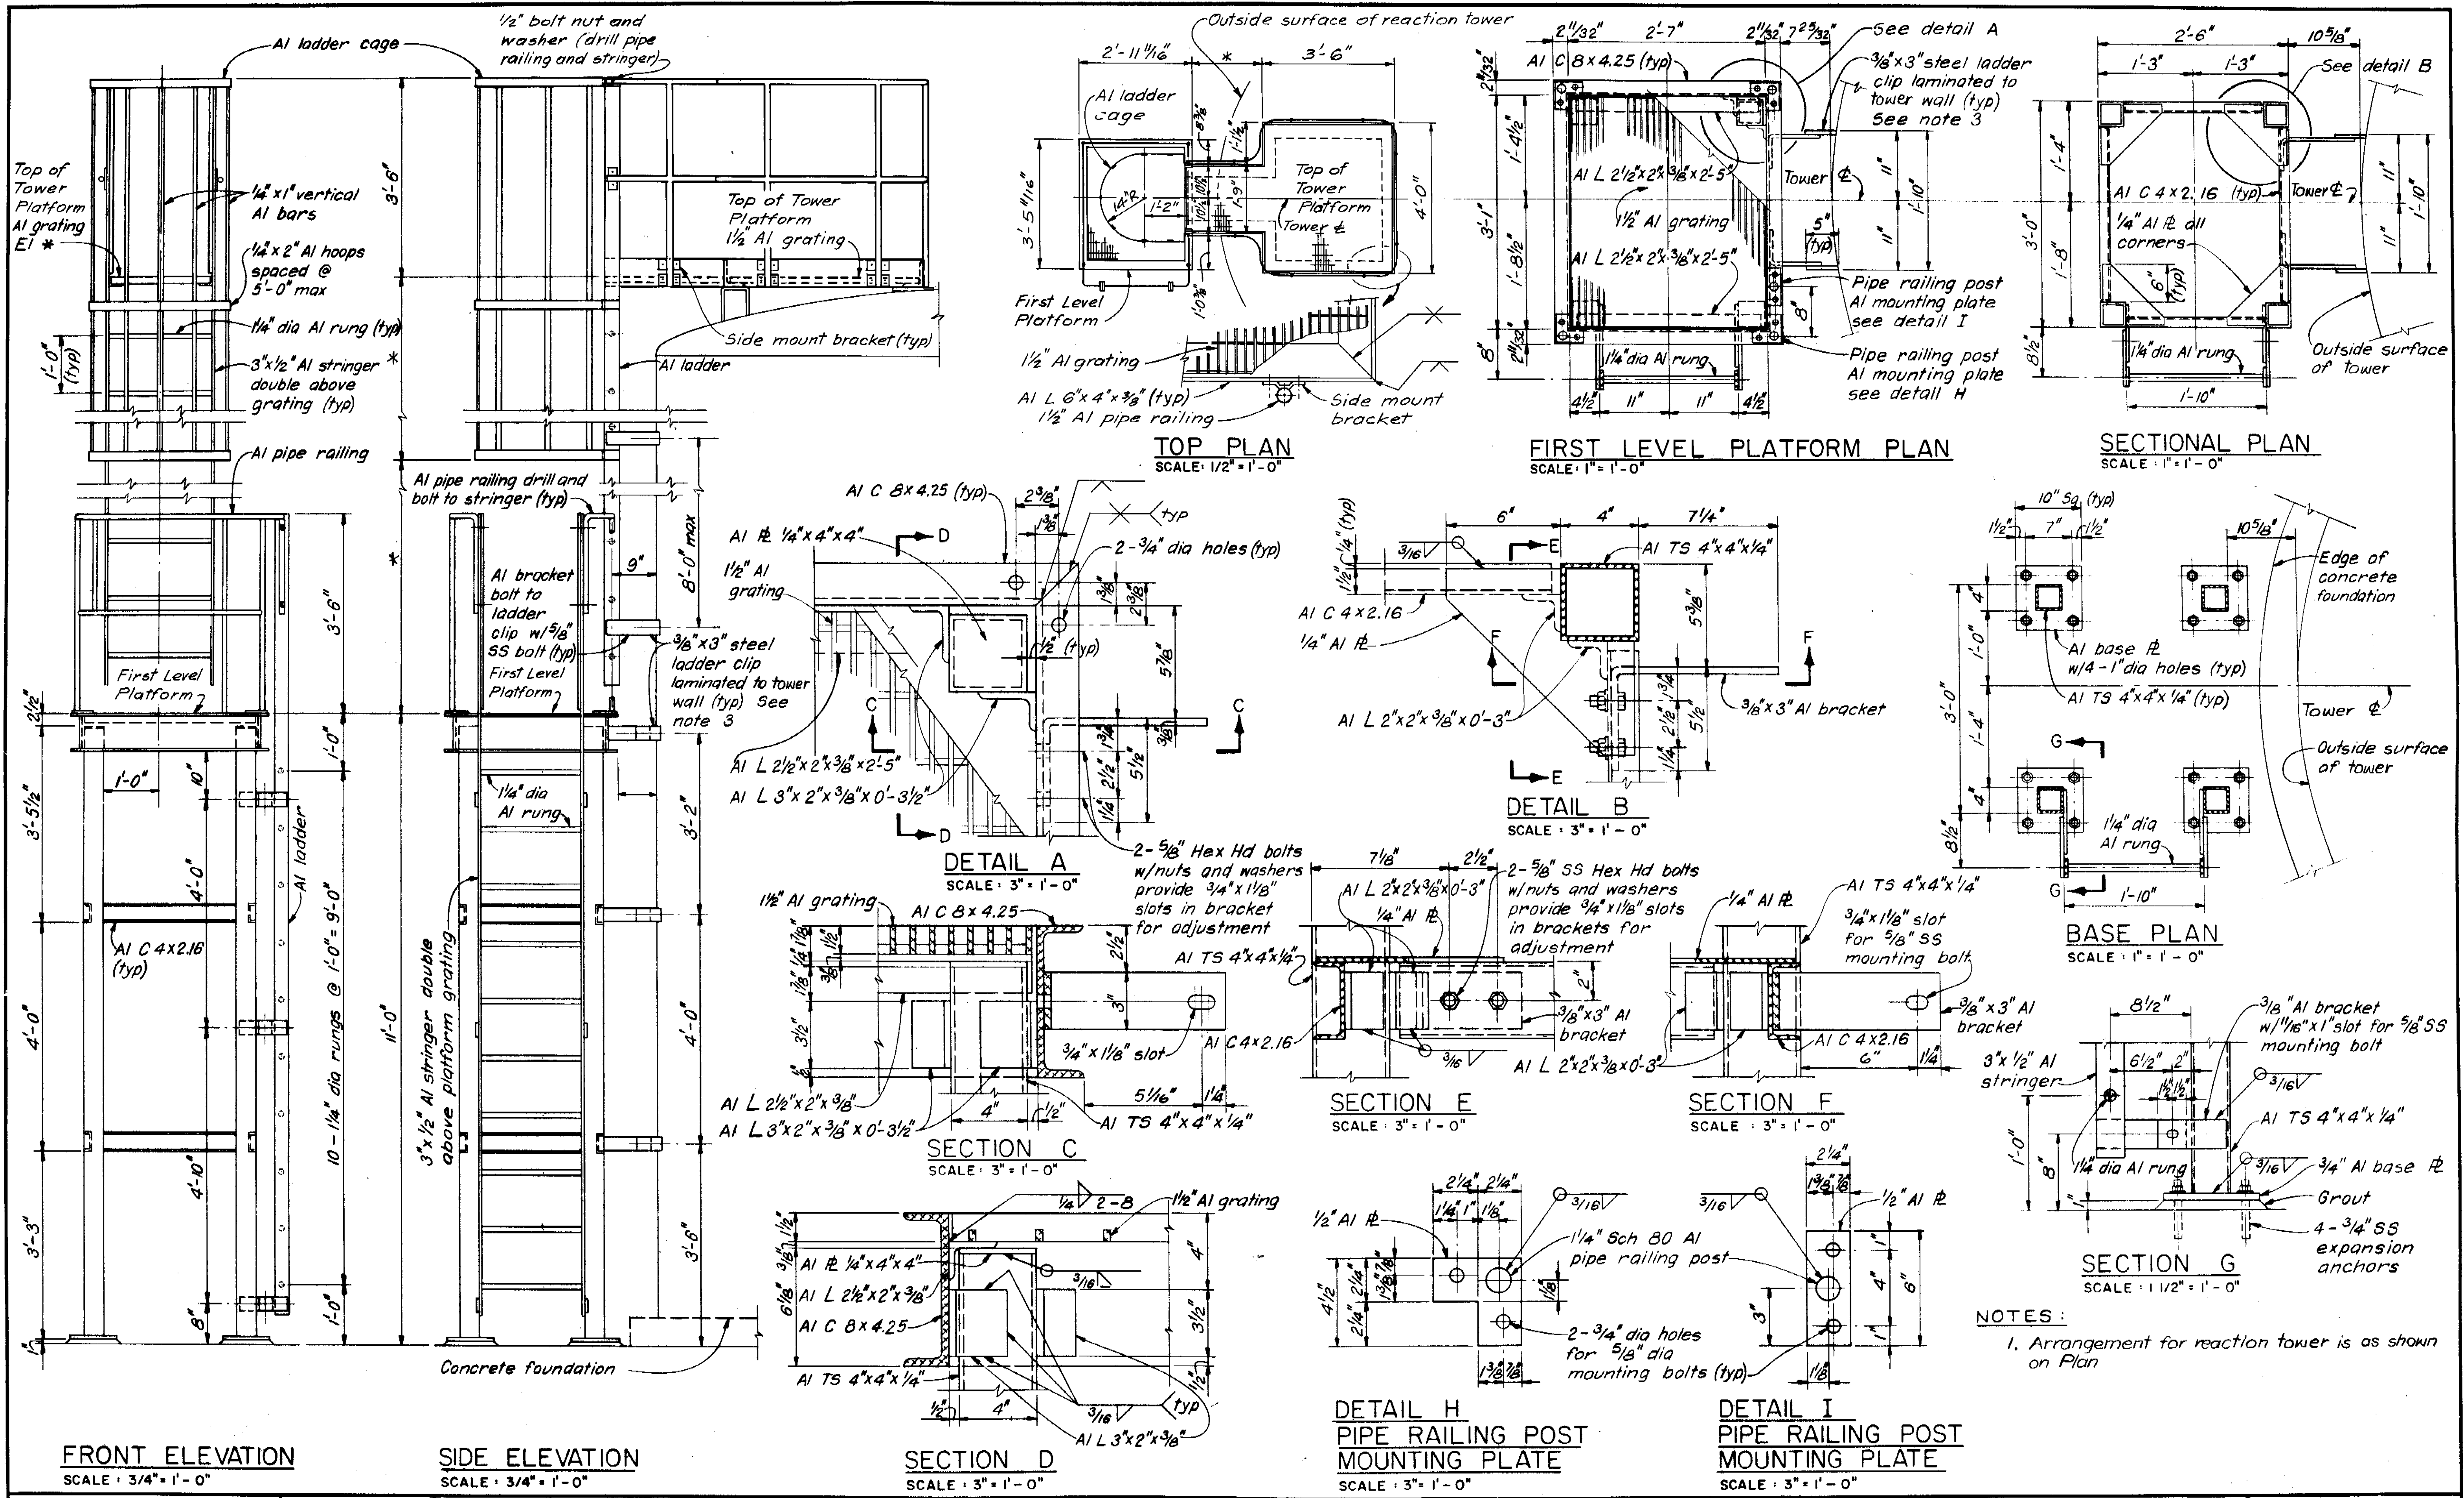

NOTES:
 1. Arrangement for reaction tower is as shown on Plan

Greeley and Hansen Engineers
 222 S. Riverside Plaza
 Chicago, Illinois 60606

DESIGNED RN
 DRAWN SK
 CHECKED KSY REB


APPROVED
 DATE
 SUPT., DEPT. OF SANITARY SEWERS
 DATE
 GREELEY AND HANSEN, ENGINEERS

NO.	DATE	APP.	REVISION




CITY OF TAMPA, FLORIDA
 SEWAGE DISPOSAL SYSTEM
 DIVISION 4L5
 PUMPING STATIONS
 ODOR CONTROL MODIFICATIONS

**ODOR CONTROL FACILITIES
 PLATFORM AND LADDER DETAILS**

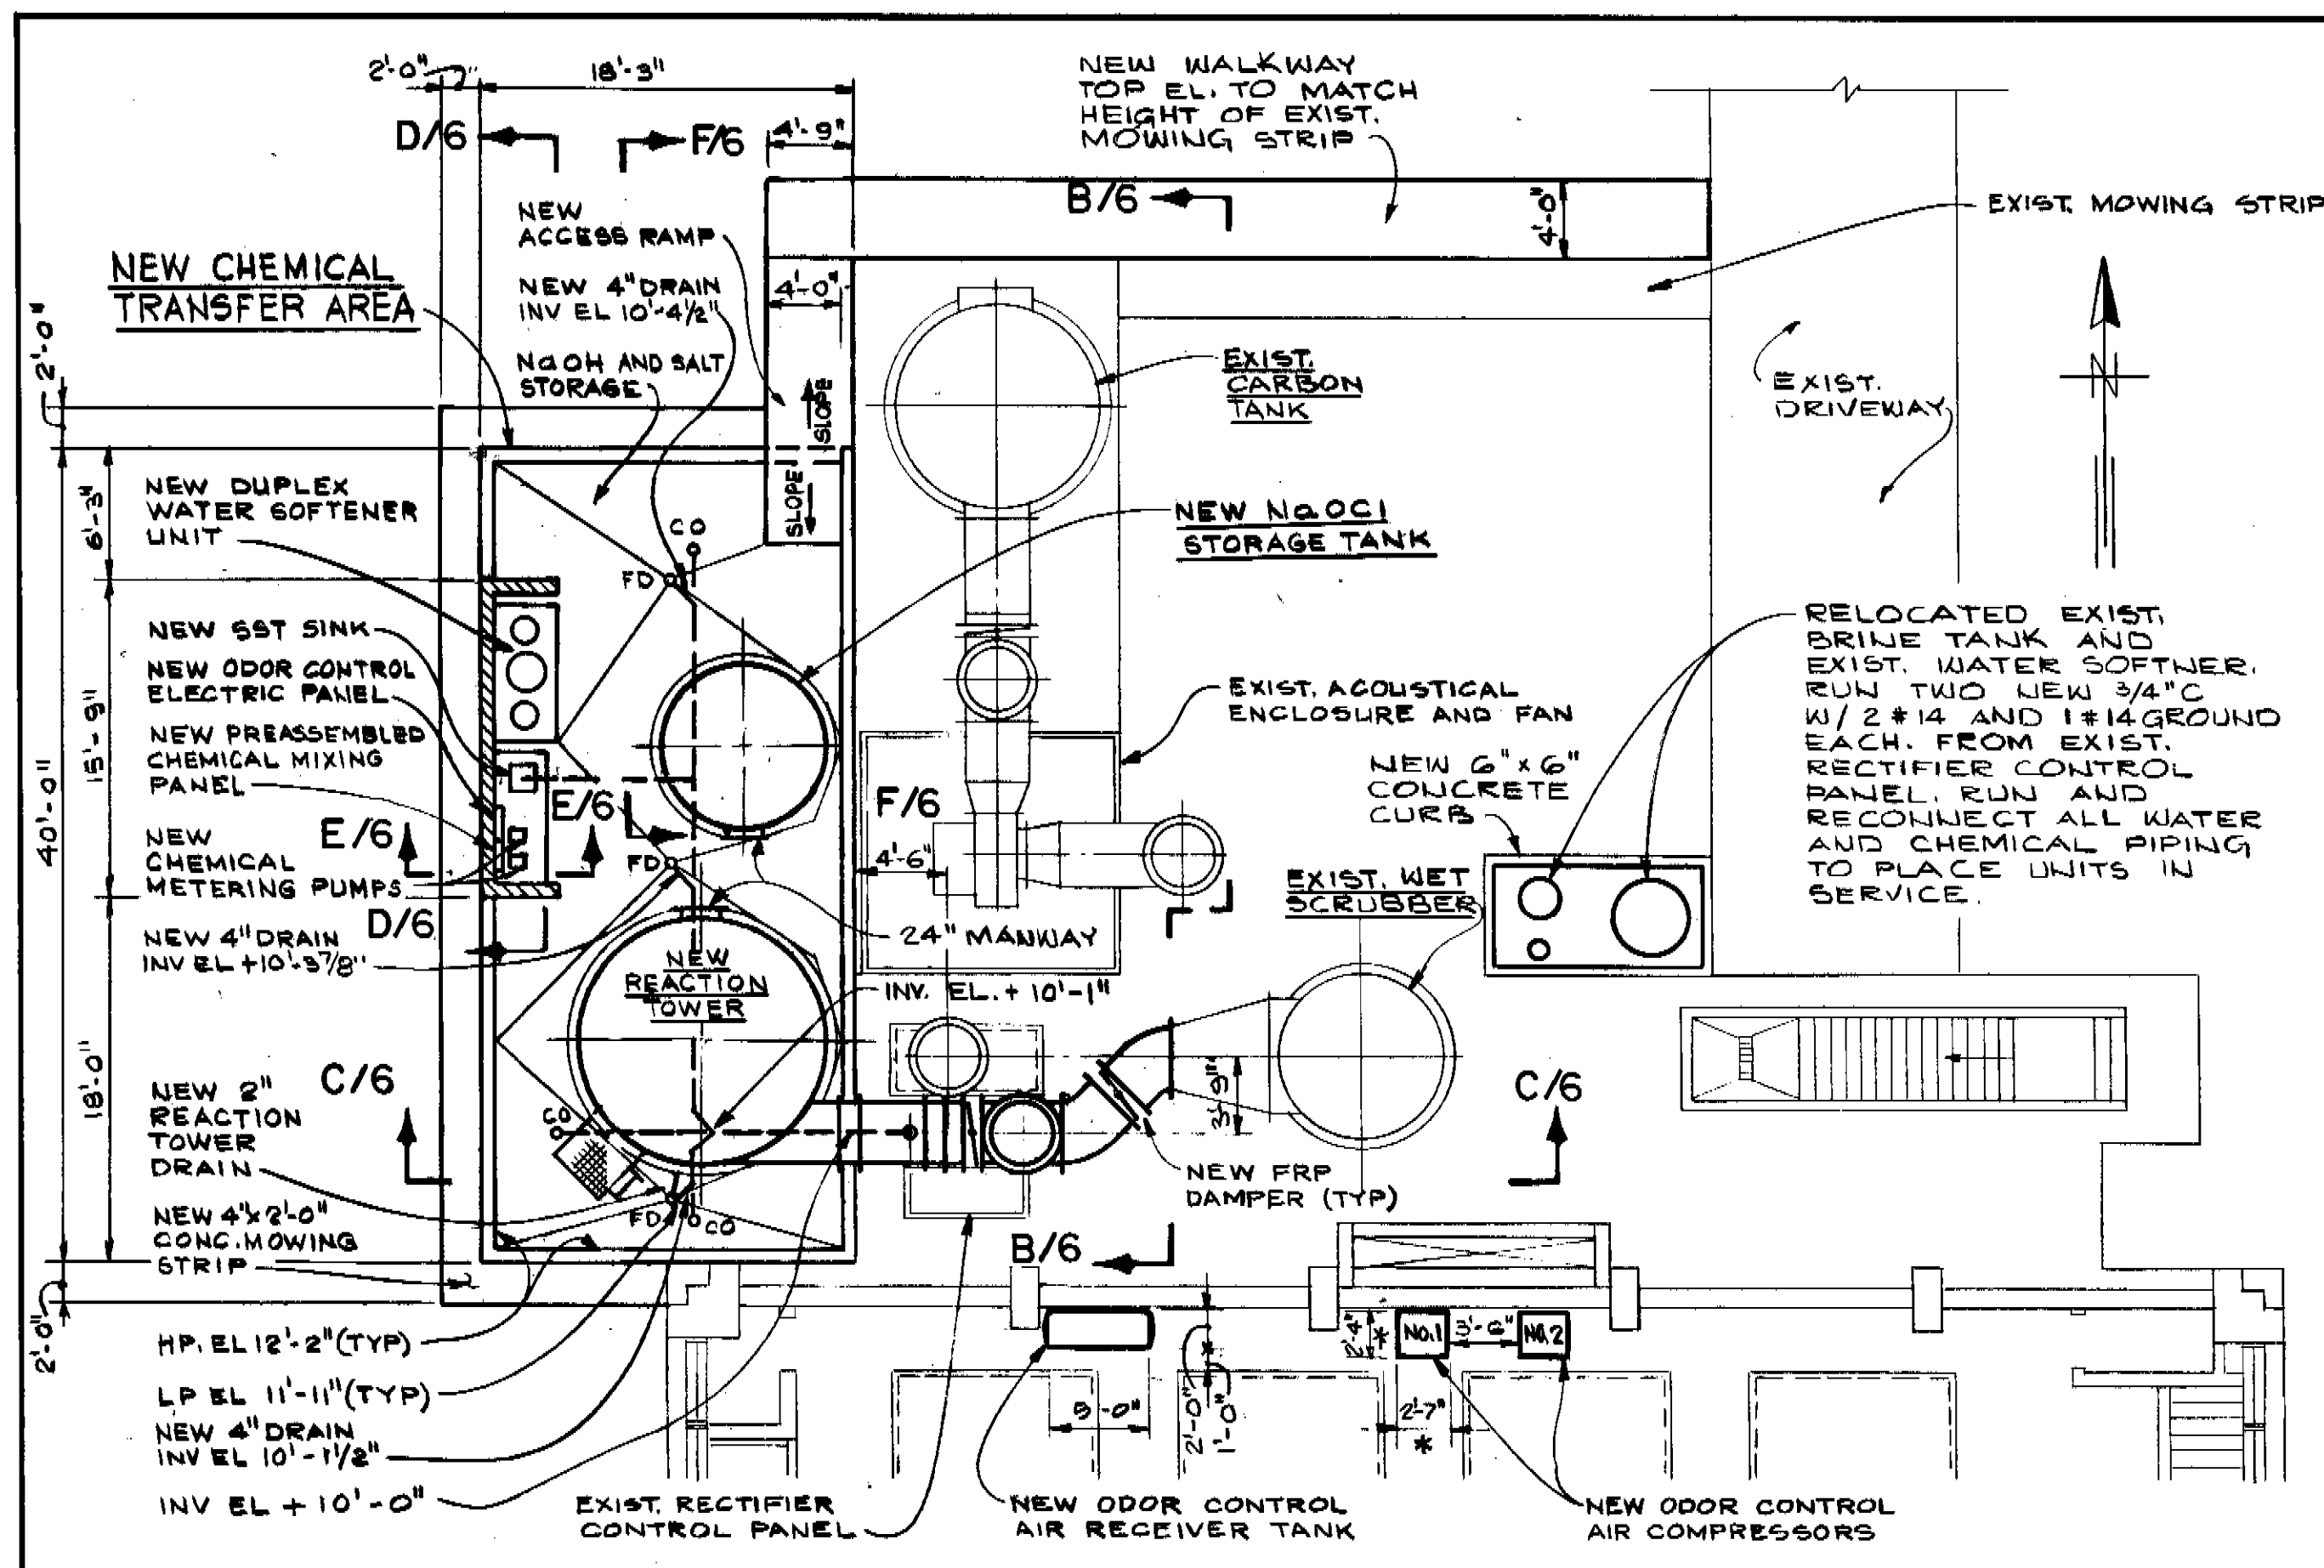


YBOR PUMPING STATION - PLAN AT EL 22'-0"
SCALE: 1/8" = 1'-0"

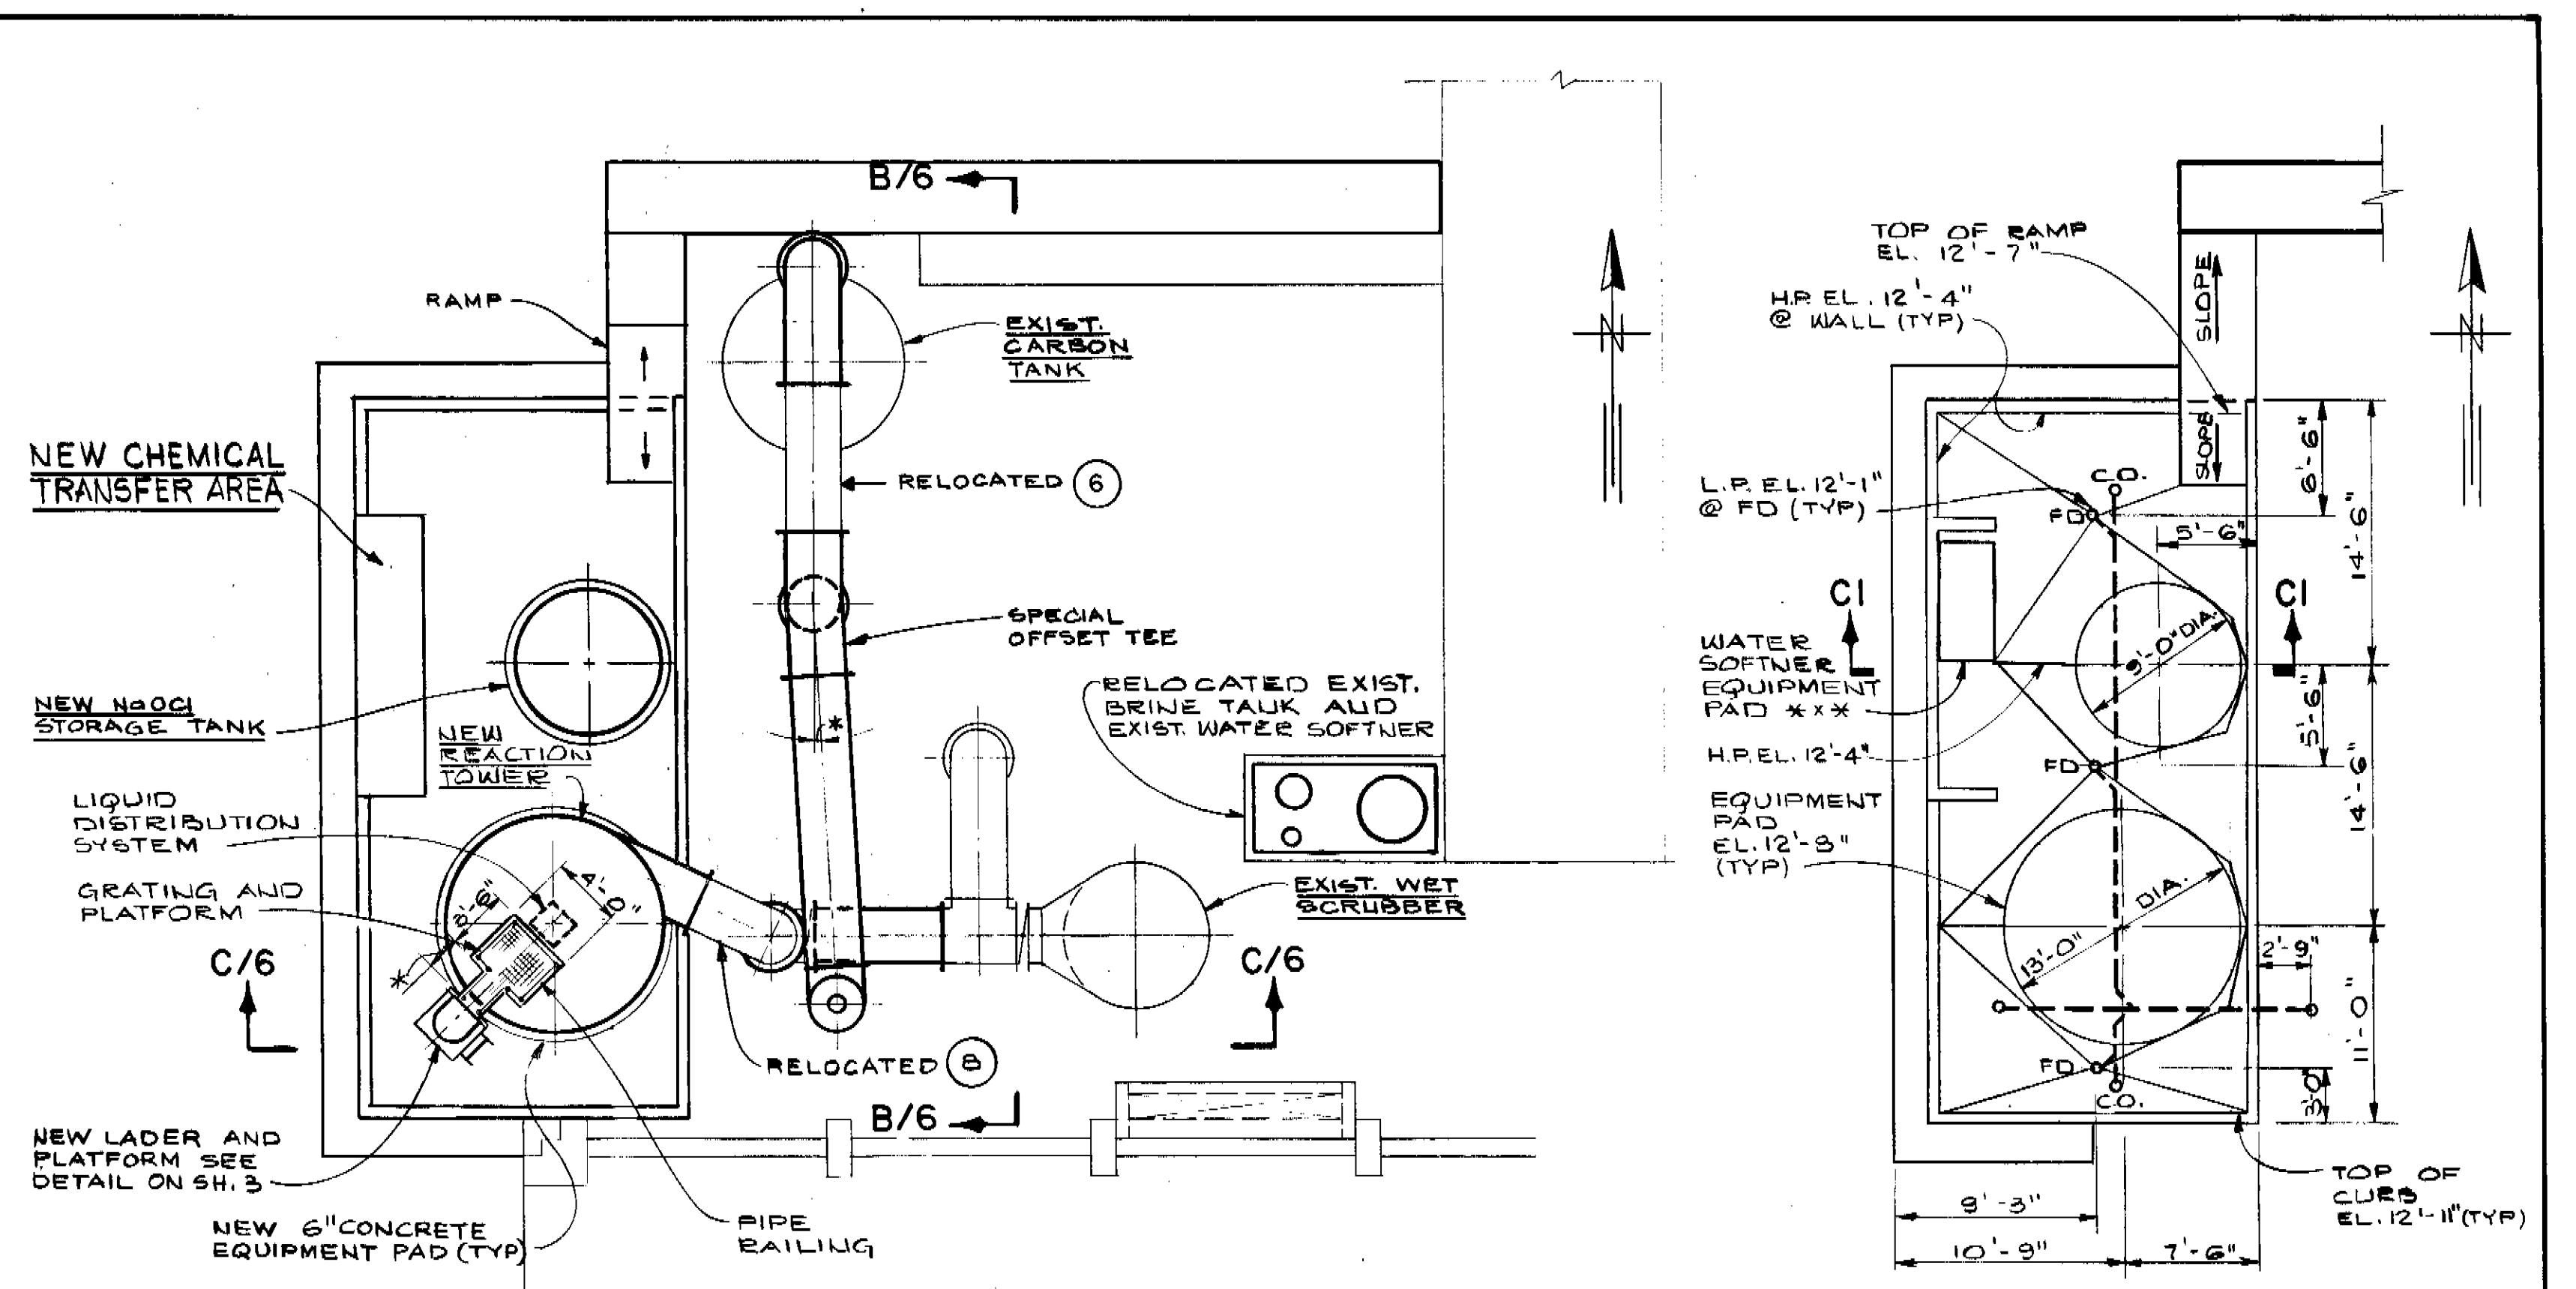


YBOR PUMPING STATION - TOP PLAN
SCALE: 1/8" = 1'-0"


PART PLAN AT EL 12'-11"
SCALE: 1/8" = 1'-0"

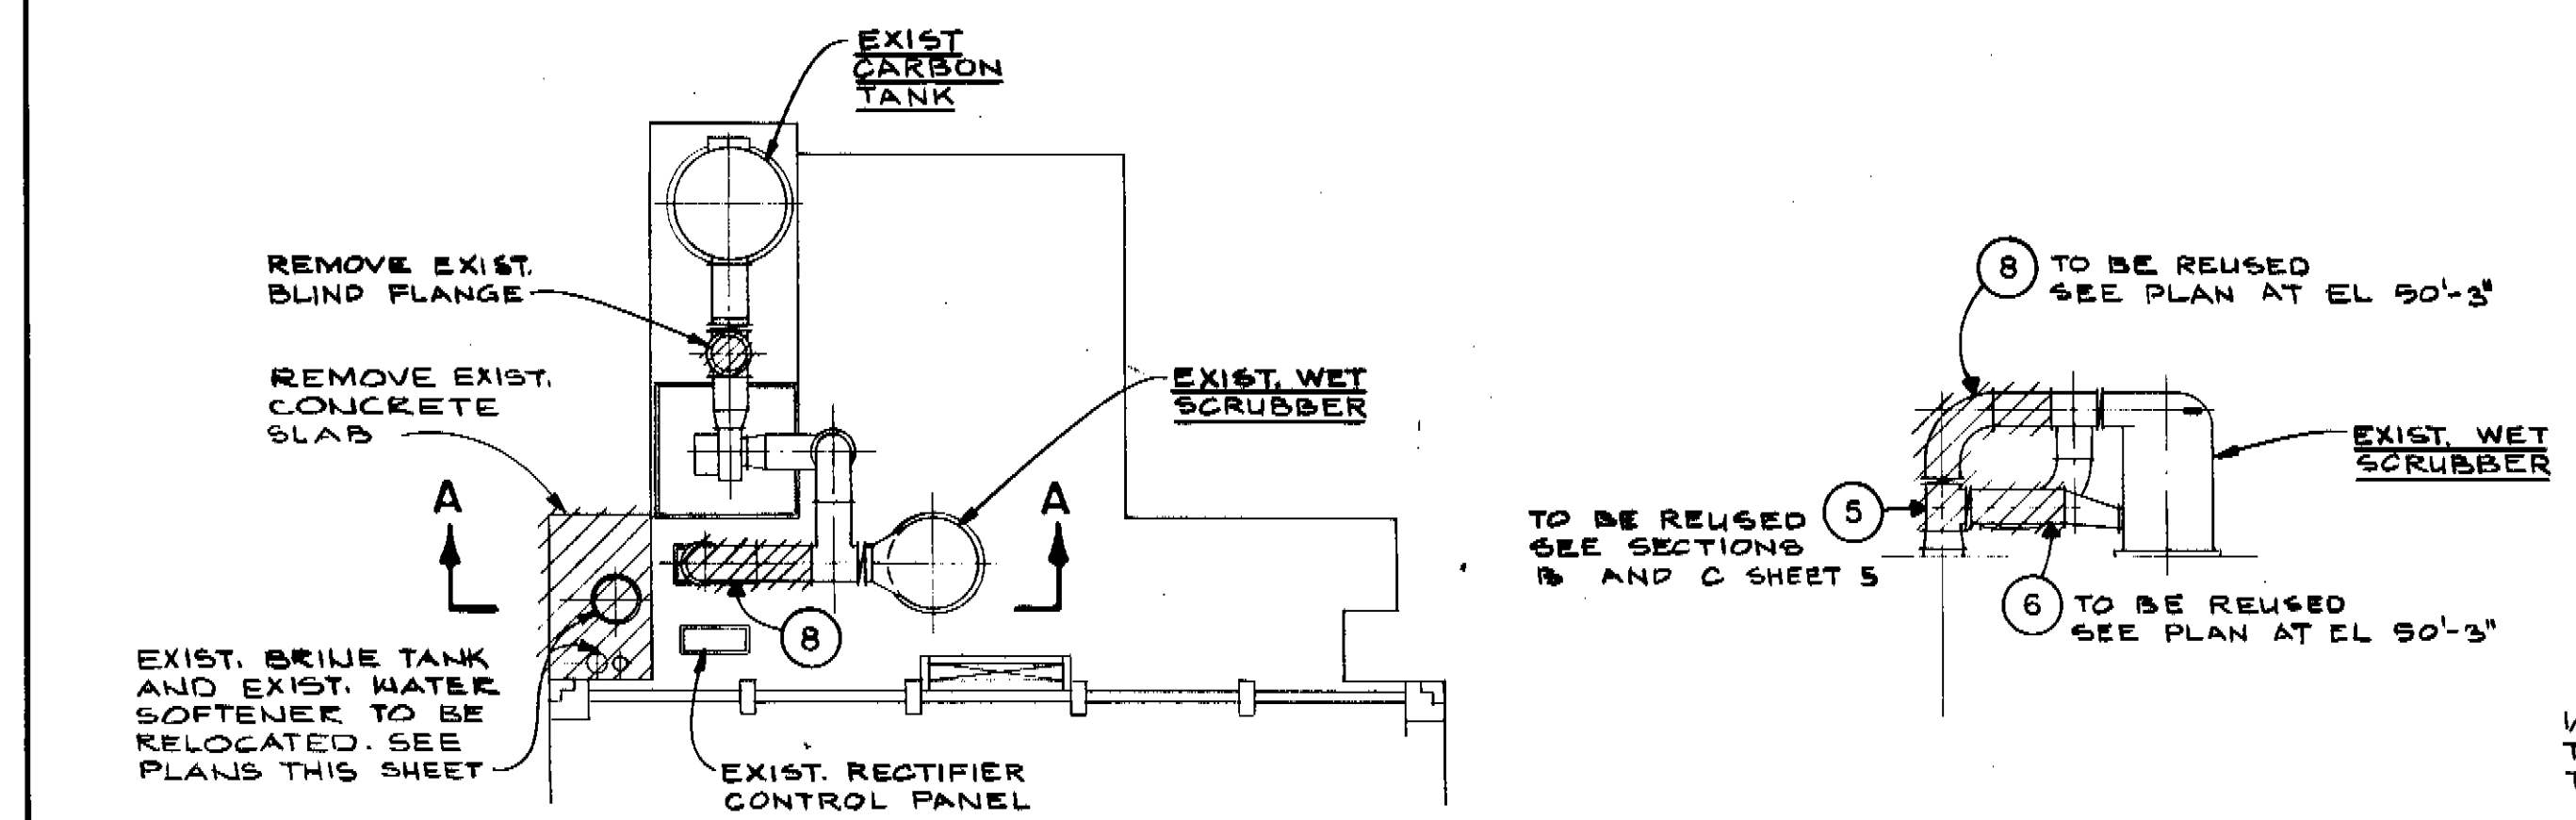


DEMOLITION PLAN
SCALE: 1/16" = 1'-0"

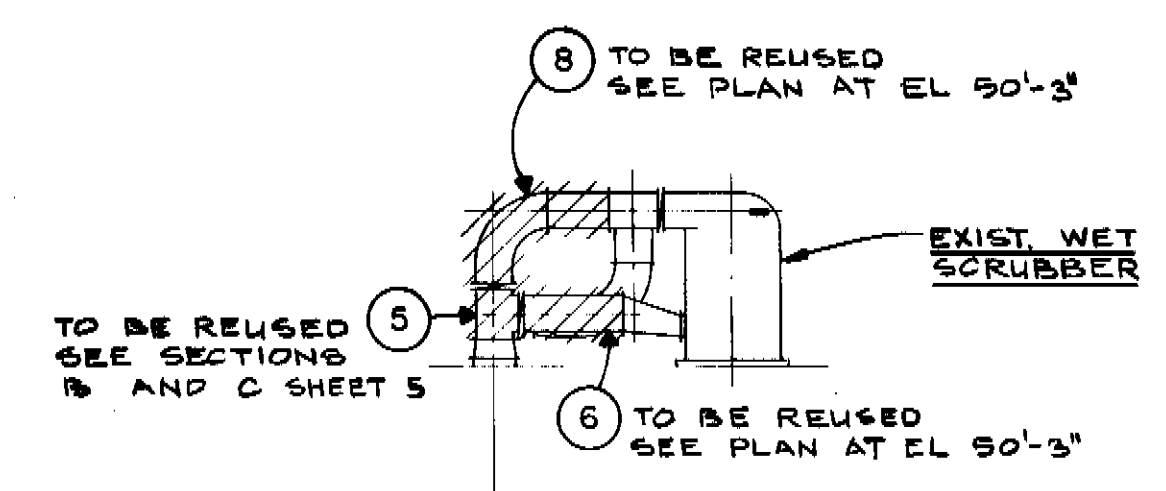

DEMOLITION SECTION A
SCALE: 1/16" = 1'-0"

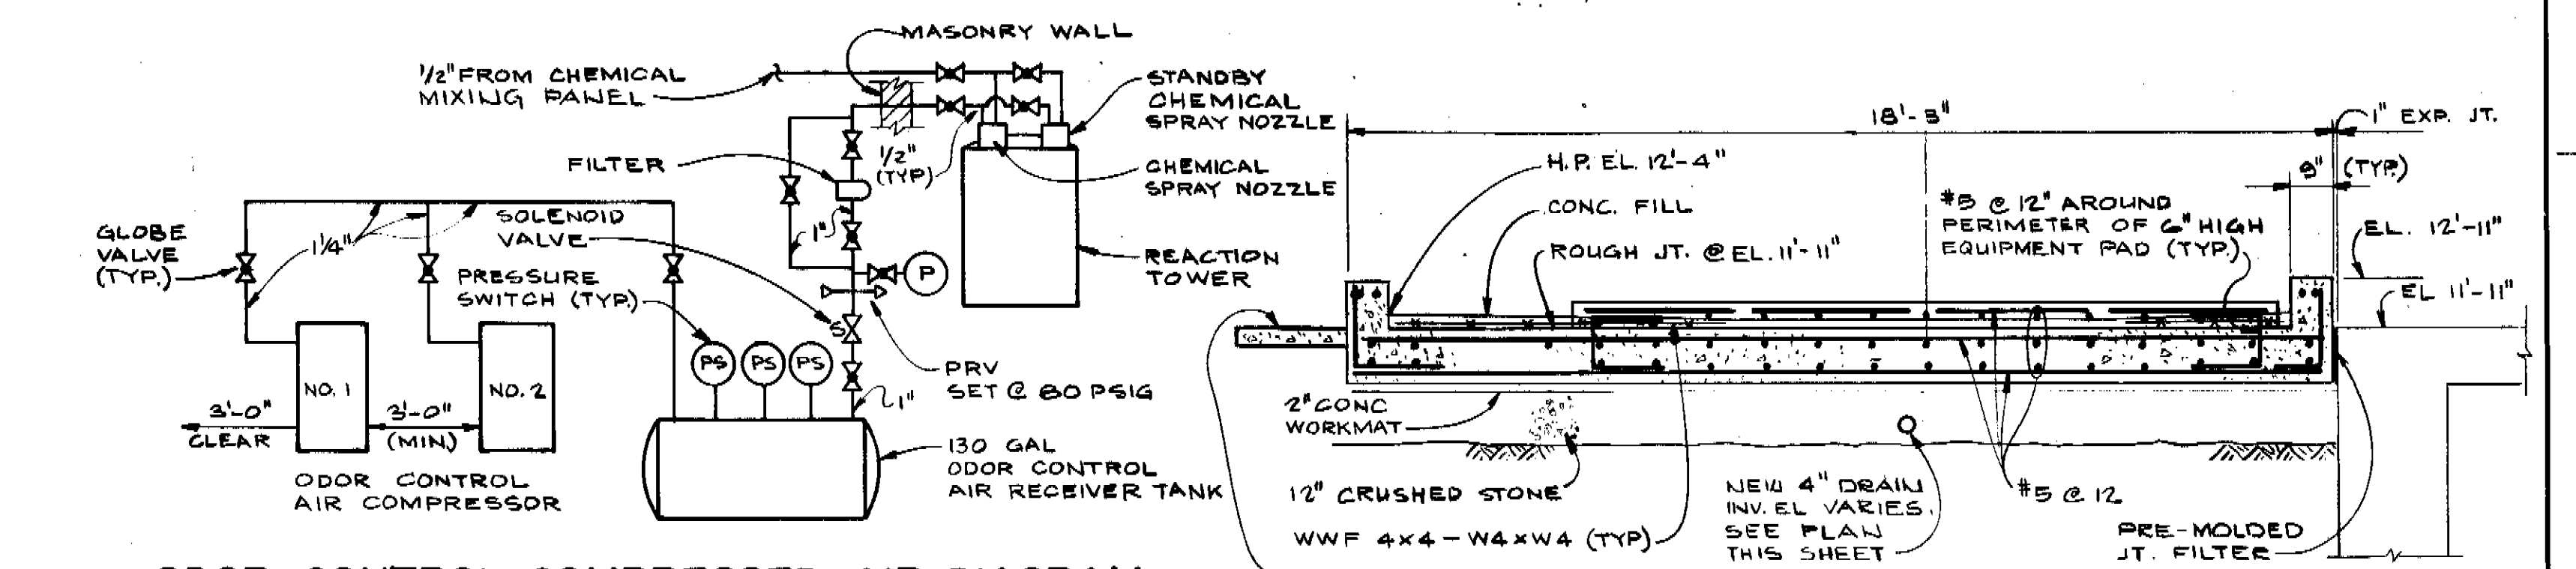

ODOR CONTROL COMPRESSED AIR DIAGRAM
NO SCALE

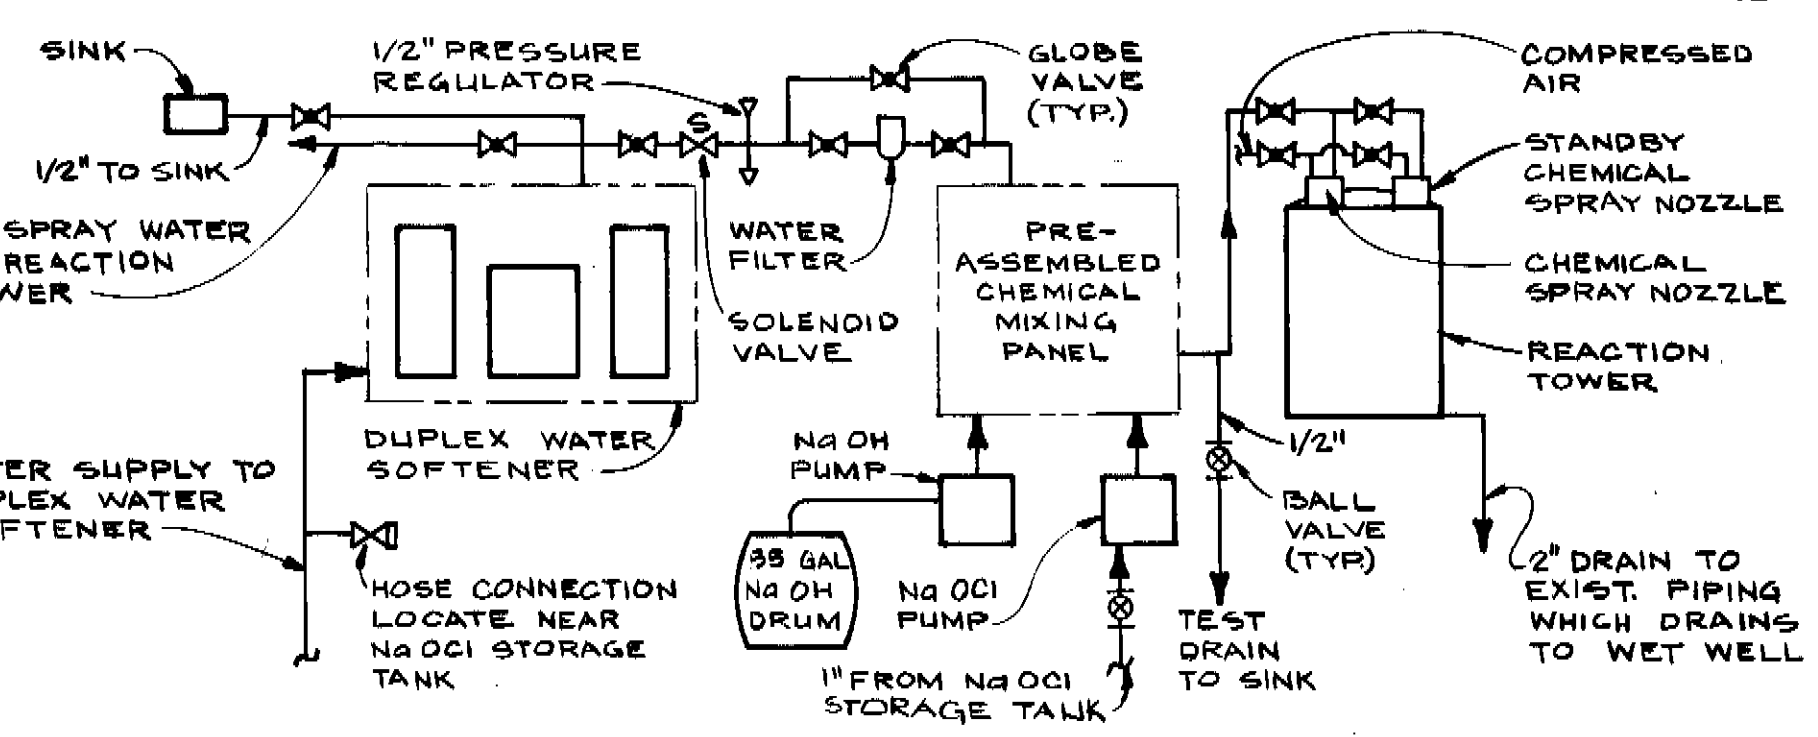

ODOR CONTROL CHEMICAL SYSTEM DIAGRAM
NO SCALE


SECTION C1
SCALE: 3/8" = 1'-0"

- NOTES:**
1. DUCTWORK DESIGNATED WITH A CIRCLED NUMBER IS EXISTING. SEE PEPCON DWG'S: 20.8-161 THROUGH 20.8-167 FOR EXISTING LOCATIONS.
 2. EXISTING DUCTWORK DESIGNATED 5, 6, AND 8 IS TO BE RELOCATED AS SHOWN ON THESE DRAWINGS.
 3. EACH FLANGED CONNECTION IN DUCTWORK REQUIRES A 1/8-INCH THICK GASKET.
 4. ALL NEW DUCT WORK SHALL BE PIGMENTED WHITE AND SHALL MATCH CONSTRUCTION OF EXISTING DUCT IN ALL RESPECTS.
 5. THIS SHEET APPLIES ONLY TO SYSTEMS WHICH REQUIRE HIGH PRESSURE AIR COMPRESSOR EQUIPMENT.

GREELEY AND HANSEN
ENGINEERS
222 S. RIVERSIDE PLAZA
CHICAGO, ILLINOIS 60608

DESIGNED MPV JRP
DRAWN SK
CHECKED JRP

NO.	DATE	APP.	REVISION

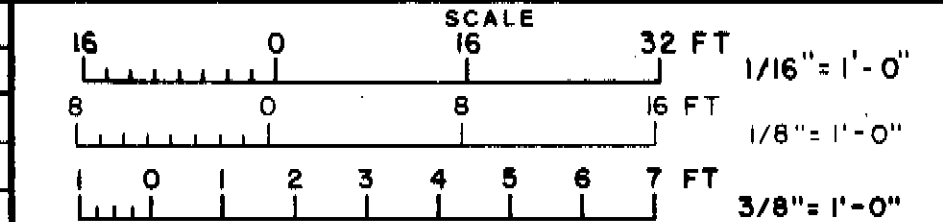


CITY OF TAMPA, FLORIDA
SEWAGE DISPOSAL SYSTEM
DIVISION 4L5
PUMPING STATIONS
ODOR CONTROL MODIFICATIONS


YBOR PUMPING STATION
PLANS, SECTIONS, DIAGRAMS

PROJ. NO.
DWG. SHEET **4** OF 10
DATE JULY 1985
REV. 0


173-37d

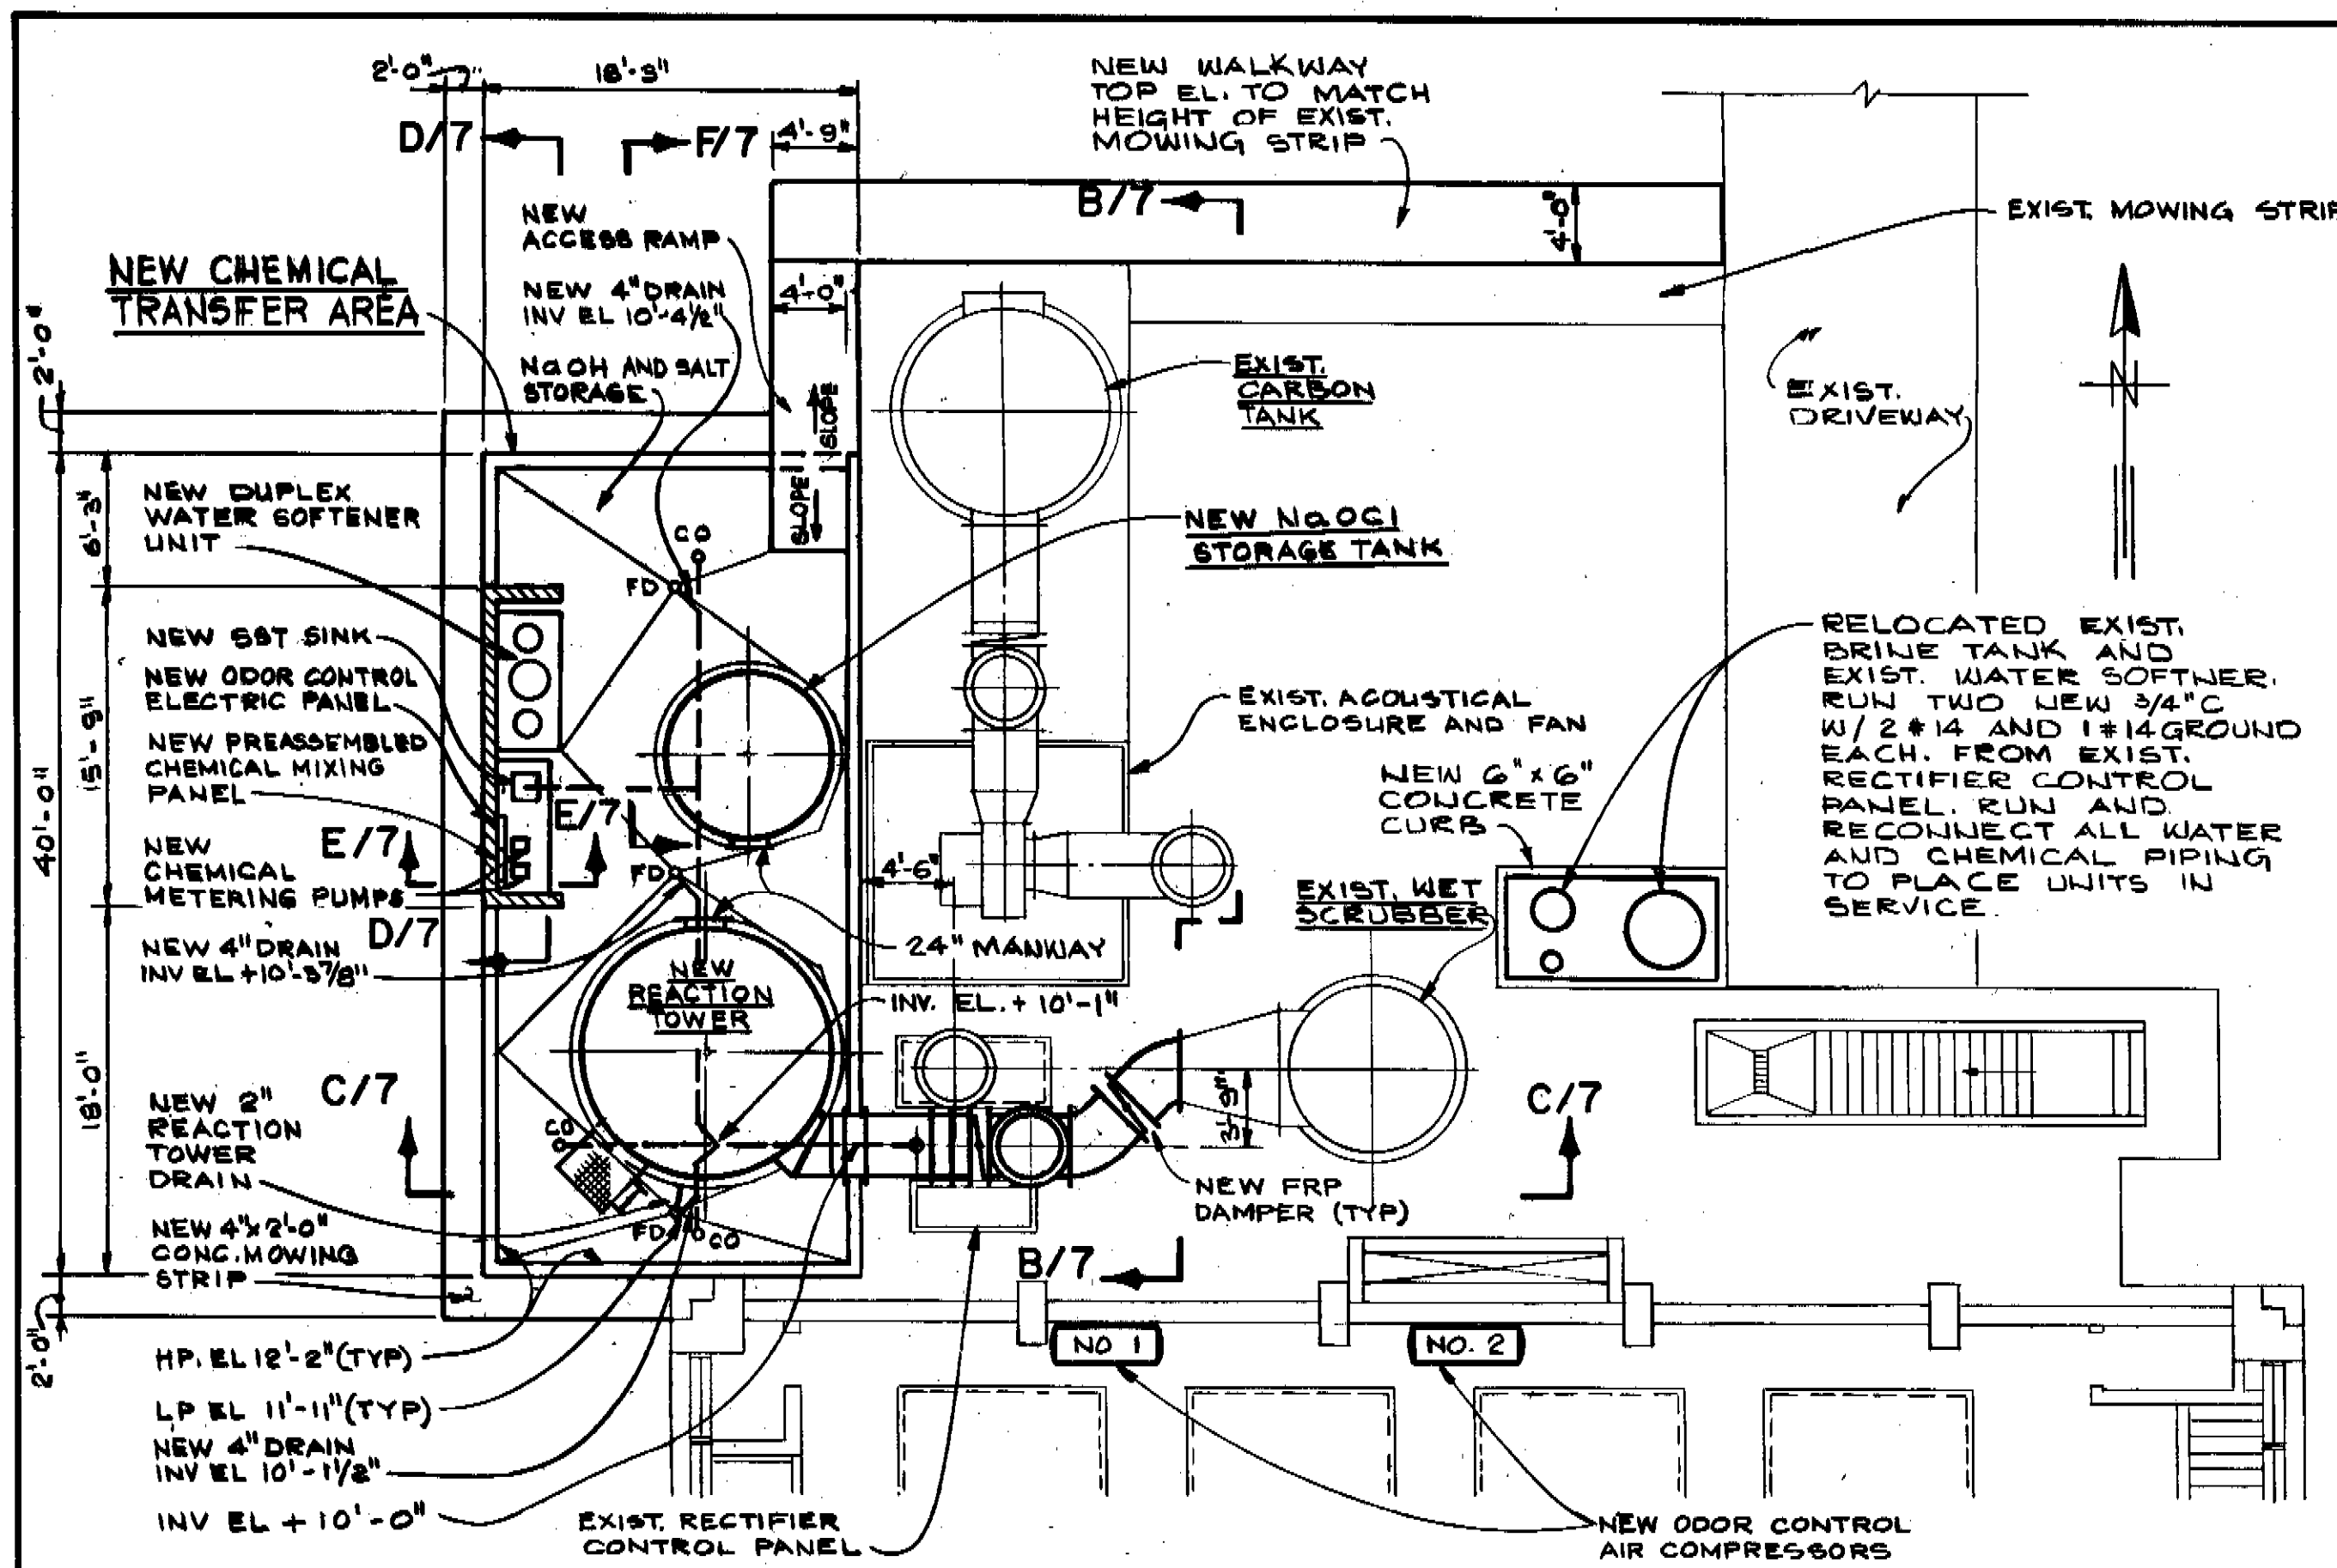


YBOR PUMPING STATION - PLAN AT EL 22'-0"
SCALE: 1/8" = 1'-0"

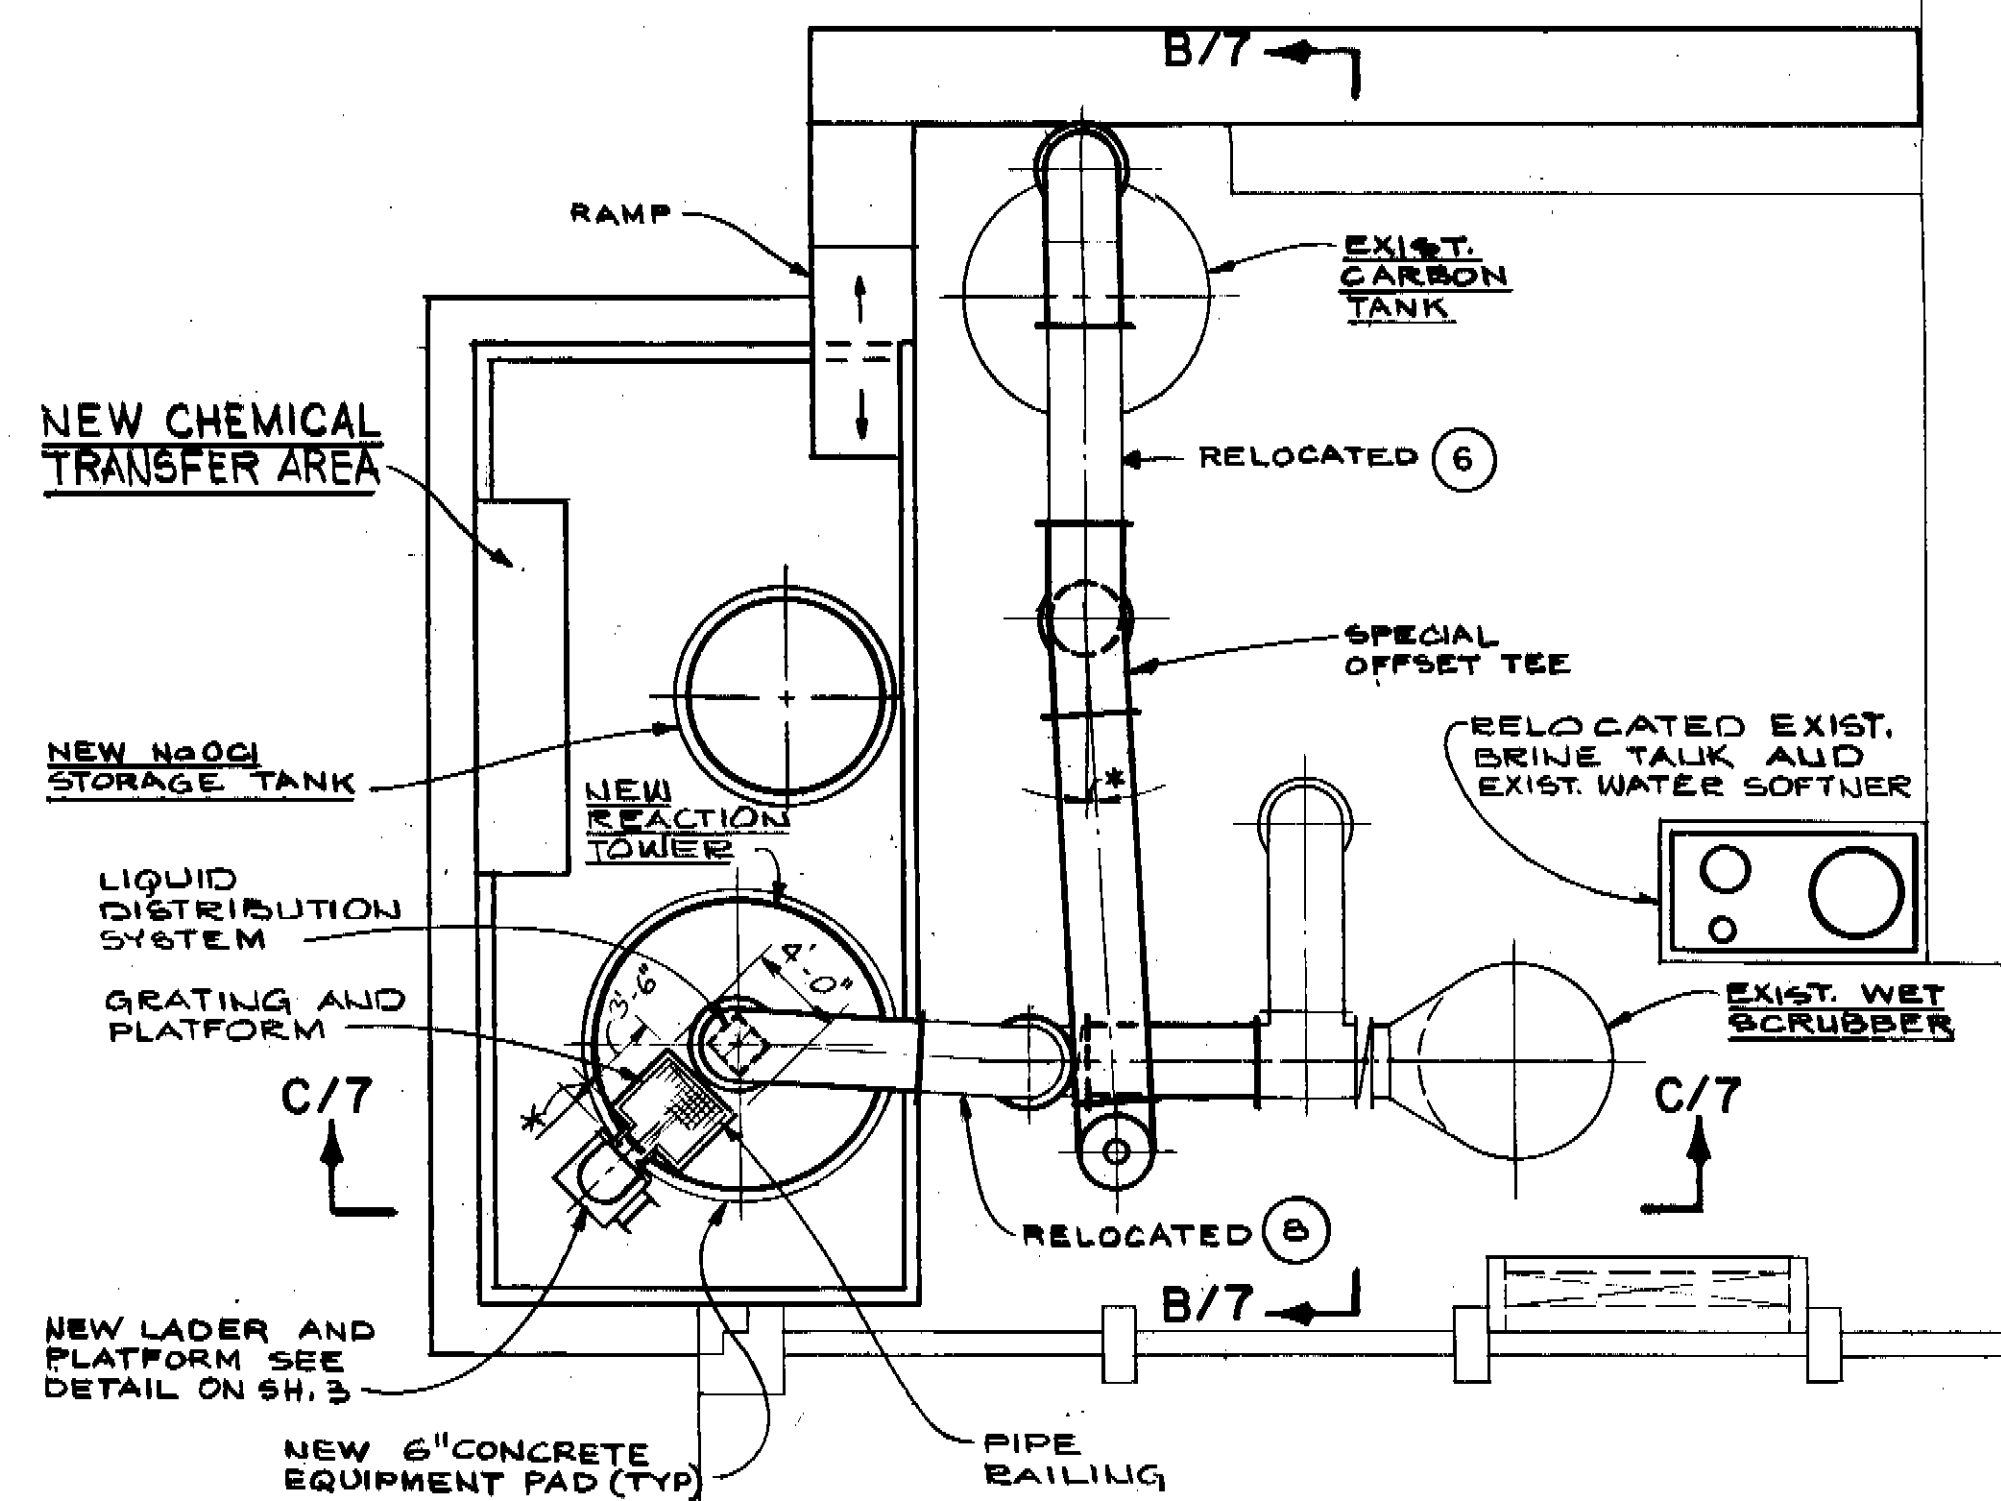


YBOR PUMPING STATION - TOP PLAN
SCALE: 1/8" = 1'-0"

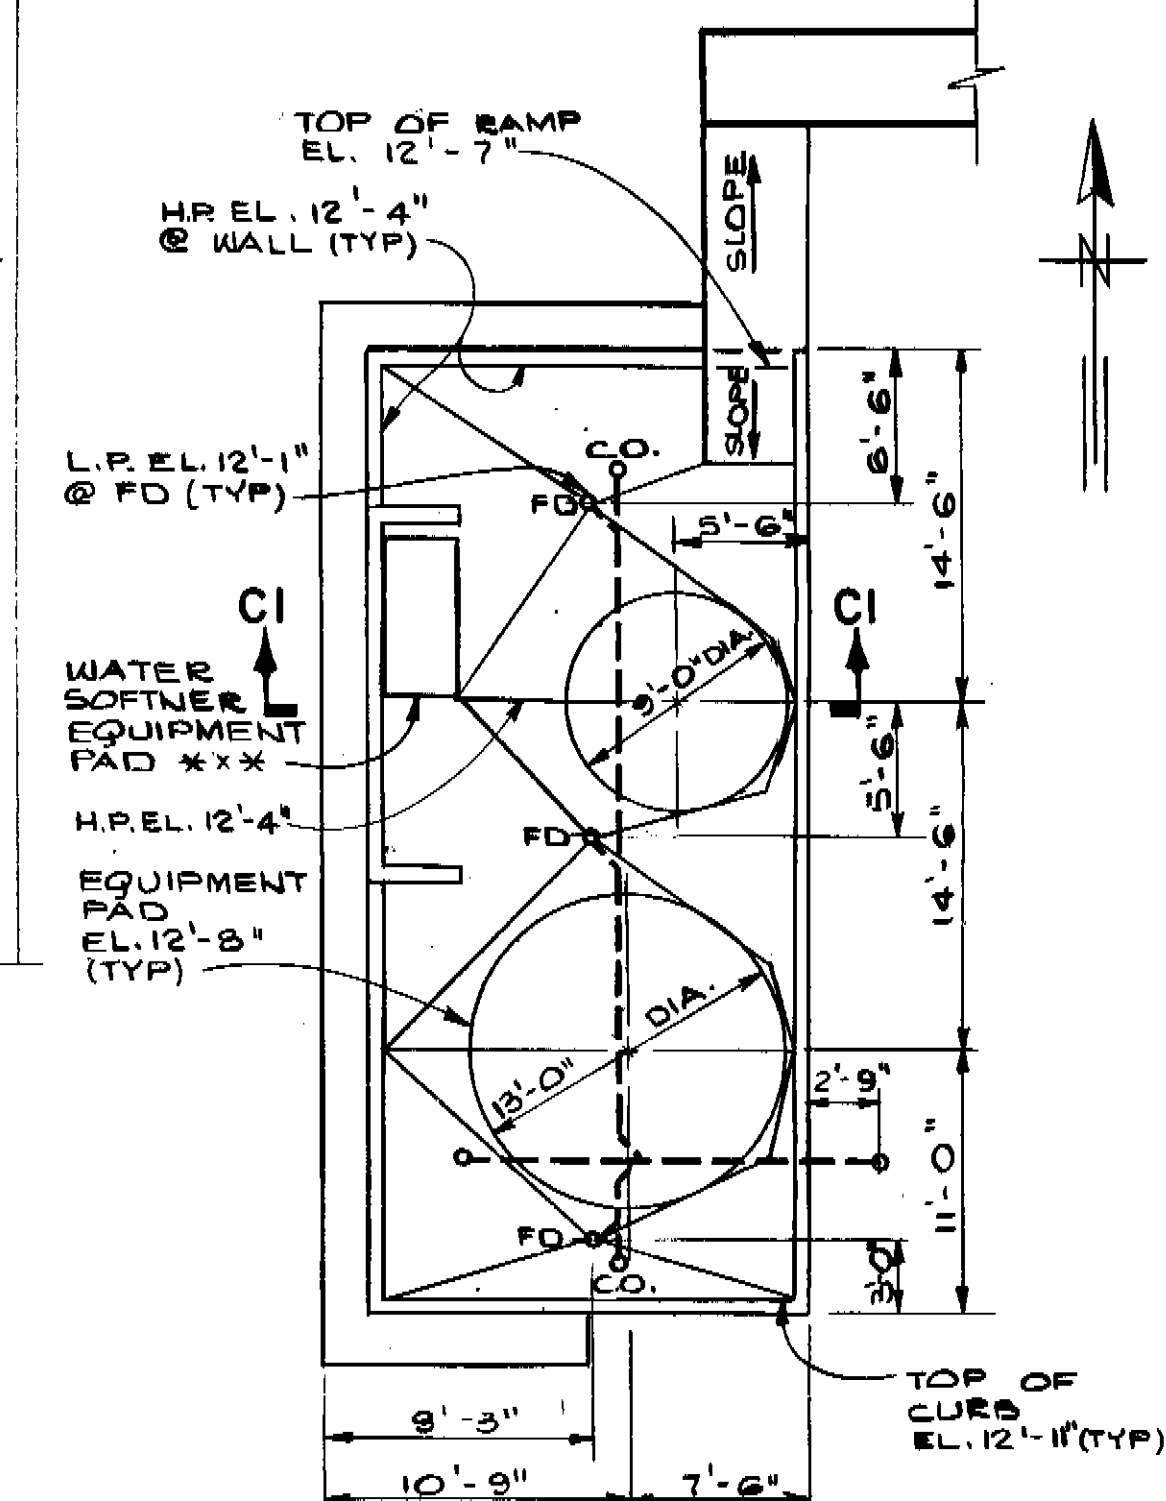



PART PLAN AT EL 12'-11"
SCALE: 1/8" = 1'-0"

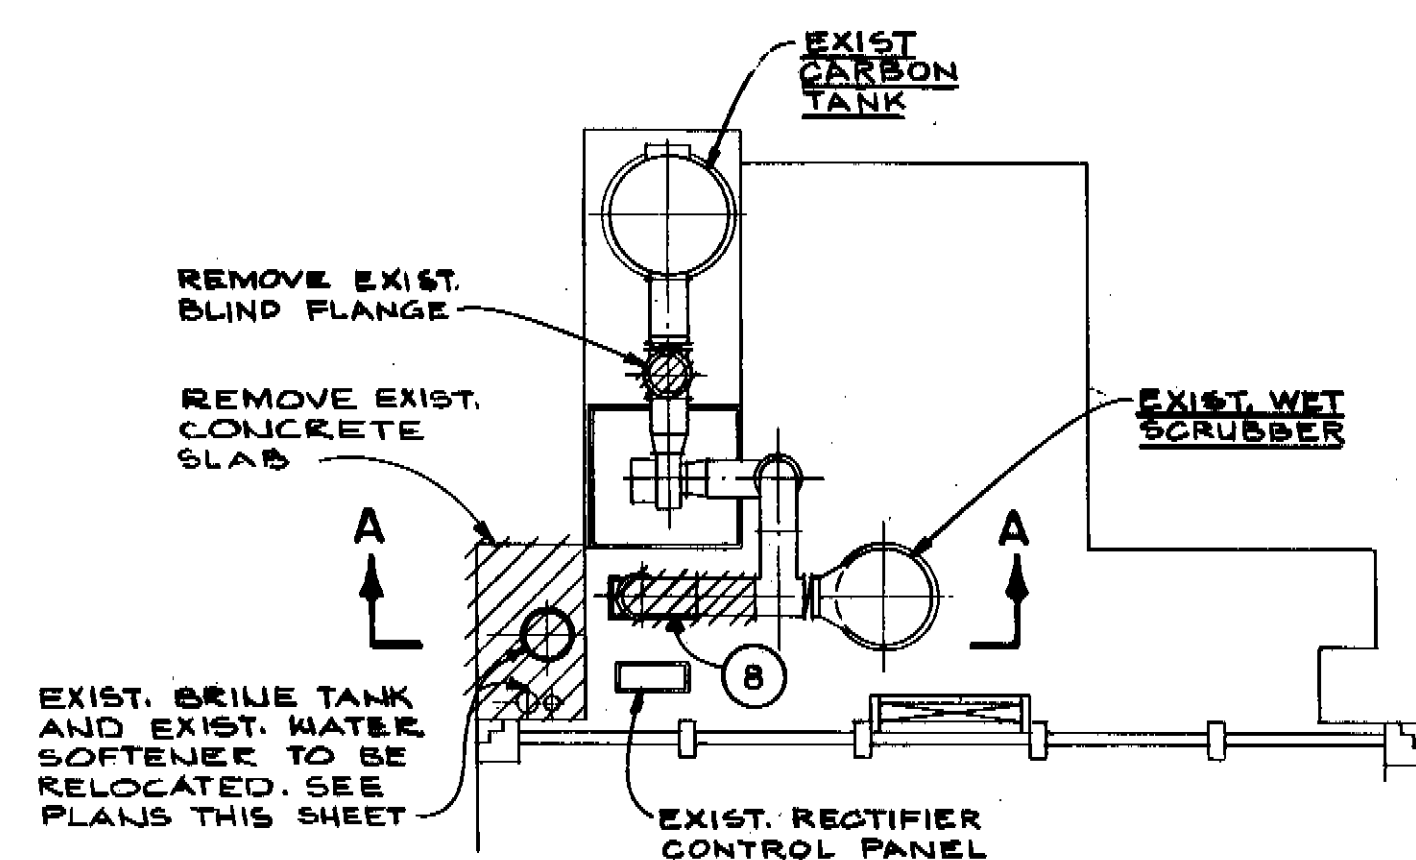


DEMOLITION PLAN
SCALE: 1/16" = 1'-0"

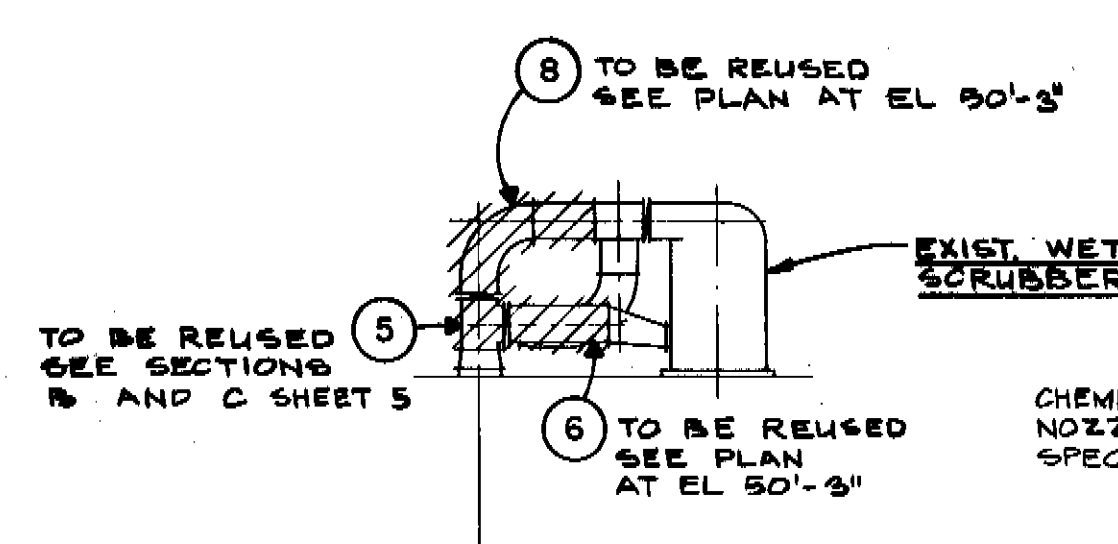

DEMOLITION SECTION A
SCALE: 1/16" = 1'-0"

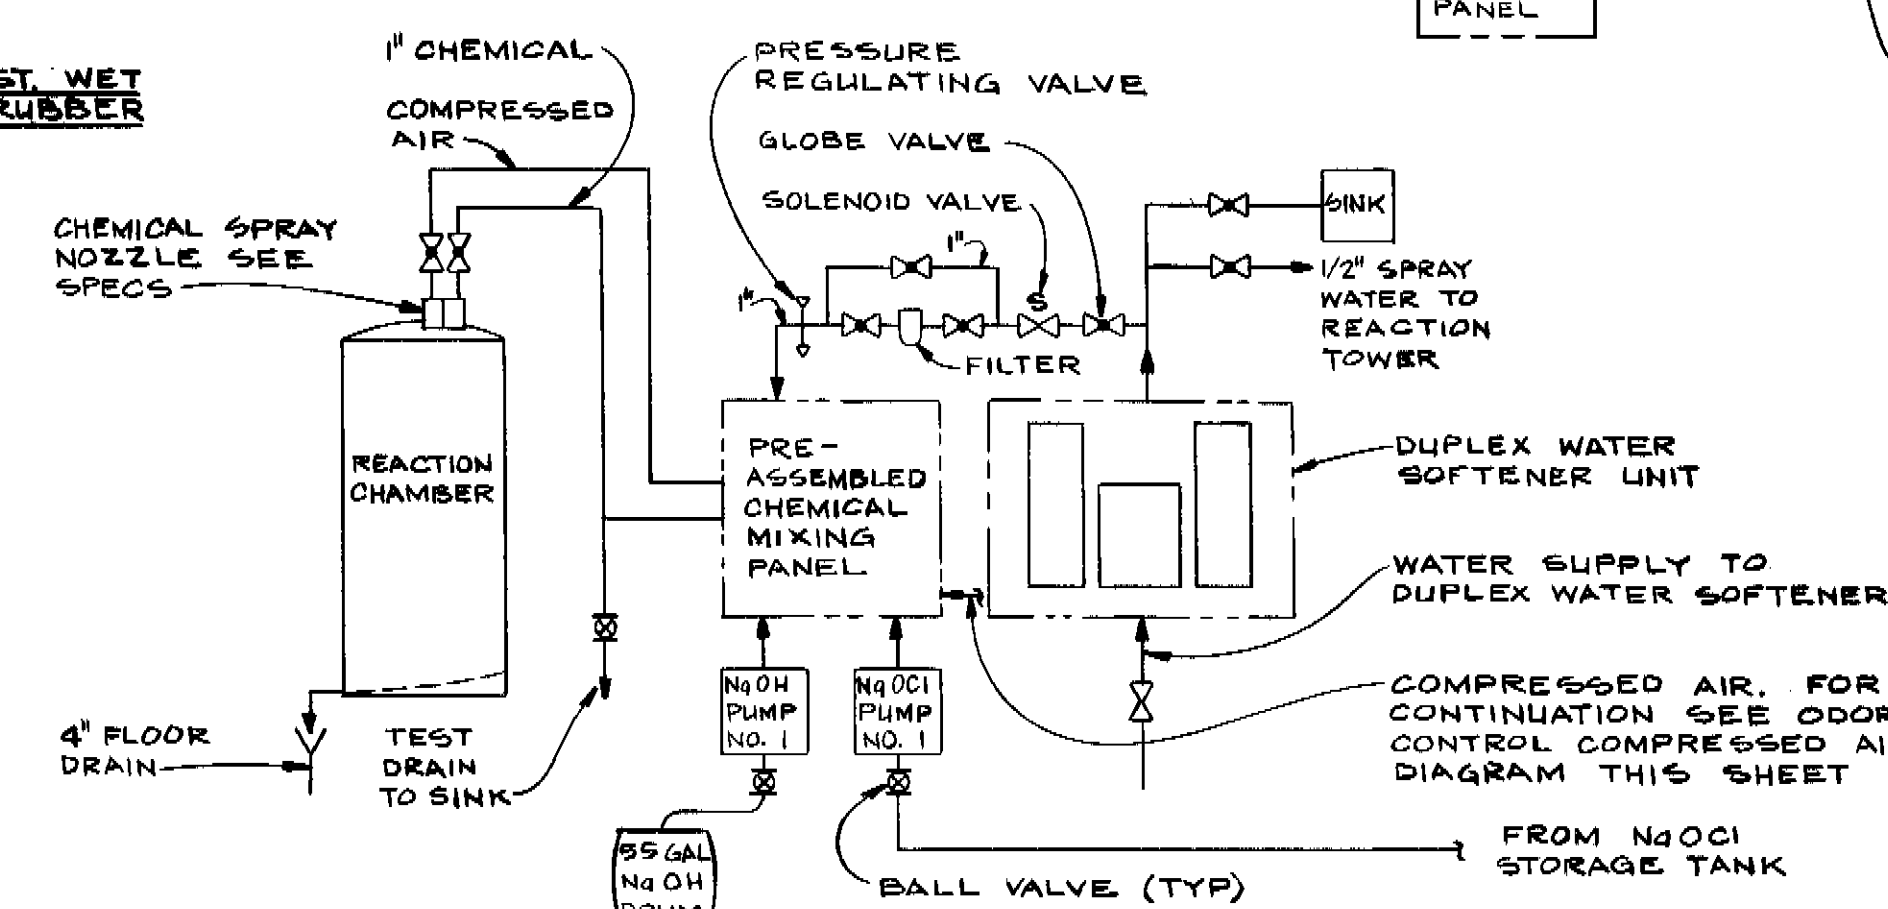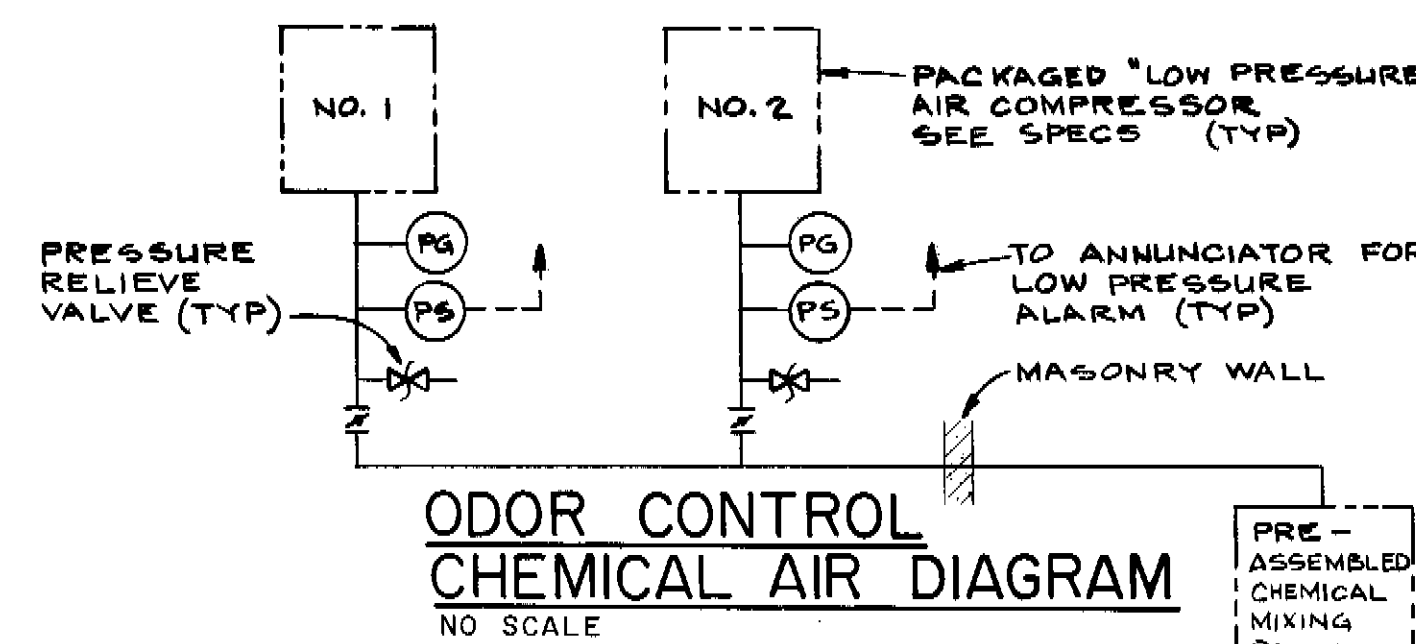

ODOR CONTROL CHEMICAL SYSTEM DIAGRAM
NO SCALE

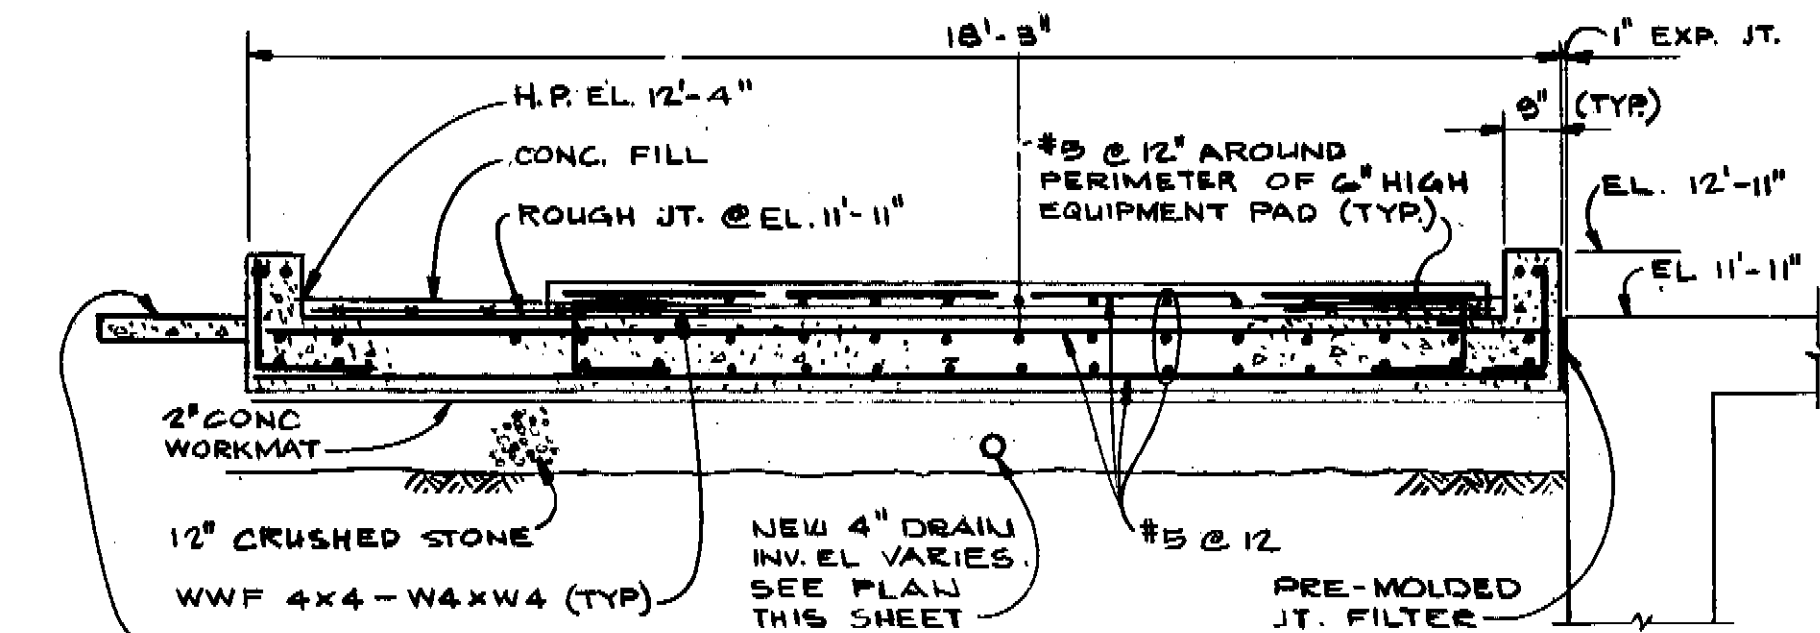


SECTION C1
SCALE: 3/8" = 1'-0"

- NOTES:**
1. DUCTWORK DESIGNATED WITH A CIRCLED NUMBER IS EXISTING. SEE PEPCON DWG'S: 20.8-161 THROUGH 20.8-167 FOR EXISTING LOCATIONS.
 2. EXISTING DUCTWORK DESIGNATED 5, 6, AND 8 IS TO BE RELOCATED AS SHOWN ON THESE DRAWINGS.
 3. EACH FLANGED CONNECTION IN DUCTWORK REQUIRES A 1/8-INCH THICK GASKET.
 4. ALL NEW DUCT WORK SHALL BE PIGMENTED WHITE AND SHALL MATCH CONSTRUCTION OF EXISTING DUCT IN ALL RESPECTS.
 5. THIS SHEET APPLIES ONLY TO SYSTEMS WHICH REQUIRE LOW PRESSURE AIR COMPRESSOR EQUIPMENT.

GREELEY AND HANSEN
ENGINEERS
222 S. RIVERSIDE PLAZA
CHICAGO, ILLINOIS 60606

DESIGNED MPV JRP
DRAWN SK
CHECKED JRP

NO.	DATE	APP.	REVISION

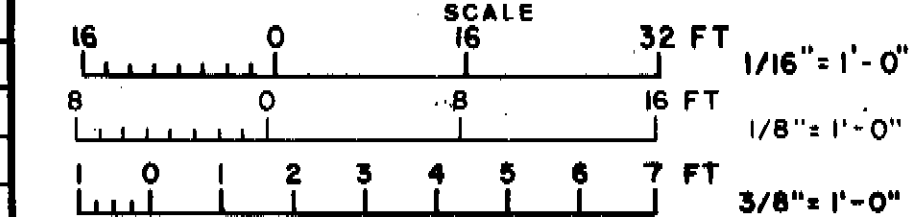


CITY OF TAMPA, FLORIDA
SEWAGE DISPOSAL SYSTEM
DIVISION 4L5
PUMPING STATIONS
ODOR CONTROL MODIFICATIONS


YBOR PUMPING STATION
PLANS, SECTIONS, DIAGRAMS

PROJ. NO.	DWG. SHEET	DATE	REV. O
	5 OF 10	JULY 1985	

173-37e

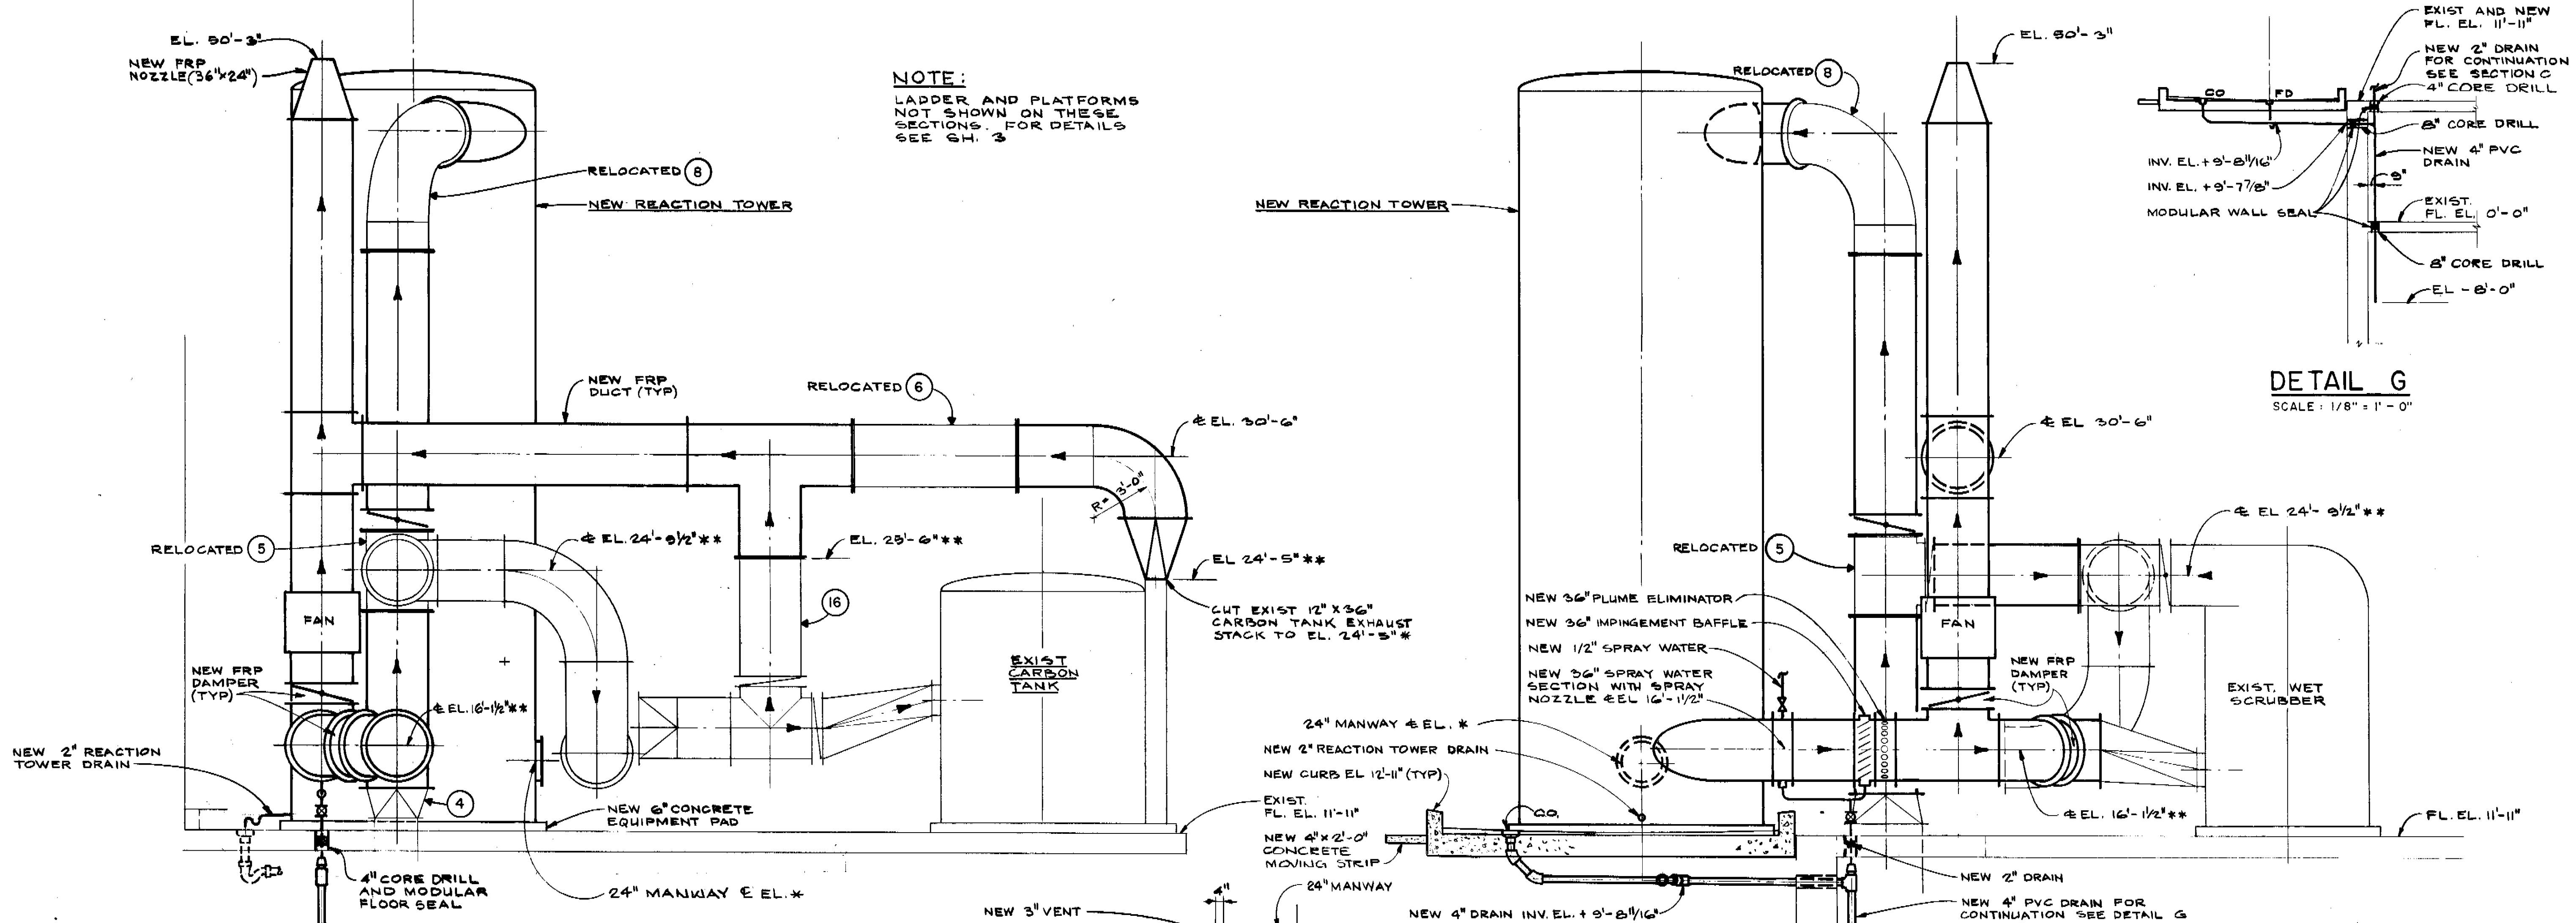


NOTE:
 LADDER AND PLATFORMS
 NOT SHOWN ON THESE
 SECTIONS. FOR DETAILS
 SEE SH. 3

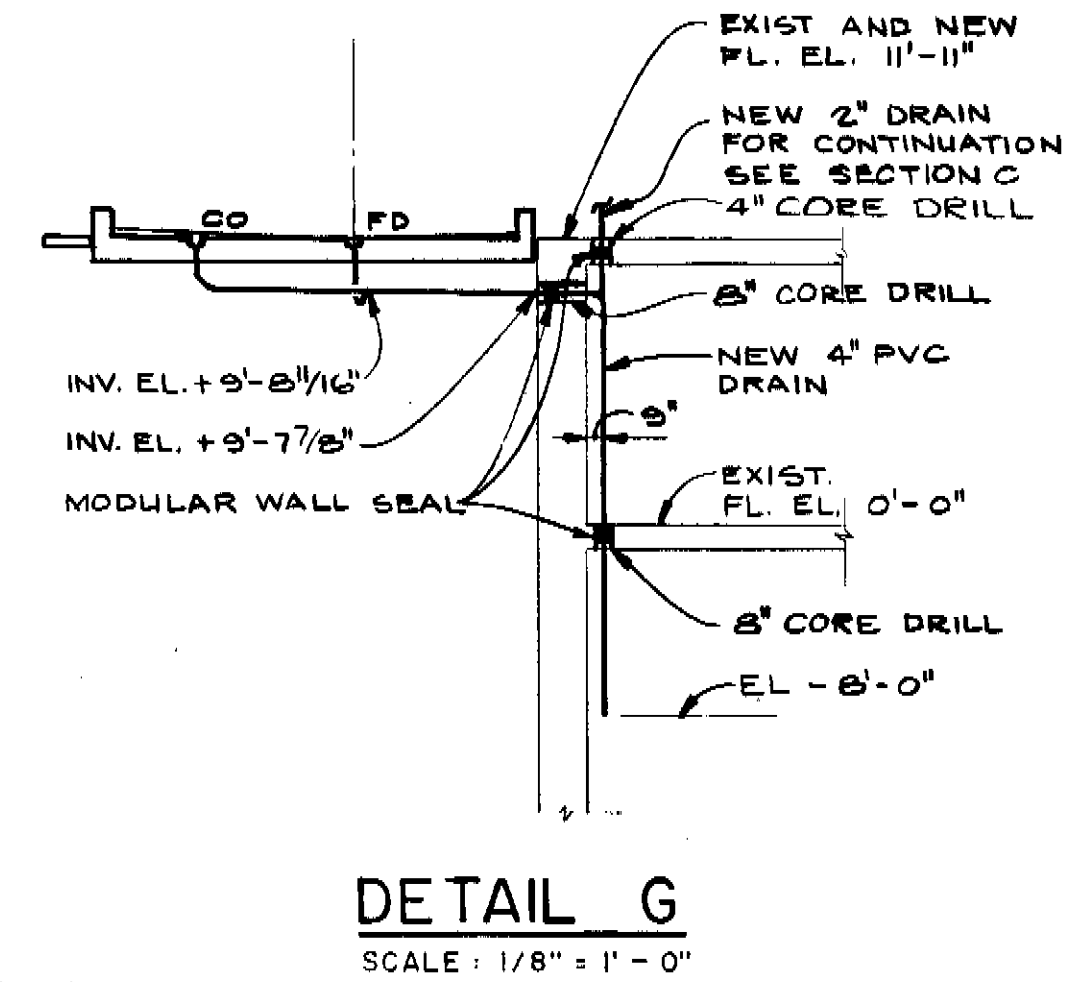


SECTION B/4
 SCALE: 1/4" = 1'-0"

SECTION C/4
 SCALE: 1/4" = 1'-0"

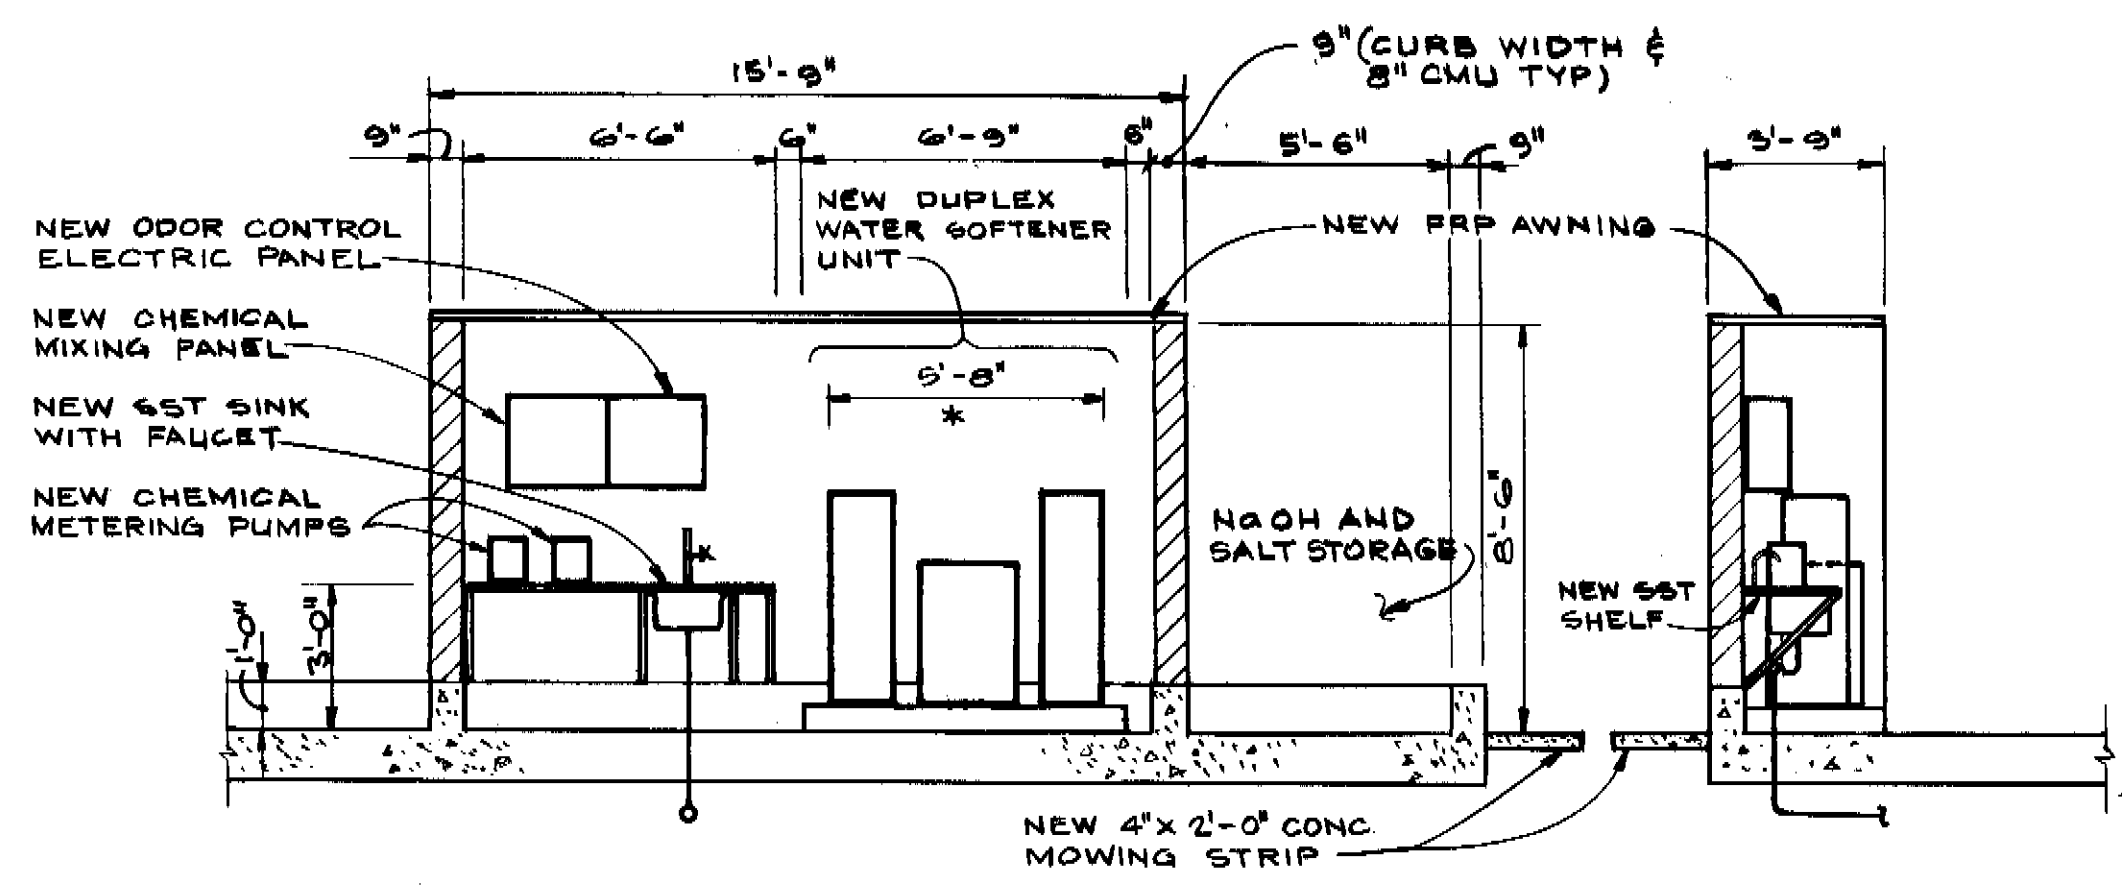


SECTION D/4
 SCALE: 1/4" = 1'-0"

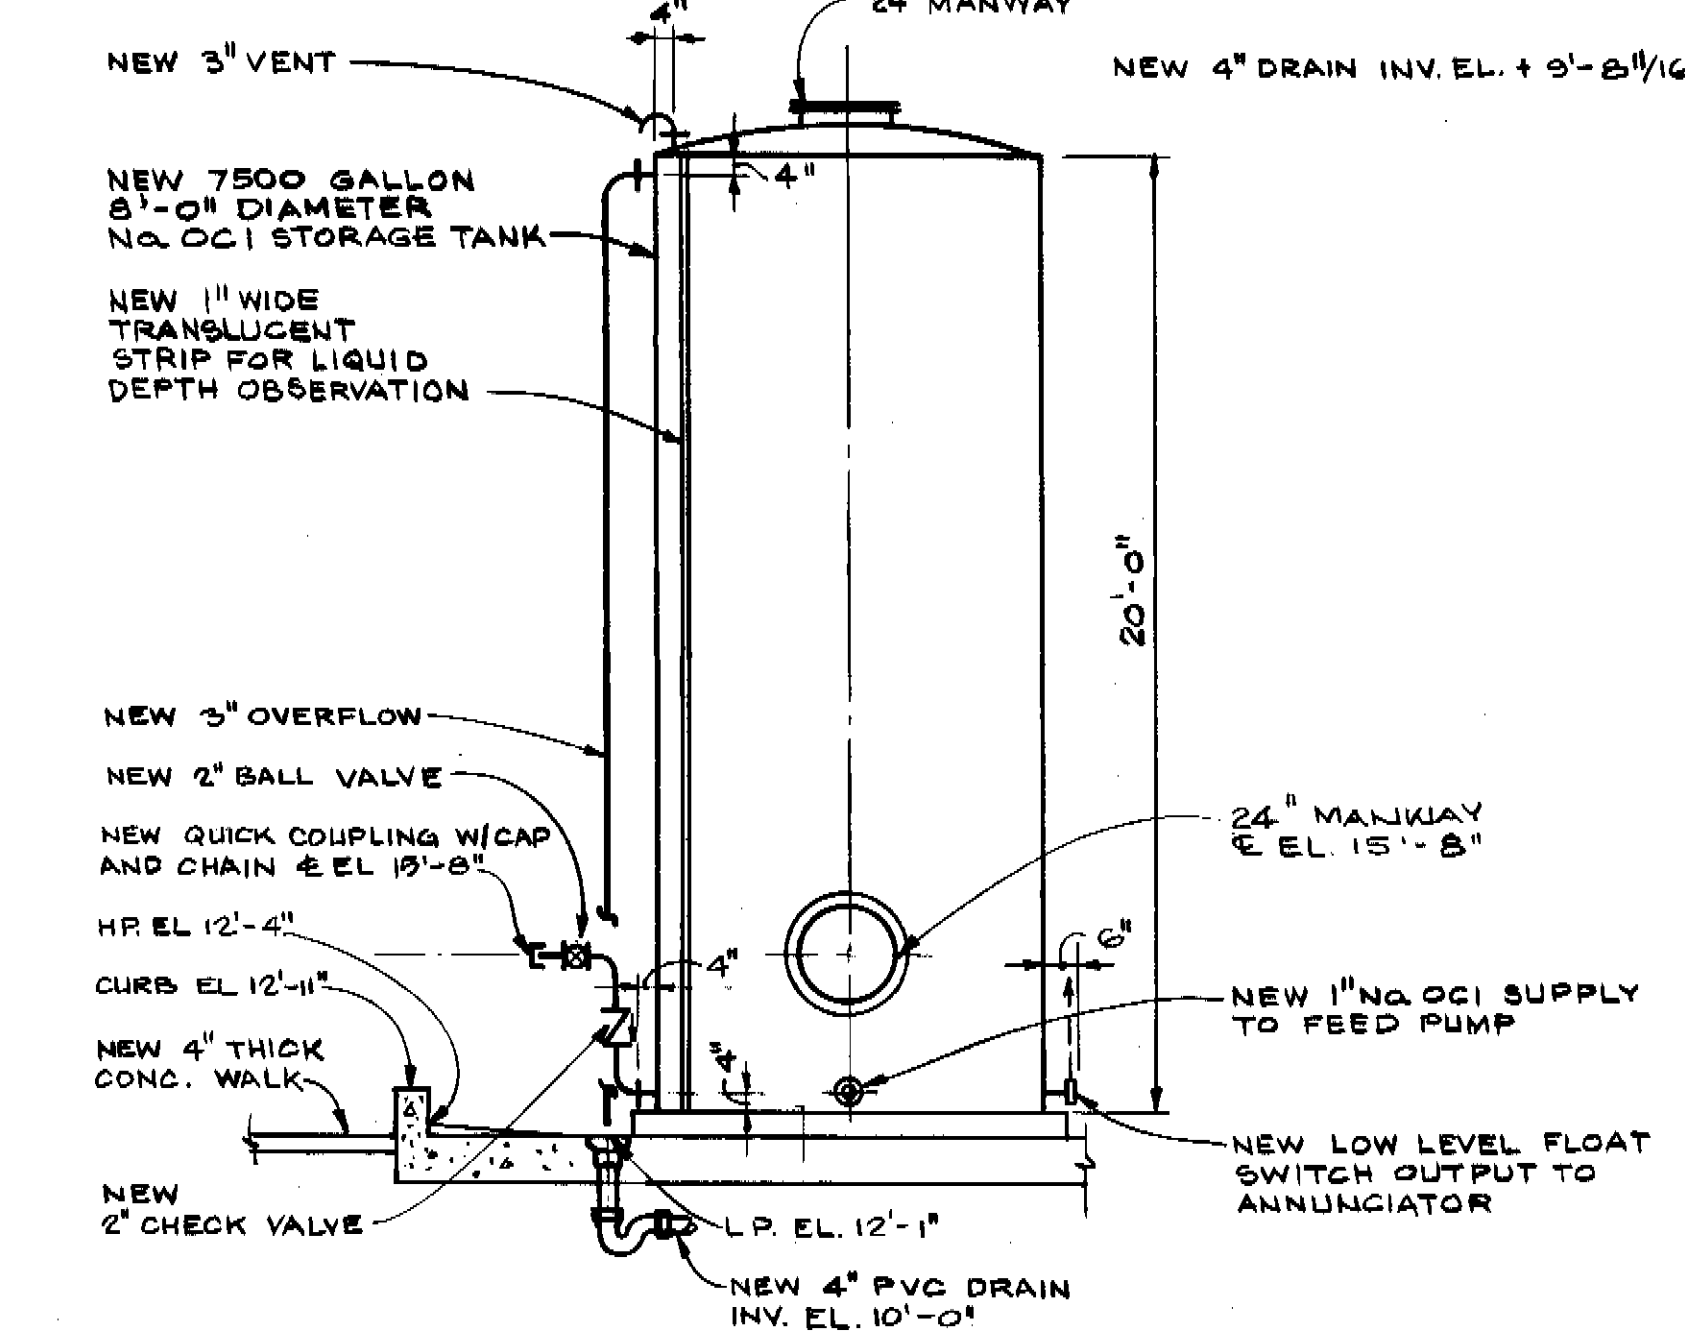

SECTION E/4
 SCALE: 1/4" = 1'-0"

SECTION F/4
 SCALE: 1/4" = 1'-0"

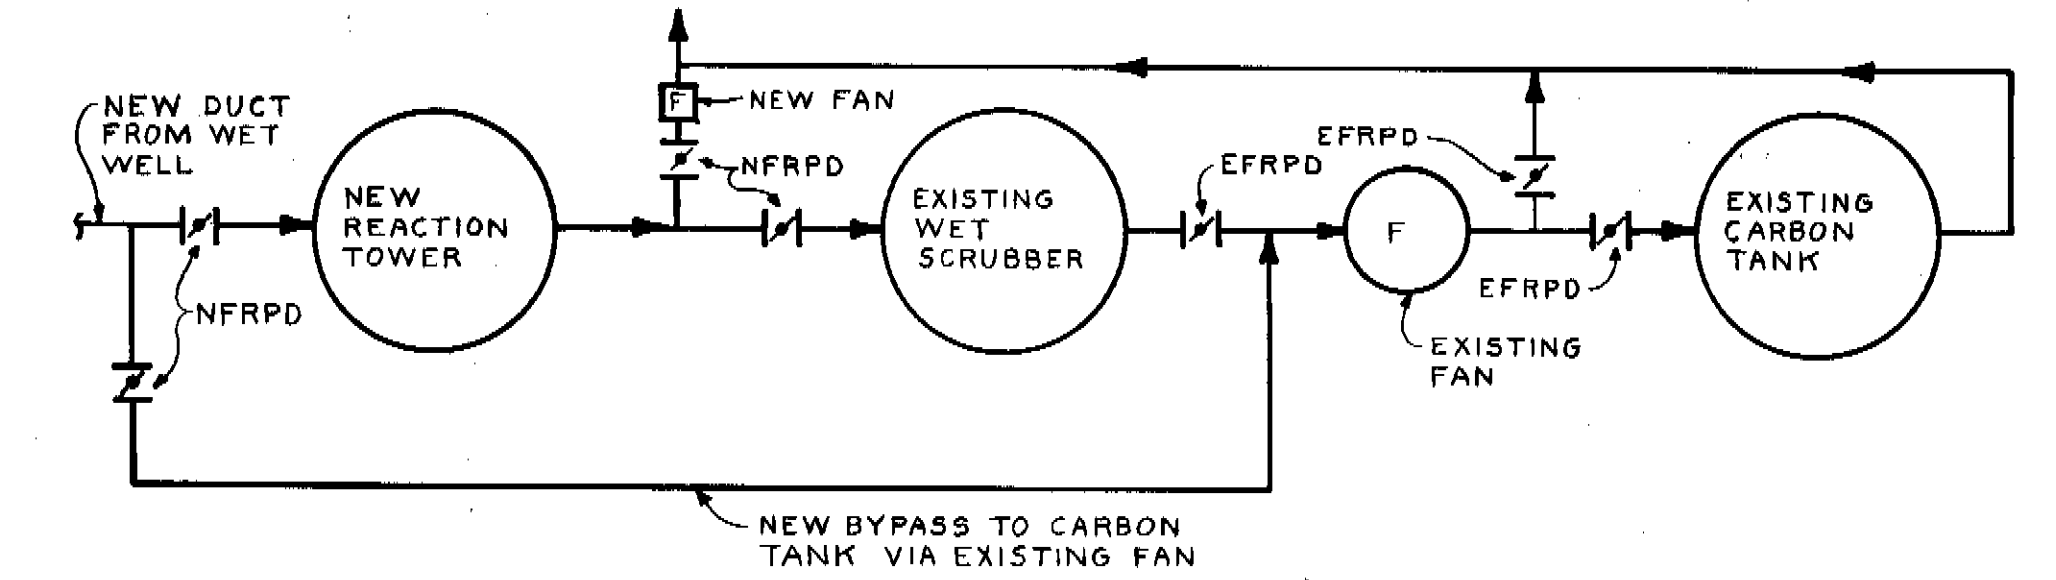

NOTE:
 SEE PLANS AND SECTIONS
 FOR LOCATION OF NEW
 AND EXISTING DUCTWORK

LEGEND
 NFRPD - NEW FRP DAMPER
 EFRPD - EXISTING FRP DAMPER

YBOR PUMPING STATION ODOR CONTROL FLOW DIAGRAM
 NO SCALE


NOTE: THIS SHEET APPLIES ONLY TO SYSTEMS WHICH REQUIRE HIGH PRESSURE AIR COMPRESSOR EQUIPMENT

GREELEY AND HANSEN
 ENGINEERS
 222 S. RIVERSIDE PLAZA
 CHICAGO, ILLINOIS 60606

DESIGNED: MPV JRP
 DRAWN: SK
 CHECKED: JRP

APPROVED

NO.	DATE	APP.	REVISION

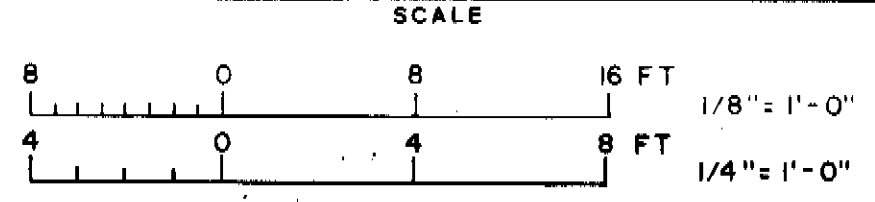


CITY OF TAMPA, FLORIDA
 SEWAGE DISPOSAL SYSTEM
 DIVISION 4LS
 PUMPING STATIONS
 ODOR CONTROL MODIFICATIONS

YBOR PUMPING STATION
 SECTIONS


PROJ. NO.
 SHEET **6** OF 10
 DATE JULY 1985 REV 0

173-37 f

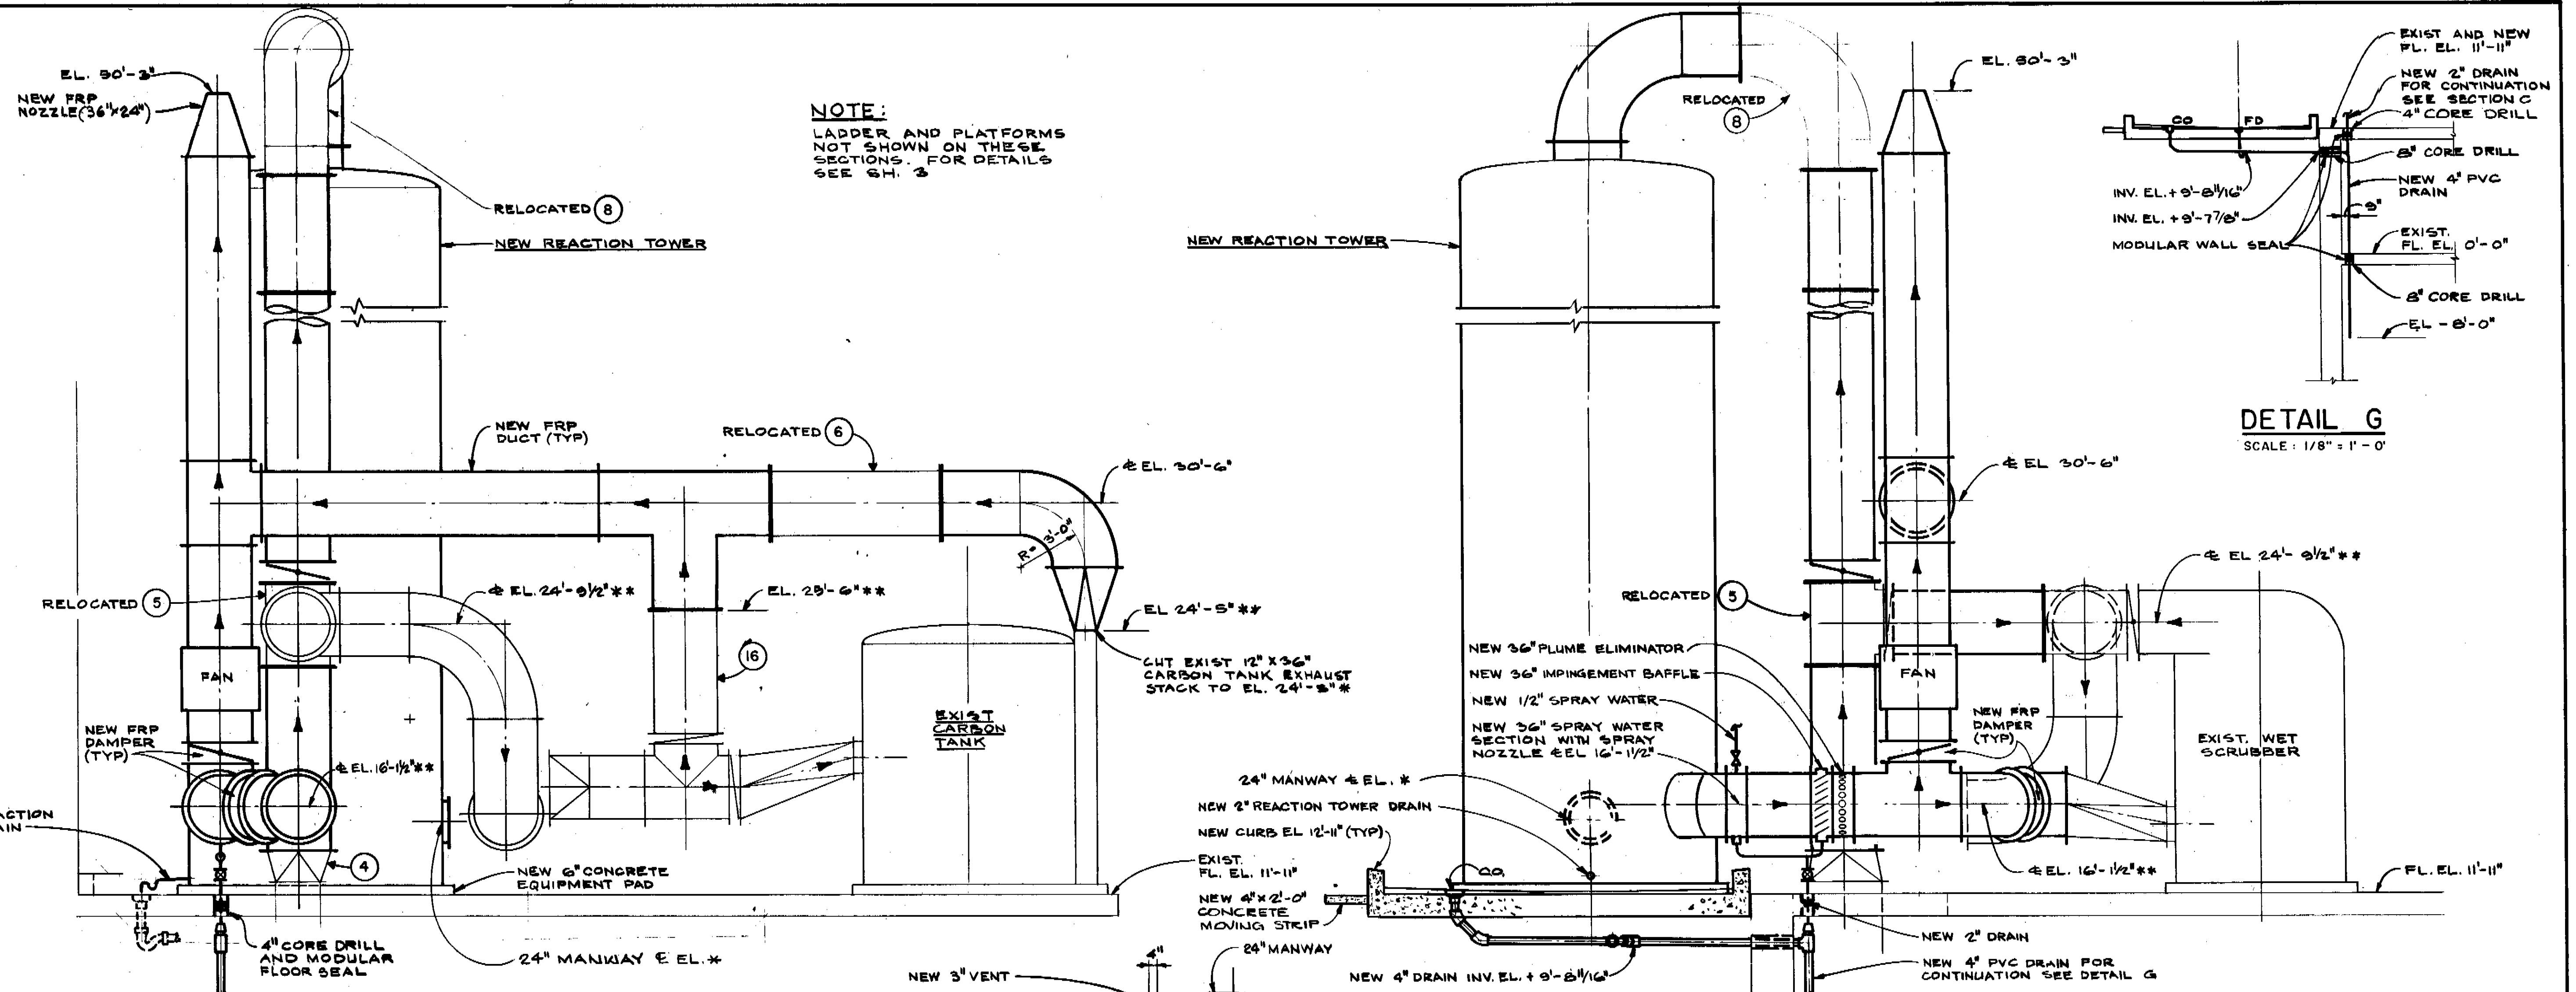


SECTION B/5
SCALE: 1/4" = 1'-0"


SECTION C/5
SCALE: 1/4" = 1'-0"

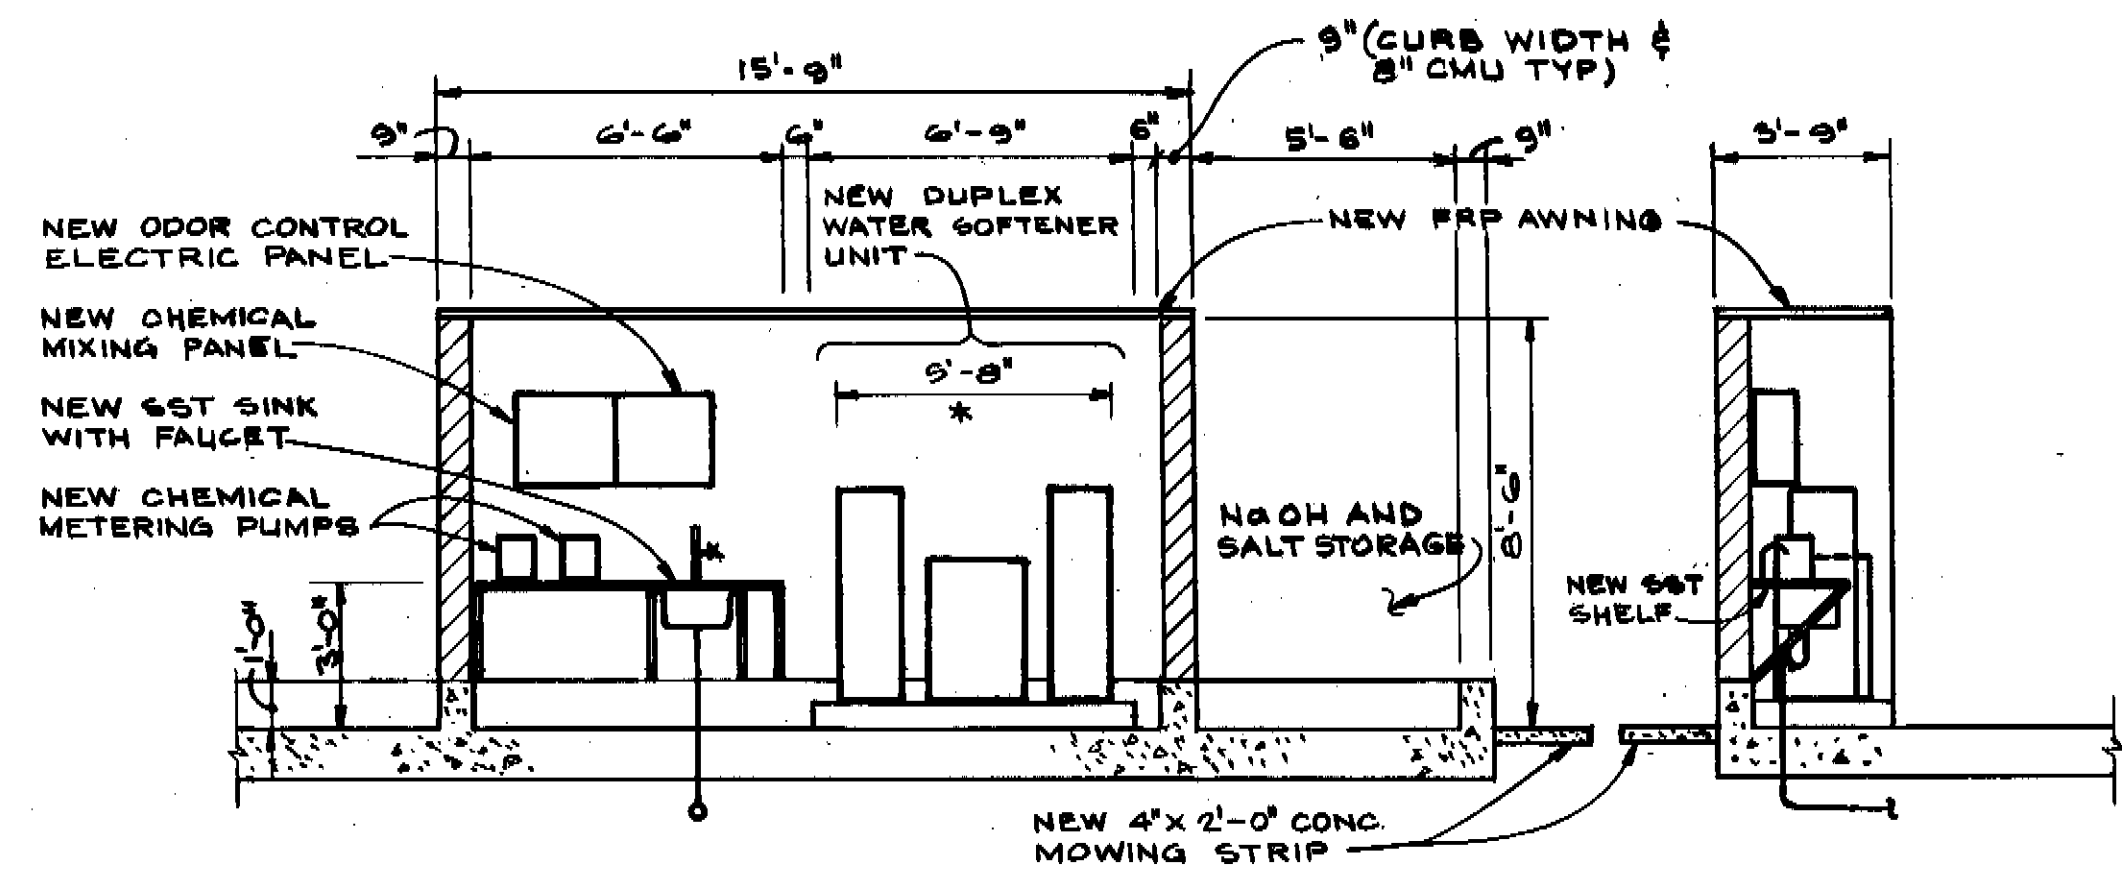

SECTION D/5
SCALE: 1/4" = 1'-0"

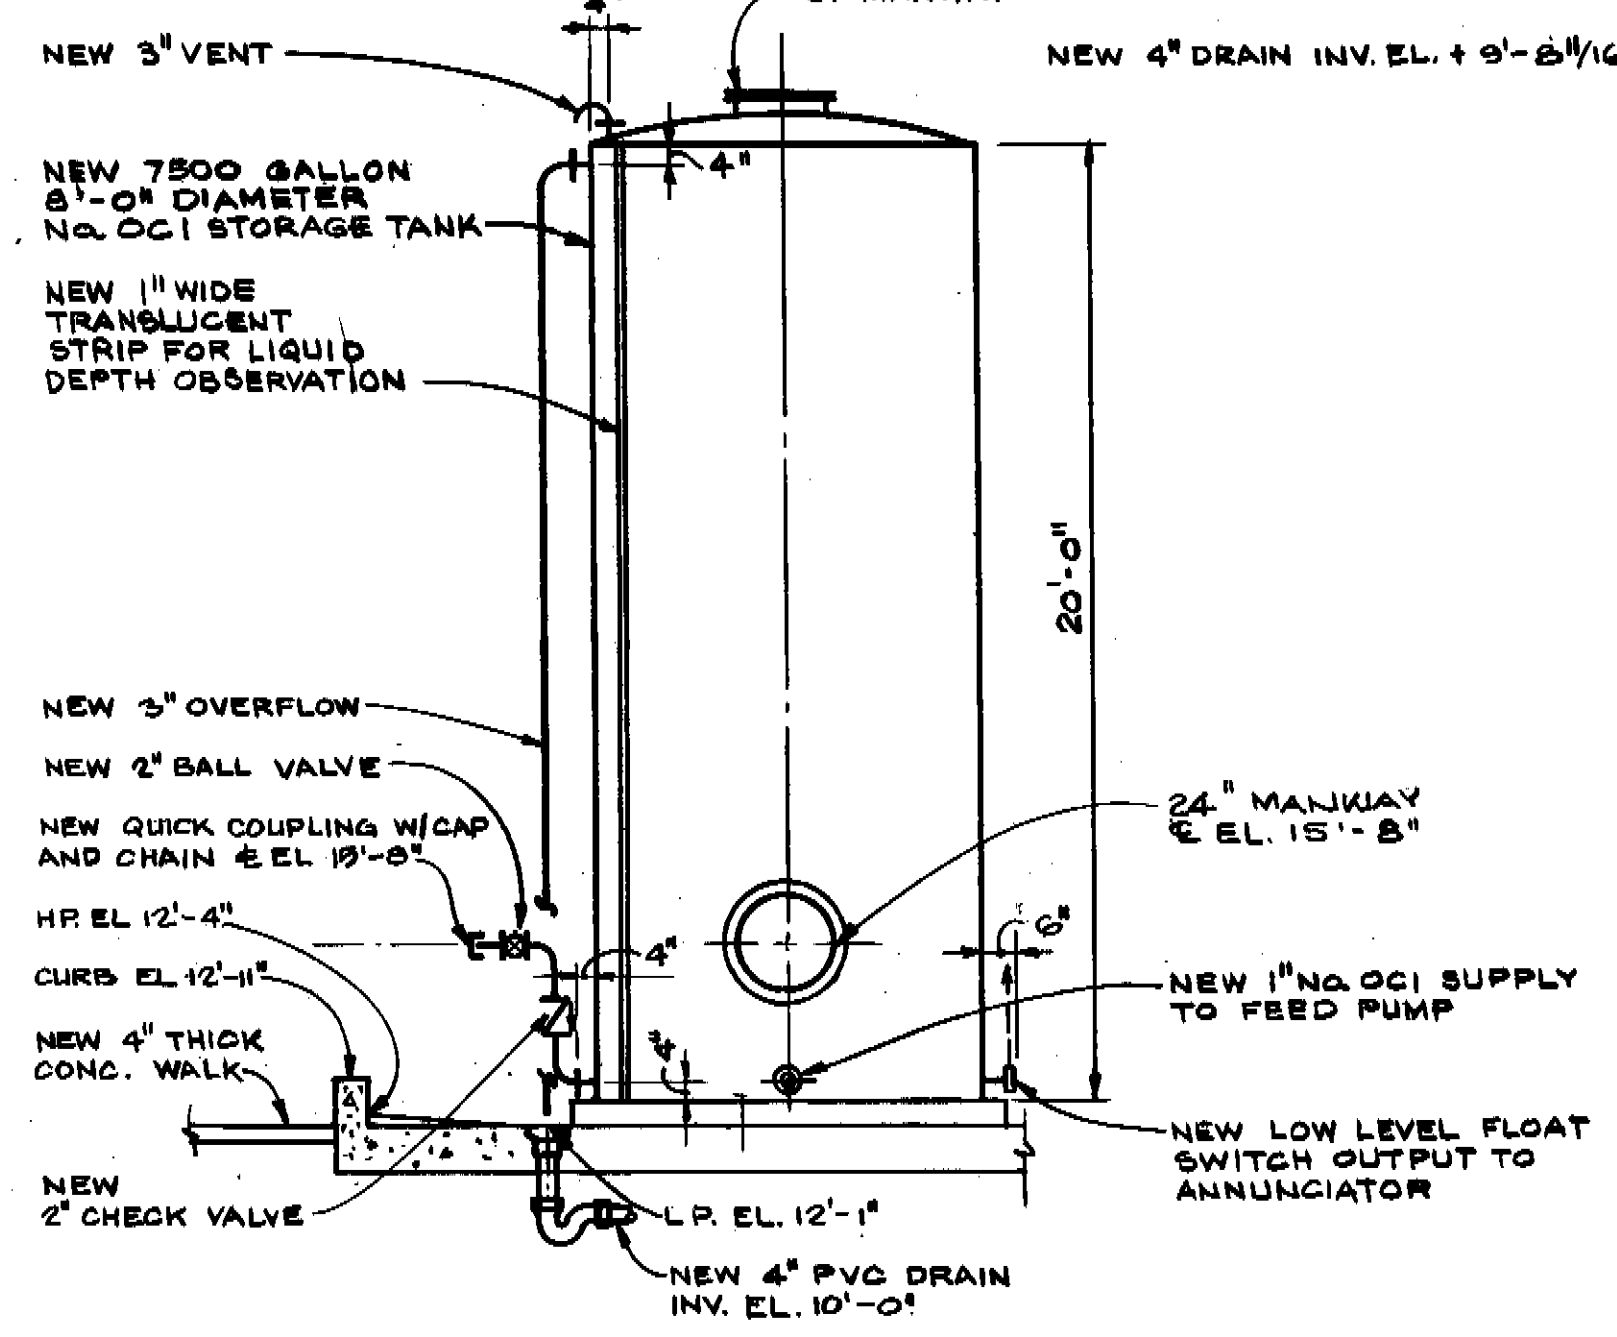

SECTION F/5
SCALE: 1/4" = 1'-0"

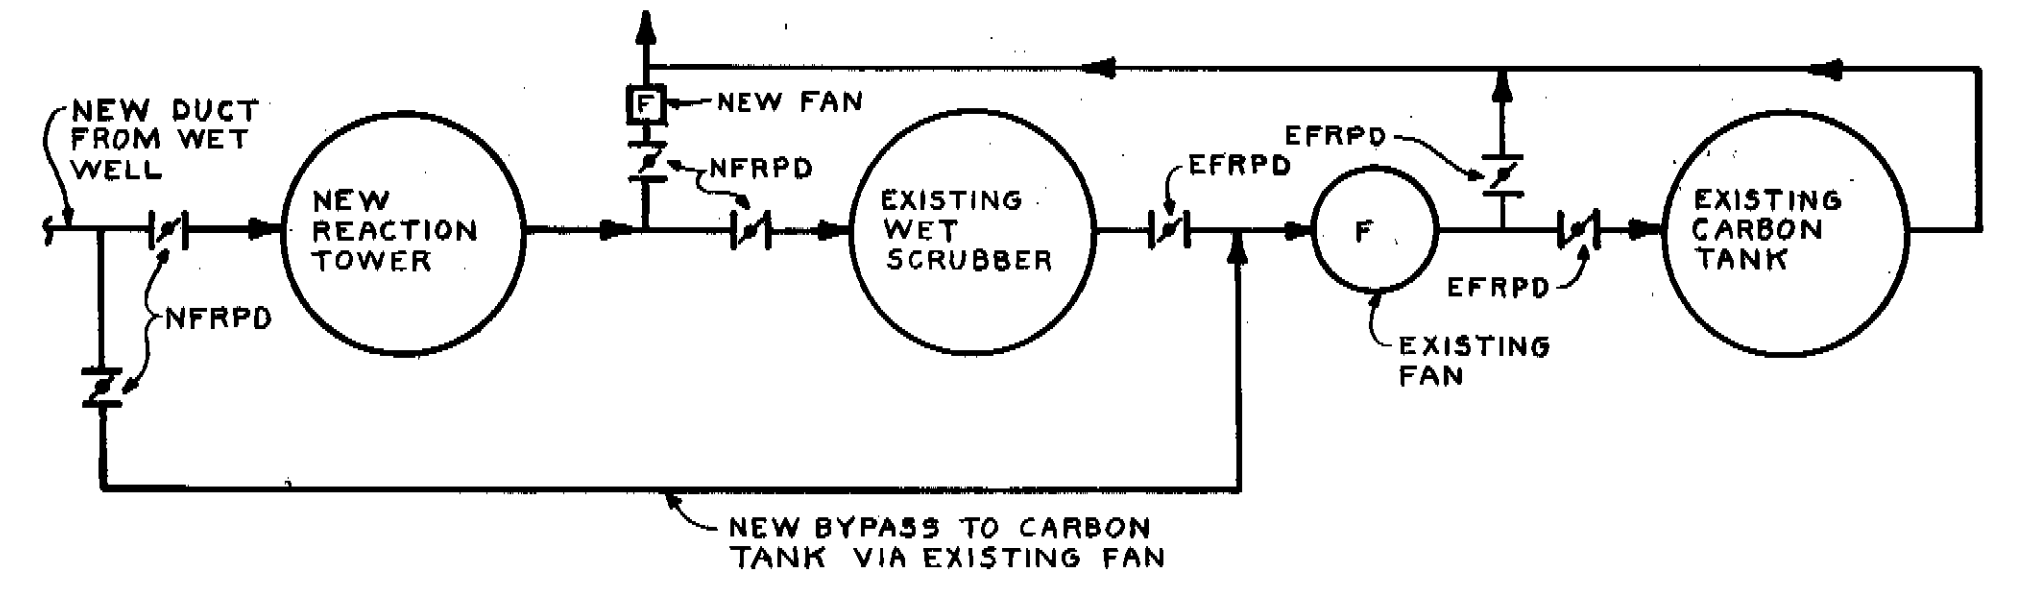

NOTE:
SEE PLANS AND SECTIONS FOR LOCATION OF NEW AND EXISTING DUCTWORK

LEGEND
NFRPD - NEW FRP DAMPER
EFRPD - EXISTING FRP DAMPER

YBOR PUMPING STATION ODOR CONTROL FLOW DIAGRAM
NO SCALE


NOTE: THIS SHEET APPLIES ONLY TO SYSTEMS WHICH REQUIRE LOW PRESSURE AIR COMPRESSOR EQUIPMENT

GREELEY AND HANSEN
ENGINEERS
222 S. RIVERSIDE PLAZA
CHICAGO, ILLINOIS 60606

DESIGNED: MPV JRP
DRAWN: SK
CHECKED: JRP

APPROVED

NO.	DATE	APP.	REVISION













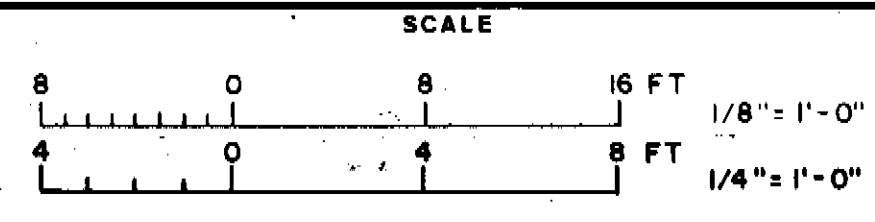


CITY OF TAMPA, FLORIDA
SEWAGE DISPOSAL SYSTEM
DIVISION 4L5
PUMPING STATIONS
ODOR CONTROL MODIFICATIONS

YBOR PUMPING STATION
SECTIONS








PROJ. NO.	
SHEET	7 OF 10
DATE	JULY 1985
REV	0

173-379

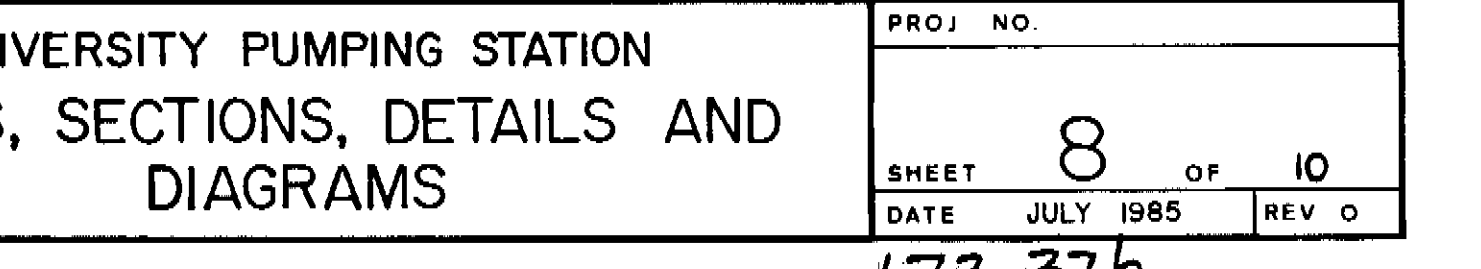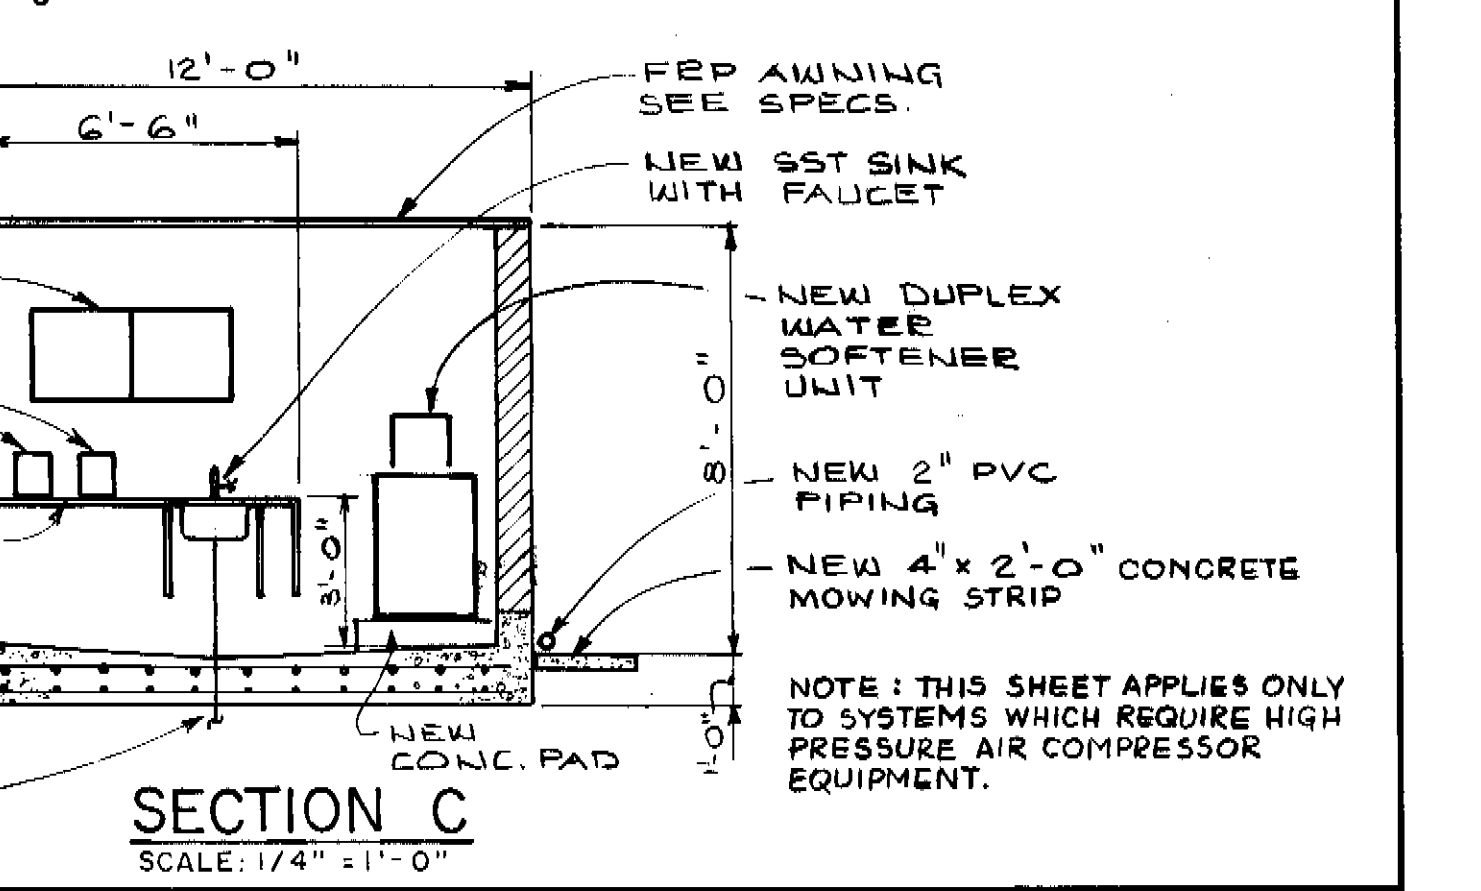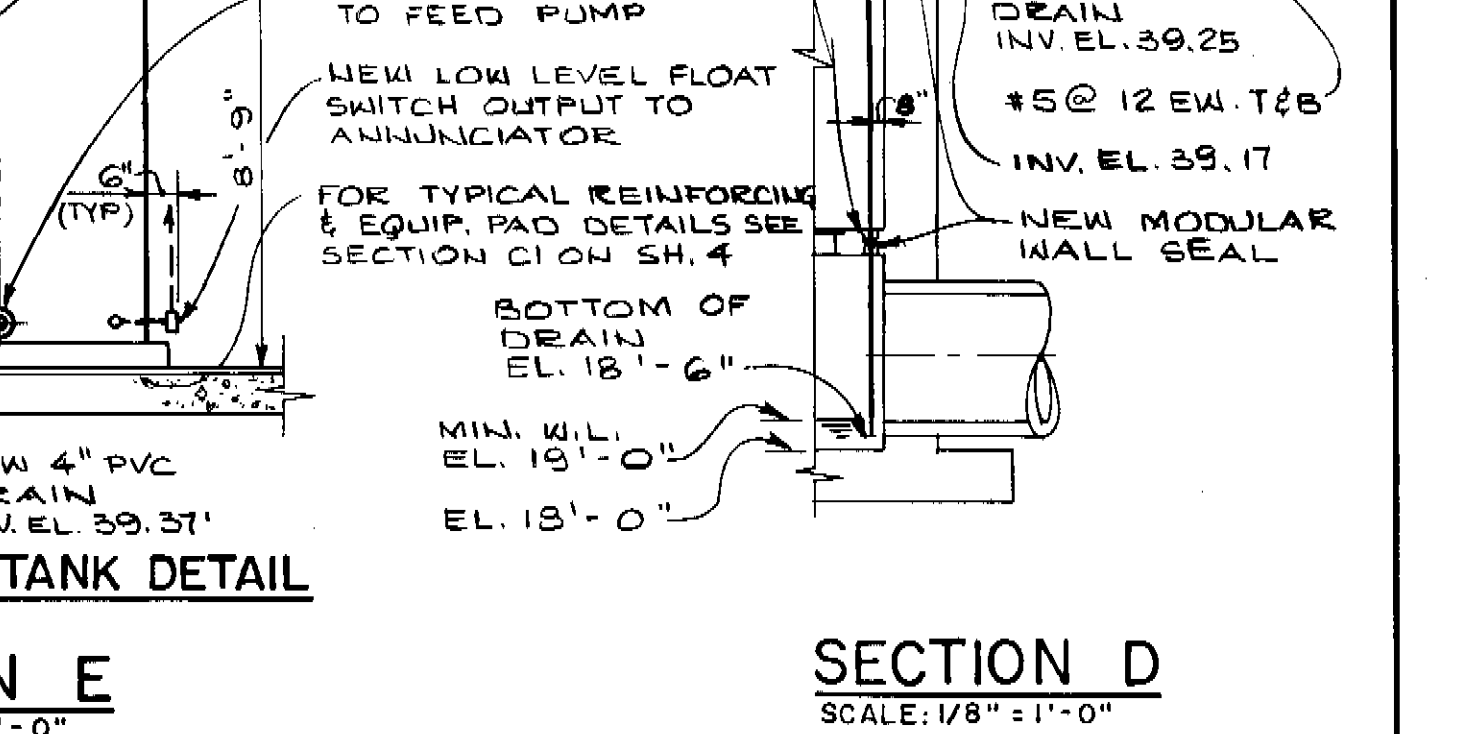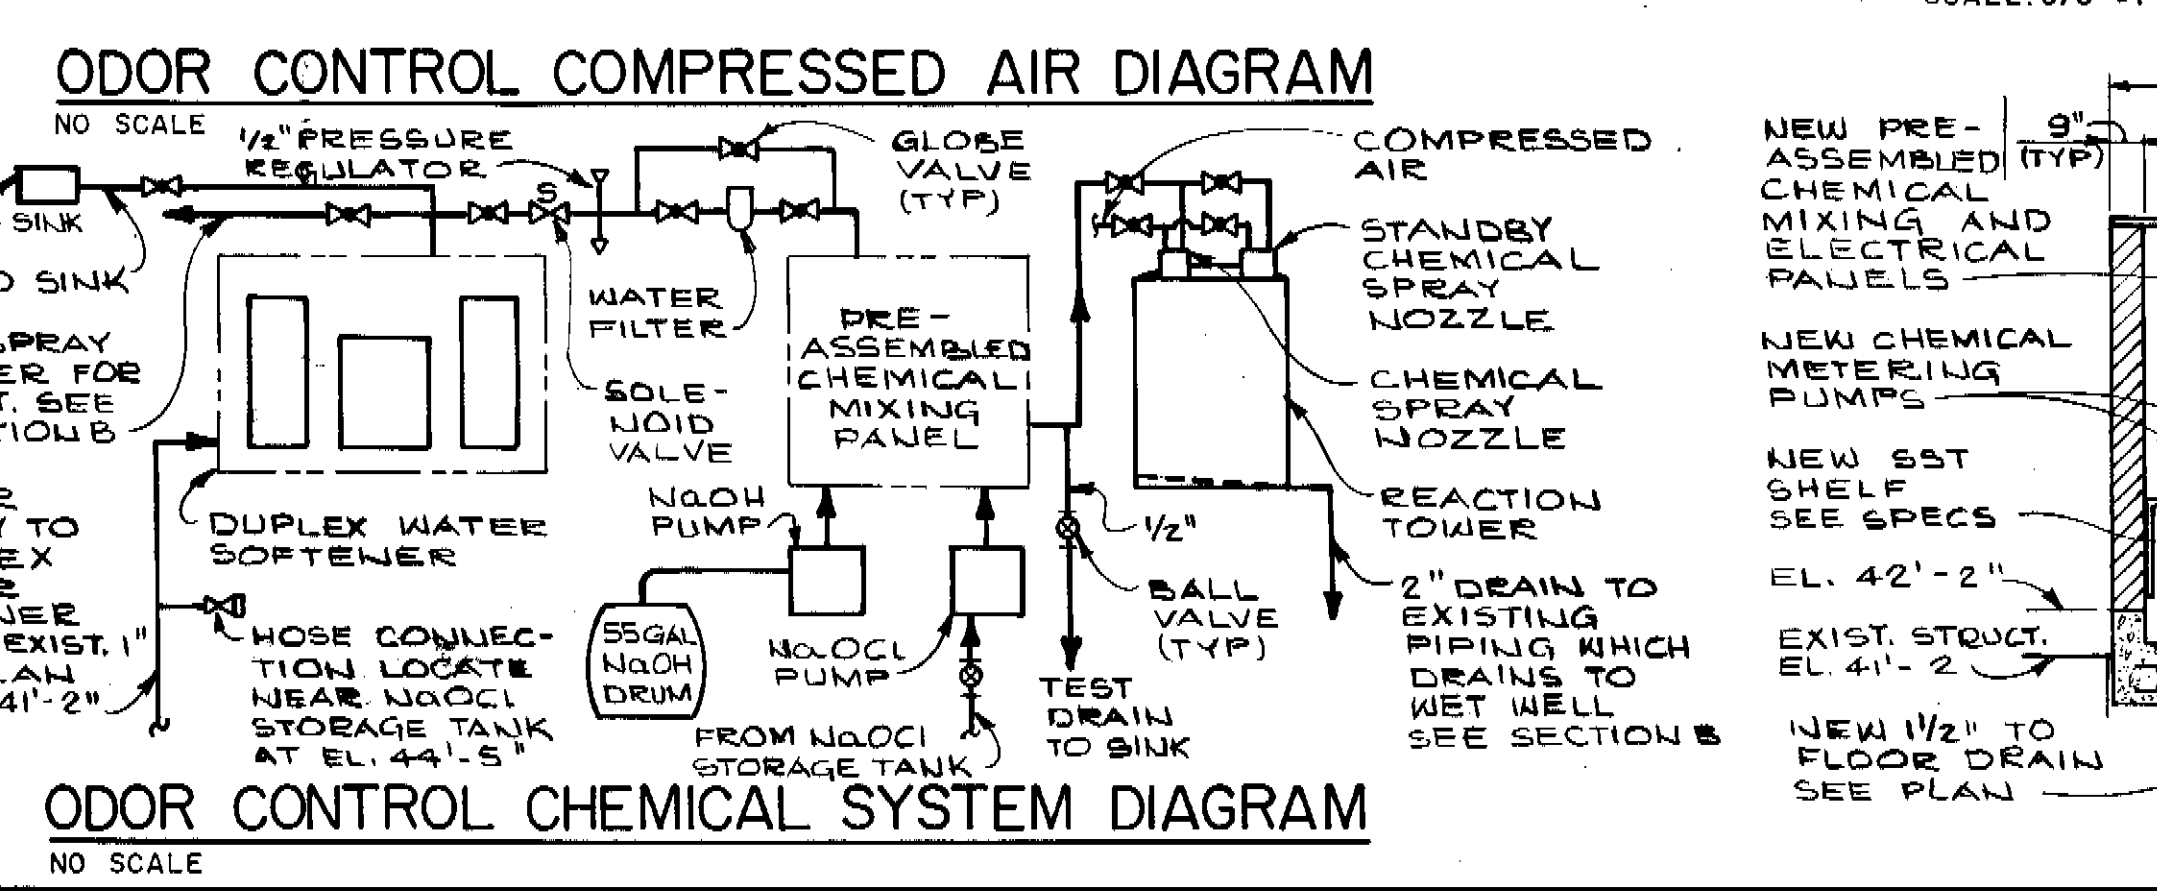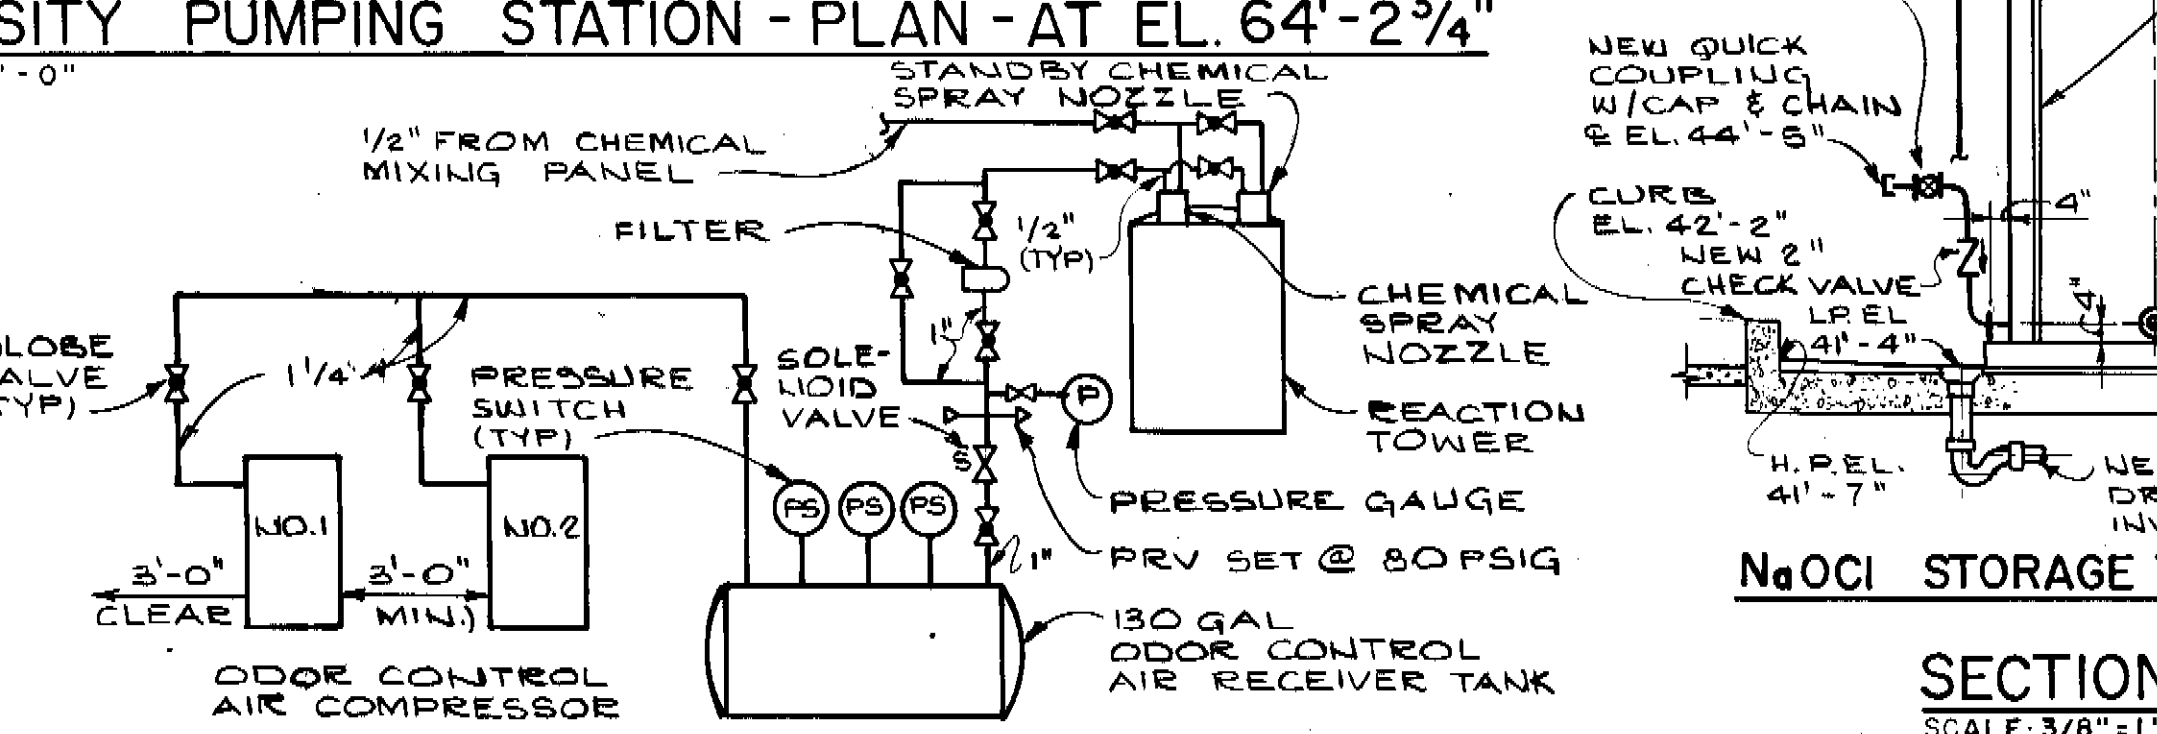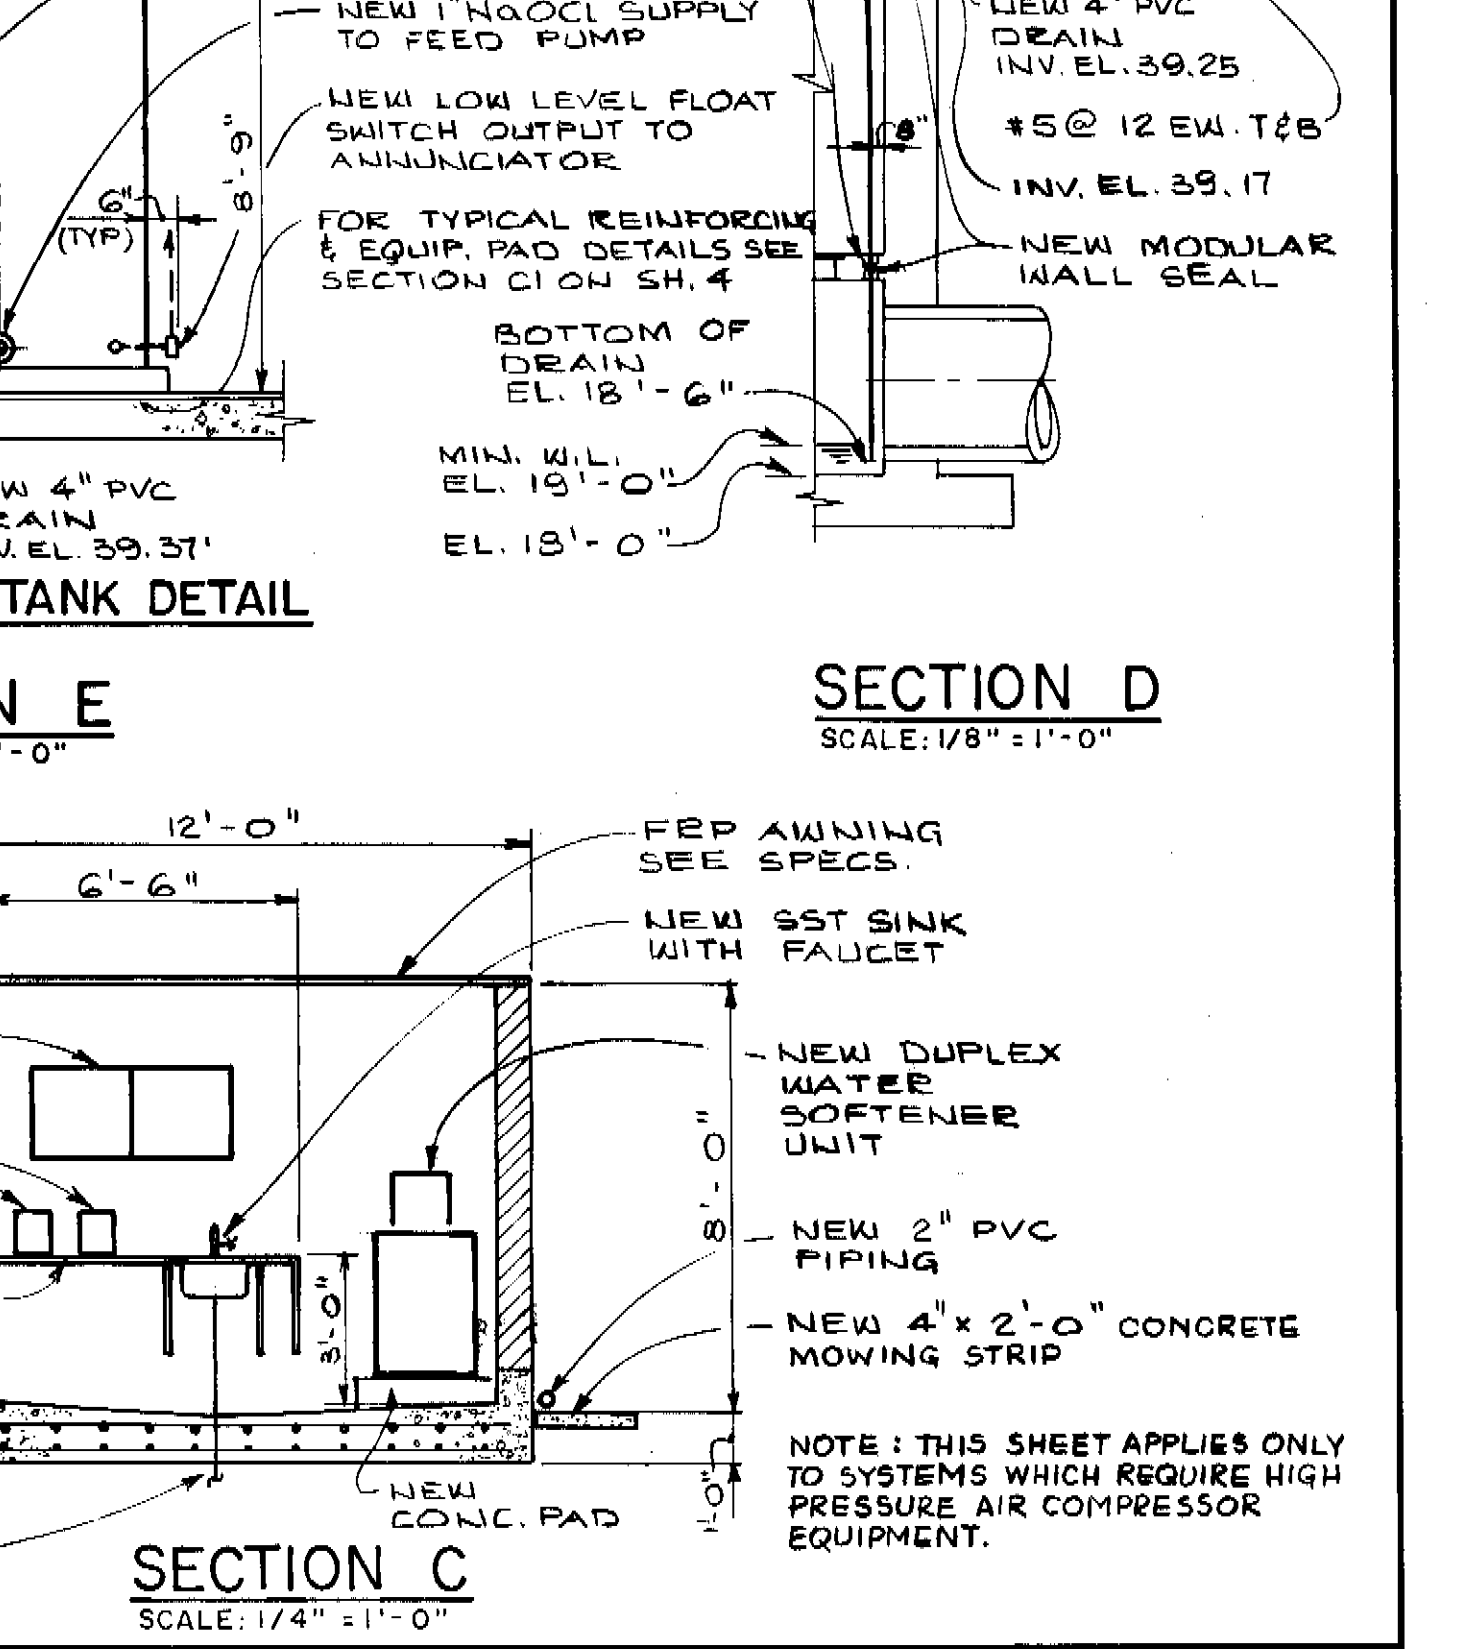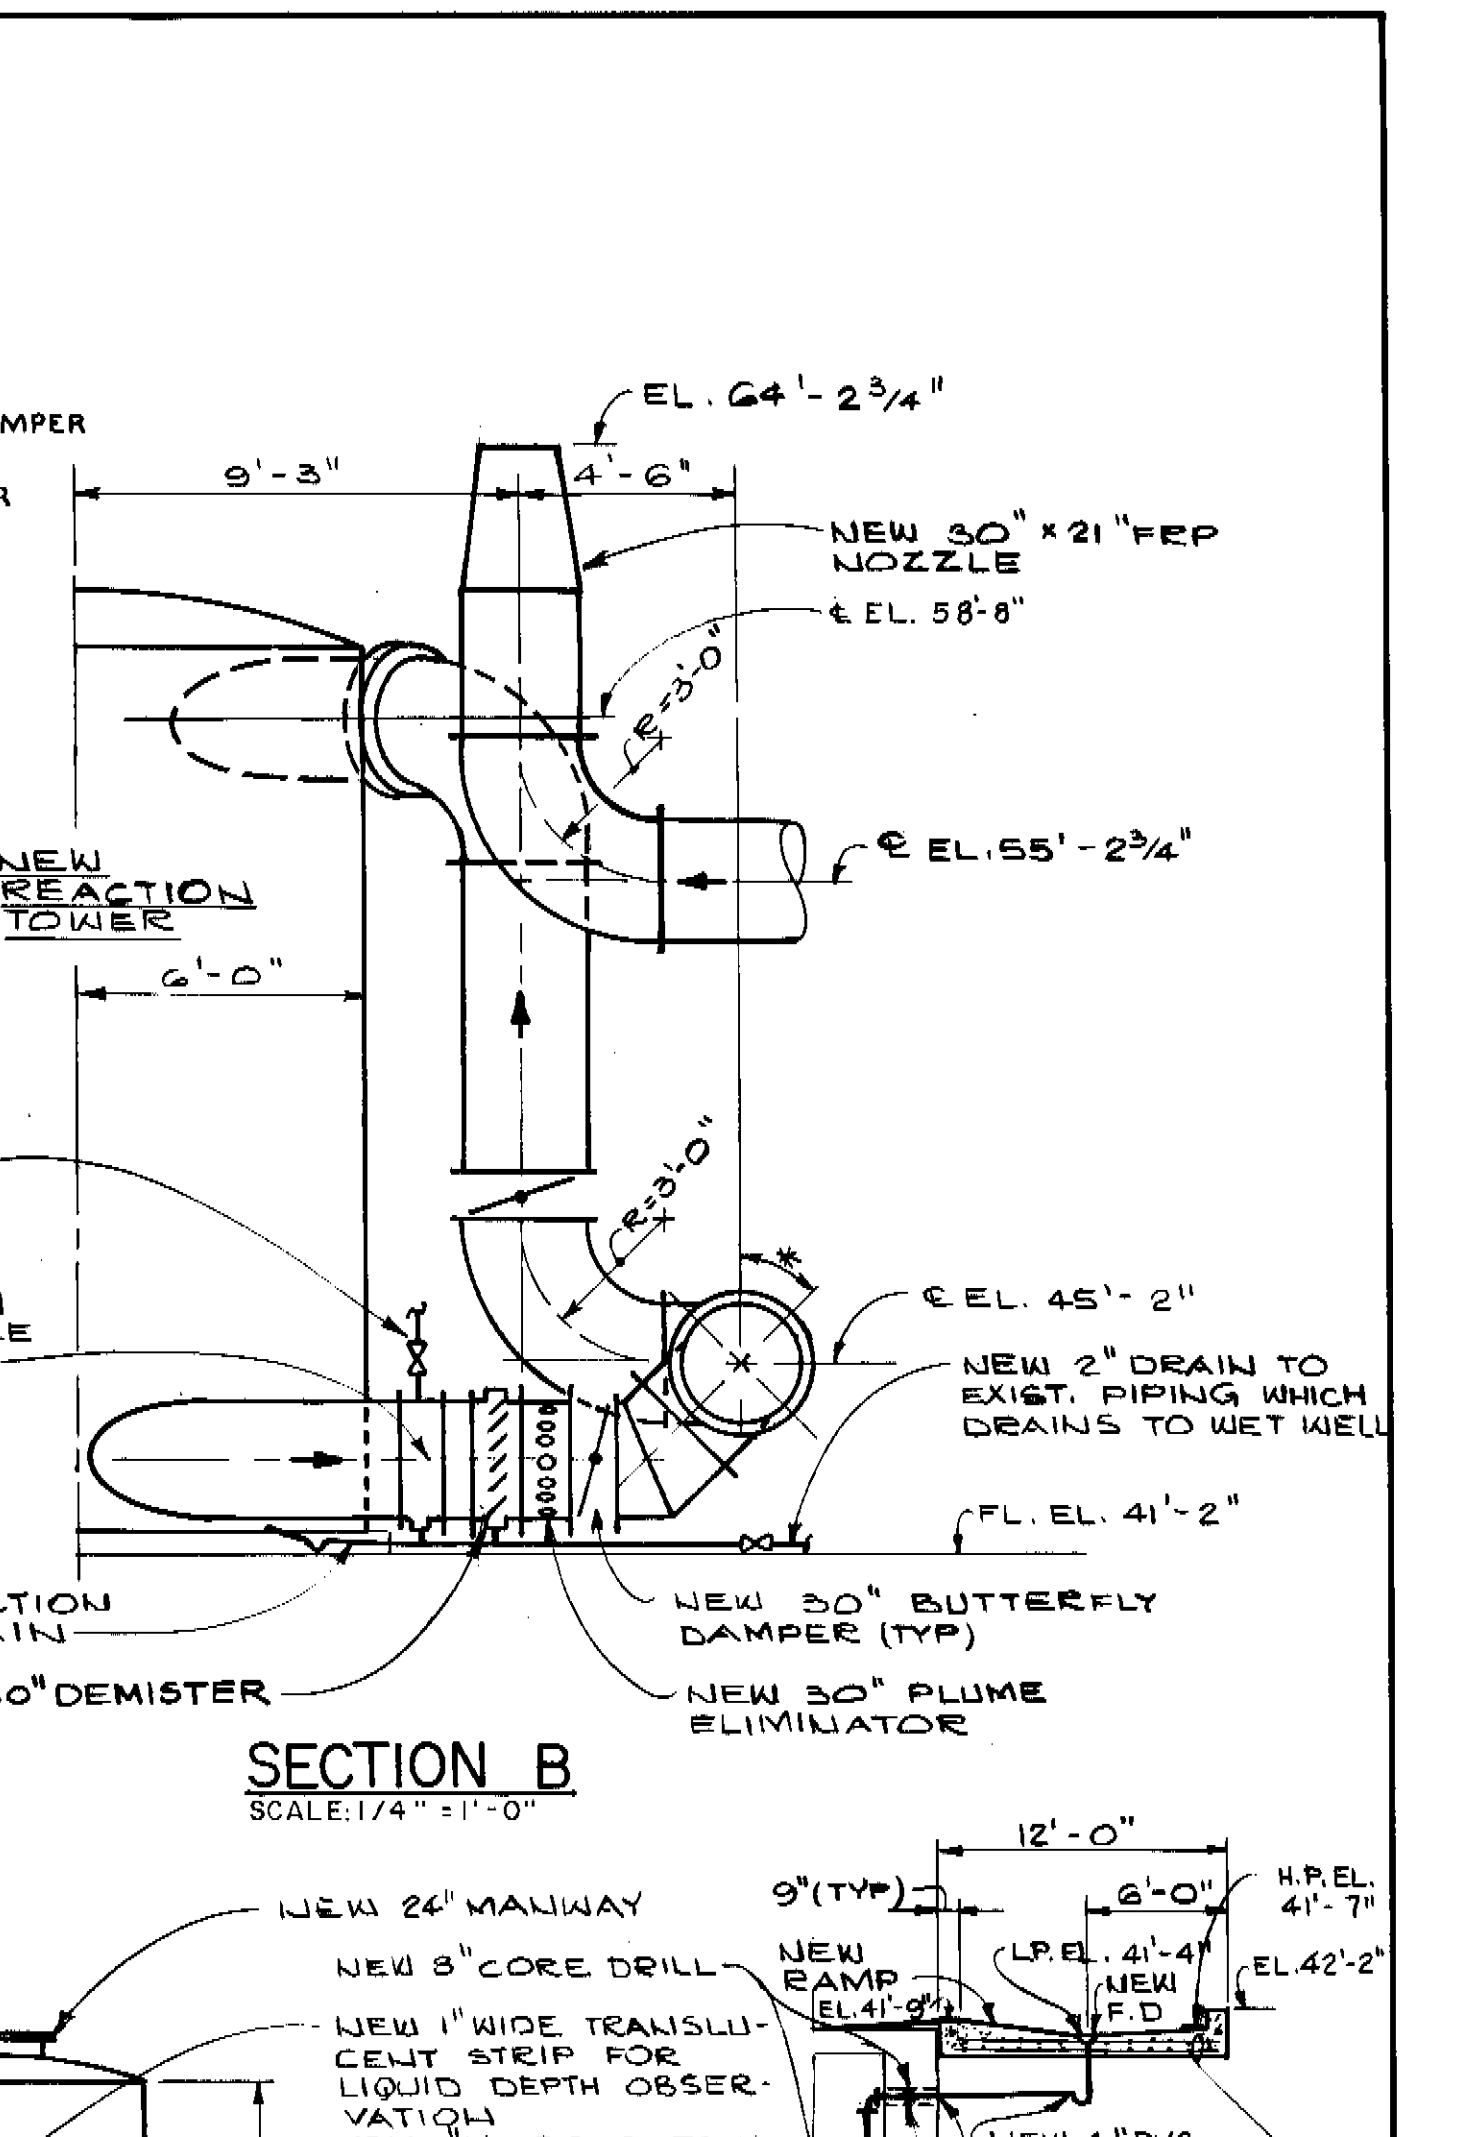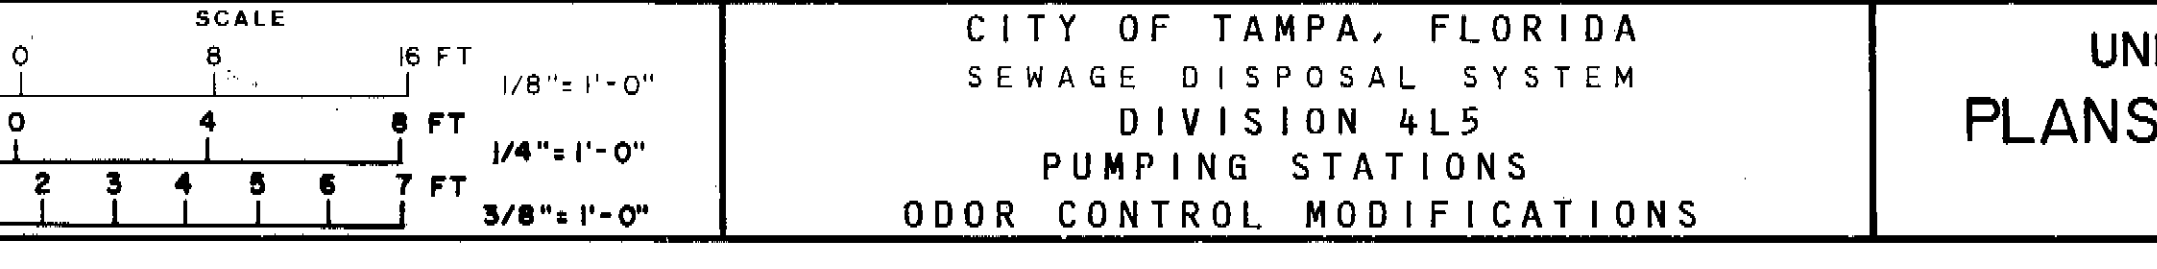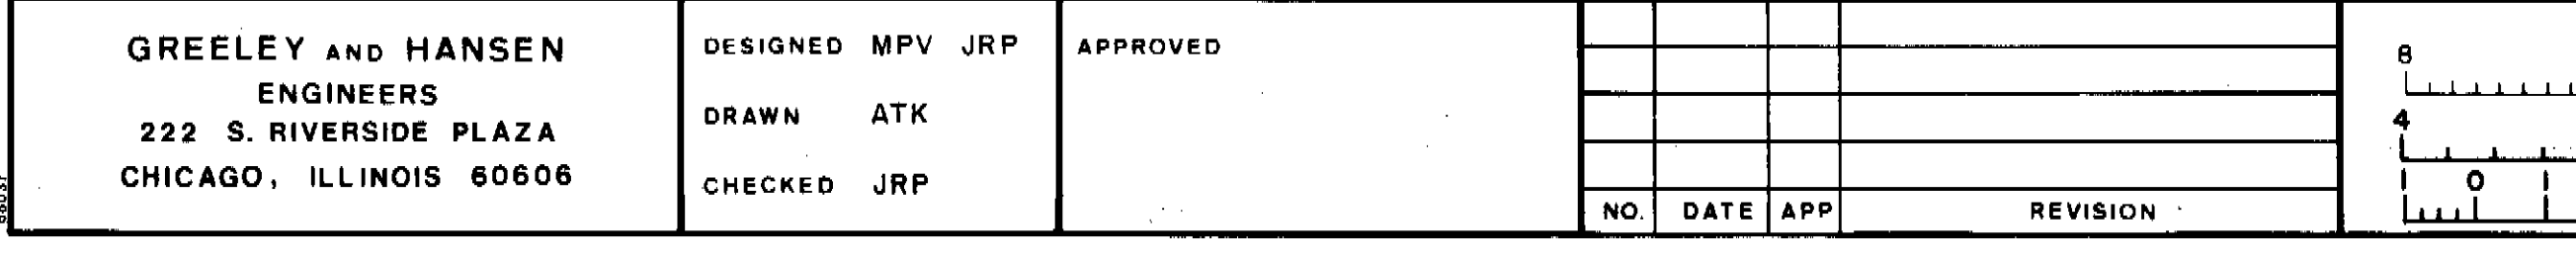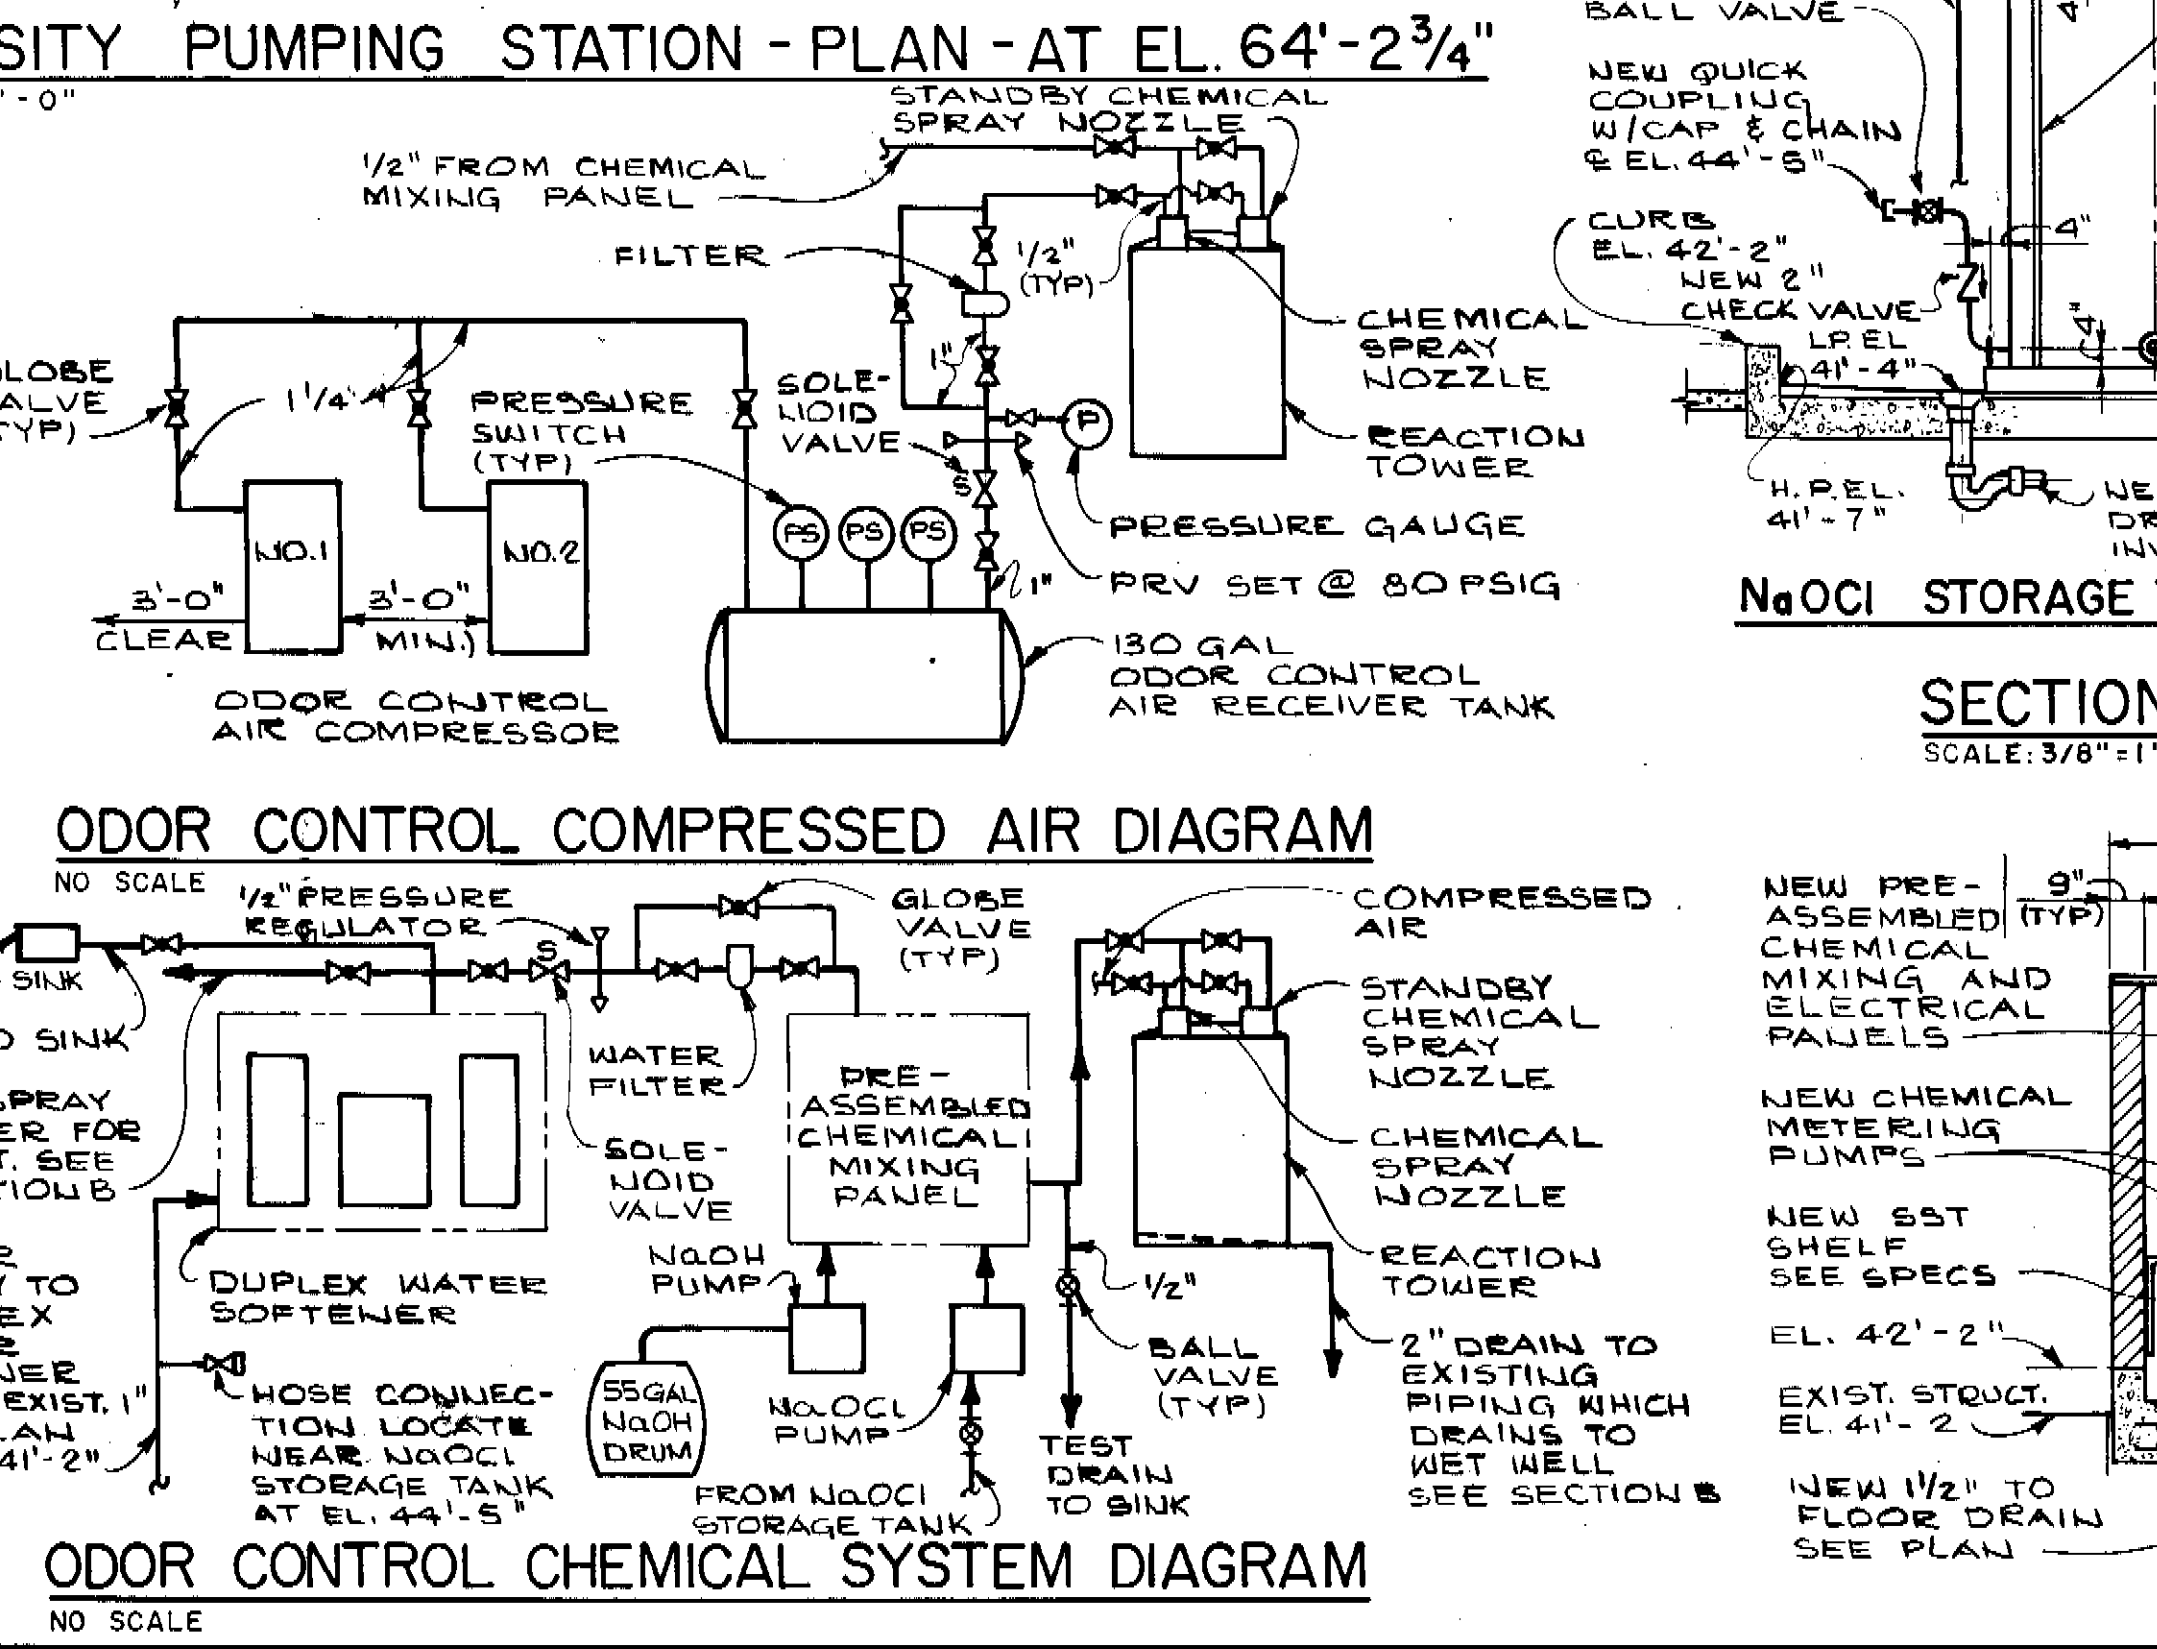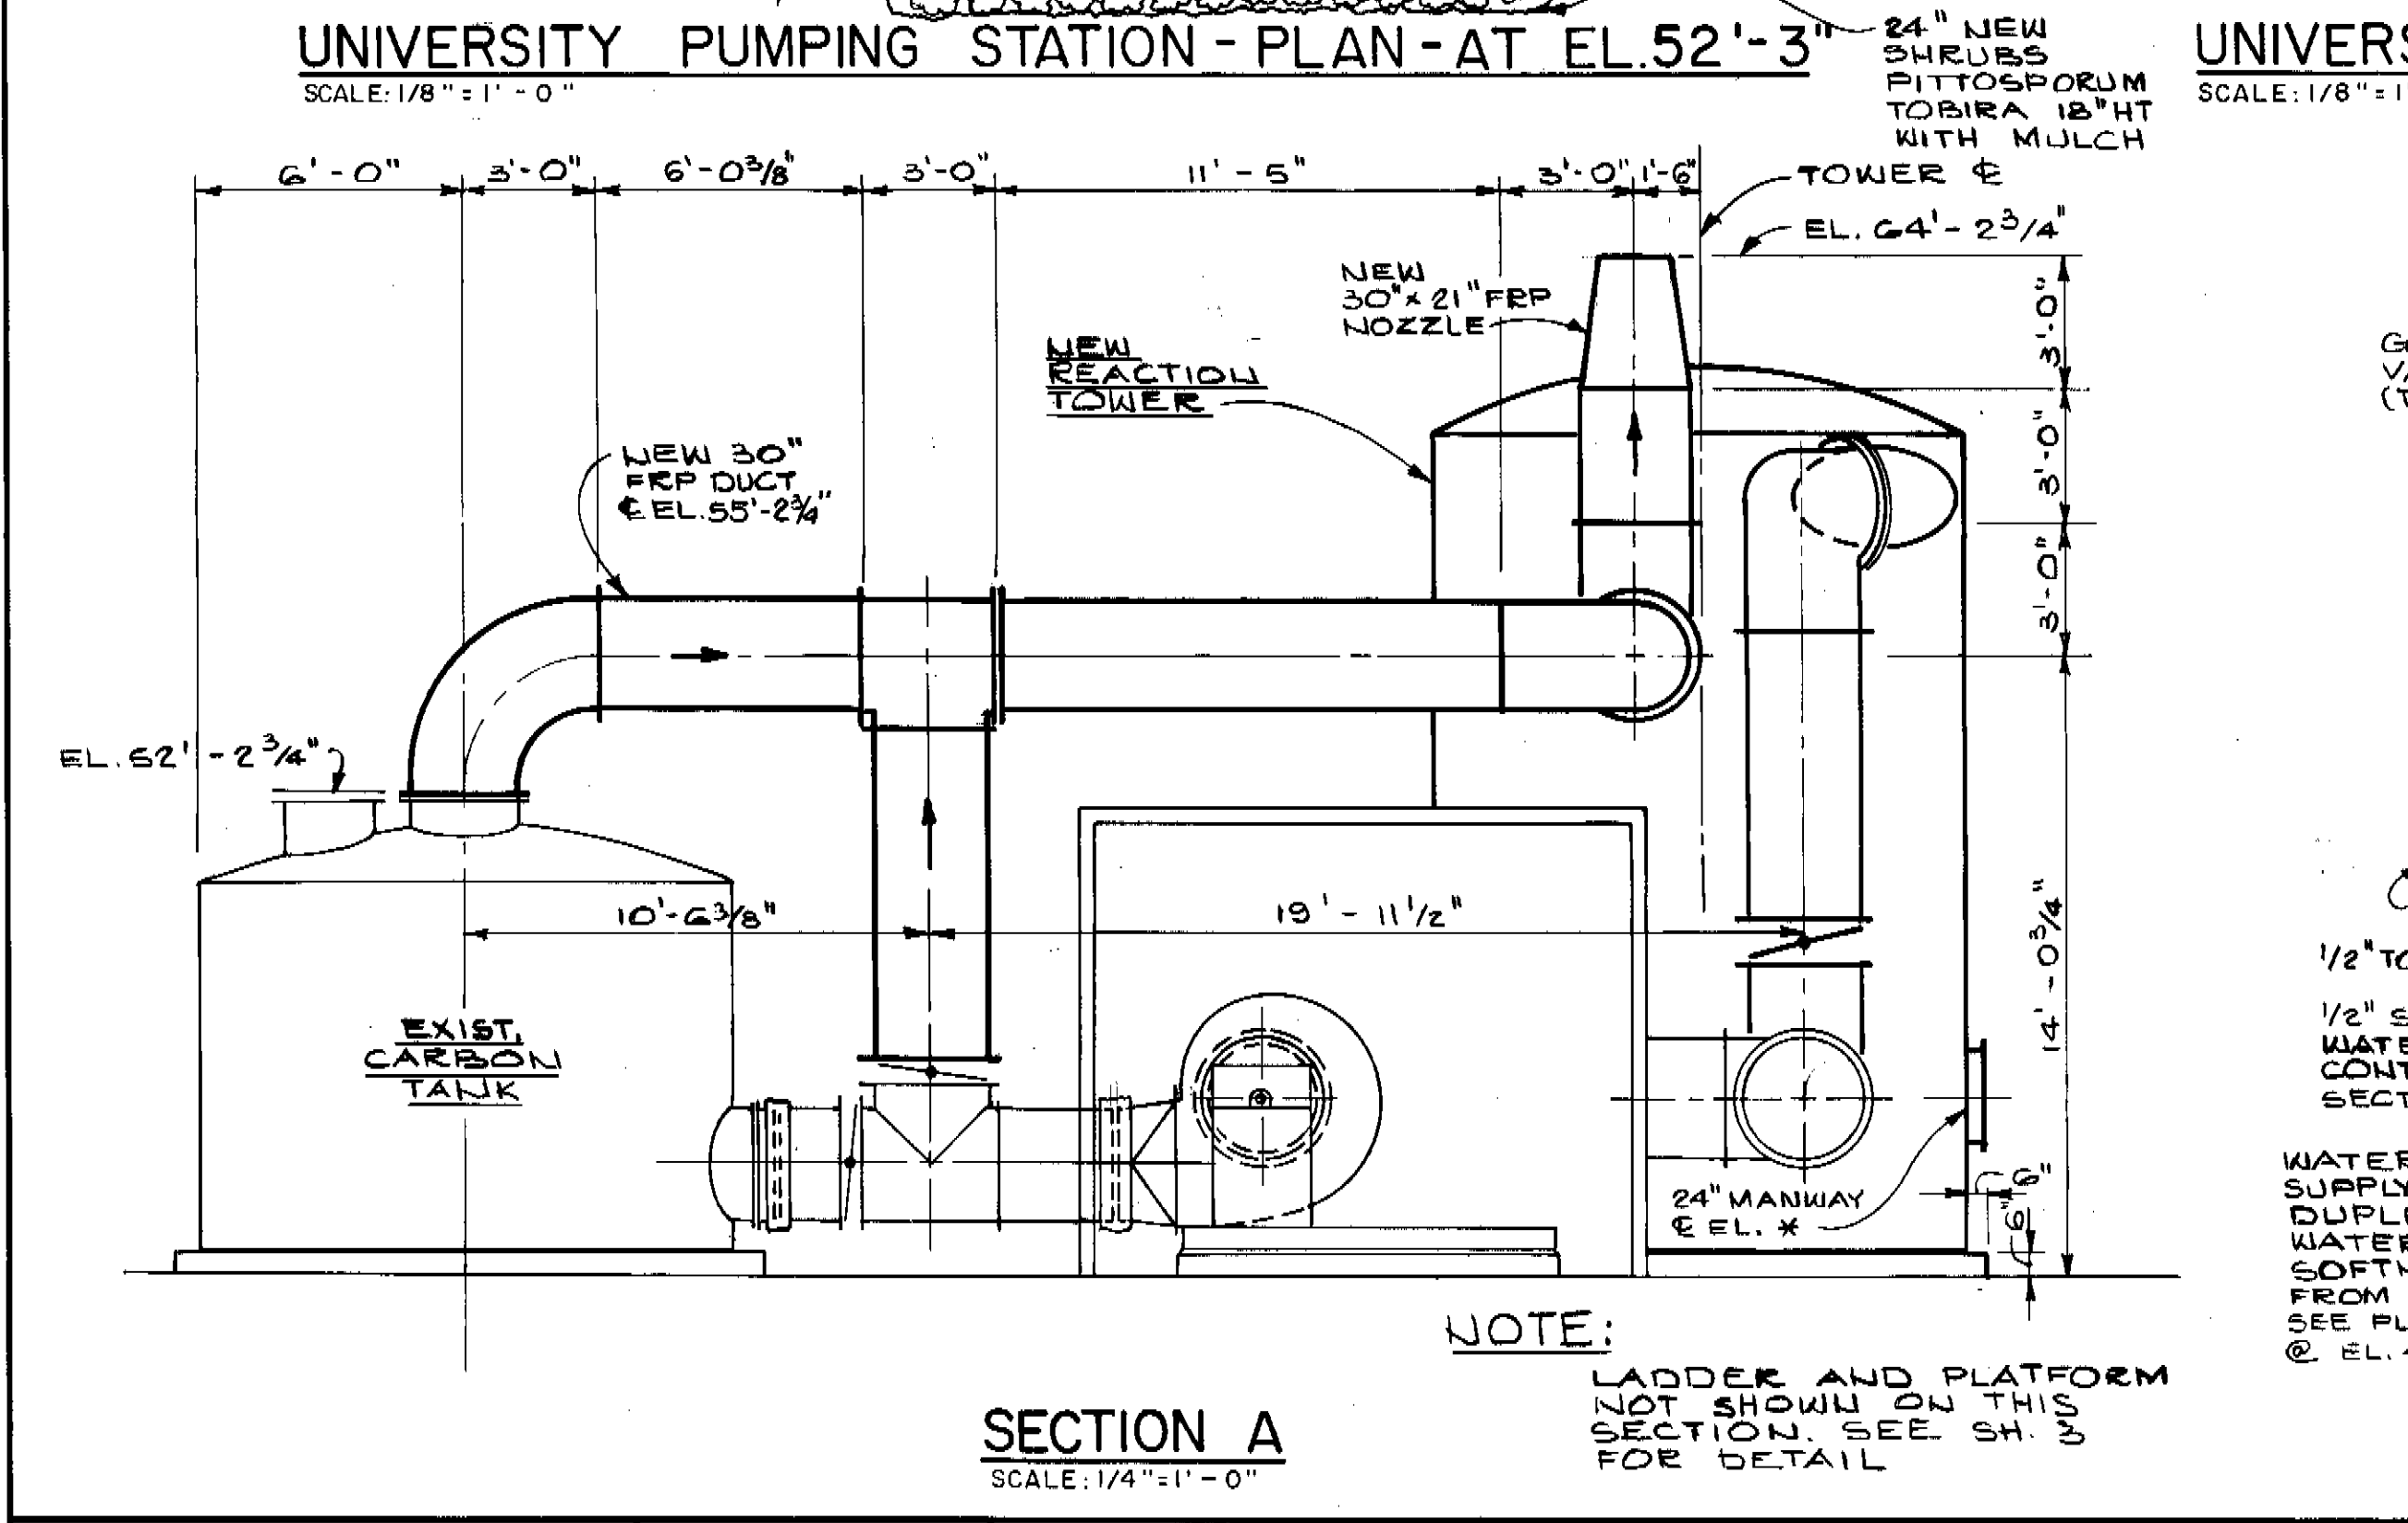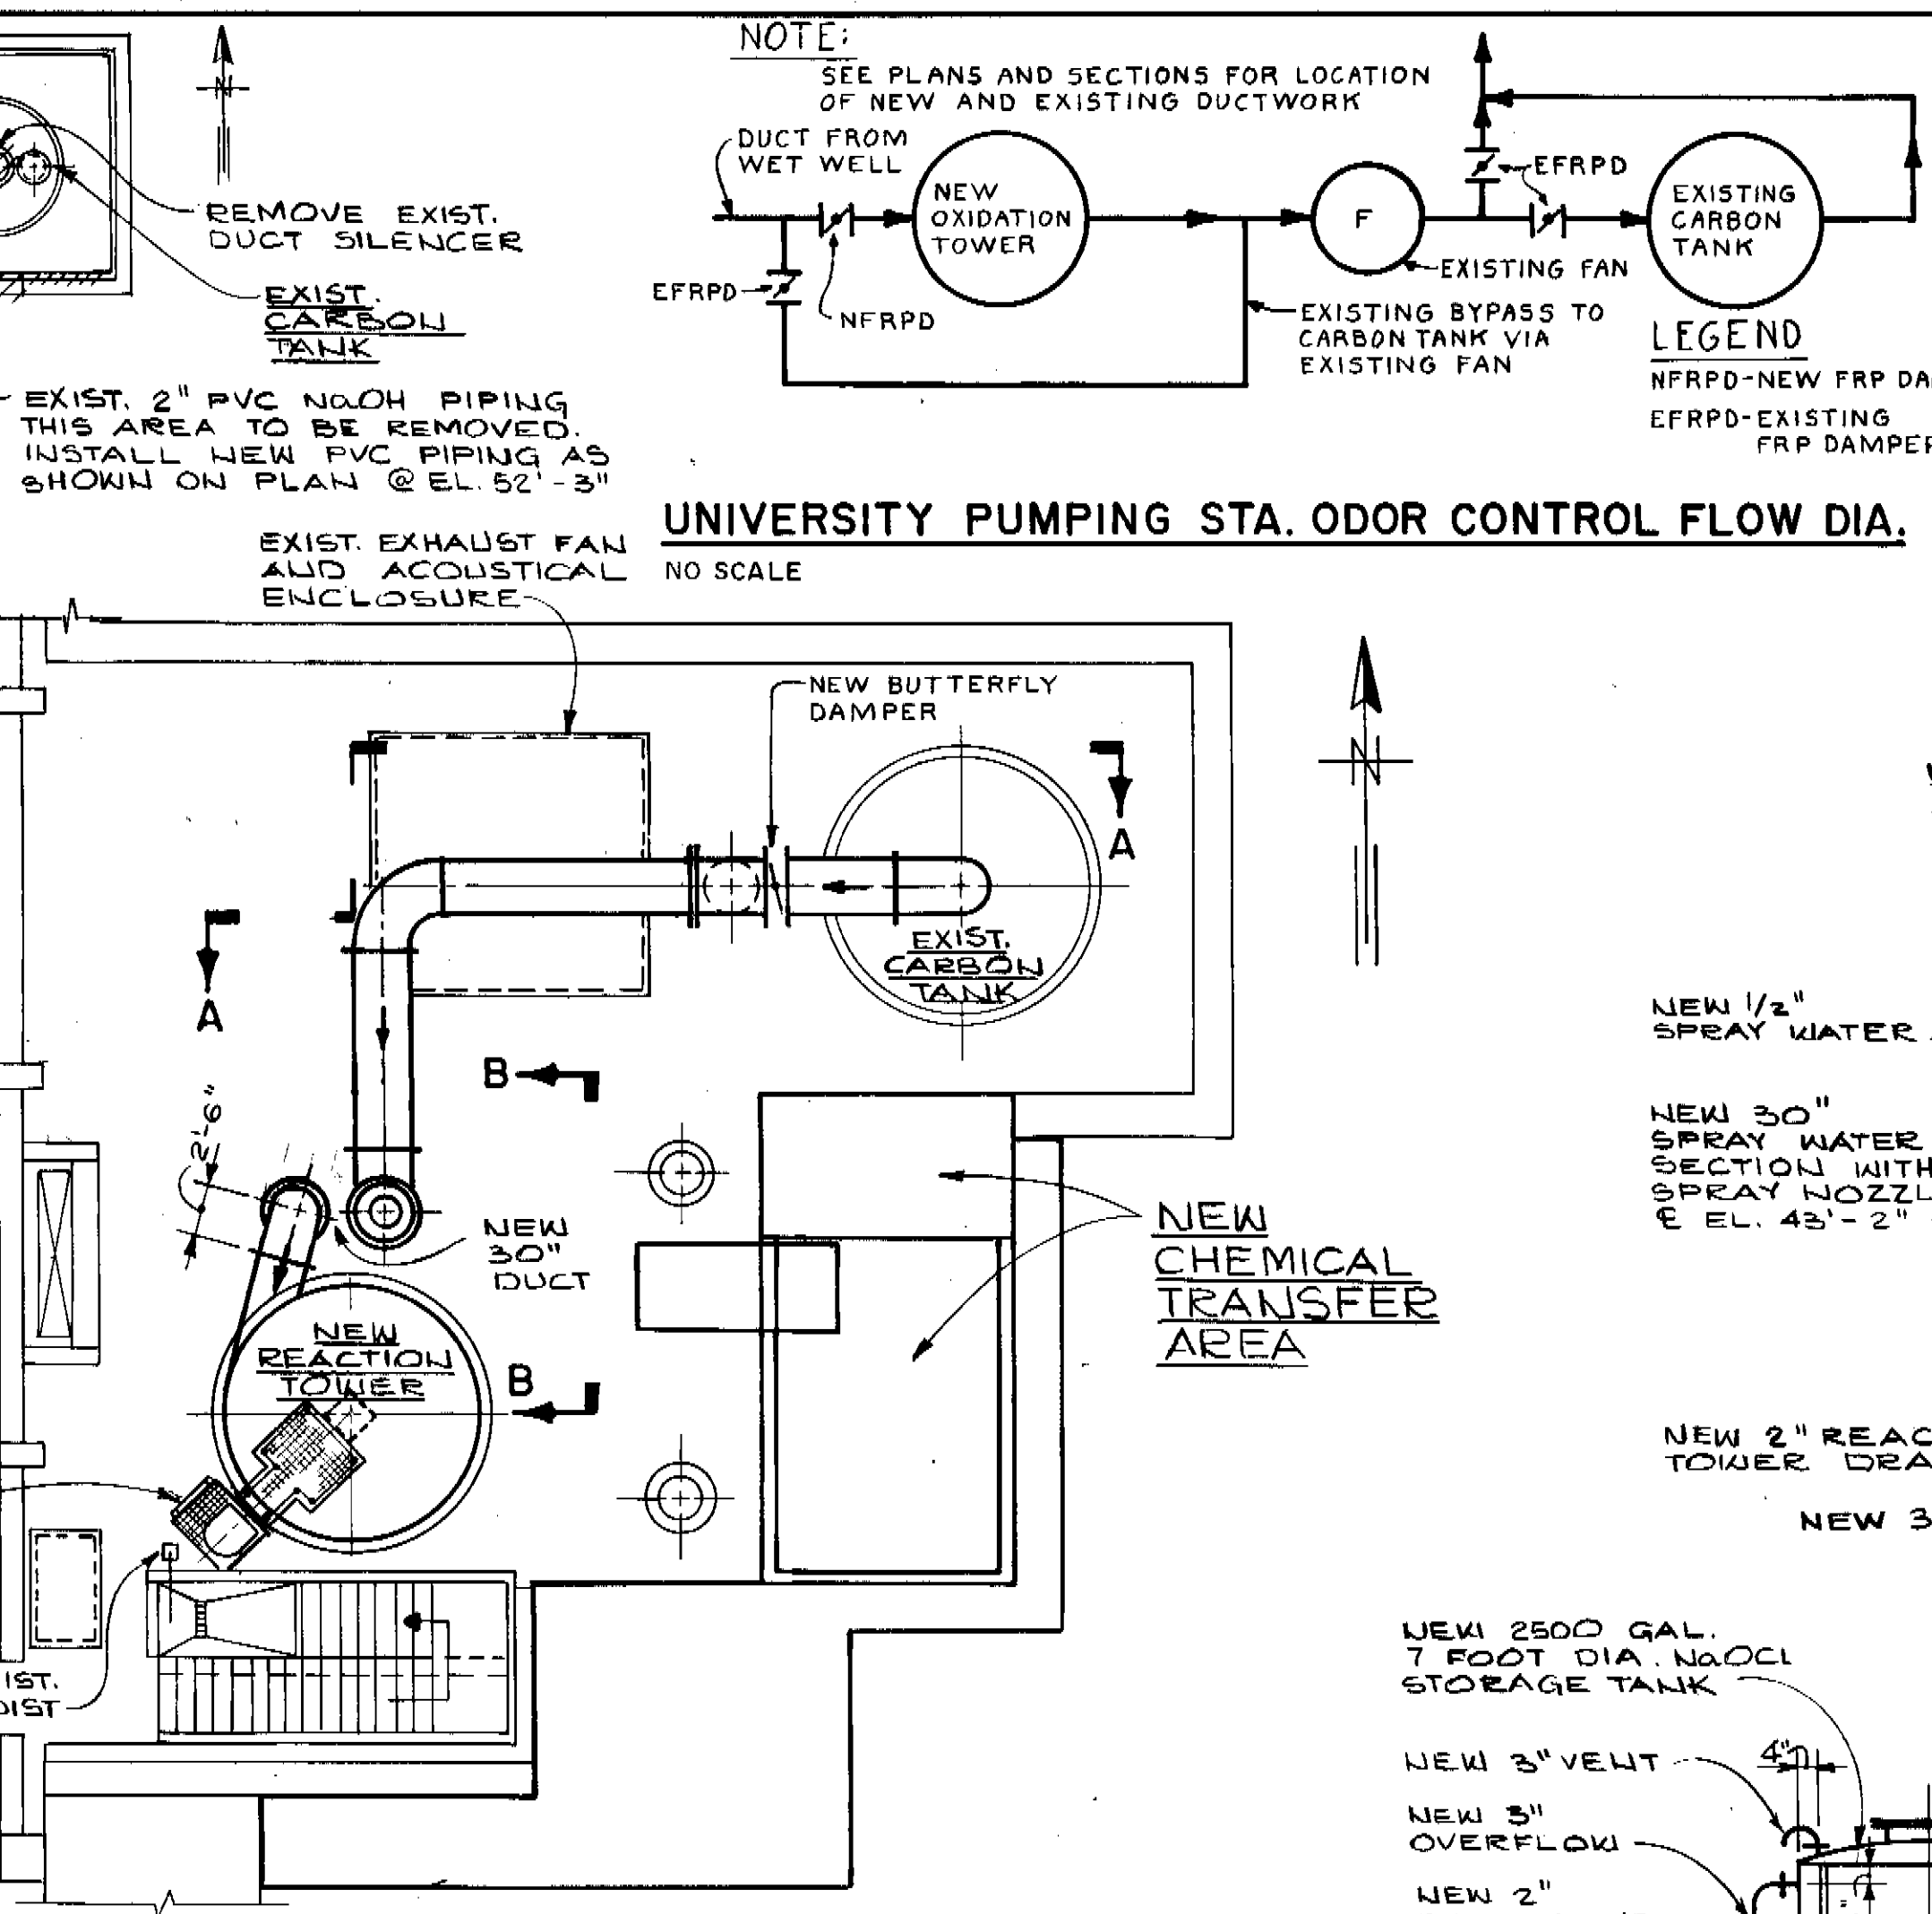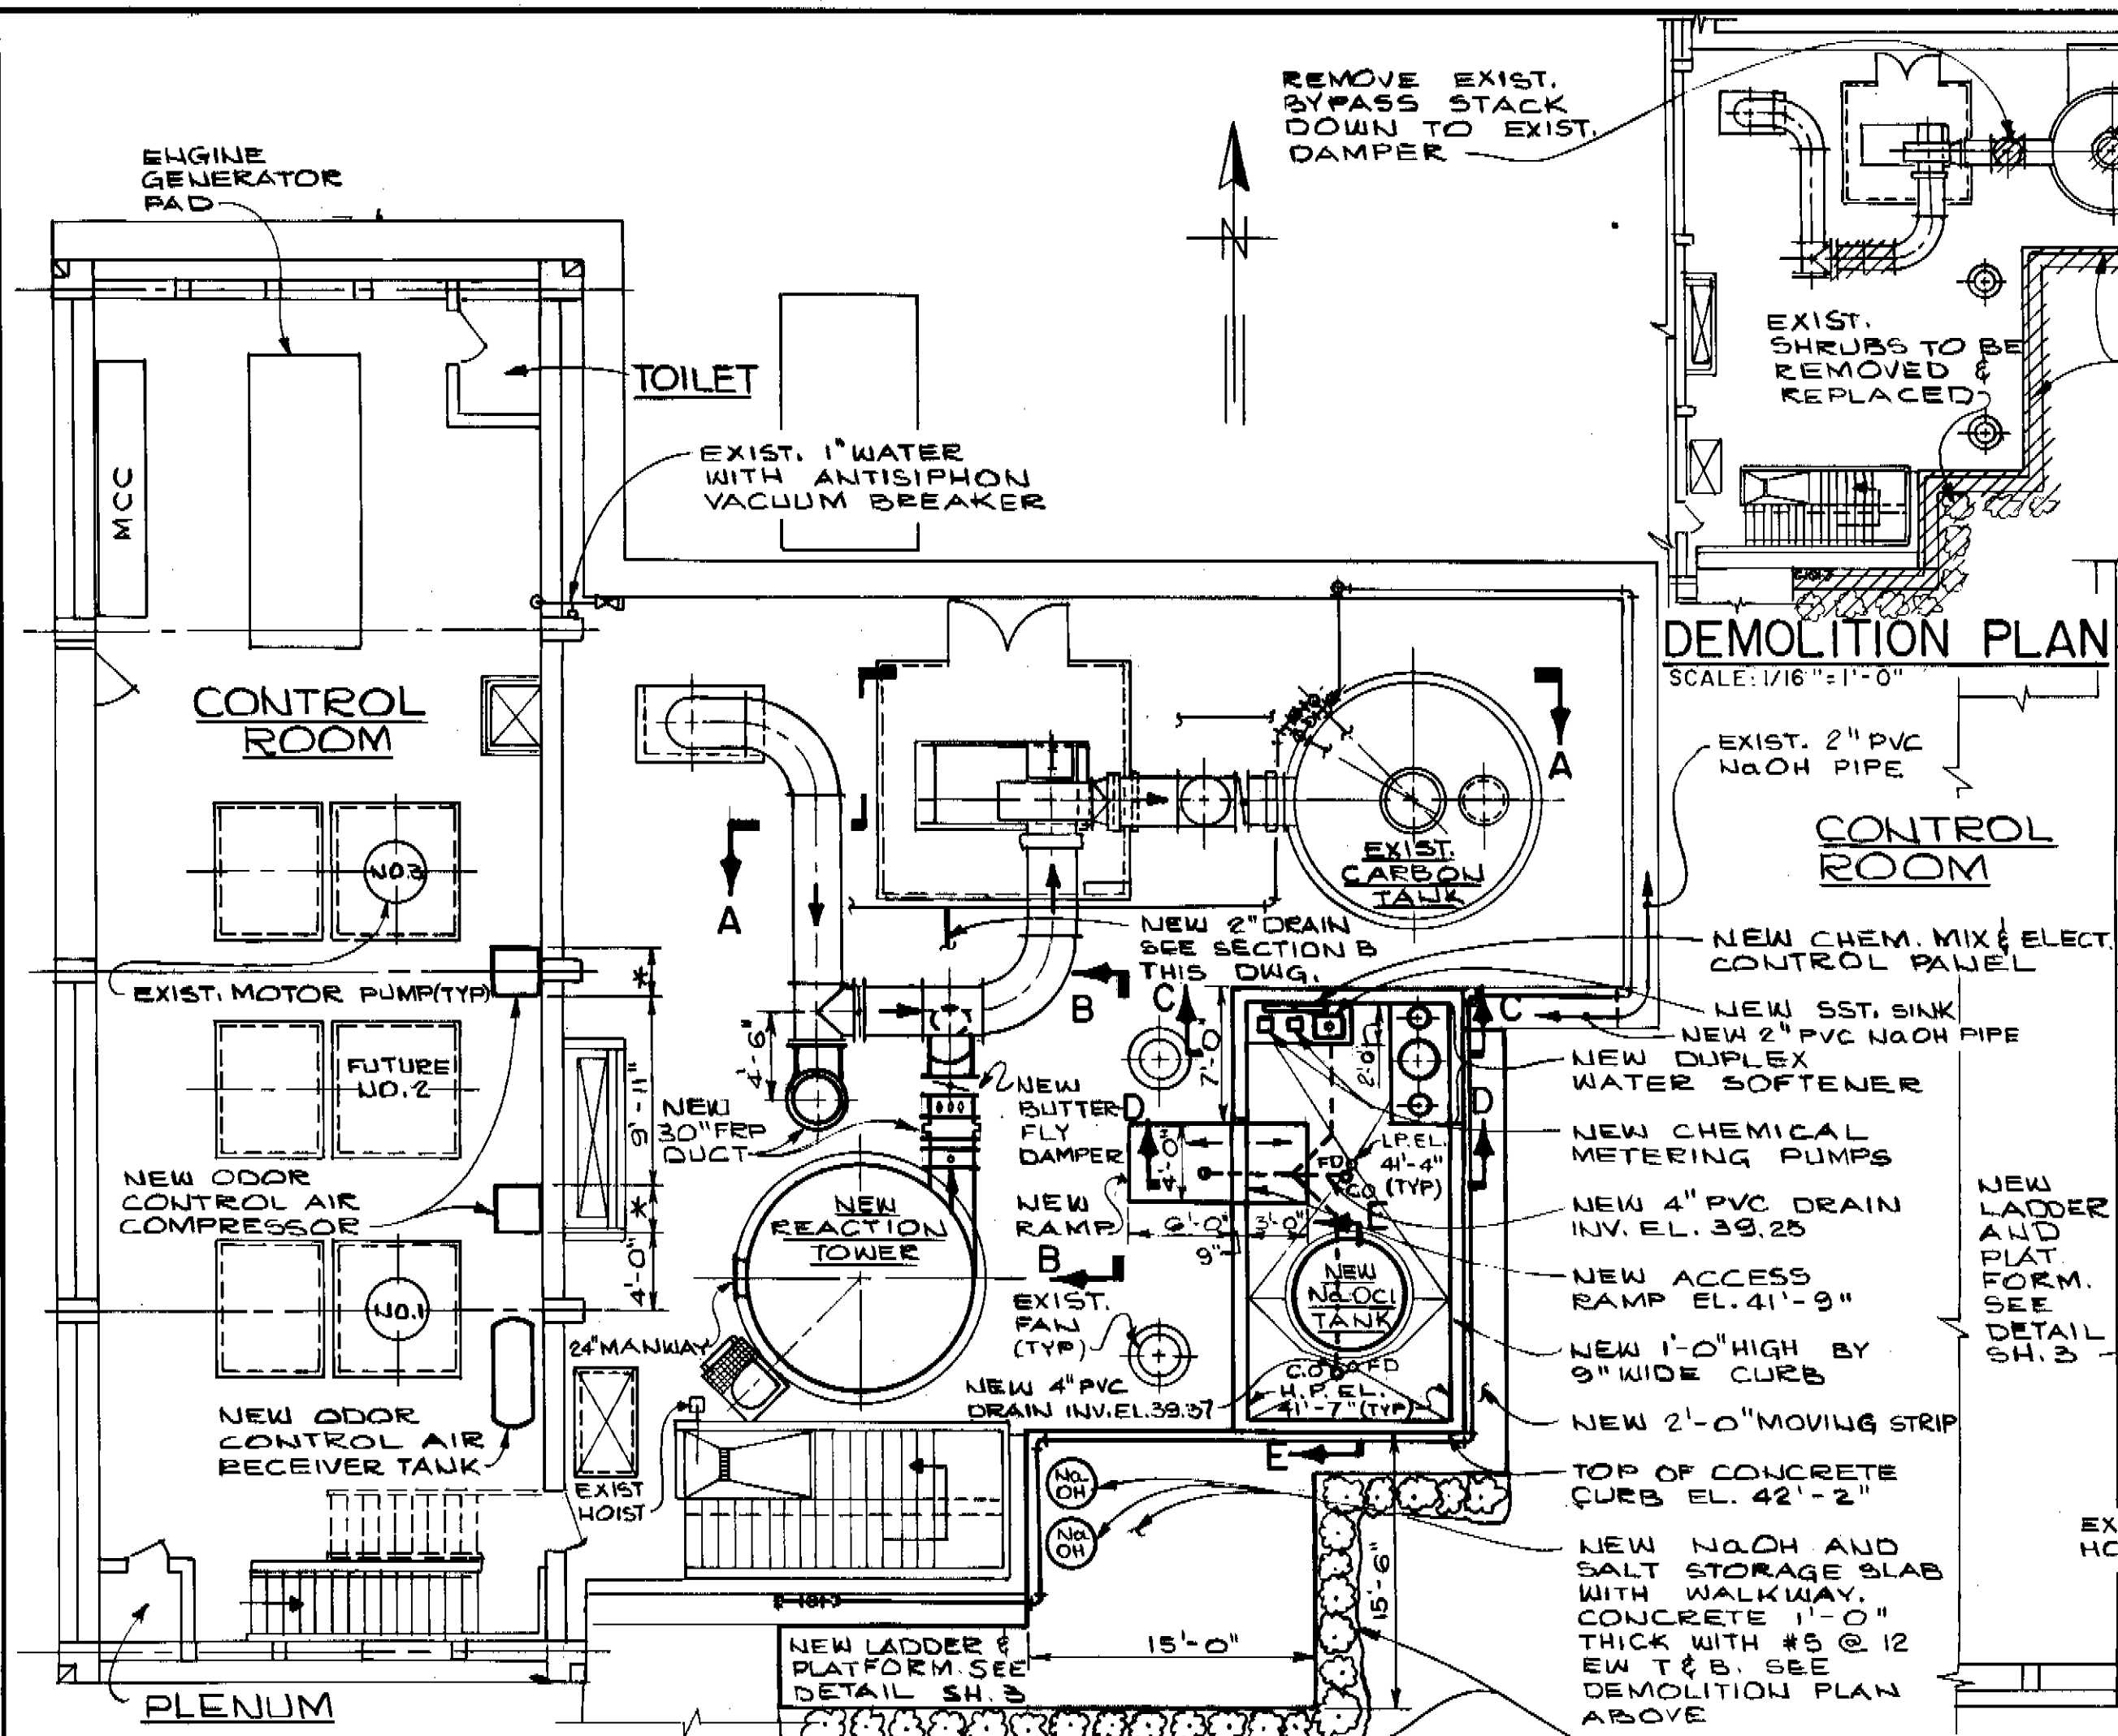

Greeley and Hansen Engineers 222 S. Riverside Plaza Chicago, Illinois 60606	DESIGNED MPV JRP	APPROVED	NO. DATE APP. REVISION	SCALE 8 0 8 16 FT 1/8" = 1'-0" 4 0 4 8 FT 1/4" = 1'-0" 0 1 2 3 4 5 6 7 FT 3/8" = 1'-0"	CITY OF TAMPA, FLORIDA SEWAGE DISPOSAL SYSTEM DIVISION 4L5 PUMPING STATIONS ODOR CONTROL MODIFICATIONS	UNIVERSITY PUMPING STATION PLANS, SECTIONS, DETAILS AND DIAGRAMS	PROJ. NO.
	DRAWN ATK	CHECKED JRP					SHEET 8 OF 10
							DATE JULY 1985 REV. 0

173-37h

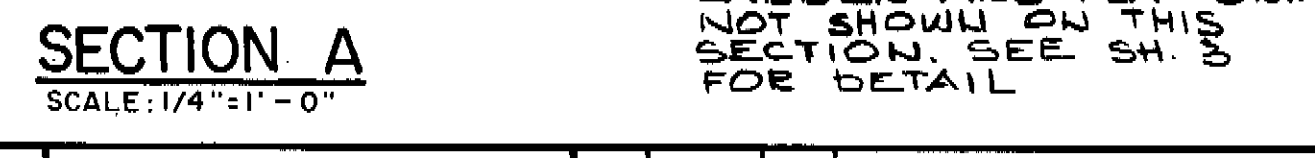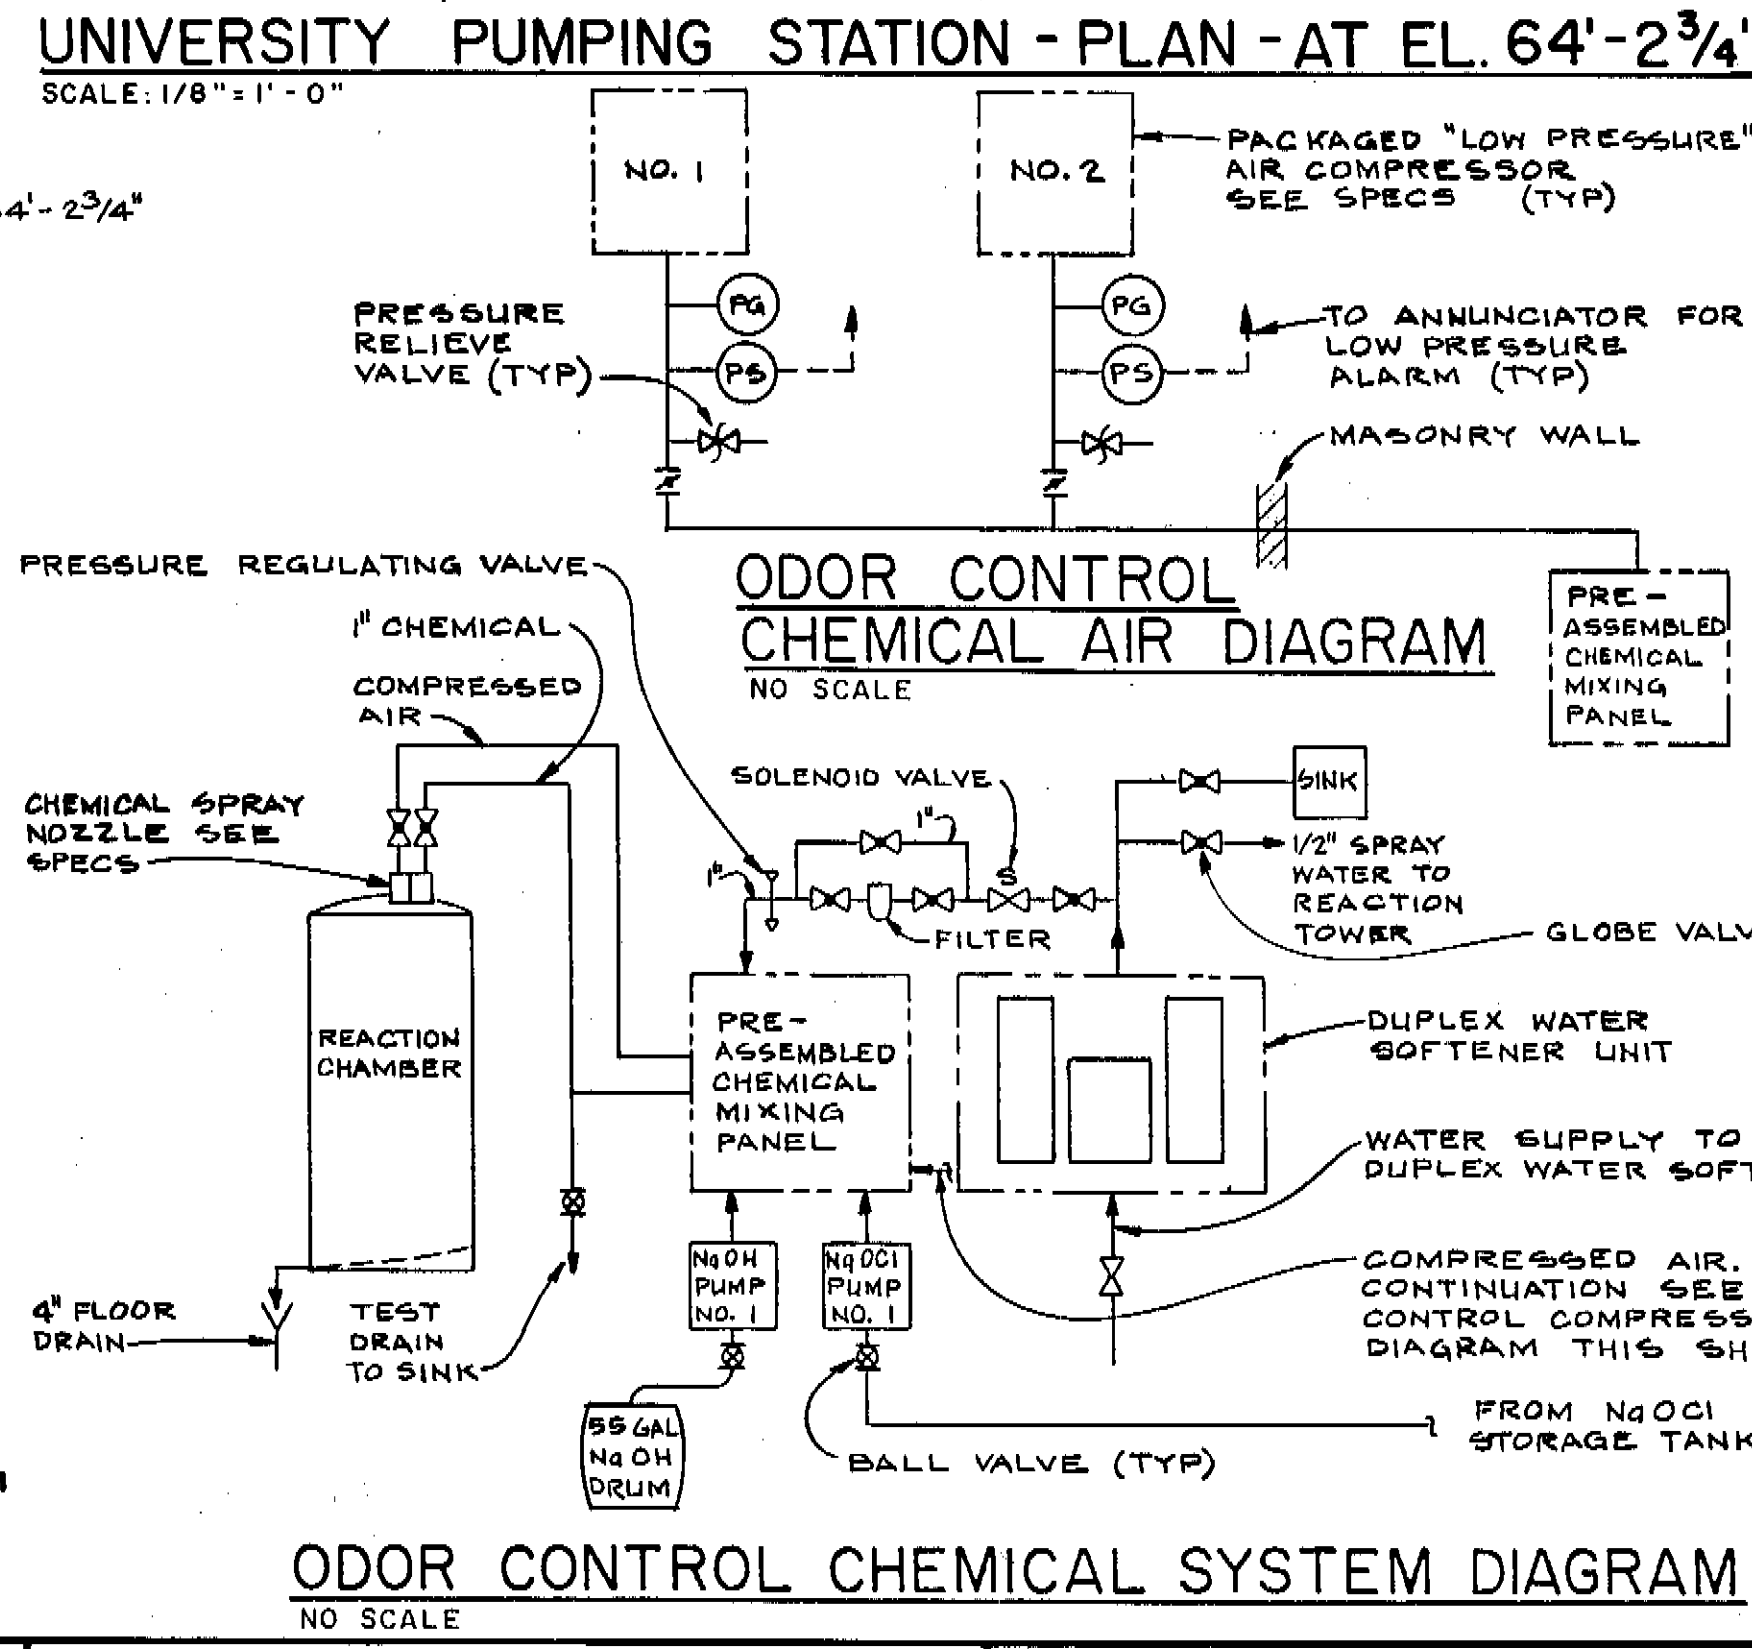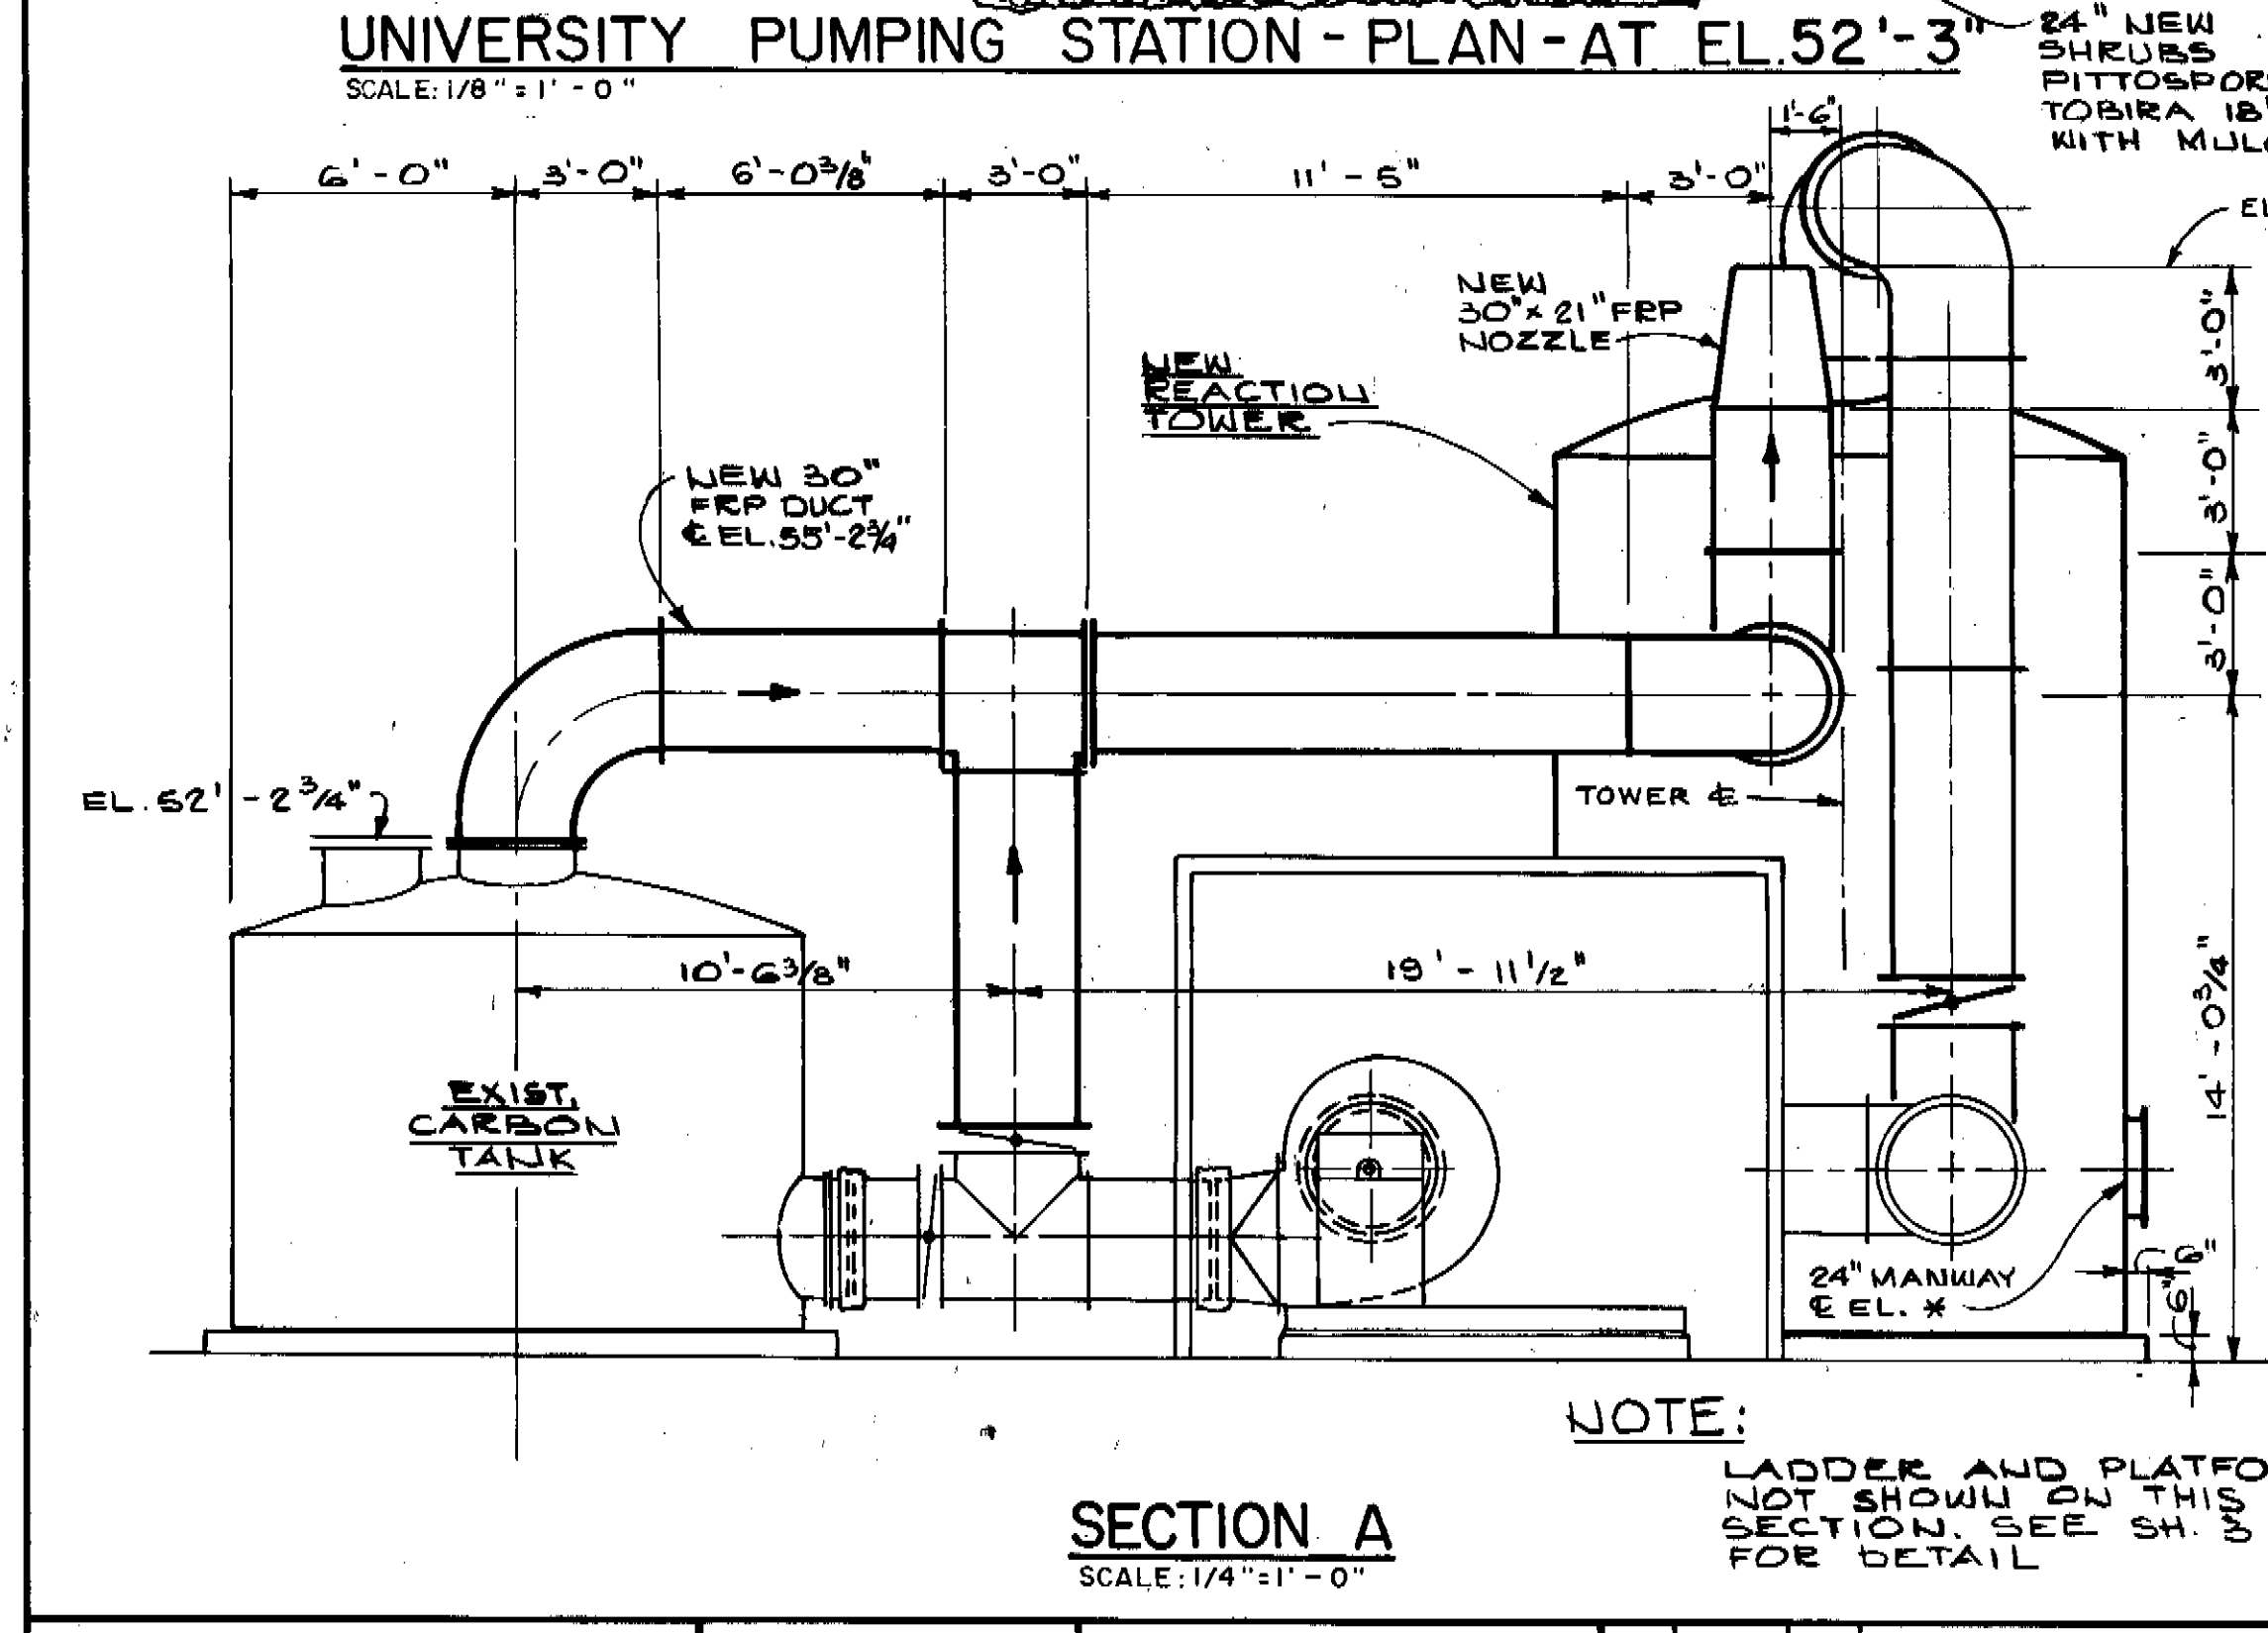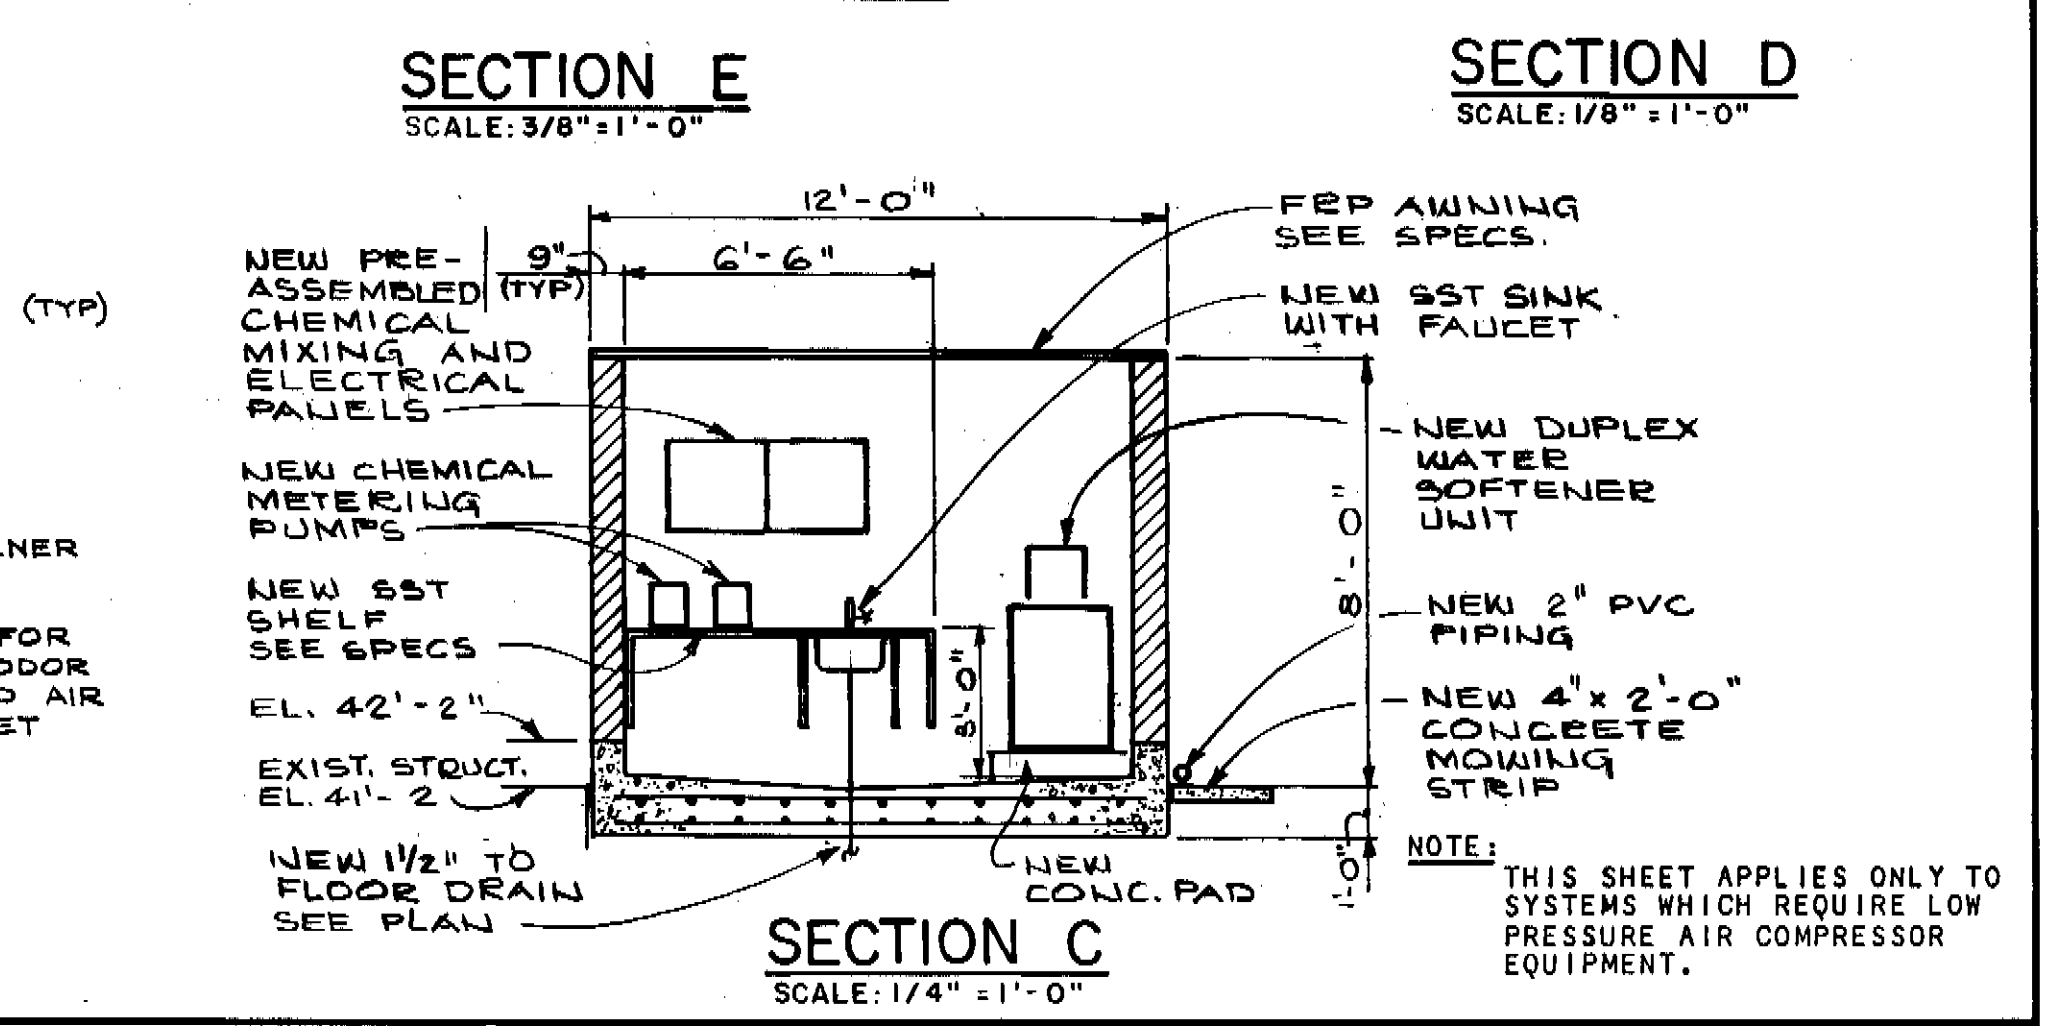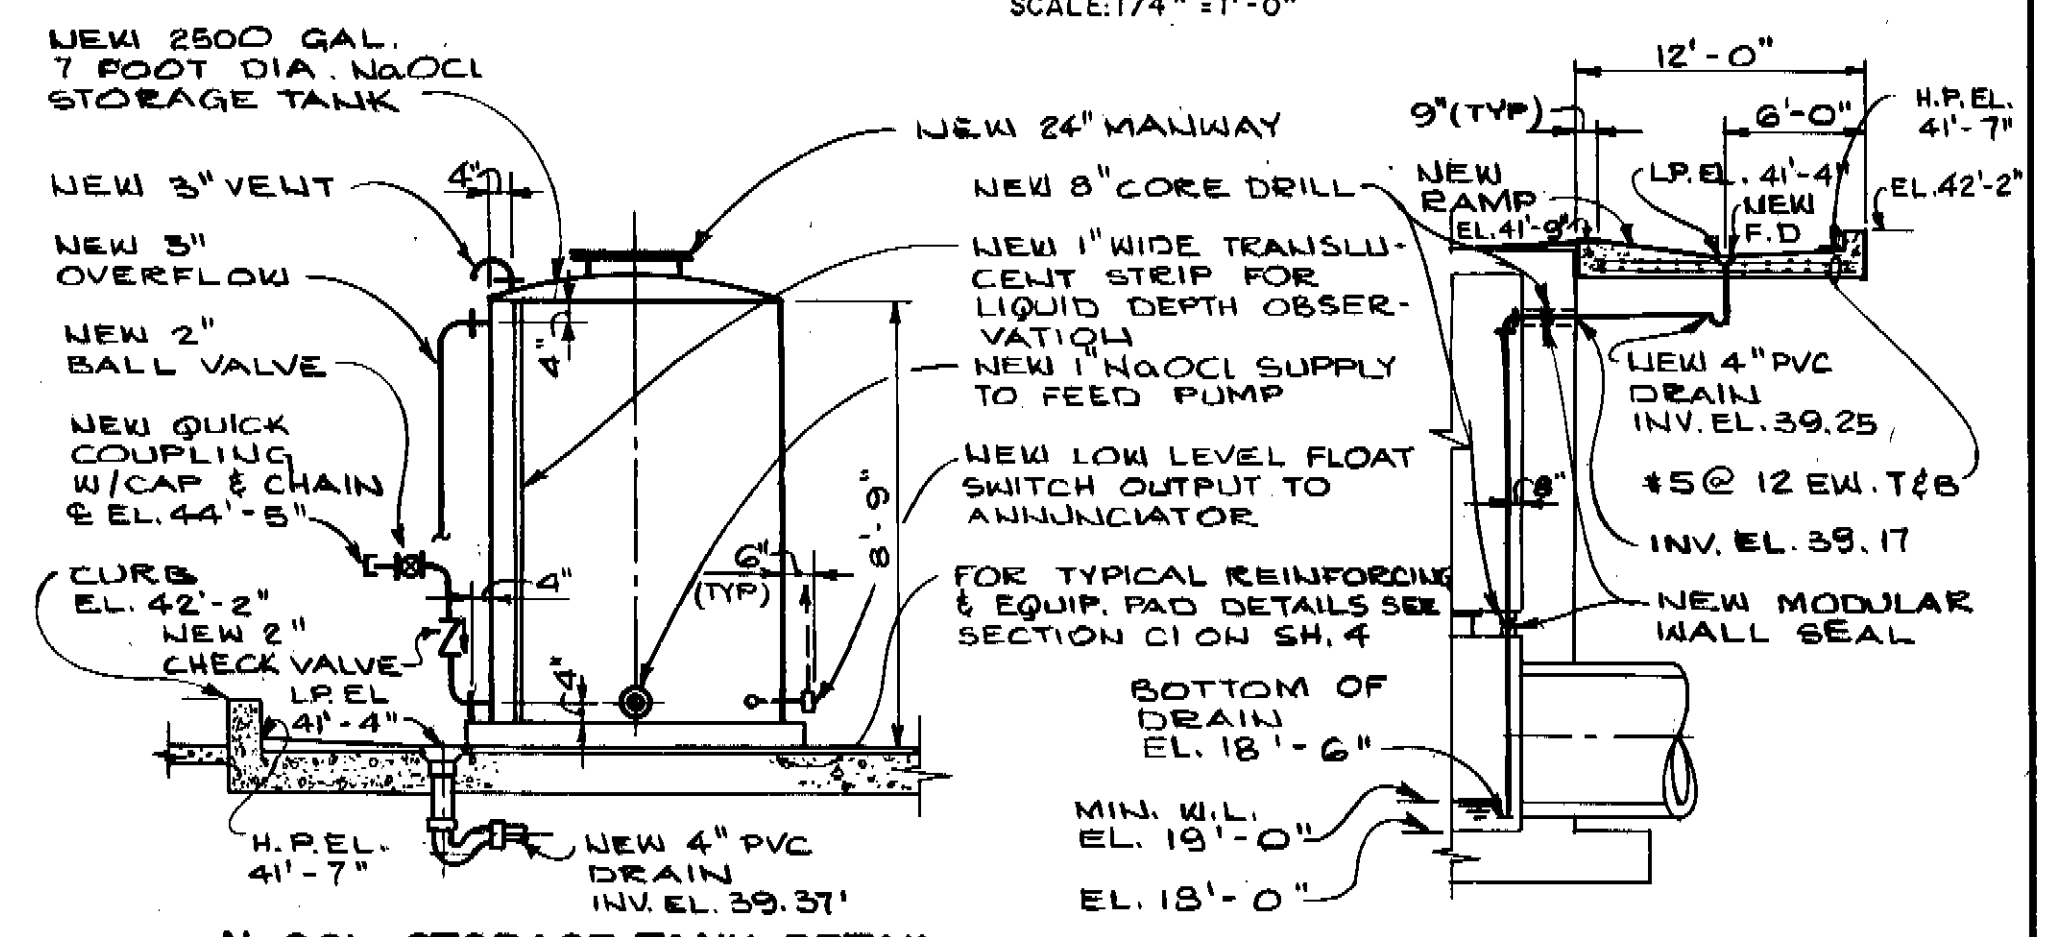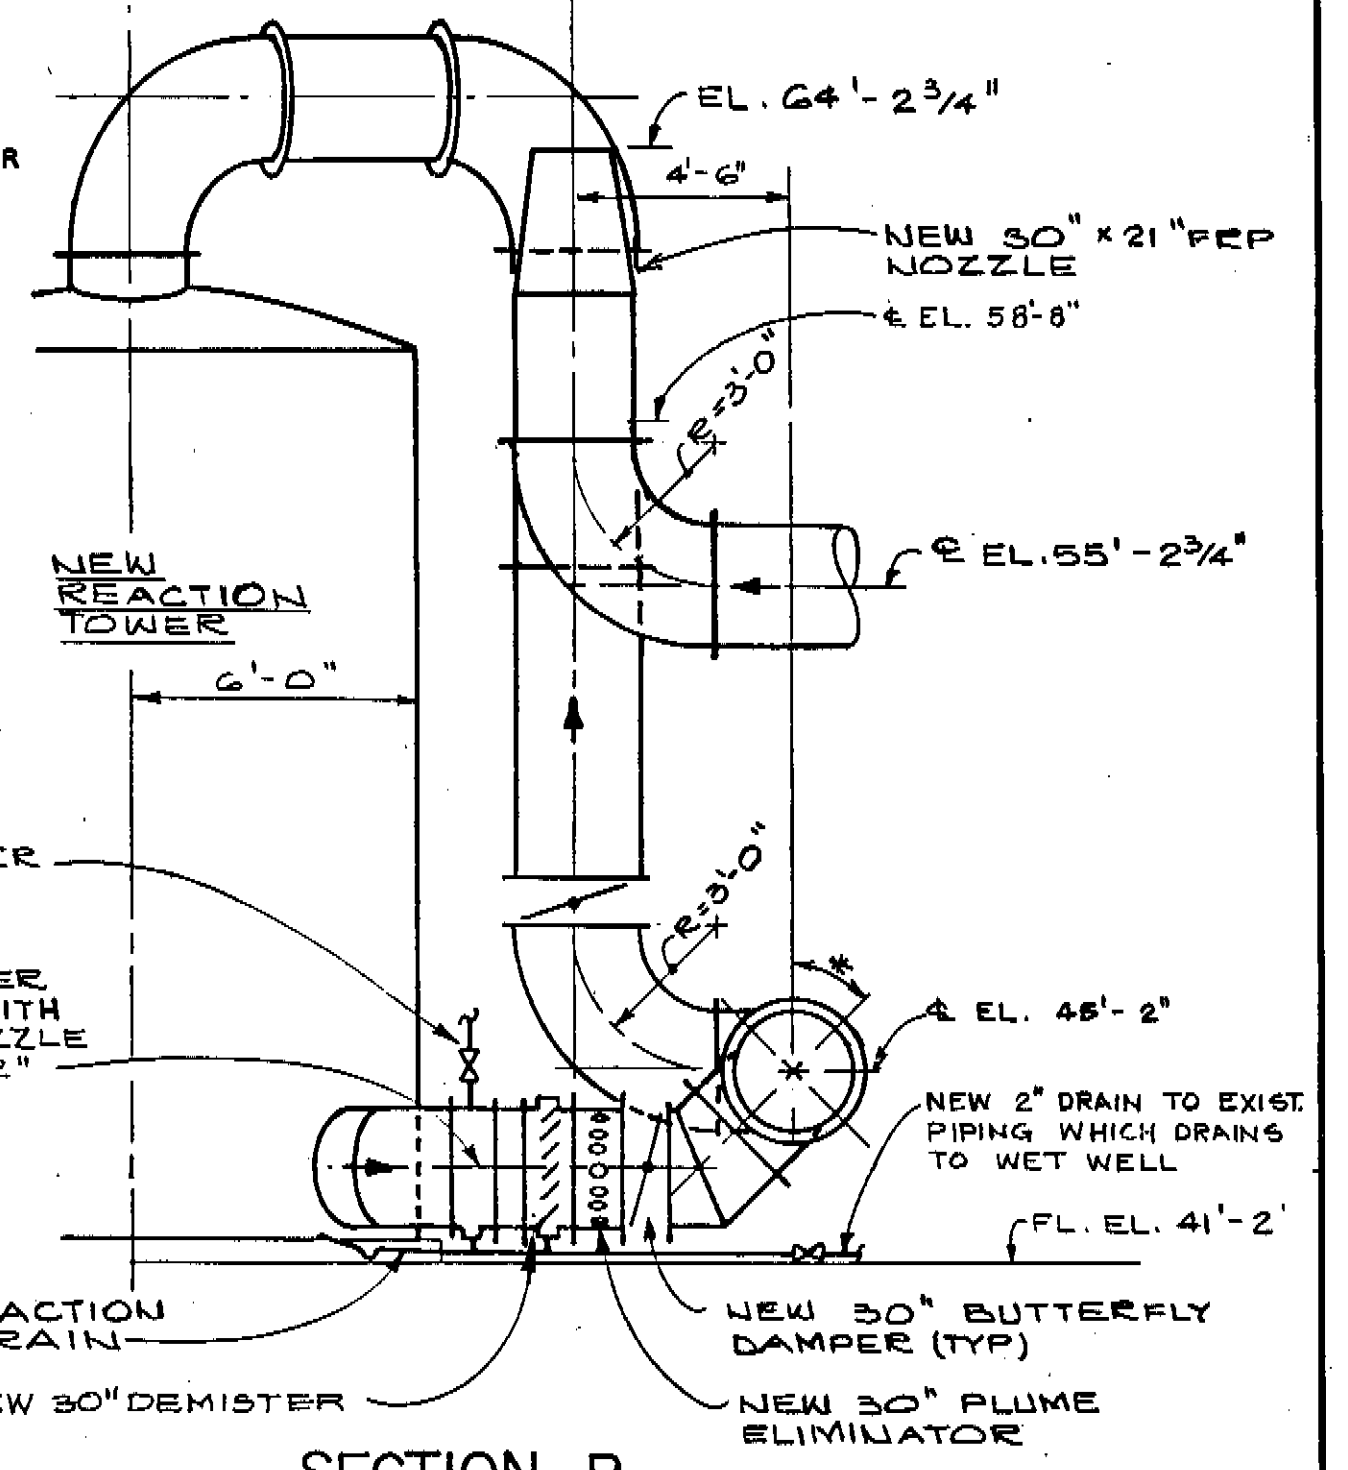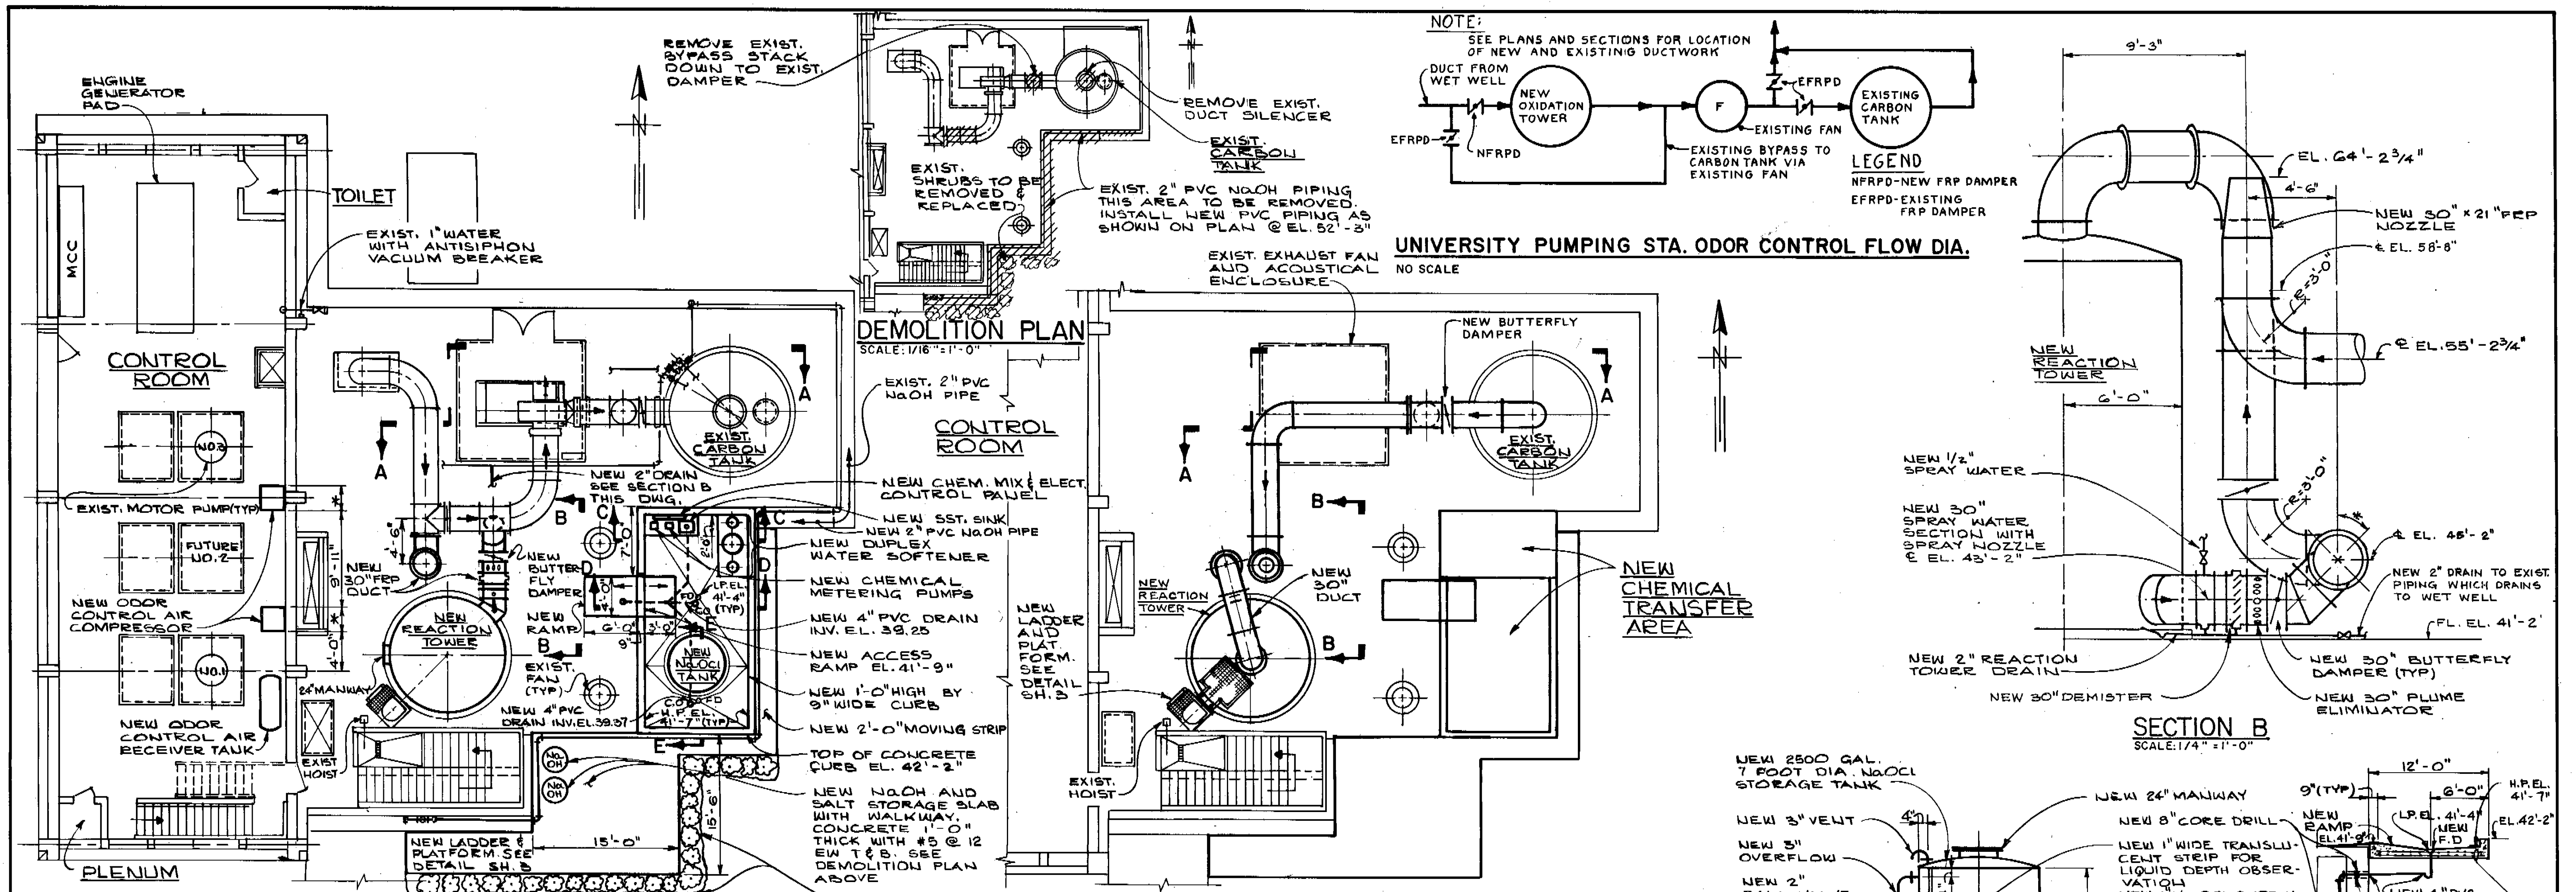


GREELEY AND HANSEN ENGINEERS 222 S. RIVERSIDE PLAZA CHICAGO, ILLINOIS 60608	DESIGNED MPV JRP DRAWN ATK CHECKED JRP	APPROVED 	NO. DATE APP. REVISION	SCALE 0 8 16 FT 1/8" = 1'-0" 0 4 8 FT 1/4" = 1'-0" 0 2 4 6 8 FT 3/8" = 1'-0"	CITY OF TAMPA, FLORIDA SEWAGE DISPOSAL SYSTEM DIVISION 4L5 PUMPING STATIONS ODOR CONTROL MODIFICATIONS	UNIVERSITY PUMPING STATION PLANS, SECTIONS, DETAILS AND DIAGRAMS	PROJ. NO. SHEET 9 OF 10 DATE JULY 1985 REV 0
	NOTE: THIS SHEET APPLIES ONLY TO SYSTEMS WHICH REQUIRE LOW PRESSURE AIR COMPRESSOR EQUIPMENT.						

CHEMICAL TRANSFER AREA


CONNECT LIGHT TO 120V POWER IN ODOR CONTROL PANEL

ODOR CONTROL PANEL

YP-2, YP2A & SPARE 2" C RUN IN SLAB

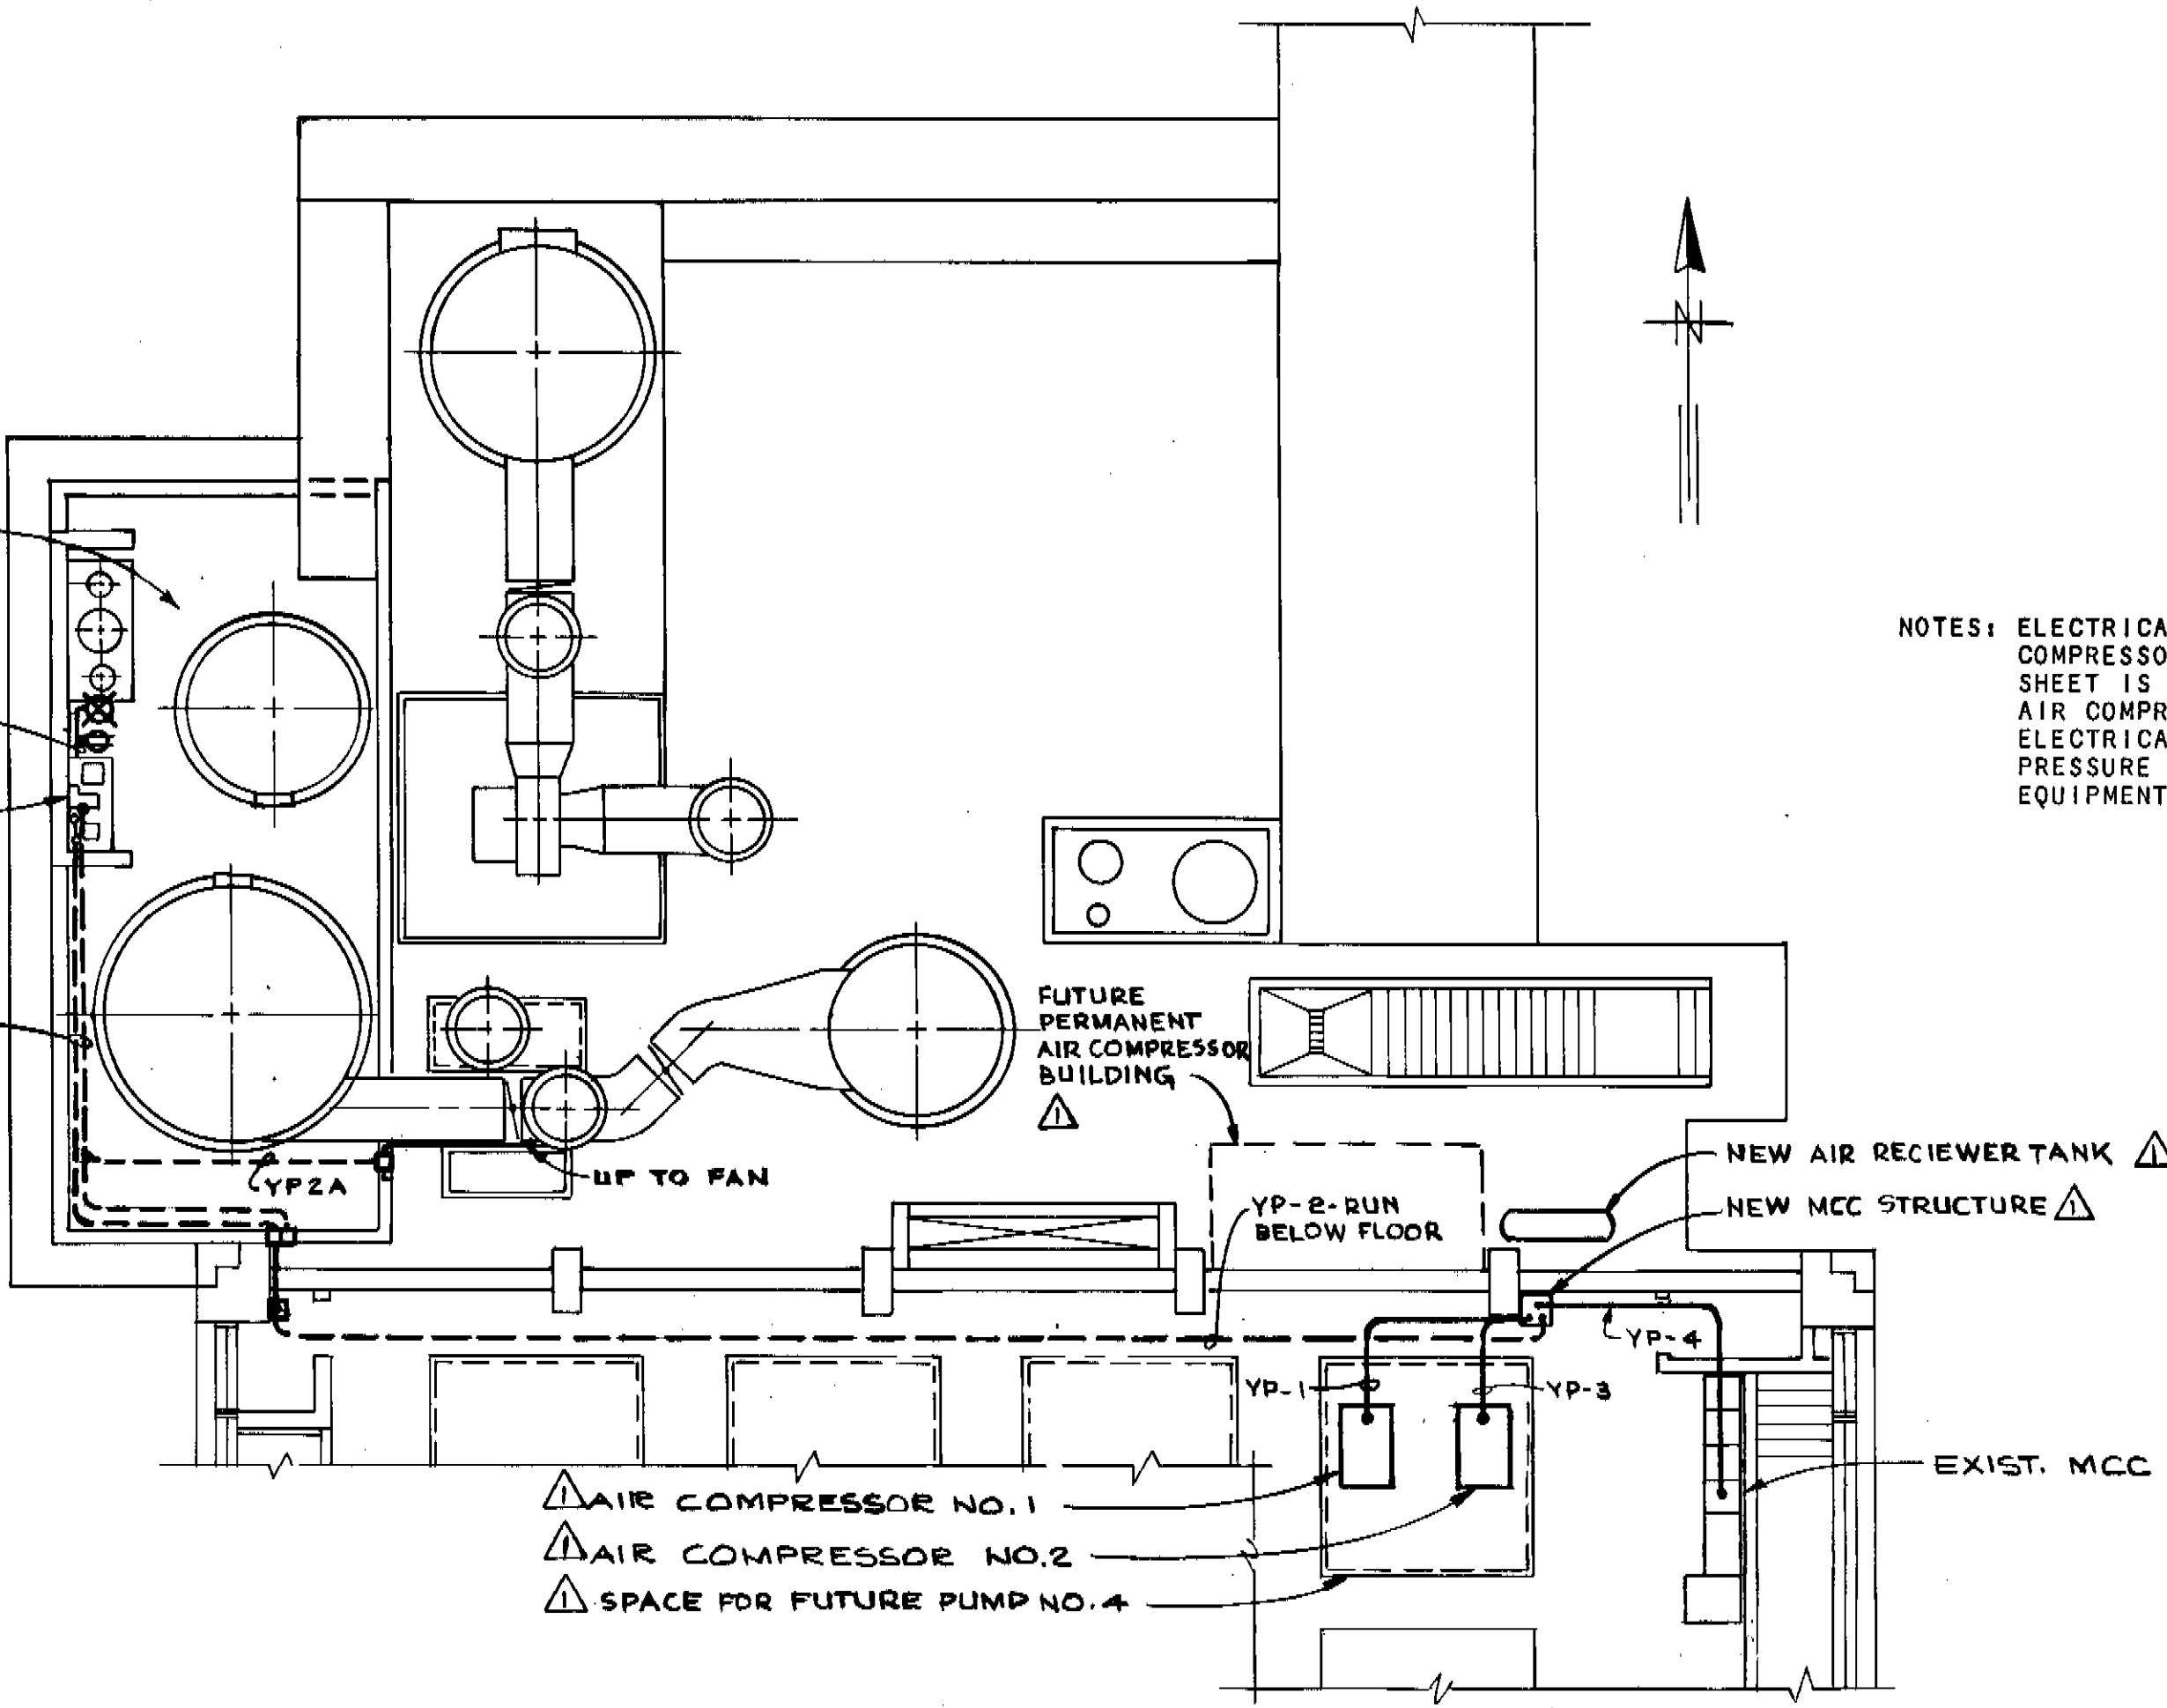


NOTES: ELECTRICAL SERVICE TO AIR COMPRESSORS SHOWN ON THIS SHEET IS FOR HIGH PRESSURE AIR COMPRESSOR EQUIPMENT. ELECTRICAL SERVICE FOR LOW PRESSURE AIR COMPRESSOR EQUIPMENT IS SIMILAR.

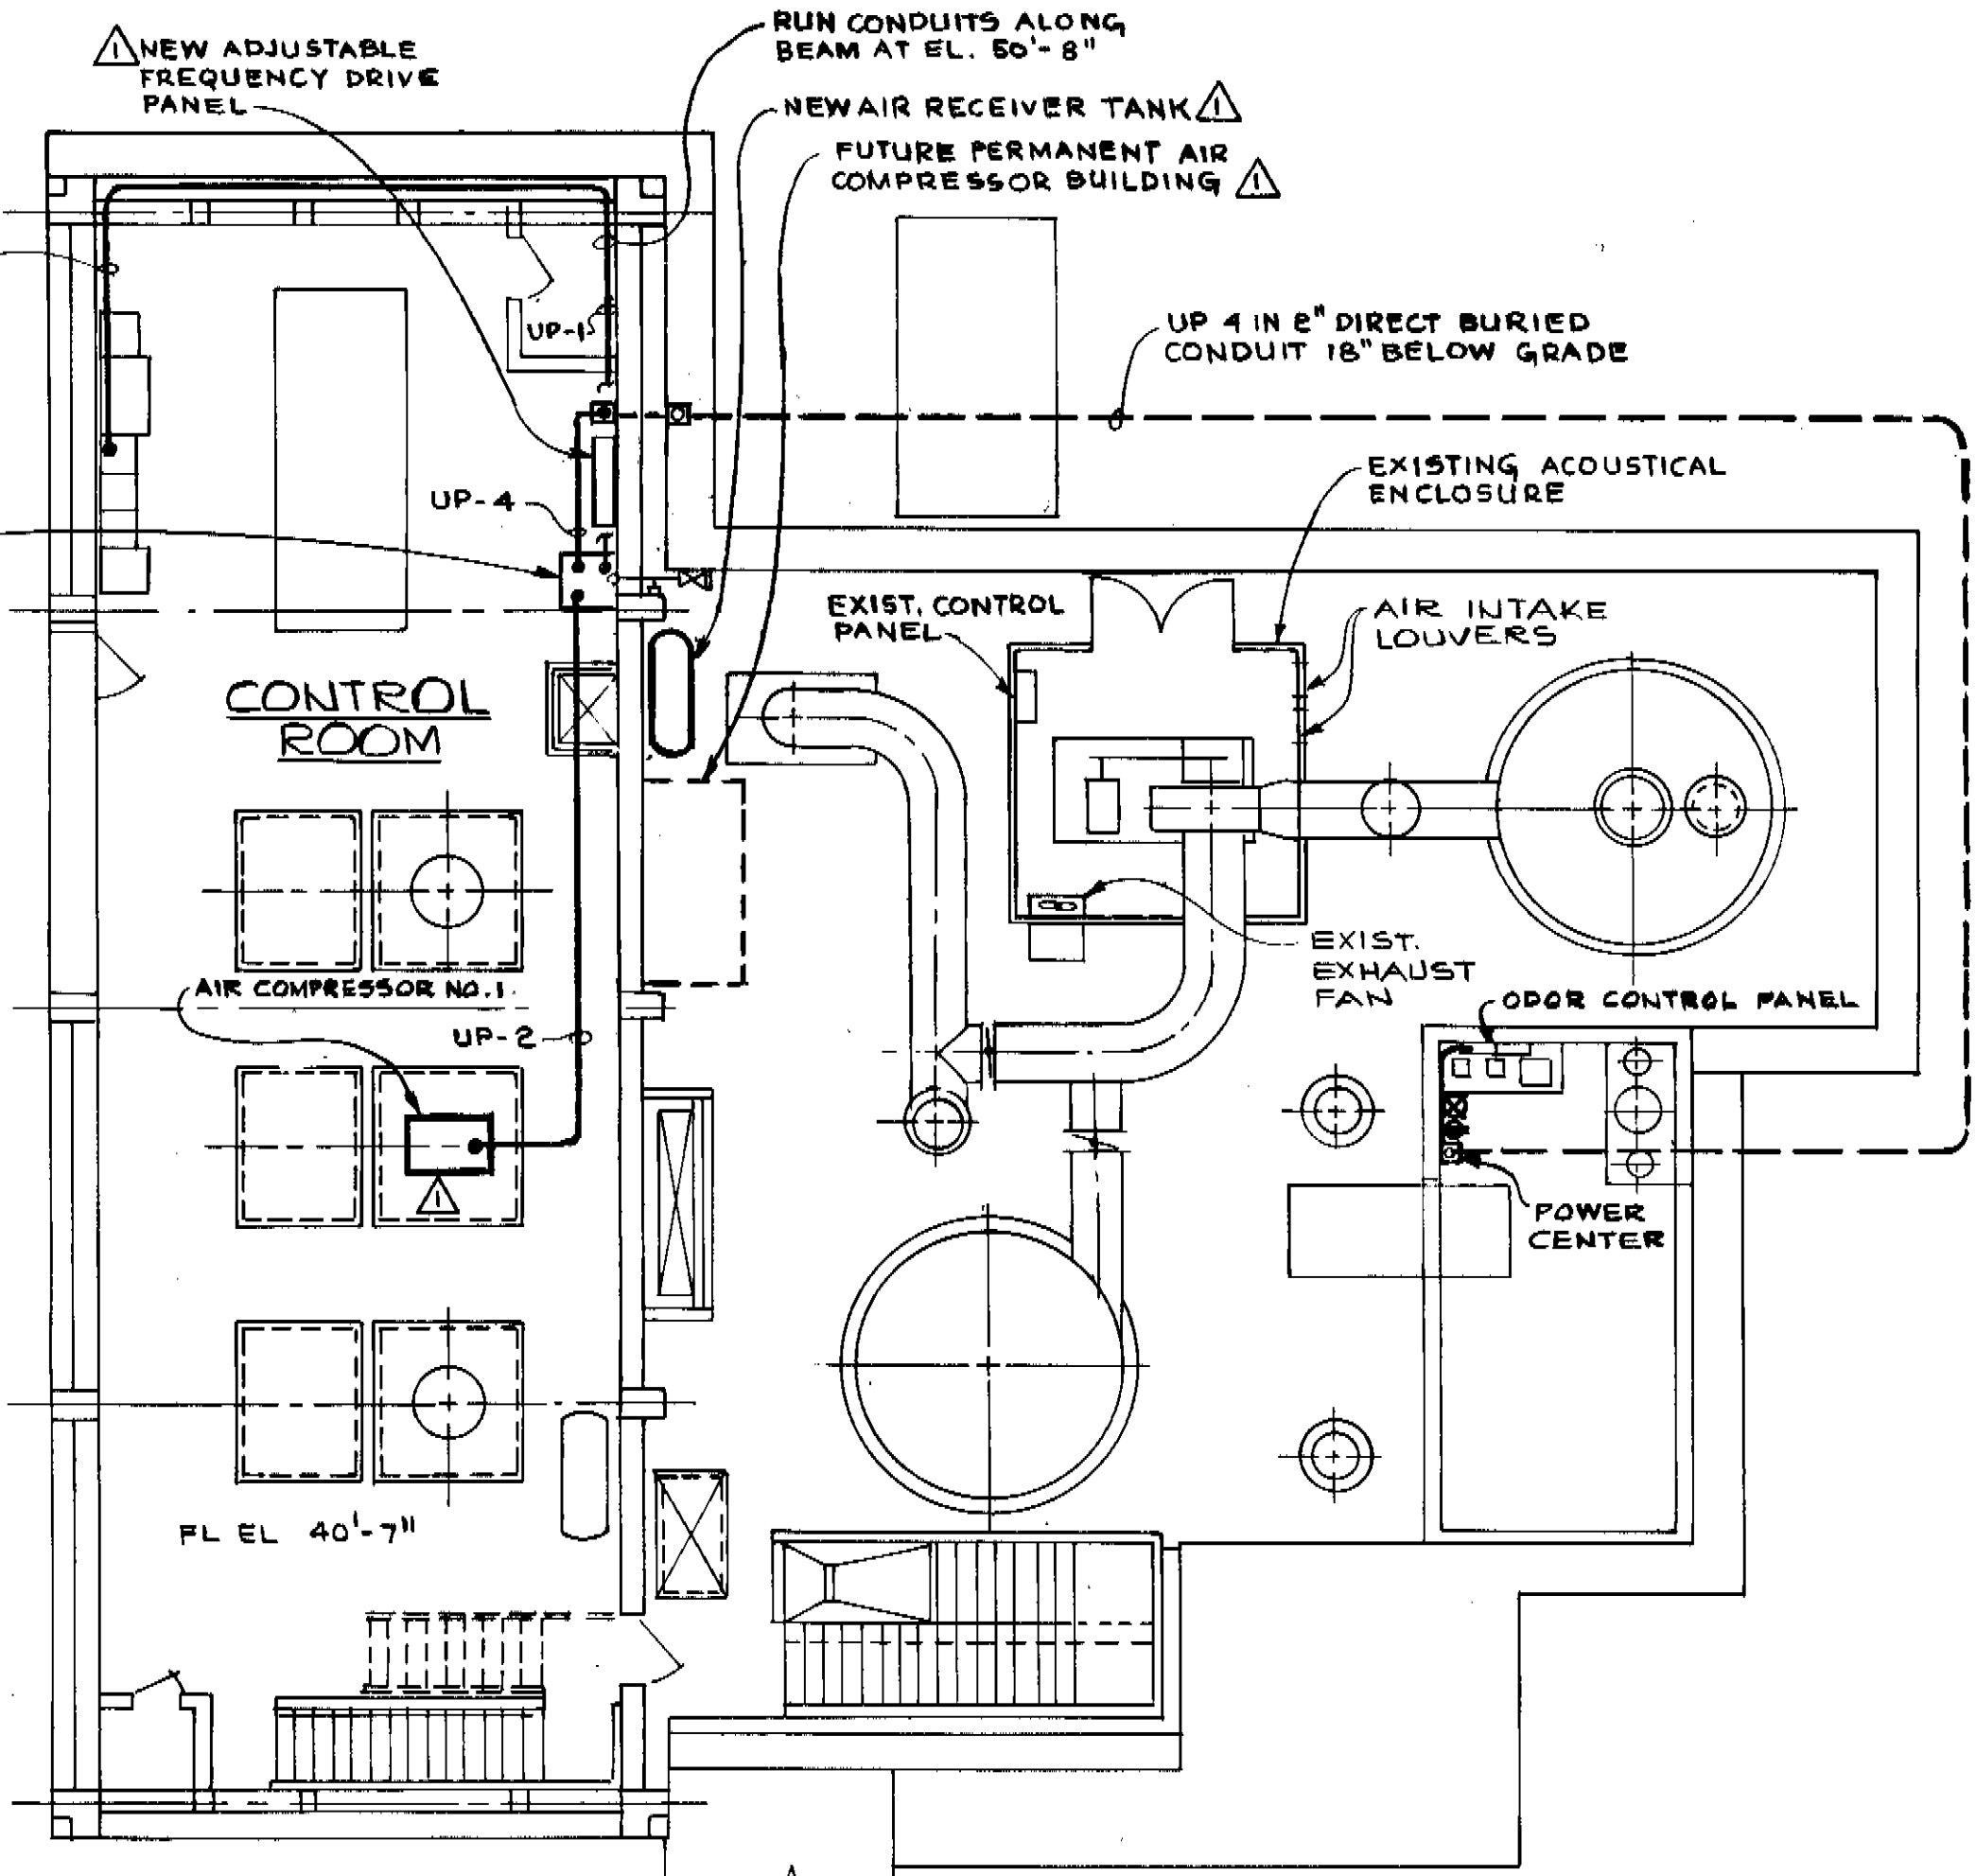


PLAN AT EL. 22'-0"
SCALE: 1/8"=1'-0"

PLAN AT EL. 52'-3"
SCALE: 1/8"=1'-0"

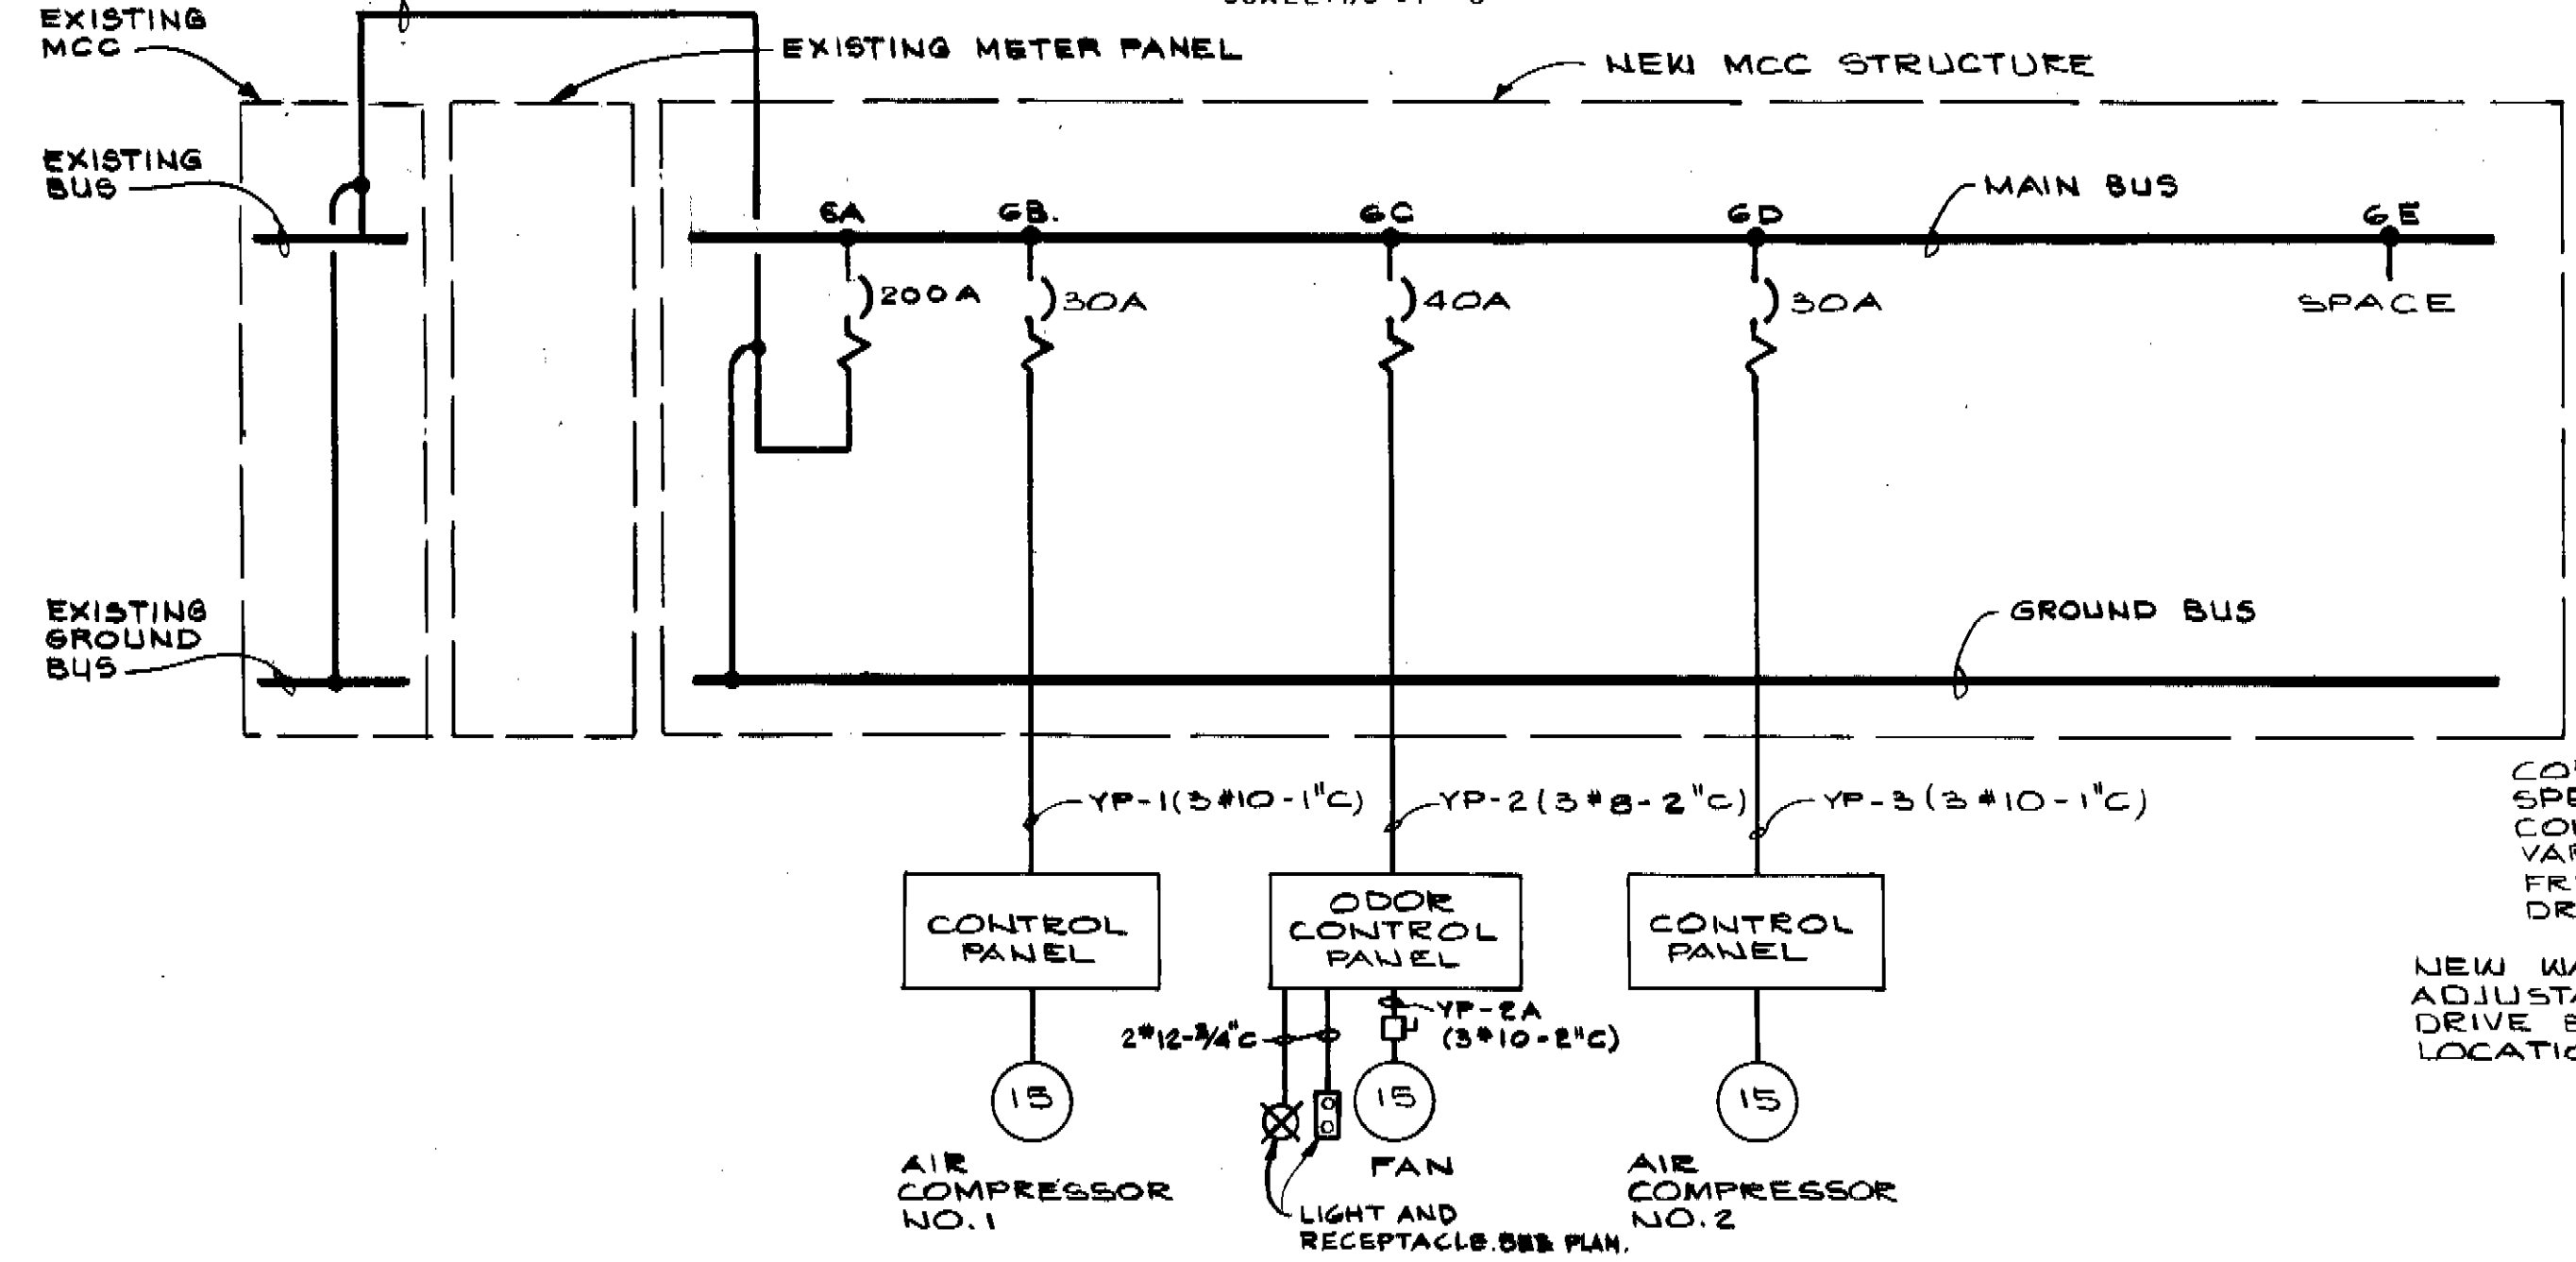


MCC PARTIAL ONE LINE DIAGRAM
480 VOLT, 3 PHASE, 60 HERTZ

YBOR PUMPING STATION

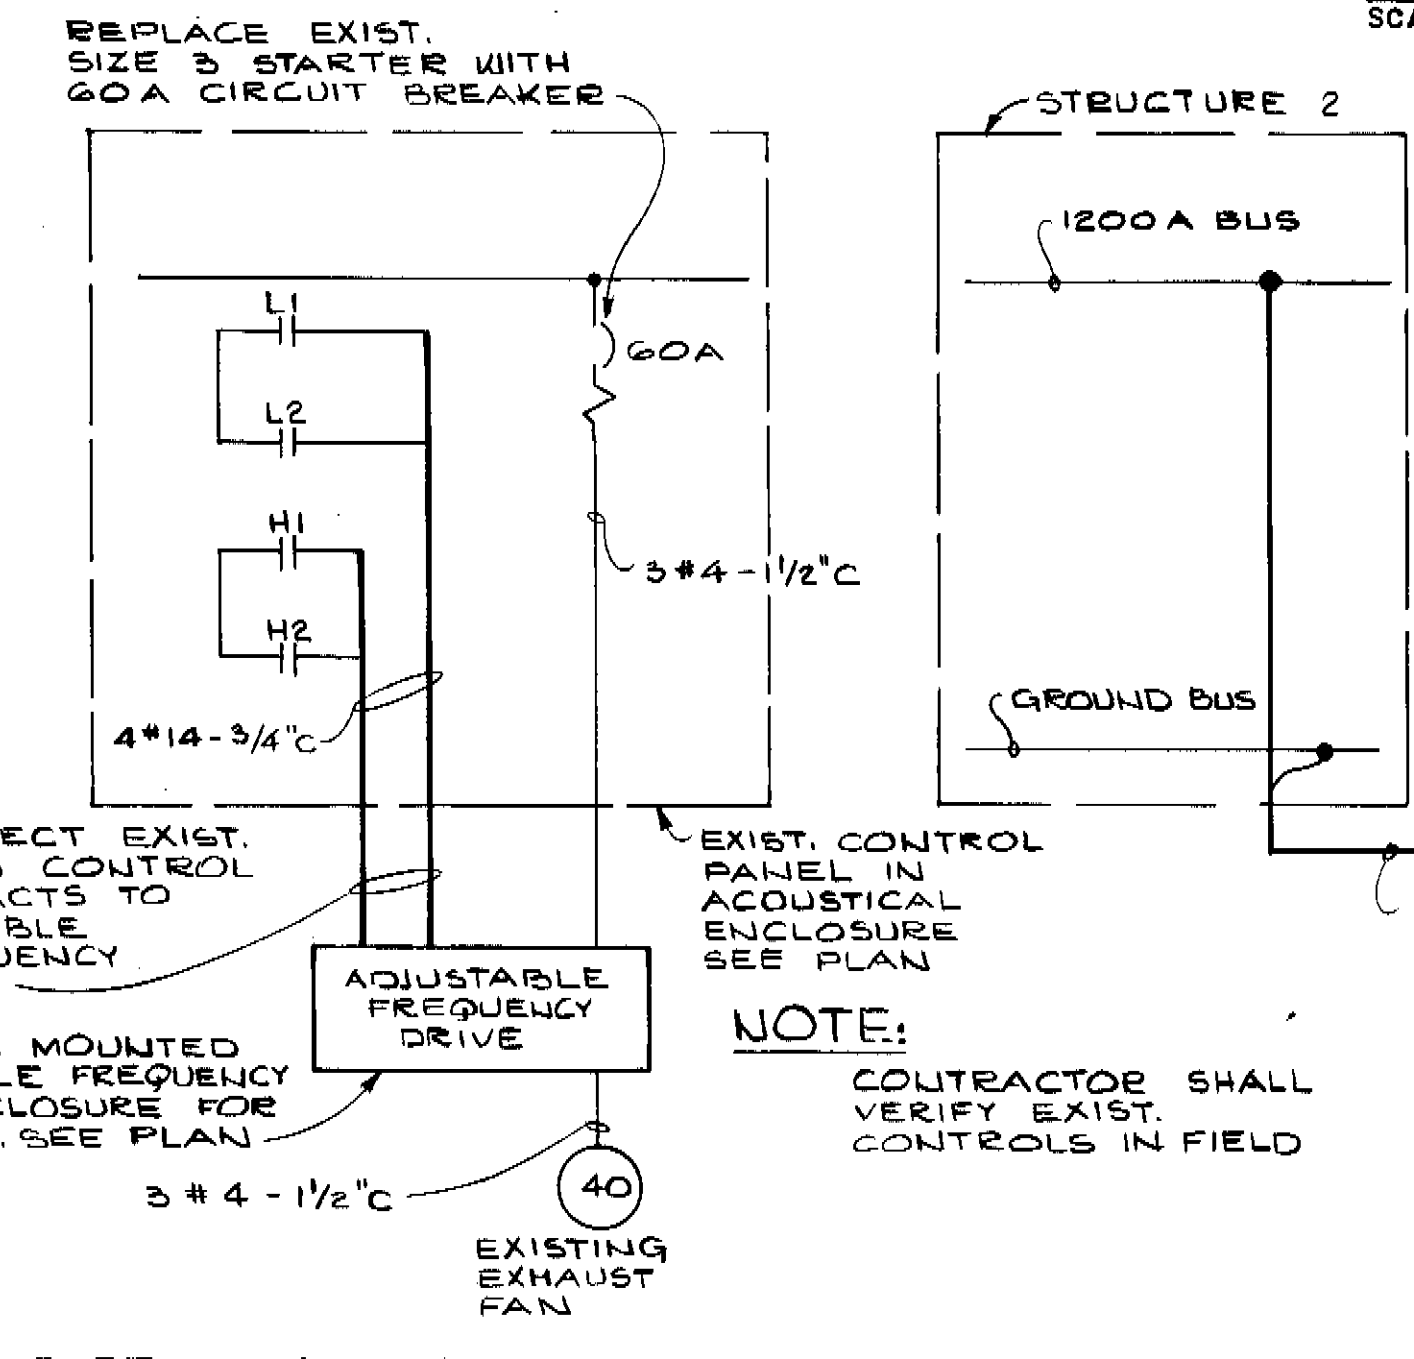

PARTIAL ONE LINE DIAGRAM OF EXISTING CONTROL CENTER AND NEW ADJUSTABLE FREQUENCY DRIVE
UNIVERSITY PUMPING STATION

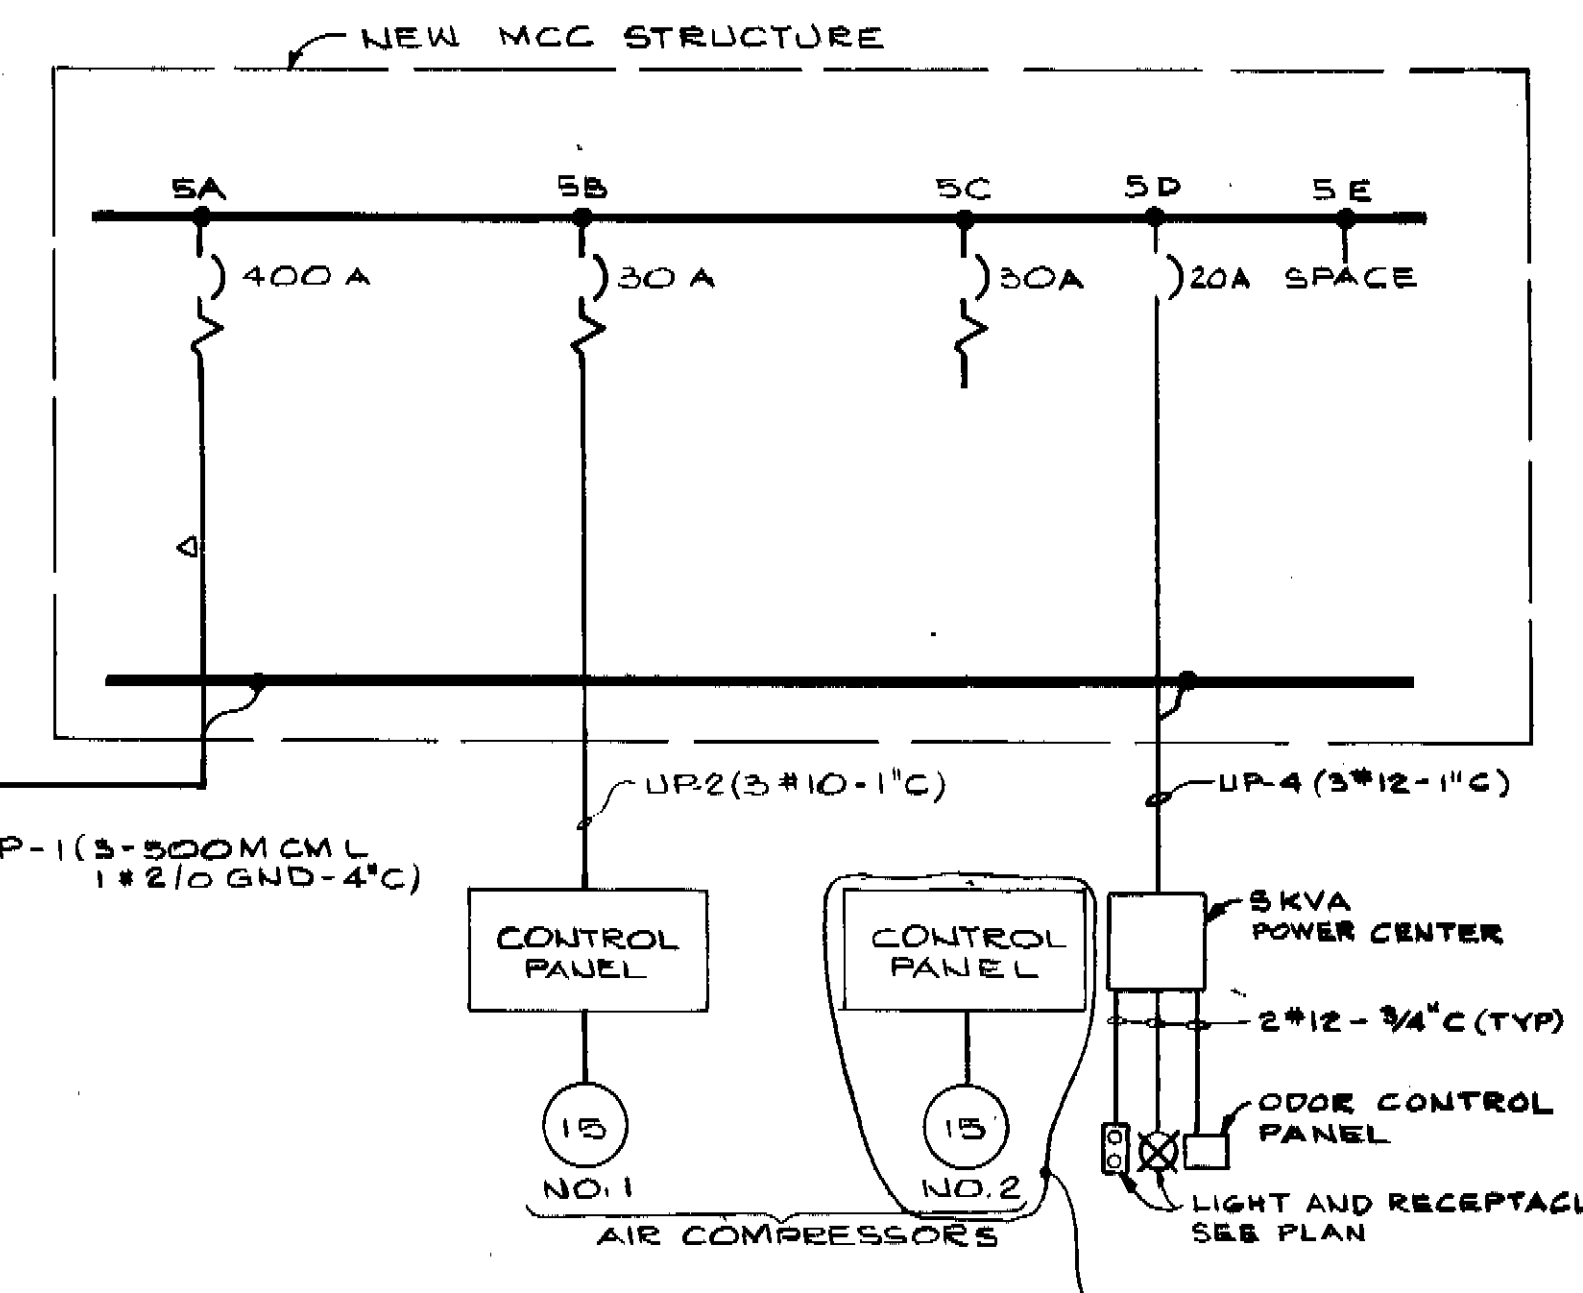

MCC PARTIAL ONE LINE DIAGRAM
480 VOLT, 3 PHASE, 60 HERTZ

UNIVERSITY PUMPING STATION

GREELEY AND HANSEN ENGINEERS
222 S. RIVERSIDE PLAZA
CHICAGO, ILLINOIS 60606

DESIGNED BBK
DRAWN AK
CHECKED BBK JRP

APPROVED

NO.	DATE	APP.	REVISION
1	5.18.87	JRP	AIR COMPRESSORS & MCC'S


SCALE
NO SCALE

CITY OF TAMPA, FLORIDA
SEWAGE DISPOSAL SYSTEM
DIVISION 4L5
PUMPING STATIONS
ODOR CONTROL MODIFICATIONS

YBOR AND UNIVERSITY PUMPING STATION ELECTRICAL

PROJ. NO.	
DWG SHEET	10 OF 10
DATE	JULY 1985
REV	1

173-37j

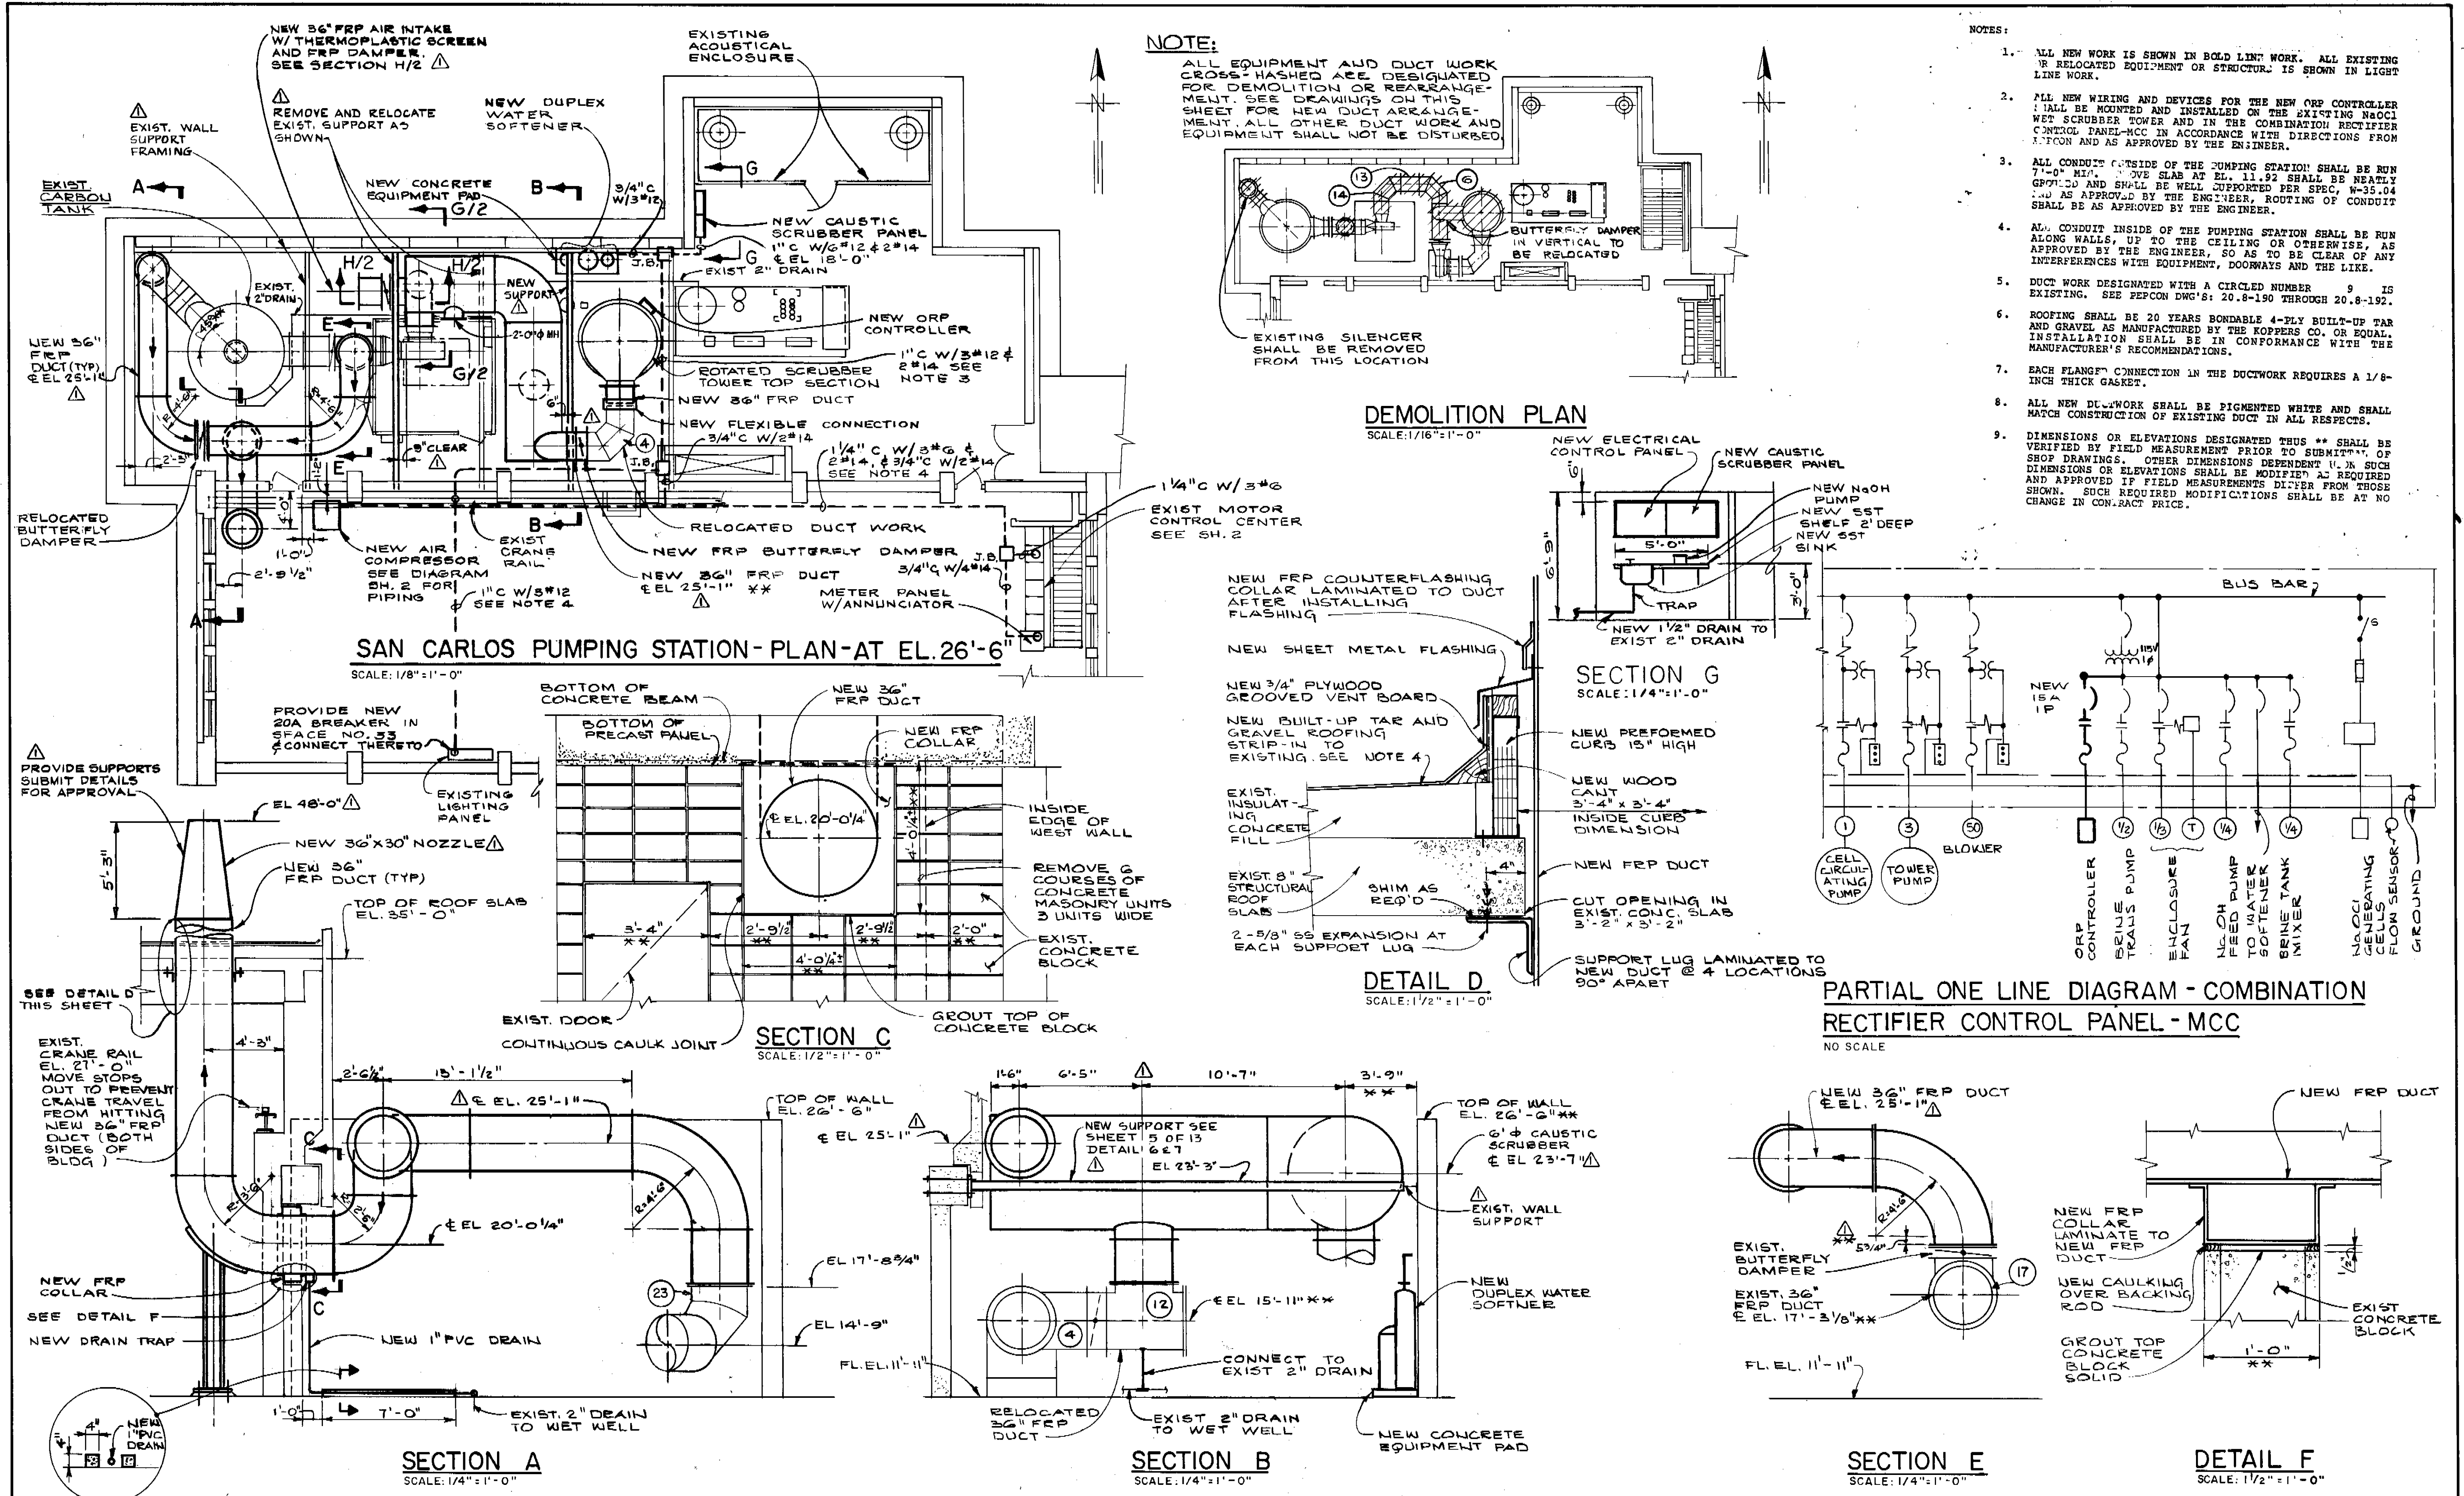

GREELEY AND HANSEN
ENGINEERS
222 S. RIVERSIDE PLAZA
CHICAGO, ILLINOIS 60606

DESIGNED JRP MPV APPROVED
DRAWN ATK
CHECKED JRP

NO.	DATE	APP.	REVISION
1	JAN 1987	JRP	AS SHOWN


SCALE:
16 0 16 32 FT 1/16" = 1'-0"
8 0 8 16 FT 1/8" = 1'-0"
4 0 4 8 FT 1/4" = 1'-0"

CITY OF TAMPA, FLORIDA
SEWAGE DISPOSAL SYSTEM
DIV. 4L-3 ODOR CONTROL EQUIPMENT
FOR THREE PUMPING STATIONS


SUPPLEMENTARY DRAWING NO. SD-3

PROJ. NO.
SHEET 1 OF 2
DATE JUNE, 1986 REV 1


1170337k

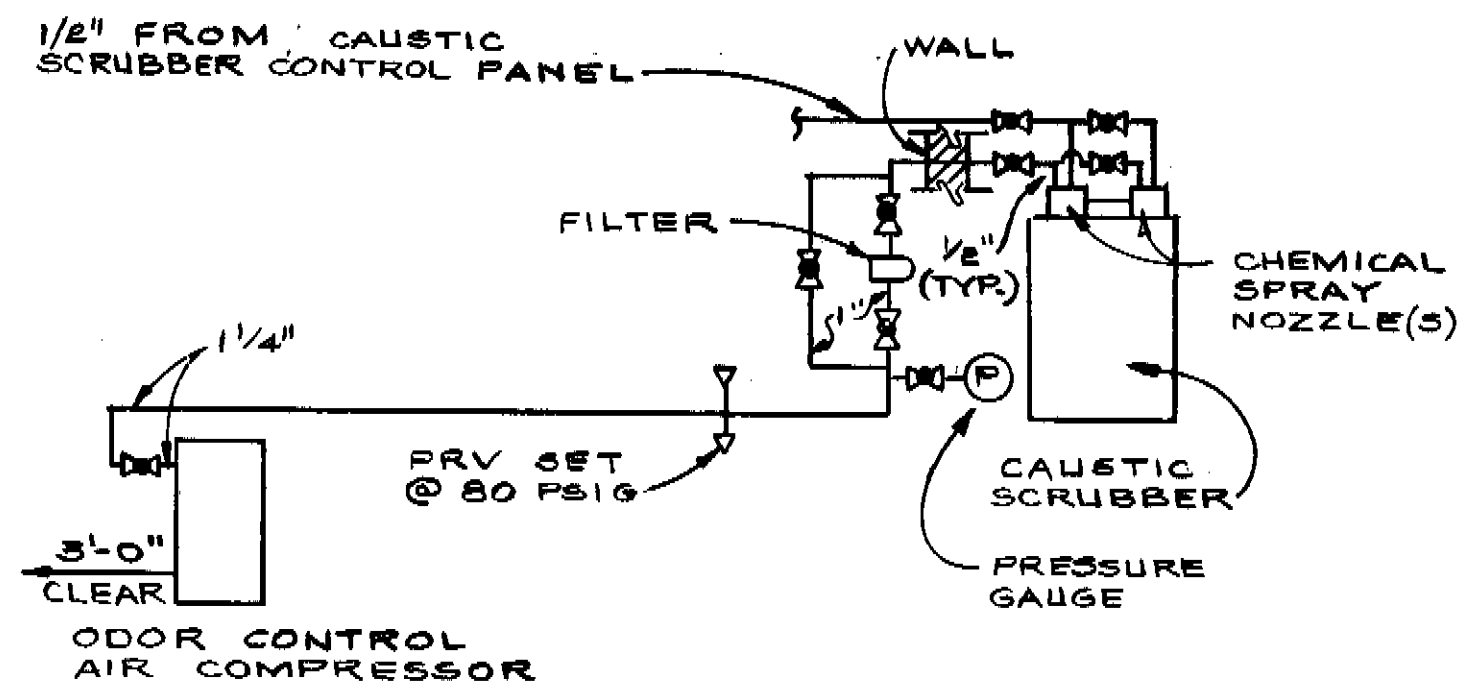


ODOR CONTROL COMPRESSED AIR DIAGRAM
NO SCALE

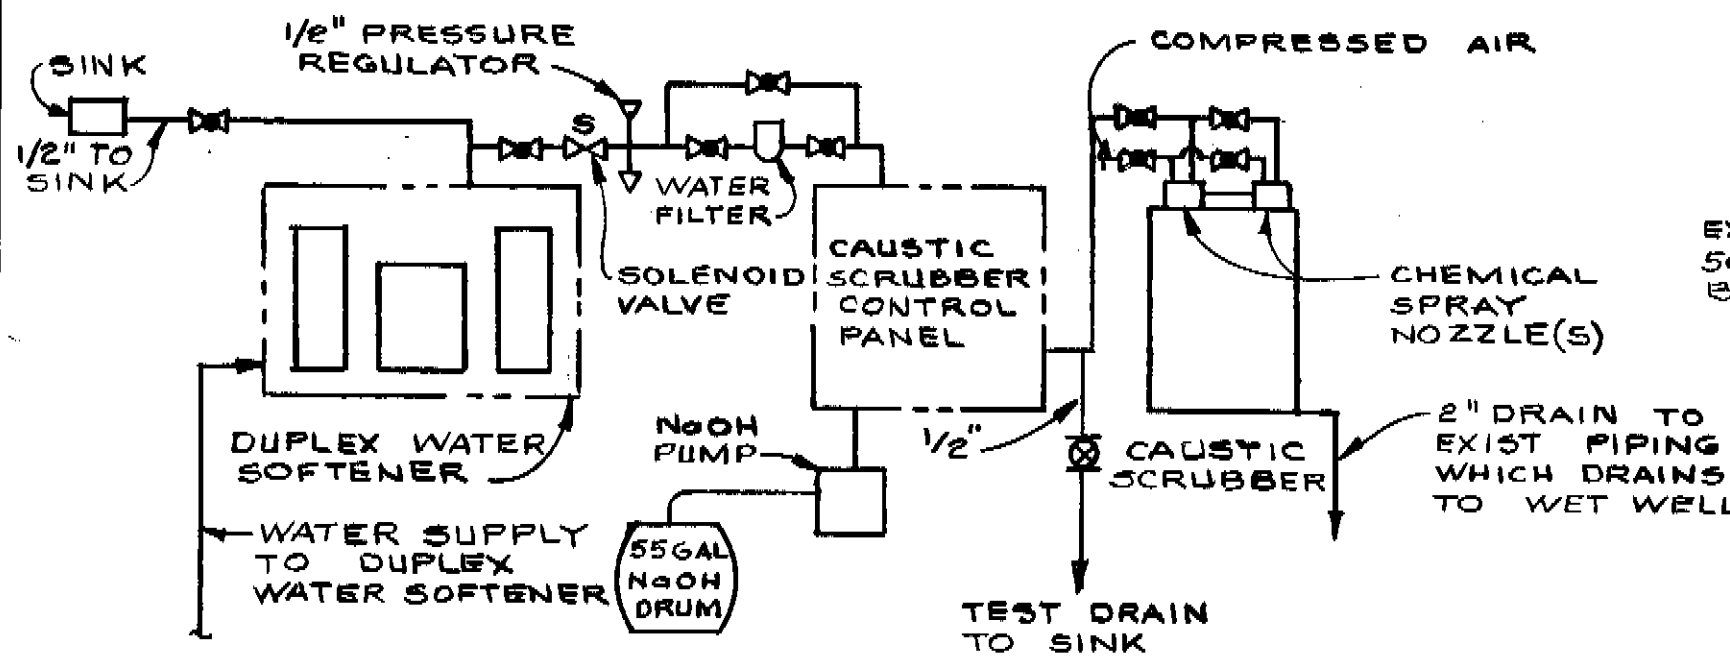


CAUSTIC SCRUBBER SYSTEM DIAGRAM
NO SCALE

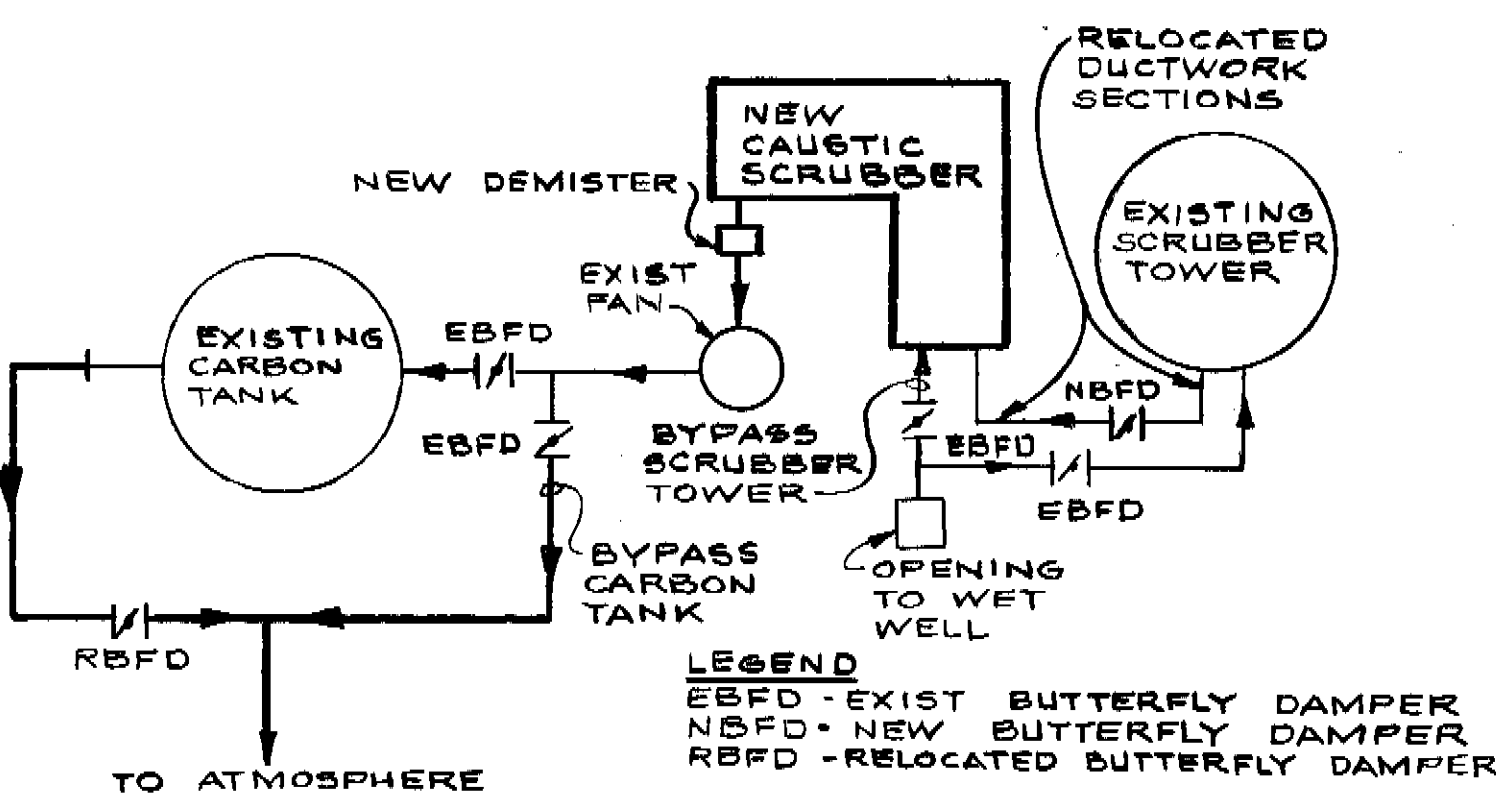


ODOR CONTROL FLOW DIAGRAM
NO SCALE

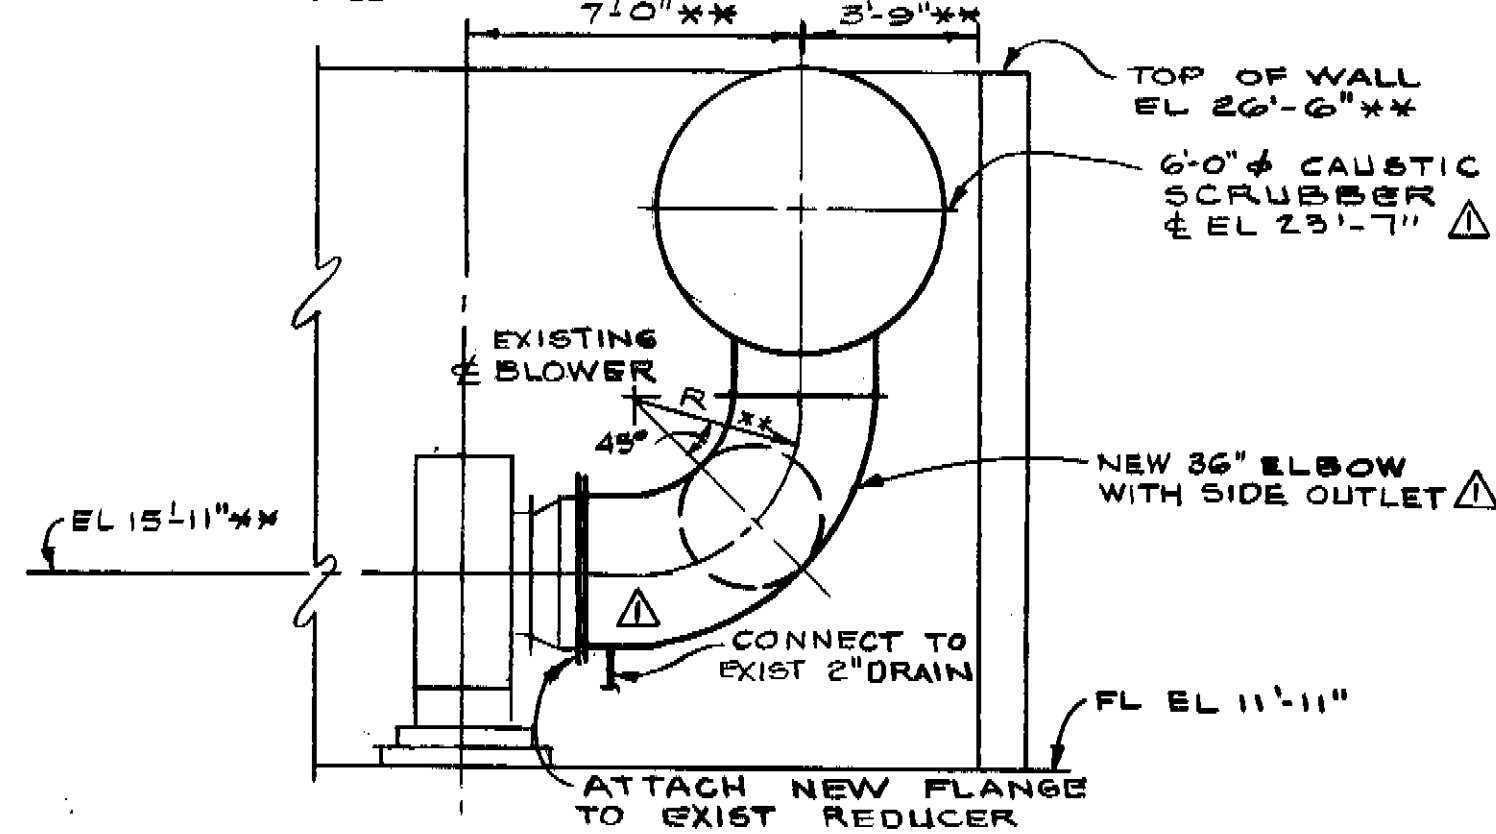


SECTION G/I
SCALE: 1/4" = 1'-0"

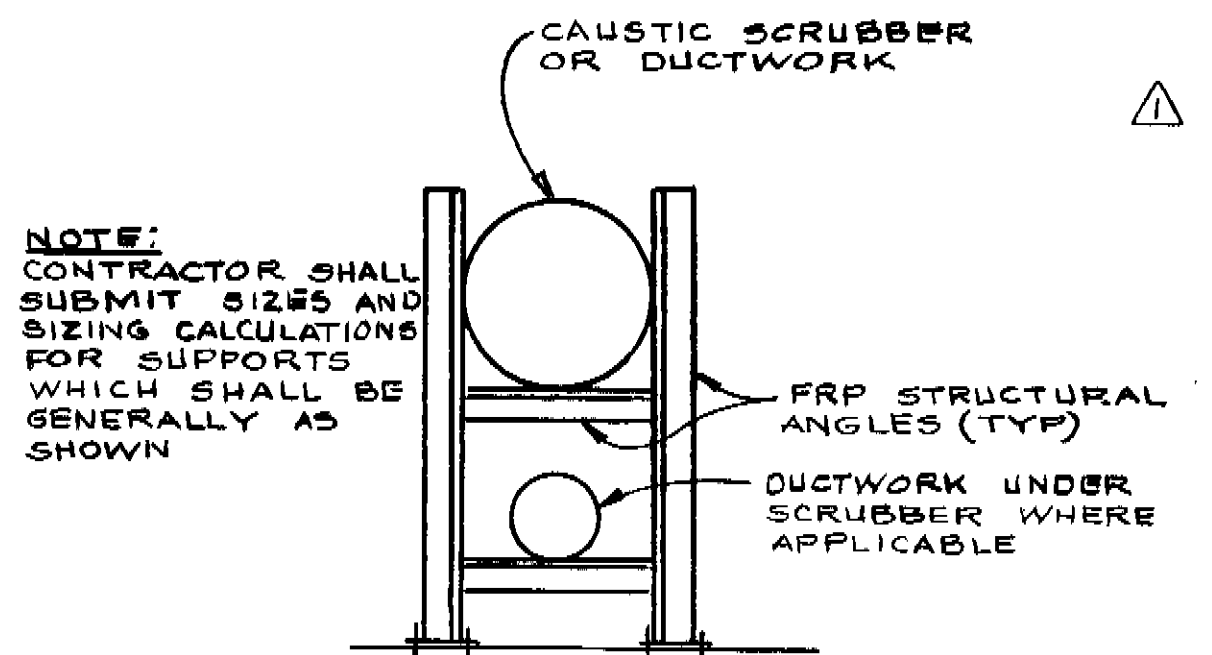


DUCTWORK AND CAUSTIC SCRUBBER SUPPORT DETAIL
NO SCALE

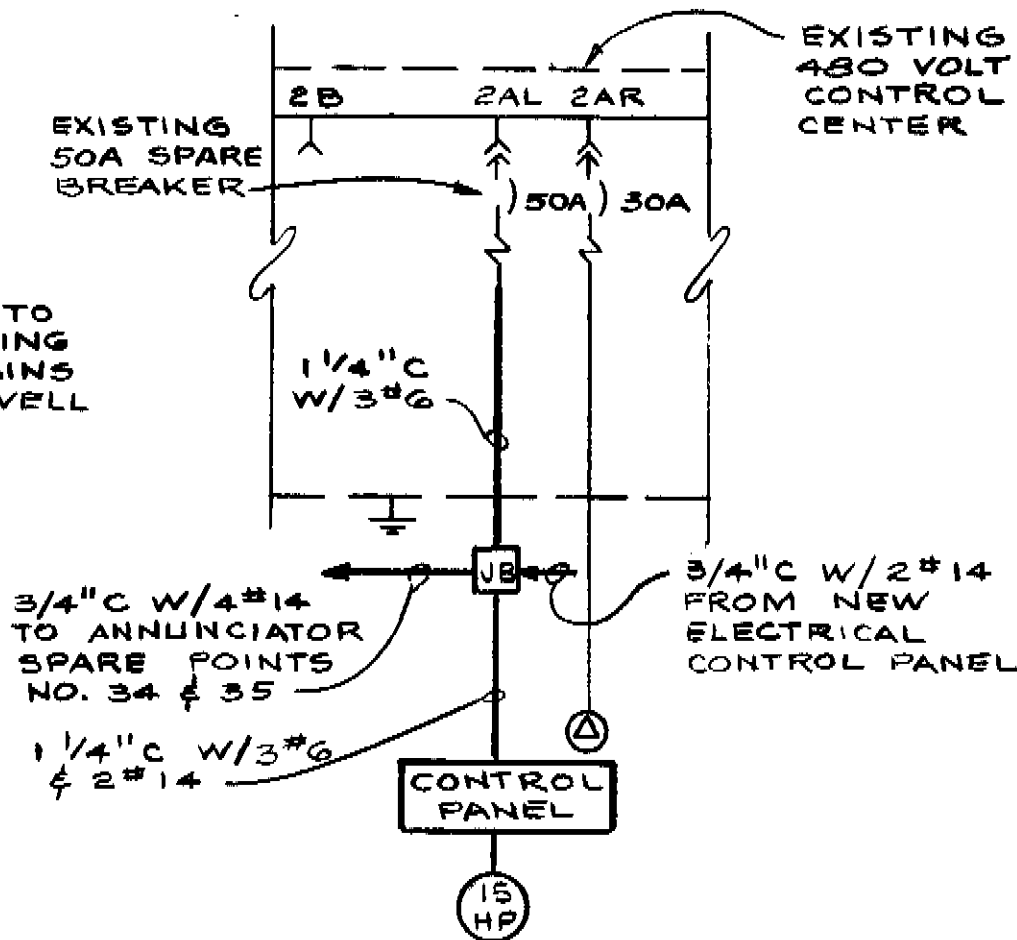

PARTIAL ONE LINE DIAGRAM
NO SCALE

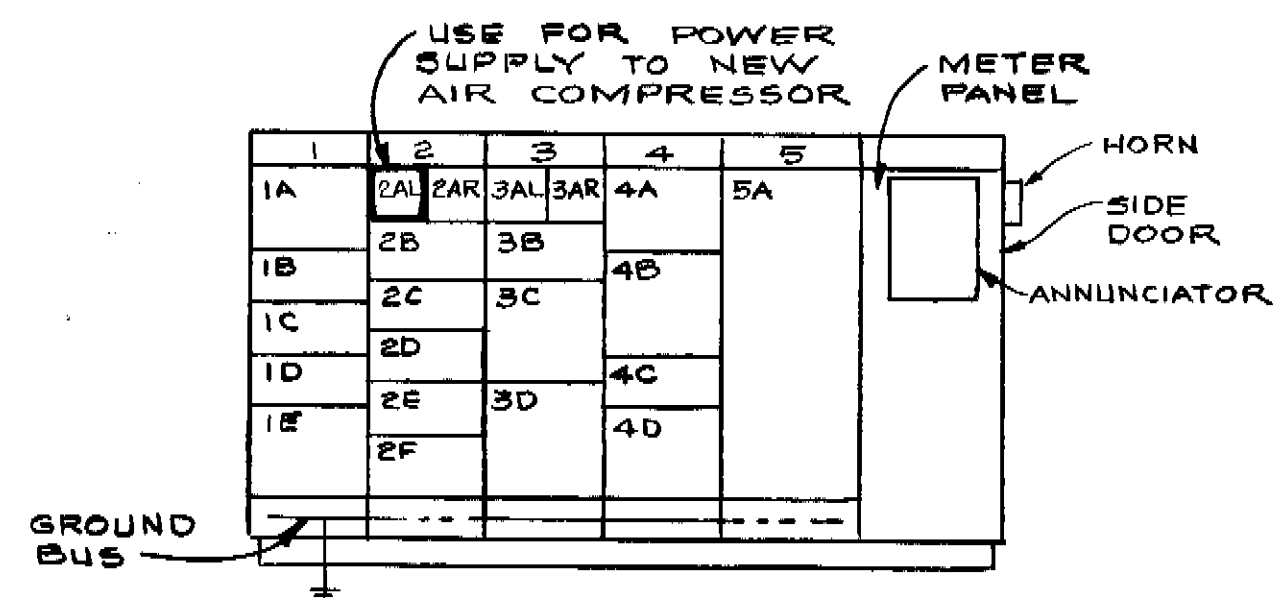

CONTROL CENTER FRONT VIEW
NOT TO SCALE

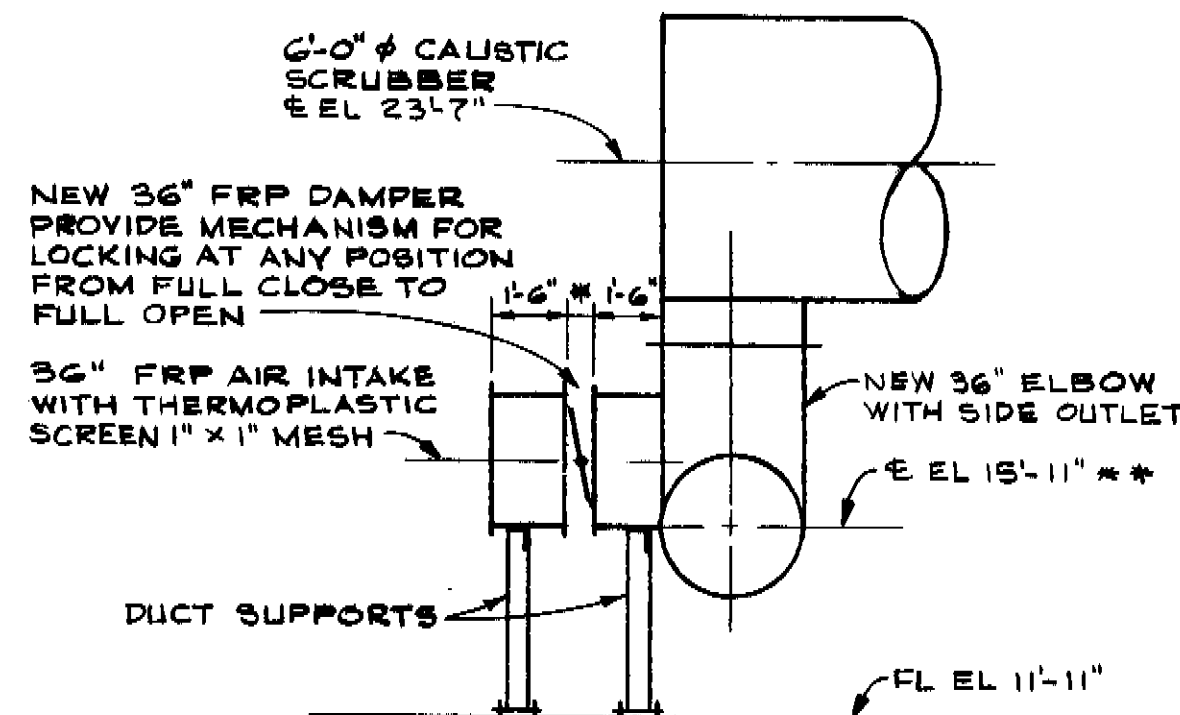

SECTION H/I
SCALE: 1/4" = 1'-0"

SPECIFICATIONS


- GENERAL**
Unless shown or specified otherwise, all Workmanship and Materials shall conform to the Division 413 Contract Documents.
- CAUSTIC SCRUBBER**
The new Caustic Scrubber shall be designed to neutralize all acids and acidic compounds present in the treated air stream from the existing NaOH Wet Scrubber Tower. The new Caustic Scrubber shall be of the size and shape shown, arranged to fit in the available space and have a retention time of approximately 3 seconds based upon an air flow rate of 12,300 cfm. The new Caustic Scrubber shall be designed to use a "once through" solution of NaOH and softened water to neutralize all acids and acidic compounds in the 12,300 cfm air stream based upon 100 percent humidity and an inlet pH range of 1.0 to 6.0. The pH of the spent chemical to drain shall be in the range of 7.5 to 8.0. Softened water consumption shall not exceed 1.0 gpm. The new Caustic Scrubber shall be constructed of FRP meeting the requirements of the Workmanship and Materials section headed "Duct work and Dampers" and shall be chemically resistant to the caustic solution. The new Caustic Scrubber shall be equipped with a chemical distribution device or devices, as required, to supply the caustic solution so as to cause intimate contact between the chemical and the air stream to provide the required acid neutralization. The new Caustic Scrubber shall be as manufactured and supplied by QUAD Environmental Technologies Corp., Highland Park, IL, or equal.
- AIR COMPRESSOR**
The new Air Compressor, shall be of the rotary screw type, having a minimum rated capacity of not less than 60 cfm at 110 psig, driven by a 15 HP 460 volt, 3 phase, 60 hertz electric motor. Final capacity and pressure requirement shall be as required by the manufacturer. The supplier of the new Caustic Scrubber. The new air compressor shall be a completely factory assembled package, housed in an acoustical enclosure, and shall be Model SK 18 as manufactured by Kaeser Compressors, Fredericksburg, VA, or equal.
An air compressor malfunction shutdown alarm contact shall be provided by the caustic scrubber manufacturer and shall be wired to a spare alarm point of the existing pumping station annunciator.
- CHEMICAL METERING PUMP**
The chemical metering pump shall be positive displacement, diaphragm type pump. Output volume shall be adjustable while pump is in operation from zero to maximum capacity. Adjustment shall be by means of readily accessible dial knobs, one for changing stroke length and the other for changing stroke frequency. Both knobs shall be located opposite the liquid handling end. Control of metering pump shall be selectable between internal and external pulsing by means of a 3-position HAND-OFF-AUTO switch. When in the HAND position, metering pump capacity shall be manually adjustable by means of the pump mounted knobs. When in the AUTO position, metering pump capacity shall be automatically adjusted by the automatic chemical pacing controls specified hereinafter. The chemical metering pump shall be capable, without a hydraulically backed diaphragm, of injecting chemicals against pressures up to 100 psig.
The size and capacity of the chemical metering pump shall be determined by the caustic scrubber manufacturer-supplier to provide the required quantity of NaOH to neutralize the compounds specified above under the heading "Caustic Scrubber."
The pump drive shall be totally enclosed with splash proof control panel and no exposed moving parts. Solid state electronic motor shall be fully encapsulated. Electronics shall be housed in chemical resistant enclosure at the rear of the pump for maximum protection against chemical spillage. The chemical metering pump shall be 120 volt, single phase 60 hertz.
Chemical metering pump housing shall be of chemically resistant glass fiber reinforced thermoplastic with a glass fiber reinforced polypropylene solenoid carrier. All exposed fasteners shall be stainless steel. Chemical metering pump valves shall be ball type, with ceramic balls setting on combination valve seat and seal ring. Valve seat and seal ring shall be renewable by replacing only the combination seat-seal ring. Pump head shall be of PVC material. Fittings and connections at pump head shall be PVC and/or polypropylene.
- CAUSTIC SCRUBBER CONTROL PANEL**
The Caustic Scrubber Control Panel shall be provided complete with all required piping, gauges, regulators, meters, valves and all other such devices required to dilute and deliver the required quantity of liquid chemicals to the caustic scrubber. The Panel shall be arranged for wall mounting as shown and shall have fittings properly labeled and ready for field connection to water, chemicals and discharge piping.
- ELECTRICAL CONTROL PANEL**
The electrical control panel shall be a NEMA 3R enclosure constructed of minimum 12 gauge Type 304 stainless steel and shall be adequately reinforced to support all components mounted therein without distortion, bowing or deflection. The electrical control panel shall be provided with a continuously hinged (vertical along left side) door with a heavy duty handle with a hasp for padlock and a 3 point catch mechanism.
Devices to be provided in the electrical control panel shall include, but may not be limited to the following:
a. Power disconnect switch with system on indicator light.
b. Water On/Off switch and On indicator light (controls water solenoid valve).
c. A chemical system power switch with On indicator light (provides power to metering pump and automatic chemical pacing controls).
- AUTOMATIC CHEMICAL PACING CONTROLS**
Automatic chemical pacing controls shall be furnished to provide reliable automatic adjustment of the chemical feed rates of the chemical metering pump so that the pH of the spent chemical to drain is in the range of 7.5 to 8.0. It is the sole responsibility of the Caustic Scrubber manufacturer to design, select and furnish such automatic chemical pacing controls. The automatic chemical pacing controls and a complete description of operation including wiring diagrams and schematics shall be submitted to the Engineer for approval.
- PIPING, VALVES, GAUGES, SWITCHES AND OTHER DEVICES**
Piping for water and compressed air shall be copper pipe and fittings meeting the requirements of the Workmanship and Materials section headed "Miscellaneous Pipe and Fitting". All pipe and fittings for chemical service shall be of plastic pipe of the proper type and formulation for the chemical service employed.
Valves for water and compressed air shall be of the types shown and shall meet the requirements of the Workmanship and Materials section headed "Valves." Valves in chemical pipelines shall be of plastic of the proper type and formulation for the chemical service employed.
Gauges, switches and all other devices shown or required shall be constructed of corrosion resistant materials such as plastic or stainless steel and shall be suitable in all respects for the service employed.
A liquid level switch shall be provided to shut down the NaOH chemical metering pump when liquid level in the drum is low and provide a low level alarm signal to a spare alarm point in the existing pumping station annunciator. The switch shall be an encapsulated reed type activated by a foamed polypropylene float mounted in a PVC float tube. The switch assembly shall be mounted in a corrosion resistant glass reinforced polypropylene housing.
- BUTTERFLY DAMPER**
Butterfly dampers shall be constructed of glass fiber reinforced polyester (FRP). Dampers shall be "Xerxes" 36-inch FRP damper with stainless steel shaft stubs and teflon shaft bushings and locking external position handle, or equal. Dampers shall be provided with hand wheel operators, or when mounted more than 6'0" above the slab, with chain wheel operators.
- DEMISTER**
All demister device constructed of plastic shall be installed in the duct work as shown. The demister shall be designed to effectively remove moisture from the air stream. Head loss through the demister device shall not exceed 0.2 inches water column. A one inch PVC drain connection shall be provided in the bottom of the duct as shown, and be piped to the existing drain system.
- ORP CONTROLLER**
A new ORP Controller shall be provided for the existing NaOH Wet Scrubber Tower. The ORP controller and associated ORP probe shall continuously check the oxidant concentration of the scrubbing solution. The controller shall adjust the dc output of the existing system rectifier to produce the required amount of sodium hypochlorite solution. The ORP probe shall be equipped with continuous cleaning capacity. The ORP probe and controller shall be as manufactured by the Pacific Engineering and Production Co. of Nevada.
- WATER SOFTENER**
The new water softener shall be Culligan Duplex model EB-45 or equal. Supply piping to the new water softener shall be connected to the existing hard water supply as directed by the Engineer.
- SINK AND FAUCET**
Stainless steel sink shall have overall dimension of 25 inches long, 22 inches wide and 10 inches deep, single bowl compartment, as manufactured by the Elkay Manufacturing Company, or equal. The basin shall be constructed of Type 302, 20-gauge stainless steel, with not less than 1-1/2 inch wide rim on all four sides. All inside corners of sink to 1-inch radius, vertically and horizontally, shall be rounded to spherical covers. The bottom of the sink compartment shall be pitched to a waste opening in a manner assuring complete drainage. The waste outlet shall be a center outlet. Exposed surfaces of the sinks shall receive a No. 4 finish. Overflows, plugs, strainers, tailpieces and related items shall be included.
The water faucet shall be one handle deck mount type with goose neck Model LR-2085-13L as manufactured by Elkay or equal.
- SPARE PARTS**
The following spare parts shall be provided:
a. One complete set of V-belts for the air compressor.
b. One complete NaOH chemical metering pump.
- MANUFACTURER'S REPRESENTATIVE**
The services of a qualified representative of the various manufacturers shall be provided to inspect the installation of the equipment, make any necessary adjustments, place it in initial trouble-free operation, and instruct the operating personnel in its operation and maintenance.

GREELEY AND HANSEN
ENGINEERS
222 S. RIVERSIDE PLAZA
CHICAGO, ILLINOIS 60606

DESIGNED JRP DCH
DRAWN EAJ
CHECKED JRP

APPROVED

NO.	DATE	APP.	REVISION
1	JAN 1987	JRP	AS SHOWN

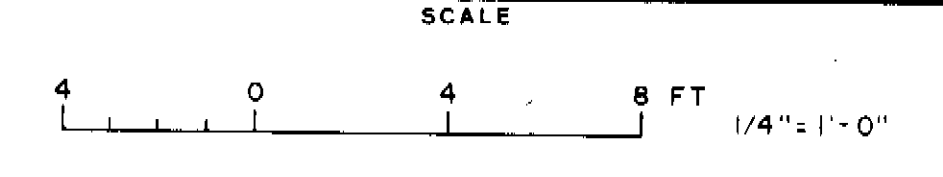

CITY OF TAMPA, FLORIDA
SEWAGE DISPOSAL SYSTEM
DIV. 4L-3 ODOR CONTROL EQUIPMENT
FOR THREE PUMPING STATIONS

SUPPLEMENTARY DRAWING NO. SD-3

PROJ. NO.
SHEET 2 OF 2
DATE JUNE, 1986 REV 1

173-371

CITY OF TAMPA


LOCATION MAP



DEPARTMENT of SANITARY SEWERS SEWAGE DISPOSAL SYSTEM PLANS

FOR ROOF MODIFICATION ACCESS COVERS OF

13th. ST. AND 131st. AVE. PUMPING STATIONS

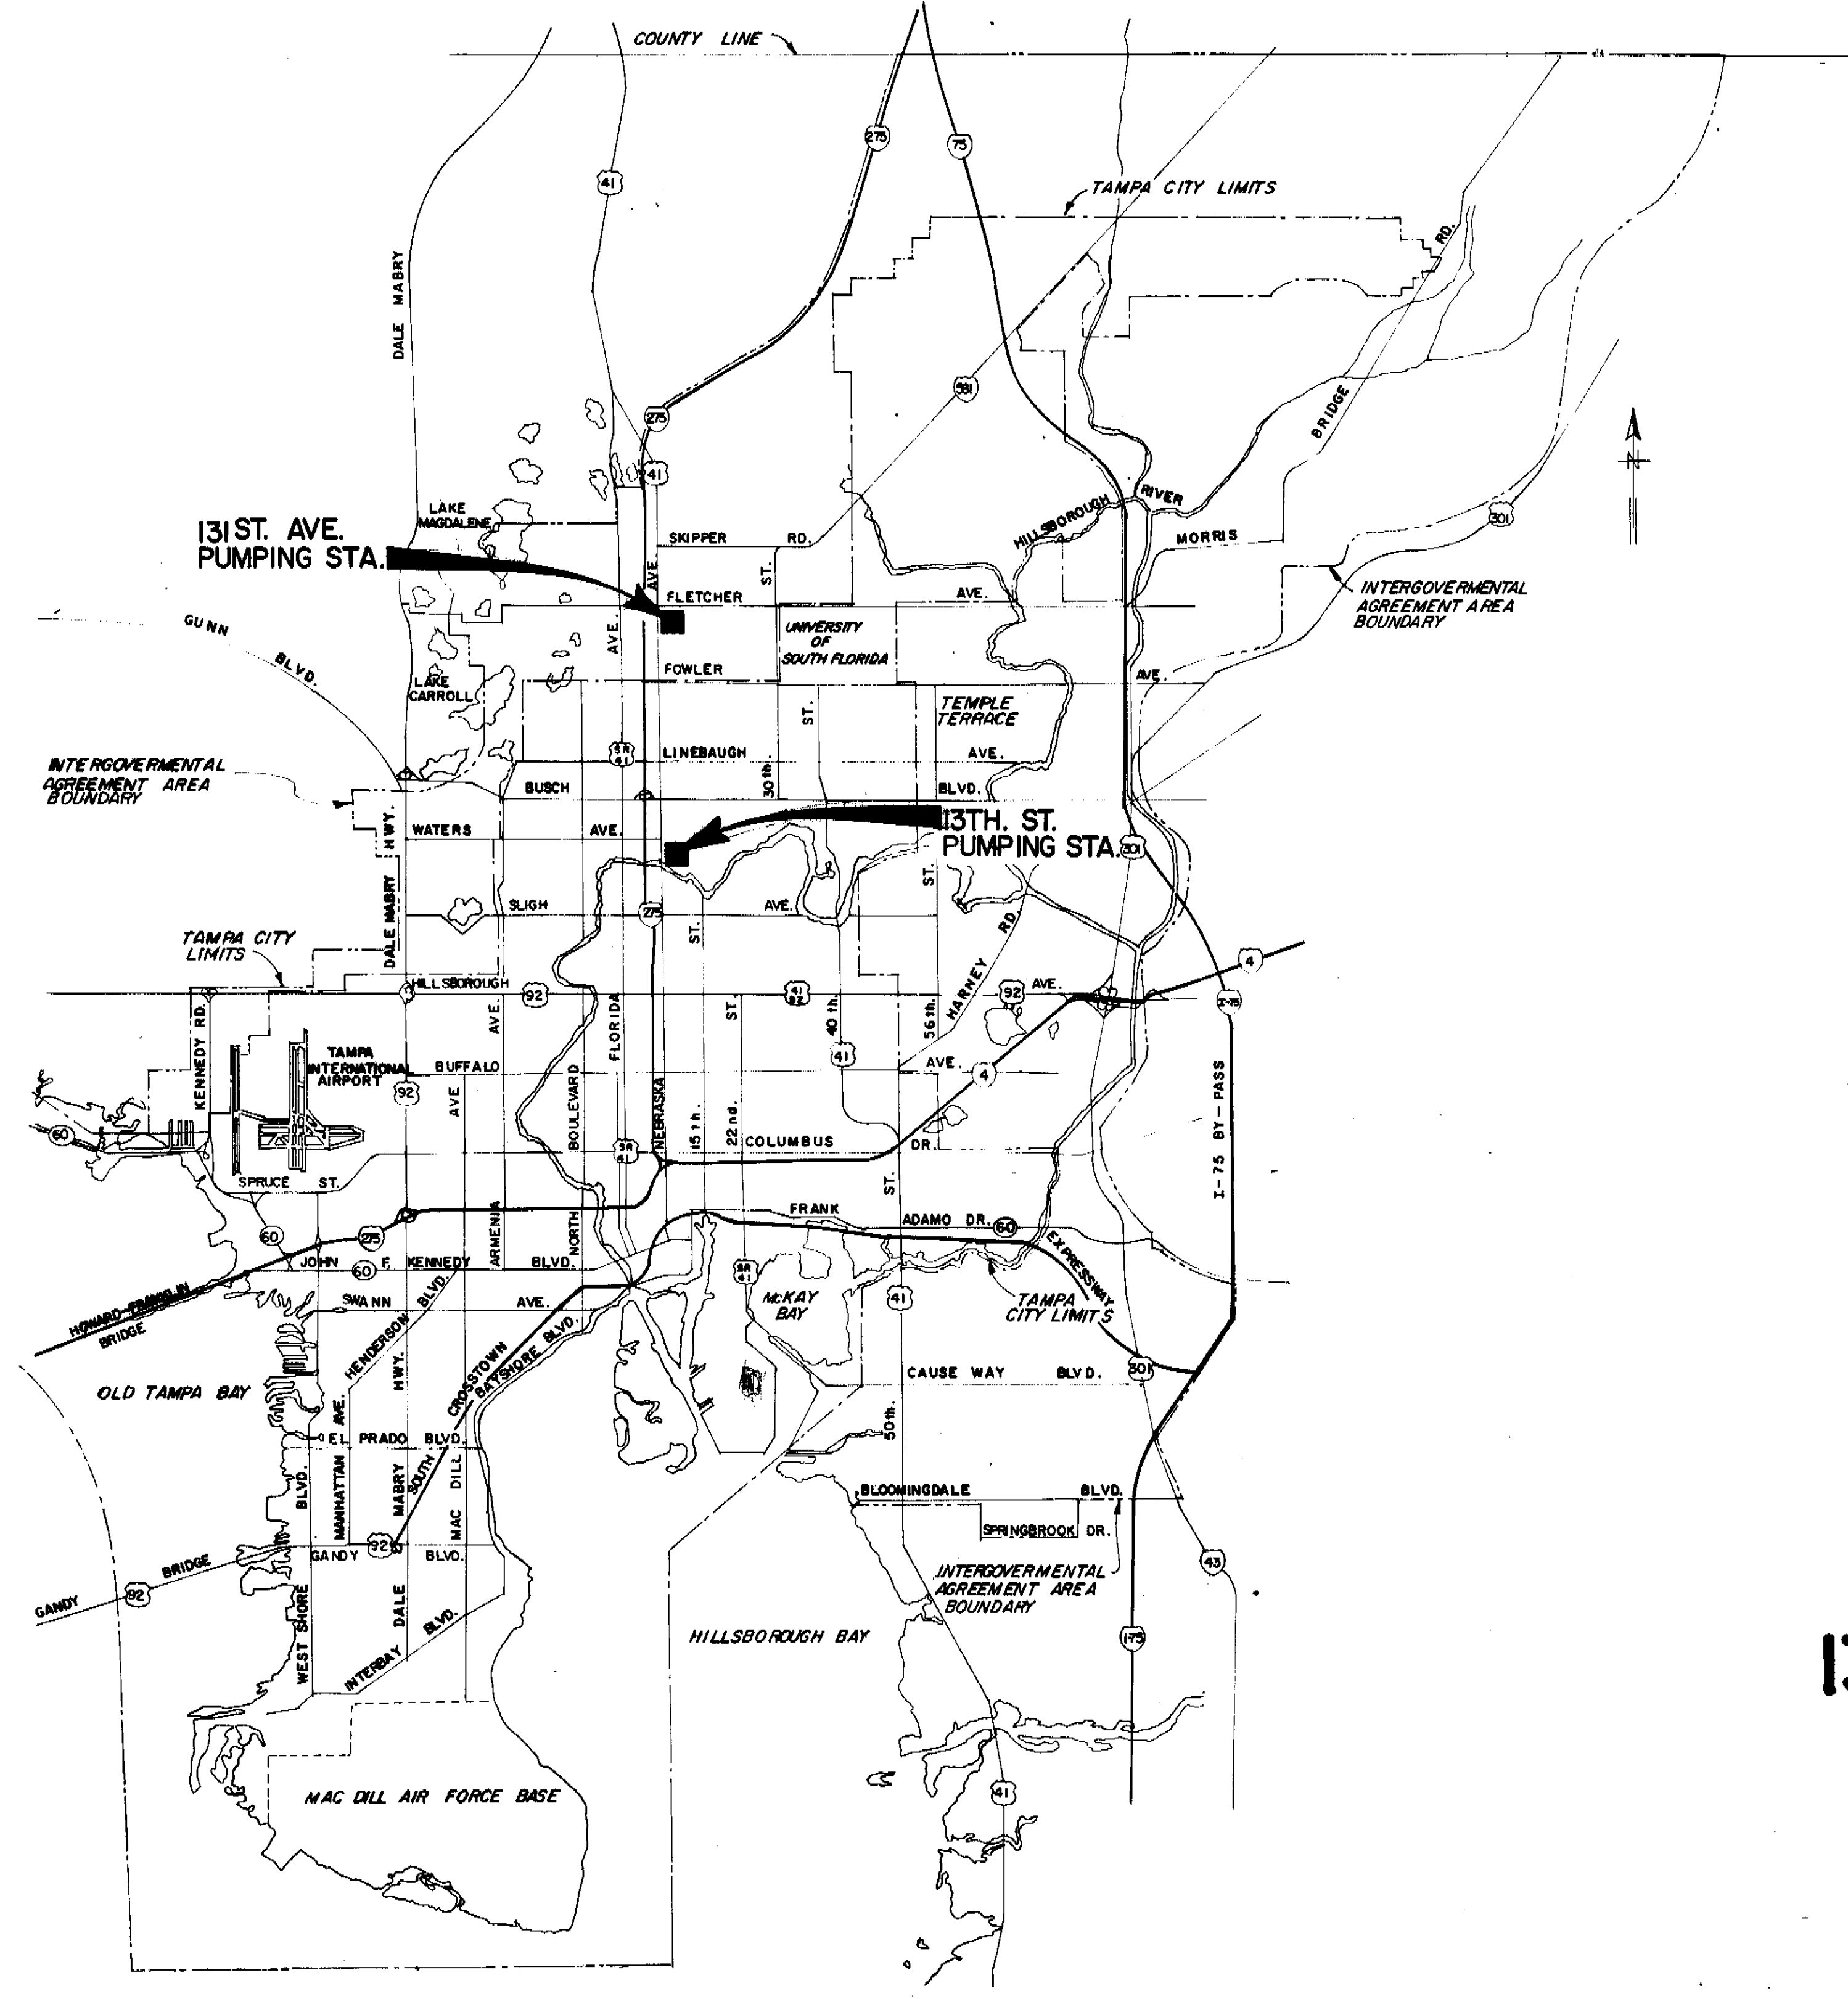

 ANDREW T. CRONBERG, P.E. # 32500 CHIEF ENGINEER DEPARTMENT of SANITARY SEWERS	DES: A. H.	APPROVED BY	NO	DATE	REVISIONS	SCALE 1" = approximately 1/4 miles	DEPARTMENT of SANITARY SEWERS CITY of TAMPA, FLORIDA RENEWAL & REPLACEMENT SEWAGE DISPOSAL SYSTEM	TITLE SHEET & LOCATION MAP	SHEET 1 OF
	DRN: E.R.		1						
	CKD: DW	JACK P. MORRIS, P.E. DIRECTOR DEPARTMENT of SANITARY SEWERS	2						
	DATE: 7-10-84		3						
			4						

C173-735(77)

GENERAL NOTES

- Slab openings to be wet saw cut. Due to the sensitive nature of the existing electrical and mechanical equipment, no water, dust or debris shall be permitted to enter the pumping station structures. To avoid this, the contractor shall construct a temporary structure directly beneath the slab opening area and may use the existing cranes to serve as plat-forms. The structure shall be completely sealed to the satisfaction of the Engineer. Refer to General Electrical note No. 4.
- The contractor shall be liable for any damage to existing equipment or structures.
- During periods when the contractor is absent from the construction site(s), the slab opening area(s) shall be covered and sealed to prevent rain, dust or debris from entering the pumping station structure(s).
- During the wet saw cut operation, the contractor shall block off the area on the ground level beneath the slab opening area. The contractor shall either post warning signs or station an employee to prevent anyone from walking in this area during the cutting and removal operation.
- Locations and elevations of existing concrete driveways have been shown to illustrate available areas for crane access. Due to the steep slope (13.7%) at the 13th St. Pumping station, special provisions may have to be made to attain a level surface for the crane.
- The existing roof slab reinforcing schedule, elevations (City of Tampa Datum) and dimensions shown are based on the best information available, but don't purport to be absolutely correct. Contractor shall verify the locations, elevations and dimensions of all existing utilities, structures and other features affecting his work prior to construction.


ELECTRICAL NOTES

- GENERAL**
- All workmanship and materials shall comply with NEC and City of Tampa Code.
 - Only copper conductors shall be used. The bonding characteristics of the new conduit shall equal the characteristics of those existing.
 - Aluminum conduit is to be used where exposed. PVC or Rigid Galvanized conduit is to be used if embedded in concrete.
 - Conduits that are to be cut must be sealed in the junction boxes on all sides of the cutting operations to prevent leakage of water (from the wet saw cut operation) into the remainder of the electrical system. After completion of the wet saw cut operation, the contractor shall blow out all water from the conduits and dry them out. Refer to General note No.2 above.
 - The contractor shall submit, to the Engineer, the procedure and final routing of conduits for approval.
 - The light fixture (131st Ave) and fan (13th St.) shall be removed, without damage, and delivered to the Electrical Division of Hookers Point AWTF 2700 Maritime Blvd., Tampa.
 - All electrical work shall be performed by a licensed electrician.


13th ST.
REF #1 and #2 Fans are each powered by three AWG #12 conductors carrying 480 V power. Prior to starting the roof cutting operation, remove the existing REF #2 conductors between the REF #2 fan and the contractor and the existing REF #1 conductors between the REF #1 fan and the existing nearest junction box or pull box on the wall of the control room.

After completion of the saw cut operation, reroute new conduit around the roof slab opening. Install three new AWG #12 copper conductors from the pull box or junction box (referenced above) to the existing REF #1 fan and verify correct rotation of fan blades.


131st AVE.
Lighting circuit #1a and #5 may be inoperative during the cutting operation. In an effort to keep the remainder of the lighting system operative, one acceptable method is to run a temporary cable from the 277/480V lighting panel to the overhead light fixture (3b) junction box located just east of REF #2 fan. Exercise caution not to obstruct the existing overhead crane. This temporary cable would substitute for 9# conductors existing within the ceiling conduit. After completion of the cutting operation and continuity of the conduits has been reestablished, new respective conductors shall be connected to the original terminations. Assure that all light fixtures perform per original schedule.

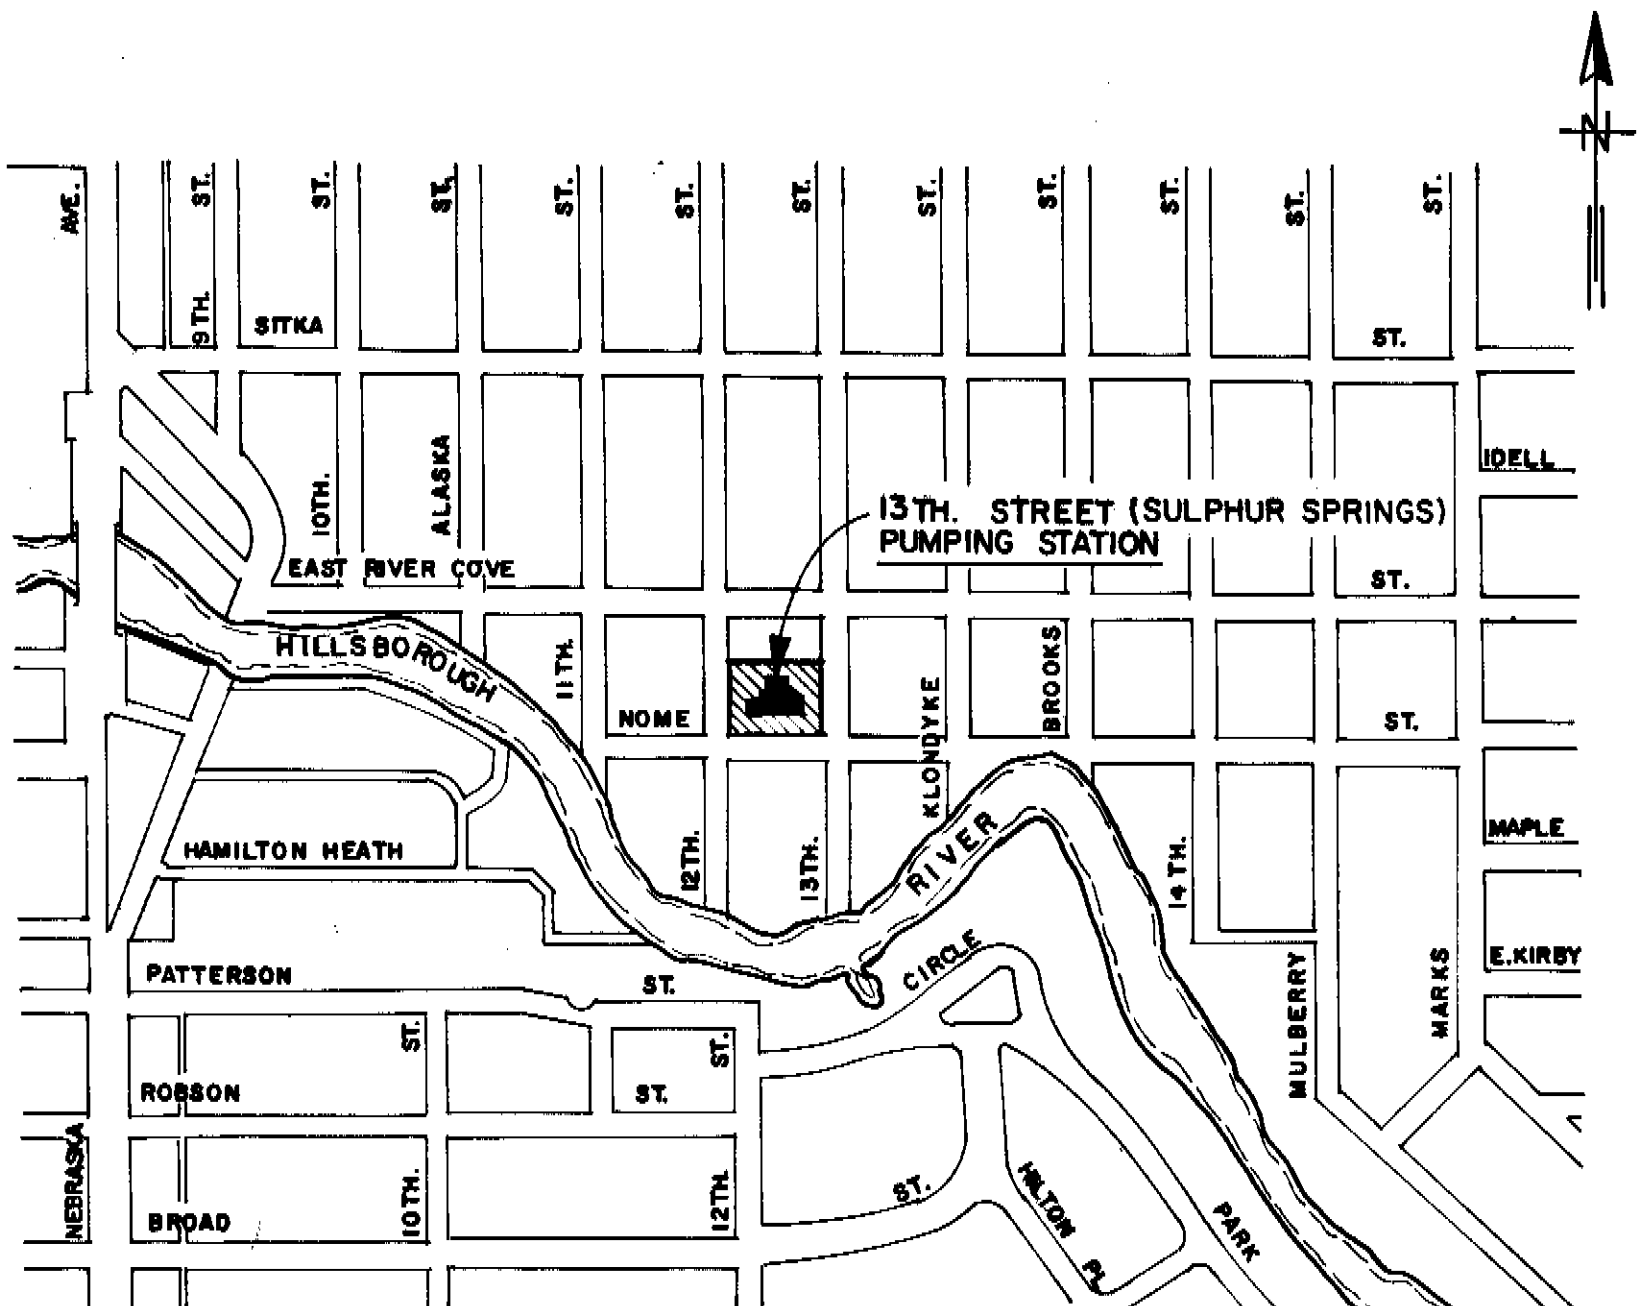


SITE PLAN
13TH. ST. PUMPING STATION
SCALE: 1" = 400'-0"

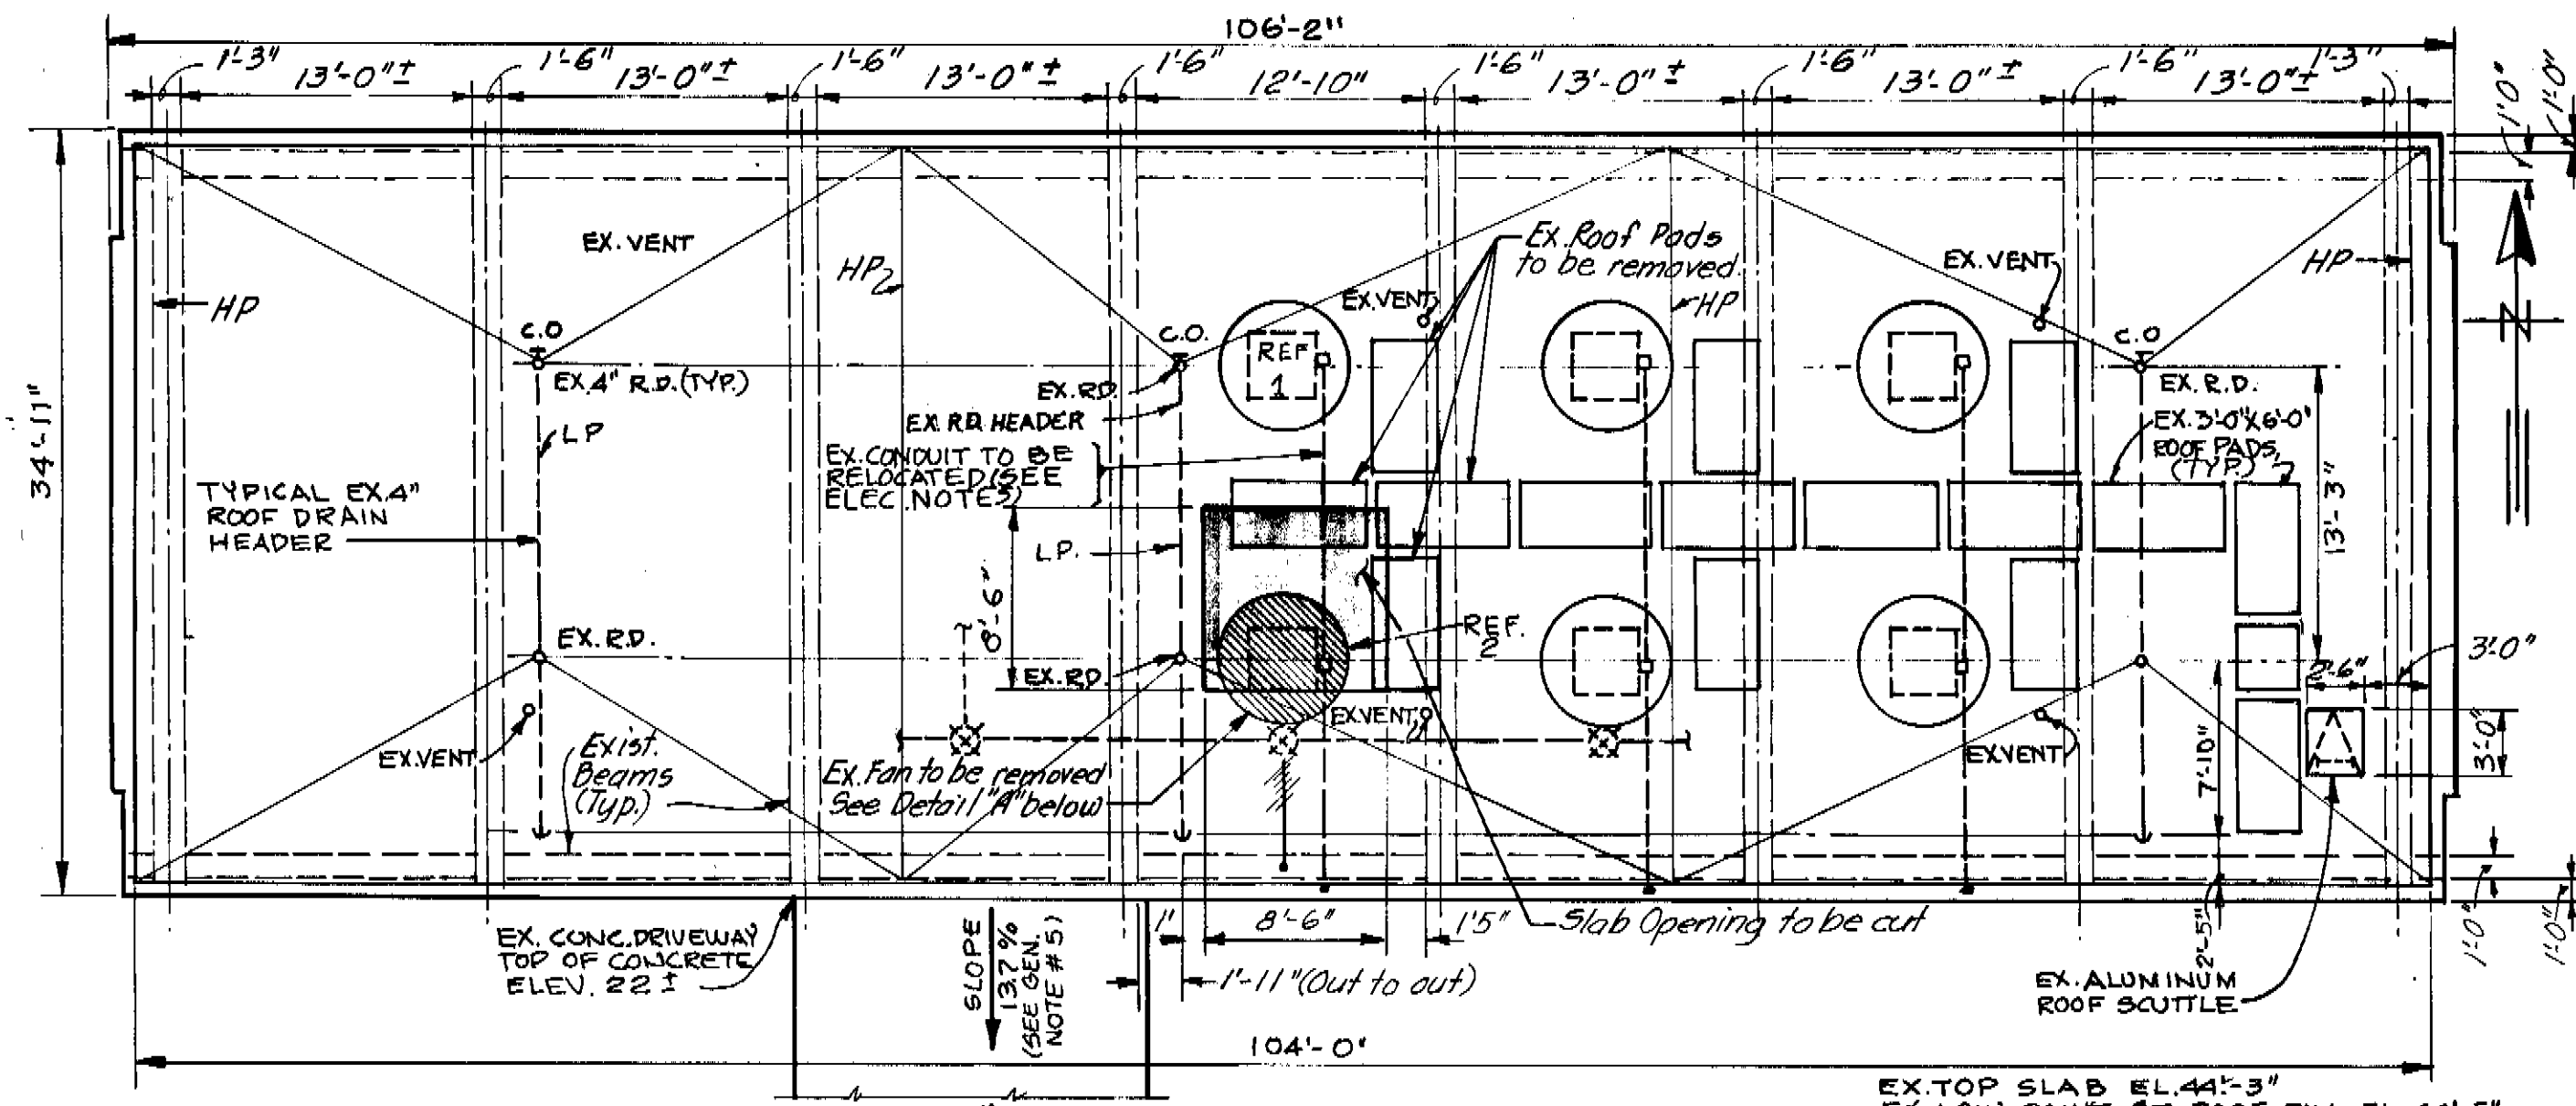


ROOF PLAN - 13th ST. PUMPING STATION.
SCALE: 1/8" = 1'-0"

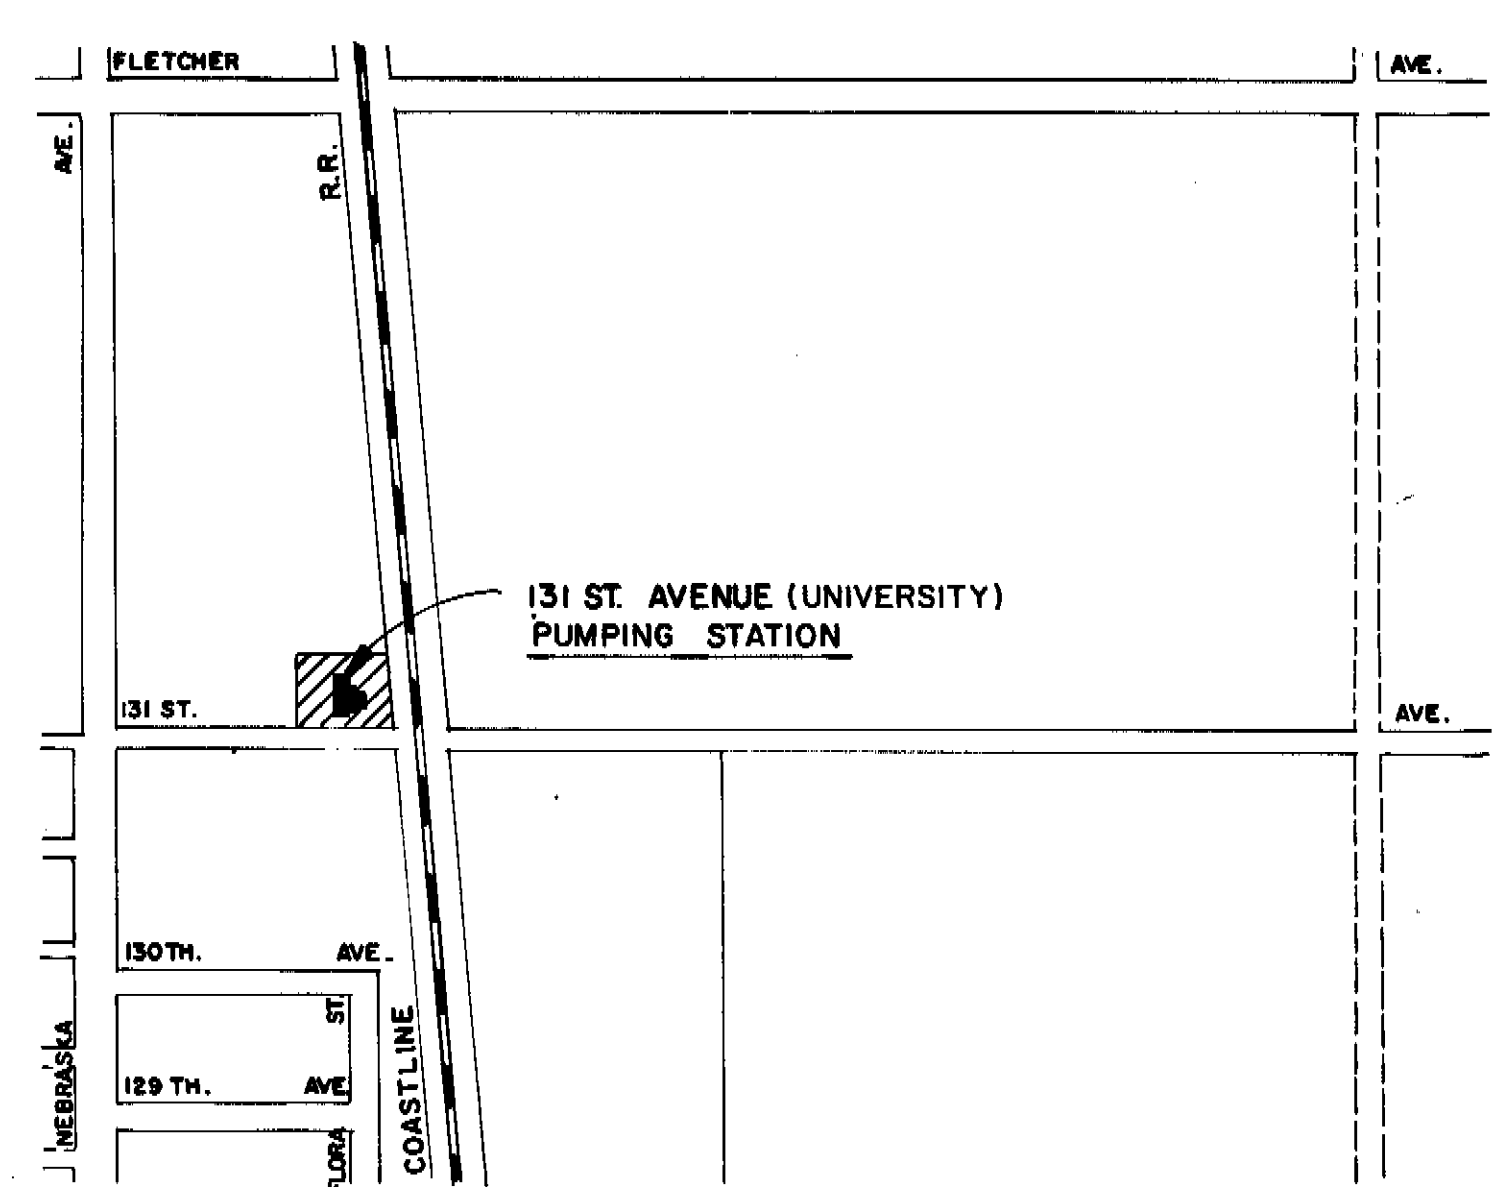

SITE PLAN
131 ST. STREET PUMPING STATION
SCALE: 1" = 400'-0"

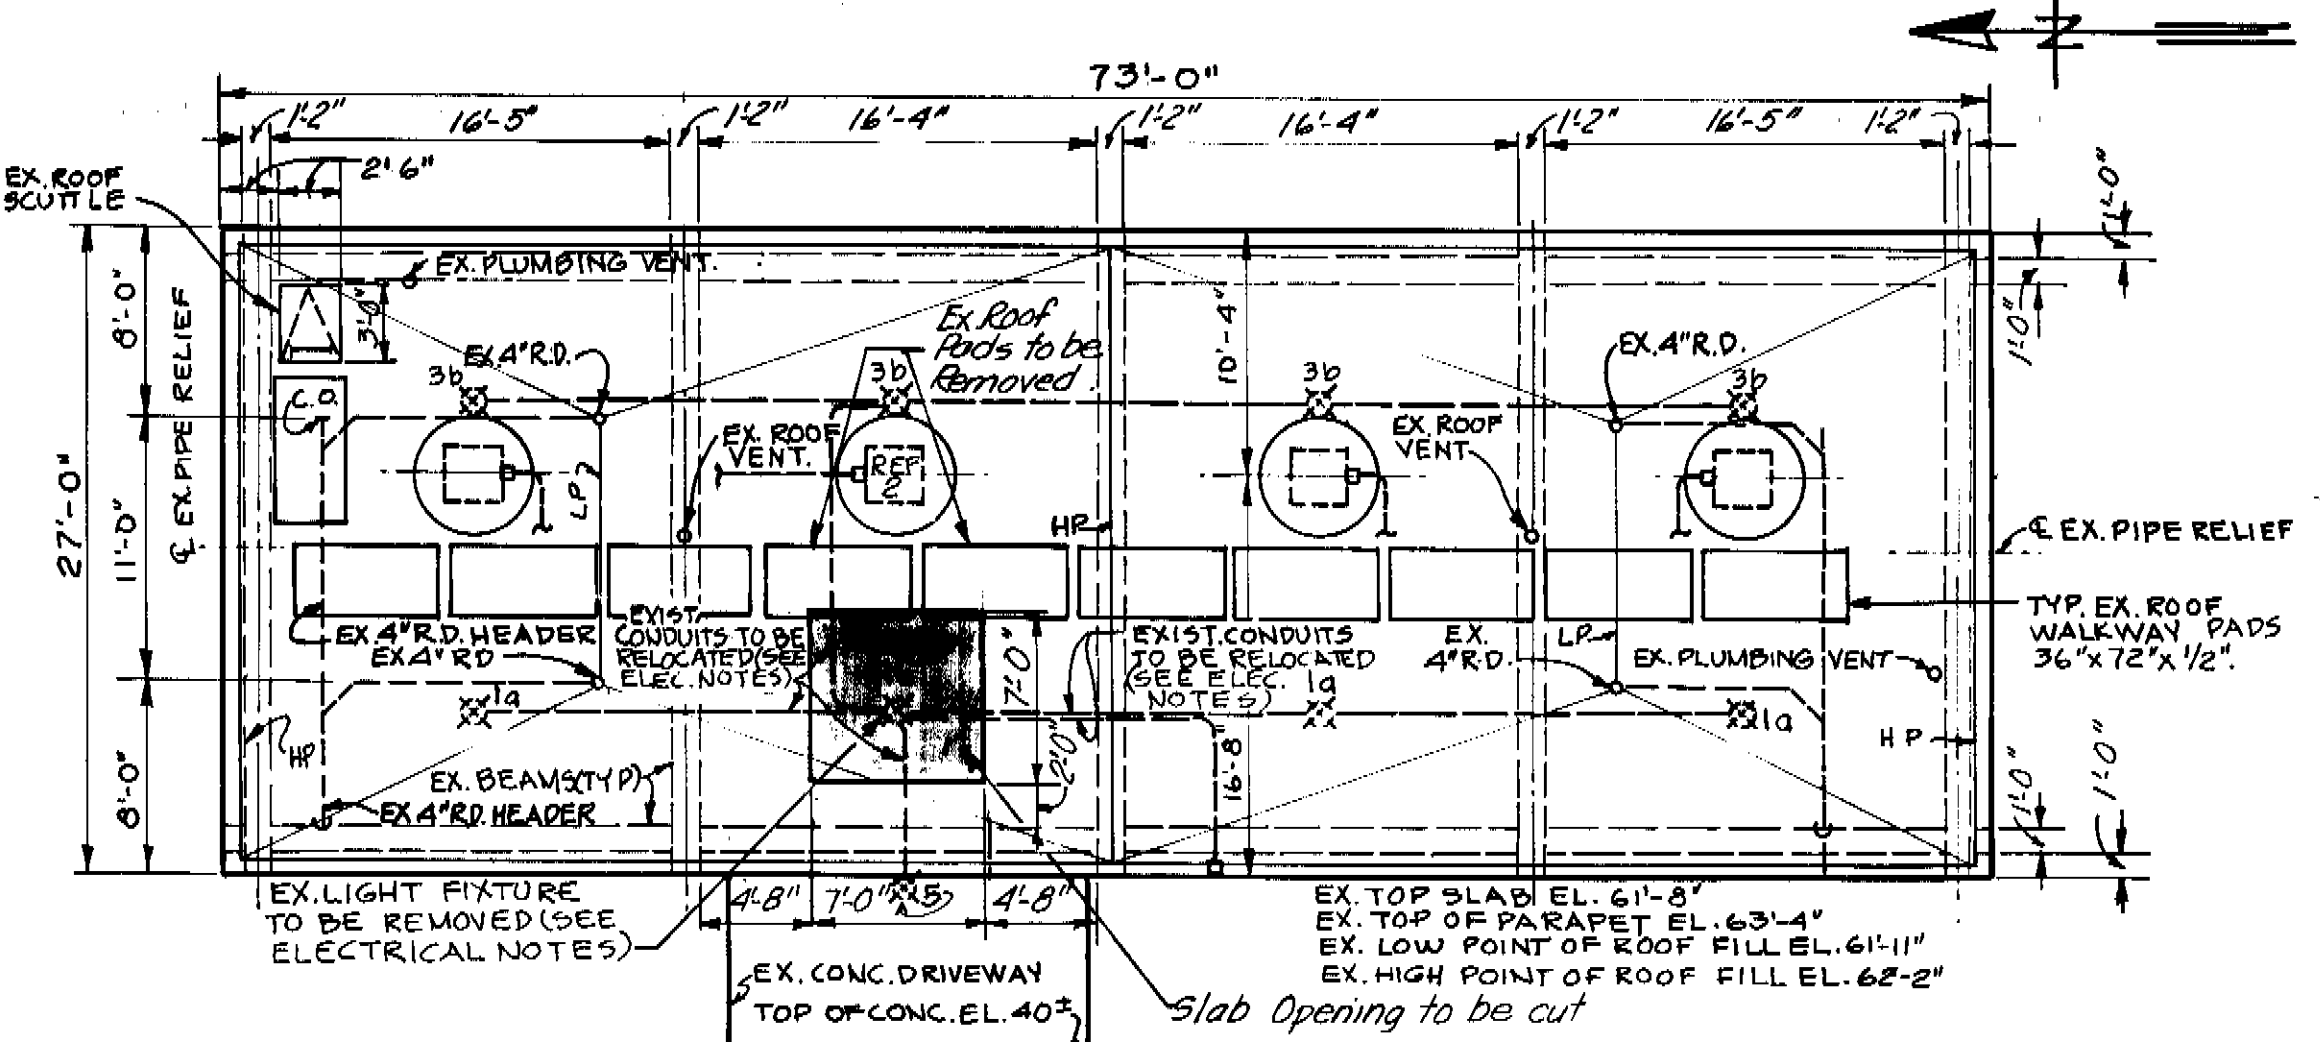

ROOF PLAN - 131st AVE. PUMPING STA.
SCALE: 1/8" = 1'-0"

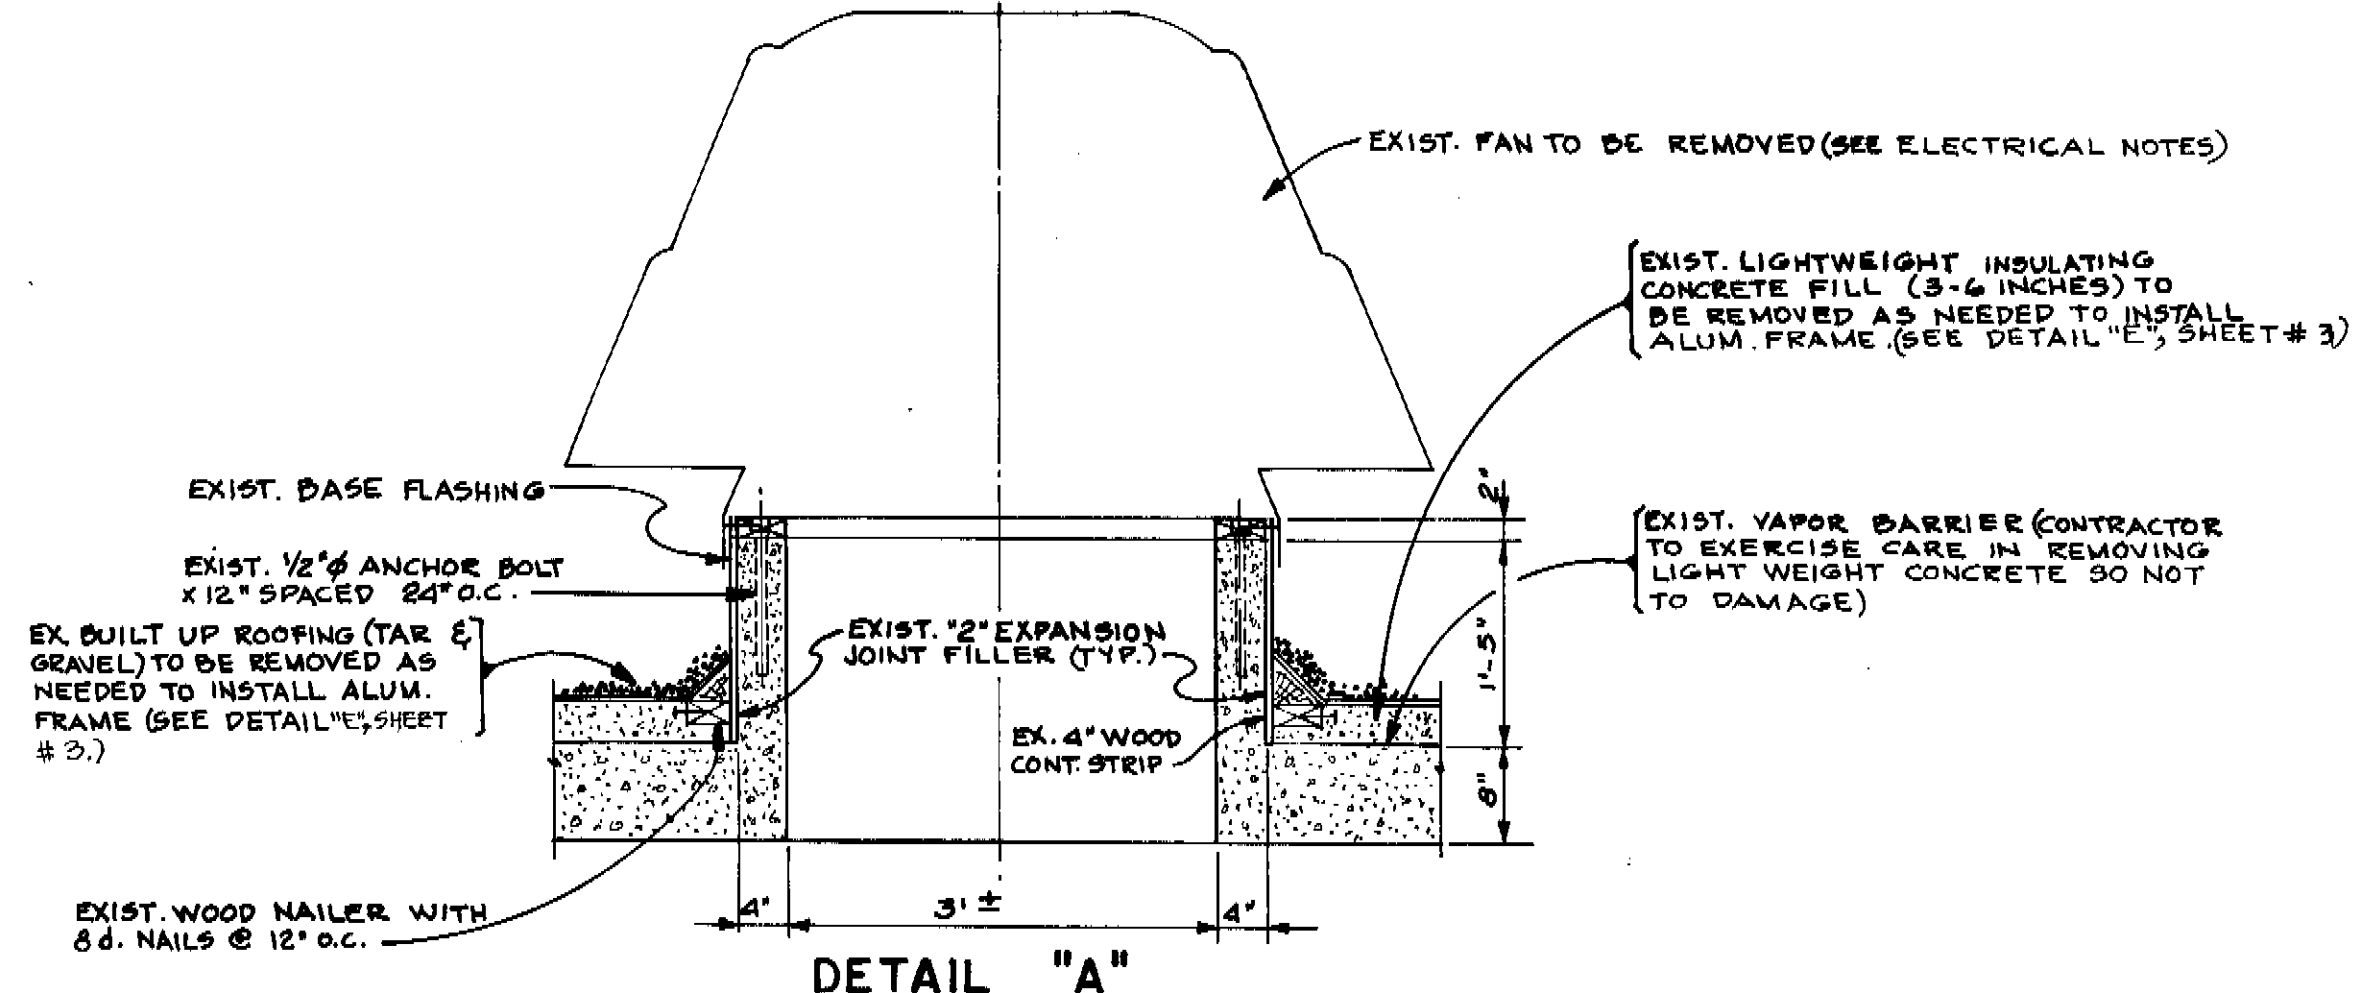

DETAIL "A"
EXISTING EXHAUST FAN TO BE REMOVED
13th ST. PUMPING STA. ONLY
(TOP OF SLAB EL. 44'-3")
NOT TO SCALE

EXISTING 8" ROOF SLAB REINFORCING SCHEDULE	
13 th ST.	#4 @ 12" o.c. T/B (North/South) #5 @ 12" o.c. T/B (East/West)
131 st AVE.	#6 @ 12" o.c. T/B (North/South) #5 @ 12" o.c. T/B (East/West)

DES: A. H.
DRN: E. R.
CKD: DW
DATE: 7-10-84

APPROVED BY
JACK P. MORRIS, P. E.
DIRECTOR
DEPARTMENT OF SANITARY SEWERS

NO	DATE	REVISIONS
1		
2		
3		
4		
5		


SCALE
AS SHOWN

DEPARTMENT OF SANITARY SEWERS
CITY OF TAMPA, FLORIDA
RENEWAL & REPLACEMENT
SEWAGE DISPOSAL SYSTEM


ROOF MODIFICATION ACCESS COVERS
13th ST. & 131st AVE. PUMPING STATIONS

SHEET
2
OF

C173-737 (87)

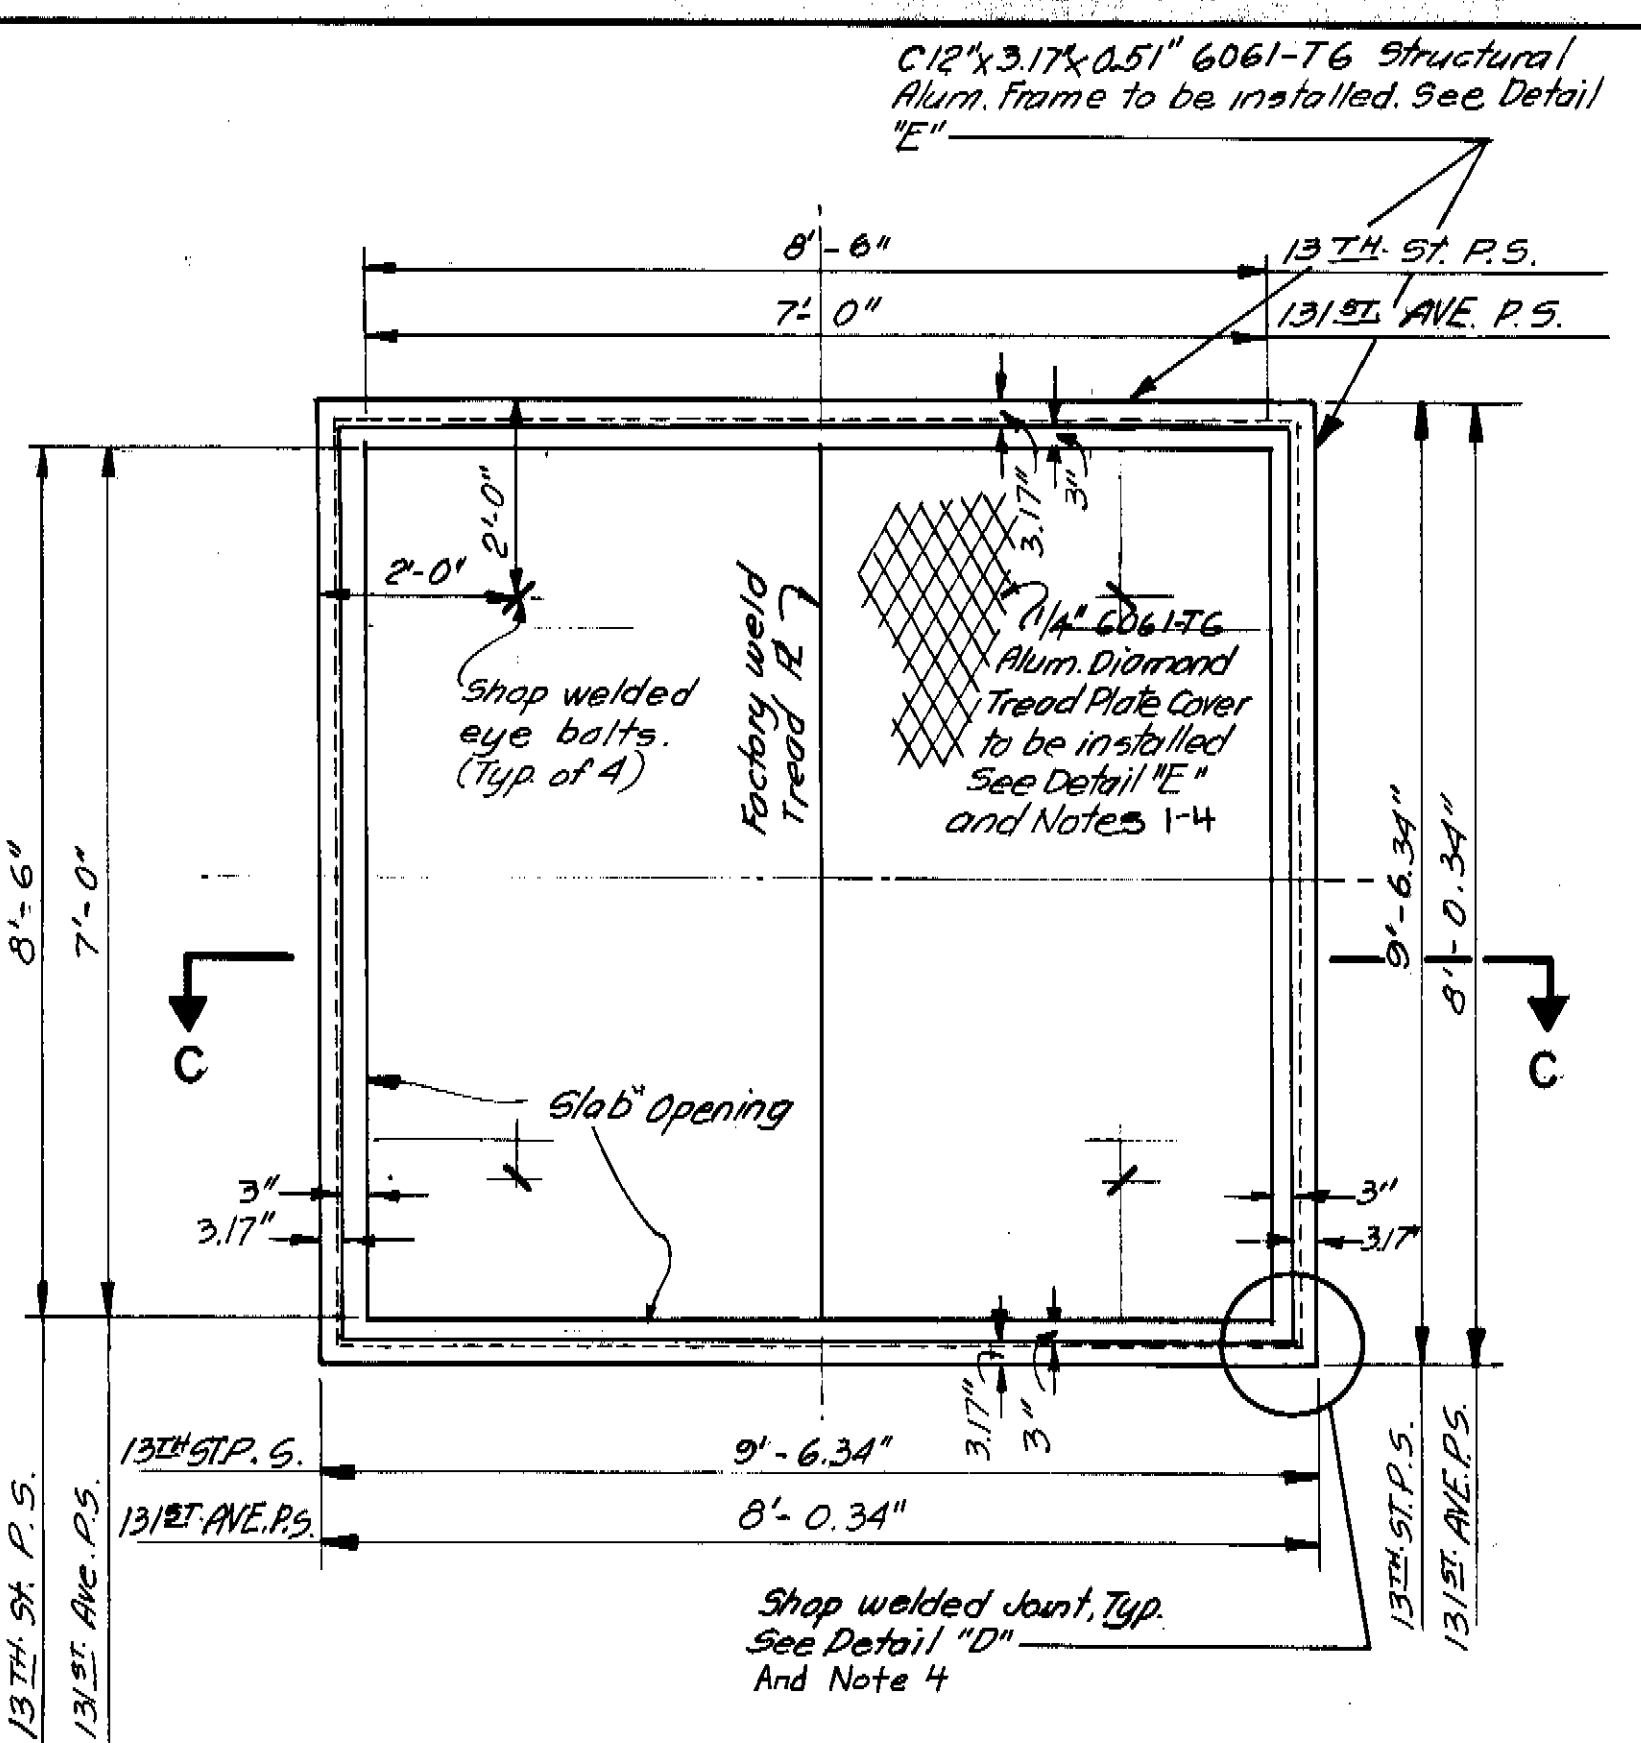


PLAN ALUM. FRAME AND COVER
NOT TO SCALE

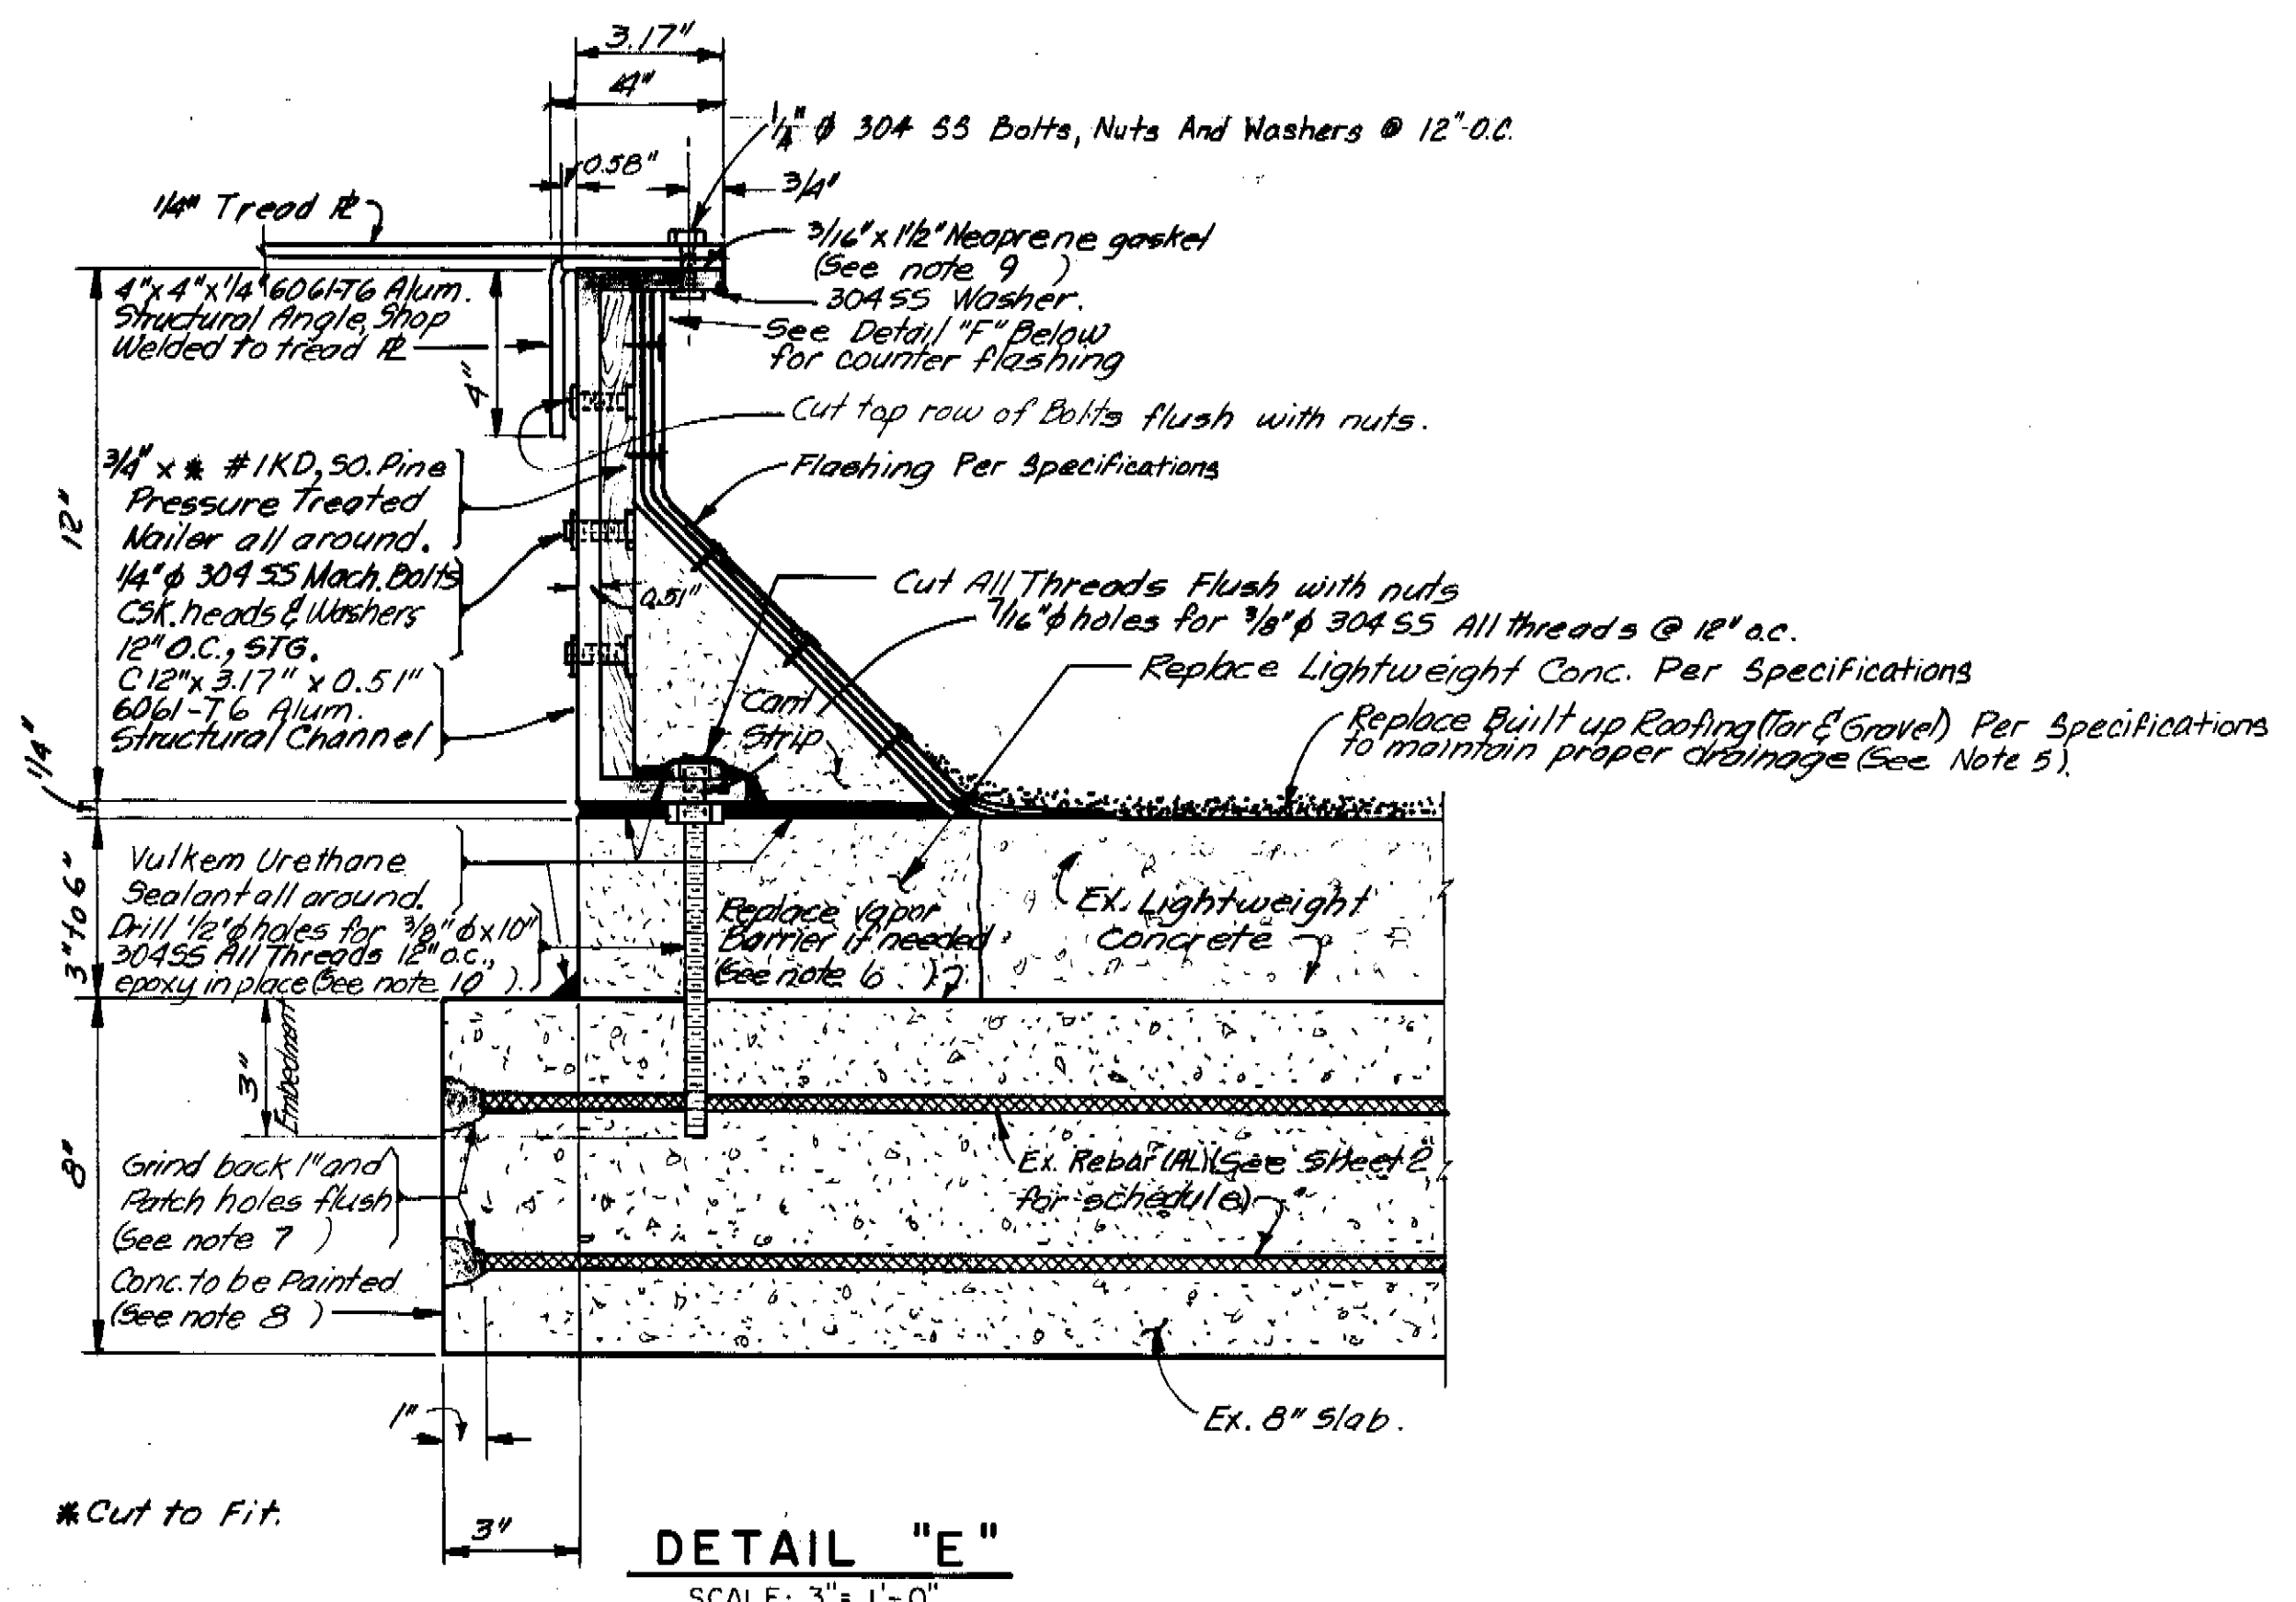

DETAIL "E"
SCALE: 3" = 1'-0"


NOTES

1. Shop drawings for both the aluminum access frame and cover and for the frame installation must be approved by the Engineer prior to fabrication and erection. All changes or substitutions must be approved by the Engineer.
2. All aluminum shall be structural 6061-T6
3. All fasteners, nuts and washers shall be A304 SS
4. All welds shall be ground smooth, cleaned and free from grease. Welded areas shall receive 2 coats of heat resistant silver metallic enamel.
5. The contractor shall be responsible for the water tightness of the frame and cover installation and for procuring proper slopes for drainage. Prior to acceptance the contractor shall demonstrate, to the satisfaction of the Engineer, that these conditions have been met. One acceptable method would be to construct a temporary bulkhead around the access cover and submerge it for a period of 2 hours in the presence of the Engineer. Conditions for acceptance are no leaks nor puddling.
6. If the existing vapor barrier is damaged while chipping away the existing lightweight concrete, it shall be replaced per specifications.
7. Grind back existing rebar 1 in and patch holes flush with Sika, High Mod LV epoxy. Sand surface flush with face prior to painting.
8. Concrete, exposed by the cutting operation, shall be painted. All chipped areas shall be filled with non-shrink grout and a 1.75 mil thickness coat of Koppers Company concrete surfacer shall be applied. Contractor to match color and texture of existing by using an existing sample.
9. 3/16" thick by 1 1/2" wide neoprene gasket shall be adhered to the flange of the channels with 3M 1300L neoprene adhesive. If the gasket is cut or damaged in any way from handling, it shall be replaced by the contractor.
10. Epoxy shall be Sika, High Mod L.V.

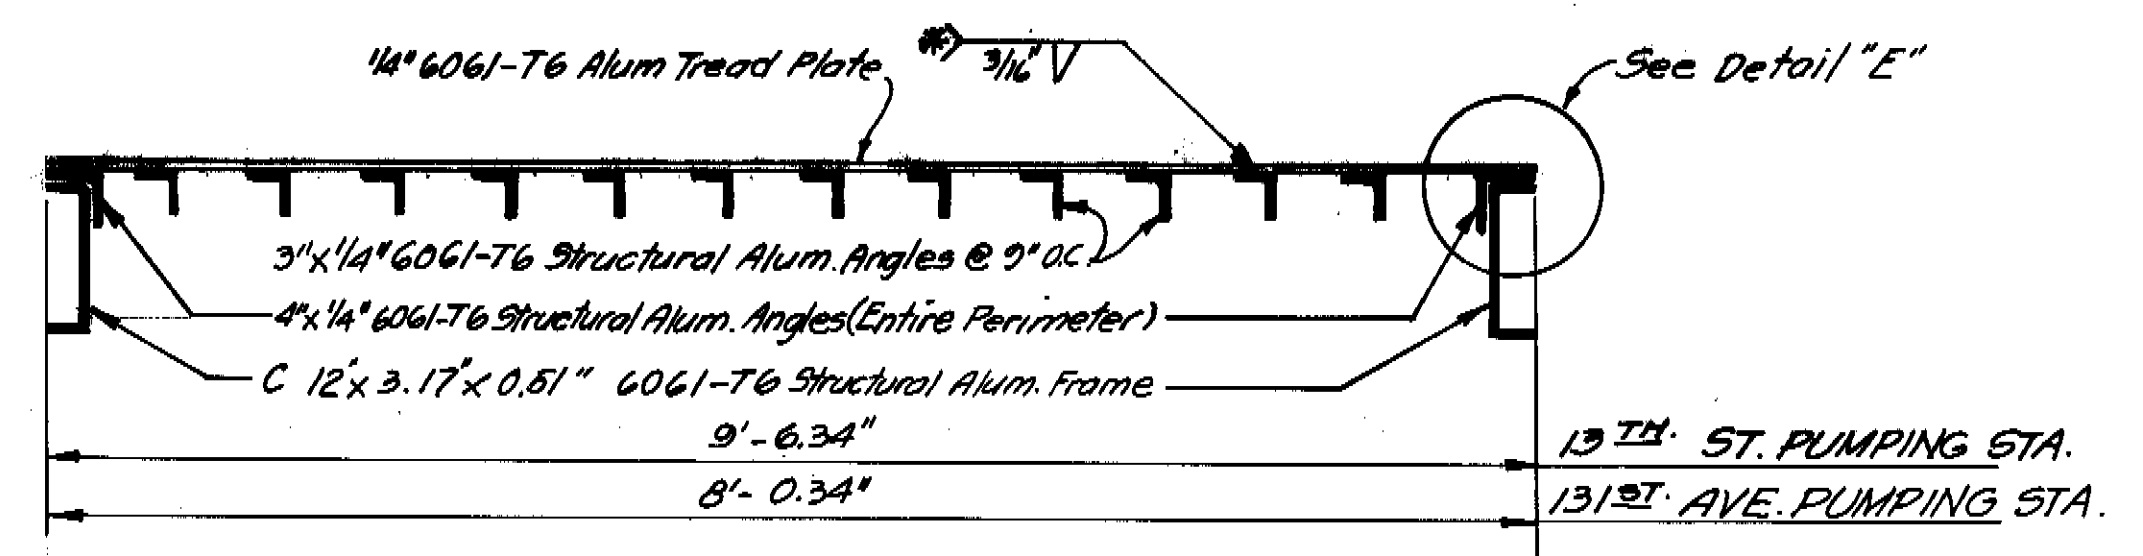


SECTION C-C
NOT TO SCALE

*Stitch weld all angles with 4045 Alloy Welding wire. Welds shall be 2" x 3" long, skip 4"-6" & staggered (both sides). (See note 4)

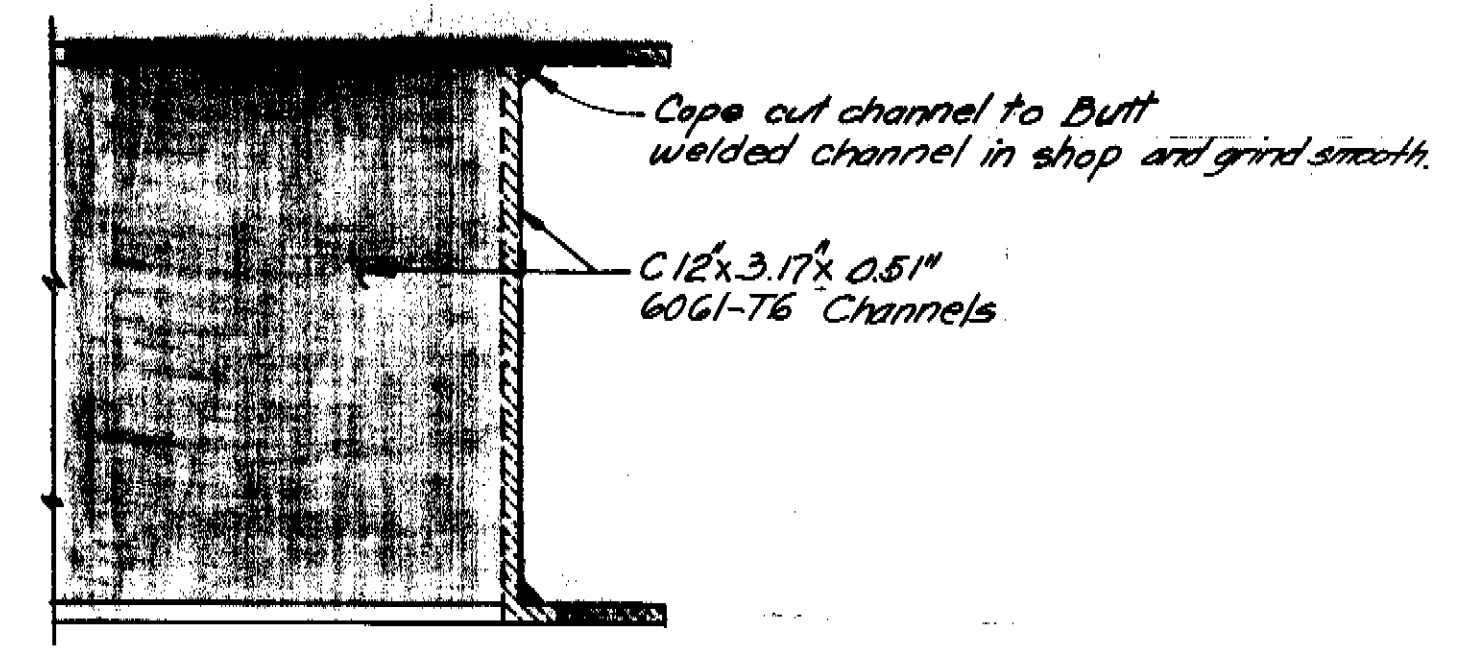

DETAIL "D"
SCALE: 3" = 1'-0"

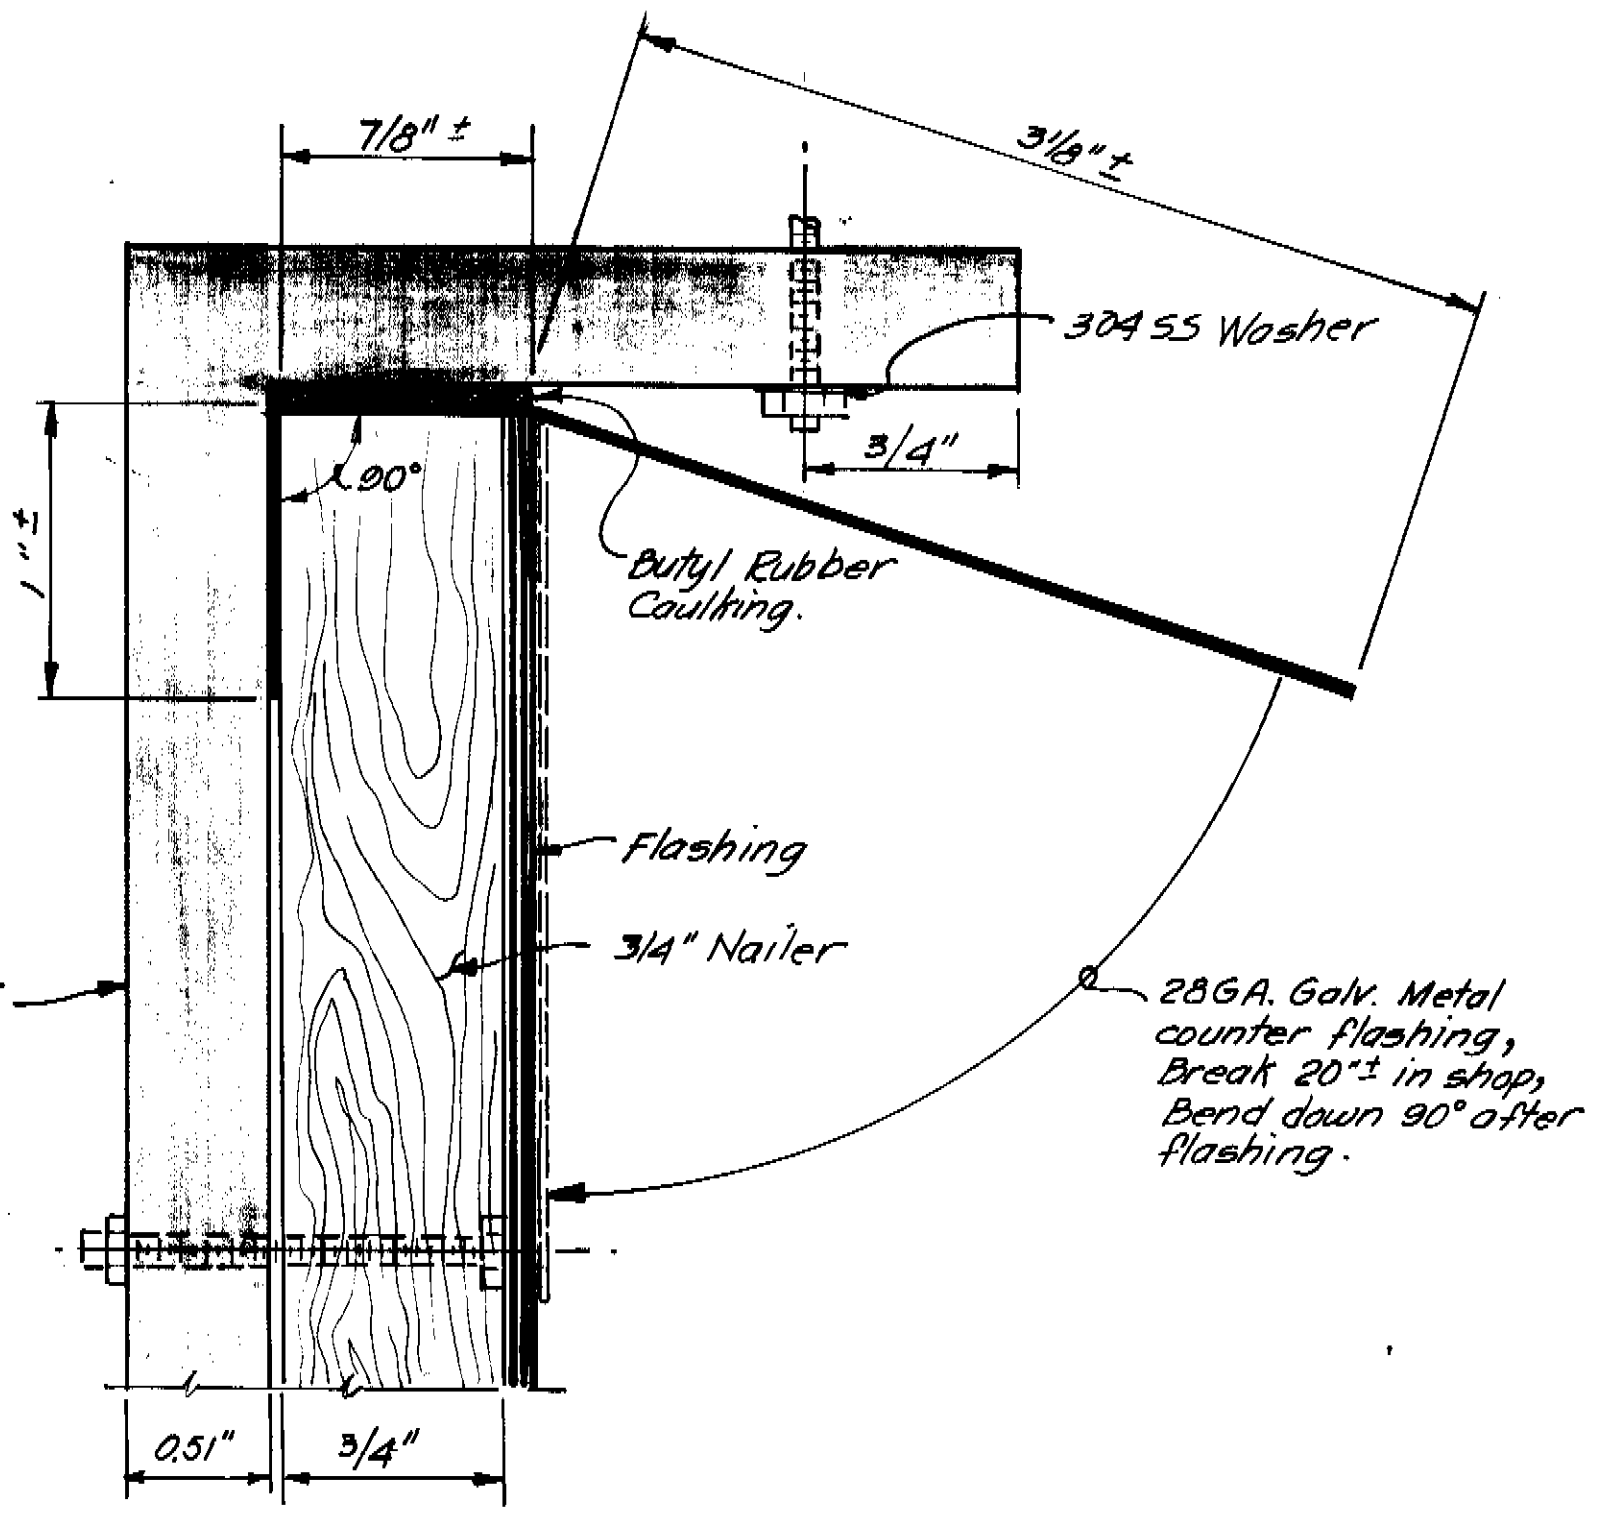


DETAIL "F"
COUNTER FLASHING
SCALE: 1 1/2" = 1"

 ANDREW T. CRONBERG, P.E. # 32320 CHIEF ENGINEER DEPARTMENT OF SANITARY SEWERS	DES: A. H.	APPROVED BY	NO. DATE REVISIONS 1 2 3 4 5	SCALE AS SHOWN	DEPARTMENT of SANITARY SEWERS CITY of TAMPA, FLORIDA RENEWAL & REPLACEMENT SEWAGE DISPOSAL SYSTEM	ROOF MODIFICATION ACCESS COVERS 13 th ST. & 13 th AVE. PUMPING STATIONS OF	SHEET 3
	DRN: E.R.	 JACK P. MORRIS, P.E. DIRECTOR DEPARTMENT OF SANITARY SEWERS					
	CKD: JW						
	DATE: 7-10-84						

CITY OF TAMPA



LOCATION MAP

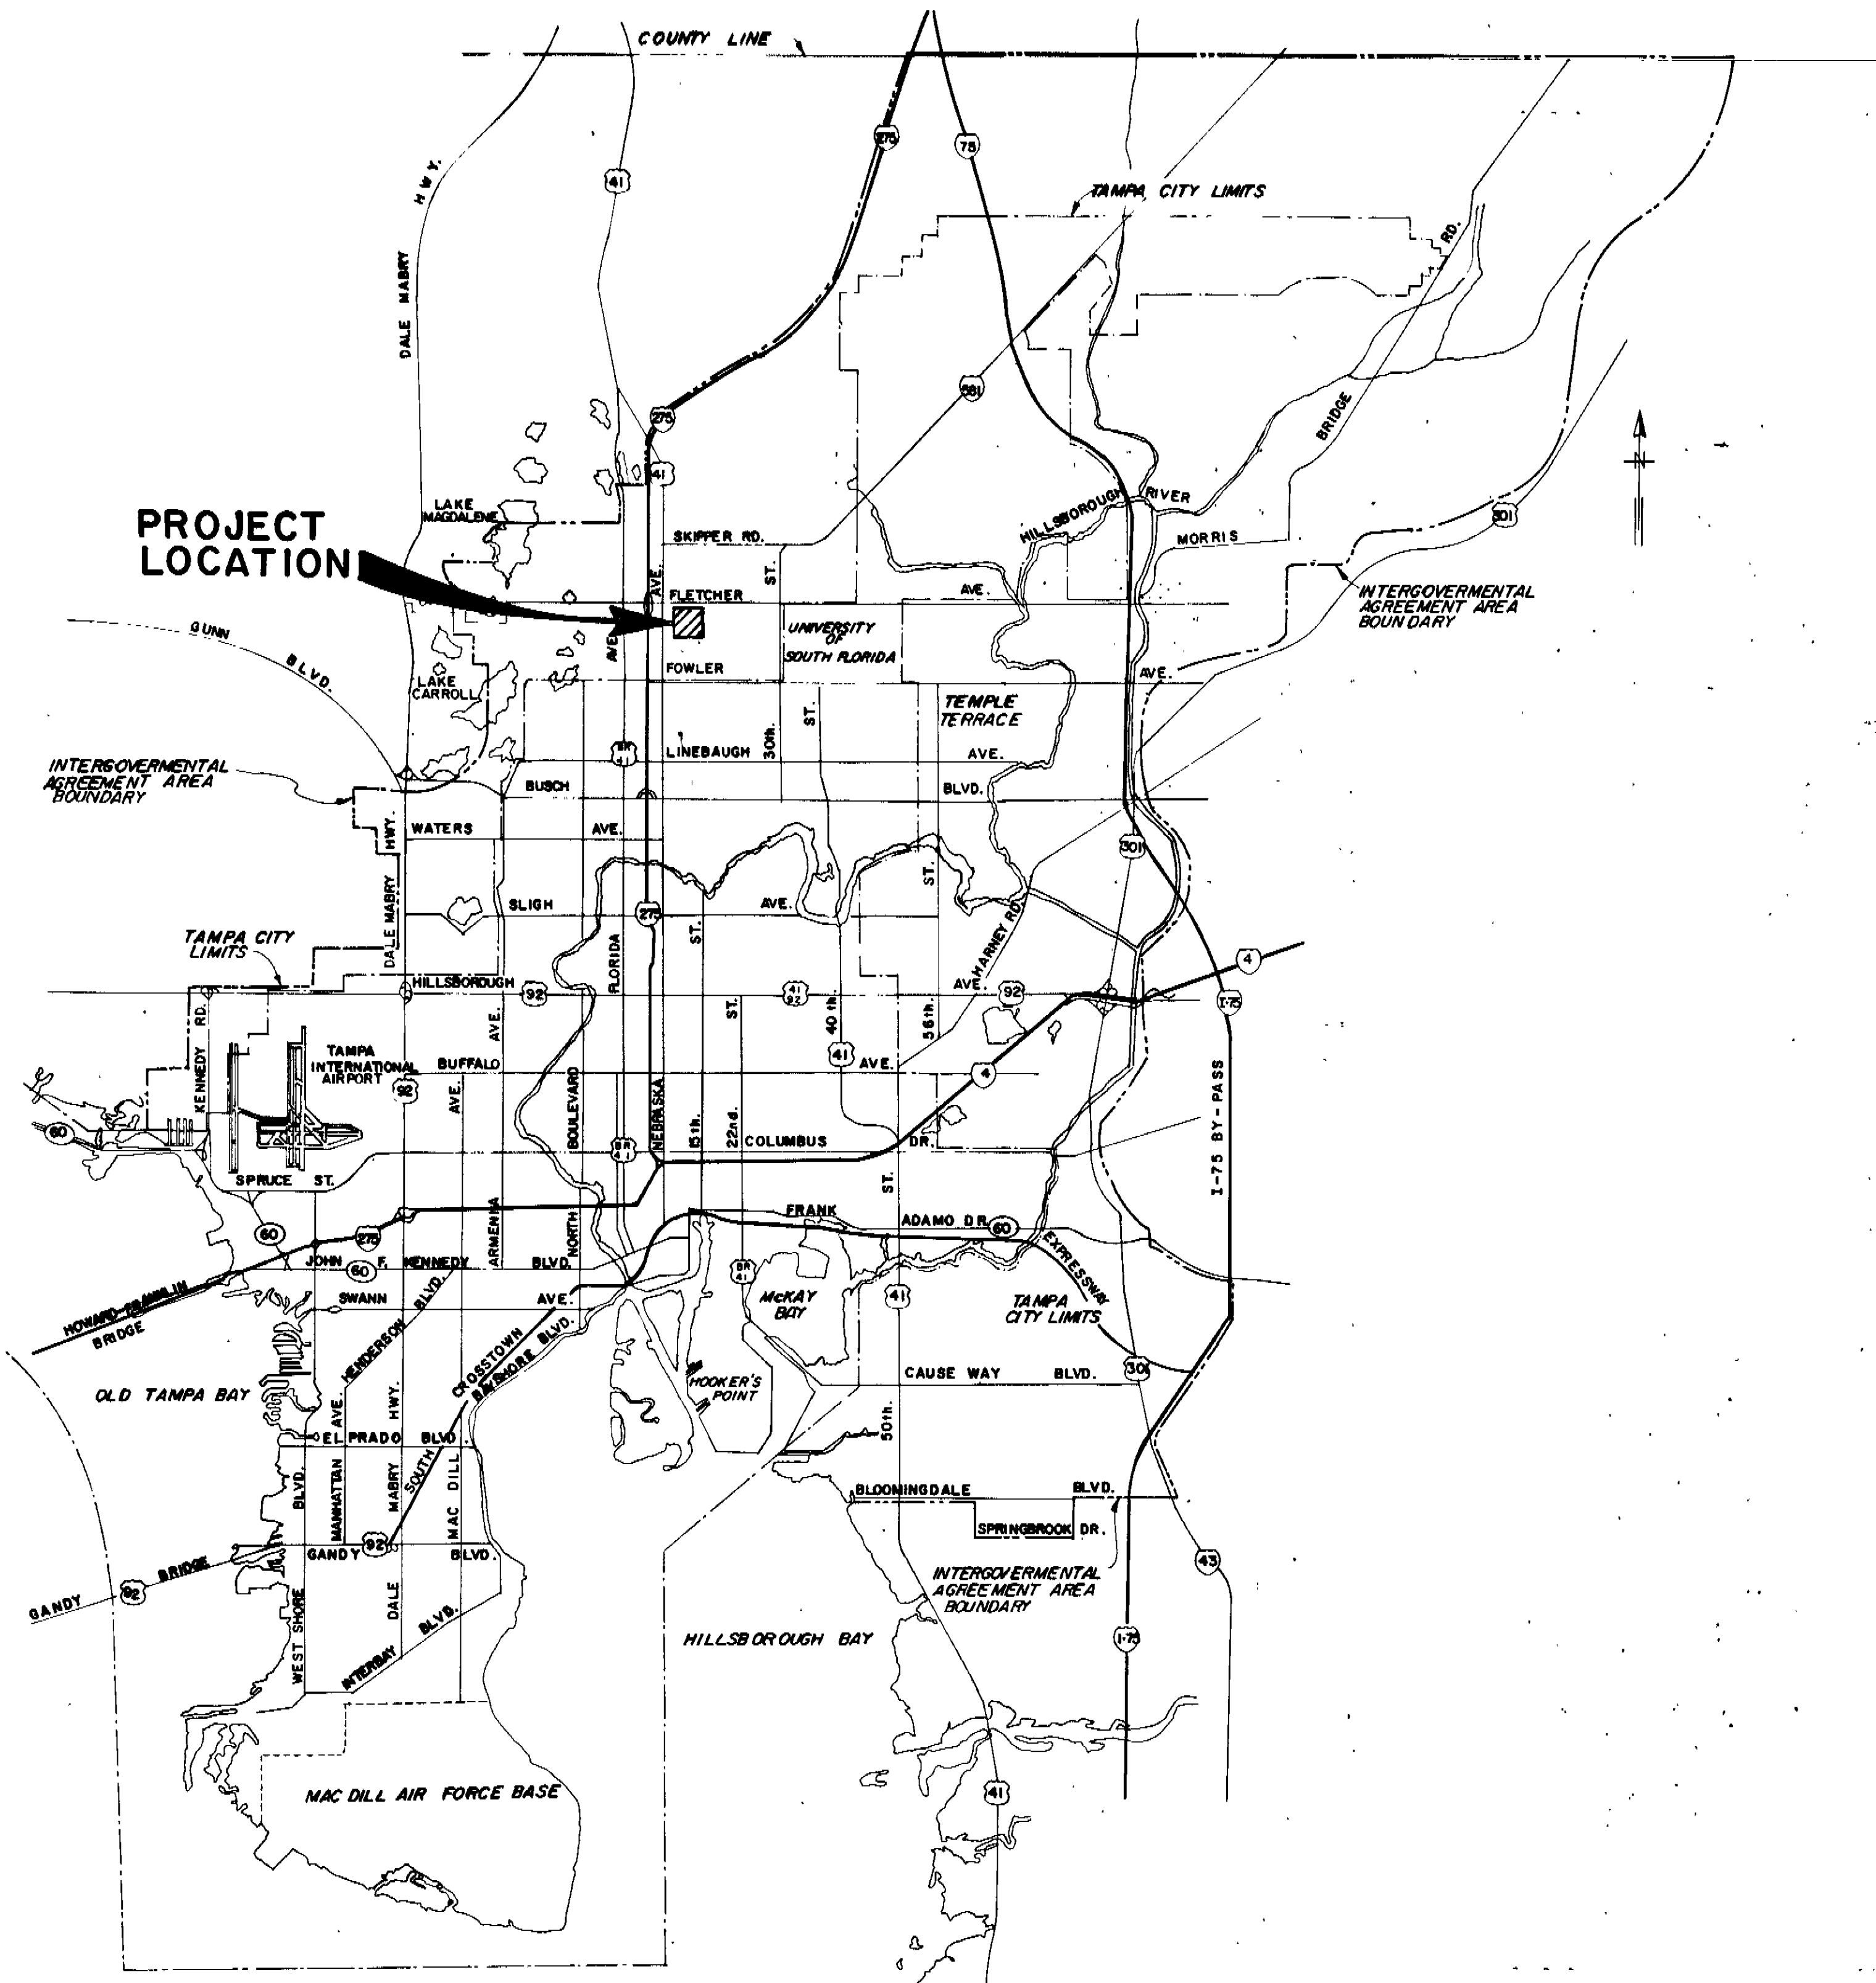

DEPARTMENT of SANITARY SEWERS SEWAGE DISPOSAL SYSTEM PLANS

FOR THE CONSTRUCTION OF

131 AVE. PUMPING STATION MOBILE GENERATOR STORAGE BUILDING

C.S. 15-1235

Andrew T. Cronberg
ANDREW T. CRONBERG, P.E. # 32560
CHIEF ENGINEER
DEPARTMENT of SANITARY SEWERS

DES: B. G.
DRN: E. R.
CKD: DW
DATE: 7-22-87

APPROVED BY
Jack F. Morris
JACK F. MORRIS, P.E.
DIRECTOR
DEPARTMENT of SANITARY SEWERS

NO	DATE	REVISIONS
1		
2		
3		
4		
5		

SCALE
1" = approximately 1 1/2 miles


DEPARTMENT of SANITARY SEWERS
CITY of TAMPA, FLORIDA
RENEWAL & REPLACEMENT
SEWAGE DISPOSAL SYSTEM

TITLE SHEET & LOCATION MAP

SHEET
1
OF 3



CIT-13a

NOTE:
ALIGN NEW MTL. SIDING WITH FACE OF EXISTING LOUVER PANEL OF EXISTING BLDG. PROVIDE WEATHER PROOF CLOSURE BETWEEN EXISTING BUILDING AND NEW CONSTRUCTION.

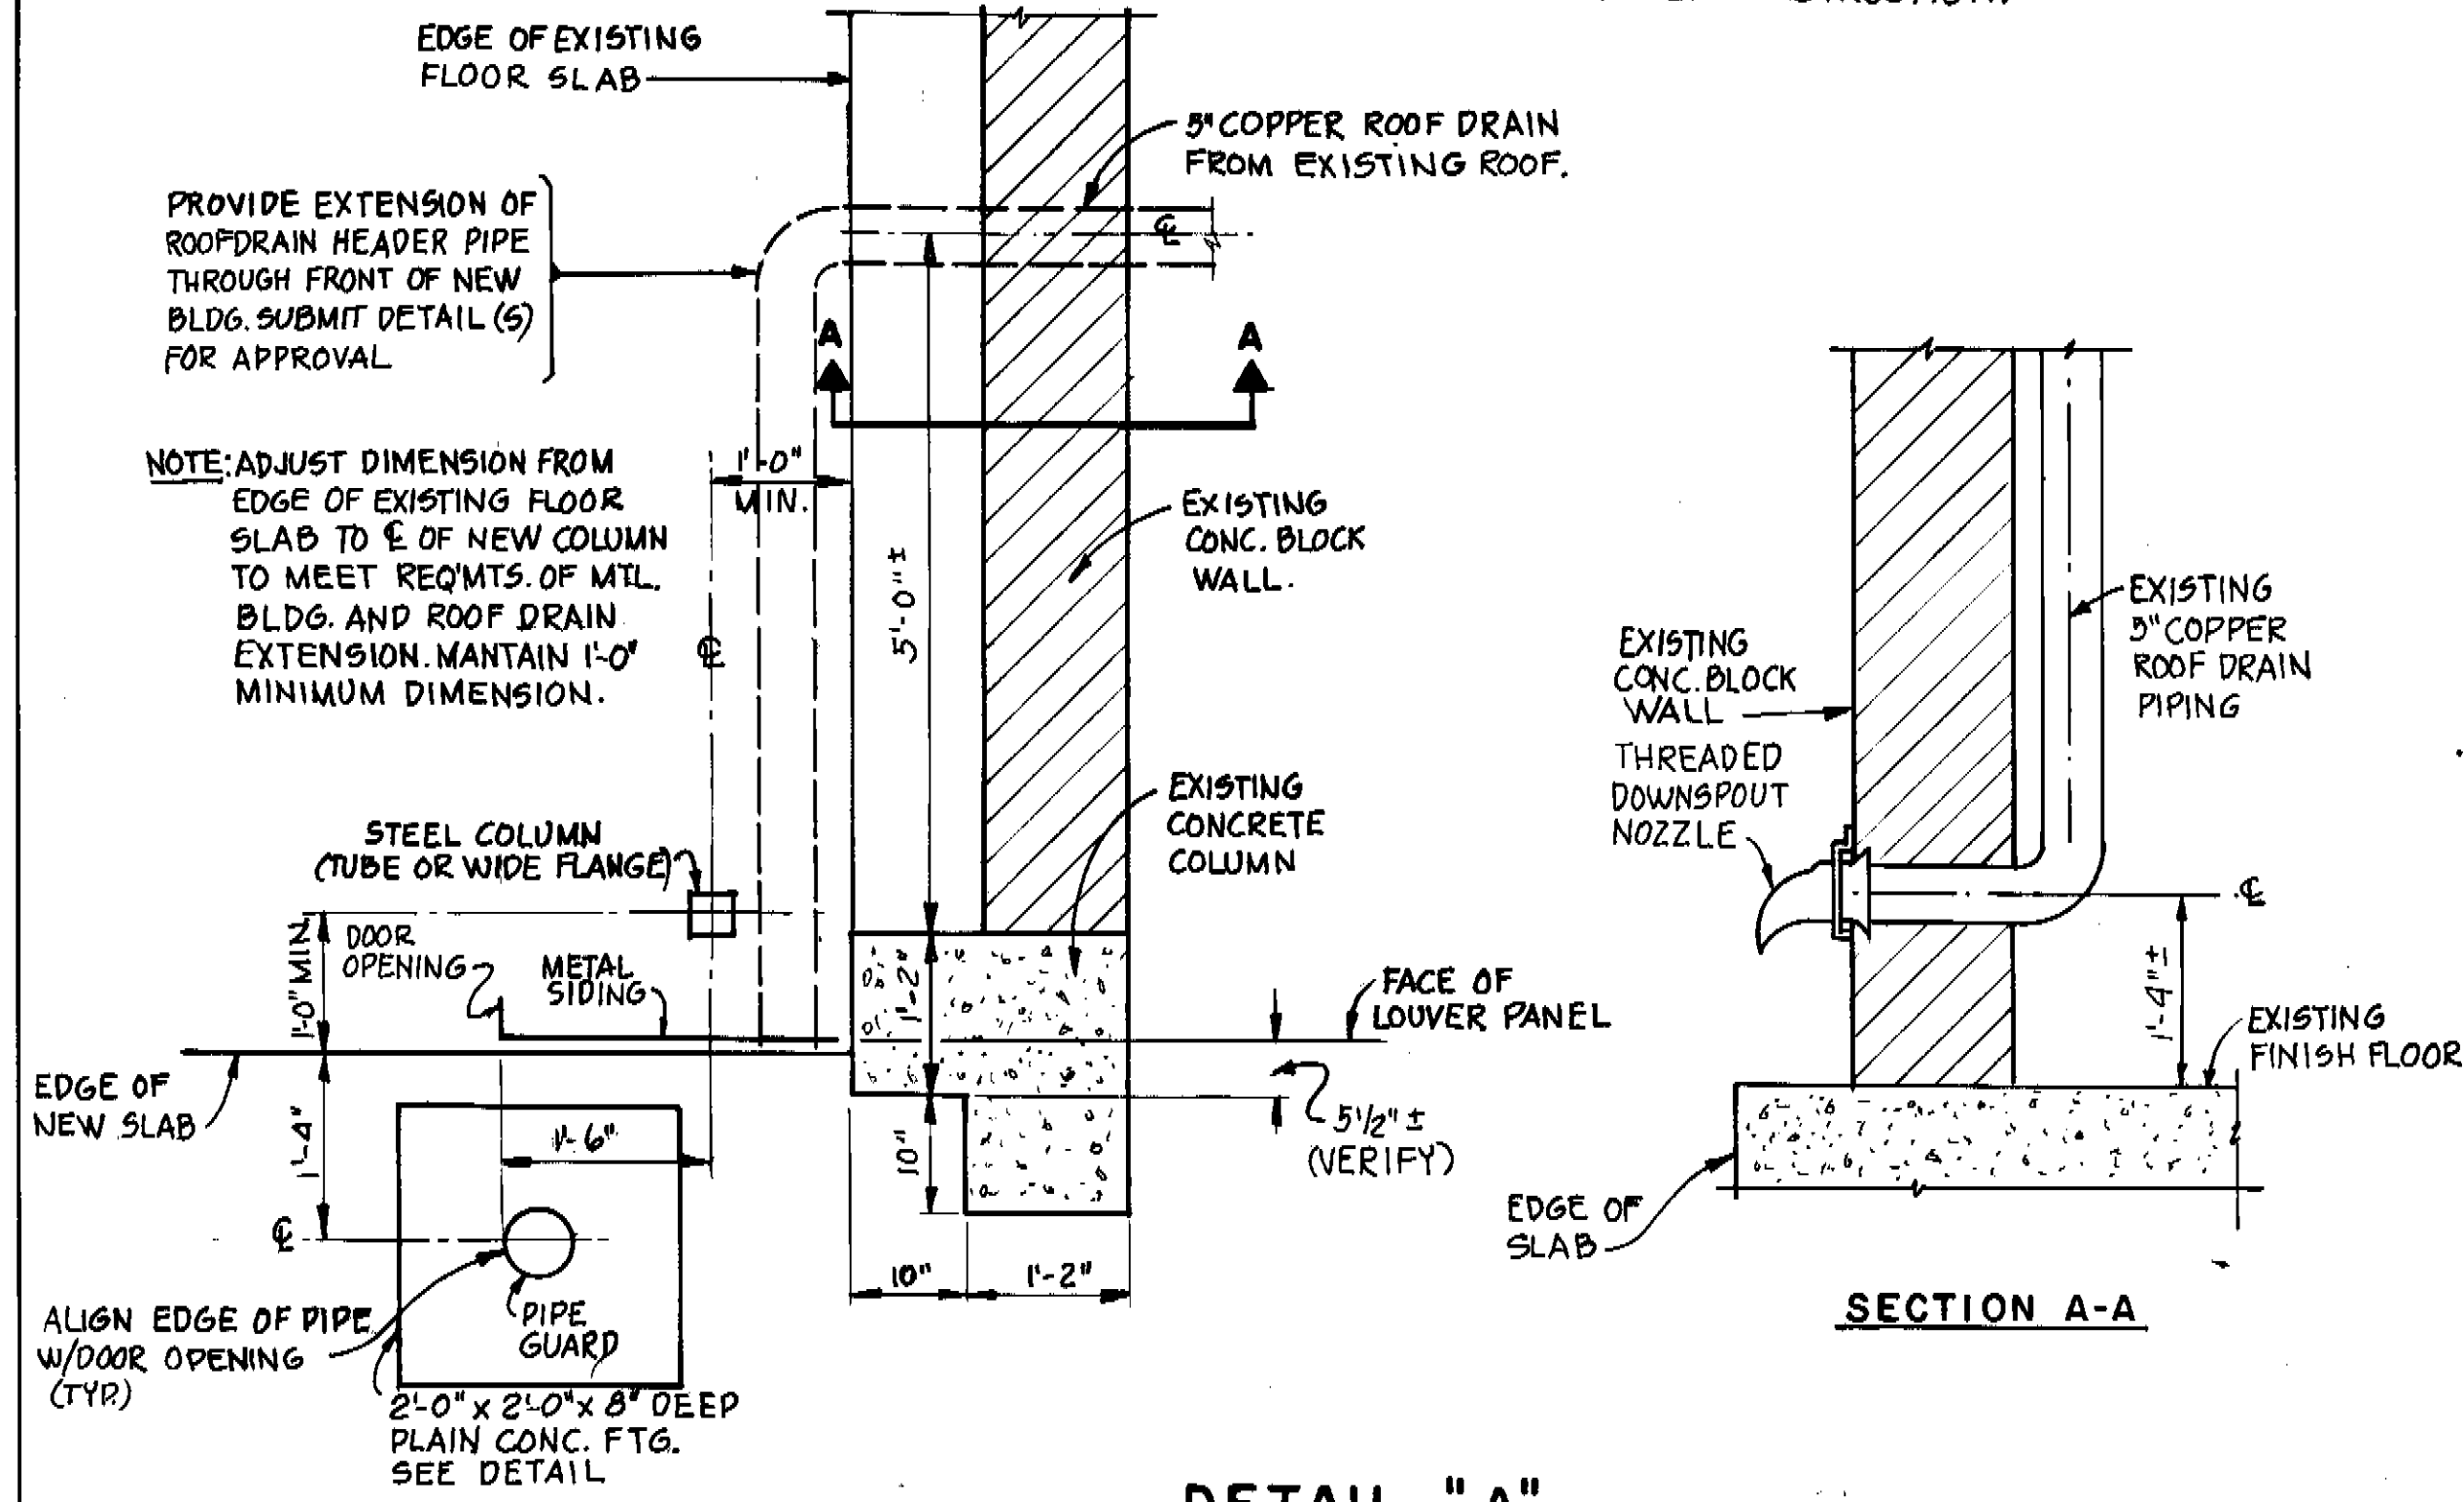

DETAIL "A"
SCALE: 3/4" = 1'-0"


(WHERE NEW CONSTRUCTION MEETS EXISTING BUILDING)

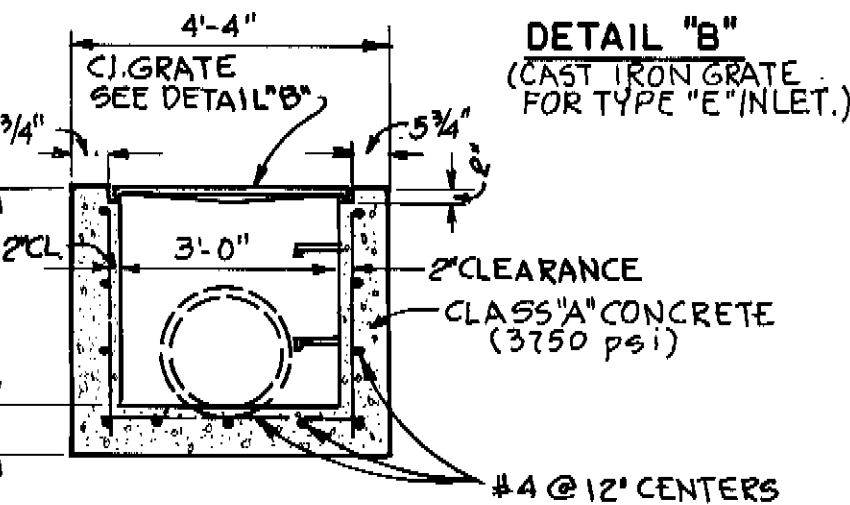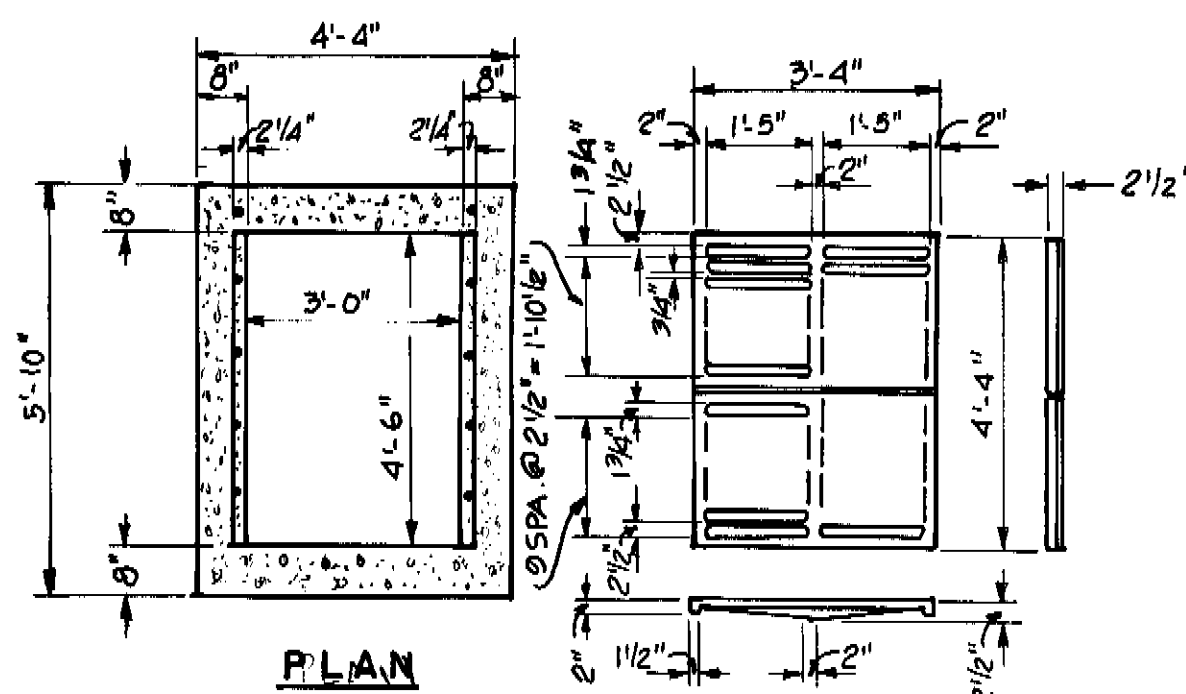


TYPE "E" INLETS
NOT TO SCALE
DETAIL "C"

NOTES


- 1- WHILE OVERALL BUILDING DIMENSIONS, SIZE AND LOCATION OF OVERHEAD DOORS, AND BUILDING ORIENTATION SHOULD BE MAINTAINED AS SHOWN IN THESE DRAWINGS, ALTERNATE ARRANGEMENTS ON ROOF FRAMING PLAN MAY BE SUBMITTED TO THE CITY FOR REVIEW; HOWEVER, THE CITY IS NOT OBLIGATED TO APPROVE SUCH ALTERNATES.
- 2- A MINIMUM OF 1'-0" FROM THE CENTERLINE OF THE EXTERIOR COLUMNS TO THE EDGE OF THE SLAB SHALL BE MAINTAINED. IF THIS DIMENSION IS LESS THAN WHAT IS REQUIRED FOR THE BUILDING'S CONSTRUCTION, THE CONTRACTOR SHALL DETERMINE ALTERNATE DIMENSIONS GREATER THAN 1'-0".
- 3- DIMENSIONS AND ELEVATIONS PERTAINING TO THE EXISTING BUILDING ARE ACCORDING TO THE BEST INFORMATION AVAILABLE. DIMENSIONS AND ELEVATIONS CRITICAL TO THE DESIGN OF NEW CONSTRUCTION SHOULD BE VERIFIED BY CONTRACTOR.
- 4- VENTILATING LOUVER PANELS HAVE BEEN SIZED TO PROVIDE MORE THAN ADEQUATE VENTILATION. ALTERNATE AND EQUIVALENT ARRANGEMENTS OF LOUVER PANELS MAY BE SUBMITTED TO THE CITY FOR REVIEW; HOWEVER, THE CITY IS NOT OBLIGATED TO APPROVE SUCH ALTERNATES.
- 5- DRIVEWAY AND PAVED AREA SHALL BE PAVED WITH 1" THICK TYPE T ASPHALTIC CONCRETE ON 6" THICK LIMEROCK BASE.
- 6- ALL ELEVATIONS SHOWN ARE REFERENCED TO CITY OF TAMPA DATUM. TO CONVERT TO NATIONAL OCEAN SURVEY (NOS) DATUM SUBTRACT 0.15 FEET (0'-1 3/16").
- 7- GRATED STORMWATER INLET TYPE "E" SHALL BE FLORIDA DOT. STANDARD.
- 8- SHOP DRAWINGS DETAILING STEEL FRAMING SHALL BE SUBMITTED TO THE CITY FOR APPROVAL. SHOP DRAWINGS SHALL BE SIGNED AND SEALED BY ENGINEER WITH PROFESSIONAL REGISTRATION IN THE STATE OF FLORIDA.

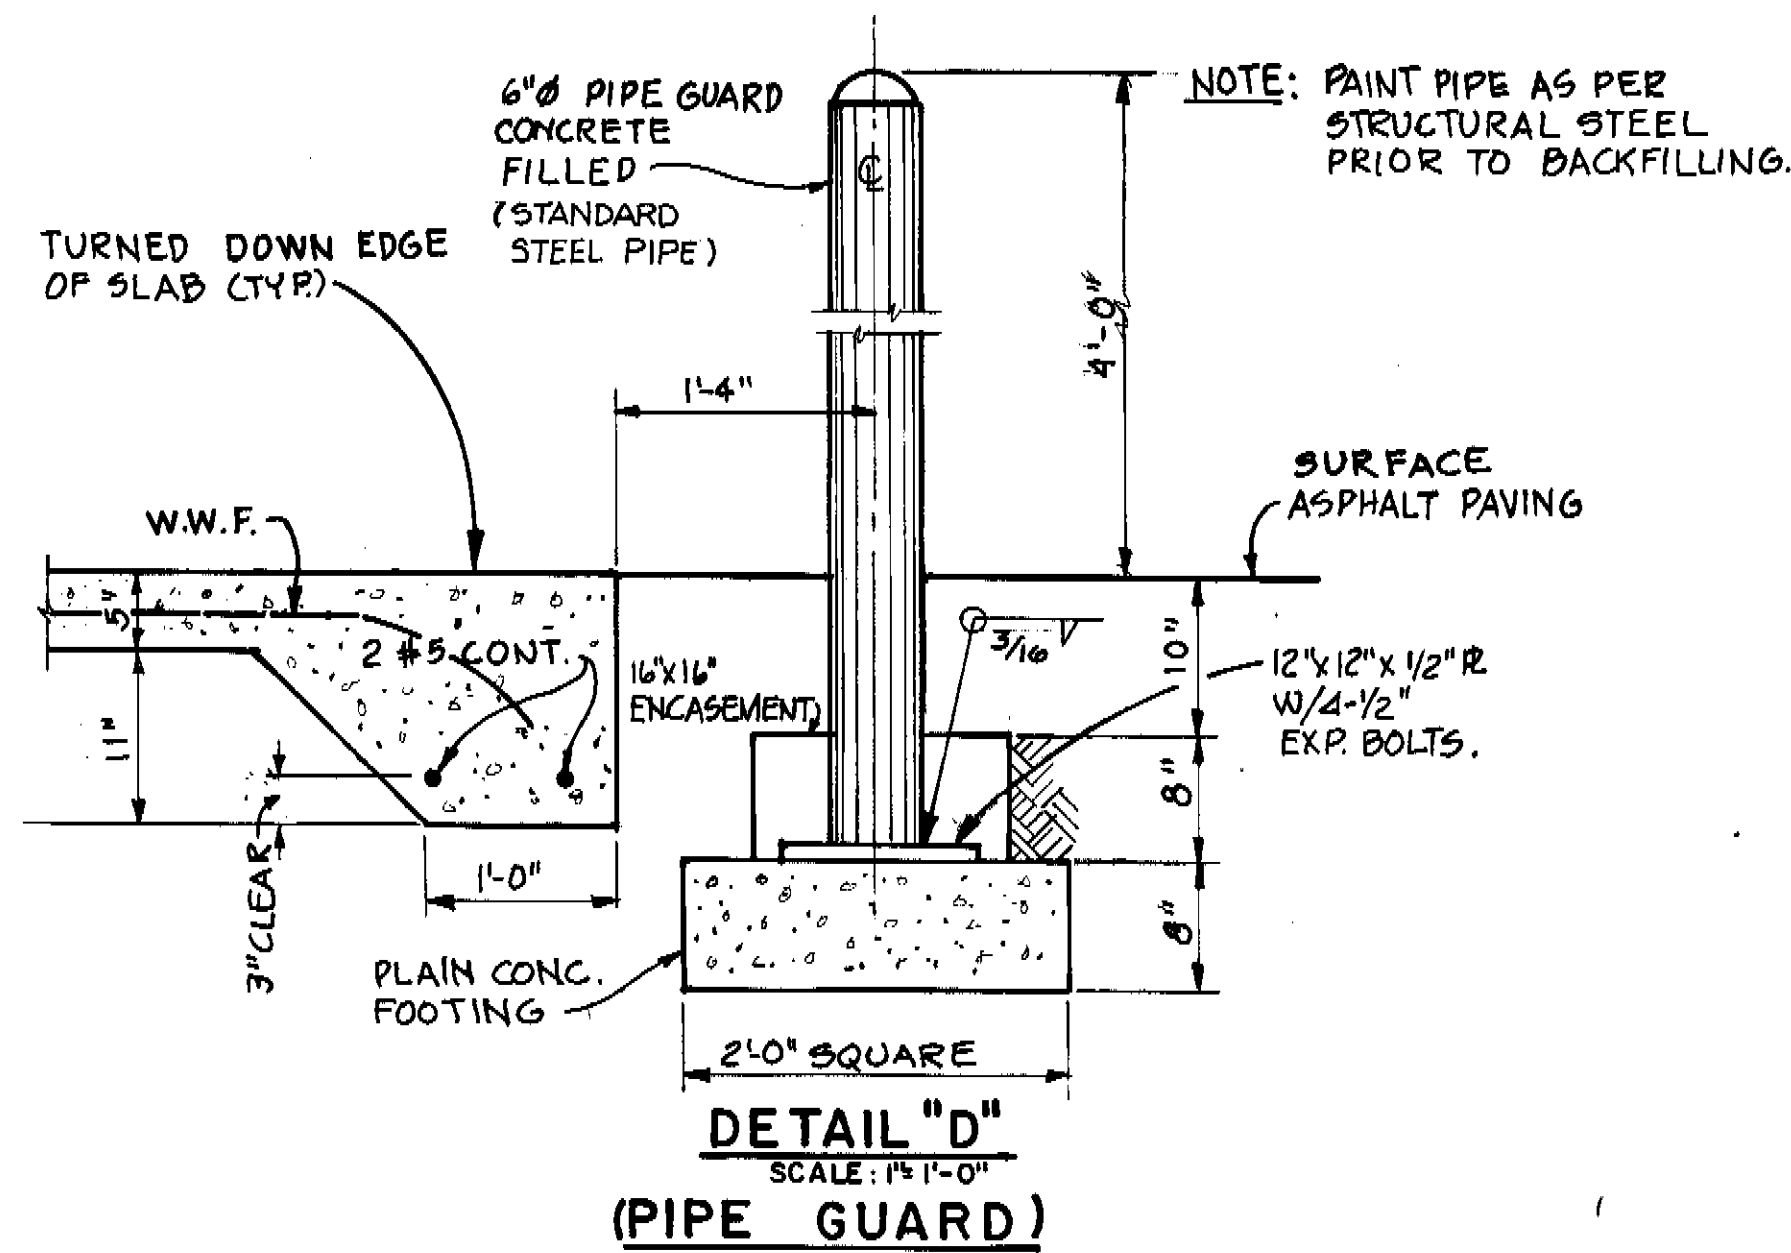


DETAIL "D"
SCALE: 1/2" = 1'-0"
(PIPE GUARD)

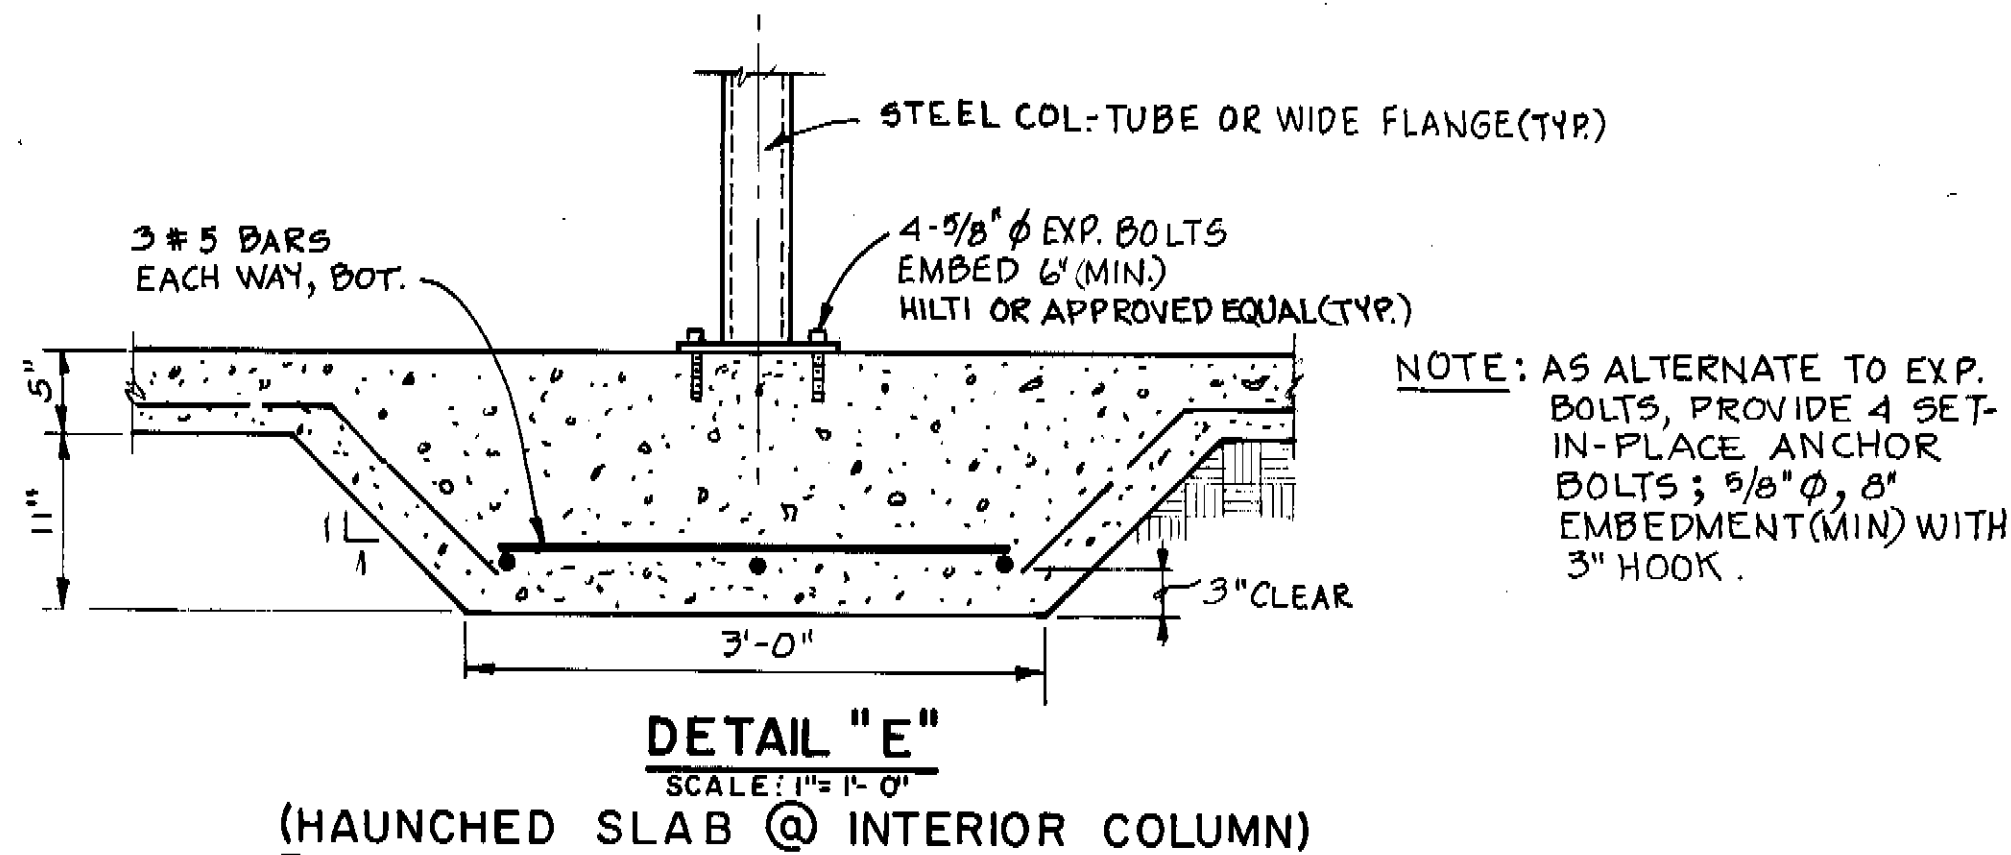

DETAIL "E"
SCALE: 1" = 1'-0"
(HAUNCHED SLAB @ INTERIOR COLUMN)

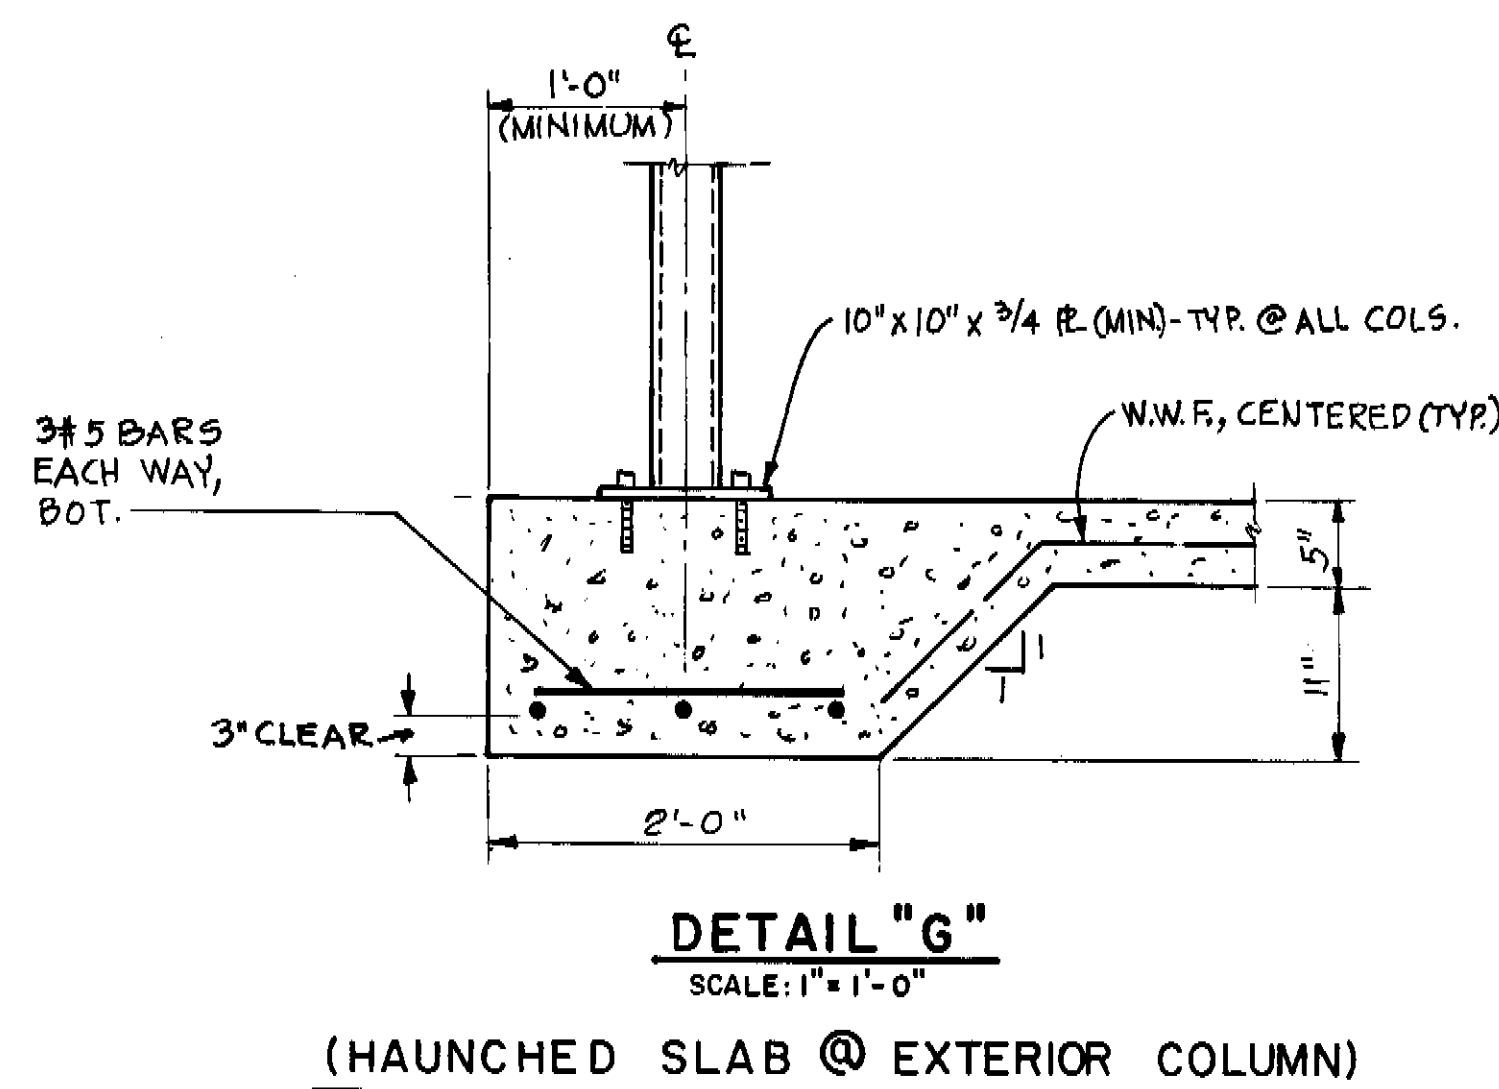

DETAIL "G"
SCALE: 1" = 1'-0"
(HAUNCHED SLAB @ EXTERIOR COLUMN)

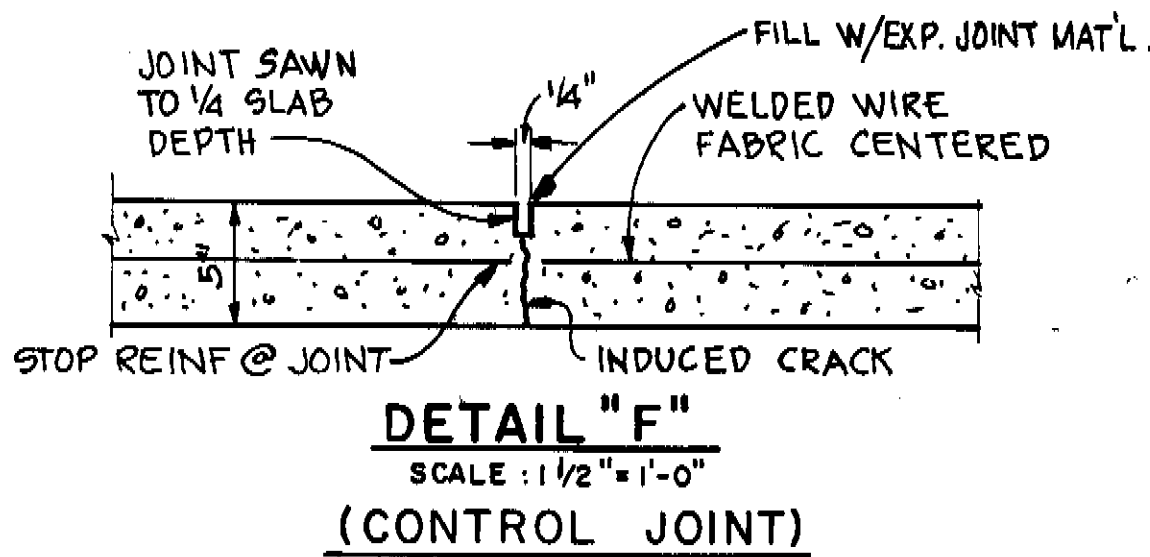

DETAIL "F"
SCALE: 1 1/2" = 1'-0"
(CONTROL JOINT)

Andrew T. Cronberg
ANDREW T. CRONBERG, P.E. # 32560
CHIEF ENGINEER
DEPARTMENT OF SANITARY SEWERS

DES: R.G.
DRN: E10.
CKD: DW
DATE: 7-22-84

APPROVED BY
Jack P. Morris
JACK P. MORRIS, P.E.
DIRECTOR
DEPARTMENT OF SANITARY SEWERS

NO.	DATE	REVISIONS
1		
2		
3		
4		
5		


SCALE
AS SHOWN

DEPARTMENT OF SANITARY SEWERS
CITY OF TAMPA, FLORIDA
RENEWAL & REPLACEMENT
SEWAGE DISPOSAL SYSTEM


131ST AVE. PUMPING STA.
MOBILE GENERATOR STORAGE
BUILDING DETAILS

SHEET
3
OF 3


C173-73c

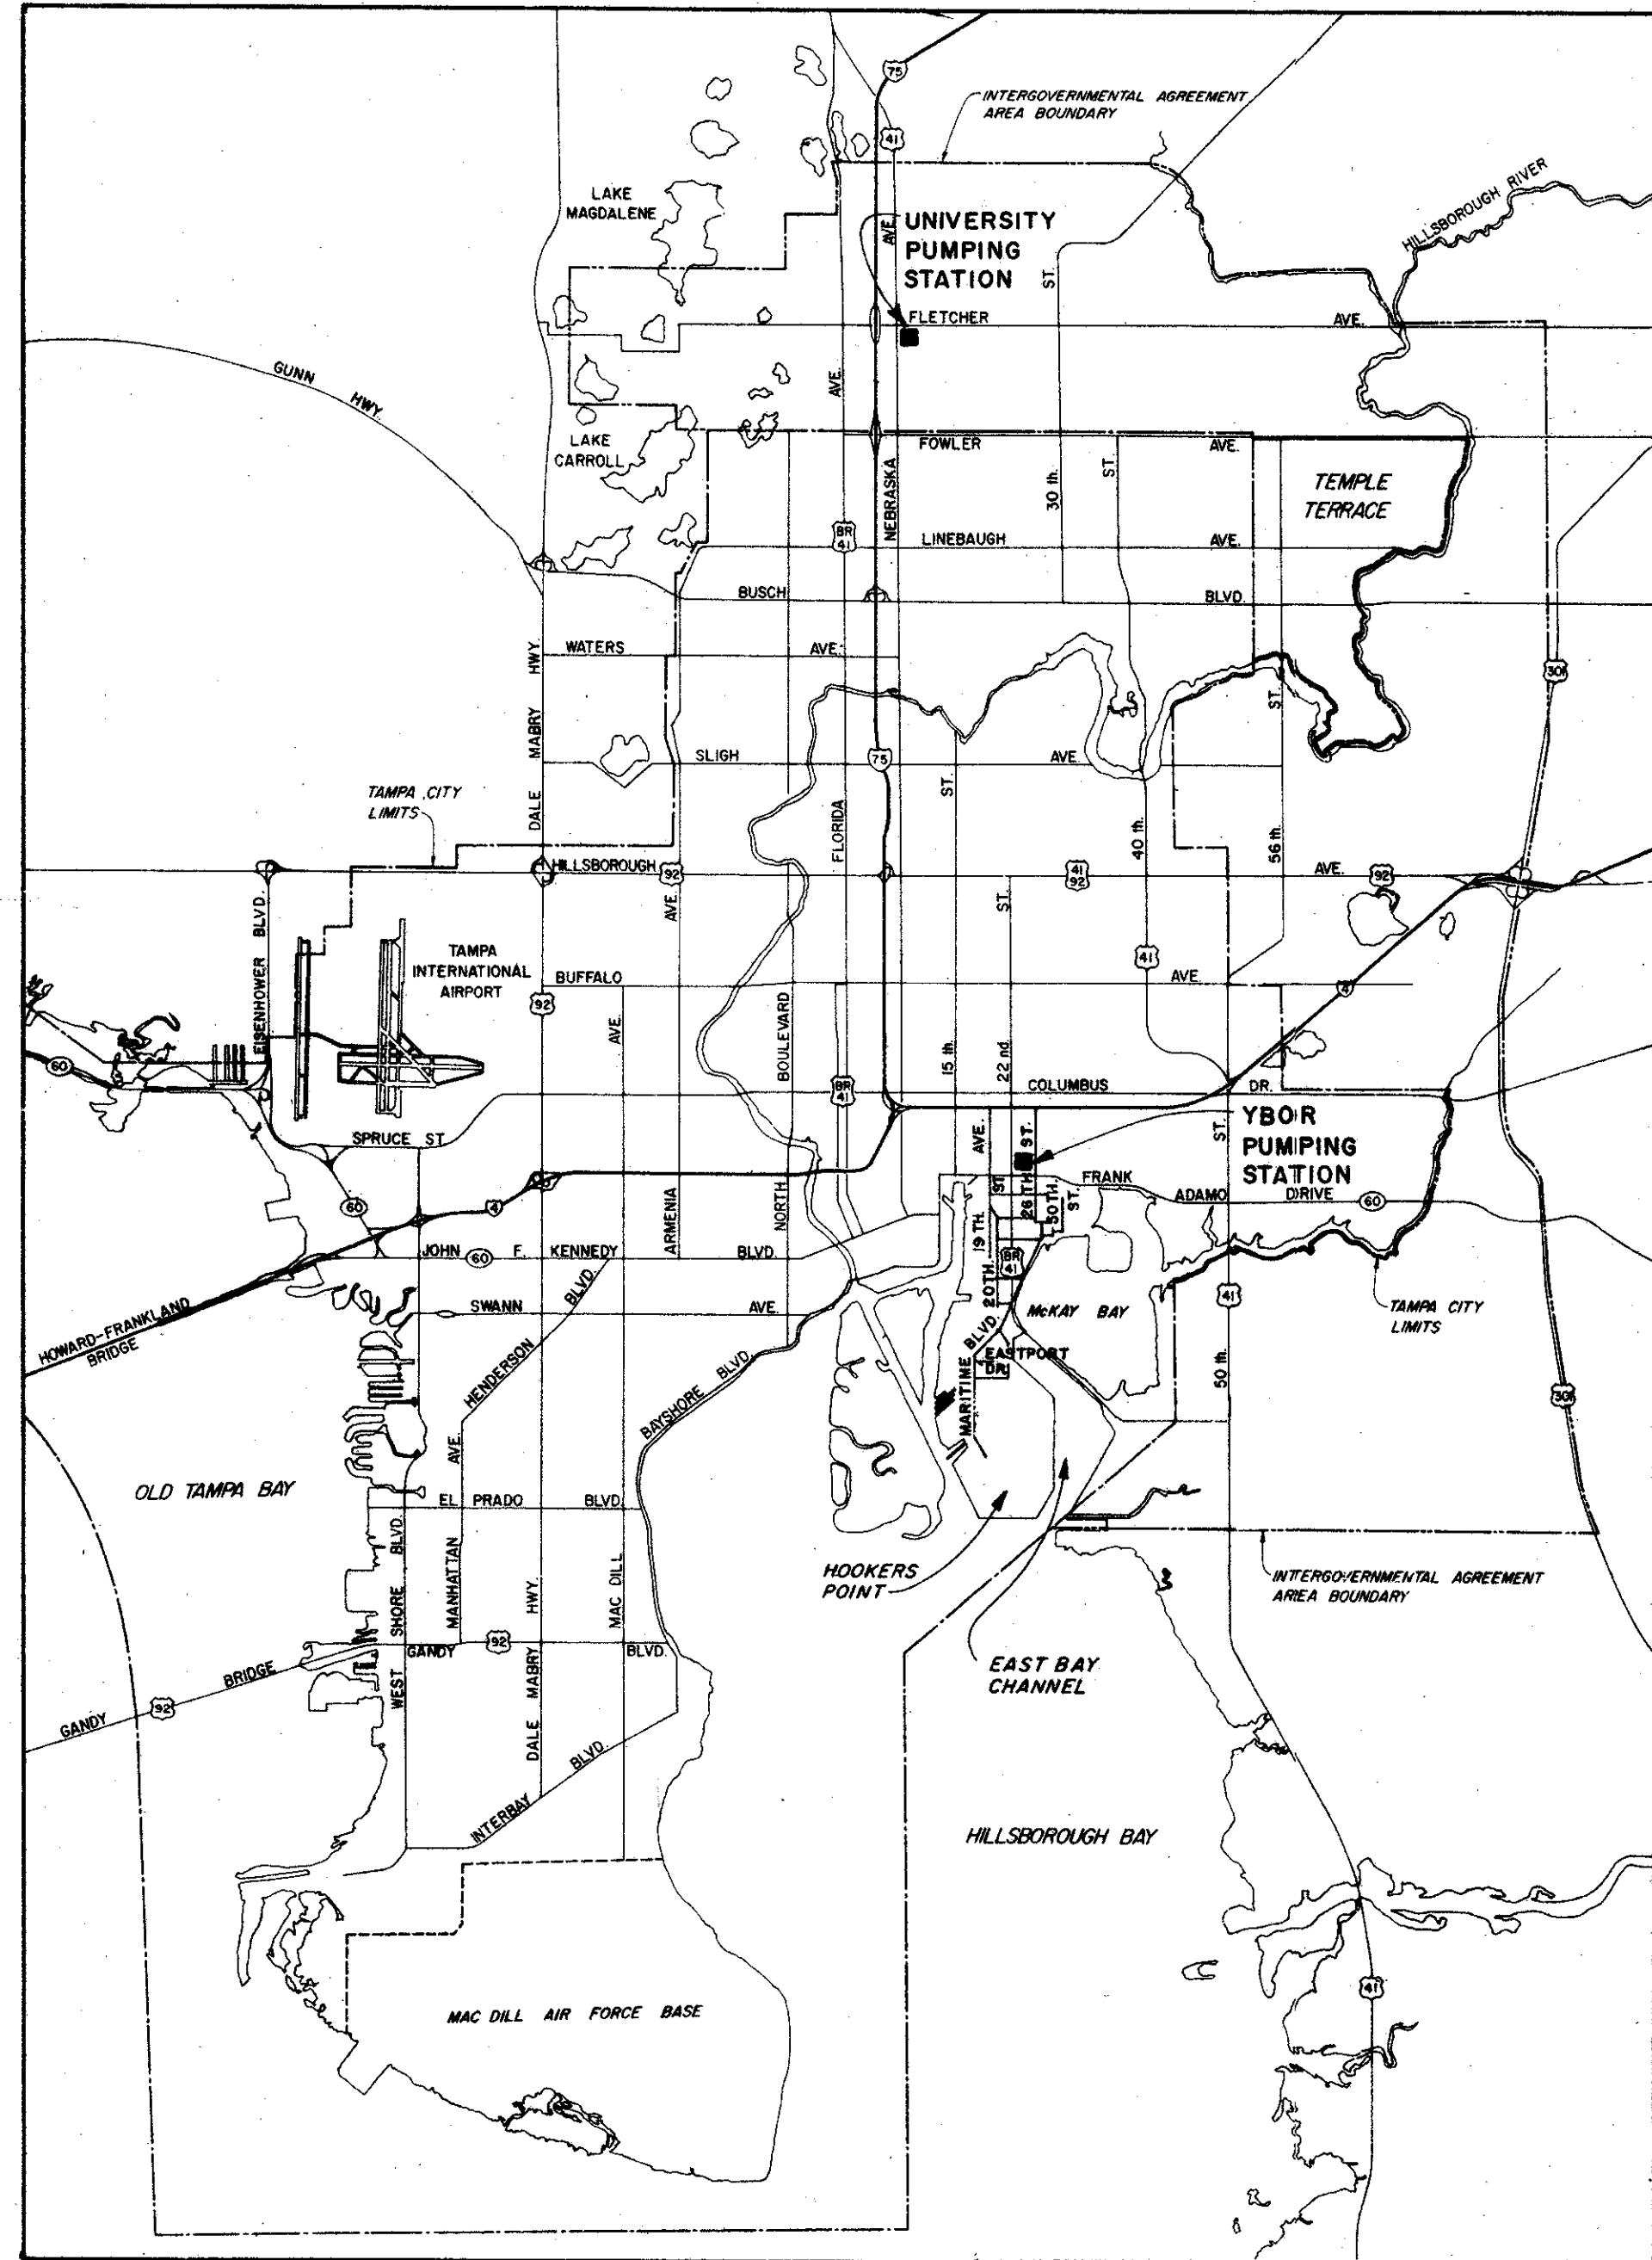

LOCATION MAP
SCALE: 1" = 8000'

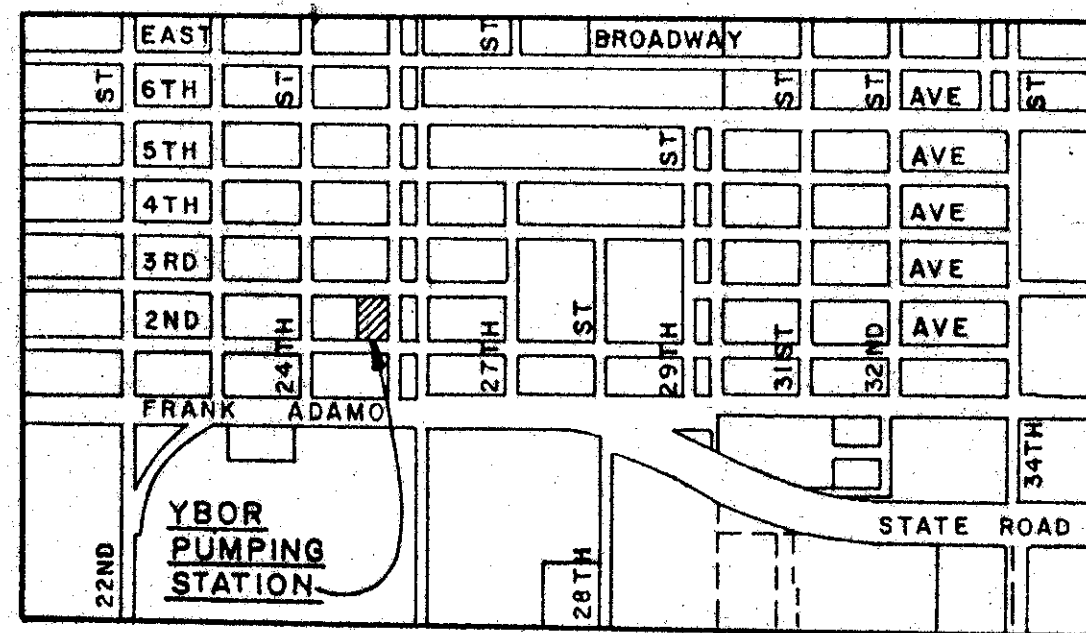

YBOR PUMPING STATION

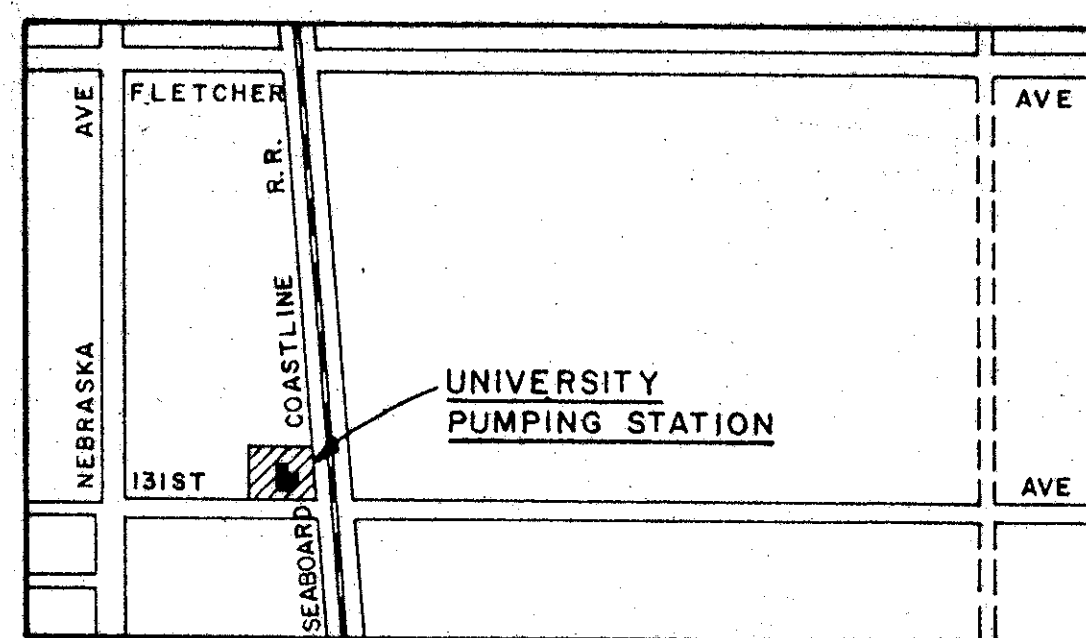


UNIVERSITY PUMPING STATION

AREA MAPS
NOT TO SCALE

INDEX

SHEET NO.	TITLE
1.	LOCATION MAP, AREA MAPS AND INDEX
2.	SYMBOL LEGEND AND GENERAL DETAILS
3.	ODOR CONTROL FACILITIES - PLATFORM AND LADDER DETAILS
4.	YBOR PUMPING STATION - PLANS, SECTIONS AND DIAGRAMS
5.	YBOR PUMPING STATION - PLANS, SECTIONS AND DIAGRAMS
6.	YBOR PUMPING STATION - SECTIONS
7.	YBOR PUMPING STATION - SECTIONS
8.	UNIVERSITY PUMPING STATION - PLANS, SECTIONS, DETAILS AND DIAGRAMS
9.	UNIVERSITY PUMPING STATION - PLANS, SECTIONS, DETAILS AND DIAGRAMS
10.	YBOR AND UNIVERSITY PUMPING STATIONS - ELECTRICAL

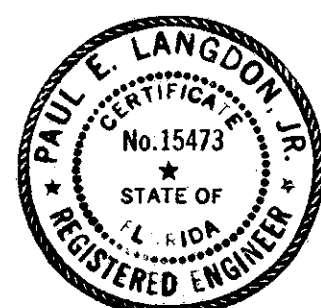

GREELEY AND HANSEN ENGINEERS
222 S. RIVERSIDE PLAZA
CHICAGO, ILLINOIS 60606

DESIGNED JRP
DRAWN ATK
CHECKED JRP

APPROVED
Supt., Dept. of Sanitary Sewers
DATE 9/12/85
Greeley and Hansen, Engineers

NO.	DATE	APP.	REVISION

SCALE
AS SHOWN



CITY OF TAMPA, FLORIDA
SEWAGE DISPOSAL SYSTEM
DIVISION 4L5
PUMPING STATIONS
ODOR CONTROL MODIFICATIONS

LOCATION MAP, AREA MAPS
AND INDEX

PROJ. NO.	
SHEET	1 OF 10
DATE	JULY 1985
REV.	0

304-14

PIPING SYMBOL	DESCRIPTION	PIPING SYMBOL	DESCRIPTION
	Gate valve (1)		Cross
	Gate valve (2)		Cross (Branch up)
	Butterfly valve (1)		Tee
	Butterfly valve (2)		Tee (Branch up)
	Plug valve (1)		Tee (Branch down)
	Plug valve (2)		45° Elbow
	Ball valve (1)		45° Elbow (Up)
	Ball valve (2)		45° Elbow (Down)
	Globe valve (1)		90° Elbow
	Globe valve (2)		90° Elbow (Up)
	Angle globe valve (1)		90° Elbow (Down)
	Angle globe valve (2)		Side outlet elbow (Up)
	Diaphragm valve (1)		Side outlet elbow (Down)
	Diaphragm valve (2)		Lateral
	Three way valve (1)		Reducer concentric-plan and elevation
	Three way valve (2)		Reducer concentric-elevation
	Four way valve (1)		Reducer eccentric-plan
	Four way valve (2)		Reducer eccentric-elevation
	Pressure relief valve (1)		Union (Screwed)
	Pressure relief valve (2)		Sleeve type coupling
	Check valve		Sleeve type coupling (Harnessed)
	Pressure reducing valve		Expansion joint-metal bellows type
	Hose valve		Expansion joint-rubber bellows type
	Flanged joint		Strainer
	Blind flange		Meter (Magnetic type)
	Bell and spigot joint		Venturi meter
	Mechanical joint		

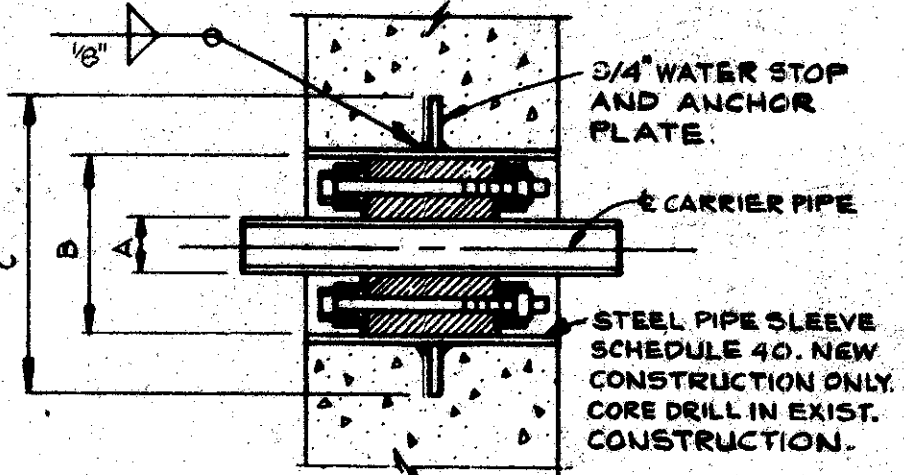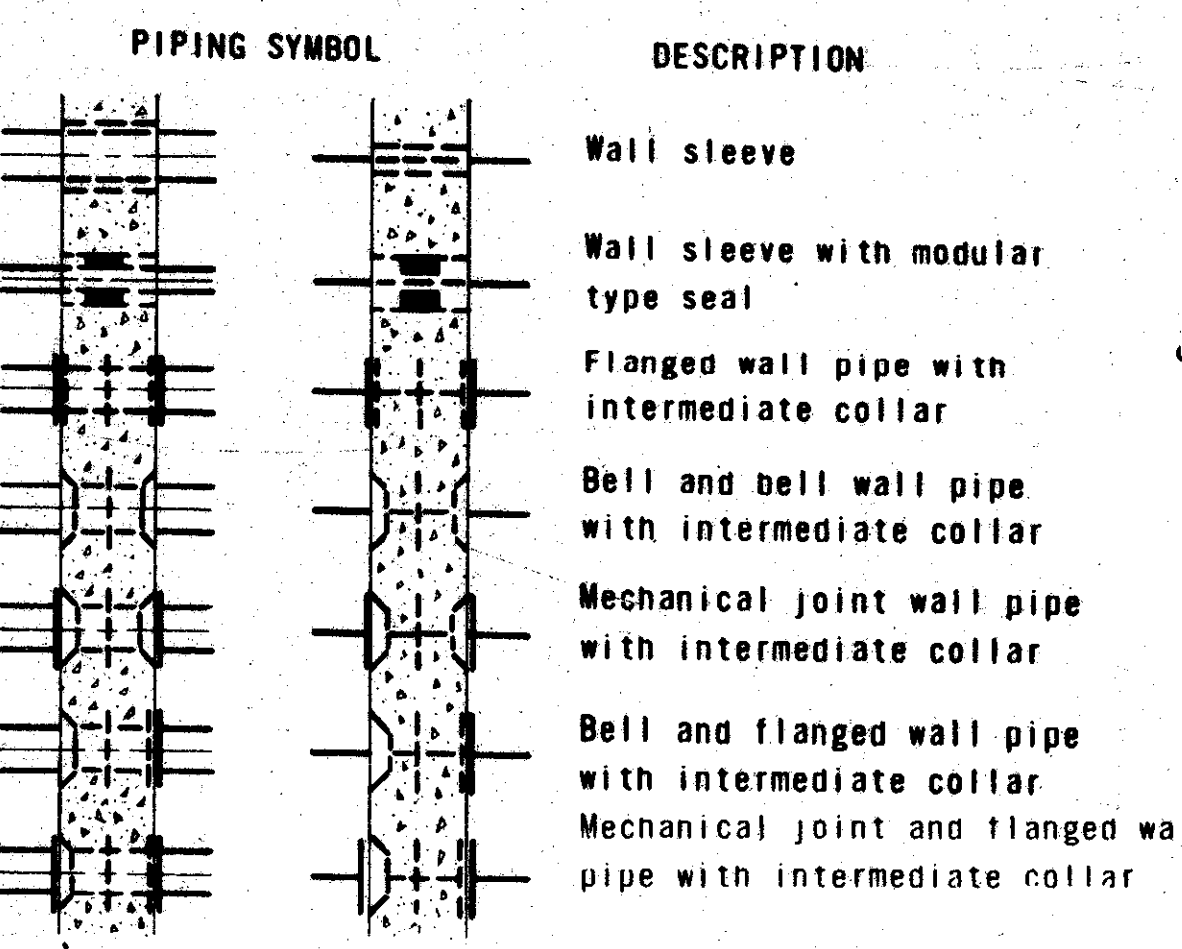

MODULAR WALL SLEEVE SEALING DETAIL

DUCTILE IRON DISCHARGE PIPE		STEEL PIPE AND WATERSTOP		MODULAR WALL SLEEVE (SEE NOTE)		
NOM. I.D.	O.D.	CORE DRILL DIA.	PIPE I.D.	WATERSTOP O.D.	LINK SEAL MOD. NO.	NO. OF LINKS
4"	4.5"	5.0"	-	-	LS-475-C	7
2"	2.375"	4.0"	-	-	LS-300-C	6

NOTE:
MODULAR WALL SLEEVE SHALL BE LINK SEAL OR EQUAL.

VALVE OPERATOR

TYPE	SYMBOL *
Manual	None
Chainwheel	C
Motor (Electric)	M
Pneumatic Cylinder	P

NOTES:
(1) Valve stem perpendicular to paper.
(2) Valve stem parallel to paper.

Where the symbol * is shown on the drawings in place of dimensions or elevations determine these dimensions or elevations after selection of equipment.

Where the symbol ** is shown on the drawings adjacent to dimensions or elevations, the Contractor must verify such dimensions or elevations by field measurement.

LEGEND

EXISTING OR OTHER DIVISIONS	NEW	DESCRIPTION
		Superstructure
		Tank and other structures
		Pavement with curb
		Pavement without curb
		Property line
		Fence
		Easement line
		Railroad tracks
		Contour
		Graded swale
		Spot elevation
		Small piping
		Storm sewer
		Large pipes and conduits
		High and/or low voltage electrical duct
		Direct burial valve * B.V.-Butterfly valve G.V.-Gate valve P.V.-Plug valve
		Concrete thrust block
		Fire hydrant
		Manhole
		Storm water inlet (lawn or pavel area type)
		Storm water inlet - curb
		Plant coordinates
		Coordinates
		Top of curb elevation arrow side only
		Top of curb elevation top of pavement elevation at the curb and plant coordinate
		Top of pavement elevation

CREELEY AND HANSEN ENGINEERS
222 S. RIVERSIDE PLAZA
CHICAGO, ILLINOIS 60606

DESIGNED JRP
DRAWN AH
CHECKED JRP

APPROVED

DATE	NO.	DATE	APP.	REVISION

SCALE
NOT TO SCALE


CITY OF TAMPA, FLORIDA
SEWAGE DISPOSAL SYSTEM
DIVISION 4L5
PUMPING STATIONS
ODQR CONTROL MODIFICATIONS

SYMBOL LEGEND AND GENERAL DETAILS

PROJ. NO.	
SHEET	2 OF 10
DATE	JULY 1985
REV.	0


304-15

304-15

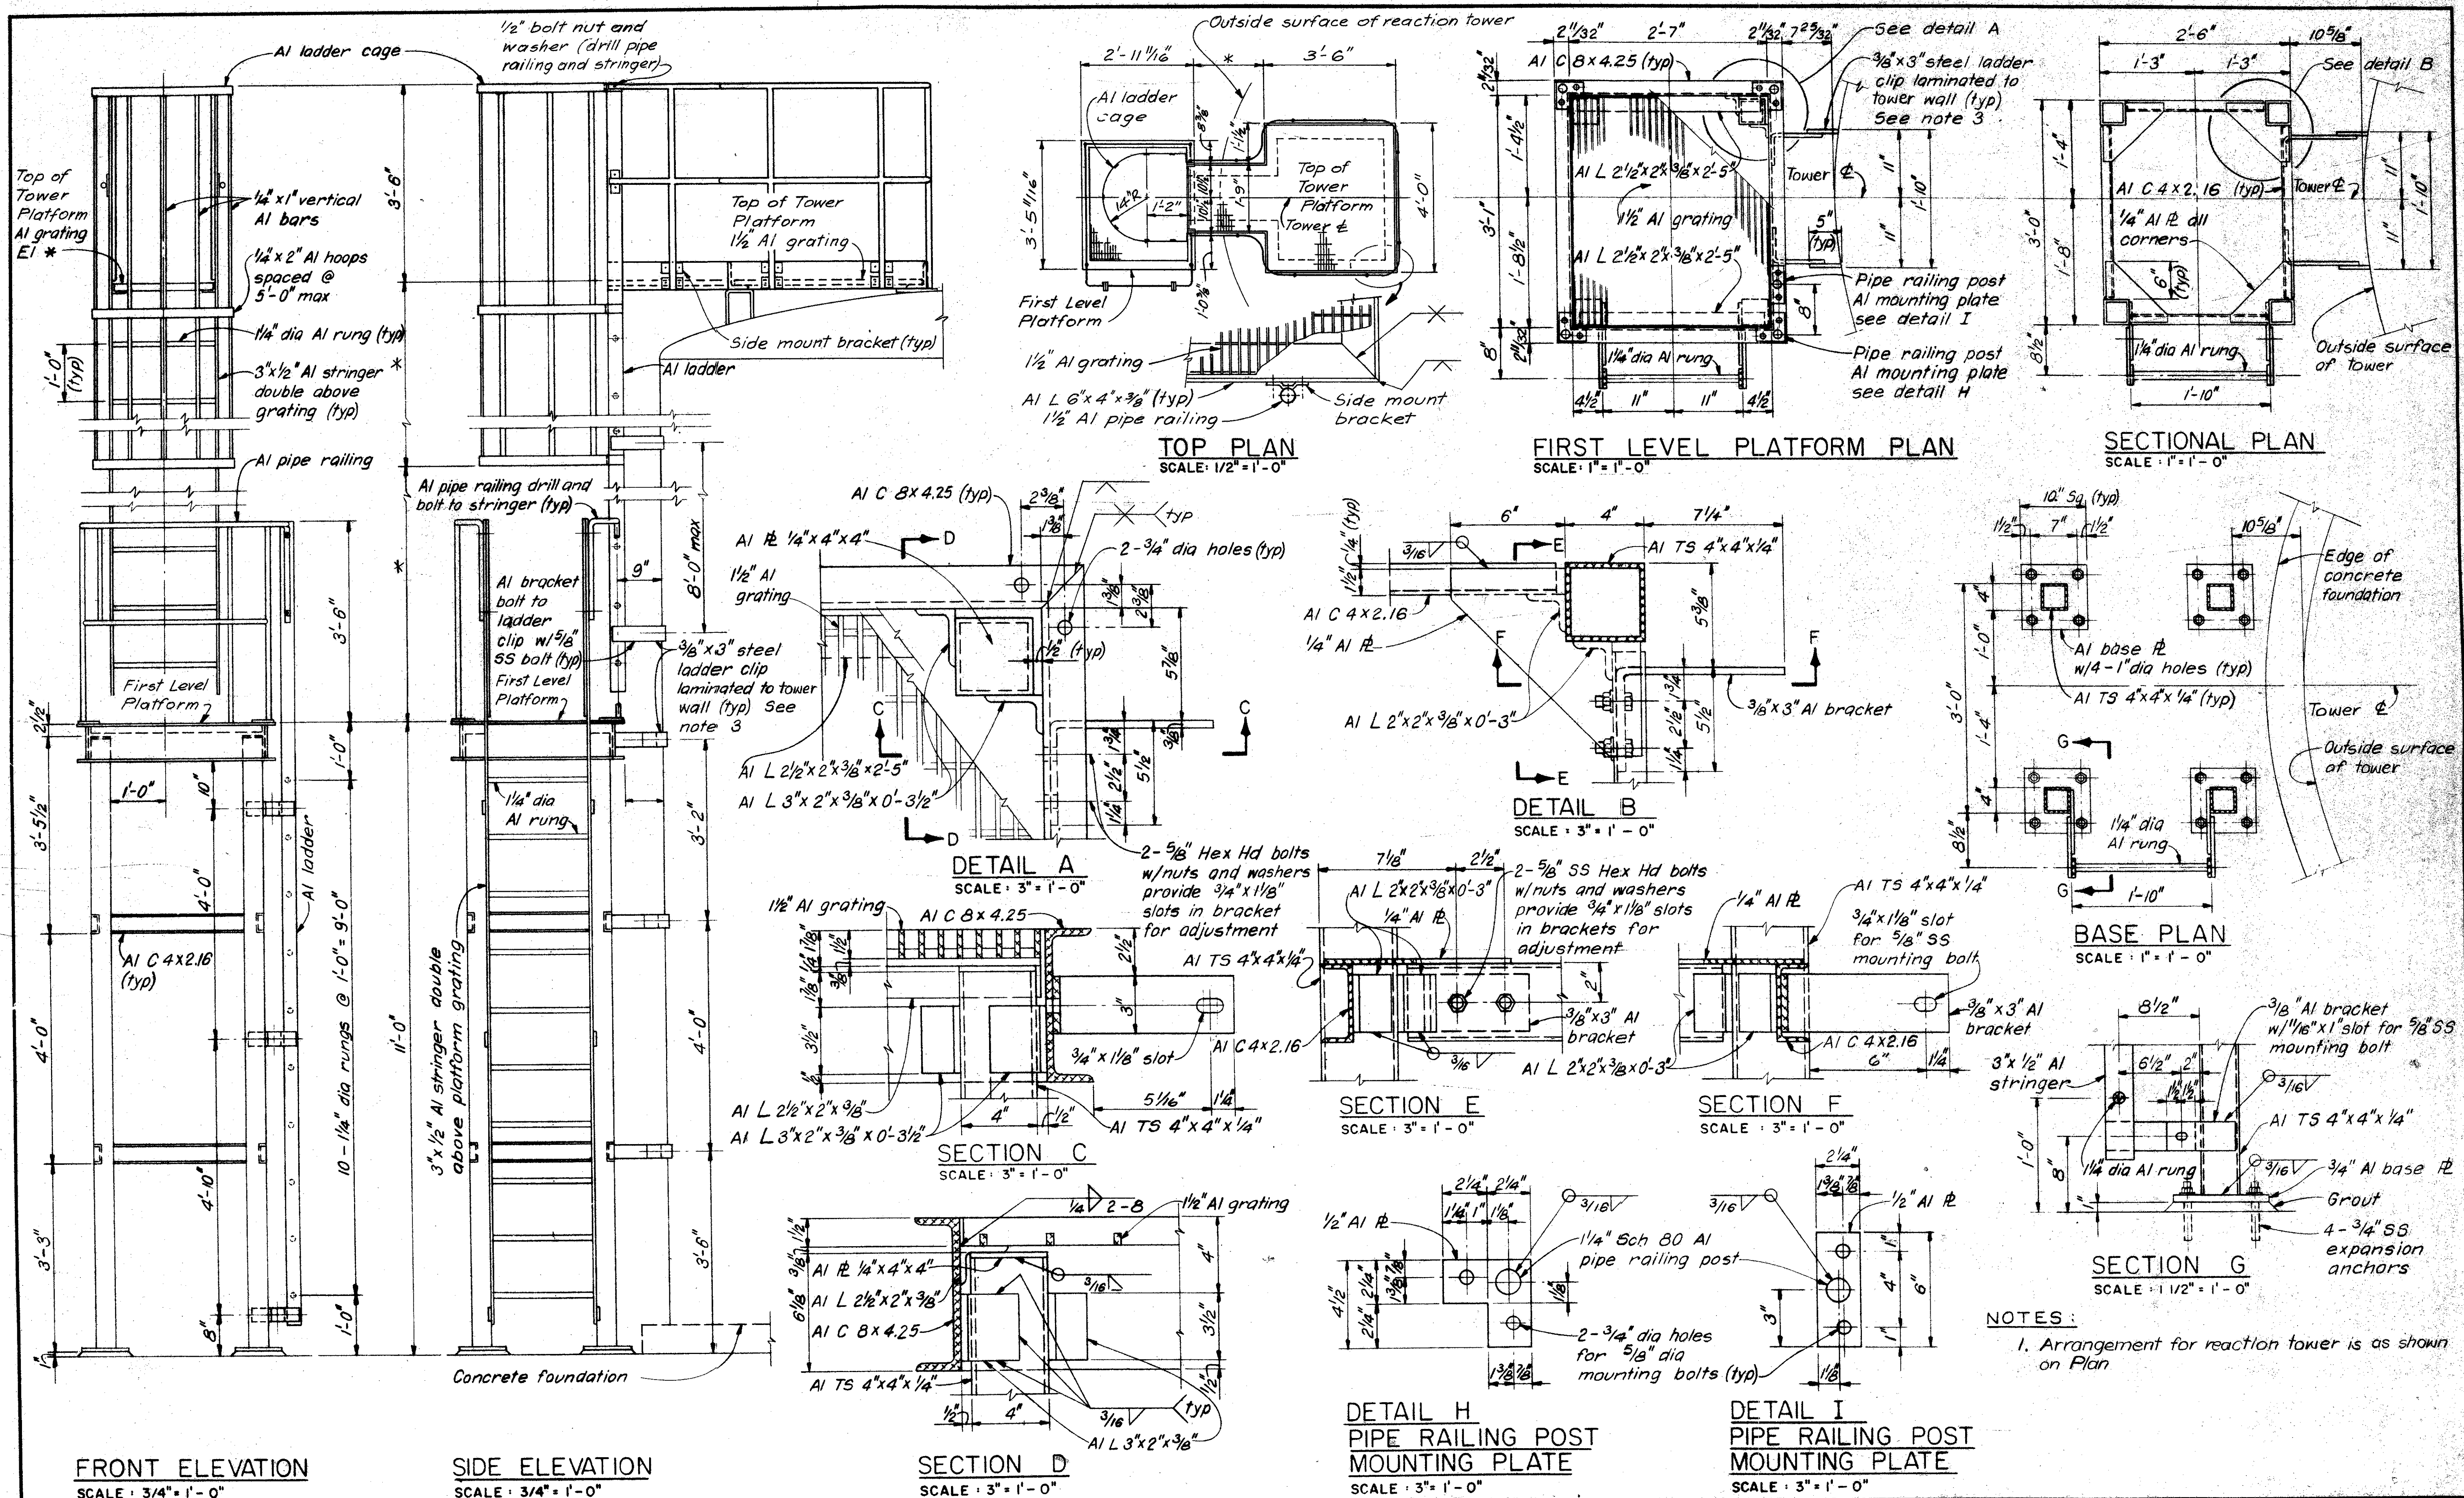


NOTES:
 1. Arrangement for reaction tower is as shown on Plan


GREELEY AND HANSEN ENGINEERS 222 S. RIVERSIDE PLAZA CHICAGO, ILLINOIS 60606	DESIGNED RN DRAWN SK CHECKED KSY REB	APPROVED _____ DATE _____ SUPT., DEPT. OF SANITARY SEWERS DATE _____ GREELEY AND HANSEN, ENGINEERS	NO. DATE APP. REVISION	SCALE 0 3 FT 3/4" = 1'-0" 0 8 FT 1" = 1'-0" 0 1 1/2 FT 3" = 1'-0"	CITY OF TAMPA, FLORIDA SEWAGE DISPOSAL SYSTEM DIVISION 4L5 PUMPING STATIONS ODOR CONTROL MODIFICATIONS	PROJ. NO. ODOR CONTROL FACILITIES PLATFORM AND LADDER DETAILS	SHEET 3 OF 10 DATE JULY 1985 REV. 0
	304-16						

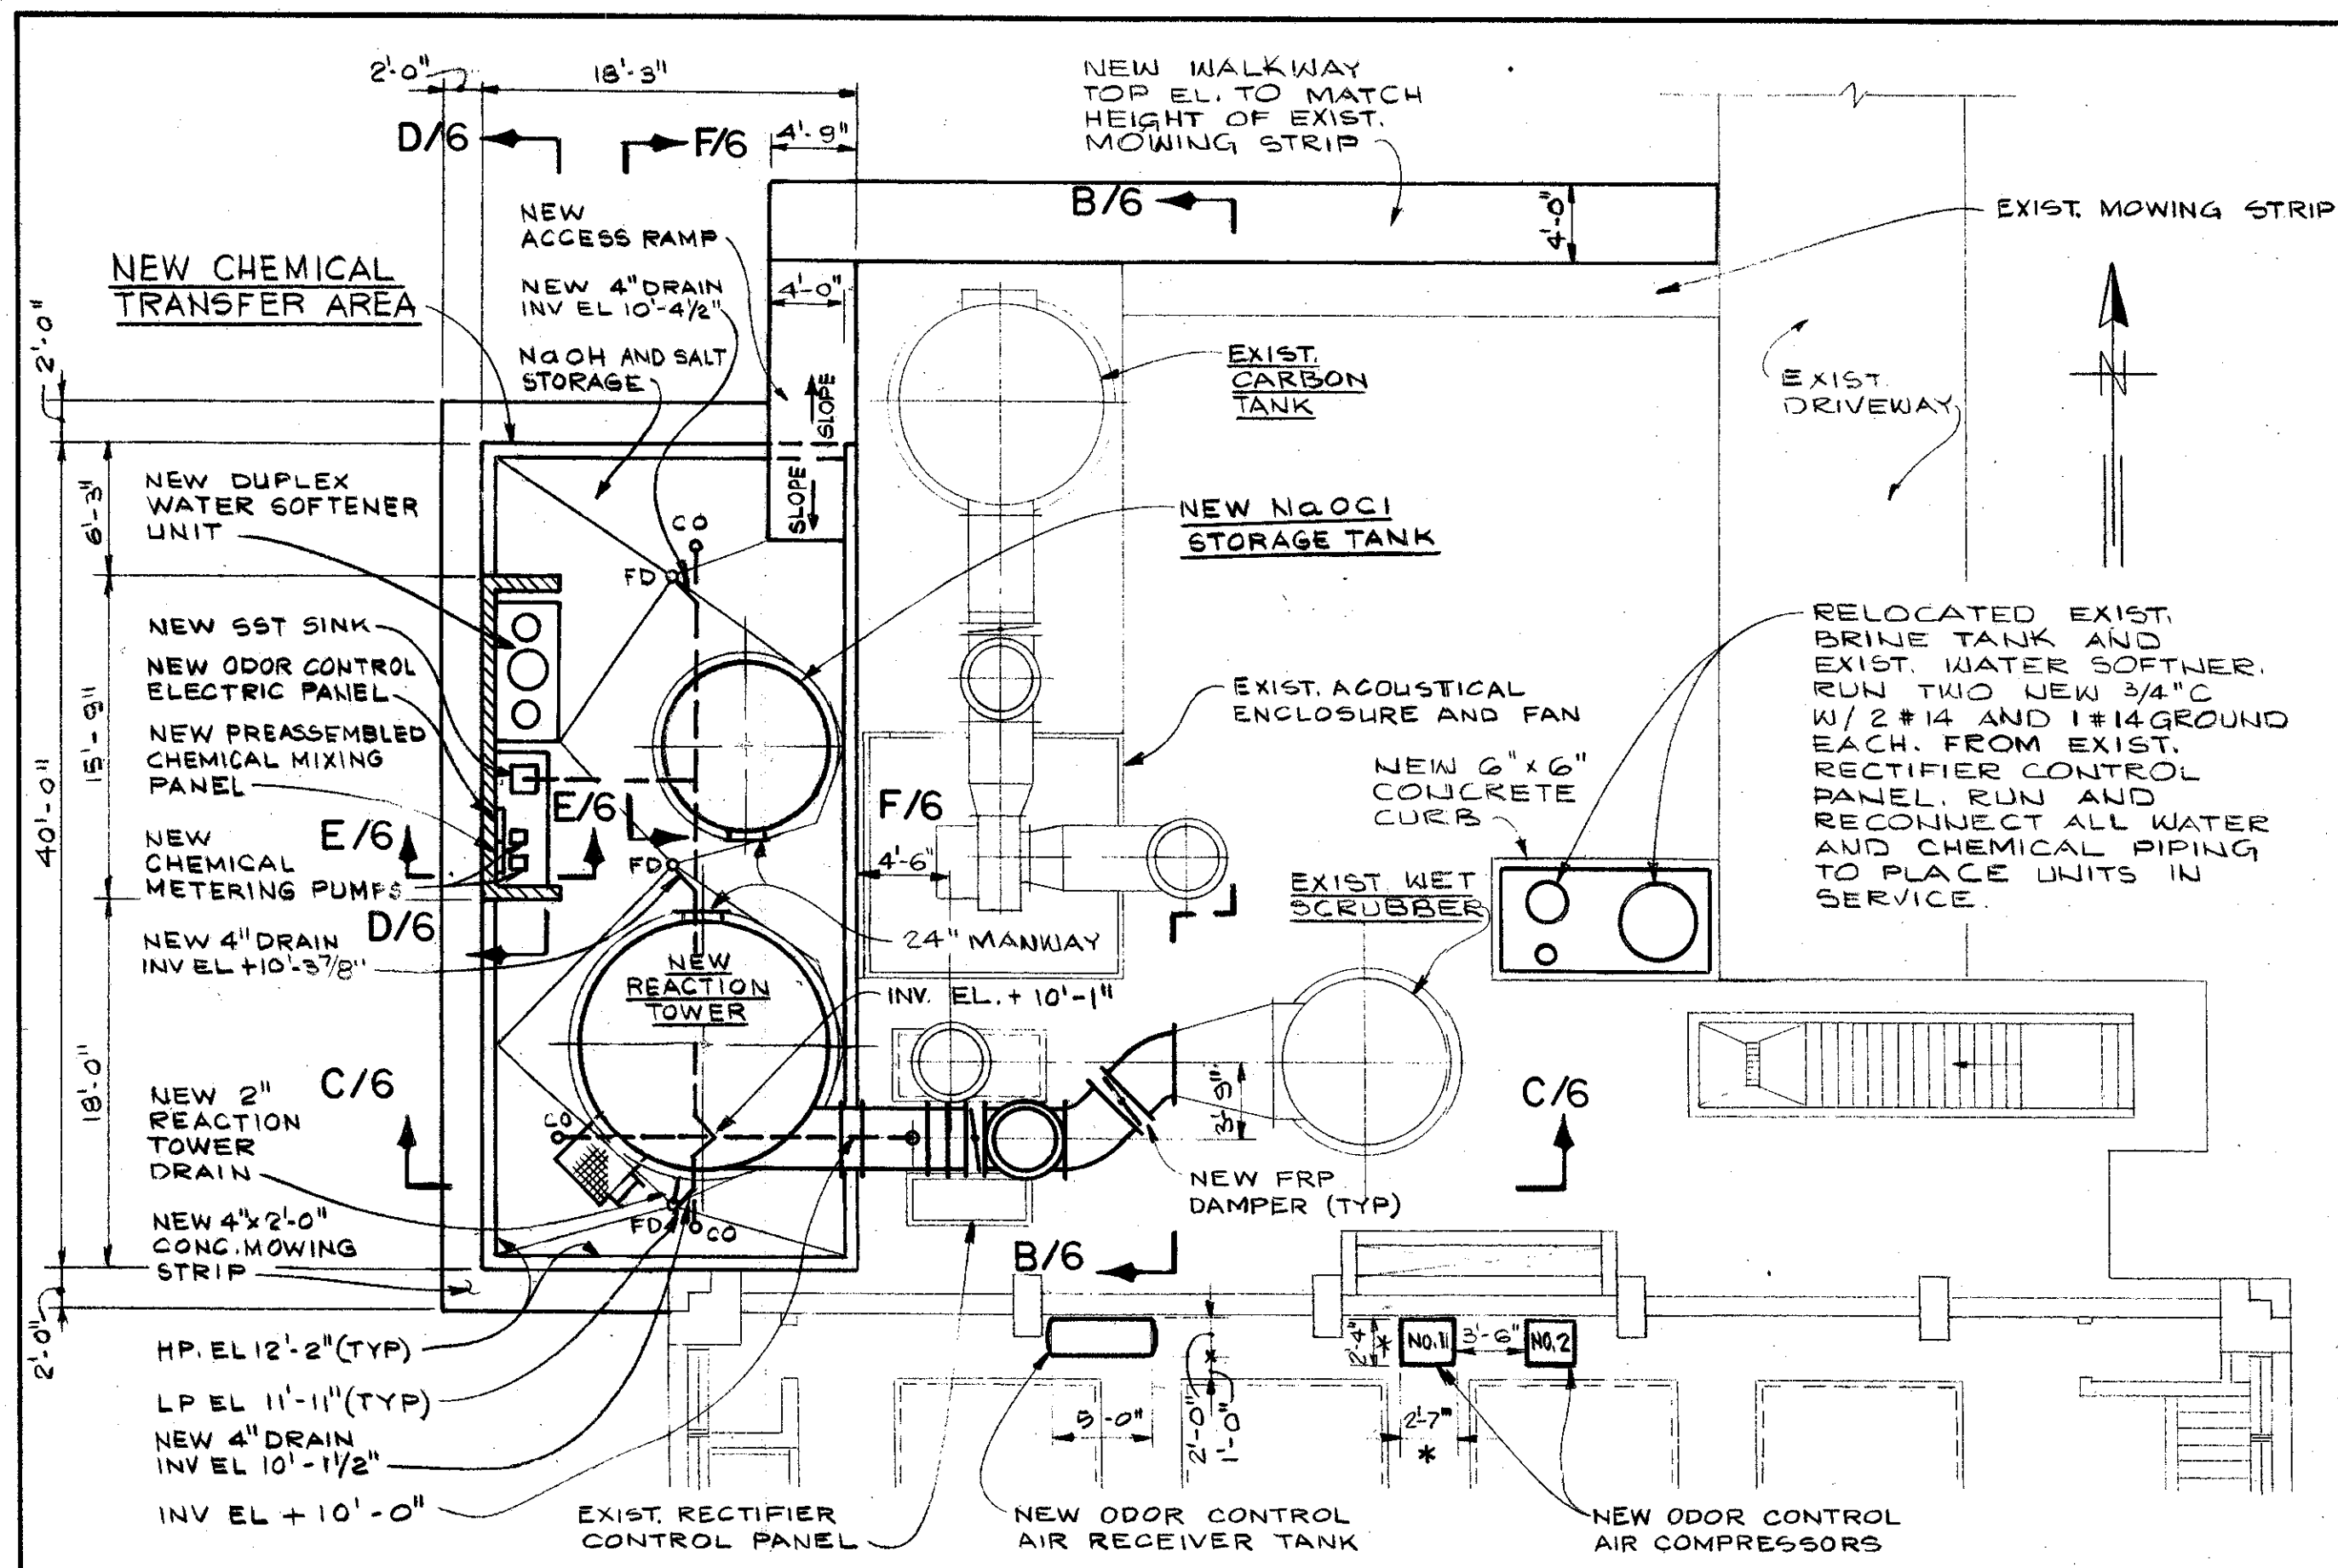


YBOR PUMPING STATION - PLAN AT EL 22'-0"
SCALE: 1/8" = 1'-0"

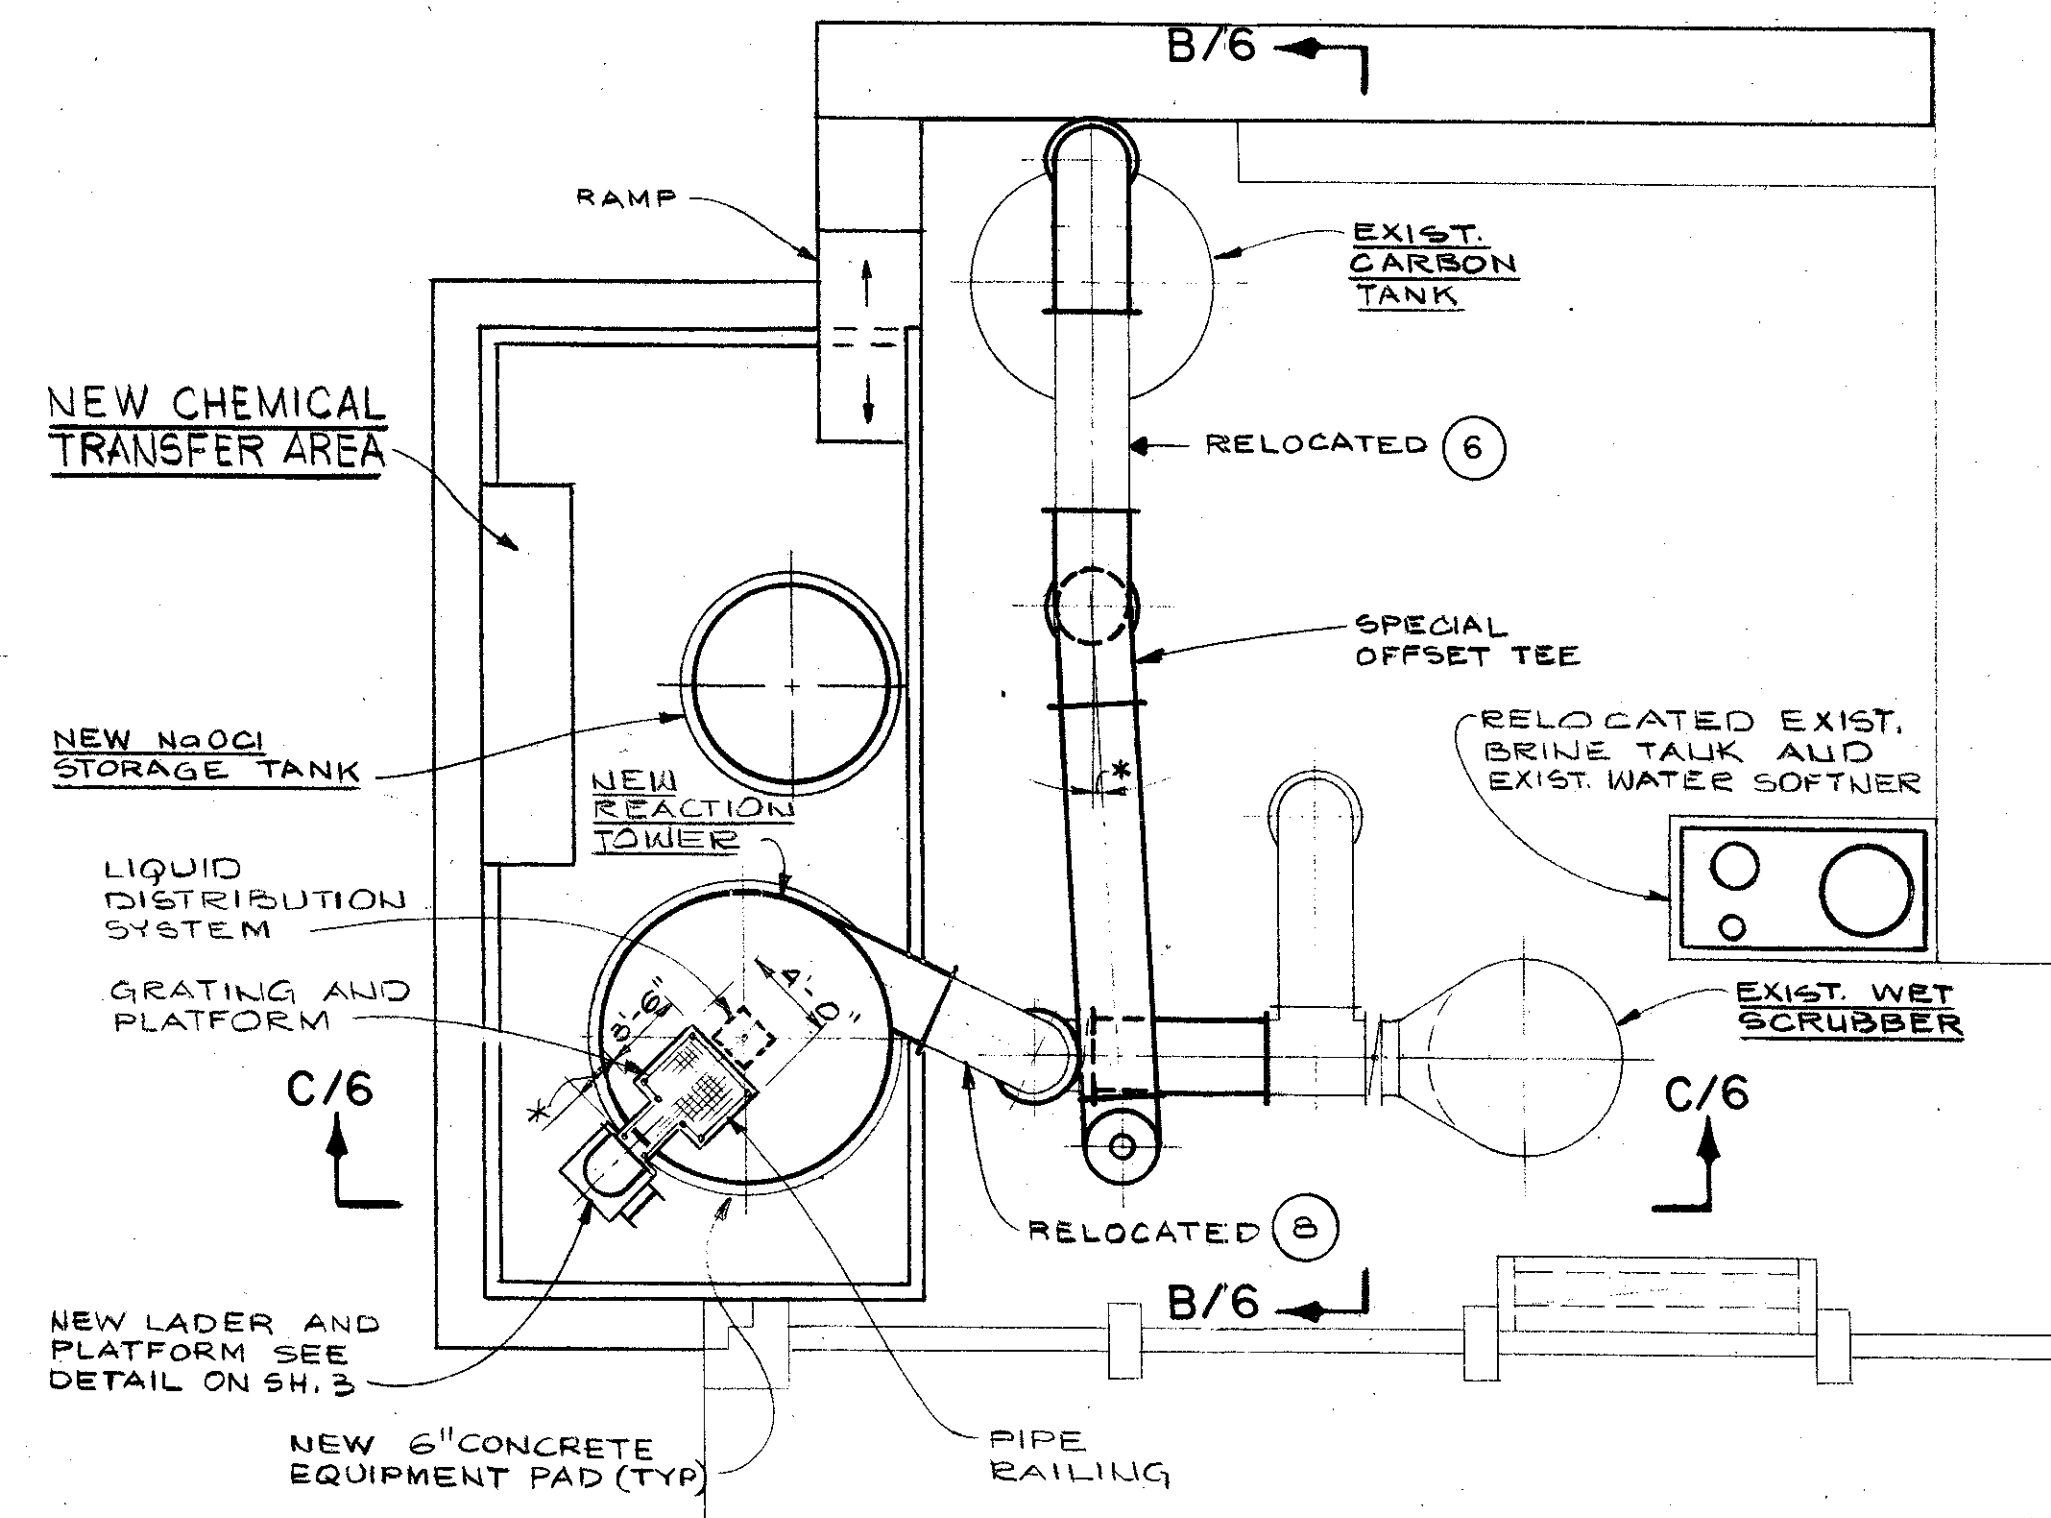


YBOR PUMPING STATION - TOP PLAN
SCALE: 1/8" = 1'-0"

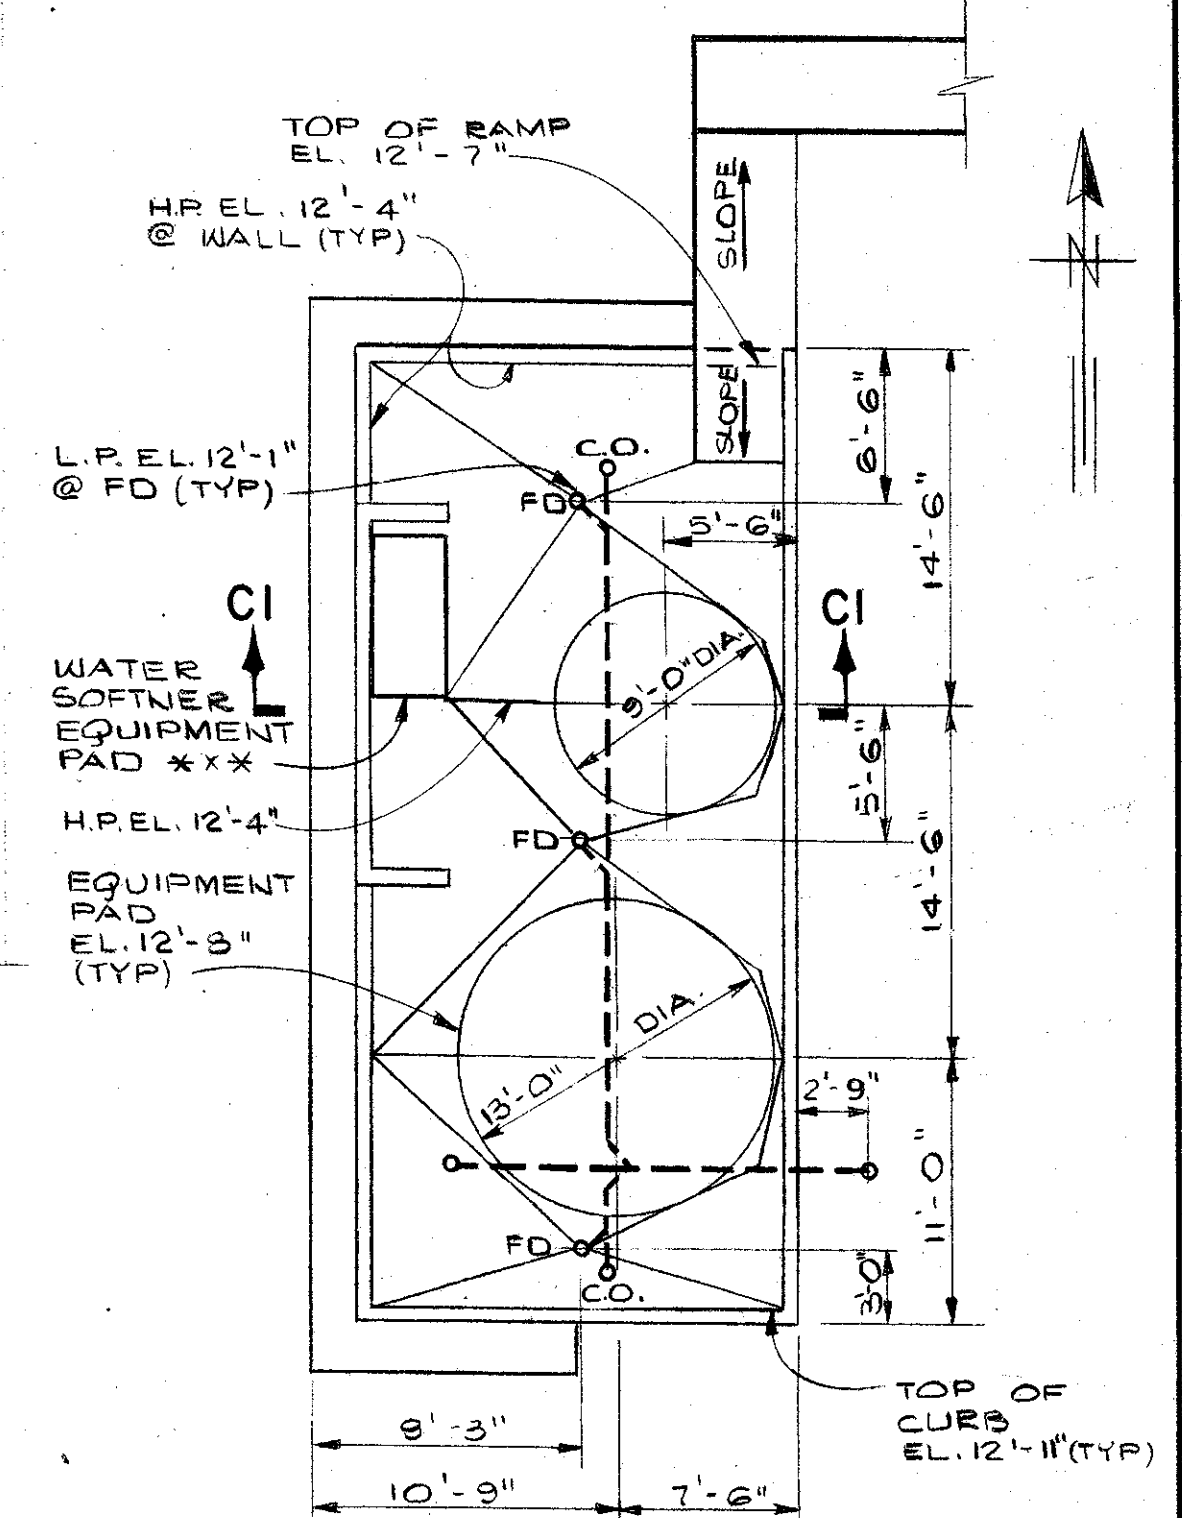


PART PLAN AT EL 12'-11"
SCALE: 1/8" = 1'-0"

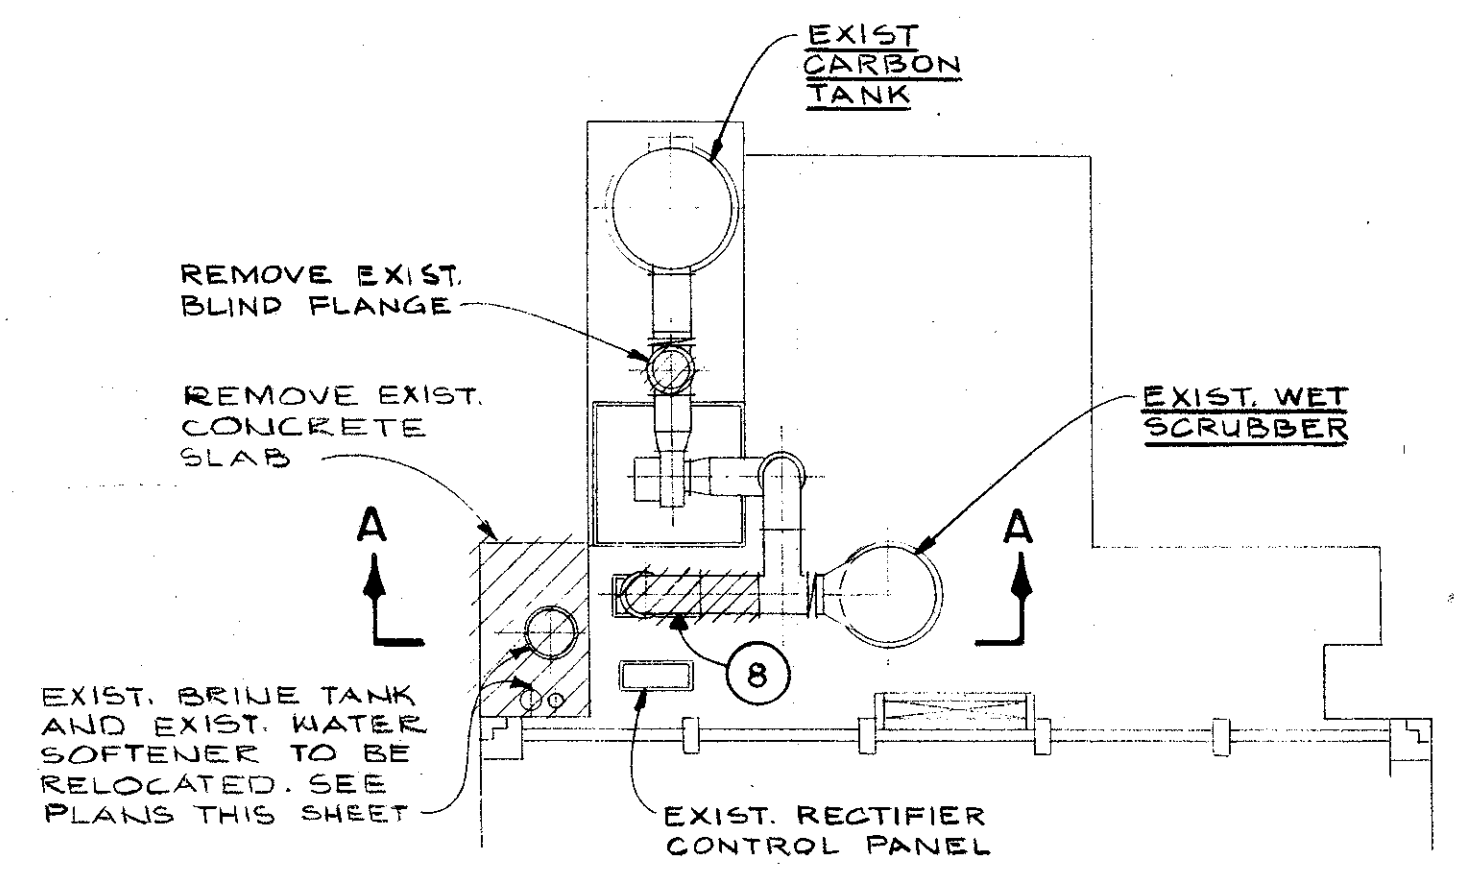


DEMOLITION PLAN
SCALE: 1/16" = 1'-0"

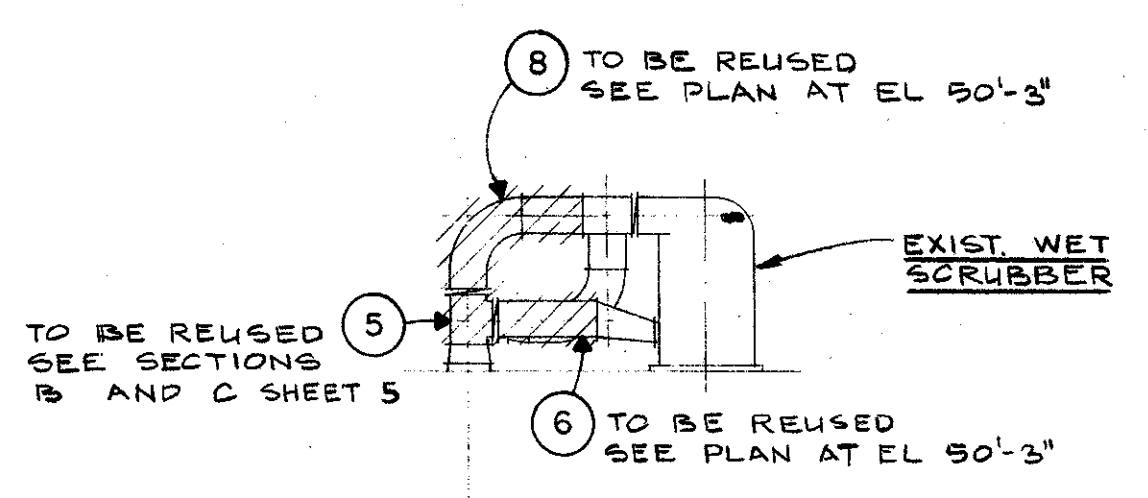

DEMOLITION SECTION A
SCALE: 1/16" = 1'-0"

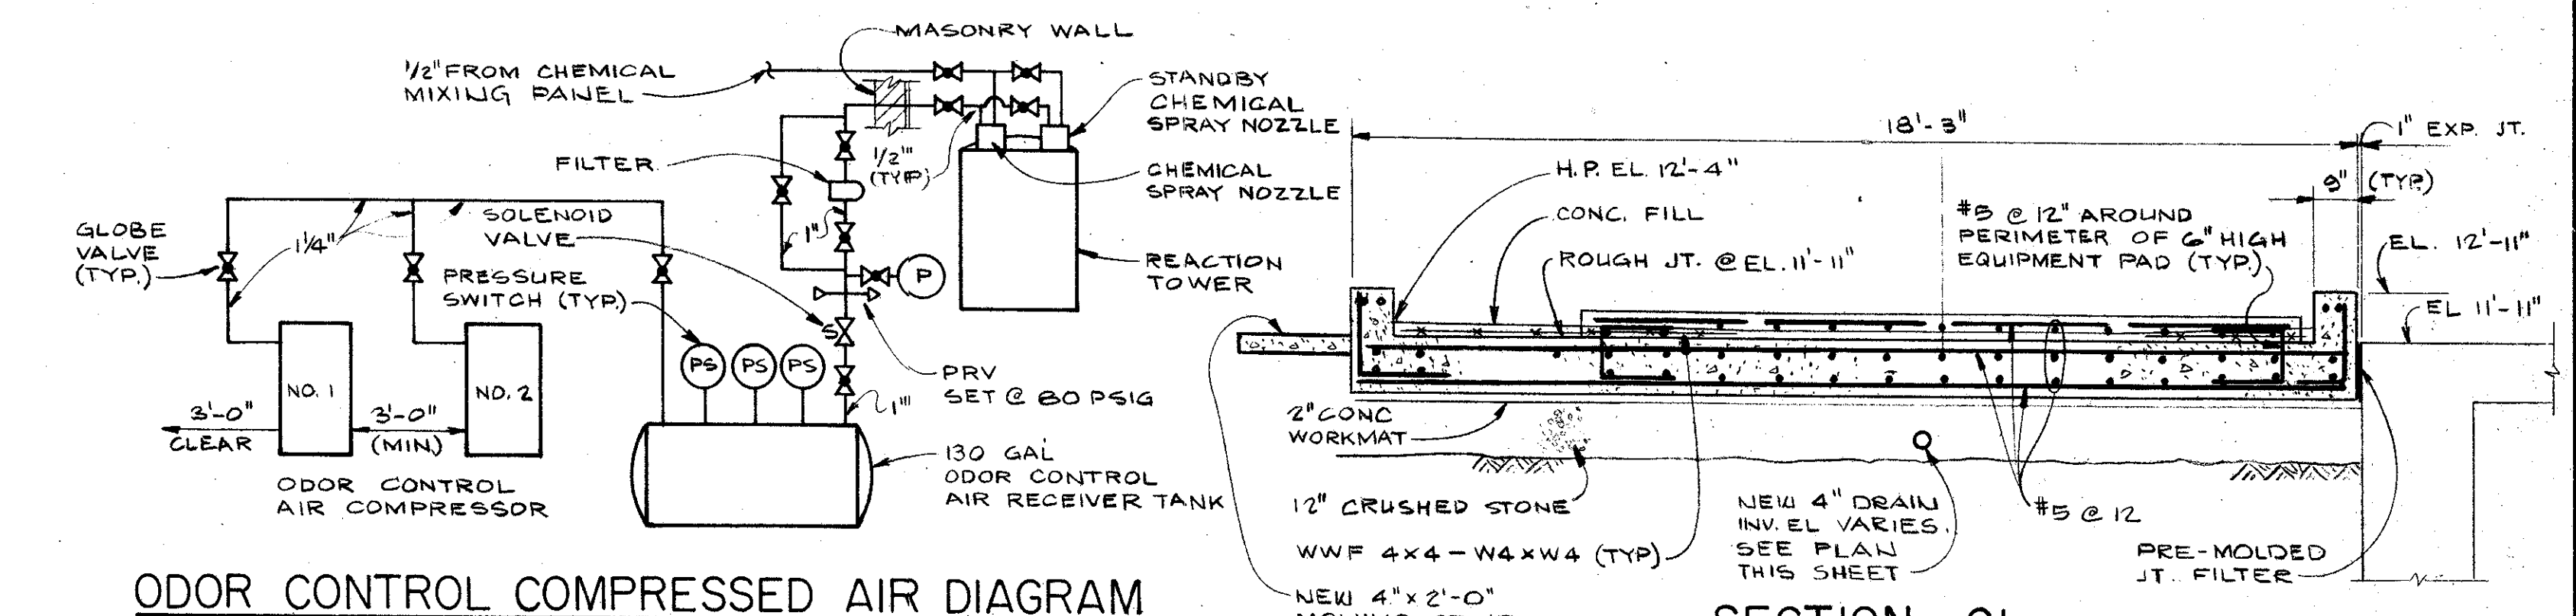

ODOR CONTROL COMPRESSED AIR DIAGRAM
NO SCALE

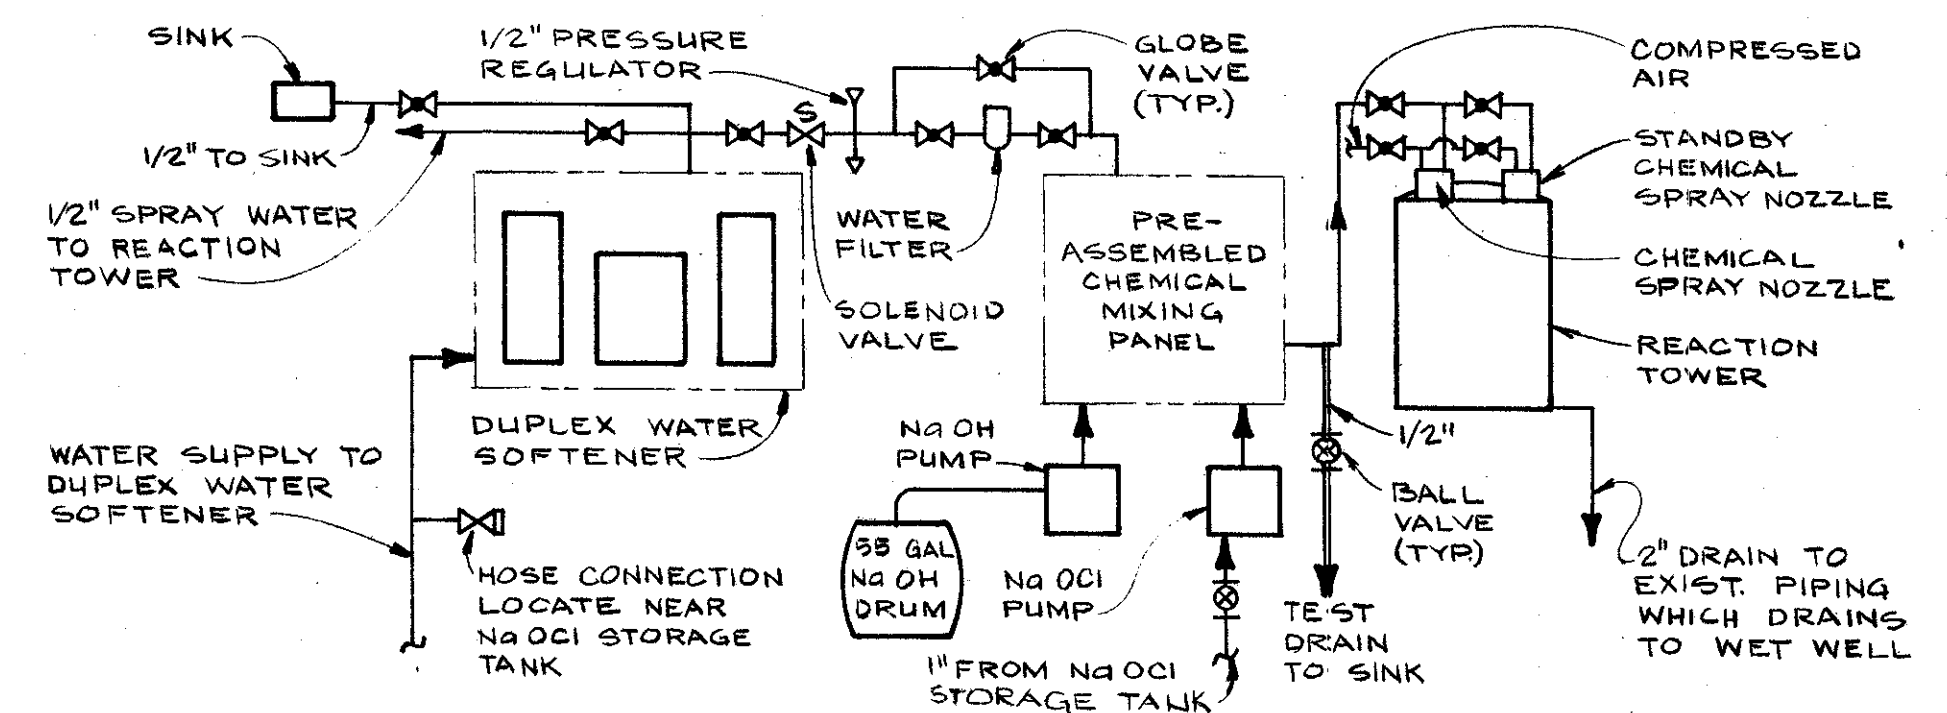

ODOR CONTROL CHEMICAL SYSTEM DIAGRAM
NO SCALE


- NOTES:**
- DUCTWORK DESIGNATED WITH A CIRCLED NUMBER IS EXISTING. SEE PEPCON DWG'S: 20.8-161 THROUGH 20.8-167 FOR EXISTING LOCATIONS.
 - EXISTING DUCTWORK DESIGNATED 5, 6, AND 8 IS TO BE RELOCATED AS SHOWN ON THESE DRAWINGS.
 - EACH FLANGED CONNECTION IN DUCTWORK REQUIRES A 1/8-INCH THICK GASKET.
 - ALL NEW DUCT WORK SHALL BE PIGMENTED WHITE AND SHALL MATCH CONSTRUCTION OF EXISTING DUCT IN ALL RESPECTS.
 - THIS SHEET APPLIES ONLY TO SYSTEMS WHICH REQUIRE HIGH PRESSURE AIR COMPRESSOR EQUIPMENT.

GREELEY AND HANSEN
ENGINEERS
222 S. RIVERSIDE PLAZA
CHICAGO, ILLINOIS 60606

DESIGNED MPV JRP
DRAWN SK
CHECKED JRP

APPROVED

NO.	DATE	APP.	REVISION

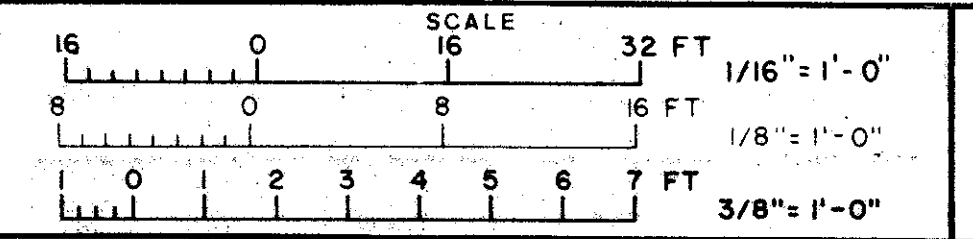


CITY OF TAMPA, FLORIDA
SEWAGE DISPOSAL SYSTEM
DIVISION 4L5
PUMPING STATIONS
ODOR CONTROL MODIFICATIONS

YBOR PUMPING STATION
PLANS, SECTIONS, DIAGRAMS

PROJ. NO.
DWG SHEET **4** OF 10
DATE JULY 1985 REV 0


304-17

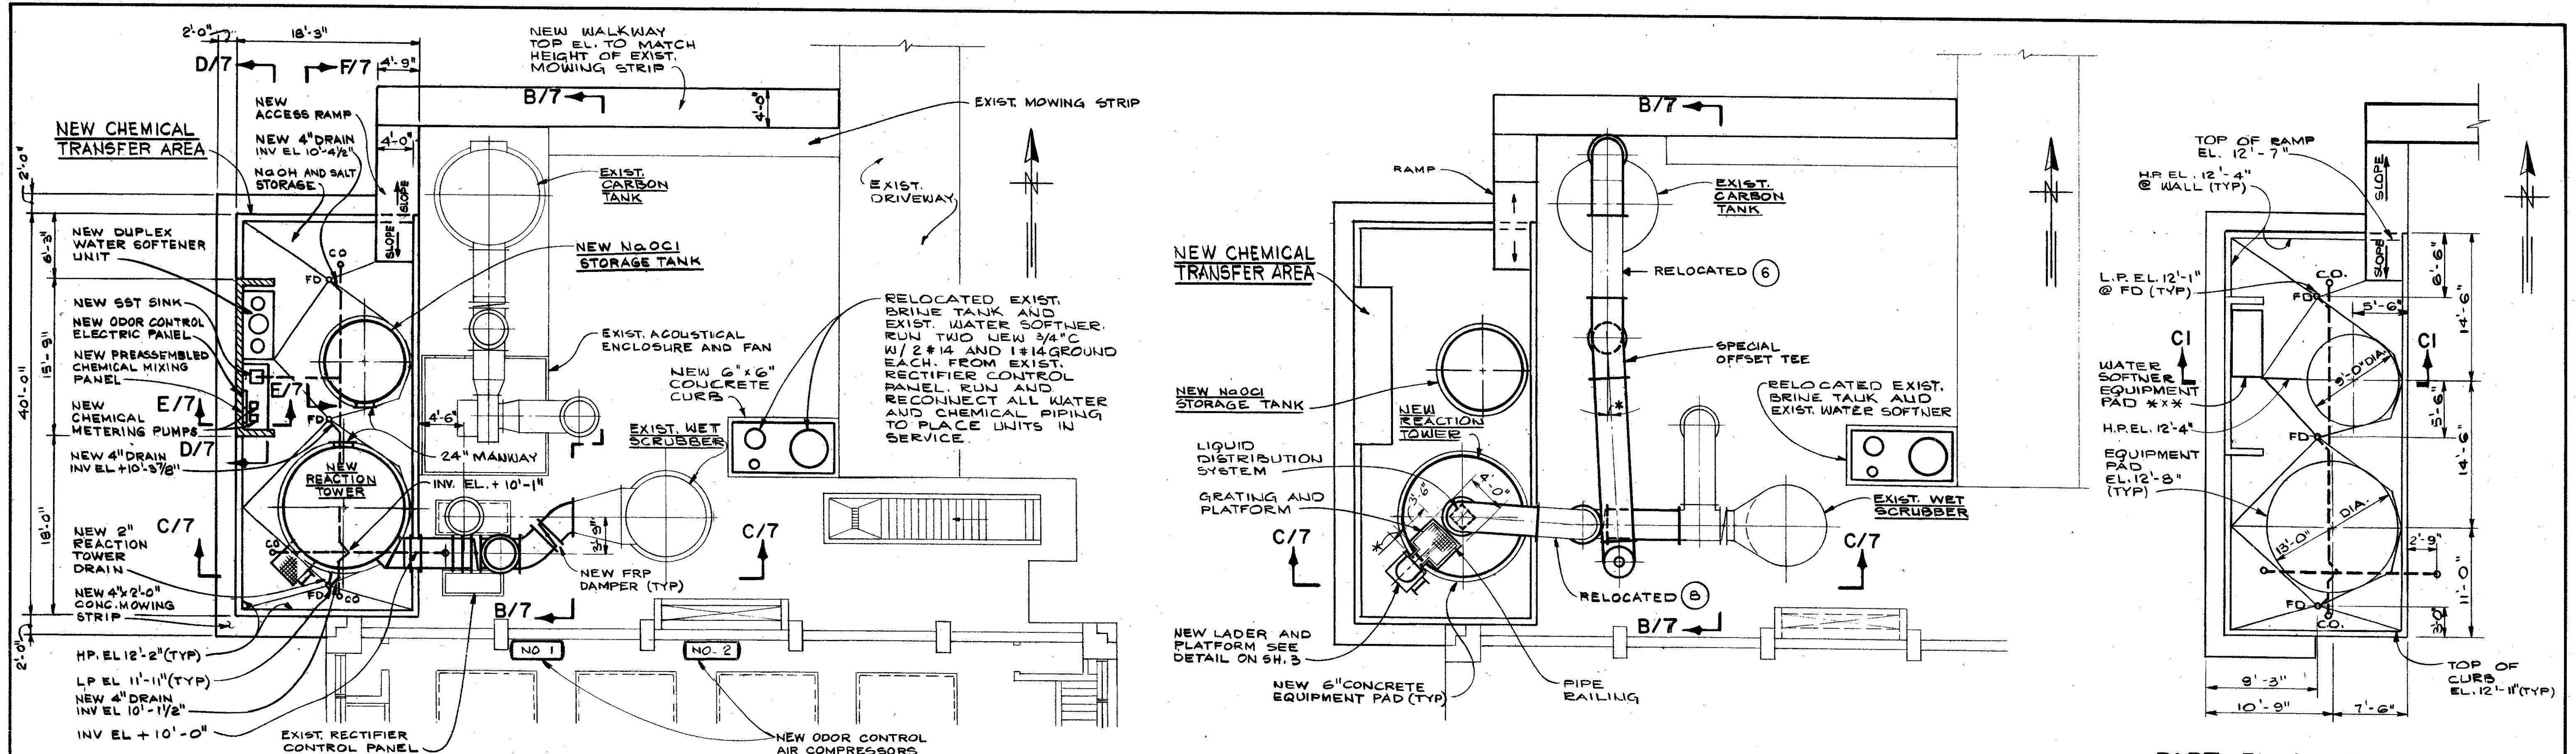


YBOR PUMPING STATION - PLAN AT EL 22'-0"
SCALE: 1/8" = 1'-0"

YBOR PUMPING STATION - TOP PLAN
SCALE: 1/8" = 1'-0"


PART PLAN AT EL 12'-11"
SCALE: 1/8" = 1'-0"

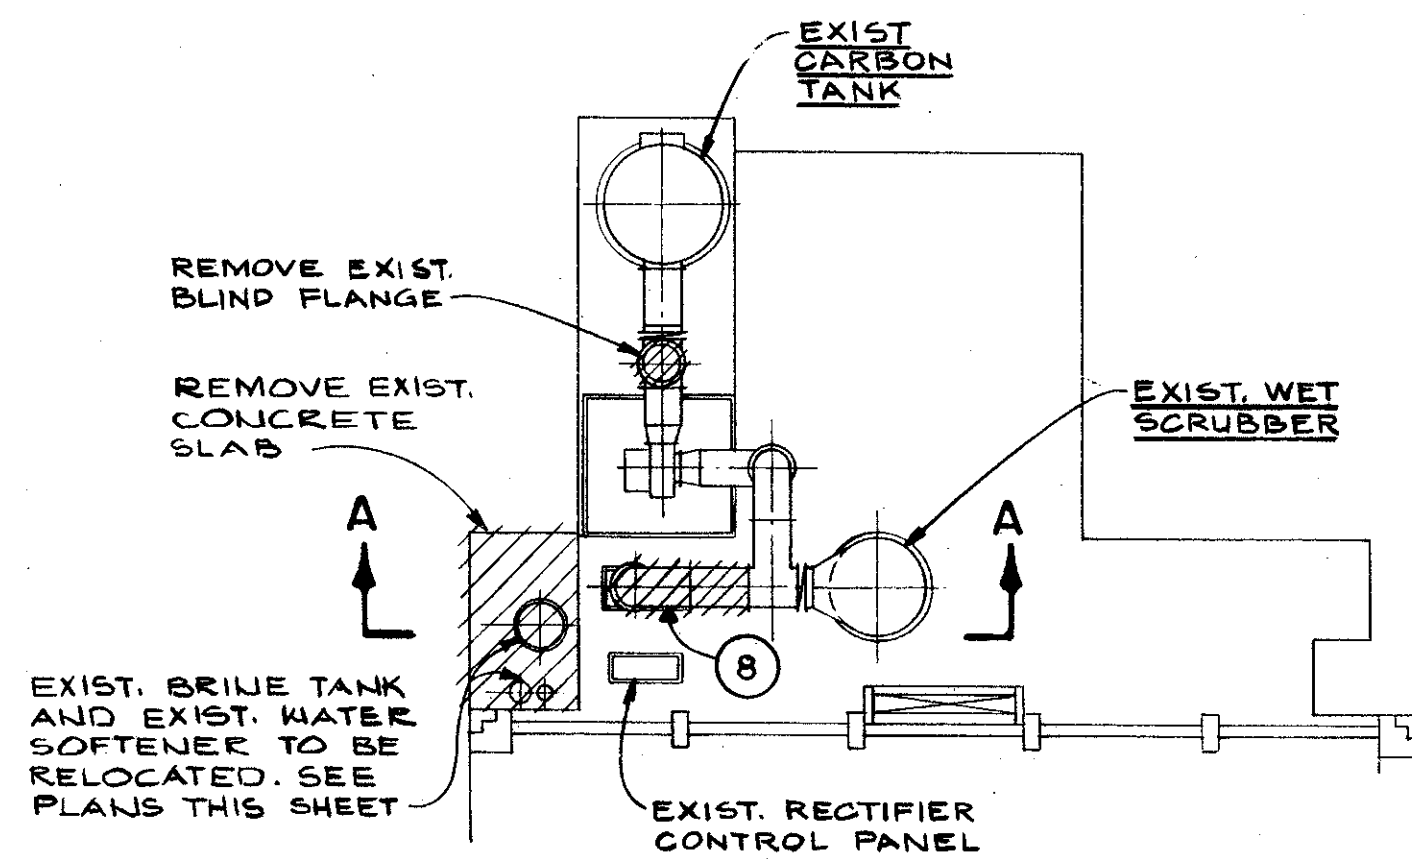


DEMOLITION PLAN
SCALE: 1/16" = 1'-0"

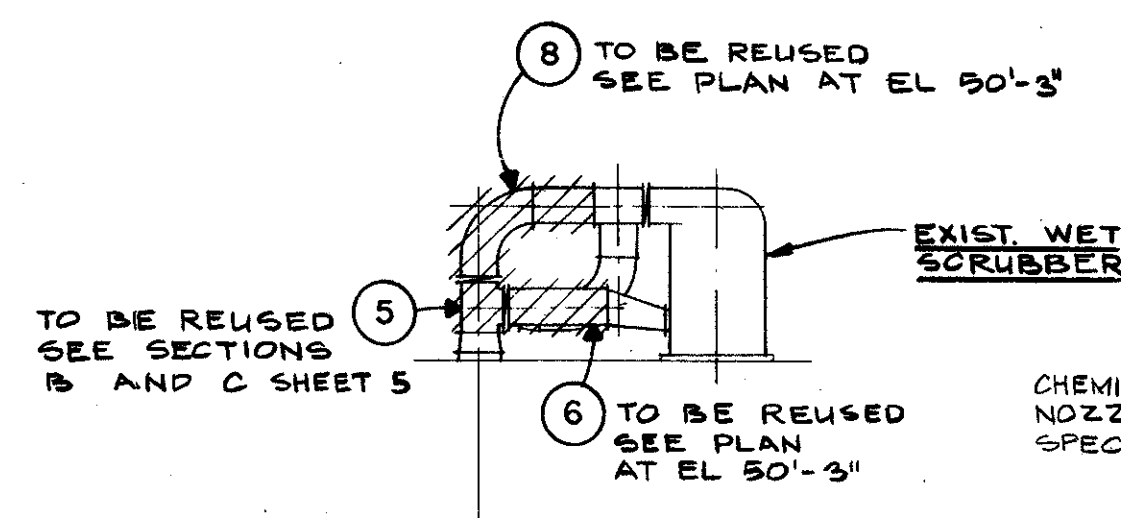


DEMOLITION SECTION A
SCALE: 1/16" = 1'-0"

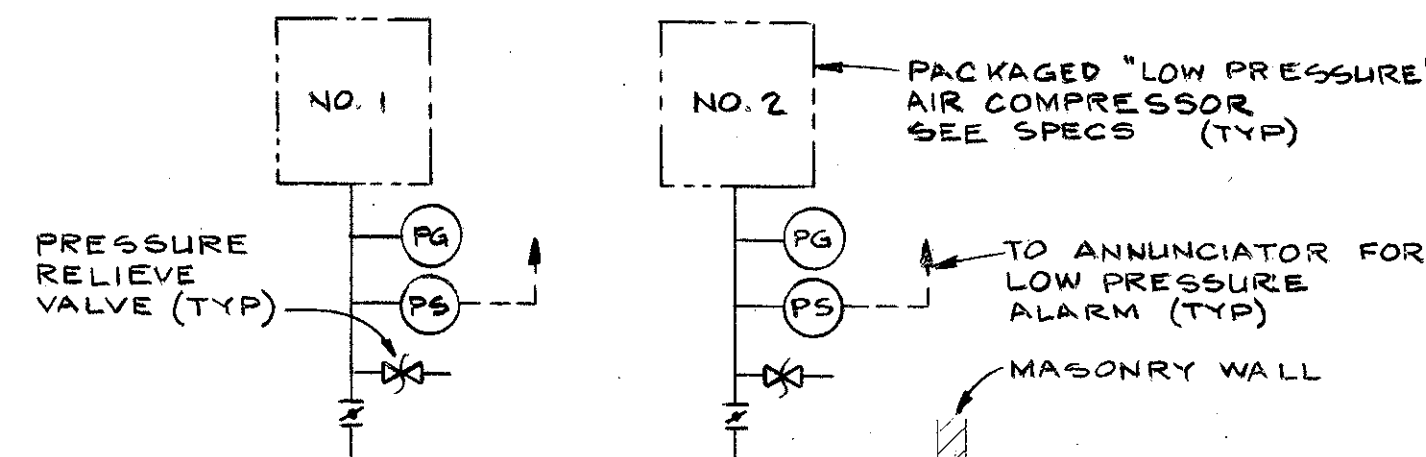

ODOR CONTROL CHEMICAL AIR DIAGRAM
NO SCALE

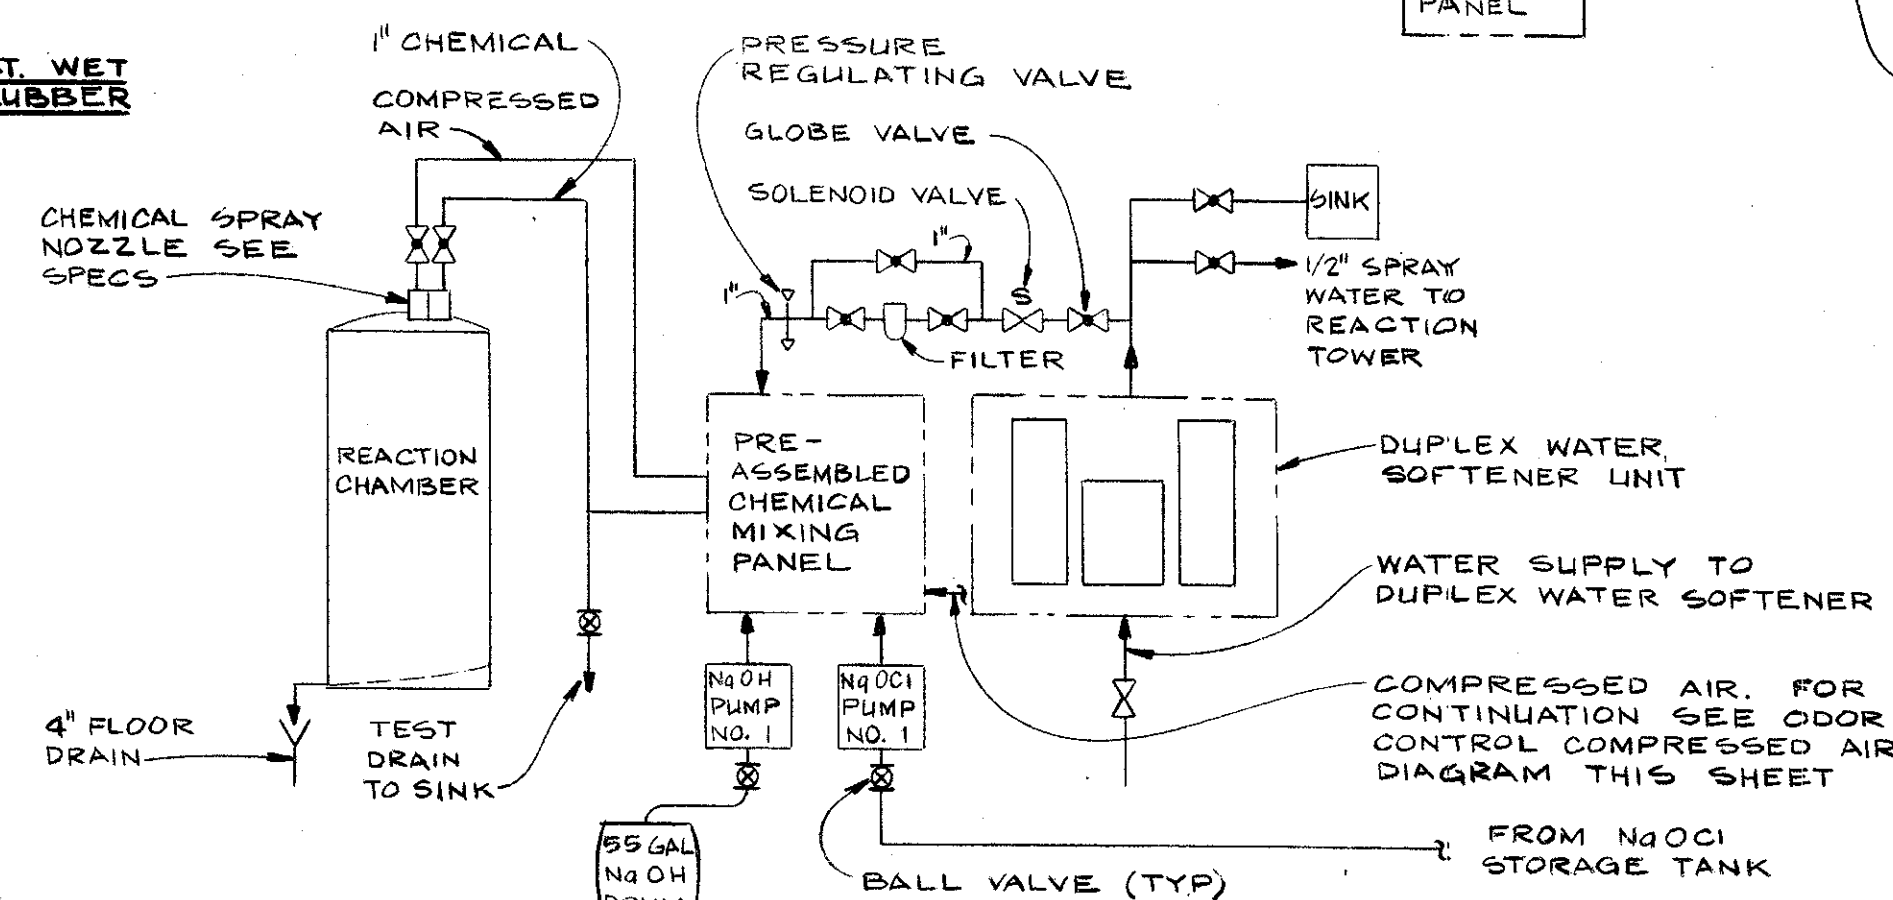

ODOR CONTROL CHEMICAL SYSTEM DIAGRAM
NO SCALE

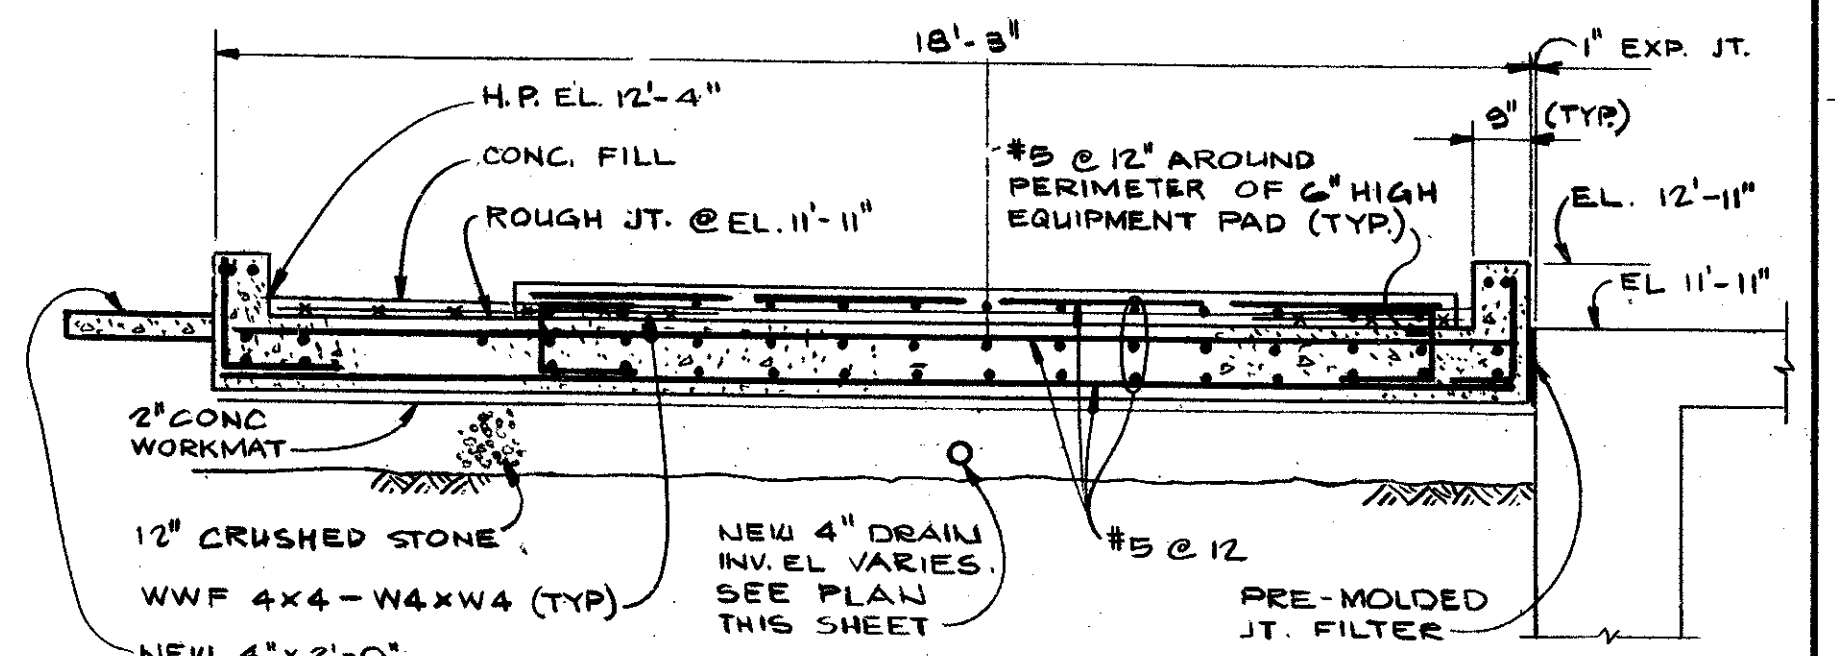

SECTION C1
SCALE: 3/8" = 1'-0"


- NOTES:**
- DUCTWORK DESIGNATED WITH A CIRCLED NUMBER IS EXISTING. SEE PEPCON DWG'S: 20.8-161 THROUGH 20.8-167 FOR EXISTING LOCATIONS.
 - EXISTING DUCTWORK DESIGNATED 5, 6, AND 8 IS TO BE RELOCATED AS SHOWN ON THESE DRAWINGS.
 - EACH FLANGED CONNECTION IN DUCTWORK REQUIRES A 1/8-INCH THICK GASKET.
 - ALL NEW DUCT WORK SHALL BE PIGMENTED WHITE AND SHALL MATCH CONSTRUCTION OF EXISTING DUCT IN ALL RESPECTS.
 - THIS SHEET APPLIES ONLY TO SYSTEMS WHICH REQUIRE LOW PRESSURE AIR COMPRESSOR EQUIPMENT.

GREELEY AND HANSEN
ENGINEERS
222 S. RIVERSIDE PLAZA
CHICAGO, ILLINOIS 60606

DESIGNED MPV JRP
DRAWN SK
CHECKED JRP

APPROVED

NO.	DATE	APP	REVISION

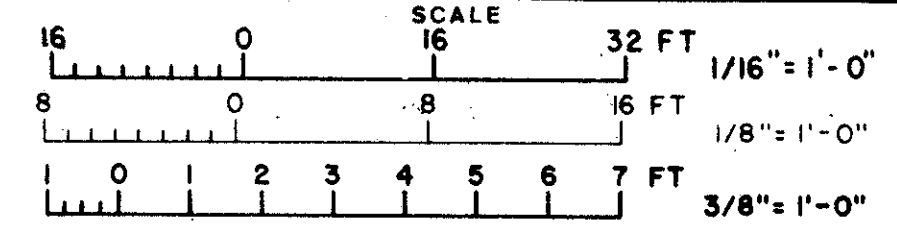


CITY OF TAMPA, FLORIDA
SEWAGE DISPOSAL SYSTEM
DIVISION 4L5
PUMPING STATIONS
ODOR CONTROL MODIFICATIONS

YBOR PUMPING STATION
PLANS, SECTIONS, DIAGRAMS


PROJ. NO.	
DWG SHEET	5 OF 10
DATE	JULY 1985
REV.	0

304-18

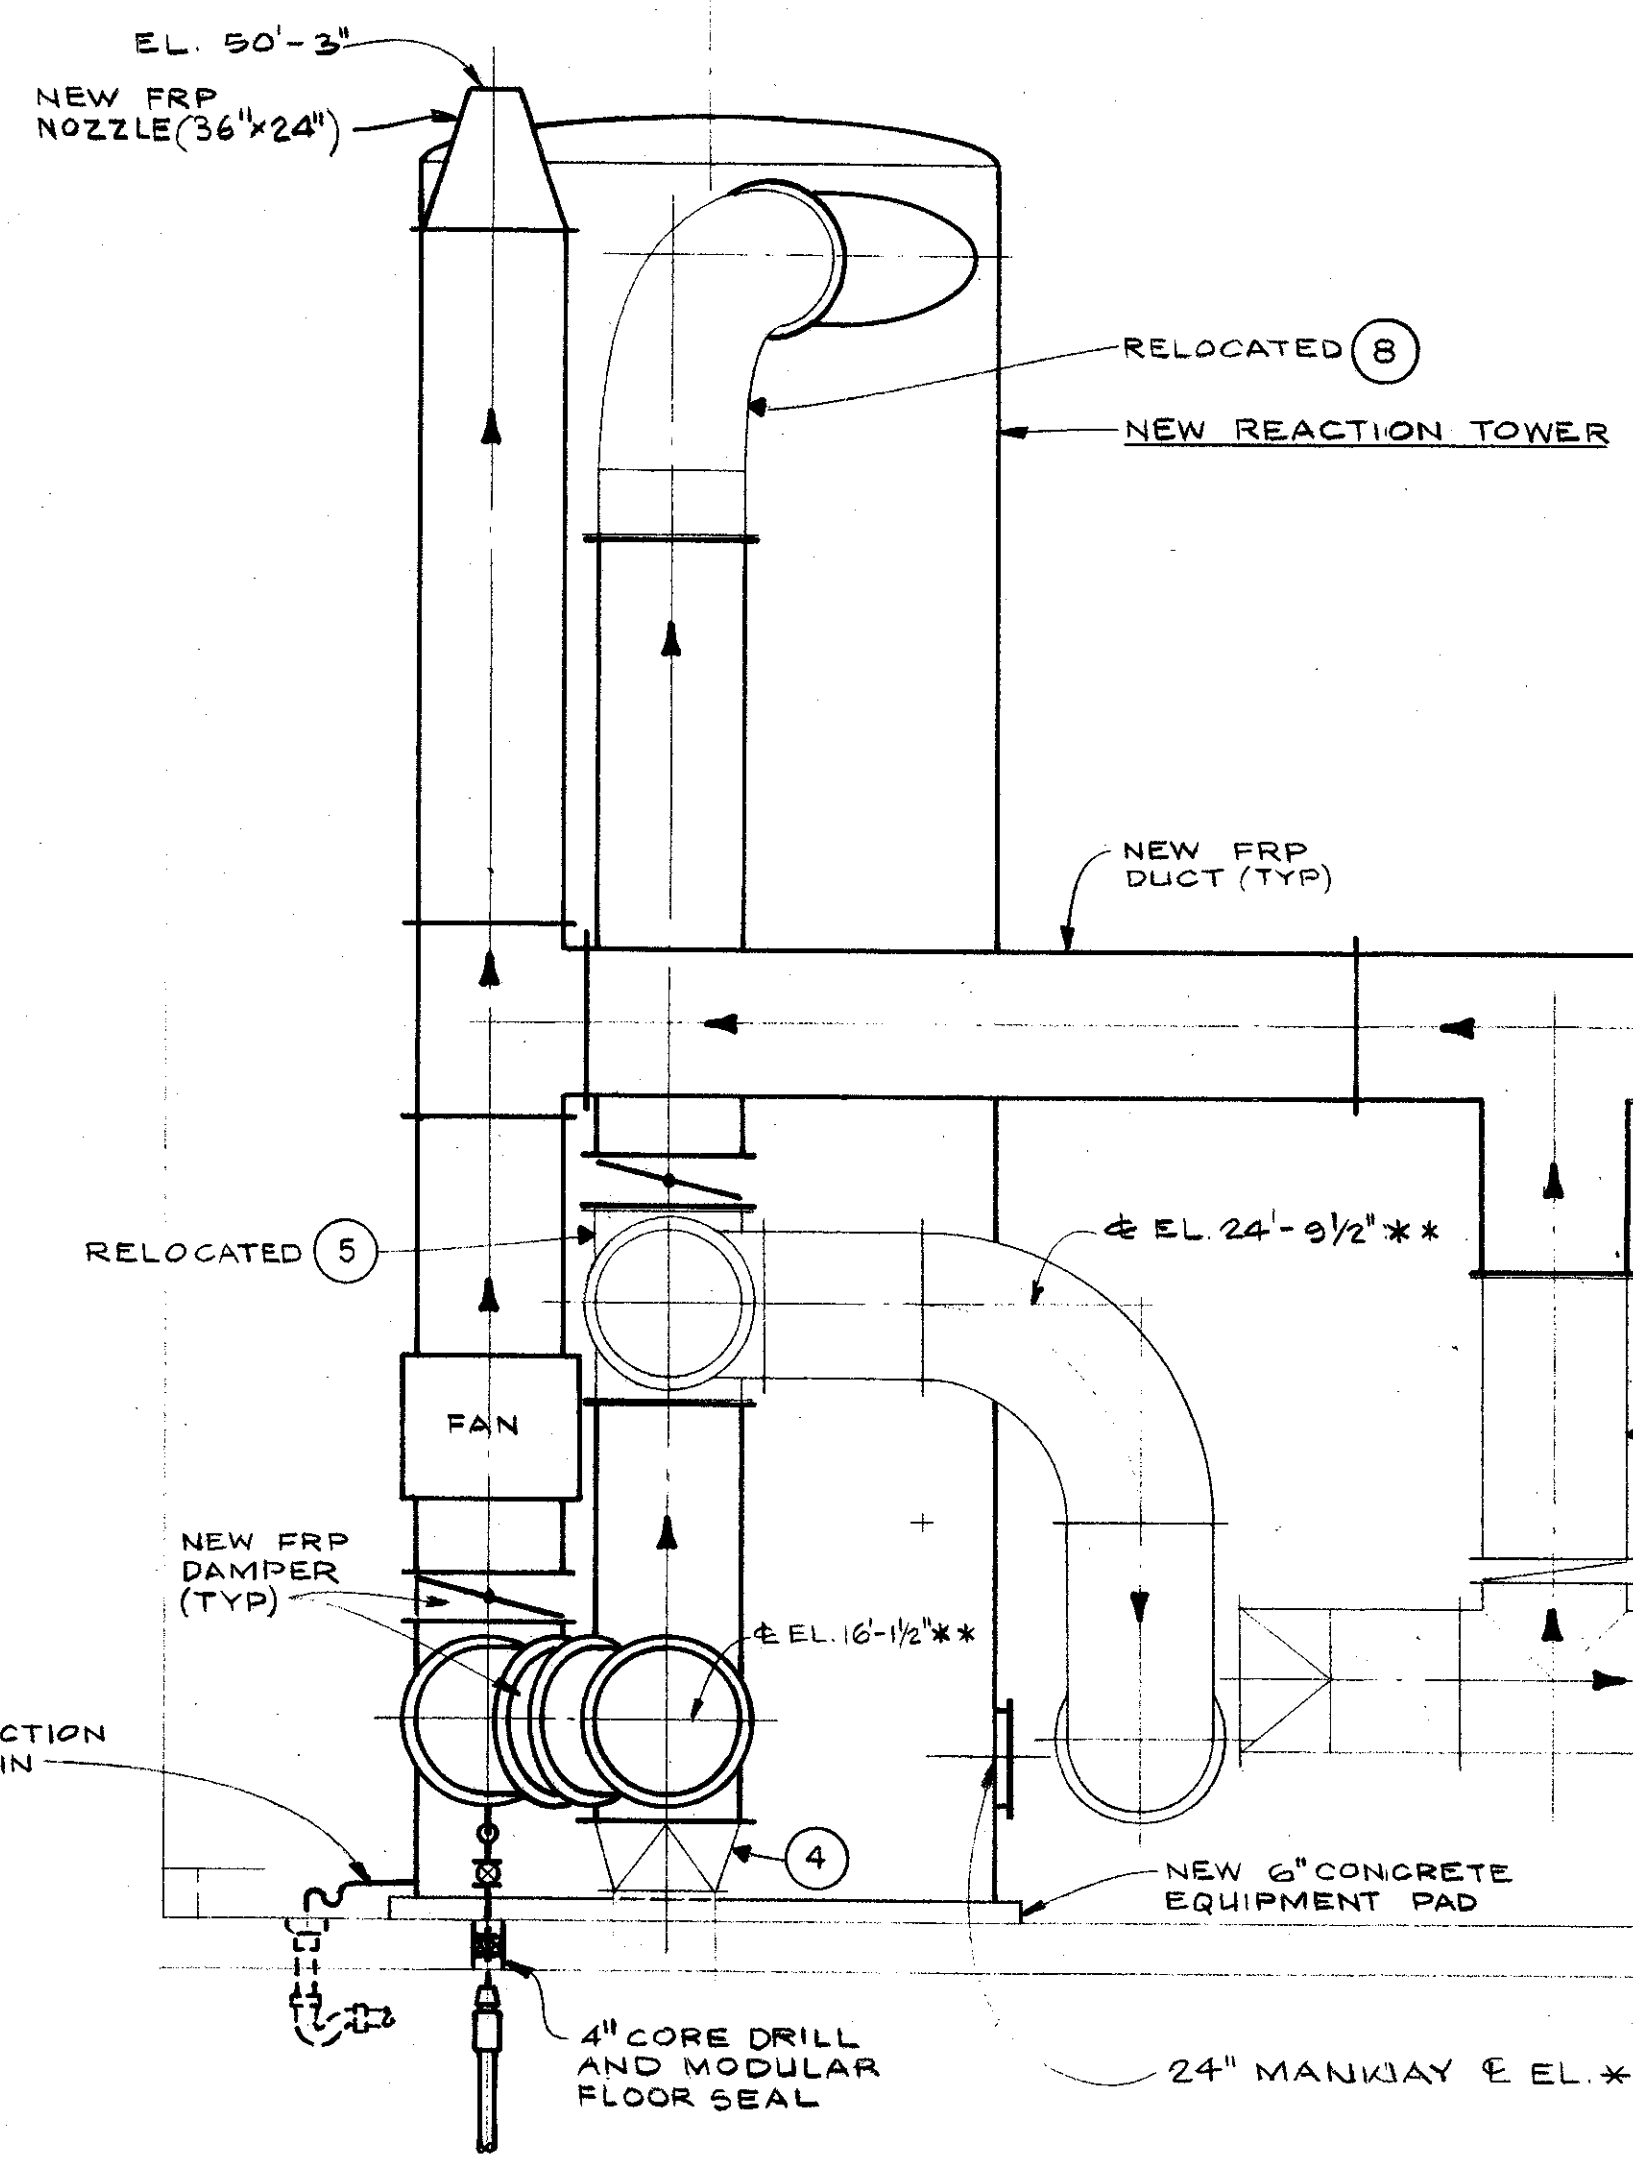


SECTION B/4
SCALE: 1/4" = 1'-0"


NOTE:
LADDER AND PLATFORMS NOT SHOWN ON THESE SECTIONS. FOR DETAILS SEE SH. 3

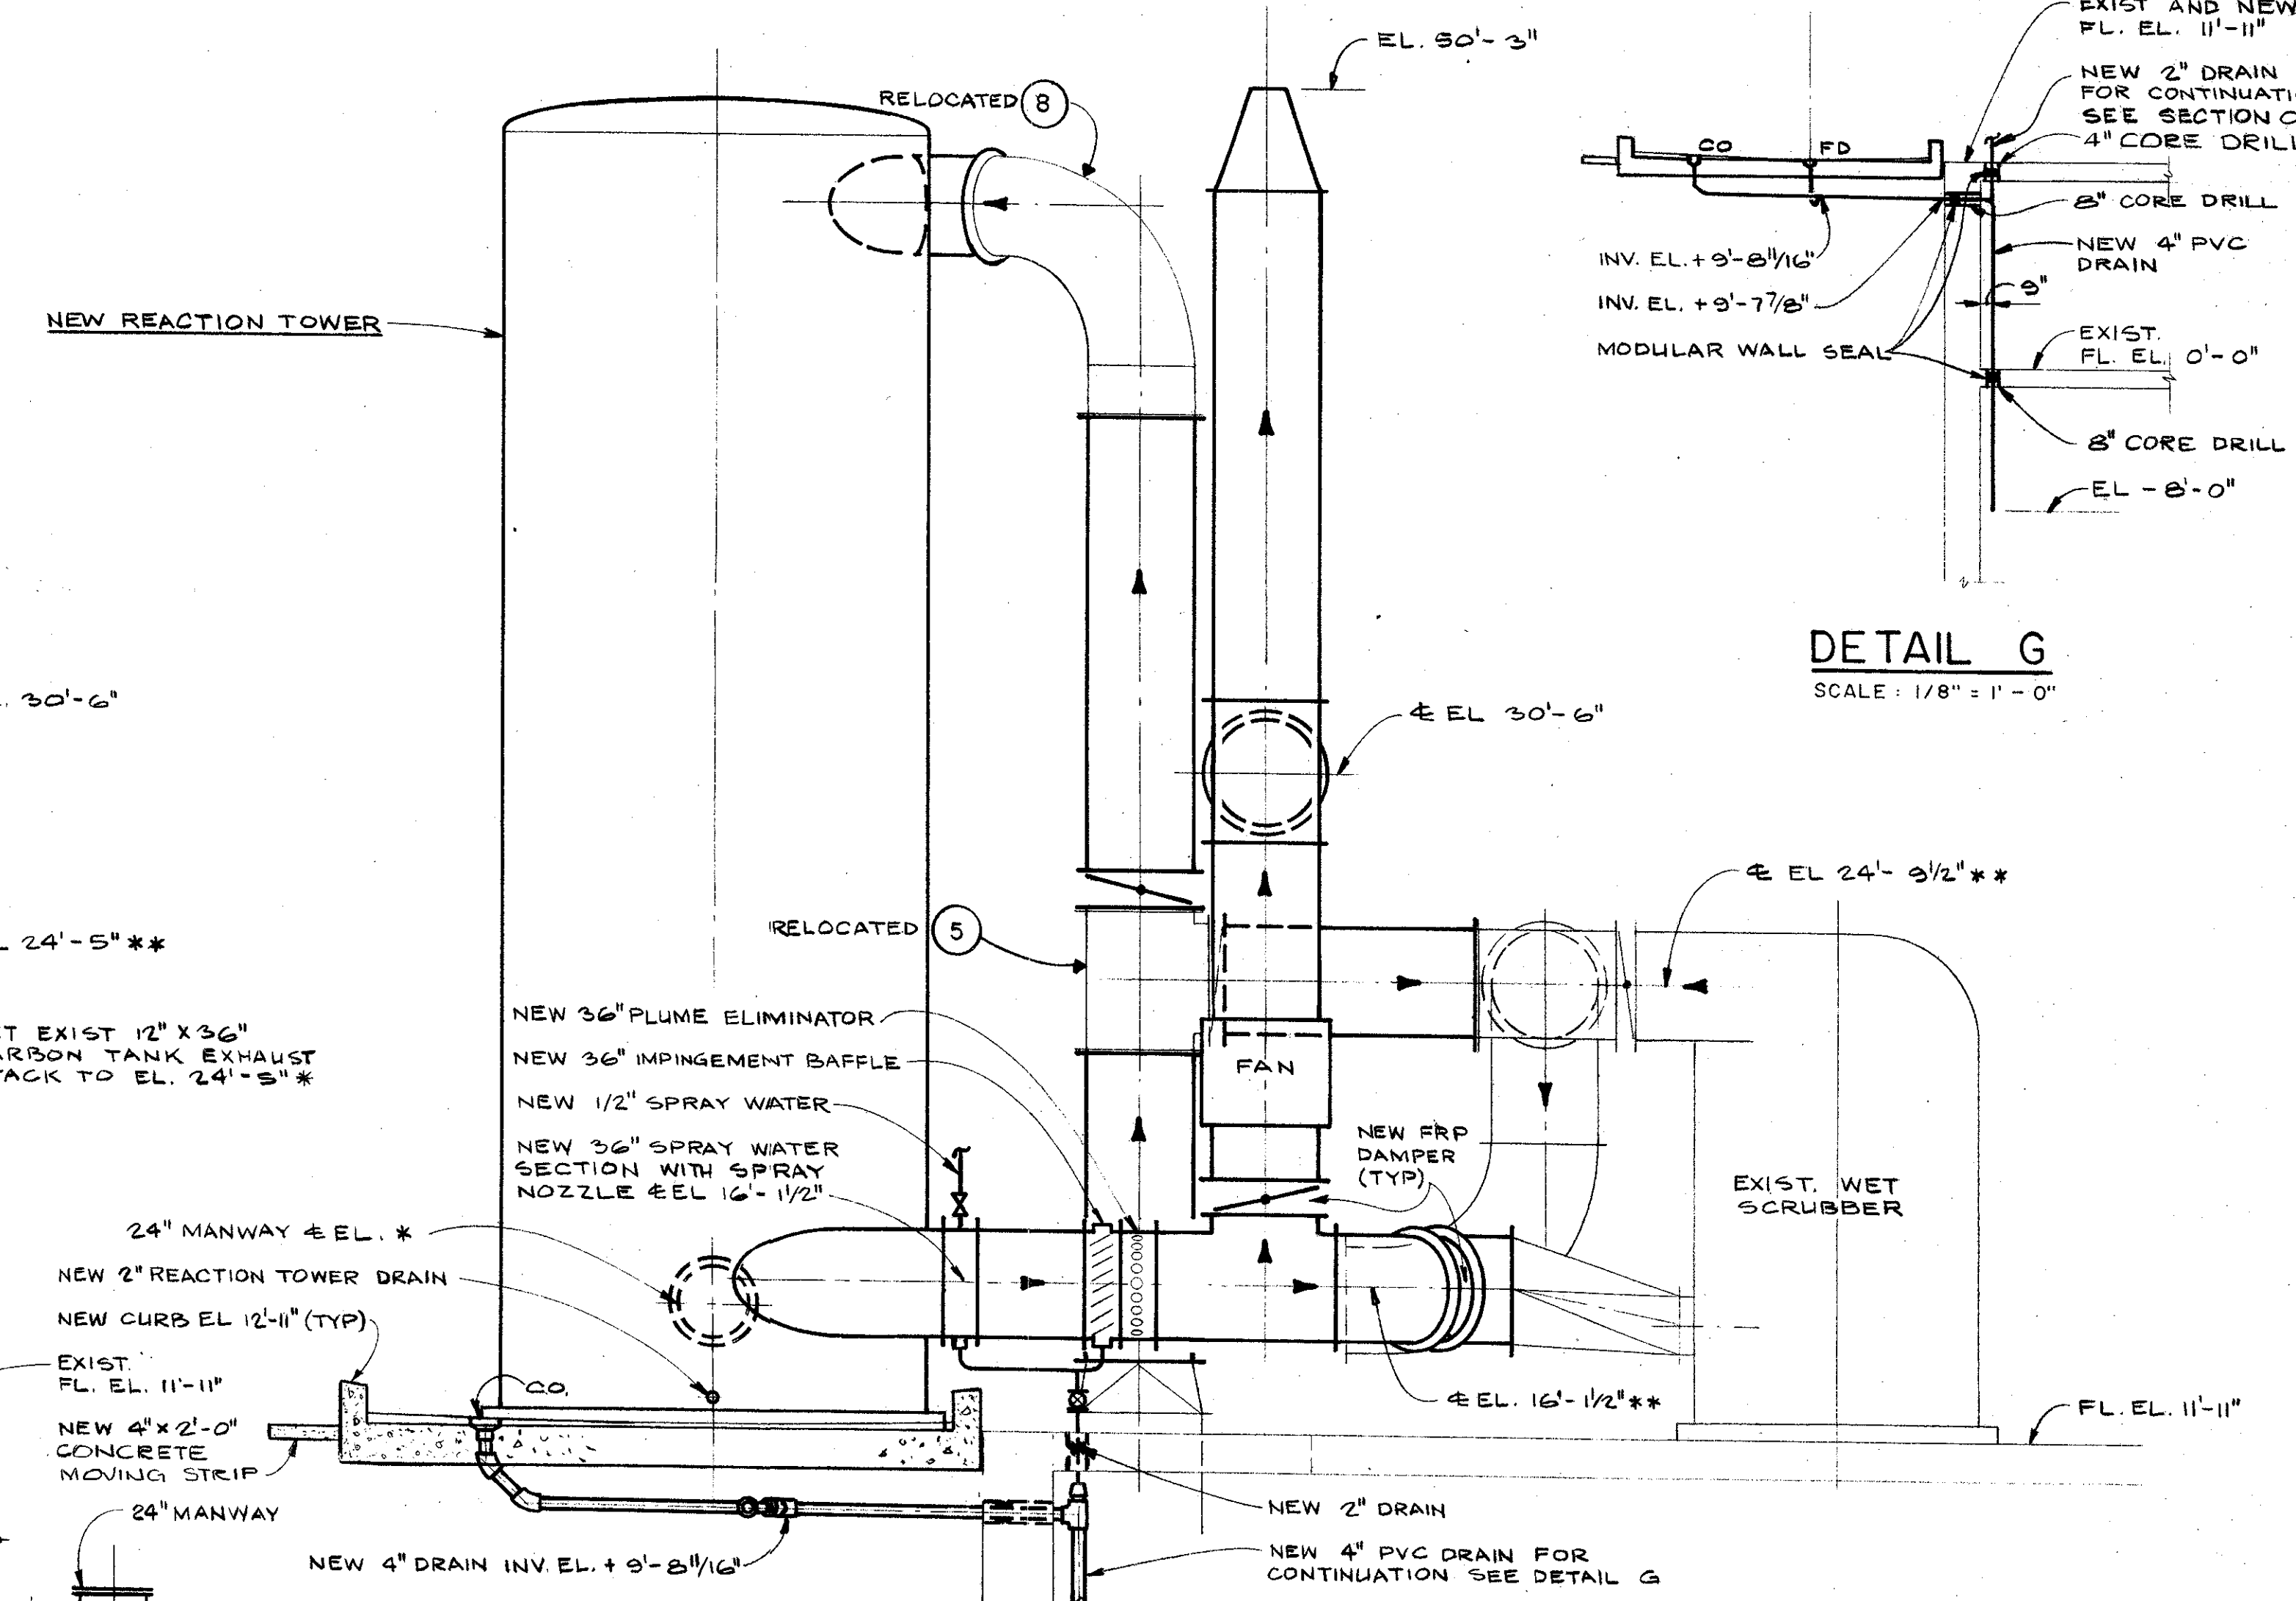


SECTION C/4
SCALE: 1/4" = 1'-0"

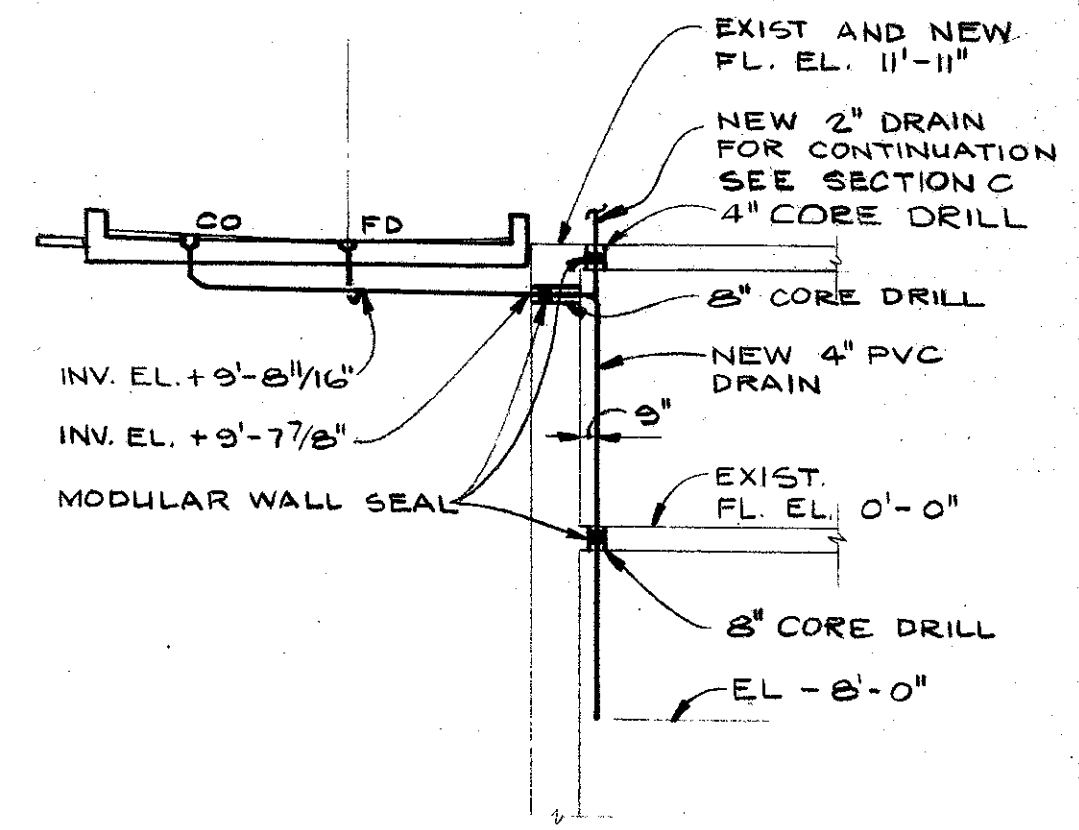


DETAIL G
SCALE: 1/8" = 1'-0"

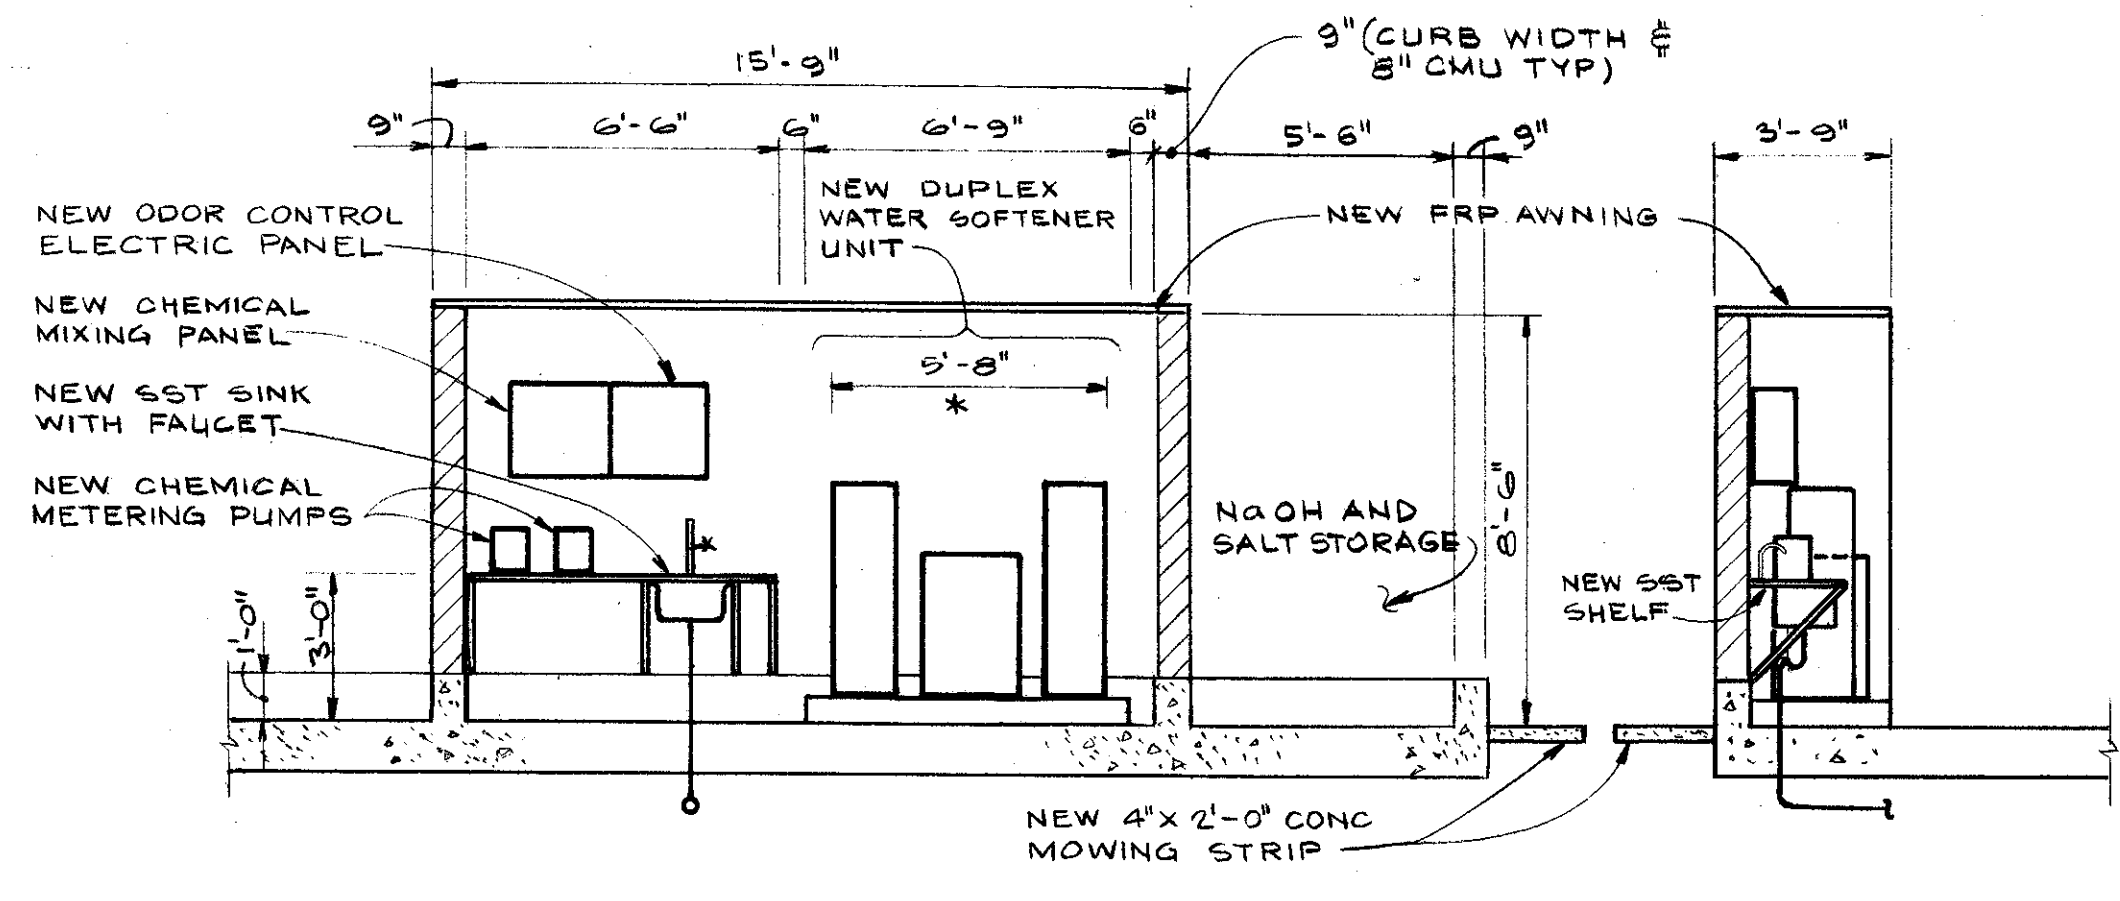

SECTION D/4
SCALE: 1/4" = 1'-0"

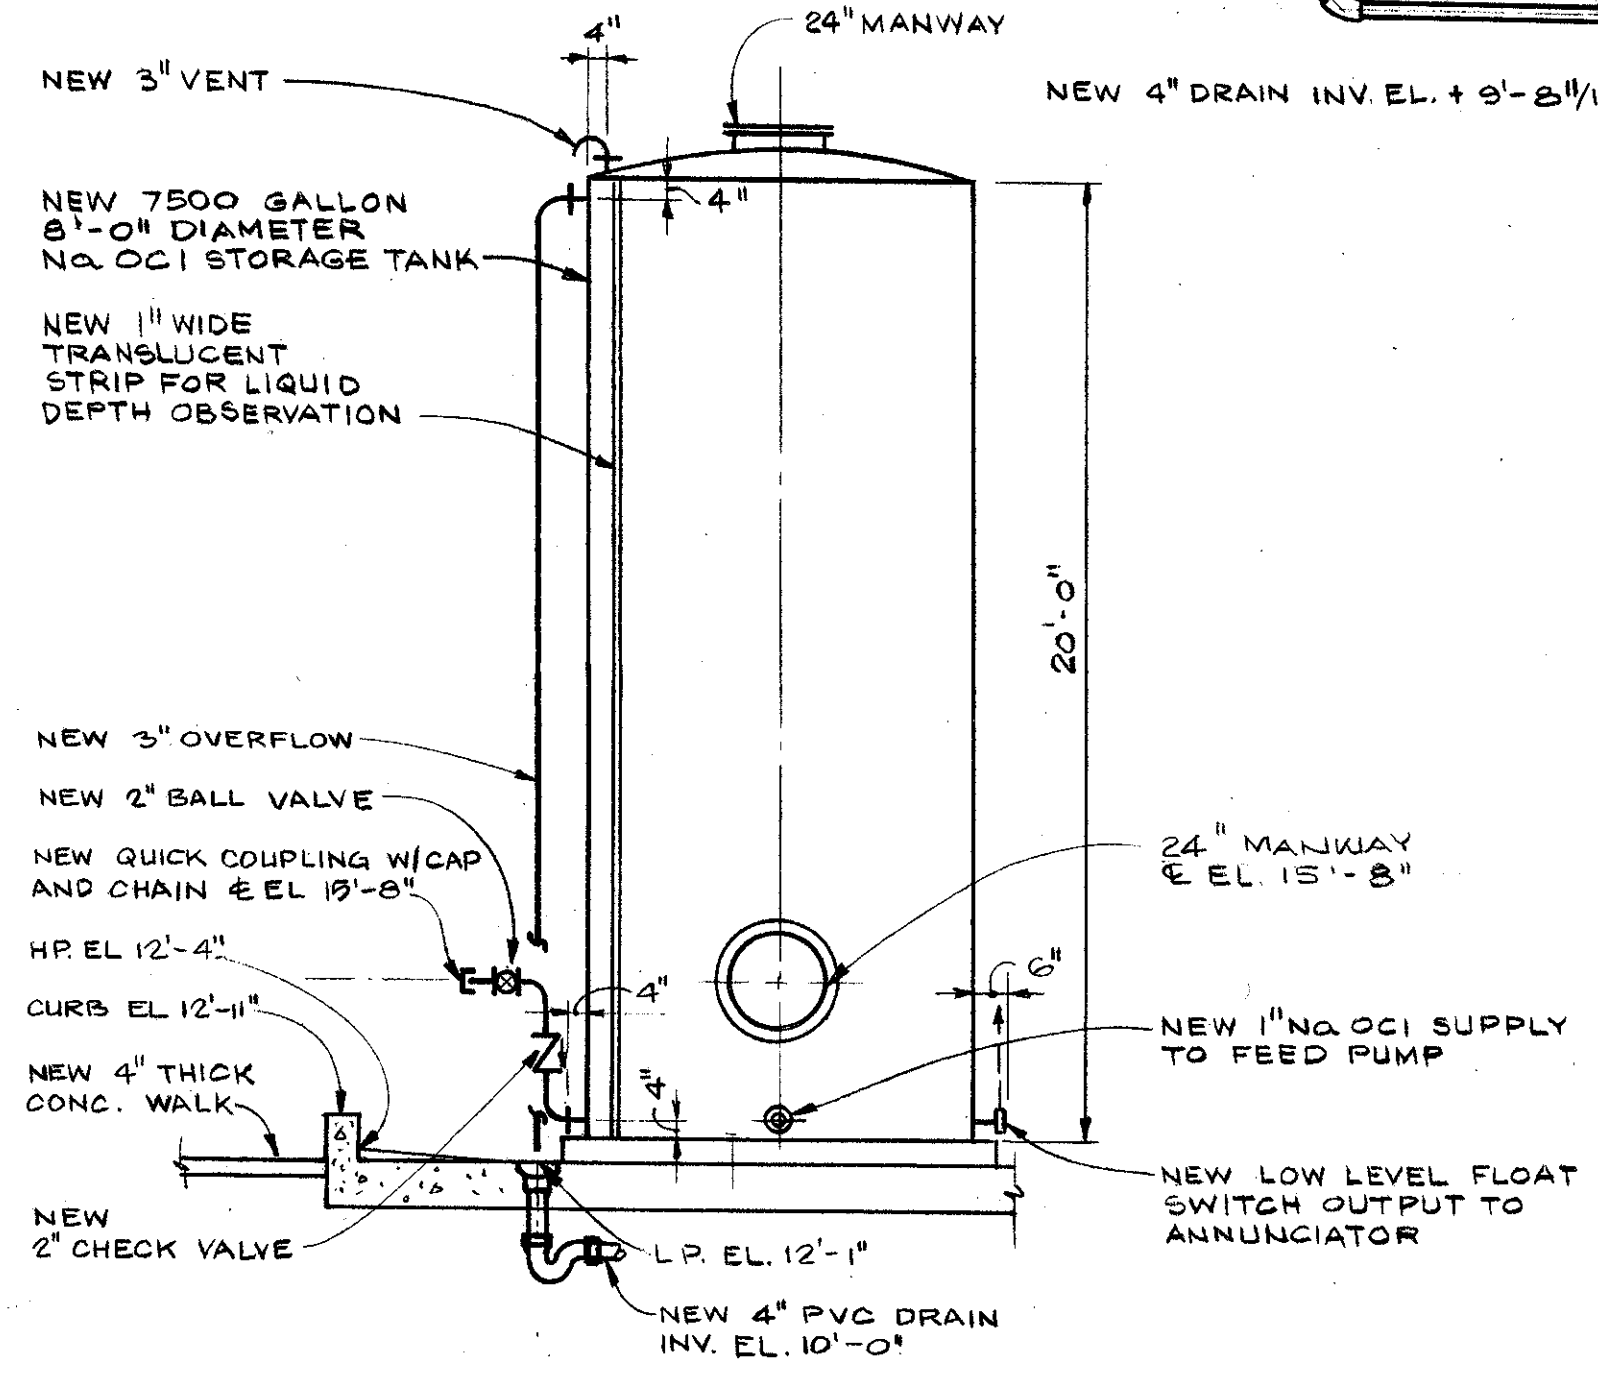

SECTION F/4
SCALE: 1/4" = 1'-0"

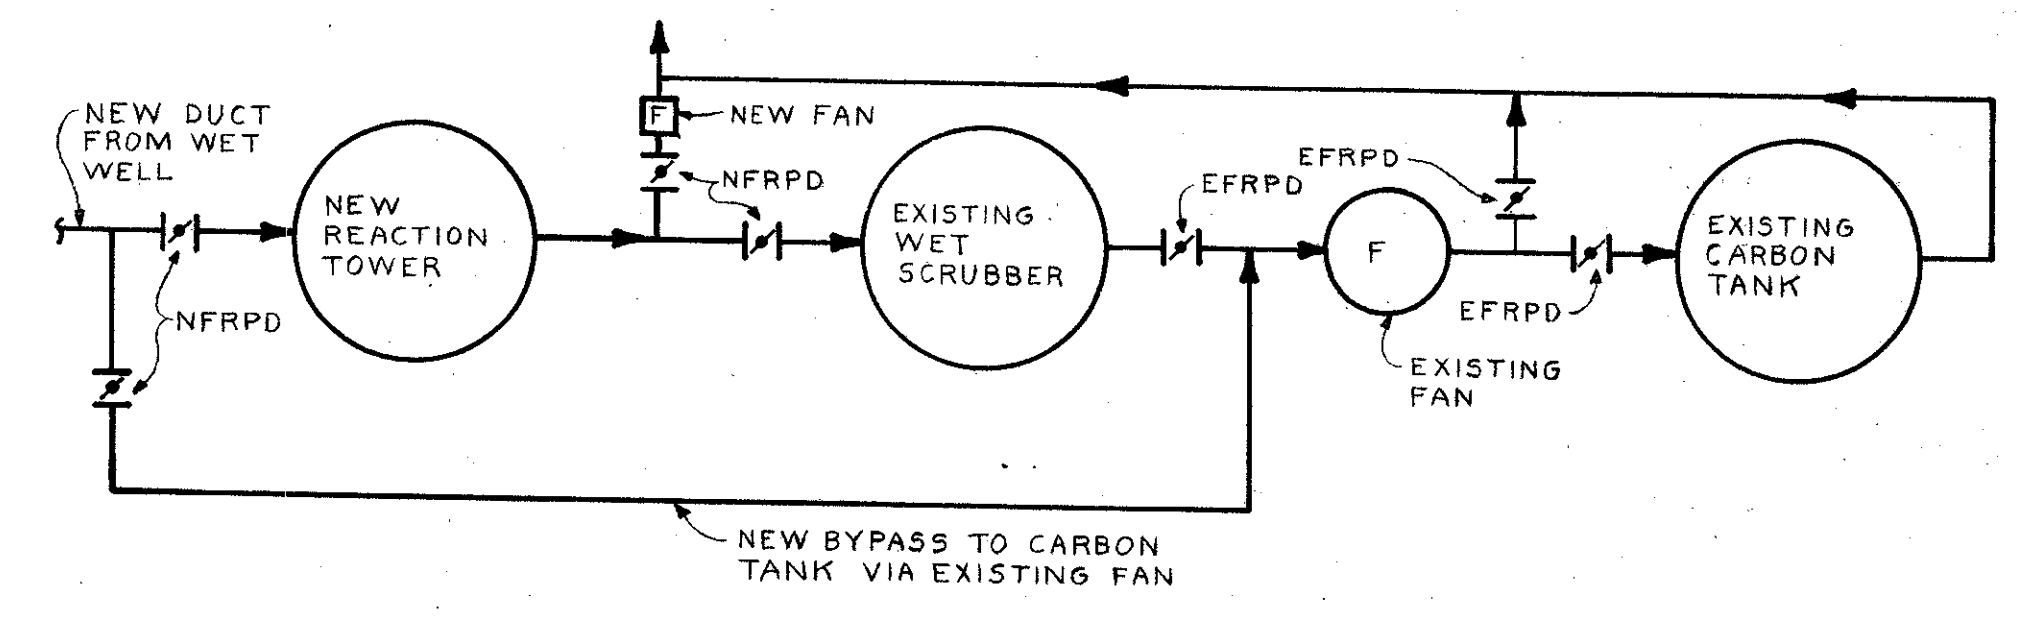

NOTE:
SEE PLANS AND SECTIONS FOR LOCATION OF NEW AND EXISTING DUCTWORK


LEGEND
NFRPD - NEW FRP DAMPER
EFRPD - EXISTING FRP DAMPER

YBOR PUMPING STATION ODOR CONTROL FLOW DIAGRAM
NO SCALE


NOTE: THIS SHEET APPLIES ONLY TO SYSTEMS WHICH REQUIRE HIGH PRESSURE AIR COMPRESSOR EQUIPMENT

GREELEY AND HANSEN ENGINEERS 222 S. RIVERSIDE PLAZA CHICAGO, ILLINOIS 60606	DESIGNED: MPV JRP	APPROVED:	SCALE 0 8 16 FT 1/8" = 1'-0" 0 4 8 FT 1/4" = 1'-0"	CITY OF TAMPA, FLORIDA SEWAGE DISPOSAL SYSTEM DIVISION 4L5 PUMPING STATIONS ODOR CONTROL MODIFICATIONS	PROJ. NO. 6 OF 10 DATE JULY 1985 REV 0
	DRAWN: SK				
CHECKED: JRP					

304-19

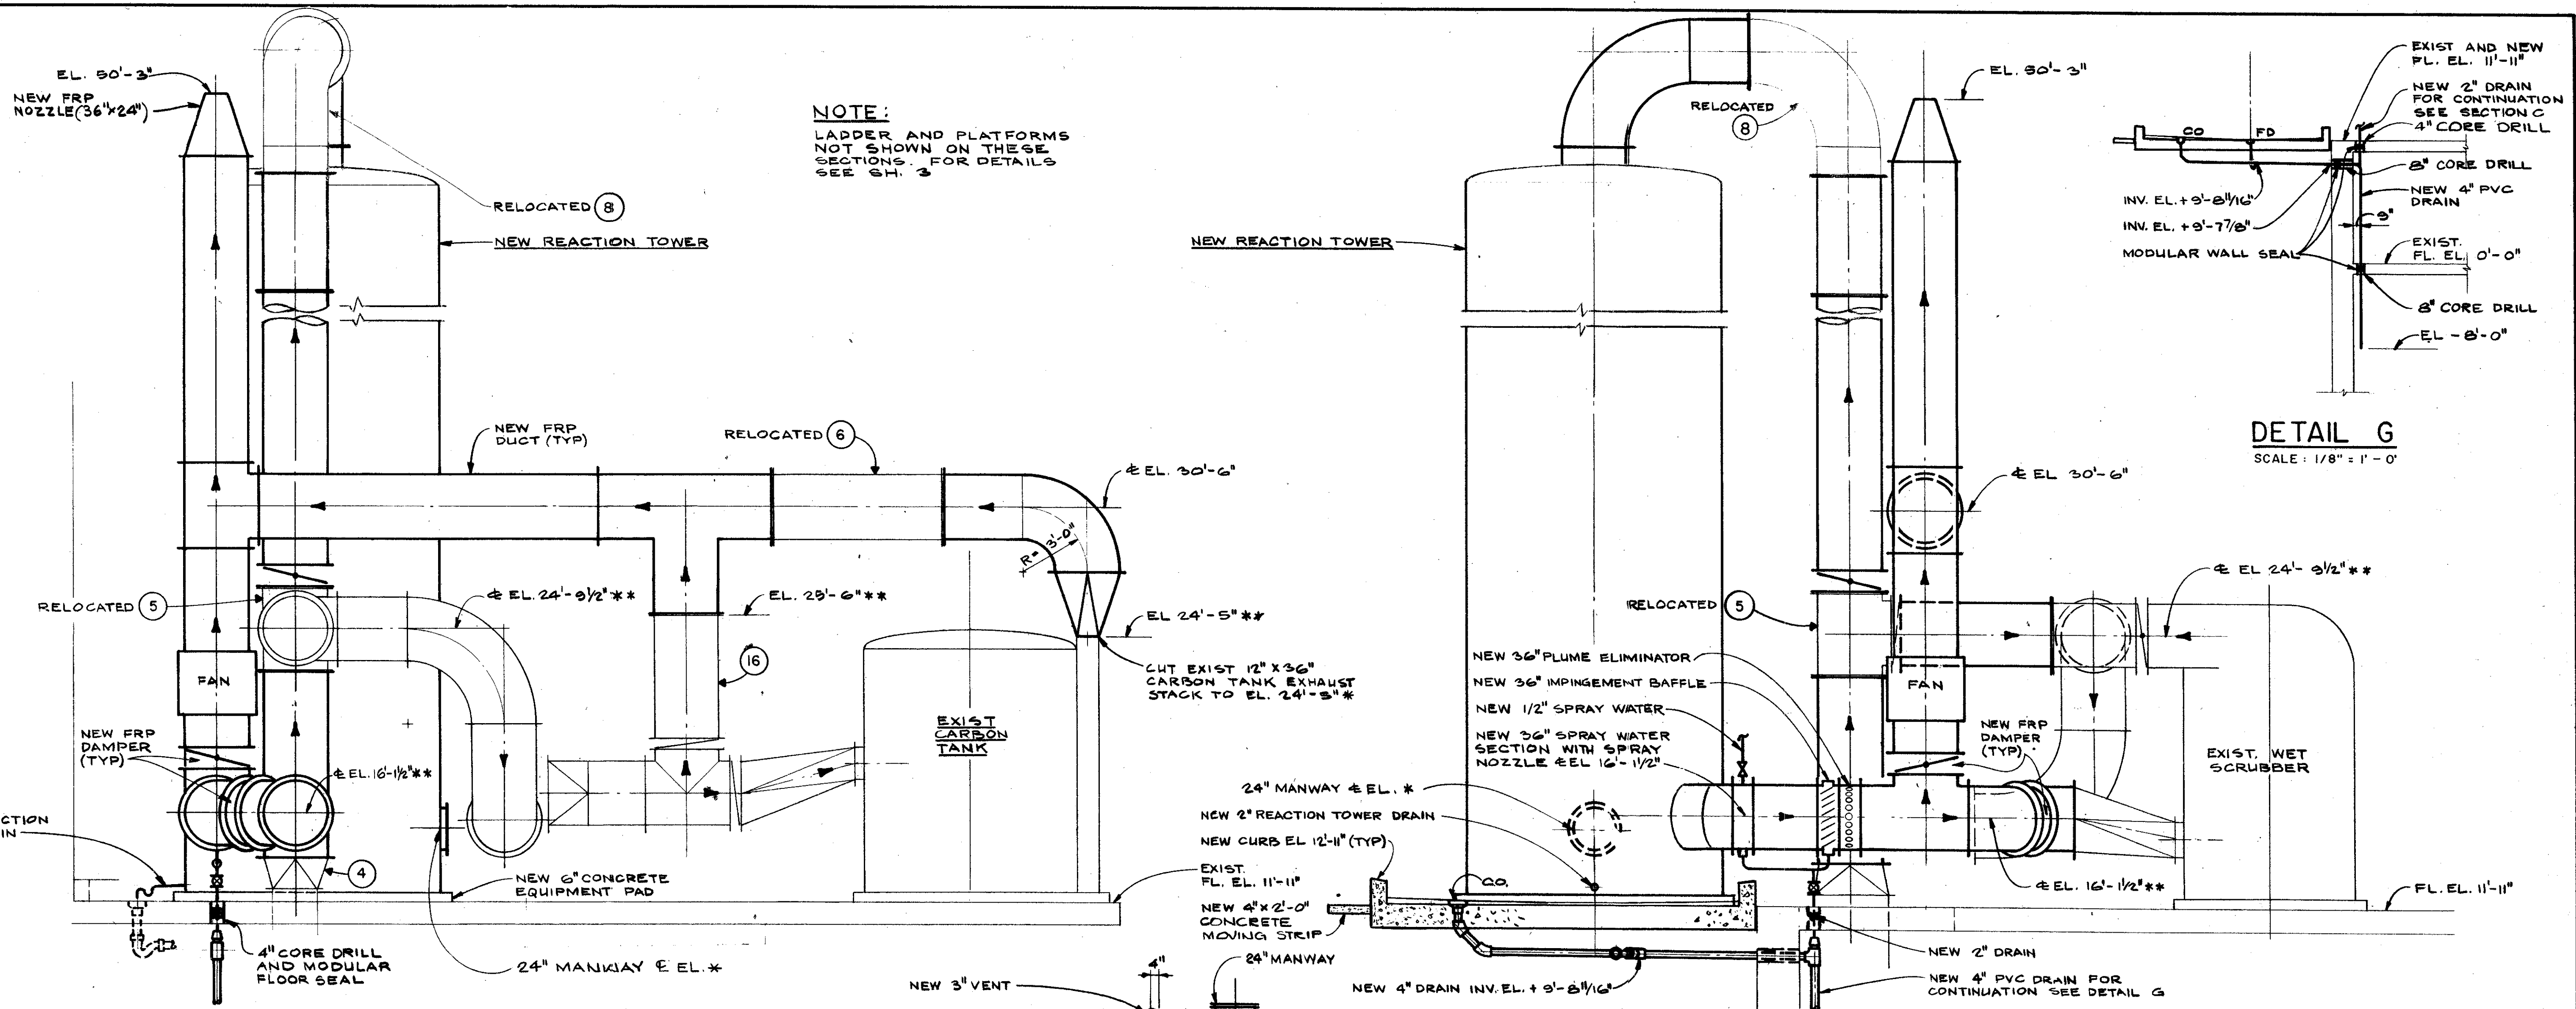


NOTE:
LADDER AND PLATFORMS NOT SHOWN ON THESE SECTIONS. FOR DETAILS SEE CH. 3

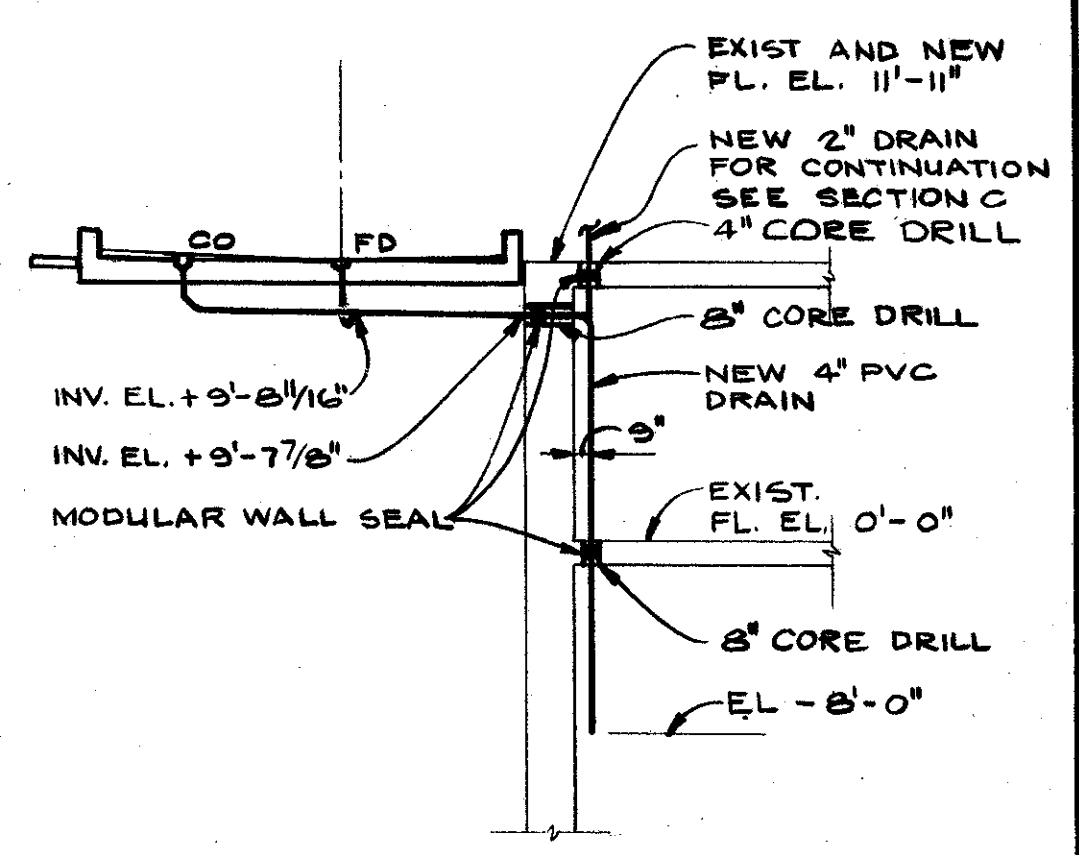


DETAIL G
SCALE: 1/8" = 1'-0"

SECTION B/5
SCALE: 1/4" = 1'-0"


SECTION C/5
SCALE: 1/4" = 1'-0"

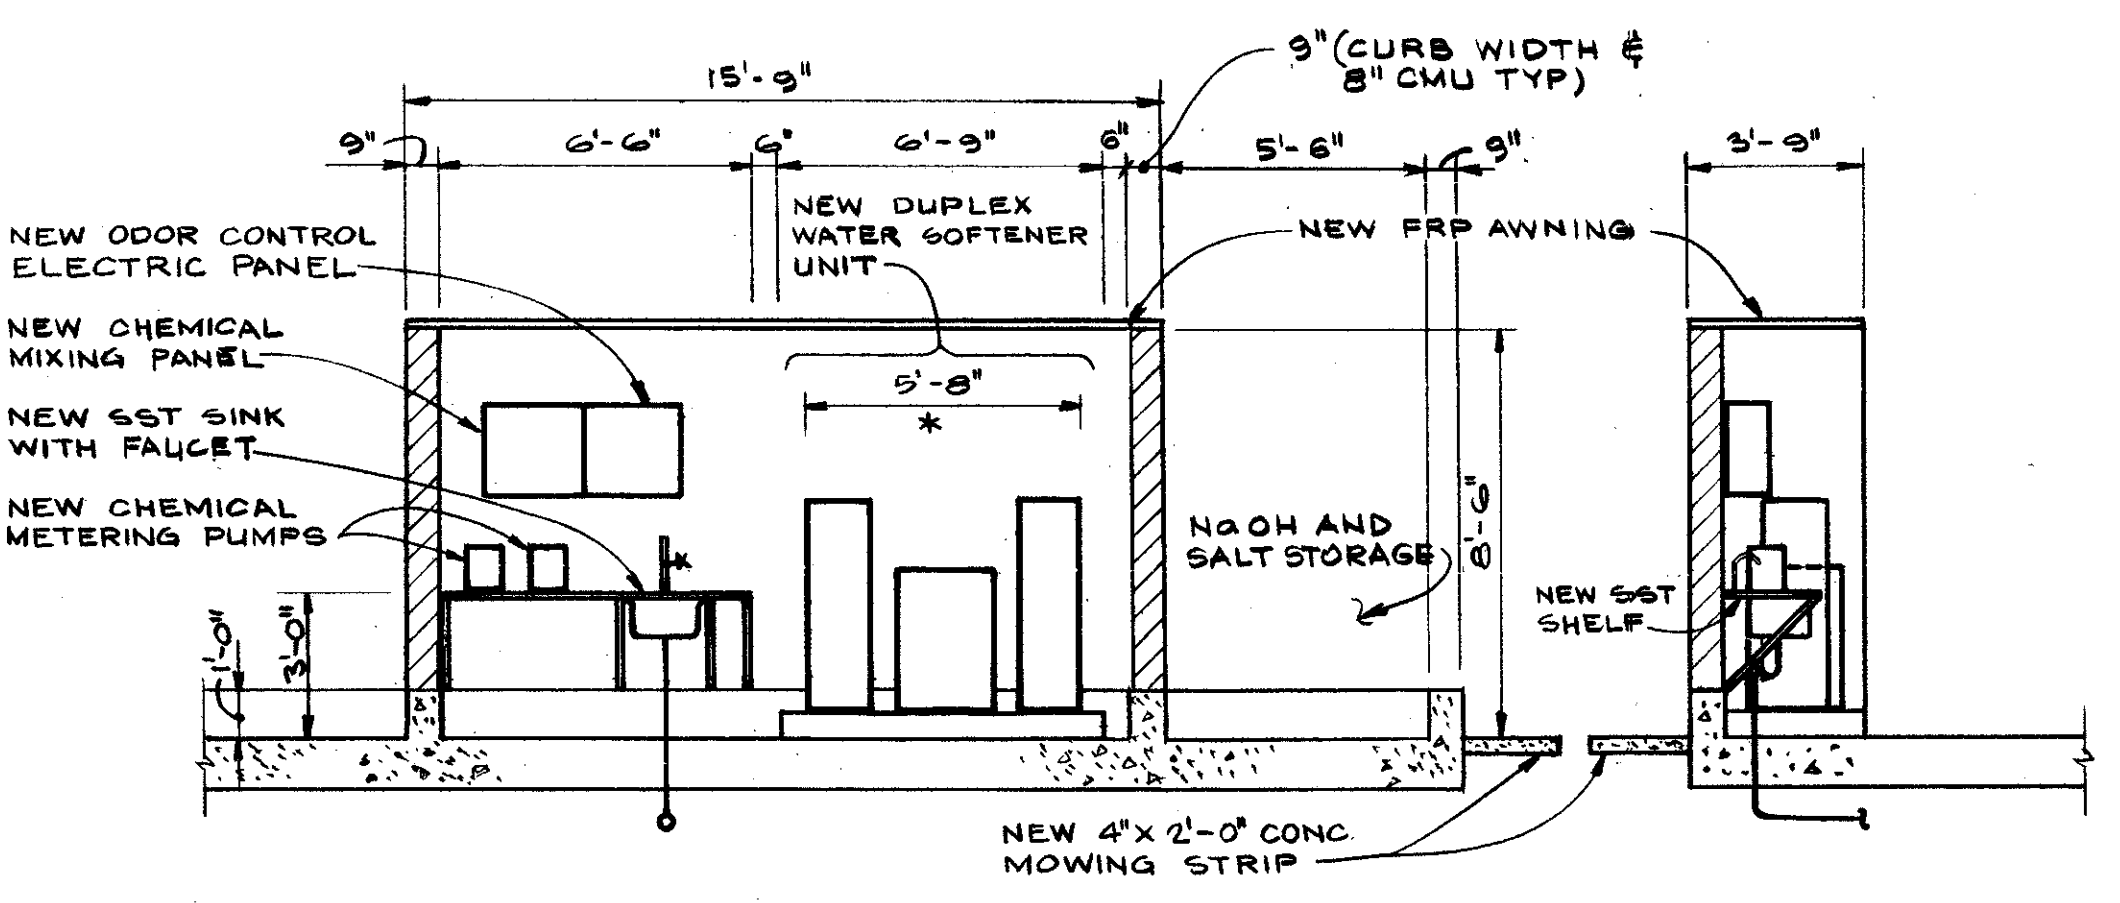

SECTION D/5
SCALE: 1/4" = 1'-0"

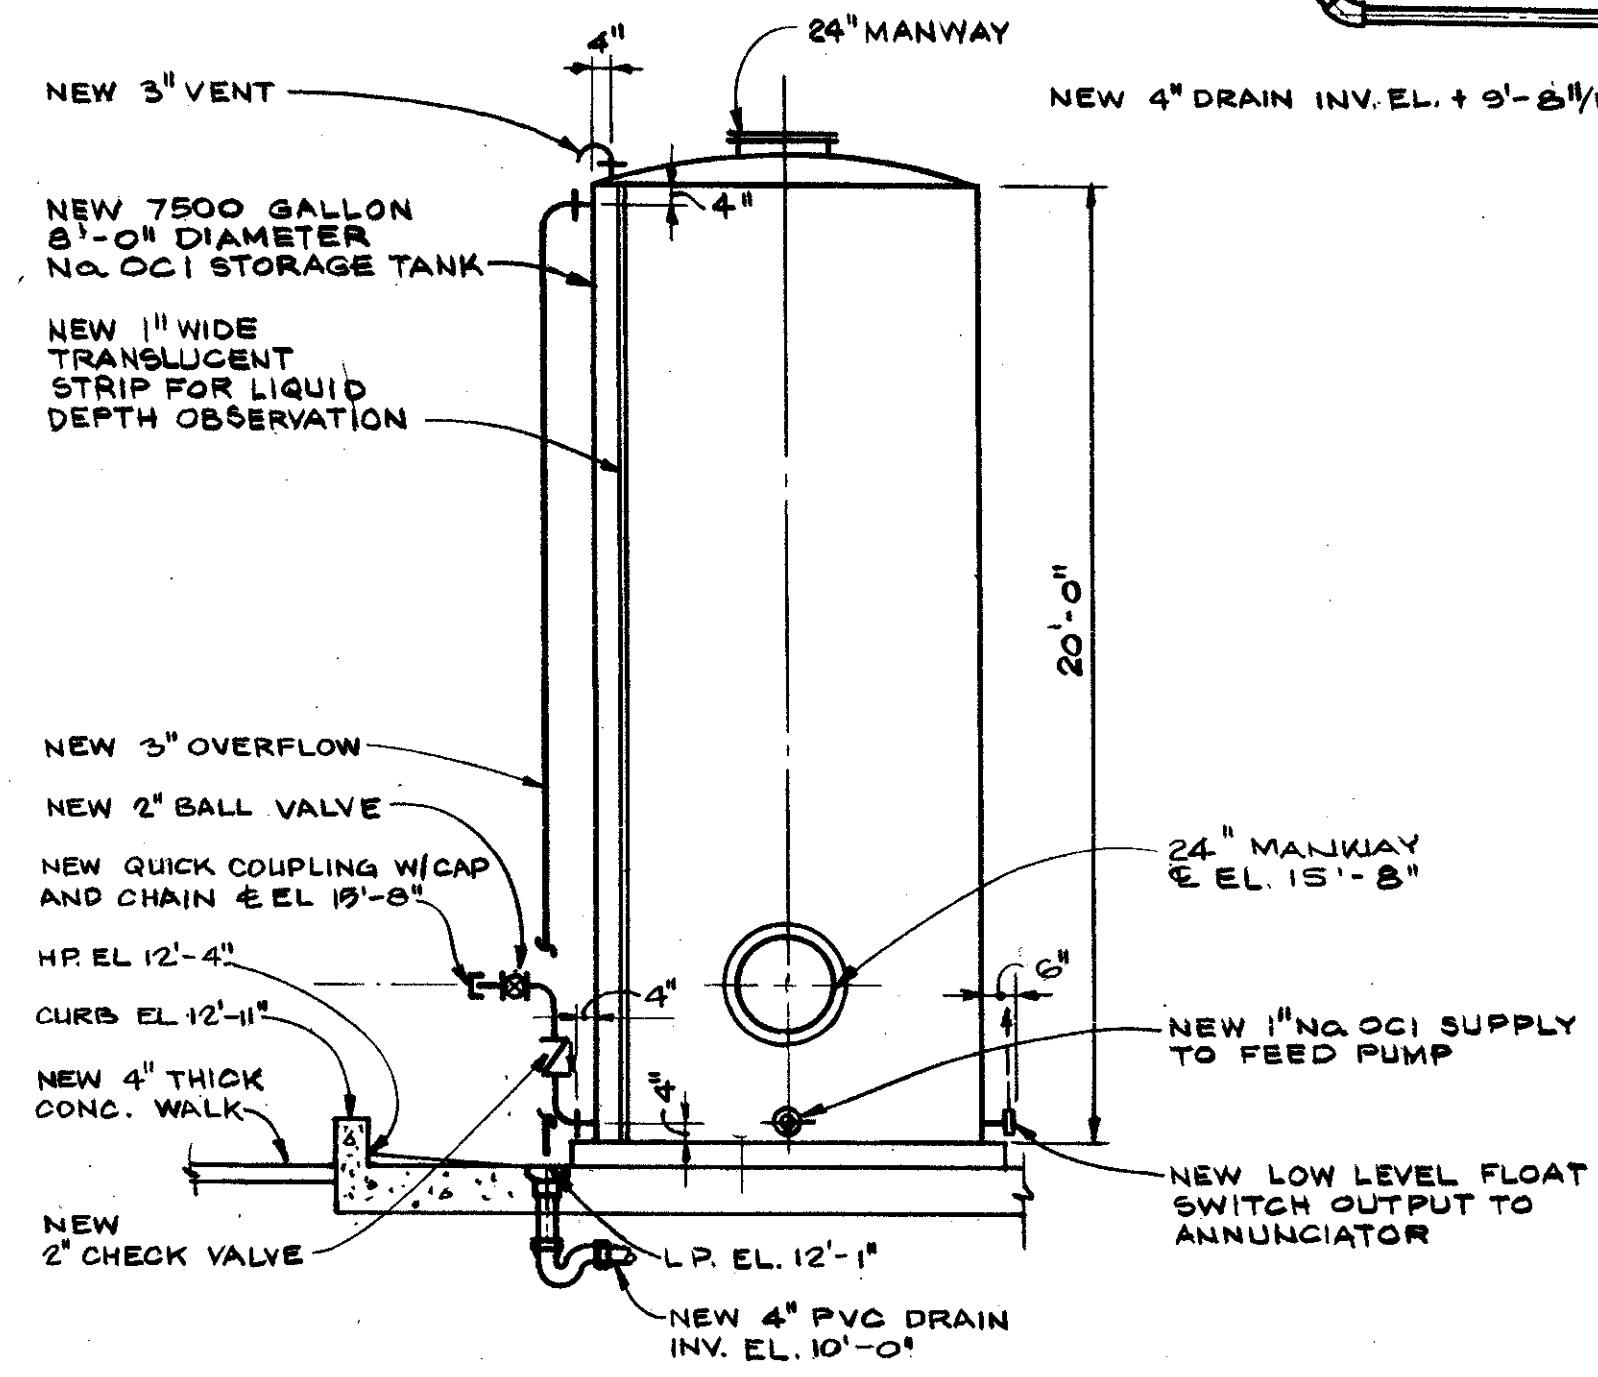

SECTION F/5
SCALE: 1/4" = 1'-0"

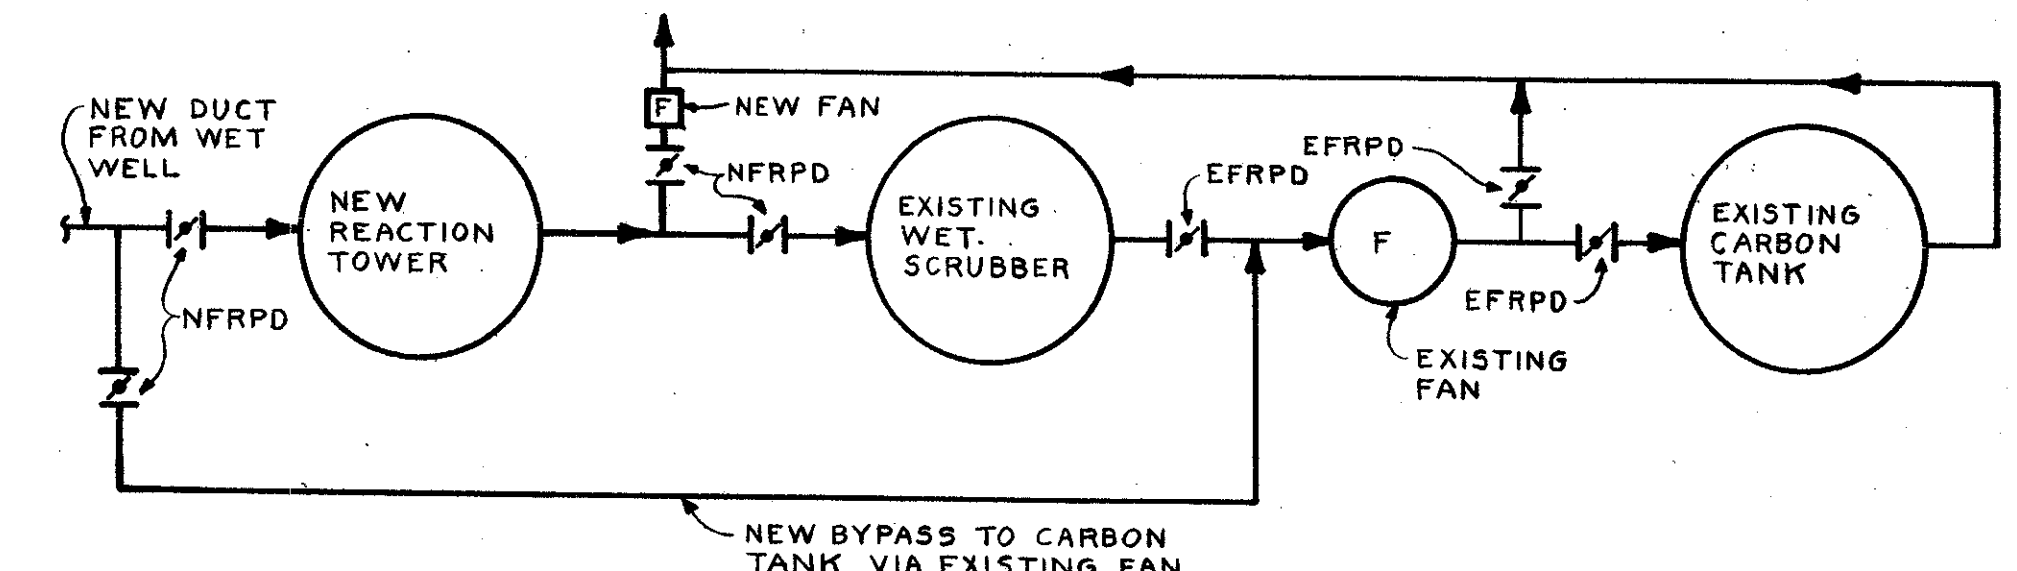

NOTE:
SEE PLANS AND SECTIONS FOR LOCATION OF NEW AND EXISTING DUCTWORK

LEGEND
NFRPD - NEW FRP DAMPER
EFRPD - EXISTING FRP DAMPER

YBOR PUMPING STATION ODOR CONTROL FLOW DIAGRAM
NO SCALE


NOTE: THIS SHEET APPLIES ONLY TO SYSTEMS WHICH REQUIRE LOW PRESSURE AIR COMPRESSOR EQUIPMENT

GREELEY AND HANSEN
ENGINEERS
222 S. RIVERSIDE PLAZA
CHICAGO, ILLINOIS 60606

DESIGNED: MPV JRP
DRAWN: SK
CHECKED: JRP

APPROVED

NO.	DATE	APP.	REVISION

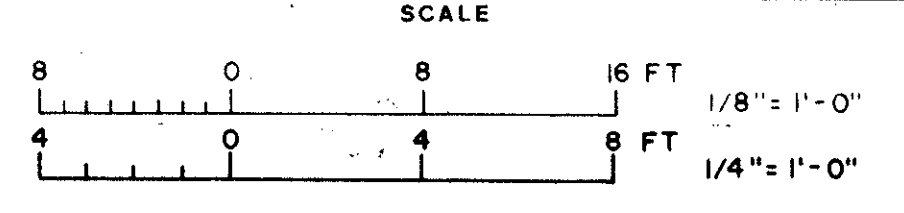


CITY OF TAMPA, FLORIDA
SEWAGE DISPOSAL SYSTEM
DIVISION 4L5
PUMPING STATIONS
ODOR CONTROL MODIFICATIONS

YBOR PUMPING STATION
SECTIONS

PROJ. NO.	
SHEET	7 OF 10
DATE	JULY 1985
REV.	0


304-20

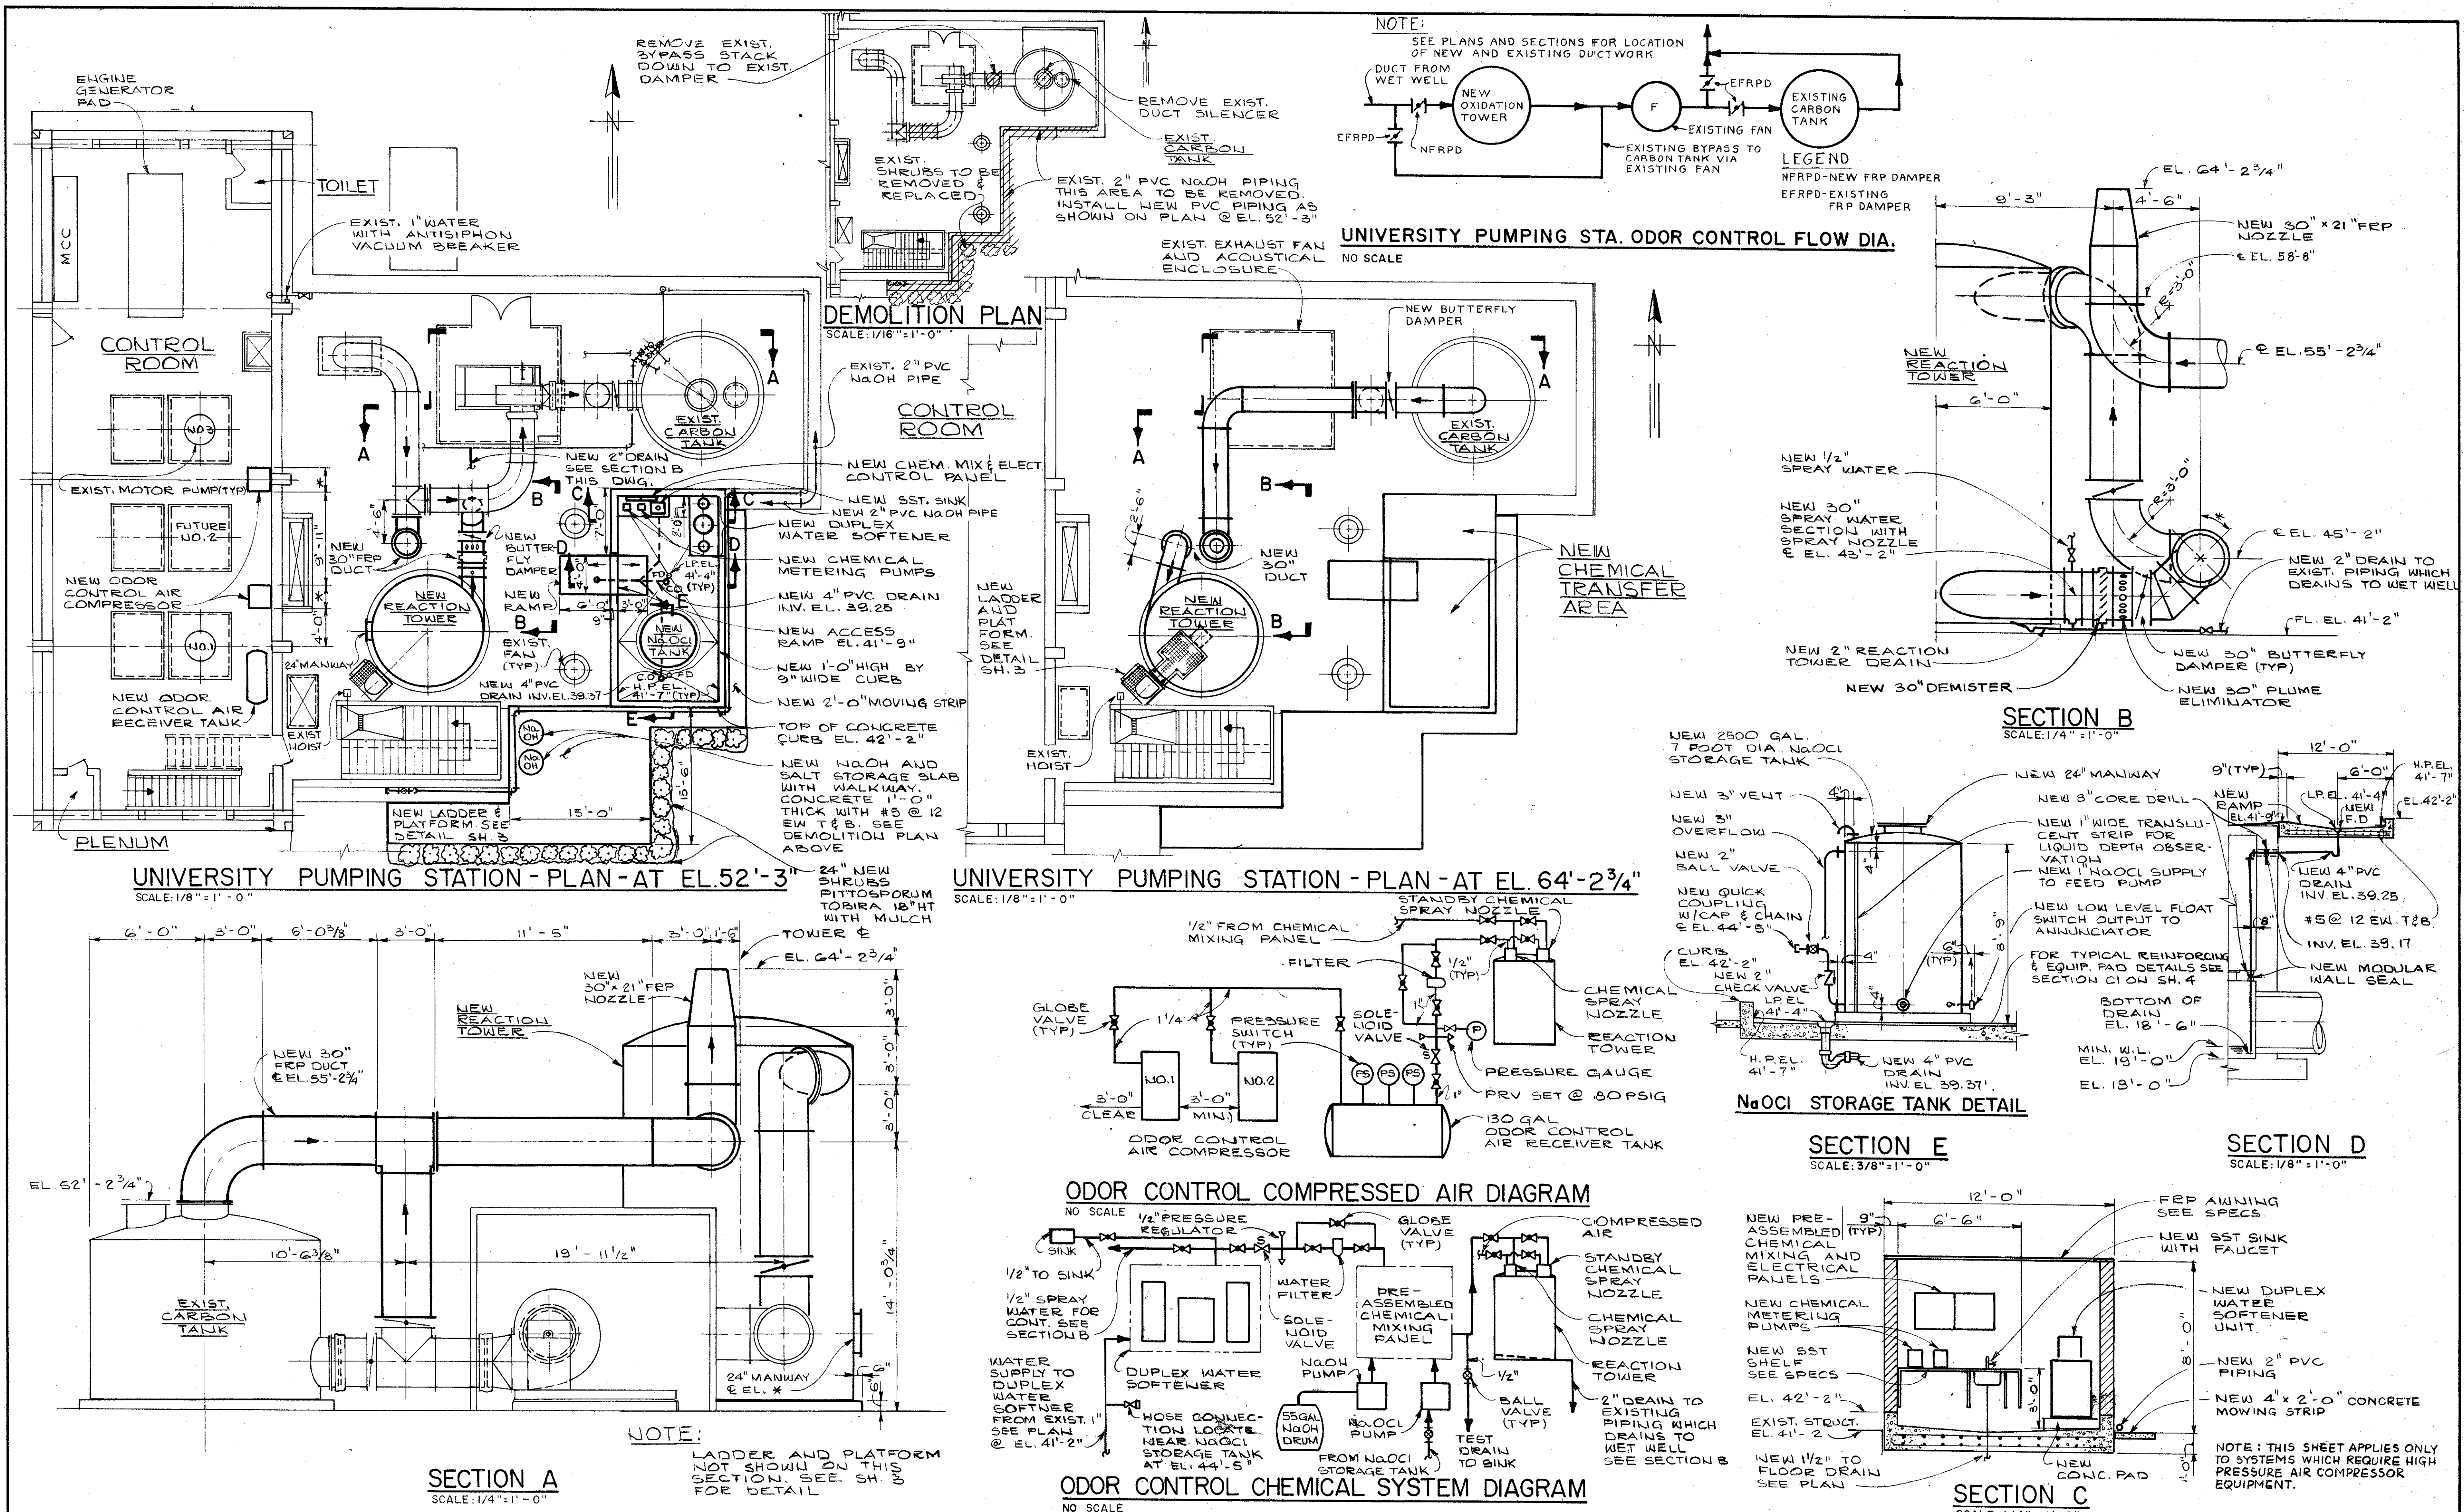

GREELEY AND HANSEN
ENGINEERS
222 S. RIVERSIDE PLAZA
CHICAGO, ILLINOIS 60606

DESIGNED MPV JRP
DRAWN ATK
CHECKED JRP

NO.	DATE	APP.	REVISION

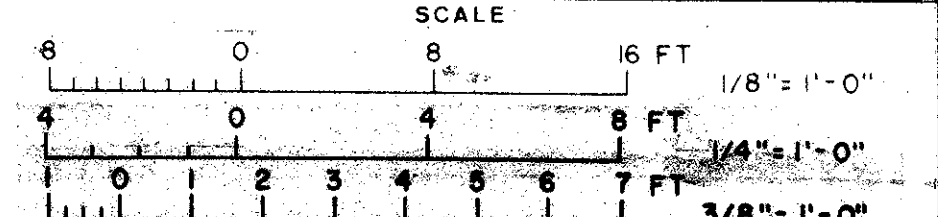


CITY OF TAMPA, FLORIDA
SEWAGE DISPOSAL SYSTEM
DIVISION 4L5
PUMPING STATIONS
ODOR CONTROL MODIFICATIONS

UNIVERSITY PUMPING STATION
PLANS, SECTIONS, DETAILS AND
DIAGRAMS

PROJ. NO.
SHEET 8 OF 10
DATE JULY 1985 REV 0


304-21

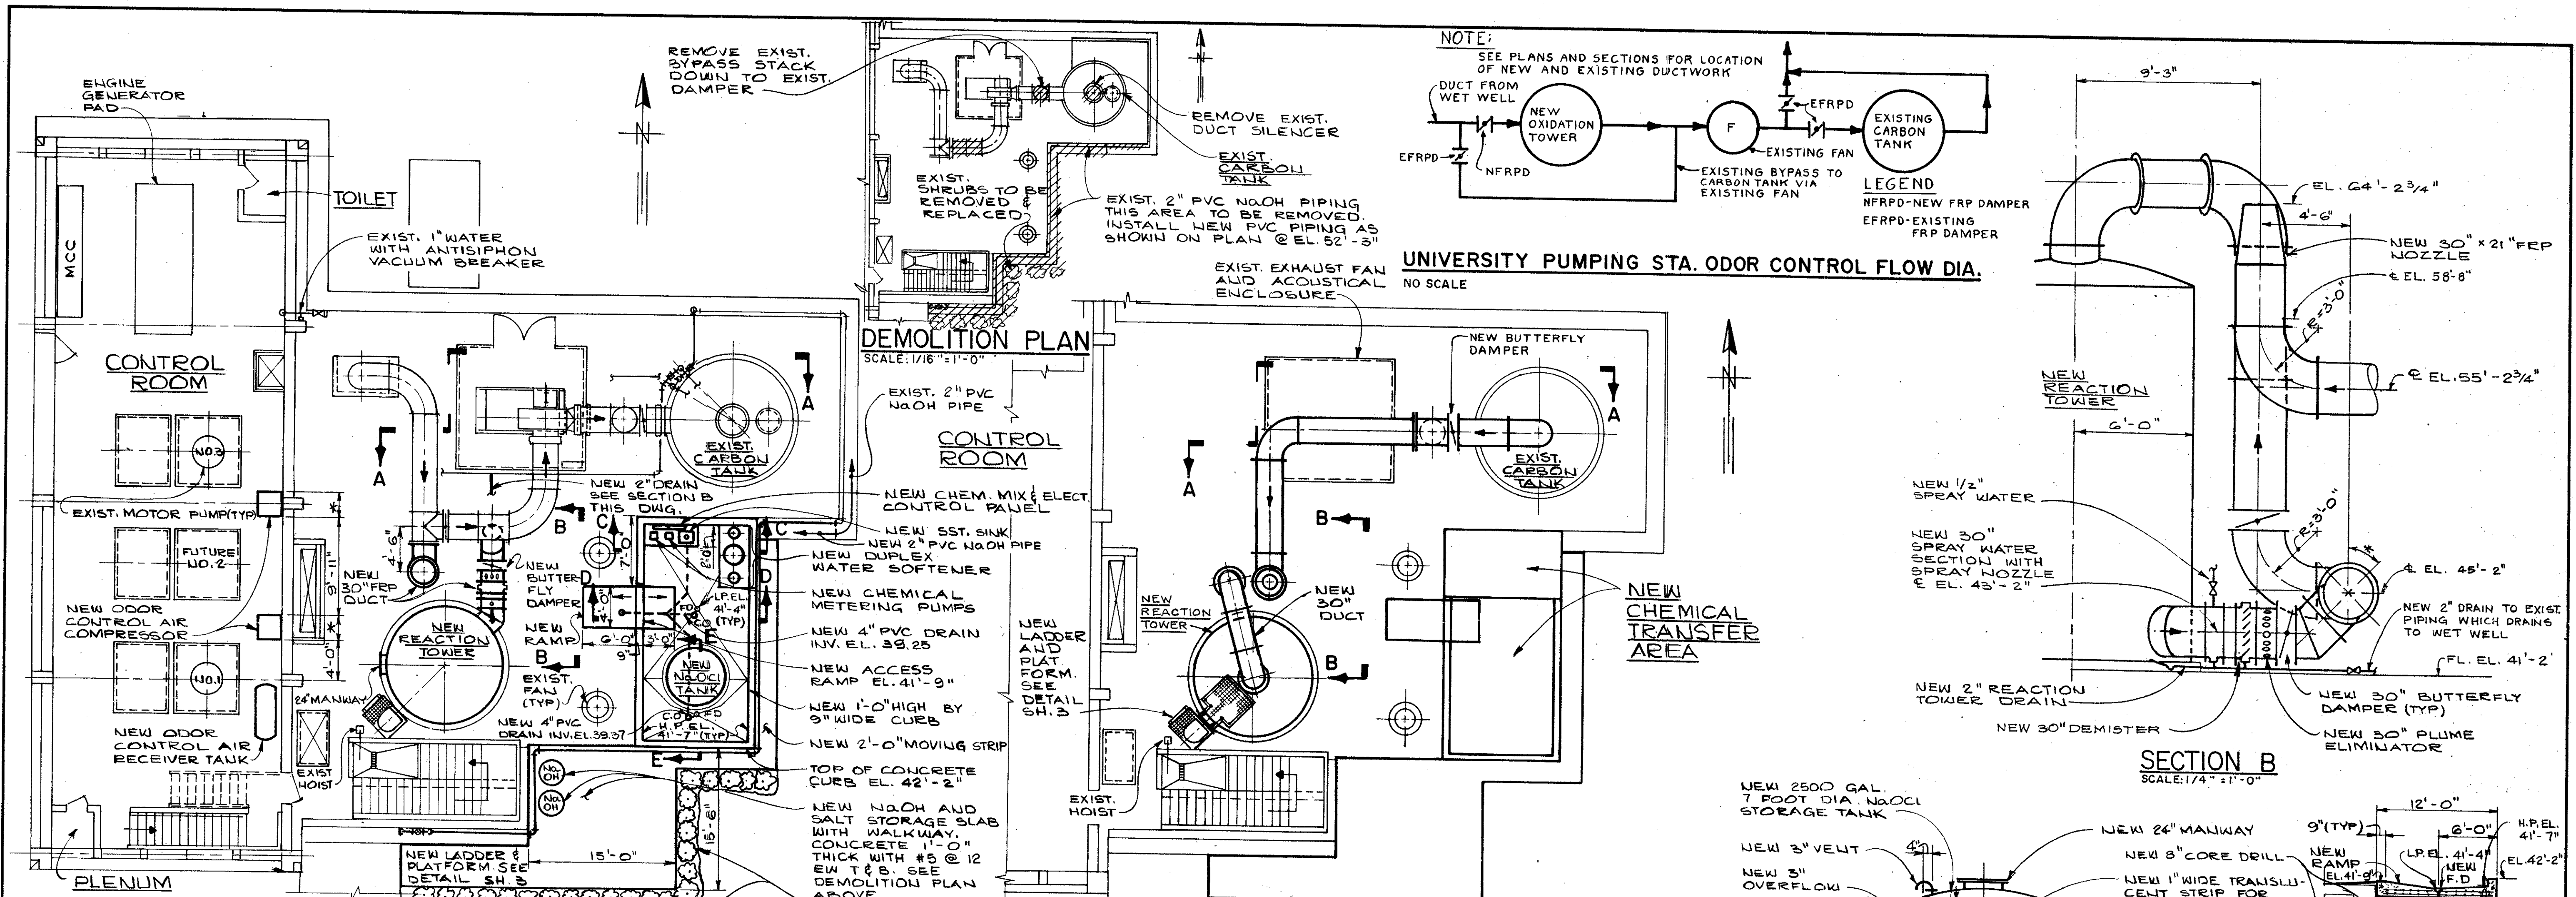

UNIVERSITY PUMPING STATION - PLAN - AT EL. 52'-3" SCALE: 1/8" = 1'-0"


UNIVERSITY PUMPING STATION - PLAN - AT EL. 64'-2 3/4" SCALE: 1/8" = 1'-0"

SECTION B SCALE: 1/4" = 1'-0"

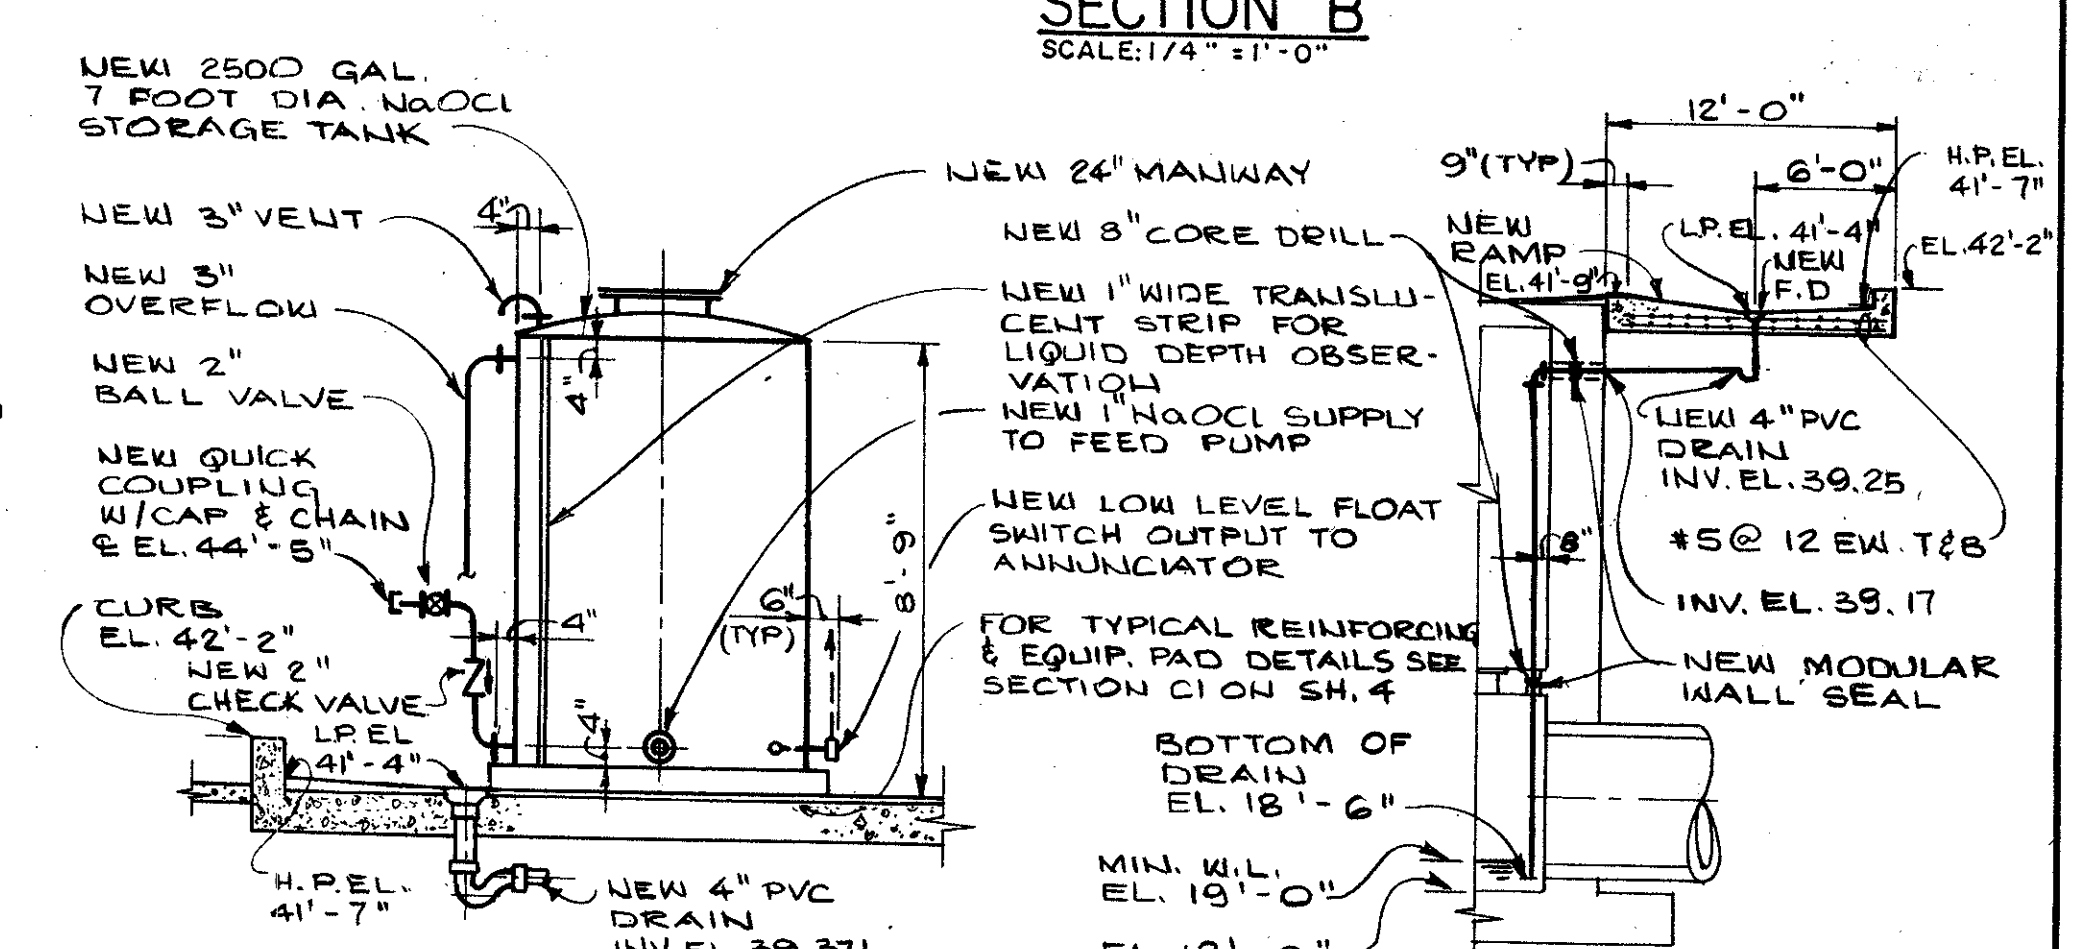


SECTION E SCALE: 3/8" = 1'-0"


SECTION D SCALE: 1/8" = 1'-0"

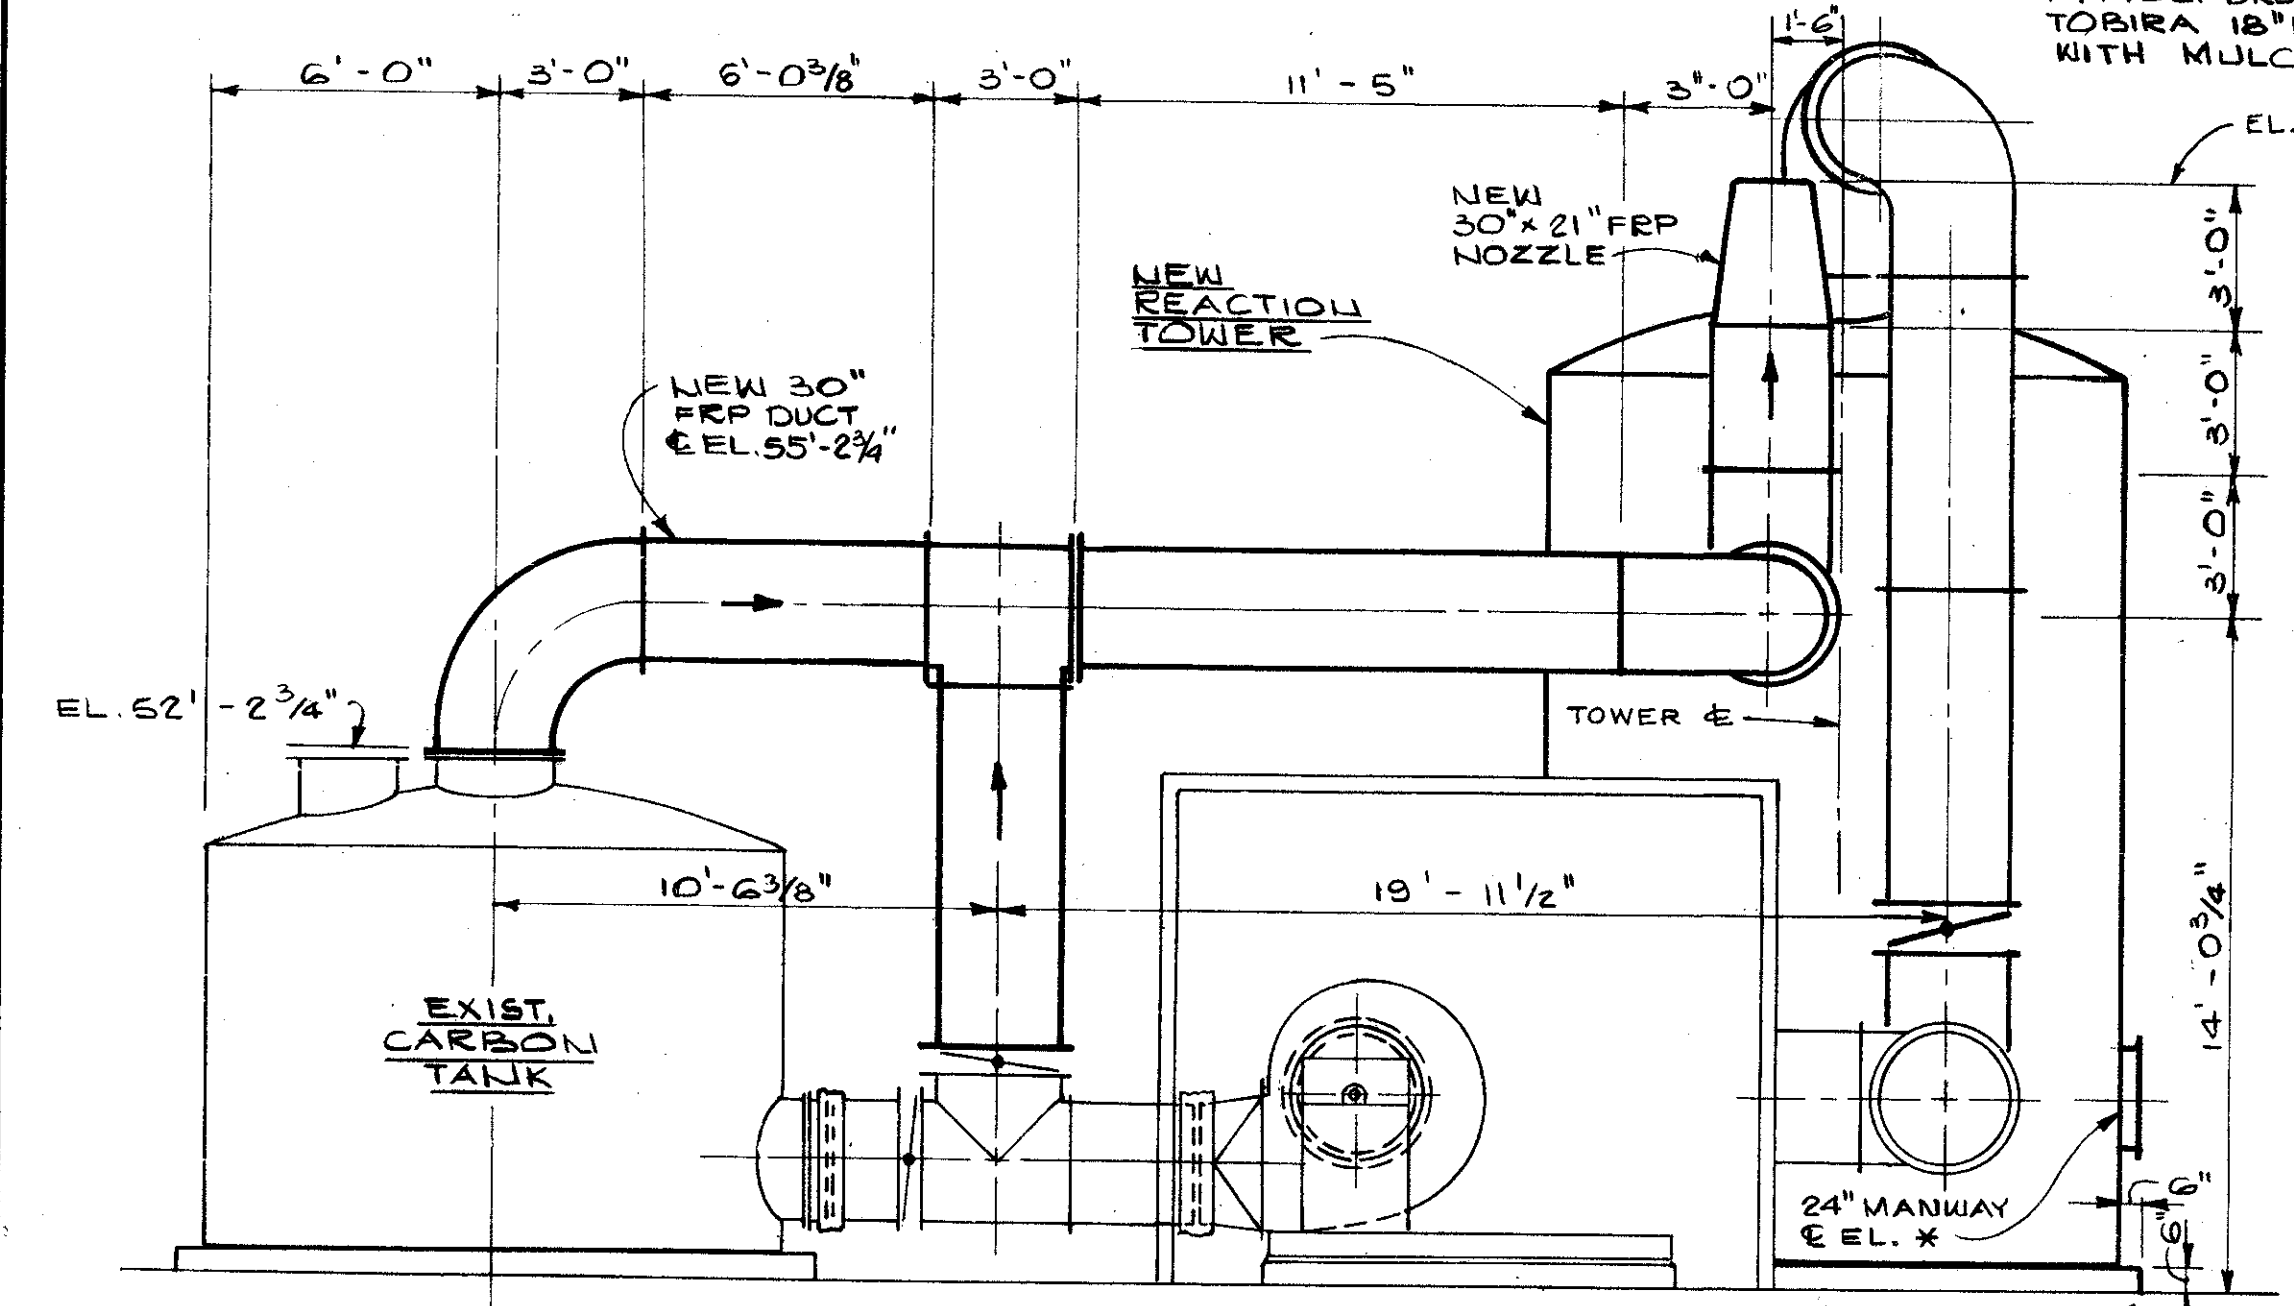

SECTION A SCALE: 1/4" = 1'-0"

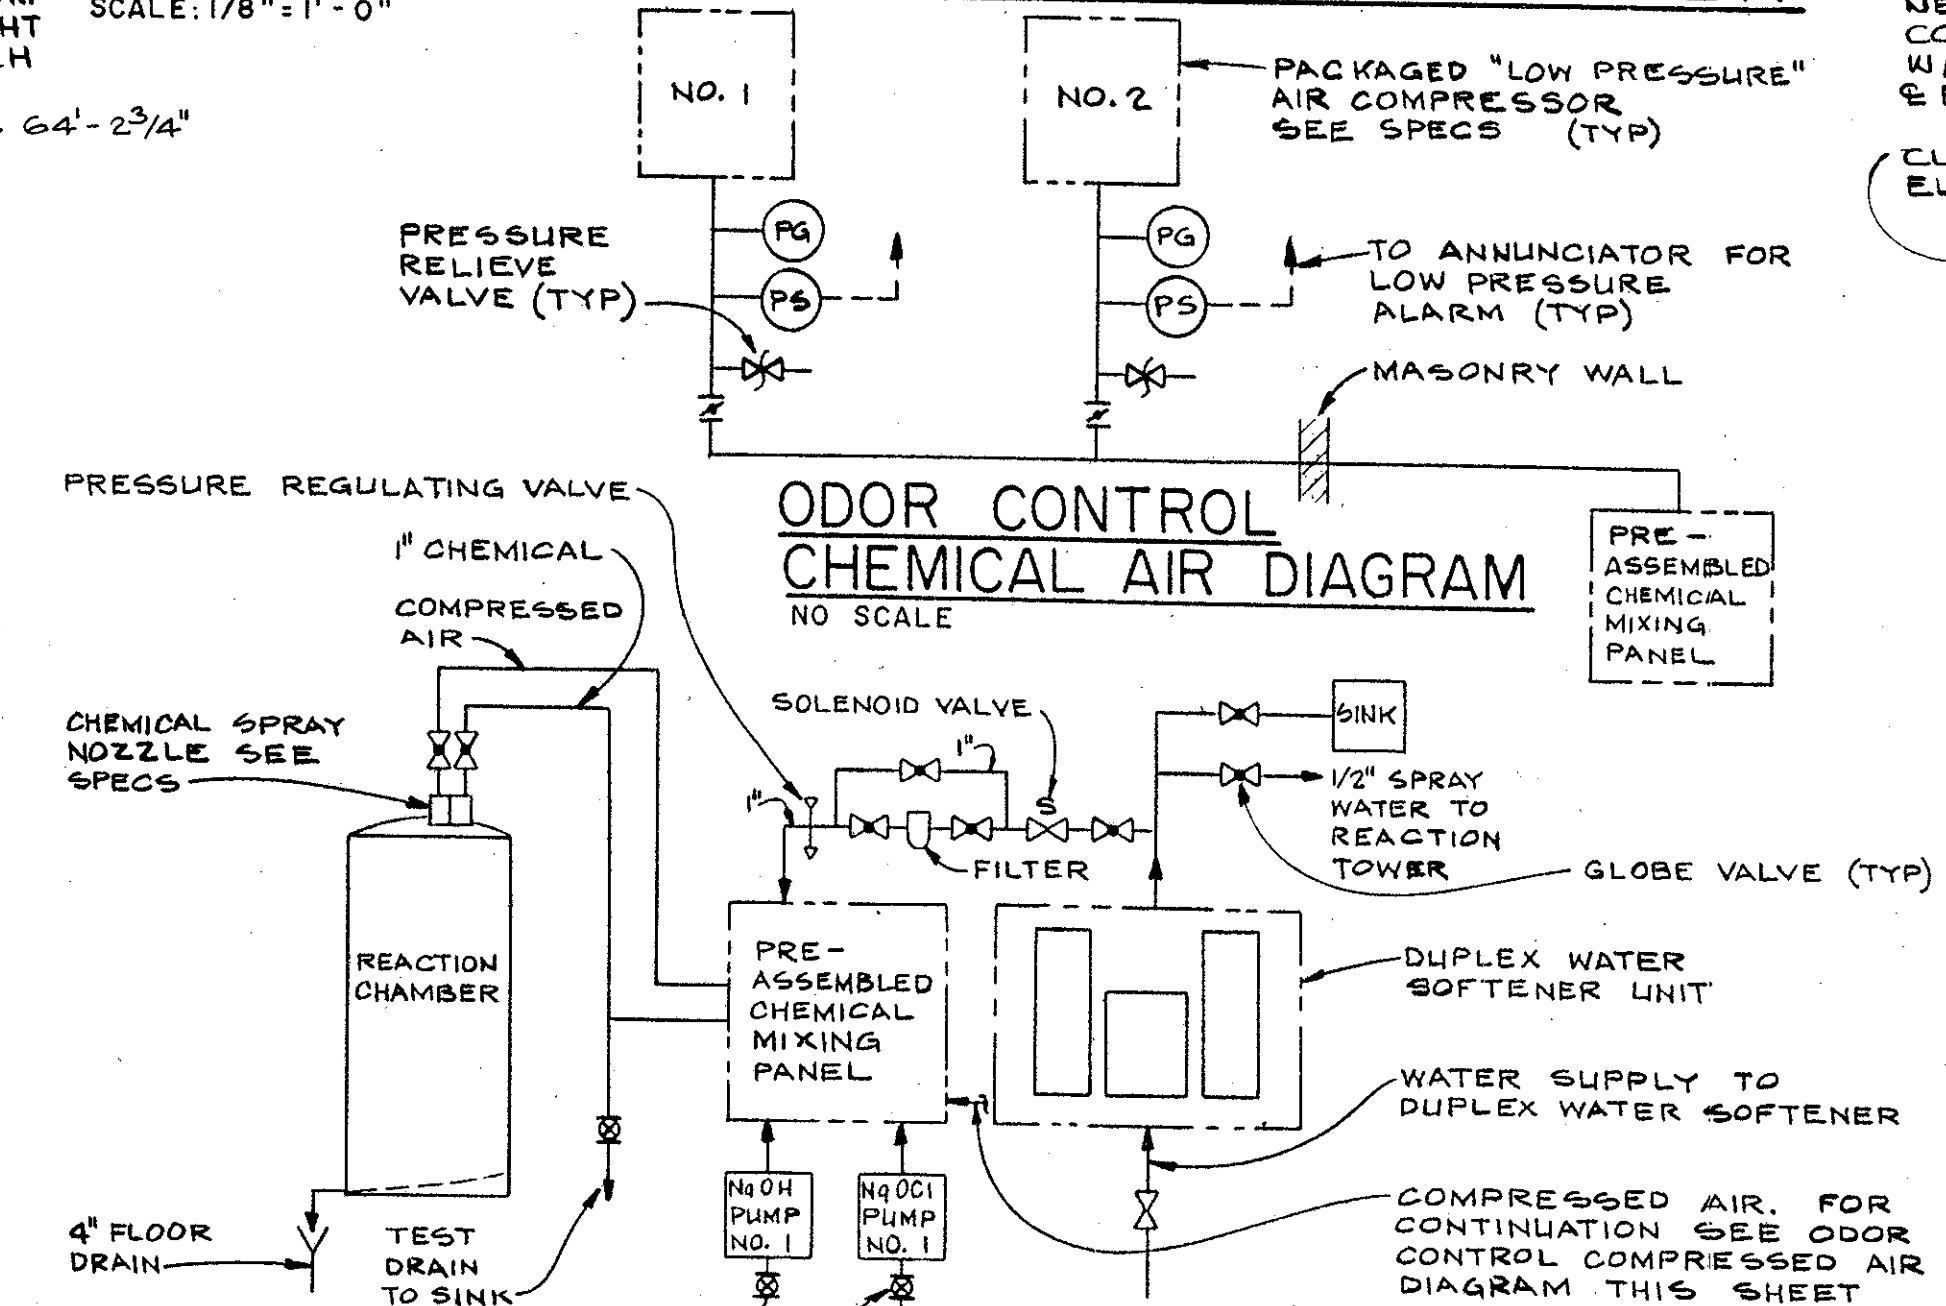

ODOR CONTROL CHEMICAL SYSTEM DIAGRAM NO SCALE


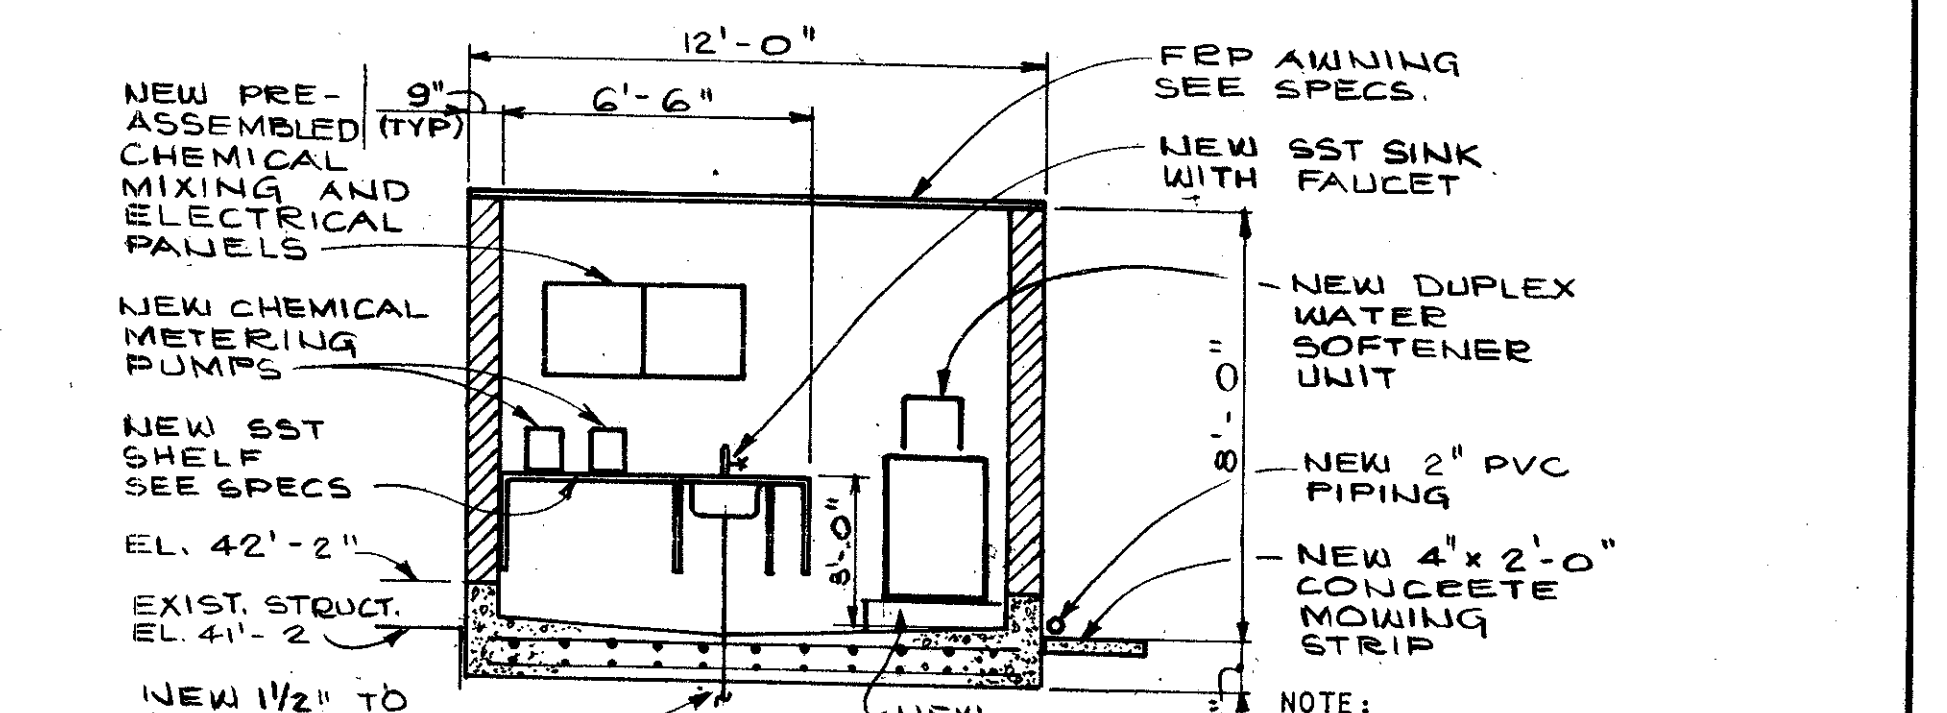


SECTION C SCALE: 1/4" = 1'-0"

NOTE: THIS SHEET APPLIES ONLY TO SYSTEMS WHICH REQUIRE LOW PRESSURE AIR COMPRESSOR EQUIPMENT.


GREELEY AND HANSEN ENGINEERS 222 S. RIVERSIDE PLAZA CHICAGO, ILLINOIS 60606	DESIGNED MPV JRP	APPROVED	NO. DATE APP REVISION	SCALE 0 8 16 FT 1/8" = 1'-0" 0 4 8 FT 1/4" = 1'-0" 0 2 4 6 7 FT 3/8" = 1'-0"	CITY OF TAMPA, FLORIDA SEWAGE DISPOSAL SYSTEM DIVISION 4L5 PUMPING STATIONS ODOR CONTROL MODIFICATIONS	UNIVERSITY PUMPING STATION PLANS, SECTIONS, DETAILS AND DIAGRAMS	PROJ. NO.
	DRAWN ATK						SHEET 9 OF 10
	CHECKED JRP						DATE JULY 1985 REV 0

304-22

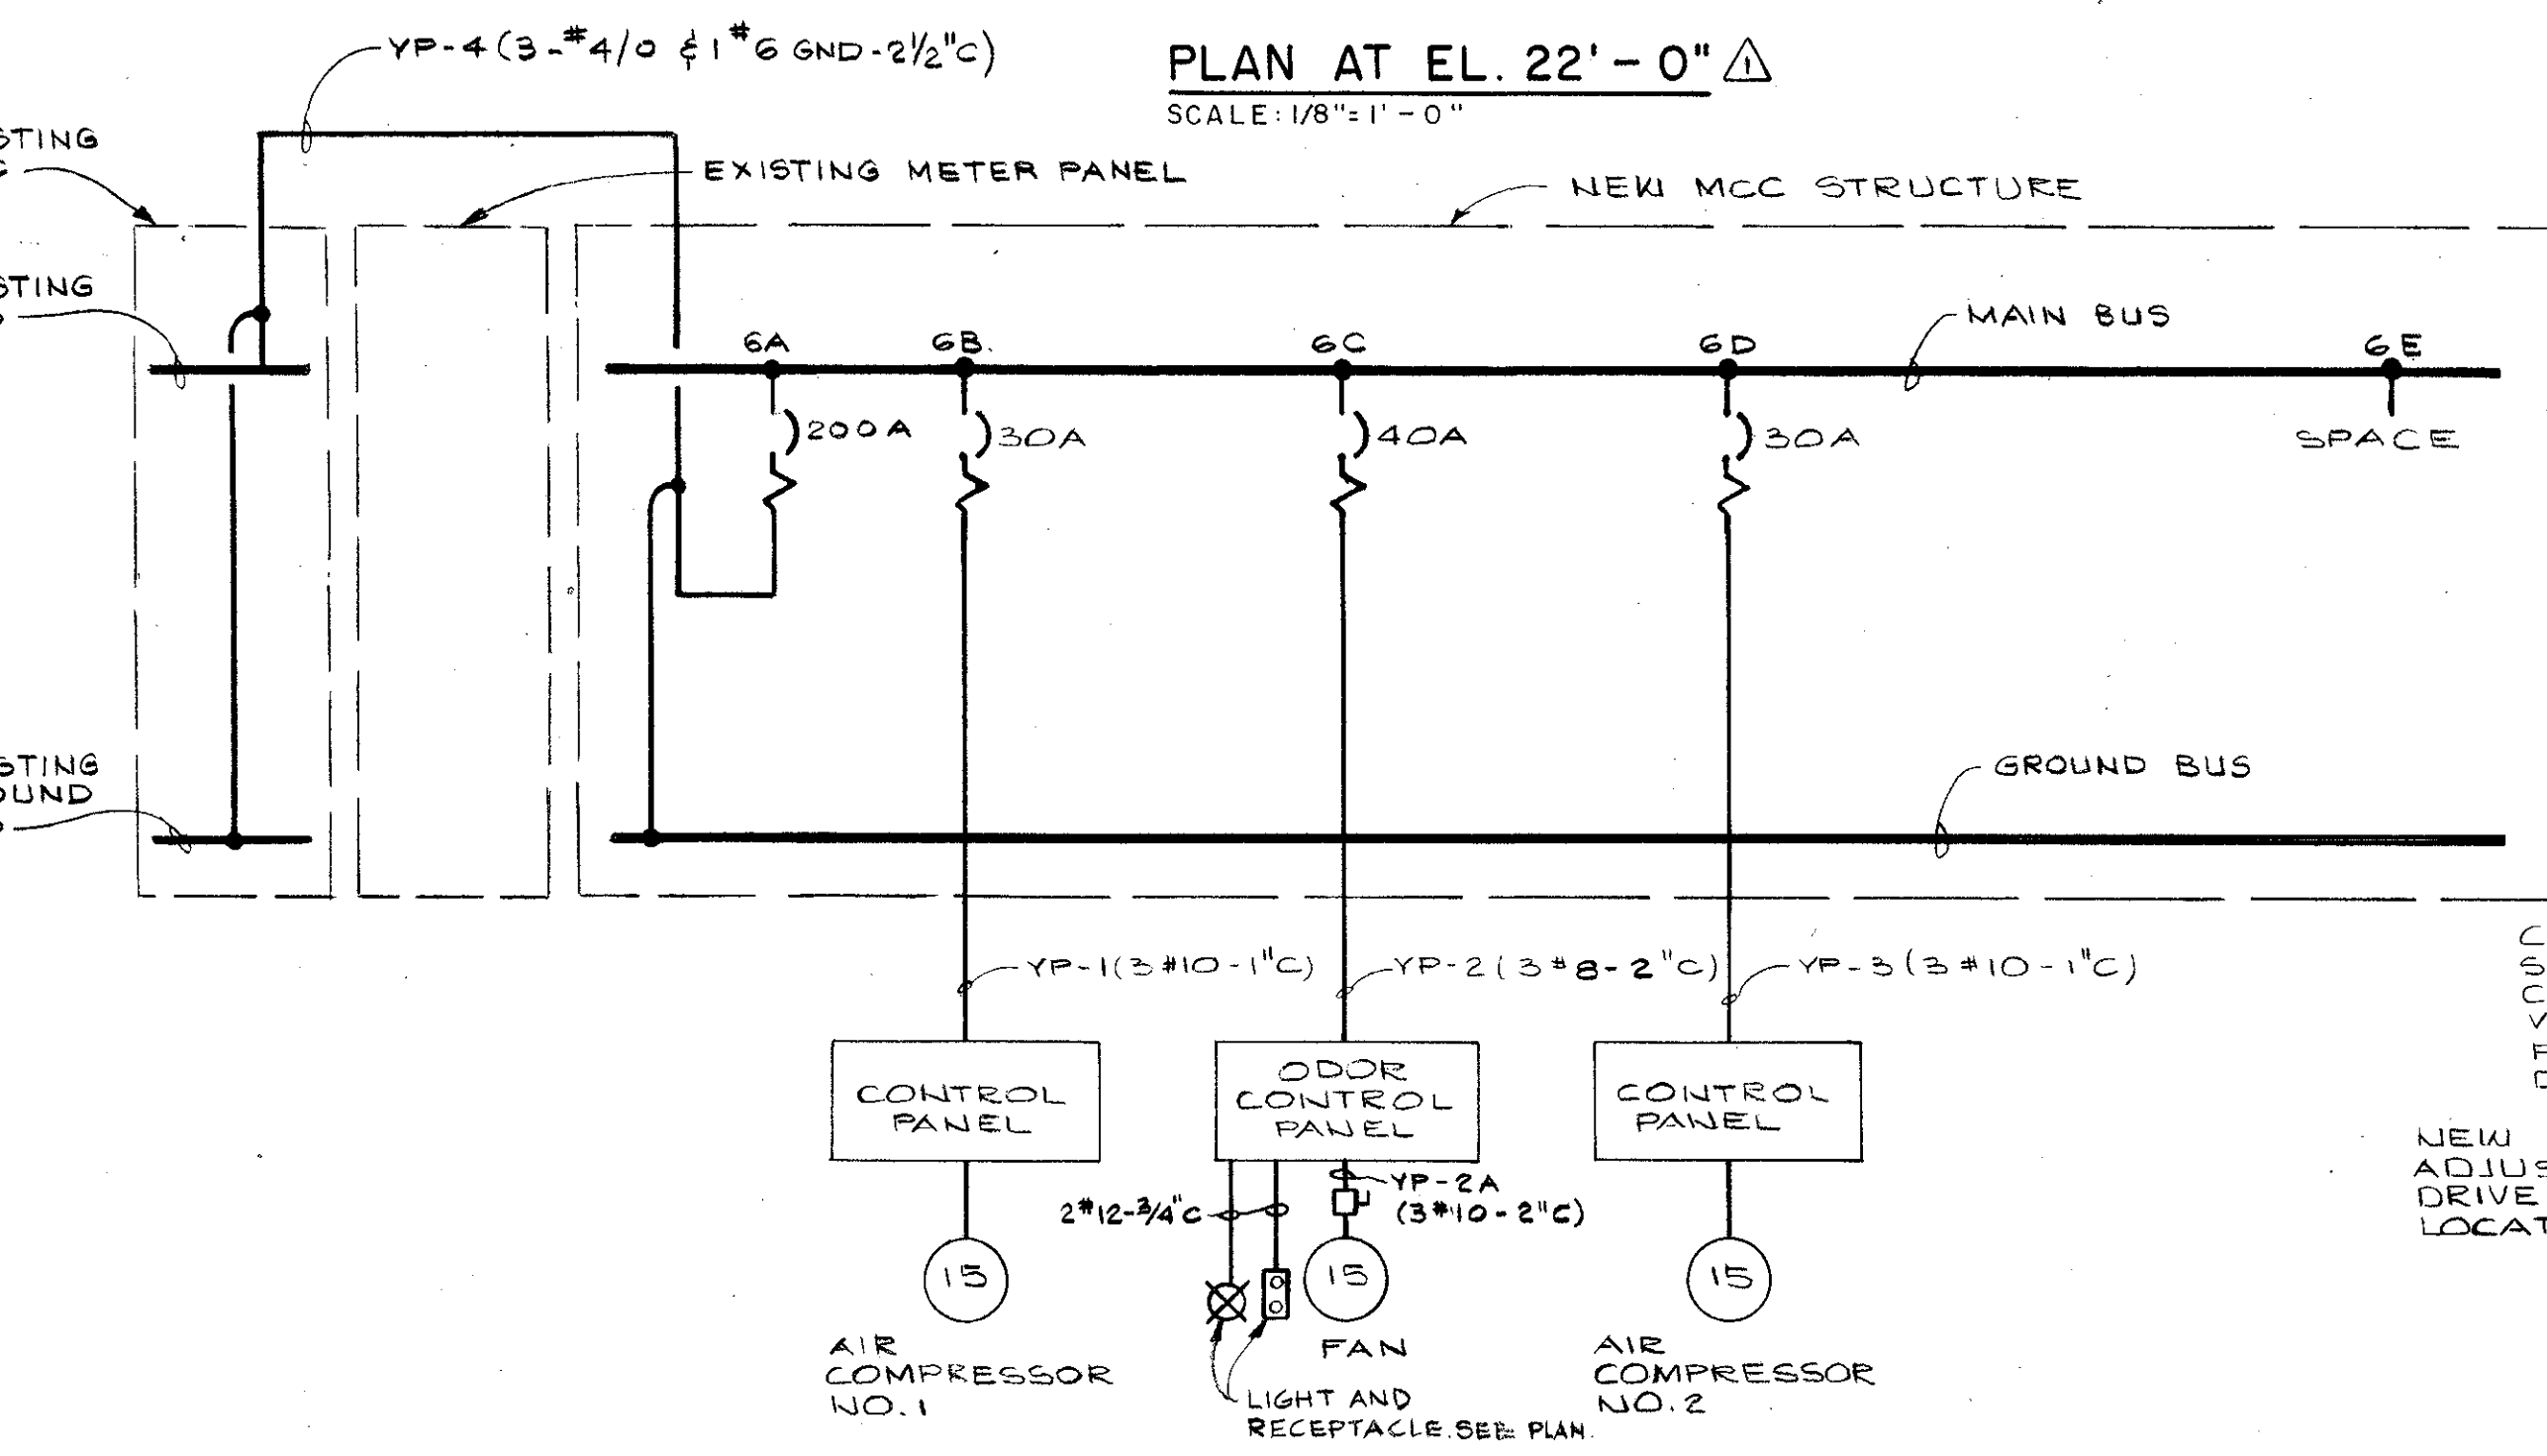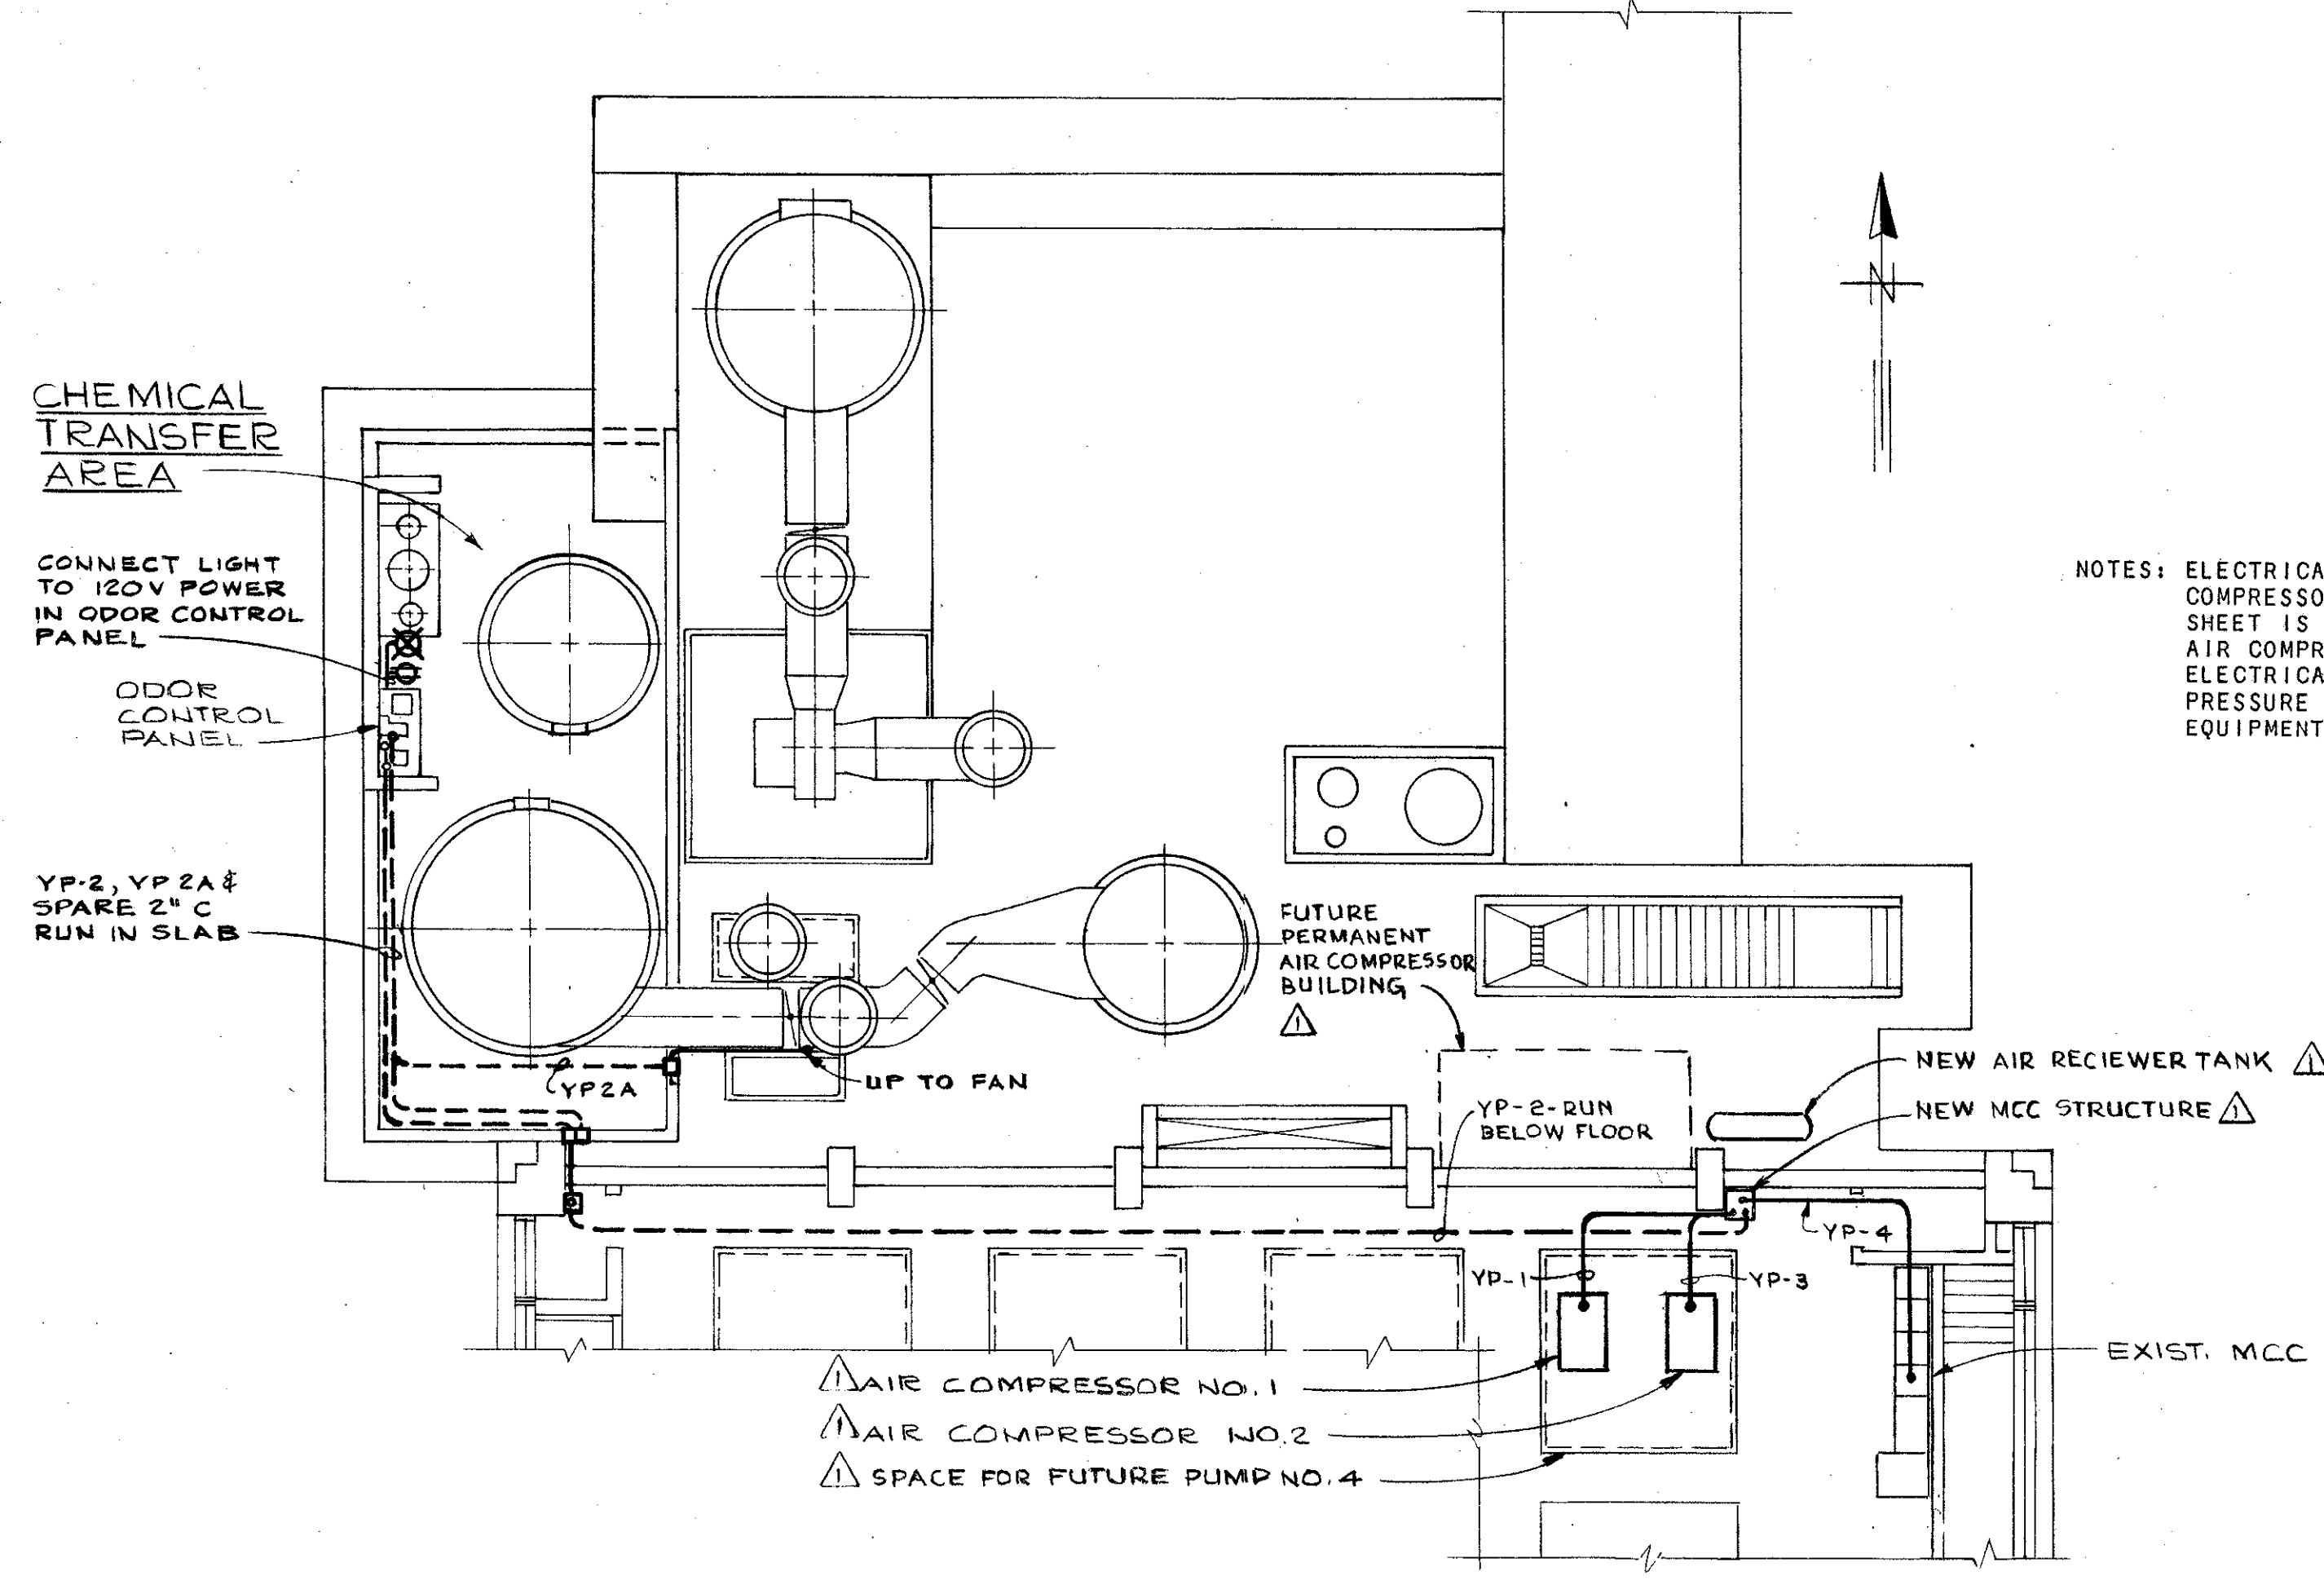


MCC PARTIAL ONE LINE DIAGRAM
480 VOLT, 3 PHASE, 60 HERTZ
YBOR PUMPING STATION

NOTES: ELECTRICAL SERVICE TO AIR COMPRESSORS SHOWN ON THIS SHEET IS FOR HIGH PRESSURE AIR COMPRESSOR EQUIPMENT. ELECTRICAL SERVICE FOR LOW PRESSURE AIR COMPRESSOR EQUIPMENT IS SIMILAR.


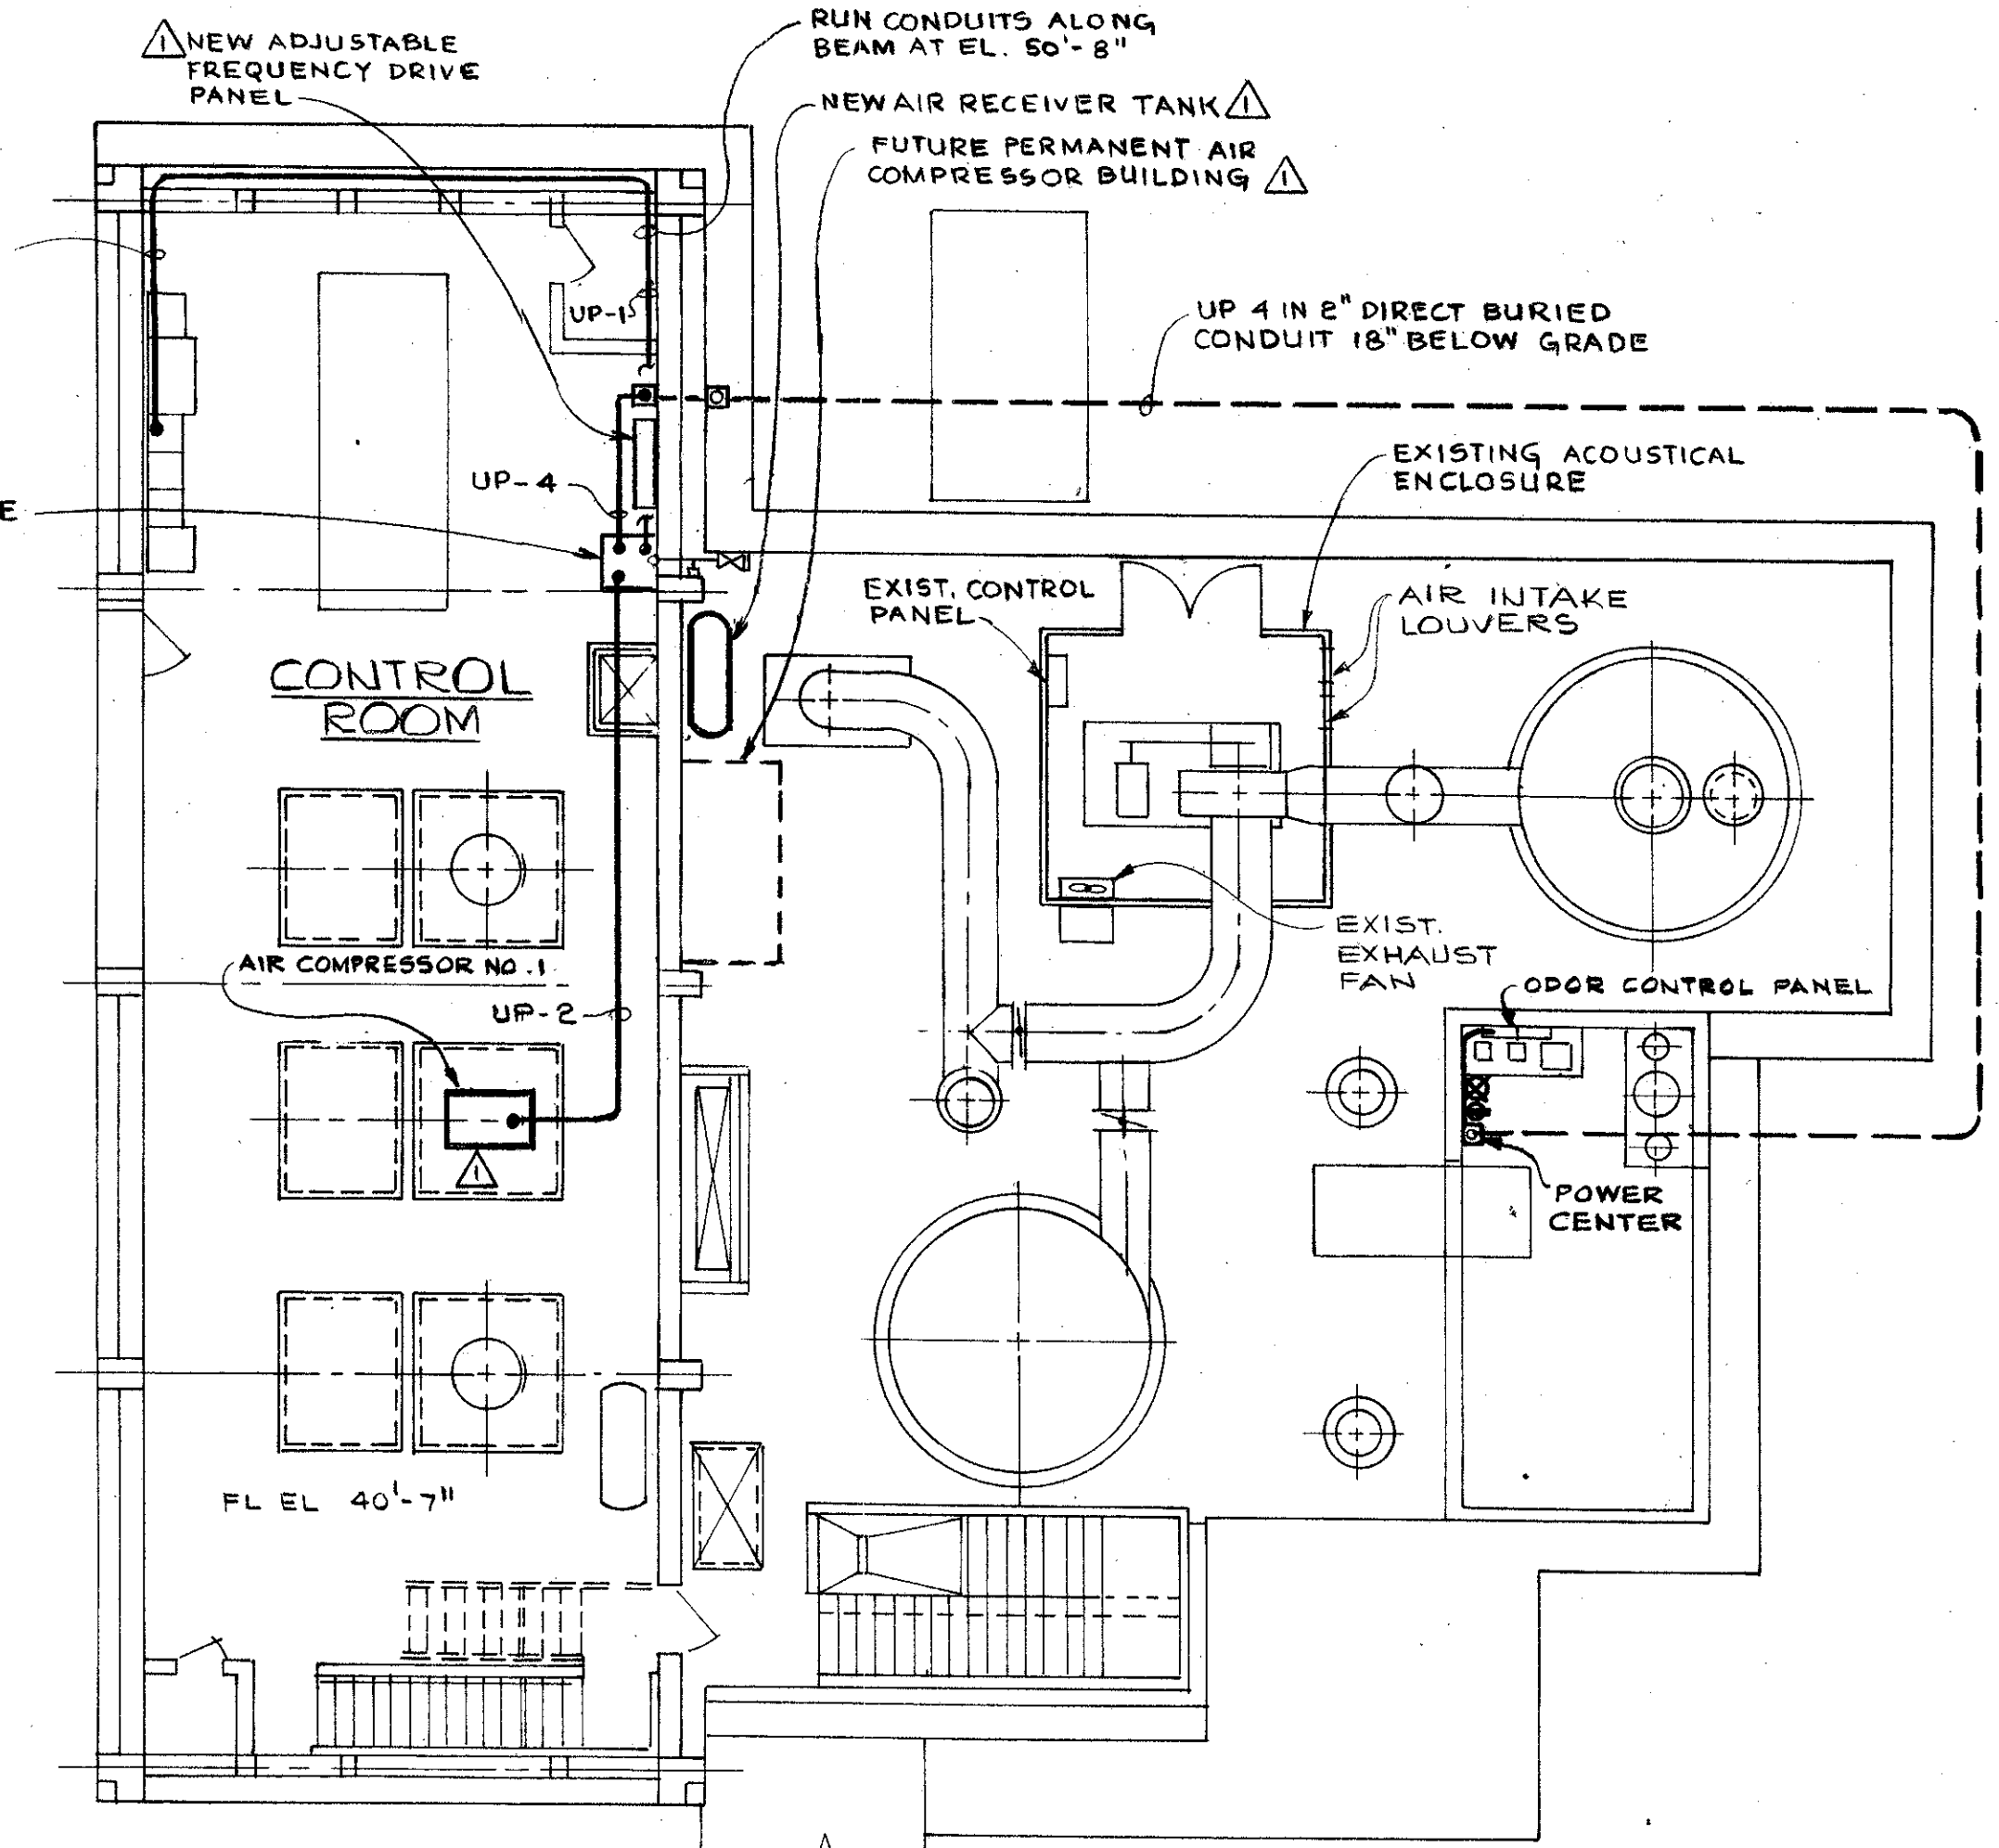


REPLACE EXIST. SIZE 3 STARTER WITH 60A CIRCUIT BREAKER

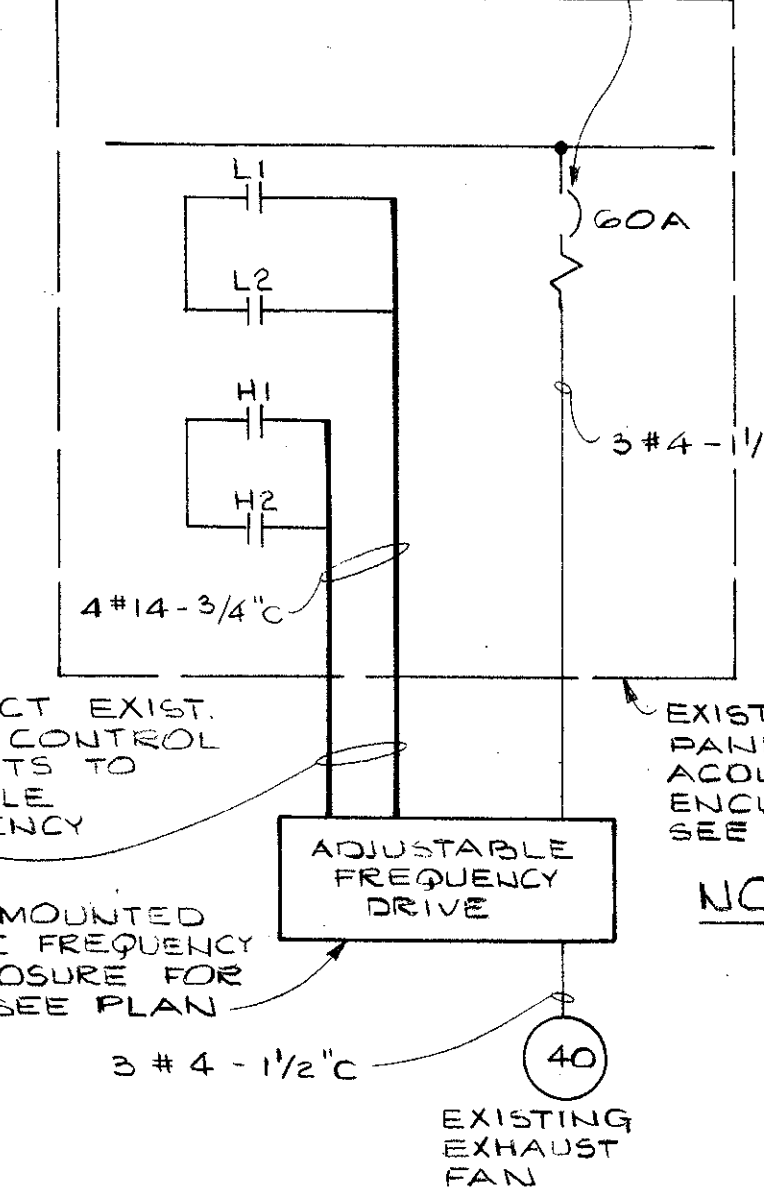

CONNECT EXIST. SPEED CONTROL CONTACTS TO VARIABLE FREQUENCY DRIVE
NEW WALL MOUNTED ADJUSTABLE FREQUENCY DRIVE ENCLOSURE FOR LOCATION: SEE PLAN

PARTIAL ONE LINE DIAGRAM OF EXISTING CONTROL CENTER AND NEW ADJUSTABLE FREQUENCY DRIVE
UNIVERSITY PUMPING STATION

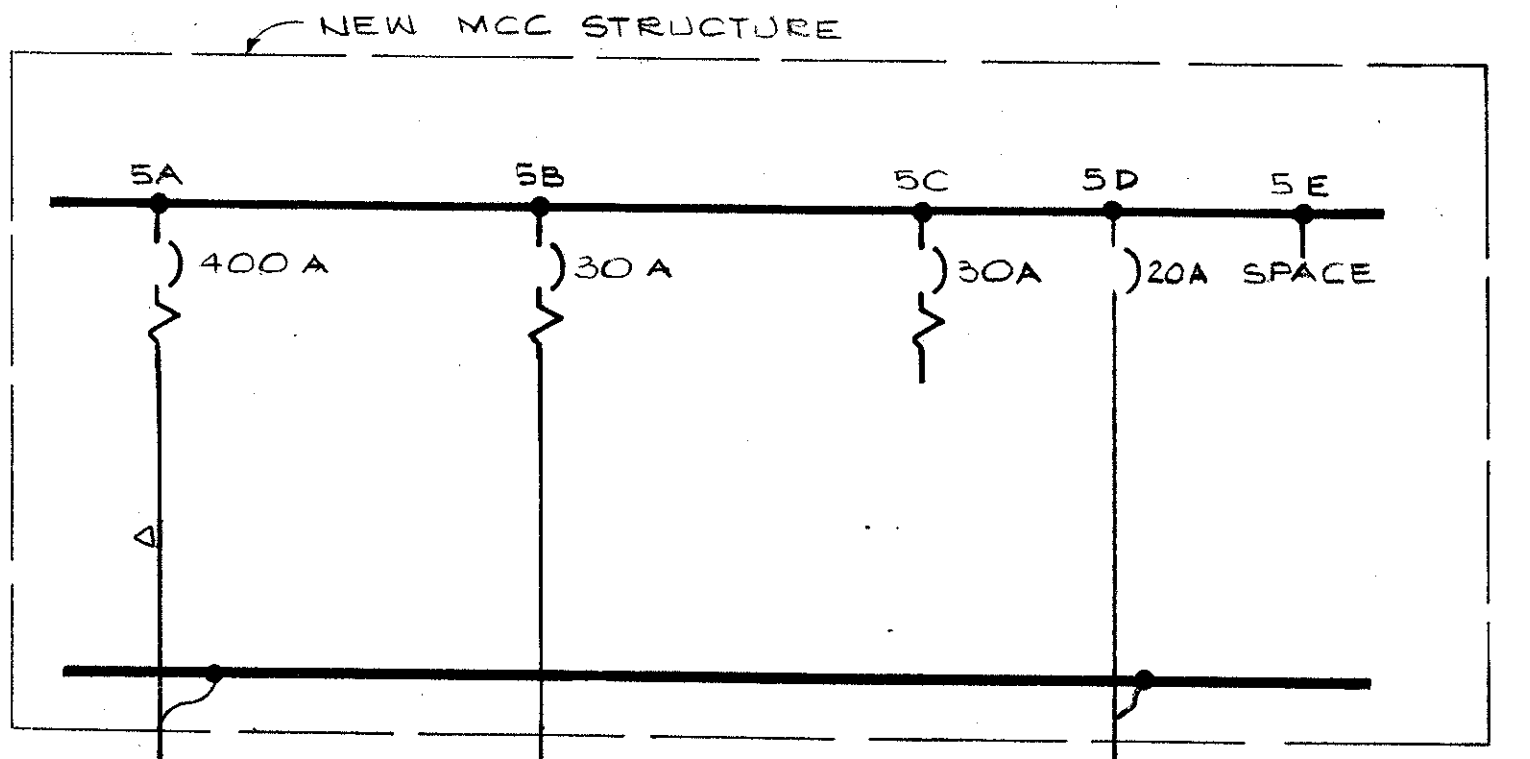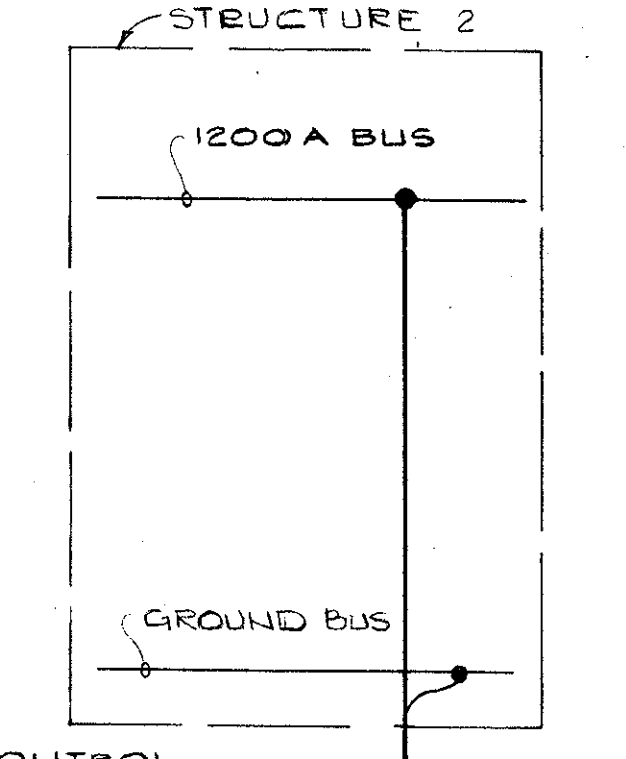


NOTE: CONTRACTOR SHALL VERIFY EXIST. CONTROLS IN FIELD
DELIVER COMPRESSOR NO. 2 TO CITY FOR FUTURE INSTALLATION BY CITY

MCC PARTIAL ONE LINE DIAGRAM
480 VOLT, 3 PHASE, 60 HERTZ
UNIVERSITY PUMPING STATION


Greeley and Hansen Engineers 222 S. Riverside Plaza Chicago, Illinois 60606	DESIGNED BBK	APPROVED	NO. DATE APP. REVISION	SCALE NO SCALE	CITY OF TAMPA, FLORIDA SEWAGE DISPOSAL SYSTEM DIVISION 4L5 PUMPING STATIONS ODOR CONTROL MODIFICATIONS	PROJ. NO. YBOR AND UNIVERSITY PUMPING STATION ELECTRICAL	DWG. SHEET 10 OF 10 DATE JULY 1985 REV. 1
	DRAWN AK						
	CHECKED BBK JRP						

304-23

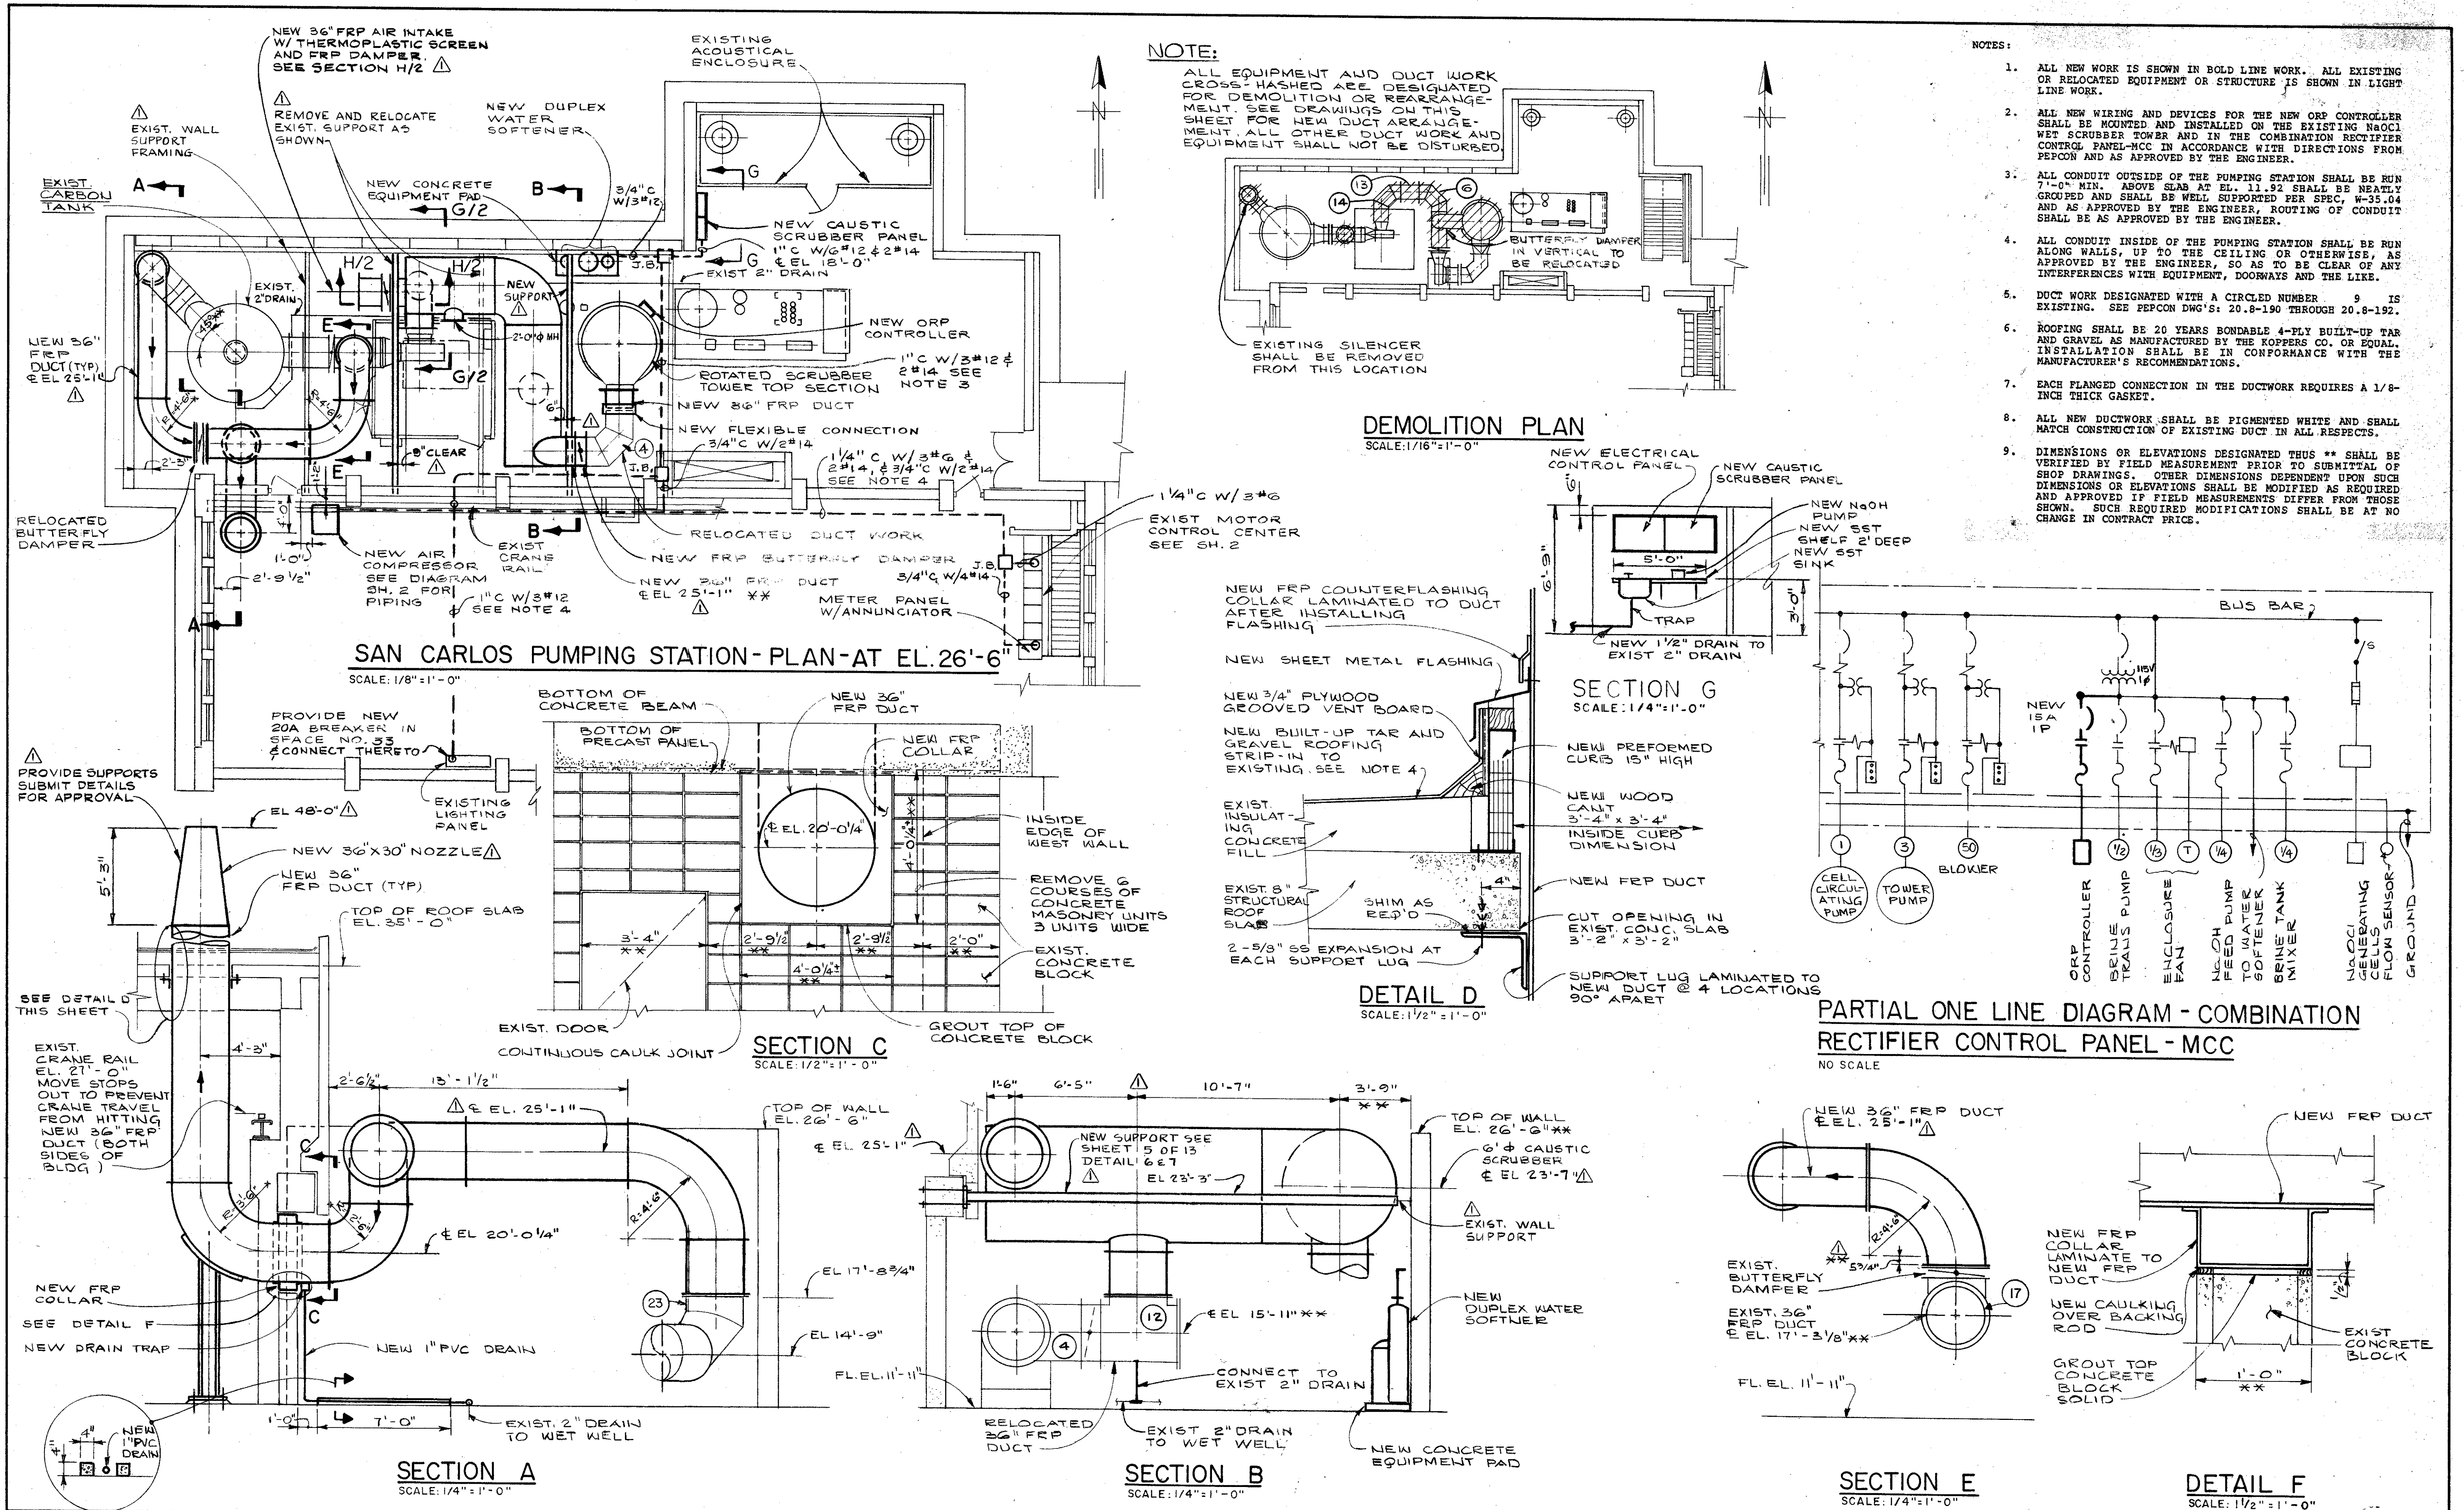


GREELEY AND HANSEN ENGINEERS 222 S. RIVERSIDE PLAZA CHICAGO, ILLINOIS 60606	DESIGNED JRP MPV	APPROVED	SCALE 16 0 32 FT 1/16" = 1'-0" 8 0 16 FT 1/8" = 1'-0" 4 0 8 FT 1/4" = 1'-0"	CITY OF TAMPA, FLORIDA SEWAGE DISPOSAL SYSTEM DIV. 4L-3 ODOR CONTROL EQUIPMENT FOR THREE PUMPING STATIONS	SUPPLEMENTARY DRAWING NO. SD-3	PROJ. NO.
	DRAWN ATK					SHEET 1 OF 2
	CHECKED JRP					DATE JUNE, 1986 REV 1


304-24

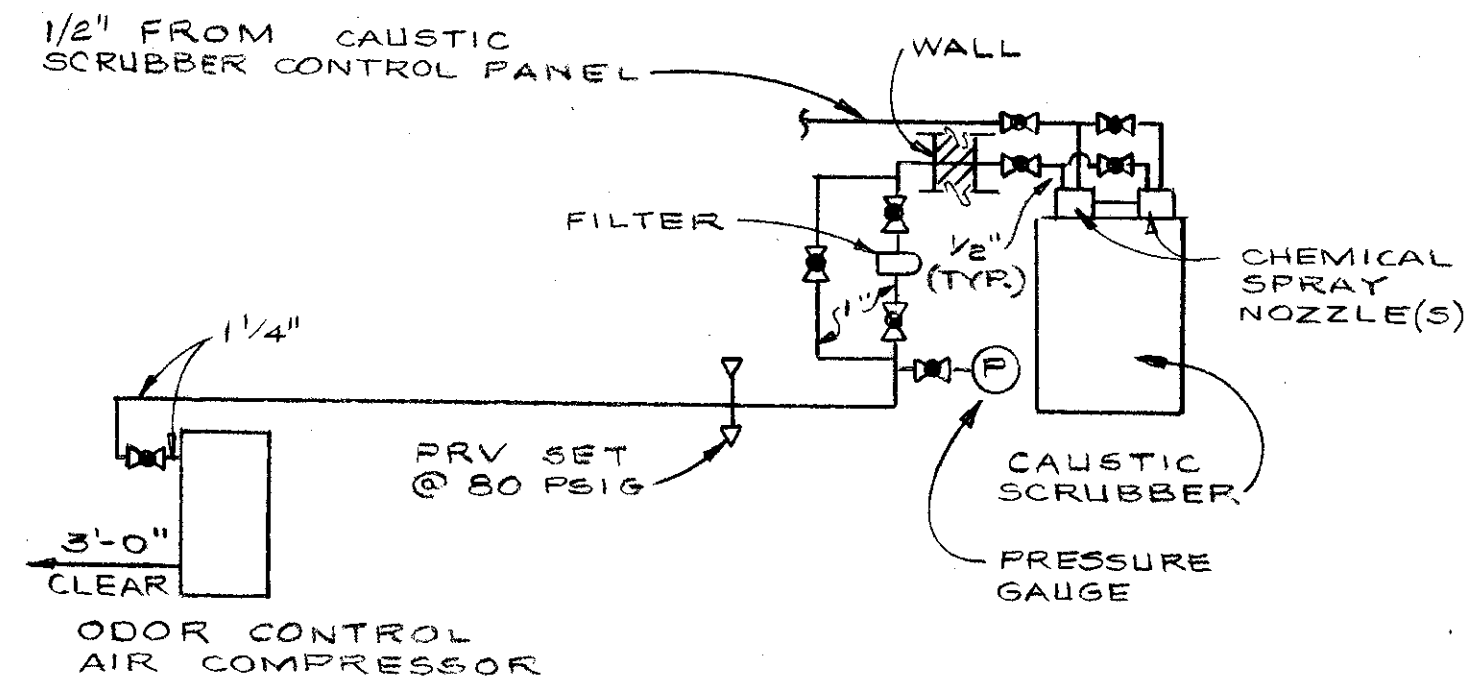


ODOR CONTROL COMPRESSED AIR DIAGRAM
NO SCALE

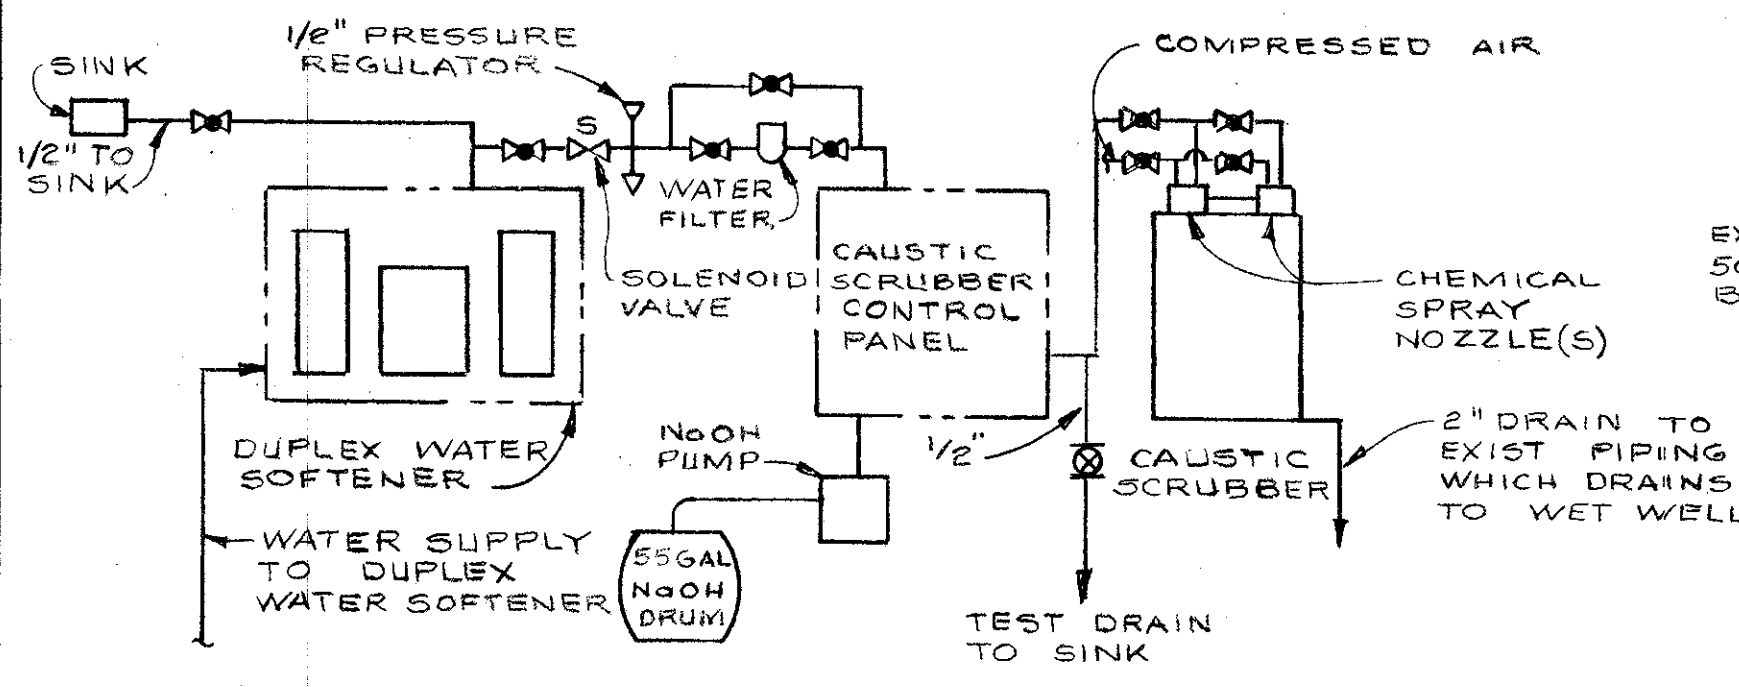


CAUSTIC SCRUBBER SYSTEM DIAGRAM
NO SCALE

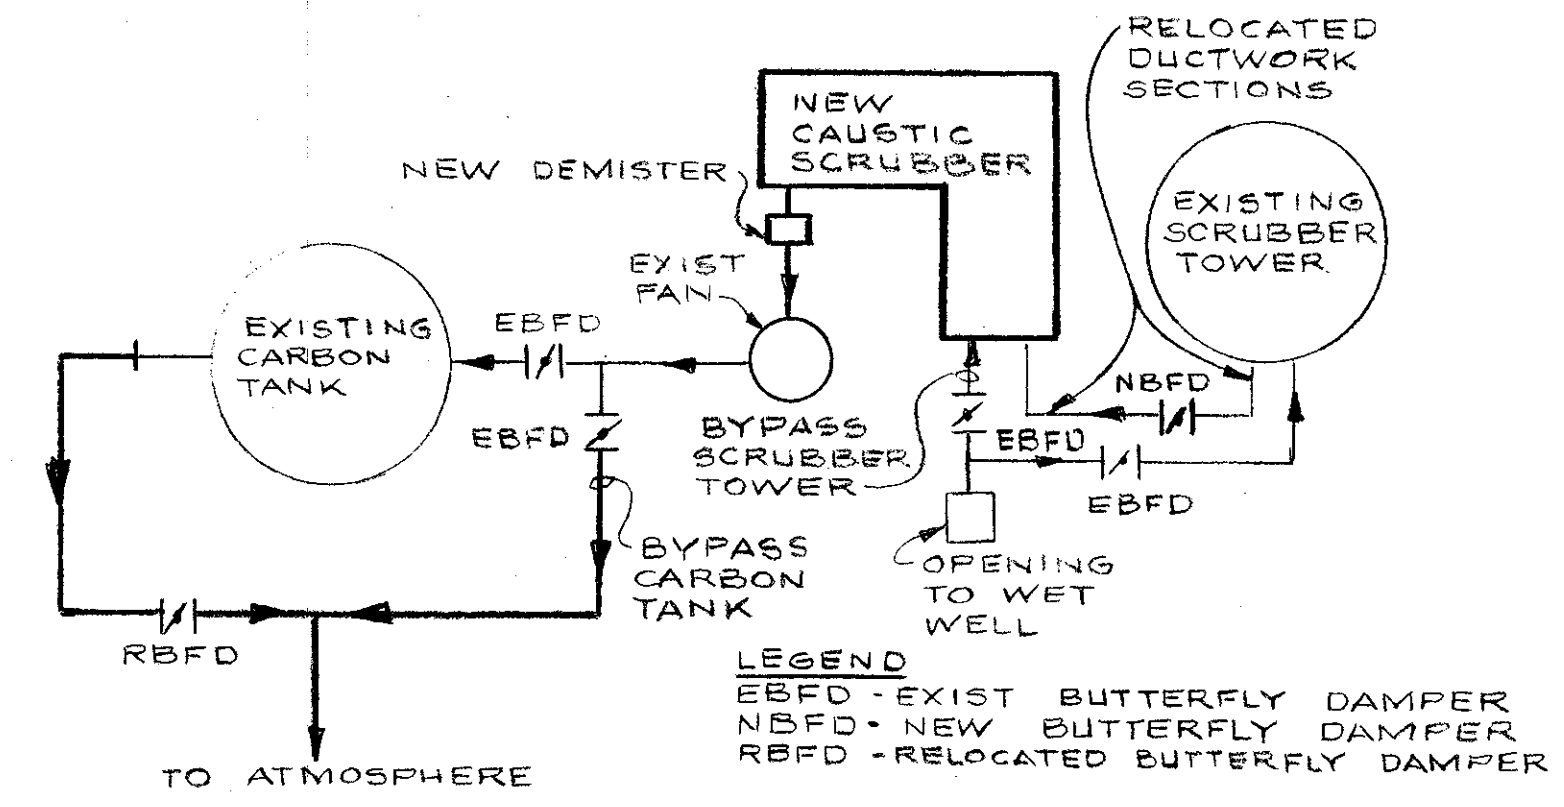


ODOR CONTROL FLOW DIAGRAM
NO SCALE

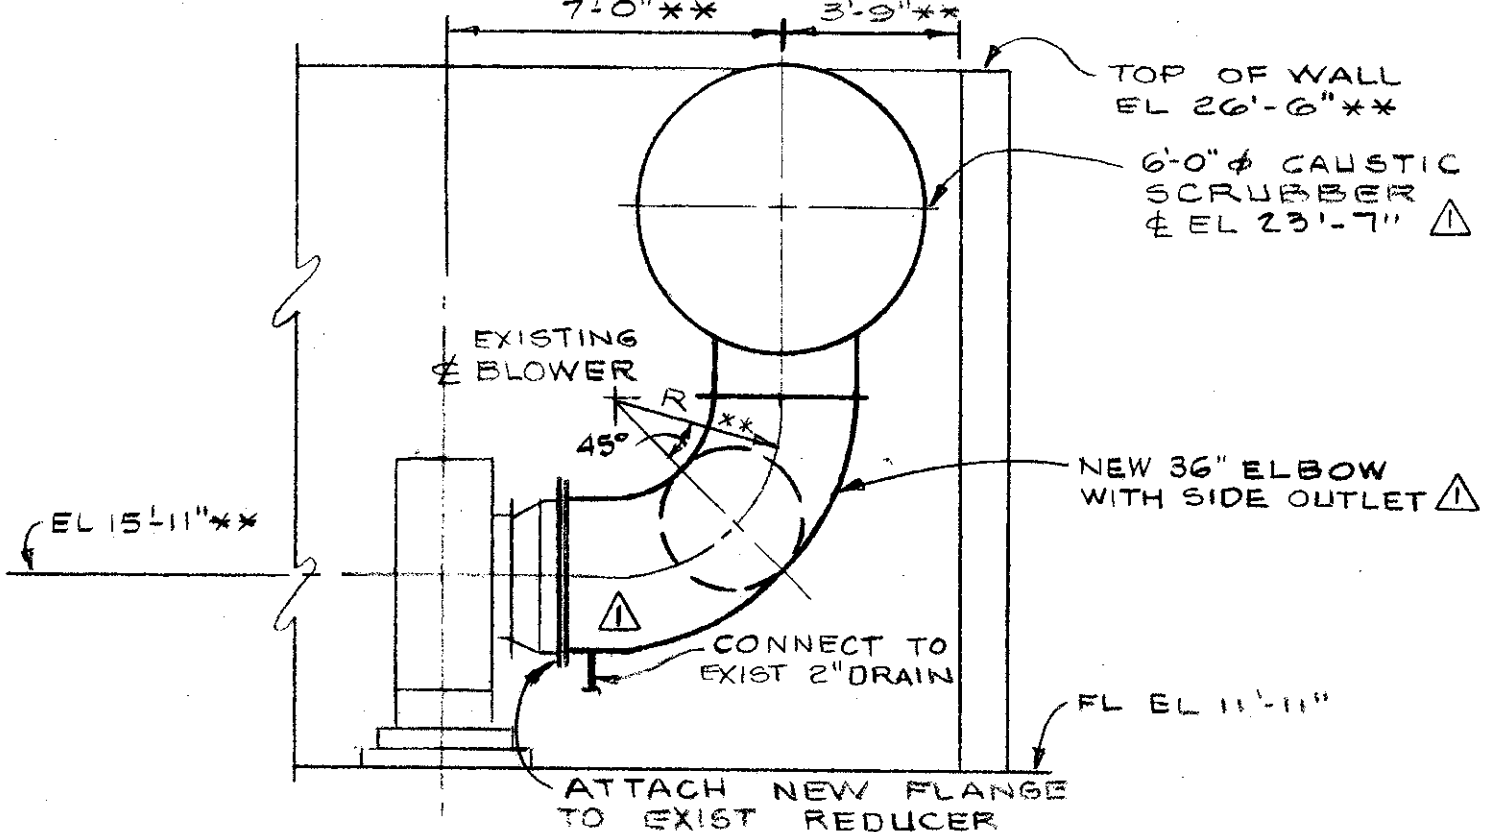


SECTION G/I
SCALE: 1/4" = 1'-0"

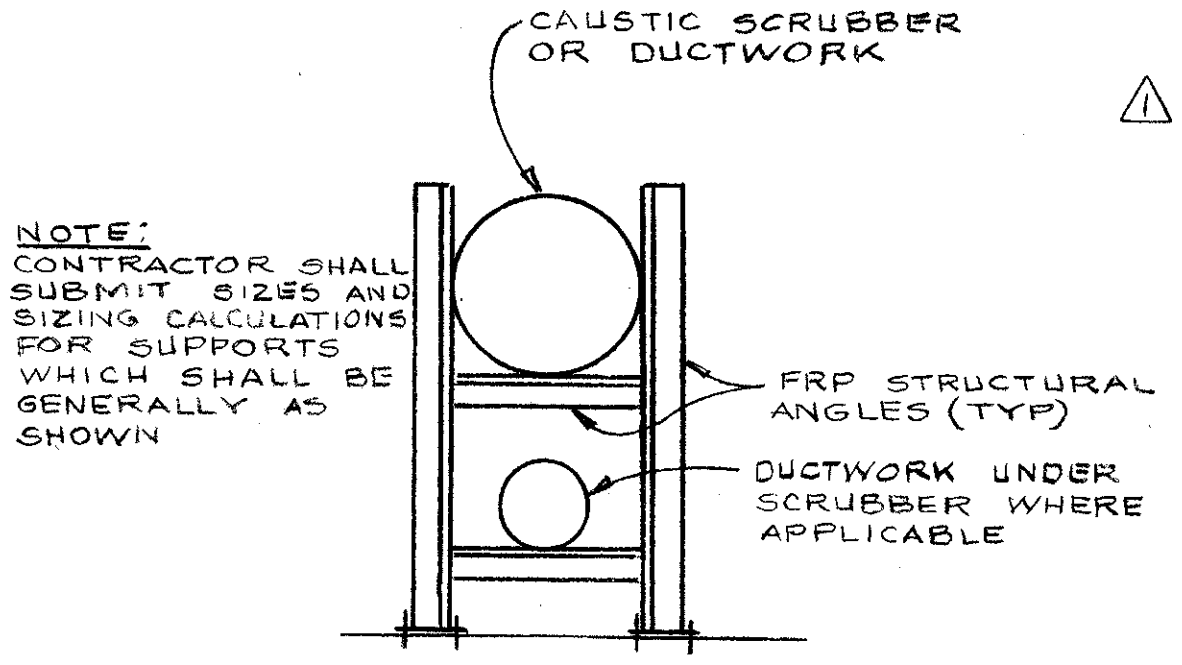


DUCTWORK AND CAUSTIC SCRUBBER SUPPORT DETAIL
NO SCALE

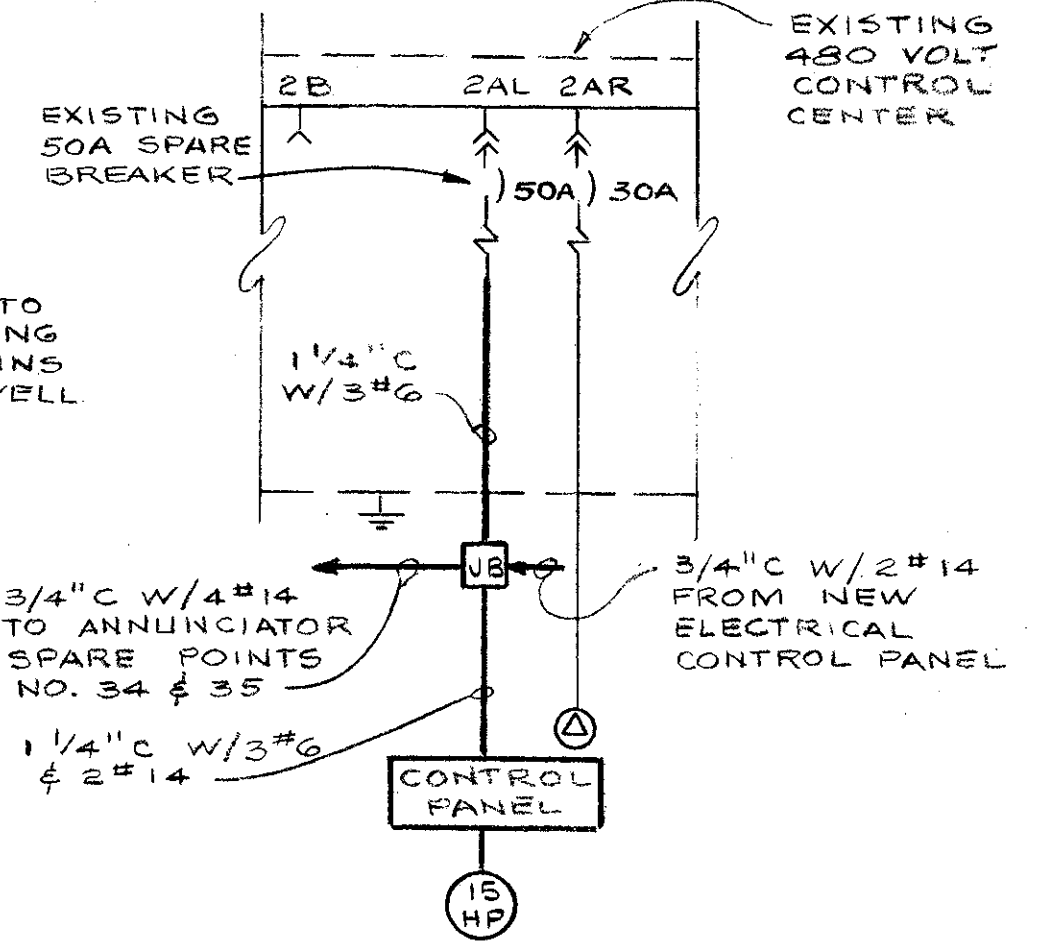

PARTIAL ONE LINE DIAGRAM
NO SCALE

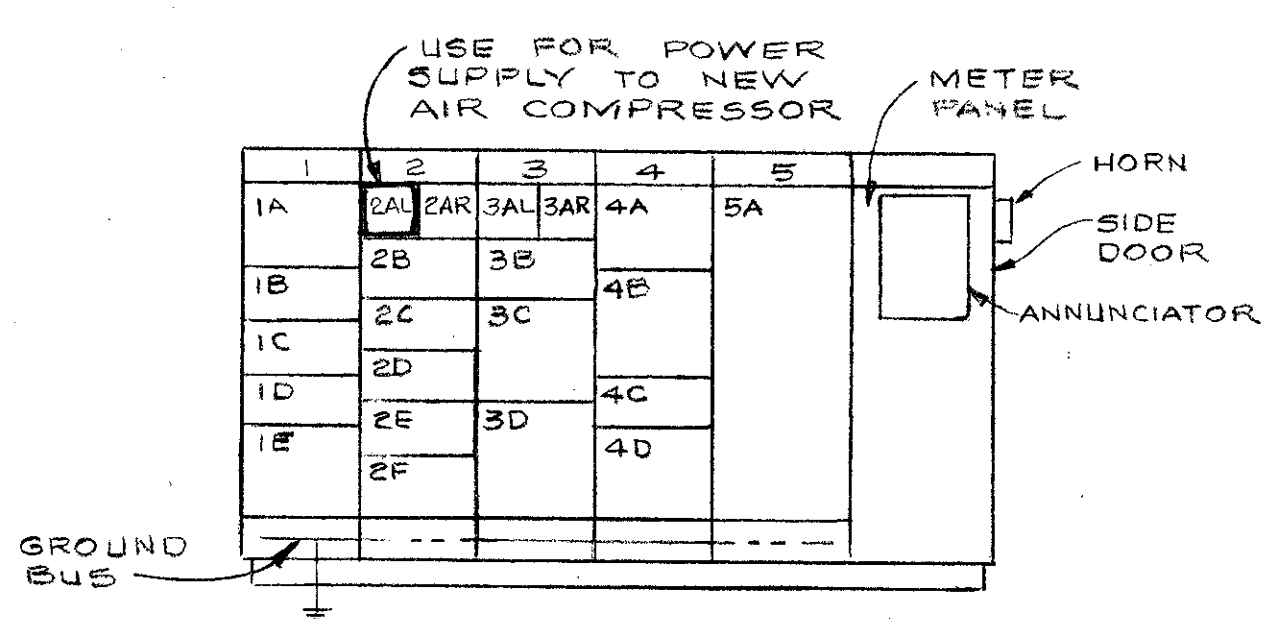

CONTROL CENTER FRONT VIEW
NOT TO SCALE

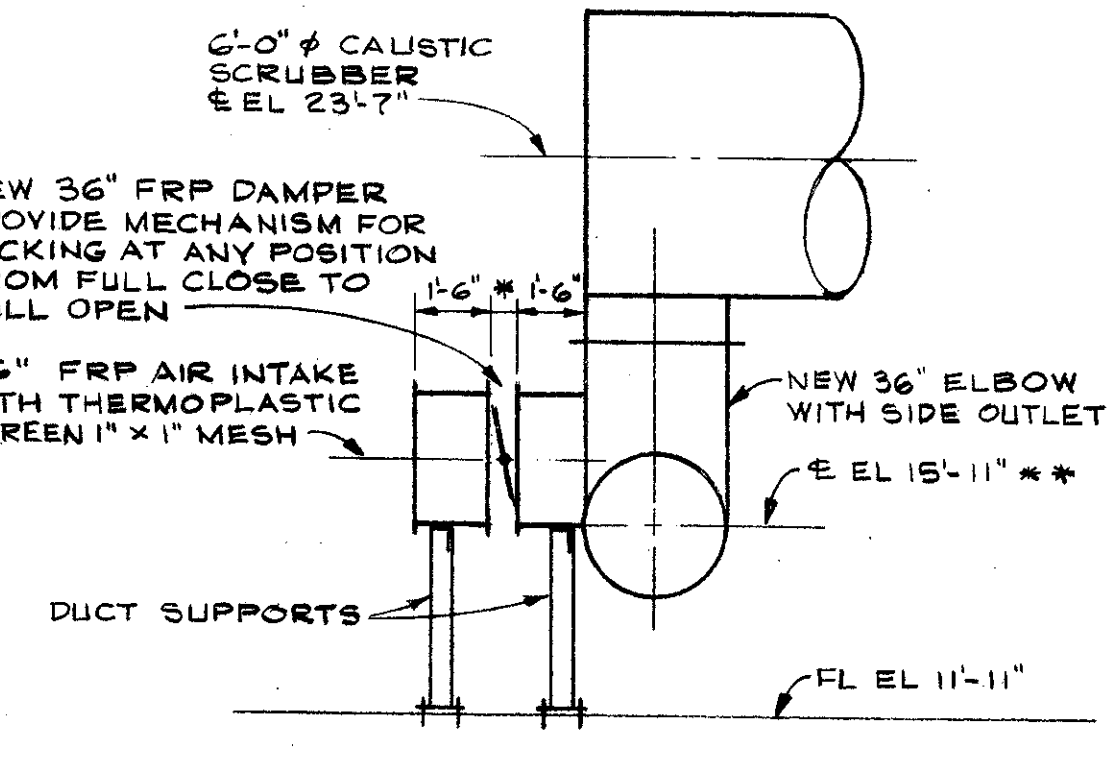

SECTION H/I
SCALE: 1/4" = 1'-0"

16. BLOWER MODIFICATIONS

The existing blower is a New York Blower, Model FE30, driven by a 50 HP, 1770 RPM, 460 V, 3 phase electric motor via 3 V-Belts on a 10.3-inch driver sheave and a 9.25-inch driven sheave at 50.7-inch centers, producing a fan speed of 1969 RPM and delivering 12,300 cfm of air at 14 inches W.C. static pressure.

Blower modifications include changing the blower drive sheaves and belts to produce a fan speed of 2100 RPM in order to deliver approximately 22,300 cfm of air at 3 inches W.C. static pressure.

SPECIFICATIONS

- GENERAL**
Unless shown or specified otherwise, all Workmanship and Materials shall conform to the Division 413 Contract Documents.
- CAUSTIC SCRUBBER**
The new Caustic Scrubber shall be designed to neutralize all acids and acidic compounds present in the treated air stream from the existing NaOH Wet Scrubber Tower. The new Caustic Scrubber shall be of the size and shape shown, arranged to fit in the available space and have a retention time of approximately 3 seconds based upon an air flow rate of 12,300 cfm. The new Caustic Scrubber shall be designed to use a "once through" solution of NaOH and softened water to neutralize all acids and acidic compounds in the 12,300 cfm air stream based upon 100 percent humidity and an inlet pH range of 1.0 to 6.0. The pH of the spent chemical to drain shall be in the range of 7.5 to 8.0. Softened water consumption shall not exceed 1.0 gpm. The new requirements of the Workmanship and Materials section headed "Duct work and Dampers" and shall be chemically resistant to the caustic solution. The new Caustic Scrubber shall be equipped with a chemical distribution device or devices, as required, to supply the caustic solution to the air stream to intimate contact between the chemical and the air stream to scrubber shall be as manufactured and supplied by QUAD Environmental Technologies Corp., Highland Park, IL, or equal.
- AIR COMPRESSOR**
An air compressor malfunction shutdown alarm contact shall be provided. The malfunction shutdown alarm contact shall be wired to a spare alarm point of the existing pumping station annunciator.
The new Air Compressor, shall be of the rotary screw type, having a minimum rated capacity of not less than 68 cfm at 110 psig, driven by a 15 HP 460 volt, 3 phase, 60 hertz electric motor. Final capacity and pressure requirements shall be as required by the manufacturer supplier of the new Caustic Scrubber. The new air compressor shall be a completely factory assembled package, housed in an acoustical enclosure, and shall be Model SK 18 as manufactured by Kaeser Compressors, Fredericksburg, VA, or equal.
- CHEMICAL METERING PUMP**
The chemical metering pump shall be positive displacement, diaphragm type pump. Output volume shall be adjustable while pump is in operation, from zero to maximum capacity. Adjustment shall be by means of readily accessible dial knobs, one for changing stroke length and the other for changing stroke frequency. Both knobs shall be located opposite the liquid handling end. Control of metering pump shall be selectable between internal and external pulsing by means of a 3-position HAND-OFF-AUTO switch. When in the HAND position, metering pump capacity shall be manually adjustable by means of the pump mounted knobs. When in the AUTO position, metering pump capacity shall be automatically adjusted by the automatic chemical metering control specified herein. The chemical metering pump shall be capable, without a hydraulically backed diaphragm, of injecting chemicals against pressures up to 100 psig.
The size and capacity of the chemical metering pump shall be determined by the caustic scrubber manufacturer-supplier to provide the required quantity of NaOH to neutralize the compounds specified above under the heading "Caustic Scrubber".
The pump drive shall be totally enclosed with splash proof control panel and no exposed moving parts. Solid state electronic pulser shall be fully encapsulated. Electronics shall be housed in chemical resistant enclosure at the rear of the pump for maximum protection against chemical spillage. The chemical metering pumps shall be 120 volt, single phase 60 hertz.
Chemical metering pump housing shall be of chemically resistant glass fiber reinforced thermoplastic with a glass fiber reinforced polypropylene solenoid carrier. All exposed fasteners shall be stainless steel. Chemical metering pump valves shall be ball type, with ceramic balls and seal ring shall be renewable by replacing only the combination seat-seal ring. Pump head shall be of PVC material. Fittings and connections at pump head shall be PVC and/or polypropylene.
- CAUSTIC SCRUBBER CONTROL PANEL**
The Caustic Scrubber Control Panel shall be provided complete with all required piping, gauges, regulators, meters, valves and all other such devices required to dilute and deliver the required quantity of liquid chemicals to the caustic scrubber. The Panel shall be arranged for wall mounting as shown and shall have fittings properly labeled and ready for field connection to water, chemicals and discharge piping.
- ELECTRICAL CONTROL PANEL**
The electrical control panel shall be a NEMA 3R enclosure constructed of minimum 12 gauge type 304 stainless steel and shall be adequately reinforced to support all components within the enclosure without distortion, bowing or deflection. The electrical control panel shall be provided with a continuously hinged (vertical along left side) door with a heavy duty handle with a hasp for padlock and a 3 point catch mechanism.
Devices to be provided in the electrical control panel shall include, but may not be limited to the following:
 - Power disconnect switch with system On indicator light.
 - Water On/Off switch and On indicator light (controls water solenoid valve).
 - A chemical system power switch with On indicator light (provides power to metering pump and automatic chemical pacing controls).


- AUTOMATIC CHEMICAL PACING CONTROLS**
Automatic chemical pacing controls shall be furnished to provide reliable automatic adjustment of the chemical feed rates of the chemical metering pump so that the pH of the spent chemical to drain is in the range of 7.5 to 8.0. It is the sole responsibility of the Caustic Scrubber manufacturer to design, select and furnish such automatic chemical pacing controls. The automatic chemical pacing controls and a complete description of operation including wiring diagrams and schematics shall be submitted to the Engineer for approval.
- PIPING, VALVES, GAUGES, SWITCHES AND OTHER DEVICES**
Piping for water and compressed air shall be copper pipe and fittings meeting the requirements of the Workmanship and Materials section headed "Miscellaneous Pipe and Fittings". All pipe and fittings for chemical service shall be of plastic pipe of the proper type and formulation for the chemical service employed.
Valves for water and compressed air shall be of the types shown and shall meet the requirements of the Workmanship and Materials section headed "Valves". Valves in chemical pipelines shall be of plastic of the proper type and formulation for the chemical service employed.
Gauges, switches and all other devices shown or required shall be constructed of corrosion resistant materials such as plastic or stainless steel and shall be suitable in all respects for the service employed.
A liquid level switch shall be provided to shut down the NaOH chemical metering pump when liquid level in the drum is low and provide a low level alarm signal to a spare alarm point in the existing pumping station annunciator. The switch shall be an encapsulated reed type activated by a formed polypropylene float mounted in a PVC float tube. The switch assembly shall be mounted in a corrosion resistant glass reinforced polypropylene housing.
- BUTTERFLY DAMPER**
Butterfly dampers shall be constructed of glass fiber reinforced polyester (FRP). Dampers shall be "Merx" 36-inch FRP damper with stainless steel shaft stubs and teflon shaft bushings and locking external position handle, or equivalent. Dampers shall be provided with hand wheel operators, or when mounted more than 6'0" above the slab, with chain wheel operators.
- DEMISTER**
All demister device constructed of plastic shall be installed in the duct work as shown. The demister shall be designed to effectively remove moisture from the air stream. Head loss through the demister device shall not exceed 0.2 inches water column. A one inch PVC drain connection shall be provided in the bottom of the duct as shown, and be piped to the existing drain system.
- ORP CONTROLLER**
A new ORP Controller shall be provided for the existing NaOH Wet Scrubber Tower. The ORP controller and associated ORP probe shall continuously check the oxidant concentration of the scrubbing solution. The controller shall adjust the dc output of the existing system rectifier to produce the required amount of sodium hypochlorite solution. The ORP probe shall be equipped with continuous cleaning capacity. The ORP probe and controller shall be as manufactured by the Pacific Engineering and Production Co. of Nevada.
- WATER SOFTENER**
The new water softener shall be Culligan Duplex model HB-45 or equal. Supply piping to the new water softener shall be connected to the existing hard water supply as directed by the Engineer.
- SINK AND FAUCET**
Stainless steel sink shall have overall dimension of 25 inches long, 22 inches wide and 10 inches deep, single bowl compartment, as manufactured by the Elkay Manufacturing Company, or equal. The basin shall be constructed of type 302, 20-gauge stainless steel, with not less than 1-1/2-inch wide rim on all four sides. All inside corners of sink compartment, vertically and horizontally, shall be rounded to 1-inch radius, and corner intersections shall be spherical covers. The bottom of the sink compartment shall be pitched to a waste opening in a manner assuring complete drainage. The waste outlet shall be a center outlet. Exposed surfaces of the sinks shall receive a No. 4 finish. Overflows, plugs, strainers, tailpieces and related items shall be included.
The water faucet shall be one handle deck mount type with goose neck Model IK-2085-13L as manufactured by Elkay or equal.
- SPARE PARTS**
The following spare parts shall be provided:
 - a. One complete set of V-belts for the air compressor.
 - b. One complete NaOH chemical metering pump.
- MANUFACTURER'S REPRESENTATIVE**
The services of a qualified representative of the various manufacturers shall be provided to inspect the installation of the equipment, make any necessary adjustments, place it in initial trouble-free operation, and instruct the operating personnel in its operation and maintenance.

GREELEY AND HANSEN
ENGINEERS
222 S. RIVERSIDE PLAZA
CHICAGO, ILLINOIS 60606

DESIGNED JRP DCH
DRAWN EAJ
CHECKED JRP

APPROVED

NO.	DATE	APP.	REVISION
1	JAN 1987	JRP	AS SHOWN

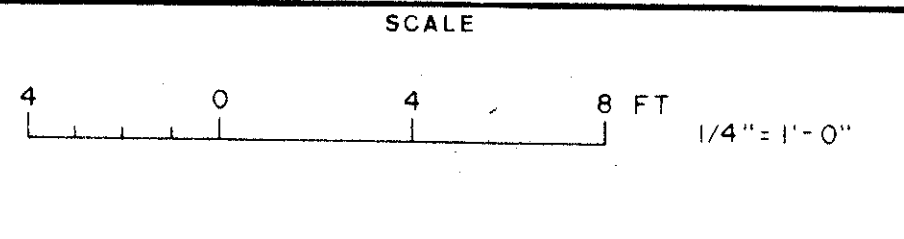

CITY OF TAMPA, FLORIDA
SEWAGE DISPOSAL SYSTEM
DIV. 4L-3 ODOR CONTROL EQUIPMENT
FOR THREE PUMPING STATIONS

SUPPLEMENTARY DRAWING NO. SD-3

PROJ. NO.	
SHEET	2 OF 2
DATE	JUNE 1986
REV.	1

304-25

CITY OF TAMPA

LOCATION MAP





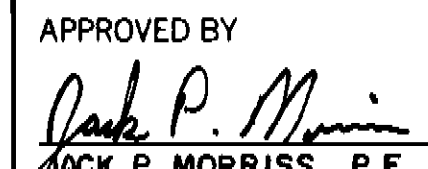
DEPARTMENT of SANITARY SEWERS

131st AVE. (UNIVERSITY)


PUMP STATION

WETWELL LINING

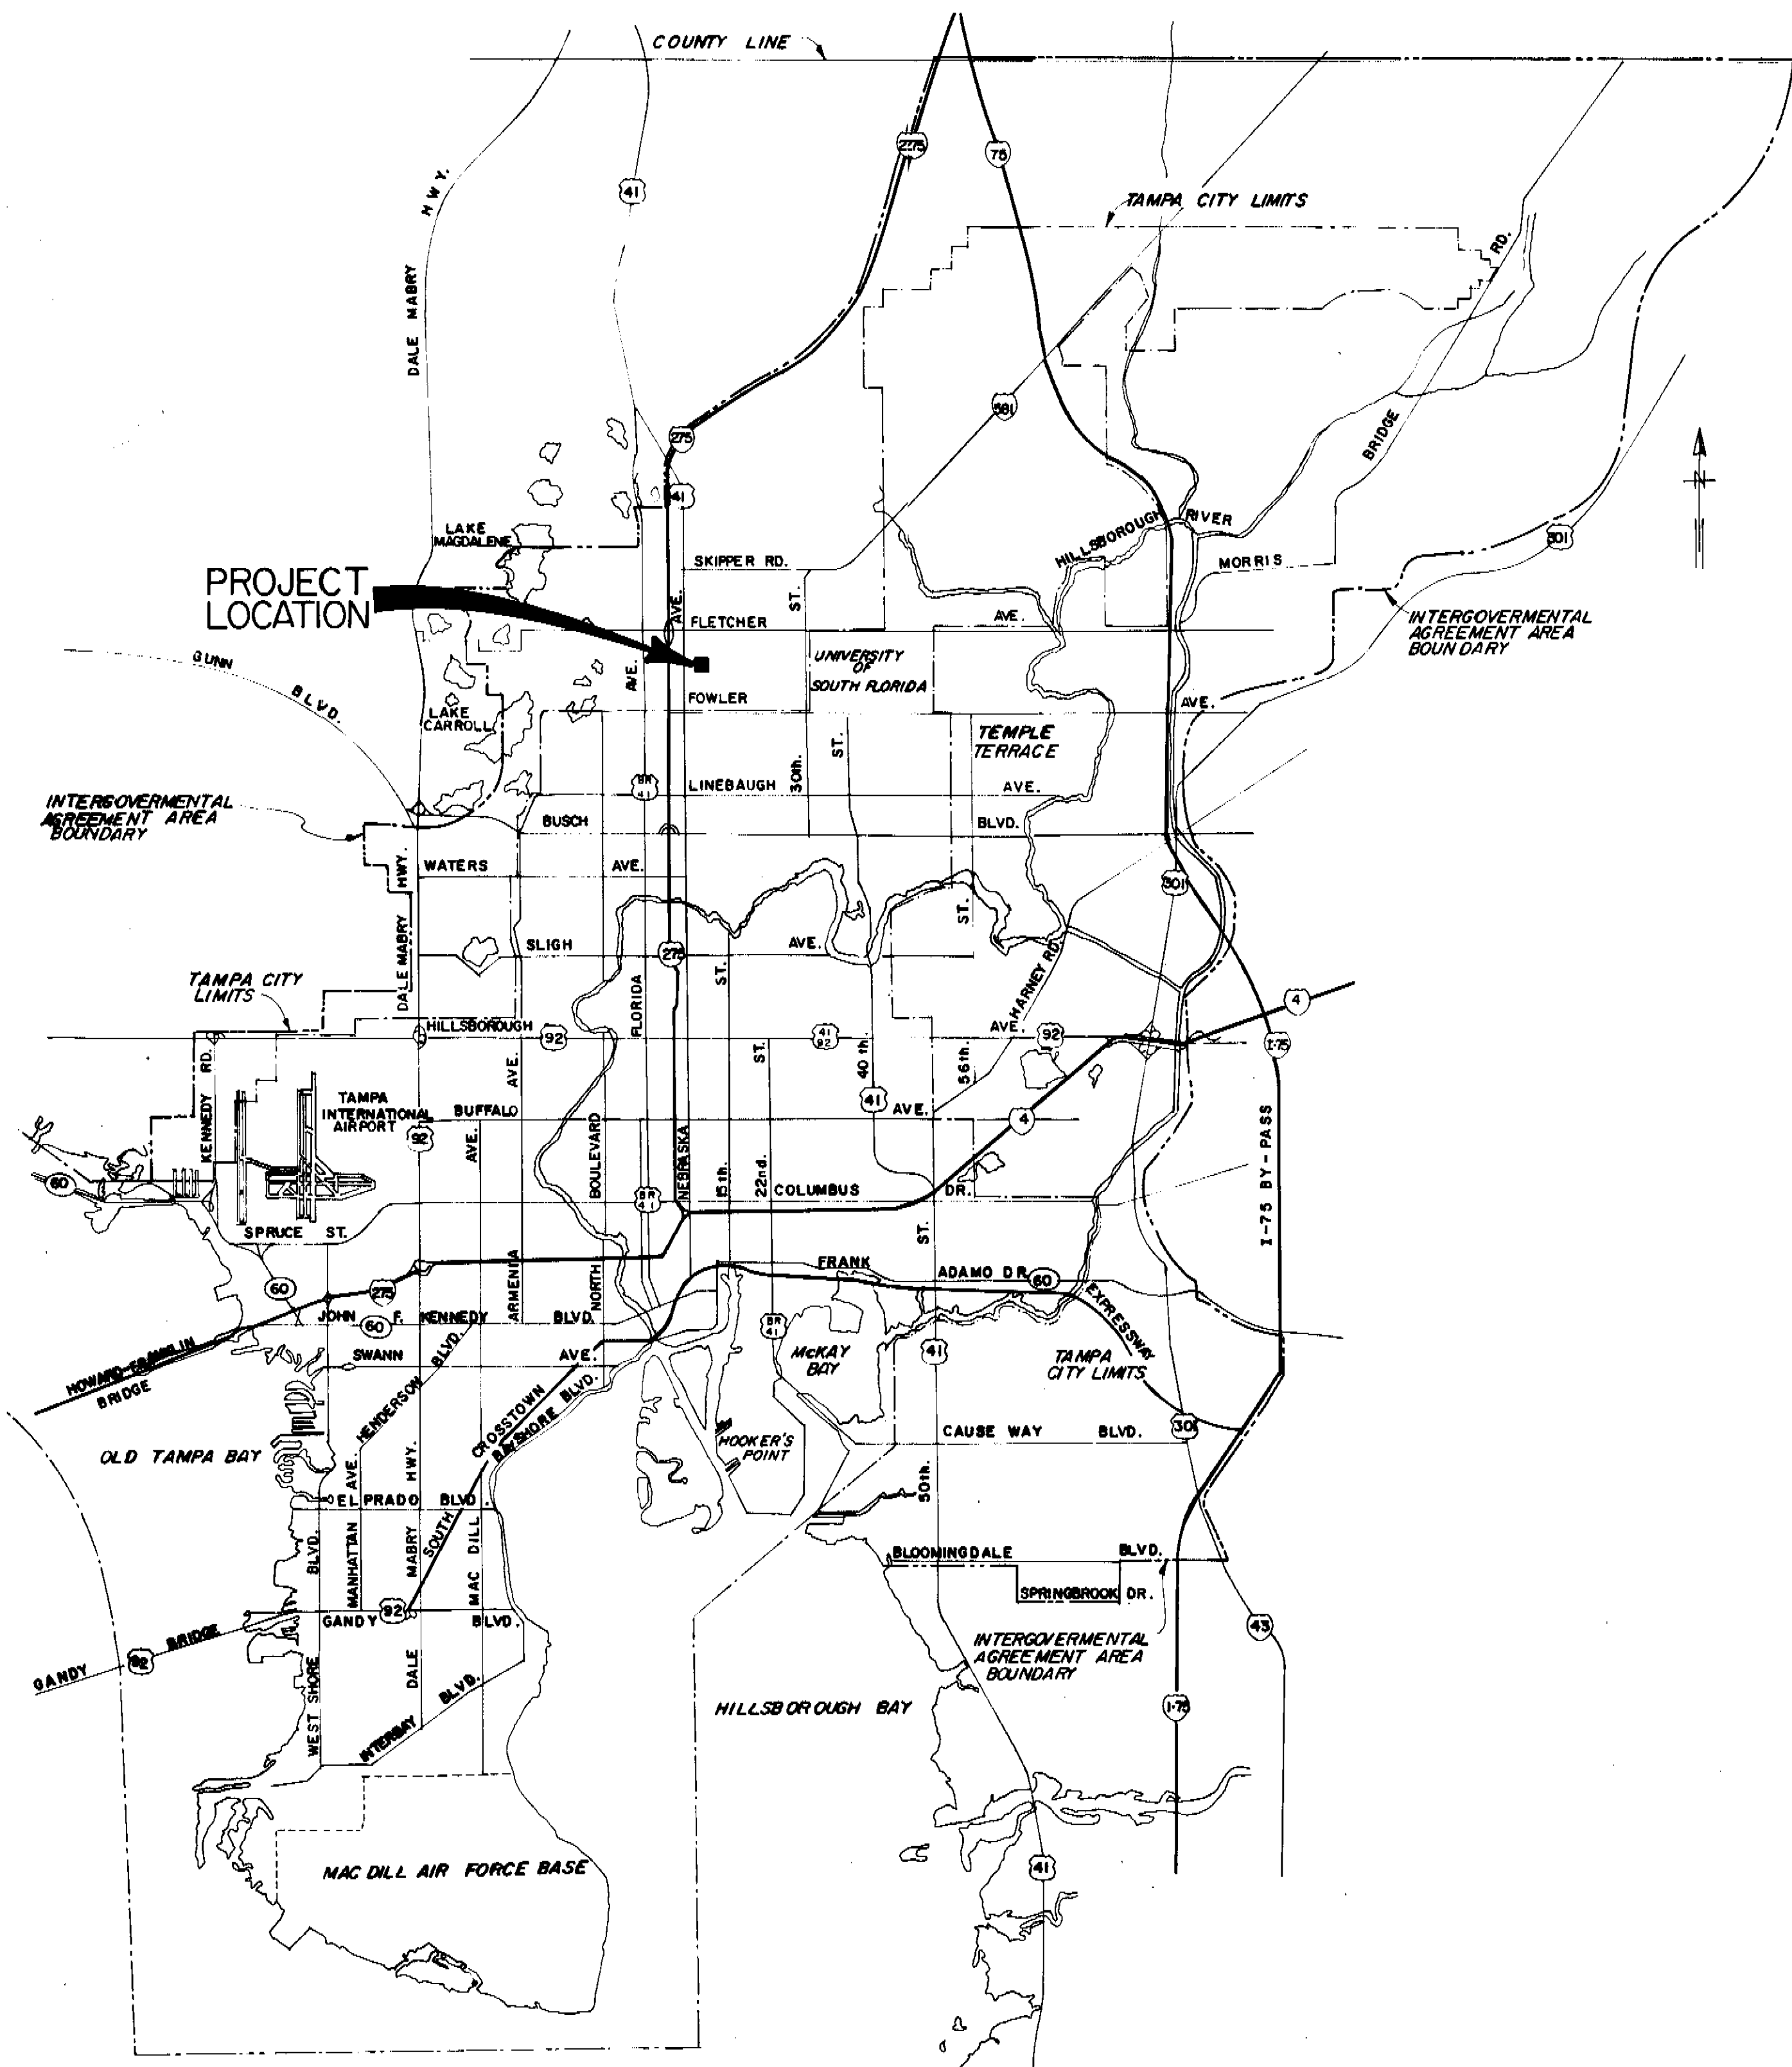

 ANDREW T. CRONBERG, P.E. # 32560 CHIEF ENGINEER DEPARTMENT OF SANITARY SEWERS	DES:	APPROVED BY	No. DATE REVISIONS 1 2 3 4 5	SCALE 1" = approximately 1/2 miles	DEPARTMENT of SANITARY SEWERS CITY of TAMPA, FLORIDA RENEWAL & REPLACEMENT	TITLE SHEET & LOCATION MAP	SHEET 1 OF 9
	DRN: E. R.						
	CKD: DW	JACK P. MORRIS, P.E. DIRECTOR					
	DATE: 7-13-87	DEPARTMENT OF SANITARY SEWERS					

K & E 19-1233

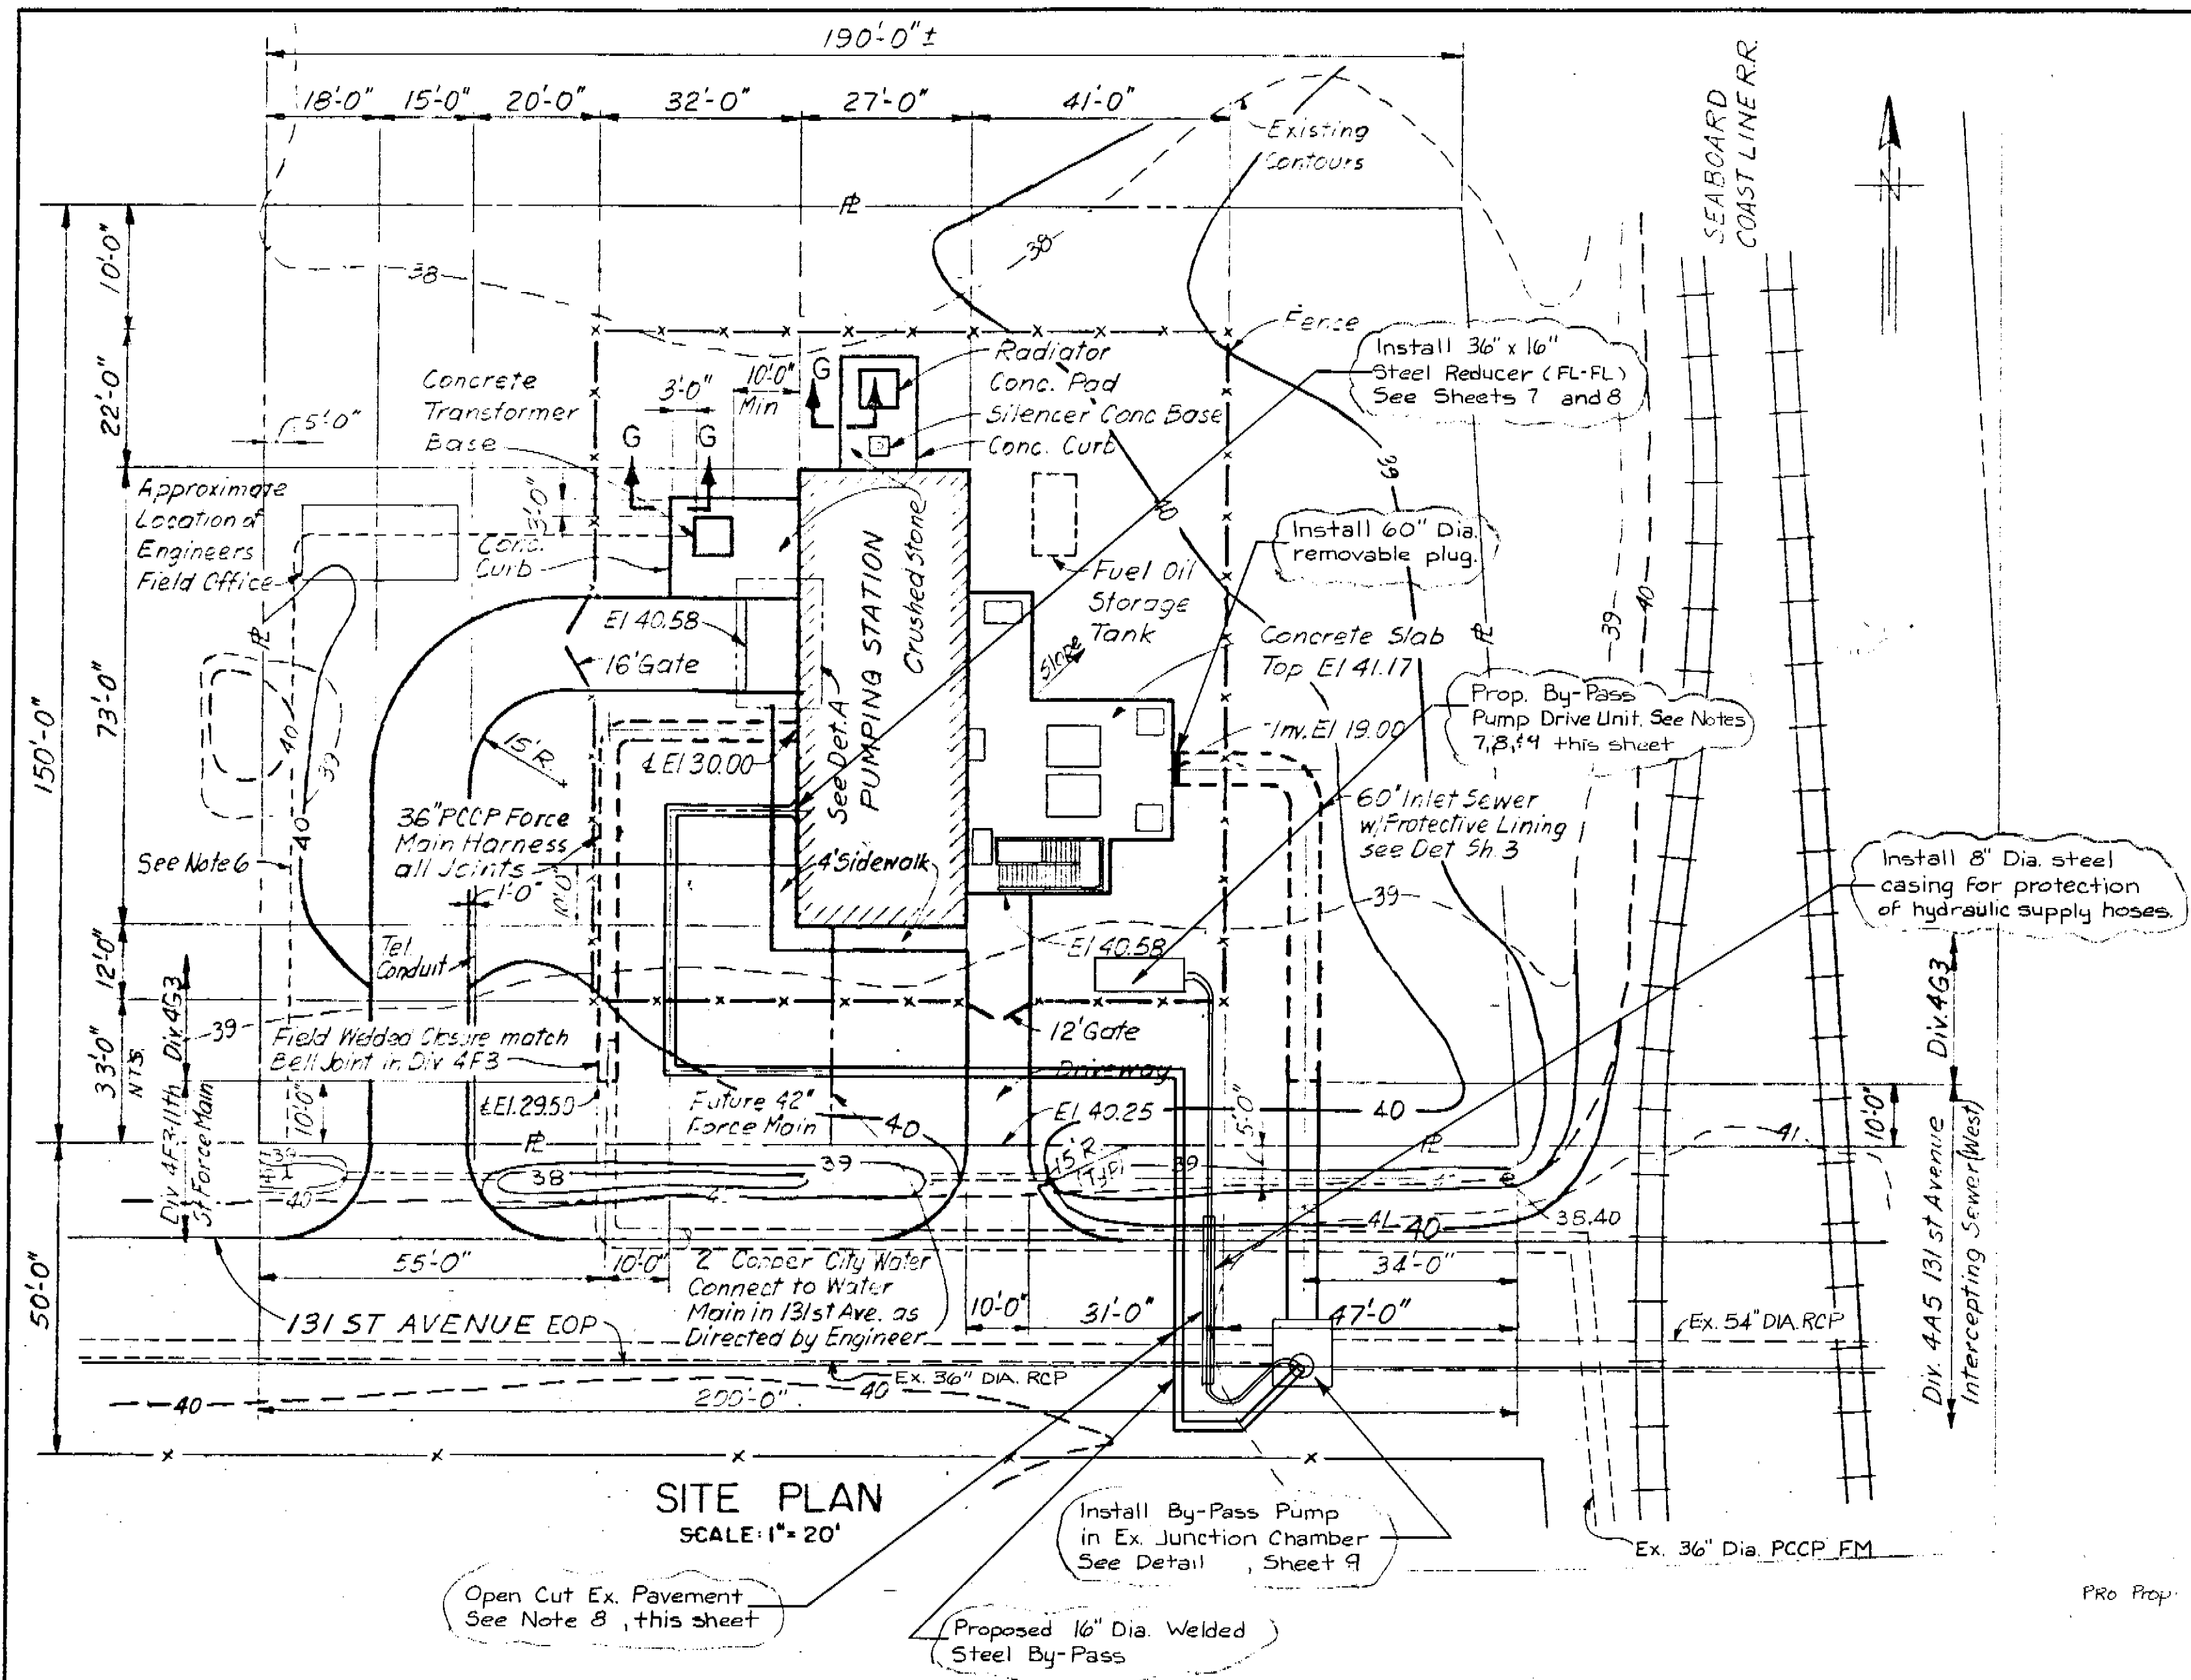


NOTES:


1. Proposed Liner shall be 3/32" thick "Amer-Plate" plain sheet liner as manufactured by Ameron or approved equal. Installation of liner shall be performed in strict conformance with manufactures instructions for "Installing Plain Sheet Amer-Plate" unless otherwise approved by the City of Tampa, Sanitary Sewer Design Division.
2. Type 316 Stainless Steel strips 1/4" x 1 1/2" shall be installed as shown on drawings for support of Amer-Plate Liner.
3. Mechanical Anchors shall be, type 316 Stainless Steel, 1/2" Dia. Hilti heavy duty expansion anchors model HSL-M8 or approved equal. Anchors shall be installed no greater than 18" o.c. and in strict conformance with manufactures specifications. If at any time the steel reinforcement of the Pump Station structure is hit during the installation of expansion anchors, the hole is to be filled with epoxy and the anchor location shifted to avoid the steel reinforcement. When installing anchors through existing aluminum angles or cast iron stop log channels insulating sleeves shall be used to prevent contact of dissimilar metals.
4. All Stainless Steel strips and anchor bolts shall be welded over with Amer-plate liner to prevent entry of water and gases.
5. Contractor will be responsible for proper preparation of concrete and metal surfaces prior to installation of Amer-Plate liner as recommended by liner manufacturer.
6. Lift gate grooves to be installed in existing channels shall be surface mounted type as manufactured by Warminster Fiberglass or approved equal. Contractor shall supply to the Sewer Department 5' Warminster Fiberglass lift gates or approved equal. Exact size of lift gate shall be determined at time of construction.
7. Contractor will be responsible for by-passing of sewage as necessary in order to install lining. Contractor may submit, for approval, alternate schemes of by-pass pumping other than that shown on plans. Average Daily Flow = 4.5 mgd @ 17.6 Ft. of Head Peak Flow = 8 mgd @ 22.7 Ft. of Head
8. Contractor must maintain traffic at all times. All pavement disturbed by construction shall be replaced with 12" limerock compacted to 98% modified proctor and 2" of Type 31 asphalt.
9. Contractor will be required to have a diesel powered back up pump on-site during by-pass pumping.

SITE PLAN
SCALE: 1" = 20'


DETAIL "A"

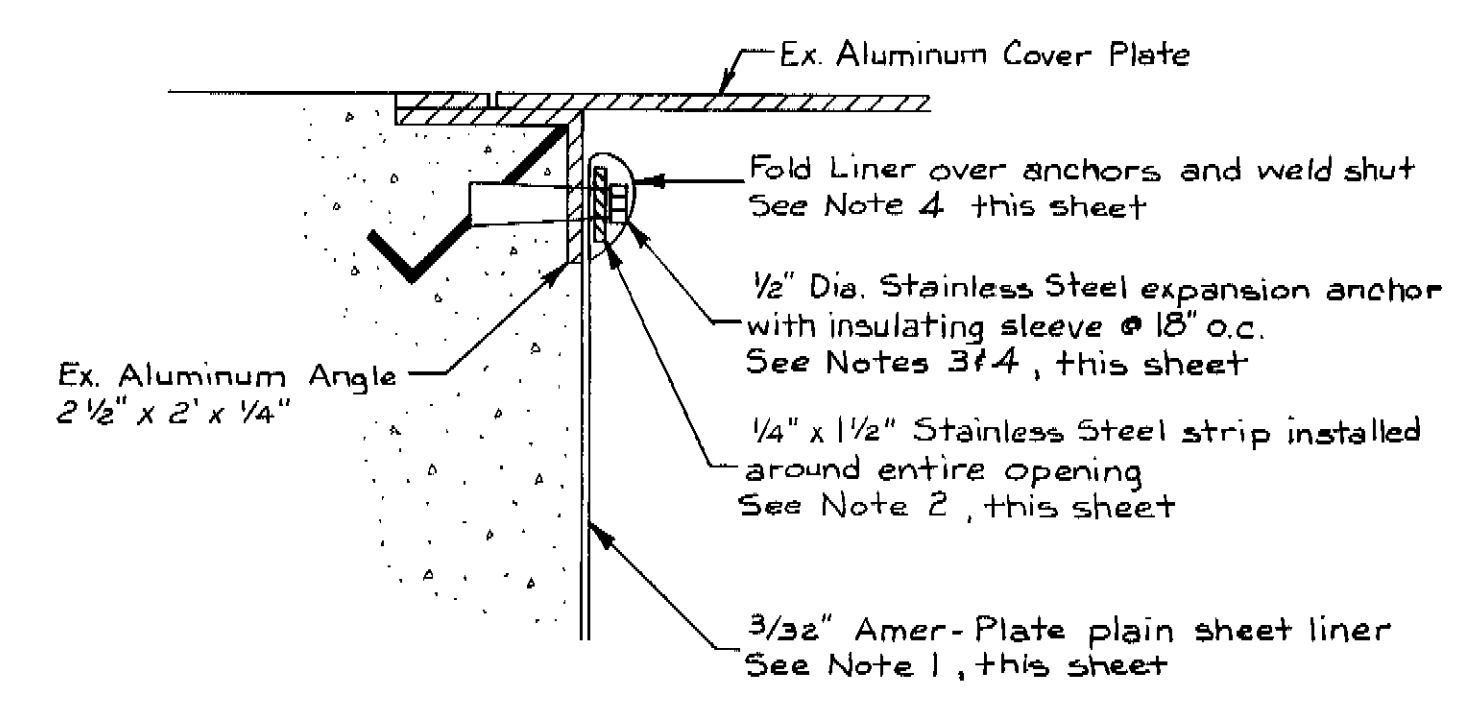


DETAIL "B"

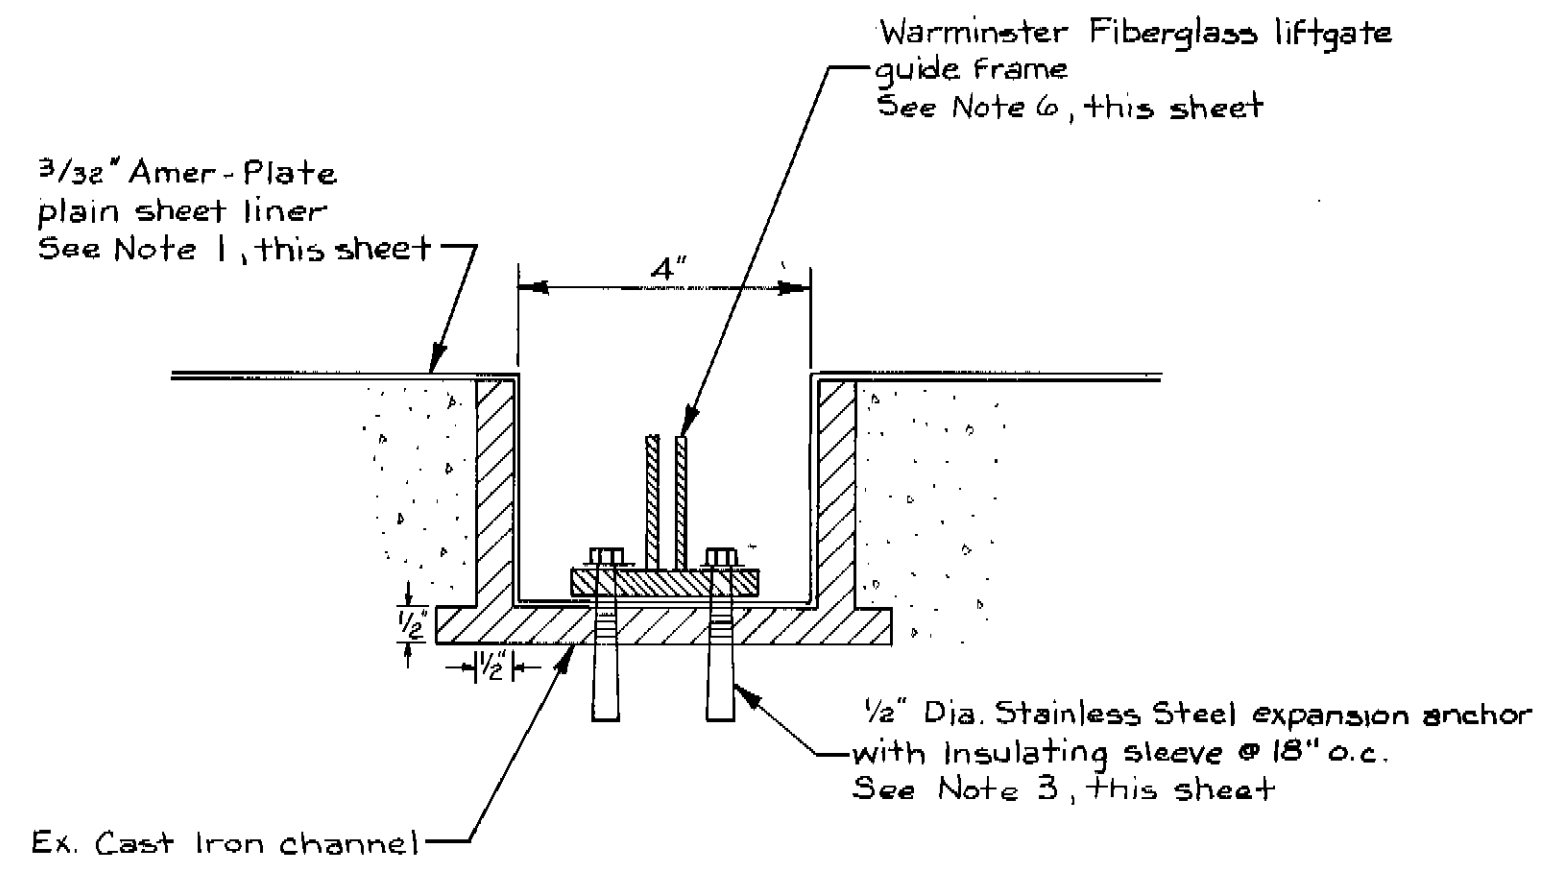

DETAIL "C"

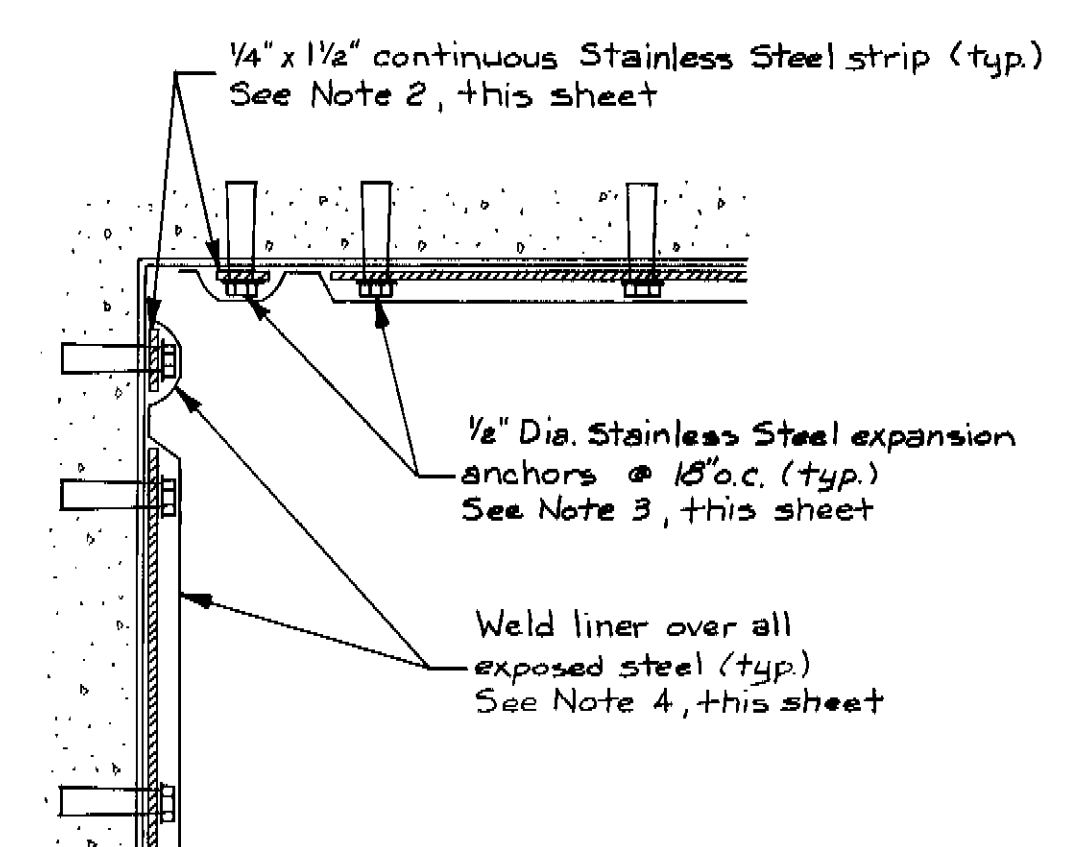


DETAIL "D"

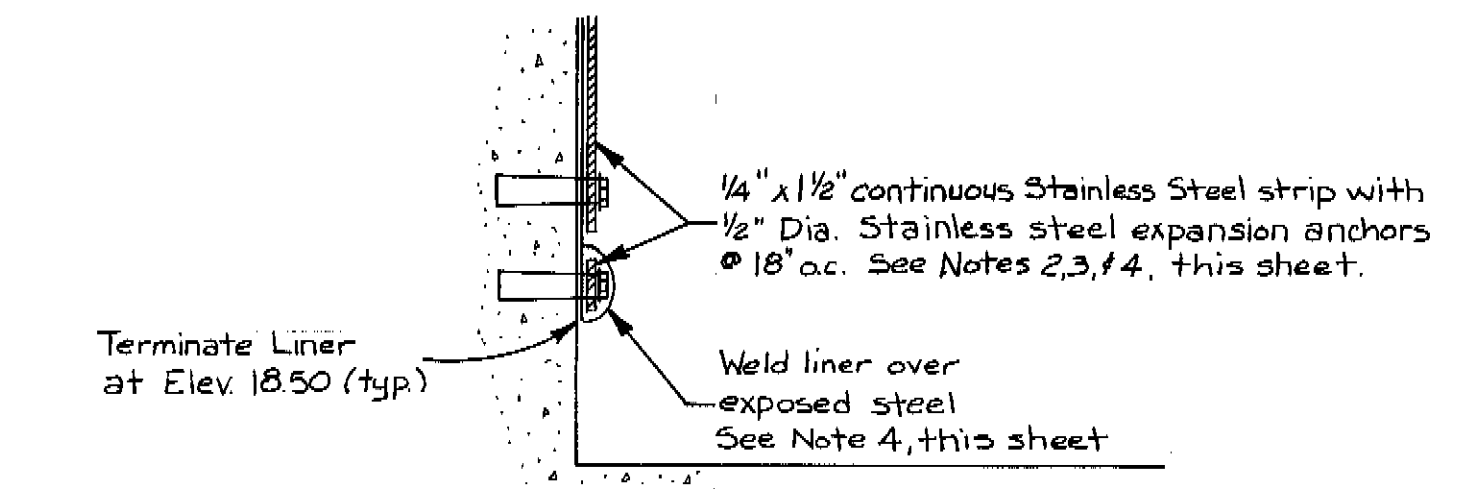

DESIGNED BY:
Andrew T. Cronberg
ANDREW T. CRONBERG, P.E. #32560
CHIEF ENGINEER

DRN:
CKD: DW


APPROVED BY:
Jack P. Morris
JACK P. MORRIS, P.E.
DIRECTOR

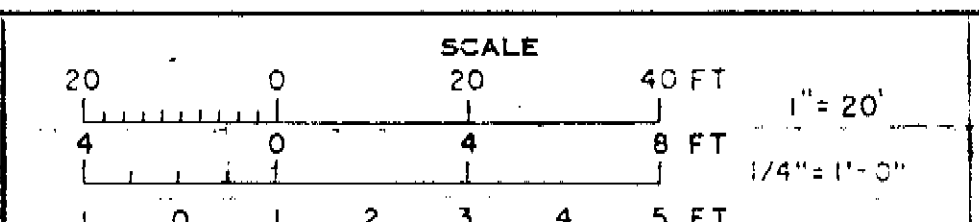

CITY OF TAMPA, FLORIDA
SEWAGE DISPOSAL SYSTEM
DIVISION 463
131ST AVENUE PUMPING STATION

EQUIPMENT
SITE PLAN
TOP FLOOR PLAN

PROJ. NO. S 202-70-300-7-463
SHEET 2 OF 9

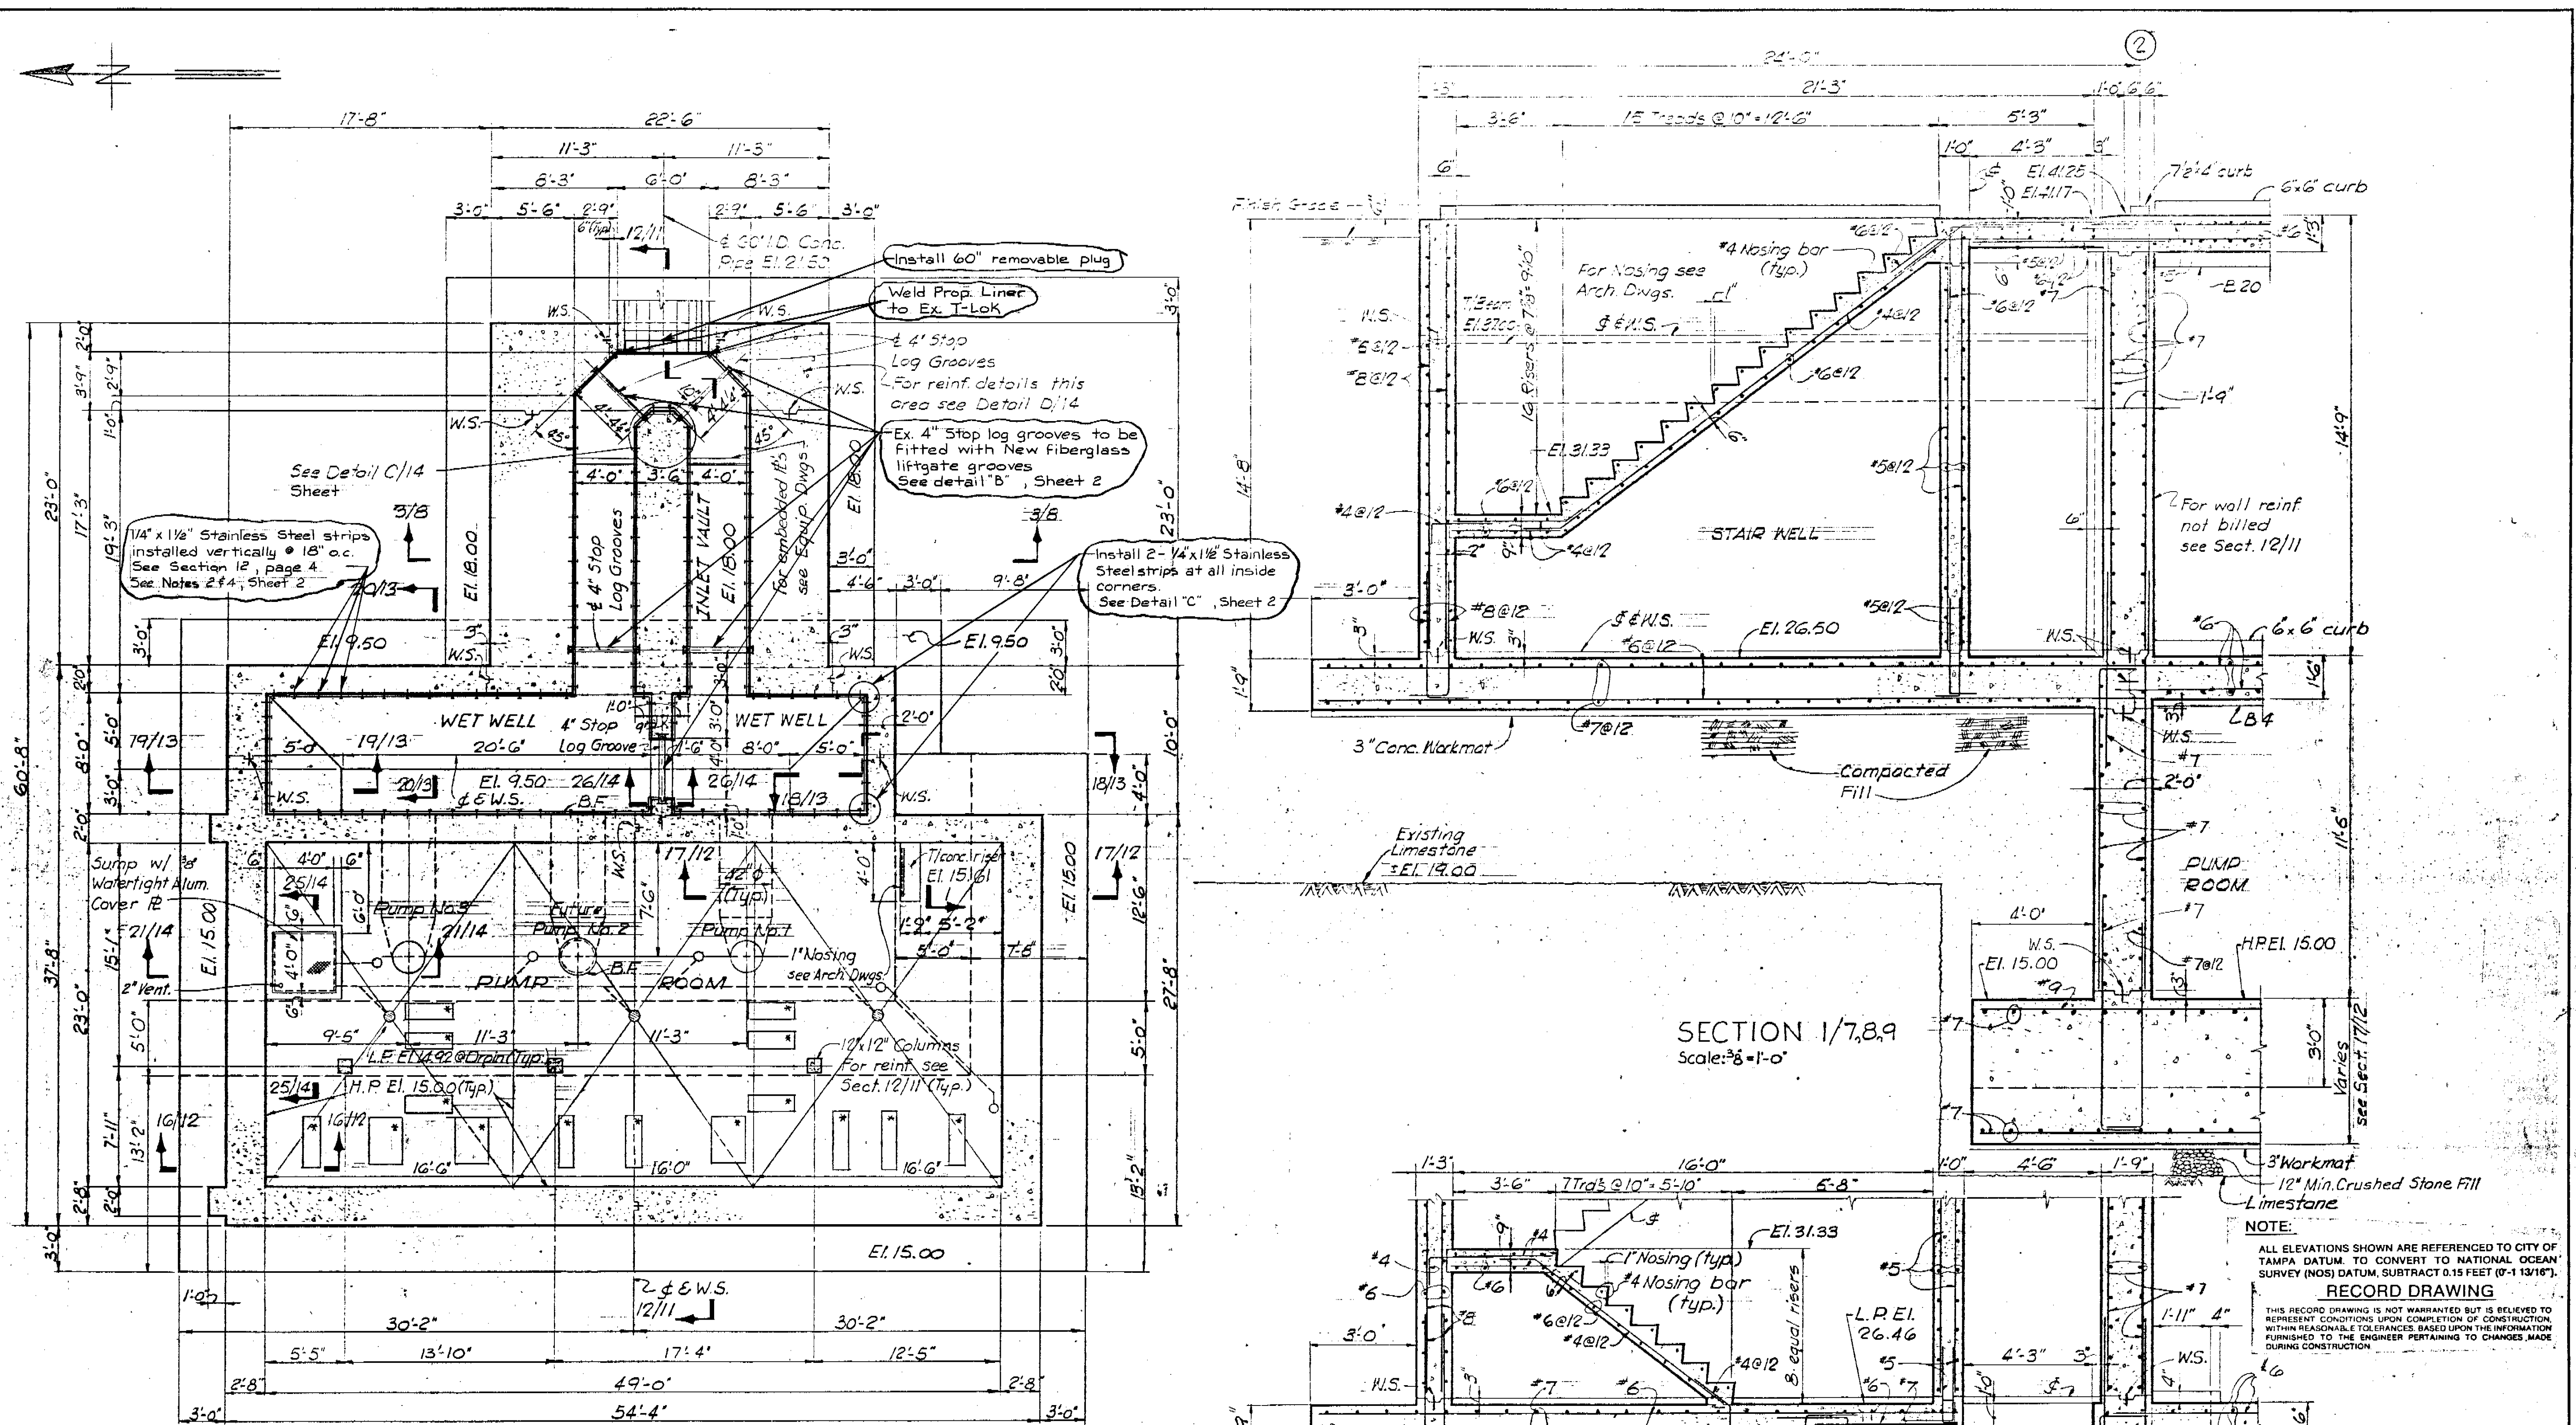

* Size and location of equipment pods and dimensions shown thus (*) to be determined after selection of equipment. See also Equipment Dwg.

SECTIONAL PLAN AT EL. 22.00
Scale: 3/8" = 1'-0"


- NOTES:
- The Substructure is stable against hydrostatic uplift with floor at El. 4.25 in place with ground water at grade.
 - See AD 3-1 for location of foundation draft holes.

NOTE:
ALL ELEVATIONS SHOWN ARE REFERENCED TO CITY OF TAMPA DATUM. TO CONVERT TO NATIONAL OCEAN SURVEY (NOS) DATUM, SUBTRACT 0.15 FEET (0'-1 1/16").

RECORD DRAWING

THIS RECORD DRAWING IS NOT WARRANTED BUT IS BELIEVED TO REPRESENT CONDITIONS UPON COMPLETION OF CONSTRUCTION WITHIN REASONABLE TOLERANCES BASED UPON THE INFORMATION FURNISHED TO THE ENGINEER PERTAINING TO CHANGES MADE DURING CONSTRUCTION.

- NOTES:
- For General Notes and Typical Details see Sh. 15 & 16
- For Beam Schedule see Sh. 9
- For Curb Details see Arch. Dwg.

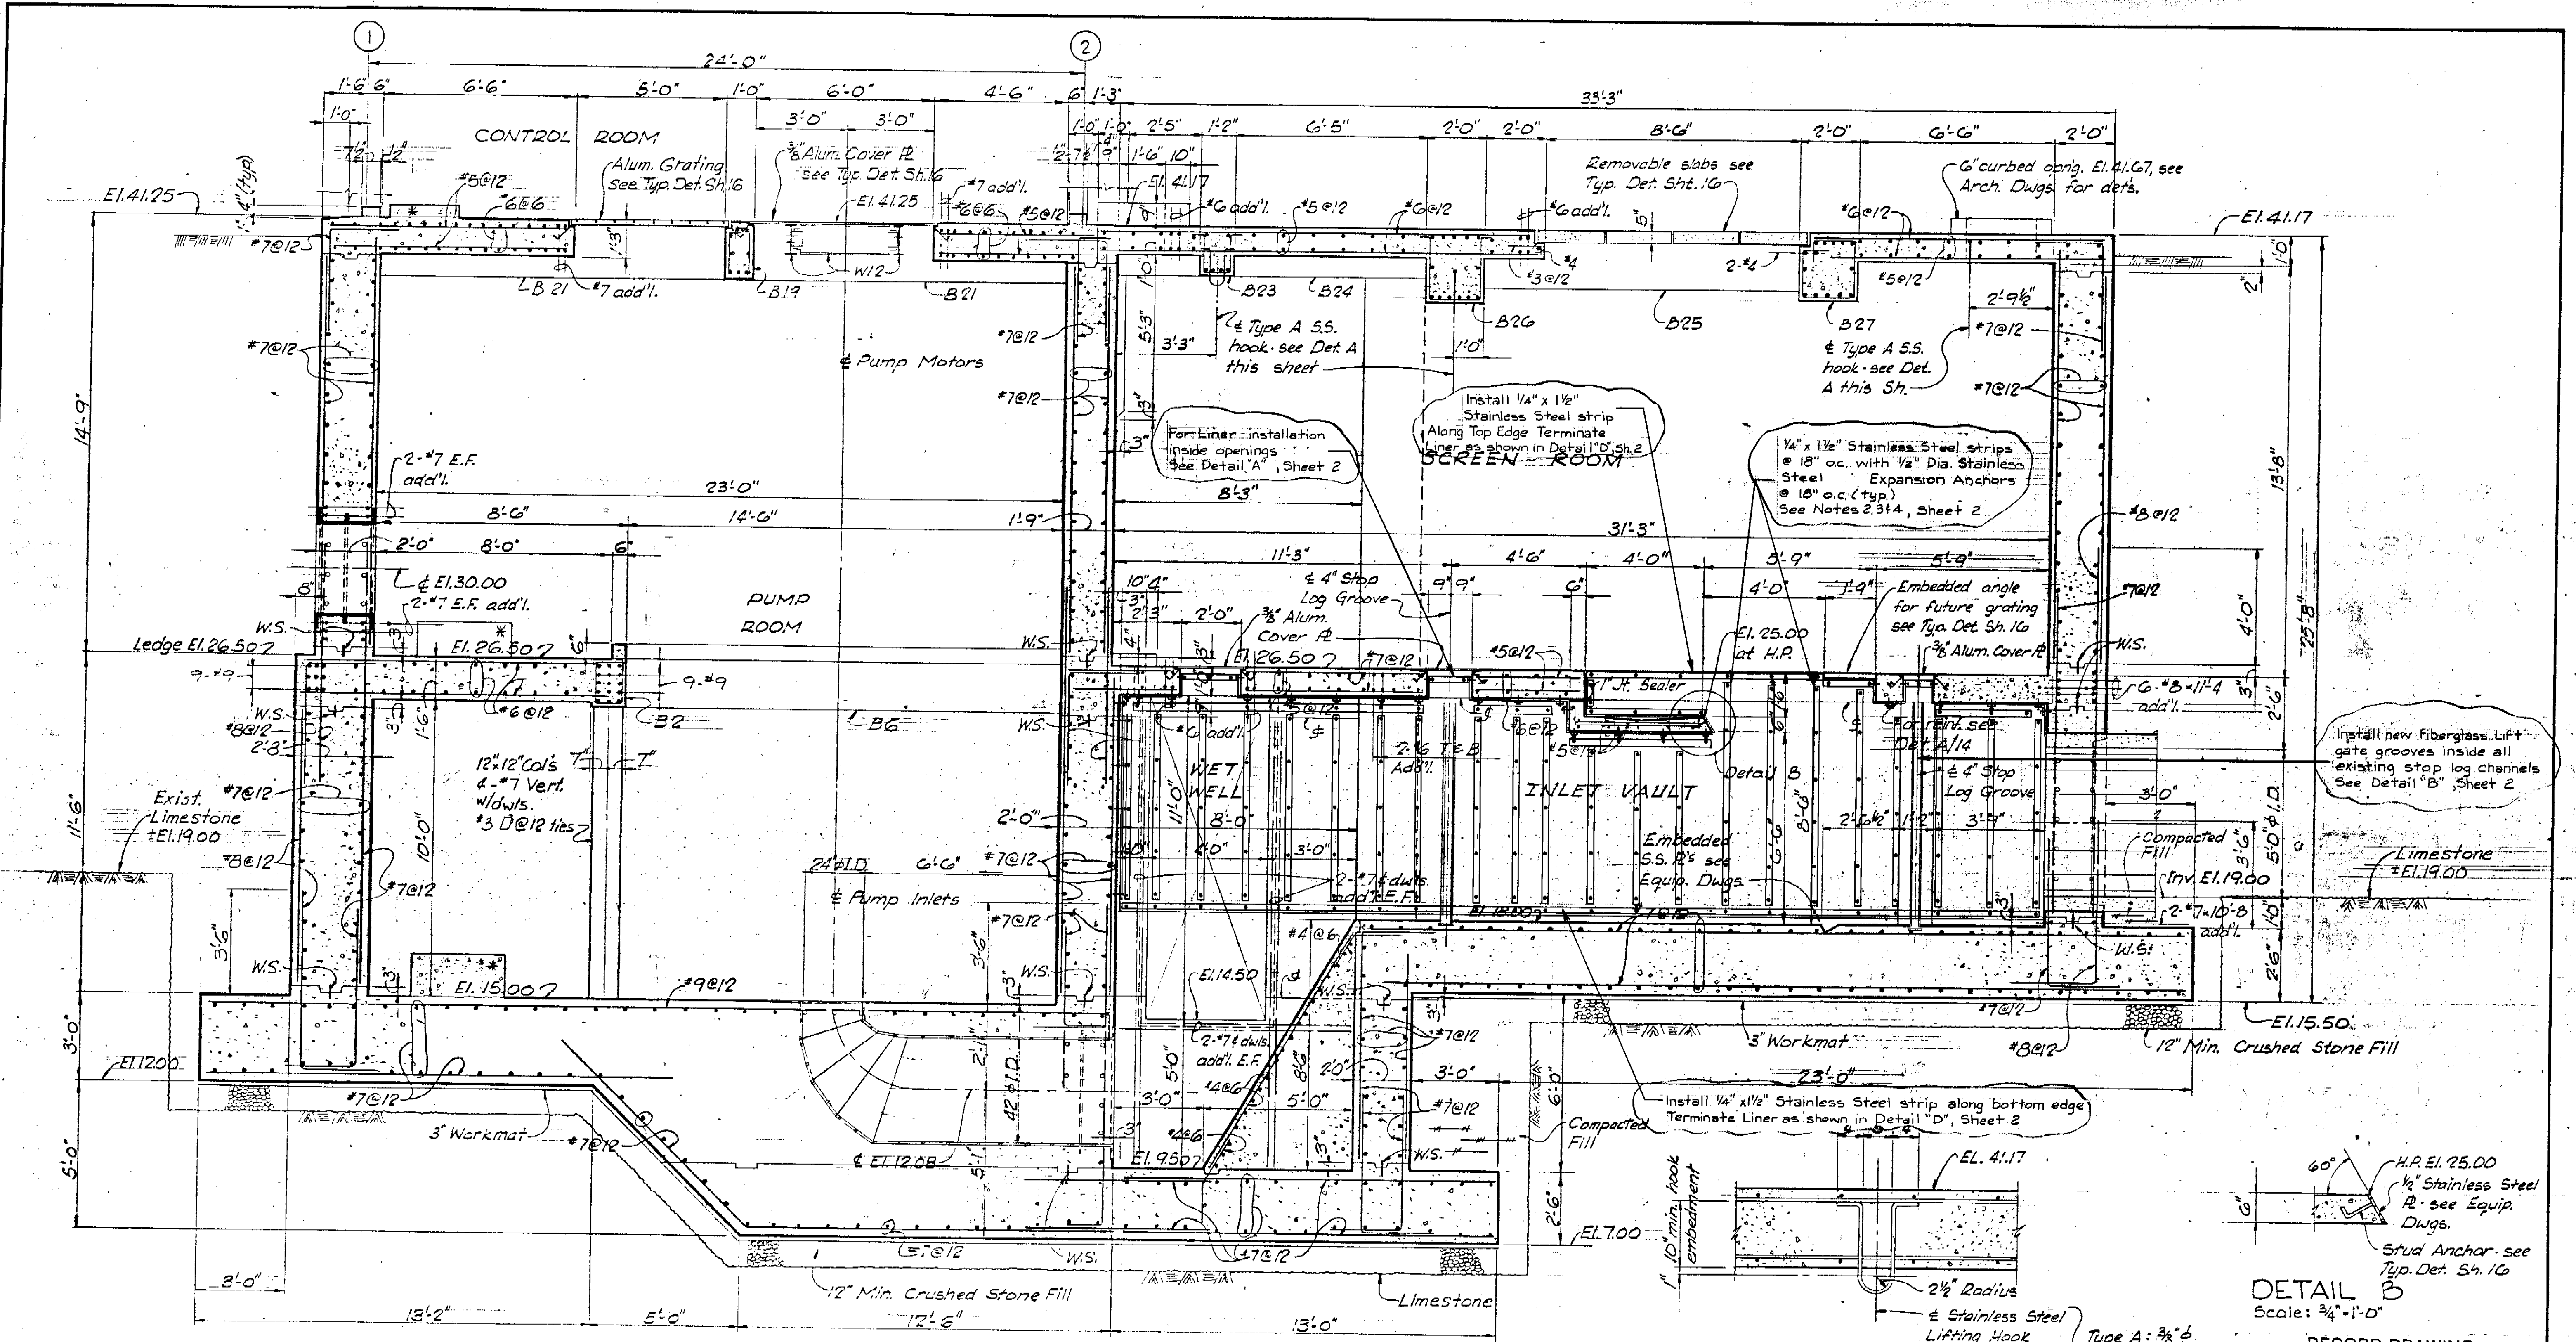

SECTION 12/78,9
Scale: 3/8"=1'-0"

DETAIL A/9
Scale: 1"=1'-0"

DETAIL B
Scale: 3/4"=1'-0"

RECORD DRAWING
THIS RECORD DRAWING IS NOT WARRANTED BUT IS BELIEVED TO REPRESENT CONDITIONS UPON COMPLETION OF CONSTRUCTION WITHIN REASONABLE TOLERANCES BASED UPON THE INFORMATION FURNISHED TO THE ENGINEER PERTAINING TO CHANGES MADE DURING CONSTRUCTION.

NOTE:
ALL ELEVATIONS SHOWN ARE REFERENCED TO CITY OF TAMPA DATUM TO CONVERT TO NATIONAL OCEAN SURVEY (NOS) DATUM, SUBTRACT 0.15 FEET (0-1 13/16").


* Size and location of equipment pads and dimensions shown thus (*) to be determined after selection of equipment.

NOTES:
For General Notes and Typical Details see Sh. 15 & 16
For Beam Schedule see Sh. 9

These record drawings are used for identifying those areas of the Wet Well to be lined.

Andrew T. Cronberg, P.E. #32560
CHIEF ENGINEER
DEPARTMENT OF SANITARY SEWERS

APPROVED BY:
Jack P. Morris, P.E.
DIRECTOR
DEPARTMENT OF SANITARY SEWERS

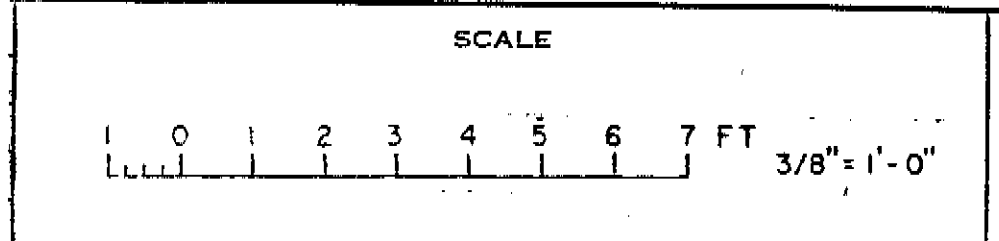


CITY OF TAMPA, FLORIDA
SEWAGE DISPOSAL SYSTEM
DIVISION 4G3
131 ST. AVENUE PUMPING STATION

STRUCTURAL SECTION

PROJ. NO. S202-70-30D-7-463
SHEET 4 OF 9
DATE AUGUST, 1972 REV. 0

173-48A

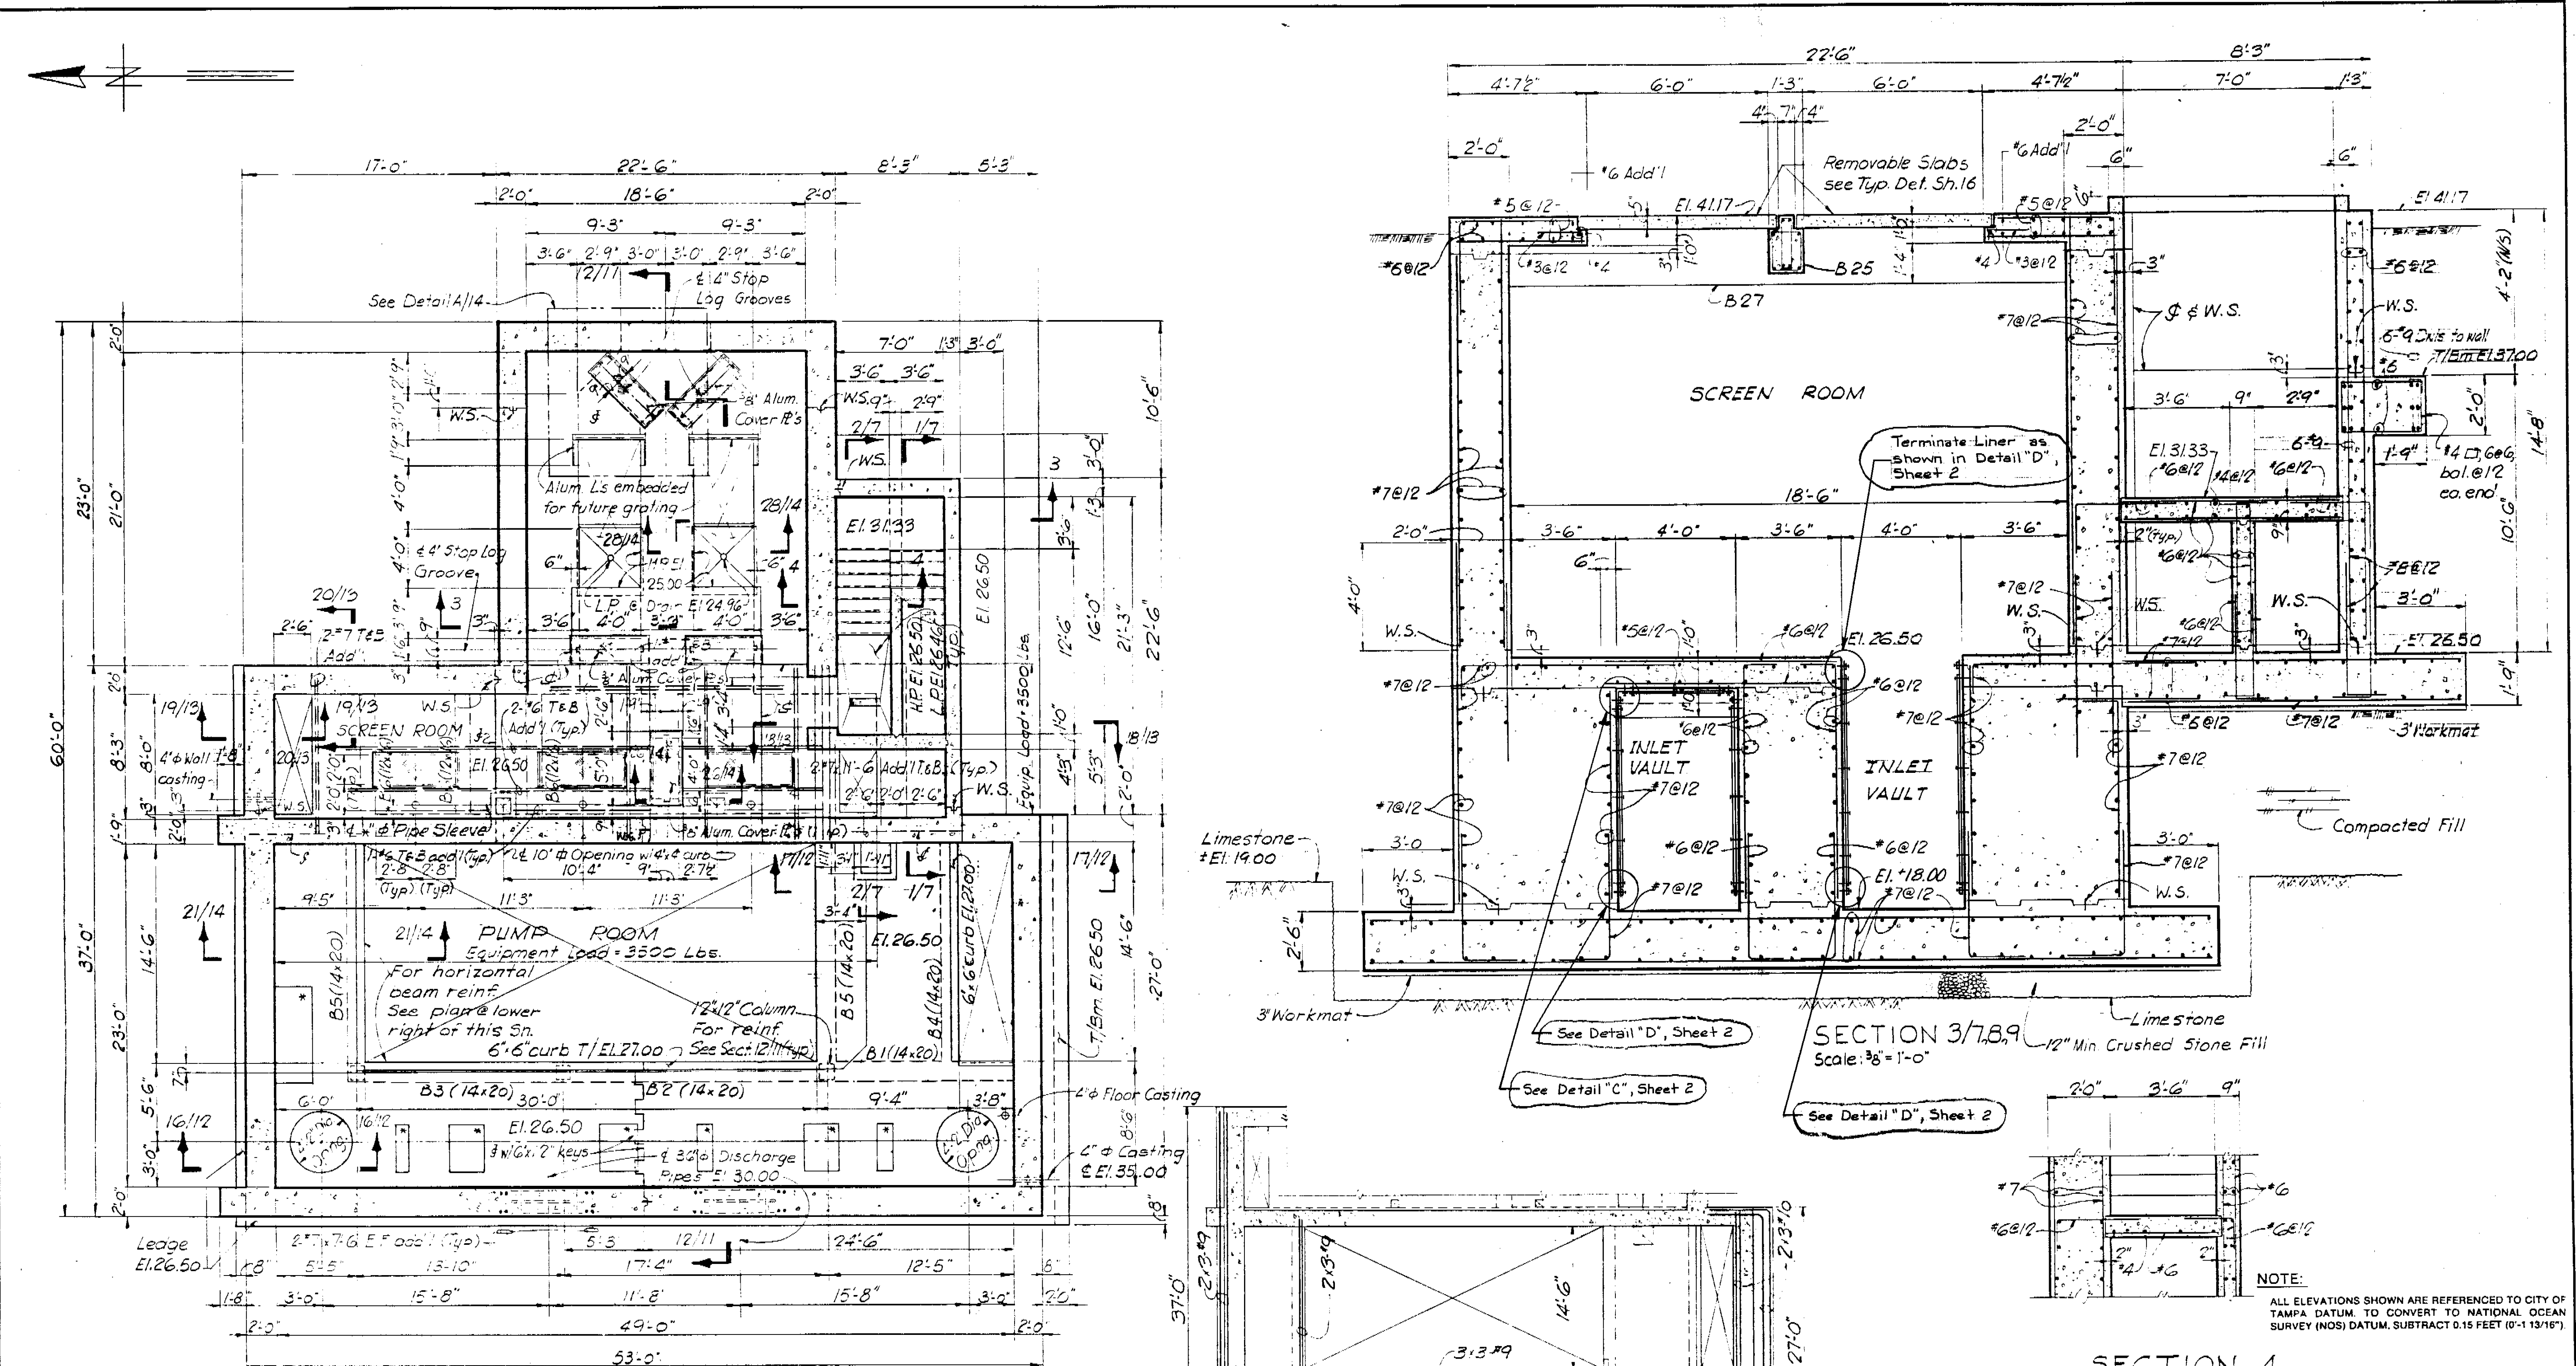

Live Load = 150 P.S.F. unless otherwise shown
SECTIONAL PLAN AT EL. 34.00
 Scale: 3/8" = 1'-0"
 T/ conc. El. 26.50 unless shown or noted
 † denotes Construction Joint
 * Size and location of equipment pads and dimensions shown thus (x) to be determined after selection of equipment. See also Equip. Dwg's

SECTION 3/7,8,9
 Scale: 3/8" = 1'-0"
 Limestone
 12" Min Crushed Stone Fill

SECTION 4
 Scale: 3/8" = 1'-0"

NOTE:
 ALL ELEVATIONS SHOWN ARE REFERENCED TO CITY OF TAMPA DATUM TO CONVERT TO NATIONAL OCEAN SURVEY (NOS) DATUM, SUBTRACT 0.15 FEET (0-1 13/16")

NOTES:
 For General Notes and Typical Details see Sheets 15 & 16
 For Beam Schedule see Sh. 9
 For Curb Details see Arch. Dwg's.

RECORD DRAWING


THIS RECORD DRAWING IS NOT WARRANTED BUT IS BELIEVED TO REPRESENT CONDITIONS UPON COMPLETION OF CONSTRUCTION WITHIN REASONABLE TOLERANCES BASED UPON THE INFORMATION FURNISHED TO THE ENGINEER PERTAINING TO CHANGES MADE DURING CONSTRUCTION.

HORIZONTAL BEAM REINFORCEMENT AT EL. 26.50
 No Scale

These record drawings are used for identifying those areas of the Wet Well to be lined.

APPROVED BY:
 Andrew T. Cronberg, P.E. #32460
 Chief Engineer
 Department of Sanitary Sewers

Jack P. Morris, P.E.
 Director
 Department of Sanitary Sewers

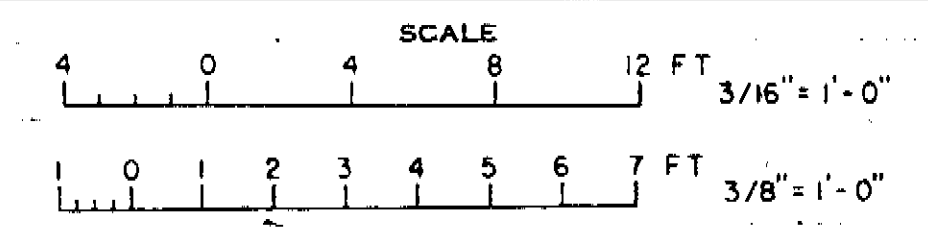


CITY OF TAMPA, FLORIDA
 SEWAGE DISPOSAL SYSTEM
 DIVISION 4G3
 131 ST. AVENUE PUMPING STATION

STRUCTURAL INTERMEDIATE FLOOR PLAN SECTIONS

PROJ. NO. S202-70-30D-7-4G3
 SHEET 5 OF 9
 DATE AUGUST, 1972 REV. 0

173-45A

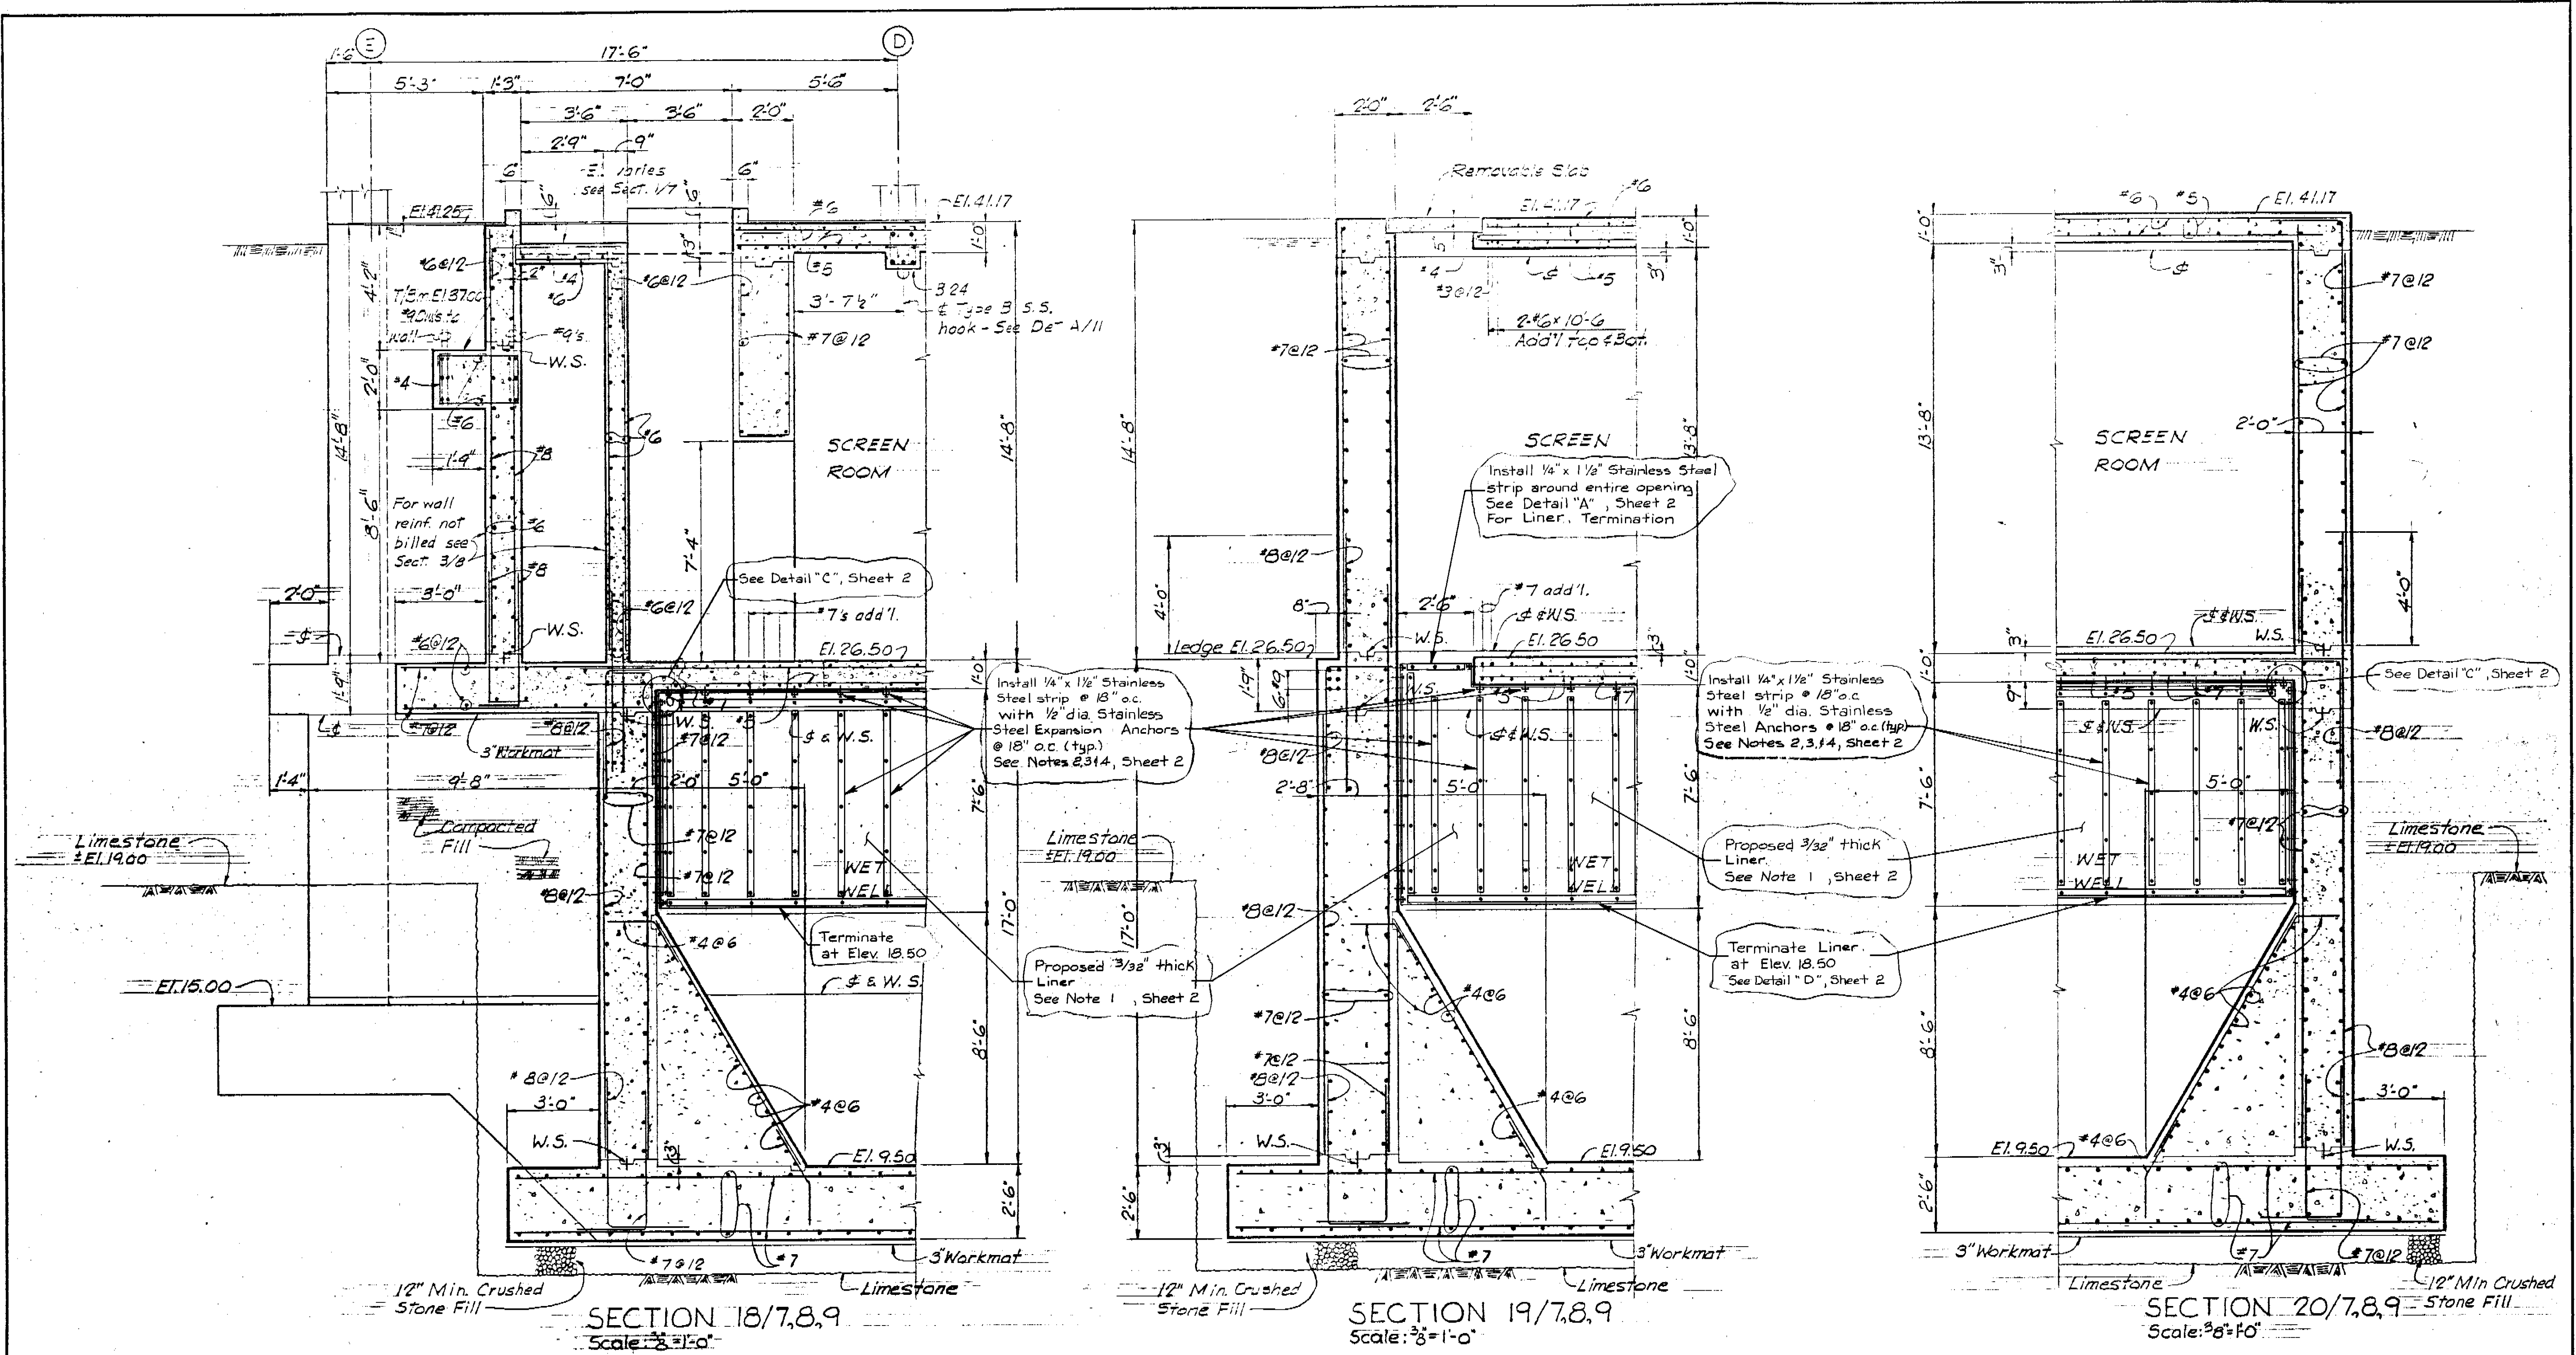

NOTE:
ALL ELEVATIONS SHOWN ARE REFERENCED TO CITY OF TAMPA DATUM. TO CONVERT TO NATIONAL OCEAN SURVEY (NOS) DATUM, SUBTRACT 0.15 FEET (0-1-13/16").


NOTE:
For General Notes and Typical Details see Sheets 15 & 16
For Beam Schedule see Sh. 9

RECORD DRAWING
THIS RECORD DRAWING IS NOT WARRANTED BUT IS BELIEVED TO REPRESENT CONDITIONS UPON COMPLETION OF CONSTRUCTION WITHIN REASONABLE TOLERANCES BASED UPON THE INFORMATION FURNISHED TO THE ENGINEER PERTAINING TO CHANGES MADE DURING CONSTRUCTION.

These record drawings are used for identifying those areas of the Wet Well to be lined.

APPROVED BY:
Andrew T. Cronberg
ANDREW T. CRONBERG, P.E. #32540
CHIEF ENGINEER
DEPARTMENT OF SANITARY SEWERS

APPROVED BY:
Jack P. Morriss
JACK P. MORRISS, P.E.
DIRECTOR
DEPARTMENT OF SANITARY SEWERS

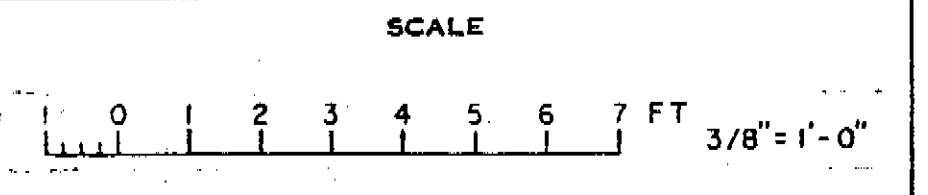


CITY OF TAMPA, FLORIDA
SEWAGE DISPOSAL SYSTEM
DIVISION 4G3
131 ST. AVENUE PUMPING STATION


STRUCTURAL SECTIONS

PROJ. NO. S 202-70-300-7-463
SHEET 6 OF 9
DATE AUGUST, 1972 REV. 0

173-50

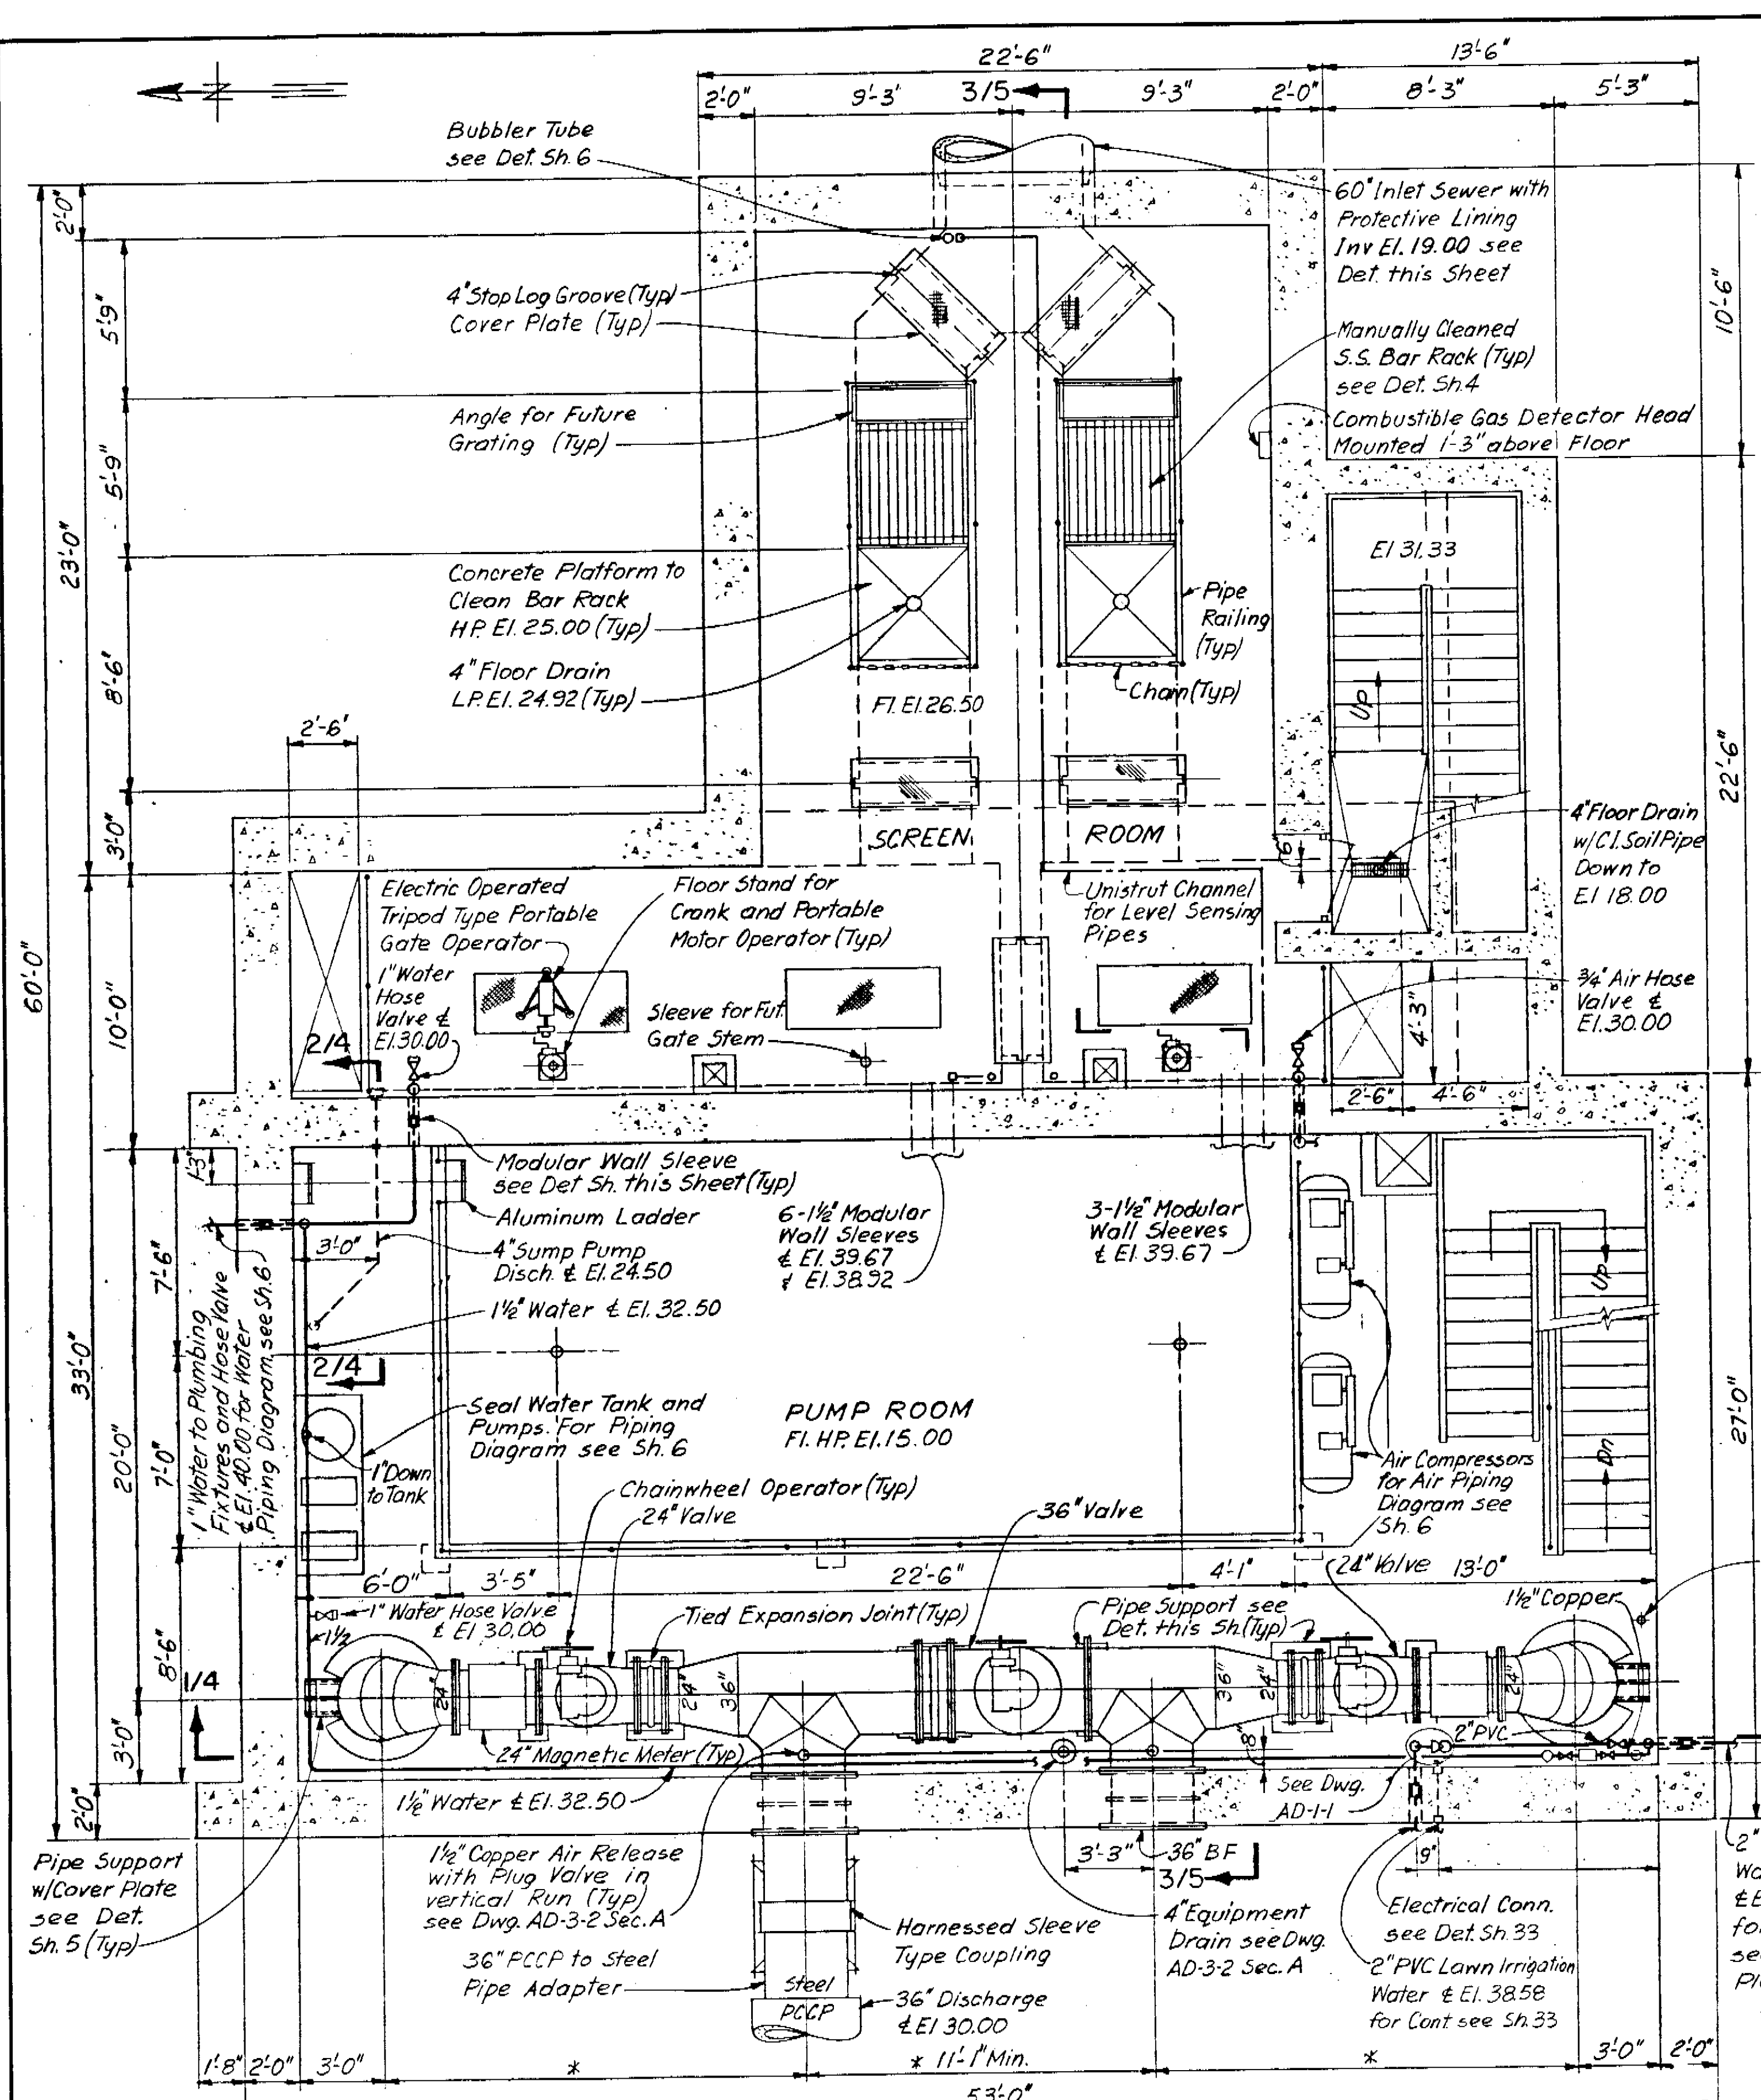

PLAN AT EL. 26.50
SCALE: 1/4" = 1'-0"

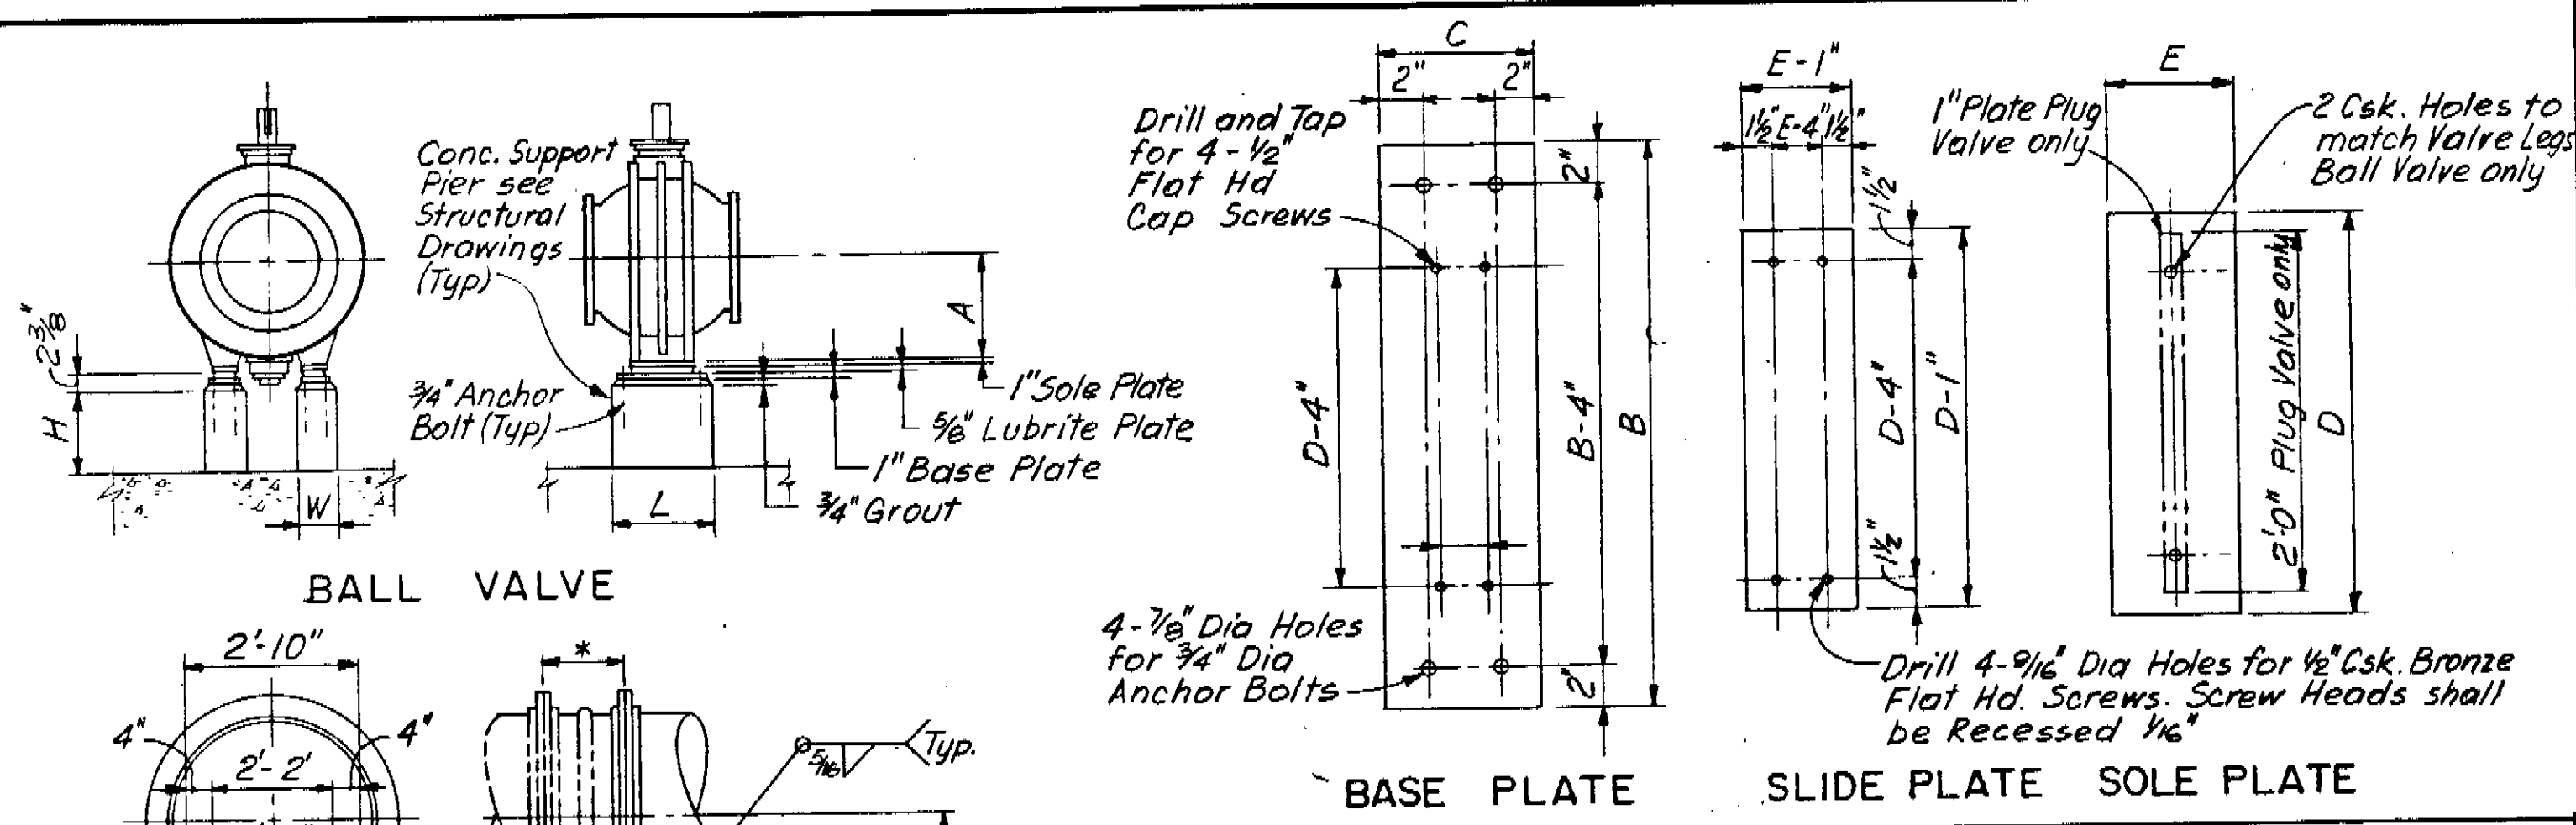


BALL VALVE SUPPORT DIMENSIONS

Valve Size	±EI	Floor EI	Location	A	B	C	D	E	W	W ₁	L	H
24"	30.00	26.50	Top Disch. Header	2'-0 1/2"	1'-4 1/2"	7 1/2"	1'-2 1/2"	5 1/2"	1'-0"	-	2'-2 1/2"	1'-2 1/2"
30"	18.50	15.00	Low Disch. Hdr. Pumps	2'-5 3/4"	2'-1 1/8"	7 1/2"	1'-7 3/4"	6 1/2"	1'-0"	-	2'-5 1/2"	8 1/2"
36"	30.00	26.50	Top Disch. Header	2'-10 3/4"	2'-5 3/4"	7 1/2"	1'-7 3/4"	6 1/2"	1'-0"	-	2'-7 3/4"	3 1/2"

PLUG VALVE AND EXP. JOINT SUPPORT DIMENSIONS

Valve Size	±EI	Floor EI	Location	A	B	C	D	E	W	W ₁	L	H
24"	30.00	26.50	Top Disch. Header	1'-6"	2'-10"	10"	2'-2"	10"	1'-2"	*	3'-2"	1'-8 1/2"
30"	18.50	15.00	Low Disch. Hdr. Pumps	1'-9 3/8"	2'-10"	10"	2'-2"	10"	1'-2"	*	3'-2"	1'-5 1/4"
36"	18.50	15.00	Low Disch. Hdr. Pumps	2'-1"	2'-10"	10"	2'-2"	10"	-	*	3'-2"	1'-1 1/2"
36"	30.00	26.50	Top Disch. Header	2'-1"	2'-10"	10"	2'-2"	10"	1'-2"	*	3'-2"	1'-1 1/2"

NOTES: 1. * Dimensions shall be determined after Final Selection of Equipment.
2. Plug Valves, Ball Valves or Cone Valves may be used. Ball Valves shall have Single Seats unless shown otherwise.
3. For Cone Valve Support Details see Sh. 5

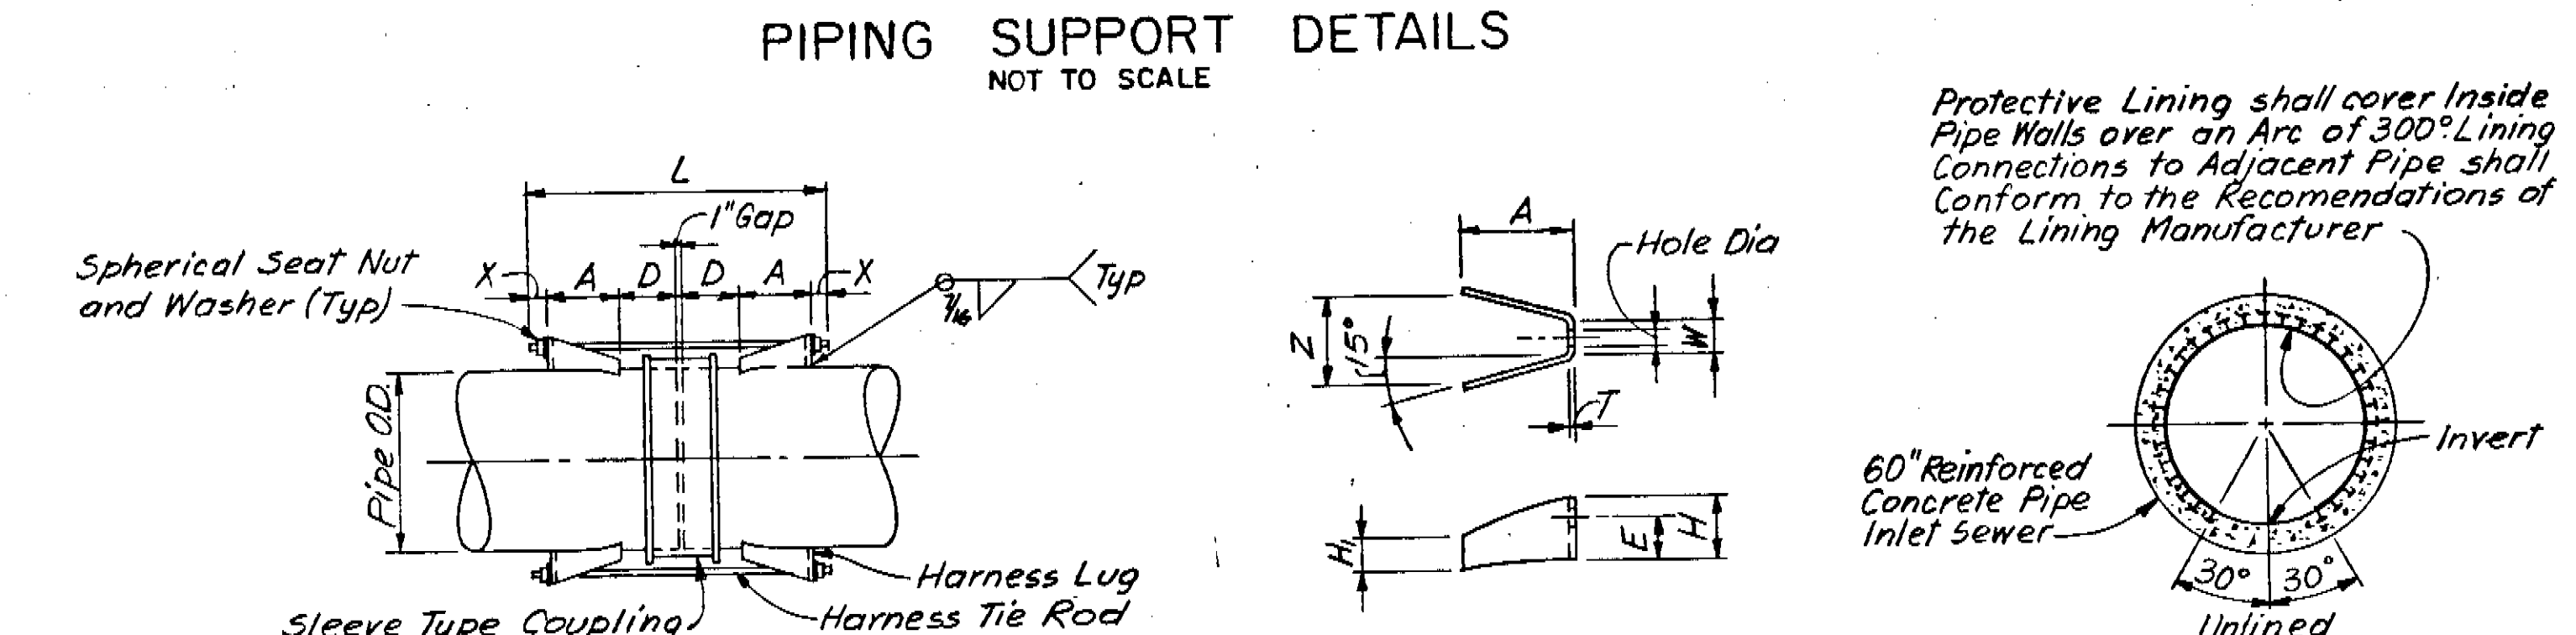

TYPE A HARNESS SLEEVE TYPE COUPLING JOINT FOR STEEL PIPE - SCHEDULE

Nom. Wall Thick. of Pipe	OD of Pipe	Test Press. PSIG	Middle Ring Length	Harness Tie Rod Thkns.	No.	Diag.	X	L	A	W	Z	T	E	H	H ₁	D	Hole	Coupling Service
3/16"	36.75	110	10"	1/2"	2	1 1/4"	2 1/4"	48 3/4"	10 1/2"	3 1/2"	8 5/8"	1/2"	4"	5 1/2"	2 1/2"	11 1/2"	1 1/8"	Raw Sewage


HARNESS SLEEVE TYPE COUPLING JOINT DETAILS
NOT TO SCALE

MODULAR WALL SLEEVE SEALING SCHEDULE


SERVICE	NOM. SIZE	PIPE OD "A"	NOM. SLEEVE I.D. "B"	SLEEVE T.D. "C"	LINK SEAL MODEL	LINKS PER SEAL	C	CARRIER PIPE MATERIAL
Lawn Irrigation Supp.	2"	2.375"	4"	4.026"	LS 300C	6	9	P.V.C.
Level Sensing	3/8"	0.5"	1 1/2"	1.610"	LS 200C	3	7	Copper
Air	3/4"	0.875"	2"	2.067"	LS 200C	4	7	Copper
Water Hose Pipe	1"	1.125"	2 1/2"	2.469"	LS 200C	5	7	Copper
Fuel Oil Return	1"	1.315"	2 1/2"	2.469"	LS 200C	5	7	Steel
Fuel Oil Supply	2"	2.375"	4"	4.026"	LS 300C	6	9	Steel
City Water Main	2"	2.125"	3 1/2"	3.548"	LS 300C	5	8 1/2	Copper

MODULAR WALL SLEEVE SEALING SCHEDULE
NOT TO SCALE


RECORD DRAWING
THIS RECORD DRAWING IS NOT WARRANTED BUT IS BELIEVED TO REPRESENT CONDITIONS UPON COMPLETION OF CONSTRUCTION WITH REASONABLE TOLERANCES BASED UPON THE INFORMATION FURNISHED TO THE ENGINEER PERTAINING TO CHANGES MADE DURING CONSTRUCTION.

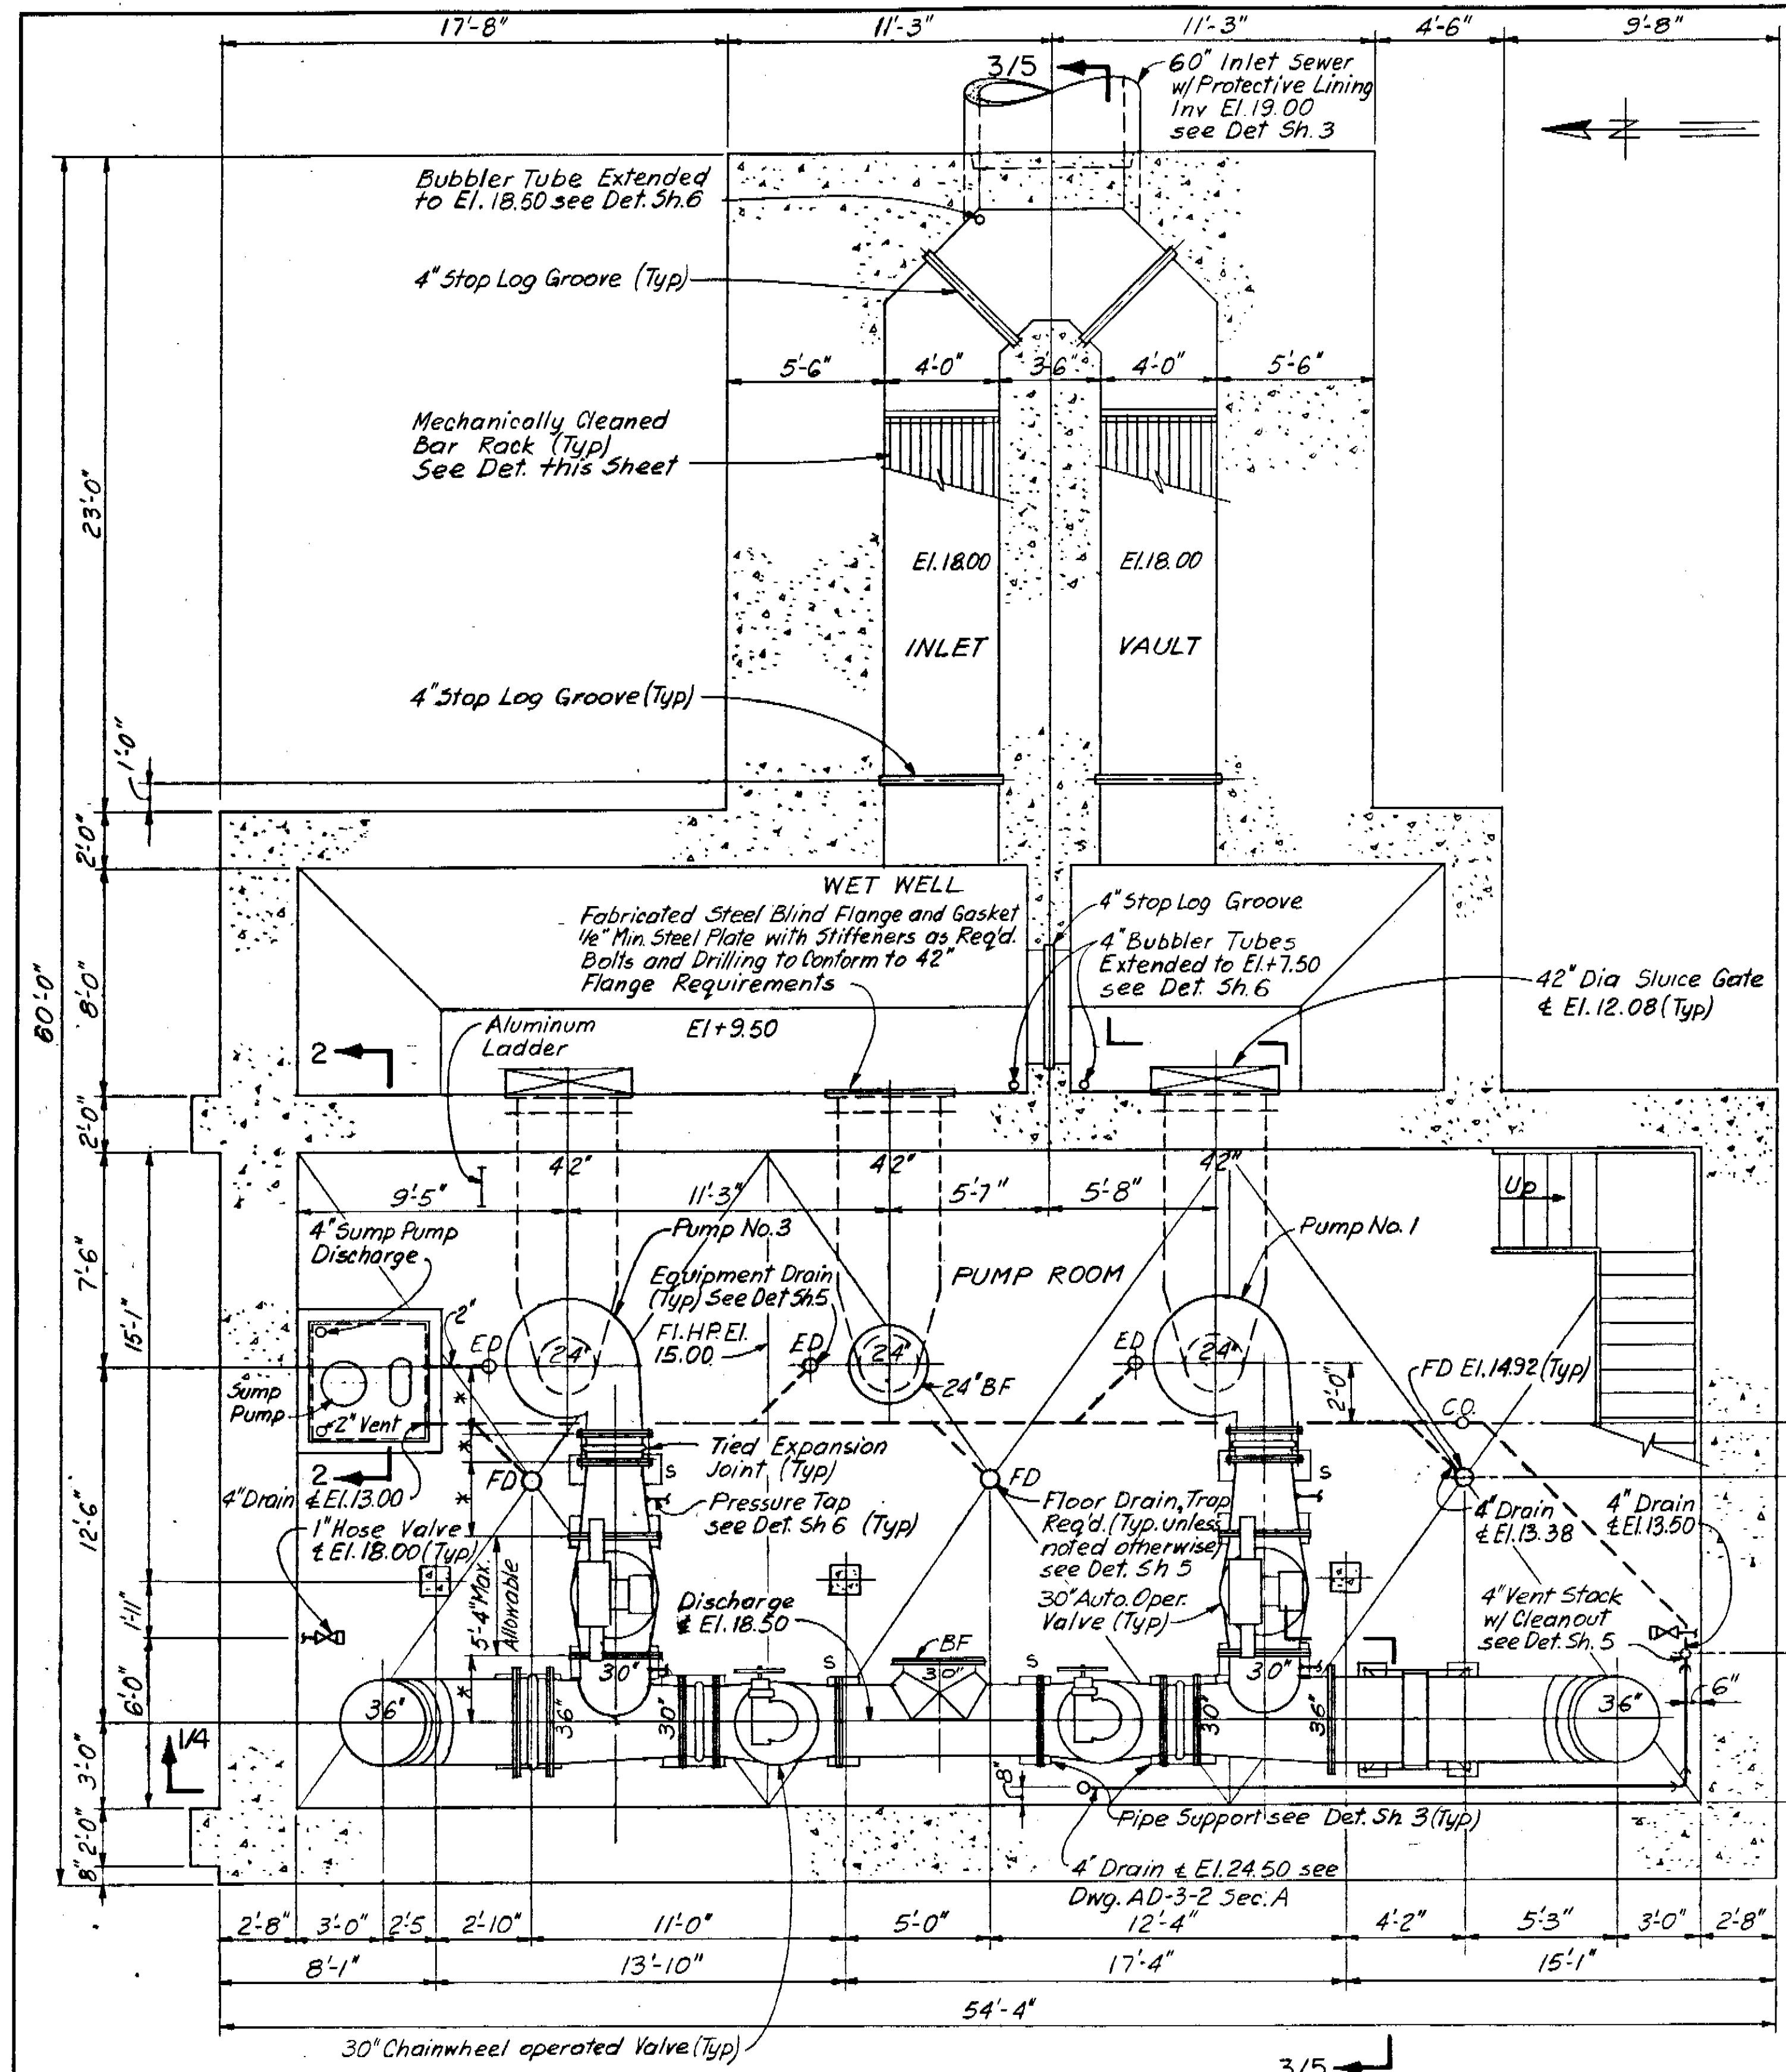

PLAN AT EL 15.00
SCALE: 1/4" = 1'-0"

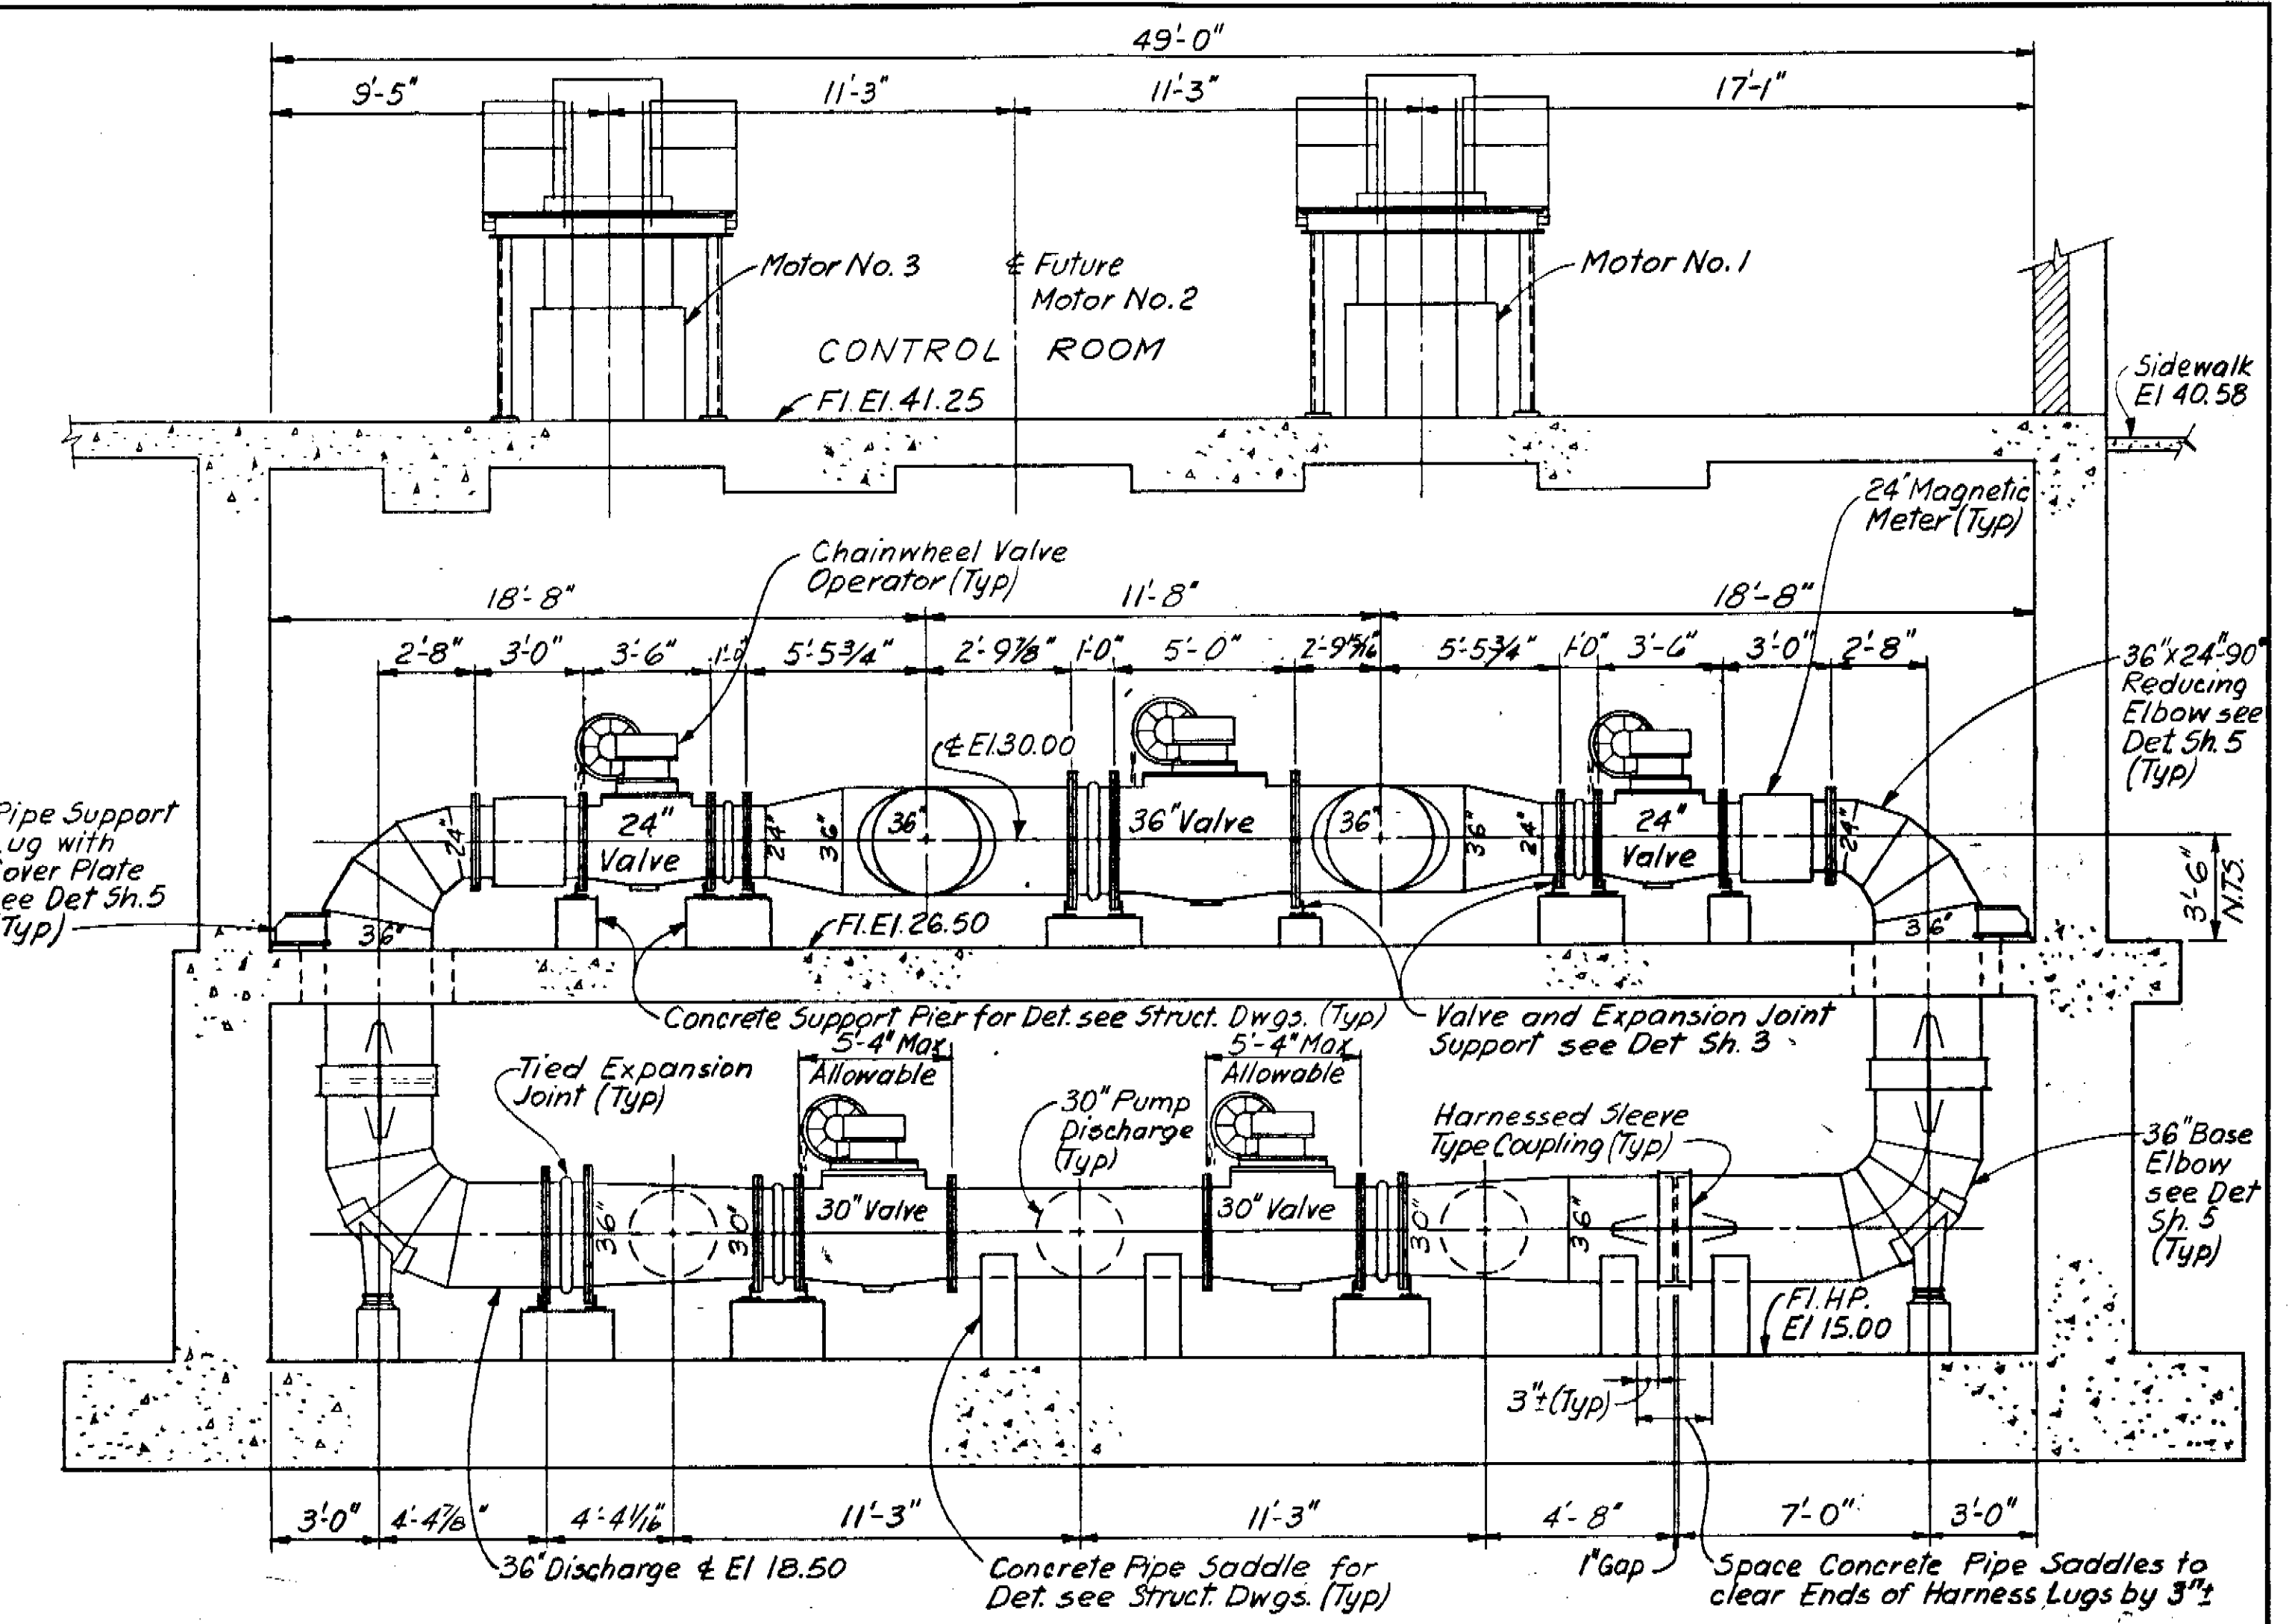


SECTION 1/3.4
SCALE: 1/4" = 1'-0"

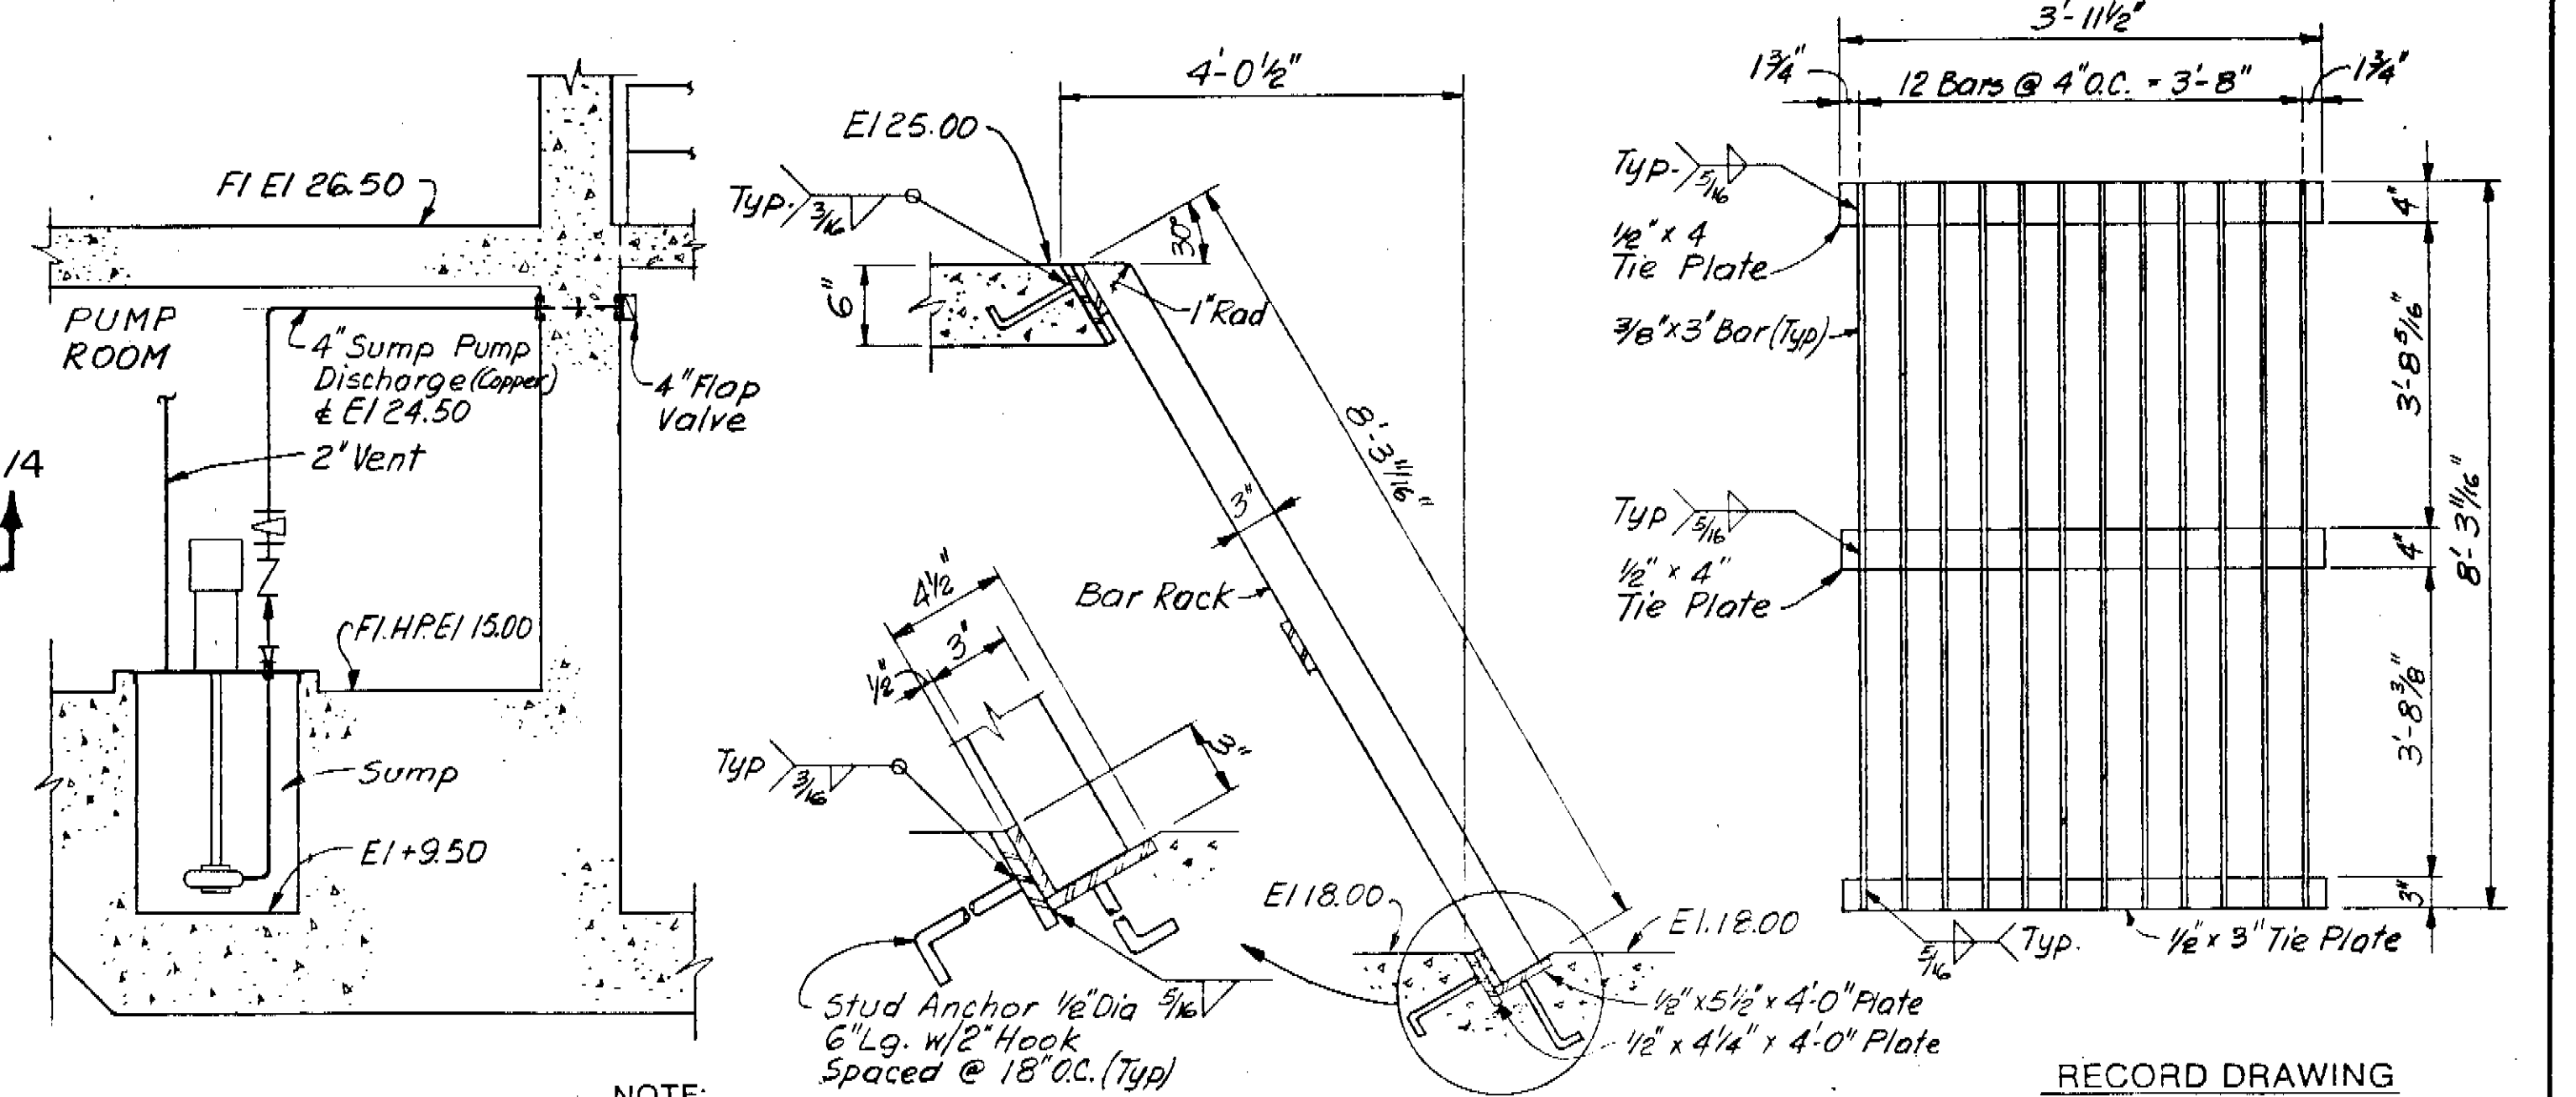

BAR RACK DETAILS
NOT TO SCALE

NOTE:
ALL ELEVATIONS SHOWN ARE REFERENCED TO CITY OF TAMPA DATUM. TO CONVERT TO NATIONAL OCEAN SURVEY (NOS) DATUM, SUBTRACT 0.15 FEET (0'-1.13/16").

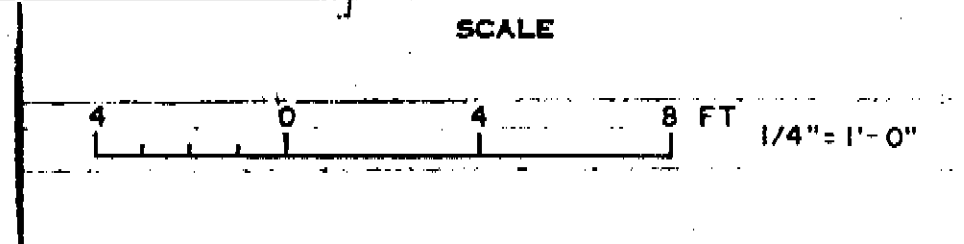

SECTION 2/3.4
SCALE: 1/4" = 1'-0"

CITY OF TAMPA, FLORIDA
SEWAGE DISPOSAL SYSTEM
DIVISION 463
131 ST. AVENUE PUMPING STATION


EQUIPMENT
LOWER FLOOR PLAN
SECTIONS AND DETAILS

PROJ. NO. 8 202-70-30D-7-463
SHEET 8 OF 9
DATE AUGUST, 1972 REV. 1



173-111A


CITY OF TAMPA

LOCATION MAP

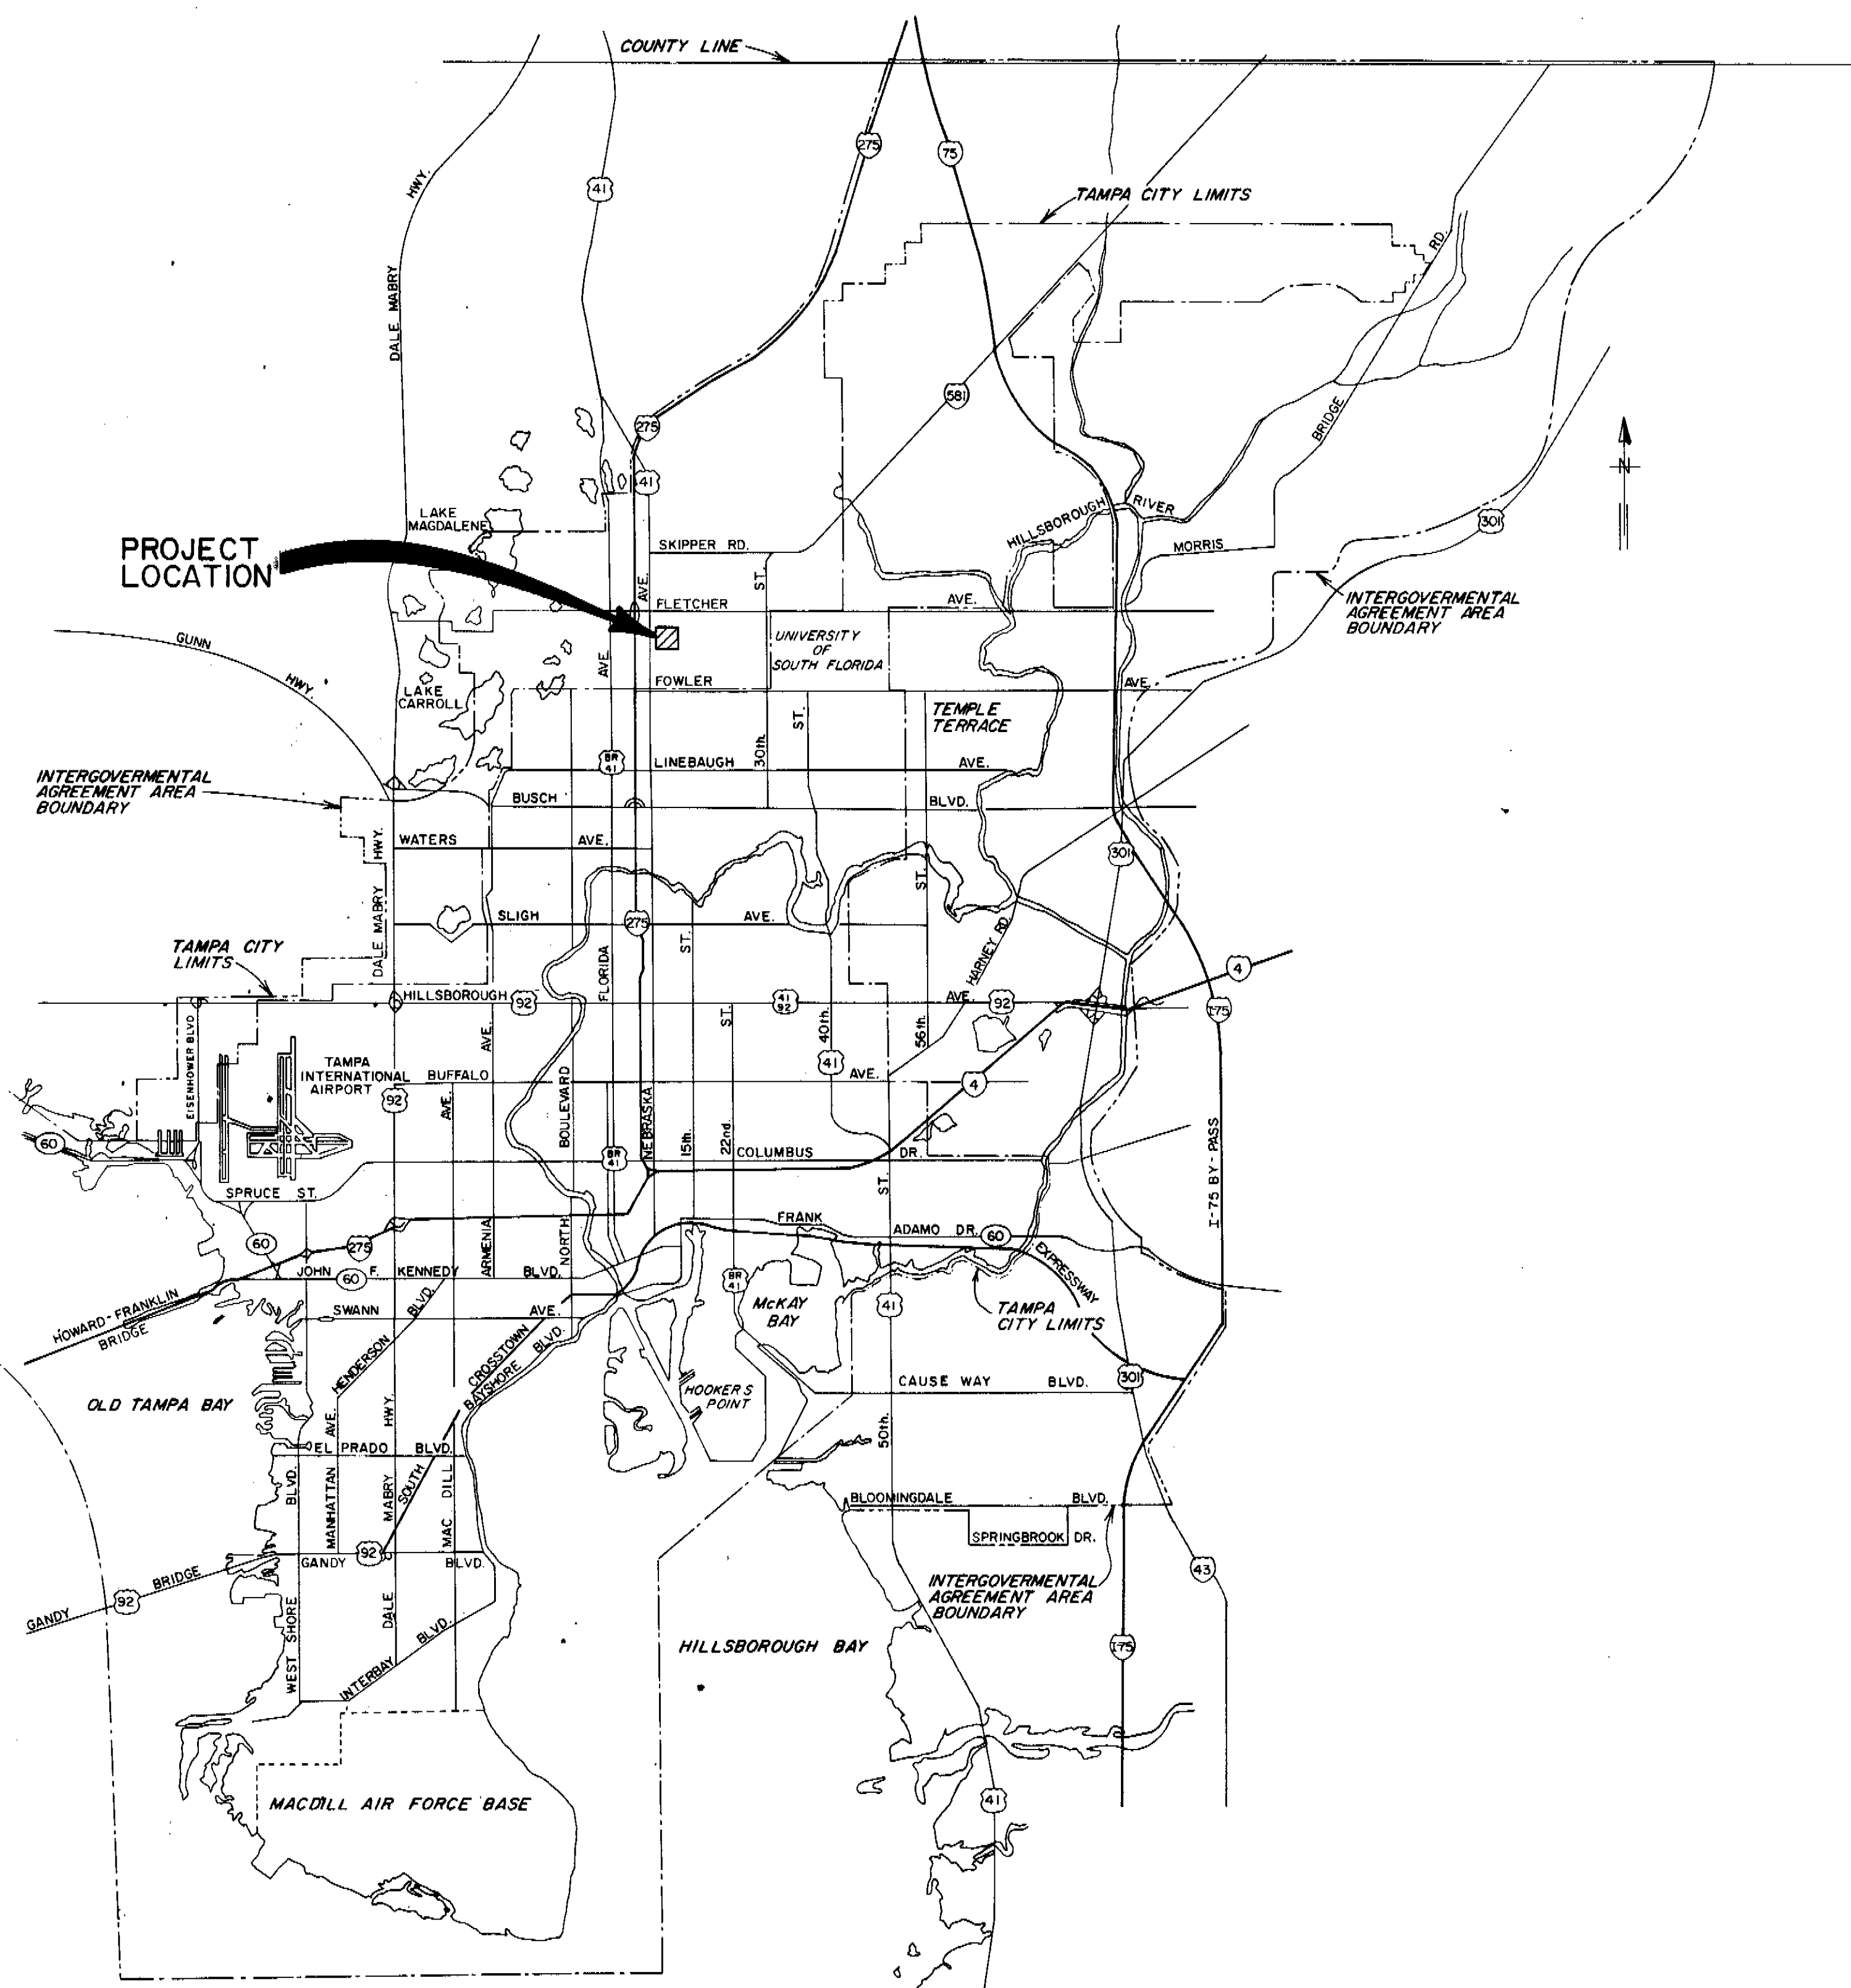

DEPARTMENT of SANITARY SEWERS
 PLANS
 FOR THE CONSTRUCTION OF
 FUEL OIL TANK
 REPLACEMENT for
 131st AVE. PUMPING STATION
 CONTRACT # 8-161

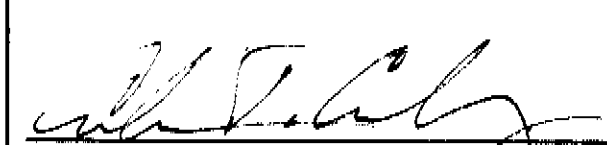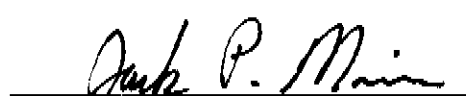
 ANDREW T. CRONBERG, P.E. # 32960 CHIEF ENGINEER DEPARTMENT of SANITARY SEWERS	DES: A.H.	APPROVED BY	SCALE 1" = approximately 1/2 miles	DEPARTMENT of SANITARY SEWERS CITY of TAMPA, FLORIDA RENEWAL & REPLACEMENT	TITLE SHEET & LOCATION MAP OF SHEET 1 OF 173-73e																
	DRN: E10/RAR																				
	CKD: DW	JACK P. MORRIS, P.E.																			
	DATE: 7-7-80	DIRECTOR																			
		DEPARTMENT of SANITARY SEWERS																			
	<table border="1"> <thead> <tr> <th>NO</th> <th>DATE</th> <th>REVISIONS</th> </tr> </thead> <tbody> <tr><td>1</td><td></td><td></td></tr> <tr><td>2</td><td></td><td></td></tr> <tr><td>3</td><td></td><td></td></tr> <tr><td>4</td><td></td><td></td></tr> <tr><td>5</td><td></td><td></td></tr> </tbody> </table>	NO	DATE	REVISIONS	1			2			3			4			5				
NO	DATE	REVISIONS																			
1																					
2																					
3																					
4																					
5																					

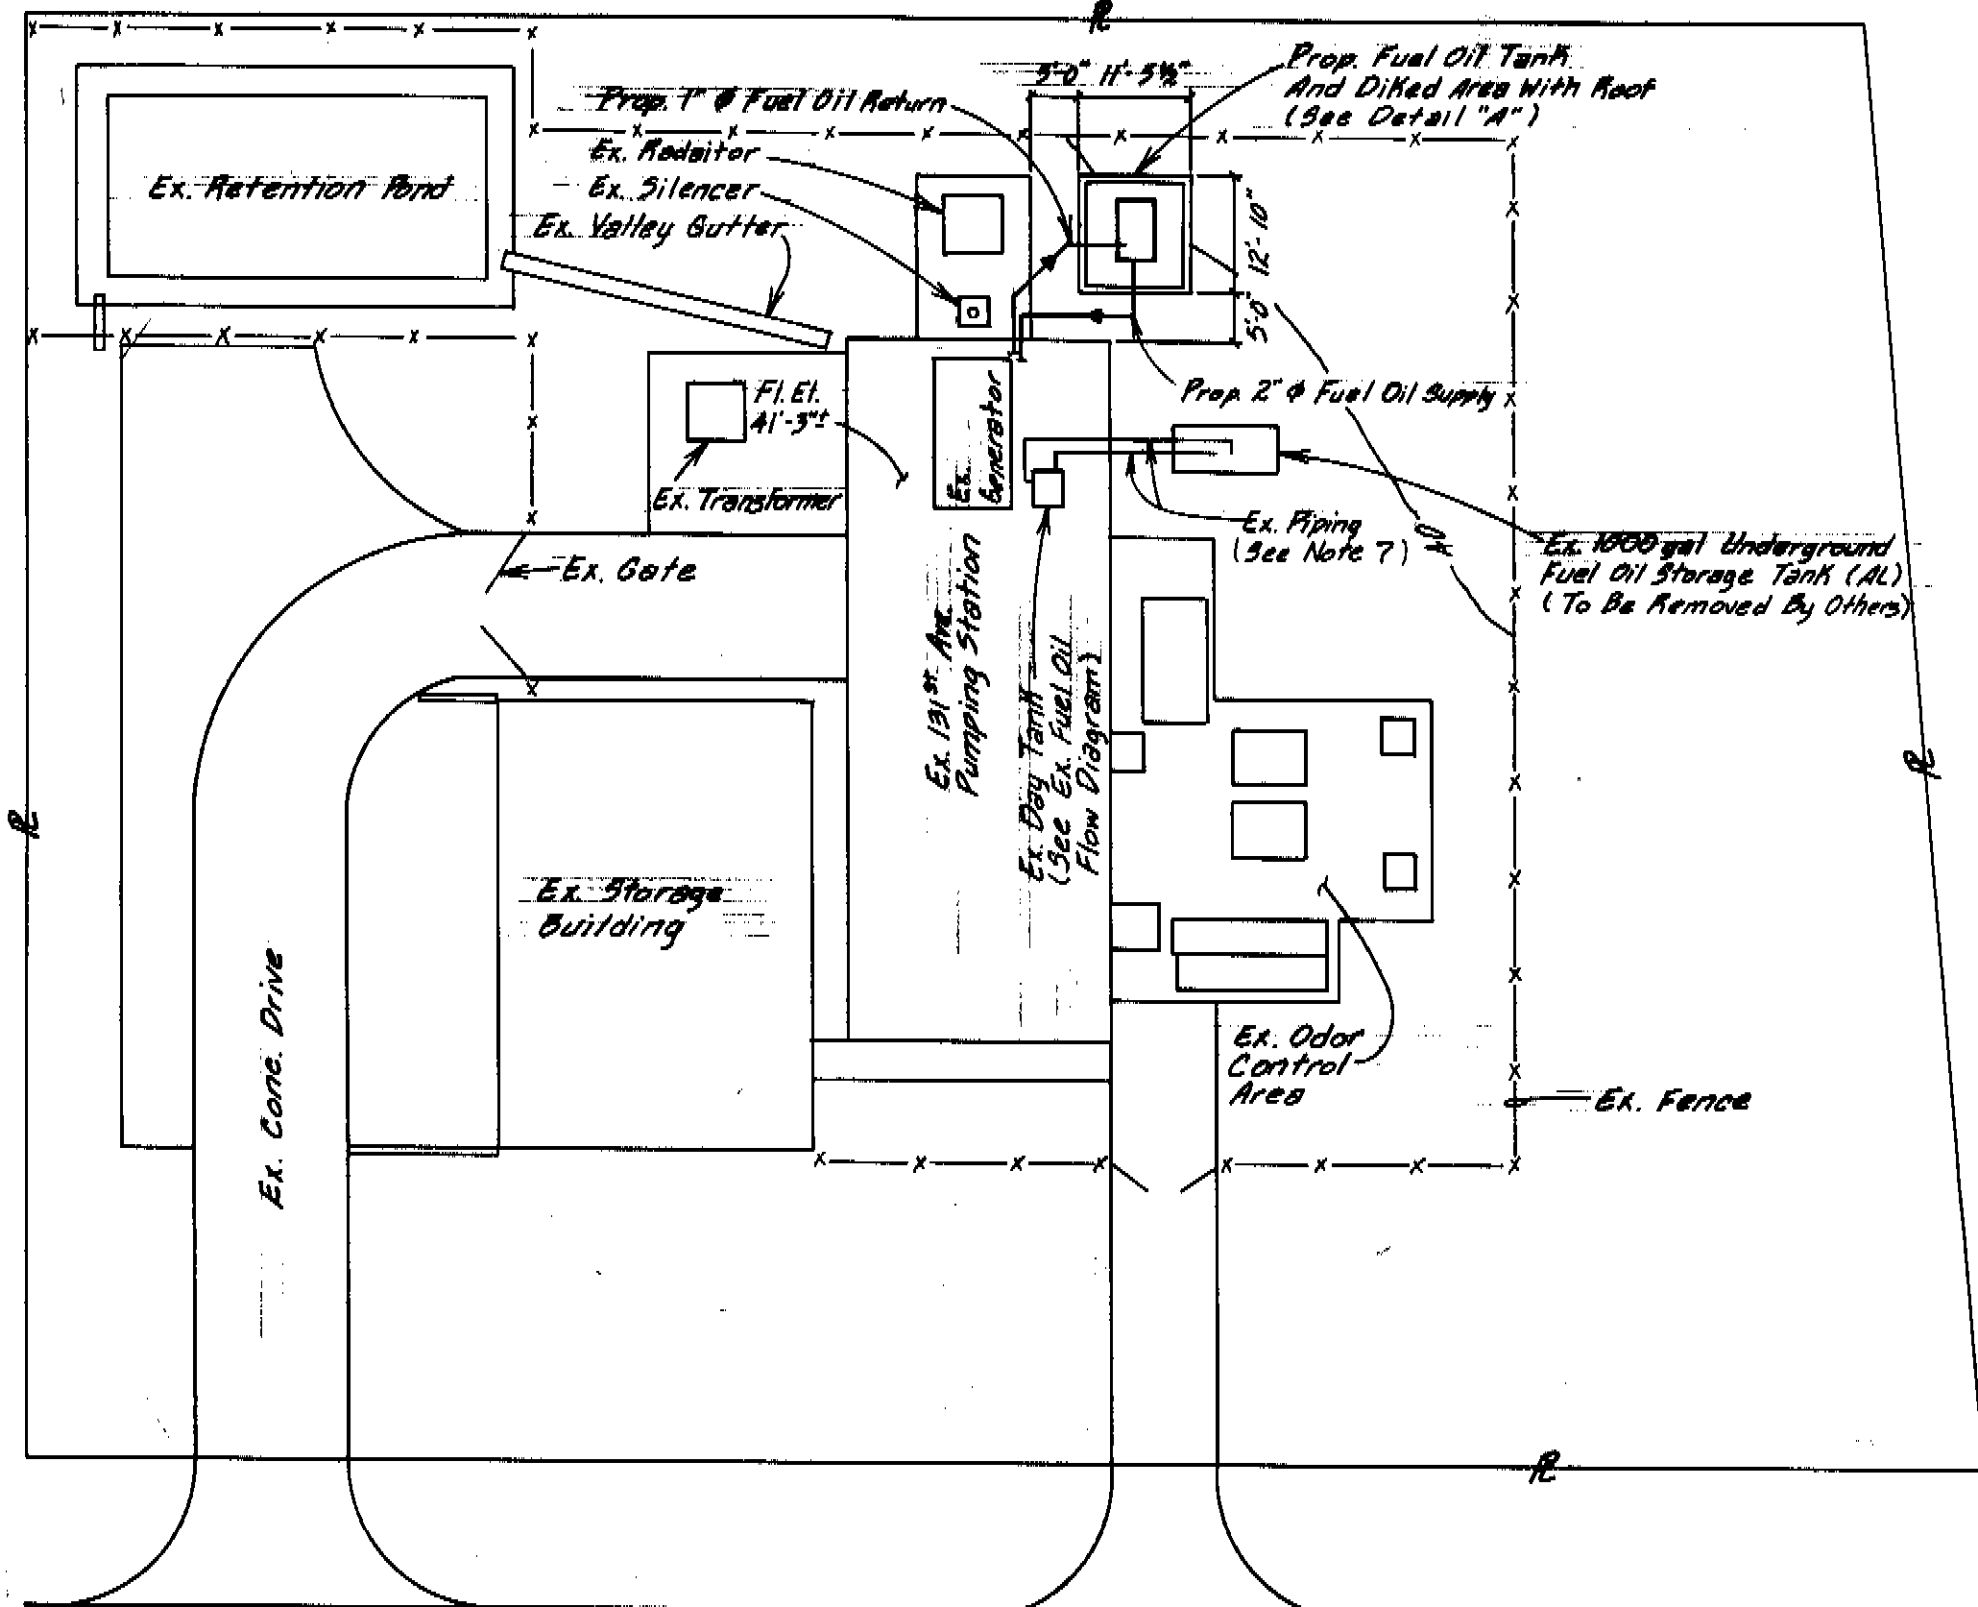


SITE PLAN
SCALE 1" = 20'

NOTES


- The Fuel Oil Tank, Diked Area, Piping and Venting Have Been Designed and Shall Be Fabricated and Constructed in Full Compliance With NFPA 30-87 As Enforced By the City of Tampa Fire Marshal And With DER 17-61. The Atmospheric Tank Will Store No. 2 Diesel Fuel Oil Which is An NFPA Class II Combustible Liquid With A Minimum Rated Flash Point of 125°F.
- The Tank Shall Be Built, Installed and Bear The Seal of UL142-1981, "Standard For Steel Aboveground Tanks For Flammable and Combustible Liquids". The Saddles Shall Be Continuously Welded To The Tank At The Factory To Prevent The Intrusion of Any Moisture Between The Two Surfaces. Stitch Welding Shall Not Be Permitted. The Tank and Saddles Shall Be Field Coated Per Specifications Prior To Anchoring.
- The Tank Shall Be Provided With A Device That Will Relieve Excessive Internal Pressure Caused By Exposure Fires Per NFPA 30-87-2-2.5, "Emergency Relief Venting For Fire Exposure For Aboveground Tanks". Such Device May Be A Self-Closing Manhole Cover, or One Using Long Bolts That Permit The Cover To Lift Under Internal Pressure, or An Additional or Larger Relief Valve or Valves.
- The Finished Top of Tank Elevation is Critical To The Installation To Prevent Splashing To The Fuel Injectors. The Contractor Shall Establish The Floor Elevation of The Pumping Station As The Benchmark And Add 4'-0" To This To Establish The Top of Tank Elevation. After Tank And Saddle Selection, Shop Drawings Shall Be Submitted Detailing Exact Elevations For The Top of Tank, Top of Slab And Ground Elevation Assuming That The Pumping Station Slab Elevation Is 41'-3".
- The Contractor Shall Submit Shop Drawings To Make The Leak Seal Wall Penetrations Liquid Tight And Shall Fill Void Spaces With Non-Shrink Grout. The Pumping Station Penetration Area Shall Be Spot Painted To Match Existing In Color And Texture. The Top Slab Shall Be Sloped A Minimum of 1% Towards The Sump.
- Piping Shall Be Schedule 40 Black Steel, Shall Be Hot Taped Where Buried And Painted Where Exposed. Flanged Flexible Expansion Joints With S.S. Strands Shall Be Provide As Shown To Protect Against Stresses Arising From Settlement, Expansion or Contraction.
- The Existing Piping From The Day Tank To The Buried Tank Is Routed Through The Floor Slab. The Piping Shall Be Capped 1" Below The Floor And Filled With A Flowable Non-Shrink Grout. Buried Piping Shall Be Terminated And Capped As Close As Possible To The East Wall of The Pumping Station.

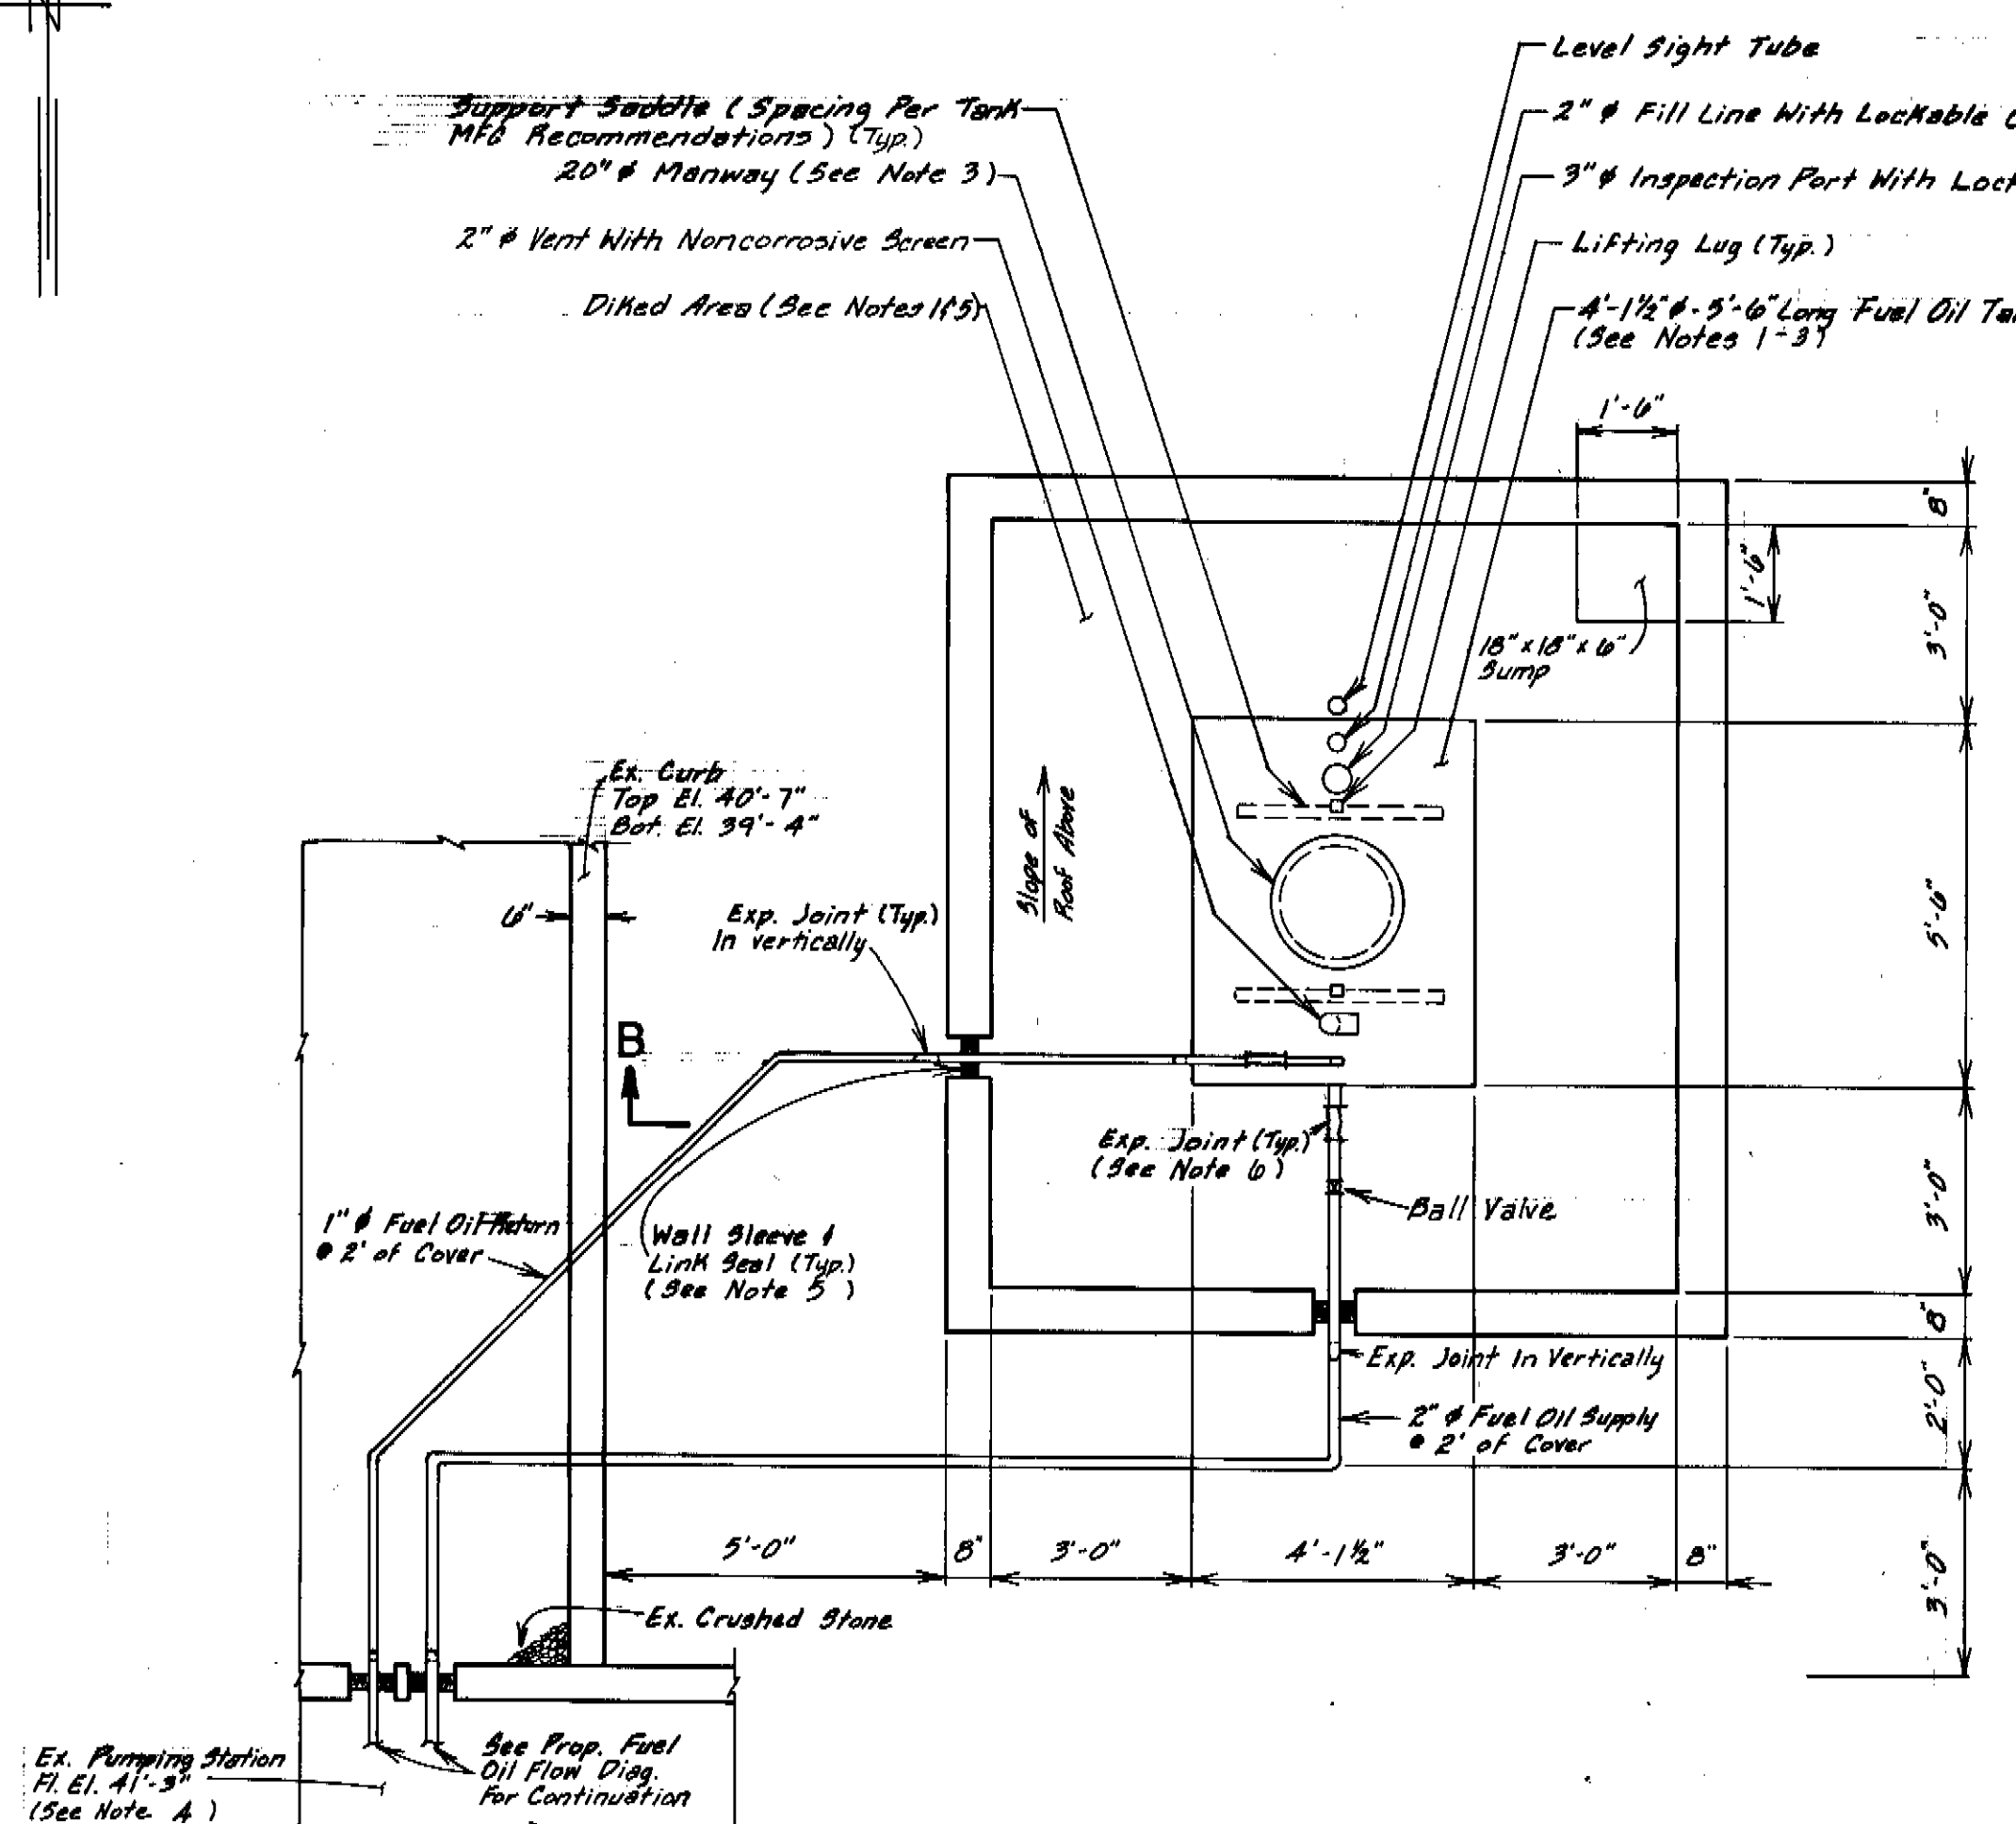


DETAIL A
PLAN AT EL. 46'-3"
SCALE 3/8" = 1'-0"

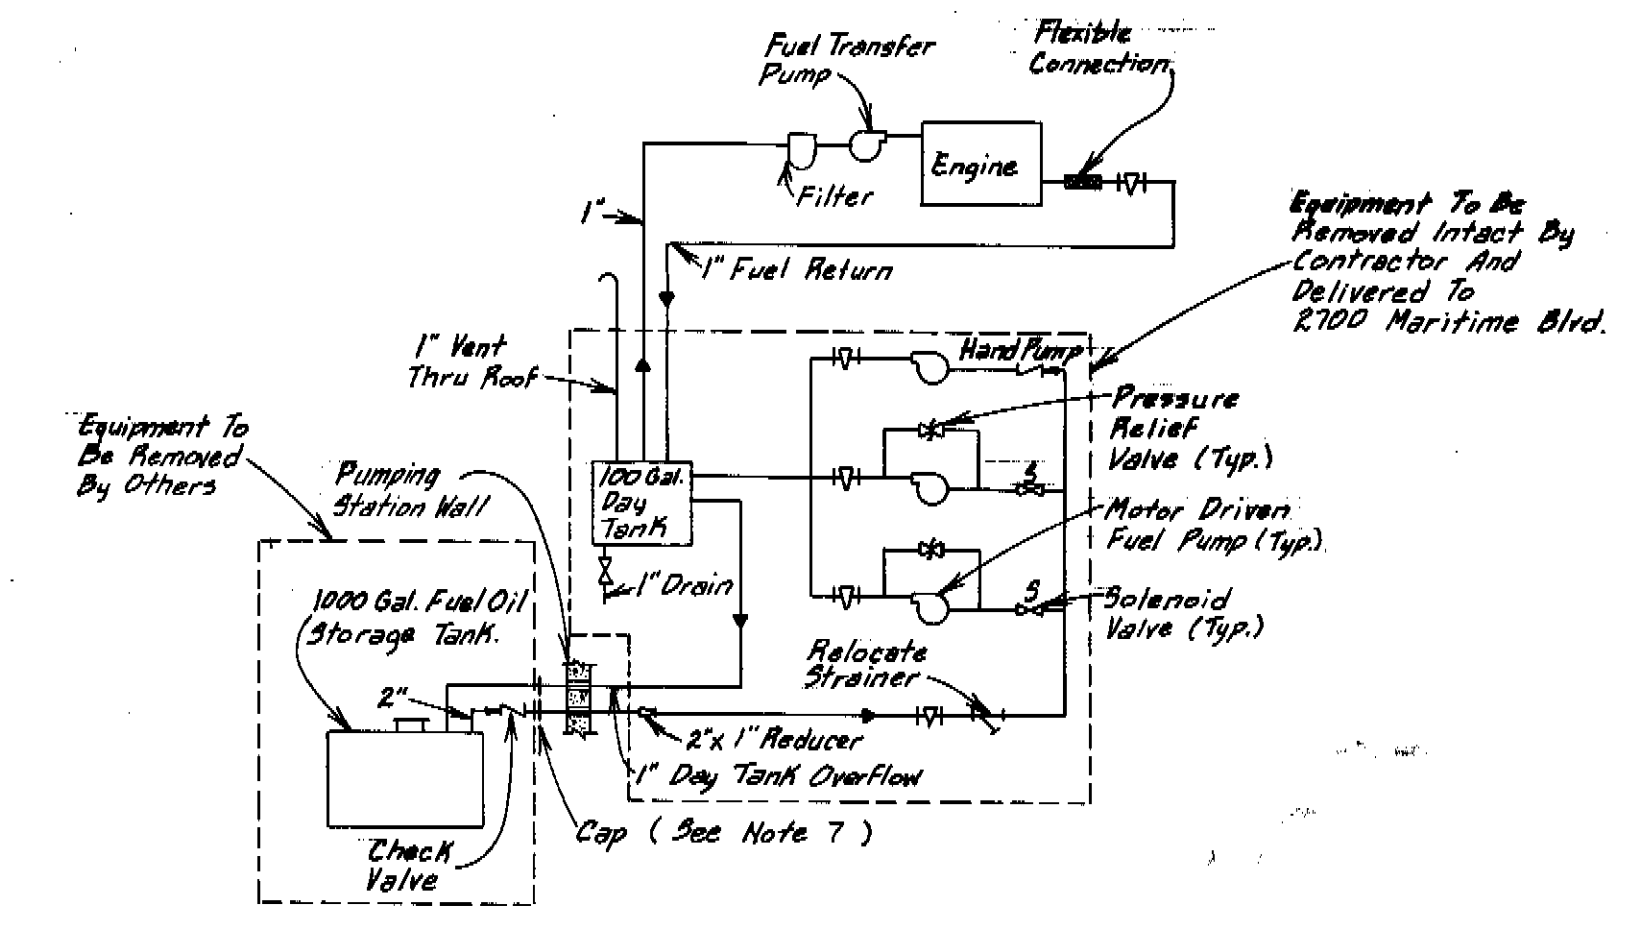

EXISTING FUEL OIL FLOW DIAGRAM
NOT TO SCALE

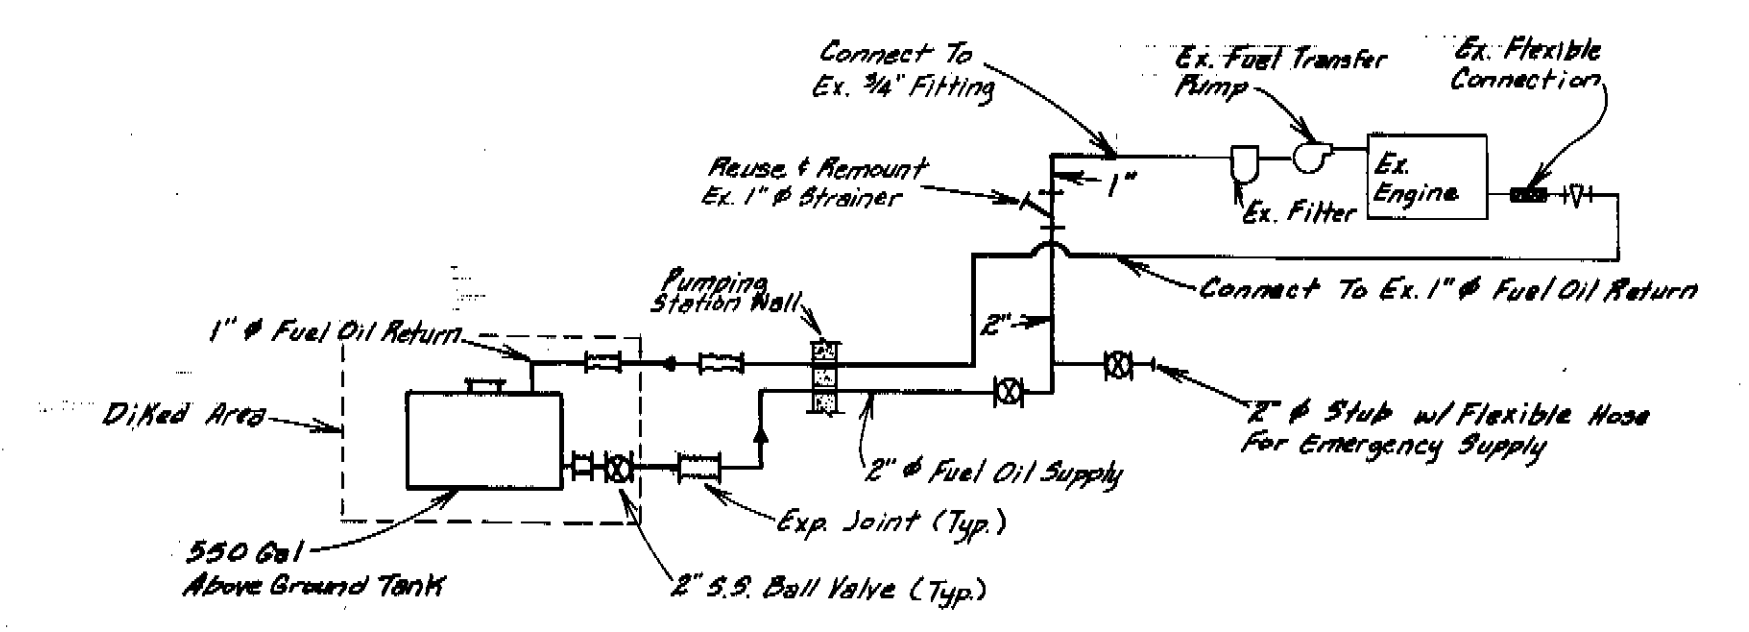

PROPOSED FUEL OIL FLOW DIAGRAM
NOT TO SCALE

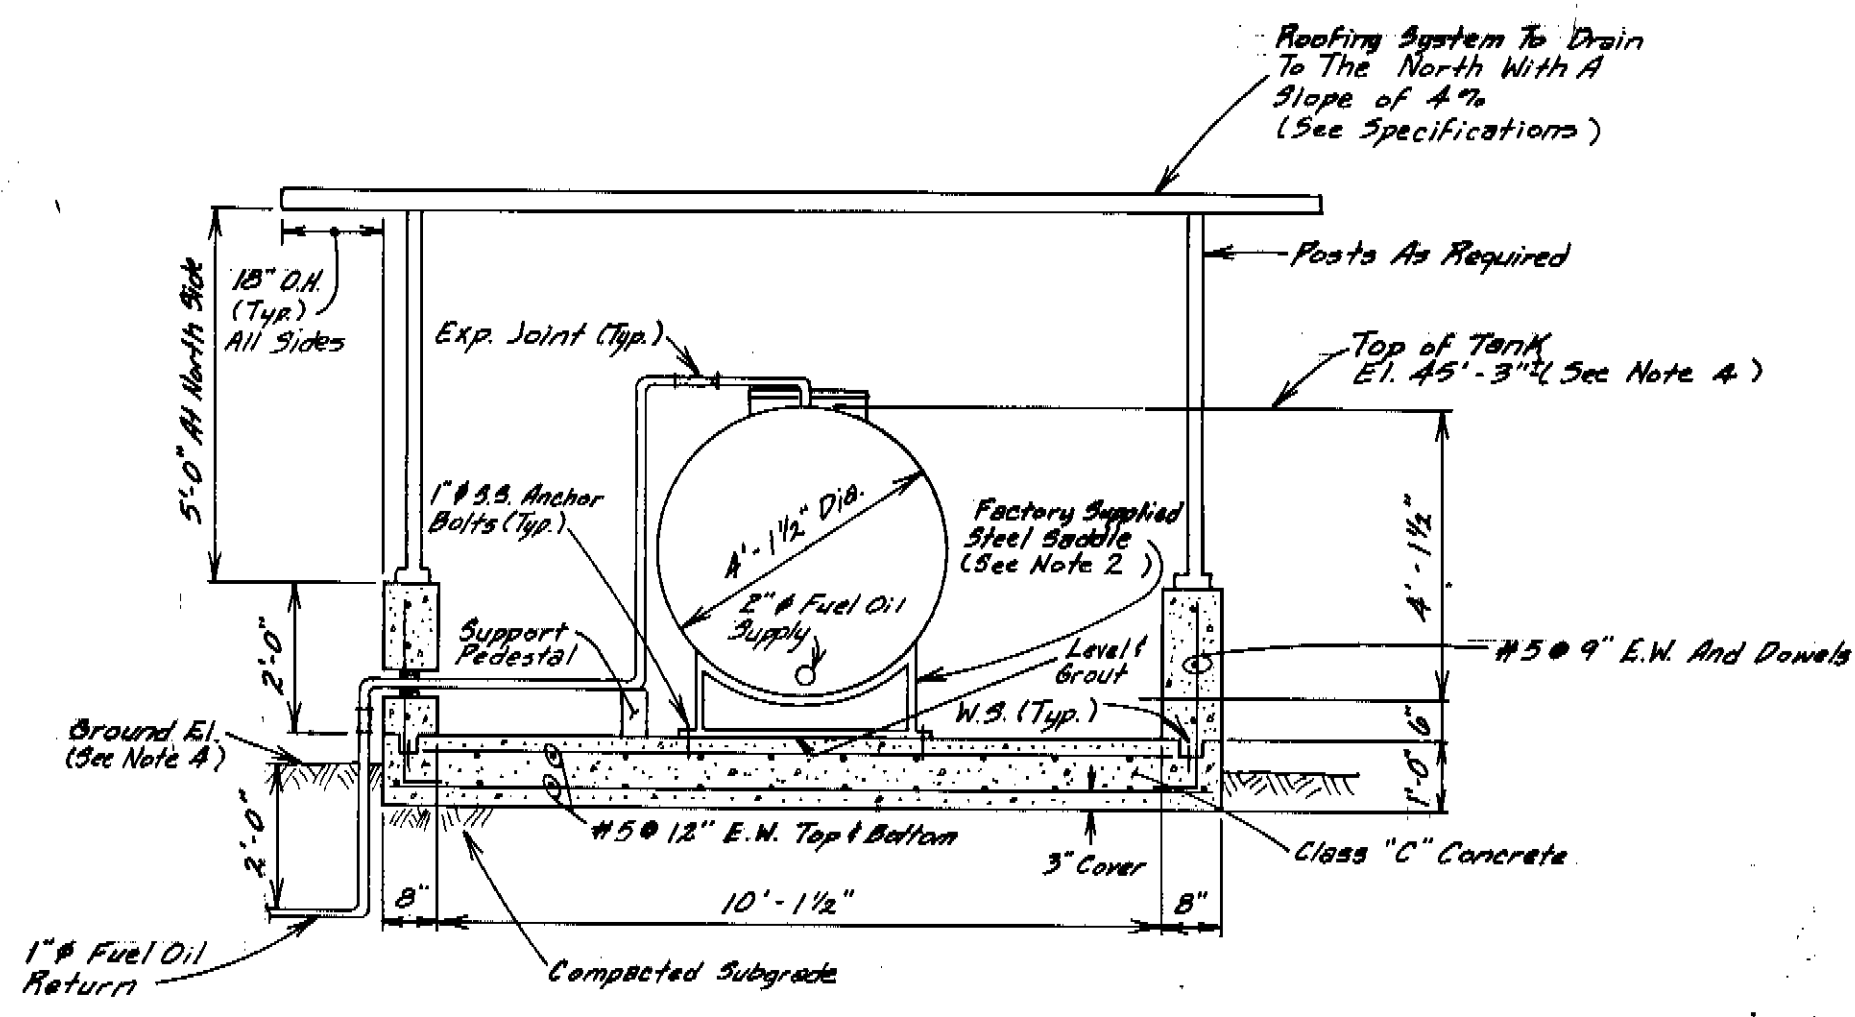

SECTION B-B
SCALE 3/8" = 1'-0"

WORK ORDER # 4171

ANDREW T. CRONBERG, P.E. #32560
CHIEF ENGINEER
DEPARTMENT OF SANITARY SEWERS

DES: A.H.
DRN: R.A.R.
CKD: DW
DATE: 7-7-24

APPROVED BY
JACK P. MORRIS, P.E.
DIRECTOR
DEPARTMENT OF SANITARY SEWERS

NO.	DATE	REVISIONS
1		
2		
3		
4		
5		


SCALE
AS SHOWN

DEPARTMENT OF SANITARY SEWERS
CITY OF TAMPA, FLORIDA


FUEL OIL TANK REPLACEMENT
131ST AVE. PUMPING STATION

SHEET
2
OF


173-734

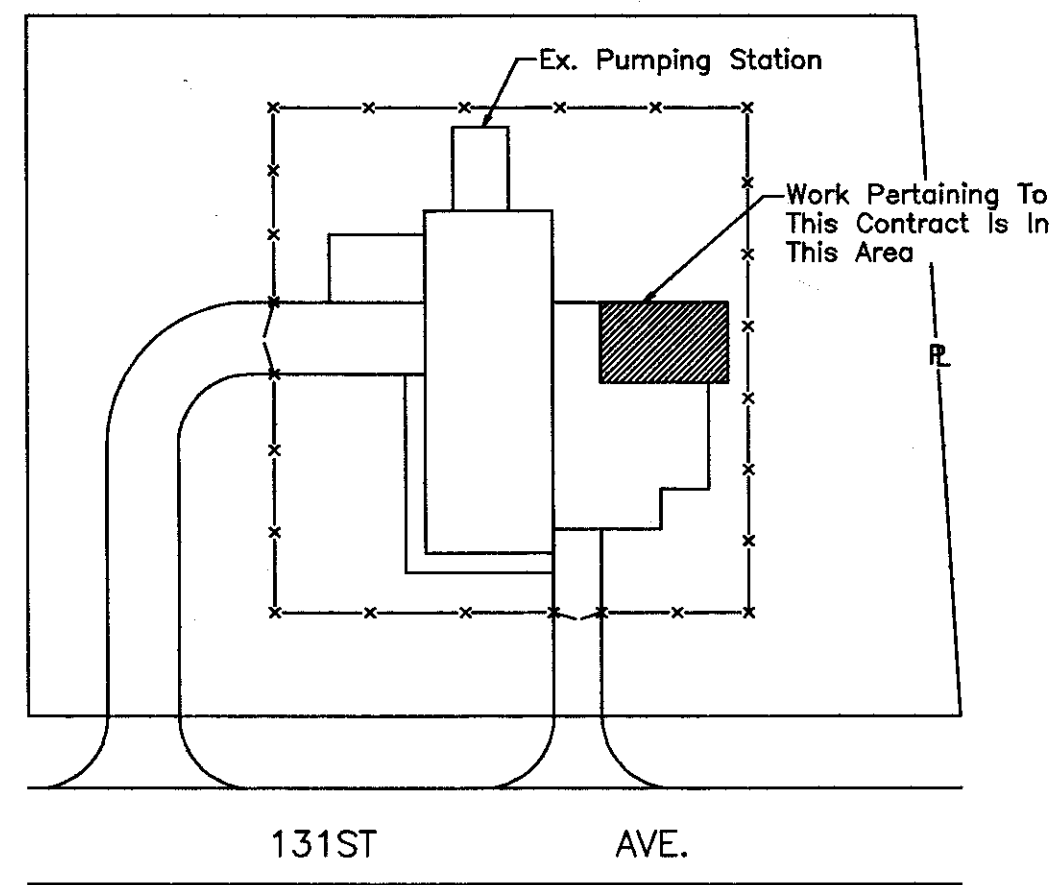

SITE PLAN

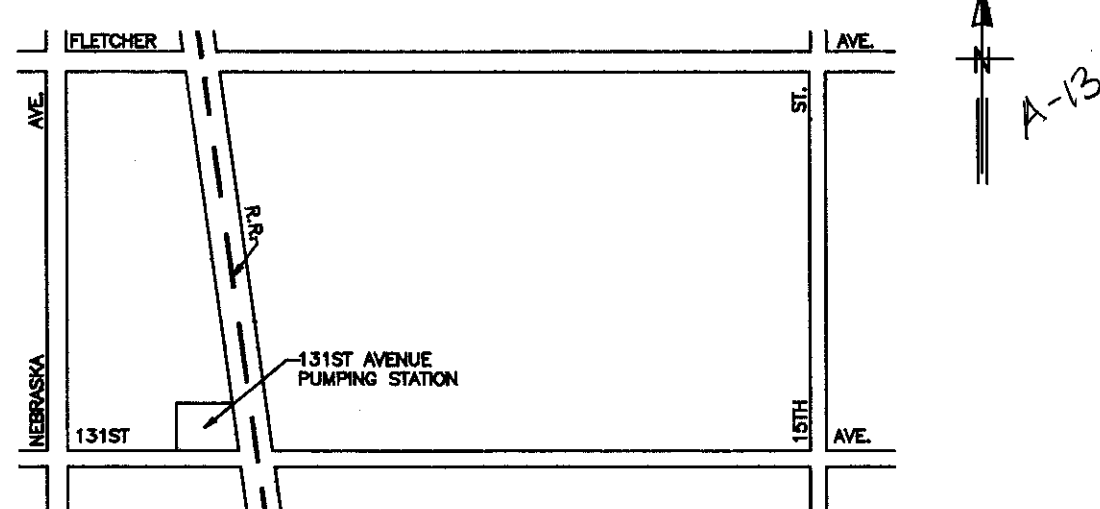

PROJECT LOCATION

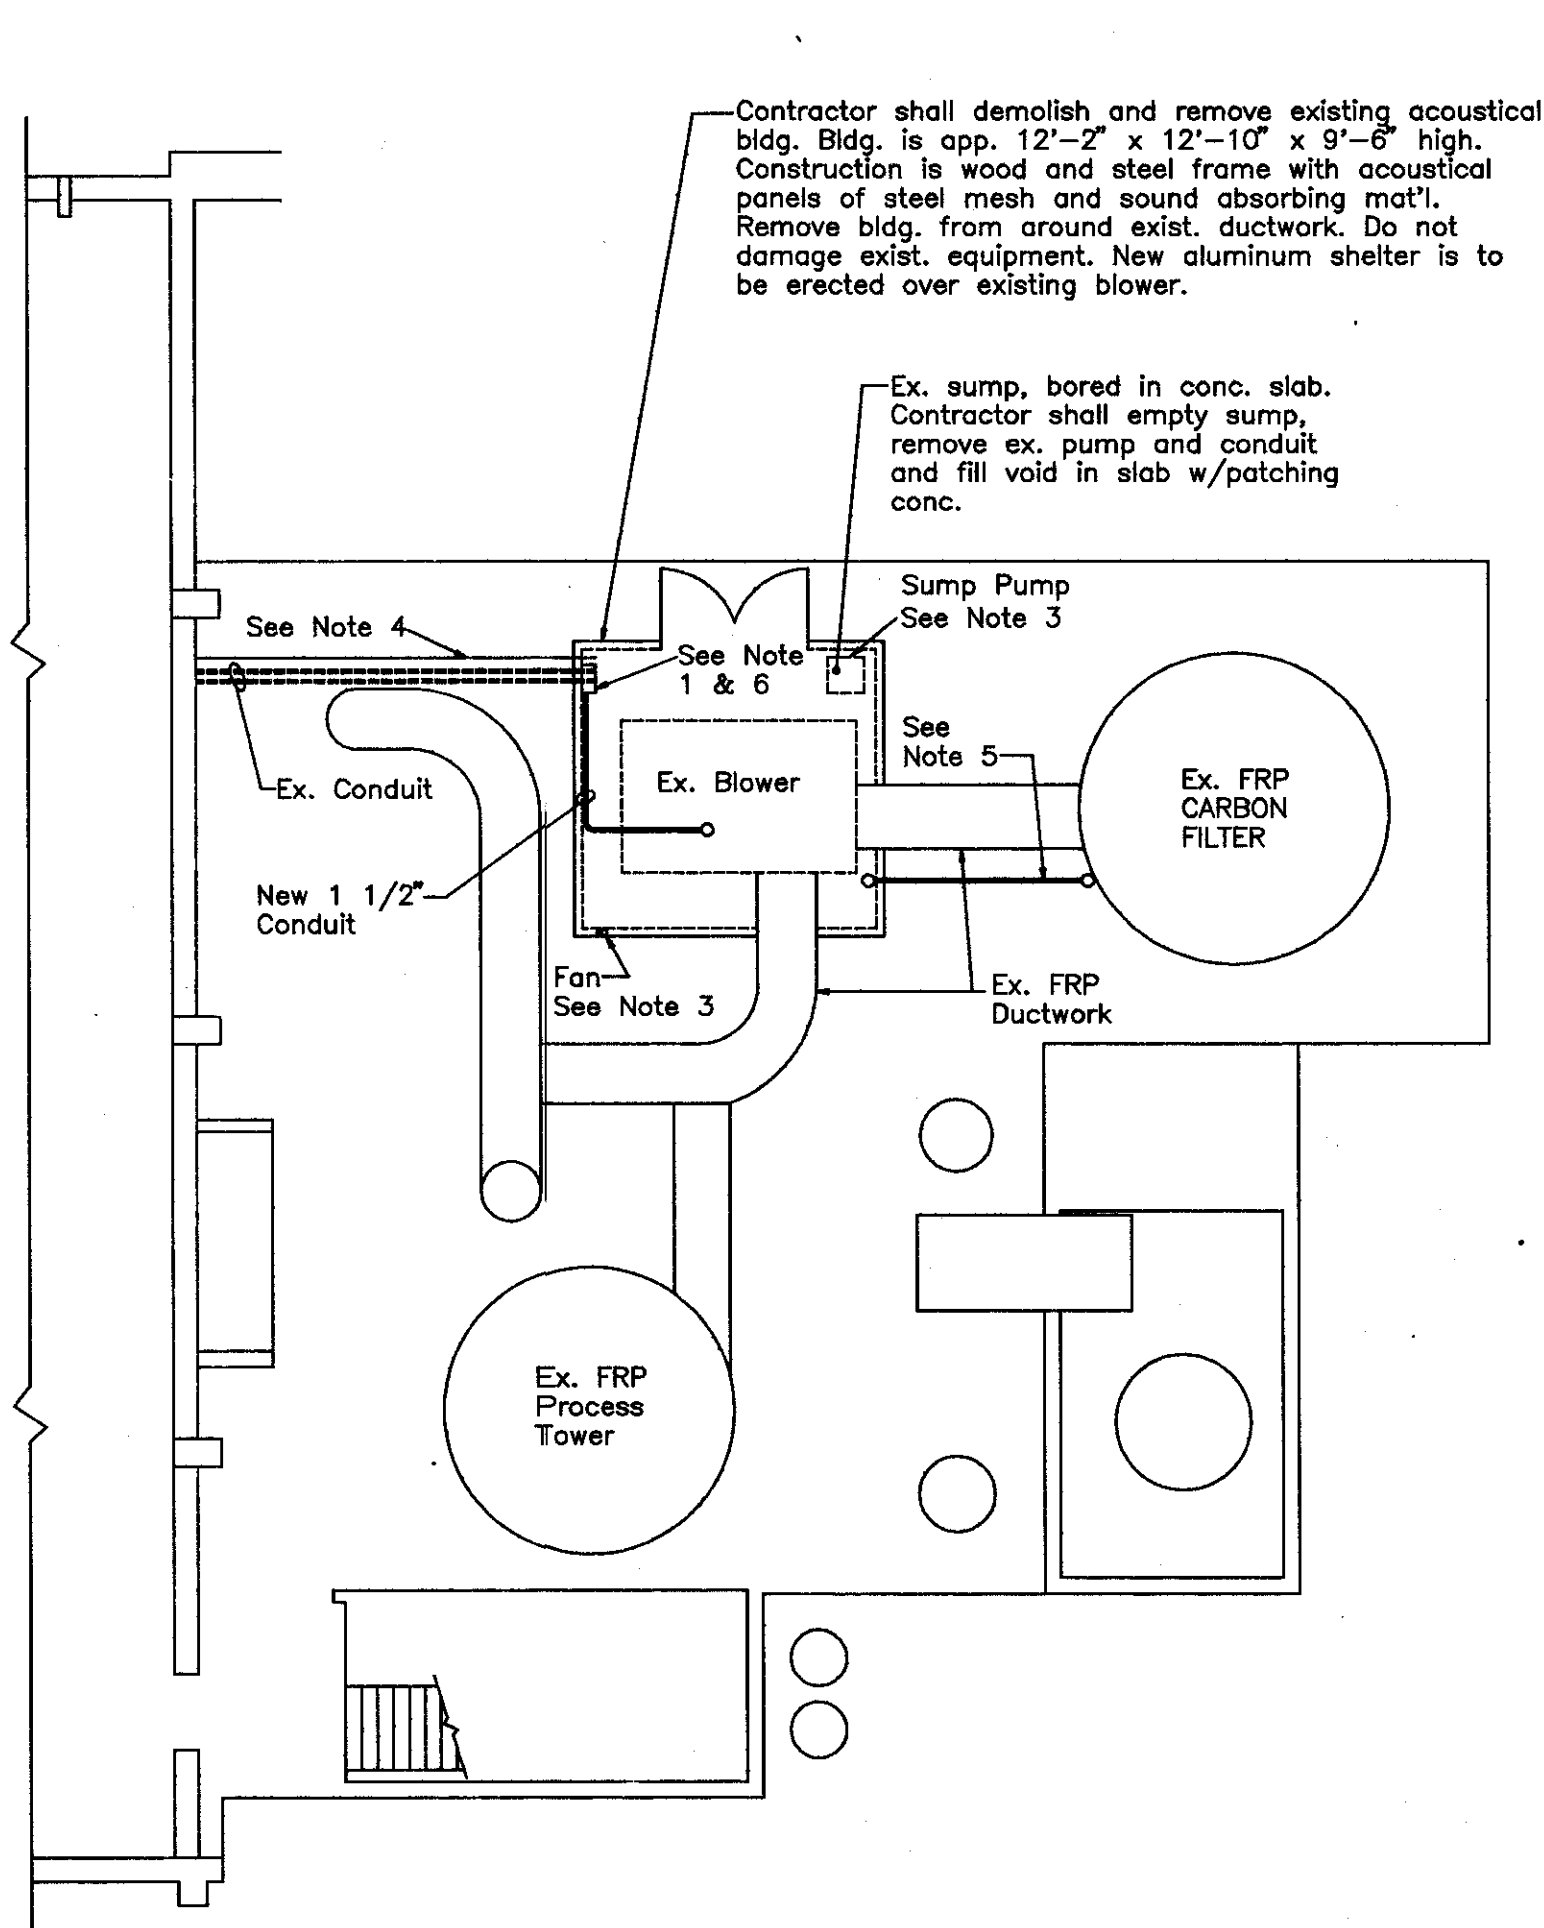


PLAN - EXISTING ODOR CONTROL FACILITIES AT 131ST AVE. PUMPING STATION

SCALE: 1/8" = 1'-0"

ELECTRICAL NOTES


1. Existing blower control cabinet is to be removed.
2. Existing control conduit shall be plugged at LB, wire of sufficient length for future pulls shall be left in LB. Wire ends shall be taped.
3. Enclosure vent fan and sump and the receptacle and conduit for them shall be removed.
4. Air pipe shall be capped immediately outside of the pump station, and all exterior air equipment and piping shall be removed.
5. Remove 3/4" conduit with 1-#10 wire that runs to carbon filter (process tank).
6. Install a new, 100 AMP, stainless steel enclosed, circuit breaker type disconnect.
7. Existing blower motor is 40hp, 460 volt, 47 fla.
8. The existing motor feeder conduit and conductors may be reused if found in good condition and in conformance with the 1987 NEC-Article 430; otherwise, new equipment shall be provided and installed. No splices shall be allowed in conduits. A minimum #6AWG, green, equipment grounding conductor shall be provided and installed.

————— Conduit to be Installed
 - - - - - Existing Conduit

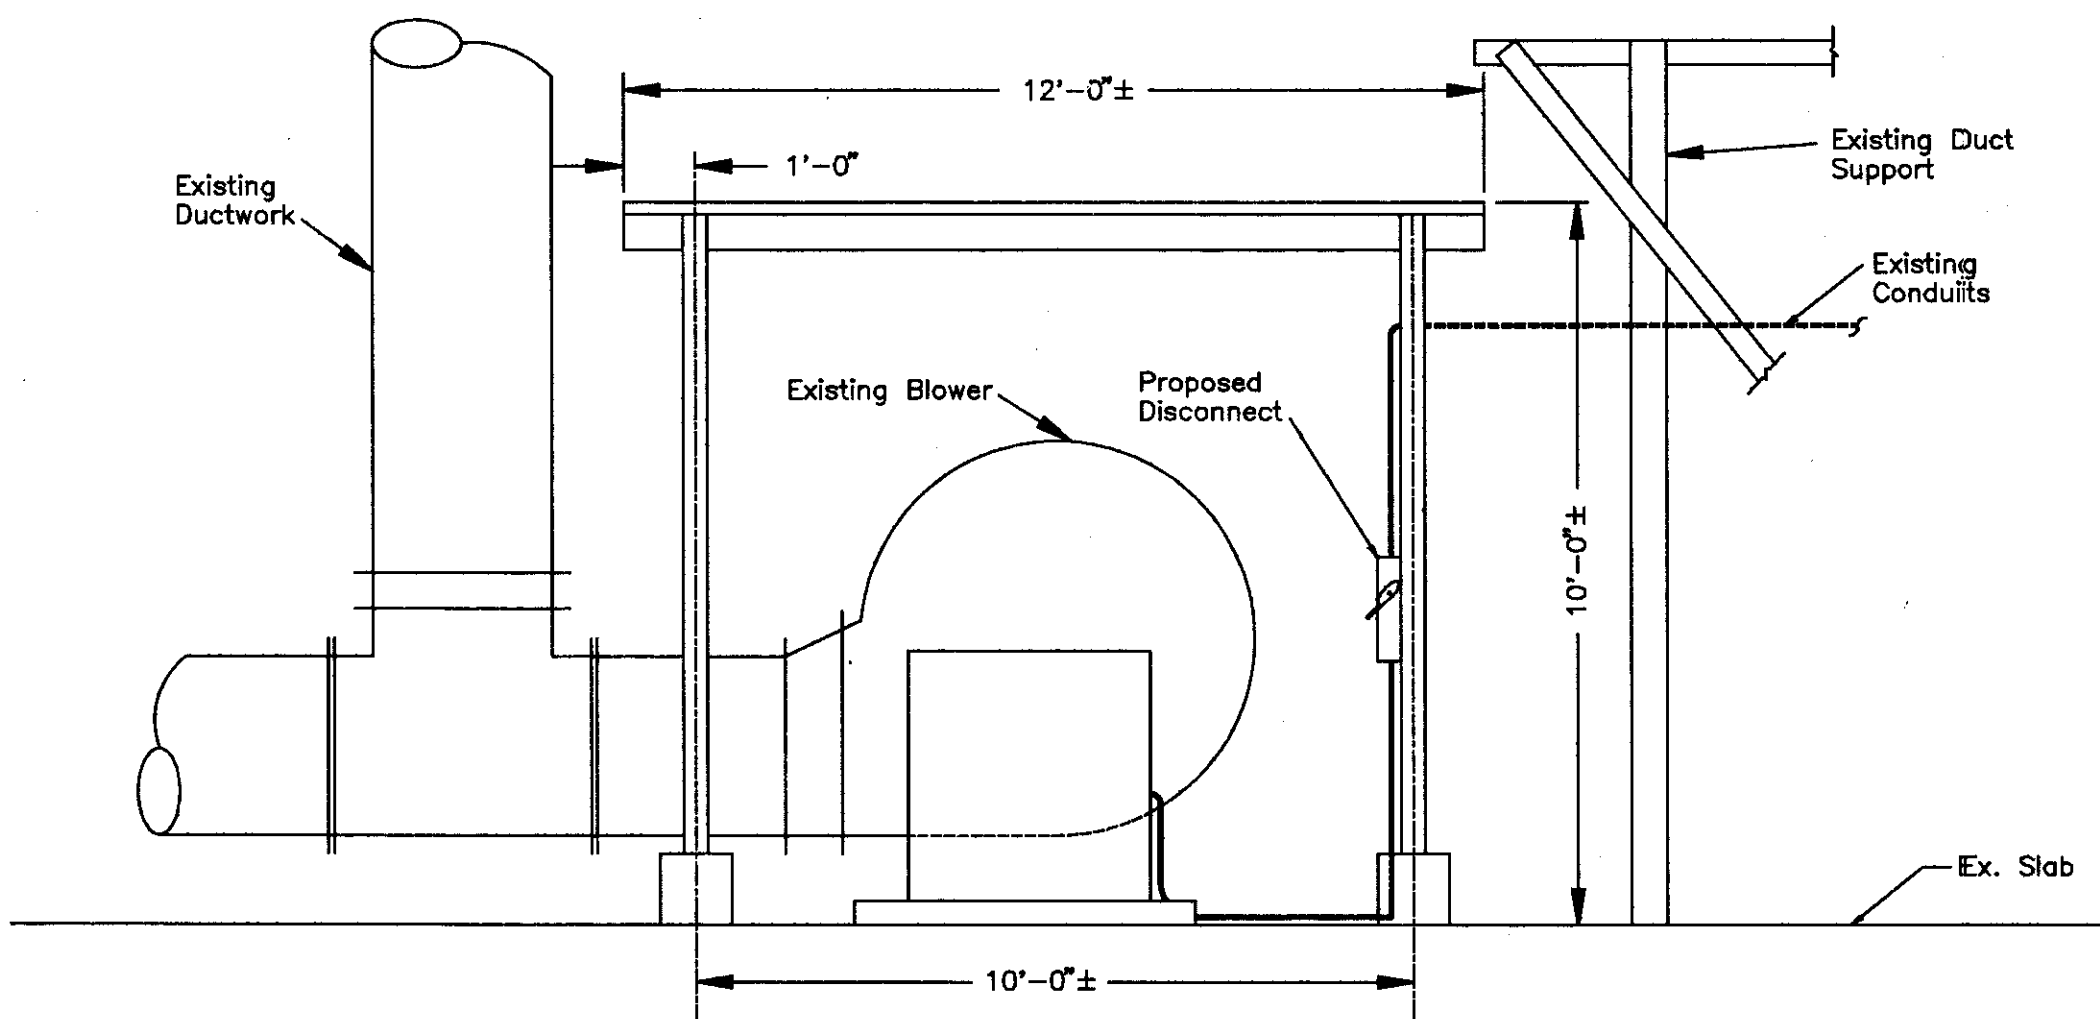


PROPOSED ALUMINUM SHELTER - NORTH ELEVATION

SCALE: 3/8" = 1'-0"

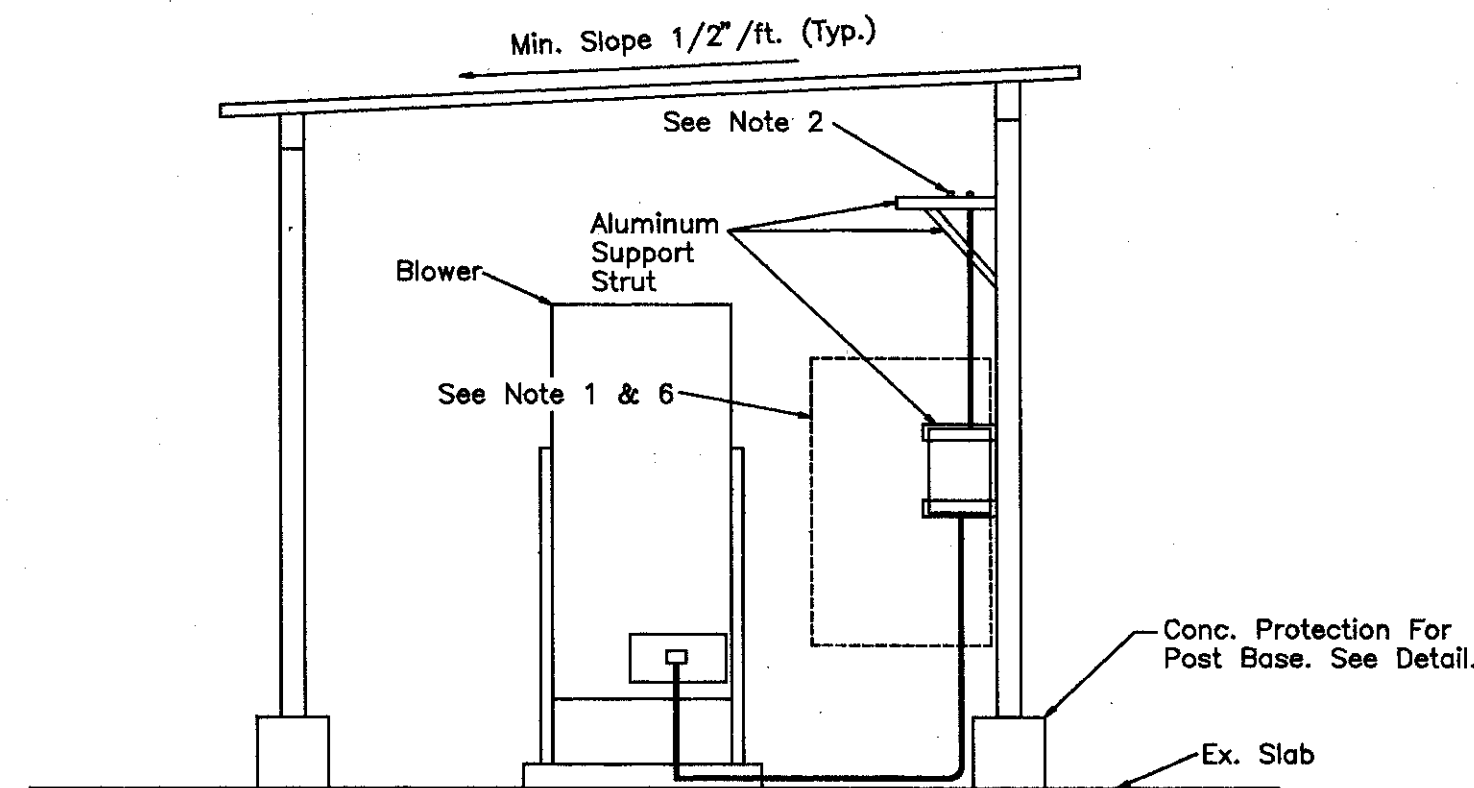

PROPOSED ALUMINUM SHELTER EAST ELEVATION

SCALE: 3/8" = 1'-0"

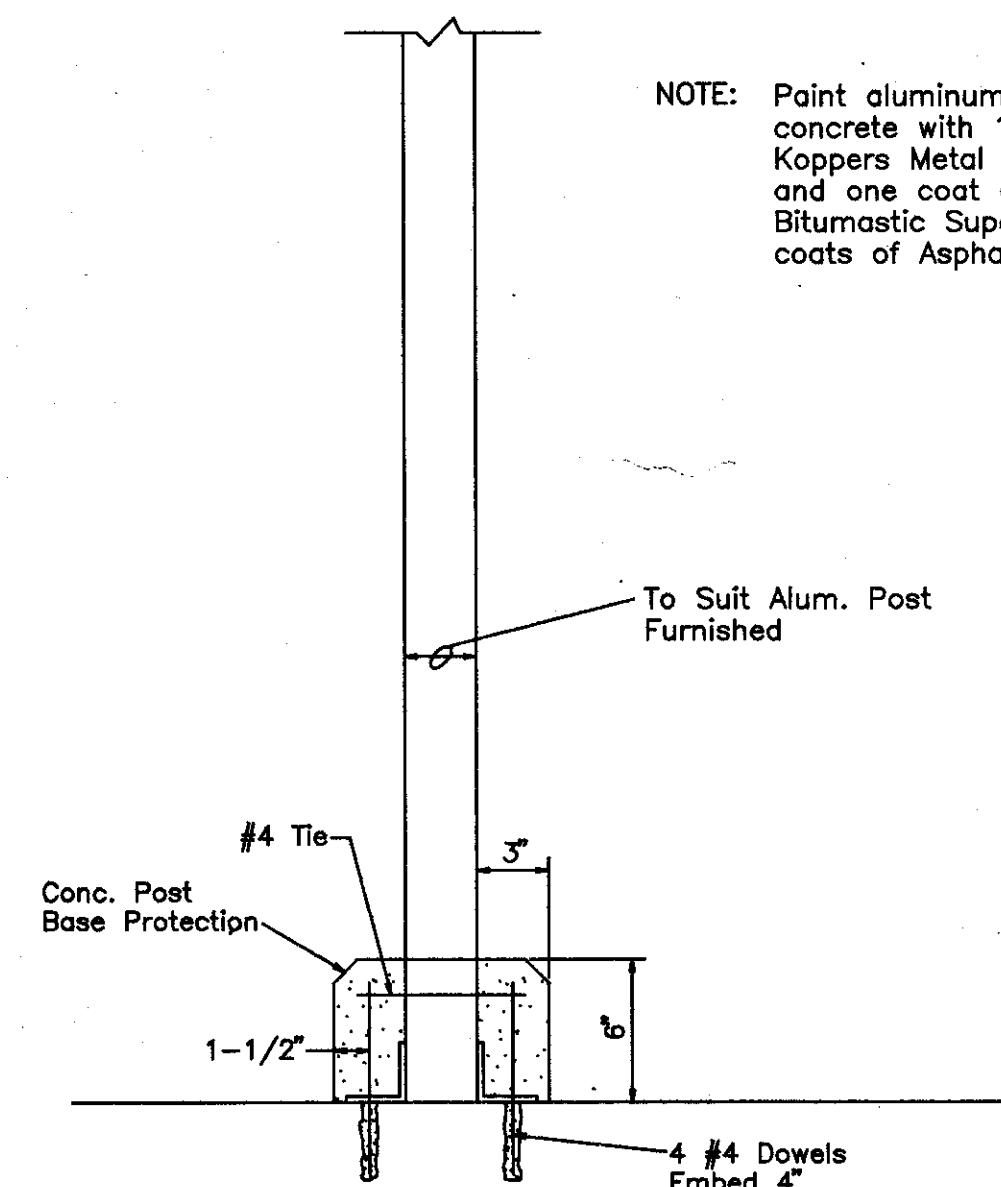

POST BASE DETAIL

SCALE: 1 1/2" = 1'-0"

NOTE: Paint aluminum in contact with concrete with 1 field coat of Koppers Metal Passivator No. 40 and one coat of Koppers Bitumastic Super Service or two coats of Asphaltic varnish.

ROMAN D. KORCHAK, P.E. #42626
 ELECTRICAL SECTION HEAD
 DEPARTMENT OF SANITARY SEWERS


HENRY L. DORZBACK, P.E. #39449
 CHIEF ENGINEER
 DEPARTMENT OF SANITARY SEWERS

RALPH L. METCALF II, P.E.
 DIRECTOR
 DEPARTMENT OF SANITARY SEWERS

DES: R.G.
 DRN: R.A.R.
 CKD: A.H.
 DATE: 3-1-91

No.	DATE	REVISIONS
1		
2		
3		
4		
5		

SCALE
 AS SHOWN

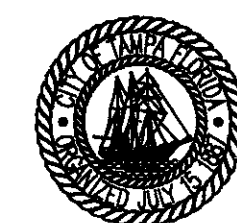

CITY OF TAMPA FLORIDA
 DEPARTMENT OF SANITARY SEWERS
 RENEWAL & REPLACEMENT
 SEWAGE DISPOSAL SYSTEM

4WIP PUMPING STATIONS ENCLOSURE REPLACEMENT
 UNIVERSITY (131ST AVE.)
 PUMPING STATION

DESIGN W.O. 4286
 CONSTRUCTION W.O.


SHEET
 4
 OF 4

304-13

304-13

CITY OF TAMPA

LOCATION MAP

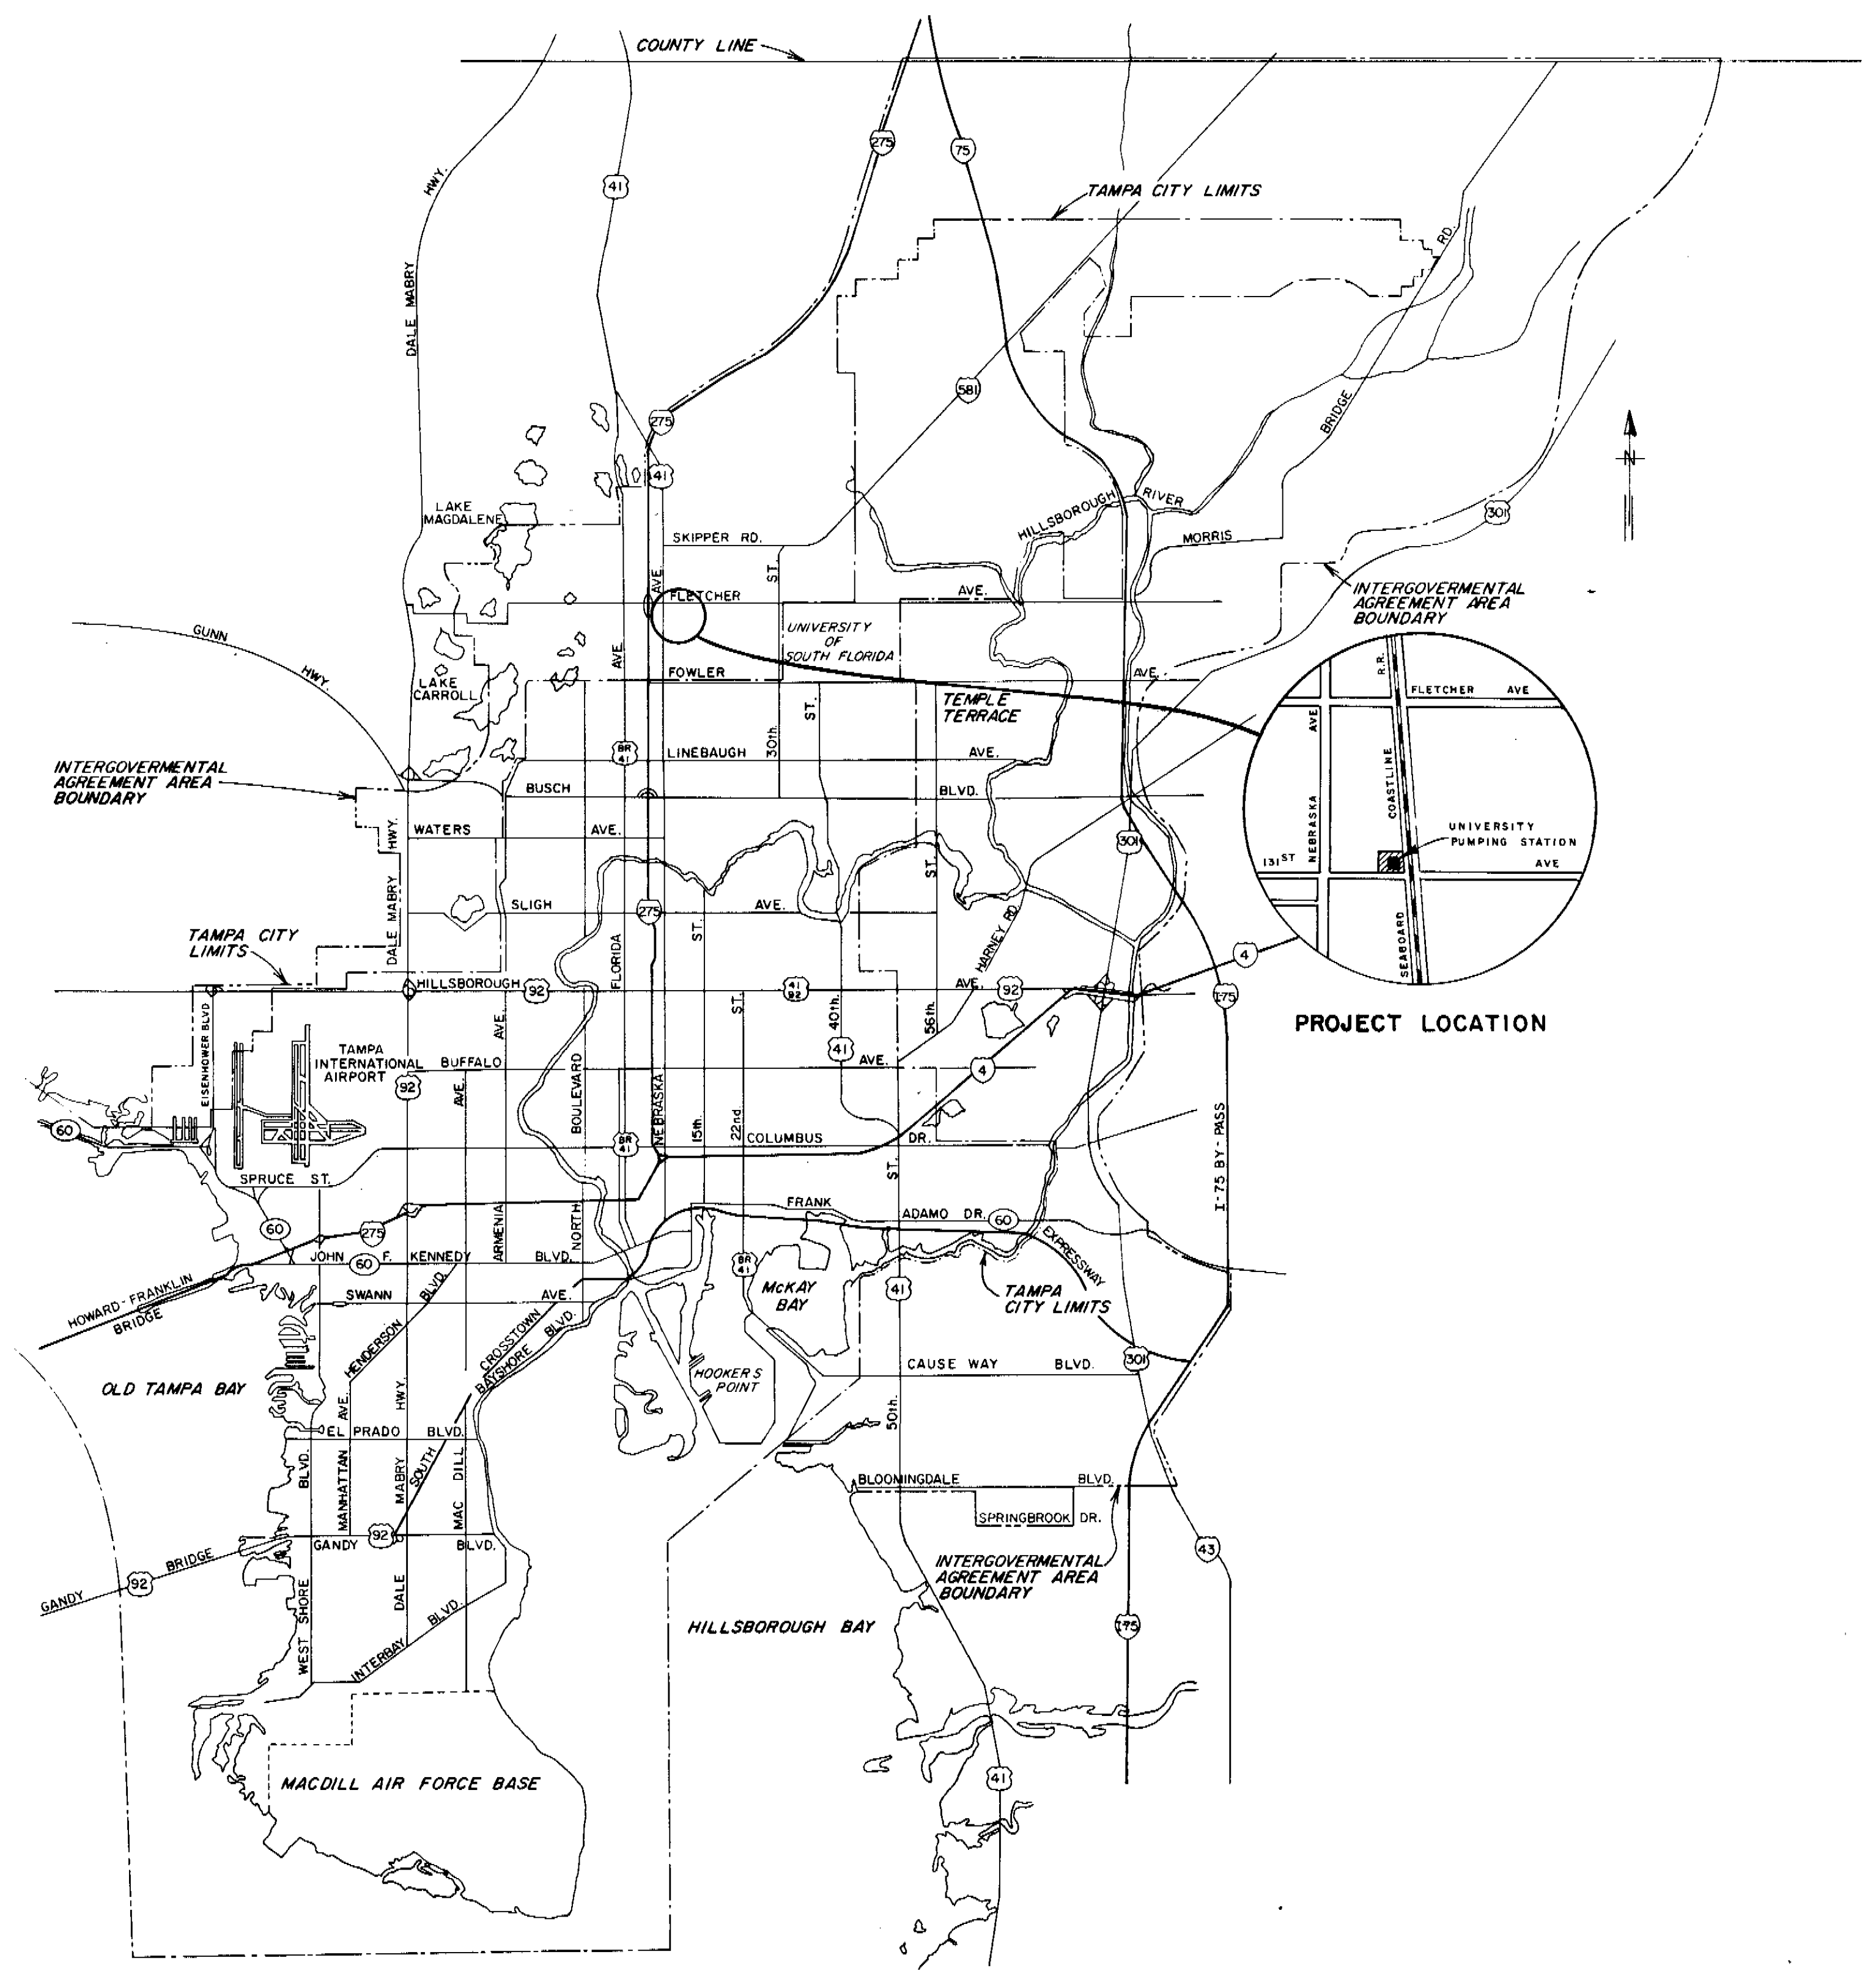


DEPARTMENT of SANITARY SEWERS

PLANS FOR

UNIVERSITY PUMPING STATION PUMP ADDITION

CONTRACT C92

DES: JH DRN: E10/RAR/C9 CKD: A.H. DATE: 11/19/91	APPROVED BY RALPH L. METCALF II, PE DIRECTOR DEPARTMENT of SANITARY SEWERS	NO.	DATE	REVISIONS	SCALE 1" = approximately 1/2 miles	DEPARTMENT of SANITARY SEWERS CITY of TAMPA, FLORIDA RENEWAL & REPLACEMENT SEWAGE DISPOSAL SYSTEM	TITLE SHEET & LOCATION MAP SHEET 1 OF
		1					
		2					
		3					
		4					

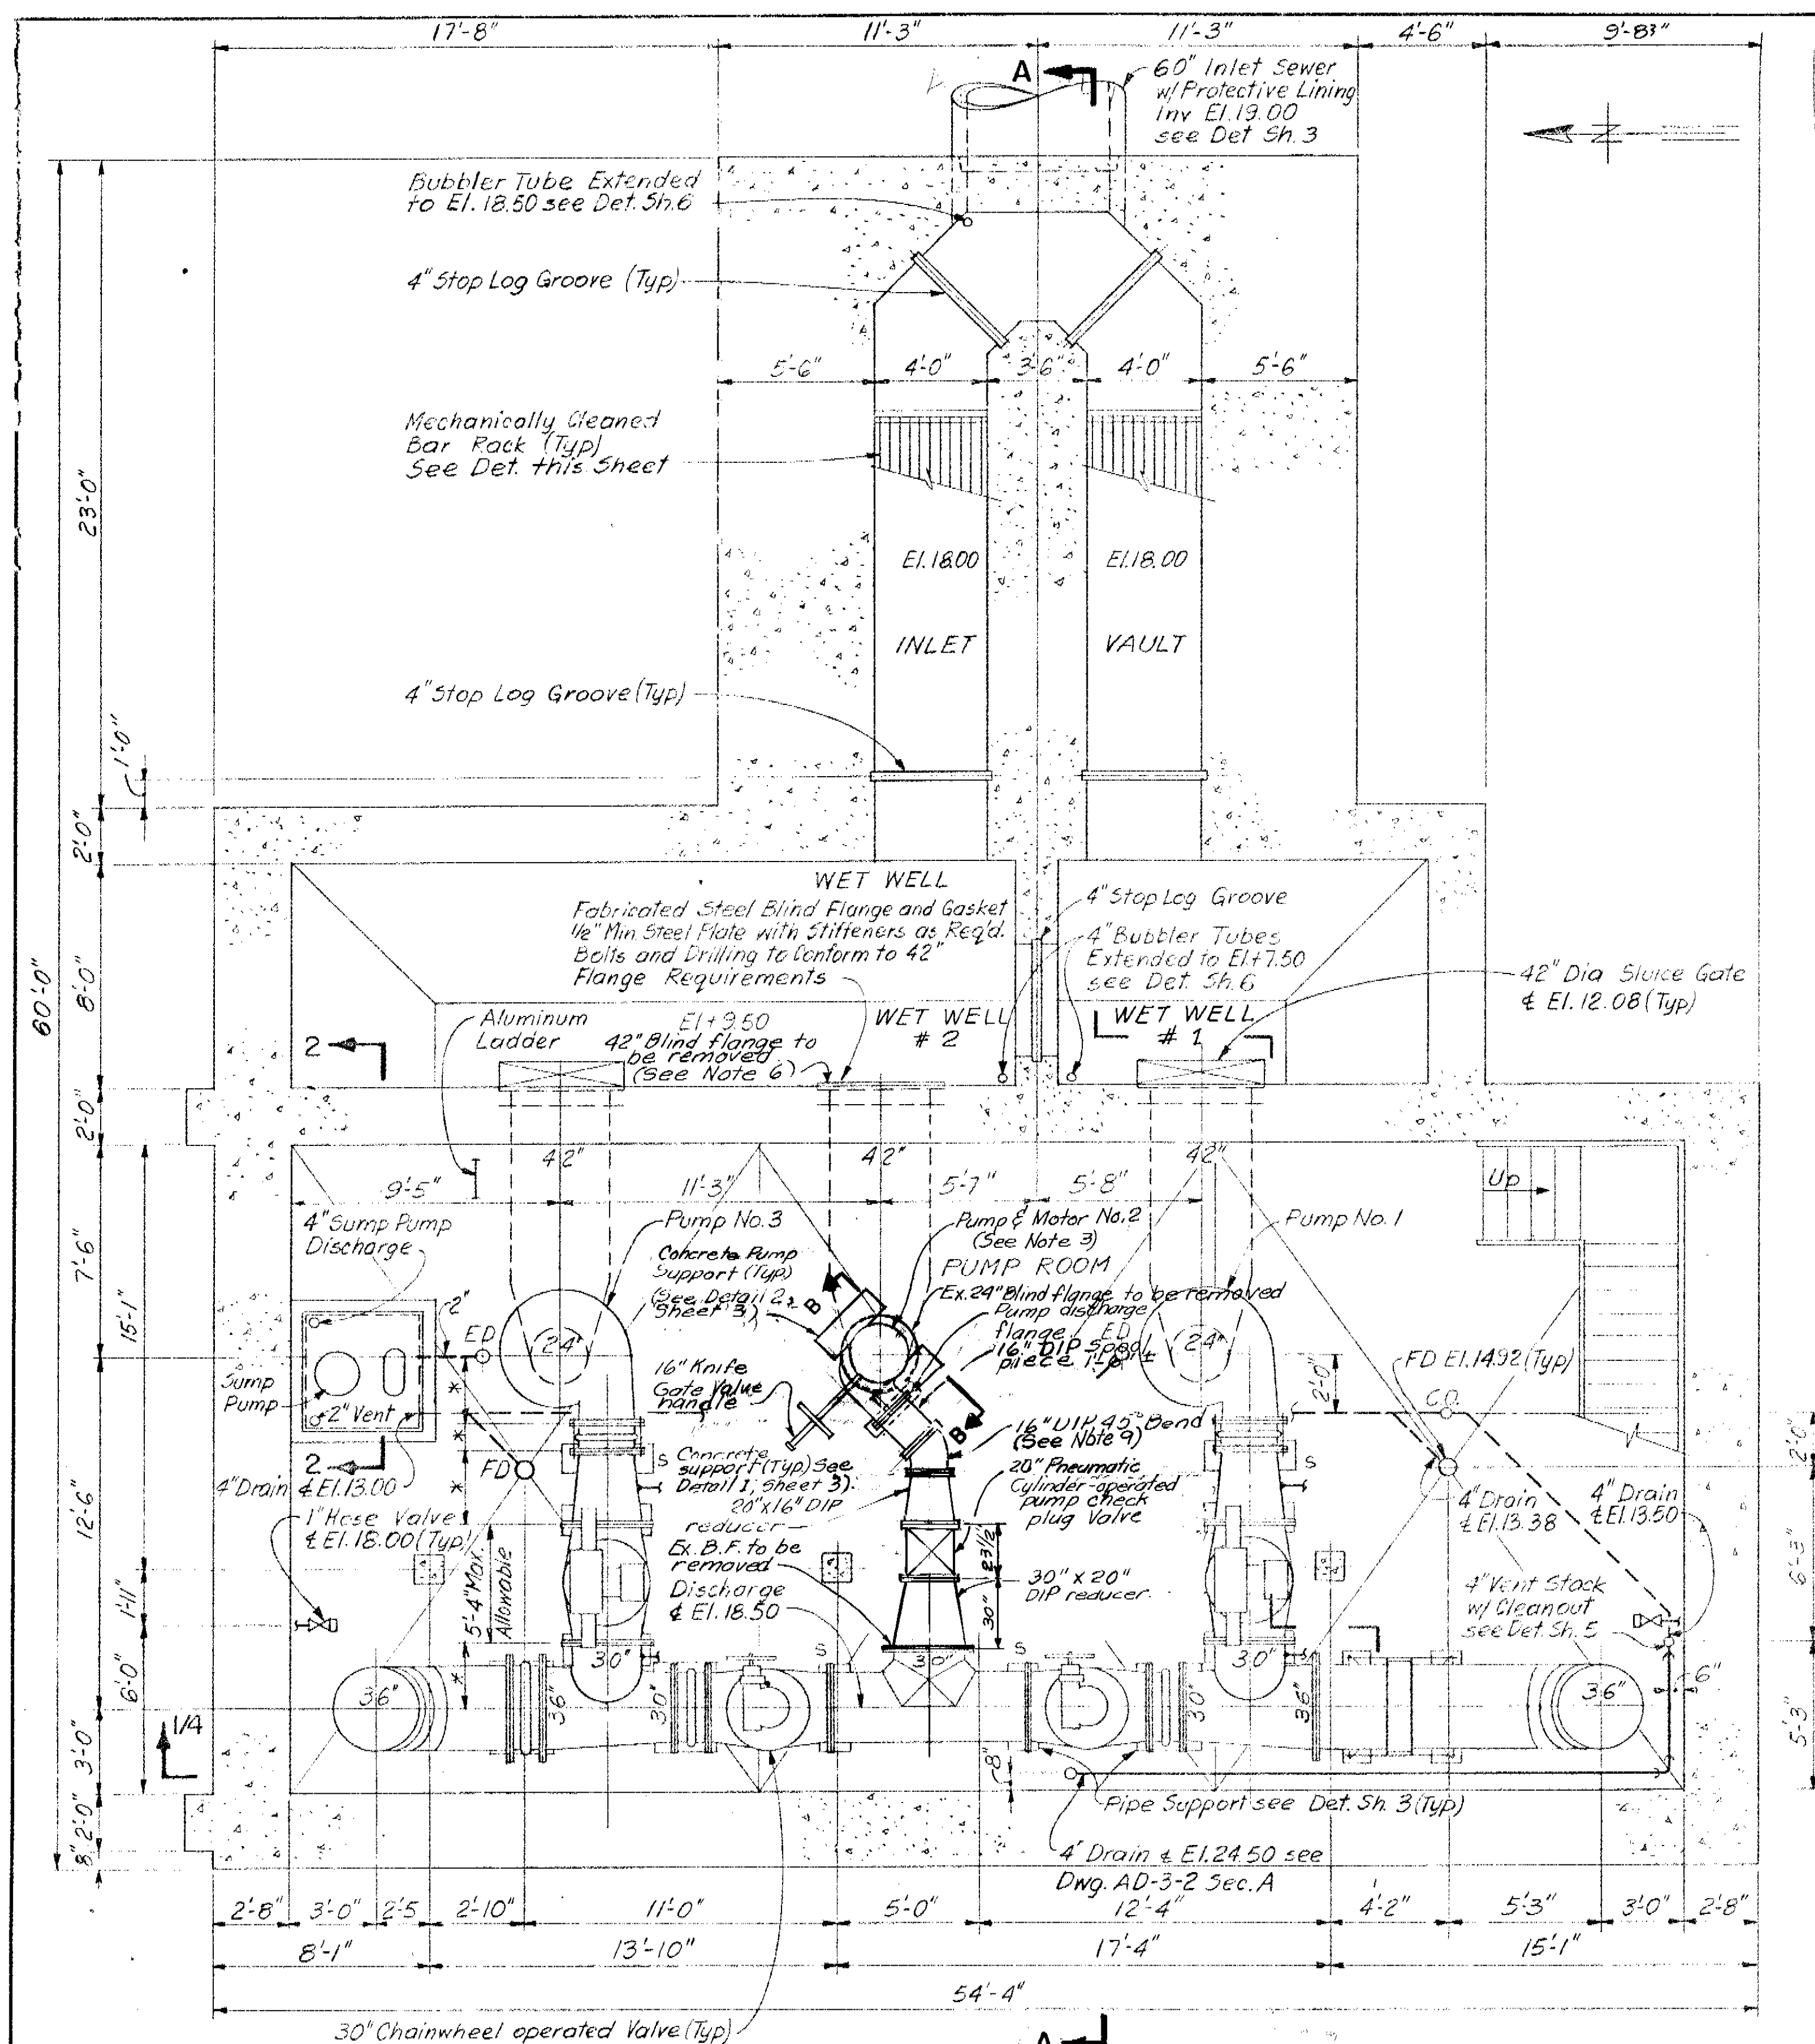

PLAN AT EL 15.00
SCALE: 1/4" = 1'-0"

NOTES

1. The Contractor shall verify all dimensions prior to submittal of piping layout drawings and ordering materials to assure proper fit of piping arrangement.
2. The Contractor is responsible for installing, leveling and aligning Motor and Pump. Procedures for installation, as outlined in the Hydraulic Institute Standards, most current edition, shall be adhered to.
3. Pump shall be 16" Fairbanks Morse Model B5741 or approved equal (See specifications). Pump discharge position shall be placed accordingly to fit the existing piping arrangement. See electrical specifications for Motor information.
4. Anchor bolts shall be submitted after selection of equipment. Anchor bolts shall be double nutted and finished with non-shrink grout.
5. Air supply for Pneumatically operated valves shall be from existing station air. Arrangement of piping and connections to existing pipes shall be made by the contractor under the direction of D.S.S. personnel.
6. The D.S.S. will furnish Stop Logs to be used to divert the flow from Wet Well #2 to Wet Well #1 in order to remove the blind flange from intake No.2. The Contractor shall install and remove the Stop Logs and supply the pump and related equipment and piping for pumping down Wet Well #2. The Contractor shall furnish a temporary bulkhead, Pumping equipment and piping to handle any leakage from the stop logs that may occur.
7. Steel reducer shall be fabricated to suit the dimensions after selection of equipment and shall be A36 with a minimum thickness.
8. Concrete Pedestal shop drawings including flange support details shall be required.
9. The Contractor shall field verify the dimension from the pump suction center line to the discharge piping center line. The 45° bend may need to be fabricated steel to suit the dimensions.

DES: JH
DRN: CP/ce
CKD: A.H.
DATE: 11/19/91

HENRY DORZBACK, PE #36449
CHIEF ENGINEER
DEPARTMENT OF SANITARY SEWERS

APPROVED BY
RALPH L. METCALF II, PE
DIRECTOR
DEPARTMENT OF SANITARY SEWERS


NO.	DATE	REVISIONS
1		
2		
3		
4		
5		

SCALE
AS SHOWN

DEPARTMENT OF SANITARY SEWERS
CITY OF TAMPA, FLORIDA
RENEWAL & REPLACEMENT
SEWAGE DISPOSAL SYSTEM

UNIVERSITY PUMPING STATION PUMP ADDITION
PLAN VIEW

SHEET
2
OF 6

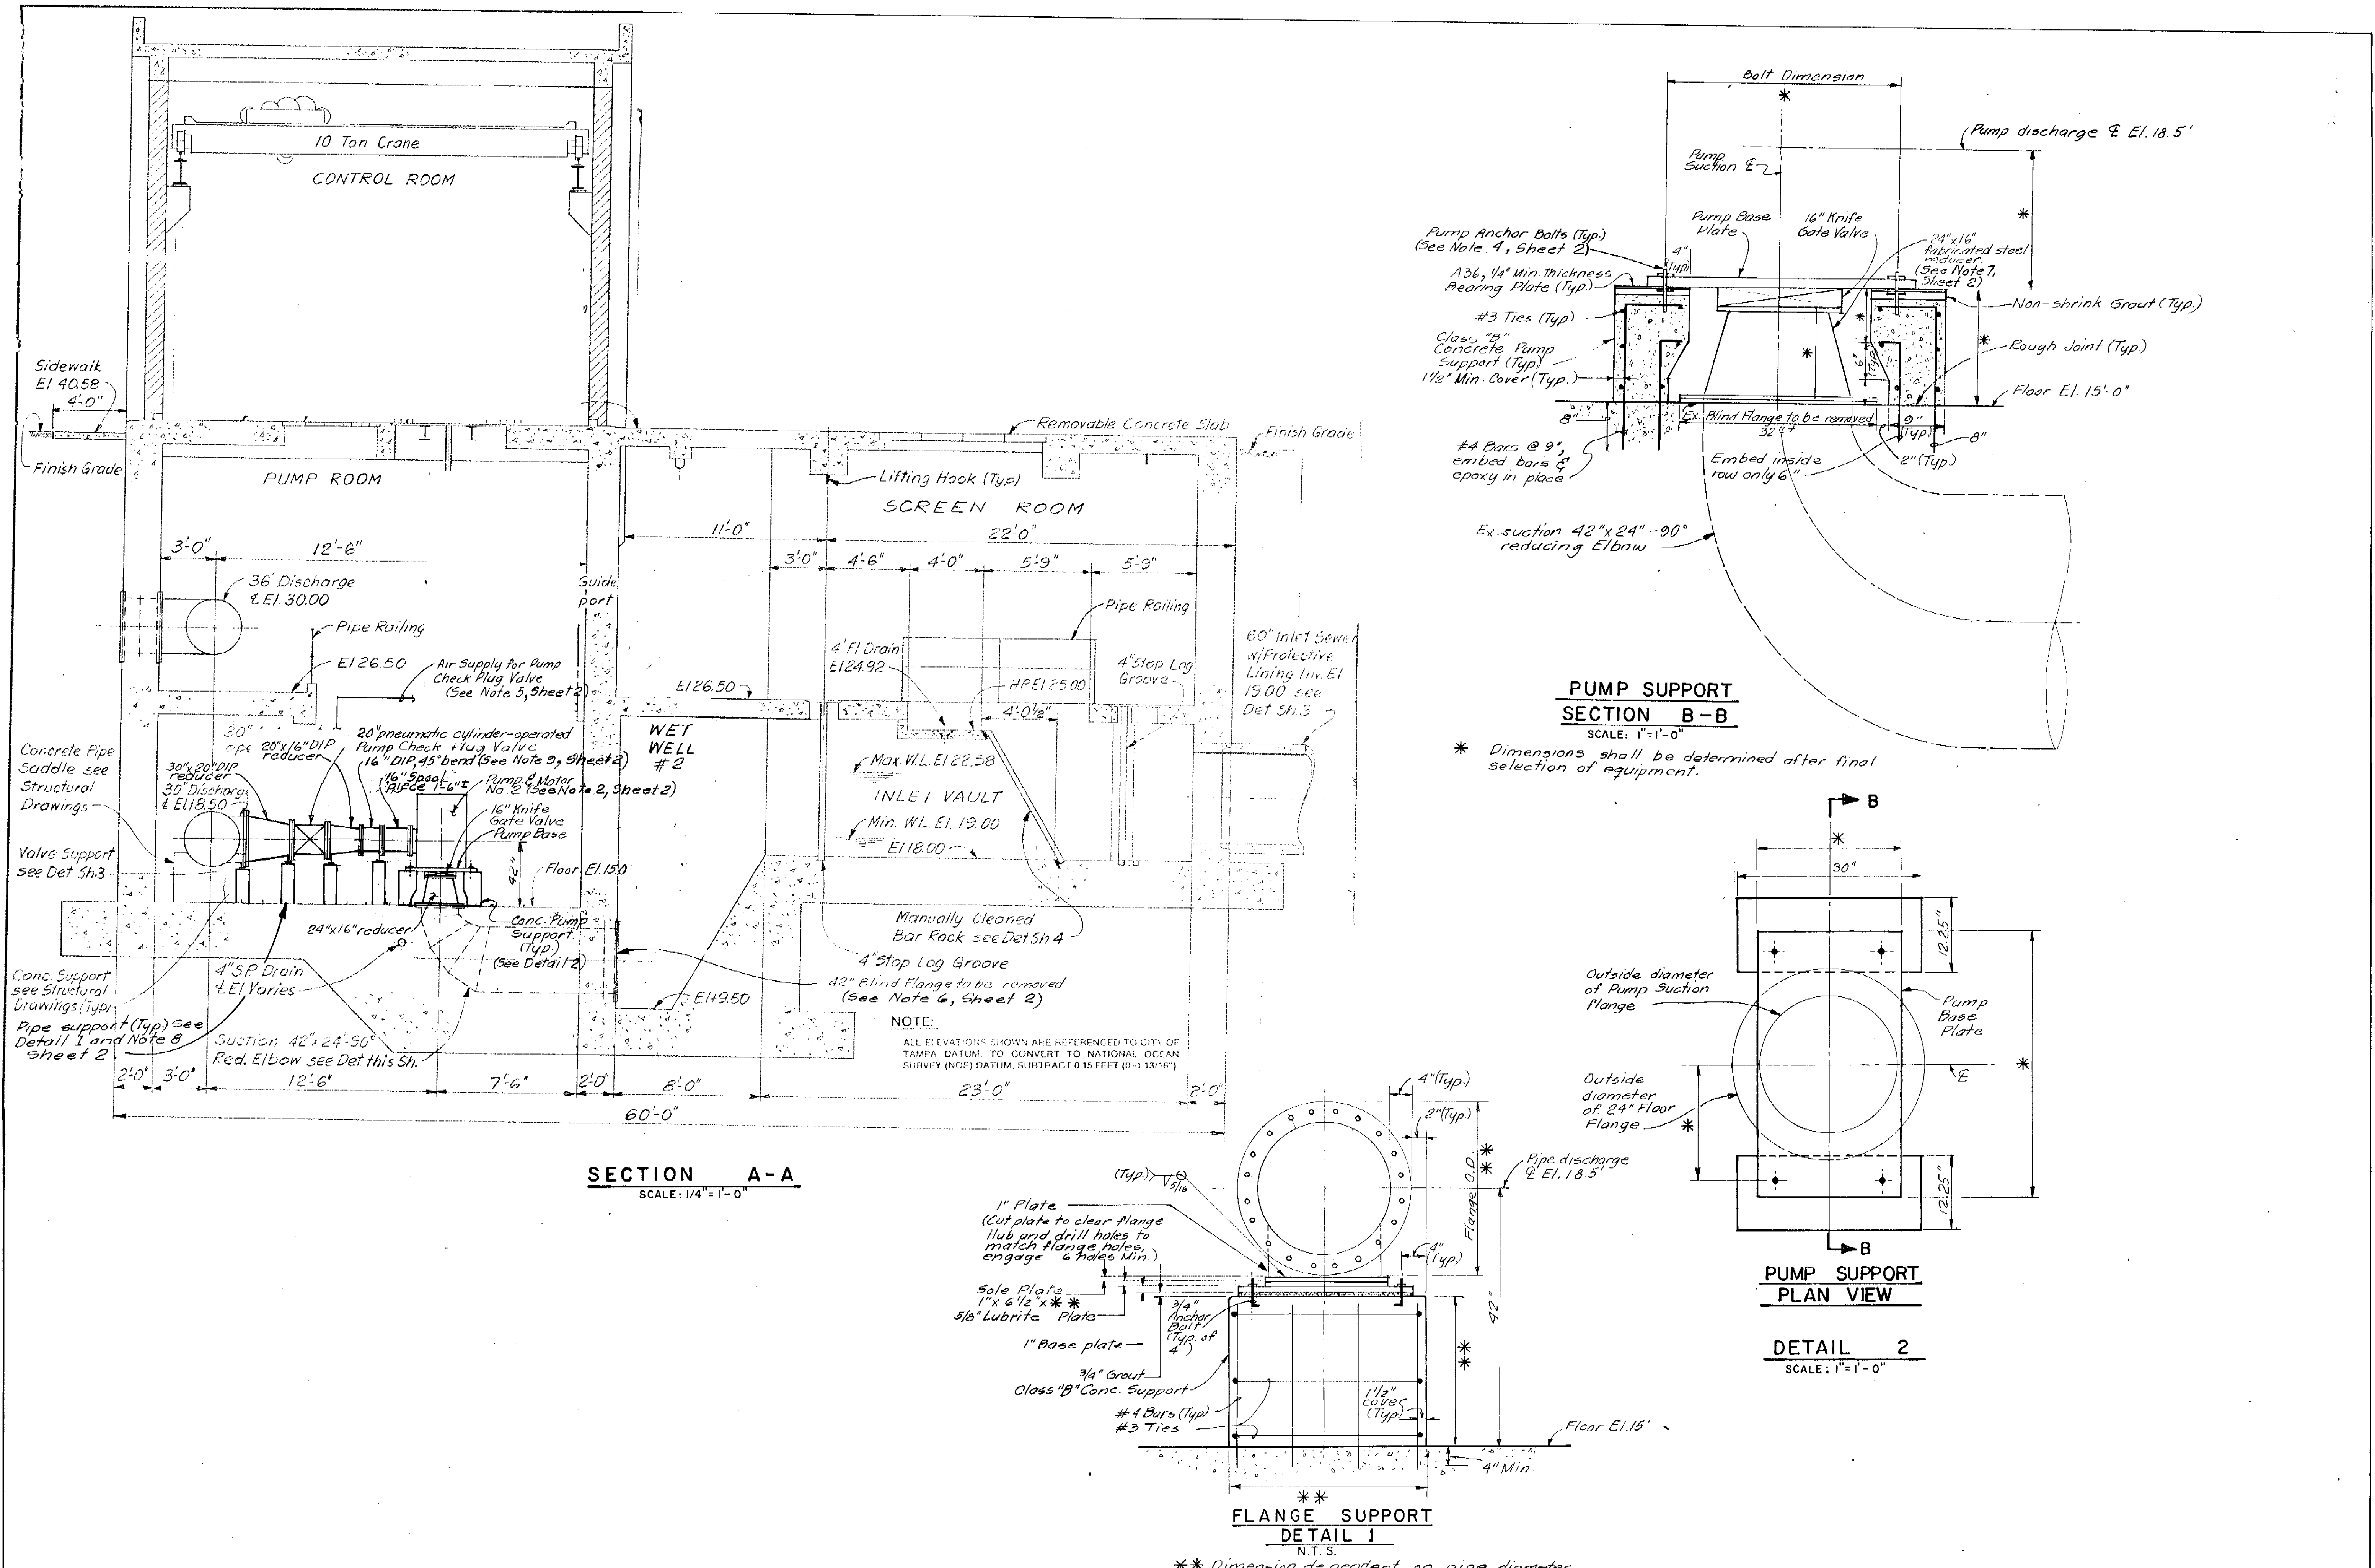

DES: JH
 DRN: CP/ELR
 CKD: R.H.
 DATE: 11/10/01

APPROVED BY
 RALPH L. METCALF II, PE
 DIRECTOR
 DEPARTMENT OF SANITARY SEWERS

NO.	DATE	REVISIONS
1		
2		
3		
4		
5		


SCALE
 AS SHOWN

DEPARTMENT OF SANITARY SEWERS
 CITY OF TAMPA, FLORIDA
 RENEWAL & REPLACEMENT
 SEWAGE DISPOSAL SYSTEM


UNIVERSITY PUMPING STATION
 PUMP ADDITION
 SECTION AND DETAILS

SHIFT
3
 OF 6


173-110-120

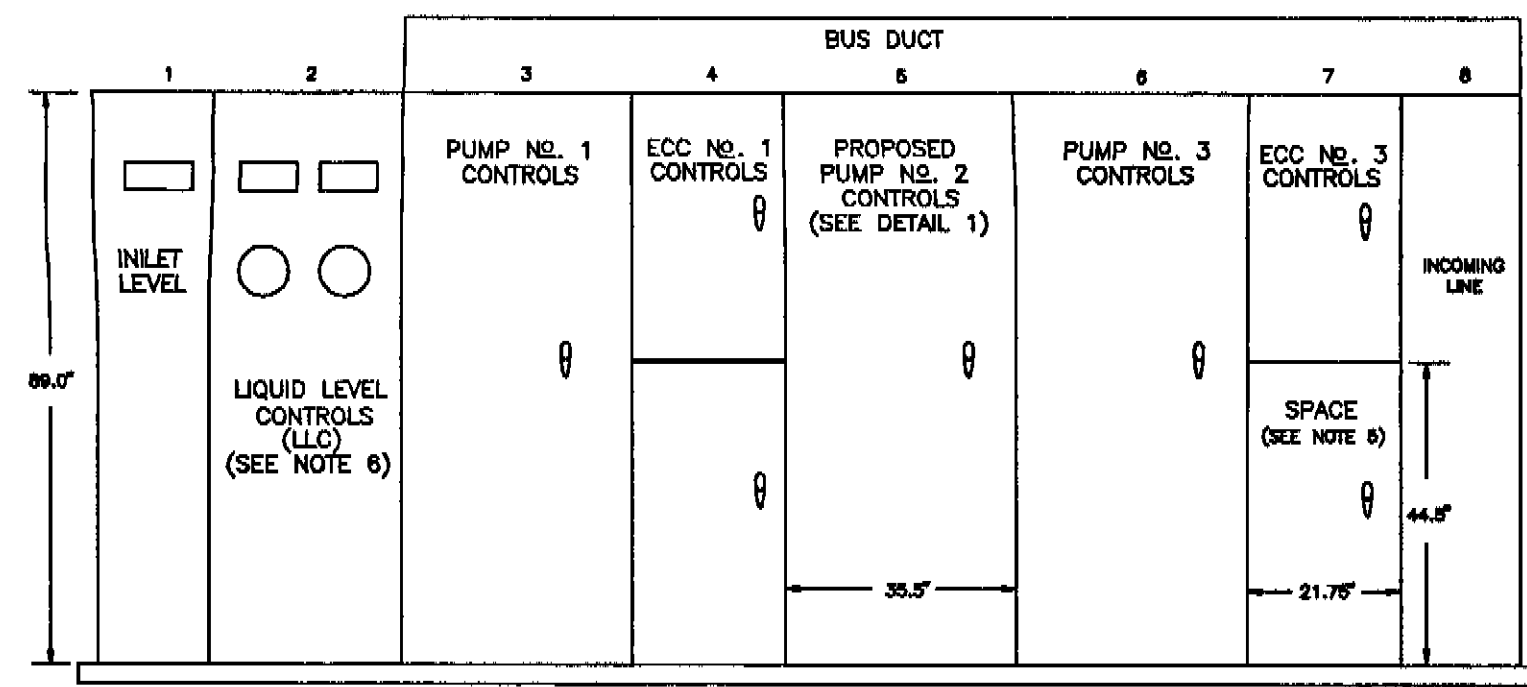


EXISTING SEWAGE PUMPS CONTROL CENTER (FRONT ELEVATION)

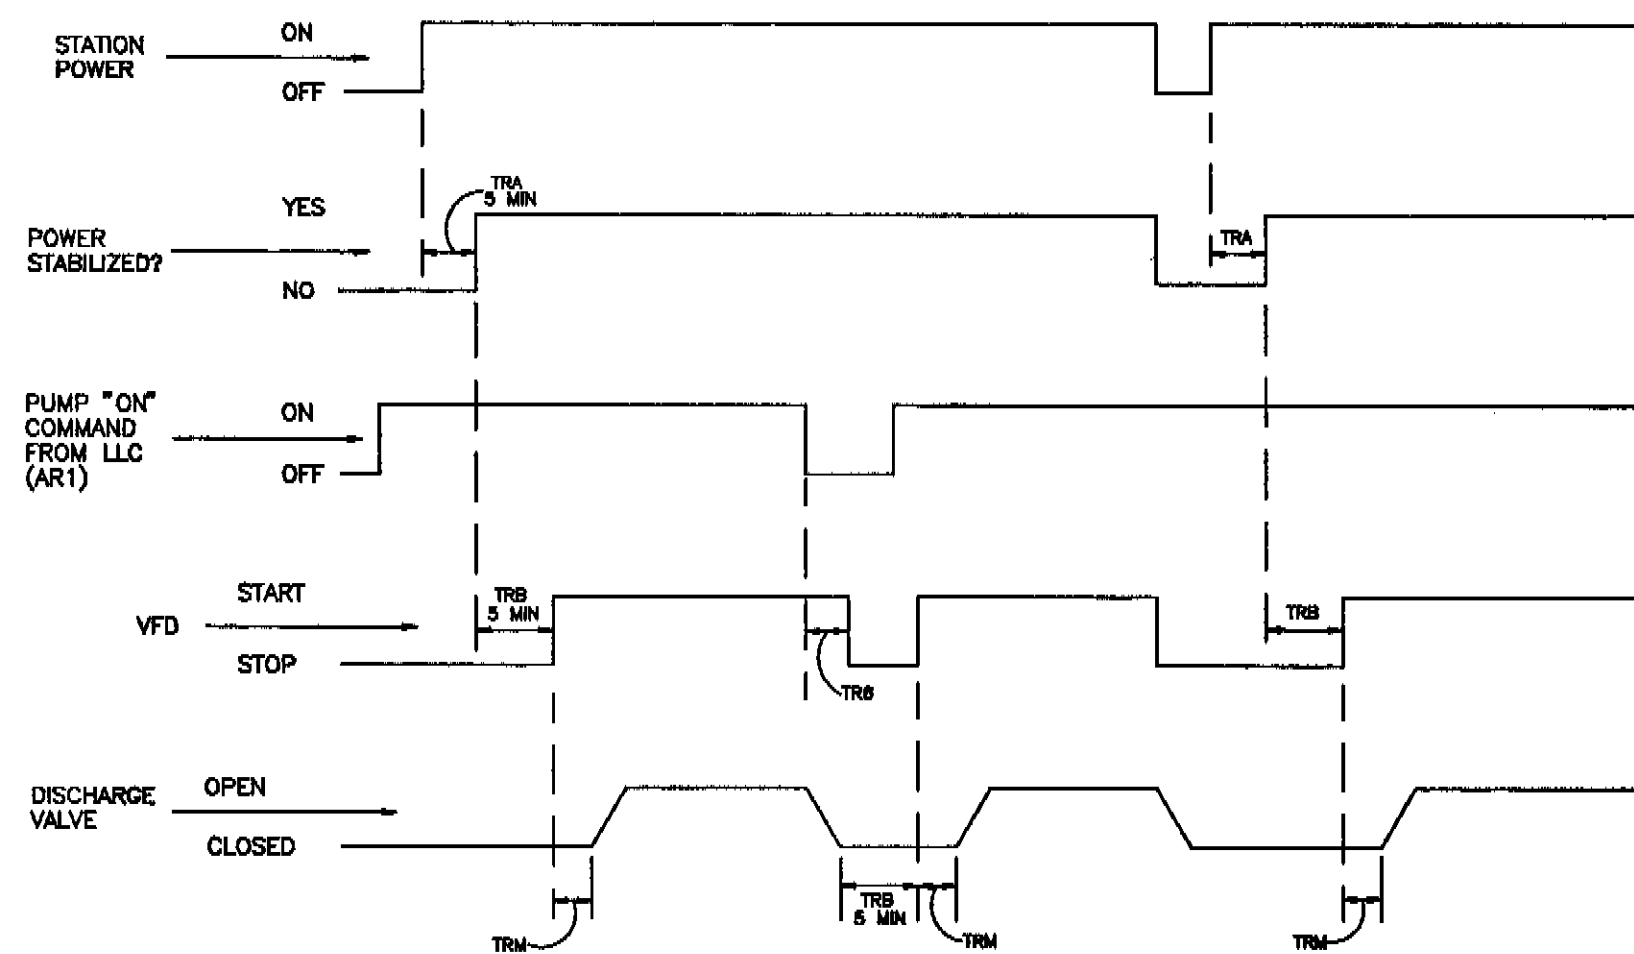

SEWAGE PUMP NO. 2 (TIMING DIAGRAM)

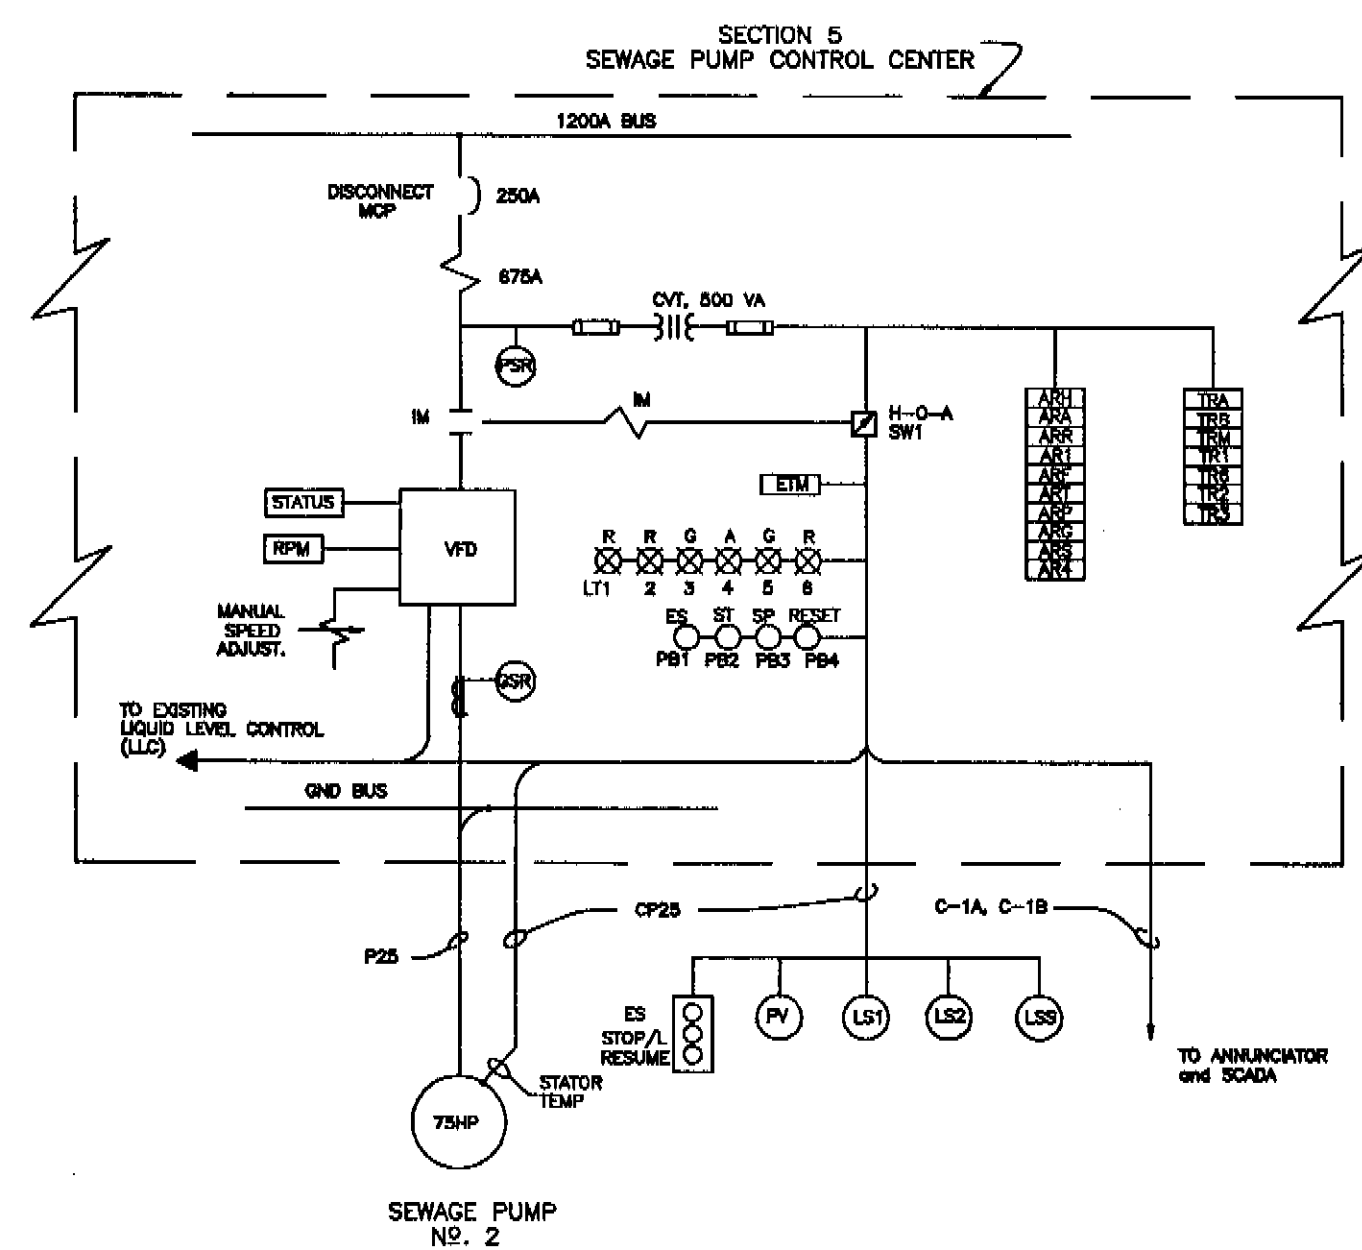

ONE LINE DIAGRAM - PUMP NO. 2 (480V - 3 PHASE - 60HZ)

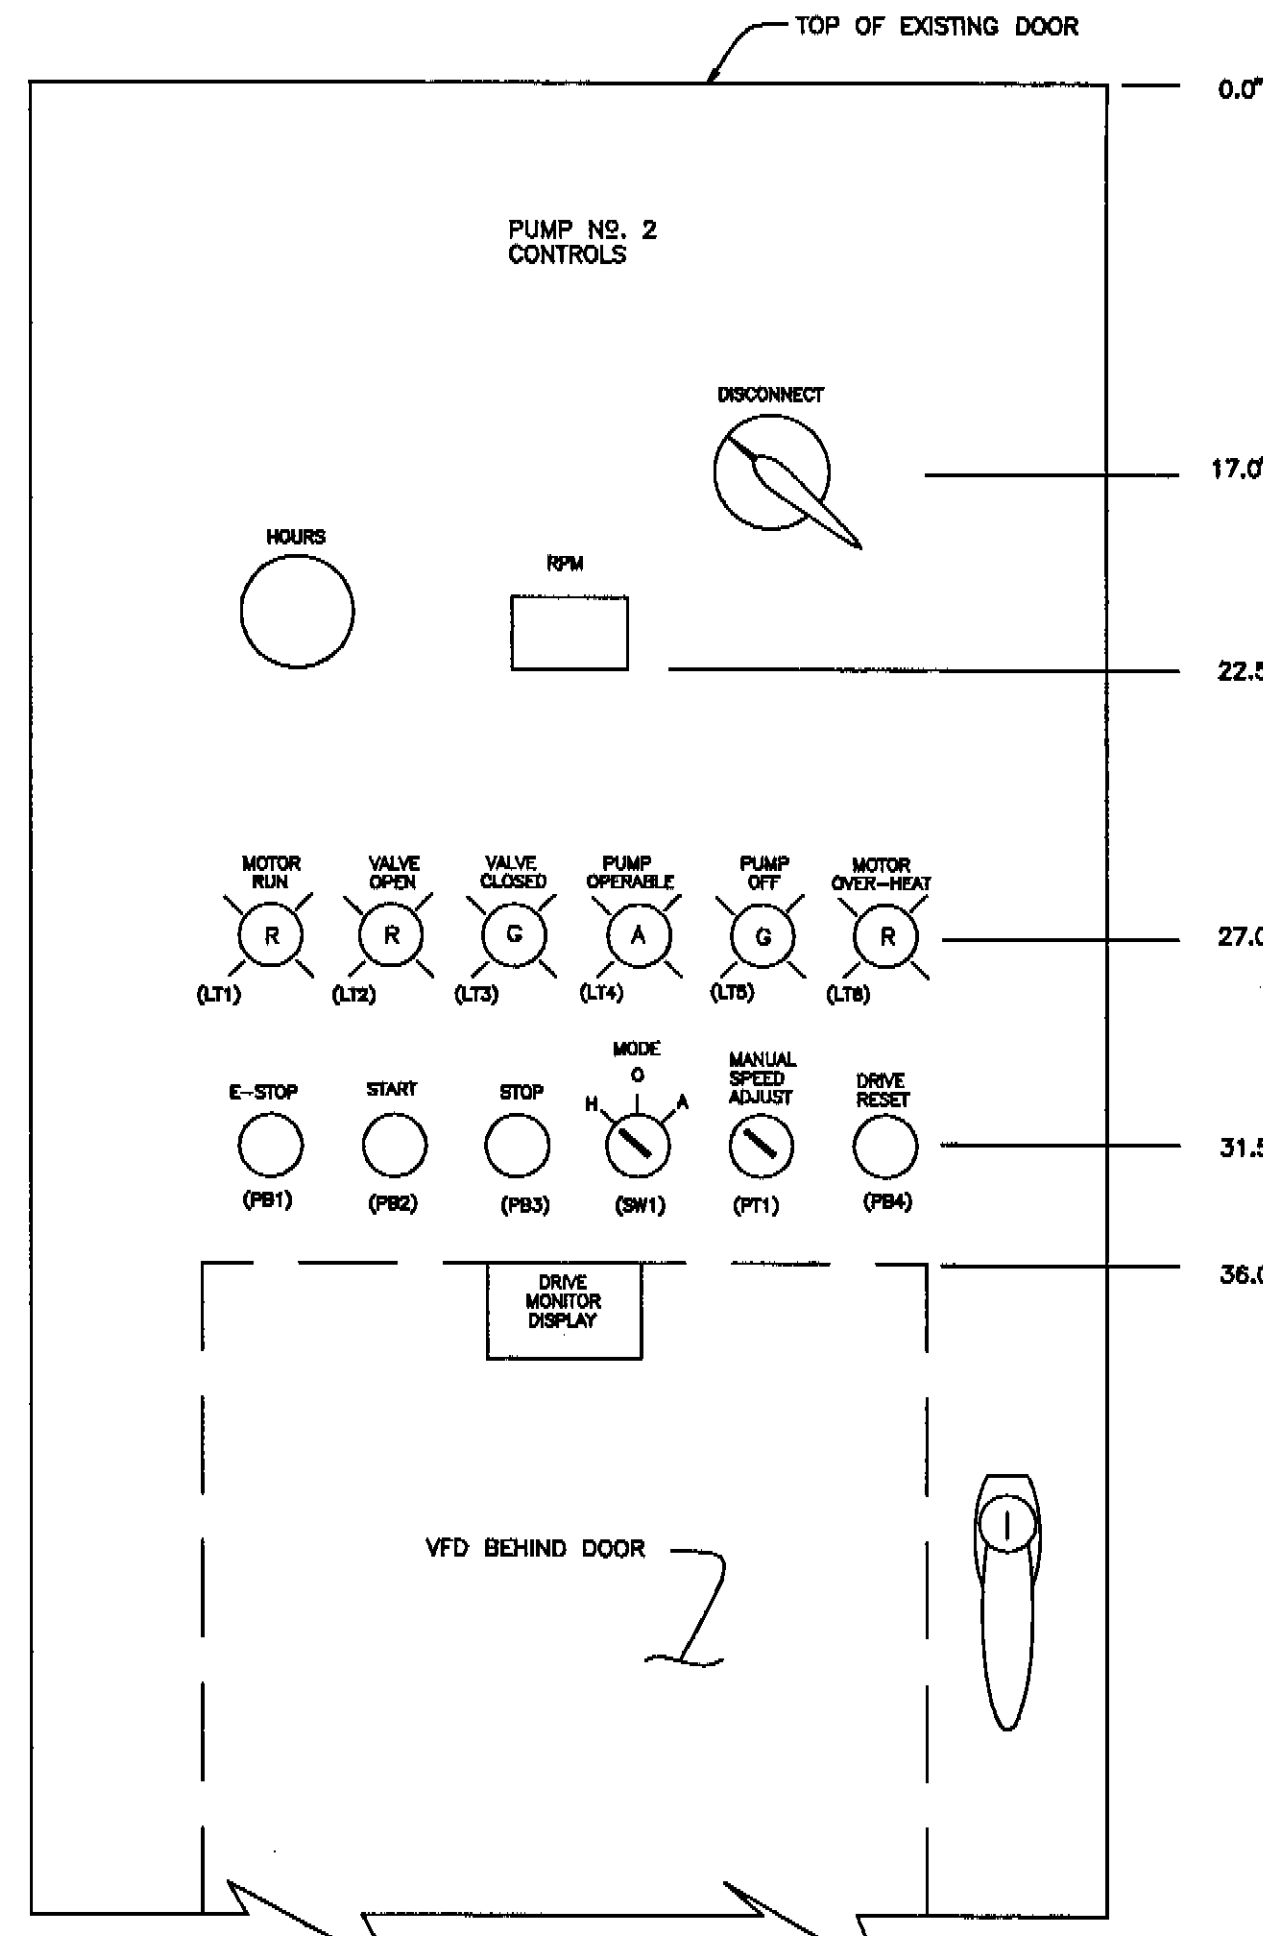

DETAIL 1, PUMP NO. 2 CONTROLS (FRONT DOOR LAYOUT)

PUMP NO. 1 GROUND FAULT	
PUMP NO. 1 DISCHARGE VALVE FAILED TO OPEN	
PUMP NO. 3 GROUND FAULT	
PUMP NO. 3 EXCESSIVE VIBRATION	
PUMP NO. 2 DRIVE FAILURE	PUMP NO. 2 MOTOR STARTER HIGH TEMP
PUMP NO. 2 GROUND FAULT	PUMP NO. 2 DISCHARGE VALVE FAILED TO OPEN

EXISTING ANNUNCIATOR NO. 2 - MODIFICATIONS (SUPPLY AND INSTALL CIRCUITRY AND LEGENDS AS SHOWN)

PARTS SCHEDULE (SCHEMATIC ON SHEET 5)

SYMBOL	DESCRIPTION	MANUFACTURER	MODEL	REMARKS
PSR	3 PHASE POWER SENSE RELAY	TIMEMARK	C263	480V INPUT
MCP	MOTOR CIRCUIT PROTECTOR, WITH DOOR OPERATOR LOCKABLE IN "OFF" POSITION	WESTINGHOUSE	HMCP250C5	250 AMP FRAME 450-500 AMP MAG TRIP, 85KVA @ 480 VAC
VFD	VARIABLE FREQUENCY DRIVE	ALLEN-BRADLEY	1336VT-B100-EDT	VARIABLE TORQUE PWM DRIVE 124 AMP RATING (SEE SPECIFICATIONS)
PT1	MANUAL SPEED POTENTIOMETER 2500 OHM	ALLEN-BRADLEY	BULLETIN 800H UR19	NEMA 4/4X MTG AND GRADUATED MARKING LEGEND LABELED - "SPEED"
RPM	UNIVERSAL DIGITAL INDICATOR	ACTION INSTRUMENTS	V508	3/4 DIGIT, AC POWERED
SC1 SC2	SIGNAL CONVERTER	MOORE INDUSTRIES	SC1	FULL ISOLATION, AC POWERED W/ INPUTS / OUTPUTS AS REQ'D
IM	ISOLATION CONTRACTOR 3 POLE	ALLEN-BRADLEY	BULLETIN 100-B180ND3	180 AMP RATING IEC CONTRACTOR
GSR	GROUND FAULT DETECTION	ALLEN-BRADLEY	BULLETIN 1409-EOB0 RELAY and 1409-N2 SENSOR	460 V, 124 AMP FULL LOAD MAXIMUM, W/ HIGH CURRENT INHIBIT
CVT	CONTROL VOLTAGE TRANSFORMER	SQUARE D	CLASS 6070 #K500D1	600 V, 240/480-120V
CR 1, 4, 5, 6, 99, 100	CONTROL RELAYS	ALLEN-BRADLEY	BULLETIN 700 TYPE F #700-F220A1	IEC, 600V MAX CONTACTS AS REQ'D
TR 1, 2, 3, 99, 100	TIMING RELAY "ON-DELAY"	AMERACE CORP.	AGASTAT 701*	*TIMING RANGE and INSTANT TRANSFER SWITCH AS SHOWN OR REQ'D
TR 6	TIMING RELAY "OFF-DELAY"	AMERACE CORP.	AGASTAT 702*	*TIMING RANGE AS SHOWN OR REQ'D
SW1	THREE POSITION SWITCH	ALLEN-BRADLEY	BULLETIN 800T #800T-J2A	LEGEND: MODE, HAND-OFF-AUTO
PB1	RED MUSHROOM HEAD PUSHBUTTON	ALLEN-BRADLEY	BULLETIN 800T #800T-D8A	LEGEND: EMERG, STOP
PB2 PB4	BLACK FLUSH HEAD PUSHBUTTON	ALLEN-BRADLEY	BULLETIN 800T #800T-AB2	LEGEND: START & RESET
PB3	RED EXTENDED HEAD PUSHBUTTON	ALLEN-BRADLEY	BULLETIN 800T #800T-B8A	LEGEND: STOP
LT-1, 2, 6	RED PUSH-TO-TEST PILOT LIGHT	ALLEN-BRADLEY	BULLETIN 800T #800T-P116R	TRANSFORMER TYPE, 120V
LT-3, 5	GREEN PUSH-TO-TEST PILOT LIGHT	ALLEN-BRADLEY	BULLETIN 800T #800T-P116G	TRANSFORMER TYPE, 120V
LT-4	AMBER PUSH-TO-TEST PILOT LIGHT	ALLEN-BRADLEY	BULLETIN 800T #800T-P115A	TRANSFORMER TYPE, 120V
□	TERMINAL BLOCK	ALLEN-BRADLEY	BULLETIN 1492-H2K024 1492-CA2	LOW VOLTAGE SUPPRESSOR TYPE STANDARD TERMINAL BLOCKS

NOTES

- EXISTING FACILITIES ARE EITHER MARKED "EXISTING" OR ARE PRESENTED AS SCREENED LINES (LOWER CONTRAST). ITEMS INCLUDED IN THIS CONTRACT ARE IN BOLD LINE.
- ALL ELECTRICAL WORK SHALL BE PERFORMED PER THE 1990 NATIONAL ELECTRICAL CODE (NEC) AND CHAPTER 5 OF THE CITY CODE.
- ALL ELECTRICAL COMPONENTS AND SYSTEMS UTILIZED SHALL BE LISTED AND LABELED BY UL OR AN EQUIVALENT TESTING LABORATORY - WHERE APPLICABLE.
- SECTION 5 OF THE EXISTING SEWAGE PUMPS CONTROL CENTER SHALL BE MODIFIED AS SHOWN TO HOUSE THE CONTROLS AND VARIABLE FREQUENCY DRIVE (VFD) FOR THE PROPOSED SEWAGE PUMP NO. 2. THE INSIDE DIMENSIONS ARE 81"X24"X27".
- THE LOWER HALF OF SECTION 7 OF THE SEWAGE PUMPS CONTROL CENTER MAY BE USED TO HOUSE ADDITIONAL PUMP NO. 2 CONTROLS, IF NECESSARY.
- THE ROBICON CORP. LIQUID LEVEL CONTROLS (LLC) IN SECTION 2 OF THE SEWAGE PUMPS CONTROL CENTER SHALL BE MODIFIED TO FACILITATE PUMP NO. 2 CONTROL. A "VARIABLE SPEED BOARD" AND AN "ON - OFF BOARD" SHALL BE PROVIDED AND INSTALLED BY THE CONTRACTOR.
- THE EXISTING ANNUNCIATOR NO. 2 SHALL BE MODIFIED AS SHOWN. EXISTING CONDUITS C-1A AND C-1B AND ANY SPARE CONDUITS THEREIN MAY BE UTILIZED TO MECHANIZE THIS DESIGN.
- EXISTING CONDUIT SLEEVES THROUGH THE FLOOR OF THE SEWAGE PUMPS CONTROL CENTER SHALL BE UTILIZED IN THE P25 AND CP25 MECHANIZATION. CORE DRILL THE INTERMEDIATE FLOOR, AS REQUIRED, TO TERMINATE CONDUITS AT PUMP ROOM ELEVATION.
- DYNAMICALLY BALANCE THE PUMP SYSTEM TO MEET INDUSTRY STANDARD GUIDE LINES. ENSURE THAT THE NATURAL FREQUENCY OF THE PUMP SYSTEM IS NOT WITHIN 25% OF THE POSSIBLE OPERATING SPEEDS.

CONDUIT AND CONDUCTOR SCHEDULE

CONDUIT NUMBER	SIZE	CONDUCTOR QUANTITY and SIZE	FROM	TO	REMARKS
P25	2	3 - 1/0 1 - #4 GND	PUMP CONTROL CENTER, SECTION 5	T.B. AT PUMP NO. 2 MOTOR	POWER LEADS
CP25	1	26 - #14 2 - #12 GND	PUMP CONTROL CENTER, SECTION 5	T.B. AT PUMP NO. 2 MOTOR	MOTOR and DISCHARGE VALVE CONTROL WIRING
C1A OF C1B	EXIST'G	(ADDITIONAL) 20 - #14 1 - 2C. SHLD	PUMP CONTROL CENTER, SECTION 7	METERING and SCADA PANEL	ANNUNCIATOR/ RTU WIRING
		2 - 2C. SHLD 2 - #14	PUMP CONTROL CENTER, SECTION 2	PUMP CONTROL CENTER, SECTION 5	LEVEL CONTROLS

LEGEND

- DISCONNECTING DEVICE
- MOTOR CIRCUIT PROTECTOR (30 AMPERE CONTINUOUS RATING, 180 AMPERE MAGNETIC TRIP SETTING)
- CONTROL POWER TRANSFORMER
- FUSE
- NORMALLY OPEN CONTACT
- NORMALLY CLOSED CONTACT
- MOTOR STARTER COIL
- MOTOR THERMAL OVERLOAD
- PILOT LIGHT (RED LENS)
- TERMINAL STRIP
- HOUR METER
- STOP PUSHBUTTON WITH PROVISIONS FOR PADLOCK
- 3 POSITION SELECTION SWITCH
- LIMIT SWITCH, NORMALLY OPEN
- LIMIT SWITCH, NORMALLY CLOSED
- PRESSURE SWITCH, NORMALLY OPEN
- 3 PHASE MOTOR
- MOUNTED NEAR EQUIPMENT OR MOTOR (LOCAL)
- NEUTRAL
- PUSHBUTTON WITH PROVISIONS FOR LOCK. (N.O.)
- N.C. PUSHBUTTON
- LOCAL CONTROL STATION ES - EMERGENCY STOP
- GROUND SENSE RELAY
- TWISTED PAIR SHIELDED CABLE
- NORMALLY CLOSED "ON DELAY" TIMING RELAY
- NORMALLY OPEN "ON DELAY" TIMING RELAY
- INSTANT CLOSE - DELAY OPEN TIMING RELAY (OFF DELAY)
- INSTANT OPEN - DELAY CLOSE TIMING RELAY (OFF DELAY)


ROMAN D. KORCHAK, P.E. #42626
ELECTRICAL SECTION HEAD
DEPARTMENT OF SANITARY SEWERS

HENRY DORZBACK, P.E.
CHIEF ENGINEER
DEPARTMENT OF SANITARY SEWERS

RALPH L. METCALF II, P.E.
DIRECTOR
DEPARTMENT OF SANITARY SEWERS

DES:	DRN:	CKD:	DATE:	No.	DATE	REVISIONS
RK	CS			1		
				2		
				3		
				4		
				5		

NO SCALE

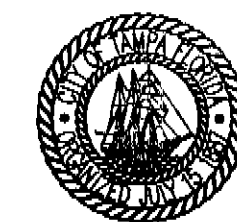



CITY OF TAMPA FLORIDA
DEPARTMENT OF SANITARY SEWERS
RENEWAL & REPLACEMENT
SEWAGE DISPOSAL SYSTEM

UNIVERSITY PUMPING STATION PUMP ADDITION

ELECTRICAL

DESIGN W.O. 4297
CONSTRUCTION W.O.

SHEET
4

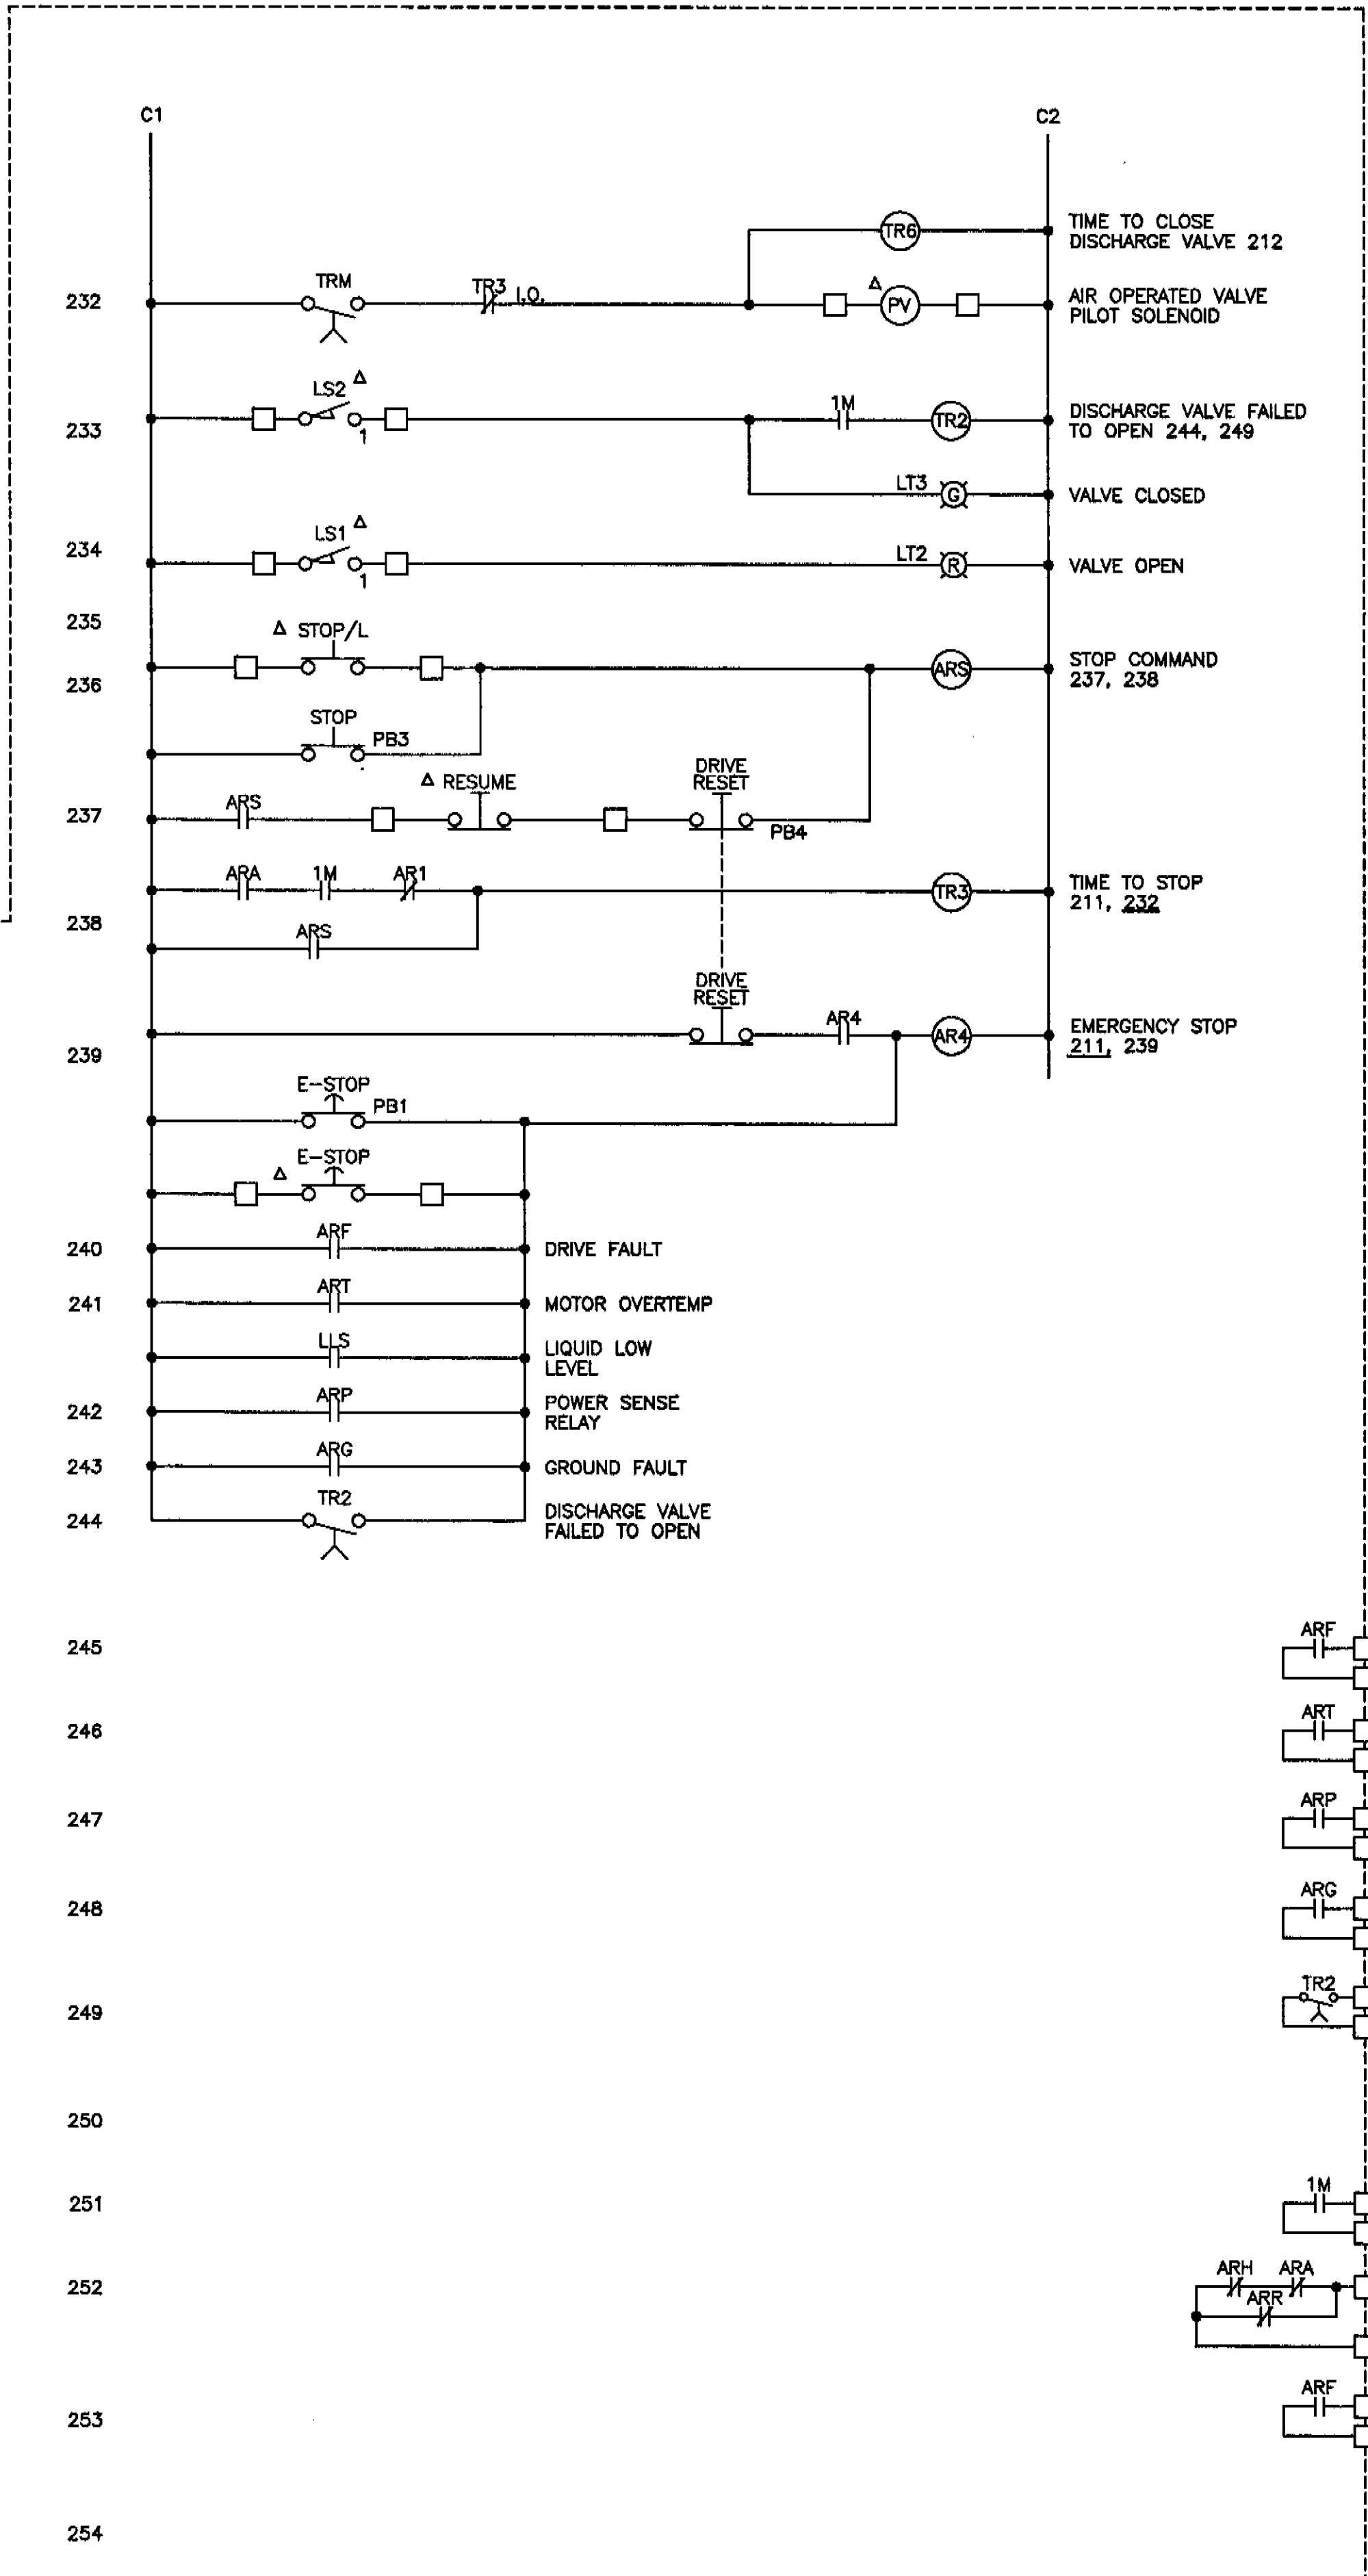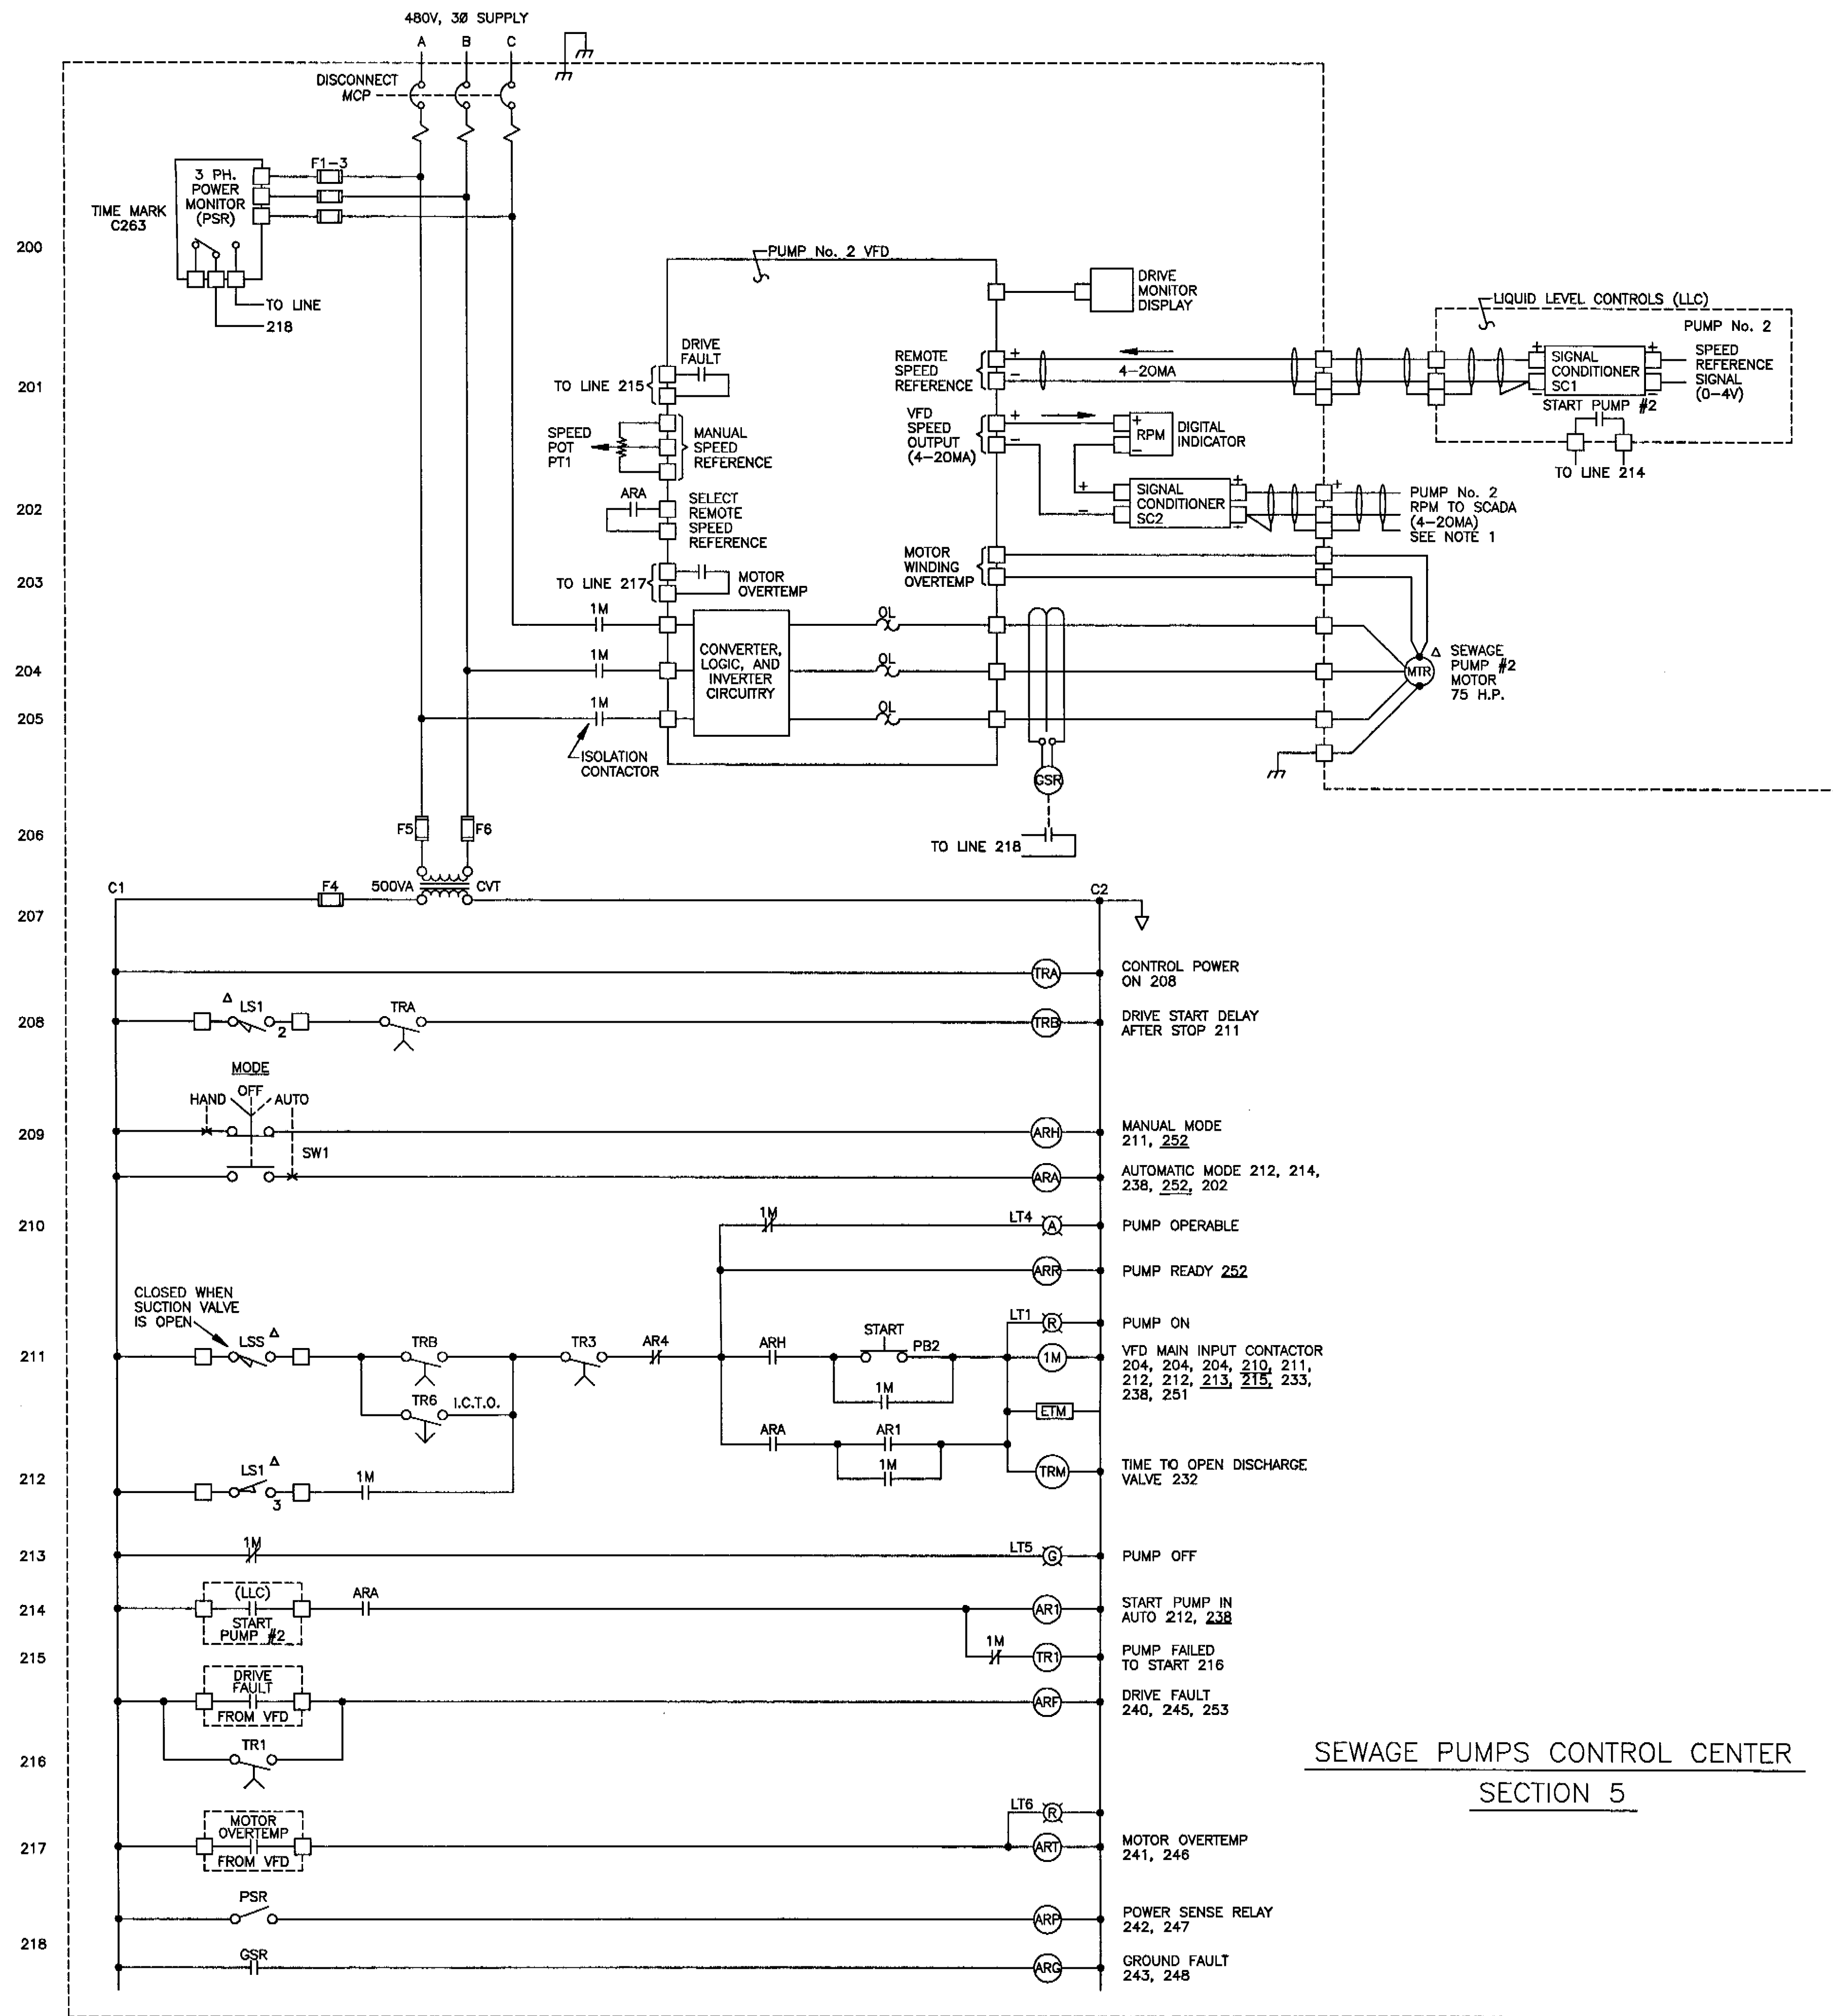

LS	CONTACT	DISCHARGE VALVE POSITION		
		FULLY CLOSED	INTERMED POSITION	FULLY OPEN
LS1	1		X	X
	2	X		
	3		X	X
	4	X		
LS2	1	X	X	
	2			X
	3	X	X	
	4			X

NOTE
 1. CONTRACTOR TO SUPPLY AND INSTALL CONDUITS AND CONDUCTORS TO THE EXISTING SCADA R.T.U. THE CITY'S INSTRUMENTATION SECTION IS TO MAKE THE FINAL R.T.U. CONNECTIONS.

SEWAGE PUMPS CONTROL CENTER
SECTION 5

ROMAN D. KORCHAK, P.E. #42626
ELECTRICAL SECTION HEAD
DEPARTMENT OF SANITARY SEWERS

HENRY DORZBACK, P.E.
CHIEF ENGINEER
DEPARTMENT OF SANITARY SEWERS

RALPH L. METCALF II, P.E.
DIRECTOR
DEPARTMENT OF SANITARY SEWERS

No.	DATE	REVISIONS
1		
2		
3		
4		
5		

DES: R.K.
 DRN: R.A.R.
 CKD:
 DATE:


SCALE
NO SCALE

CITY OF TAMPA FLORIDA
DEPARTMENT OF SANITARY SEWERS
RENEWAL & REPLACEMENT
SEWAGE DISPOSAL SYSTEM



UNIVERSITY PUMPING STATION PUMP ADDITION
PUMP No. 2 SCHEMATIC
CONTROL DIAGRAM

DESIGN W.O. 4297
CONSTRUCTION W.O.

SHEET
5
OF 6

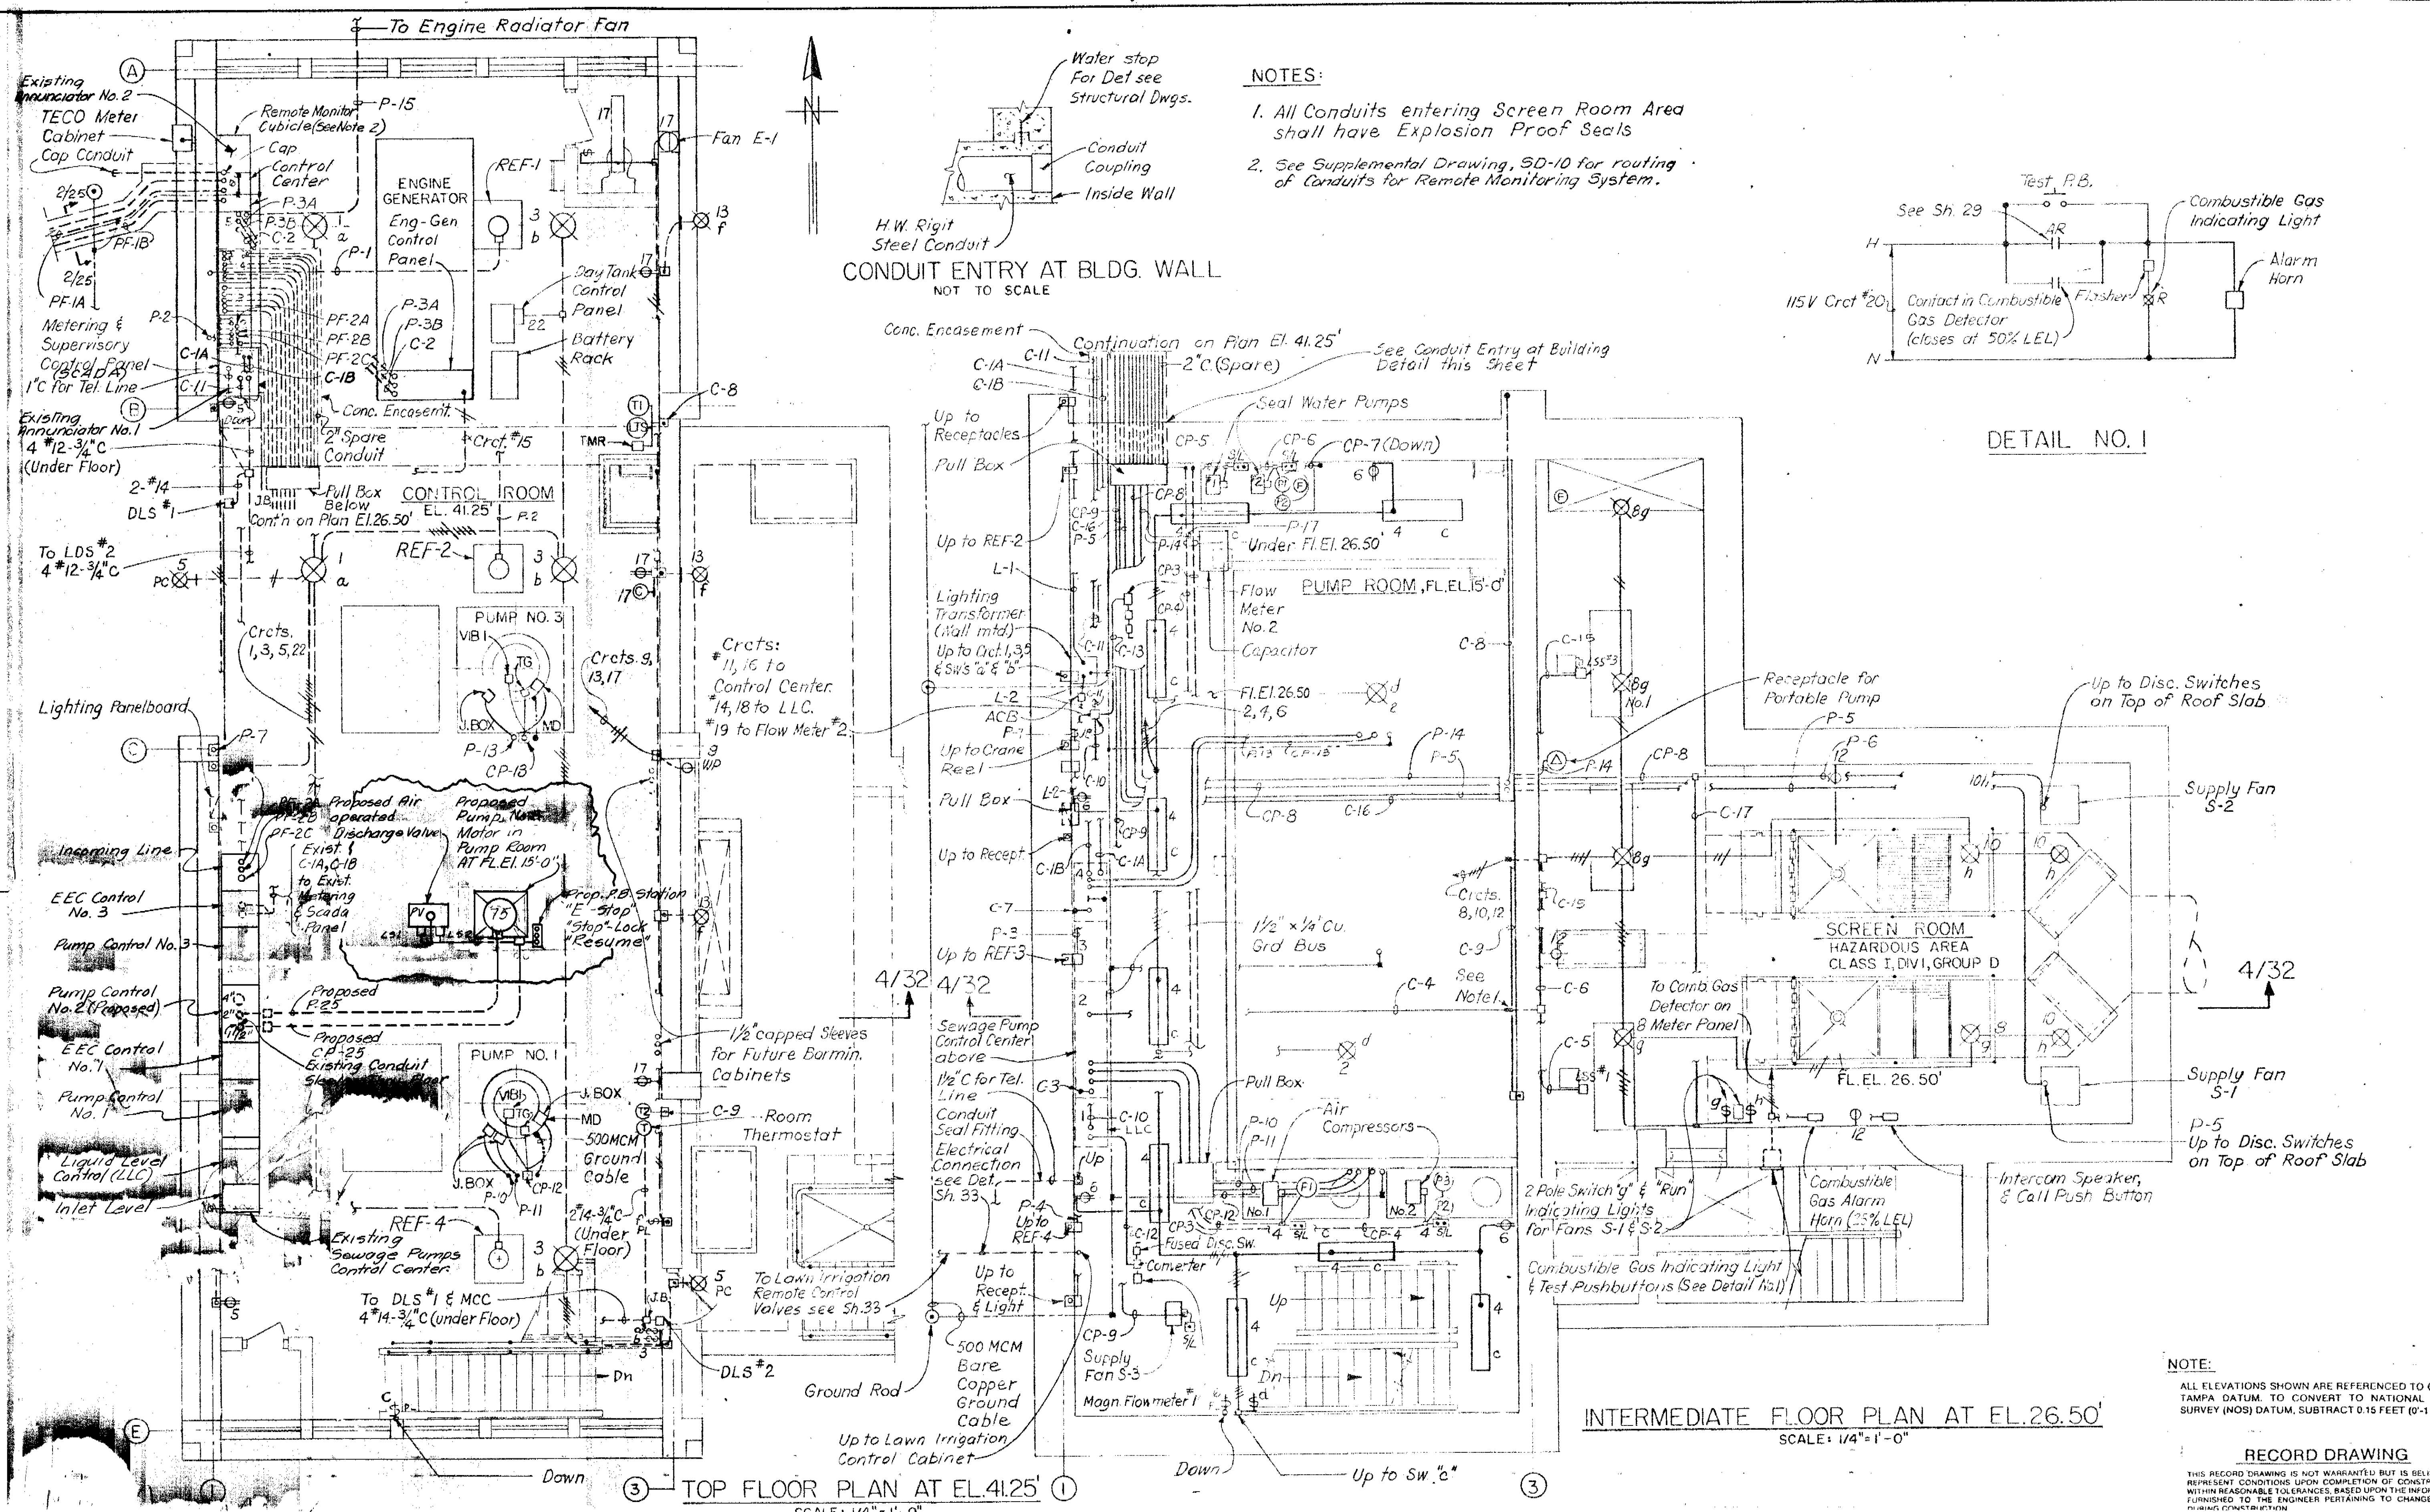

- NOTES:**
1. All Conduits entering Screen Room Area shall have Explosion Proof Seals
 2. See Supplemental Drawing, SD-10 for routing of Conduits for Remote Monitoring System.

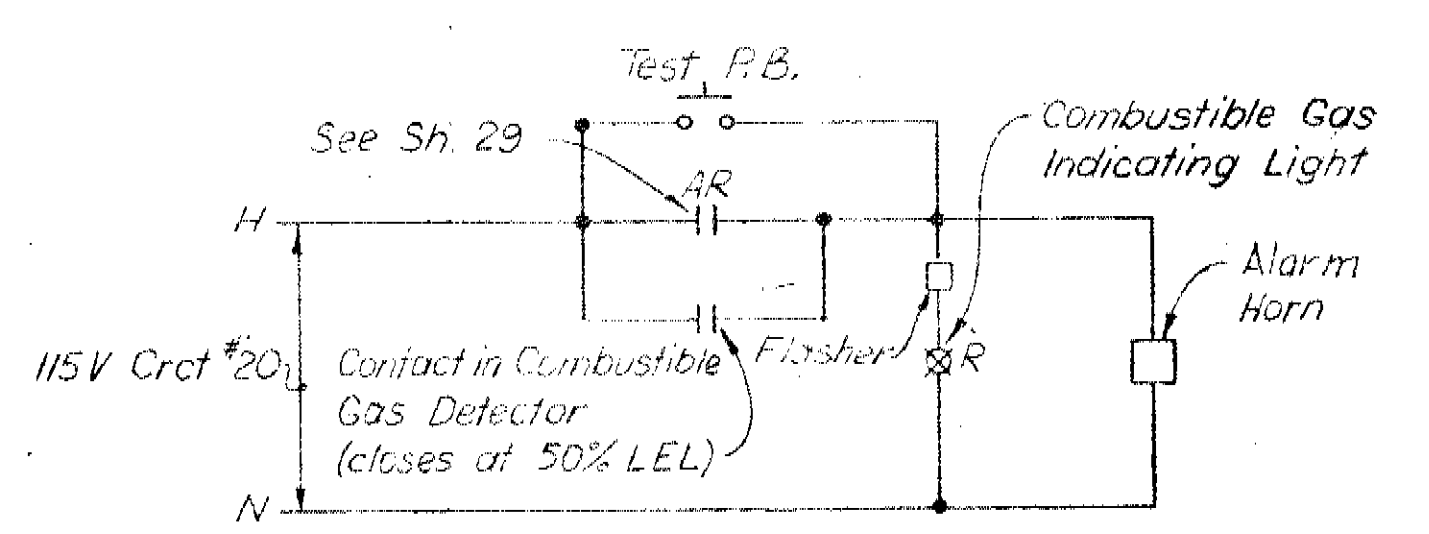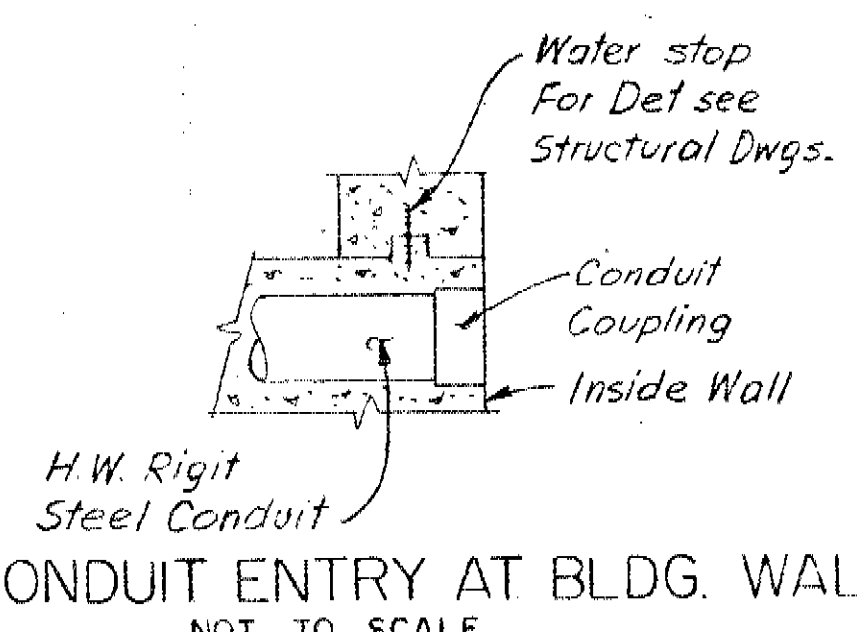


NOTE:
ALL ELEVATIONS SHOWN ARE REFERENCED TO CITY OF TAMPA DATUM. TO CONVERT TO NATIONAL OCEAN SURVEY (NOS) DATUM, SUBTRACT 0.15 FEET (0'-1 1/16").

RECORD DRAWING
THIS RECORD DRAWING IS NOT WARRANTED BUT IS BELIEVED TO REPRESENT CONDITIONS UPON COMPLETION OF CONSTRUCTION, WITHIN REASONABLE TOLERANCES, BASED UPON THE INFORMATION FURNISHED TO THE ENGINEER PERTAINING TO CHANGES MADE DURING CONSTRUCTION.

 ROMAN KORCHAK, P.E. # 42626 ELECTRICAL SECTION HEAD DEPARTMENT OF SANITARY SEWERS	 HENRY DORZBACK, P.E. CHIEF ENGINEER DEPARTMENT OF SANITARY SEWERS	DES. R. K.	APPROVED BY	DATE REVISIONS 1 2 3 4 5	SCALE As shown	DEPARTMENT of SANITARY SEWERS CITY of TAMPA, FLORIDA RENEWAL & REPLACEMENT SEWAGE DISPOSAL SYSTEM	UNIVERSITY PUMPING STATION PUMP ADDITION • POWER PLAN	SHEET 6 OF 6
		DRN: ce.						
		CKD:	RALPH L. METCALF II, PE DIRECTOR DEPARTMENT of SANITARY SEWERS					
DATE:								

LOCATION MAP

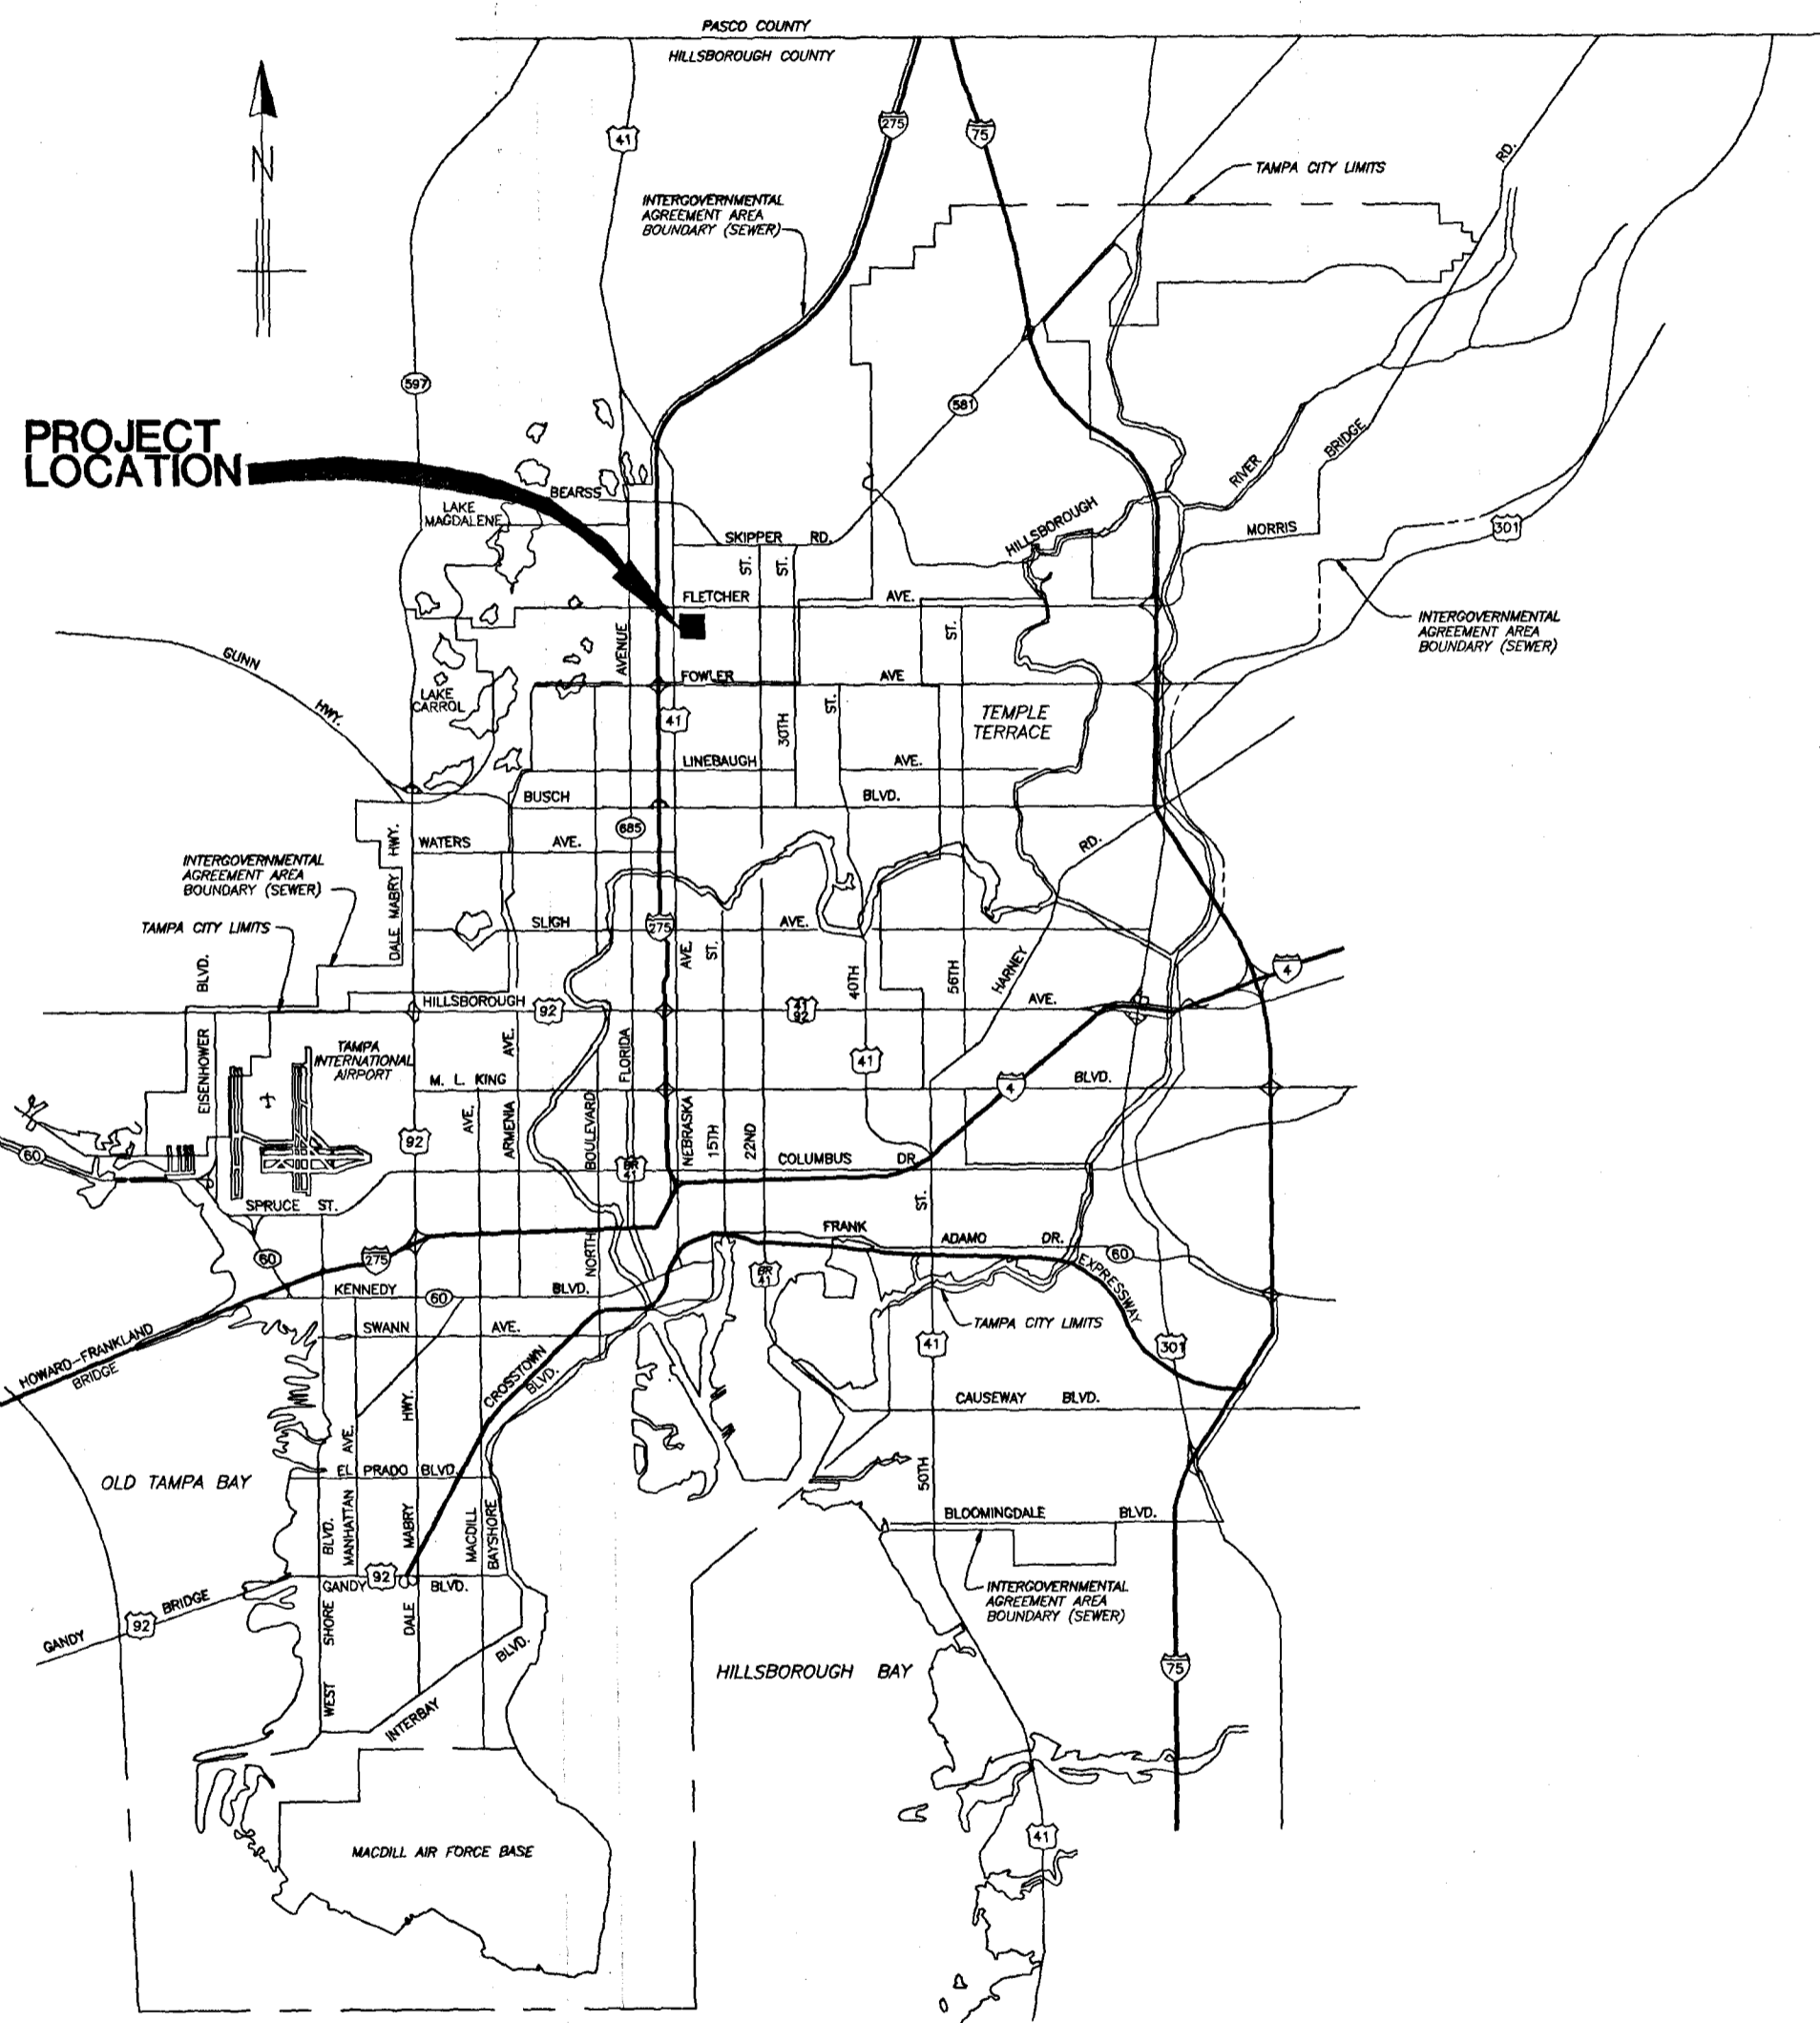

CITY of TAMPA



DEPARTMENT OF SANITARY SEWERS

SEWAGE DISPOSAL SYSTEM


PLANS FOR

UNIVERSITY PUMPING STATION TRUCK ACCESS

CONTRACT NO. F-94

 HENRY DORZBACK, P.E. #39449 CHIEF ENGINEER DEPARTMENT OF SANITARY SEWERS	 RALPH L. METCALF II, P.E. DIRECTOR DEPARTMENT OF SANITARY SEWERS	DES: J.P.W.	No. DATE REVISIONS 1 _____ 2 _____ 3 _____ 4 _____ 5 _____	CITY of TAMPA, FLORIDA DEPARTMENT OF SANITARY SEWERS RENEWAL & REPLACEMENT SEWAGE DISPOSAL SYSTEM	TITLE SHEET	DESIGN W.O. 4312 CONSTRUCTION W.O.	SHEET 1 OF 4
		DRN: <i>cc</i>					
		CKD: <i>at</i>					
		DATE: <i>6/16/94</i>					

PROJECT MAP

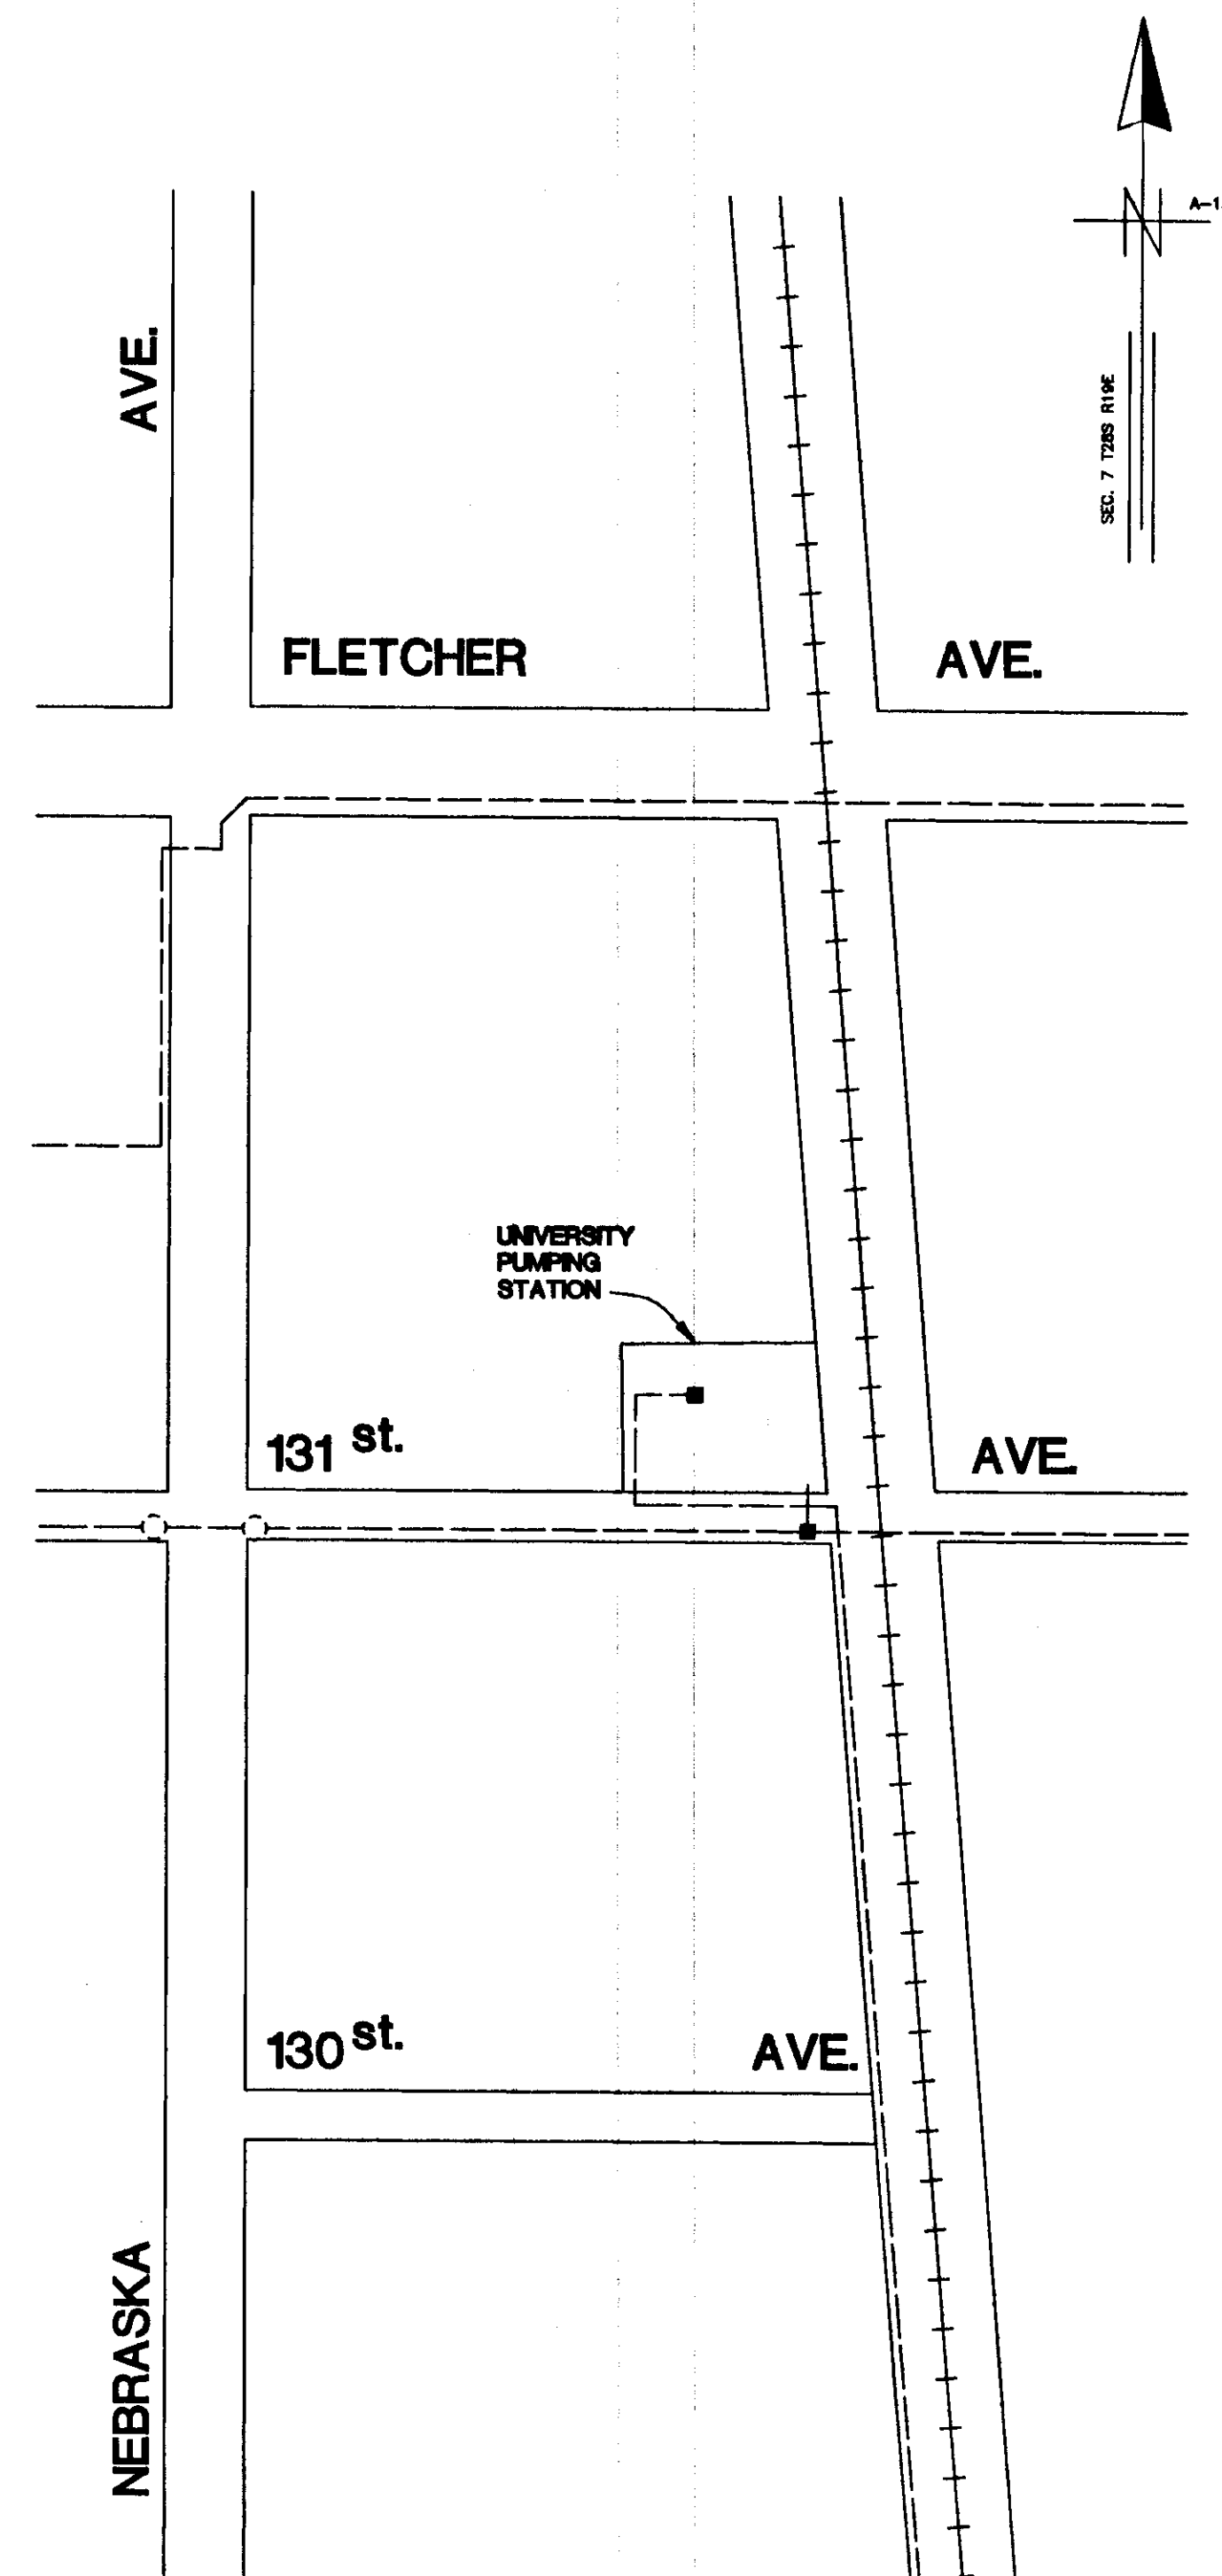

INDEX

	STREET	FROM	TO
1	COVER SHEET		
2	PROJECT MAP		
3	PLAN		
4	DETAIL SHEET		

LEGEND

EXISTING FEATURES & STRUCTURES

SEWERS	Up to 36" & Smaller	36" & Larger
Force Main		
Ex. San. Sewer & Manhole		
Storm Sewer & Manhole		
Proposed Sanitary Sewer		
OTHER FEATURES		
Right of Way Line		
Property Line		
Curb Line		
Water Line		
Gas Line		
Electrical Cable of Duct		
Telephone Cable or Duct		
TV Cable		
Valve		
Hydrant		
Catch Basin, Grate		
Power Pole		
Telephone Pole		
Valve Vault		
Water Meter		
Electrical Manhole or Vault		
Fire Alarm Box		
Fire Alarm Cable		
Telephone Manhole or Vault		
Telephone Booth		
Guy Pole		
Guy Wire		
Building Limit		
Fence		
Trees		
Conifer		
Palm		
Oak		
Other		
Shrub		
Railroad Tracks		
Marsh		
Fresh		
Salt		
Hedge		
Bridge or Culvert		
Property Corners		
Iron Pipe		
Concrete Monument		
Open Ditches		
Section Boundary		
Service Connections		
Existing Wye (Location Unknown)		
Existing Wye		
Proposed Wye		

ABBREVIATIONS

Top of Pipe	_____	T.P.
Invert Elevation	_____	Inv. El.
Right of Way	_____	R/W
Manhole	_____	MH or M.H.
Polyvinyl Chloride Pipe	_____	P.V.C.P.
Vetrified Clay Pipe	_____	V.C.P.
Ductile Iron Pipe	_____	D.I.P.
Reinforced Concrete Pipe	_____	R.C.P.
Concrete Pipe	_____	C.P.
Approximate Location	_____	A.L.
Bench Mark	_____	B.M.
Point of Intersection	_____	P.I.
Survey Line	_____	℄

STATION #2

CL-2000-UNIVERSITY-4312-2

Henry Dorzback
 HENRY DORZBACK, P.E. #39449
 CHIEF ENGINEER
 DEPARTMENT OF SANITARY SEWERS

Ralph L. Metcalf II
 RALPH L. METCALF II, P.E.
 DIRECTOR
 DEPARTMENT OF SANITARY SEWERS

DES: J.P.W.
 DRN: CE
 CKD: P.H.
 DATE: 5/10/94

No.	DATE	REVISIONS
1		
2		
3		
4		
5		





CITY OF TAMPA FLORIDA
 DEPARTMENT OF SANITARY SEWERS
 RENEWAL & REPLACEMENT
 SEWAGE DISPOSAL SYSTEM

PROJECT MAP, LEGEND & INDEX

DESIGN W.O. 4312
 CONSTRUCTION W.O.


SHEET
2
 OF 4

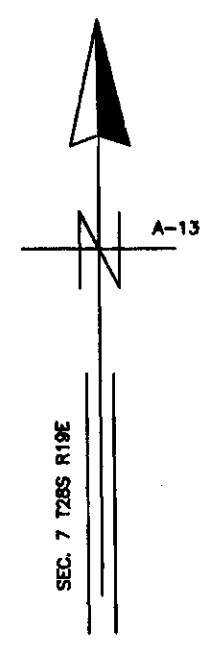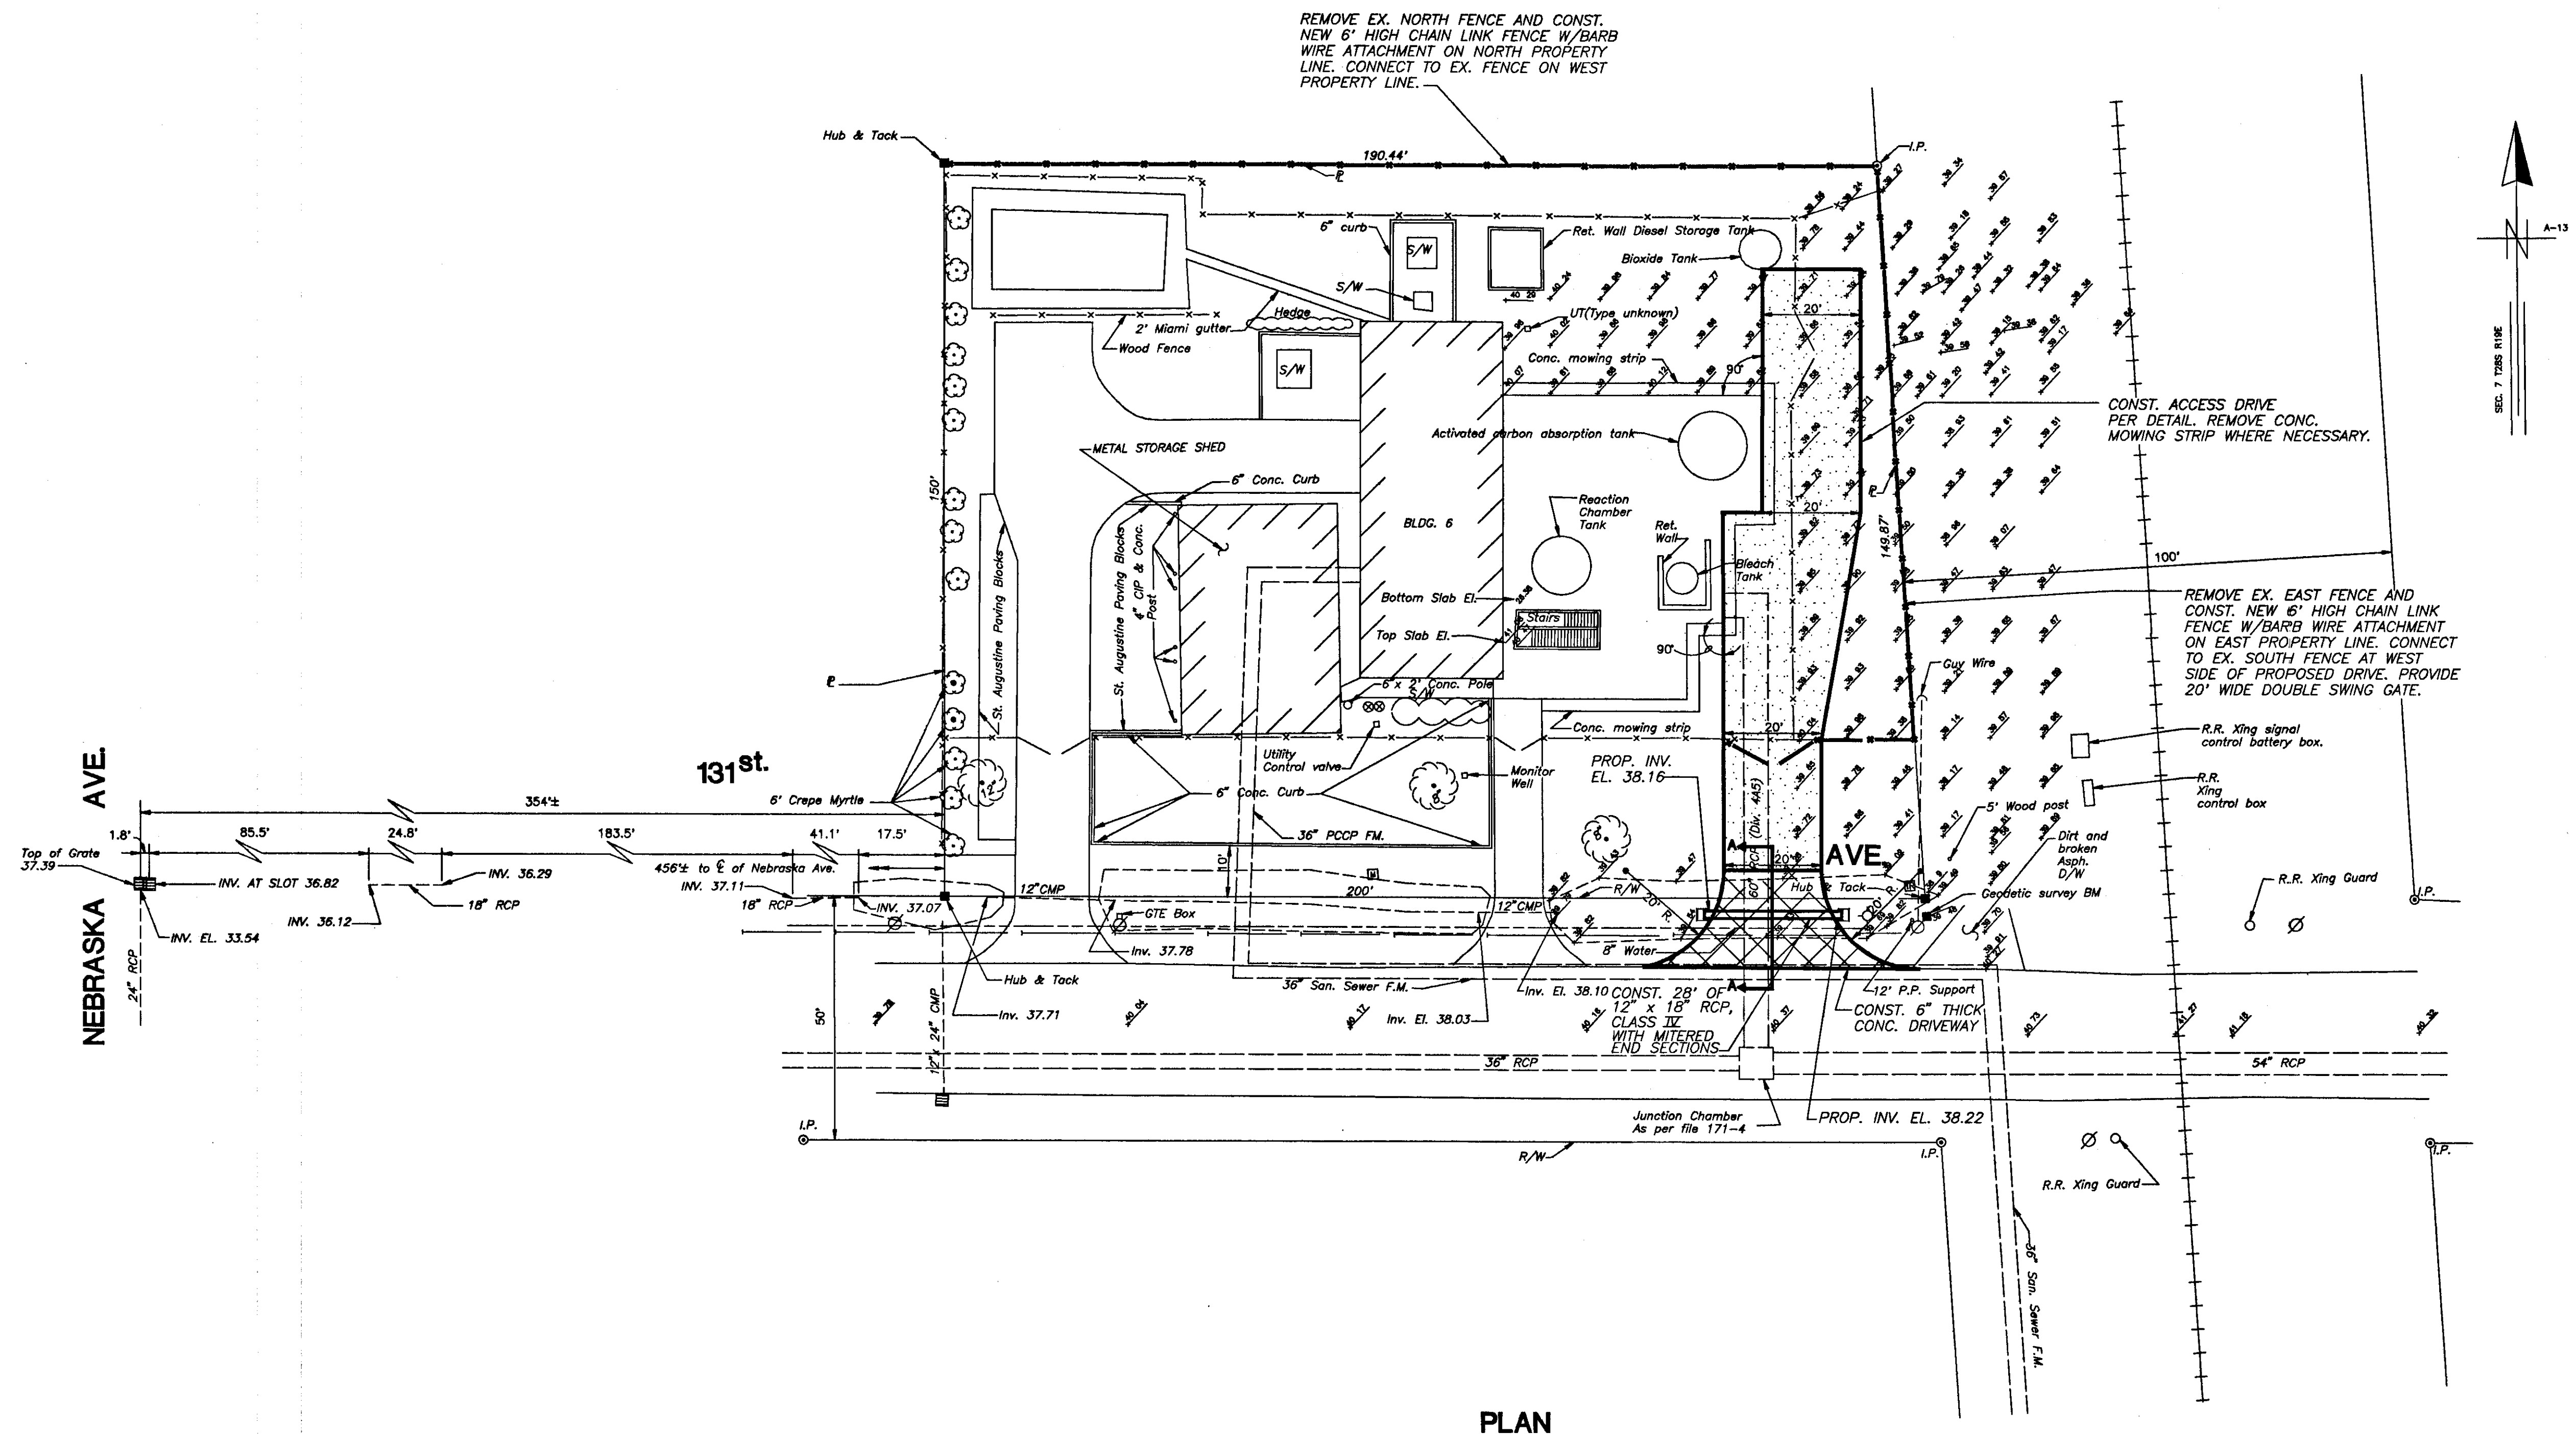


PLAN


LEGEND

- EXISTING ELEVATION
- PROPOSED CONCRETE DRIVEWAY
- PROPOSED ACCESS DRIVE

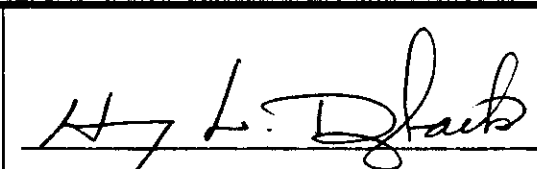
 HENRY DORZBACK, P.E. #39449
 CHIEF ENGINEER
 DEPARTMENT OF SANITARY SEWERS


 RALPH L. METCALF II, P.E.
 DIRECTOR
 DEPARTMENT OF SANITARY SEWERS

No.	DATE	REVISIONS
1		
2		
3		
4		
5		

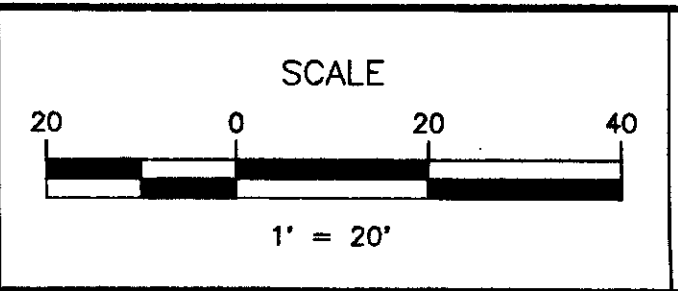


CITY OF TAMPA FLORIDA
 DEPARTMENT OF SANITARY SEWERS
 RENEWAL & REPLACEMENT
 SEWAGE DISPOSAL SYSTEM

UNIVERSITY PUMPING STATION
TRUCK ACCESS

DESIGN W.O. 4312
 CONSTRUCTION W.O.


SHEET
3
 OF 4

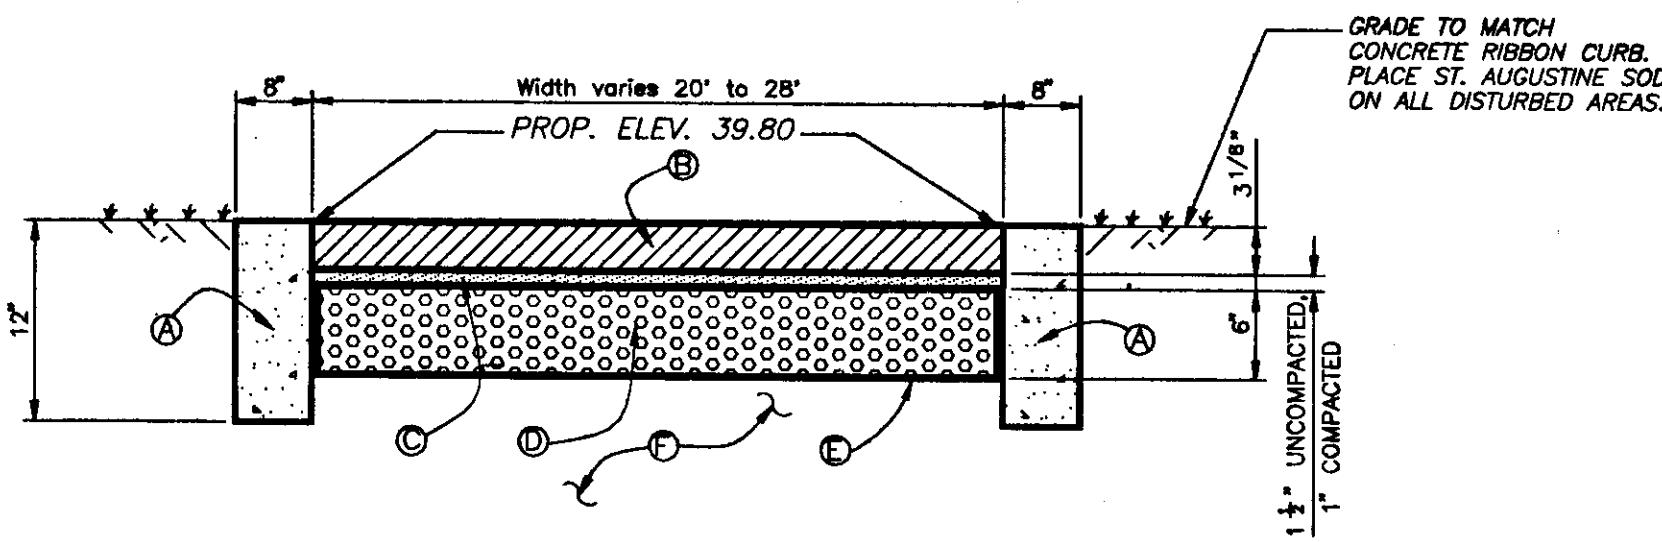

- (A) CONCRETE RIBBON CURB. NOT NECESSARY WHEN ADJACENT TO EXISTING CONCRETE SLAB.
- (B) PRECAST CONCRETE TURF BLOCK PAVING UNITS. BACKFILLED WITH FDOT #57 COARSE AGGREGATE.
- (C) 1 1/2" OF UNCOMPACTED CONCRETE SAND, TO BE COMPACTED TO 1" AFTER TURF BLOCK PAVING UNITS ARE INSTALLED. DO NOT USE MASON SAND.
- (D) FDOT #57 COARSE AGGREGATE BASE, COMPACTED.
- (E) FILTER FABRIC. COVER TOP, BOTTOM AND SIDES OF BASE. OVERLAP SEAMS MIN. OF 12".
- (F) COMPACTED NATIVE SUB-BASE.


TYPICAL SECTION - ACCESS DRIVE

NOT TO SCALE

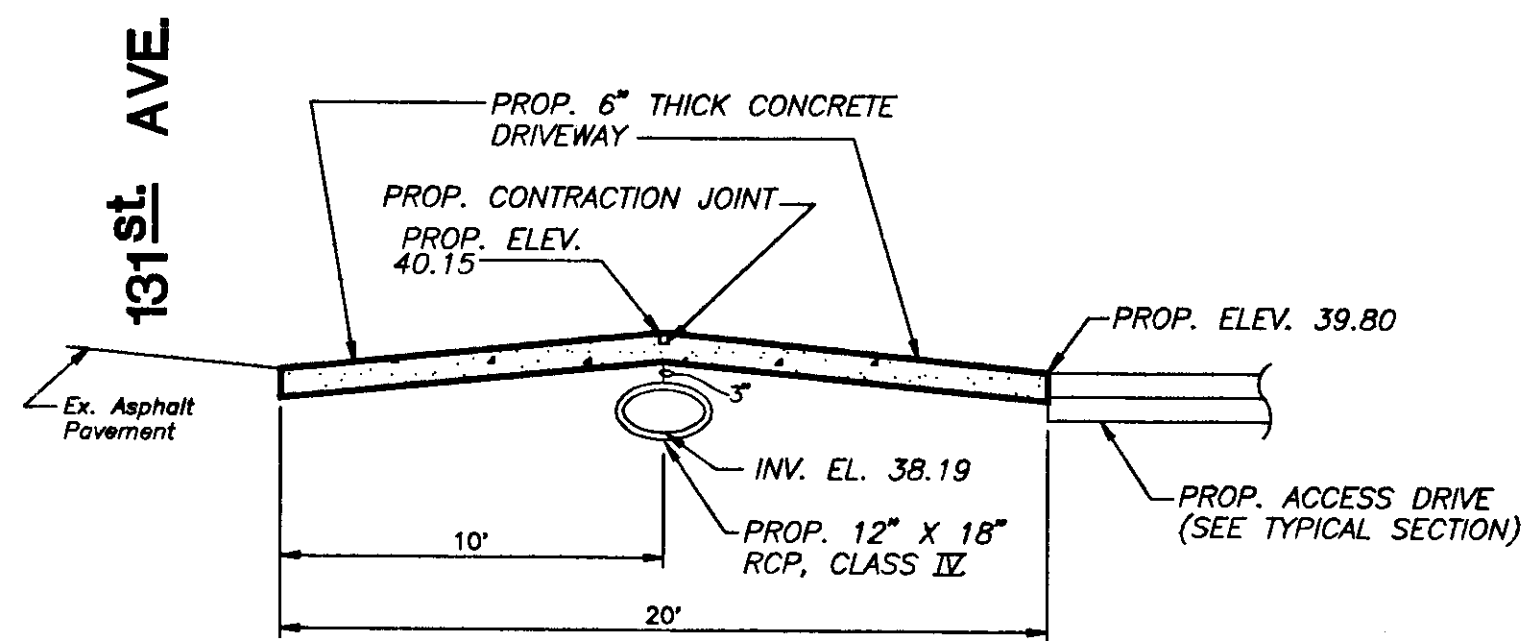



SECTION A-A

NOT TO SCALE









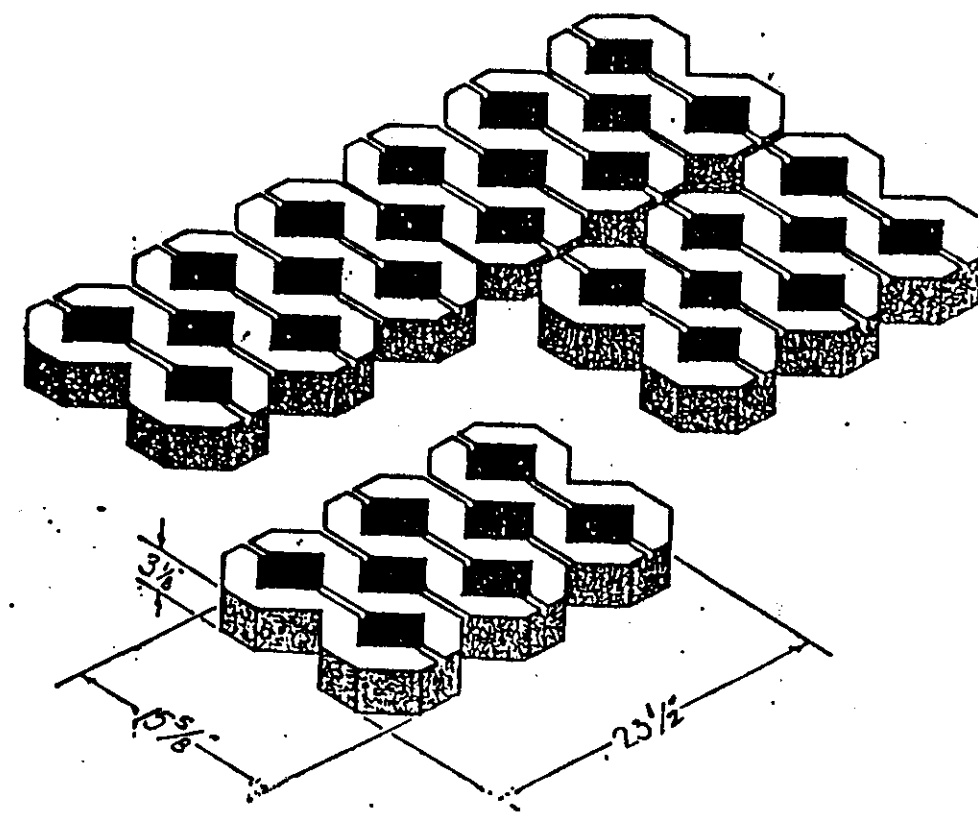


TURF BLOCK PAVING UNITS

NOT TO SCALE

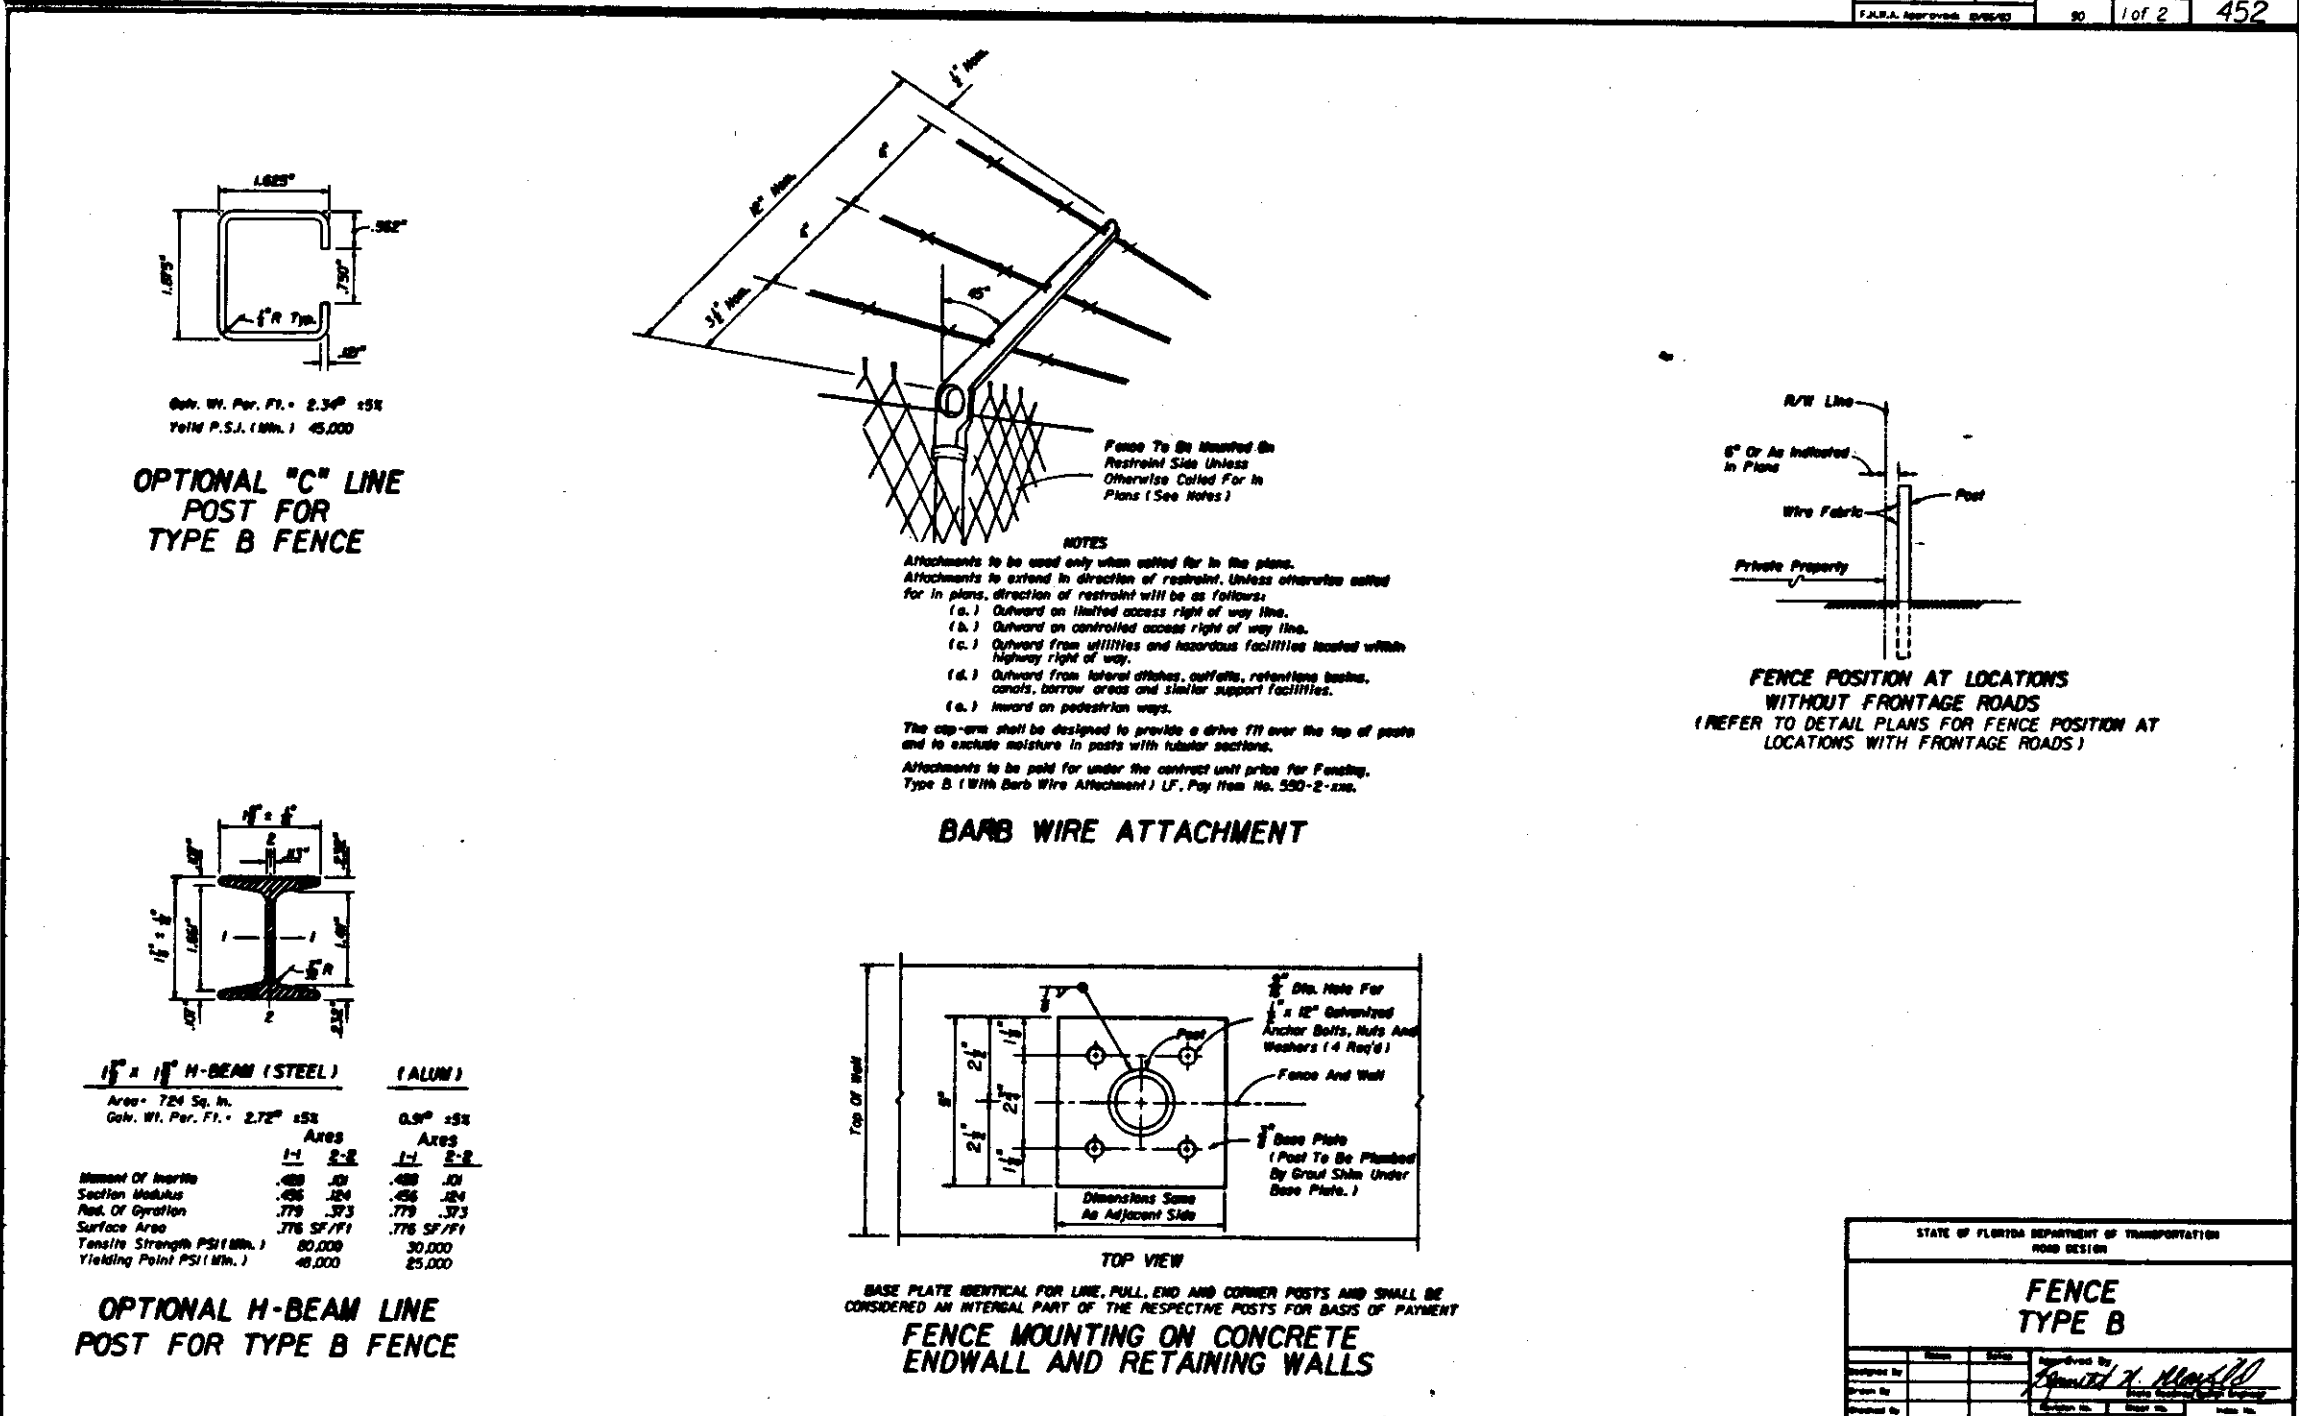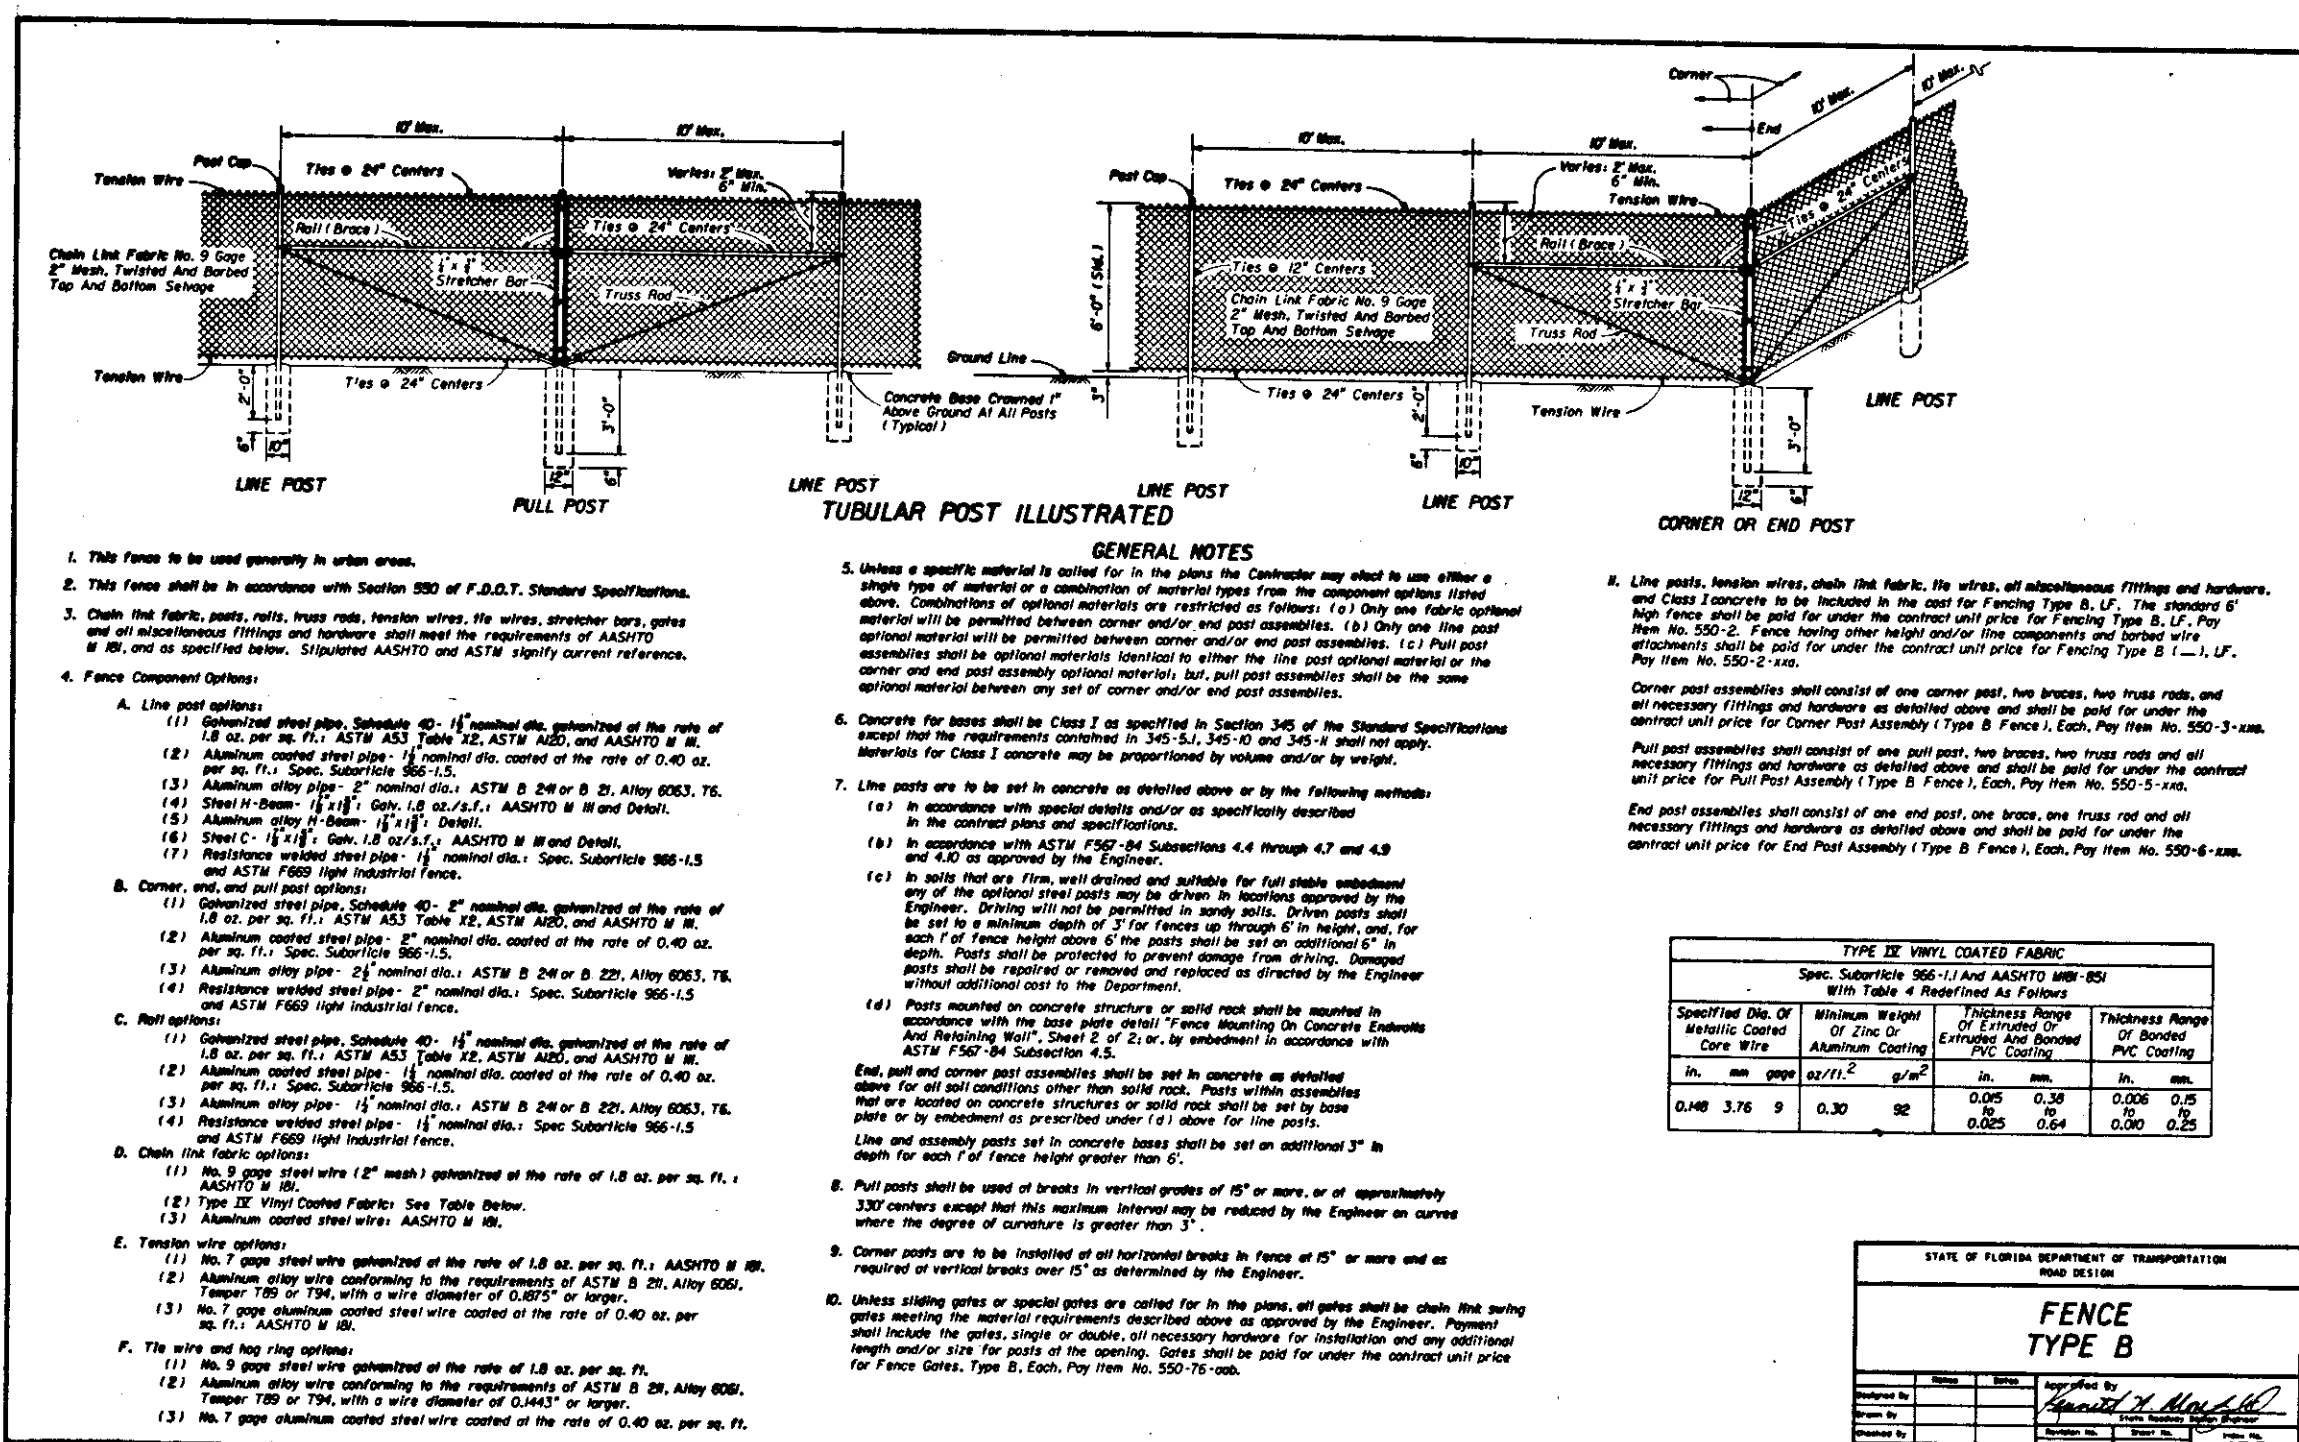

D	Z	A	B	C	E	F	G	GRATE SIZES		CONCRETE (Cu. Yds.)		SODDING (Sq. Yds.)	
								Single	Double	Single	Double	Single	Double
12"	12"	12"	12"	12"	12"	12"	12"	12"	12"	12"	12"	12"	12"

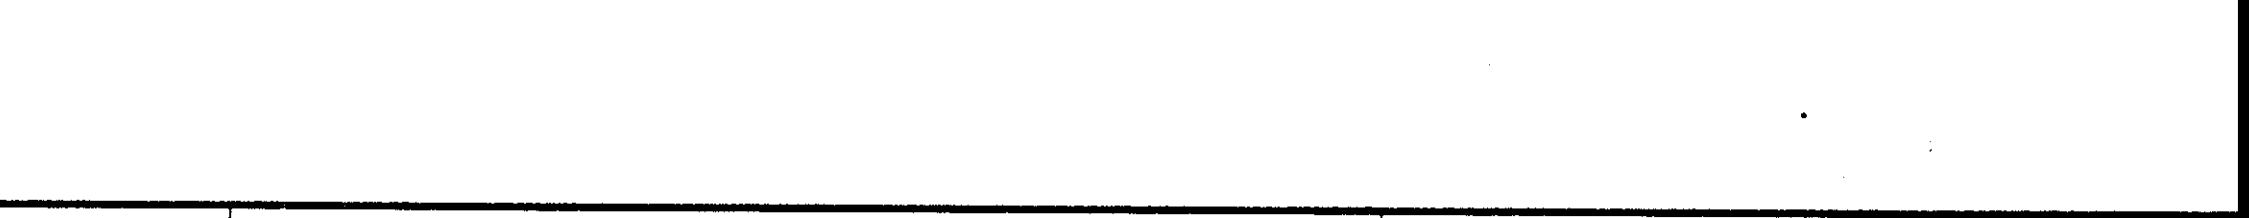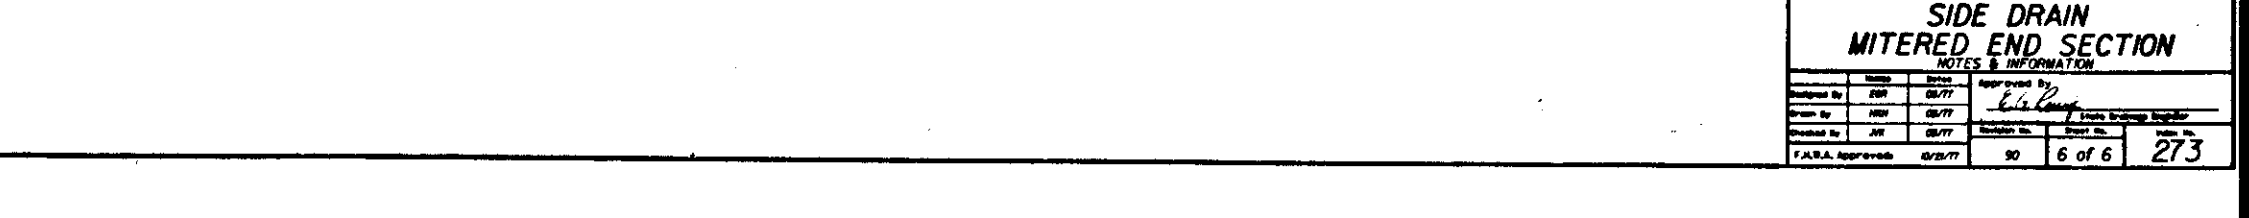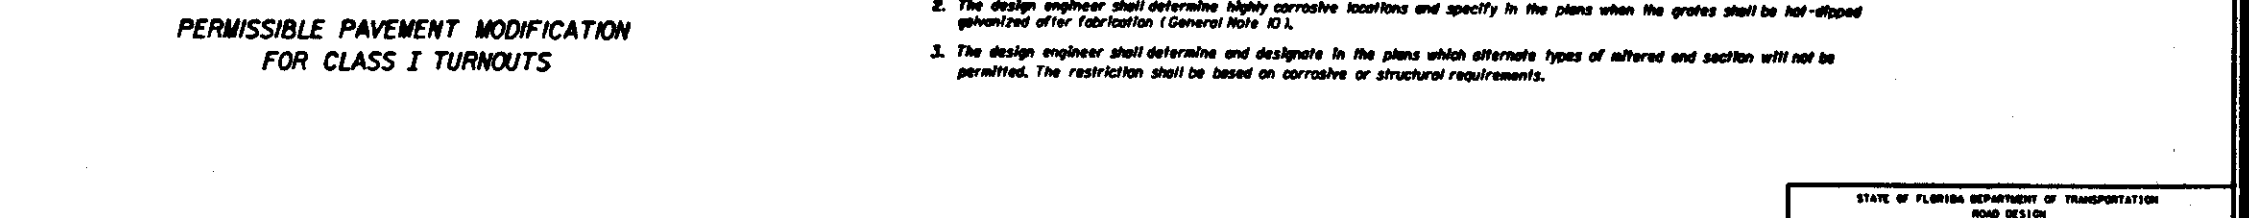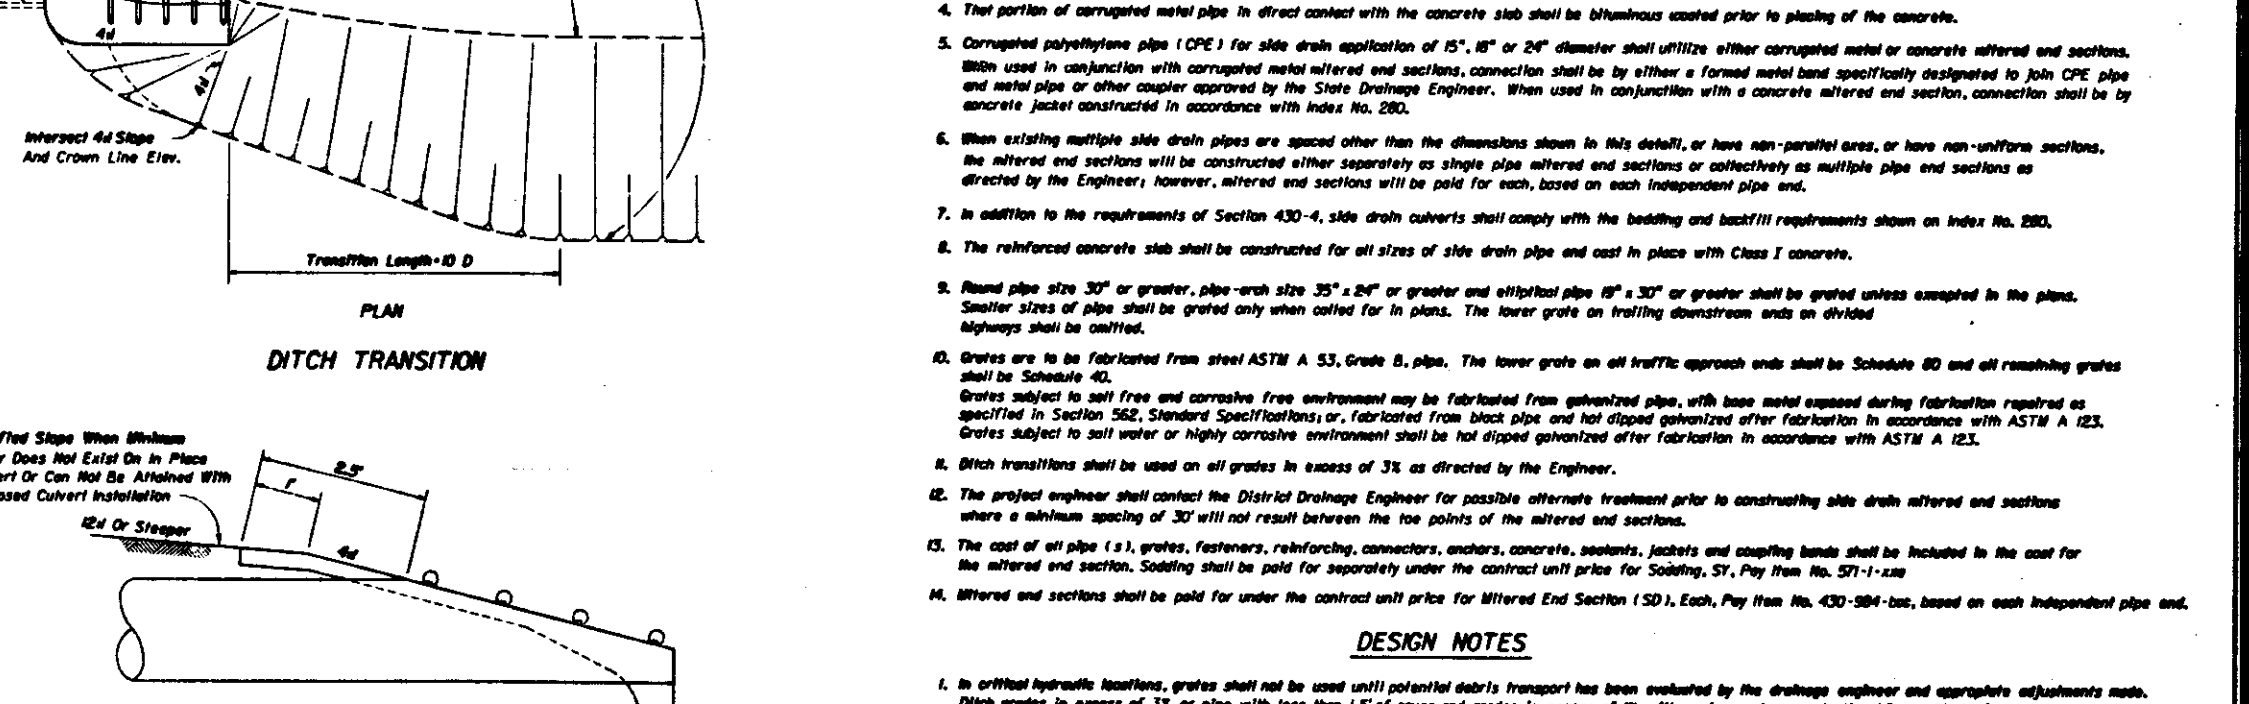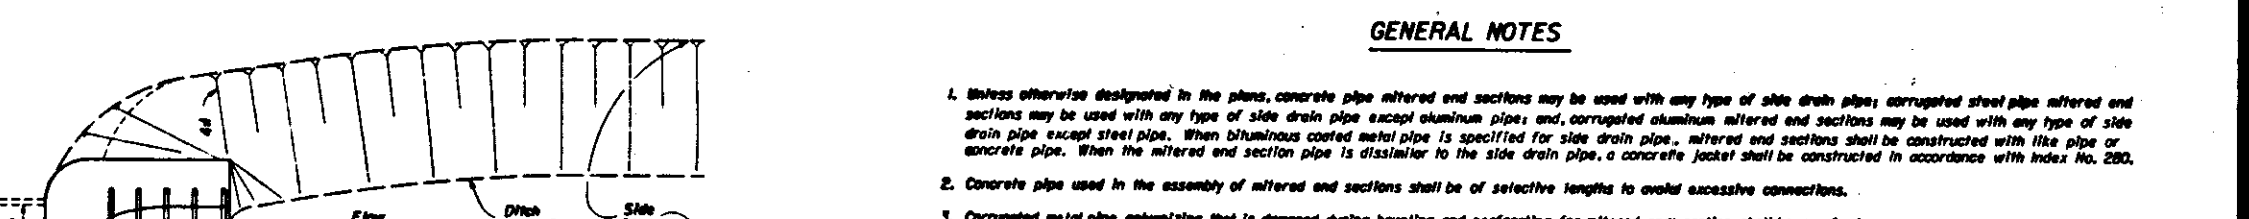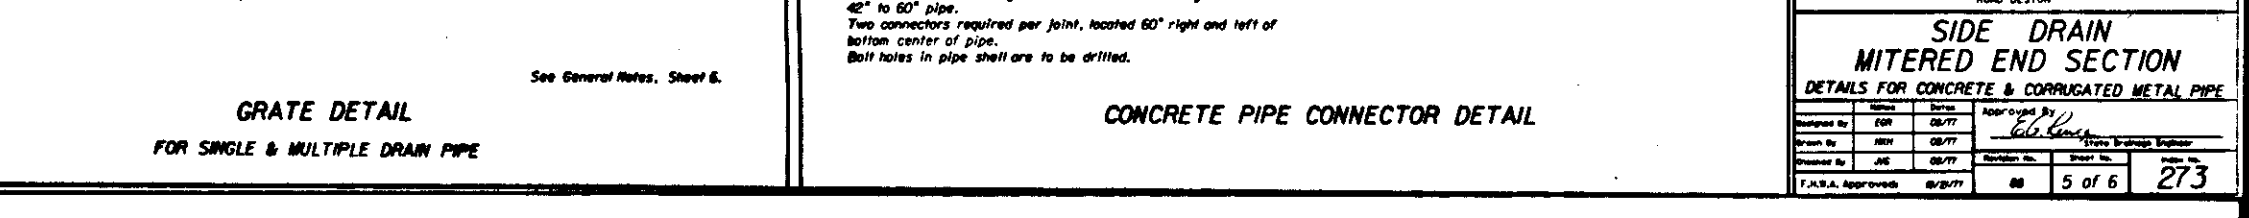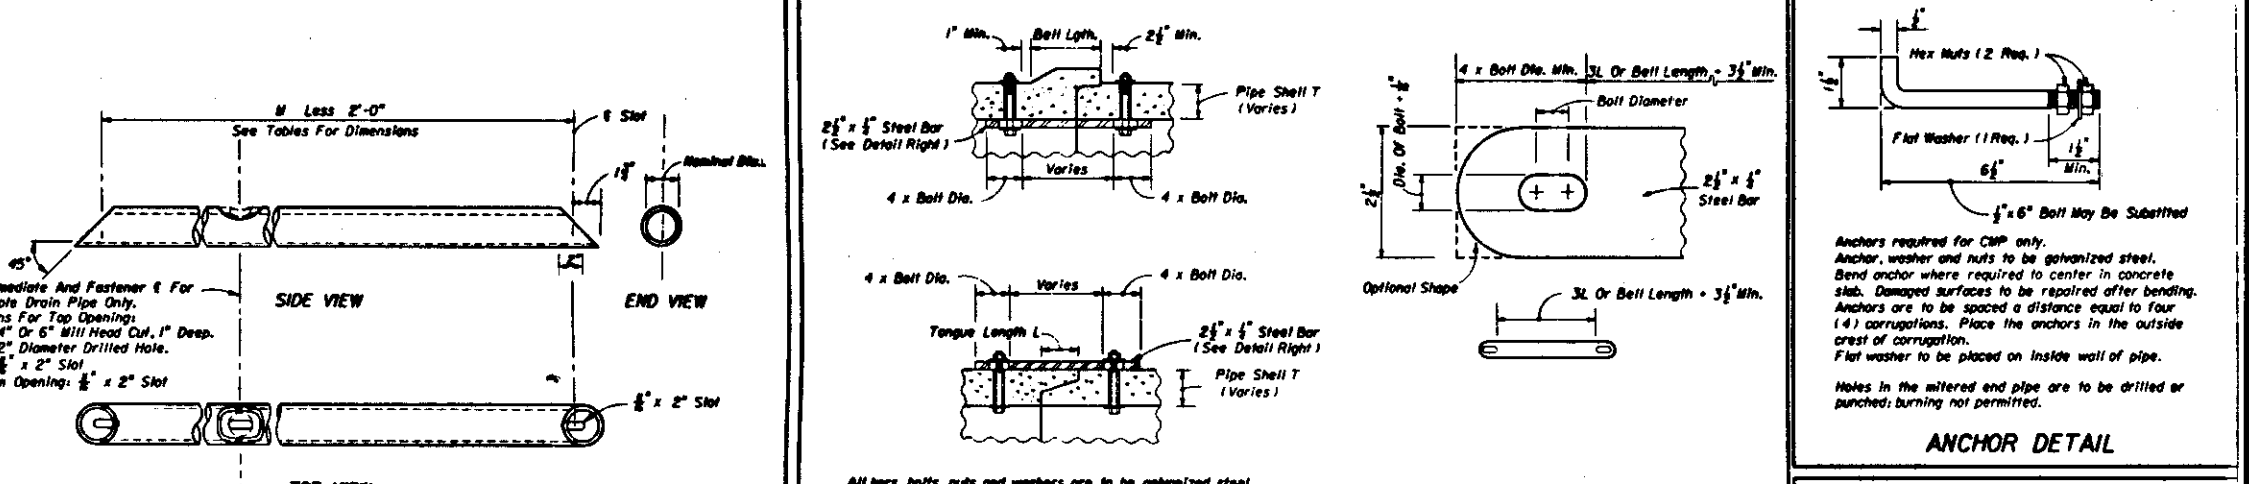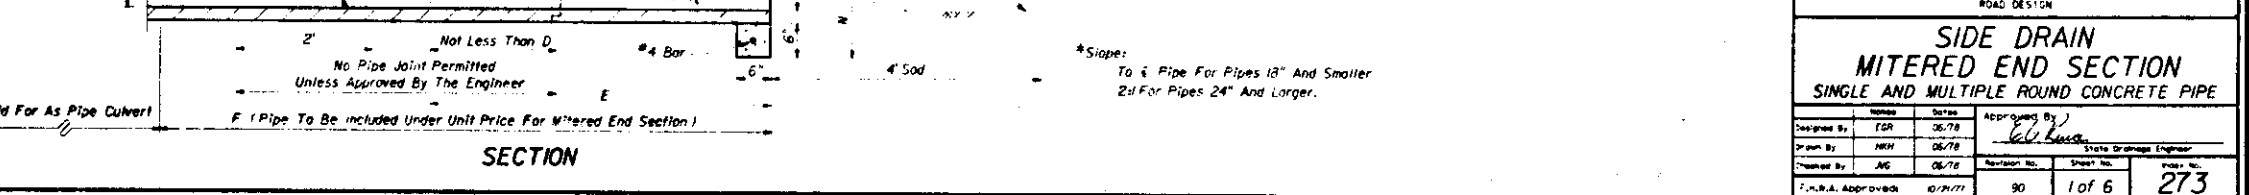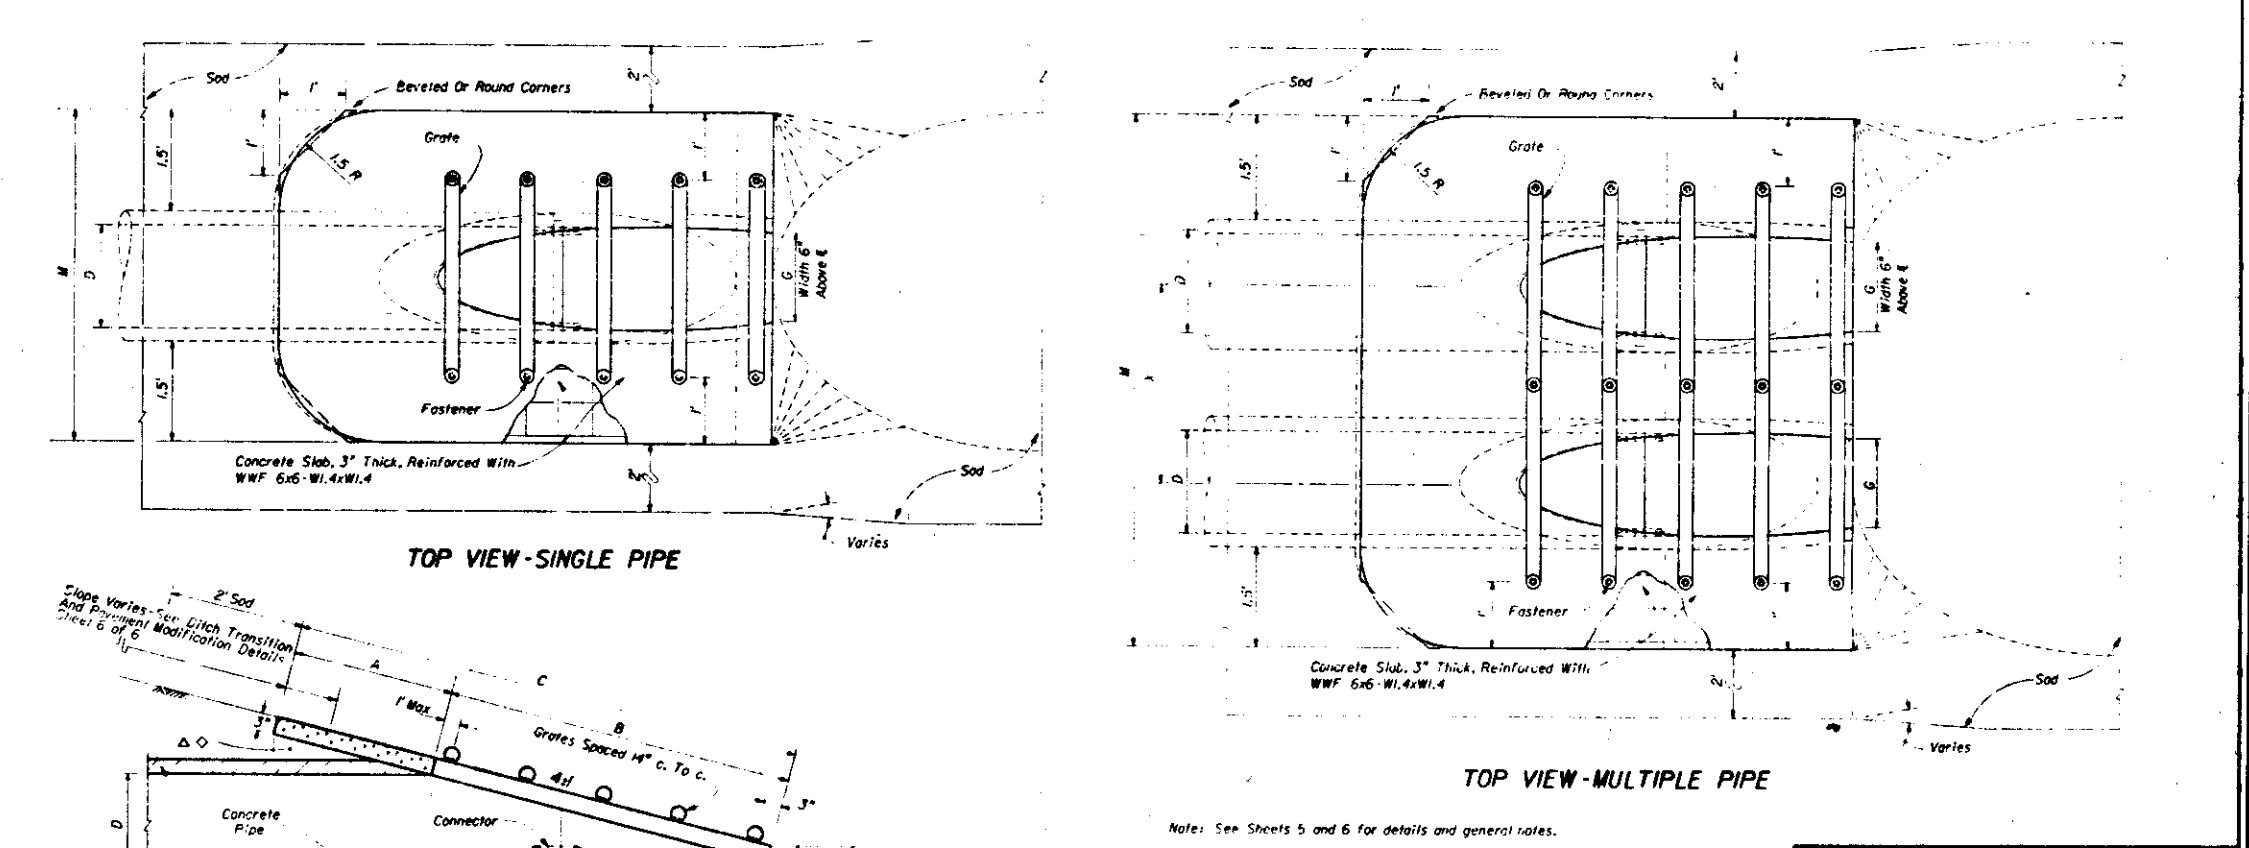

DES: J.P.W.
DRN: ec
CKD: A.H.
DATE: 5/20/04

HENRY DORZBACK, P.E. #39449
CHIEF ENGINEER
DEPARTMENT OF SANITARY SEWERS

RALPH L. METCALF II, P.E.
DIRECTOR
DEPARTMENT OF SANITARY SEWERS

No.	DATE	REVISIONS
1		
2		
3		
4		
5		

AS SHOWN

CITY OF TAMPA FLORIDA
DEPARTMENT OF SANITARY SEWERS
RENEWAL & REPLACEMENT
SEWAGE DISPOSAL SYSTEM

UNIVERSITY PUMPING STATION
TRUCK ACCESS DRIVE

DESIGN W.O. 4312
CONSTRUCTION W.O.

SHEET
4
OF 4

282-6

CITY of TAMPA




DEPARTMENT OF SANITARY SEWERS SEWAGE DISPOSAL SYSTEM

PLANS FOR 131ST AVENUE PUMPING STATION ODOR CONTROL REHABILITATION

CONTRACT II-02

LOCATION MAP

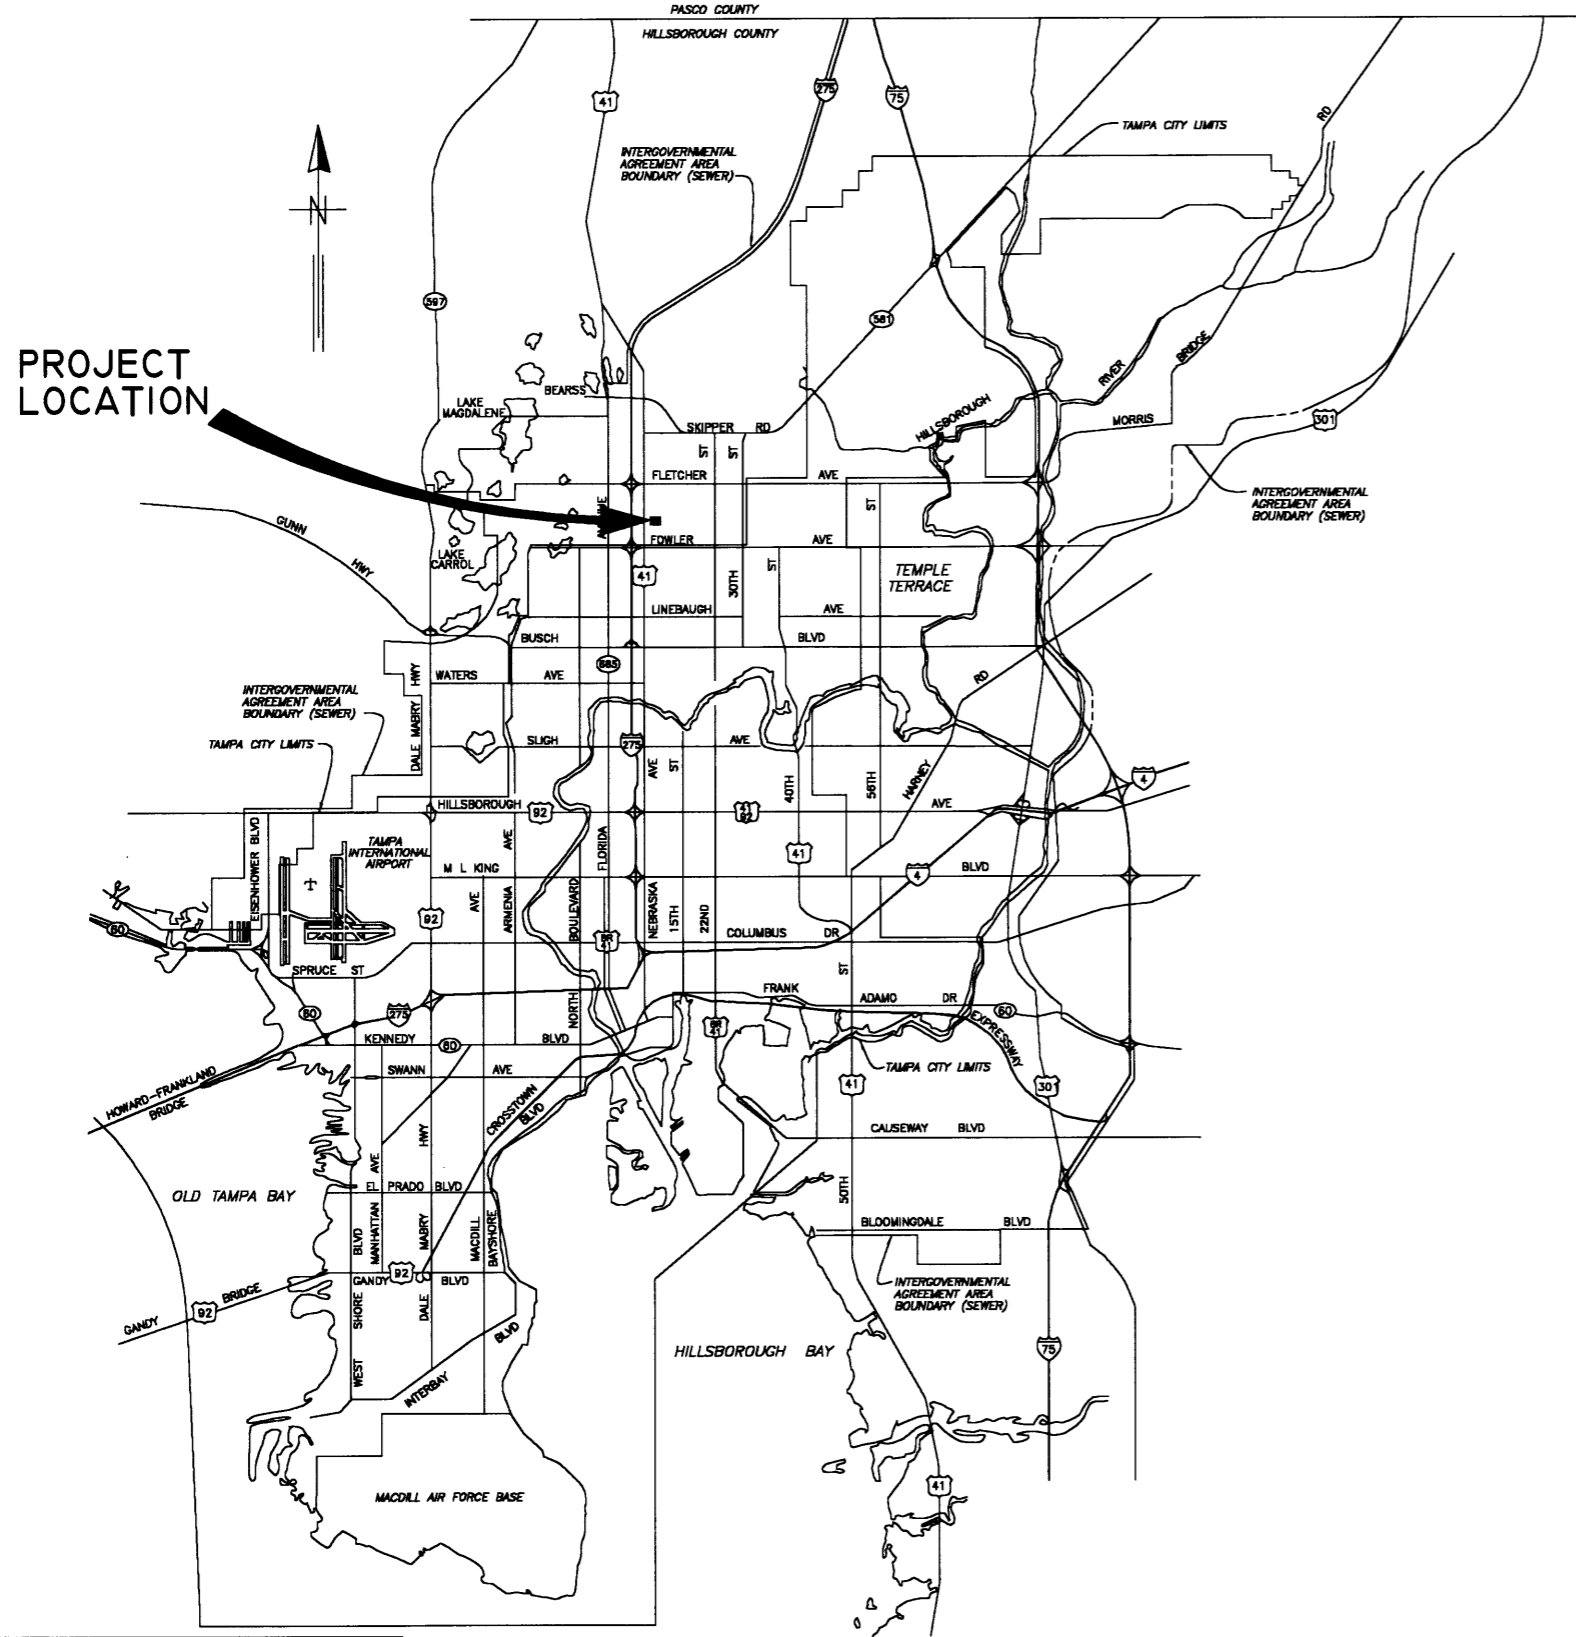

131ST AVE PUMPING STA ODOR CONTROL REHAB

Roman D. Korchak
ROMAN D KORCHAK, PE #42626
ELECTRICAL SECTION HEAD
DEPARTMENT OF SANITARY SEWERS

Henry Dorzback
HENRY DORZBACK, P.E. #39449
CHIEF ENGINEER
DEPARTMENT OF SANITARY SEWERS

Ralph L. Metcalf III
RALPH L. METCALF III, P.E.
DIRECTOR
DEPARTMENT OF SANITARY SEWERS

DES:	No.	DATE	REVISIONS
CL	3		
MPL	2		
A.H.	1		
DATE: 6-02			

CITY of TAMPA
DEPARTMENT OF SANITARY SEWERS
SANITARY SEWERS DIVISION

COVER SHEET

NOTES



- 1) The Contractor shall arrange the work to minimize the time that the pumping station will not have an odor control system in operation. The existing odor control system shall remain in operation until the construction of the proposed system is completed. The Contractor shall then connect the new system to the opening in the wet well and place the existing system out of operation. The existing system shall remain intact until all performance tests on the new system have been successfully completed.
- 2) The Contractor is responsible for obtaining all field measurements and verifying the locations, elevations, and dimensions of all existing piping, structures, and other features affecting his work prior to submittal of shop drawings or starting construction.
- 3) All equipment, piping, structures, etc. indicated for removal shall be removed and either delivered to the Howard F. Curren Treatment Plant or properly disposed by the Contractor. In general, all items constructed of metal or aluminum shall remain the property of the City and shall be delivered to the treatment plant. The existing bleach storage tank and caustic storage tank shall also be delivered to the treatment plant. The Contractor shall dispose all other items.
- 4) The existing carbon tank contains approximately 2-ft of activated carbon. The Contractor shall be responsible for removing the carbon and properly disposing it. The carbon may be delivered to the treatment plant if no other suitable disposal site can be found.
- 5) The existing concrete pedestals for the scrubber tower, bleach tank, carbon tank, and blower shall be removed flush with the existing floor. All rebar or anchor bolts cast into the existing floor that are remaining after the removal of the concrete pedestals and other equipment shall be ground back a minimum of 1-inch and the hole filled with epoxy or grout. Areas of the floor that are disturbed by the removal of the concrete pedestals and other equipment shall be made smooth.
- 6) The existing air compressor building and the two air compressors inside the building shall be removed. Air piping between the air compressors and the existing odor control system shall also be removed. Air piping that extends into the building and that is connected to the pumping station air system shall be capped at a suitable location inside the pumping station.
- 7) The Contractor shall submit a detailed layout of the proposed equipment and the containment area for the approval by the Engineer. The equipment shall be arranged to provide maximum access to all components. The dimensions of the proposed containment area shall be sufficient to accommodate all components of new odor control system and provide a minimum 4-ft between the containment walls and each system component. Height of containment curb shall be as required to provide a containment volume that is 110% of the volume of the ~~largest chemical storage vessel~~ *Sump of the largest scrubber tower. (Per addendum 2)*
- 8) Soil below the proposed concrete containment area shall be compacted to 95% maximum density per AASHTO T-180.
- 9) The existing concrete containment curb shall be removed and reconstructed as required to suit the proposed odor control equipment. Width and height of new containment curb shall match the existing curb. New curb shall be constructed of 4000 psi concrete and shall be reinforced with one #4 bar installed parallel to the curb. Curb shall be anchored to the existing concrete slab using #4 dowel @18" O.C. drilled and epoxied into the existing concrete (4-inch minimum embedment). New concrete shall be bonded to existing concrete using a high strength bonding agent.
- 10) Locations and number of floor drains shown on the plans for the proposed containment area are approximate. Contractor may adjust locations and provide additional drains to suit the layout of the selected equipment and ensure proper drainage. Floor drains and clean-outs shall be constructed of PVC. Floor drain piping shall be schedule 80 PVC and shall have a minimum slope of 1/8" per foot. Drain piping shall be connected to the existing drain piping located inside the wet well as shown on the plans. If the connection requires removing a portion of the existing concrete mower strip or containment curb, the concrete shall be removed and repaired as follows: Existing concrete shall be removed by saw-cutting the perimeter of the area to be removed. Mower strip shall be repaired with 4000 psi concrete reinforced with #4 @ 12" O.C.E.W. Thickness of the new concrete shall match the existing concrete. Containment curb shall be replaced in accordance with note 9.

- 11) The scrubber tower, blower, and chemical recirculation pumps, for the odor control system shall be securely mounted to concrete house keeping pads. The pads shall be constructed of 4000 psi concrete reinforced with 4"x4"-W6XW6 WWF. The pads shall be a minimum of 6-inches high and shall have sufficient length and width to completely support the proposed equipment. The pads shall be anchored to the concrete floor by providing No. 4 dowels at 12" O.C.E.W. drilled and epoxied or cast into the concrete floor (minimum 4-inches embedment).
- 12) All ductwork shall be constructed of fiberglass reinforced plastic (FRP). The ductwork and exhaust stack shall be supported and anchored as required to withstand a 120 mph wind load and all other loads that may be imposed on the ductwork. Hangers and supports shall be constructed of either vinylester FRP or 316 stainless steel. All guy wires, fasteners, bolts, nuts, washers, anchors, etc. shall be constructed of 316 stainless steel. The Contractor shall submit shop drawings for the supports and hangers.
- 13) The existing wet well intake duct transition piece shall be removed and replaced from the connection to the existing above ground ductwork to the first flanged joint below the wet well ceiling. Remaining ductwork through the wet well floor shall remain. New transition piece shall be constructed of FRP. The configuration and dimensions of the new transition piece shall be as required to connect to the remaining ductwork in the wet well and to the new ductwork for the proposed odor control system. The intake duct shall also be equipped with a flange to seal the annular space between the duct and the opening in the wet well ceiling. Contractor shall submit shop drawings for the transition piece before starting construction.
- 14) The Contractor shall install chemical storage tank fill pipes to allow the tanks to be filled from the location shown on the plans. Fill pipe shall be constructed of CPVC and shall have a minimum diameter of 2-inches. Ball valves and check valves shall be constructed of CPVC and shall be equipped with unions for removal. Anchors, supports, and hangers used to secure the pipe shall be constructed of FRP or stainless steel. Fill pipes shall connect to the top of the storage tanks. Contractor shall submit layout of the fill pipes prior to beginning construction.
- 15) Contractor shall install a new 2-inch water line and 2-inch backflow preventer assembly to provide make-up water to the new odor control. The new water line shall be connected to the existing 2-inch water line downstream of the existing backflow preventer located on the south side of the pumping station (see sheet 3). Water line shall be constructed of schedule 80 CPVC and shall be installed with a minimum of 30-inches of cover. Grassed areas disturbed by the installation shall be re-sodded. If the installation requires removal of the existing concrete driveway, the concrete shall be removed by saw-cutting along the trench edges. Concrete driveway shall be replaced with 4000 psi concrete reinforced with 4"x4" W6xW6 WWF. Existing turf block driveway shall be removed and replaced in kind. Back flow preventer assembly shall meet City of Tampa Water Department standards. Existing 1-inch water supply shall be removed and capped.
- 16) During the construction, the Bioxide tank and feed system must remain in operation. If the construction requires relocation of the tank, the Contractor shall coordinate the relocation with Treatment Plant personnel. The relocation and connections for the feed system shall be performed by others.
- 17) Contractor shall remove and replace the existing emergency eyewash/shower system. Location of new system shall be determined by the Engineer at the time of construction.
- 18) Contractor to provide 3/4" water supply line and a Walts #8 hose valve/vacuum breaker with 3/4" hose thread for washdown purposes in the new containment area. Water supply shall be connected to the new 2" water line.

13th AVE PUMP STA ODOR CONTROL REHAB

No.	DATE	REVISIONS	No.	DATE	REVISIONS
3			6		
2			5		
1			4		

DES: CL	CITY of TAMPA DEPARTMENT OF SANITARY SEWERS SANITARY SEWERS DIVISION	13th AVENUE PUMPING STATION ODOR CONTROL REHABILITATION	DRN: MPL	W.O. 5165
CKD: <i>AH</i>			SHEET	
DATE: <i>6-22</i>			2	
			OF 15	

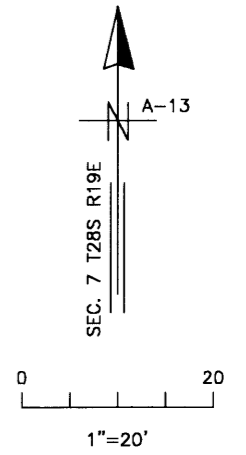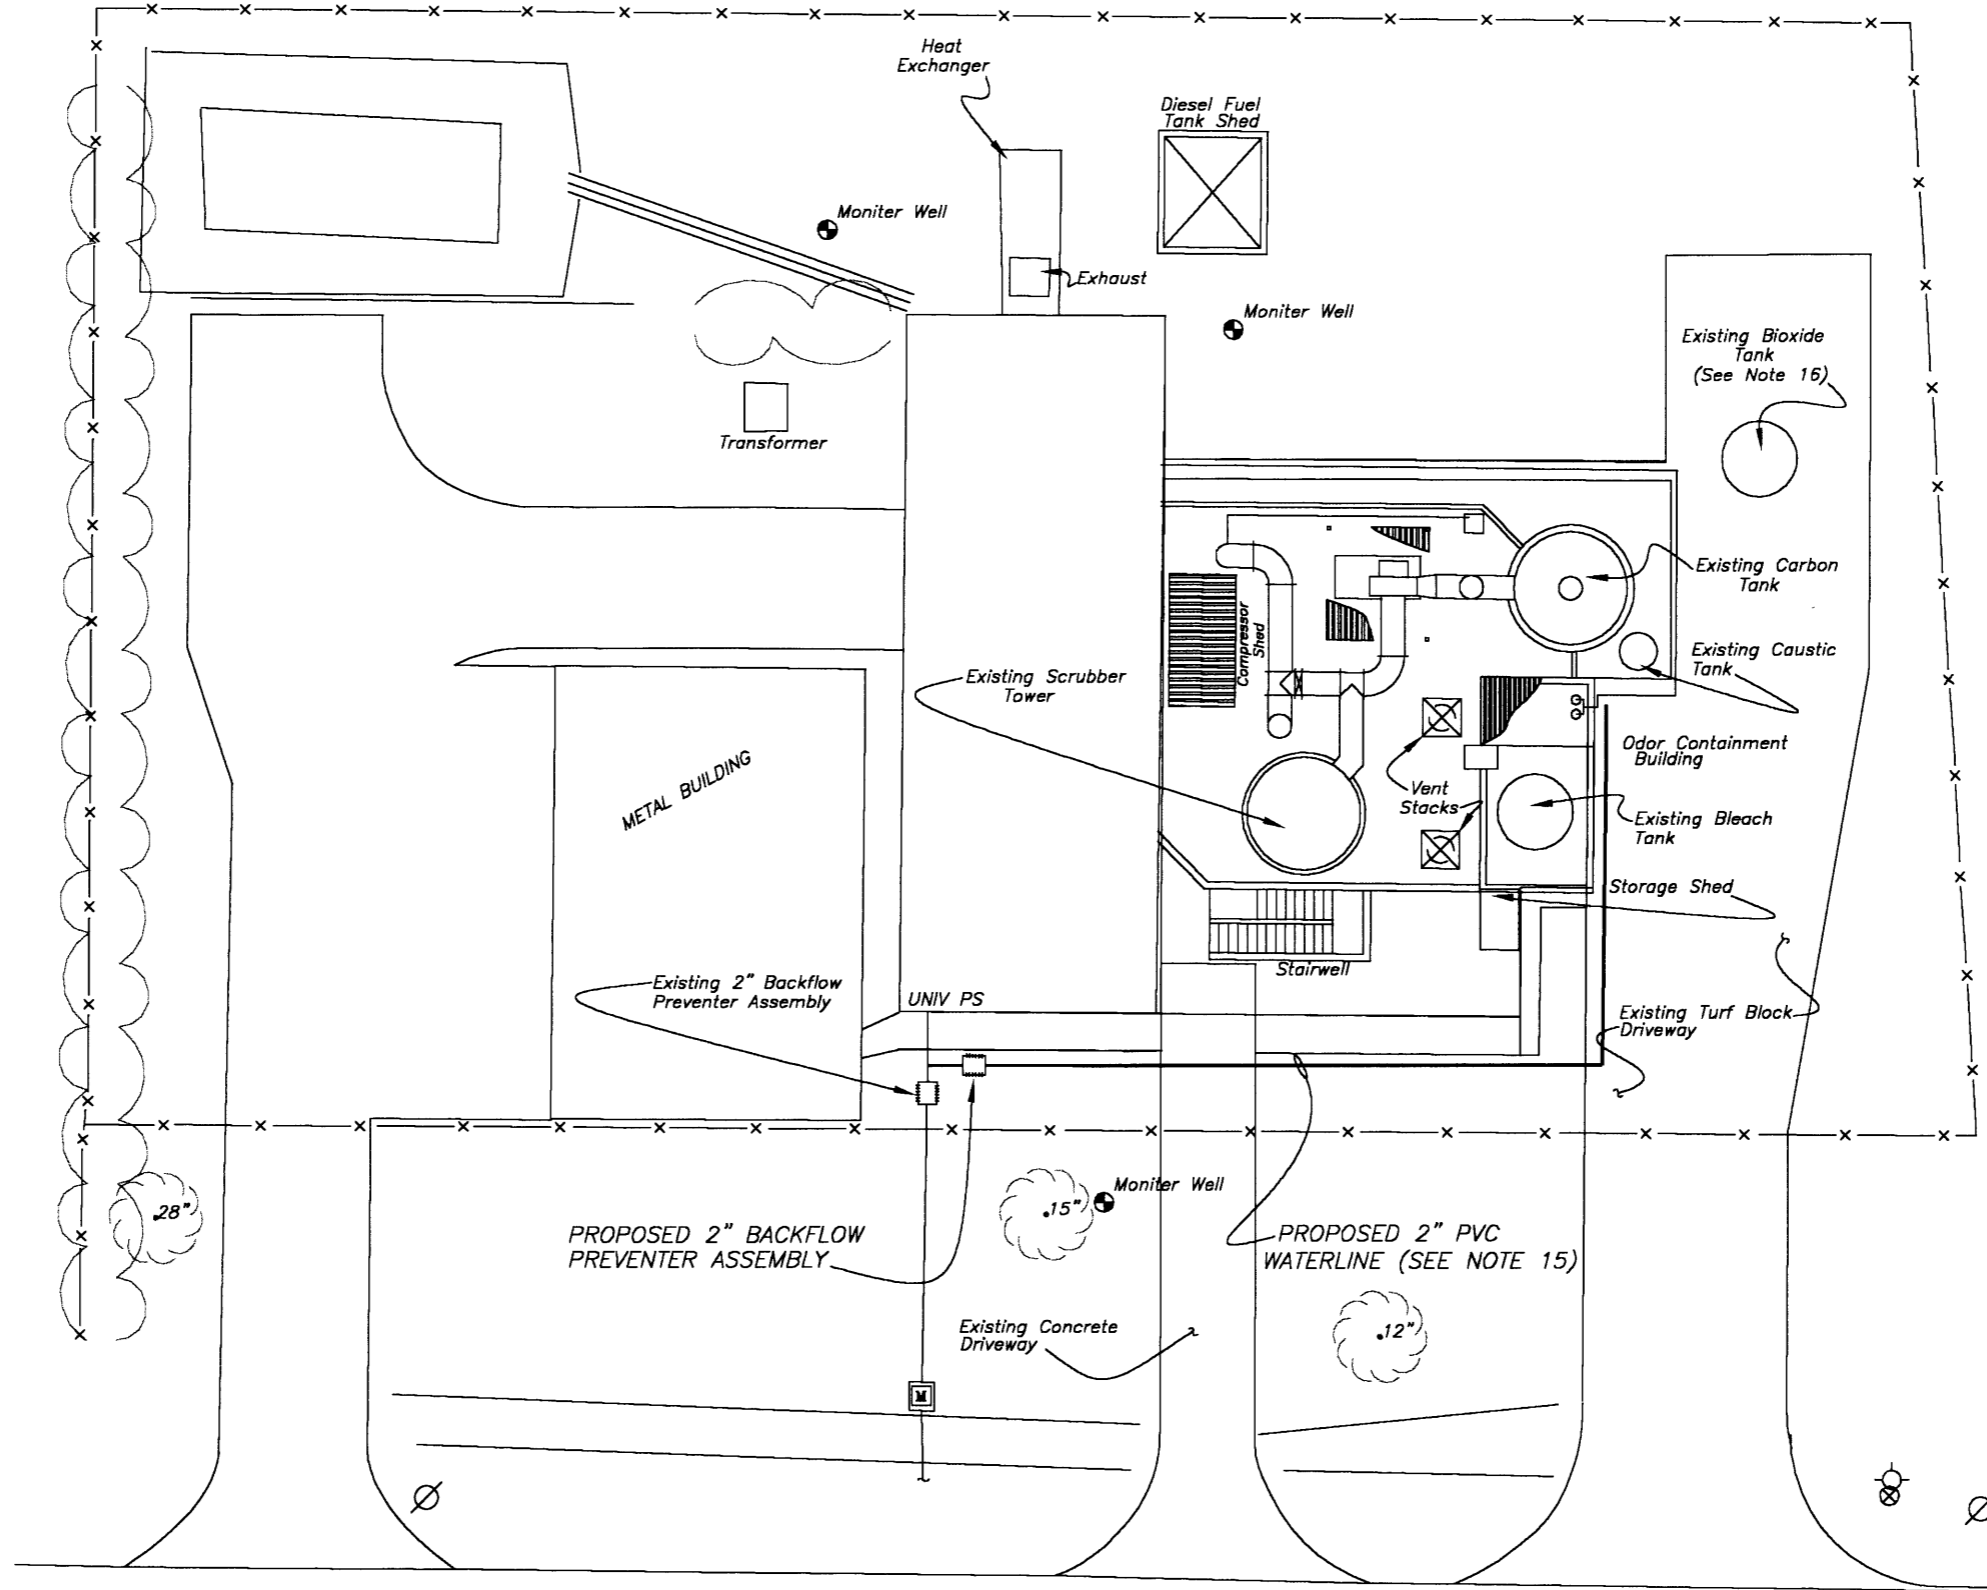

131ST AVE

20

131st AVE PUMP STA ODOR CONTROL REHAB



No.	DATE	REVISIONS	No.	DATE	REVISIONS
3			6		
2			5		
1			4		

DES: CL
 DRN: MPL
 CKD: *AH*
 DATE: *6-02*

CITY of TAMPA
 DEPARTMENT OF SANITARY SEWERS
 SANITARY SEWERS DIVISION

131ST AVENUE PUMPING STATION
 ODOR CONTROL REHABILITATION
 EXISTING SITE PLAN

W.O. 5165
 SHEET
3
 OF 15

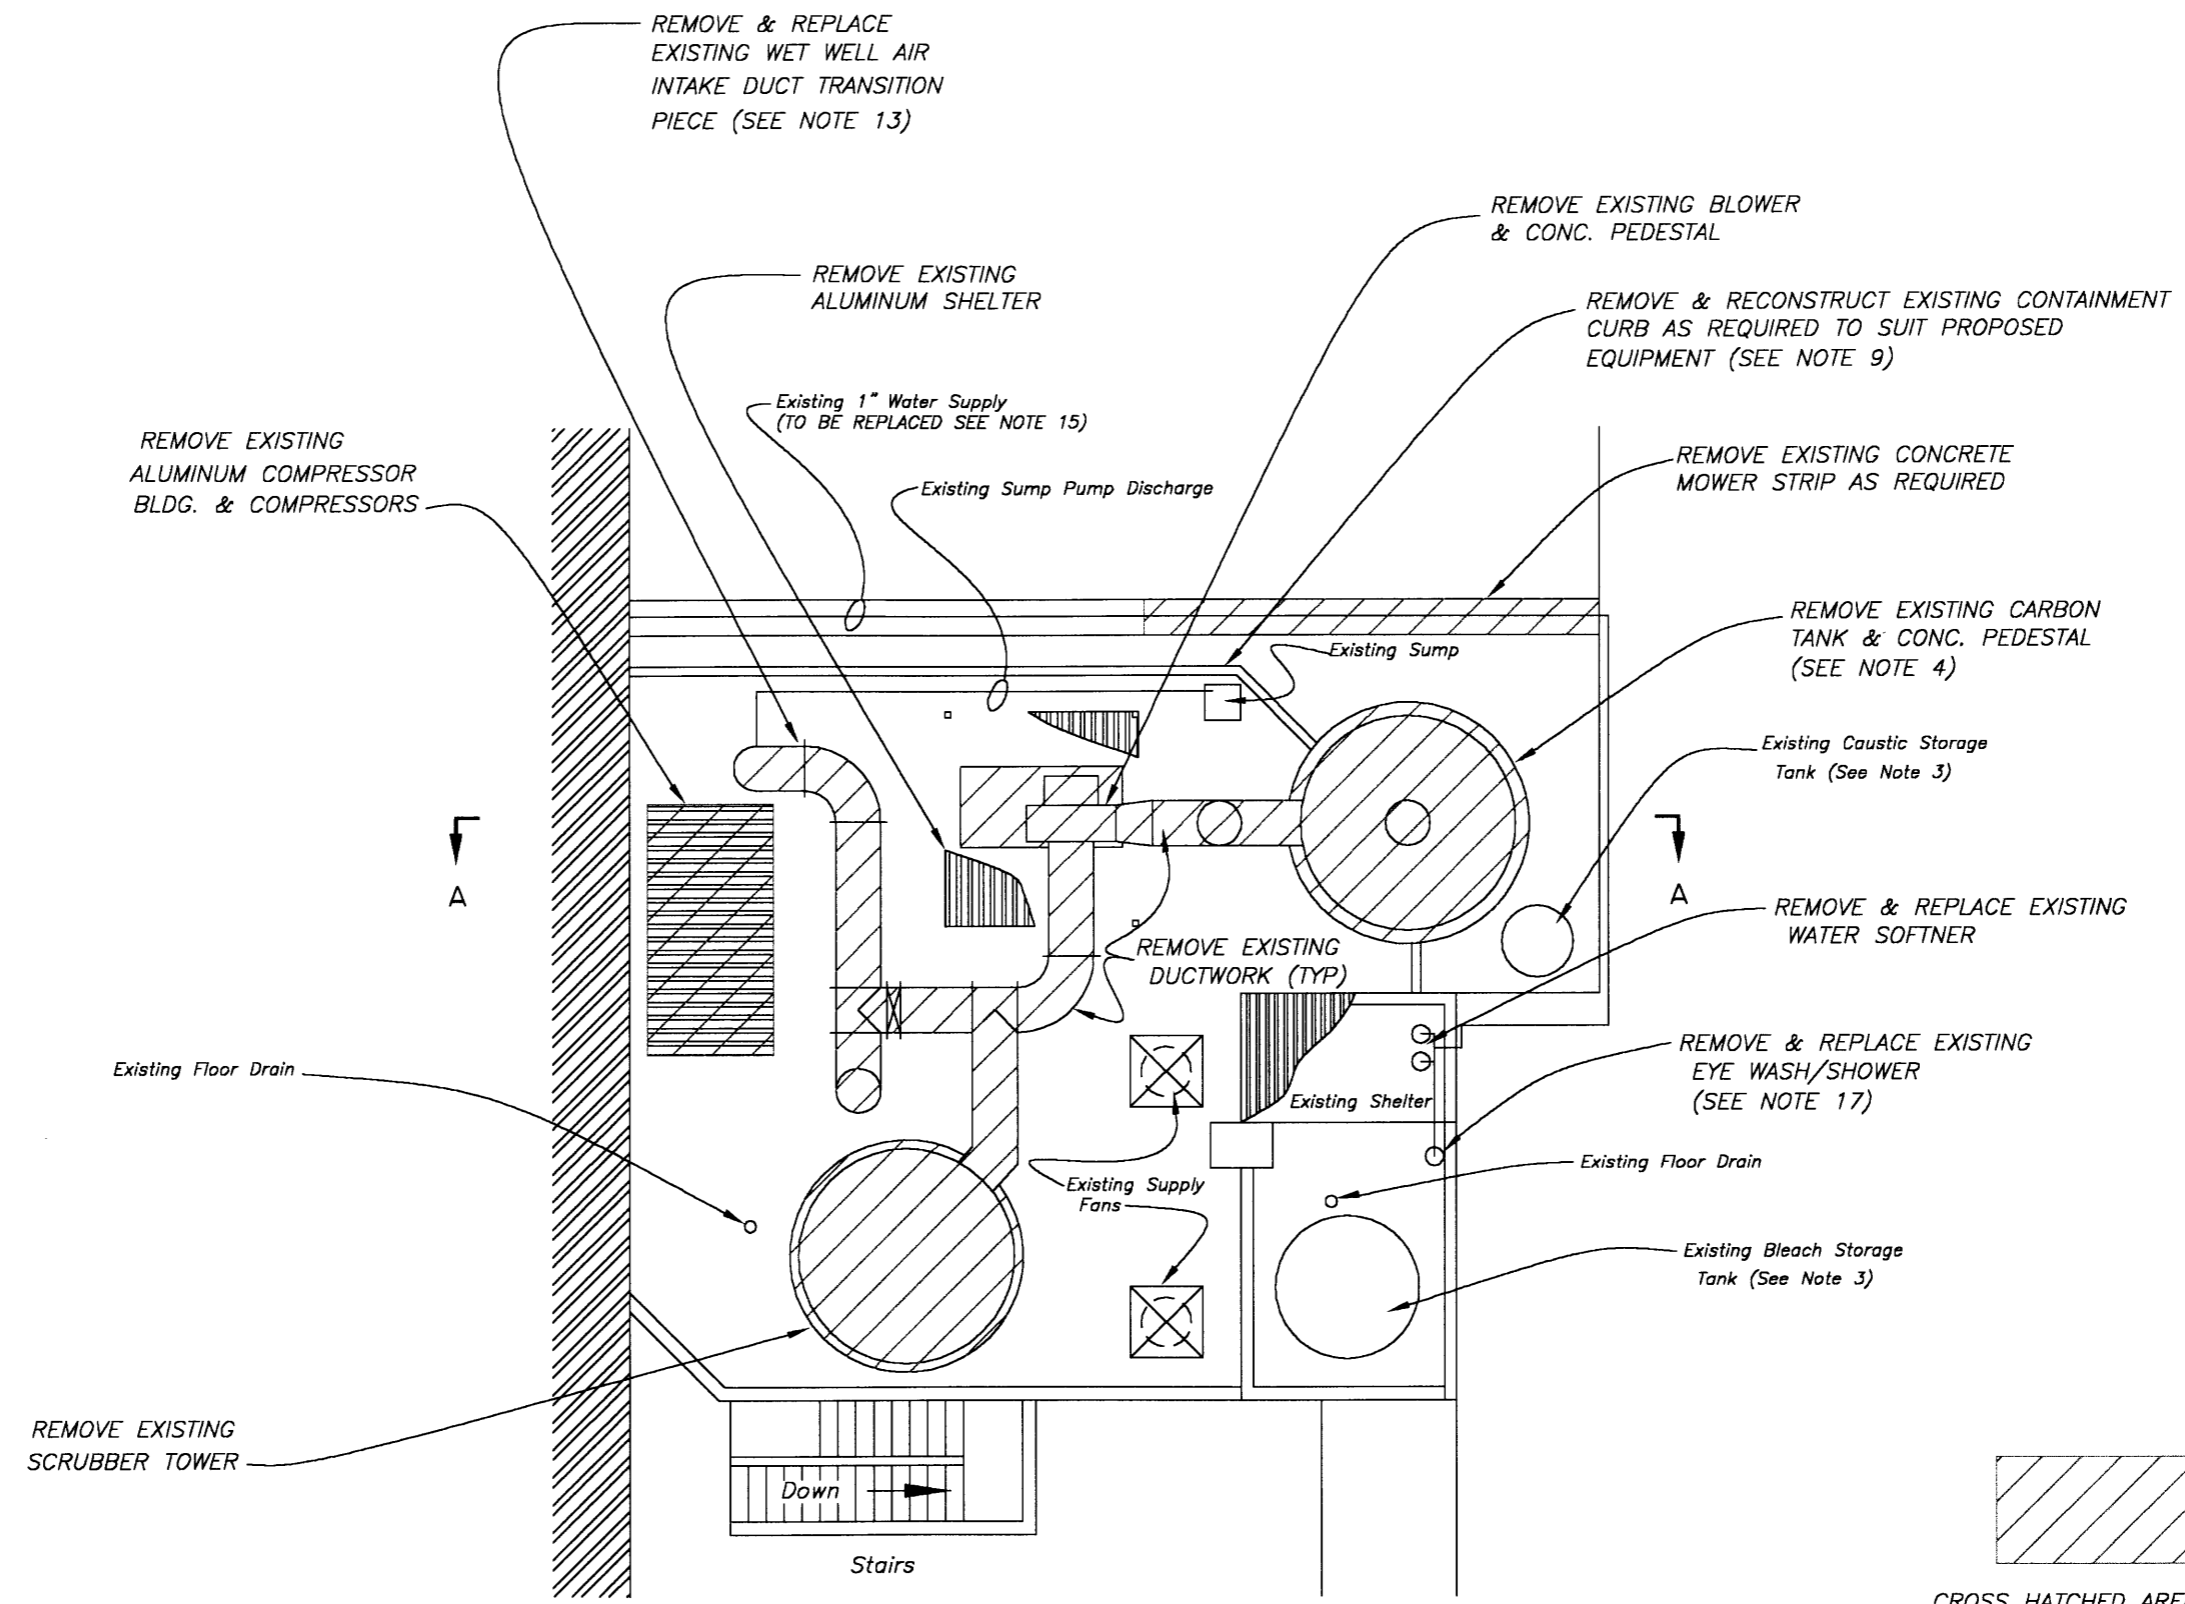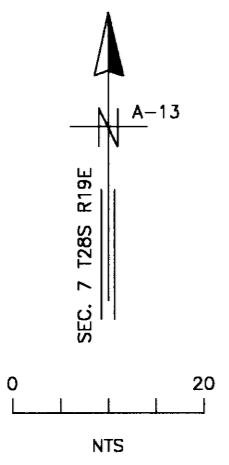

CROSS HATCHED AREAS INDICATE STRUCTURES & EQUIPMENT TO BE REMOVED

PLAN

13th AVE PUMP STA ODOR CONTROL REHAB


No.	DATE	REVISIONS	No.	DATE	REVISIONS
3			6		
2			5		
1			4		

DES: CL
 DRN: MPL
 CKD: Art
 DATE: 6-02

CITY of TAMPA
 DEPARTMENT OF SANITARY SEWERS
 SANITARY SEWERS DIVISION

13th AVENUE PUMPING STATION
 ODOR CONTROL REHABILITATION
 DEMOLITION PLAN VIEW

W.O. 5165
 SHEET
4
 OF 15

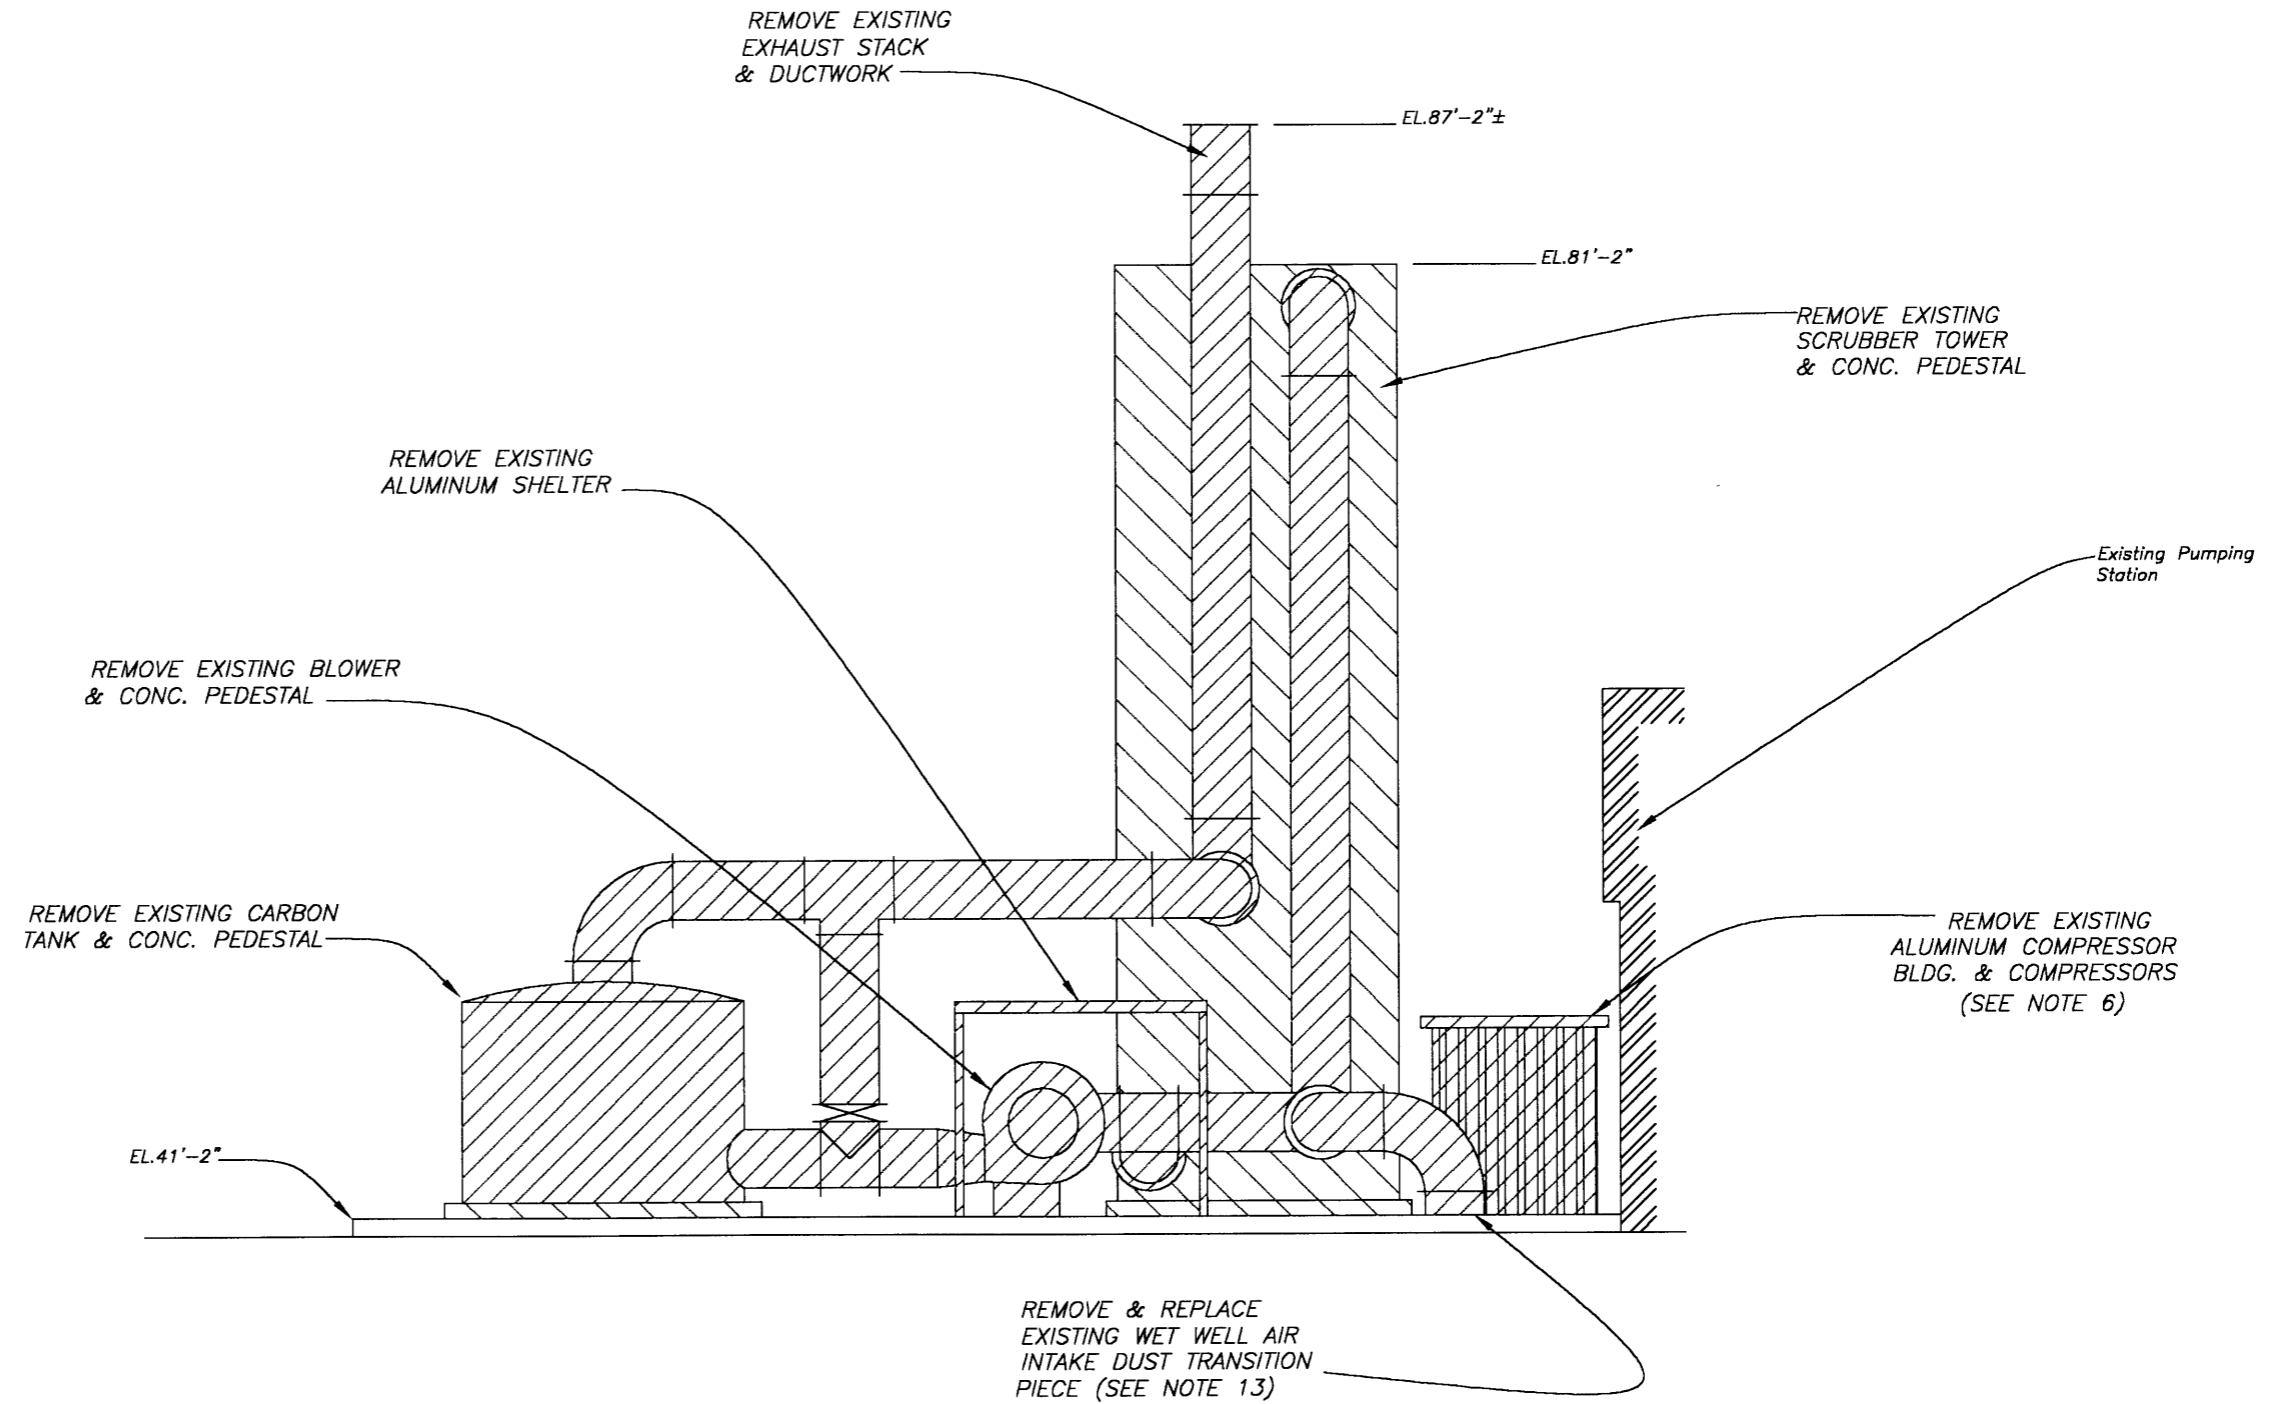

SECTION A-A
Scale 1/8" = 1'


13th AVE PUMP STA ODOR CONTROL REHAB

No.	DATE	REVISIONS	No.	DATE	REVISIONS
3			6		
2			5		
1			4		

DES: CL
DRN: MPL
CKD: *AH*
DATE: *6-02*

CITY of TAMPA
DEPARTMENT OF SANITARY SEWERS
SANITARY SEWERS DIVISION

13th AVENUE PUMPING STATION
ODOR CONTROL REHABILITATION
DEMOLITION SECTION A-A

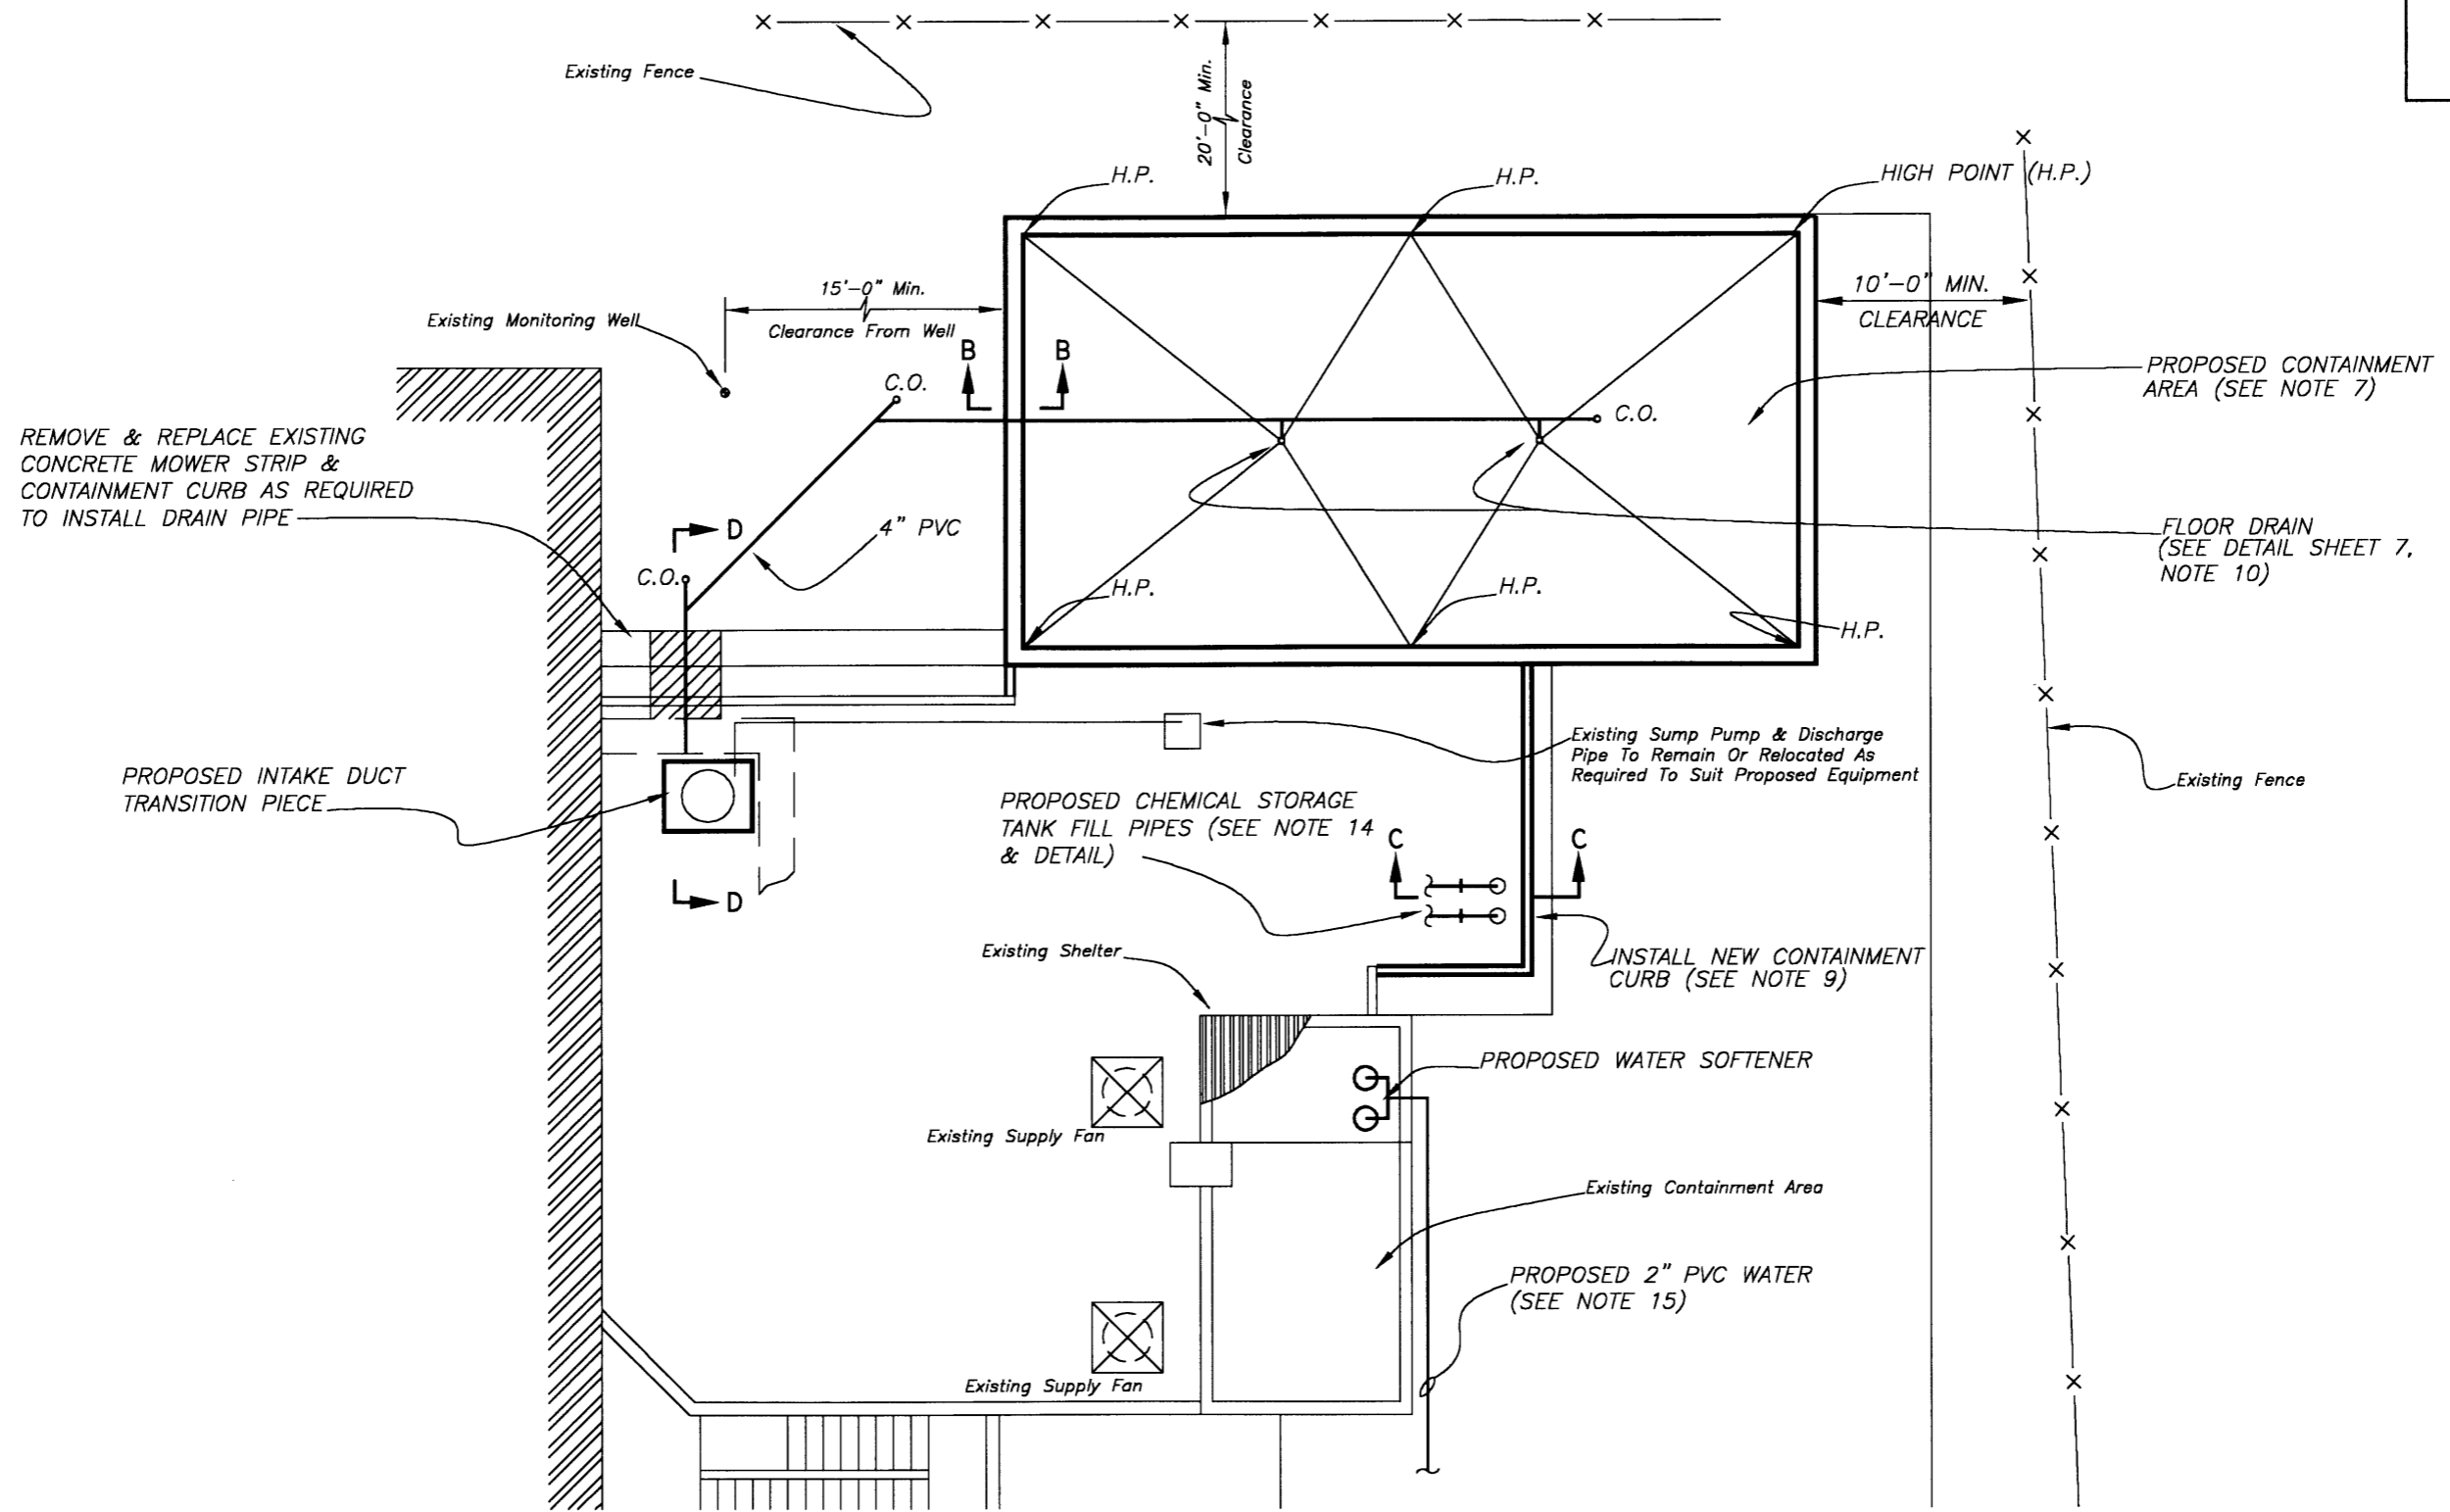

PLAN
Scale 3/32" = 1'





13th AVE PUMP STA ODOR CONTROL REHAB

No.	DATE	REVISIONS	No.	DATE	REVISIONS
3			6		
2			5		
1			4		

DES: CL
DRN: MPL
CKD: *AH*
DATE: *6-02*

CITY of TAMPA
DEPARTMENT OF SANITARY SEWERS
SANITARY SEWERS DIVISION

13th AVENUE PUMPING STATION
ODOR CONTROL REHABILITATION
PROPOSED PLAN

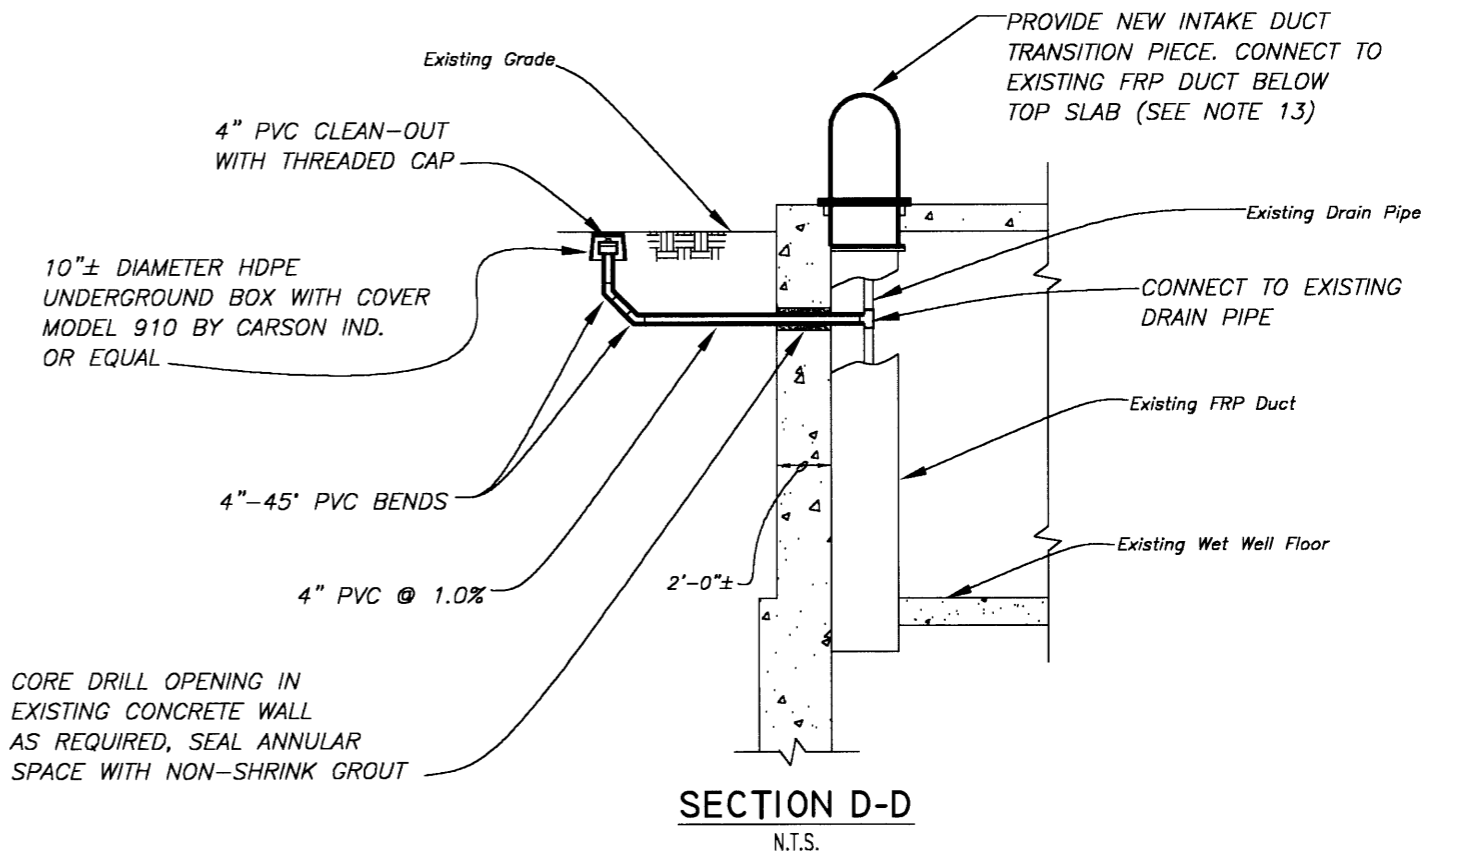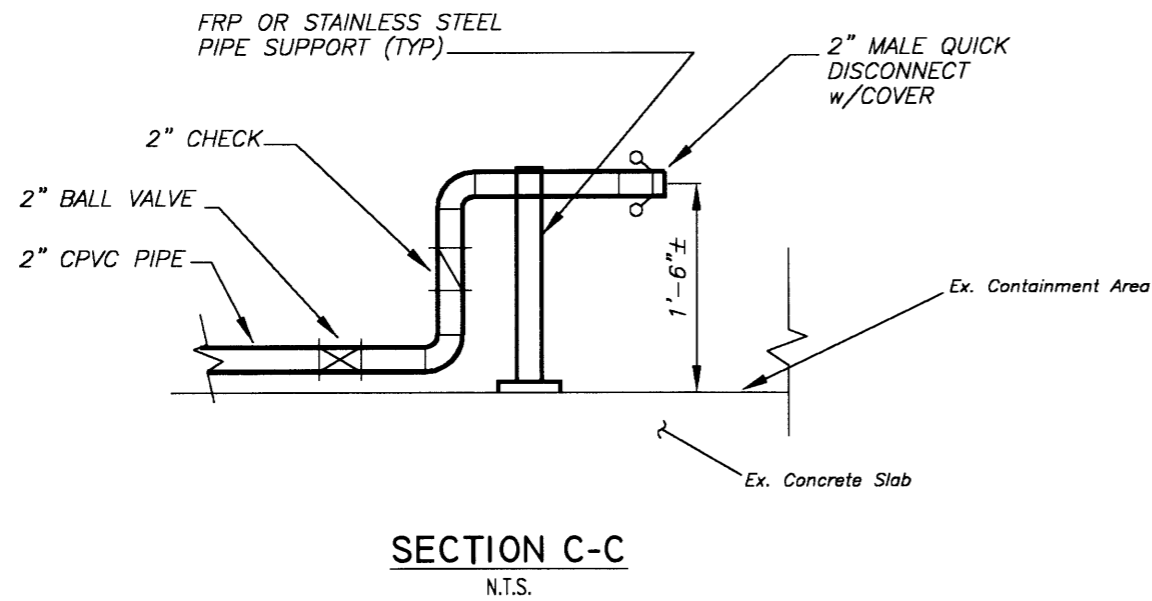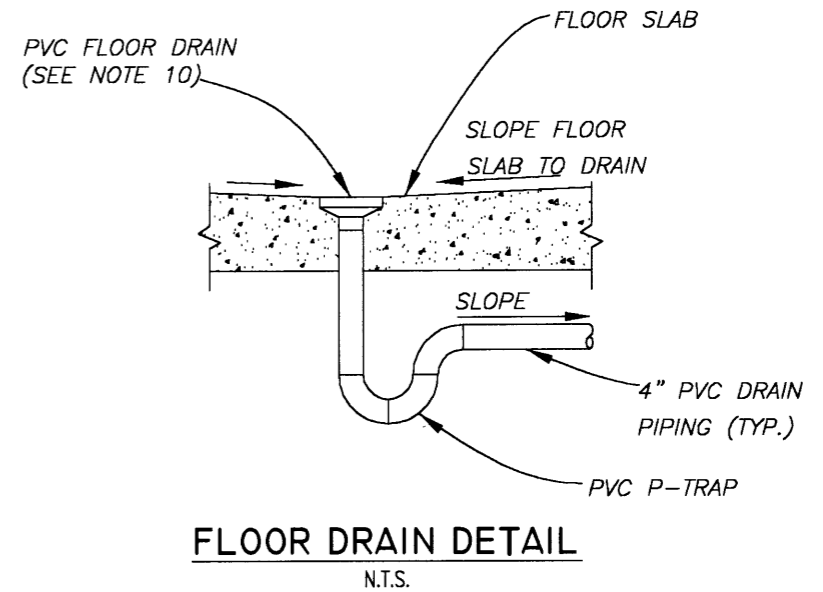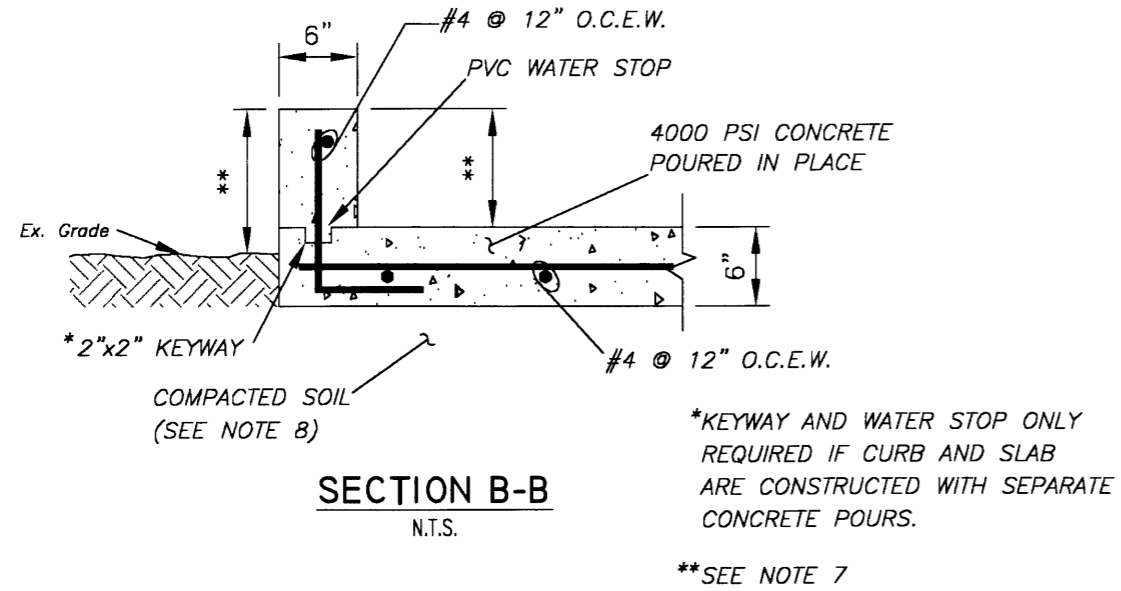

13th AVE PUMP STA ODOR CONTROL REHAB


No.	DATE	REVISIONS	No.	DATE	REVISIONS
3			6		
2			5		
1			4		

DES: CL
DRN: MPL
CKD: **AH**
DATE: 6-02

CITY of TAMPA
DEPARTMENT OF SANITARY SEWERS
SANITARY SEWERS DIVISION

131ST AVENUE PUMPING STATION
ODOR CONTROL REHABILITATION
DETAILS & SECTIONS

W.O. 5165
SHEET
7
OF 15

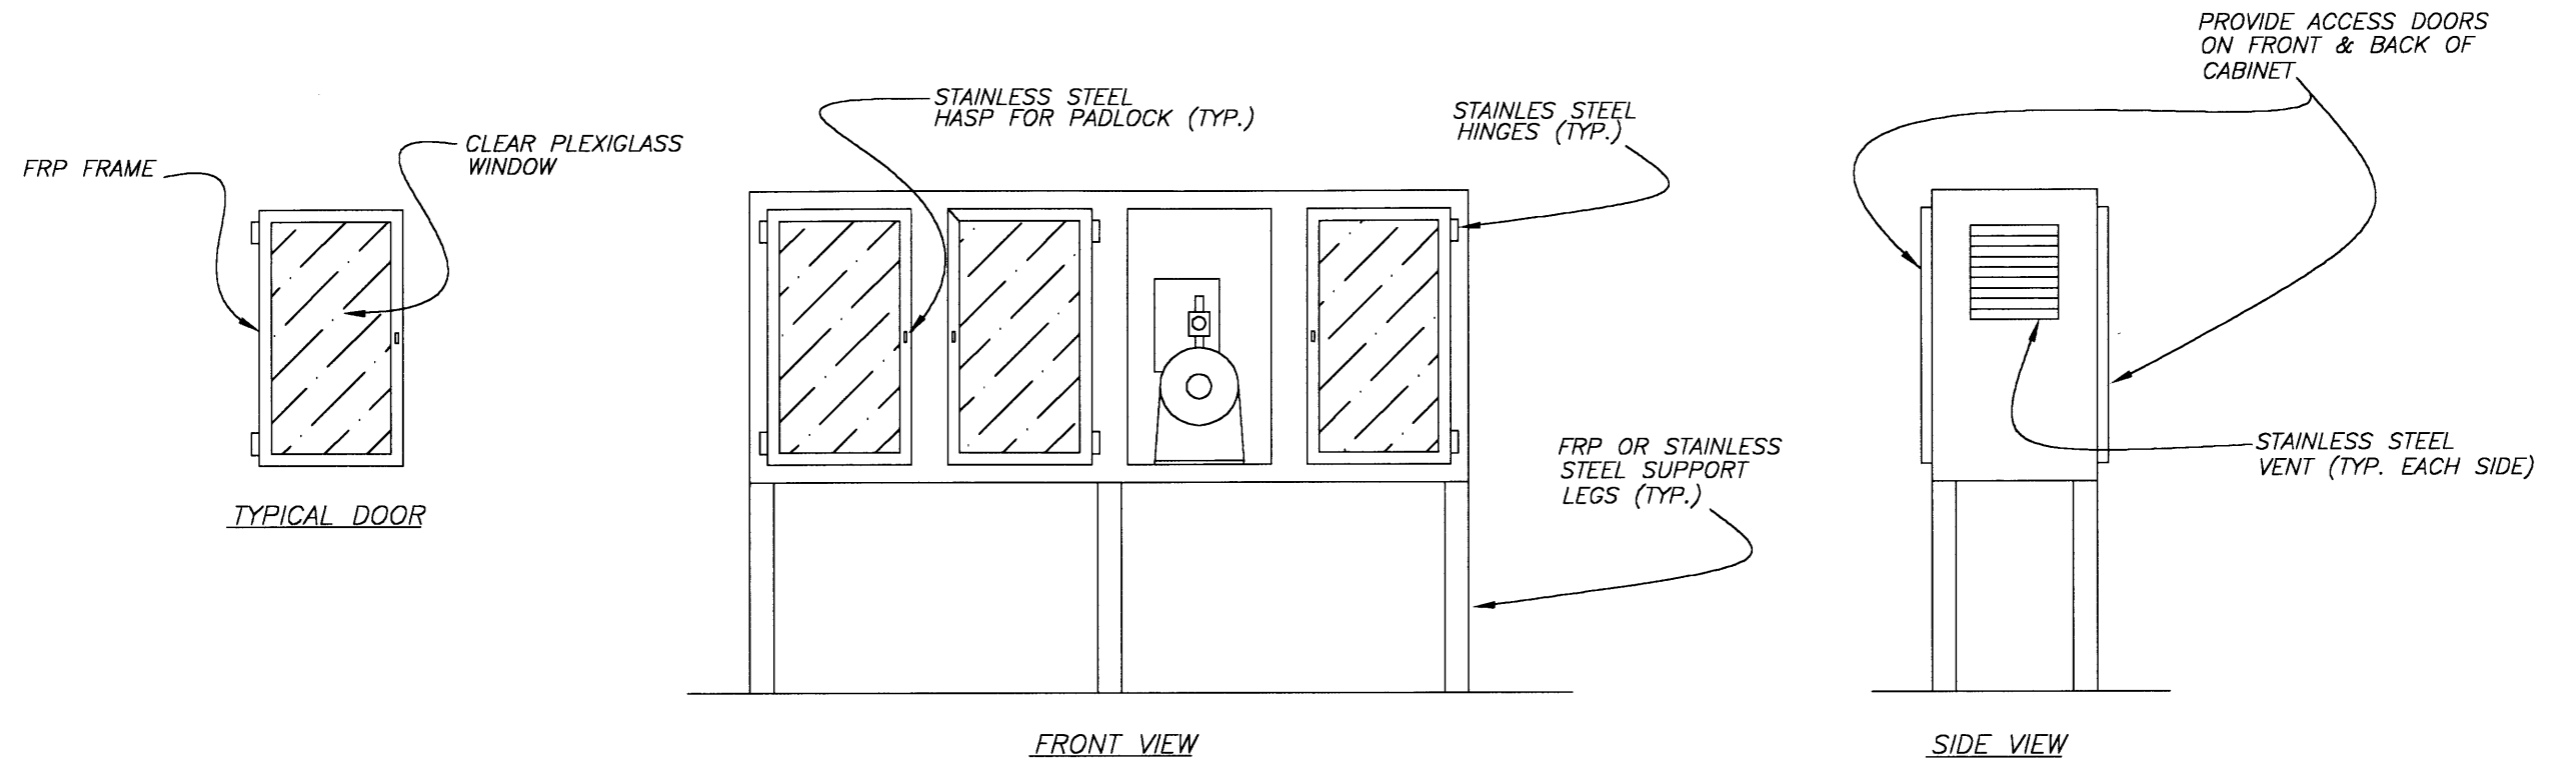

ENCLOSURE/CABINET FOR CHEMICAL METERING PUMPS

NOTES

- 1) These drawings are intended to show the general layout and design of the chemical metering pump enclosures/cabinet. Dimensions of the enclosures/cabinet shall be determined by the Contractor based on final selected equipment. Enclosure/cabinet shall either be designed to house all metering pumps or separate cabinets shall be provided to house the metering pumps for the sodium hypochlorite supply system and the metering pumps for the sodium hydroxide supply system.
- 2) Enclosures shall be constructed of chemical resistant FRP with a minimum thickness of 1/4-inch. Enclosures shall be weather proof and shall be designed to support the chemical metering pumps and a windload of 120 mph.

13th AVE PUMP STA ODOR CONTROL REHAB


No.	DATE	REVISIONS	No.	DATE	REVISIONS
3			6		
2			5		
1			4		

DES: CL
 DRN: MPL
 CKD: A.H.
 DATE: 6-02

CITY of TAMPA
 DEPARTMENT OF SANITARY SEWERS
 SANITARY SEWERS DIVISION

131ST AVENUE PUMPING STATION
ODOR CONTROL REHABILITATION
PUMP CABINET

W.O. 5165
 SHEET
8
 OF 15

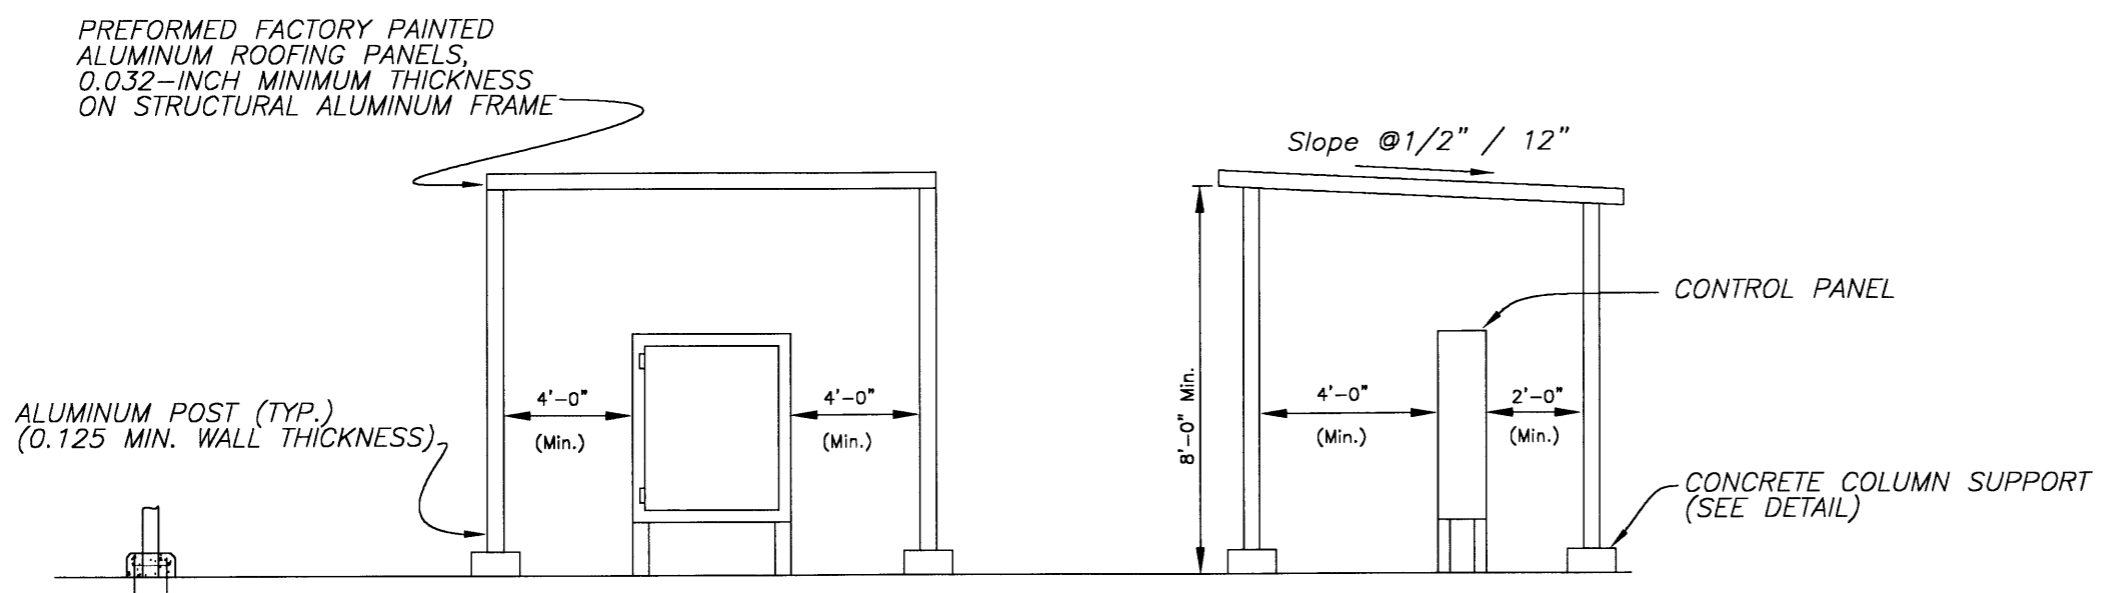


ALUMINUM AWNING DETAIL

N.T.S.

NOTES

- 1) Drawings for the aluminum awning are intended to show the general concept and minimum dimension for the structure. The Contractor shall provide final design in accordance with the Contract Specifications and the Southern Building Code. Contractor shall submit design and details of the structure prior to purchasing materials and fabrication.
- 2) Structural aluminum beams and posts shall be manufactured structural shapes of Alloy 6061-T6, 6063, or other alloy approved by the Aluminum Association for structural purposes.
- 3) All metal surfaces that contact concrete surfaces shall be coated with 2-coats of coal tar epoxy applied to the metal surface.
- 4) Fasteners for aluminum structural members and roofing panels shall either be stainless steel or aluminum. Plated or coated steel fasteners shall not be used.

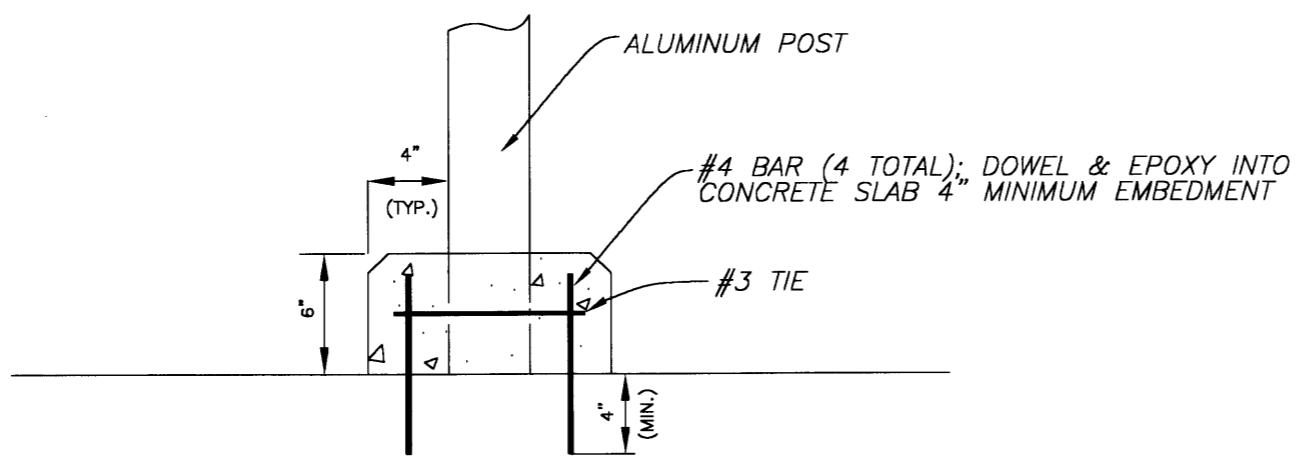


CONCRETE COLUMN SUPPORT


N.T.S.

13th AVE PUMP STA ODOR CONTROL REHAB

No.	DATE	REVISIONS	No.	DATE	REVISIONS	DES: CL DRN: MPL CKD: A.H DATE: 6-02	CITY of TAMPA DEPARTMENT OF SANITARY SEWERS SANITARY SEWERS DIVISION	13 th AVENUE PUMPING STATION ODOR CONTROL REHABILITATION AWNING DETAIL	W.O. 5165 SHEET 9 OF 15
3			6						
2			5						
1			4						

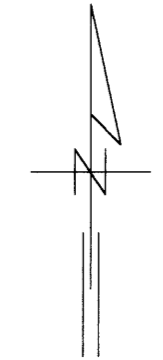

Scale 1/8" = 1'-0"

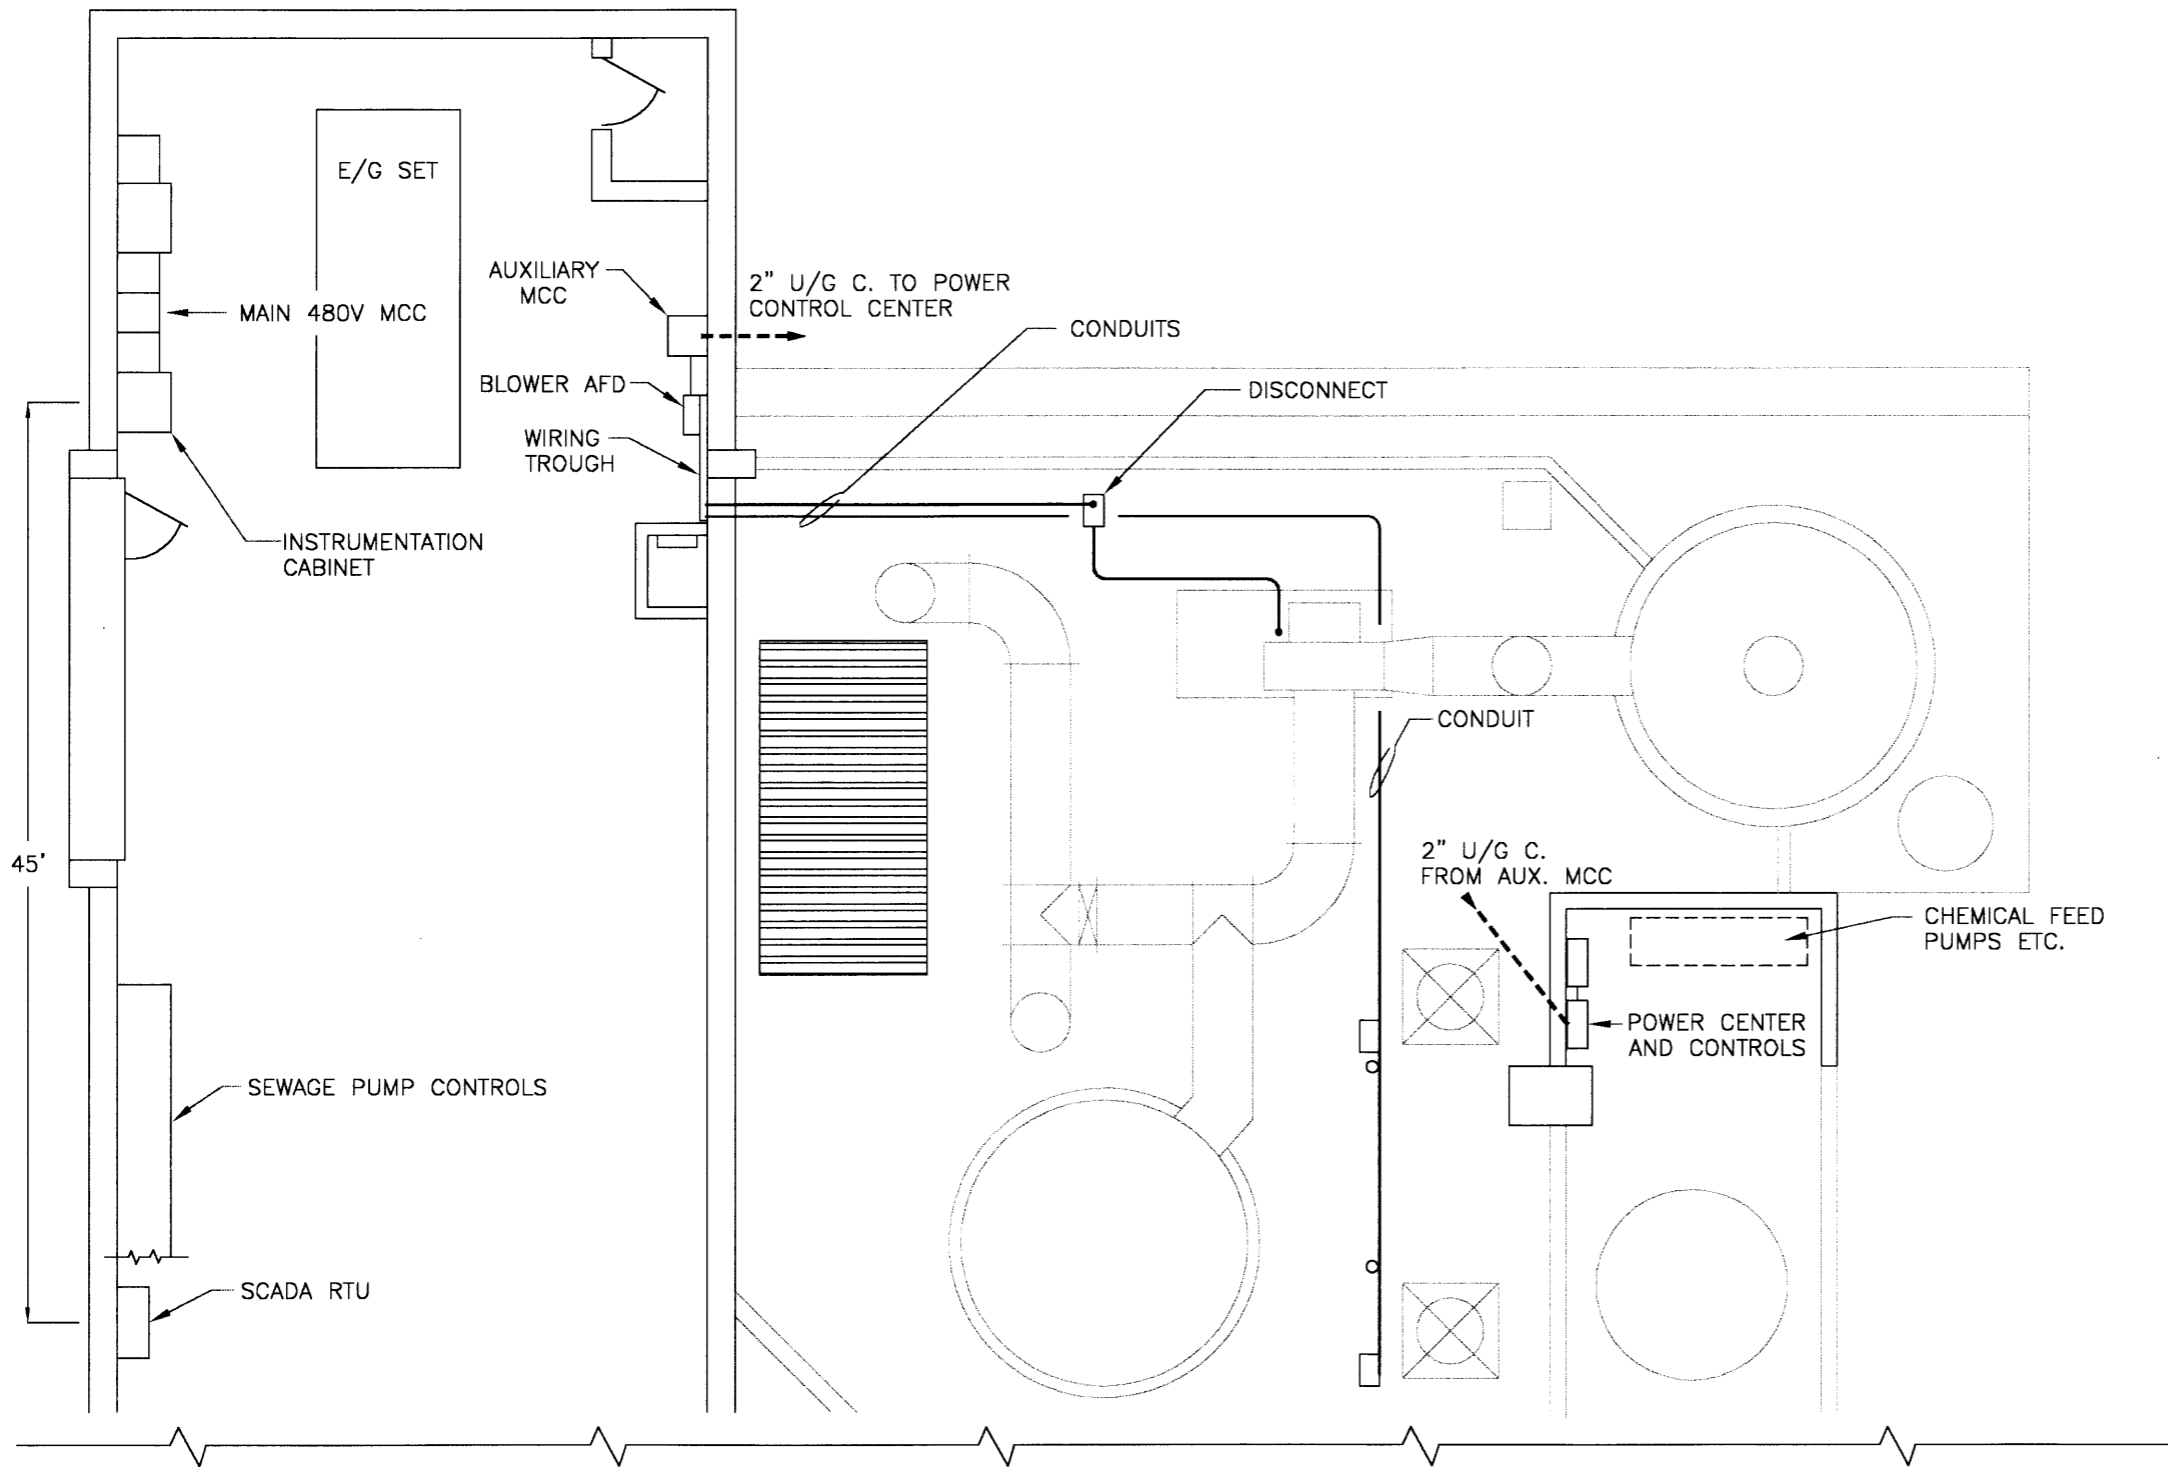

NOTES:

1. THIS DRAWING IS PROVIDED TO OUTLINE, IN GENERAL TERMS, THE EXISTING ODOR CONTROL FACILITIES.
2. THE CONTRACTOR SHALL FIELD VERIFY ALL ELECTRICAL EQUIPMENT AND INTERCONNECTIONS THAT MAY BE OF CONSEQUENCE IN THE EXECUTION OF THIS CONTRACT.

131st AVE PUMP STA. ODOR CONTROL REHAB 1/8"


No.	DATE	REVISIONS	No.	DATE	REVISIONS
3			6		
2			5		
1			4		

DES: RK
 DRN: RK
 CKD:
 DATE:


CITY of TAMPA
 DEPARTMENT OF SANITARY SEWERS
 SANITARY SEWERS DIVISION

**131ST AVE. PUMPING STATION
 ODOR CONTROL REHABILITATION
 EXISTING SITE PLAN**

W.O. 5165
 SHEET
E-1
 OF 15

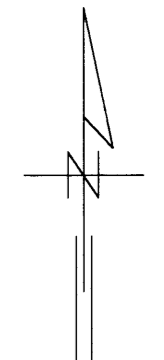

Scale 1/8" = 1'-0"

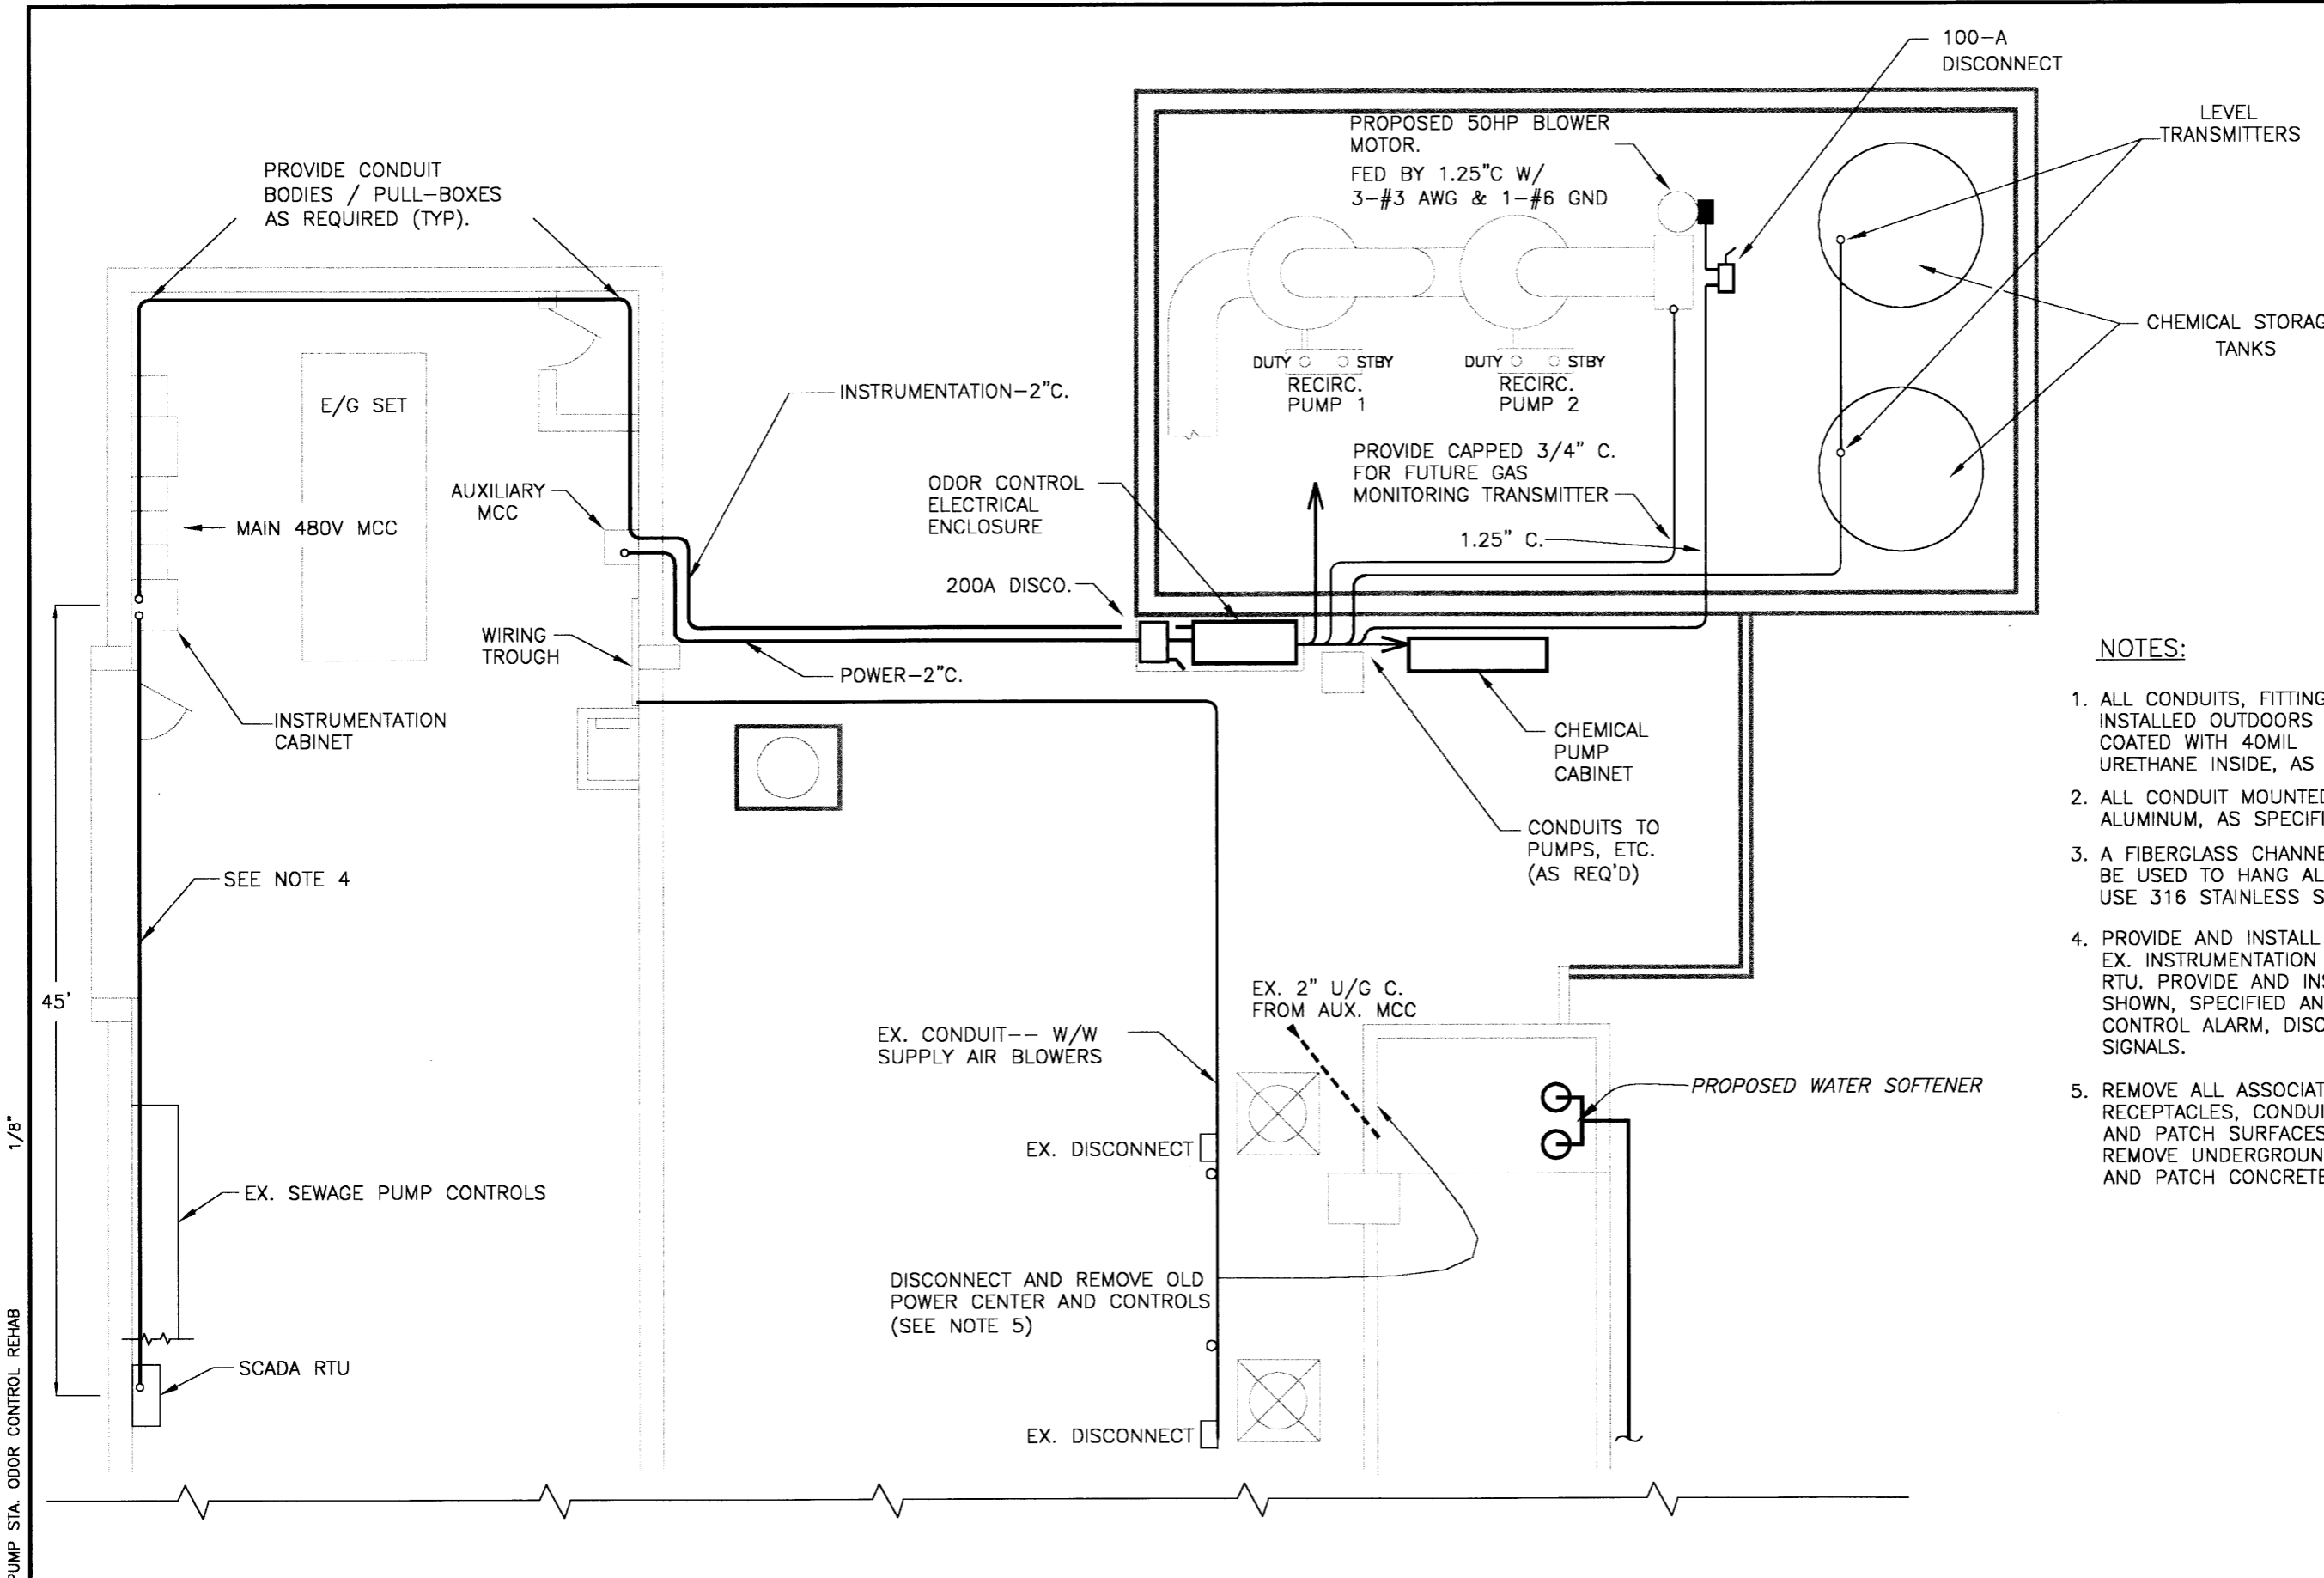

NOTES:

1. ALL CONDUITS, FITTINGS, AND TERMINAL BOXES INSTALLED OUTDOORS SHALL BE RIGID ALUMINUM COATED WITH 40MIL PVC OUTSIDE AND 2MIL URETHANE INSIDE, AS MANUFACTURED BY ROBROY.
2. ALL CONDUIT MOUNTED INSIDE SHALL BE RIGID ALUMINUM, AS SPECIFIED.
3. A FIBERGLASS CHANNEL ERECTOR SYSTEM SHALL BE USED TO HANG ALL CONDUITS, BOXES, ETC. USE 316 STAINLESS STEEL MOUNTING HARDWARE.
4. PROVIDE AND INSTALL A 2" AL. CONDUIT FROM EX. INSTRUMENTATION CABINET TO EX. SCADA RTU. PROVIDE AND INSTALL CONDUCTORS AS SHOWN, SPECIFIED AND REQUIRED FOR ODOR CONTROL ALARM, DISCRETE, AND PROCESS SIGNALS.
5. REMOVE ALL ASSOCIATED LIGHTING, RECEPTACLES, CONDUITS, CONDUCTORS, ETC AND PATCH SURFACES TO MATCH EXISTING. REMOVE UNDERGROUND CONDUITS BELOW GRADE AND PATCH CONCRETE AS REQUIRED.

131st AVE PUMP STA. ODOR CONTROL REHAB


No.	DATE	REVISIONS	No.	DATE	REVISIONS
3			6		
2			5		
1			4		

DES: RK
 DRN: RK
 CKD:
 DATE:


CITY of TAMPA
 DEPARTMENT OF SANITARY SEWERS
 SANITARY SEWERS DIVISION

**131st AVE. PUMPING STATION
 ODOR CONTROL REHABILITATION
 PROPOSED SITE PLAN**

W.O. 5165
 SHEET
E-2
 OF 15

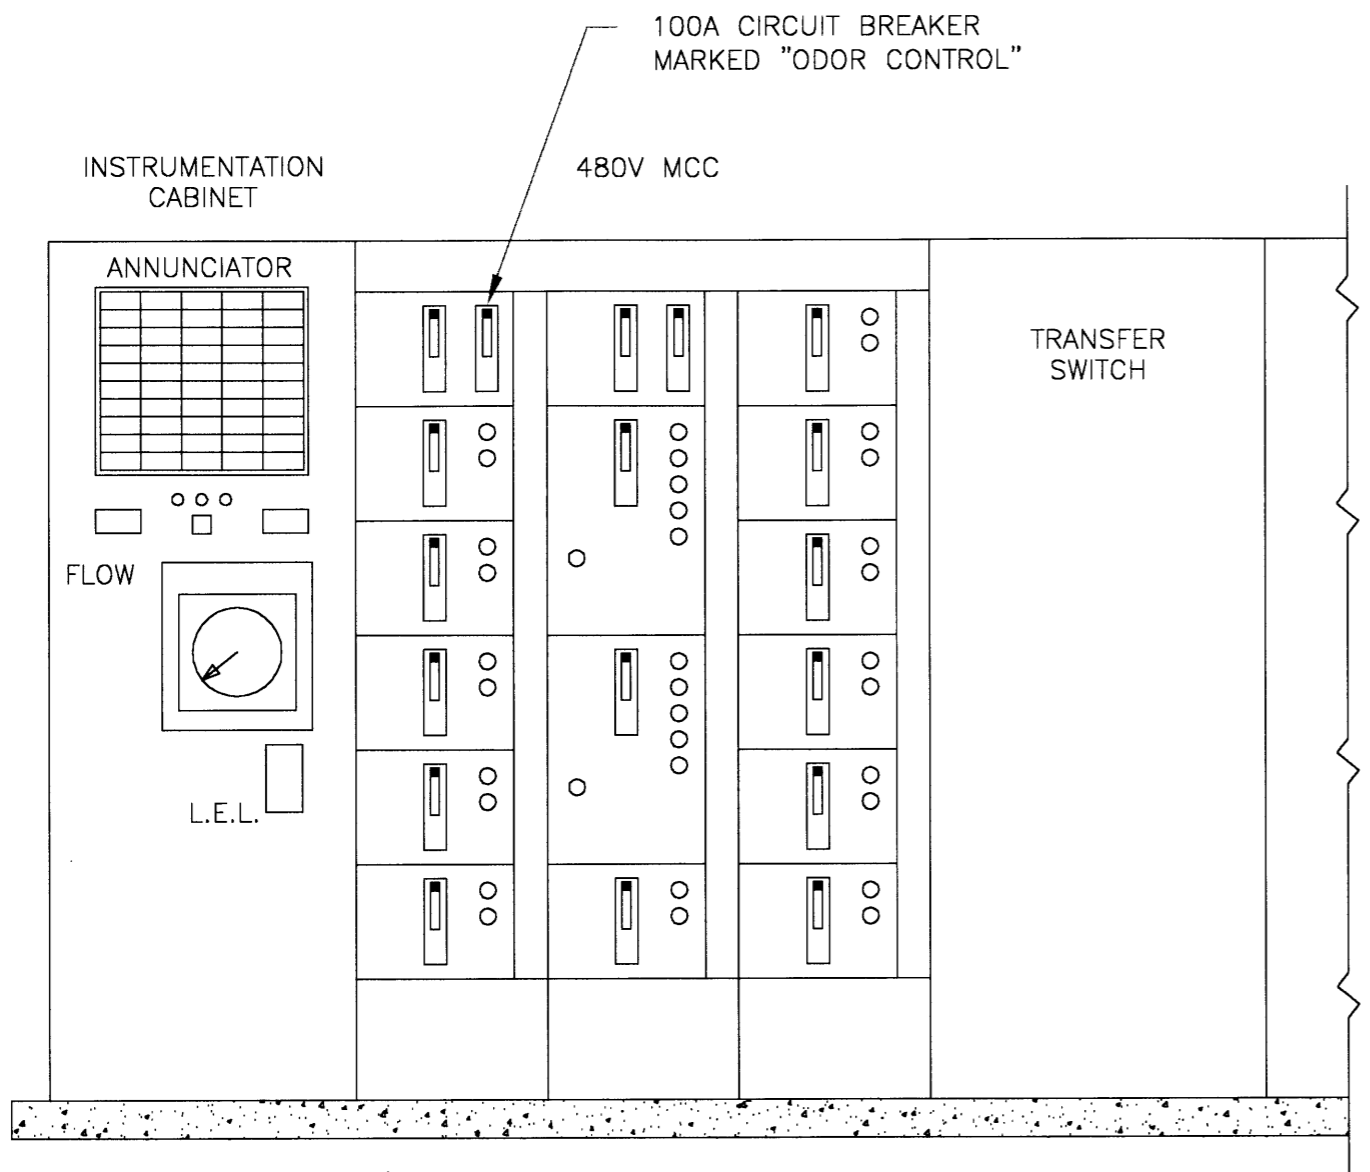

MAIN 480V MCC
(LOCATED ON WEST WALL)

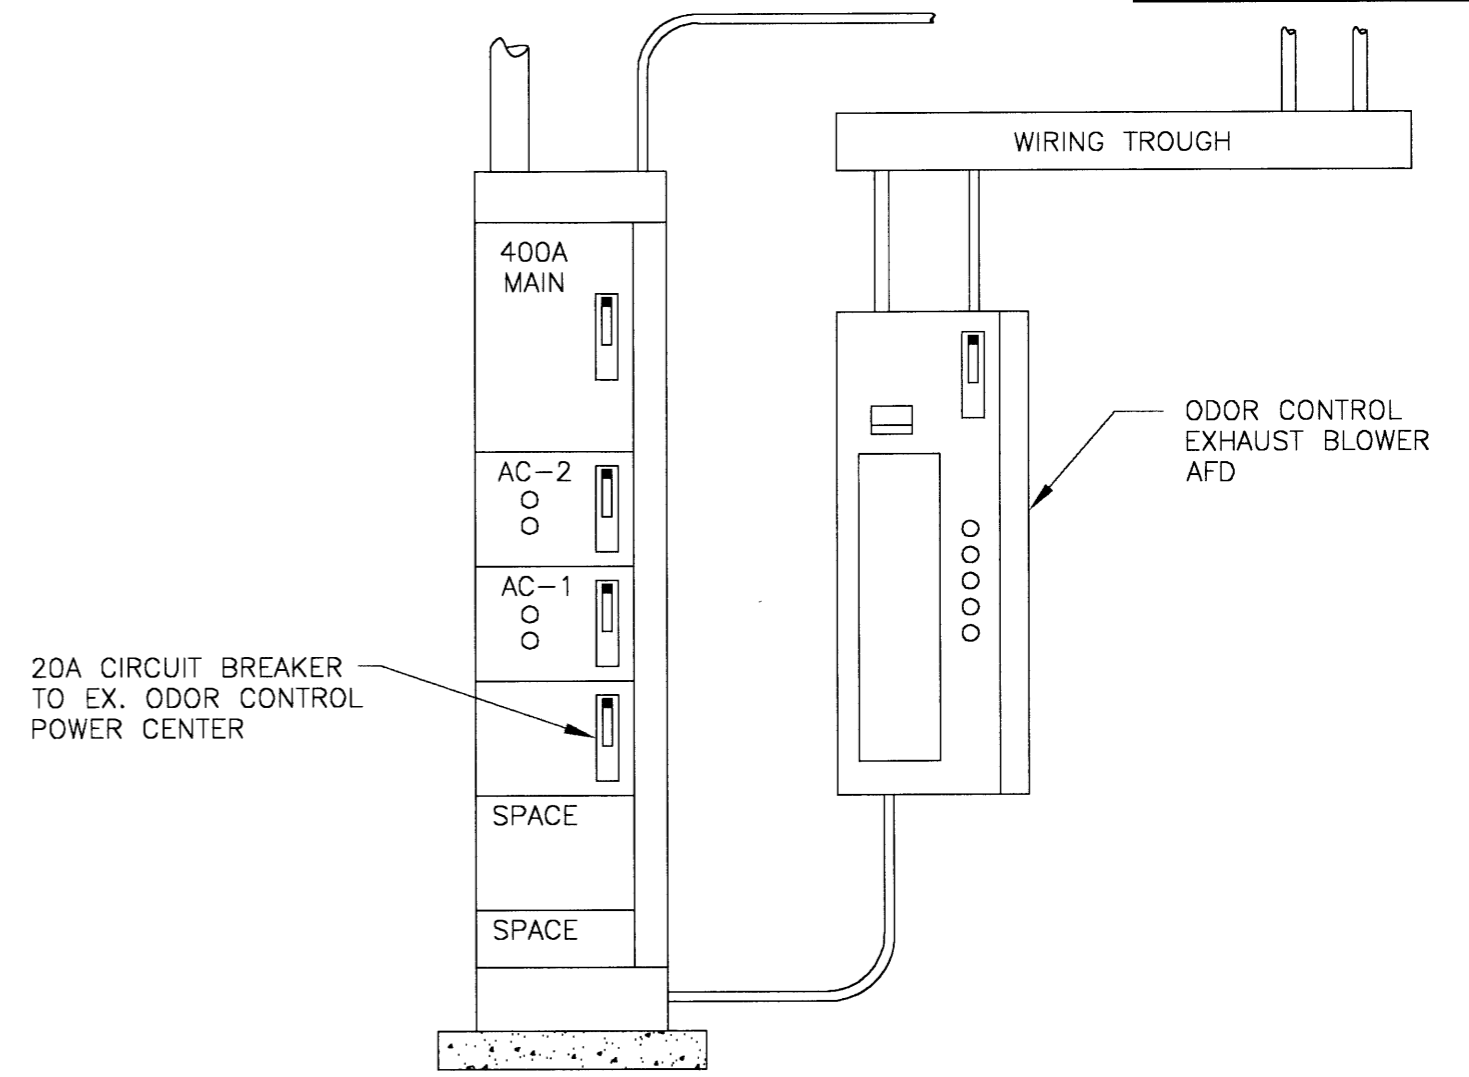

AUXILIARY 480V MCC STRUCTURE
(LOCATED ON EAST WALL)

NOTES:

1. THIS DRAWING IS PROVIDED TO OUTLINE, IN GENERAL TERMS, THE EXISTING ODOR CONTROL FACILITIES.
2. THE CONTRACTOR SHALL FIELD VERIFY ALL ELECTRICAL EQUIPMENT AND INTERCONNECTIONS THAT MAY BE OF CONSEQUENCE IN THE EXECUTION OF THIS CONTRACT.


131st AVE PUMP STA. ODOR CONTROL REHAB

No.	DATE	REVISIONS	No.	DATE	REVISIONS
3			6		
2			5		
1			4		


DES: RK
DRN: RK
CKD:
DATE:

CITY of TAMPA
DEPARTMENT OF SANITARY SEWERS
SANITARY SEWERS DIVISION

131st AVE. PUMPING STATION
ODOR CONTROL REHABILITATION
EXISTING MCC

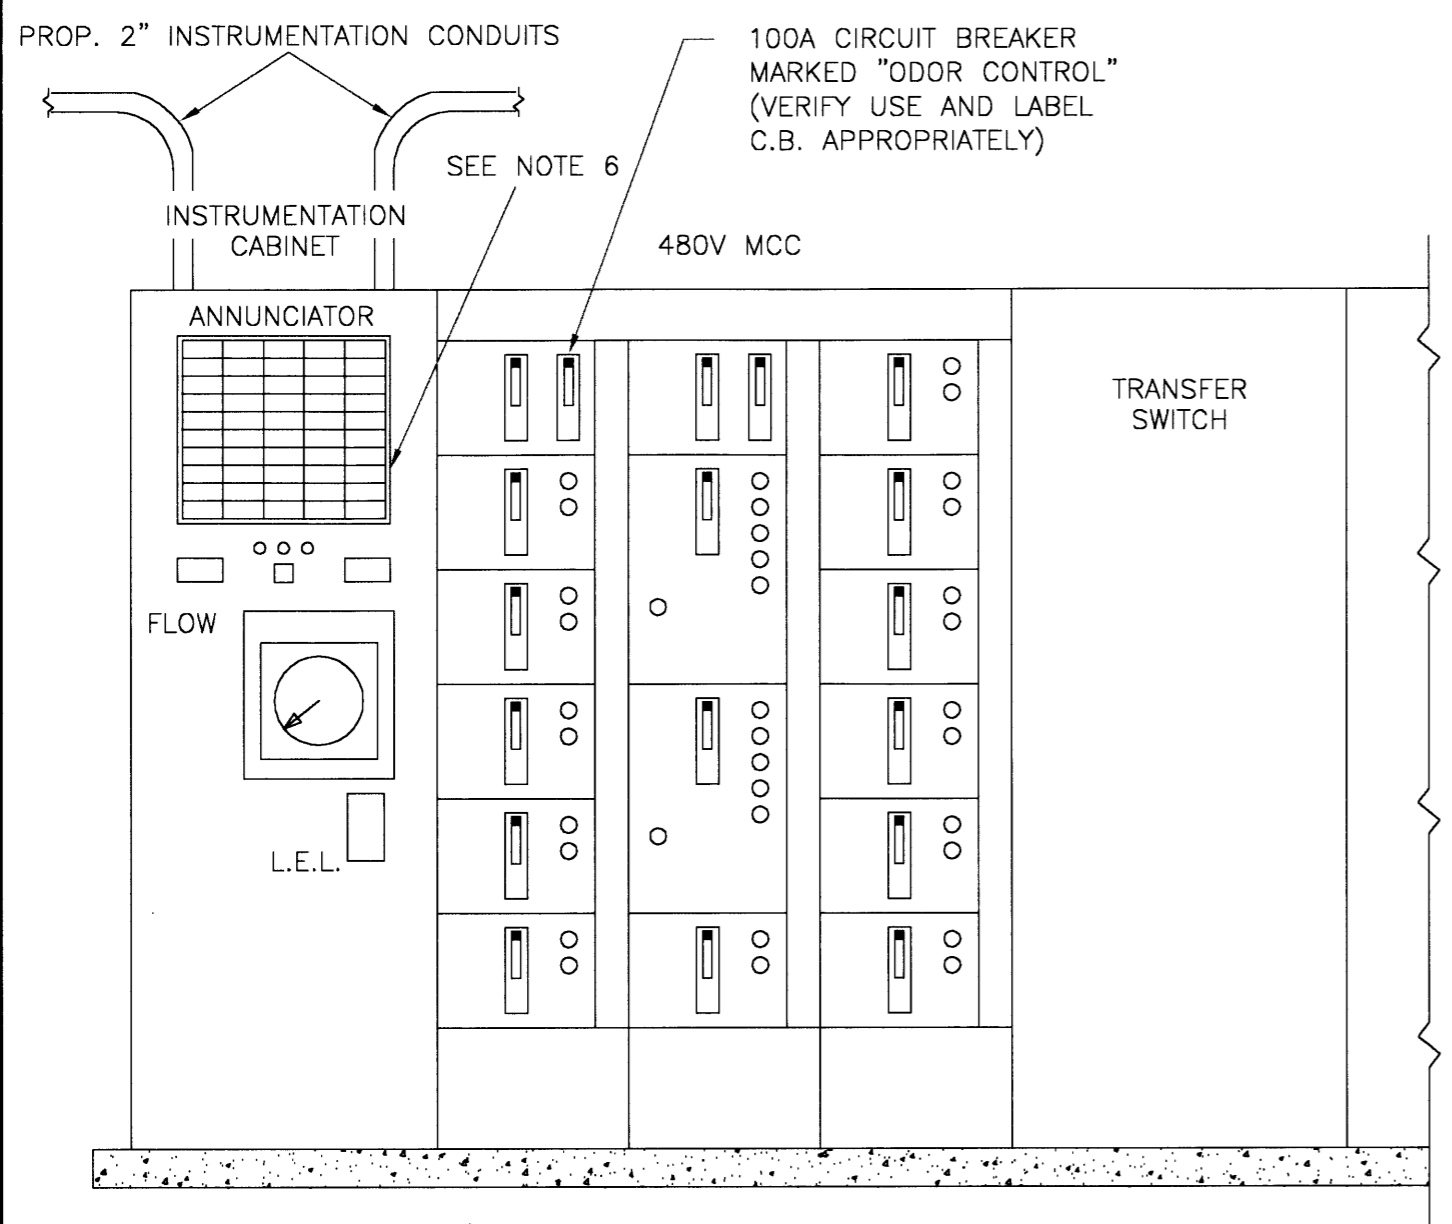

MAIN 480V MCC
(LOCATED ON WEST WALL)

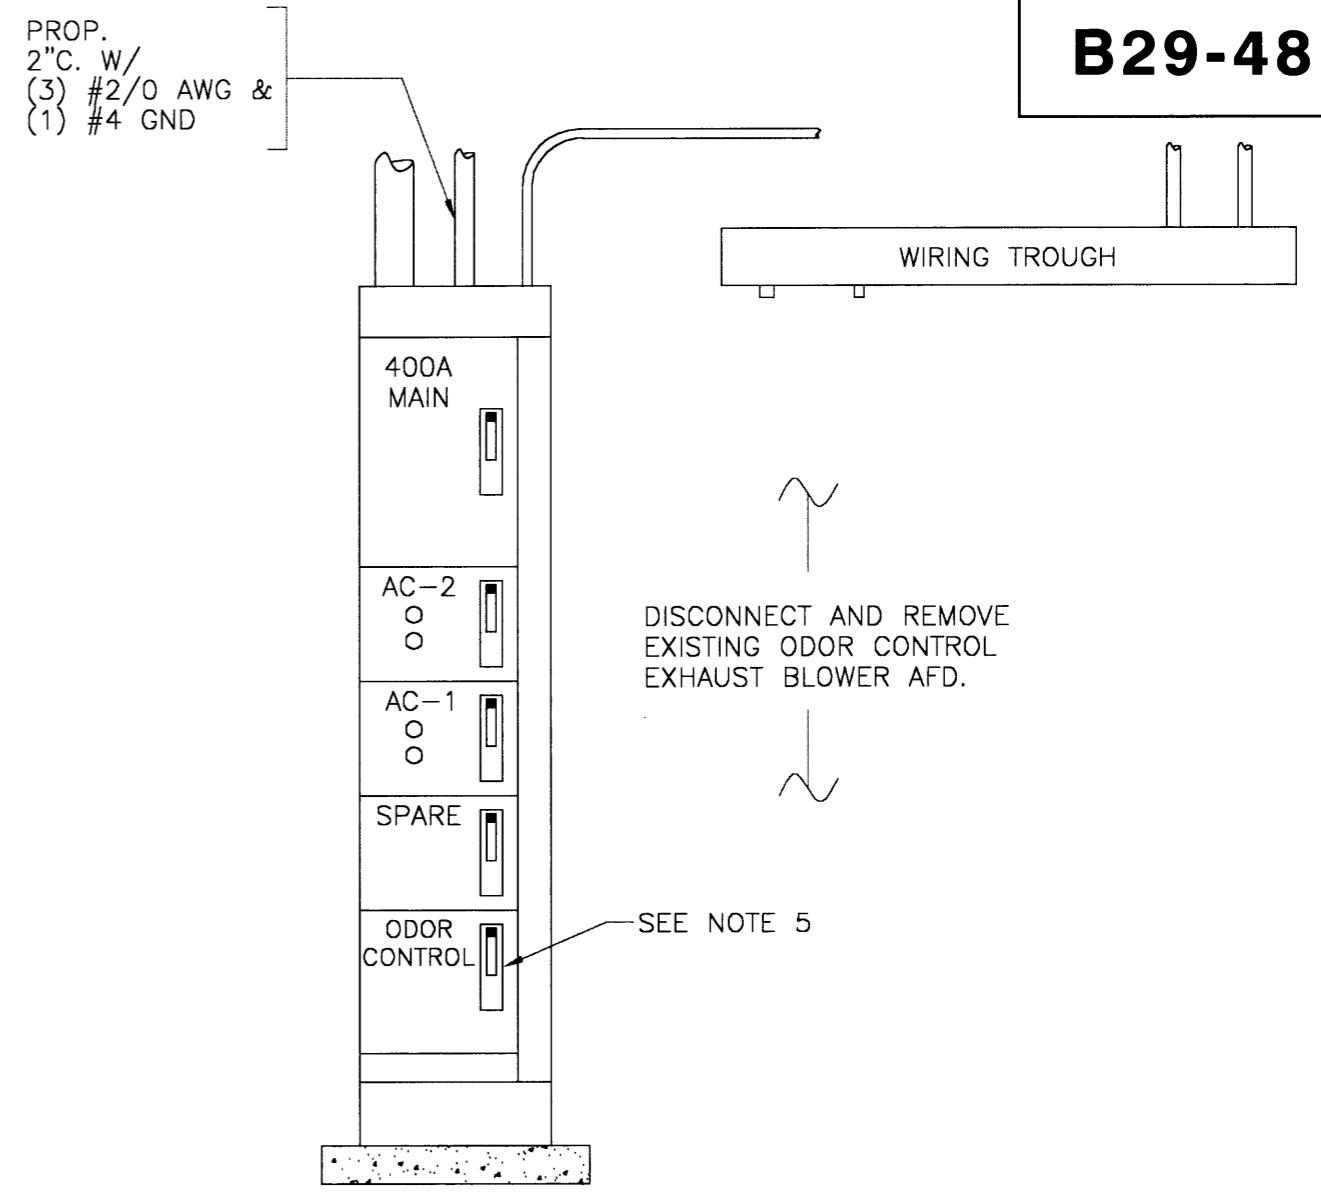

AUXILIARY 480V MCC STRUCTURE
(LOCATED ON EAST WALL)

NOTES:

1. ALL CONDUITS, FITTINGS, AND TERMINAL BOXES INSTALLED OUTDOORS SHALL BE RIGID ALUMINUM COATED WITH 40MIL PVC OUTSIDE AND 2MIL URETHANE INSIDE, AS MANUFACTURED BY ROBROY.
2. ALL CONDUIT MOUNTED INSIDE SHALL BE RIGID ALUMINUM, AS SPECIFIED.
3. A FIBERGLASS CHANNEL ERECTOR SYSTEM SHALL BE USED TO HANG ALL CONDUITS, BOXES, ETC. USE 316 STAINLESS STEEL MOUNTING HARDWARE.
4. THE CONTRACTOR SHALL FIELD VERIFY EXISTING CONDITIONS AND MAKE ADJUSTMENTS AS NECESSARY TO EXECUTE THIS CONTRACT.
5. PROVIDE NEW ODOR CONTROL SYSTEM FEEDER CIRCUIT BREAKER AS SHOWN, SPECIFIED, OR REQUIRED. MINIMUM INTERRUPTING CAPACITY SHALL BE 50KA @ 480V. MODIFY MCC CUBICLES AS REQUIRED. REMAINING CUBICLES SHALL BE MARKED AS SHOWN.
6. MODIFY EXISTING ANNUNCIATOR WINDOWS AND ALARM ELECTRONICS TO FACILITATE PROPOSED "ODOR CONTROL STAGE-1 FAULT", "ODOR CONTROL STAGE-2 FAULT", AND "EXHAUST BLOWER FAULT" INDICATION. CITY INSTRUMENTATION PERSONNEL WILL MAKE FINAL SCADA RTU CONNECTION.

131st AVE PUMP STA. ODOR CONTROL REHAB


No.	DATE	REVISIONS	No.	DATE	REVISIONS
3			6		
2			5		
1			4		

DES: RK
DRN: RK
CKD:
DATE:

CITY of TAMPA
DEPARTMENT OF SANITARY SEWERS
SANITARY SEWERS DIVISION


131st AVE. PUMPING STATION
ODOR CONTROL REHABILITATION
PROPOSED MCC MODIFICATIONS

W.O. 5165
SHEET
E-4
OF 15

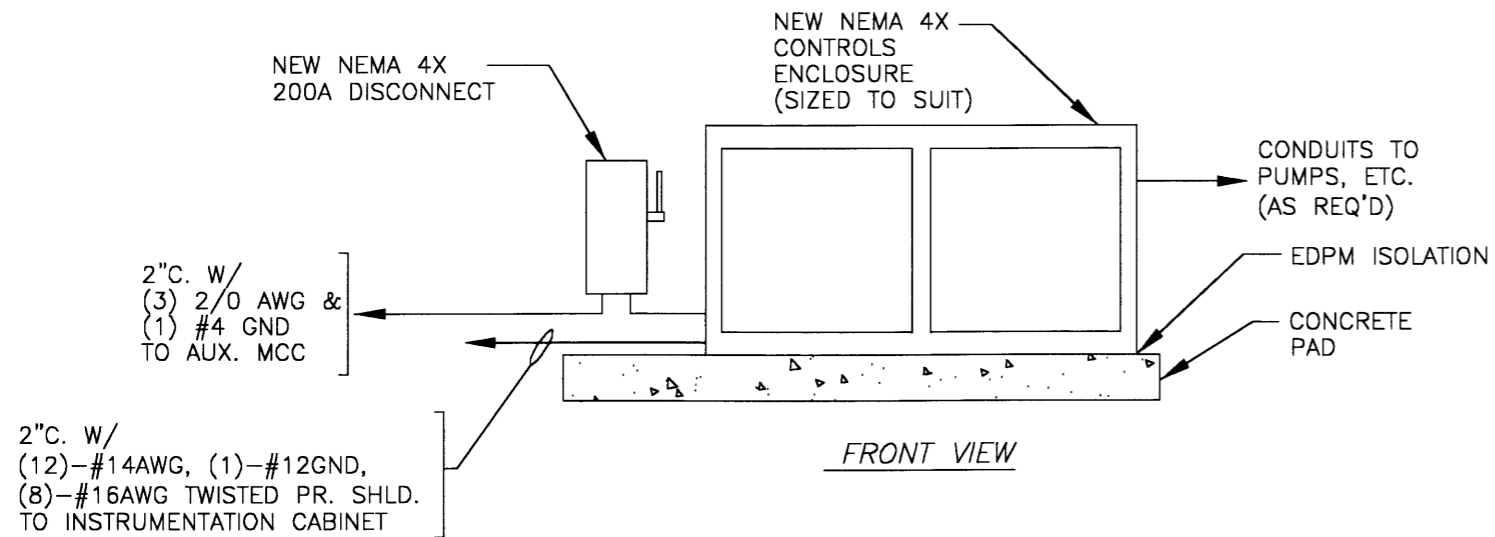

NEW ODOR CONTROL ELECTRICAL ENCLOSURE

NO SCALE

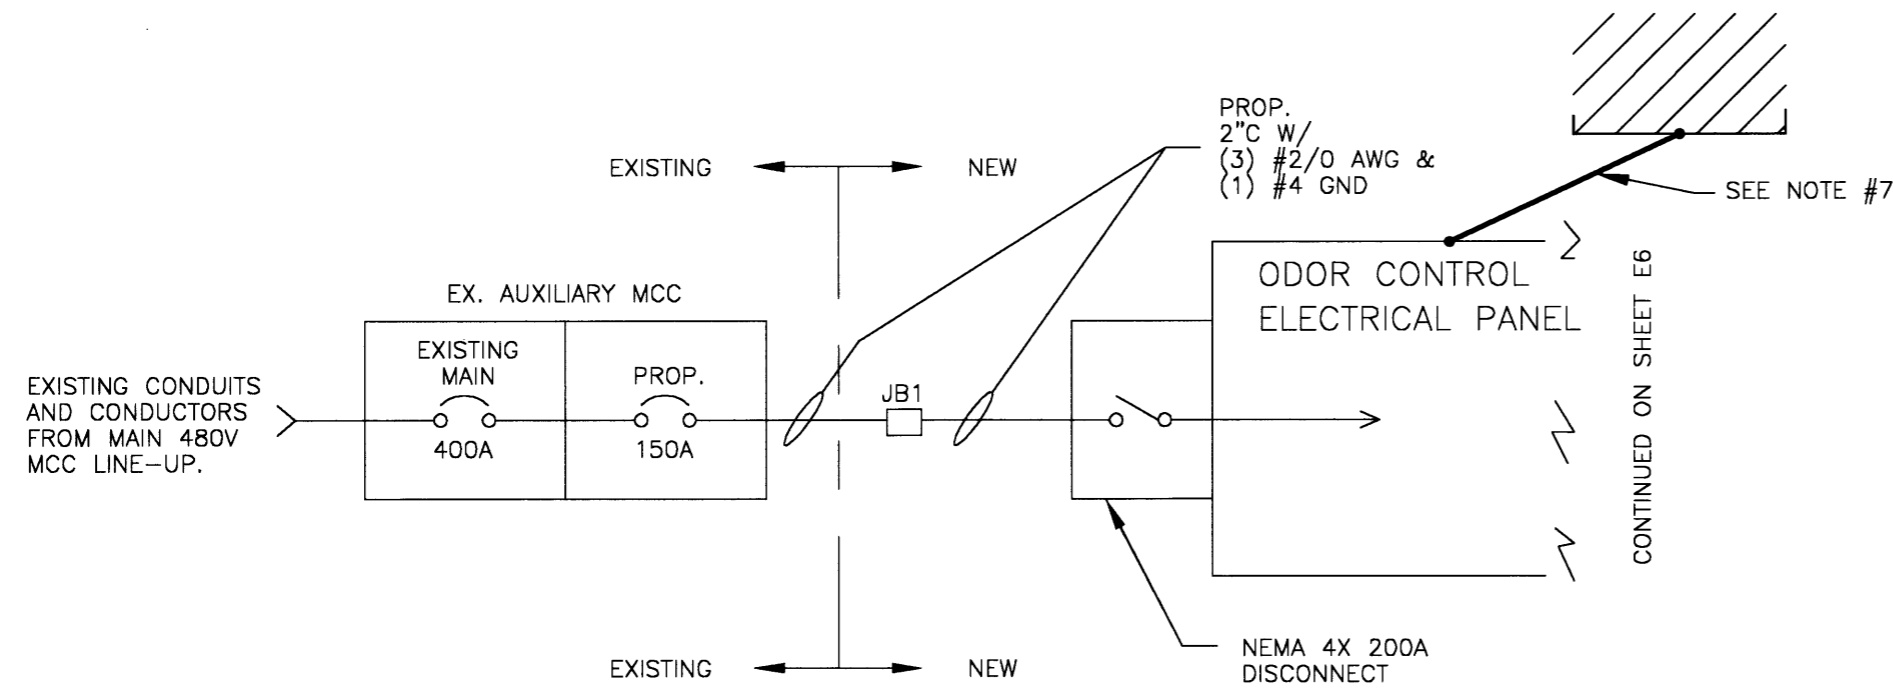

ELEMENTARY ONE LINE DIAGRAM

NO SCALE

NOTES FOR SHEETS E5 AND E6:

1. ALL MOTOR RATINGS, CONDUIT & CONDUCTOR SIZES, AND RELATED CONTROL EQUIPMENT SHOWN ARE APPROXIMATE. ACTUAL COMPONENTS SHALL BE DETERMINED BY THE ODOR CONTROL EQUIPMENT DESIGNER/SUPPLIER AND ELECTRICAL CONTRACTOR. SUBMIT SHOP DRAWINGS TO THE ENGINEER FOR APPROVAL PRIOR TO FABRICATION.
2. ALL CONDUITS SHALL ENTER BOXES, ENCLOSURES, ETC., FROM THE BOTTOM, IF PRACTICABLE; OTHERWISE, THE HUB AREA SHALL BE PROTECTED FROM STANDING WATER USING ALTERNATE, APPROVED, TECHNIQUES.
3. IF A PROGRAMMABLE LOGIC CONTROLLER (PLC) IS USED IN THE MECHANIZATION OF THIS DESIGN, IT SHALL BE A G.E. FANUC, AS SPECIFIED.
4. ALL ELECTRICAL EQUIPMENT, CONTROLS, AND INSTRUMENTATION SHALL BE AS SHOWN, SPECIFIED OR REQUIRED.
5. TANK LEVEL TRANSMITTERS SHALL BE SUBMERSIBLE PRESSURE SENSOR TYPE AS MANUFACTURED BY DEVAR. DIGITAL PANEL METERS SHALL BE 3.5 DIGIT WITH TRANSMITTER EXCITATION OUTPUT-- NEWPORT 202A-P-E, OR EQUAL. PROVIDE NEMA 4X COVERS. PROVIDE 4-20MA SIGNAL ISOLATORS/AMPLIFIERS FOR SCADA SIGNALS.
6. MODIFY EXISTING ANNUNCIATOR WINDOWS AND ALARM ELECTRONICS TO FACILITATE PROPOSED "ODOR CONTROL STAGE-1 FAULT", "ODOR CONTROL STAGE-2 FAULT", AND "EXHAUST BLOWER FAULT" INDICATION. PROVIDE 4-20MA SIGNALS TO SCADA FOR PH-1, PH-2, ORP-2, NaOH LEVEL, AND NaOCI LEVEL. CITY INSTRUMENTATION PERSONNEL WILL MAKE FINAL SCADA RTU CONNECTIONS.
7. BOND THE PROPOSED CONTROL CABINET SHELTER TO THE CONTROL CABINET USING MINIMUM #4AWG STRANDED CONDUCTORS. ENSURE THAT ALL METAL SHELTER COMPONENTS ARE ADEQUATELY BONDED TOGETHER.

131st AVE PUMP STA. ODOR CONTROL REHAB

No.	DATE	REVISIONS	No.	DATE	REVISIONS
3			6		
2			5		
1			4		


DES: RK
DRN: RK
CKD:
DATE:

CITY of TAMPA
DEPARTMENT OF SANITARY SEWERS
SANITARY SEWERS DIVISION

131st AVE. PUMPING STATION
ODOR CONTROL REHABILITATION
ELECTRICAL DETAILS

W.O. 5165
SHEET
E-5
OF 15

PROP.
ODOR CONTROL
ELECTRICAL PANEL

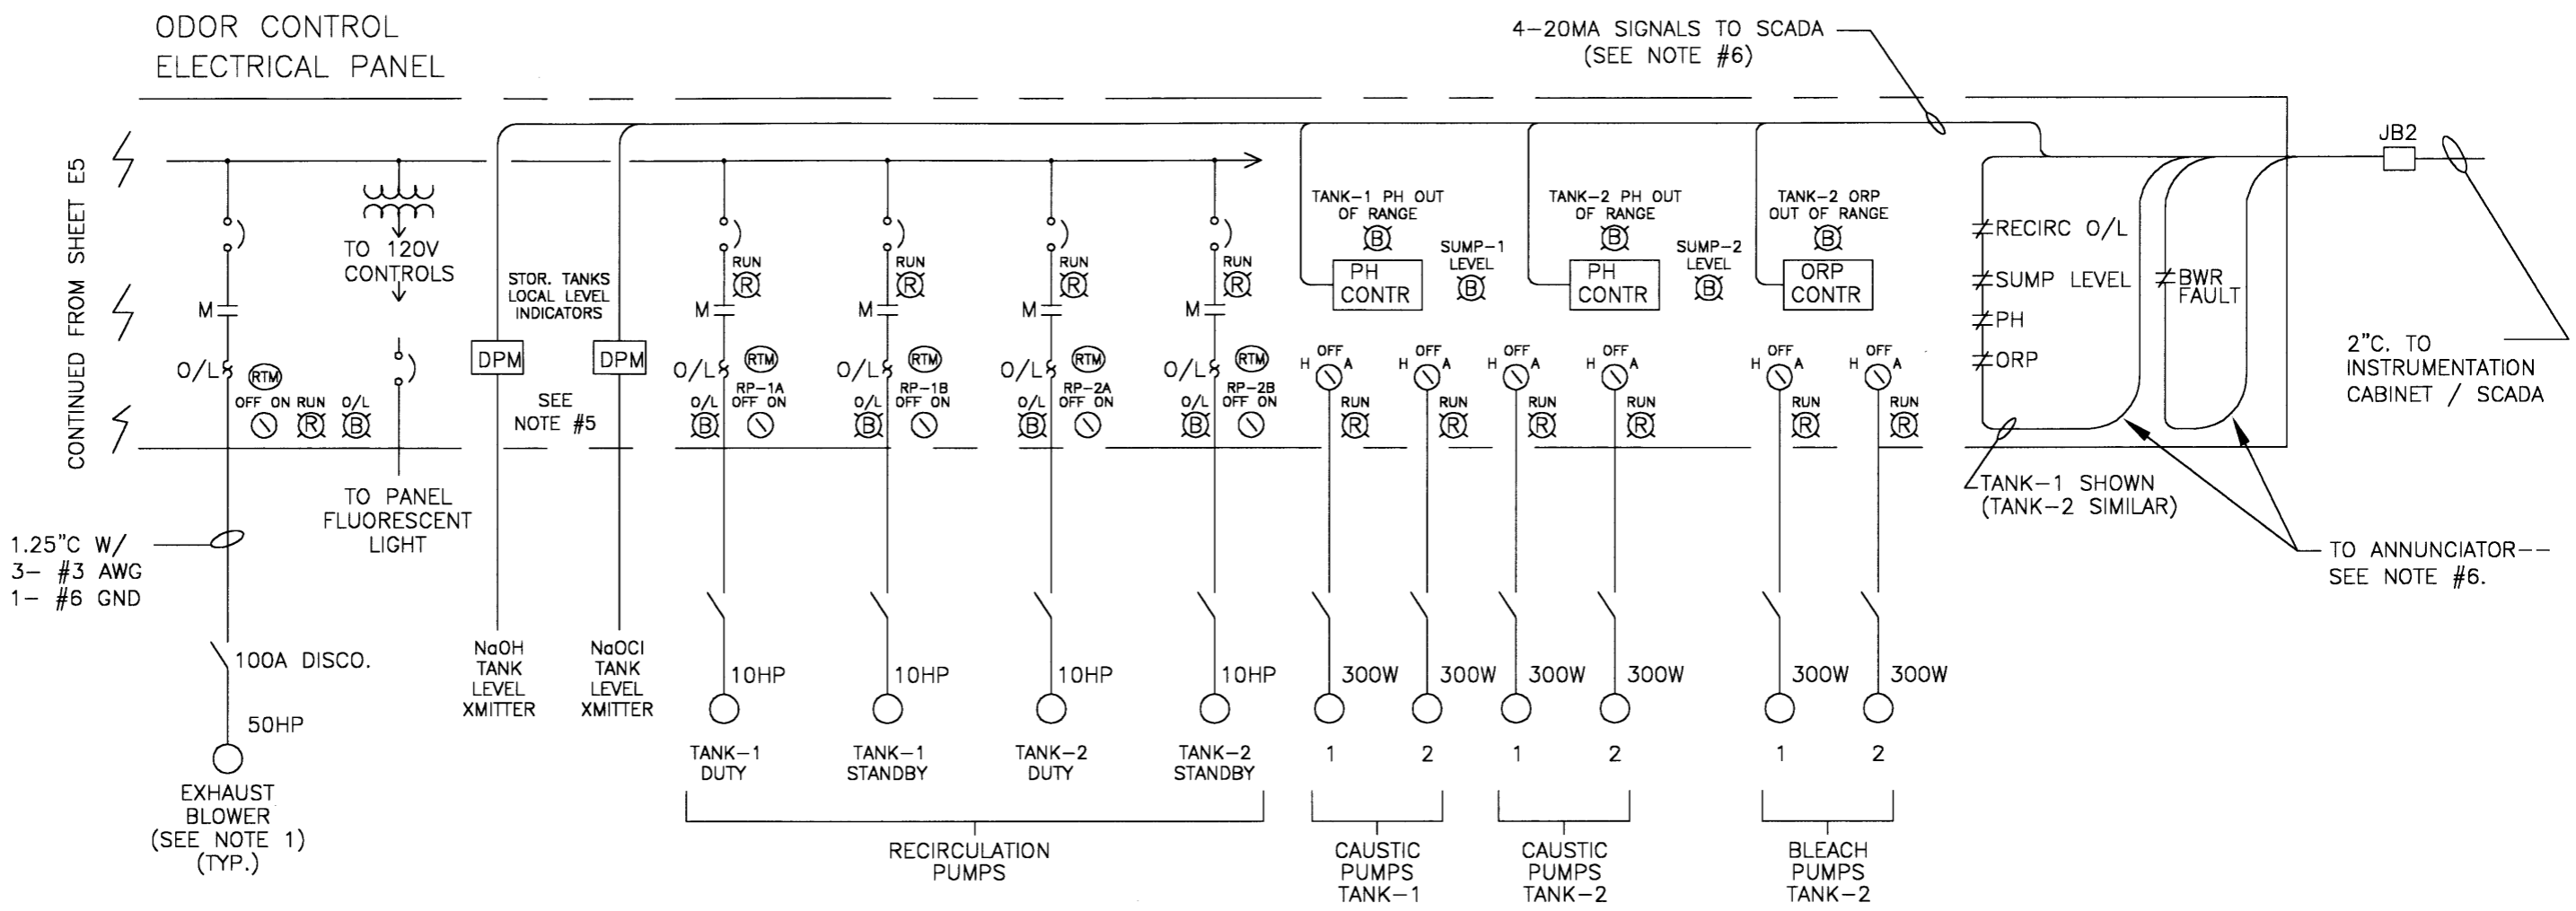

ELEMENTARY ONE LINE DIAGRAM


NO SCALE

SEE NOTES ON SHEET E5

131st AVE PUMP STA. ODOR CONTROL REHAB

No.	DATE	REVISIONS	No.	DATE	REVISIONS	DES: RK	CITY of TAMPA DEPARTMENT OF SANITARY SEWERS SANITARY SEWERS DIVISION	131ST AVE. PUMPING STATION ODOR CONTROL REHABILITATION ELECTRICAL DETAILS	W.O. 5165
3			6			DRN: RK			SHEET
2			5			CKD:			E-6
1			4			DATE:			OF 15

CITY of TAMPA

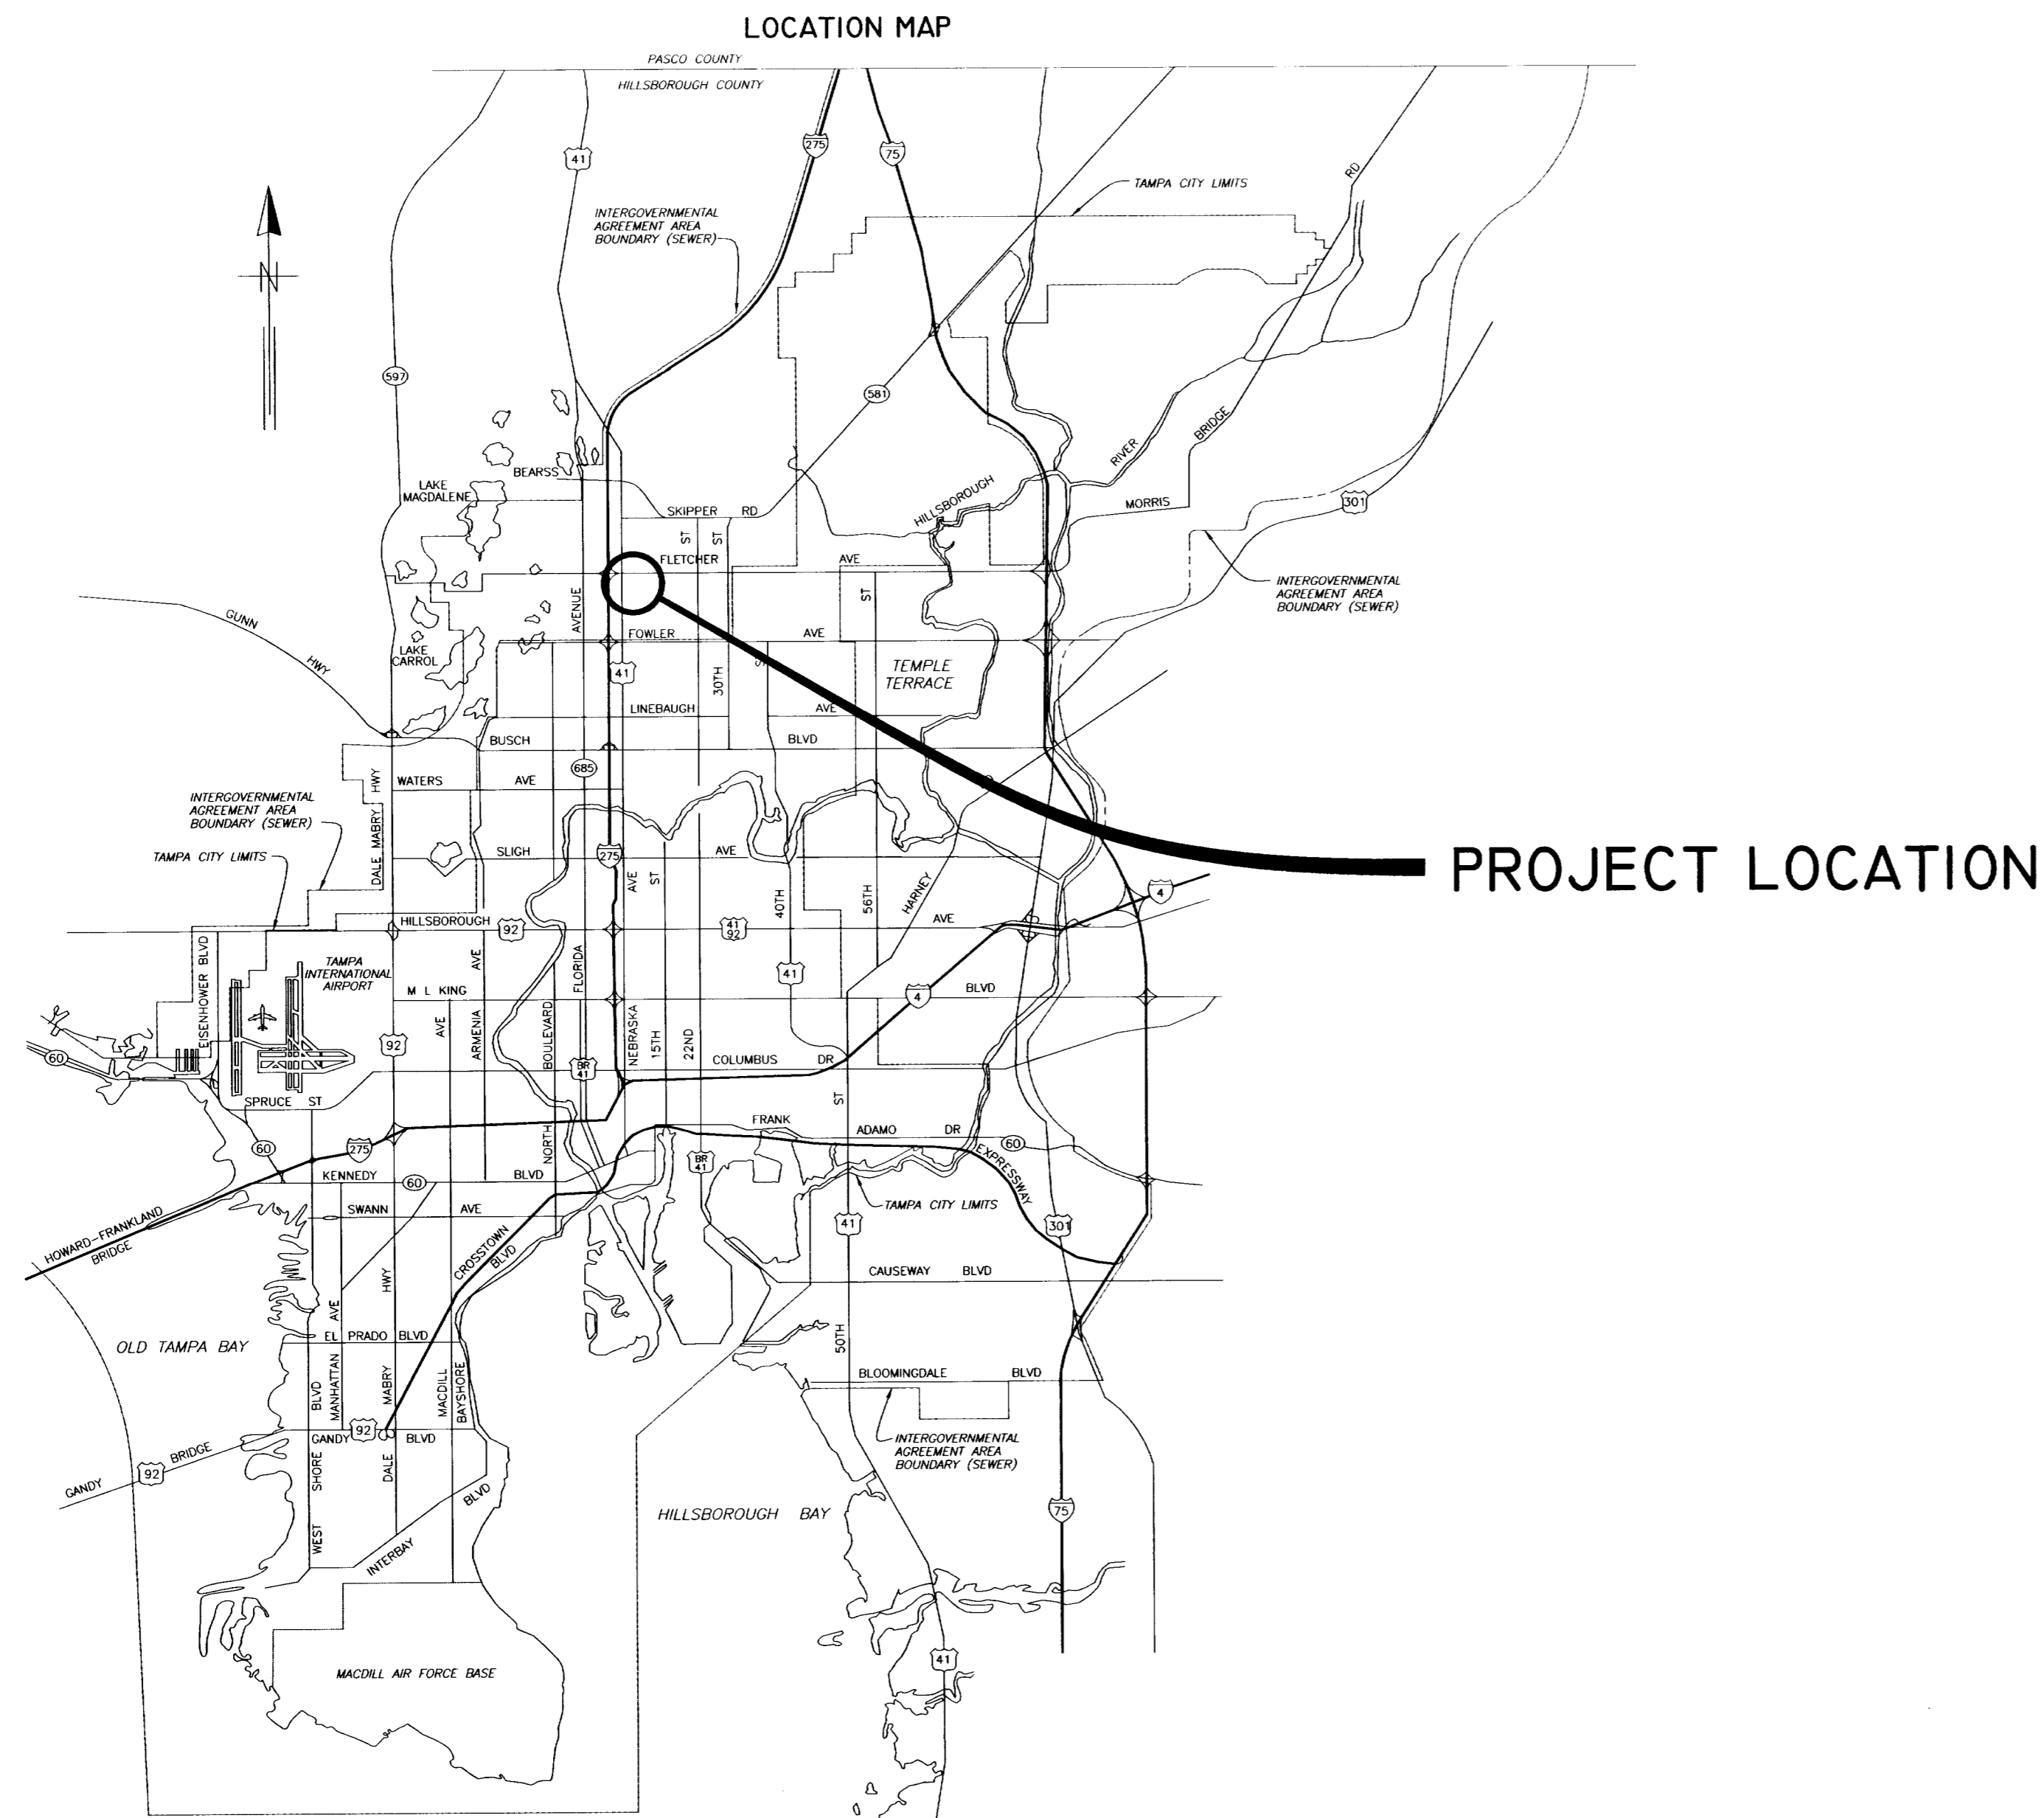

DEPARTMENT OF SANITARY SEWERS

PLANS FOR

131ST AVE. PUMPING STATION IMPROVEMENTS

CONTRACT 15 - 03

15-03
131st Ave. P.S.
Improvements

C:\ACAD\2000\DWG\PS 5165-STE 1-40

Roman D. Korchak
ROMAN D. KORCHAK, P.E. #42626
ELECTRICAL SECTION HEAD
DEPARTMENT OF SANITARY SEWERS

Henry Borzback
HENRY BORZBACK, P.E. #39449
CHIEF ENGINEER
DEPARTMENT OF SANITARY SEWERS

No.	DATE	REVISIONS
1		
2		
3		
4		
5		

NOTE:
THE ABOVE BASE MAP AND UTILITY LOCATIONS (PLAN & PROFILE) WAS PROVIDED BY CITY OF TAMPA DEPARTMENT OF PUBLIC WORKS (FILE No. 4833, JOB No. PW97-30).
REFERENCE INFORMATION WAS NOT VERIFIED BY CITY OF TAMPA DEPARTMENT OF SANITARY SEWERS FIELD SURVEYORS.

DES: B.G.
DRN: 999
CKD: AH
DATE: 4/17/03

CITY OF TAMPA FLORIDA
DEPARTMENT OF SANITARY SEWERS
RENEWAL & REPLACEMENT
SEWAGE DISPOSAL SYSTEM

131ST AVE. PUMPING STATION
IMPROVEMENTS



DESIGN W.O. 5165
CONSTRUCTION W.O.

SHEET
1
OF 7

NOTES


- THIS SET OF DRAWINGS INCLUDES FACSIMILES OF THE "AS-BUILT" DRAWINGS FOR THE ORIGINAL 131ST AVENUE PUMPING STATION THAT HAVE BEEN MODIFIED TO ILLUSTRATE THE WORK OF THIS CONTRACT. NOTES PERTAINING TO THE WORK OF THIS CONTRACT ARE ENCLOSED IN "CLOUDS" ON THESE DRAWINGS. OTHER ITEMS AND DETAILS REFER TO THE ORIGINAL PUMPING STATION AND ARE INCLUDED FOR INFORMATION ONLY.
- IT IS THE ENGINEER'S INTENT THAT THE EXPANSION JOINT REPLACEMENT AND PUMPING STATION SHUTDOWN ARE SCHEDULED AND ACCOMPLISHED WITHOUT THE NEED FOR BY-PASS PUMPING OR LINESHOFFING. IN ORDER TO ACCOMPLISH THIS, THE CONTRACTOR MAY BE REQUIRED TO REMOVE AND REPLACE THE EXISTING EXPANSION JOINTS UNDER RAW SEWAGE BACKFLOW CONDITIONS DURING WHICH AN UNKNOWN QUANTITY OF THE FORCEMAIN'S CONTENTS WILL FLOW BACK TO THE STATION. THE CITY HAS PERFORMED TRIAL SHUTDOWNS OF THE 131ST AVENUE PUMPING STATION AND DETERMINED THAT THE STATION CAN BE SHUT DOWN FOR A DURATION OF UP TO 10 HOURS DURING PERIODS OF LOW FLOW AND NO RAINFALL. DURING THE TRIAL SHUTDOWNS, THE PUMPS WERE TURNED OFF AND THE FORCEMAIN'S CONTENTS WERE ALLOWED TO FLOW BACK THROUGH THE PUMPS, INTO THE WETWELL AND TO SURCHARGE THE INFLUENT GRAVITY SEWERS. AFTER A PERIOD OF 1 TO 2 HOURS, THE BACKFLOW WAS OBSERVED TO DIMINISH TO A MORE MANAGEABLE RATE, HOWEVER, IT MAY NOT BE POSSIBLE TO DRAIN THE FORCEMAIN COMPLETELY AND COMPLETE THE WORK DURING ONE SHUTDOWN. IT IS THE ENGINEER'S INTENT THAT THE CONTRACTOR UNDERTAKE THE REMOVAL AND REPLACEMENT OF THE EXPANSION JOINTS AFTER THE FORCEMAIN HAS BEEN ALLOWED TO PARTIALLY DRAIN. DURING THE REMOVAL AND REPLACEMENT OF THE EXPANSION JOINTS, THE FORCEMAIN'S CONTENTS WILL CONTINUE TO DRAIN INTO THE PUMPING STATION AND THROUGH THE STATION'S FLOOR DRAINS TO THE WETWELL. IT SHALL BE THE CONTRACTOR'S RESPONSIBILITY TO ASSESS THE BACKFLOW CONDITIONS AND DETERMINE THE WORK METHODS AND NUMBER OF PUMPING STATION SHUTDOWNS REQUIRED FOR THE REMOVAL AND REPLACEMENT OF THE EXPANSION JOINTS. THE CONTRACTOR SHALL PROVIDE ANY EQUIPMENT AND TRAINING THAT MAY BE NECESSARY FOR THE SAFETY AND HEALTH OF THE WORKERS THAT ARE EXPOSED TO RAW SEWAGE CONDITIONS. FOLLOWING THE EXPANSION JOINT REPLACEMENT, THE CONTRACTOR SHALL CLEAN AND DISINFECT THE AREAS OF THE PUMPING STATION SUBJECTED TO RAW SEWAGE SPILLS.
- THE CONTRACTOR SHALL SCHEDULE THE PUMPING STATION SHUTDOWN FOR A PERIOD OF LOW FLOWS (LATE EVENING THROUGH EARLY MORNING) AND NO RAINFALL. THE CONTRACTOR SHALL COORDINATE THE SHUTDOWN WITH SEWER DEPARTMENT PERSONNEL. SEWER DEPARTMENT PERSONNEL WILL SHUT DOWN UPSTREAM PUMPING STATIONS AND MONITOR SEWAGE LEVELS AT THE PUMPING STATIONS AS WELL AS AT MANHOLES OF THE INFLUENT GRAVITY SYSTEM IN ORDER TO AVOID OVERFLOWS.
- THE EXISTING EXPANSION JOINTS ARE LEAKING AND HAVE CREATED AN UNPLEASANT ENVIRONMENT INSIDE THE PUMPING STATION AND HAVE BECOME A CONTINUING MAINTENANCE PROBLEM. IT IS THE ENGINEER'S INTENT THAT THE EXPANSION JOINTS BE REPLACED BEFORE OTHER WORK IS BEGUN. THE CONTRACTOR SHALL DEVELOP A WORK SCHEDULE THAT WILL PRIORITIZE THE EXPANSION JOINT REPLACEMENT. THE WORK SCHEDULE SHALL BE SUBJECT TO REVIEW AND APPROVAL BY THE ENGINEER.
- UNDER THE TERMS OF A SEPARATE CONTRACT, THE CITY OF TAMPA HAS BEGUN TO CLEAN UP CONTAMINATED SOILS AT THE 131ST AVE. PUMPING STATION SITE. THE CLEAN-UP OPERATION IS LIMITED TO THE NORTHEAST CORNER OF THE SITE AND SHOULD BE WELL OUT OF THE WAY OF THE PROPOSED WORK OF THIS CONTRACT. THE CONTRACTOR AND SUBCONTRACTORS PERFORMING THE WORK OF THIS CONTRACT (131ST AVE. PUMPING STATION IMPROVEMENTS), SHALL BE AWARE OF THE CLEAN-UP OPERATION AND COORDINATE PARKING, DELIVERIES, LAY-DOWN AREAS, ETC. WITH THE ENGINEER TO ALLOW THE WORK OF THE CLEAN-UP OPERATION TO PROCEED.

GENERAL LOCATION OF CONTAMINATED SOIL & CLEAN-UP OPERATION, SEE NOTE 5 THIS SHEET

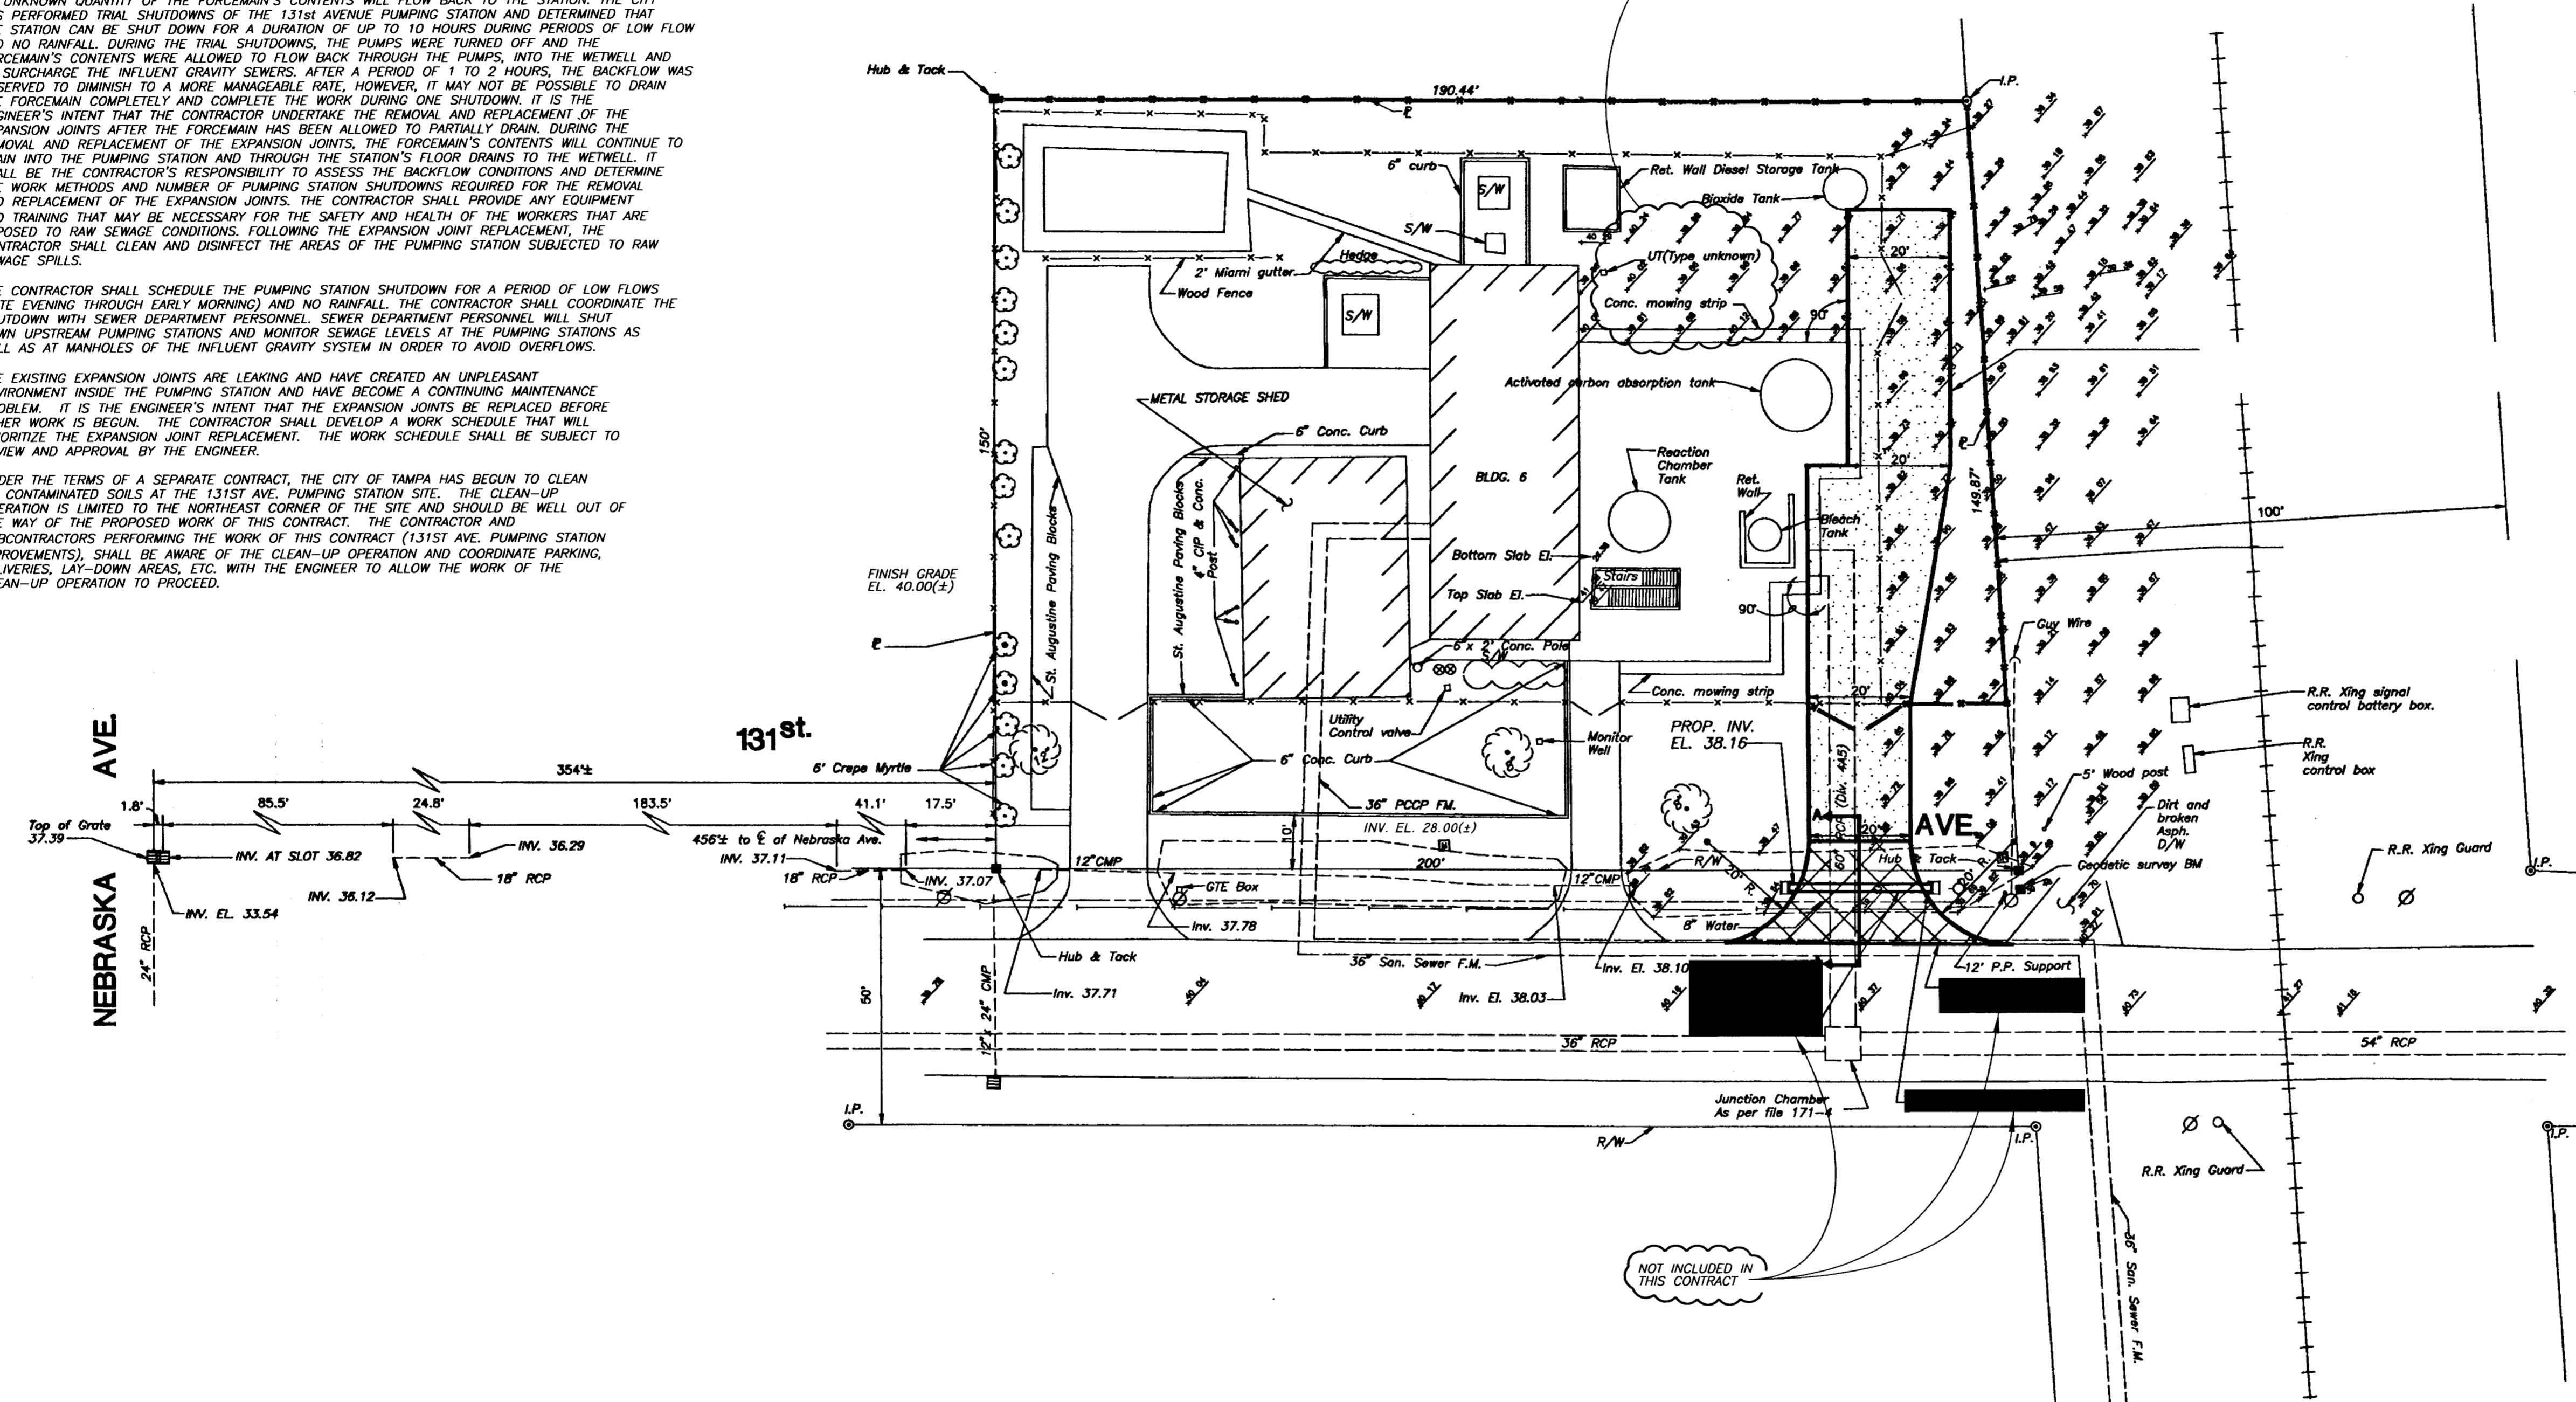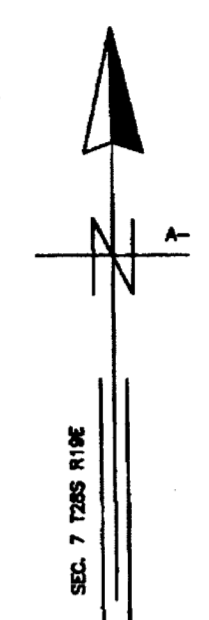

PLAN

LEGEND

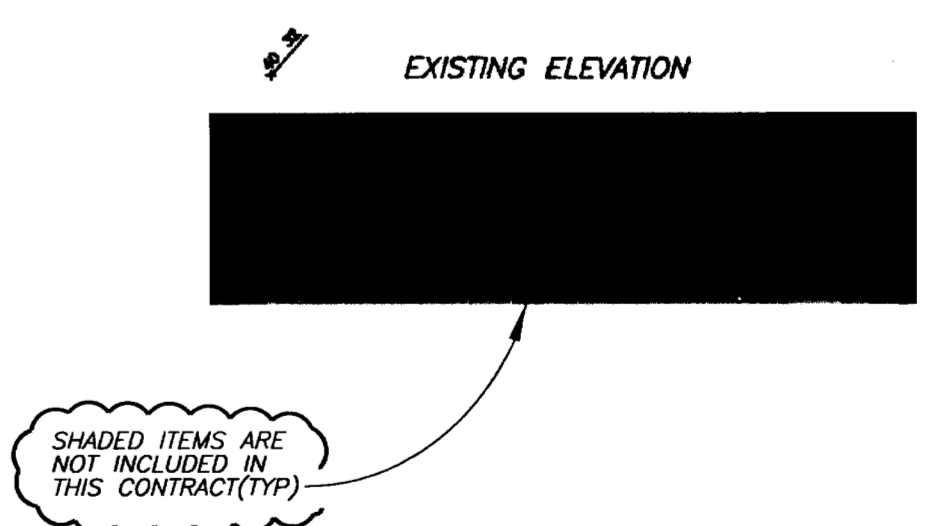

No.	DATE	REVISIONS	No.	DATE	REVISIONS
1	05-02-03	REMOVED NOTES RELATED TO LINESHOP, REVISED NOTES	6		
2			7		
3			8		
4			9		
5			10		

NOTE: THE ABOVE BASE MAP AND UTILITY LOCATIONS (PLAN & PROFILE) WAS PROVIDED BY CITY OF TAMPA DEPARTMENT OF PUBLIC WORKS (FILE No 4833, JOB No PW97-30). REFERENCE INFORMATION WAS NOT VERIFIED BY CITY OF TAMPA DEPARTMENT OF SANITARY SEWERS FIELD SURVEYORS.

DES: B.G.
 DRN: [Signature]
 CKD: [Signature]
 DATE: 5/10/03


CITY OF TAMPA FLORIDA
 DEPARTMENT OF SANITARY SEWERS
 RENEWAL & REPLACEMENT
 SEWAGE DISPOSAL SYSTEM

131ST AVE. PUMPING STATION
 IMPROVEMENTS


DESIGN W.O. 5165
 CONSTRUCTION W.O.

SHEET
2
 OF 7


CUT STRAP AND REMOVE 3/8" ANGLE @ EDGE OF OPENING. TYPICAL FOR REMOVABLE SLAB LOCATIONS NOTED. SEE DETAIL, THIS SHEET.

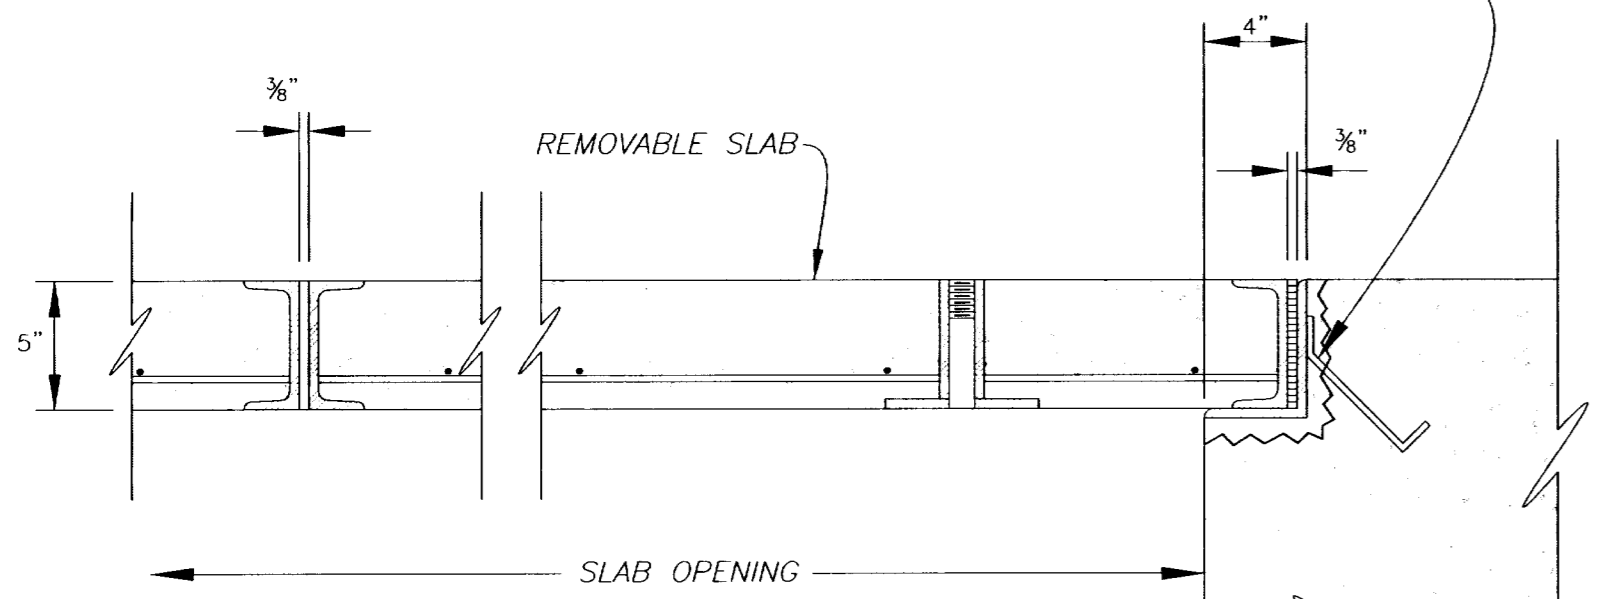


SECTION C-C

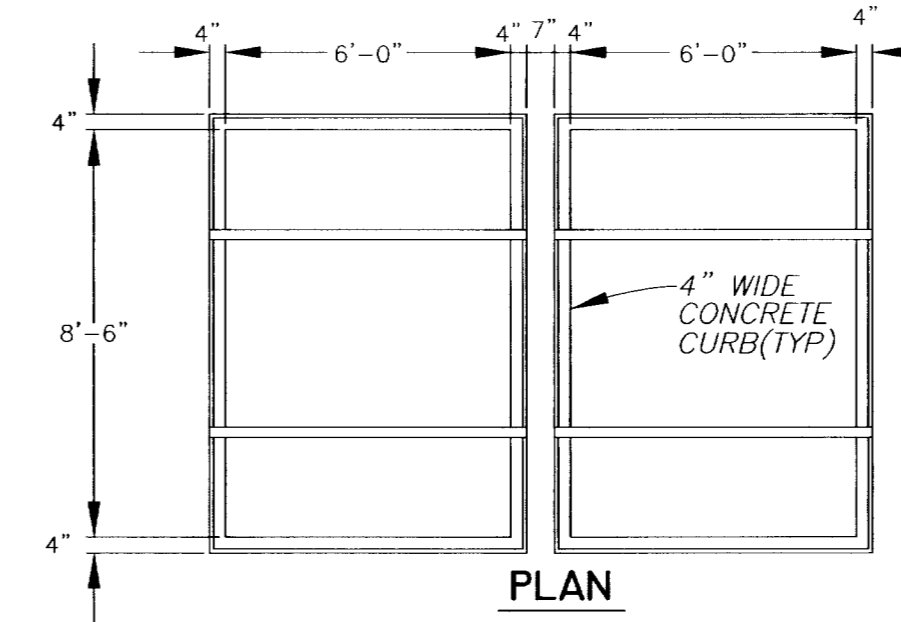


PLAN

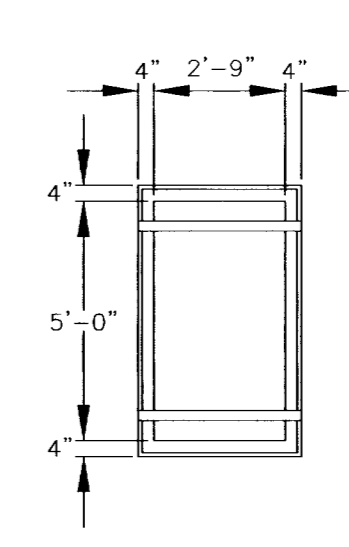

PLAN

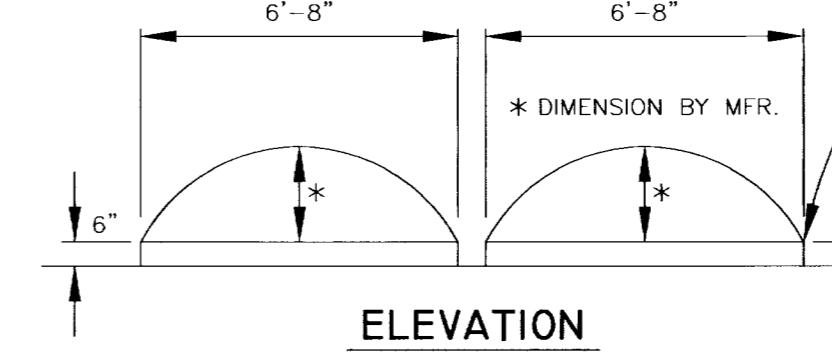

ELEVATION

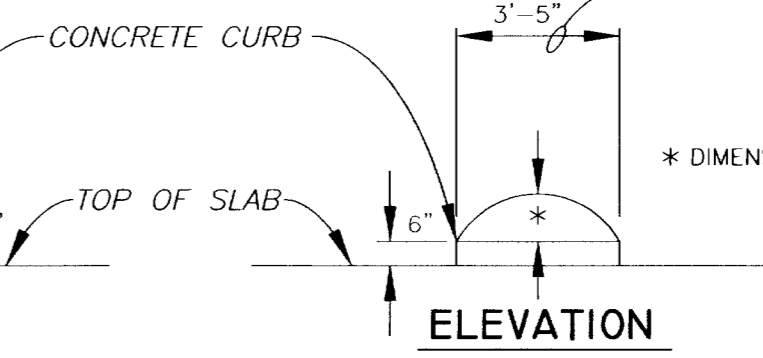


ELEVATION

PROPOSED SKYLIGHTS

SCALE: 1/4" = 1'-0"


PROVIDE AND INSTALL WASCO PRODUCTS, INC. LOW RISE BARREL VAULT SKYLIGHTS. MODEL DBVV TO SUIT PROPOSED CURB DIMENSIONS. FIELD VERIFY CURB DIMENSIONS PRIOR TO FABRICATION AND PURCHASE.

DIMENSION SHOWN IS DESIGN PROPOSAL TO SUIT EXISTING REMOVABLE SLAB. DIMENSION MAY VARY TO SUIT INSTALLATION REQUIREMENTS AND LIMITED CLEARANCES IN PROXIMITY TO PUMP STATION WALL.

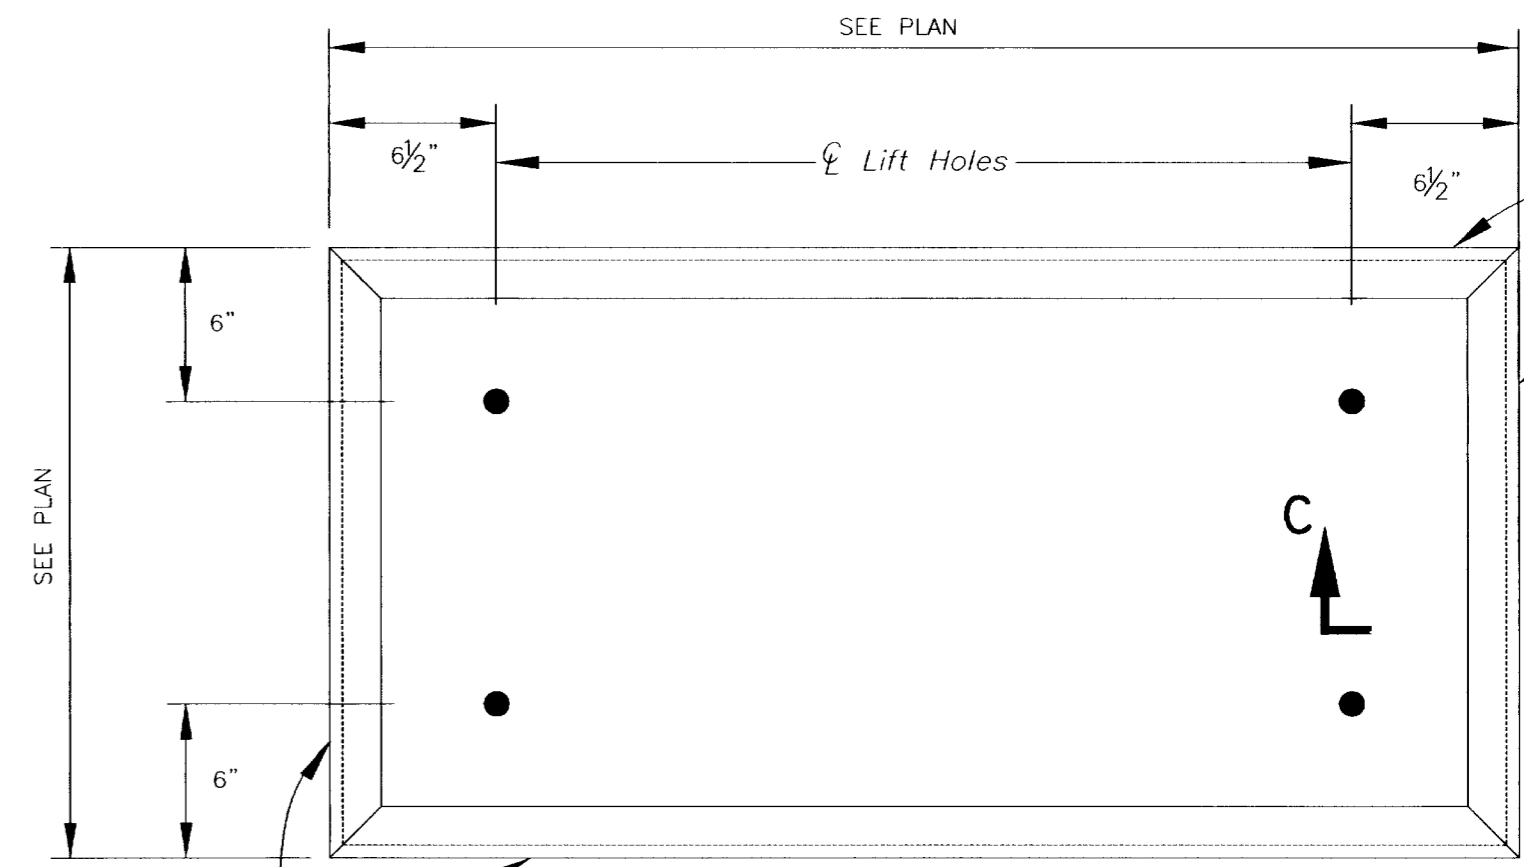

TYPICAL REMOVABLE SLAB


SCALE: 1 1/2" = 1'-0"

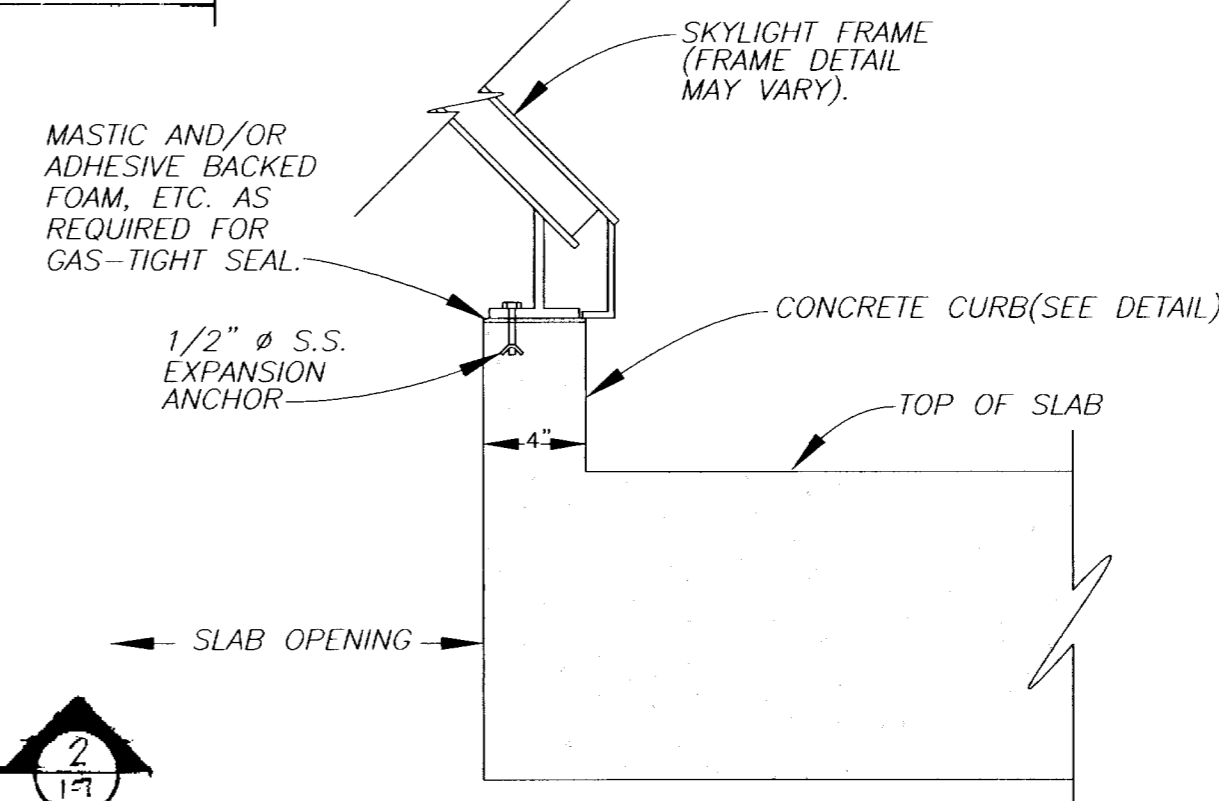

SKYLIGHT / CURB CONNECTION


SCALE: 1 1/2" = 1'-0"

REINFORCING STEEL: ASTM GRADE 60
CONCRETE: f'c = 4000 psi @ 28 DAYS

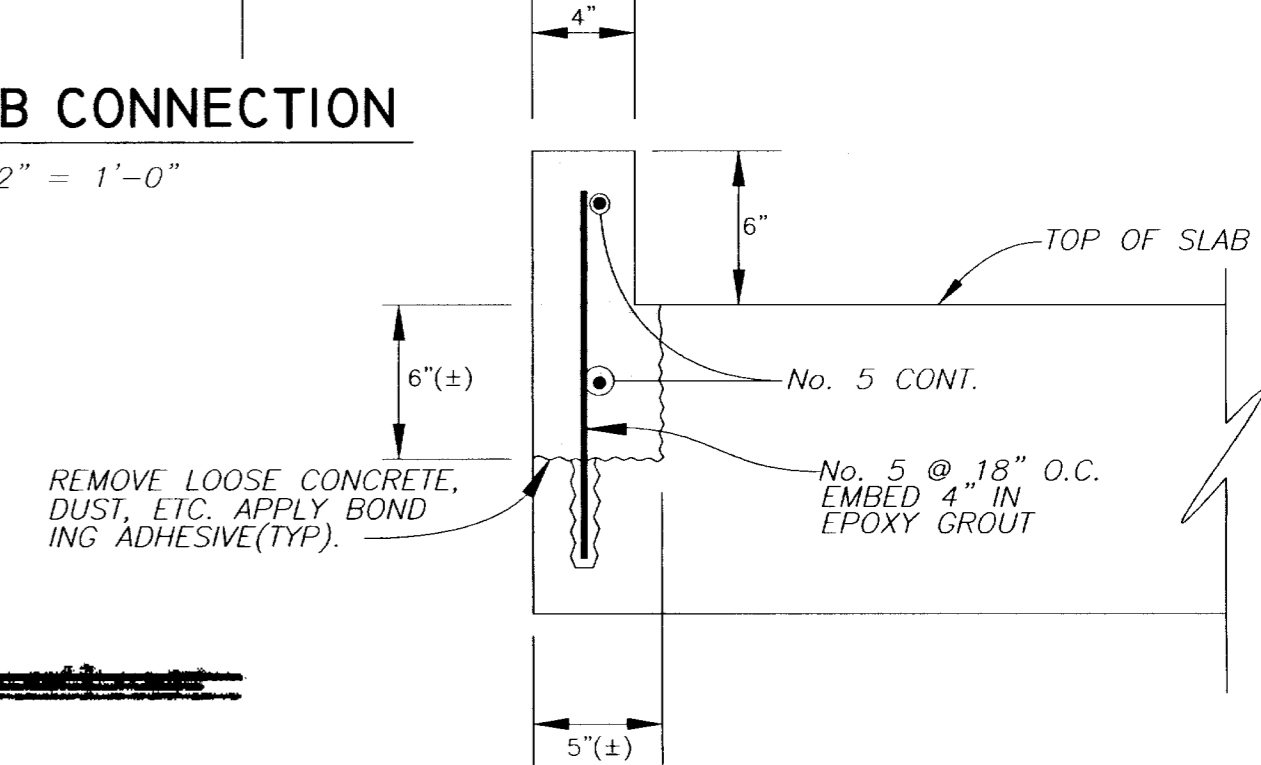

PROPOSED CURB DETAIL

SCALE: 1 1/2" = 1'-0"

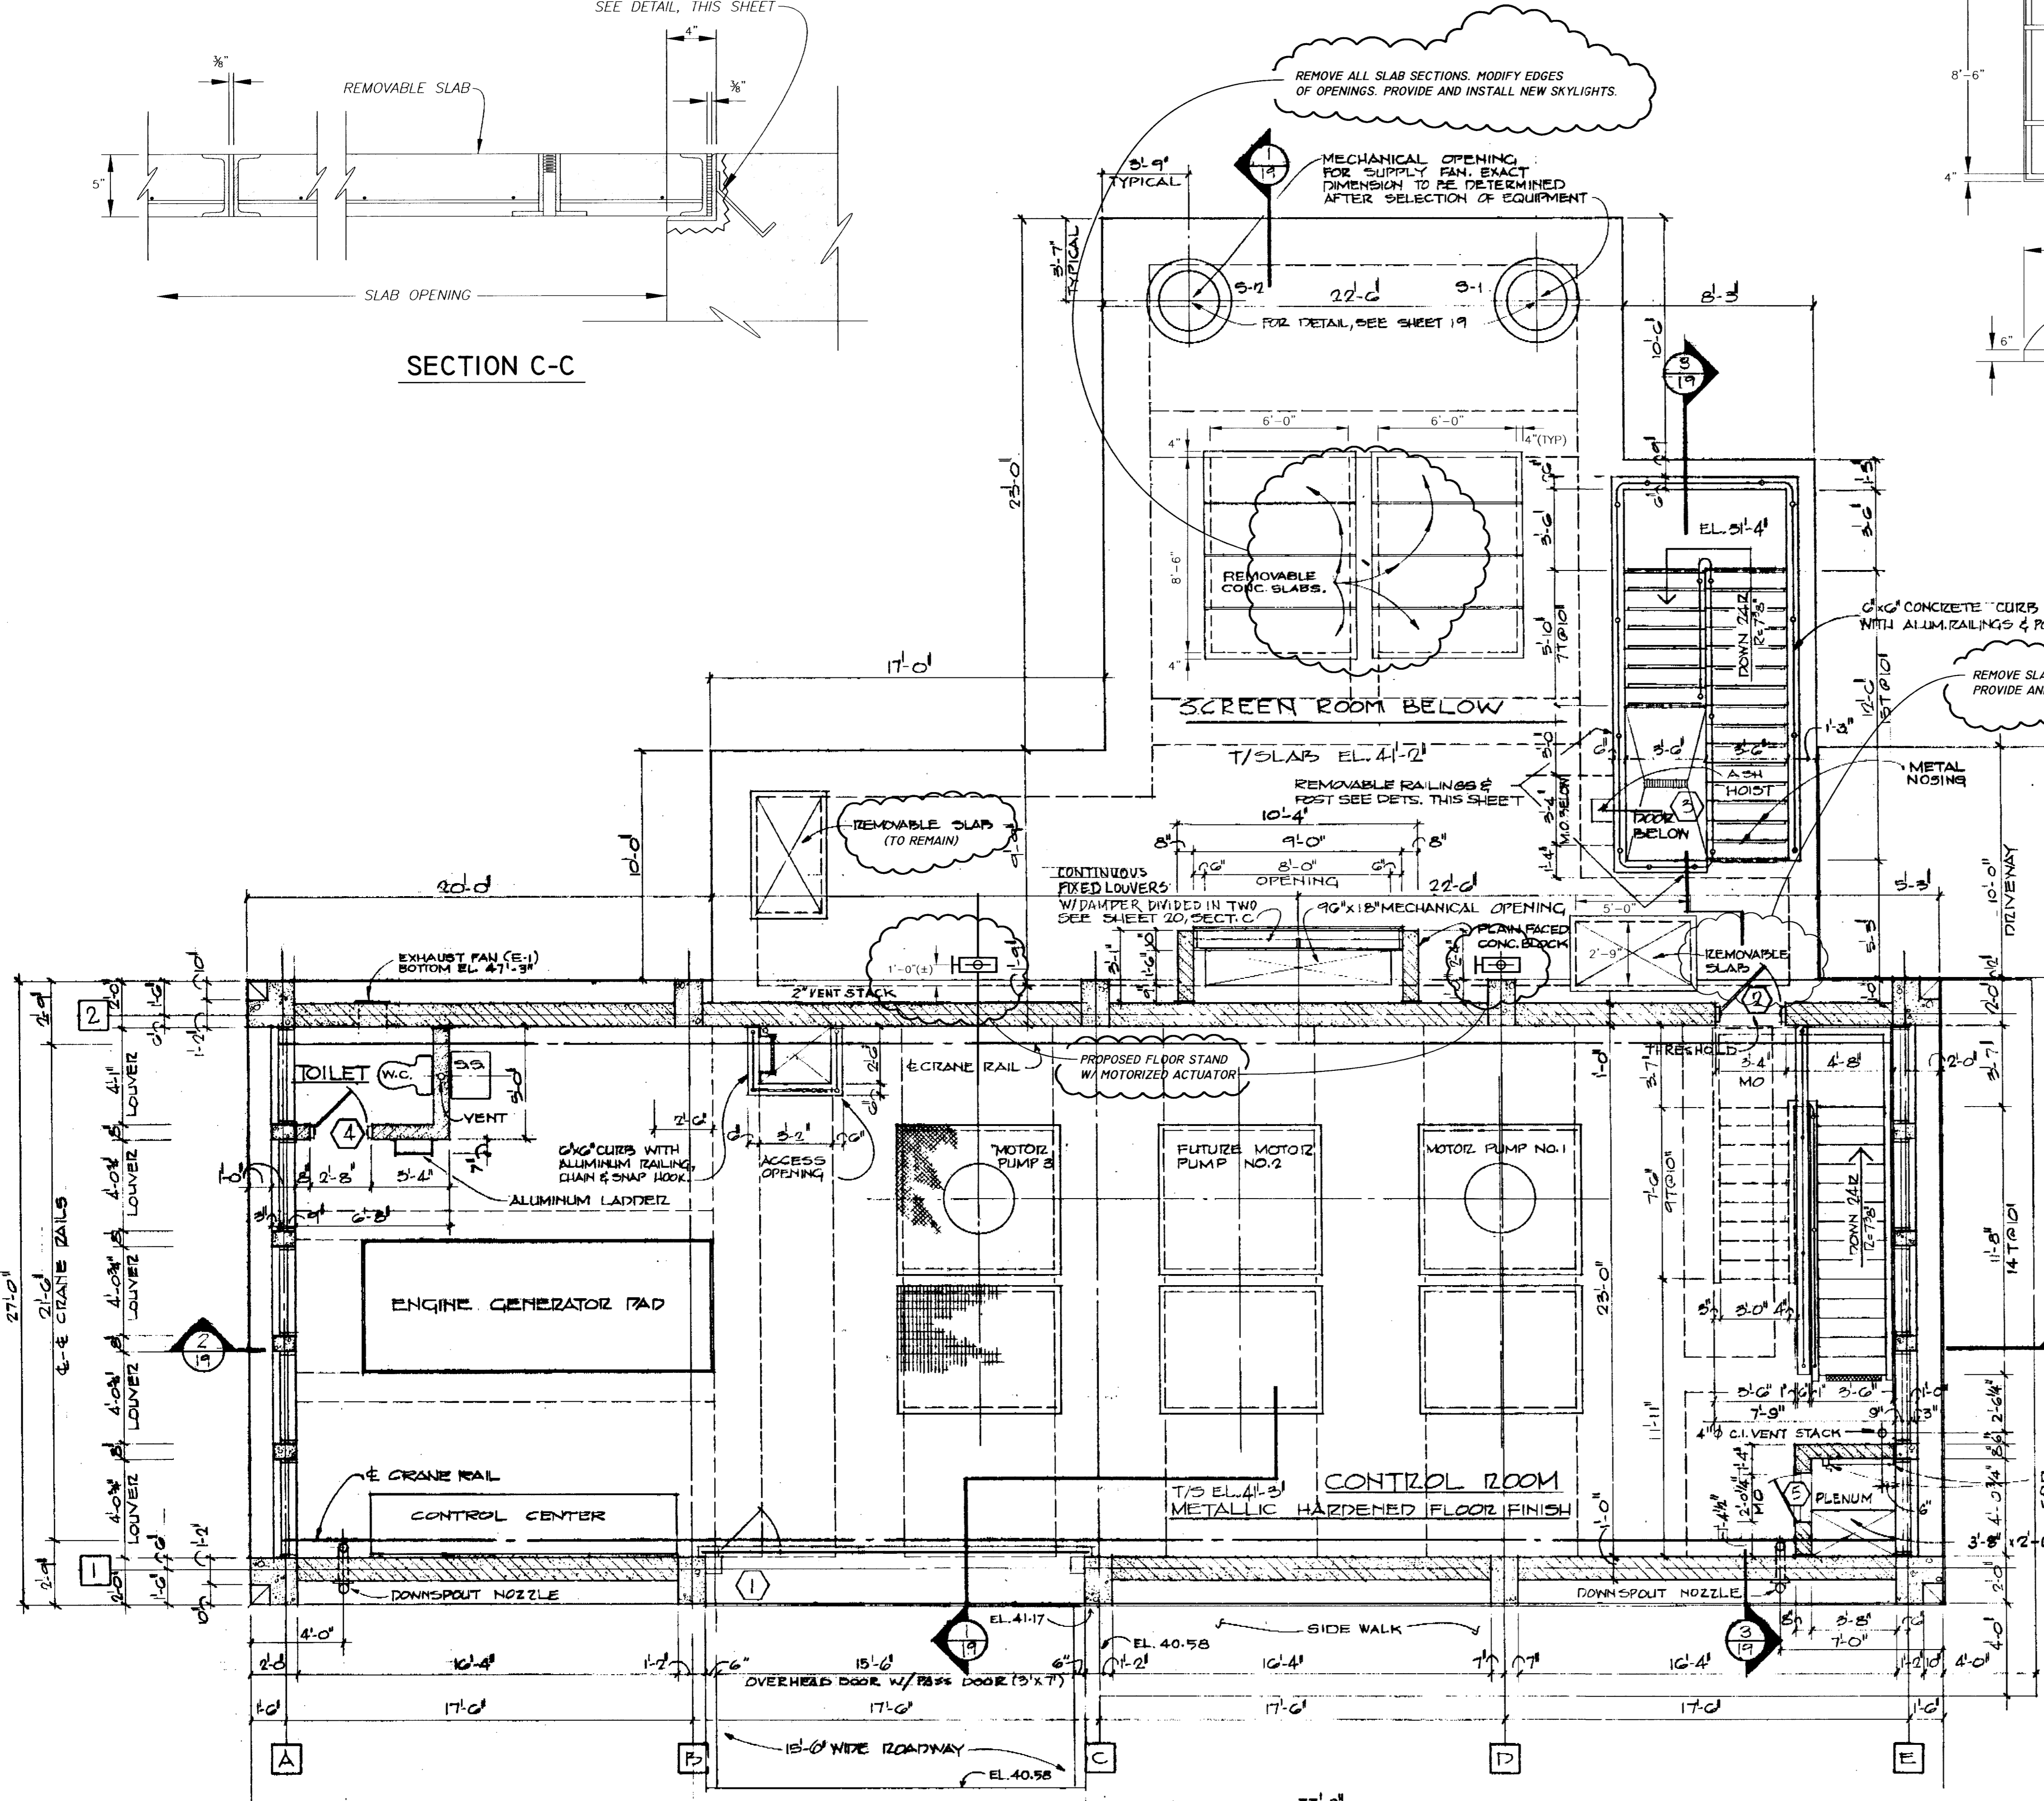

PLAN AT FL. EL. 41'-3"

SCALE: 1/4" = 1'-0"

No.	DATE	REVISIONS	No.	DATE	REVISIONS
1			6		
2			7		
3			8		
4			9		
5			10		

NOTE: THE ABOVE BASE MAP AND UTILITY LOCATIONS (PLAN & PROFILE) WAS PROVIDED BY CITY OF TAMPA DEPARTMENT OF PUBLIC WORKS (FILE NO. 4833, JOB NO. PW97-30). REFERENCE INFORMATION WAS NOT VERIFIED BY CITY OF TAMPA DEPARTMENT OF SANITARY SEWERS FIELD SURVEYORS.



DES: B.G.
DRN: B.B.
CKD: H.H.
DATE: 4/11/05

CITY OF TAMPA FLORIDA
DEPARTMENT OF SANITARY SEWERS
RENEWAL & REPLACEMENT
SEWAGE DISPOSAL SYSTEM

131ST AVE. PUMPING STATION
IMPROVEMENTS

DESIGN W.O.
5165

SHEET
3
OF 7

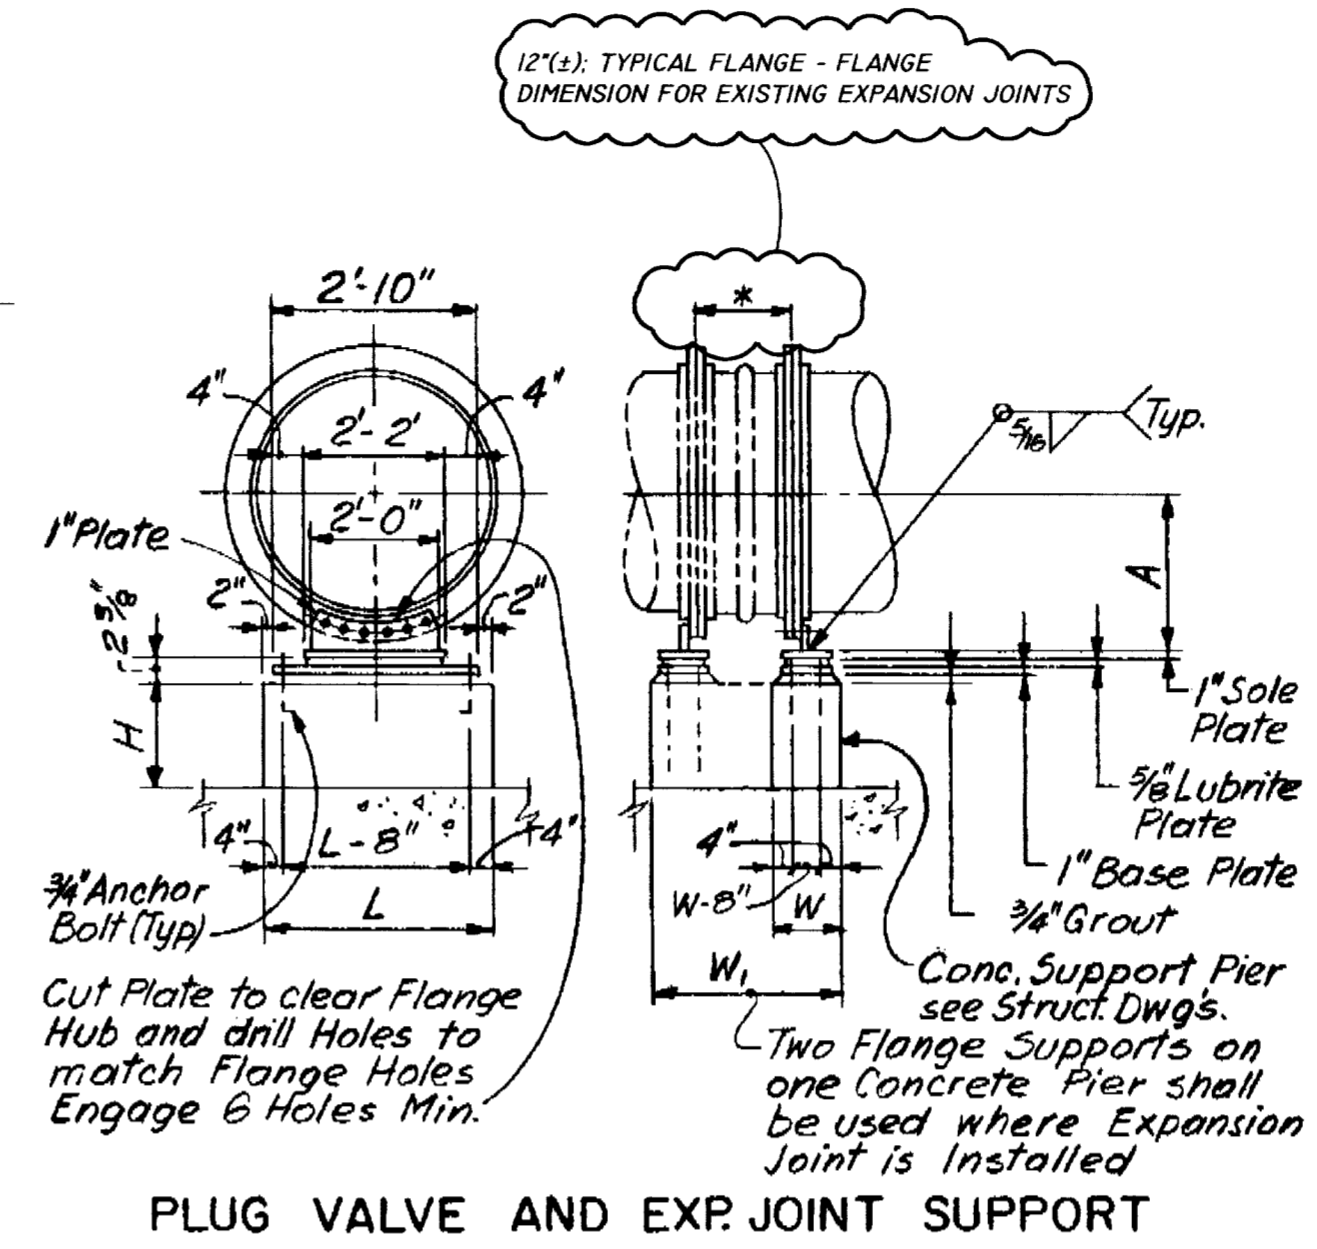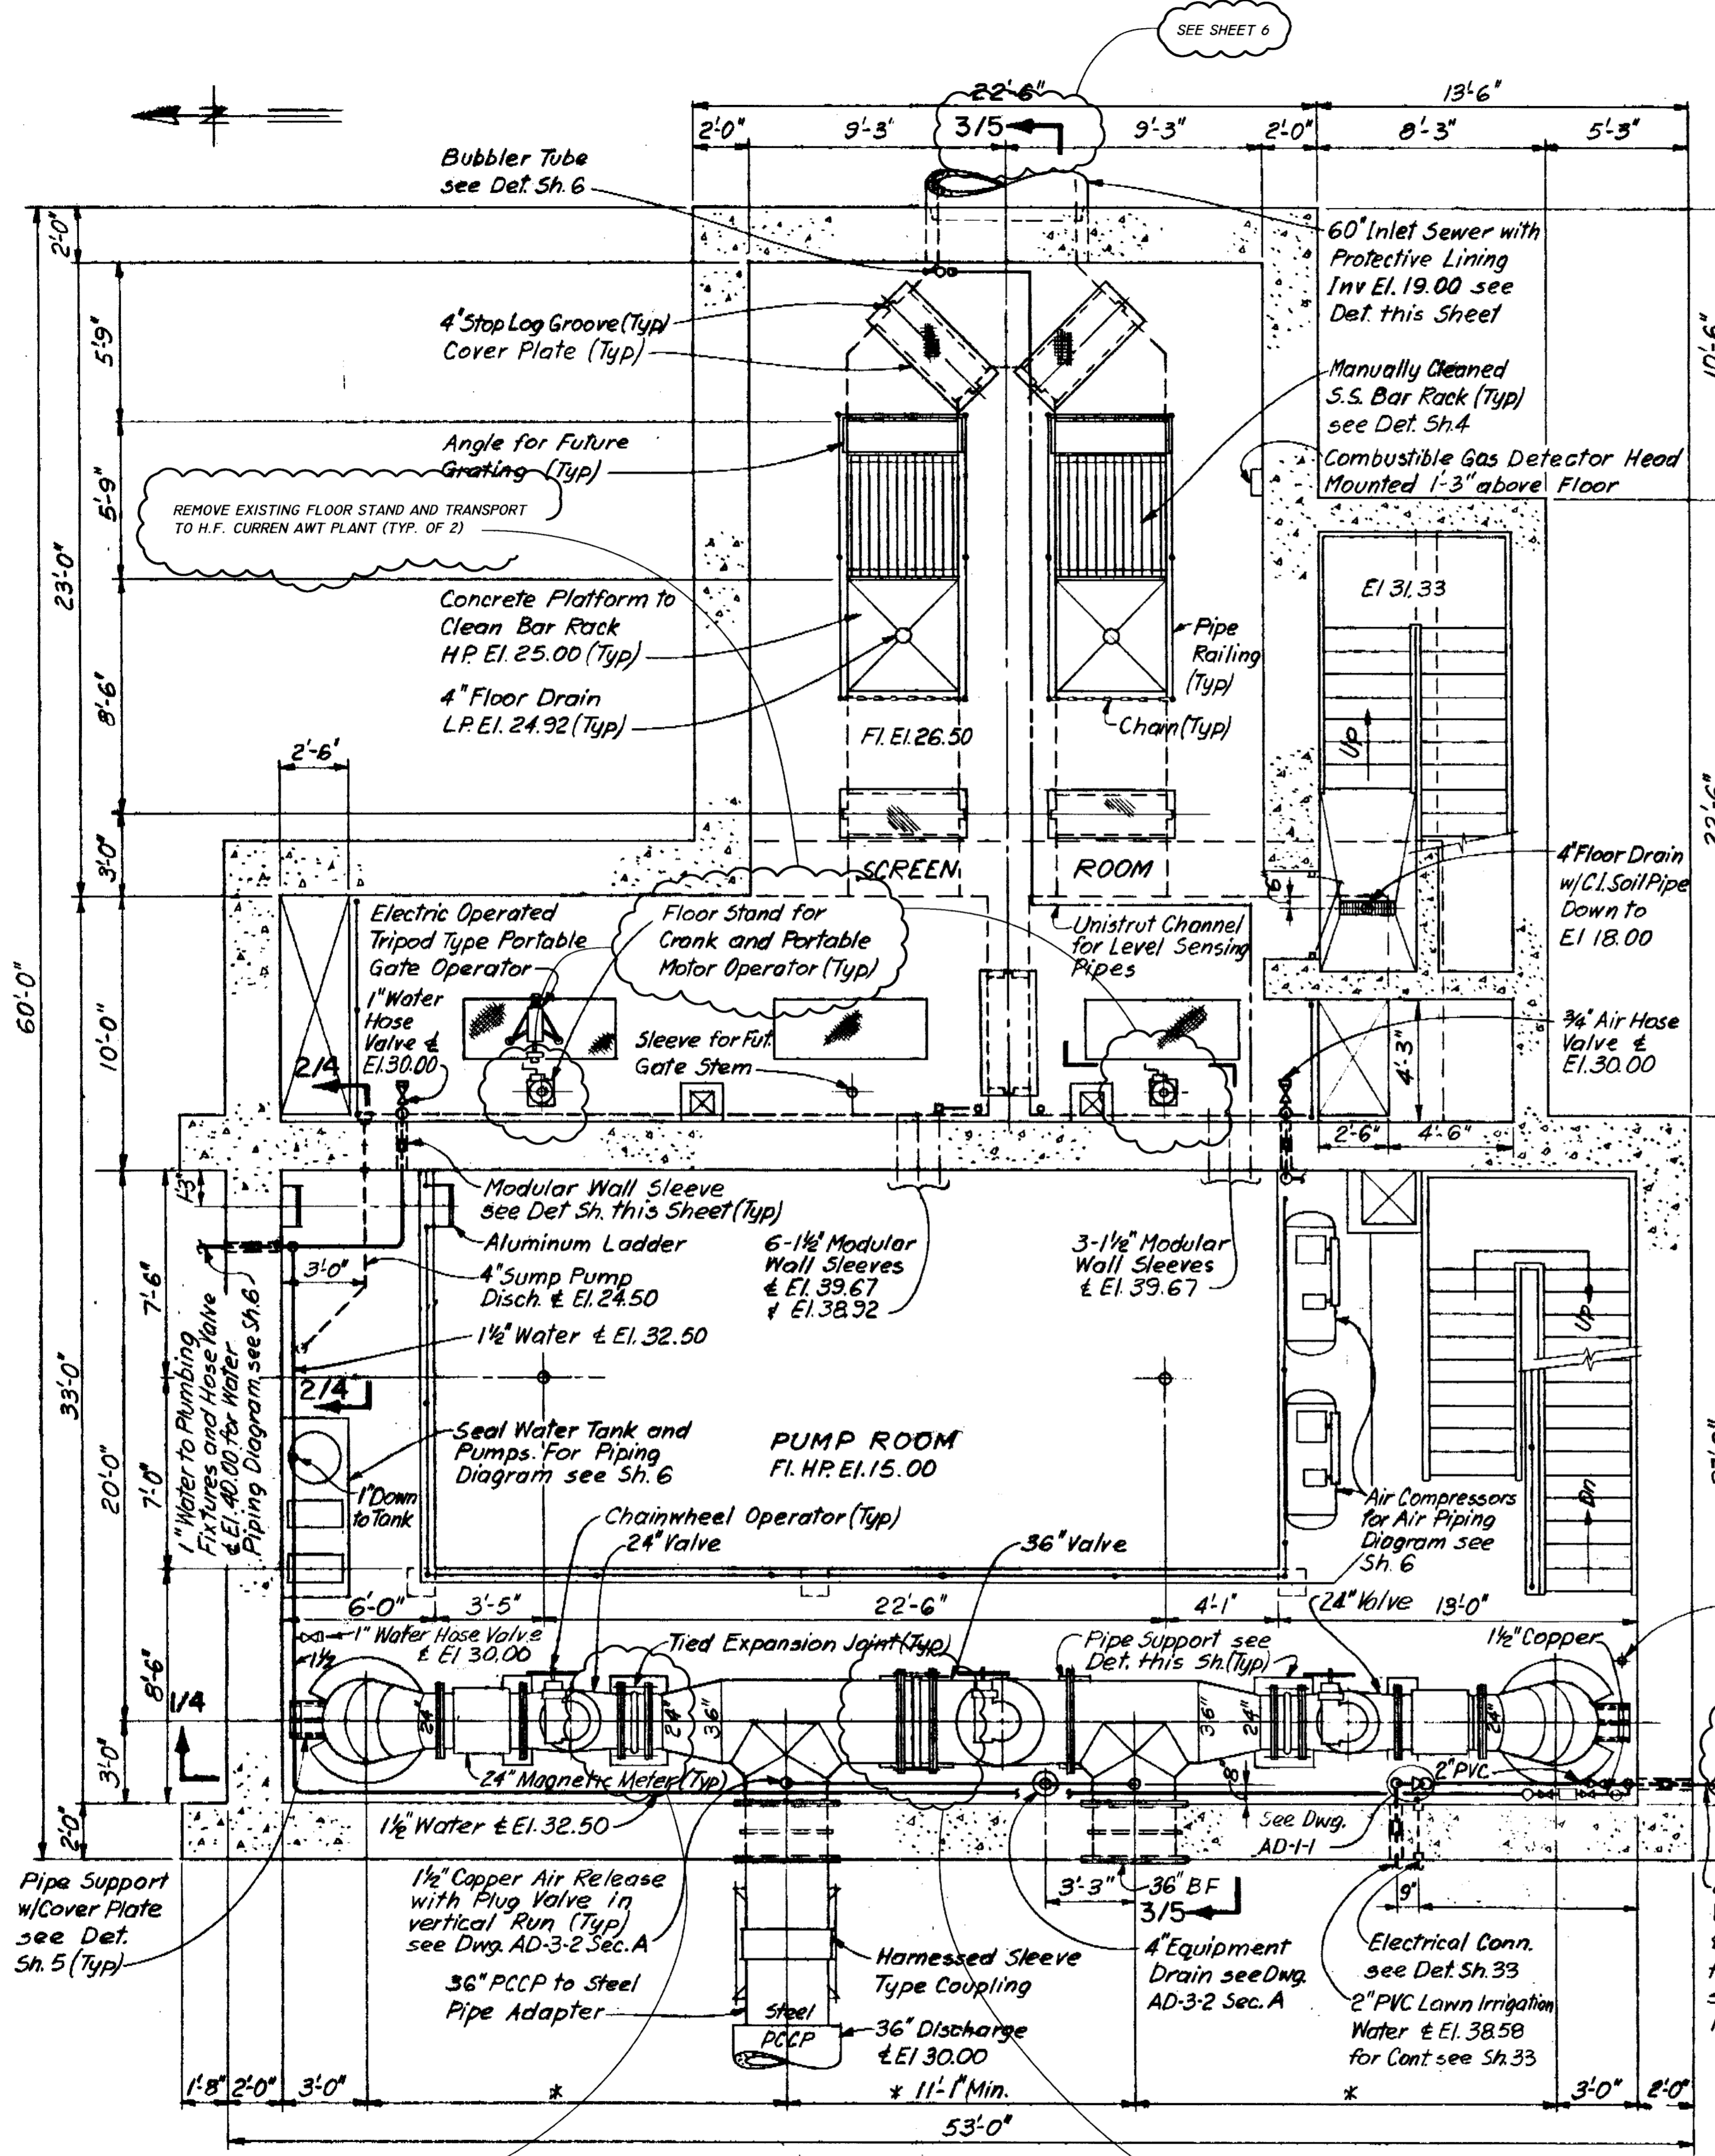

PLAN AT EL. 26.50
SCALE: 1/4" = 1'-0"

REMOVE EXISTING 24" STEEL EXPANSION JOINT. INSTALL NEW RUBBER EXPANSION JOINT TO BE PROVIDED BY THE CITY OF TAMPA

CONTRACTOR SHALL PROVIDE AND INSTALL 316 STAINLESS STEEL NUTS, BOLTS AND THRUST RESTRAINT RODS AND 1/8" CLOTH INSERTED RUBBER GASKETS FOR EXPANSION JOINTS.

REMOVE EXISTING 36" STEEL EXPANSION JOINT. INSTALL NEW RUBBER EXPANSION JOINT TO BE PROVIDED BY THE CITY OF TAMPA

No.	DATE	REVISIONS	No.	DATE	REVISIONS
1			6		
2			7		
3			8		
4			9		
5			10		

NOTE: THE ABOVE BASE MAP AND UTILITY LOCATIONS (PLAN & PROFILE) WAS PROVIDED BY CITY OF TAMPA DEPARTMENT OF PUBLIC WORKS (FILE No. 4833, JOB No. PW97-30). REFERENCE INFORMATION WAS NOT VERIFIED BY CITY OF TAMPA DEPARTMENT OF SANITARY SEWERS FIELD SURVEYORS.


DES: B.G.
DRN: BJB
CKD: B.H.
DATE: 4/10/03

CITY OF TAMPA FLORIDA
DEPARTMENT OF SANITARY SEWERS
RENEWAL & REPLACEMENT
SEWAGE DISPOSAL SYSTEM


131ST AVE. PUMPING STATION
IMPROVEMENTS

DESIGN W.O.
5165

SHEET
4
OF 7

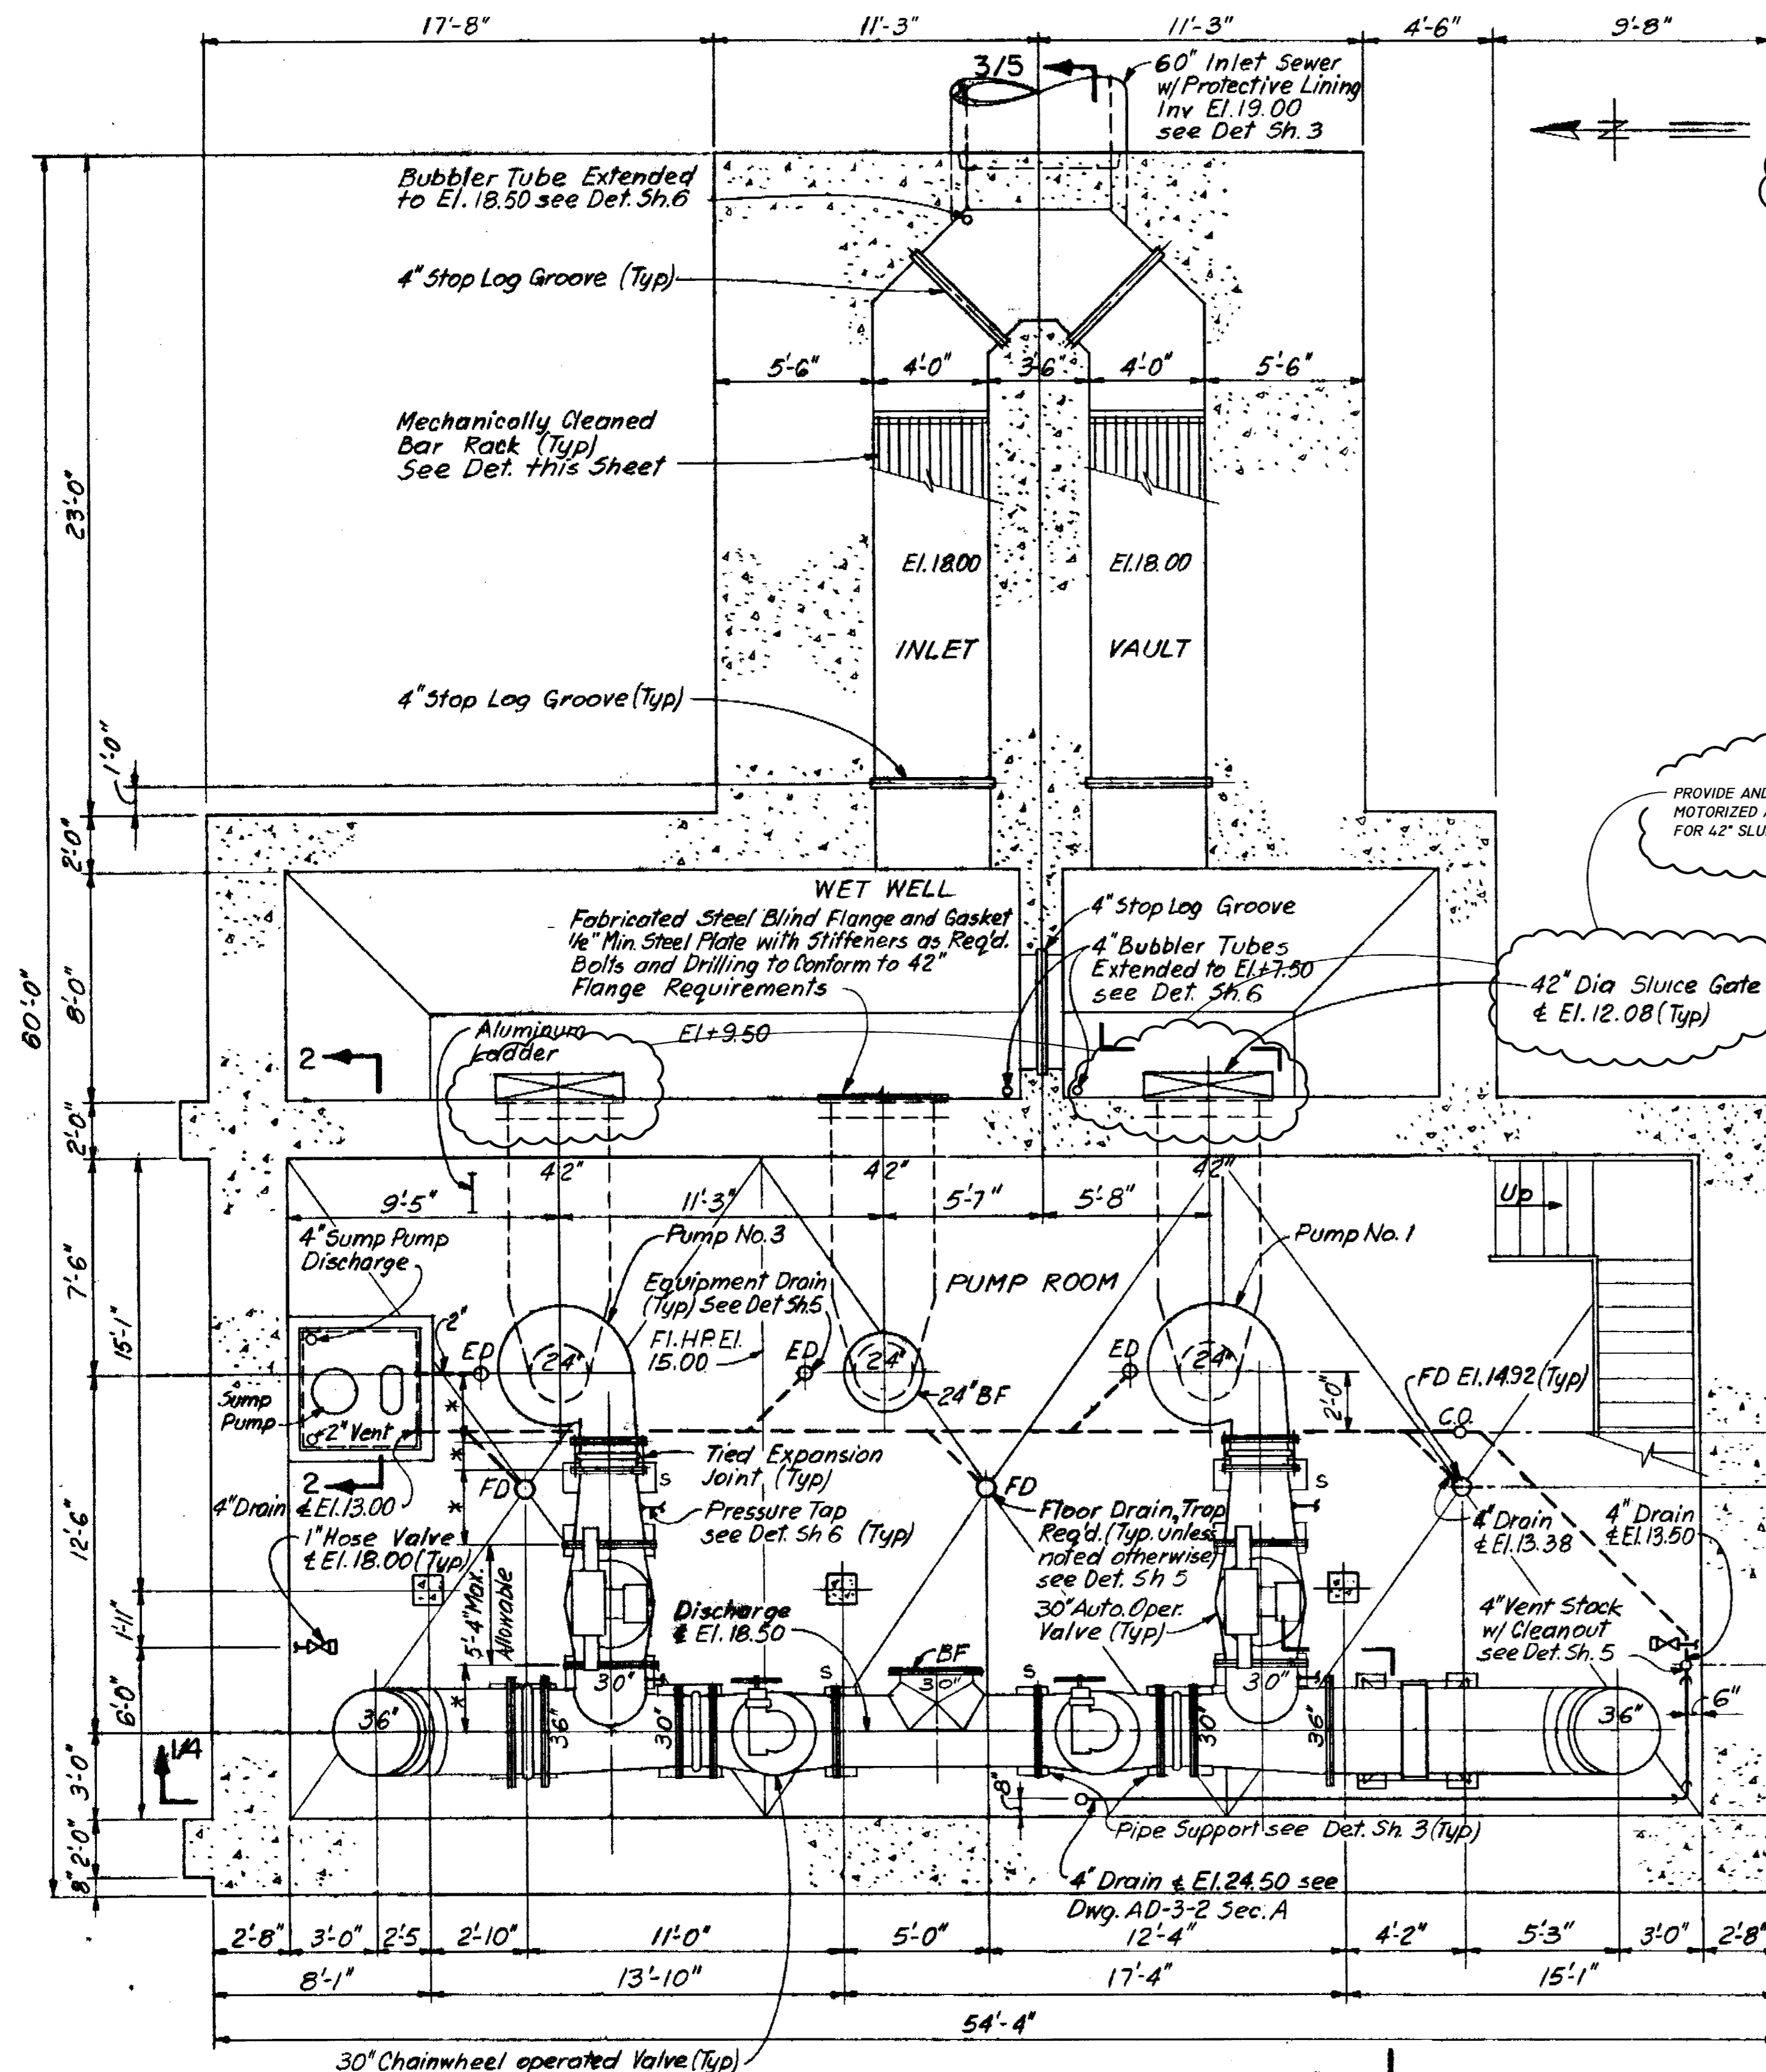

PLAN AT EL. 15.00
SCALE: 1/4" = 1'-0"

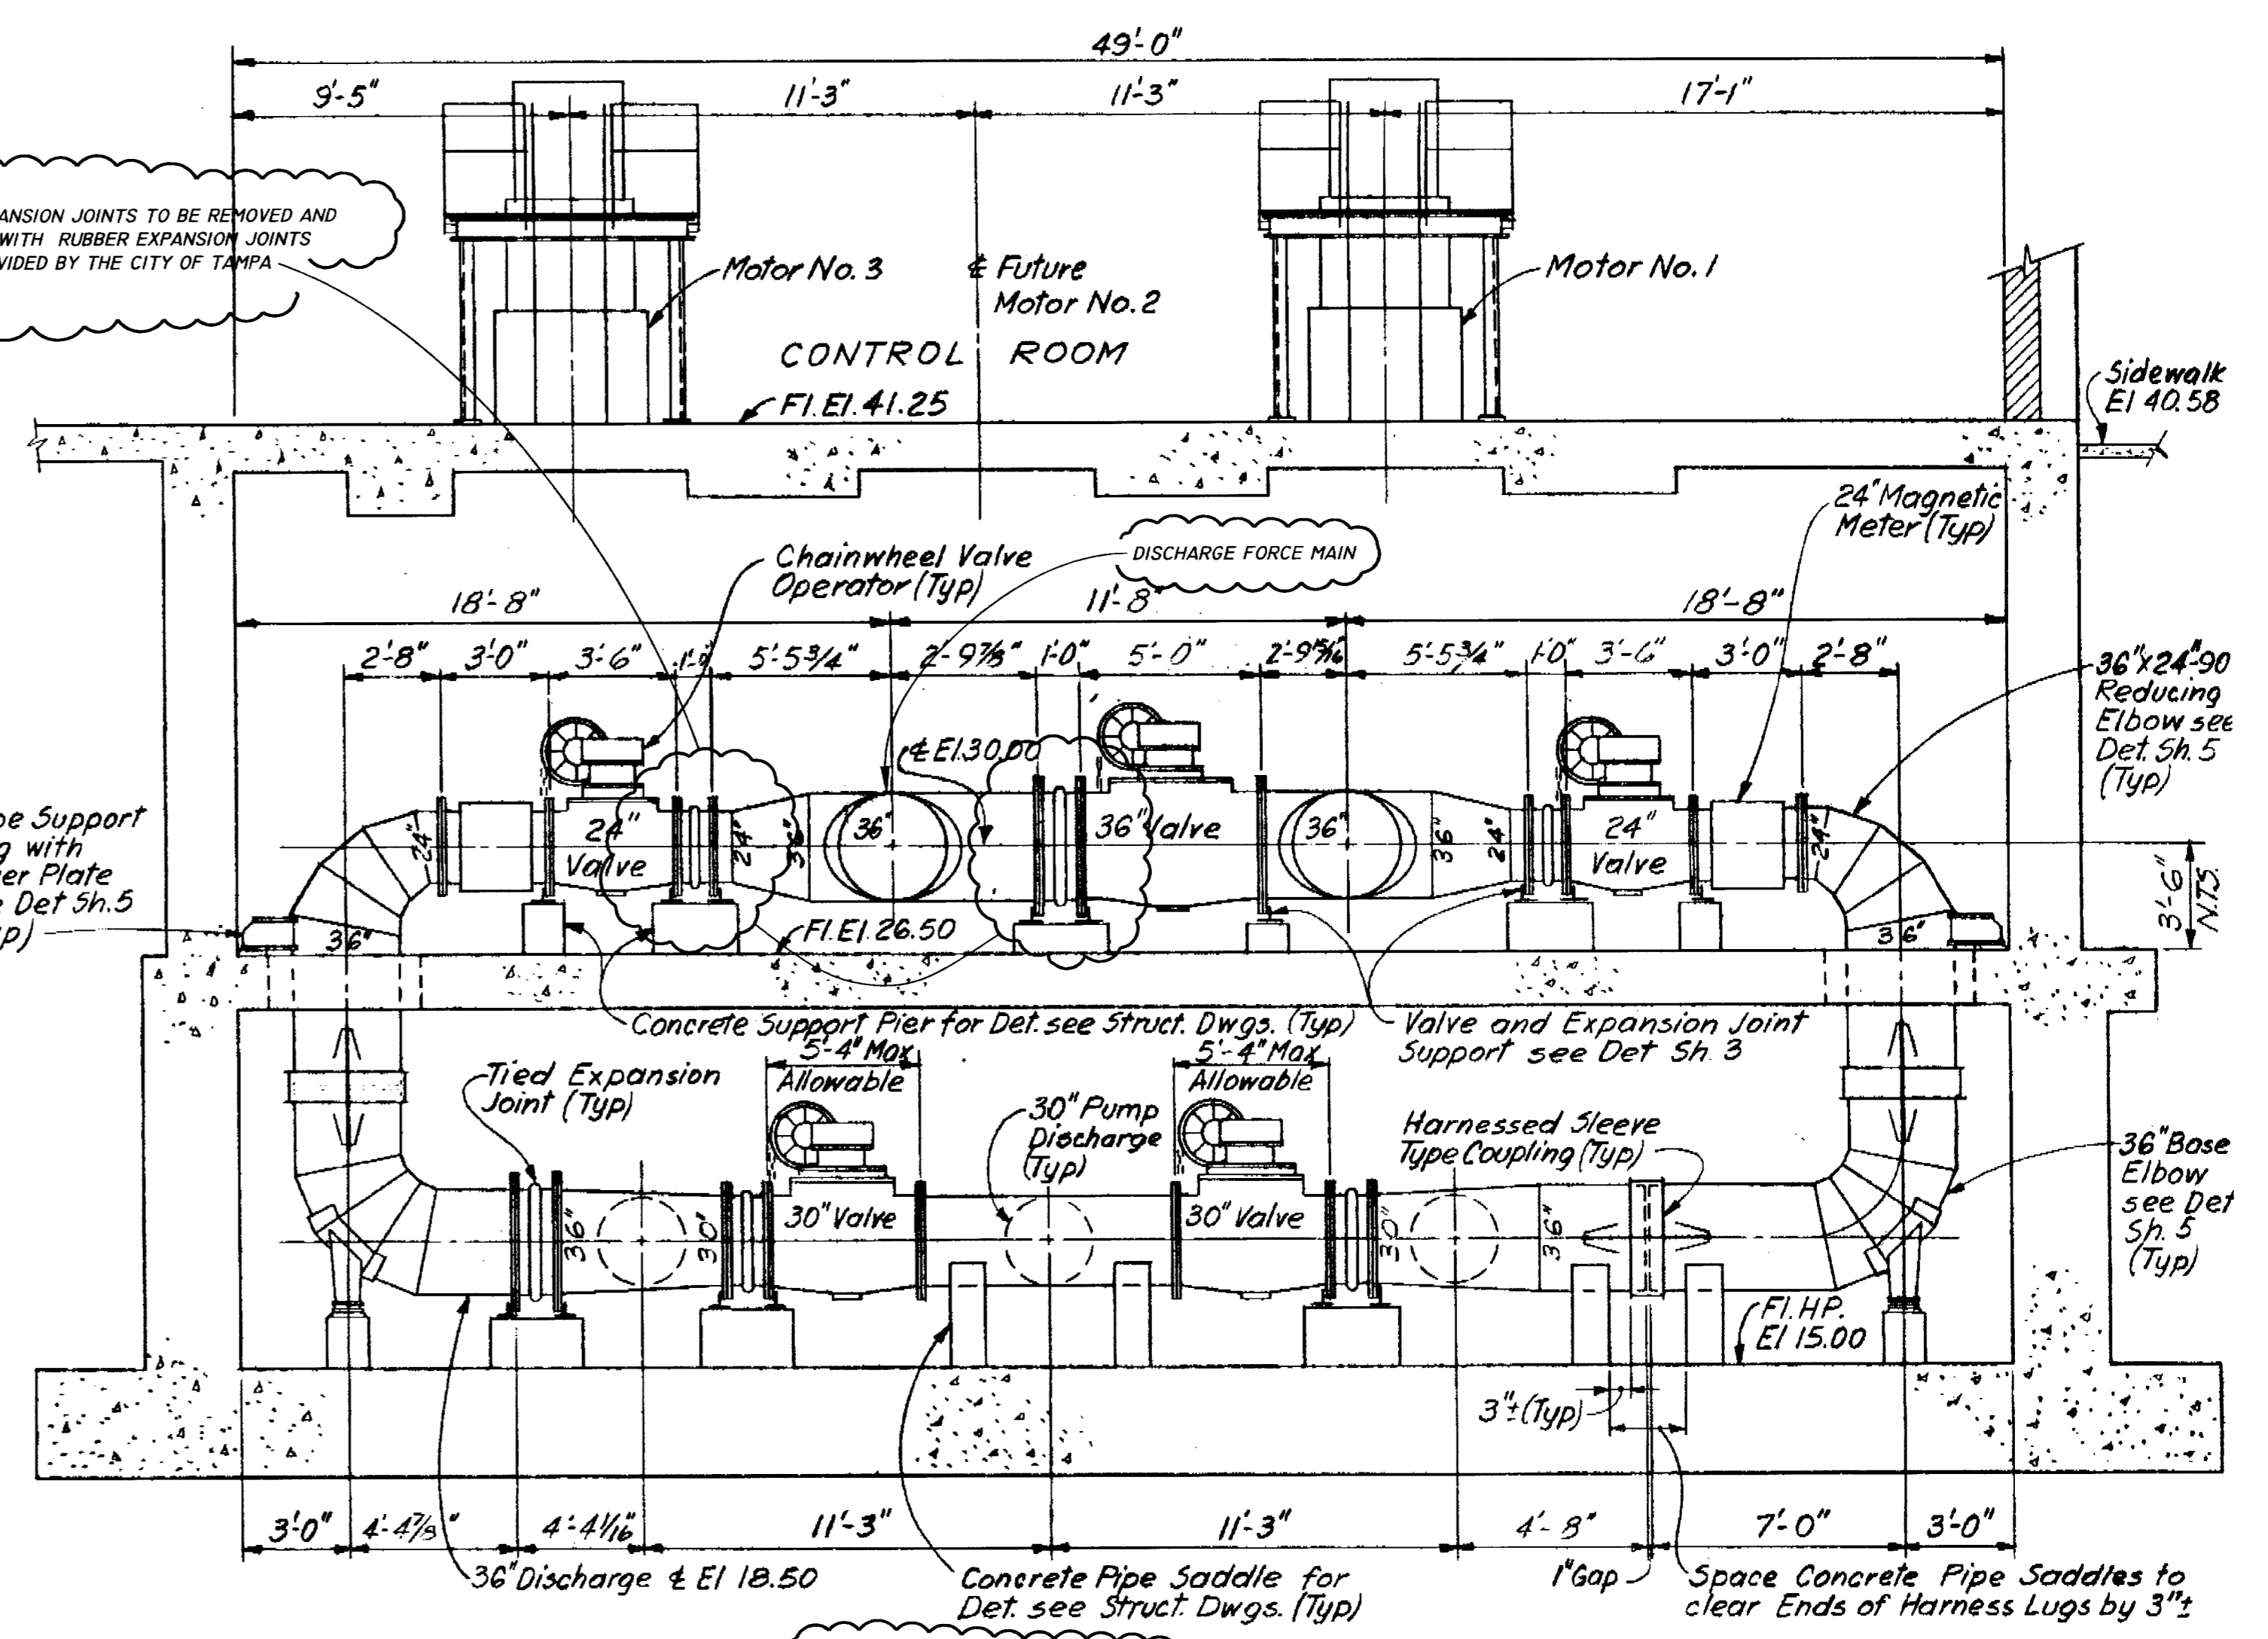

SECTION 1/3.4
SCALE: 1/4" = 1'-0"

C:\PROGRAMFILES\ACAD2000\DWG\PS\15165-3

No.	DATE	REVISIONS	No.	DATE	REVISIONS
1			6		
2			7		
3			8		
4			9		
5			10		

NOTE:
THE ABOVE BASE MAP AND UTILITY LOCATIONS (PLAN & PROFILE) WAS PROVIDED BY CITY OF TAMPA DEPARTMENT OF PUBLIC WORKS (FILE No 4833, JOB No PW97-30).
REFERENCE INFORMATION WAS NOT VERIFIED BY CITY OF TAMPA DEPARTMENT OF SANITARY SEWERS FIELD SURVEYORS.

DES: B.G.
DRN: BB
CKD: [Signature]
DATE: 4/1/03

CITY OF TAMPA FLORIDA
DEPARTMENT OF SANITARY SEWERS
RENEWAL & REPLACEMENT
SEWAGE DISPOSAL SYSTEM

131ST AVE. PUMPING STATION
IMPROVEMENTS



DESIGN W.O.
5165

SHEET
5
OF 7

336-50


NOTES:

1. PROVIDE AND INSTALL MOTORIZED SLUICE GATE ACTUATORS BY WATERMAN INDUSTRIES, INC. TO SUIT EXISTING SLUICE GATE. (SEE SPECIFICATIONS)
2. PROVIDE AND INSTALL STEM COUPLERS, STEM EXTENSIONS AND STEM GUIDES AS SHOWN AND SPECIFIED.
3. CORE DRILL CONCRETE BEAM AS REQUIRED FOR STEM EXTENSIONS. (SEE DETAIL, THIS SHEET)
4. REMOVE EXISTING FLOOR STAND ACTUATORS AND TRANSPORT TO H.F. CURREN A.W.T. PLANT FOR DISPOSAL.
5. THE ATMOSPHERE IN THE SCREEN ROOM IS SUBJECT TO HAZARDOUS LEVELS OF HYDROGEN SULFIDE AND METHANE GASES. THE CONTRACTOR SHALL BE RESPONSIBLE FOR MONITORING THE AIR QUALITY AND PROVIDING ADEQUATE VENTILATION AND SAFETY EQUIPMENT THAT MAY BE NECESSARY FOR THE SAFETY OF THE WORKERS.
6. EACH FLOOR STAND SHALL BE ANCHORED TO THE CONCRETE SLAB WITH 4(FOUR) 3/4" DIAMETER (MINIMUM) STAINLESS STEEL ADHESIVE ANCHORS EMBEDDED 6"(MINIMUM) IN THE SLAB. ADHESIVE ANCHORS SHALL BE HILTI HVA ANCHORS OR EQUAL.

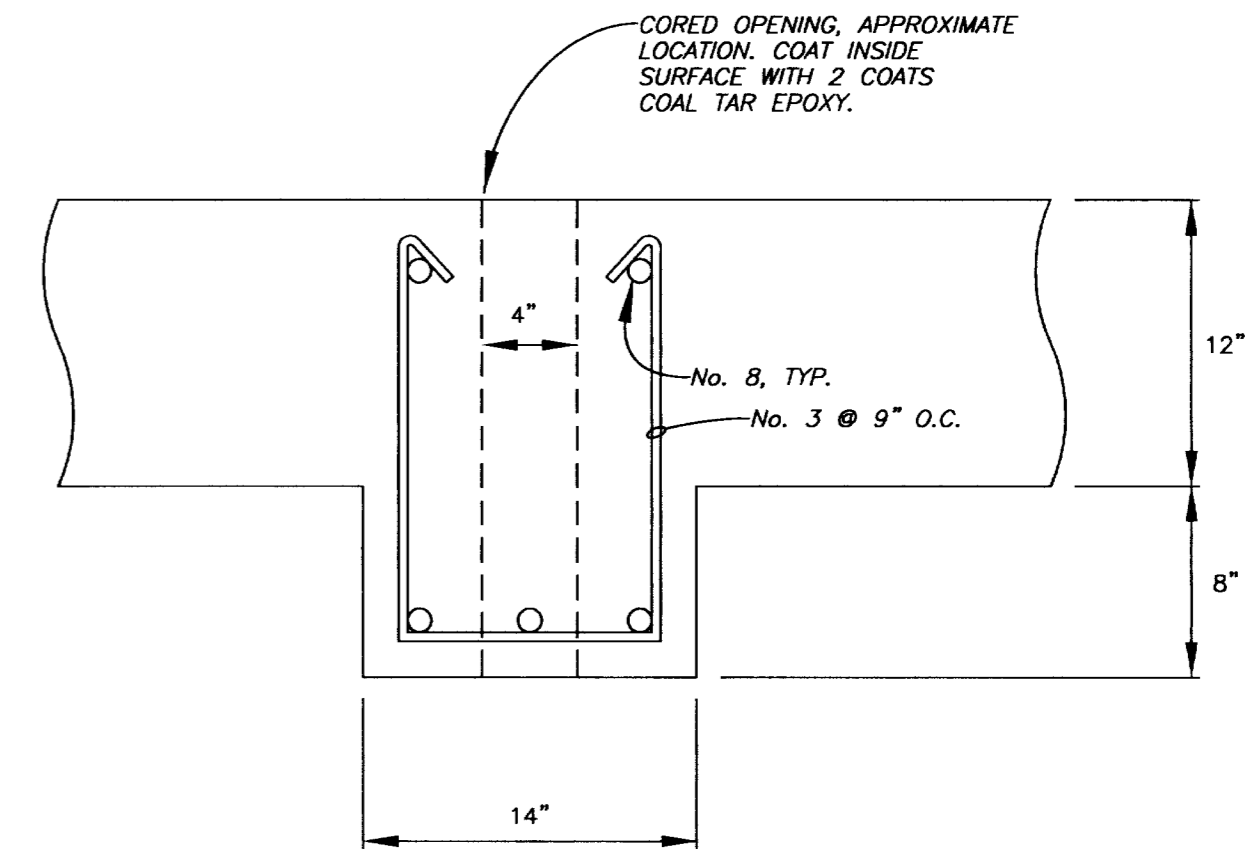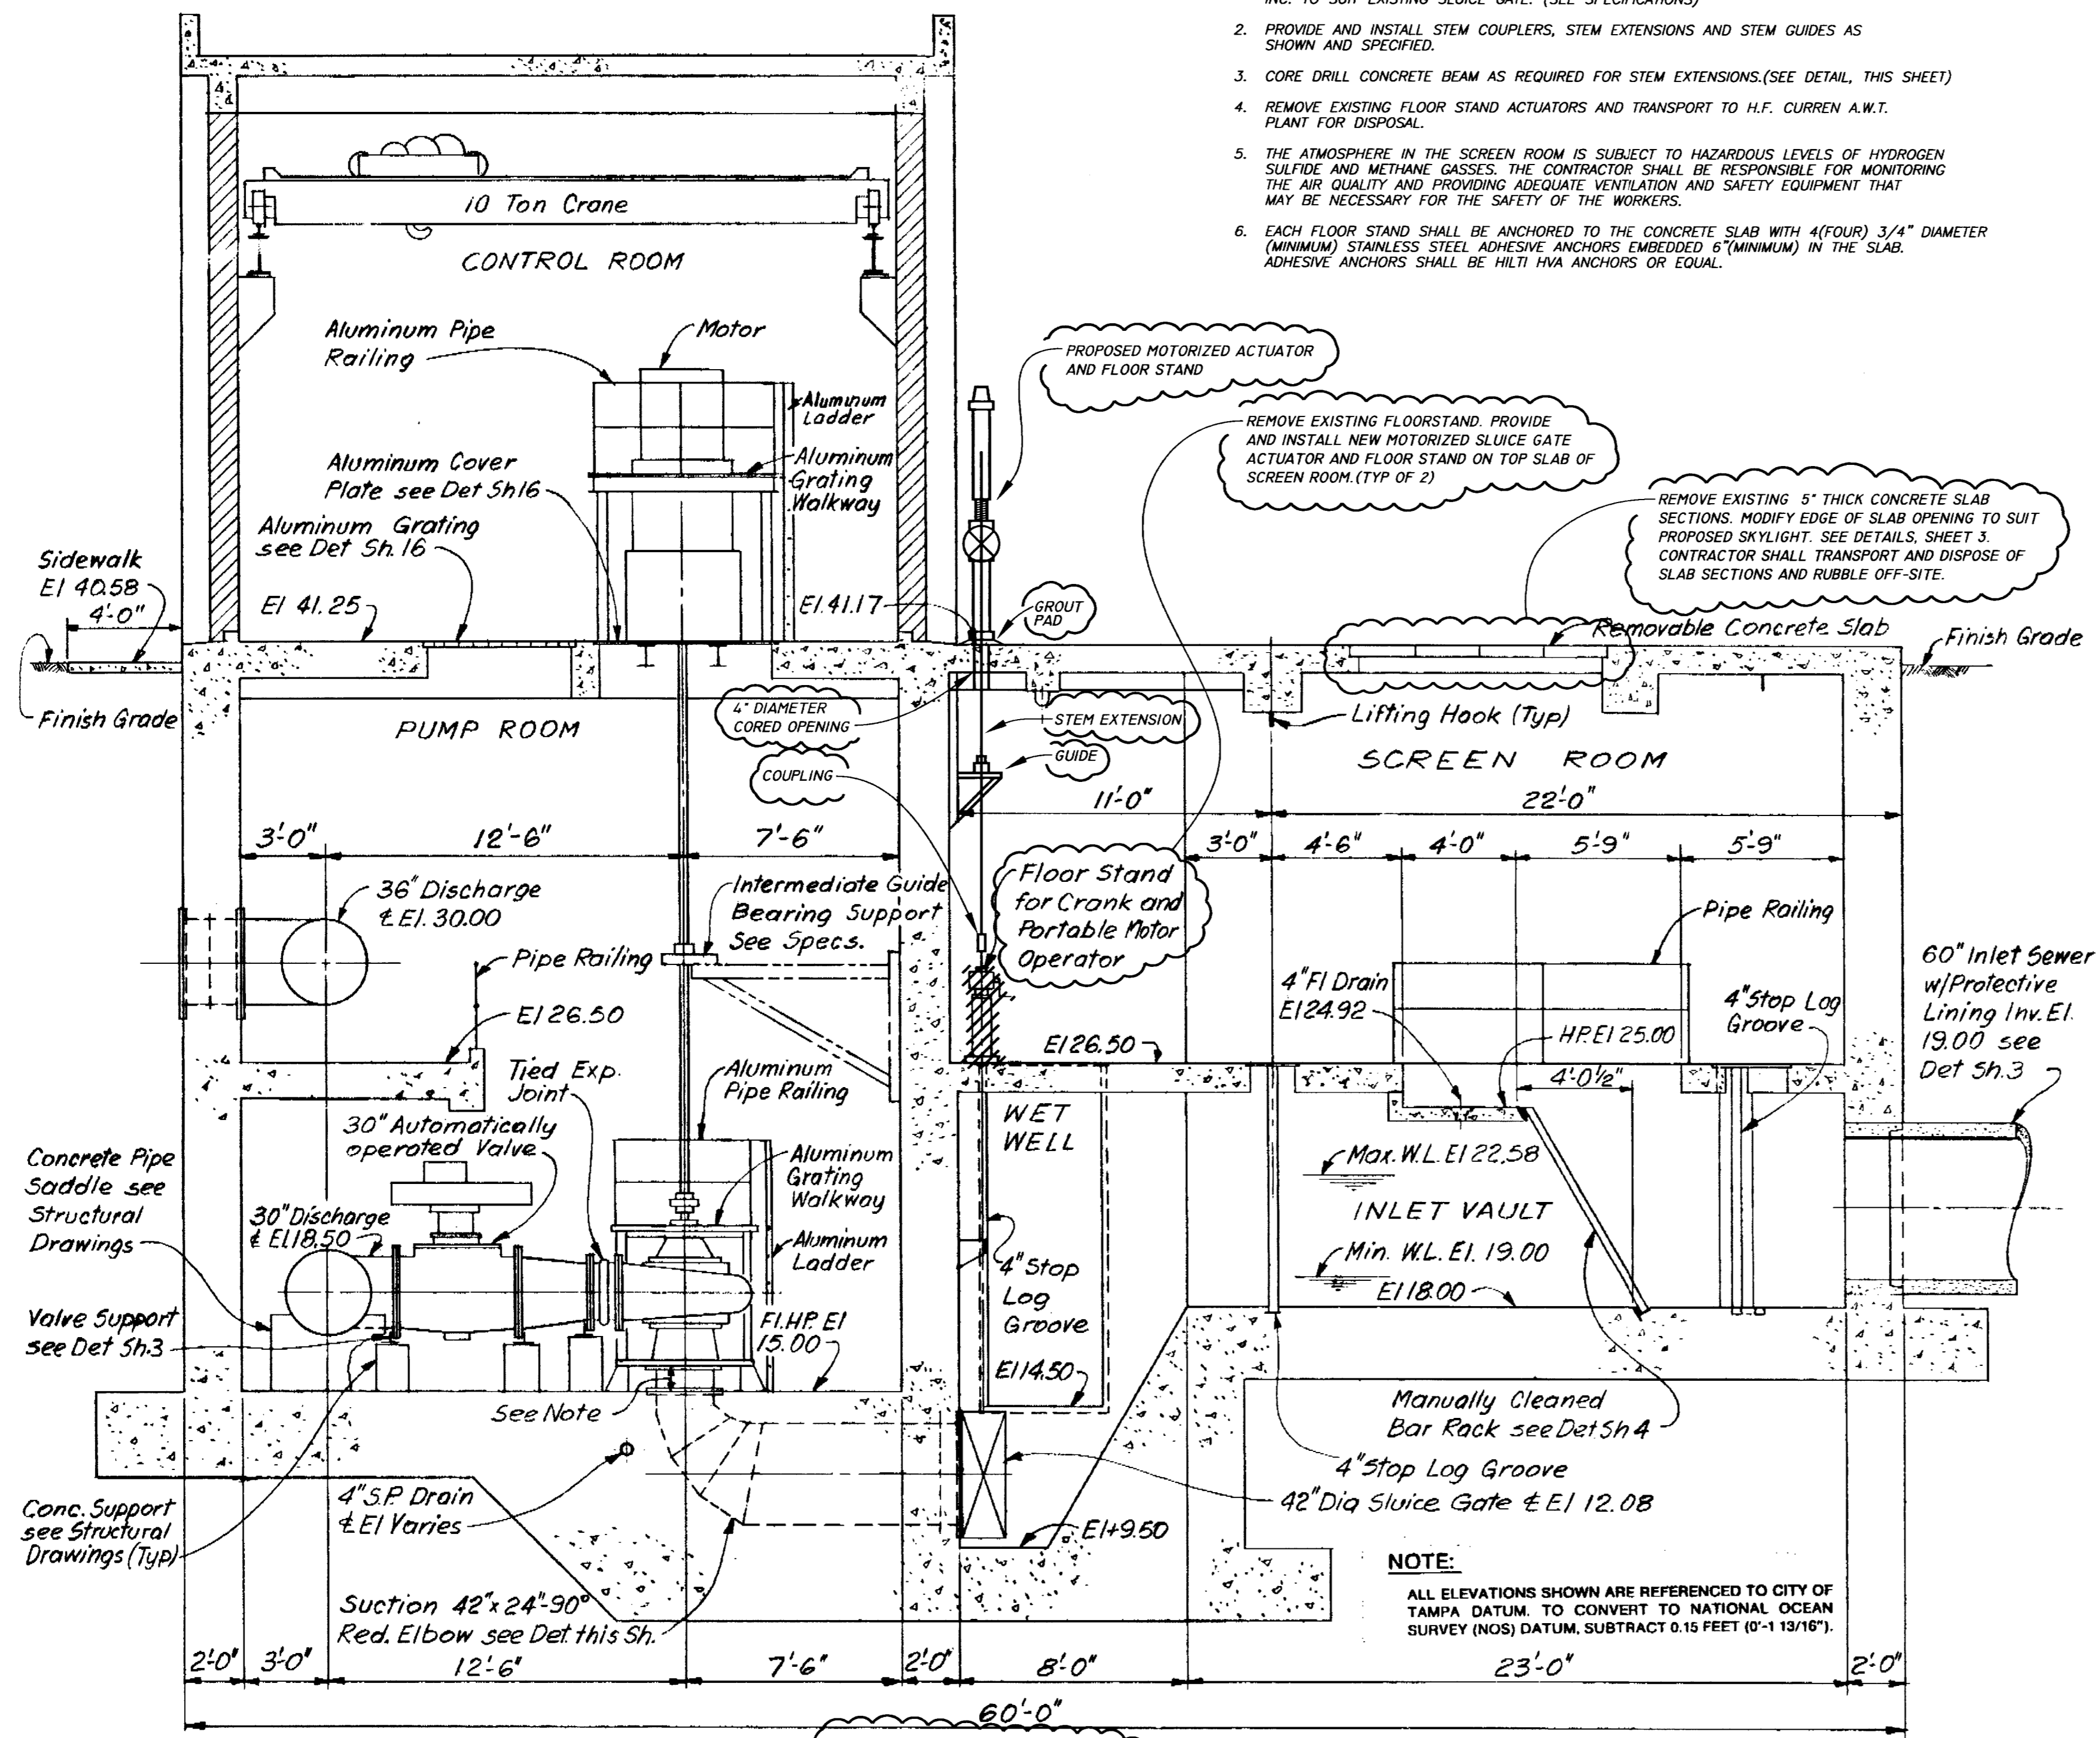

DETAIL - CORED OPENING FOR STEM EXTENSION

SCALE: 1 1/2" = 1'-0"

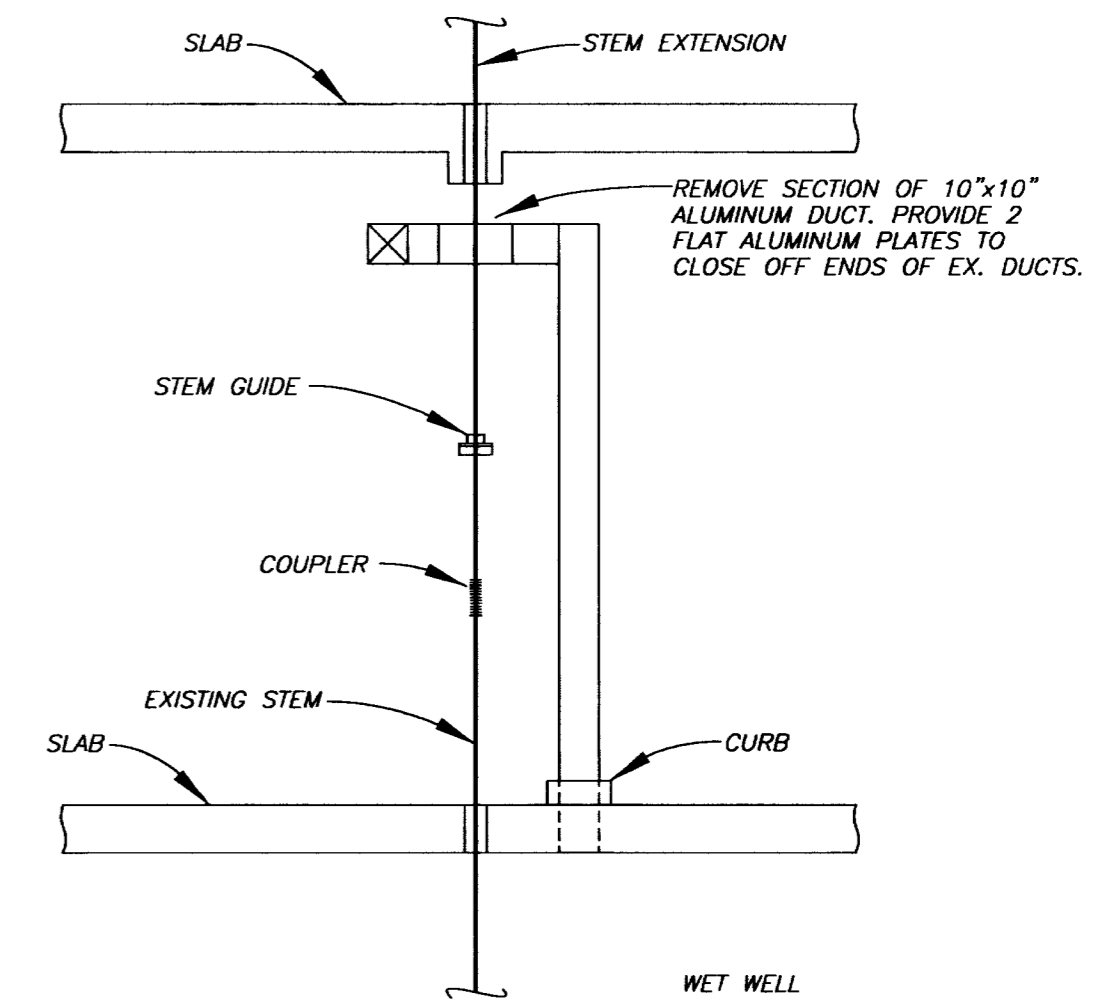

DETAIL - STEM EXTENSION FOR SOUTHERN SLUICE GATE (PUMP No. 1)

SCALE: 1/4" = 1'-0"

NOTE:
ALL ELEVATIONS SHOWN ARE REFERENCED TO CITY OF TAMPA DATUM. TO CONVERT TO NATIONAL OCEAN SURVEY (NOS) DATUM, SUBTRACT 0.15 FEET (0'-1 13/16").

NOTE:
THE ABOVE BASE MAP AND UTILITY LOCATIONS (PLAN & PROFILE) WAS PROVIDED BY CITY OF TAMPA DEPARTMENT OF PUBLIC WORKS (FILE No 4833, JOB No PW97-30). REFERENCE INFORMATION WAS NOT VERIFIED BY CITY OF TAMPA DEPARTMENT OF SANITARY SEWERS FIELD SURVEYORS.

DES: B.G.
DRN: JPB
CKD: JTB
DATE: 5/26/03


CITY OF TAMPA FLORIDA
DEPARTMENT OF SANITARY SEWERS
RENEWAL & REPLACEMENT
SEWAGE DISPOSAL SYSTEM

131ST AVE. PUMPING STATION
IMPROVEMENTS

DESIGN W.O.
5165


SHEET
6
OF 7

No.	DATE	REVISIONS	No.	DATE	REVISIONS
1	05-02-03	REMOVED NOTES RELATED TO LINES	6		
2			7		
3			8		
4			9		
5			10		

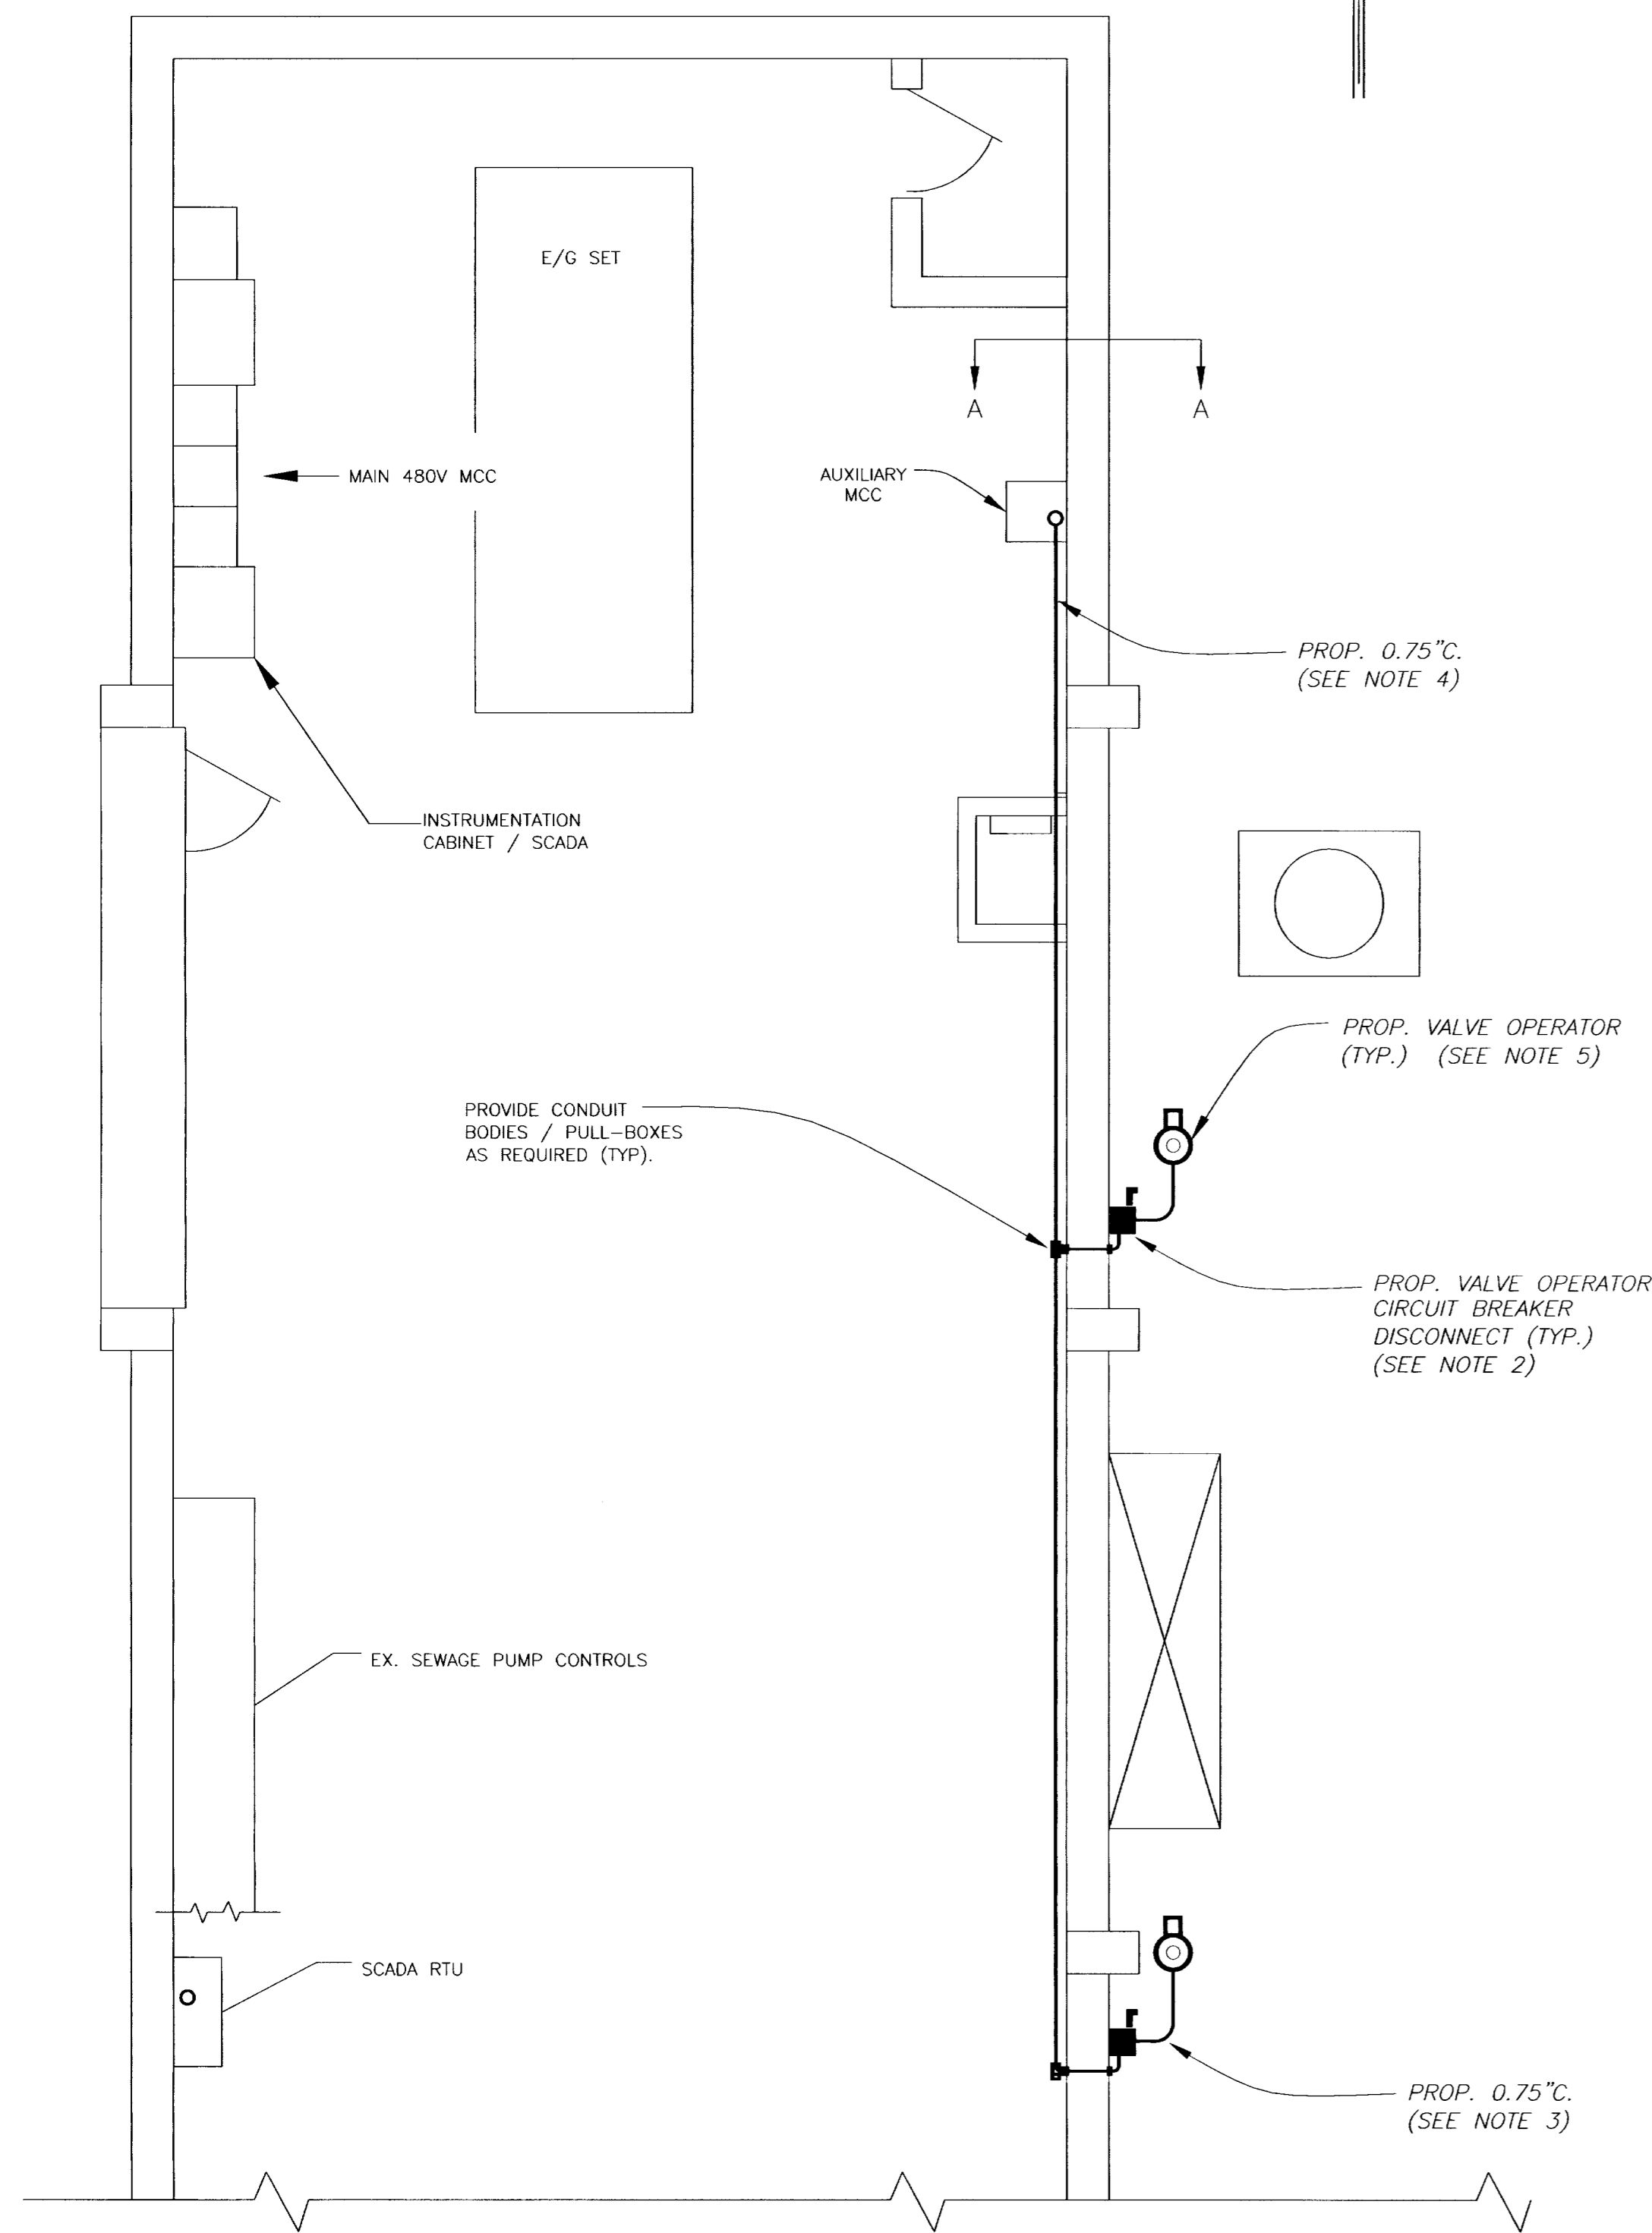


PLAN AT FL. EL. 41'-3"

SCALE: 1/4" = 1'-0"

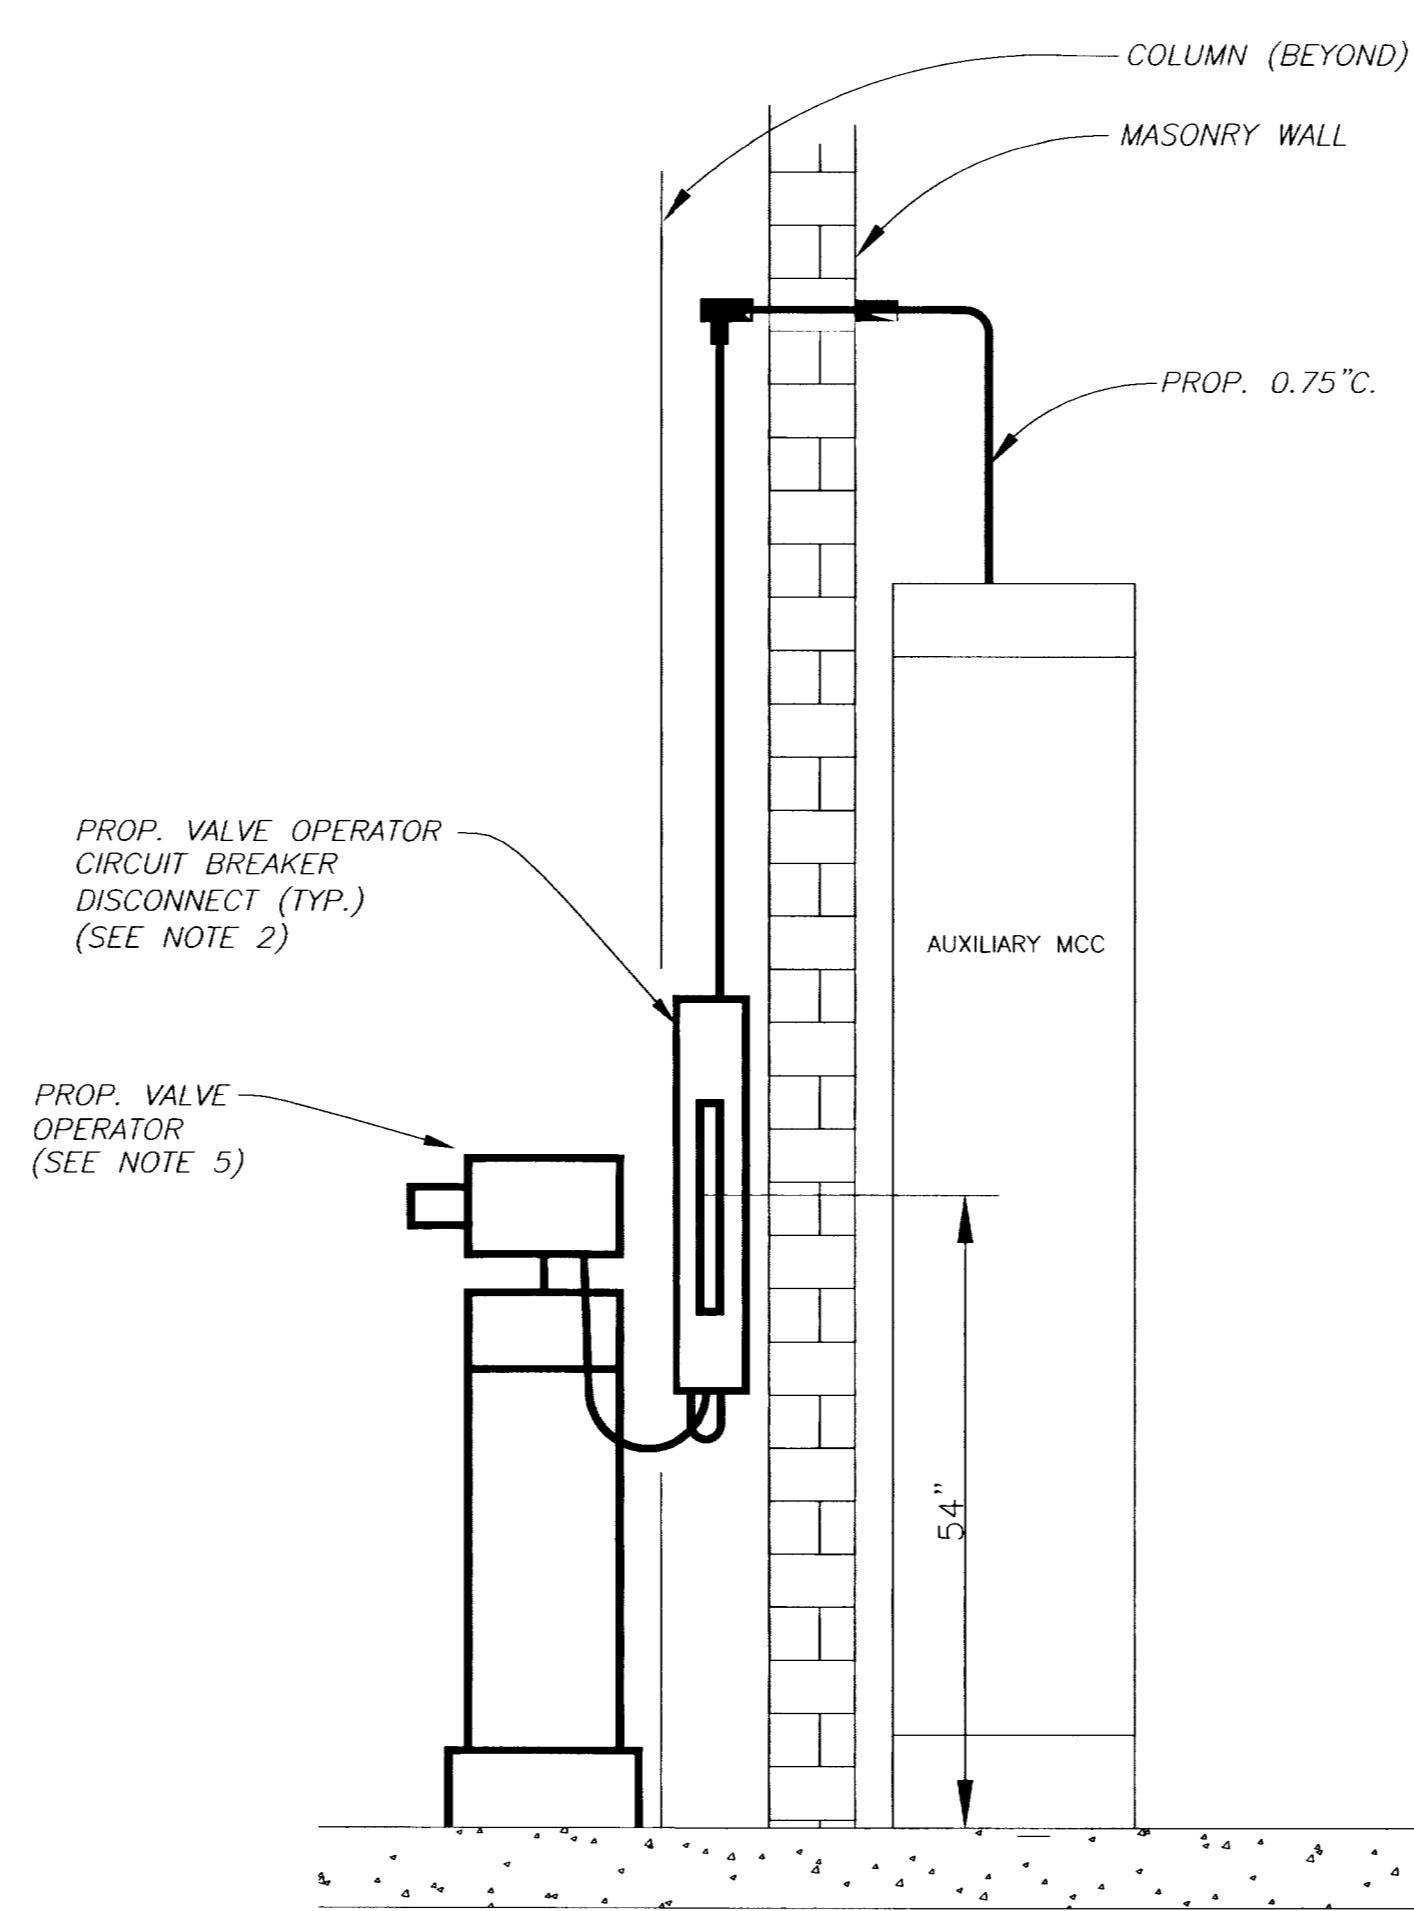


SECTION A - A

N.T.S.

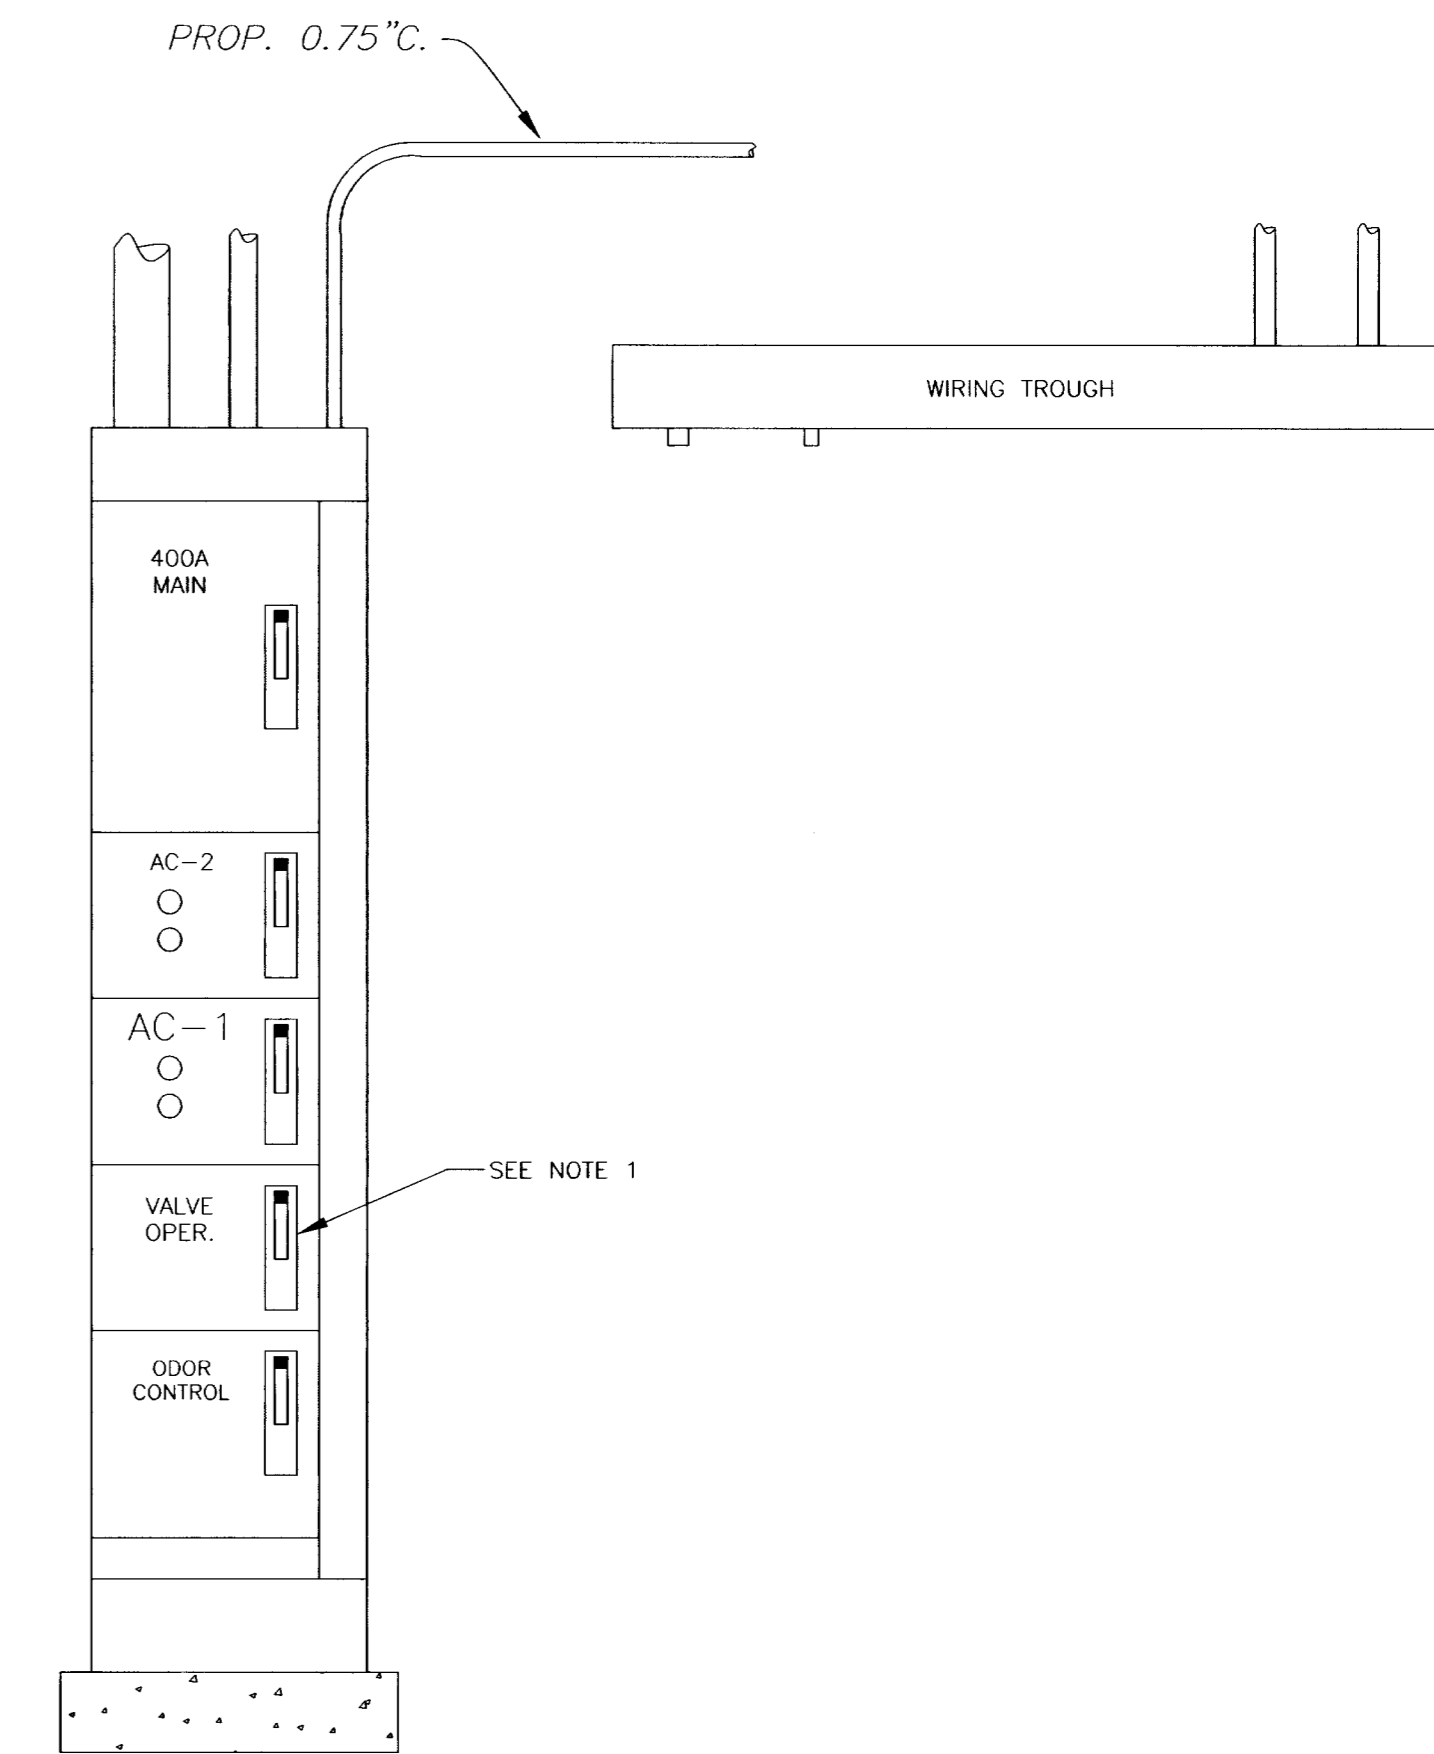

AUXILIARY 480V MCC STRUCTURE (FRONT)

(LOCATED ON EAST WALL) N.T.S.

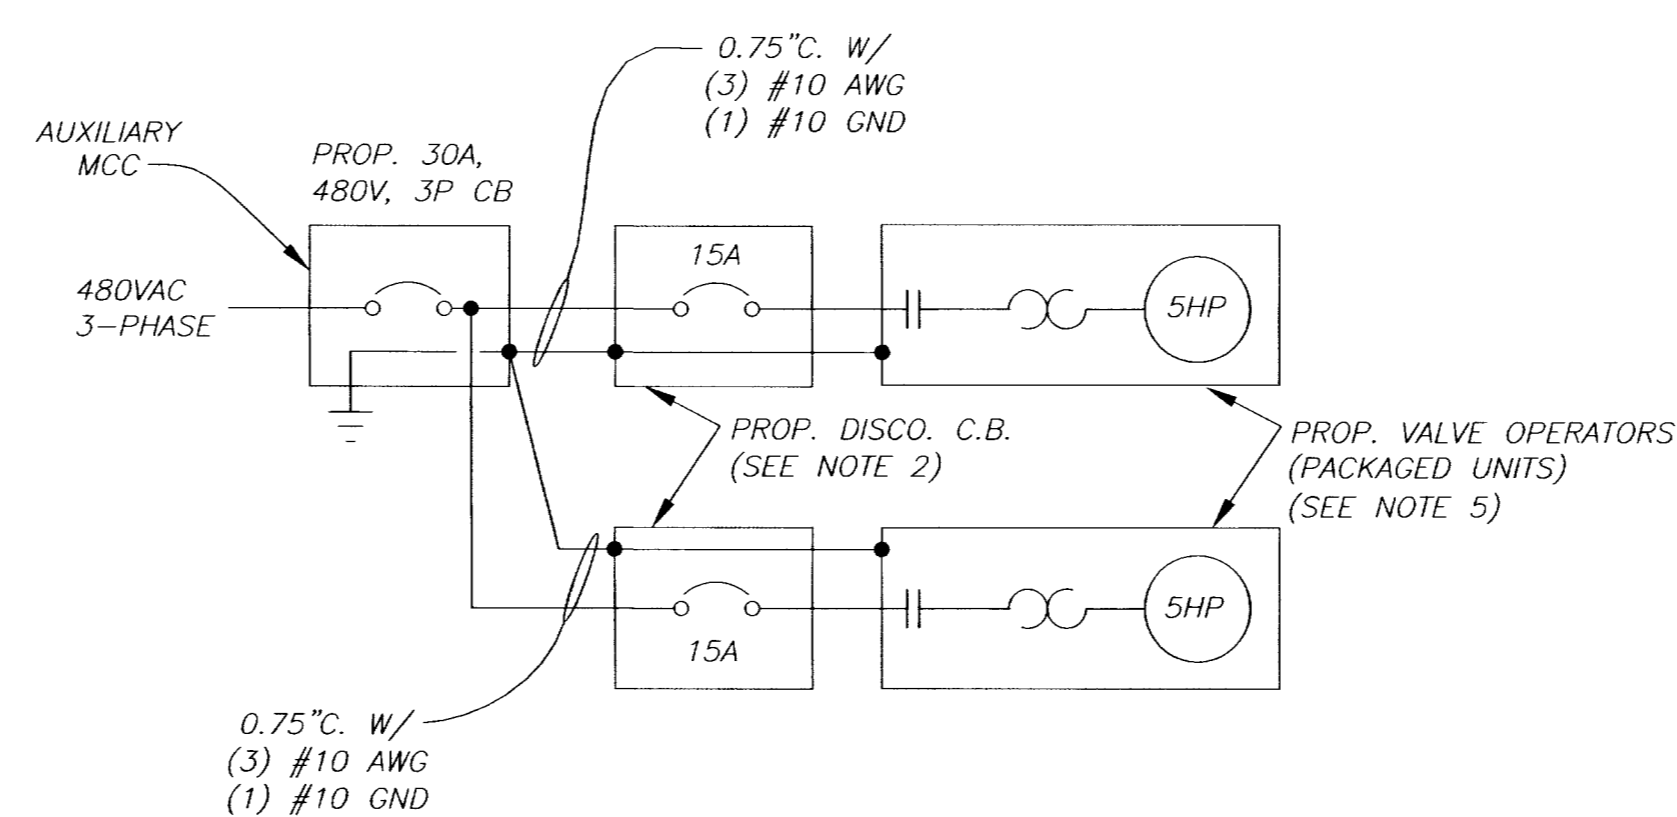

VALVE OPERATORS ONE LINE DIAGRAM

NOTES:

1. REMOVE EXISTING 20A CIRCUIT BREAKER. PROVIDE AND INSTALL 30A, 3P, 600V CIRCUIT BREAKER (FHL36030) FOR VALVE OPERATORS. RUN SEPARATE 10 AWG CONDUCTORS TO EACH VALVE OPERATOR CIRCUIT BREAKER DISCONNECT. LABEL CUBICLE AS SHOWN.
2. 480V, 3P CIRCUIT BREAKER MOUNTED IN A COPPER FREE CAST ALUMINUM NEMA 4X ENCLOSURE W/ EPOXY POWDER COATING INSIDE AND OUTSIDE. CONDUITS SHALL ENTER ALL OUTDOOR ENCLOSURES FROM THE BOTTOM. COORDINATE CIRCUIT BREAKER DISCONNECT RATINGS WITH VALVE OPERATORS SUPPLIED.
3. ALL CONDUITS, FITTINGS, AND TERMINAL BOXES INSTALLED OUTDOORS SHALL BE RIGID ALUMINUM COATED WITH 40mil PVC OUTSIDE AND 2mil URETHANE INSIDE, AS MANUFACTURED BY ROBROY.
4. ALL CONDUIT MOUNTED INDOORS SHALL BE RIGID ALUMINUM, AS SPECIFIED.
5. PROVIDE AND INSTALL MOTORIZED VALVE OPERATORS AS SHOWN, SPECIFIED, AND REQUIRED.
6. A FIBERGLASS OR STAINLESS STEEL CHANNEL ERECTOR SYSTEM SHALL BE USED TO HANG ALL CONDUITS, BOXES, ETC. OUTDOORS. ALUMINUM MAY BE USED INDOORS. USE 316 STAINLESS STEEL MOUNTING HARDWARE.
7. RUN A PROPERLY SIZED BONDING CONDUCTOR IN ALL CONDUITS.
8. ALL ITEMS NOT MARKED "PROP." ARE EXISTING

C:\ACAD2000\DWG\PS\51185-SITE 1-40

No.	DATE	REVISIONS	No.	DATE	REVISIONS
1			6		
2			7		
3			8		
4			9		
5			10		

DES: R.K.
 DRN: R.K.
 CKD: *AA*
 DATE: 4/1/05

CITY OF TAMPA FLORIDA
 DEPARTMENT OF SANITARY SEWERS
 RENEWAL & REPLACEMENT
 SEWAGE DISPOSAL SYSTEM

131st AVE. PUMPING STATION
 VALVE OPERATOR ADDITION
 ELECTRICAL

DESIGN W.O. 5165
 CONSTRUCTION W.O.

SHEET
EI-7
 OF 7

CITY of TAMPA




As-Built Drawings

WASTEWATER DEPARTMENT

PLANS FOR
 UNIVERSITY PUMPING STATION
 PUMP NO. 2 REPLACEMENT
 CONTRACT : 08-C-00034

LOCATION MAP

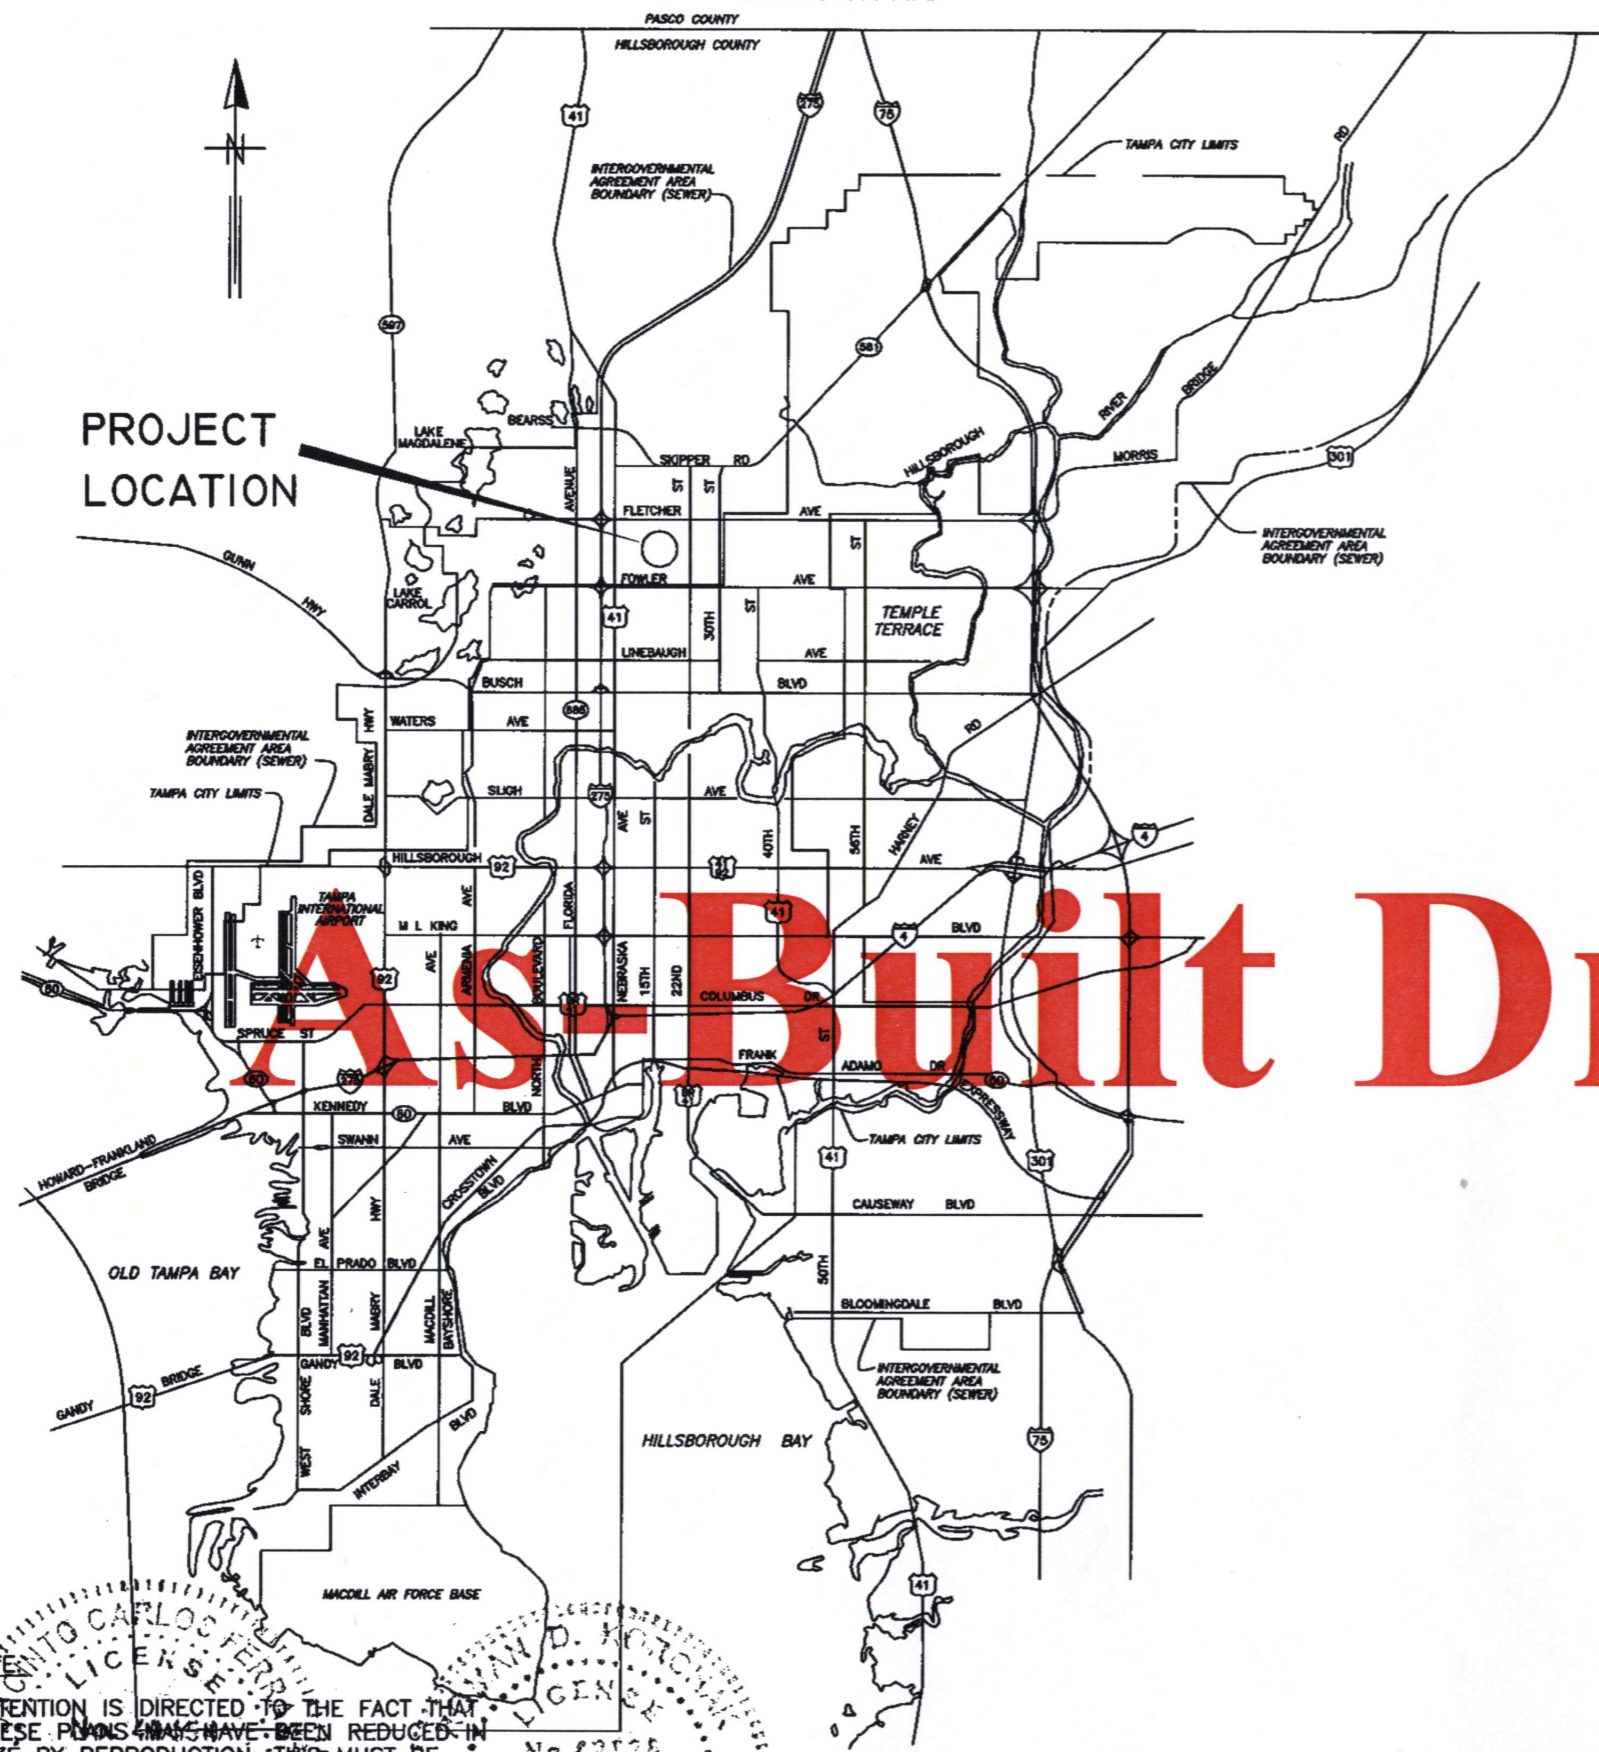

NOTE: ATTENTION IS DIRECTED TO THE FACT THAT THESE PLANS HAVE BEEN REDUCED IN SIZE BY REPRODUCTION. THIS MUST BE CONSIDERED WHEN OBTAINING SCALED DATA.

JACINTO CARLOS FERRAS, P.E. #9454
 DESIGN DIVISION HEAD
 WASTEWATER DEPARTMENT

ROMAN D. KORCHAK, P.E. #42823
 ELECTRICAL SECTION HEAD
 WASTEWATER DEPARTMENT

No.	DATE	REVISIONS
3		
2		
1		


DES: JH
 DRN: MRL
 CKD: JF
 DATE: 7/1/08

CITY of TAMPA
 WASTEWATER DEPARTMENT

COVER SHEET

W.O. 5395
 SHEET
 1

User: ssBk Drawing Name: K:\micat\autocad\DESIGN WORK\JACK\UNIVERSITY (131st st.) PS\DWGS\UNIVERSITY PS.DWG Layout: Jul 01, 2008 - 10:48am

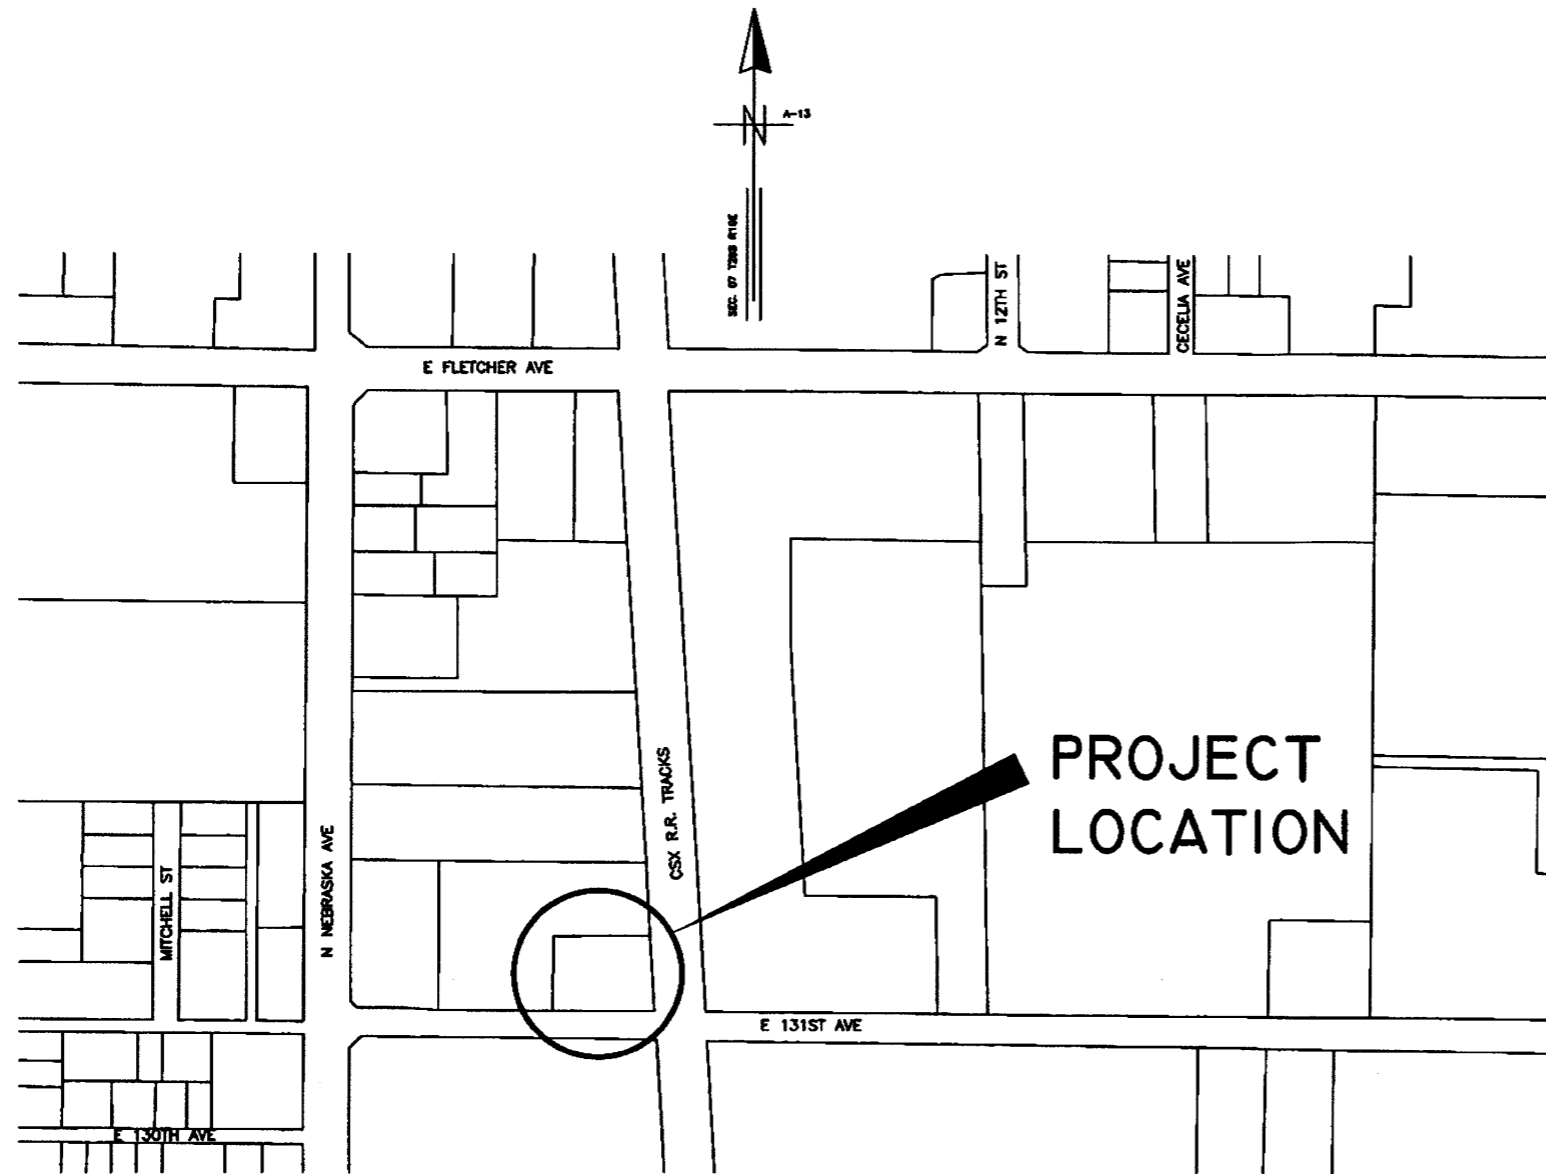


INDEX

SHEET 1	COVER SHEET
SHEET 2	LOCATION MAP & INDEX
SHEET 3	SITE PLAN
SHEET 4	GENERAL NOTES
SHEET 5	DEMOLITION PLAN
SHEET 6	DEMOLITION SECTIONS/ISOLATION DETAIL
SHEET 7	WET WELL SEPARATION
SHEET 8	PROP. PUMP ROOM PLAN
SHEET 9	PROP. PUMP ROOM PROFILE
SHEET 10	MISC. PUMP ROOM DETAILS
SHEET 11	TRANSFORMER MOUNTING PLATFORM
SHEET E0-E10	ELECTRICAL PLANS

User: ssBk Drawing Name: K:\micah\outocad\DESIGN WORK\JACK\UNIVERSITY (131st st.) PS\DWGS\UNIVERSITY PS.DWG Layout: Jul 01, 2008 - 10:49am

JACINTO CARLOS FERRAS, P.E. #49454 DESIGN DIVISION HEAD WASTEWATER DEPARTMENT	No.	DATE	REVISIONS	DES: JH DRN: MRL CKD: JF DATE: 7/1/08	CITY of TAMPA WASTEWATER DEPARTMENT	UNIVERSITY PUMPING STATION PUMP NO. 2 REPLACEMENT COVER SHEET	W.O. 5395
	3						SHEET
	2						2
	1						

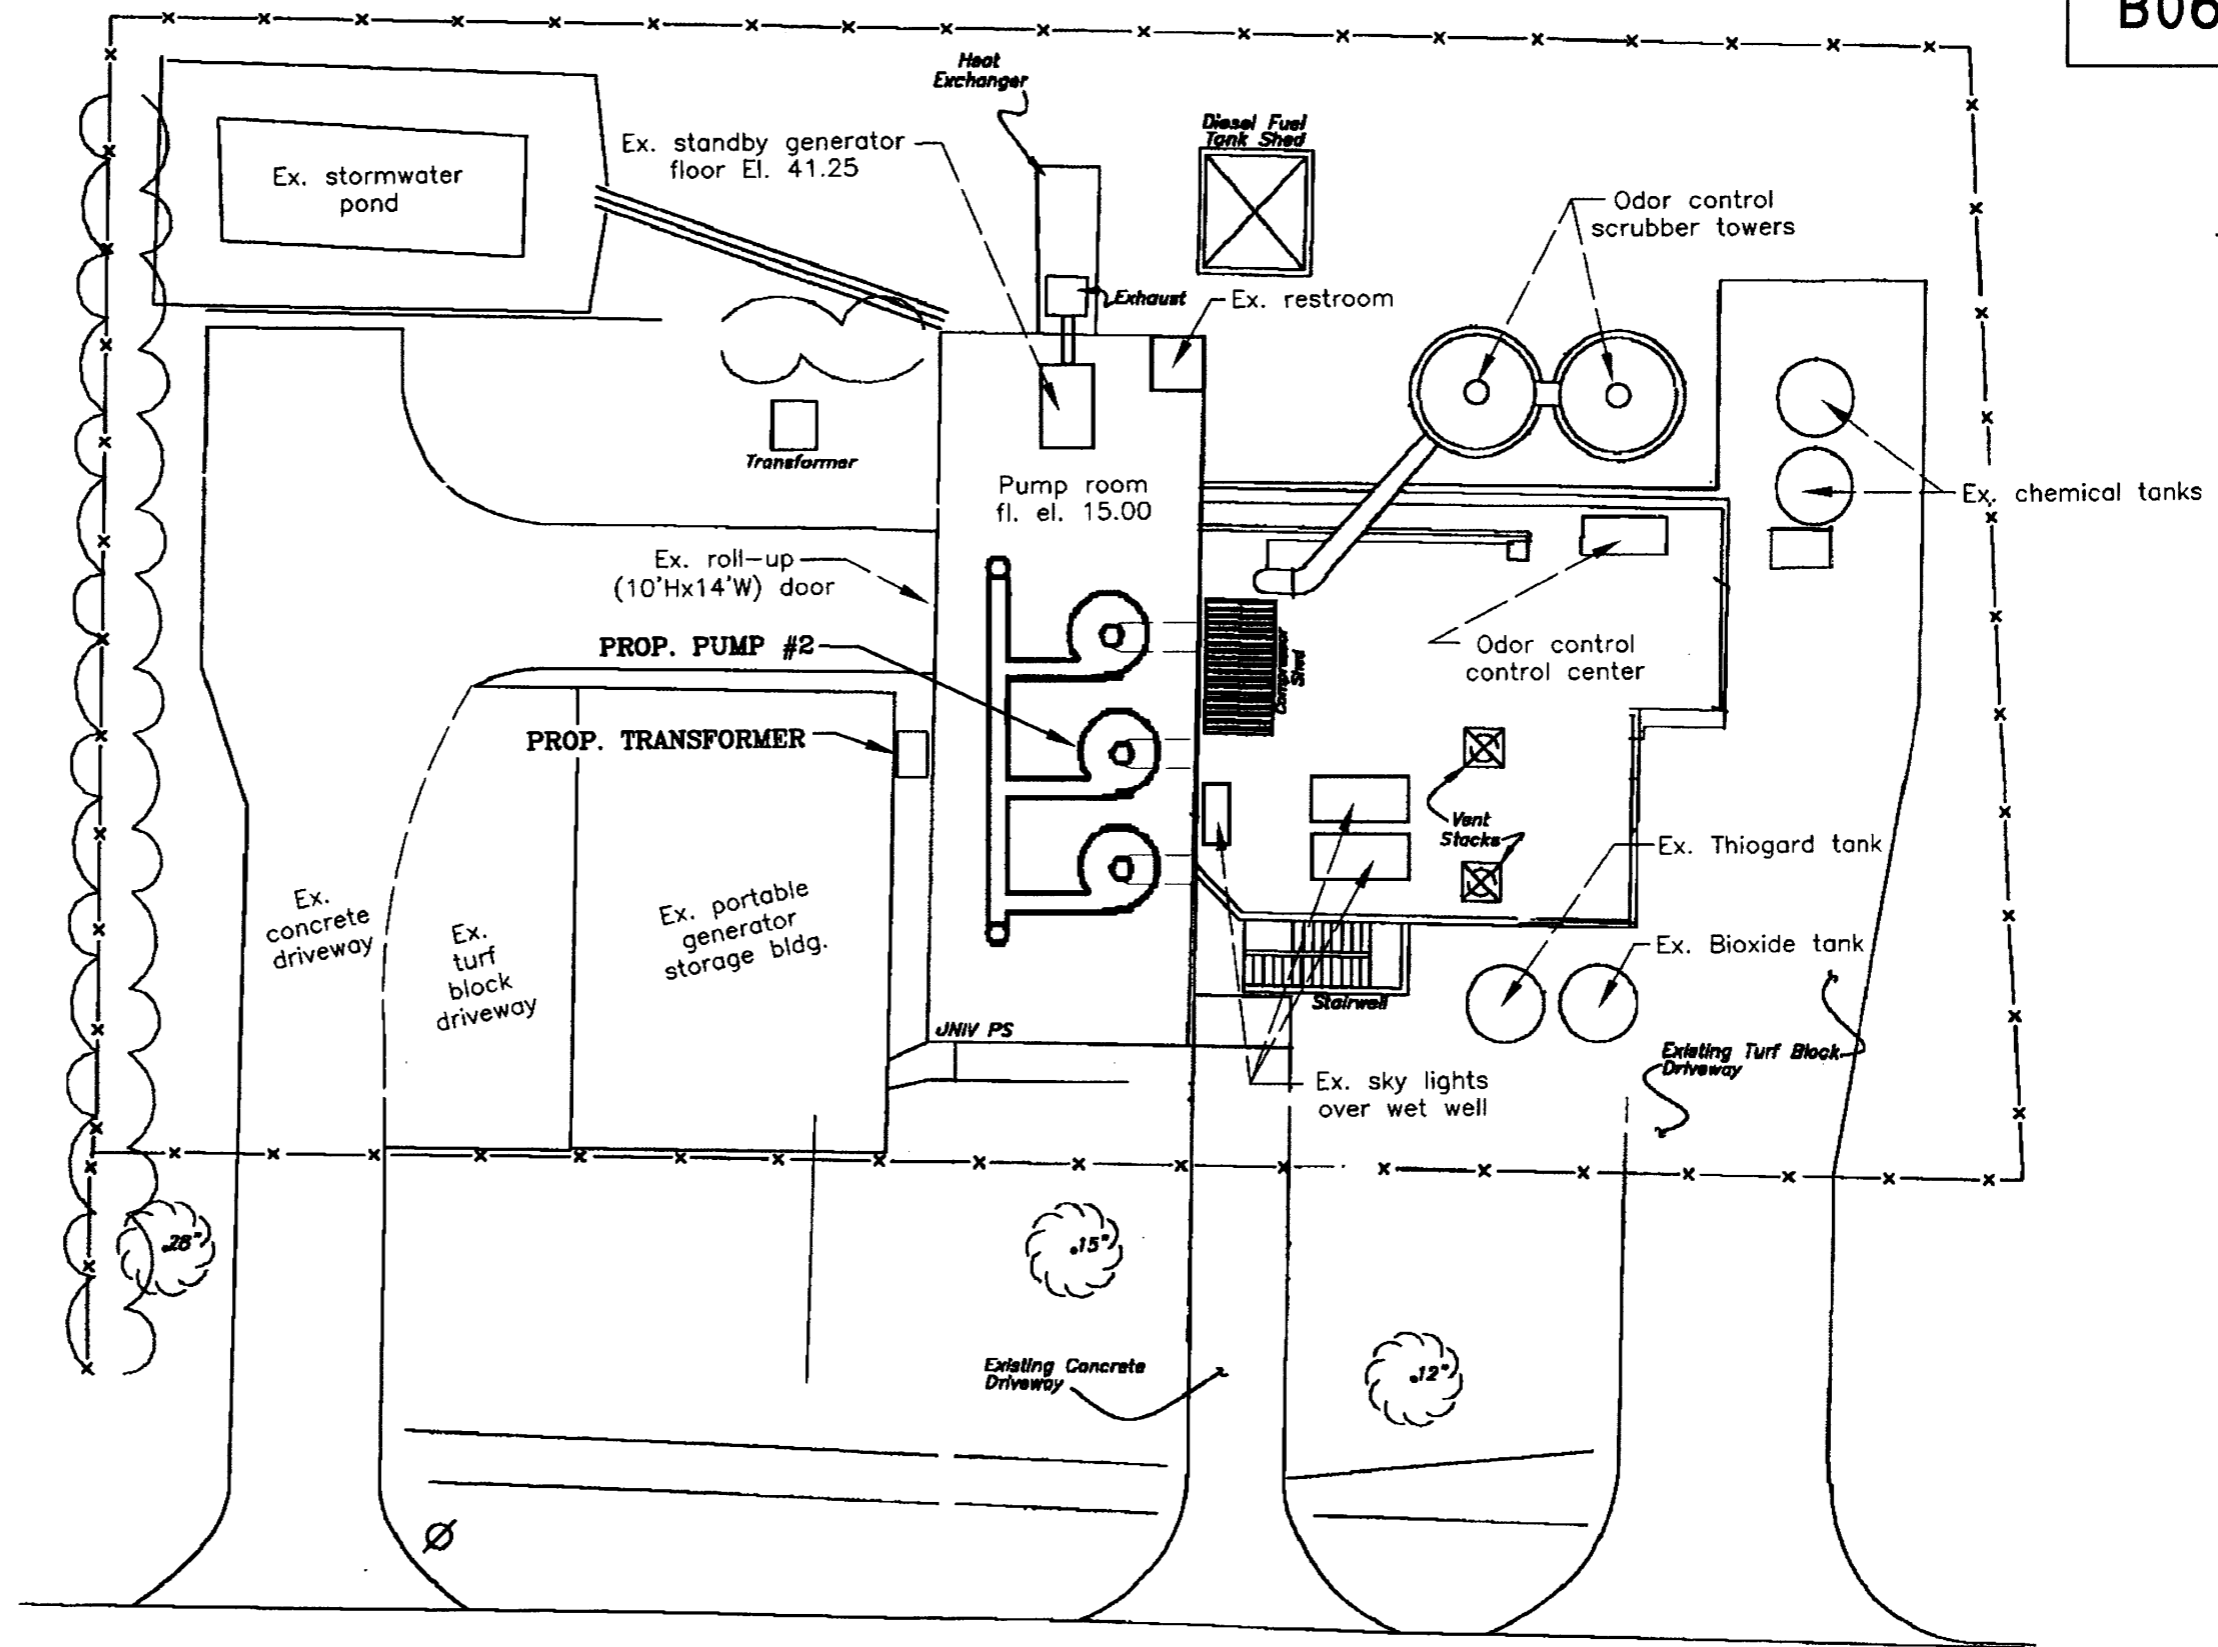

131ST AVE

SITE PLAN
NOT TO SCALE

User: ss8k Drawing Name: K:\micah\autocad\DESIGN WORK\JACK\UNIVERSITY (131st st.) PS\DWGS\UNIVERSITY PS.DWG Layout - Jul 01, 2008 - 10:49am

JACINTO CARLOS FERRAS, P.E. #49454 DESIGN DIVISION HEAD WASTEWATER DEPARTMENT	No.	DATE	REVISIONS	DES: JH	CITY of TAMPA WASTEWATER DEPARTMENT	UNIVERSITY PUMPING STATION PUMP NO. 2 REPLACEMENT SITE PLAN	W.O. 5395
	3			DRN: MRL			SHEET
	2			CKD: JF			3
	1			DATE: 7/1/08			

CONSTRUCTION NOTES

GENERAL

- G-1. CONTRACTOR SHALL COORDINATE ALL CONSTRUCTION ACTIVITIES WITH DEPARTMENT PERSONNEL AND PUMPING STATION OPERATIONS.
- G-2. EXISTING DIMENSIONS AND ELEVATIONS ARE BASED ON THE BEST INFORMATION AVAILABLE. TRUE DIMENSIONS AND ELEVATIONS SHALL BE DETERMINED IN THE FIELD PRIOR TO LAYOUT AND SHOP DRAWING SUBMITTALS.
- G-3. ALL SUBMITTALS AND SHOP DRAWINGS SHALL BE ORIGINALS OR HIGH QUALITY COPIES (EASILY READABLE). NO FAXED SHEETS OR POOR QUALITY COPIES WILL BE ACCEPTED FOR SUBMITTAL REVIEW.
- G-4. CONTRACTOR SHALL PROVIDE AND INSTALL A STOP LOG AND STEEL SHEET (AS A BULKHEAD) TO BE USED TO DIVERT THE FLOW FROM WET WELL #2 TO WET WELL #1 IN ORDER TO REMOVE THE EXISTING KNIFE GATE VALVE AND 24"x16" REDUCER UNDER THE EXISTING PUMP #2. THE STOP LOG SHALL BE PLACED IN THE STOP LOG GROOVE IN BETWEEN WET WELL #1 AND WET WELL #2. THE STEEL SHEET SHALL BE PLACED OVER THE BAR SCREEN IN THE CHANNEL JUST UPSTREAM FROM WET WELL #2.
- G-5. DIVERTING FLOW FROM WET WELL #2 MAY ONLY BE DONE DURING THE LOW FLOW PERIOD OF THE DAY, BETWEEN 2:00AM AND 7:00AM.
- G-6. MECHANICAL AND ELECTRICAL EQUIPMENT TO BE LOCKED OUT SHALL BE LOCKED OUT WITH A MULTIPLE-LOCK MASTER LOCK-OUT DEVICE, WHICH SHALL BE INSTALLED BY CITY PERSONNEL AND LOCKED BY BOTH THE CITY PERSONNEL AND THE CONTRACTOR.
- G-7. CONTRACTOR SHALL PROVIDE THE PUMP, PIPING AND RELATED EQUIPMENT FOR PUMPING DOWN WET WELL #2 AFTER THE STOP LOG/BULKHEAD ARE INSTALLED. THE CONTRACTOR SHALL FURNISH SUFFICIENT PUMPING EQUIPMENT AND DISCHARGE PIPING TO HANDLE ANY LEAKAGE AROUND THE STOP LOGS THAT MAY OCCUR.
- G-8. CONTRACTOR MAY TEMPORARILY REMOVE SKYLIGHTS OVER THE SCREEN ROOM IN ORDER TO INSTALL STOP LOG AND STEEL PLATE BULKHEAD.
- G-9. THE CONTRACTOR IS RESPONSIBLE FOR PROVIDING, INSTALLING, LEVELING AND ALIGNING MOTOR AND PUMP. PROCEDURES FOR INSTALLATION, AS OUTLINED IN THE HYDRAULIC INSTITUTE STANDARDS, MOST CURRENT EDITION, SHALL BE ADHERED TO.
- G-10. PROPOSED PUMP SHALL BE A 350 HORSEPOWER, 24-INCH, 600 RPM FAIRBANKS MORSE VERTICAL CLOSE-COUPLED ANGLEFLOW PUMP MODEL#C5741. PUMP SHALL BE RATED FOR 28.4 MGD @ 50.8 FEET TDH. SEE SPECIFICATIONS FOR MOTOR INFORMATION.
- G-11. PROPOSED KNIFE GATE VALVE SHALL BE A 24" L&M MODEL 24M145C100-BG4-X PERFORMANCE PLUS KNIFE GATE VALVE, AS MADE BY TYCO VALVE AND CONTROLS.
- G-12. PUMP-CHECK VALVE SHALL BE A 30" DEZURIK PEF, ECCENTRIC PLUG VALVE AND SHALL BE PROVIDED WITH A REMOTELY OPERATED PNEUMATIC ACTUATOR THAT SHALL BE PROPERLY SIZED FOR THE EXISTING PUMPING STATION COMPRESSED AIR SYSTEM.

- G-13. AIR SUPPLY FOR PNEUMATICALLY ACTUATED PUMP-CHECK VALVE SHALL BE FROM EXISTING STATION AIR. ARRANGEMENT OF PIPING AND CONNECTIONS TO EXISTING PIPES SHALL BE MADE BY THE CONTRACTOR UNDER THE DIRECTION OF THE ENGINEER.
- G-14. ANCHOR BOLTS SHALL BE AS PER PUMP MANUFACTURER'S RECOMMENDATIONS. ANCHOR BOLTS SHALL BE DOUBLE NUTTED AND FINISHED WITH NON-SHRINK GROUT. ALL BOLTS SHALL EXTEND BEYOND THE FASTENING NUTS BY A MINIMUM OF 1/2-INCH.
- G-15. ALL HARDWARE, UNLESS OTHERWISE NOTED, SHALL BE TYPE 316 STAINLESS STEEL.
- G-16. 30"x30"x30" TEE AND 30"x24" STEEL REDUCER SHALL BE FABRICATED TO SUIT THE DIMENSIONS OF THE PROPOSED EQUIPMENT AND SHALL BE A36-STEEL WITH A 150 PSI RATING. STEEL FITTINGS SHALL BE MANUFACTURED BY AN AWWA CERTIFIED FABRICATOR.
- G-17. ALL CEMENTITIOUS CONCRETE AND GROUT, UNLESS OTHERWISE SPECIFIED, SHALL BE CLASS "B" 4000 PSI COMPRESSIVE STRENGTH AT 28 DAYS.
- G-18. EXPOSED CONCRETE CORNERS SHALL HAVE A 3/4" CHAMFER AND RE-ENTRANT CORNERS SHALL HAVE A 3/4" FLAT FILLET UNLESS OTHERWISE NOTED.
- G-19. CONCRETE PEDESTAL SHOP DRAWINGS INCLUDING FLANGE SUPPORT DETAILS SHALL BE SUBMITTED FOR APPROVAL.
- G-20. ALL STEEL REINFORCING SHALL BE DETAILED ACCORDING TO THE LATEST "ACI MANUAL OF STANDARD PRACTICE FOR DETAILING REINFORCED CONCRETE STRUCTURES". ACTUAL PLACEMENT OF STEEL REINFORCING SHALL BE SHOWN ON SHOP DRAWINGS. ALL LAPS AND SPLICES SHALL BE AT LEAST 32 BAR DIAMETERS OR 24 INCHES.
- G-21. CONTRACTOR SHALL TAKE PRECAUTIONARY MEASURES TO MINIMIZE DAMAGE TO REINFORCING STEEL WHEN PENETRATING CONCRETE FLOOR BEAM FOR ELECTRICAL CONDUIT ROUTING. CONTRACTOR SHALL SUBMIT METHOD OF BEAM PENETRATION FOR APPROVAL.
- G-22. CONTRACTOR SHALL SUBMIT SHOP DRAWINGS FOR APPROVAL TO THE ENGINEER FOR THE PROPOSED STOP LOG AND BULKHEAD. SHOP DRAWINGS SHALL INCLUDE MATERIAL(S) TO BE USED TO MINIMIZE LEAKAGE BETWEEN STEEL SHEETS AND EXISTING STRUCTURES.
- G-23. CONTRACTOR SHALL SUBMIT SHOP DRAWINGS FOR APPROVAL TO THE ENGINEER FOR THE TRANSFORMER MOUNTING PLATFORM.

DEMOLITION NOTES


- D-1. ALL DIMENSIONS ARE APPROXIMATE. TRUE DIMENSIONS SHALL BE DETERMINED IN THE FIELD.
- D-2. SALVAGEABLE MATERIAL AS DETERMINED BY DEPARTMENT PERSONNEL SHALL BE DELIVERED TO THE CITY OF TAMPA'S HOWARD F. CURREN AWTP AT 2700 MARITIME BOULEVARD. NON-SALVAGEABLE MATERIALS ARE TO BE REMOVED FROM THE SITE AND PROPERLY DISPOSED OF AT THE CONTRACTOR'S EXPENSE. IN GENERAL, ALL PUMP AND CONTROLS EQUIPMENT SHALL REMAIN PROPERTY OF THE CITY AND SHALL BE DELIVERED TO THE TREATMENT PLANT.
- D-3. THE PUMP STATION SITE SHALL BE MAINTAINED IN AS NEAT AND ORDERLY CONDITION AS POSSIBLE DURING CONSTRUCTION OPERATIONS. WALKWAYS AND DRIVEWAYS SHALL BE KEPT CLEAR FOR DEPARTMENT PERSONNEL TO PASS THROUGH.
- D-4. CONTRACTOR SHALL CUT ALL EXPOSED REINFORCING STEEL TO A DEPTH OF 1-INCH BELOW THE EXPOSED SURFACE AND GROUT OVER.
- D-5. CONTRACTOR SHALL SUBMIT A PLAN FOR APPROVAL THAT WILL PREVENT THE EXPANSION JOINTS IN THE 30"-36" DISCHARGE HEADER FROM EXPANDING AFTER THE EXISTING 30"x30"x30' TEE HAS BEEN REMOVED IN THE PUMP ROOM.

"POSSIBLE" SEQUENCE OF OPERATIONS

- S-1. CLOSE EXISTING 16" KNIFE GATE VALVE UNDER PUMP #2 AND TWO 30" PLUG VALVES IN DISCHARGE PIPING HEADER; REMOVE PUMP, MOTOR, PIPE AND FITTINGS (INCLUDING 30"x30"x30" TEE). ALSO, REMOVE EXISTING ELECTRICAL EQUIPMENT, CONDUIT AND WIRING FOR EXISTING PUMP #2.
- S-2. RELOCATE STOP LOG AND STEEL PLATE BULKHEAD TO WET WELL #2 CHAMBERS, PUMP OUT WET WELL #2, REMOVE EXISTING 16" KNIFE GATE VALVE AND 24" X 16" SPOOL PIECE, INSTALL NEW 24" SPOOL PIECE AND 24" KNIFE GATE VALVE. ALSO, BEGIN INSTALLING ELECTRICAL EQUIPMENT, CONDUIT, AND WIRING FOR PROPOSED PUMPING EQUIPMENT.
- S-3. INSTALL PROPOSED PUMP #2, MOTOR, PUMP CHECK VALVE, PIPE AND FITTINGS (INCLUDING 30"x30"x30" TEE).
- S-4. POUR CONCRETE PEDESTALS FOR PROPOSED PUMP AND PIPING. ALSO, TIE-IN ELECTRICAL EQUIPMENT AND CONTROLS.
- S-5. PERFORM REQUIRED TESTS ON PROPOSED PUMPING EQUIPMENT.
- S-6. PERFORM TRAINING, COMPLETE PUNCHLIST ITEMS.

User: ssBk Drawing Name: K:\micah\autocad\DESIGN WORK\JACK\UNIVERSITY (131st st.) PS\DWGS\UNIVERSITY PS.DWG Layout- Jul 01, 2008 - 10:49am

JACINTO CARLOS FERRAS, P.E. #49454 DESIGN DIVISION HEAD WASTEWATER DEPARTMENT	No.	DATE	REVISIONS	DES: JH	CITY of TAMPA WASTEWATER DEPARTMENT	UNIVERSITY PUMPING STATION PUMP NO. 2 REPLACEMENT NOTES	W.O. 5395
	3			DRN: MRL			SHEET
	2			CKD: JF			4
	1			DATE: 7/1/08			

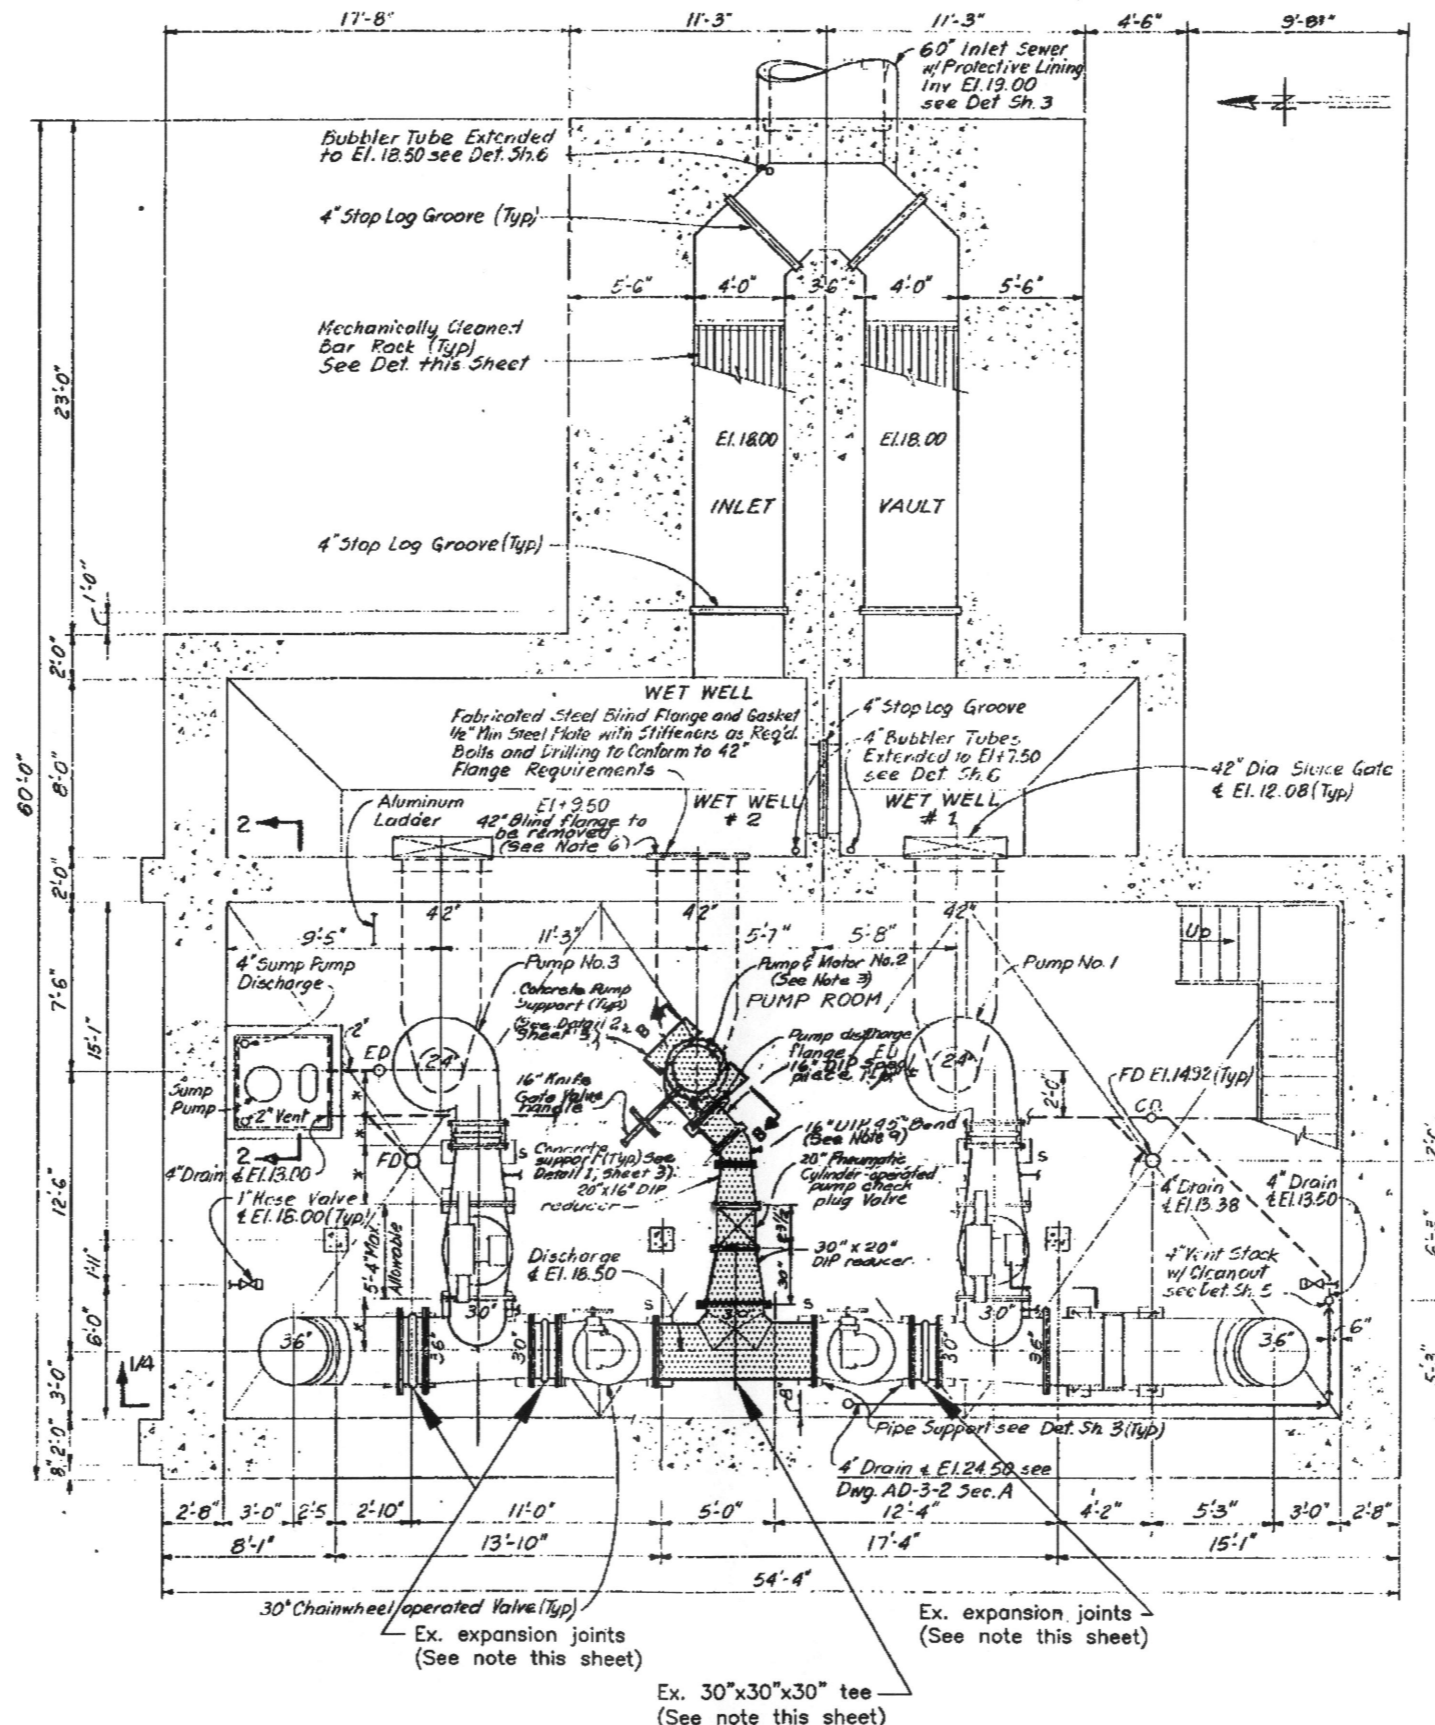

NOTE: PRIOR TO REMOVING EXISTING 30"x30"x30" TEE CONTRACTOR SHALL SUBMIT FOR APPROVAL A METHOD FOR PREVENTING EXPANSION JOINTS IN DISCHARGE HEADER FROM EXPANDING UNDER PRESSURE.

DEMOLITION PLAN AT EL. 15.00

NOT TO SCALE

User: ss8k Drawing Name: K:\micah\autocad\DESIGN WORK\JACK\UNIVERSITY (131st st.) PS\DWGS\UNIVERSITY PS.DWG Layout: Jul 01, 2008 - 10:49am

JACINTO CARLOS FERRAS, P.E. #49454
 DESIGN DIVISION HEAD
 WASTEWATER DEPARTMENT

No.	DATE	REVISIONS
3		
2		
1		


DES: JH
 DRN: MRL
 CKD: JF
 DATE: 7/1/08

CITY of TAMPA
 WASTEWATER DEPARTMENT


UNIVERSITY PUMPING STATION
 PUMP NO. 2 REPLACEMENT
 DEMOLITION PLAN

W.O. 5395
 SHEET
 5

User: ss8k Drawing Name: K:\micah\autocad\DESIGN WORK\JACK\UNIVERSITY (131st st.) PS\DWGS\UNIVERSITY PS.DWG Layout: Jul 01, 2008 - 10:49am

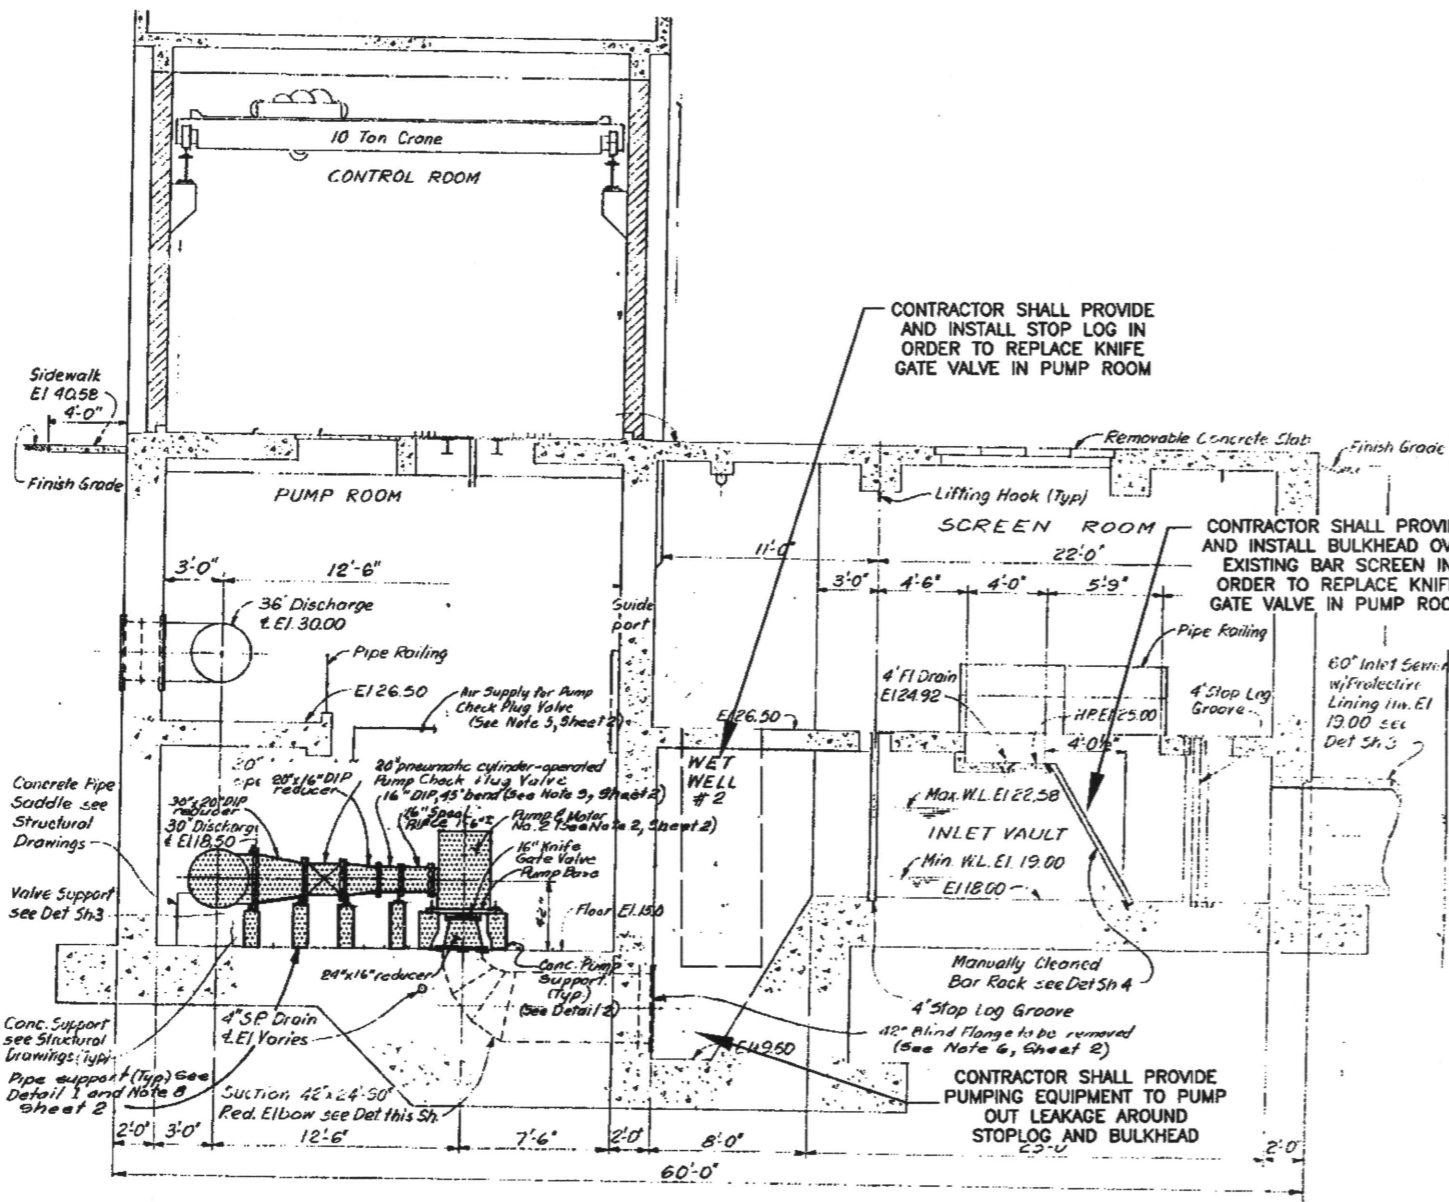


SECTION A/4
NOT TO SCALE

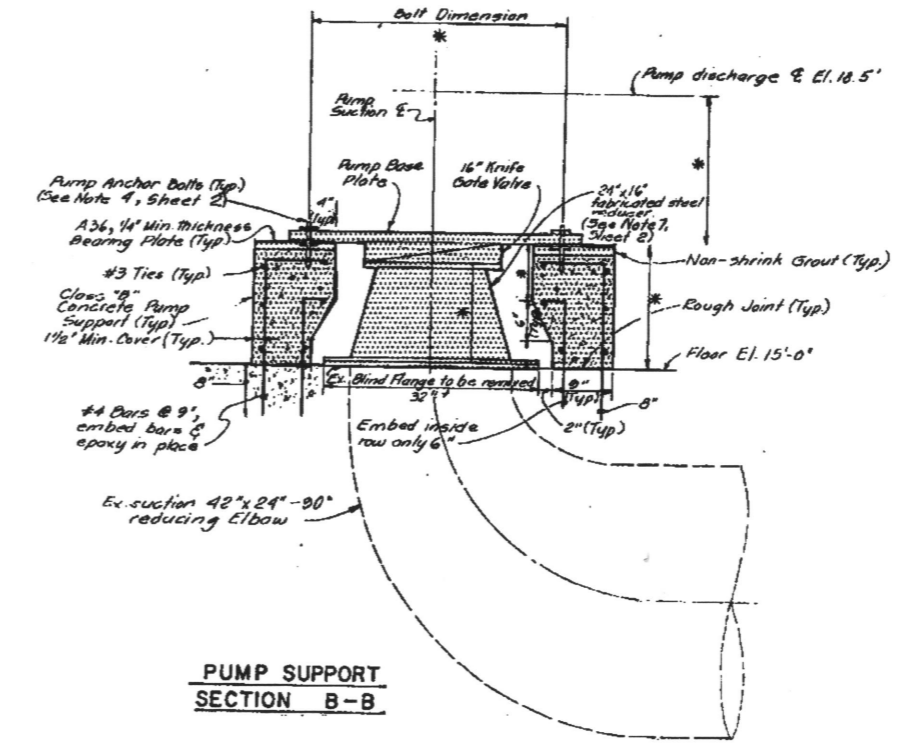


PUMP SUPPORT SECTION B-B

Ex. structures and equipment to be removed by the contractor

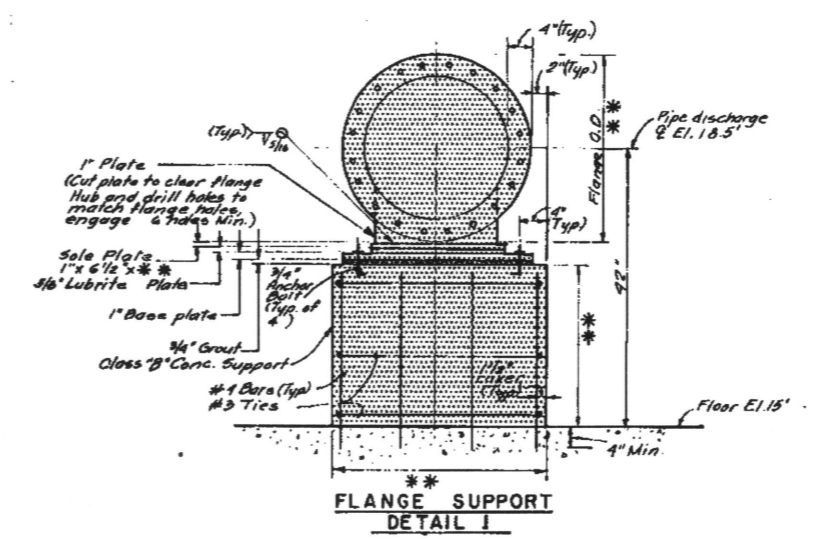

FLANGE SUPPORT DETAIL I

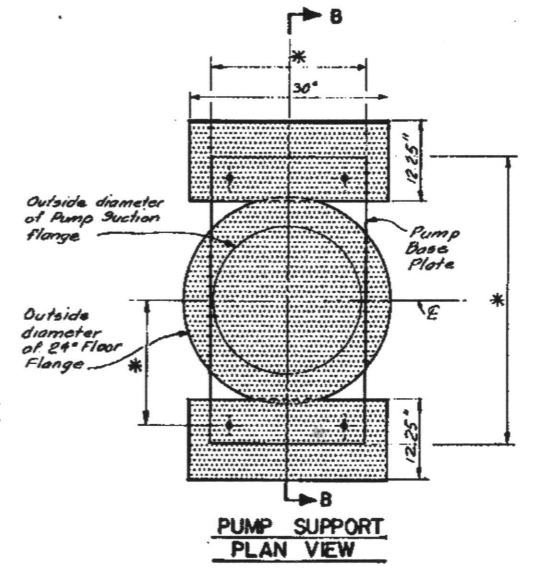

PUMP SUPPORT PLAN VIEW


JACINTO CARLOS FERRAS, P.E. #49454 DESIGN DIVISION HEAD WASTEWATER DEPARTMENT	No.	DATE	REVISIONS
	3		
	2		
	1		

DES: JH
DRN: MRL
CKD: JF
DATE: 7/1/08

CITY of TAMPA
WASTEWATER DEPARTMENT

UNIVERSITY PUMPING STATION
PUMP NO. 2 REPLACEMENT
DEMOLITION SECTIONS

W.O. 5395
SHEET
6

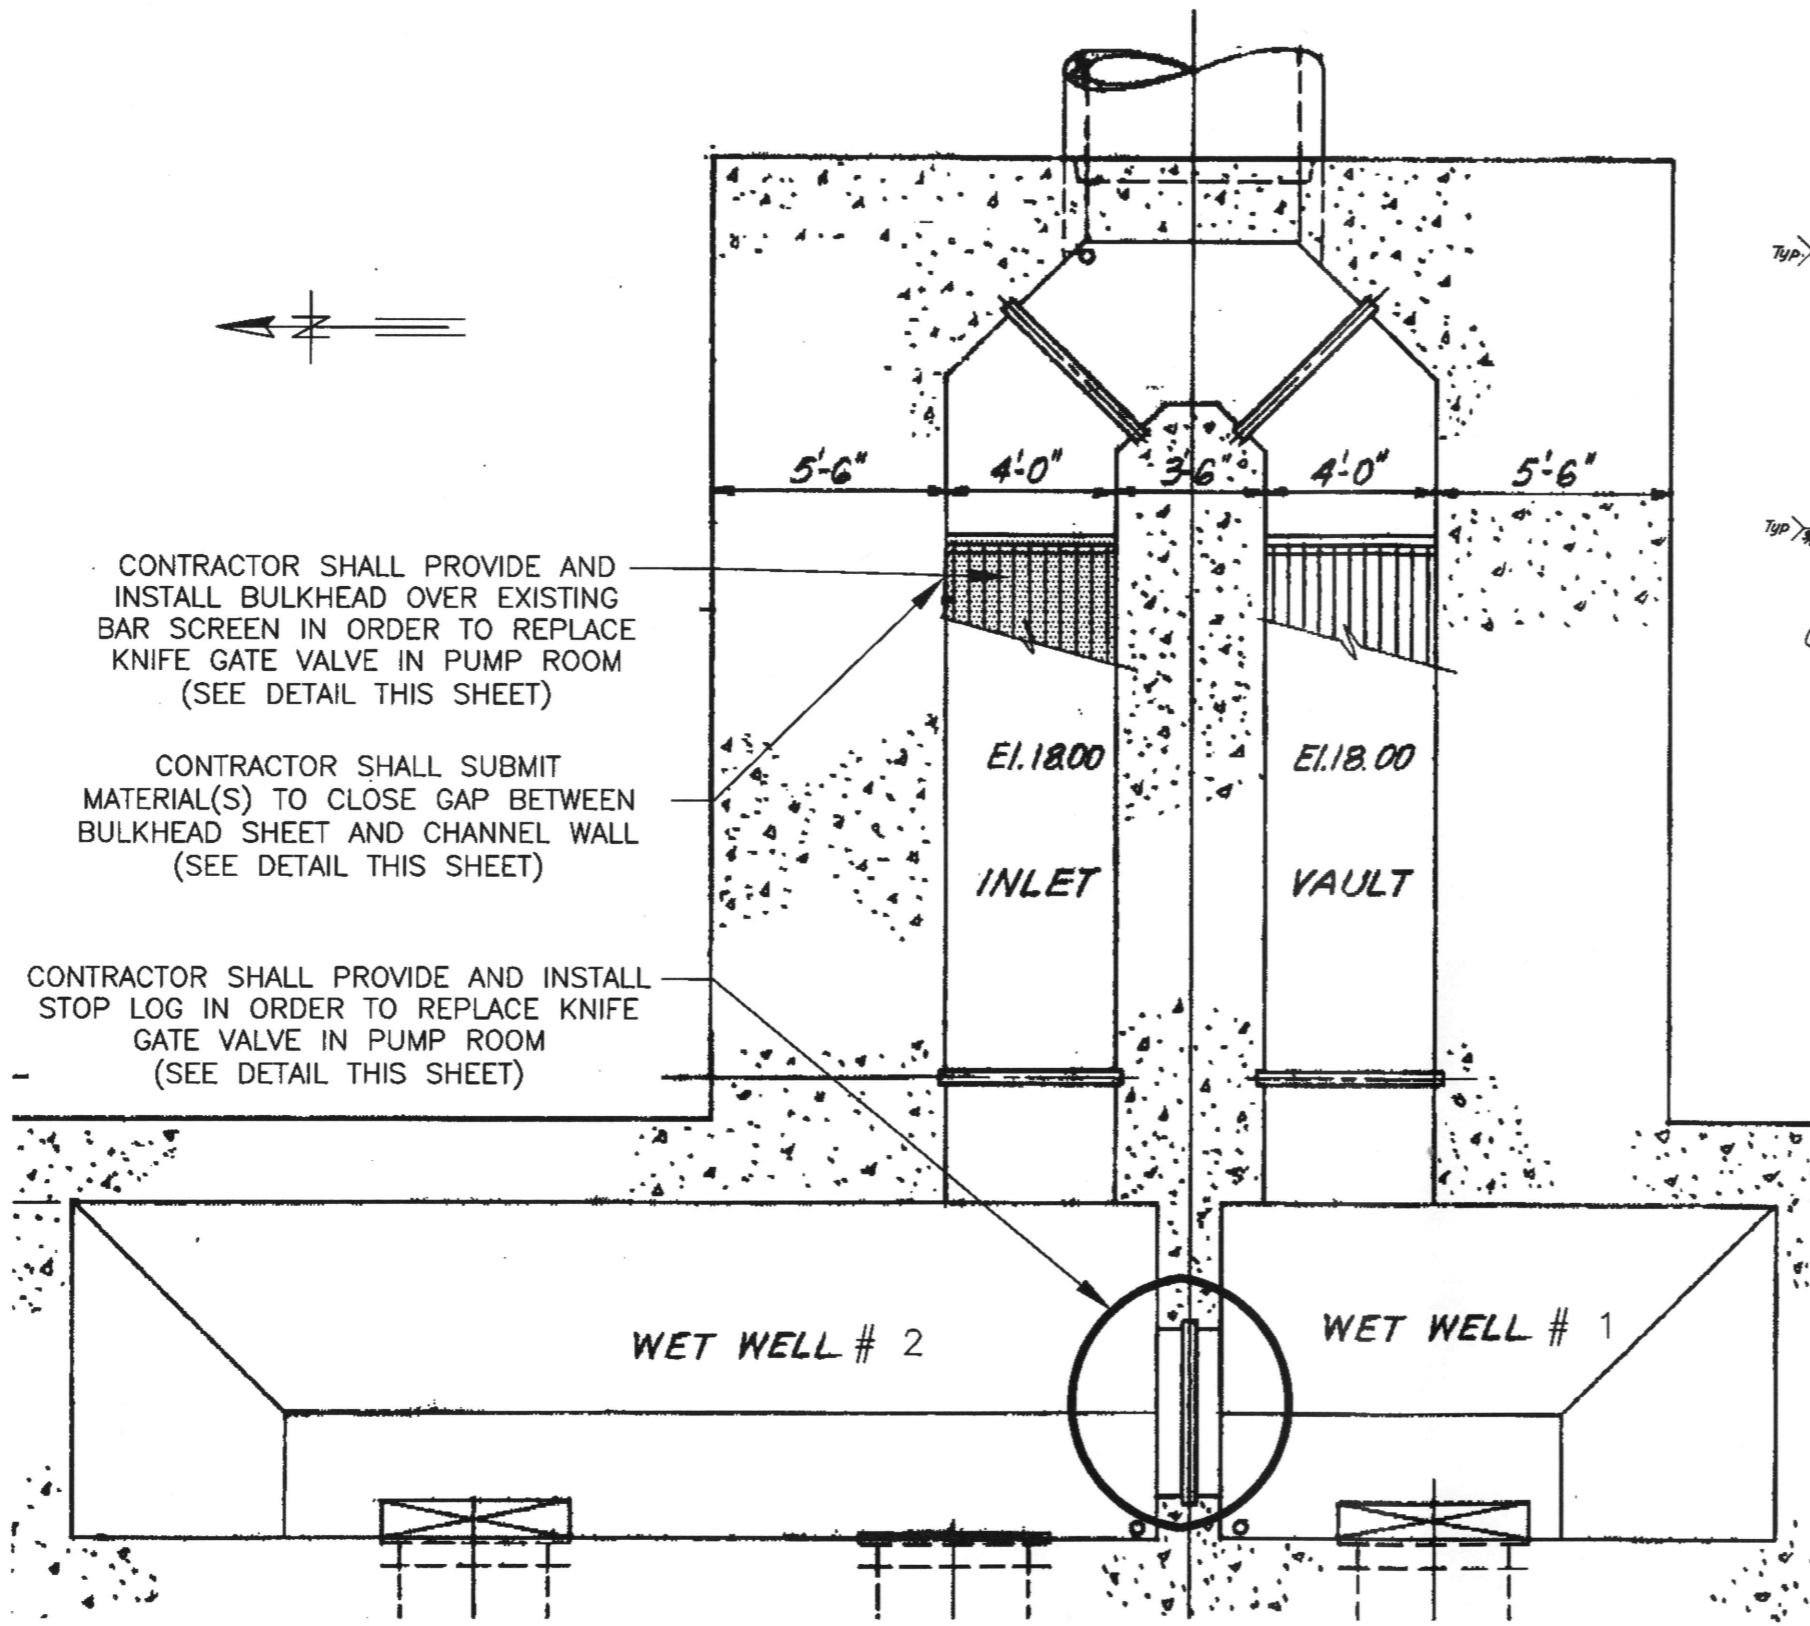


SECTIONAL PLAN AT EL. 15.00
NOT TO SCALE


CONTRACTOR SHALL PROVIDE AND INSTALL BULKHEAD OVER EXISTING BAR SCREEN IN ORDER TO REPLACE KNIFE GATE VALVE IN PUMP ROOM (SEE DETAIL THIS SHEET)

CONTRACTOR SHALL SUBMIT MATERIAL(S) TO CLOSE GAP BETWEEN BULKHEAD SHEET AND CHANNEL WALL (SEE DETAIL THIS SHEET)


CONTRACTOR SHALL PROVIDE AND INSTALL STOP LOG IN ORDER TO REPLACE KNIFE GATE VALVE IN PUMP ROOM (SEE DETAIL THIS SHEET)

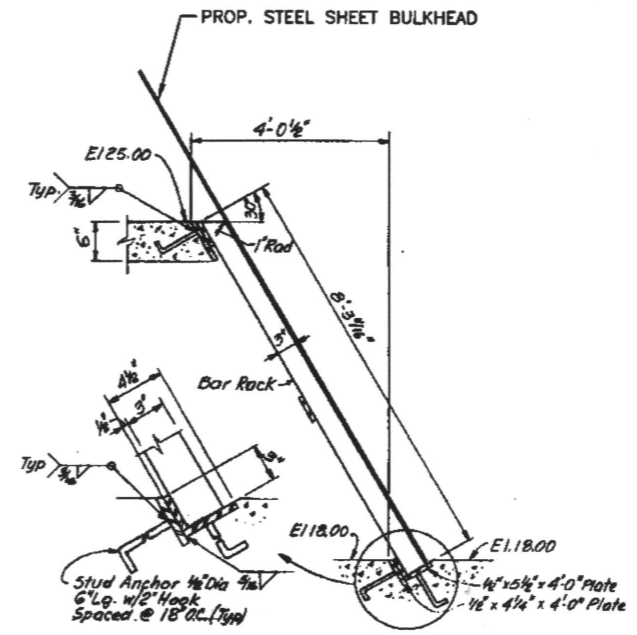

TEMP. BULKHEAD DETAIL
NOT TO SCALE

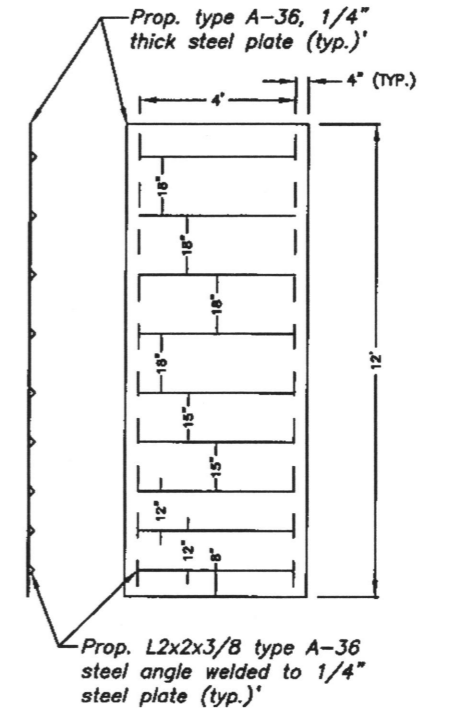

PROPOSED STOP LOG DETAIL
NOT TO SCALE

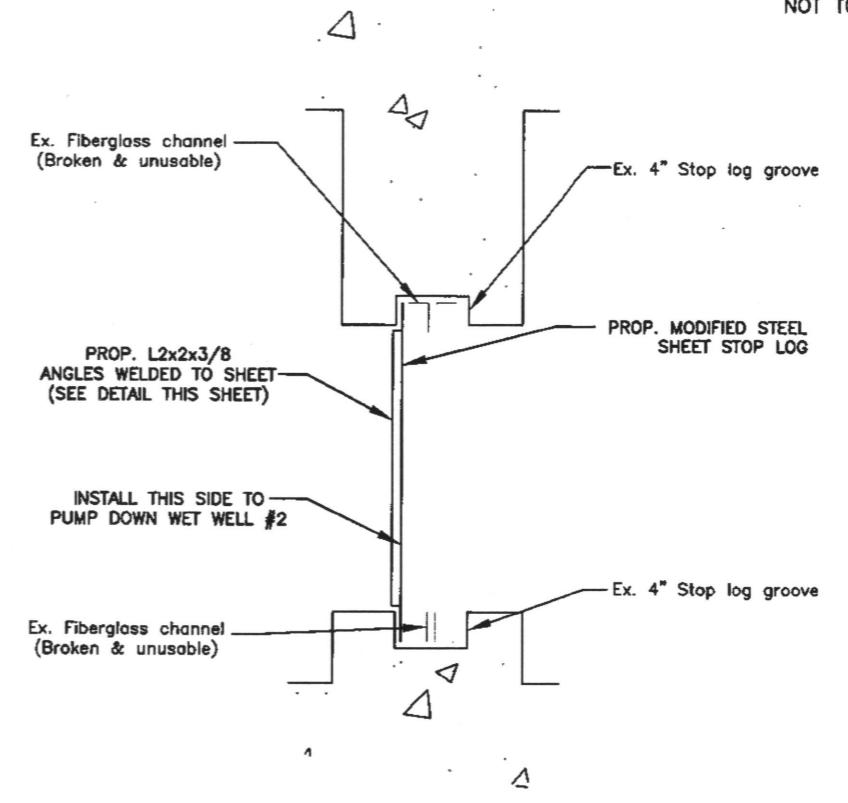

STOP LOG GROOVE DETAIL
NOT TO SCALE

User: ssBk Drawing Name: K:\micah\autocad\DESIGN WORK\JACK\UNIVERSITY (131st st.) PS\DWGS\UNIVERSITY PS.DWG Layout - Jul 01, 2008 - 10:49am

JACINTO CARLOS FERRAS, P.E. #49454
DESIGN DIVISION HEAD
WASTEWATER DEPARTMENT


No.	DATE	REVISIONS
3		
2		
1		

DES: JH
DRN: MRL
CKD: JF
DATE: 7/1/08

CITY of TAMPA
WASTEWATER DEPARTMENT

UNIVERSITY PUMPING STATION
PUMP NO. 2 REPLACEMENT
WET WELL ISOLATION DETAILS

W.O. 5395
SHEET
7

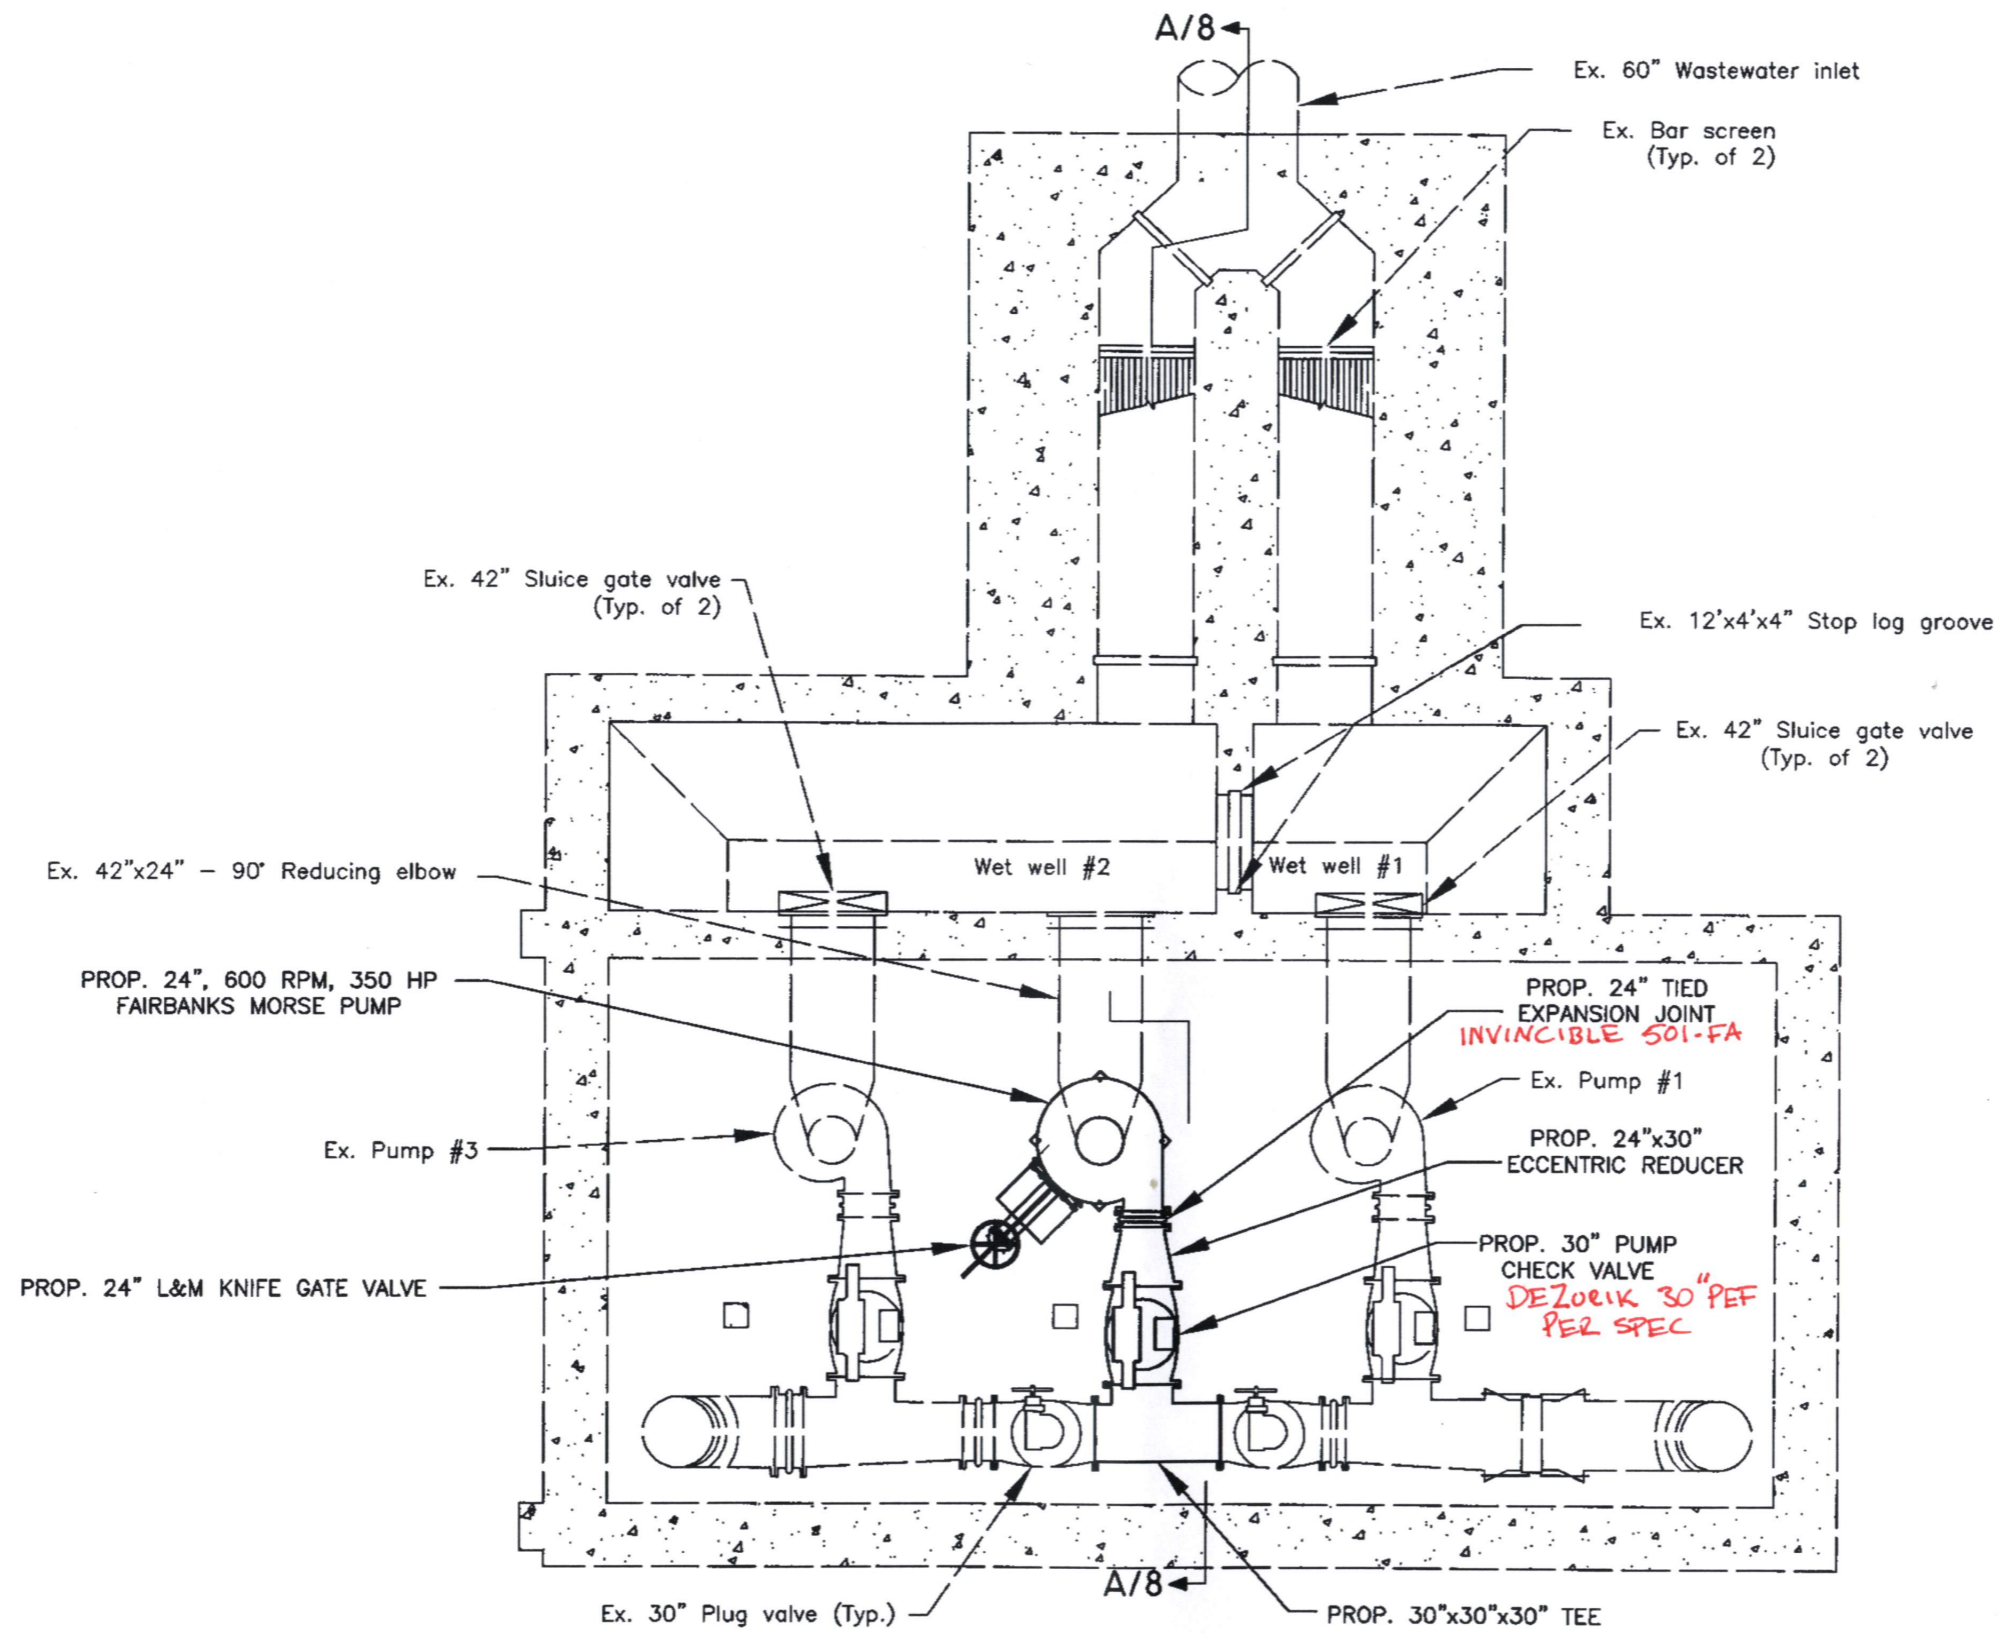

PLAN AT EL. 19.00

1/8" = 1'

User: ss8k Drawing Name: K:\micah\autocad\DESIGN WORK\JACK\UNIVERSITY (131st st.) PS\DWGS\UNIVERSITY PS.DWG Layout - Jul 01, 2008 - 10:49am

JACINTO CARLOS FERRAS, P.E. #49454
 DESIGN DIVISION HEAD
 WASTEWATER DEPARTMENT

No.	DATE	REVISIONS
3		
2		
1		


DES: JH
 DRN: MRL
 CKD: JF
 DATE: 7/1/08

CITY of TAMPA
 WASTEWATER DEPARTMENT

UNIVERSITY PUMPING STATION
 PUMP NO. 2 REPLACEMENT
 PROPOSED PUMP ROOM PLAN

W.O. 5395
 SHEET
8


COATINGS
 - FIRST COAT SHERWIN WILLIAMS
 MACROPOXY 646
 - SECOND COAT SHERWIN WILLIAMS
 ACRYLON 218

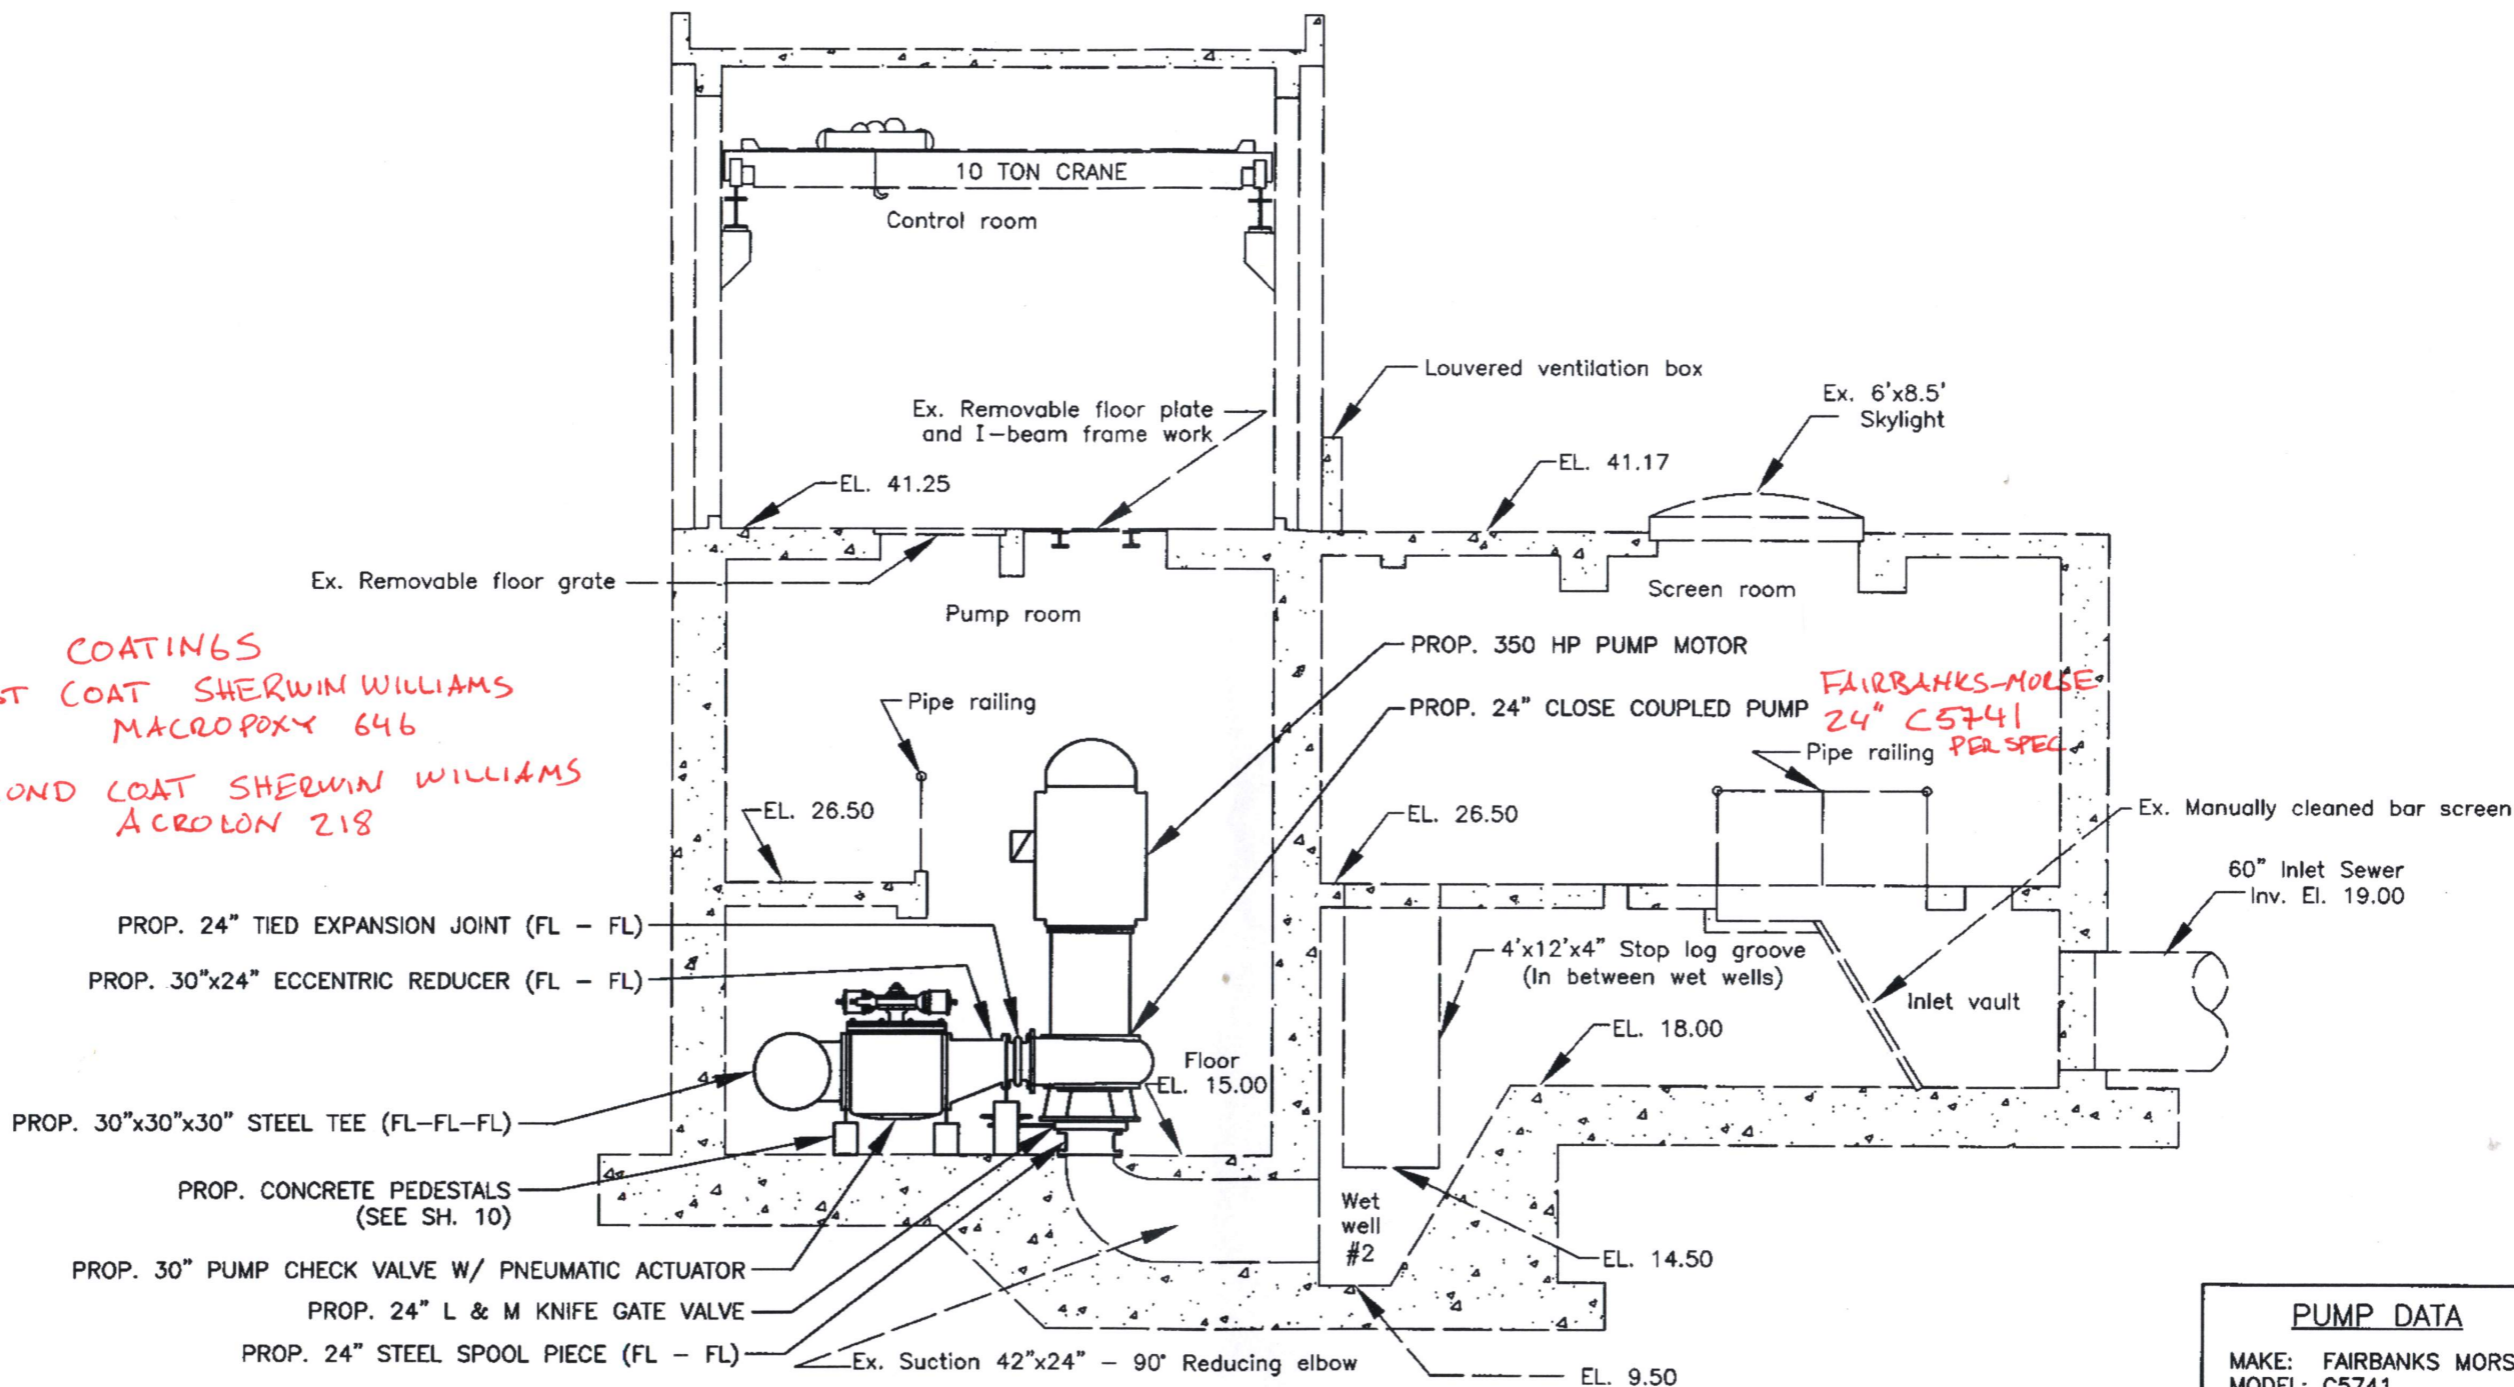

PUMP DATA	
MAKE:	FAIRBANKS MORSE
MODEL:	C5741
HP:	350
	460V, 3 PHASE, 497.0 FLA


User: ssBk Drawing Name: K:\micah\autocad\DESIGN WORK\JACK\UNIVERSITY (131st st.) PS\DWGS\UNIVERSITY PS.DWG Layout- Jul 01, 2008 - 10:49am

JACINTO CARLOS FERRAS, P.E. #49454 DESIGN DIVISION HEAD WASTEWATER DEPARTMENT	No.	DATE	REVISIONS	DES: JH	CITY of TAMPA WASTEWATER DEPARTMENT	UNIVERSITY PUMPING STATION PUMP NO. 2 REPLACEMENT PROPOSED PUMP ROOM PROFILE	W.O. 5395
	3			DRN: MRL			SHEET
	2			CKD: JF			9
	1			DATE: 7/1/08			

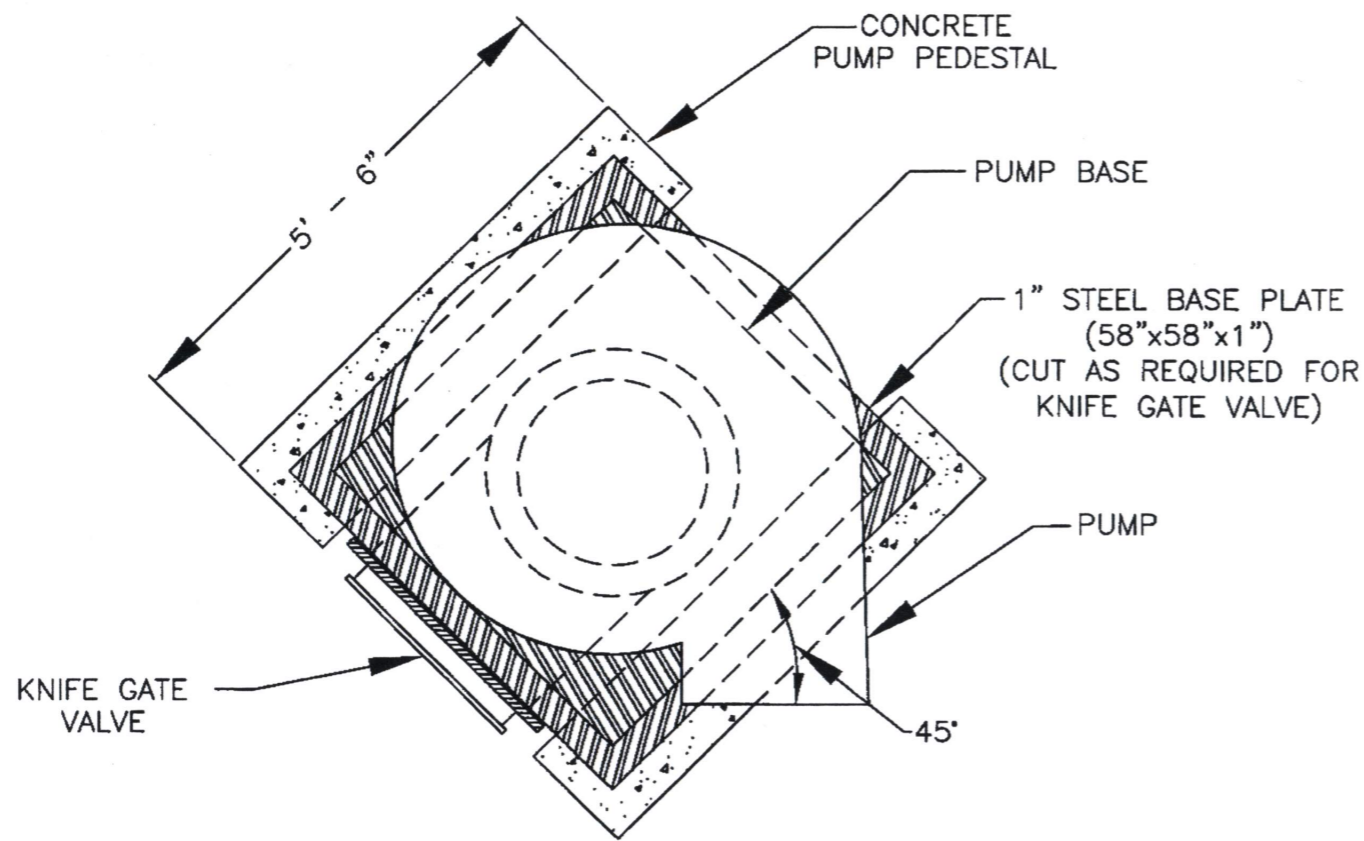


PUMP SUPPORT - PLAN

SUGGESTED PUMP ANCHOR BOLT CONFIGURATION

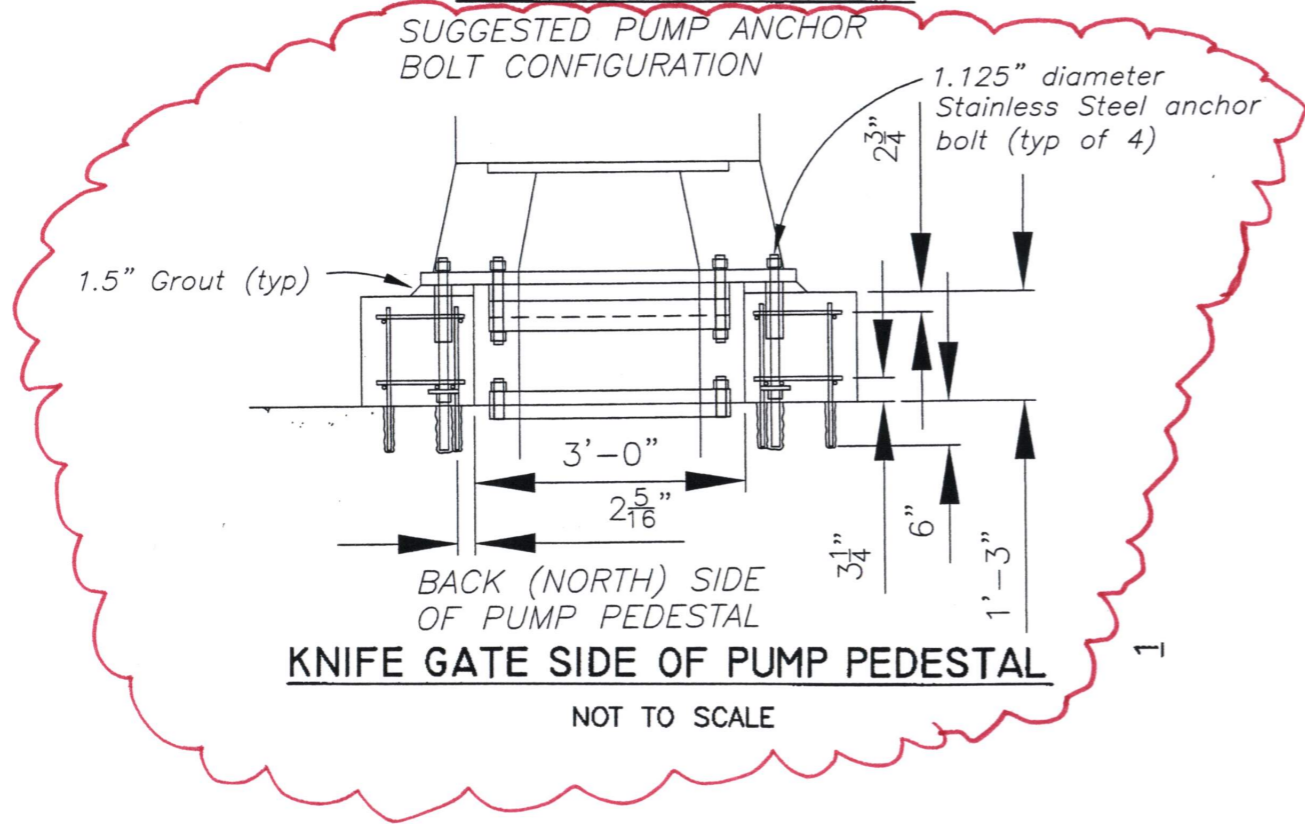

KNIFE GATE SIDE OF PUMP PEDESTAL


NOT TO SCALE

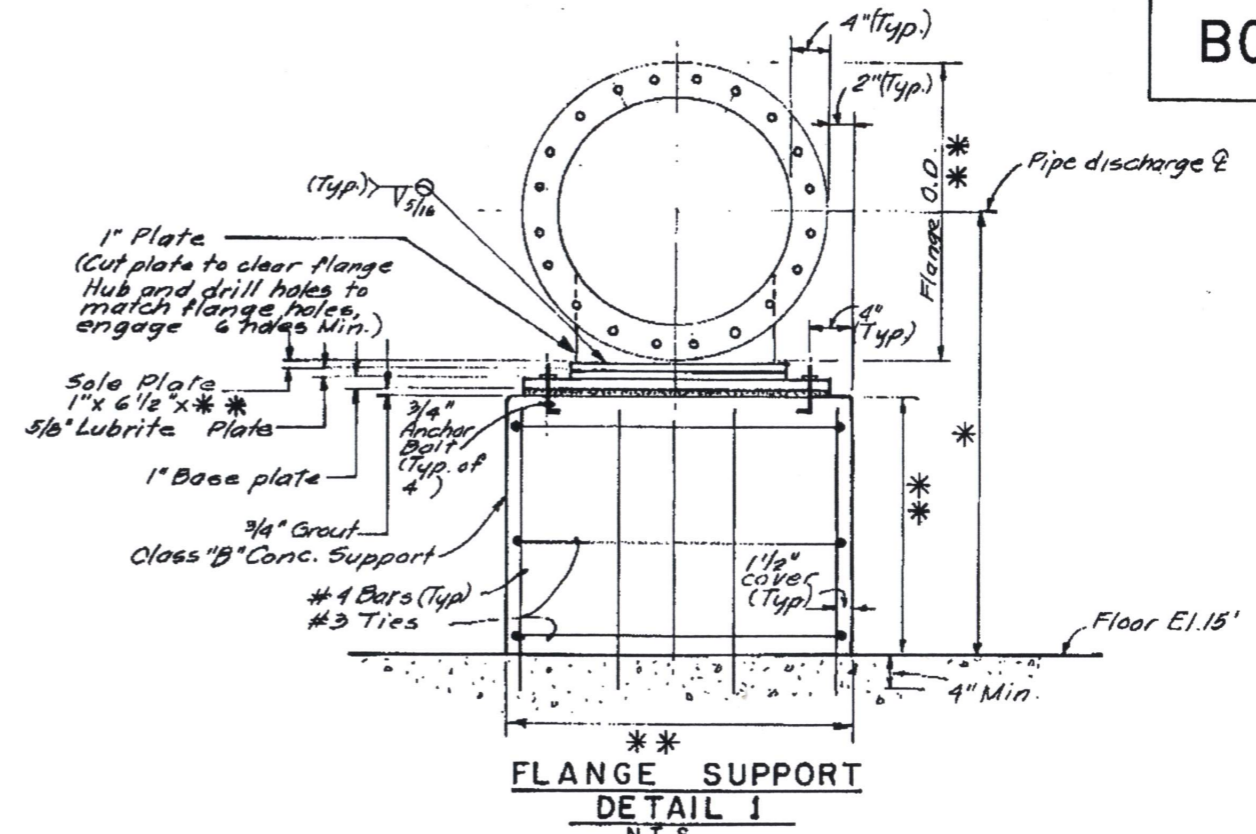

FLANGE SUPPORT DETAIL 1

N.T.S.

** Dimension dependent on pipe diameter

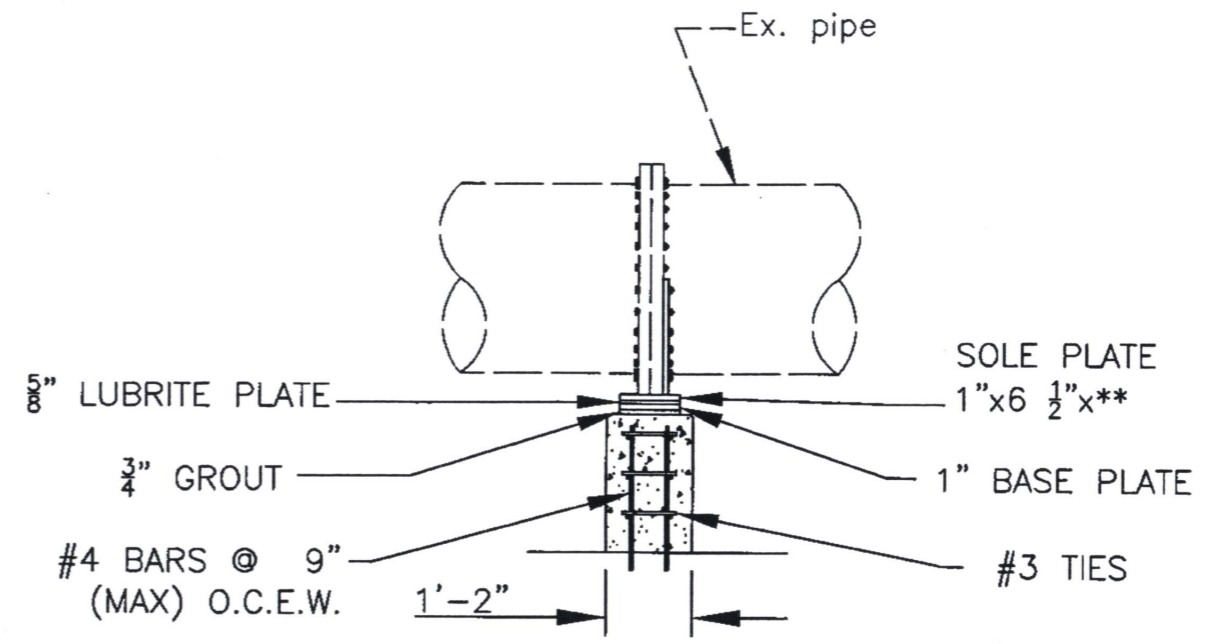


FLANGE SUPPORT DETAIL 2

NOT TO SCALE

User: ss8k Drawing Name: K:\micah\autocad\DESIGN WORK\JACK\UNIVERSITY (131st st.) PS\DWGS\UNIVERSITY PS.DWG Layout - Jul 01, 2008 - 10:49am

JACINTO CARLOS FERRAS, P.E. #49454 DESIGN DIVISION HEAD WASTEWATER DEPARTMENT	No.	DATE	REVISIONS	DES: JH	CITY of TAMPA WASTEWATER DEPARTMENT	UNIVERSITY PUMPING STATION PUMP NO. 2 REPLACEMENT MISC. PUMP ROOM DETAILS	W.O. 5395
	3			DRN: MRL			SHEET
	2			CKD: JF			10
	1			DATE: 7/1/08			

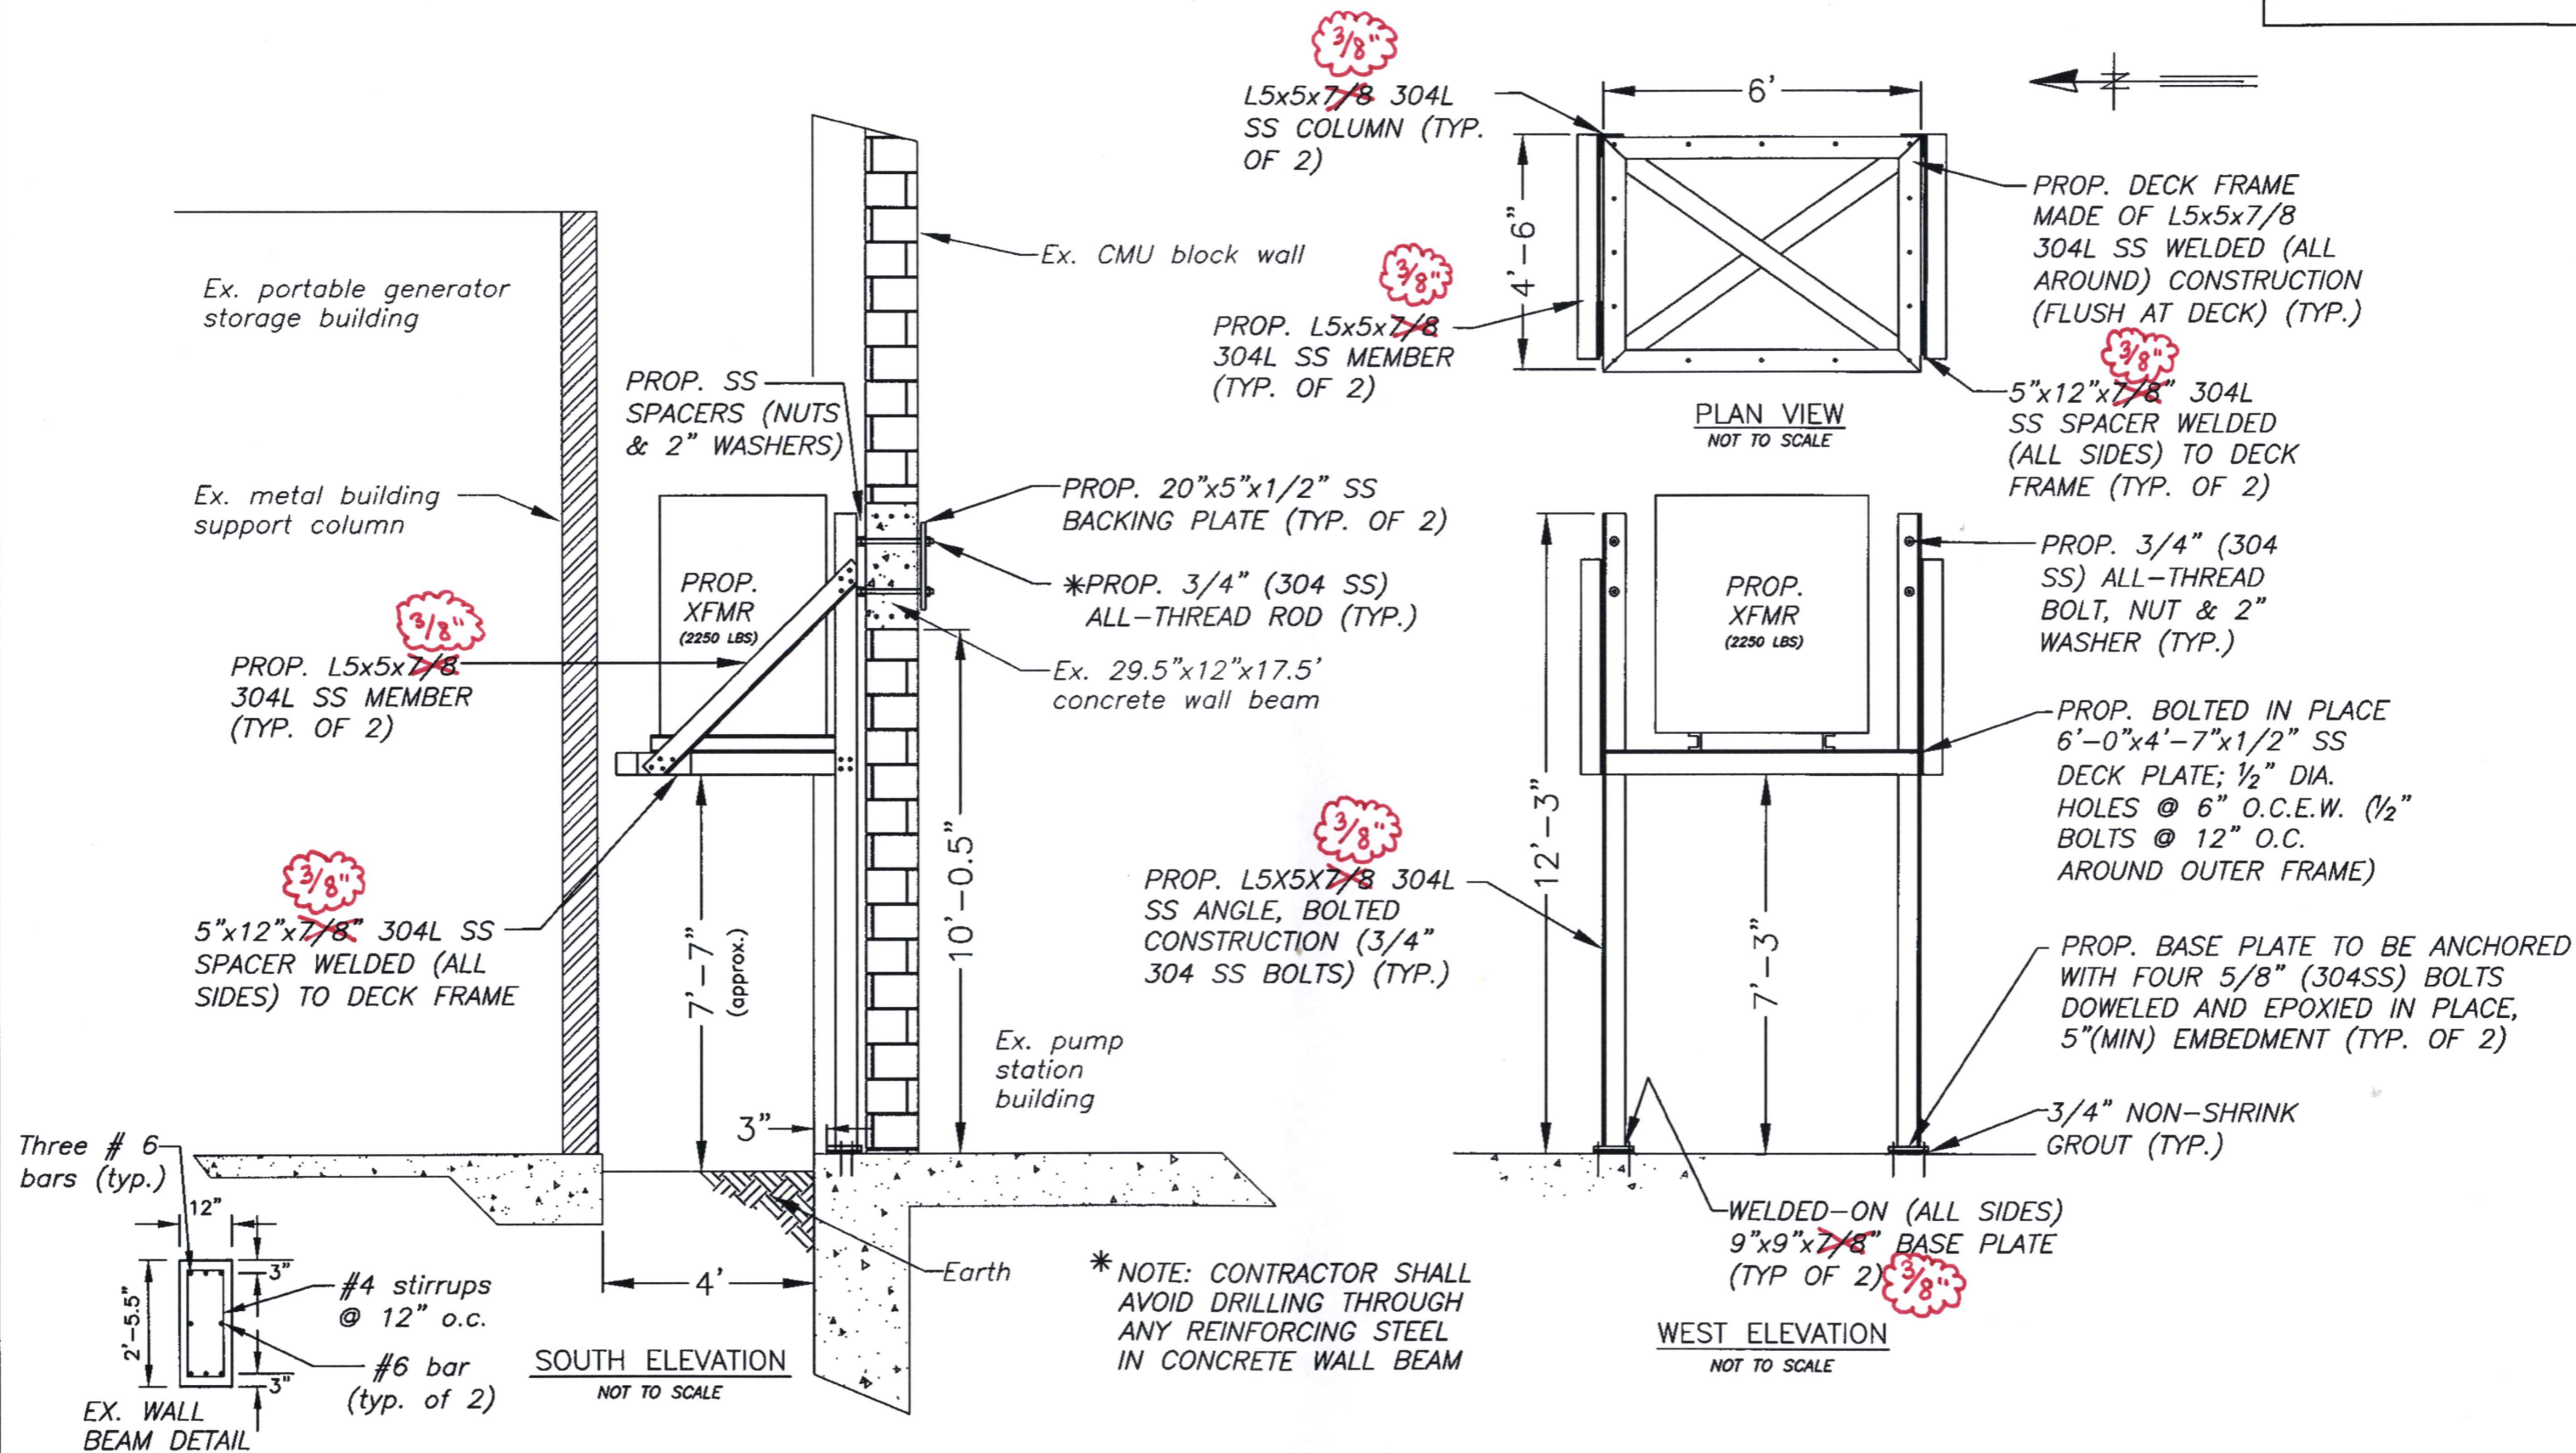

User: sskk Drawing Name: K:\micah\autocad\DESIGN WORK\JACK\UNIVERSITY (131st st.) PS\DWGS\UNIVERSITY PS.DWG Layout - Jul 03, 2008 - 3:06pm

JACINTO CARLOS FERRAS, P.E. #49454
 DESIGN DIVISION HEAD
 WASTEWATER DEPARTMENT

No.	DATE	REVISIONS
3		
2		
1		











 




 












DES: JH
 DRN: MRL
 CKD: JF
 DATE: 7/1/08


CITY of TAMPA
 WASTEWATER DEPARTMENT

UNIVERSITY PUMPING STATION
 PUMP NO. 2 REPLACEMENT
 PROPOSED TRANSFORMER PLATFORM

 W.O. 5395
 SHEET
 11

LEGEND

-  DISCONNECTING DEVICE
-  MOTOR CIRCUIT PROTECTOR
(30 AMPERE CONTINUOUS RATING
(80 AMPERE MAGNETIC TRIP SETTING)
-  CONTROL POWER TRANSFORMER
-  FUSE
-  NORMALLY OPEN CONTACT
-  NORMALLY CLOSED CONTACT
-  MOTOR STARTER COIL
-  MOTOR THERMAL OVERLOAD
-  PILOT LIGHT (RED LENS)
-  TERMINAL STRIP
-  HOUR METER
-  STOP PUSHBUTTON
WITH PROVISIONS FOR PADLOCK
-  3 POSITION SELECTION SWITCH
-  LIMIT SWITCH, NORMALLY OPEN
-  LIMIT SWITCH, NORMALLY CLOSED
-  PRESSURE SWITCH, NORMALLY OPEN
-  3 PHASE MOTOR
-  MOUNTED NEAR EQUIPMENT OR
MOTOR (LOCAL)
-  NEUTRAL
-  PUSHBUTTON WITH PROVISIONS
FOR LOCK. (N.O.)
-  N.C. PUSHBUTTON
-  LOCAL CONTROL STATION
ES - EMERGENCY STOP
-  GROUND SENSE RELAY
-  TWISTED PAIR SHIELDED CABLE
-  NORMALLY CLOSED "ON DELAY"
TIMING RELAY
-  NORMALLY OPEN "ON DELAY"
TIMING RELAY
-  INSTANT CLOSE - DELAY OPEN
TIMING RELAY (OFF DELAY)
-  INSTANT OPEN - DELAY CLOSE
TIMING RELAY (OFF DELAY)

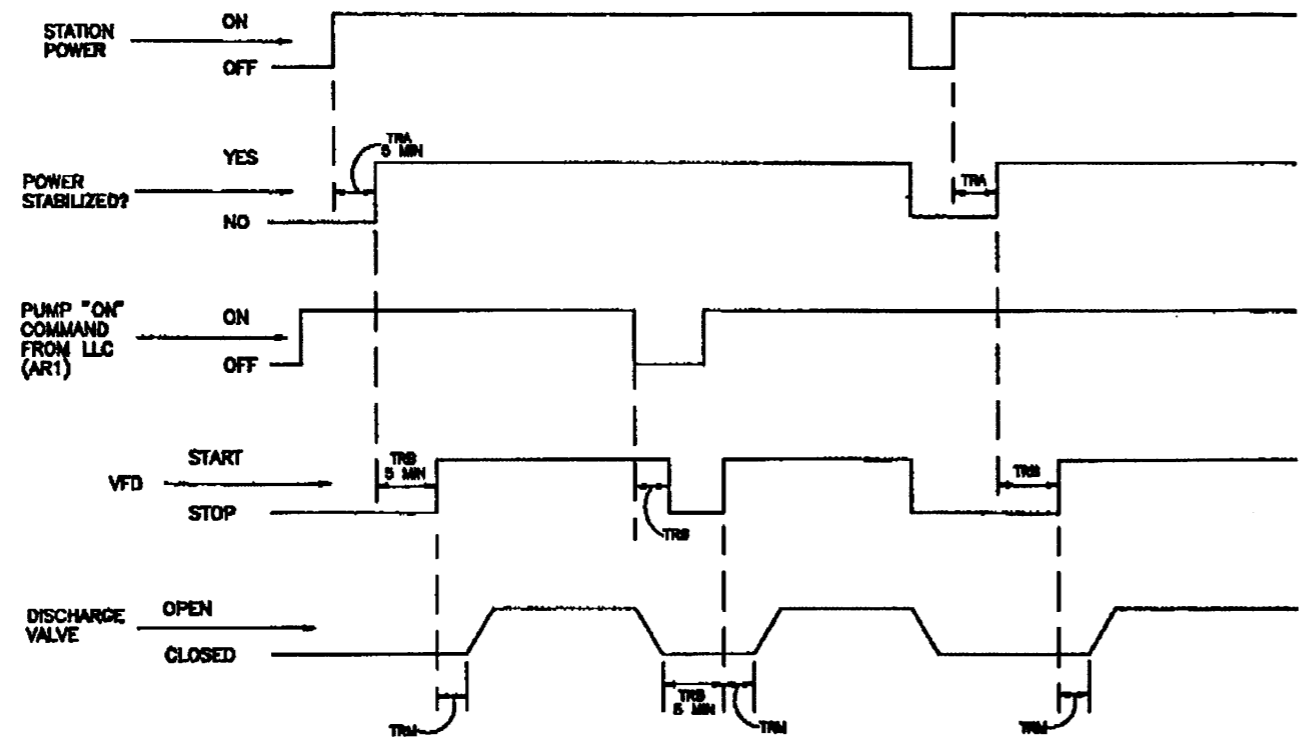


**SEWAGE PUMP NO. 2
(TIMING DIAGRAM)**

PLOT

FILENAME

ROMAN D. KORCHAK, P.E. #42626 ELECTRICAL SECTION HEAD WASTEWATER DEPARTMENT	No.	DATE	REVISIONS	DES: RDK	CITY of TAMPA WASTEWATER DEPARTMENT	UNIVERSITY P.S. PUMP No.2 REPLACEMENT TIMING DIAGRAM AND LEGEND	W.O. 5395
	3			DRN: RDK			SHEET
	2			CKD:			E0
	1			DATE: 6/10/08			OF

EXISTING SEWAGE PUMPS CONTROL CENTER (SECTIONS 4 & 5)

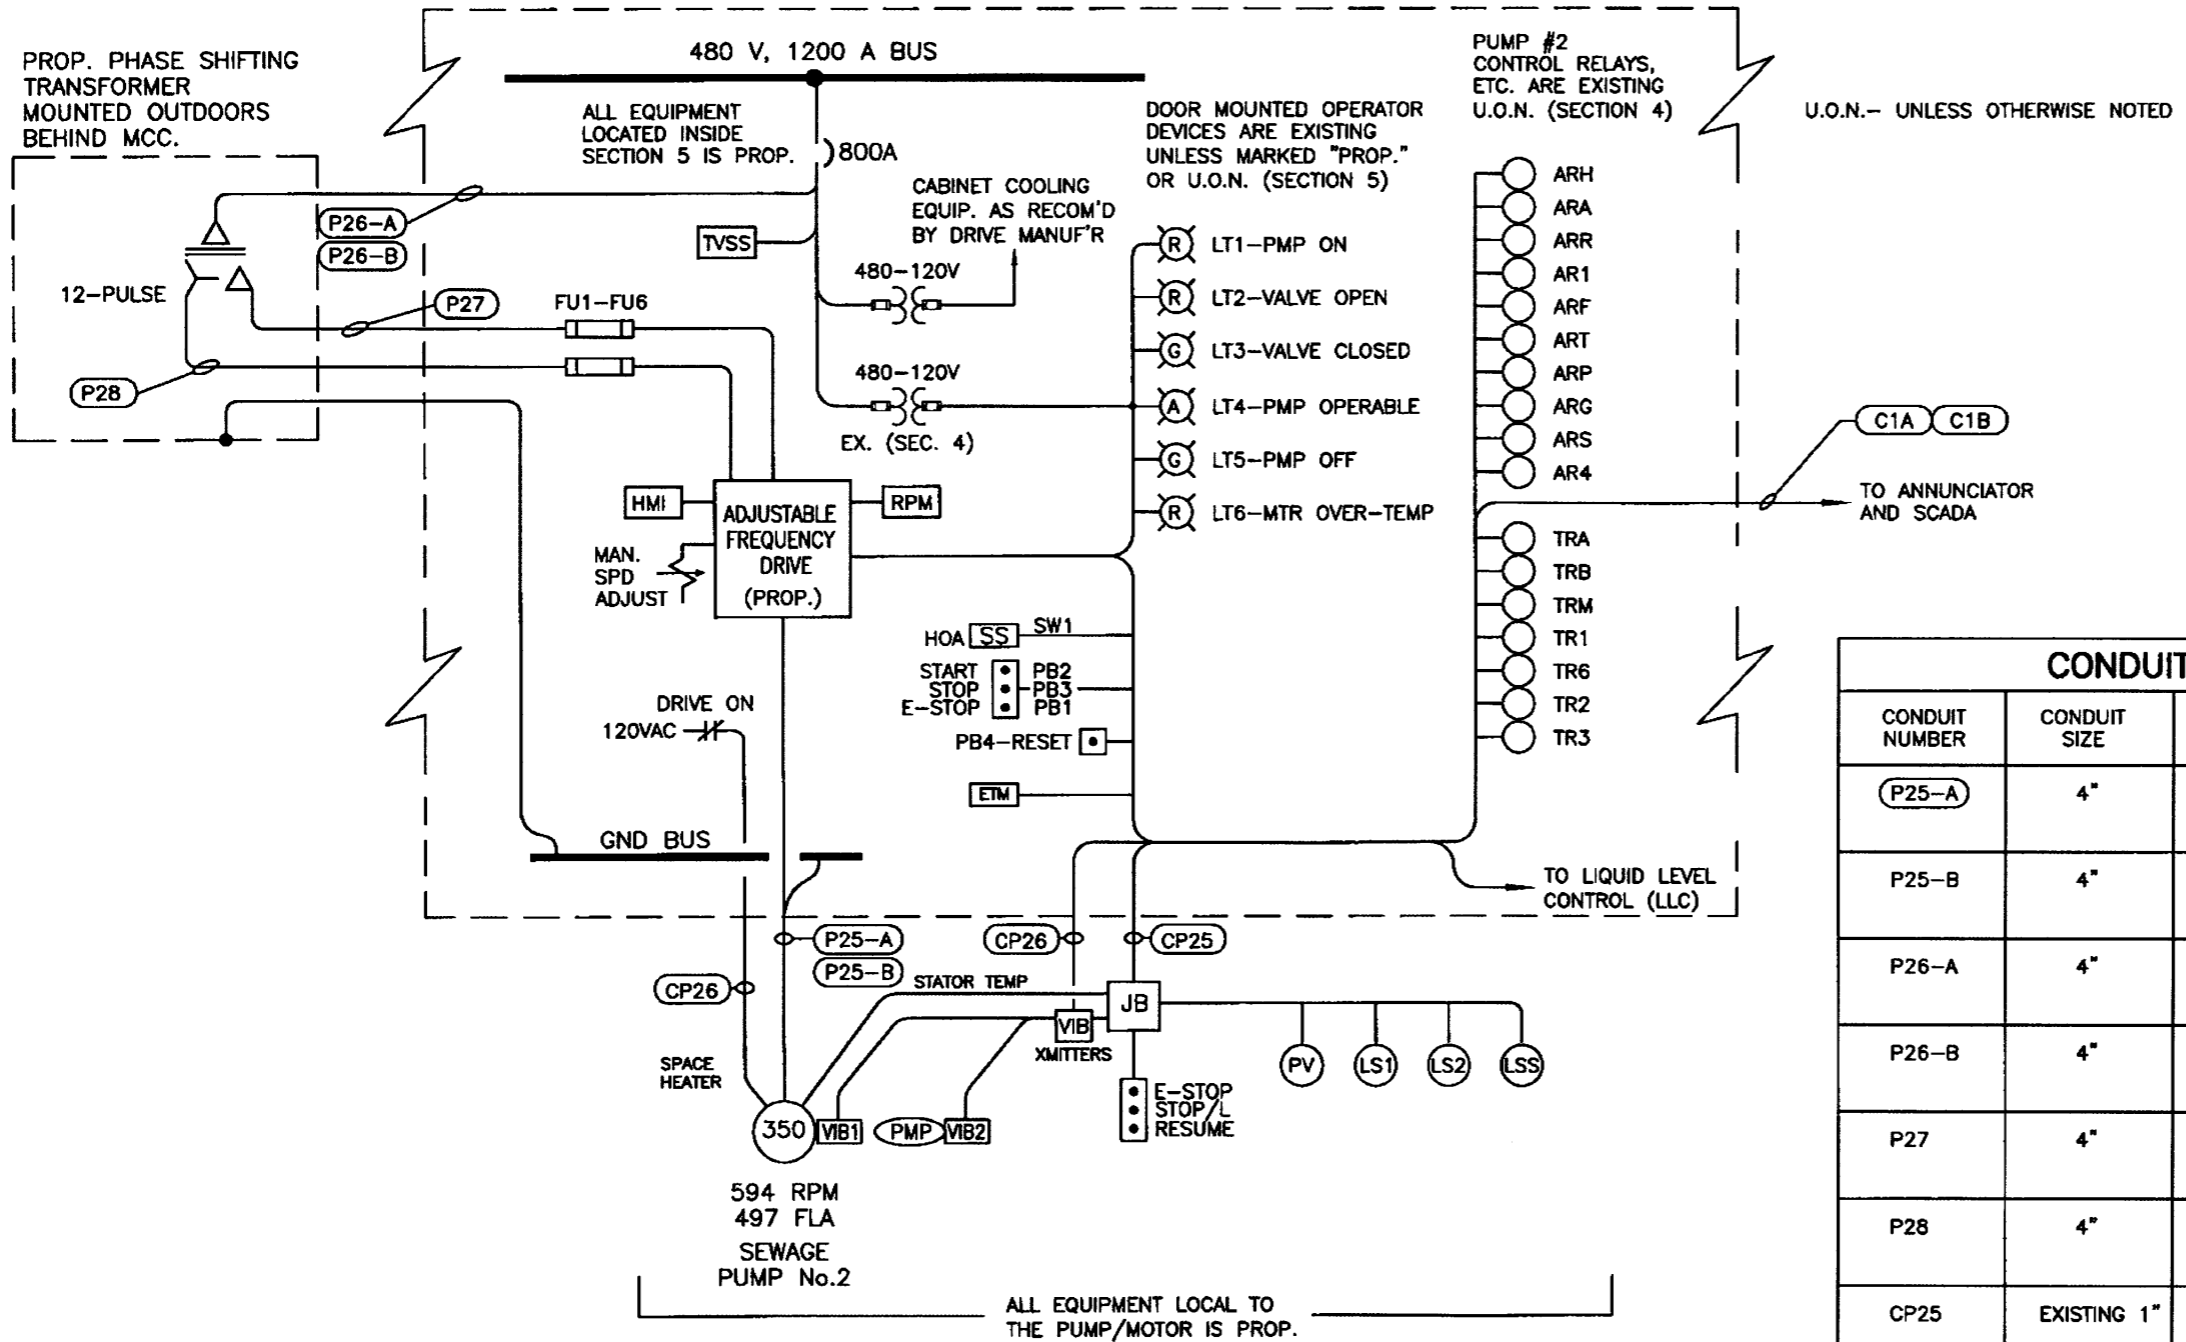

ONE LINE DIAGRAM - PUMP No.2
480V - 3PH - 60HZ

CONDUIT AND CONDUCTOR SCHEDULE					
CONDUIT NUMBER	CONDUIT SIZE	CONDUCTOR QUAN. & SIZE	FROM	TO	REMARKS
P25-A	4"	(3)-400KCMIL (1)-#2/0 GND	PUMP CONTROL CENTER, SEC. 5	PUMP MOTOR No.2	POWER LEADS
P25-B	4"	(3)-400KCMIL (1)-#2/0 GND	PUMP CONTROL CENTER, SEC. 5	PUMP MOTOR No.2	POWER LEADS
P26-A	4"	(3)-500KCMIL (1)-#2/0 GND	PUMP CONTROL CENTER, SEC. 5	12-PULSE TRANSFORMER	PRIMARY LEADS
P26-B	4"	(3)-500KCMIL (1)-#2/0 GND	PUMP CONTROL CENTER, SEC. 5	12-PULSE TRANSFORMER	PRIMARY LEADS
P27	4"	(3)-500KCMIL (1)-#2/0 GND	12-PULSE TRANSFORMER	PUMP CONTROL CENTER, SEC. 5	SECONDARY LEADS
P28	4"	(3)-500KCMIL (1)-#2/0 GND	12-PULSE TRANSFORMER	PUMP CONTROL CENTER, SEC. 5	SECONDARY LEADS
CP25	EXISTING 1"	(34)-#14 (2)-#12 GND	PUMP CONTROL CENTER, SEC. 5	T.B. AT PUMP No.2 MOTOR	CONTROL WIRING
CP26	1-1/2"	(2)-#10 (1)-#10 GND	PUMP CONTROL CENTER, SEC. 4	PUMP MOTOR No.2	SPACE HEATER
		(2)#16-2C, SHLD		VIB. XMITTERS	ANALOG SIG.
		(2)#16-3C, SHLD			120VAC POWER
C1A OR C1B	EXISTING	ADD COND. AS REQ'D	PUMP CONTROL CENTER, SEC. 4	METERING AND SCADA PANEL	ANNUN. & RTU WIRING

PLOT

ROMAN D. KORCHAK, P.E. #42626
ELECTRICAL SECTION HEAD
WASTEWATER DEPARTMENT


No.	DATE	REVISIONS
3		
2		
1		

DES: RDK
DRN: RDK
CKD:
DATE: 6/02/08

CITY of TAMPA
WASTEWATER DEPARTMENT

UNIVERSITY P.S.
PUMP No.2 REPLACEMENT
ELECTRICAL- ONE-LINE DIAGRAM

W.O. 5395
SHEET
EI
of

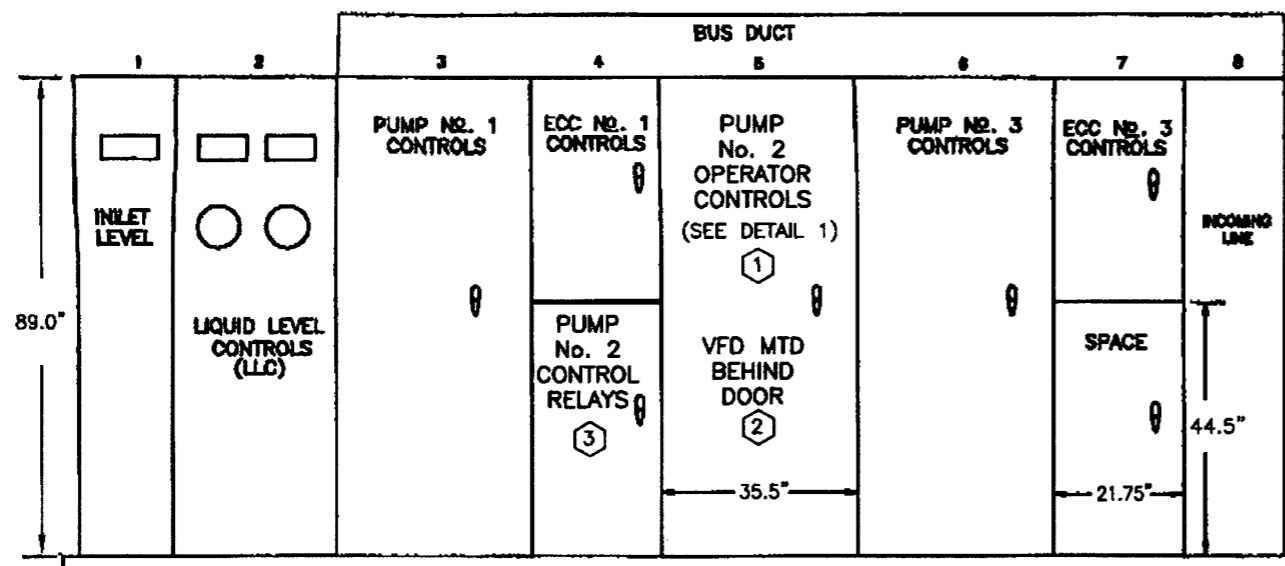


**EXISTING SEWAGE PUMPS CONTROL CENTER
(FRONT ELEVATION)**

THE NOTED EXISTING EQUIPMENT SHALL BE REMOVED OR MODIFIED AS REQUIRED TO FACILITATE THE INSTALLATION OF THE NEW EQUIPMENT PROVIDED AND INSTALLED UNDER THIS CONTRACT.

INDEXED NOTES:

- ① DOOR MOUNTED OPERATOR DEVICES ARE EXISTING UNLESS MARKED "PROP." OR U.O.N.
- ② ALL EQUIPMENT LOCATED INSIDE SECTION 5 IS PROPOSED.
- ③ PUMP No.2 CONTROL RELAYS, ETC, ARE EXISTING U.O.N.

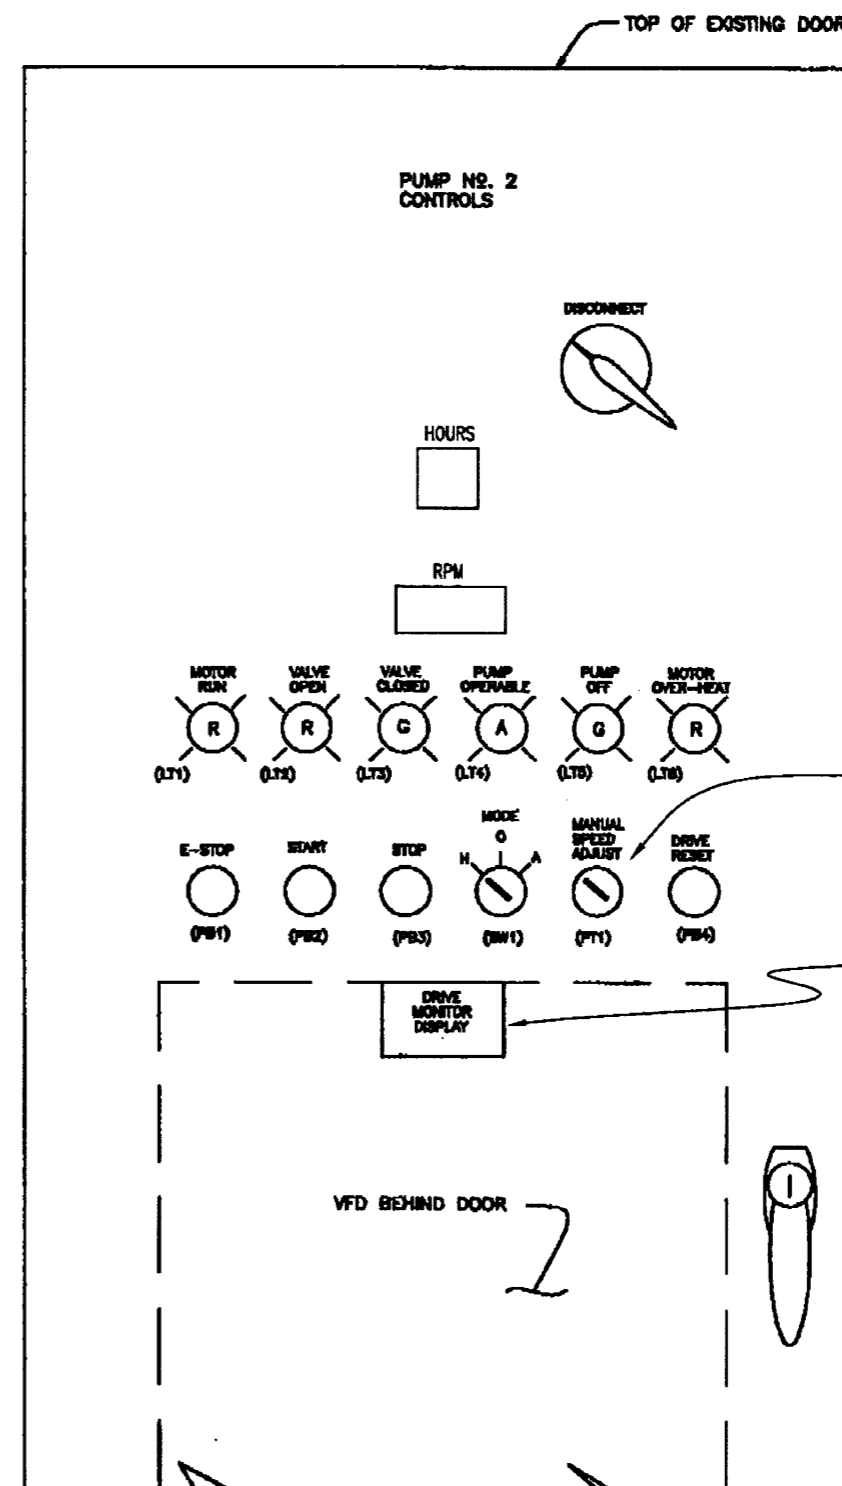

**DETAIL 1, PUMP NO. 2 CONTROLS
(FRONT DOOR LAYOUT)**

①

PLOT

ROMAN D. KORCHAK, P.E. #42626
ELECTRICAL SECTION HEAD
WASTEWATER DEPARTMENT


No.	DATE	REVISIONS
3		
2		
1		

DES: RDK
DRN: RDK
CKD:
DATE: 6/30/08

CITY of TAMPA
WASTEWATER DEPARTMENT

UNIVERSITY P.S.
PUMP No.2 REPLACEMENT
ELECTRICAL- MCC LAYOUT

W.O. 5395
SHEET
E2
OF

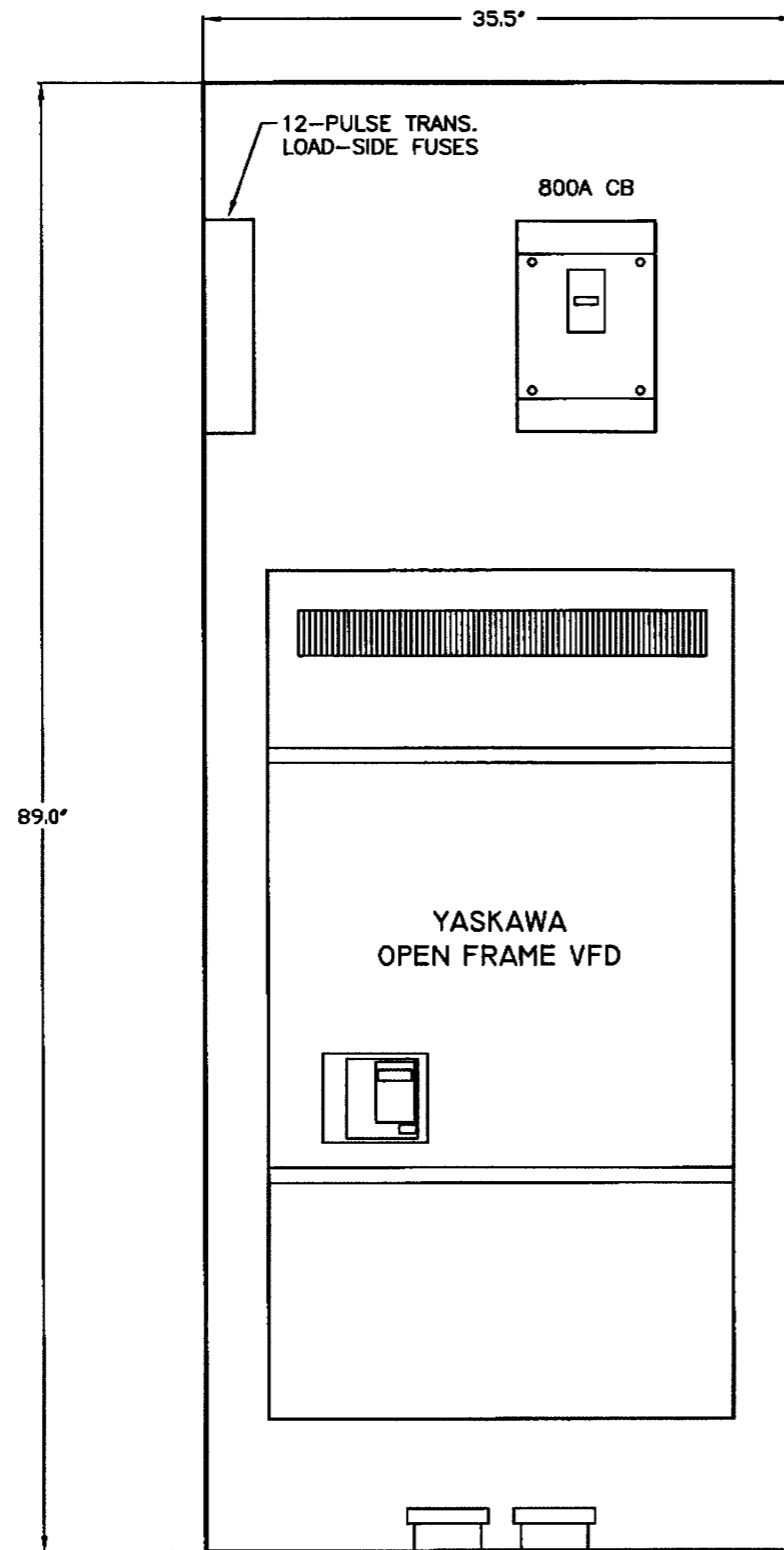

NOTE:

VFD #2 VENTILATION SHALL BE PROVIDED AND INSTALLED UNDER THE GUIDANCE AND SUPERVISION OF AN INDIVIDUAL WITH YASKAWA AUTHORIZED SERVICE PROVIDER CERTIFICATION.

SEWAGE PUMP No.2
SECTION 5 - PROP. LAYOUT

(DOOR REMOVED FOR CLARITY)

PROP. (2)- 4" AL RIGID C. W/
 GROUNDING BUSHING. CORE
 DRILL CONCRETE AS REQ'D.

PLOT

FILENAME

ROMAN D. KORCHAK, P.E. #42626
 ELECTRICAL SECTION HEAD
 WASTEWATER DEPARTMENT

No.	DATE	REVISIONS
3		
2		
1		


DES: RDK
 DRN: RDK
 CKD:
 DATE: 6/02/08

CITY of TAMPA
WASTEWATER DEPARTMENT

UNIVERSITY P.S.
PUMP No.2 REPLACEMENT
PROP. VFD CUBICLE LAYOUT

W.O. 5395
 SHEET
E3
 of .

PUMP No.2 VFD ENCLOSURE

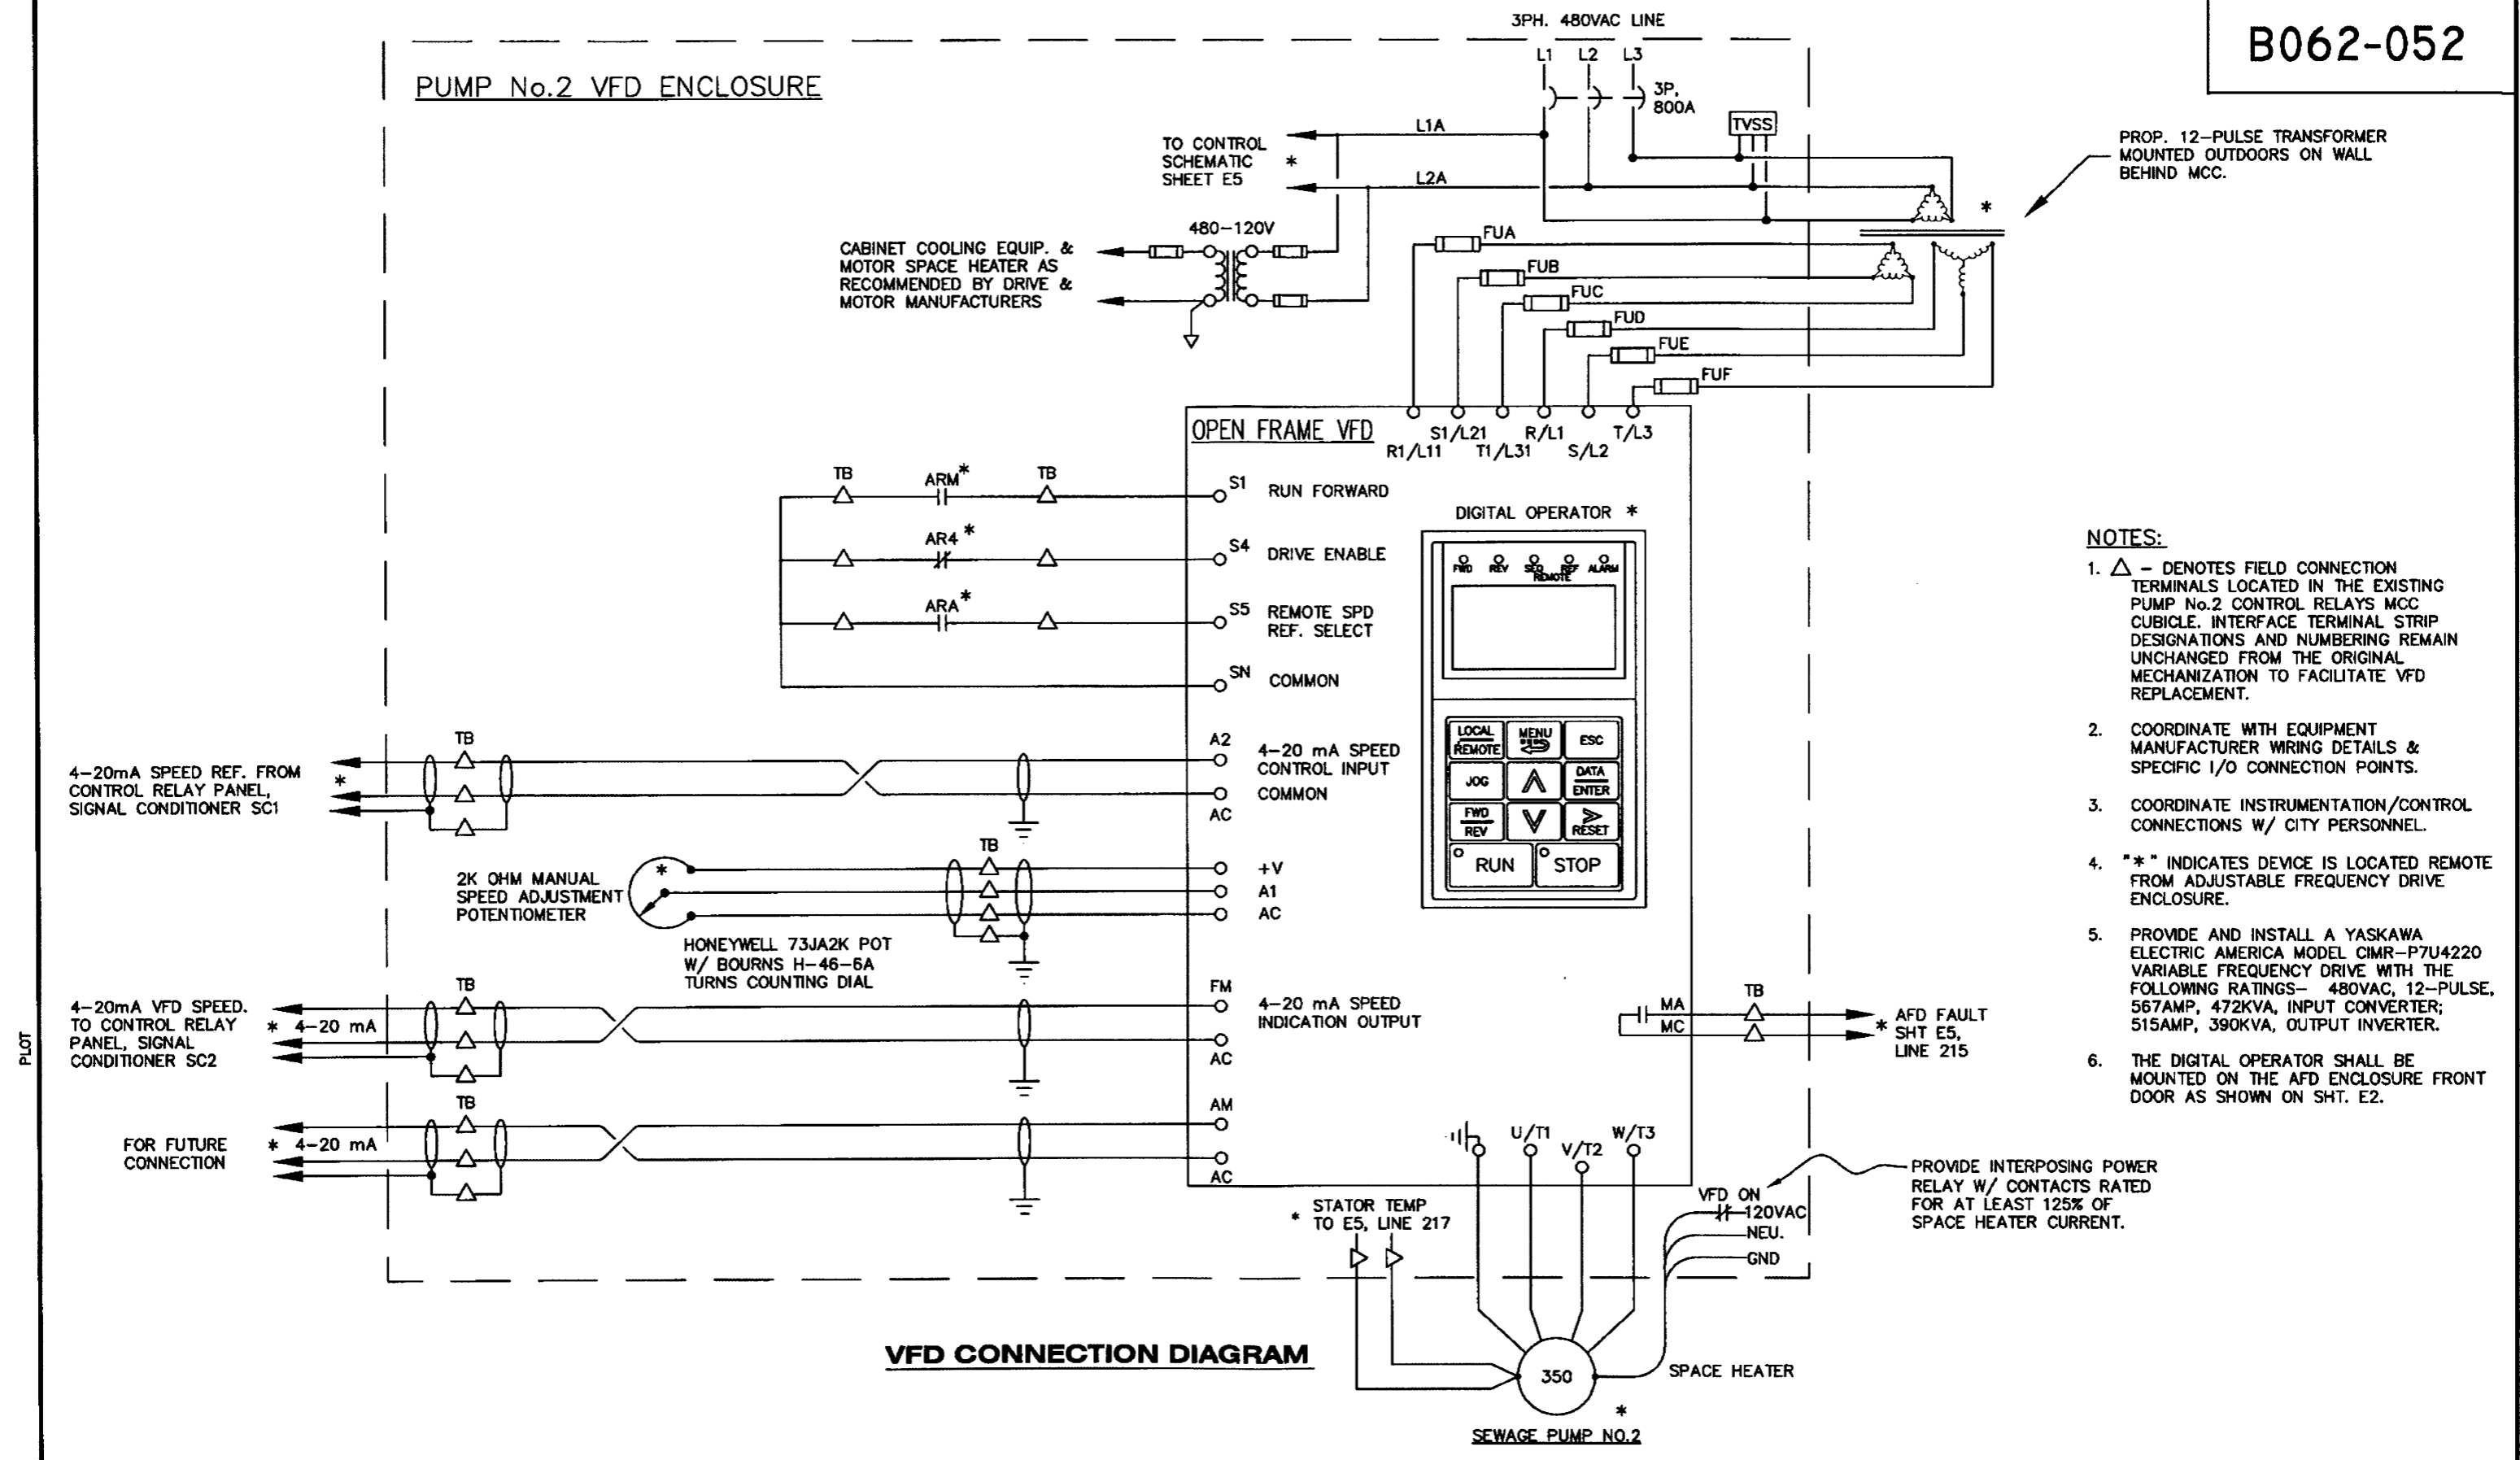

- NOTES:**
1. Δ - DENOTES FIELD CONNECTION TERMINALS LOCATED IN THE EXISTING PUMP No.2 CONTROL RELAYS MCC CUBICLE. INTERFACE TERMINAL STRIP DESIGNATIONS AND NUMBERING REMAIN UNCHANGED FROM THE ORIGINAL MECHANIZATION TO FACILITATE VFD REPLACEMENT.
 2. COORDINATE WITH EQUIPMENT MANUFACTURER WIRING DETAILS & SPECIFIC I/O CONNECTION POINTS.
 3. COORDINATE INSTRUMENTATION/CONTROL CONNECTIONS W/ CITY PERSONNEL.
 4. "*" INDICATES DEVICE IS LOCATED REMOTE FROM ADJUSTABLE FREQUENCY DRIVE ENCLOSURE.
 5. PROVIDE AND INSTALL A YASKAWA ELECTRIC AMERICA MODEL CIMR-P7U4220 VARIABLE FREQUENCY DRIVE WITH THE FOLLOWING RATINGS- 480VAC, 12-PULSE, 567AMP, 472KVA, INPUT CONVERTER; 515AMP, 390KVA, OUTPUT INVERTER.
 6. THE DIGITAL OPERATOR SHALL BE MOUNTED ON THE AFD ENCLOSURE FRONT DOOR AS SHOWN ON SHT. E2.

VFD CONNECTION DIAGRAM

FILENAME
 ROMAN D. KORCHAK, P.E. #42626
 ELECTRICAL SECTION HEAD
 WASTEWATER DEPARTMENT


No.	DATE	REVISIONS
3		
2		
1		

DES: RDK
 DRN: RDK
 CKD:
 DATE: 6/30/08

CITY of TAMPA
 WASTEWATER DEPARTMENT

UNIVERSITY P.S.
 PUMP No.2 REPLACEMENT
 ELECTRICAL- VFD INTERCONNECTIONS

W.O. 5395
 SHEET
E4
 OF

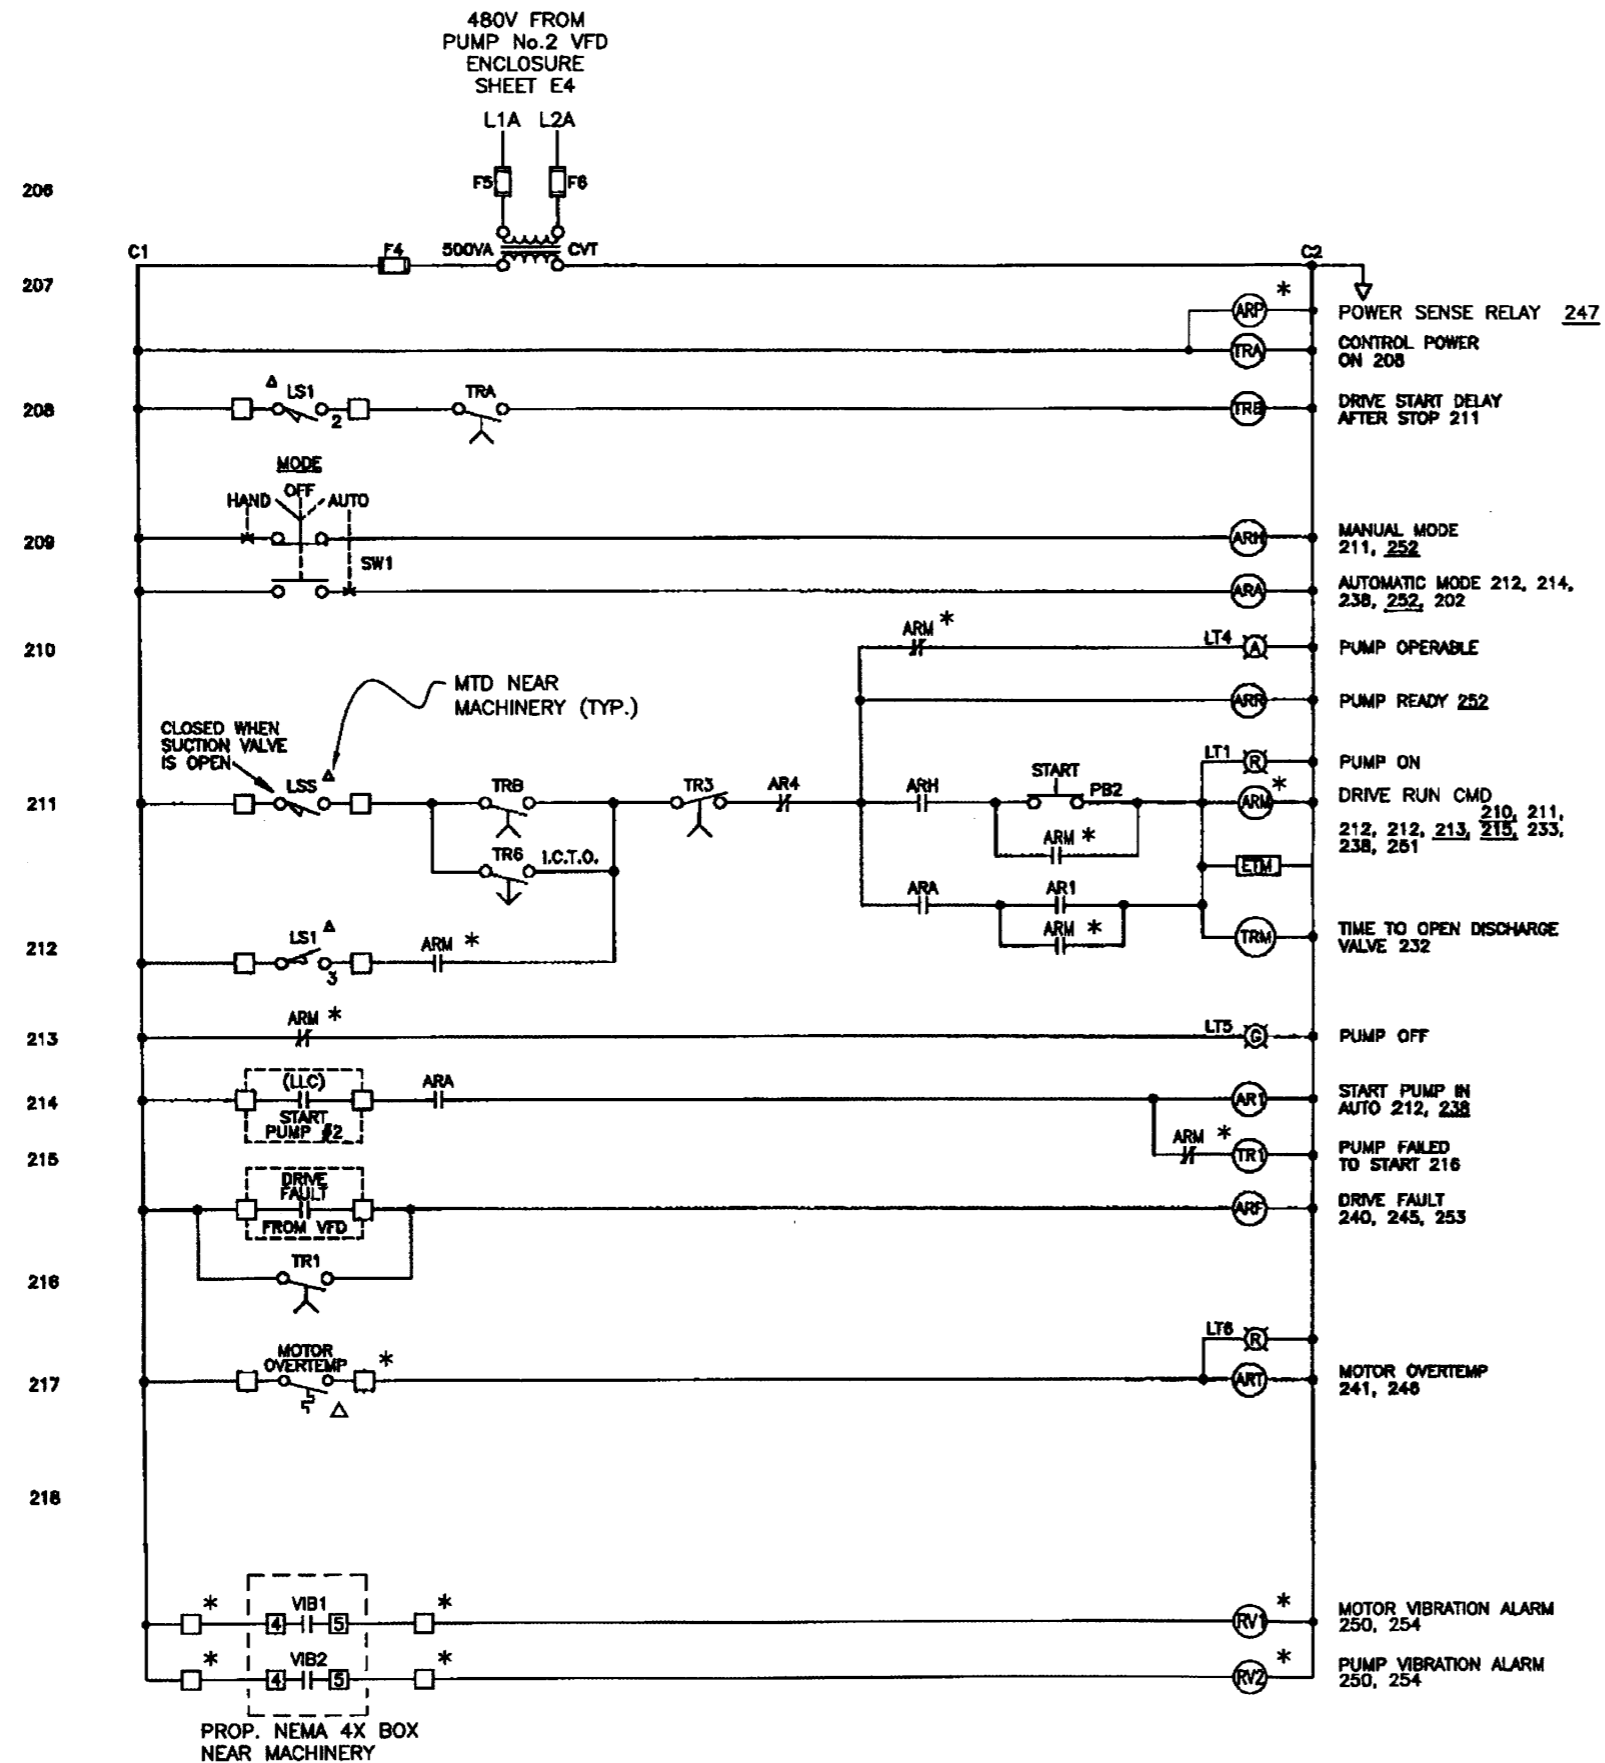

LS	CONTACT	DISCHARGE VALVE POSITION		
		FULLY CLOSED	INTERMED POSITION	FULLY OPEN
LS1	1		X	X
	2	X		
	3		X	X
	4	X		
LS2	1	X	X	
	2			X
	3	X	X	
	4			X

CONTROLS ARE LOCATED IN THE LOWER HALF OF SECTION 4 OF THE PUMP CONTROL CENTER.

MODIFICATIONS TO THE EXISTING CONTROLS ARE MARKED WITH "*".

PLOT

FILENAME
 ROMAN D. KORCHAK, P.E. #42626
 ELECTRICAL SECTION HEAD
 WASTEWATER DEPARTMENT



No.	DATE	REVISIONS
3		
2		
1		

DES: RDK
 DRN: RDK
 CKD:
 DATE: 6/30/08

CITY of TAMPA
 WASTEWATER DEPARTMENT

UNIVERSITY P.S.
 PUMP No.2 REPLACEMENT
 PUMP No.2 CONTROLS (SHT. 1 OF 4)

W.O. 5395
 SHEET
 E5
 of

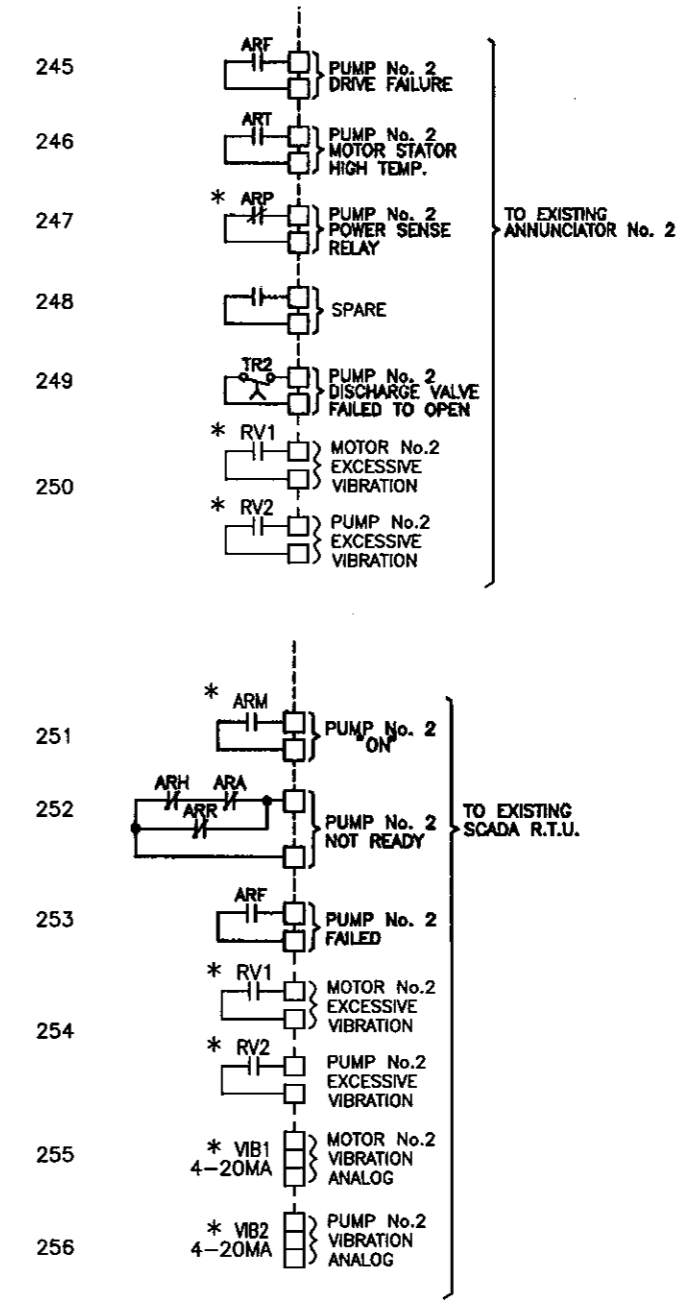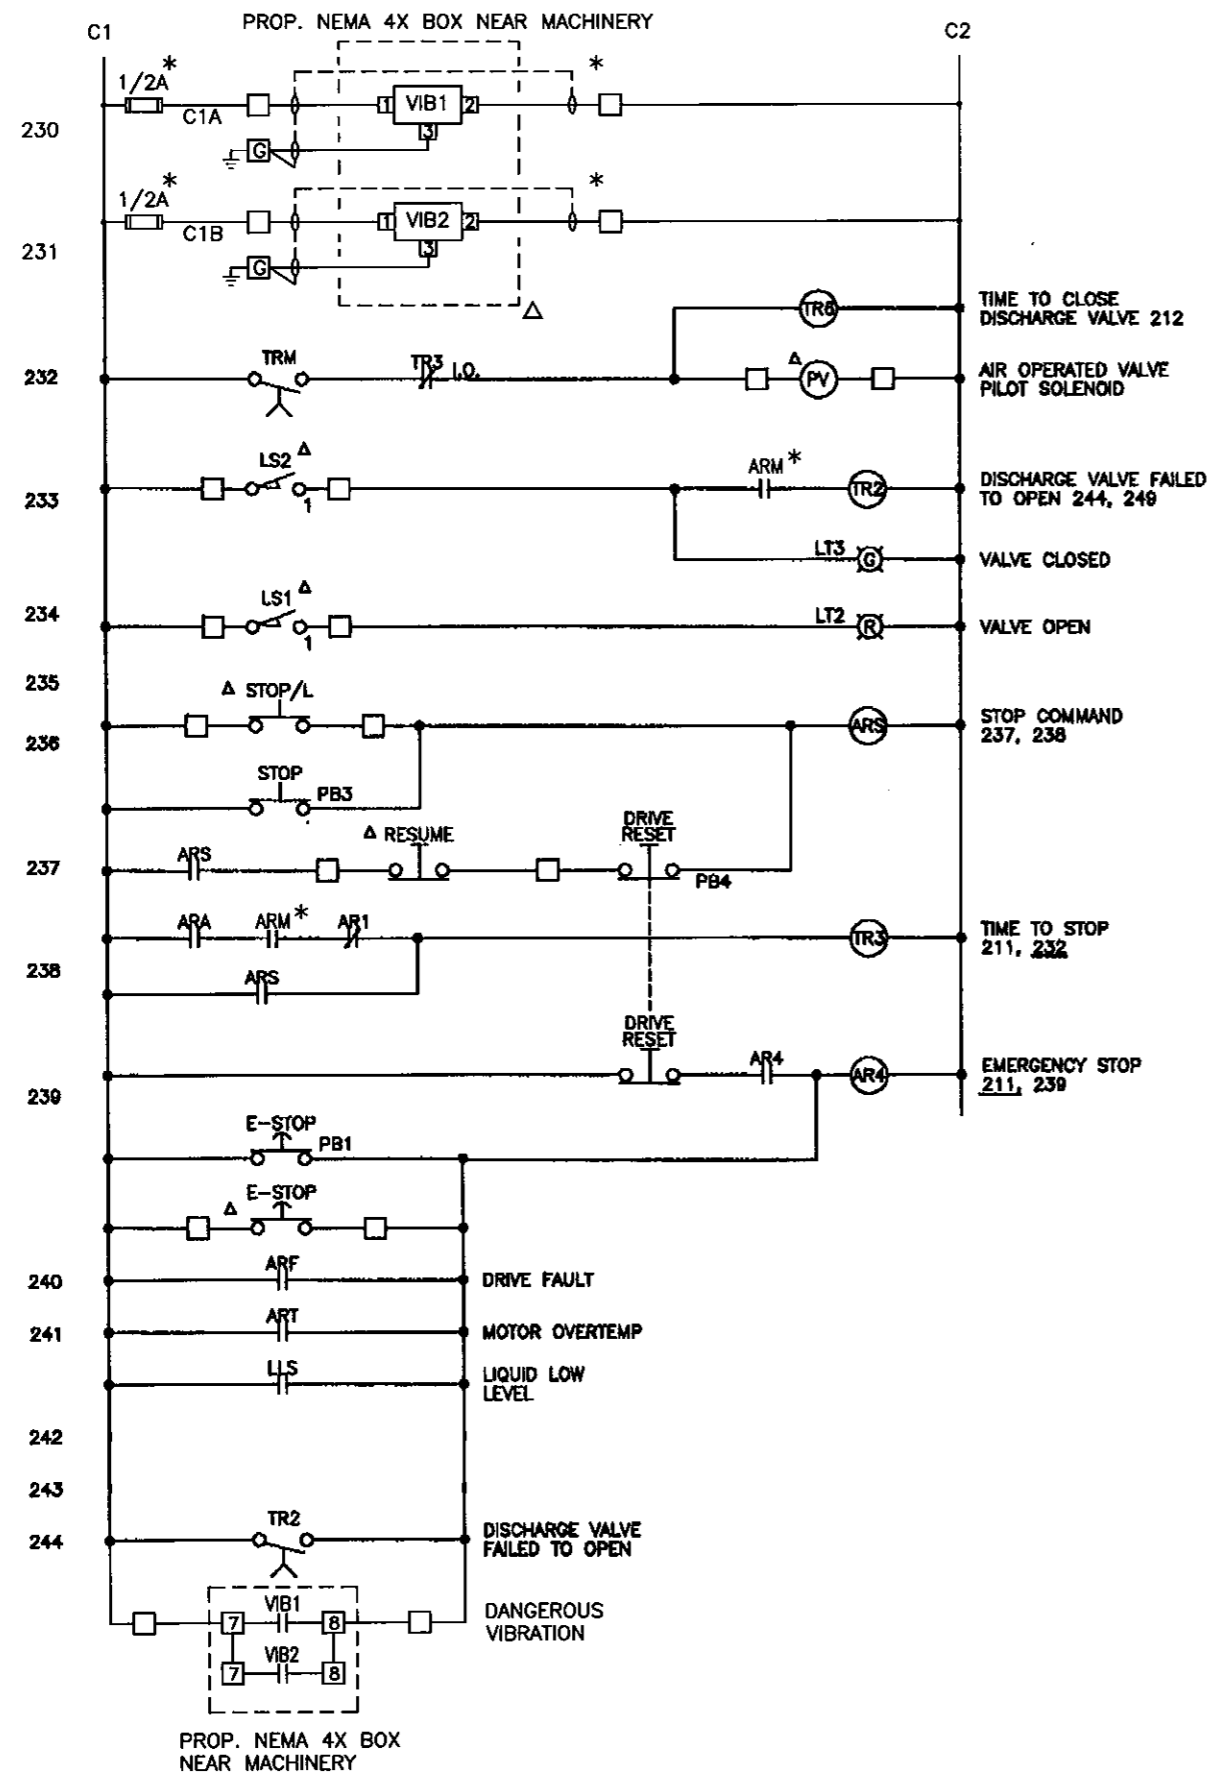

CONTROLS ARE LOCATED IN THE LOWER HALF OF SECTION 4 OF THE PUMP CONTROL CENTER.
 MODIFICATIONS TO THE EXISTING CONTROLS ARE MARKED WITH "*".

PLOT

FILENAME

ROMAN D. KORCHAK, P.E. #42626
 ELECTRICAL SECTION HEAD
 WASTEWATER DEPARTMENT


No.	DATE	REVISIONS
3		
2		
1		

DES: RDK
 DRN: RDK
 CKD:
 DATE: 6/30/08

CITY of TAMPA
 WASTEWATER DEPARTMENT

UNIVERSITY P.S.
 PUMP No.2 REPLACEMENT
 PUMP No.2 CONTROLS (SHT. 2 OF 4)

W.O. 5395
 SHEET
E6
 OF

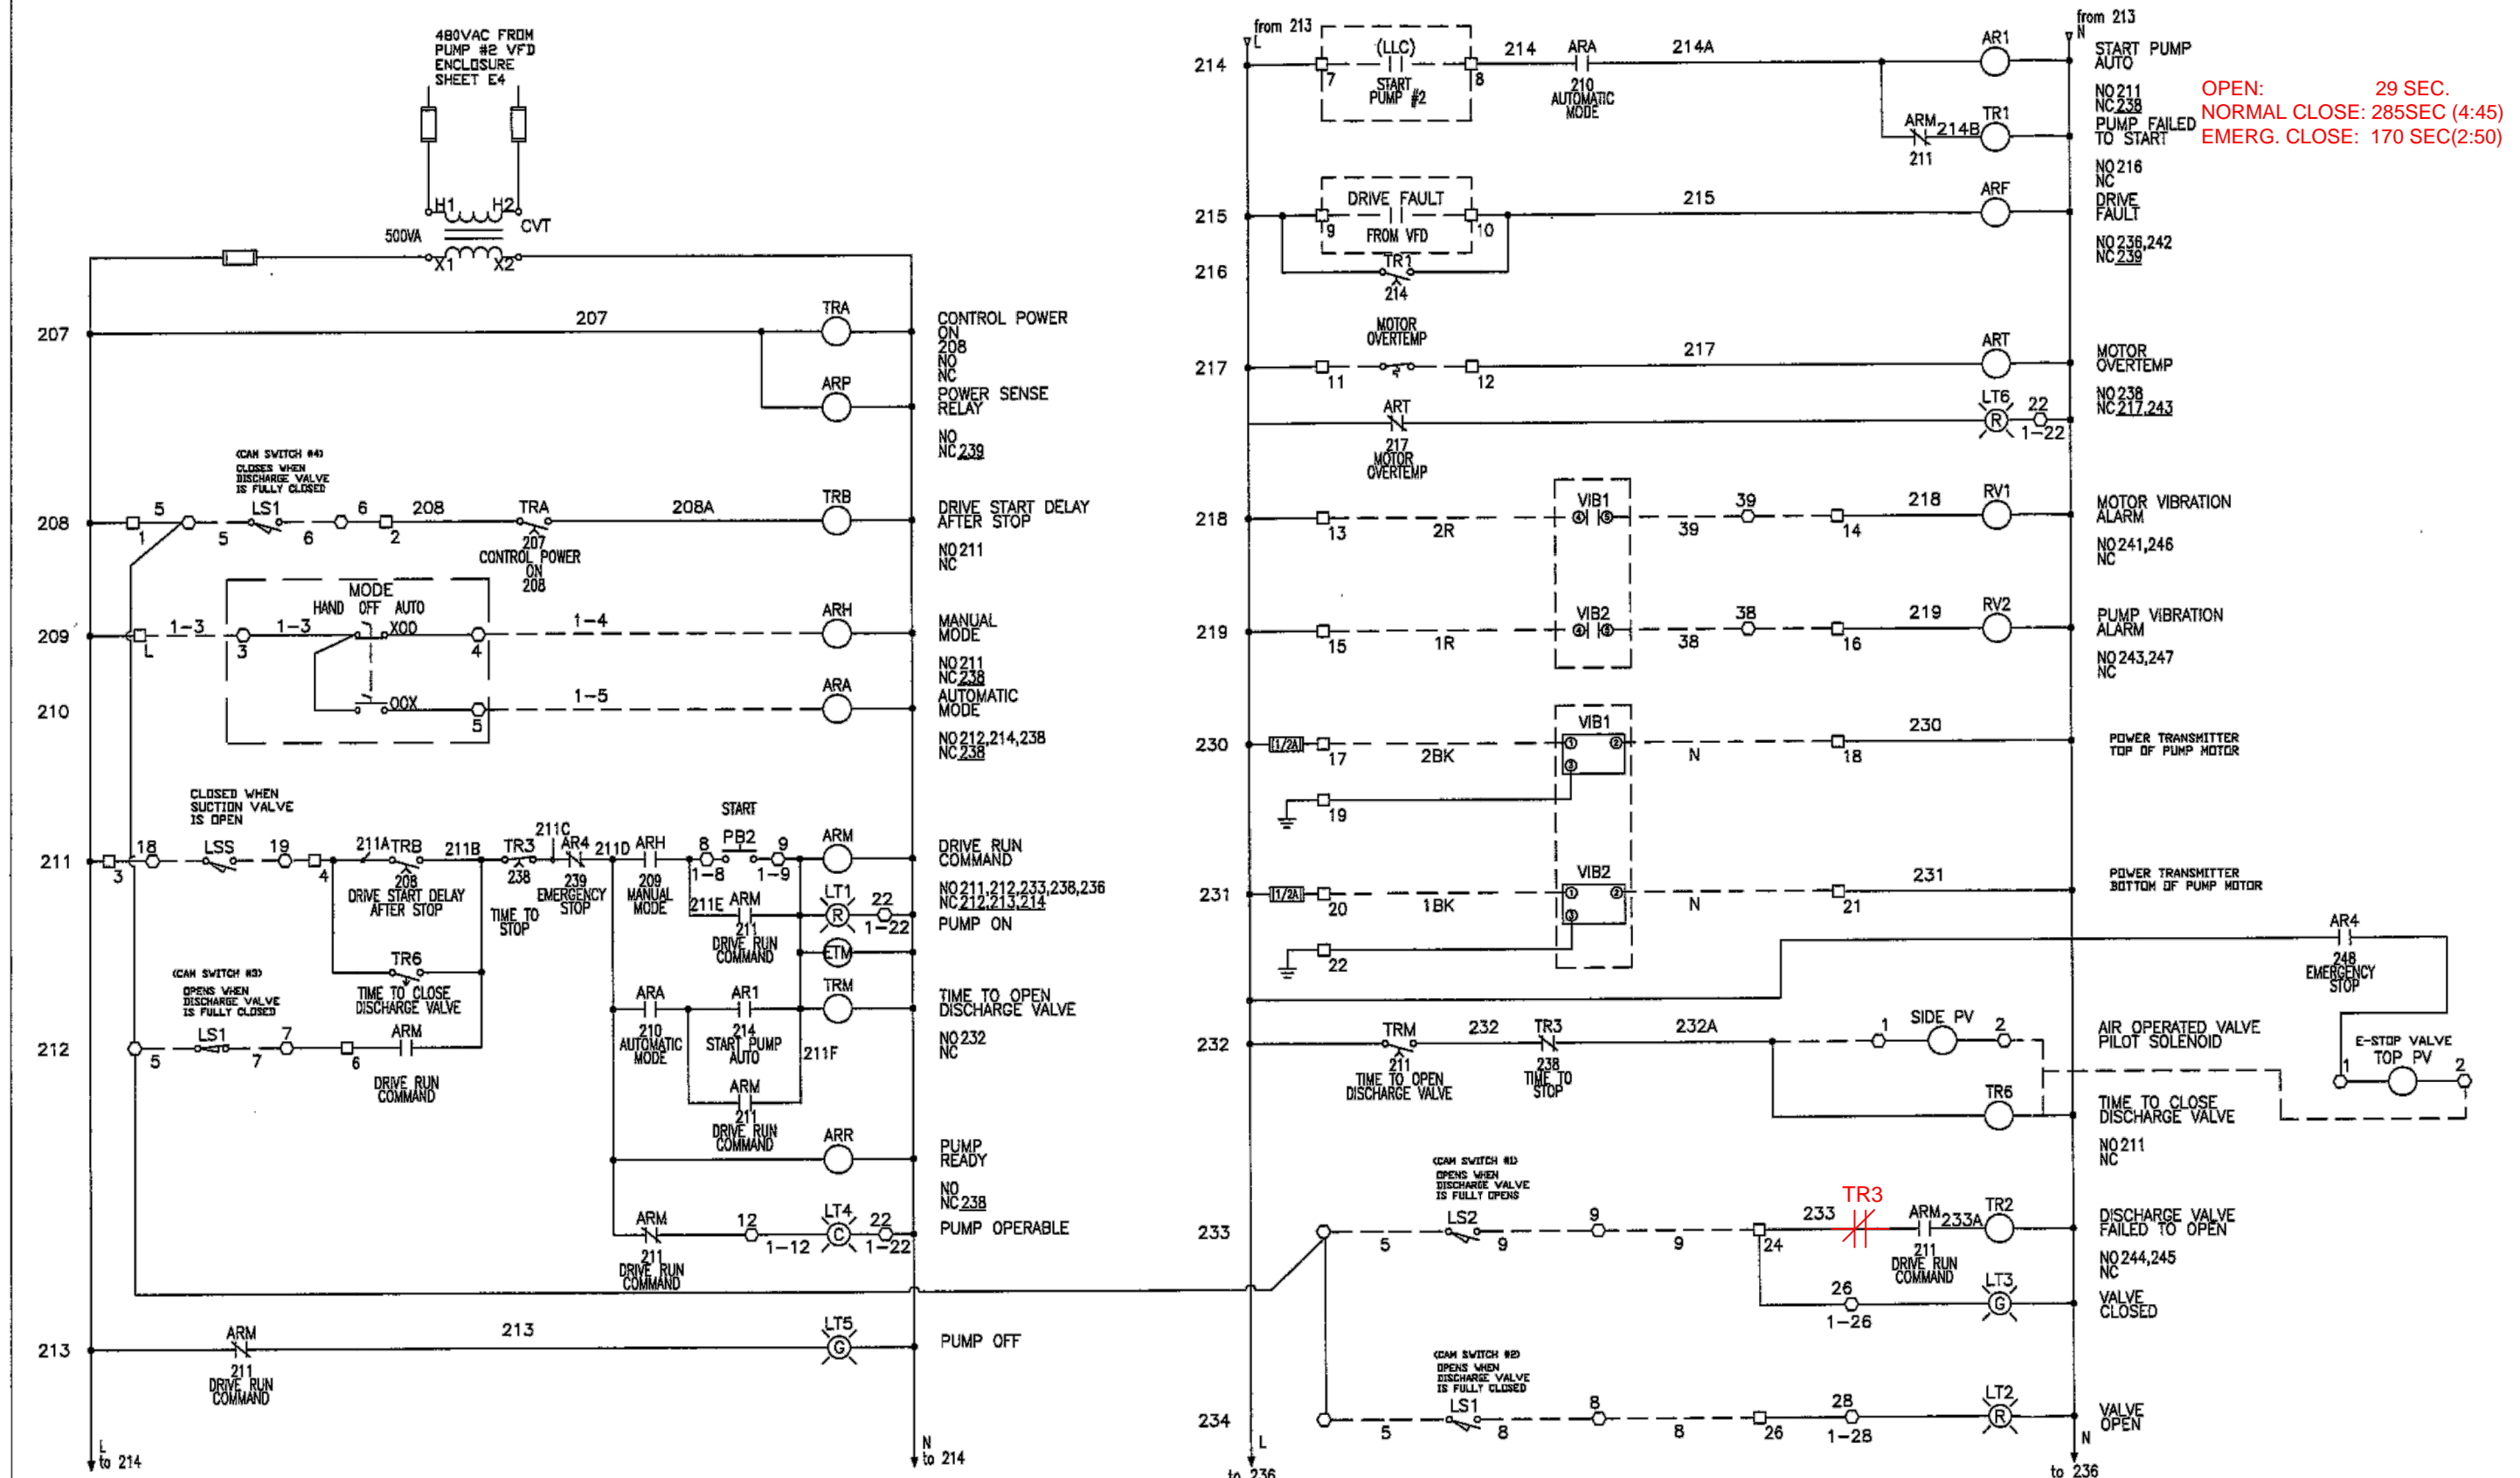

NOTES: 1. ALL CONTROL WIRING TO BE #14 AWG RED UNLESS SPECIFIED OTHERWISE
 2. Y DENOTES #14 AWG YELLOW
 3. W DENOTES #14 AWG WHITE
 4. B DENOTES #14 AWG BLUE
 5. B/W DENOTES #14 AWG BLUE/WHITE TRACER
 6. SHIELDED TWISTED PAIR SHALL BE #18 AWG
 7.
 8.
 9.

NOTES:2015
 1010-12 E01 & E02 IS UNDER CITY CONTRACT 8-C-34
 1010-18 E01 & E02 IS UNDER CITY CONTRACT 11-C-00008


REV.	DATE	DESCRIPTION	BY	DESIGNED	DATE
1	04/14/09	SUBMITTAL	JB	J. BUSHONG	04/14/09
2	08/01/09	AS-BUILT	CAA	J. BUSHONG	04/14/09
3	01/21/10	AS INSTALLED	CAA		

Rocha Controls

5556 56th Commerce Park Blvd. Tampa, Florida 33610
 813-628-5584 813-664-6713 Fax

THIS DRAWING IS THE CONFIDENTIAL PROPERTY OF ROCHA CONTROLS TAMPA FL. AND MAY NOT BE RELEASED, REPRODUCED, OR USED WITHOUT WRITTEN CONSENT AND MUST BE RETURNED UPON REQUEST.

CLIENT	CITY OF TAMPA UNIVERSITY P.S. PUMP NO.2 REPLACEMENT	ROCHA CONTROLS PROJECT NO: 1010-12
TITLE	PUMP NO.2 CONTROLS POWER WIRING	DWG. NO. ED1
		REV. 3

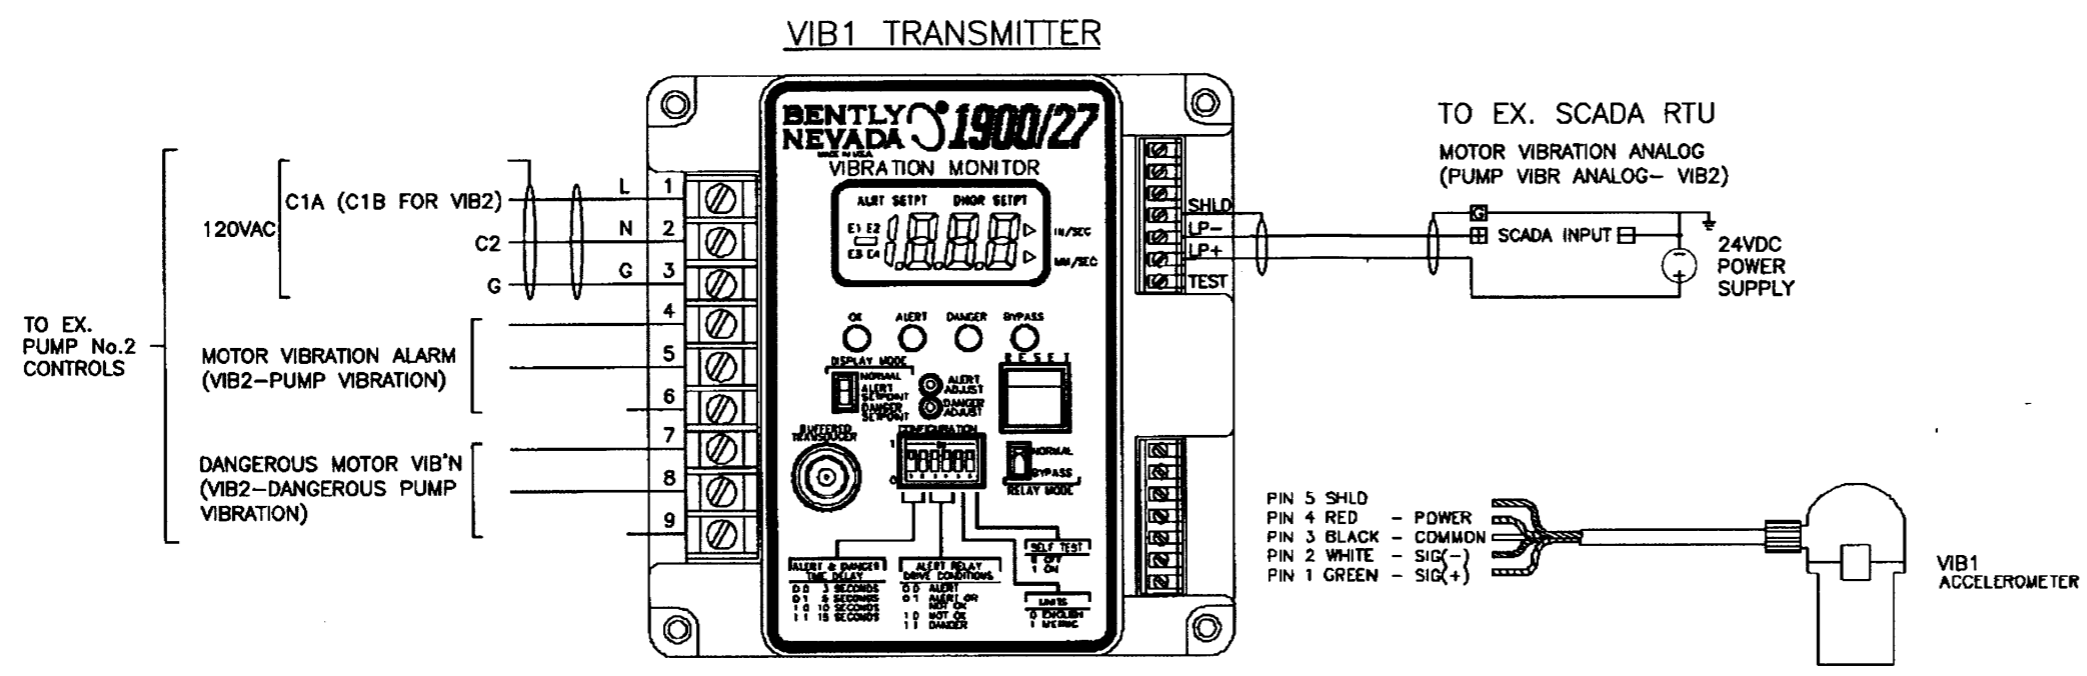

POWER SUPPLY CONNECTIONS	
INPUT VOLTAGE	CONNECTIONS
110 VAC	1 LINE 2 NEUTRAL 3 GROUND
220 VAC	1 LINE 1 2 LINE 2/NEUTRAL 3 GROUND
24 VDC	1 +24 VDC 2 COMMON 3 GROUND

RELAY CONTACTS			
		NORMALLY DE-ENERGIZED (FACTORY DEFAULT)	NORMALLY ENERGIZED
ALERT	4	NORMALLY CLOSED	NORMALLY OPEN
	5	COMMON	COMMON
	6	NORMALLY OPEN	NORMALLY CLOSED
DANGER	7	NORMALLY CLOSED	NORMALLY OPEN
	8	COMMON	COMMON
	9	NORMALLY OPEN	NORMALLY CLOSED


MOTOR VIBRATION MONITOR, VIB1
(PUMP VIBRATION MONITOR, VIB2, IS SIMILAR)

THE PUMP / MOTOR SUPPLIER SHALL PROVIDE THE SPECIFIED VIBRATION MONITORING EQUIPMENT AND INSTALL THE ACCELEROMETERS ON THE MACHINERY AS REQUIRED. VIB1 AND VIB2 TRANSMITTERS SHALL BE MOUNTED IN A COMMON NEMA 4X S.S. ENCLOSURE MOUNTED NEAR THE MACHINERY AND WIRED AS REQUIRED BY THE ELECTRICAL SUBCONTRACTOR.

PLOT

FILENAME

ROMAN D. KORCHAK, P.E. #42626 ELECTRICAL SECTION HEAD WASTEWATER DEPARTMENT	No.	DATE	REVISIONS	DES: RDK	CITY of TAMPA WASTEWATER DEPARTMENT	UNIVERSITY P.S. PUMP No.2 REPLACEMENT PUMP No.2 CONTROLS (SHT. 3 OF 4)	W.O. 5395
	3			DRN: RDK			SHEET
	2			CKD:			E7
	1			DATE: 6/06/08			OF

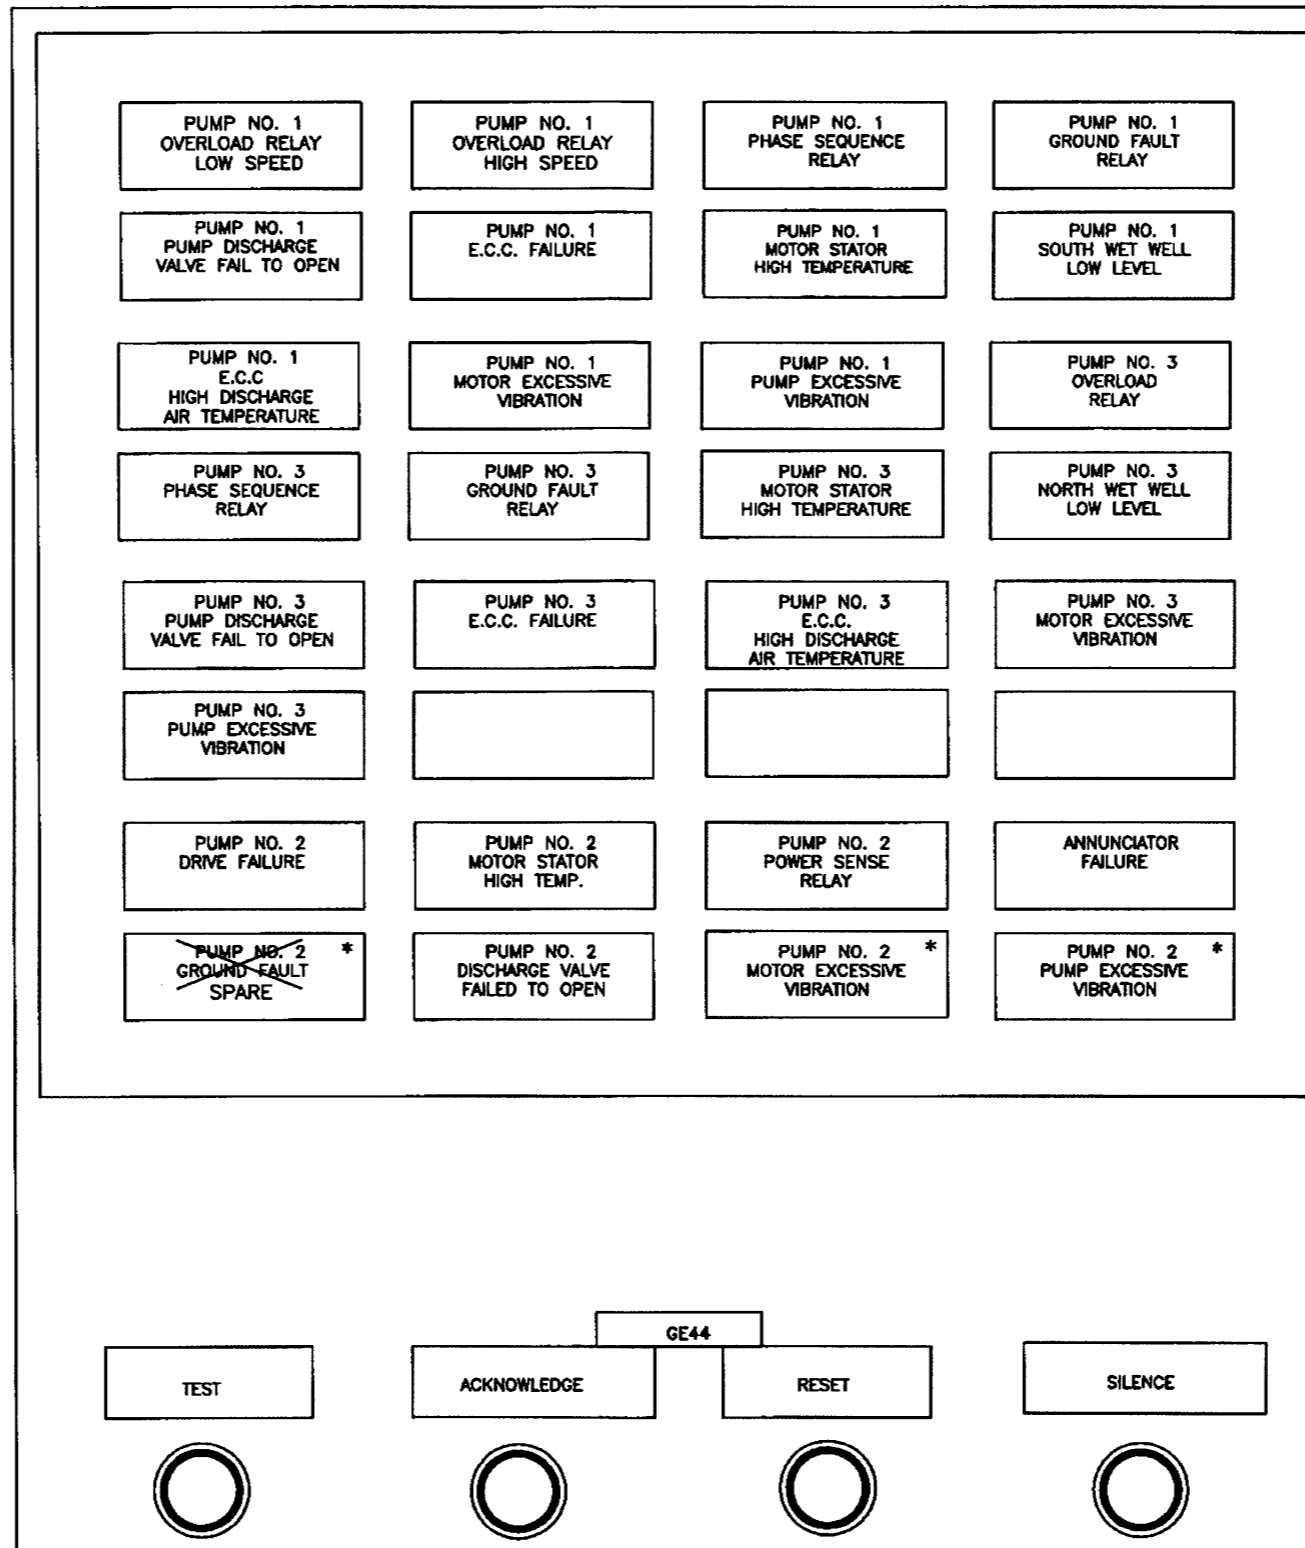

EXISTING ANNUNCIATOR



WINDOWS TO BE ADDED ARE MARKED "*"

PLOT



FILENAME

ROMAN D. KORCHAK, P.E. #42626 ELECTRICAL SECTION HEAD WASTEWATER DEPARTMENT	No.	DATE	REVISIONS	DES: RDK	CITY of TAMPA WASTEWATER DEPARTMENT	UNIVERSITY P.S. PUMP No.2 REPLACEMENT PUMP No.2 CONTROLS (SHT. 4 OF 4)	W.O. 5395
	3			DRN: RDK			SHEET
	2			CKD:			E8
	1			DATE: 6/30/08			OF




SEWAGE PUMP No.3

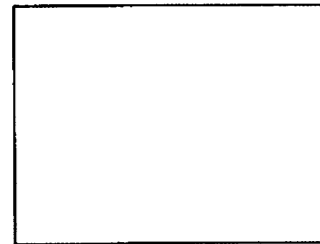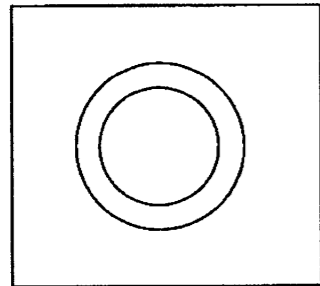

PROP. SEWAGE PUMP No.2

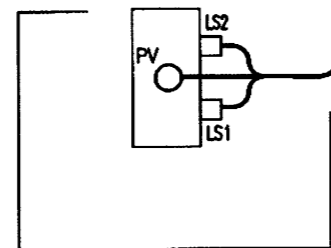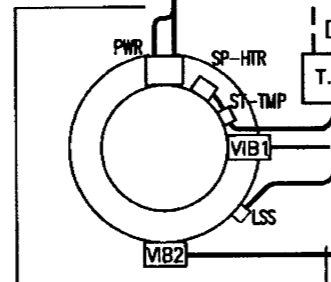

SEWAGE PUMP No.1

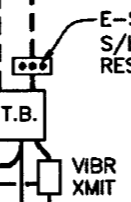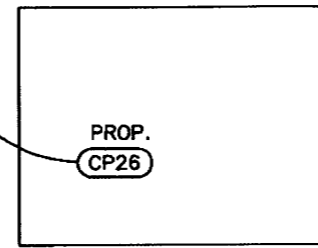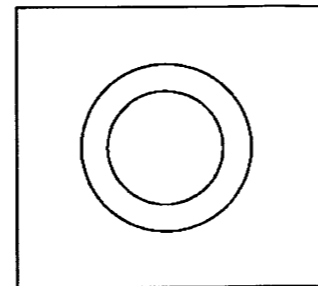


PROP. P25-A
P25-B


PROP. CP25
(MODIFY EX. CONDUIT RUN AND
No. OF CONDUCTORS AS REQ'D)

SEWAGE PUMPS CONTROL CENTER

C1A C1B
TO ANNUNCIATOR
AND SCADA

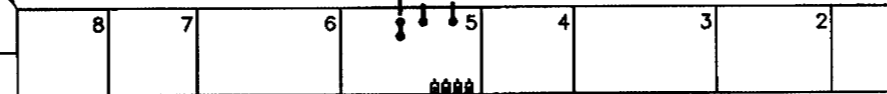

PROP. 12-PULSE TRANSFORMER

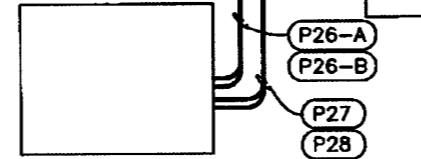

EX. METAL BLD

PLAN VIEW

SCALE: 1/4"=1'-0"

SEWAGE PUMPS CONTROL CENTER ON TOP FL.- EL. 41.25'
PUMP MOTORS AND ACCESSORIES ON BOTTOM FL.- EL. 15.00'

ROMAN D. KORCHAK, P.E. #42626
ELECTRICAL SECTION HEAD
WASTEWATER DEPARTMENT

No.	DATE	REVISIONS
3		
2		
1		

DES: RDK
DRN: RDK
CKD:
DATE: 6/06/08


CITY of TAMPA
WASTEWATER DEPARTMENT

UNIVERSITY P.S.
PUMP No.2 REPLACEMENT
ELECTRICAL- POWER PLAN

W.O. 5395
SHEET
E9
OF

PLOT

FILENAME

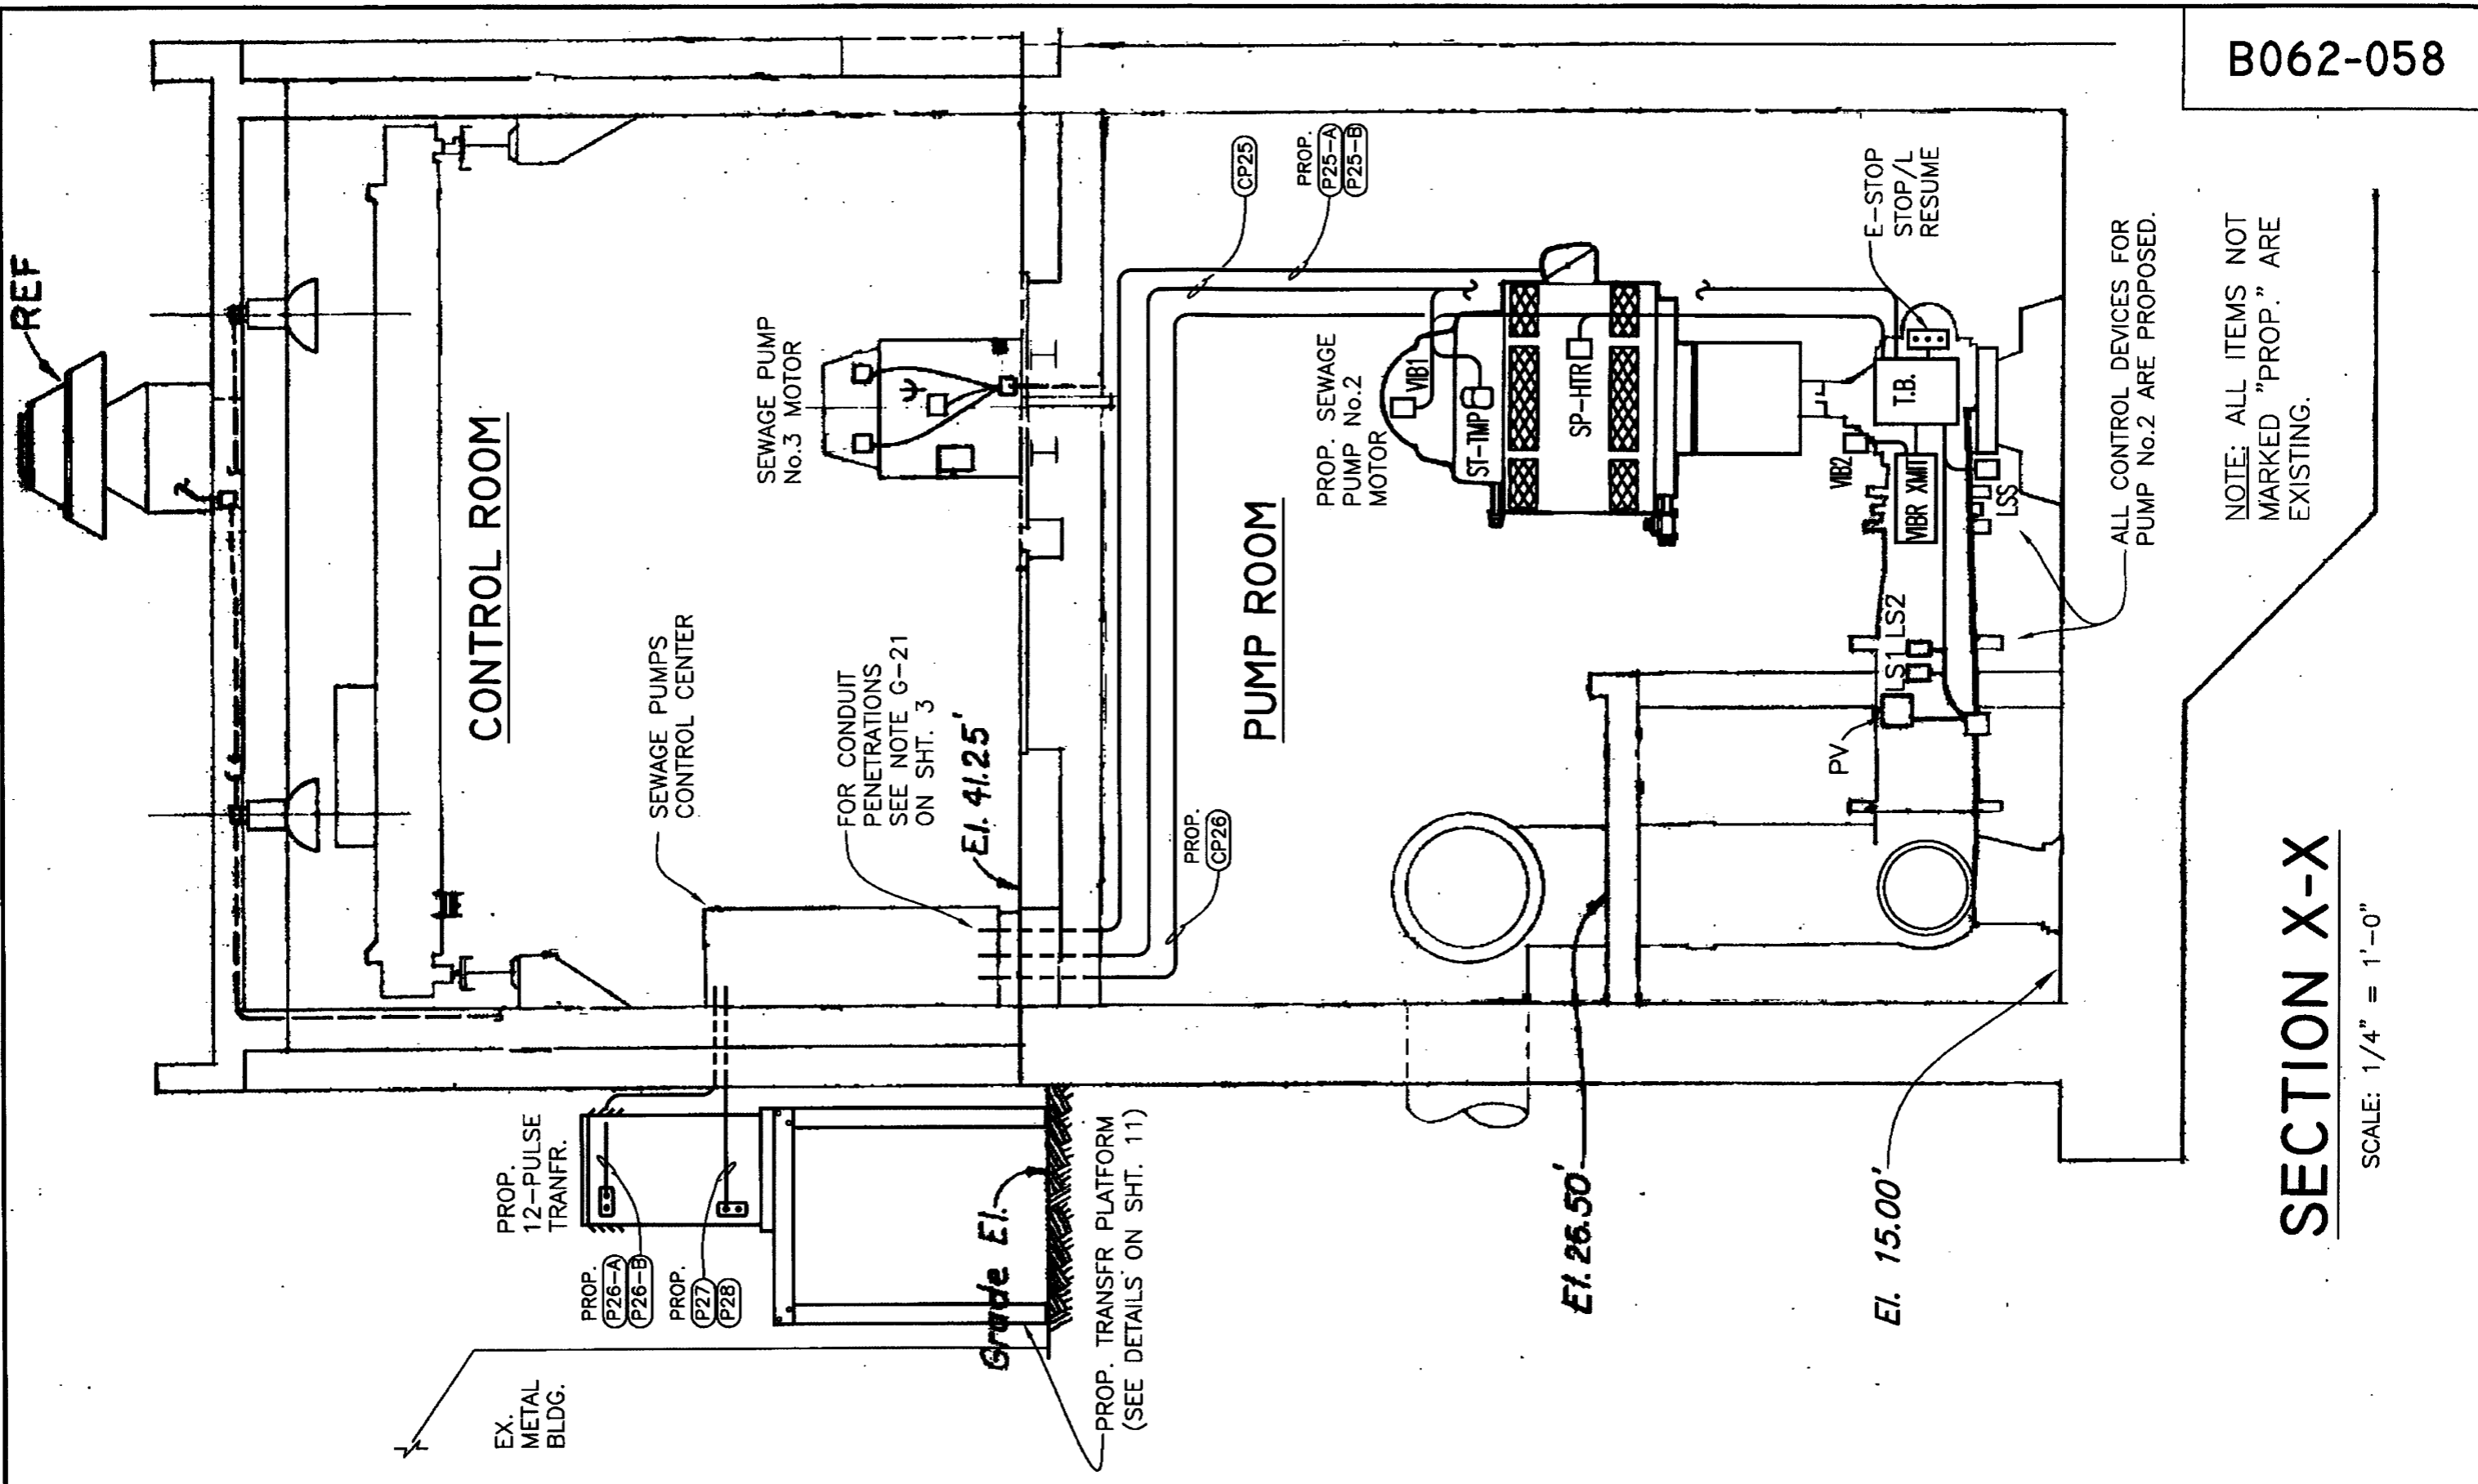

SECTION X-X

SCALE: 1/4" = 1'-0"

ROMAN D. KORCHAK, P.E. #42626
ELECTRICAL SECTION HEAD
WASTEWATER DEPARTMENT

No.	DATE	REVISIONS
3		
2		
1		

DES: RDK
DRN: RDK
CKD:
DATE: 6/09/08


CITY of TAMPA
WASTEWATER DEPARTMENT

UNIVERSITY P.S.
PUMP No.2 REPLACEMENT
ELECTRICAL POWER SECTION

W.O. 5395
SHEET
E10
OF

B069-154

LOCATION MAP

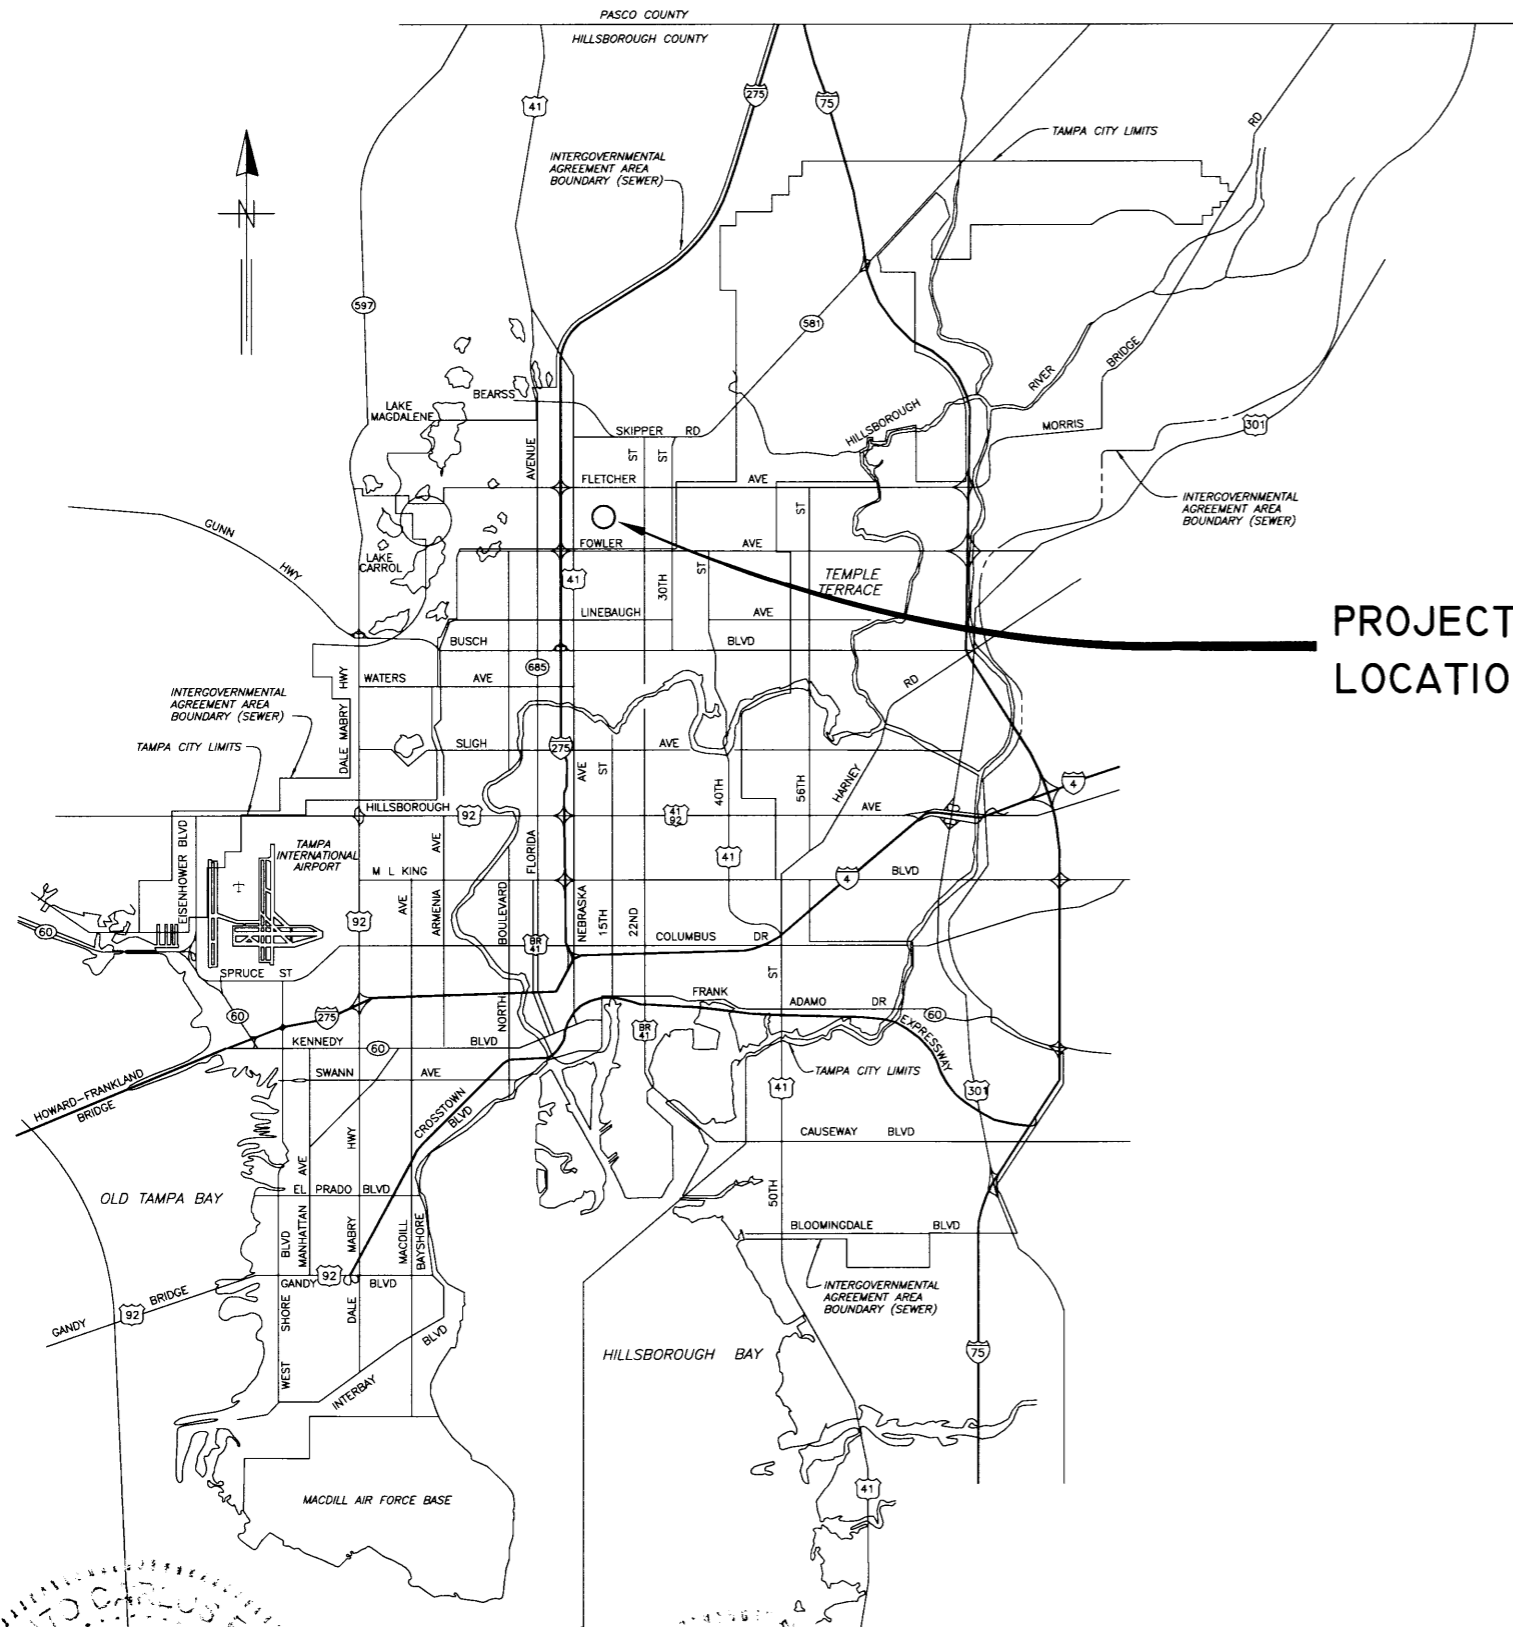

PROJECT
LOCATION

CITY of TAMPA



WASTEWATER DEPARTMENT


PLANS FOR
UNIVERSITY PUMPING STATION
REHABILITATION

CONTRACT: II-C-00008


**PROJECT
RECORD**

C:\PROGRAMFILES\AUTOCAD\CIVIL3D\2010\DWGFILES\PS\UNIVERSITY.P.S.\4511-SHEET-01.DWG

<p>Jacinto Carlos Ferras 2/17/11 JACINTO CARLOS FERRAS, P.E. #49454 DESIGN DIVISION HEAD WASTEWATER DEPARTMENT</p>	<p>Roman D. Korchak 2/18/11 ROMAN D. KORCHAK, P.E. #42626 ELECTRICAL SECTION HEAD WASTEWATER DEPARTMENT</p>	<table border="1"> <thead> <tr> <th>No.</th> <th>DATE</th> <th>REVISIONS</th> </tr> </thead> <tbody> <tr> <td>3</td> <td></td> <td></td> </tr> <tr> <td>2</td> <td></td> <td></td> </tr> <tr> <td>1</td> <td></td> <td></td> </tr> </tbody> </table>	No.	DATE	REVISIONS	3			2			1			<p>DES: D.R. DRN: BB CKD: JF DATE: 2/17/11</p>	<p>CITY of TAMPA WASTEWATER DEPARTMENT</p>	<p>COVER SHEET</p>	<p>W.O. 4511 SHEET 1</p>
No.	DATE	REVISIONS																
3																		
2																		
1																		

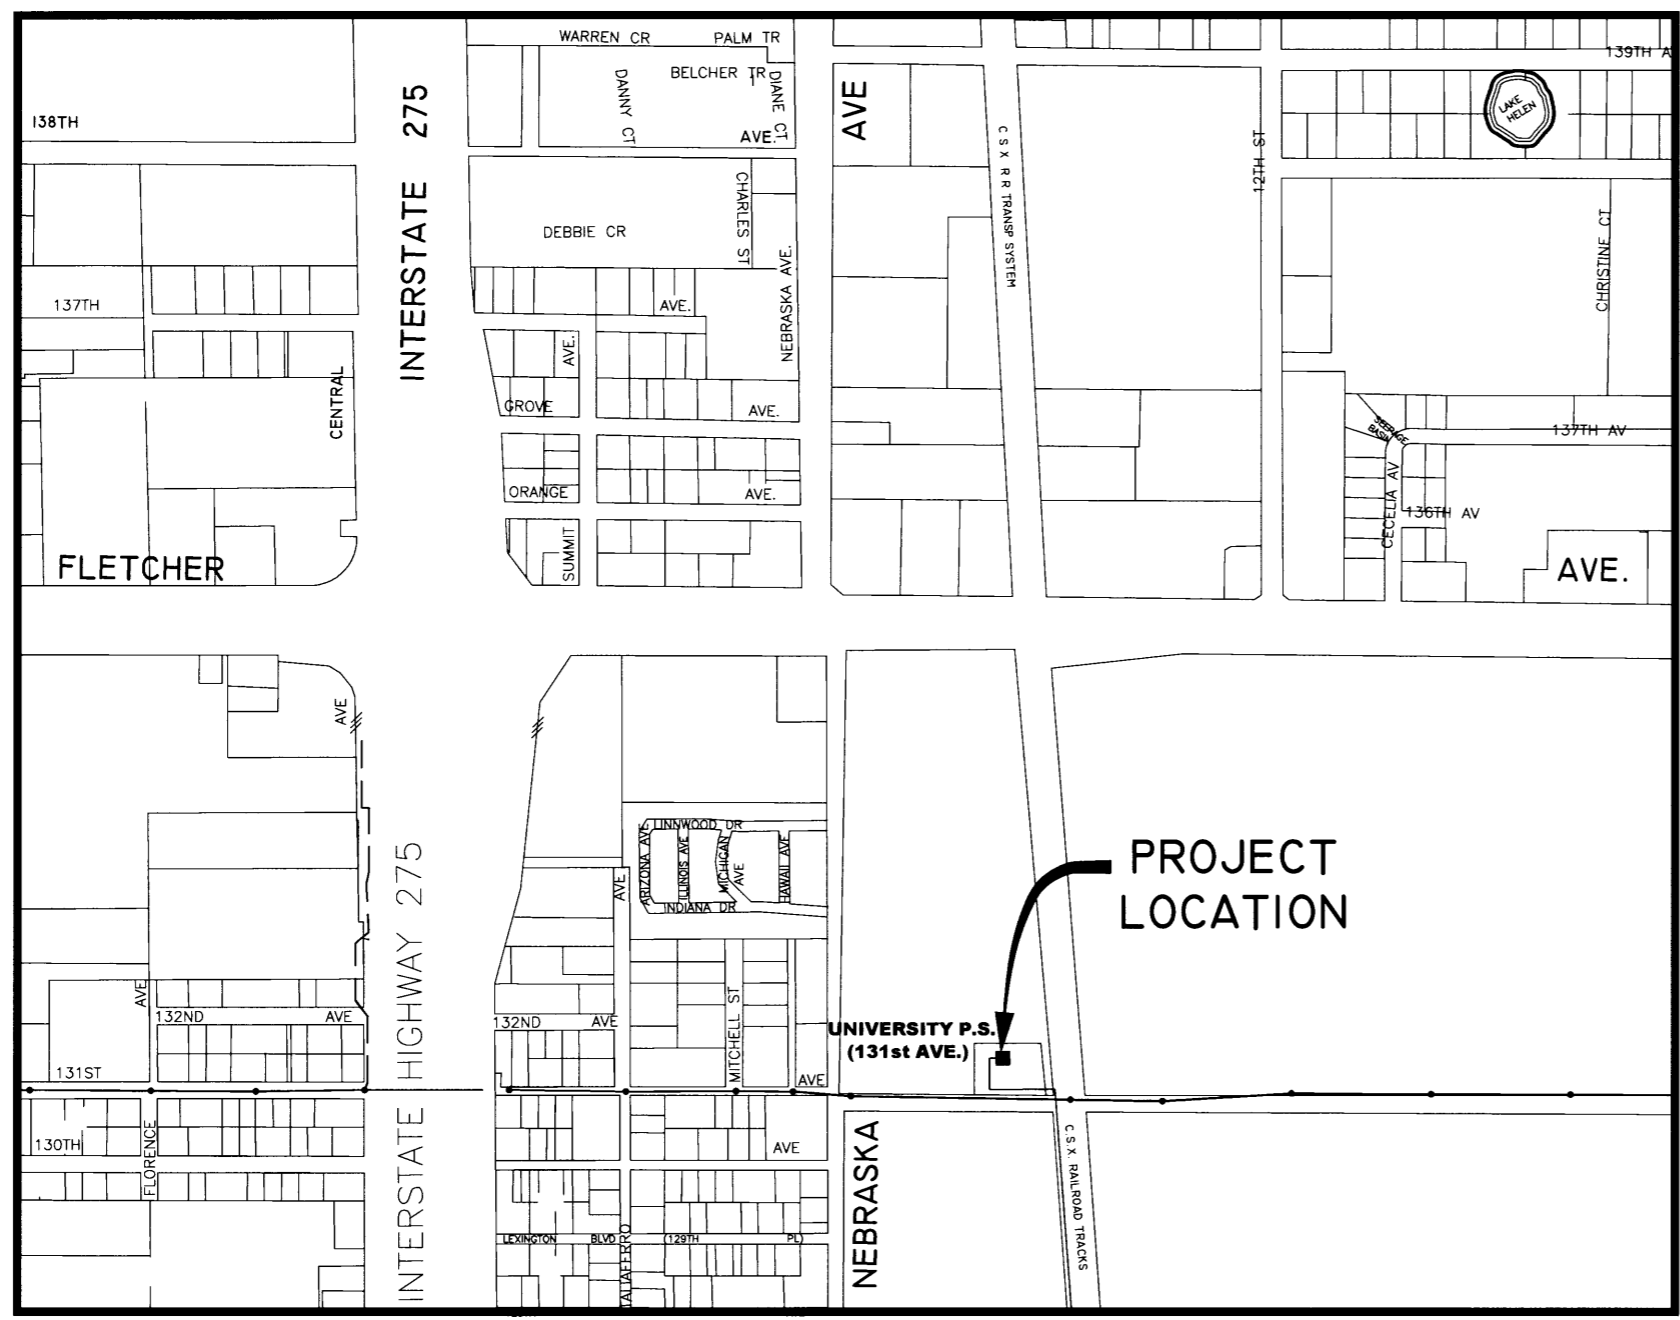

PROJECT MAP
NOT TO SCALE

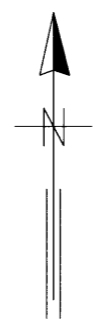


INDEX	
SH. No.	DESCRIPTION
1	COVER SHEET
2	INDEX & PROJECT MAP
3	SITE PLAN AND TRANSFORMER PAD DETAILS
4	GENERAL NOTES
5	DEMOLITION PLAN AT ELEV. 26.50
6	DEMOLITION PLAN AT ELEV. 15.00
7	DEMOLITION SECTION
8	VENTILATION DEMOLITION PLAN AT ELEV. 26.50
9	VENTILATION DEMOLITION SECTIONS
10	PROPOSED SCREEN ROOM PLAN AT ELEV. 26.50
11	PROPOSED PLAN AT ELEV. 15.00 AND SECTION
12	PROPOSED SECTION
13	PROPOSED VENTILATION PLAN AT ELEV. 26.50
14	PROPOSED VENTILATION SECTION
15	MISC. DETAILS
16	CONCRETE RESTORATION DETAILS AND NOTES
E0	ELECTRICAL – PUMP CONTROL FLOW CHART AND SYMBOLS
E1	ELECTRICAL – ONE LINE DIAGRAM
E2	ELECTRICAL – VFD CUBICLE LAYOUT
E3	ELECTRICAL – MCC LAYOUT AND PARTS SCHEDULE
E4	ELECTRICAL – VFD INTERCONNECTIONS
E5	ELECTRICAL – PUMP No.3 CONTROLS (SHT. 1 OF 4)
E6	ELECTRICAL – PUMP No.3 CONTROLS (SHT. 2 OF 4)
E7	ELECTRICAL – PUMP No.3 CONTROLS (SHT. 3 OF 4)
E8	ELECTRICAL – PUMP No.3 CONTROLS (SHT. 4 OF 4)
E9	ELECTRICAL – POWER PLAN
E10	ELECTRICAL – POWER SECTION
E11	ELECTRICAL – DEMOLITION PLAN
E12	ELECTRICAL – PROPOSED PLAN – WET WELL
E13	ELECTRICAL – PROPOSED – SECTION A-A
E14	ELECTRICAL – SCREEN ROOM SUPPLY FAN SCHEMATIC

PROJECT RECORD


C:\PROGRAMFILES\AUTODESKMAP2007\DWG\PS\UNIVERSITYPS\UNIVERSITYPS-SH-02.DWG

JACINTO CARLOS FERRAS, P.E. #49454 DESIGN DIVISION HEAD WASTEWATER DEPARTMENT	No.	DATE	REVISIONS	DES: D.R.	CITY of TAMPA WASTEWATER DEPARTMENT	UNIVERSITY PUMPING STATION REHABILITATION INDEX & PROJECT MAP	W.O. 4511 SHEET 2
	3			DRN: BB			
	2			CKD: JF			
	1			DATE: 2/17/11			


B069-156

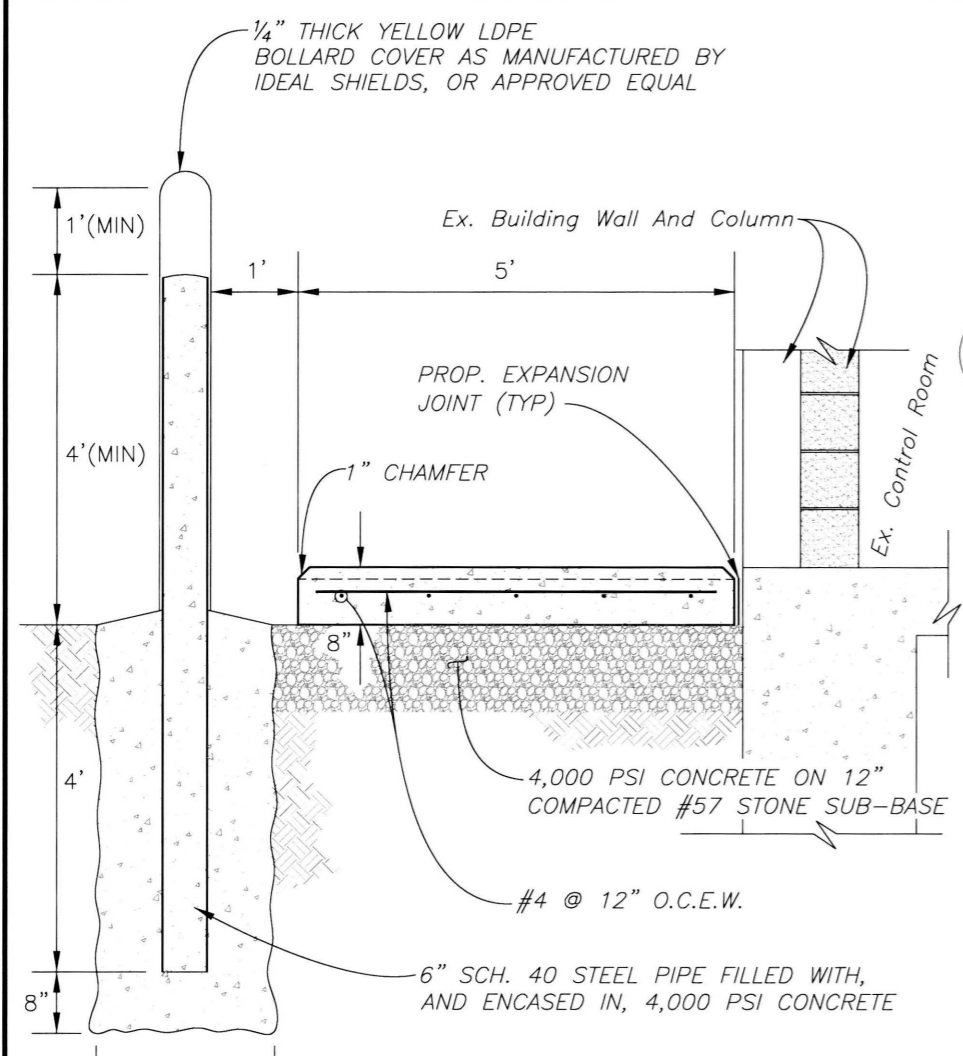


SECTION A-A
NOT TO SCALE

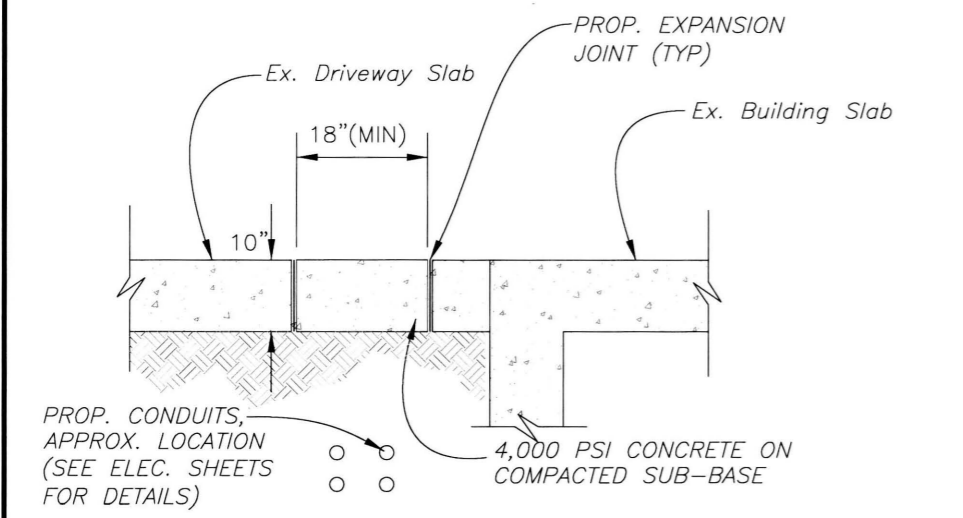

SECTION B-B
NOT TO SCALE

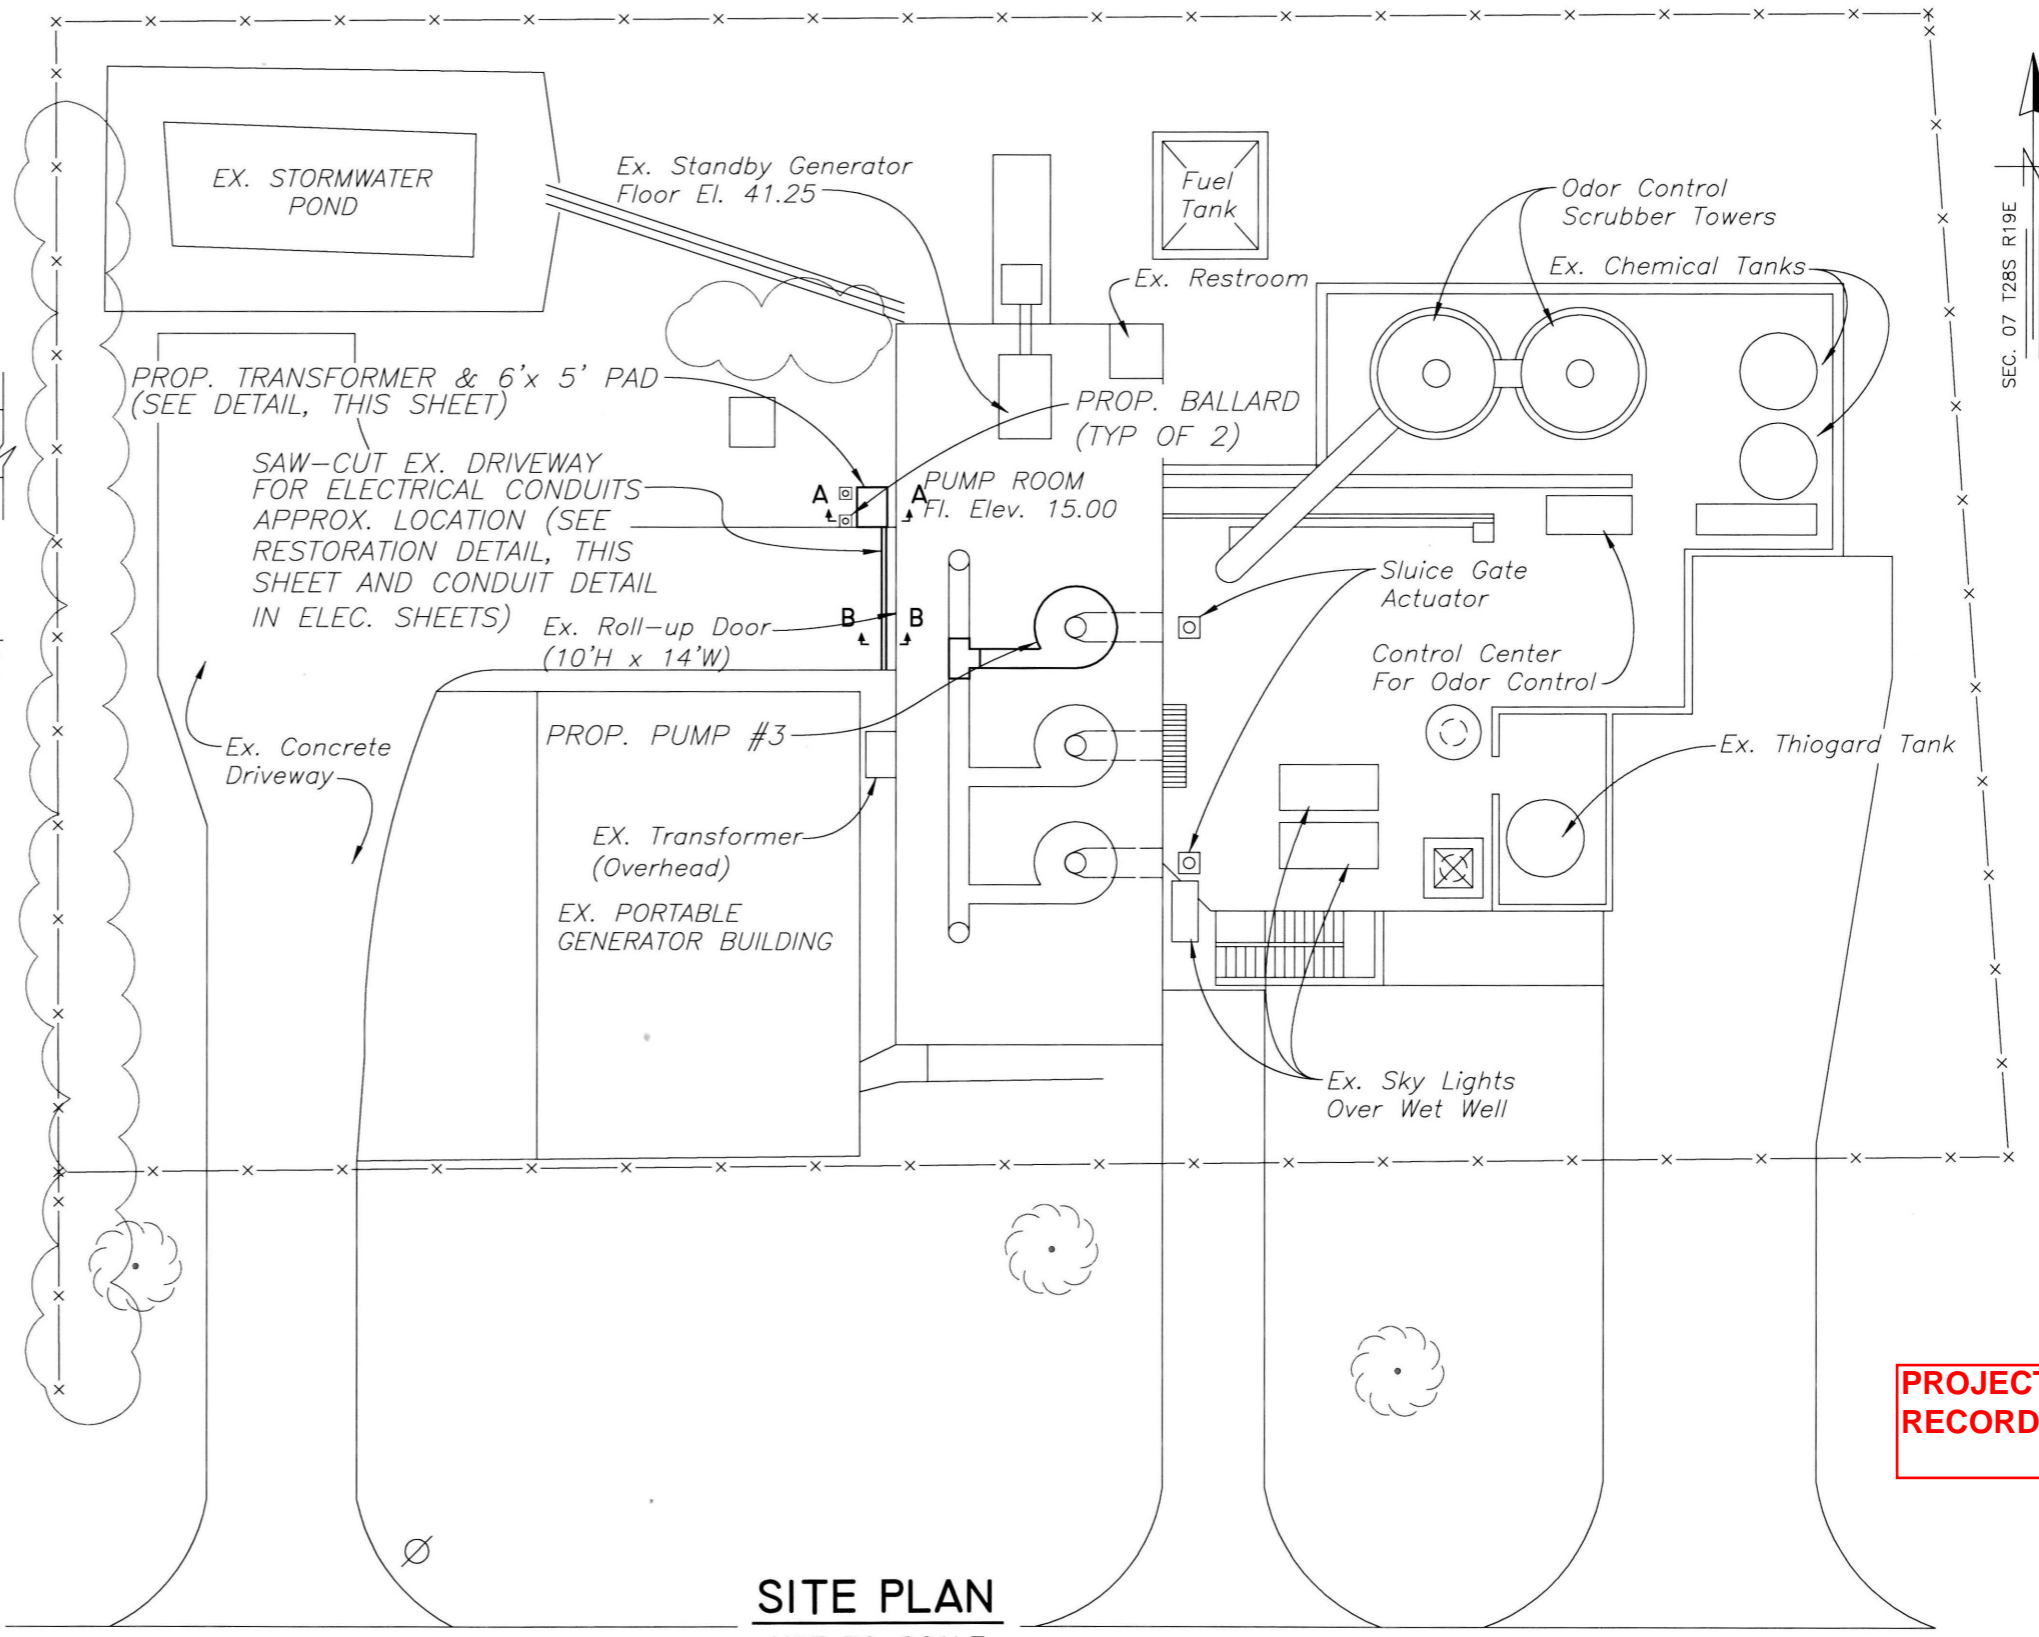

SITE PLAN
NOT TO SCALE

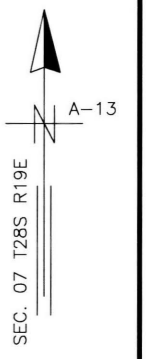

PROJECT RECORD

User: SS1F Drawing Name: C:\Program Files\AutoCAD Civil 3D 2010\DWG files\PS\University Pumping Station\4511 -Sheets 3-16.dwg Layout: Feb 16, 2011 - 3:58pm

JACINTO CARLOS FERRAS, P.E. #49454
DESIGN DIVISION HEAD
WASTEWATER DEPARTMENT

No.	DATE	REVISIONS
3		
2		
1		

DES: D.R.
DRN: *BB*
CKD: *JF*
DATE: 2/17/11

CITY of TAMPA
WASTEWATER DEPARTMENT

**UNIVERSITY PUMPING STATION
REHABILITATION
SITE PLAN AND TRANSFORMER PAD DETAIL**

W.O. 4511
SHEET
3

NOTES

GENERAL

- G-1. CONTRACTOR SHALL COORDINATE ALL CONSTRUCTION ACTIVITIES WITH DEPARTMENT PERSONNEL AND PUMPING STATION OPERATIONS.
- G-2. EXISTING DIMENSIONS AND ELEVATIONS ARE BASED ON THE BEST INFORMATION AVAILABLE. TRUE DIMENSIONS AND ELEVATIONS SHALL BE DETERMINED IN THE FIELD PRIOR TO LAYOUT AND SHOP DRAWING SUBMITTALS.
- G-3. ALL SUBMITTALS AND SHOP DRAWINGS SHALL BE ORIGINALS OR HIGH QUALITY COPIES (EASILY READABLE). NO FAXED SHEETS OR POOR QUALITY COPIES WILL BE ACCEPTED FOR SUBMITTAL REVIEW.
- G-4. REPLACEMENT OF EXPANSION JOINT AT ELEV. 30.00 SHALL OCCUR BEFORE ANY WORK ASSOCIATED WITH PUMP #3 REPLACEMENT.
- G-5. PRIOR TO PUMP #3 DEMOLITION, CITY FORCES WILL CLOSE THE 42" SLUICE GATE IN THE WET WELL AND THE NECESSARY PLUG VALVES INSIDE THE PUMPING STATION TO ISOLATE PUMP #3. THE CITY REQUIRES A MIN. 1 WEEK ADVANCE NOTICE FOR THIS WORK.
- G-6. MECHANICAL AND ELECTRICAL EQUIPMENT TO BE LOCKED OUT SHALL BE LOCKED OUT WITH A MULTIPLE-LOCK MASTER LOCK-OUT DEVICE, WHICH SHALL BE INSTALLED BY CITY PERSONNEL AND LOCKED BY BOTH THE CITY PERSONNEL AND THE CONTRACTOR.
- G-7. THE CONTRACTOR IS RESPONSIBLE FOR PROVIDING, INSTALLING, LEVELING AND ALIGNING MOTOR AND PUMP. PROCEDURES FOR INSTALLATION, AS OUTLINED IN THE HYDRAULIC INSTITUTE STANDARDS, MOST CURRENT EDITION, SHALL BE ADHERED TO. SEE SPECIFIC PROVISION SP-80. IF CONFLICT BETWEEN THE SPECS AND THE H.I.S. PROCEDURE ARISE, THE MOST STRINGENT STANDARD SHALL BE FOLLOWED.
- G-8. PROPOSED PUMP SHALL BE A 350 HORSEPOWER, 24-INCH, 600 RPM FAIRBANKS MORSE VERTICAL CLOSE-COUPLED ANGLEFLOW PUMP MODEL#C5741. PUMP SHALL BE RATED FOR 29.1 MGD @ 51.1 FEET TDH. SEE SPECIFICATIONS FOR MOTOR INFORMATION.
- G-9. PROPOSED KNIFE GATE VALVE SHALL BE A 24" L&M MODEL 24M145C100-BG4-X PERFORMANCE PLUS KNIFE GATE VALVE, AS MADE BY TYCO VALVE AND CONTROLS.
- G-10. PUMP-CHECK VALVE SHALL BE A 30" DEZURIK PEF, ECCENTRIC PLUG VALVE AND SHALL BE PROVIDED WITH A REMOTELY OPERATED PNEUMATIC ACTUATOR THAT SHALL BE PROPERLY SIZED FOR THE EXISTING PUMPING STATION COMPRESSED AIR SYSTEM.

- G-11. AIR SUPPLY FOR PNEUMATICALLY ACTUATED PUMP-CHECK VALVE SHALL BE FROM EXISTING STATION AIR. ARRANGEMENT OF PIPING AND CONNECTIONS TO EXISTING PIPES SHALL BE MADE BY THE CONTRACTOR UNDER THE DIRECTION OF THE ENGINEER.
- G-12. ANCHOR BOLTS SHALL BE AS PER PUMP MANUFACTURER'S RECOMMENDATIONS. ANCHOR BOLTS SHALL BE DOUBLE-NUTTED AND FINISHED WITH NON-SHRINK GROUT. ALL BOLTS SHALL EXTEND BEYOND THE FASTENING NUTS BY A MINIMUM OF 1/2-INCH.
- G-13. ALL HARDWARE, UNLESS OTHERWISE NOTED, SHALL BE TYPE 316 STAINLESS STEEL.
- G-14. 36"x30"x30" REDUCING TEE SHALL BE FABRICATED TO SUIT THE DIMENSIONS OF THE PROPOSED EQUIPMENT AND SHALL BE A36-STEEL WITH A 150 PSI RATING. STEEL FITTINGS SHALL BE MANUFACTURED BY AN AWWA CERTIFIED FABRICATOR.
- G-15. ALL CEMENTITIOUS CONCRETE AND GROUT, UNLESS OTHERWISE SPECIFIED, SHALL BE CLASS "B" 4000 PSI COMPRESSIVE STRENGTH AT 28 DAYS.
- G-16. EXPOSED CONCRETE CORNERS SHALL HAVE A 3/4" CHAMFER AND RE-ENTRANT CORNERS SHALL HAVE A 3/4" FLAT FILLET UNLESS OTHERWISE NOTED.
- G-17. CONCRETE PEDESTAL SHOP DRAWINGS INCLUDING FLANGE SUPPORT DETAILS SHALL BE SUBMITTED FOR APPROVAL.
- G-18. ALL STEEL REINFORCING SHALL BE DETAILED ACCORDING TO THE LATEST "ACI MANUAL OF STANDARD PRACTICE FOR DETAILING REINFORCED CONCRETE STRUCTURES". ACTUAL PLACEMENT OF STEEL REINFORCING SHALL BE SHOWN ON SHOP DRAWINGS. ALL LAPS AND SPLICES SHALL BE AT LEAST 32 BAR DIAMETERS OR 24 INCHES.
- G-19. CERTAIN PORTIONS OF THIS PROJECT MAY REQUIRE NIGHT TIME WORK.
- G-20. ALL NOTES PERTAINING TO PROPOSED WORK INSIDE SCREEN ROOM ARE LOCATED ON PERTINENT SHEETS.

DEMOLITION NOTES

- D-1. ALL DIMENSIONS ARE APPROXIMATE. TRUE DIMENSIONS SHALL BE DETERMINED IN THE FIELD.
- D-2. SALVAGEABLE MATERIAL AS DETERMINED BY DEPARTMENT PERSONNEL SHALL BE DELIVERED TO THE CITY OF TAMPA'S HOWARD F. CURREN AWTP AT 2700 MARITIME BOULEVARD. NON-SALVAGEABLE MATERIALS ARE TO BE REMOVED FROM THE SITE AND PROPERLY DISPOSED OF AT THE CONTRACTOR'S EXPENSE. IN GENERAL, ALL PUMP AND CONTROLS EQUIPMENT SHALL REMAIN PROPERTY OF THE CITY AND SHALL BE DELIVERED TO THE TREATMENT PLANT.
- D-3. ALL ALUMINUM FRAMES AND PLATFORMS ON PUMP No. 3 SHALL BE SALVAGED AND DELIVERED TO THE TREATMENT PLANT.
- D-4. THE PUMP STATION SITE SHALL BE MAINTAINED IN AS NEAT AND ORDERLY CONDITION AS POSSIBLE DURING CONSTRUCTION OPERATIONS. WALKWAYS AND DRIVEWAYS SHALL BE KEPT CLEAR FOR DEPARTMENT PERSONNEL TO PASS THROUGH.
- D-5. CONTRACTOR SHALL CUT ALL EXPOSED REINFORCING STEEL TO A DEPTH OF 1-INCH BELOW THE EXPOSED SURFACE AND GROUT OVER.
- D-6. CONTRACTOR SHALL SUBMIT A PLAN FOR APPROVAL THAT WILL PREVENT THE EXPANSION JOINTS IN THE 30"-36" DISCHARGE HEADER FROM EXPANDING AFTER THE EXISTING 30"x30"x30' TEE HAS BEEN REMOVED IN THE PUMP ROOM.




"POSSIBLE" CONSTRUCTION SEQUENCE *

- S-1. CITY FORCES EXERCISE VALVES TO ISOLATE 24" TIED EXPANSION JOINT AT EL. 30.00
- S-2. REPLACE 24" TIED EXPANSION JOINT.
- S-3. CITY FORCES CLOSE 42" SLUICE GATE IN WET WELL AND EXERCISE VALVES INSIDE PUMPING STATION TO ISOLATE PUMP #3.
- S-4. PROCEED WITH DEMOLITION AND INSTALL 24" KNIFE GATE VALVE AS SOON AS POSSIBLE.
- S-5. INSTALL PROPOSED PUMP #3, PUMP CHECK VALVE, PIPE AND FITTING (INCLUDING ELECTRICAL WORK).
- S-6. PERFORM REQUIRED TESTS ON PROPOSED PUMPING EQUIPMENT.
- S-7. PERFORM TRAINING, COMPLETE PUNCHLIST ITEMS.

* DOES NOT INCLUDE WORK IN SCREEN ROOM.

User: SS1F Drawing Name: C:\Program Files\AutoCAD Civil 3D 2010\DWG files\PS\University Pumping Station\4511 -Sheets_3-16.dwg Layout- Feb 16, 2011 - 3:59pm

JACINTO CARLOS FERRAS, P.E. #49454 DESIGN DIVISION HEAD WASTEWATER DEPARTMENT	No.	DATE	REVISIONS	DES: D.R.	CITY of TAMPA WASTEWATER DEPARTMENT	UNIVERSITY PUMPING STATION REHABILITATION GENERAL NOTES	W.O. 4511
	3			DRN: BB			SHEET
	2			CKD: JF			4
	1			DATE: 2/17/11			

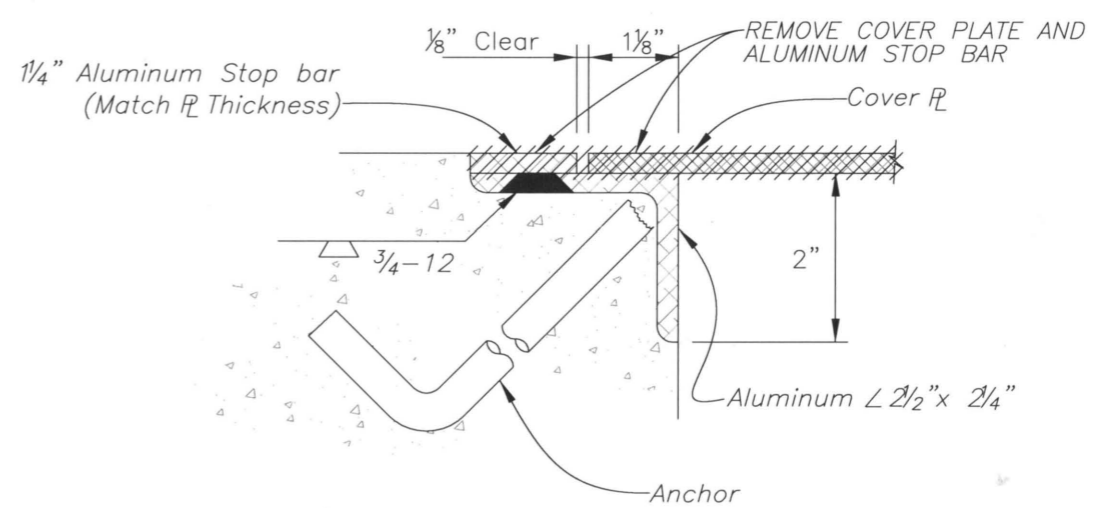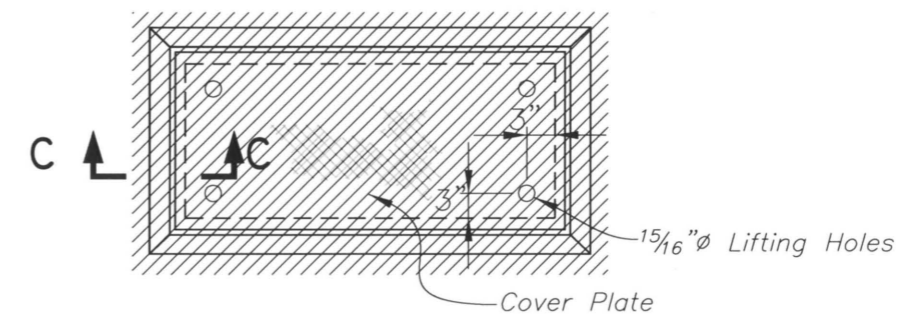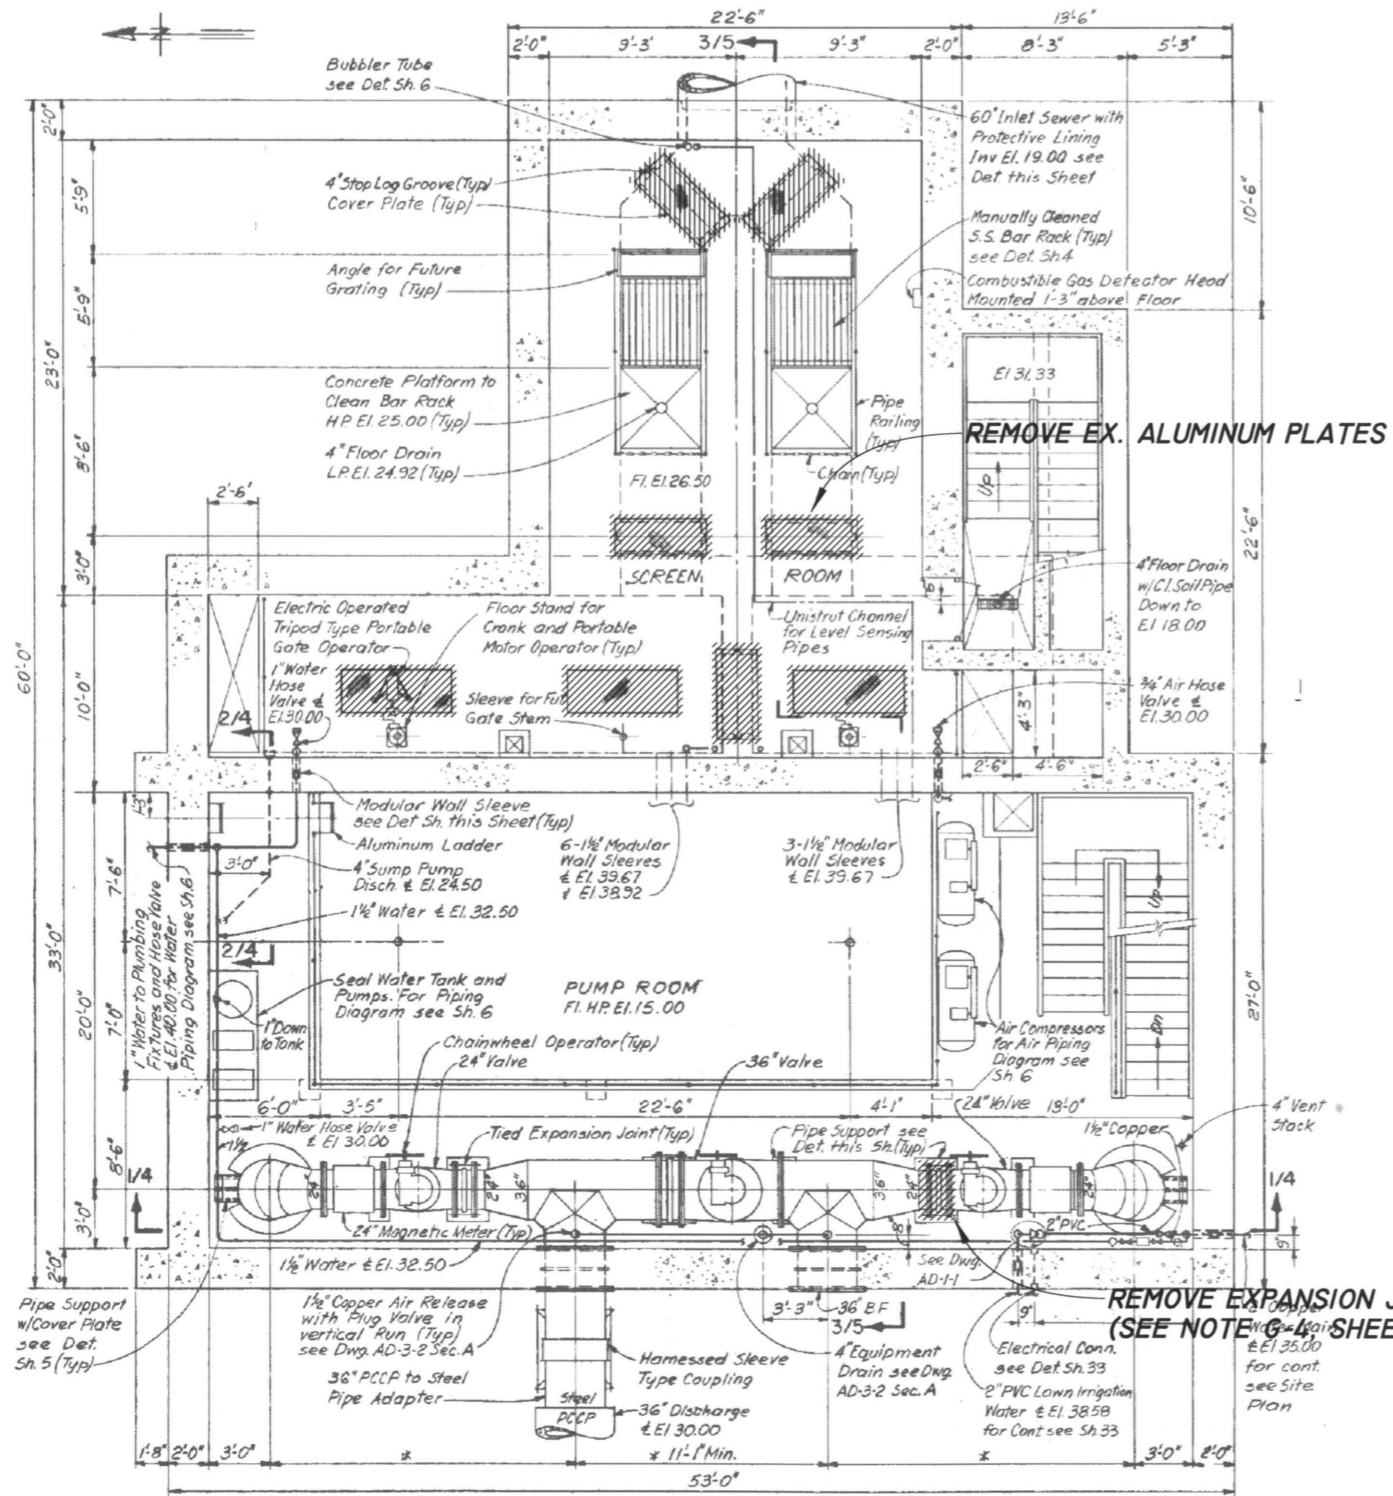

REMOVE EXPANSION JOINT
(SEE NOTE 4 SHEET 4)


ITEMS SHOWN HATCHED
ARE TO BE REMOVED

PROJECT
RECORD

User: SS1F Drawing Name: C:\Program Files\AutoCAD Civil 3D 2010\DWG files\PS\University Pumping Station\4511 -Sheets 3-16.dwg Layout: Mar 11, 2011 - 3:58pm

JACINTO CARLOS FERRAS, P.E. #49454 DESIGN DIVISION HEAD WASTEWATER DEPARTMENT	No.	DATE	REVISIONS	DES: D.R.	CITY of TAMPA WASTEWATER DEPARTMENT	UNIVERSITY PUMPING STATION REHABILITATION DEMOLITION PLAN AT ELEV. 26.50	W.O. 4511
	3			DRN: BB			SHEET
	2			CKD:			5
	1			DATE:			

REMOVE PUMP, VALVE, FITTINGS, EXPANSION JOINTS AND CONCRETE PEDESTALS

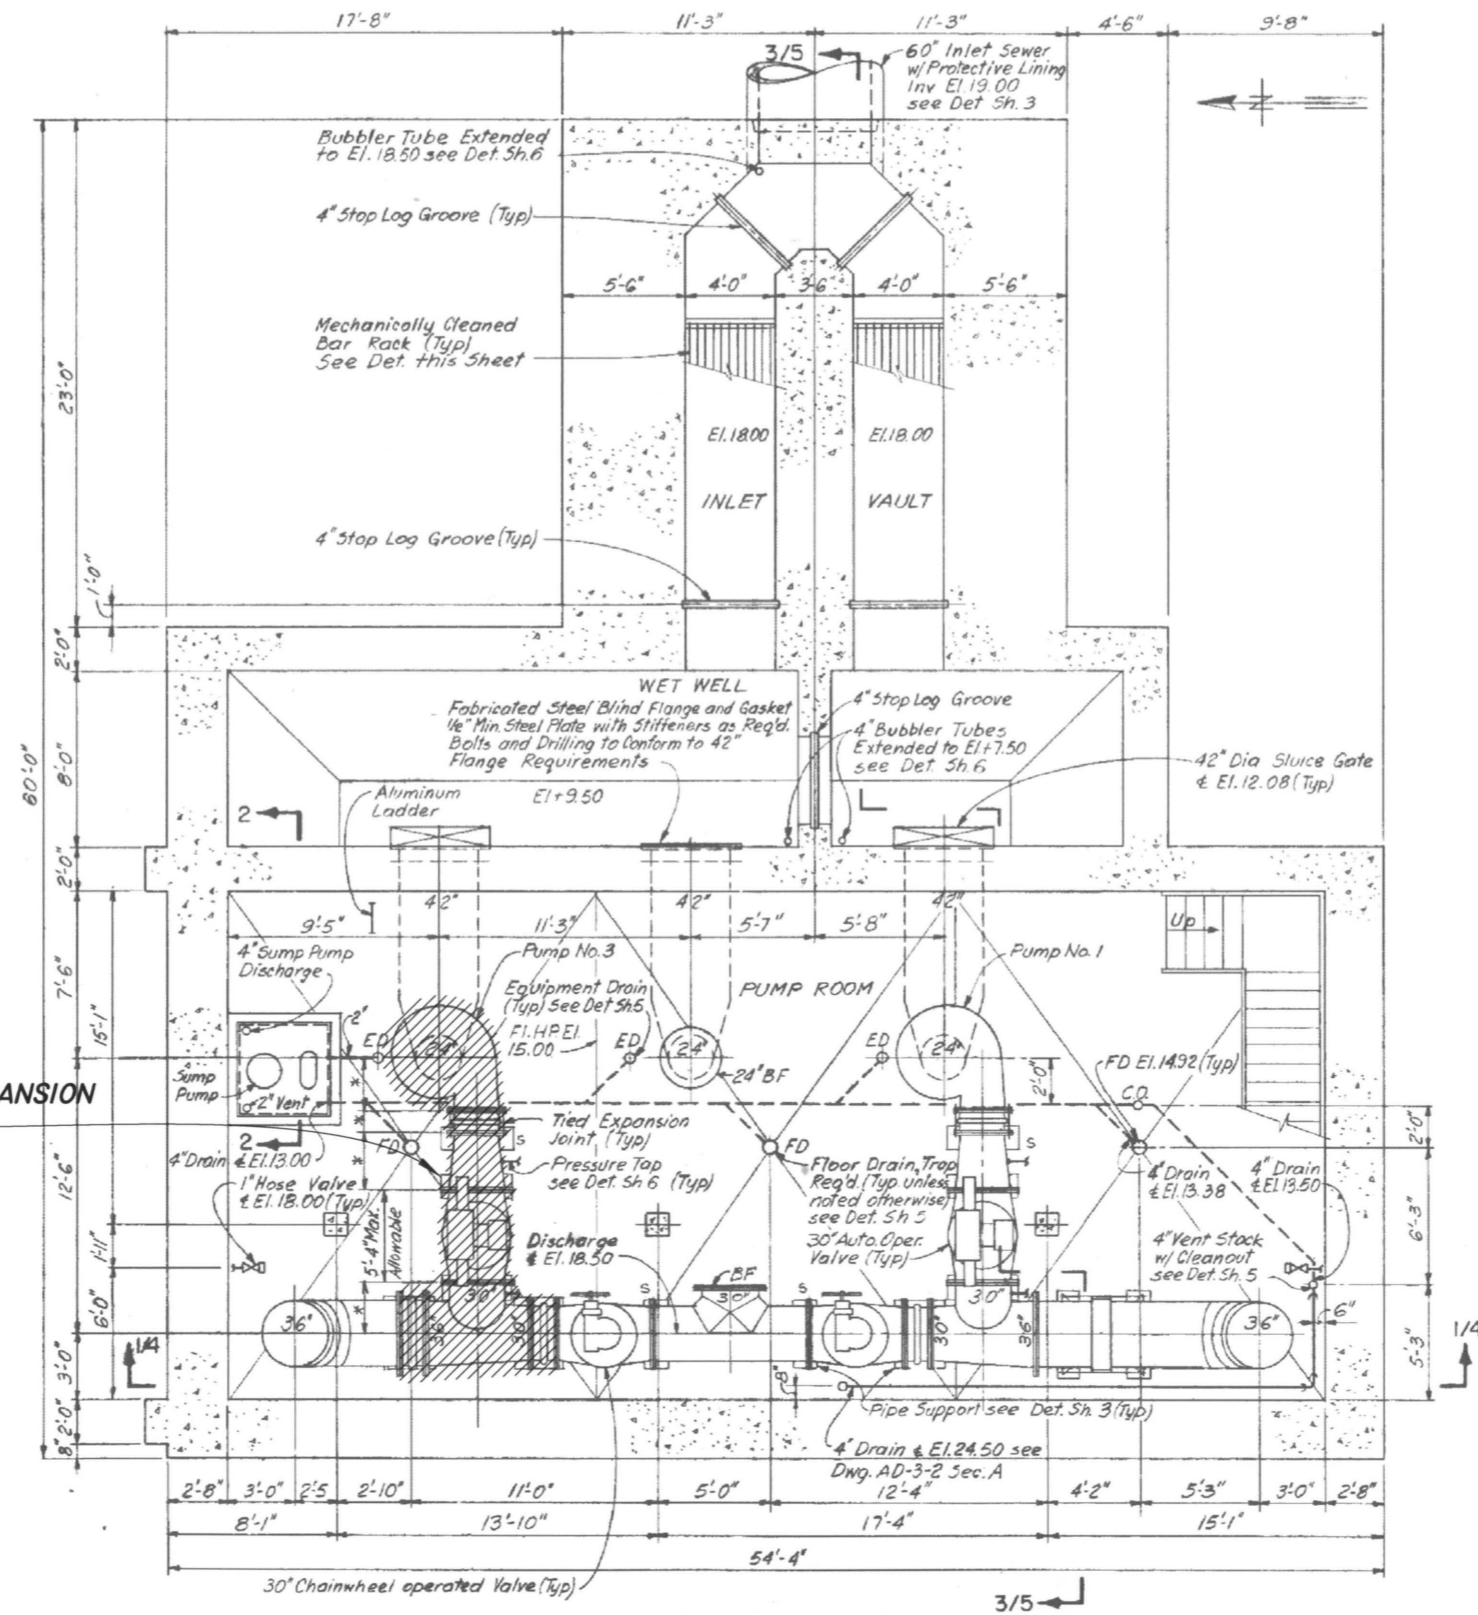

DEMOLITION PLAN AT EL. 15.00


NOT TO SCALE

ITEMS SHOWN HATCHED ARE TO BE REMOVED

PROJECT RECORD





User: SSIF Drawing Name: C:\Program Files\AutoCAD Civil 3D 2010\DWG files\PS\University Pumping Station\4511 -Sheets 3-16.dwg Layout: Mar 11, 2011 - 3:58pm

JACINTO CARLOS FERRAS, P.E. #49454 DESIGN DIVISION HEAD WASTEWATER DEPARTMENT	No.	DATE	REVISIONS	DES: D.R.	CITY of TAMPA WASTEWATER DEPARTMENT	UNIVERSITY PUMPING STATION REHABILITATION DEMOLITION PLAN AT ELEV. 15.00	W.O. 4511
	3			DRN: BB			SHEET
	2			CKD:			6
	1			DATE:			

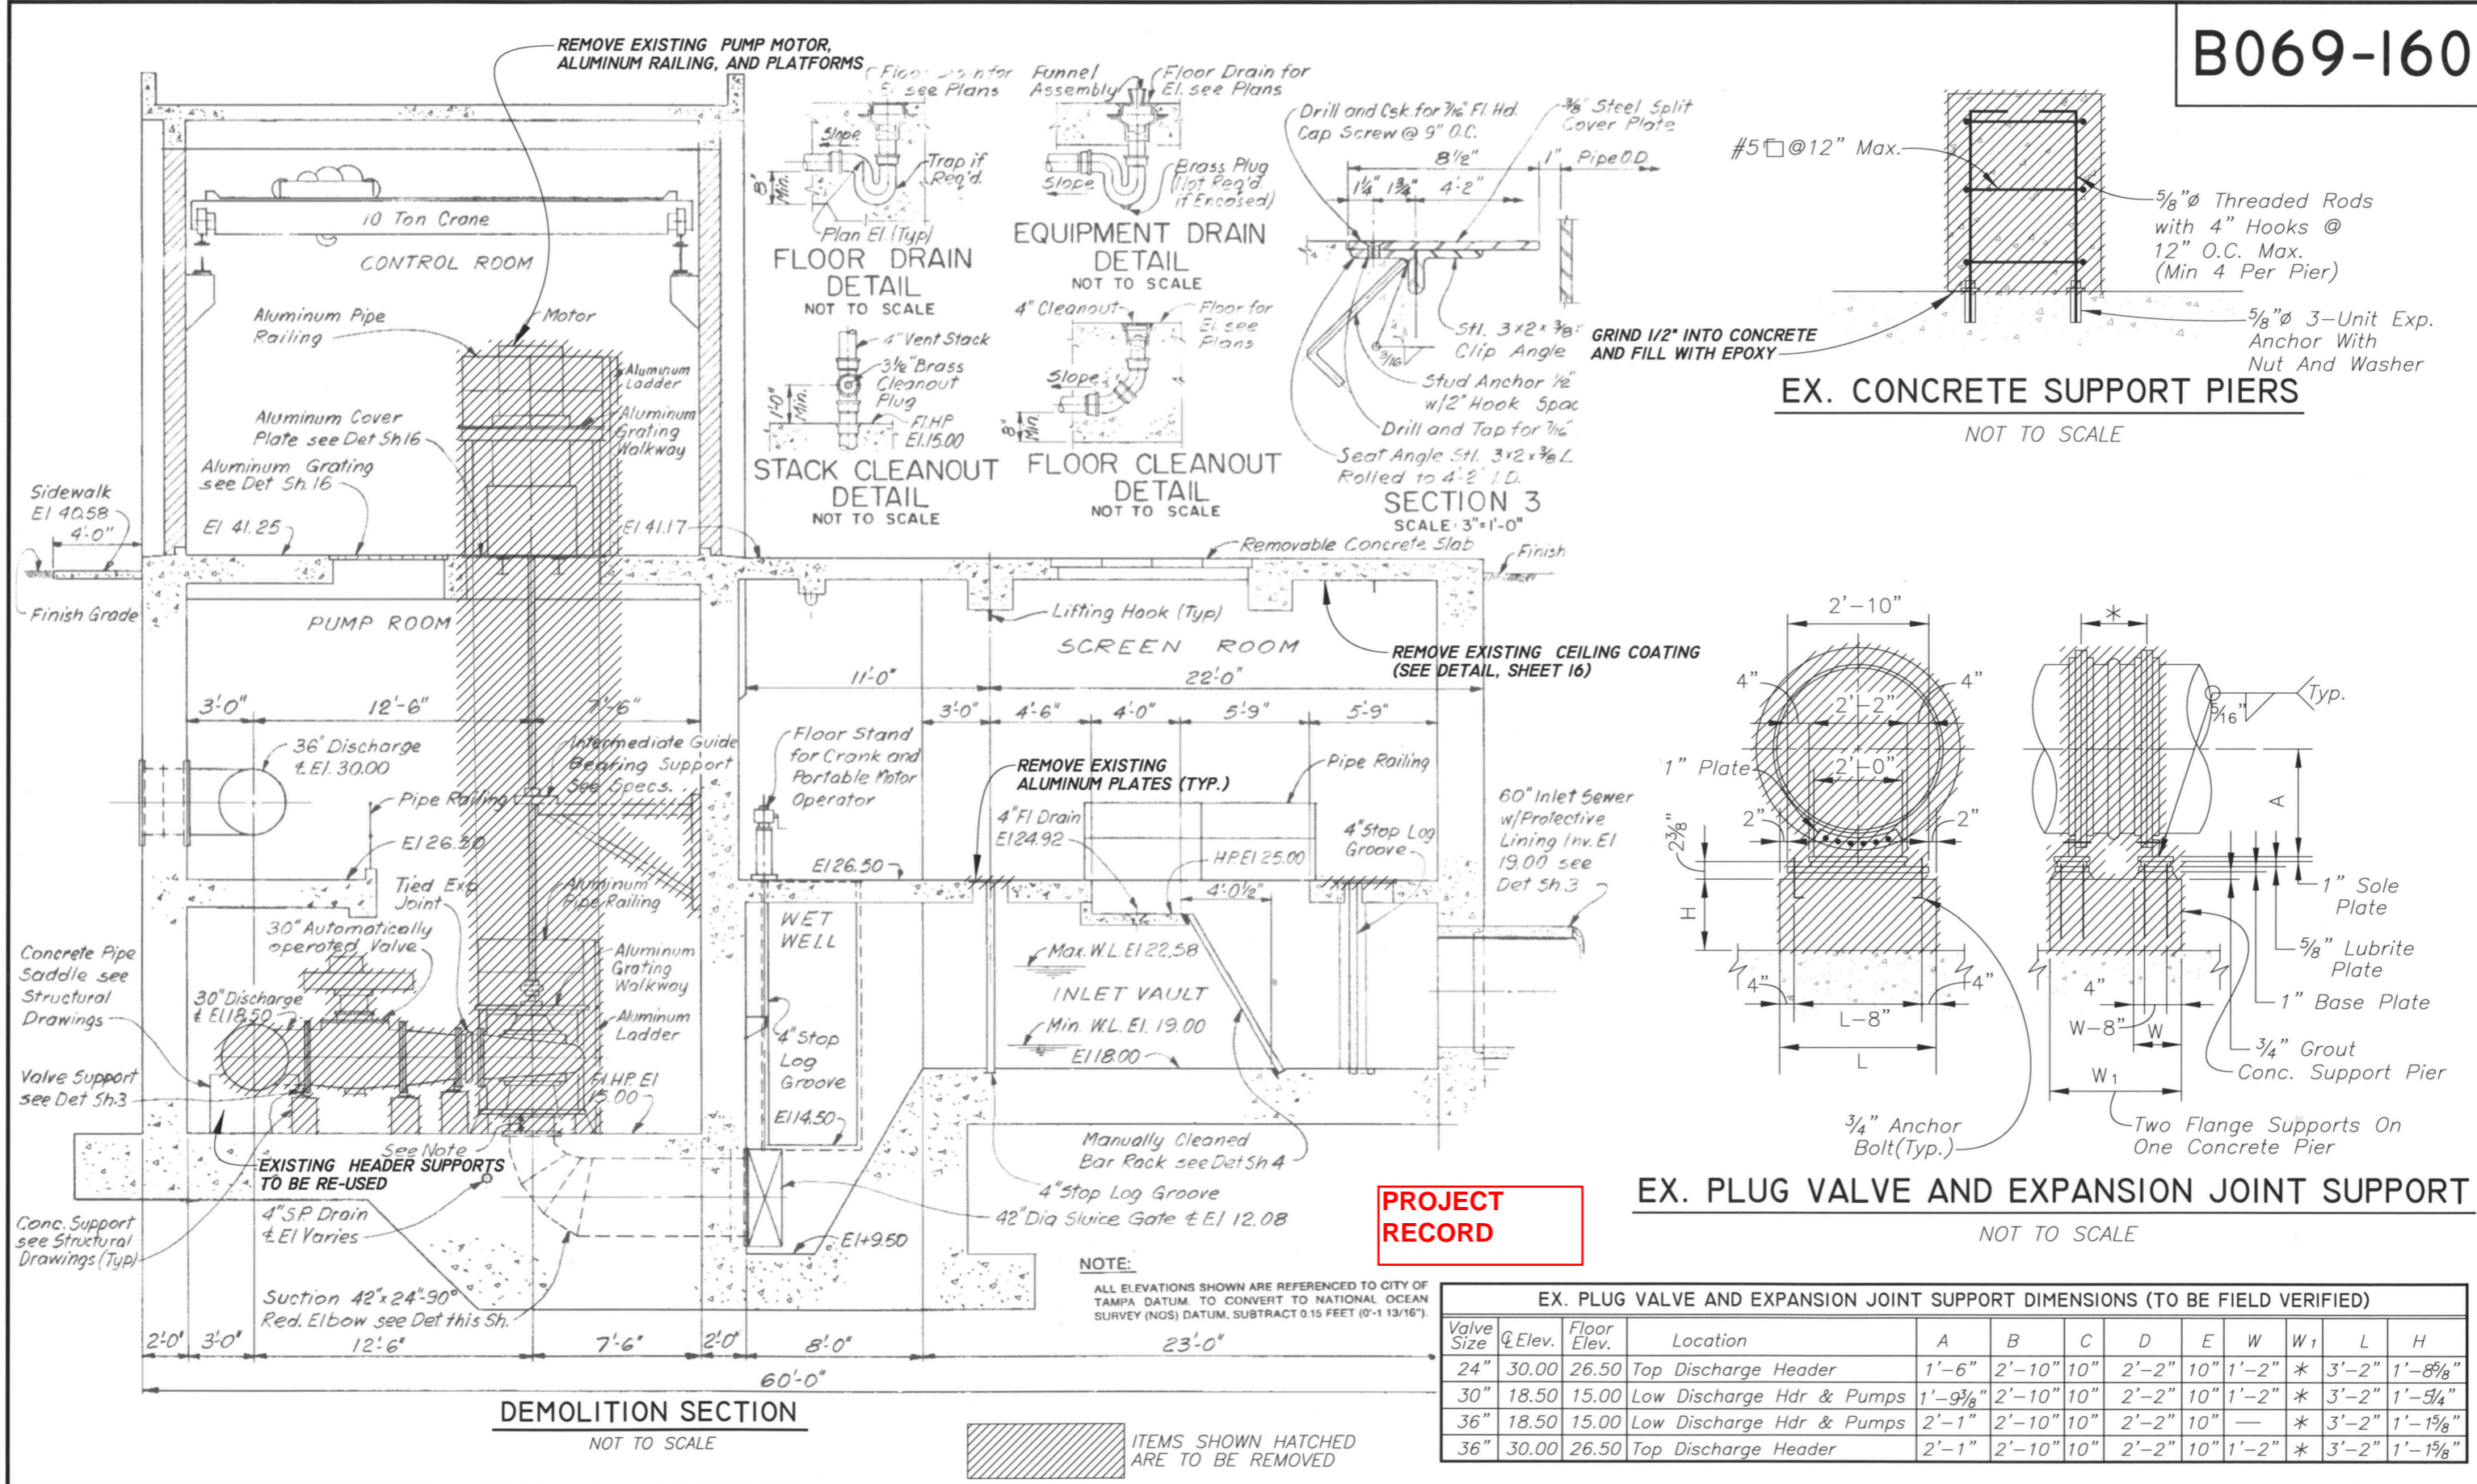

User: SS1F Drawing Name: C:\Program Files\AutoCAD Civil 3D 2010\DMC files\PS\University Pumping Station\4511 - Sheets 3-16.dwg Layout: Mar 11, 2011 3:58pm

B069-160

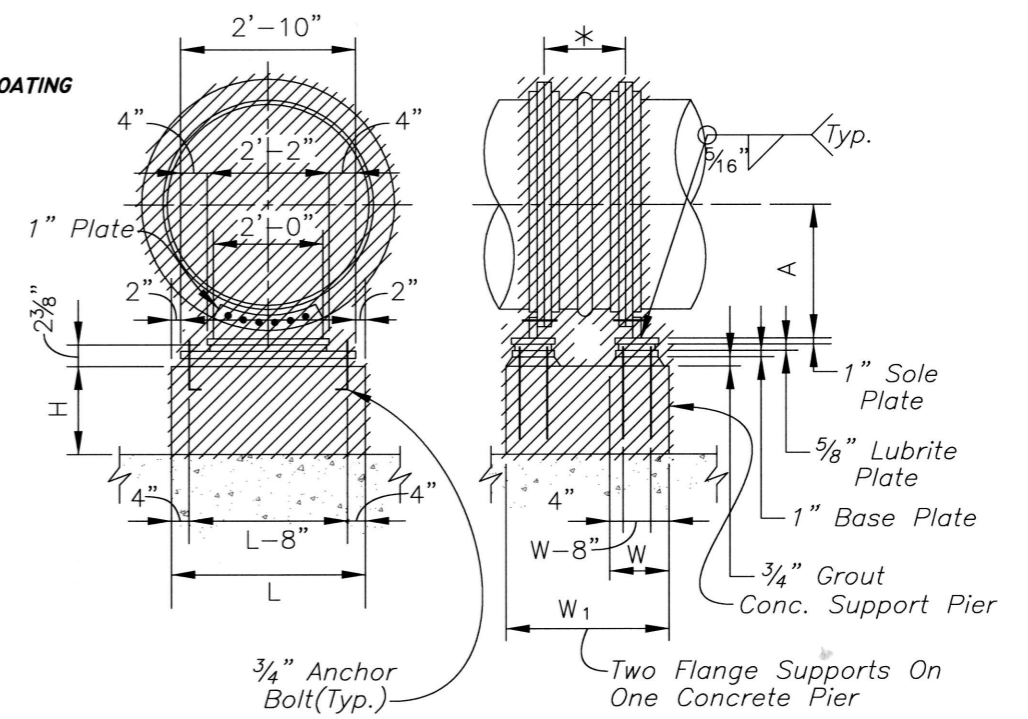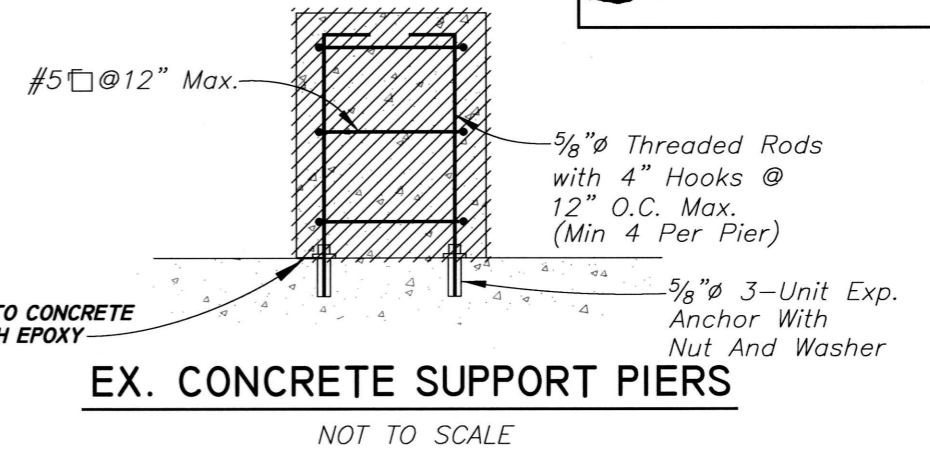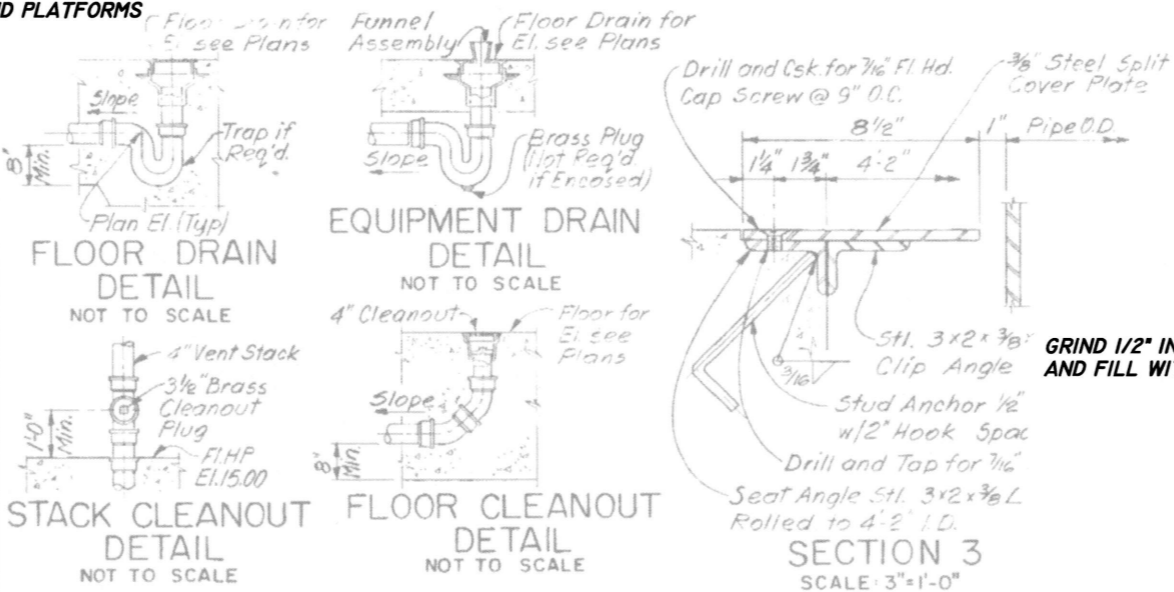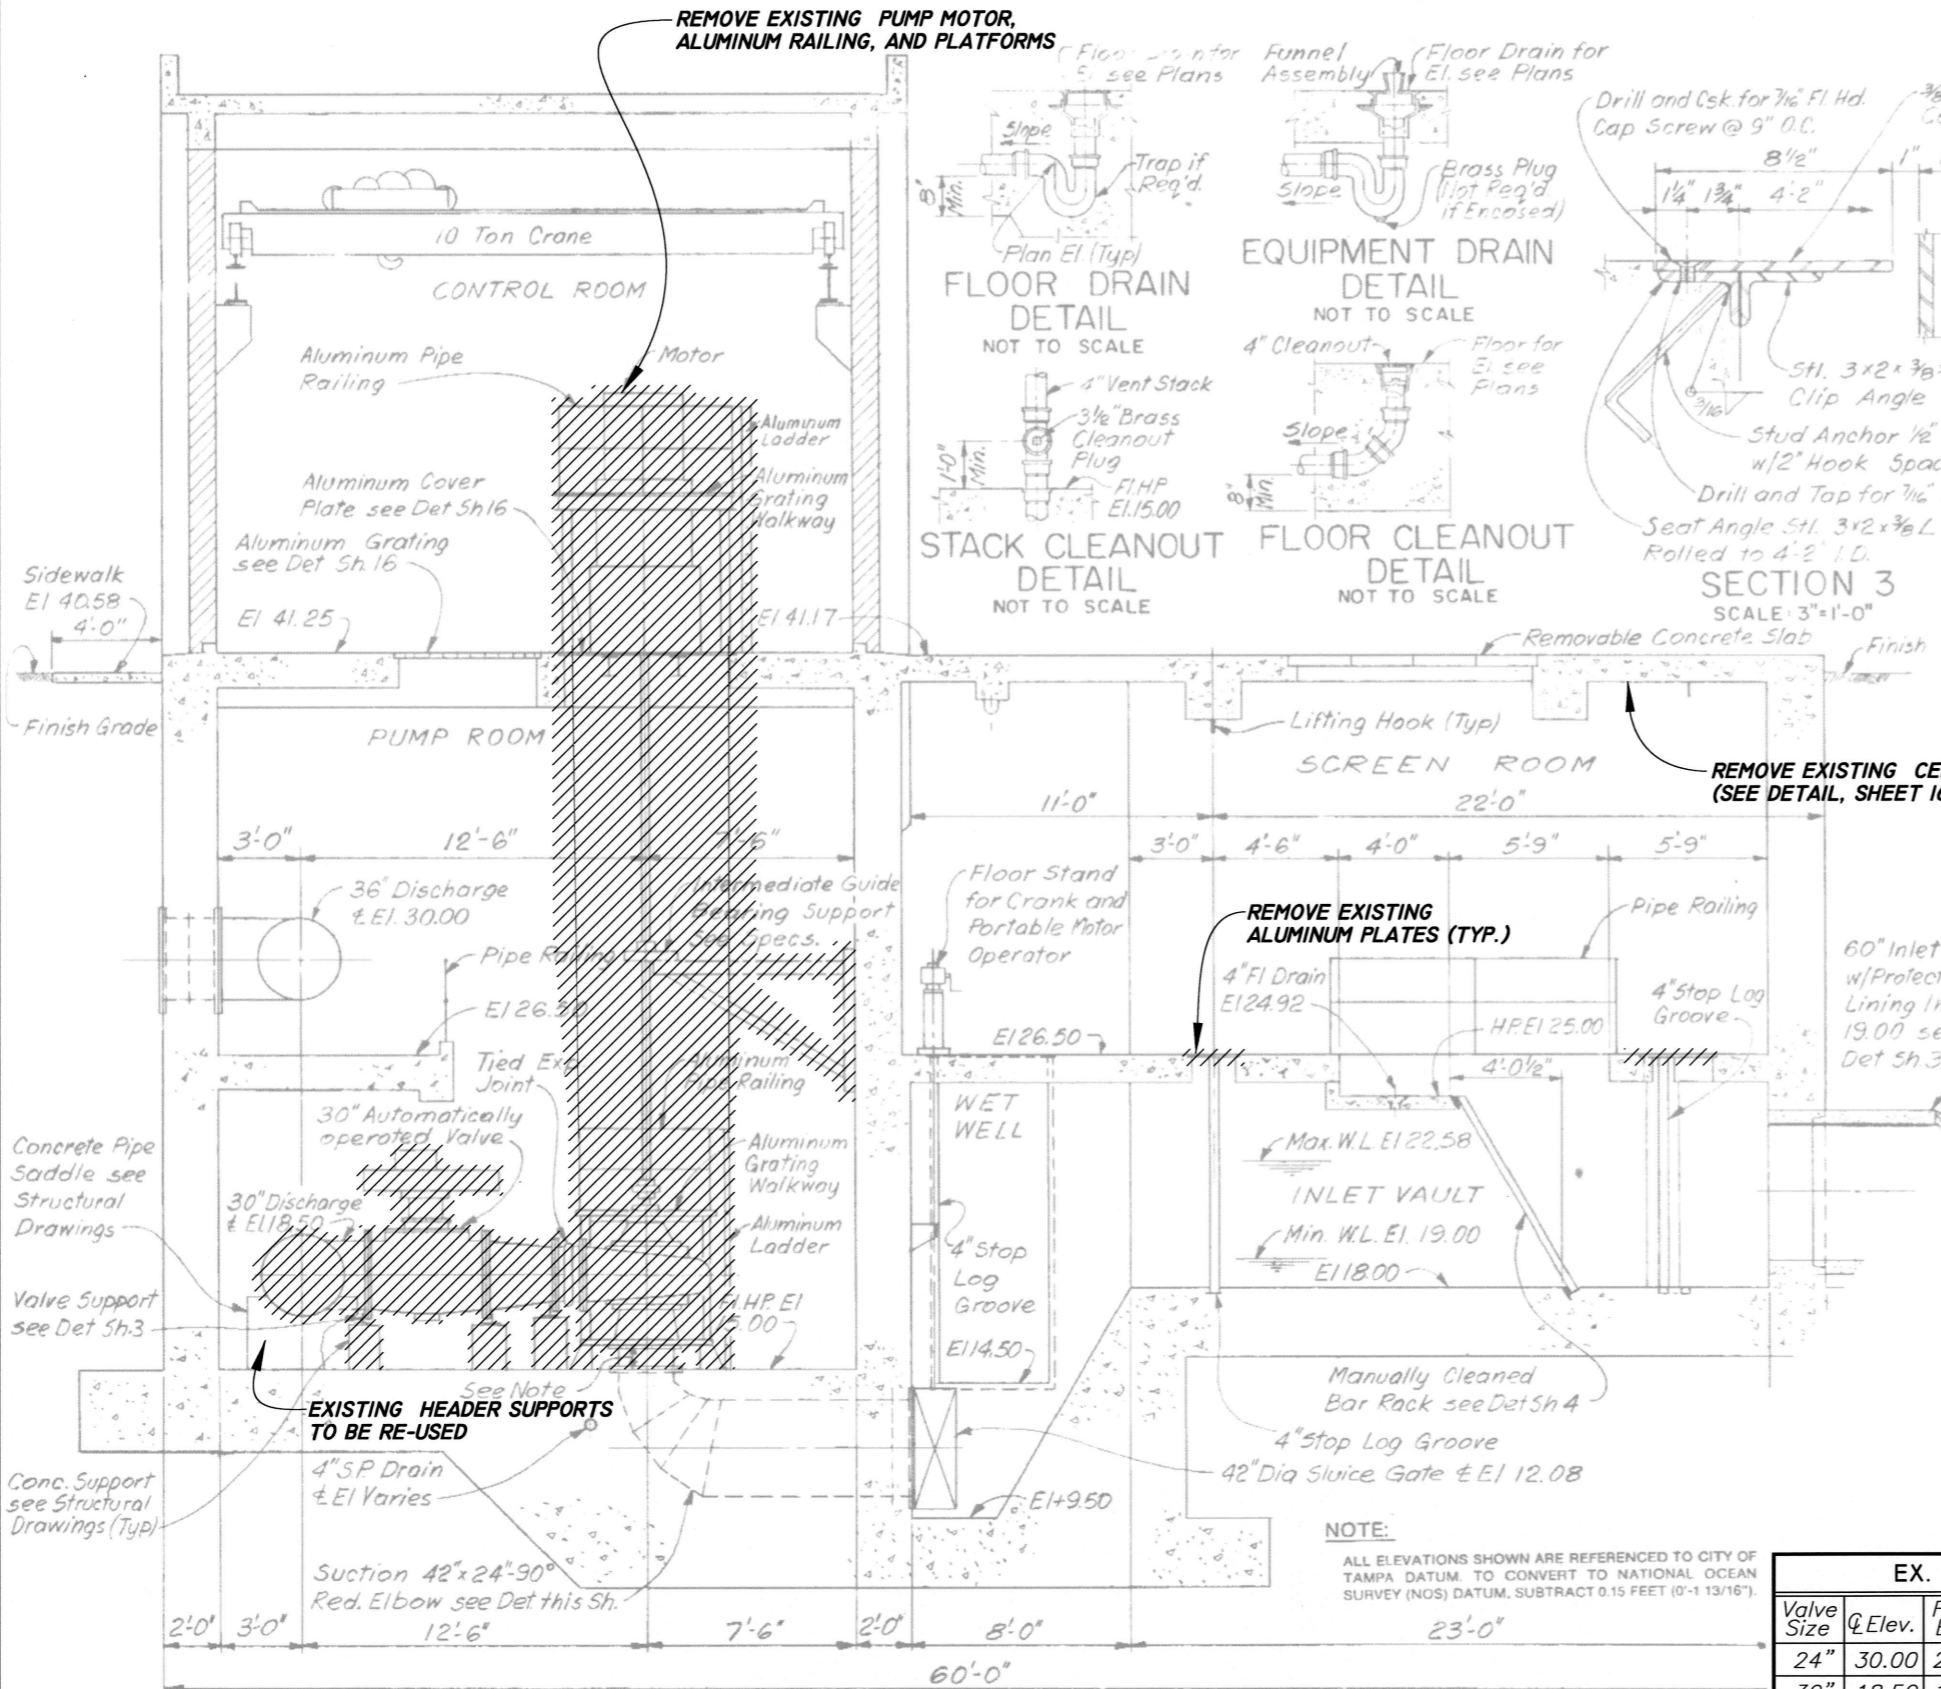

NOTE:
ALL ELEVATIONS SHOWN ARE REFERENCED TO CITY OF TAMPA DATUM. TO CONVERT TO NATIONAL OCEAN SURVEY (NOS) DATUM, SUBTRACT 0.15 FEET (0'-1 13/16").

EX. PLUG VALVE AND EXPANSION JOINT SUPPORT DIMENSIONS (TO BE FIELD VERIFIED)

Valve Size	Q Elev.	Floor Elev.	Location	A	B	C	D	E	W	W ₁	L	H
24"	30.00	26.50	Top Discharge Header	1'-6"	2'-10"	10"	2'-2"	10"	1'-2"	*	3'-2"	1'-8 5/8"
30"	18.50	15.00	Low Discharge Hdr & Pumps	1'-9 3/8"	2'-10"	10"	2'-2"	10"	1'-2"	*	3'-2"	1'-5 1/4"
36"	18.50	15.00	Low Discharge Hdr & Pumps	2'-1"	2'-10"	10"	2'-2"	10"	—	*	3'-2"	1'-1 5/8"
36"	30.00	26.50	Top Discharge Header	2'-1"	2'-10"	10"	2'-2"	10"	1'-2"	*	3'-2"	1'-1 5/8"

User: SS1F Drawing Name: C:\Program Files\AutoCAD Civil 3D 2010\DWG files\PS\University Pumping Station\4511 -Sheets 3-16.dwg Layout: Feb 17, 2011 - 11:01am

JACINTO CARLOS FERRAS, P.E. #49454
DESIGN DIVISION HEAD
WASTEWATER DEPARTMENT


No.	DATE	REVISIONS
3		
2		
1		

DES: D.R.
DRN: BB
CKD: JF
DATE: 2/17/11

CITY of TAMPA
WASTEWATER DEPARTMENT

UNIVERSITY PUMPING STATION
REHABILITATION
DEMOLITION SECTION

W.O. 4511
SHEET
7

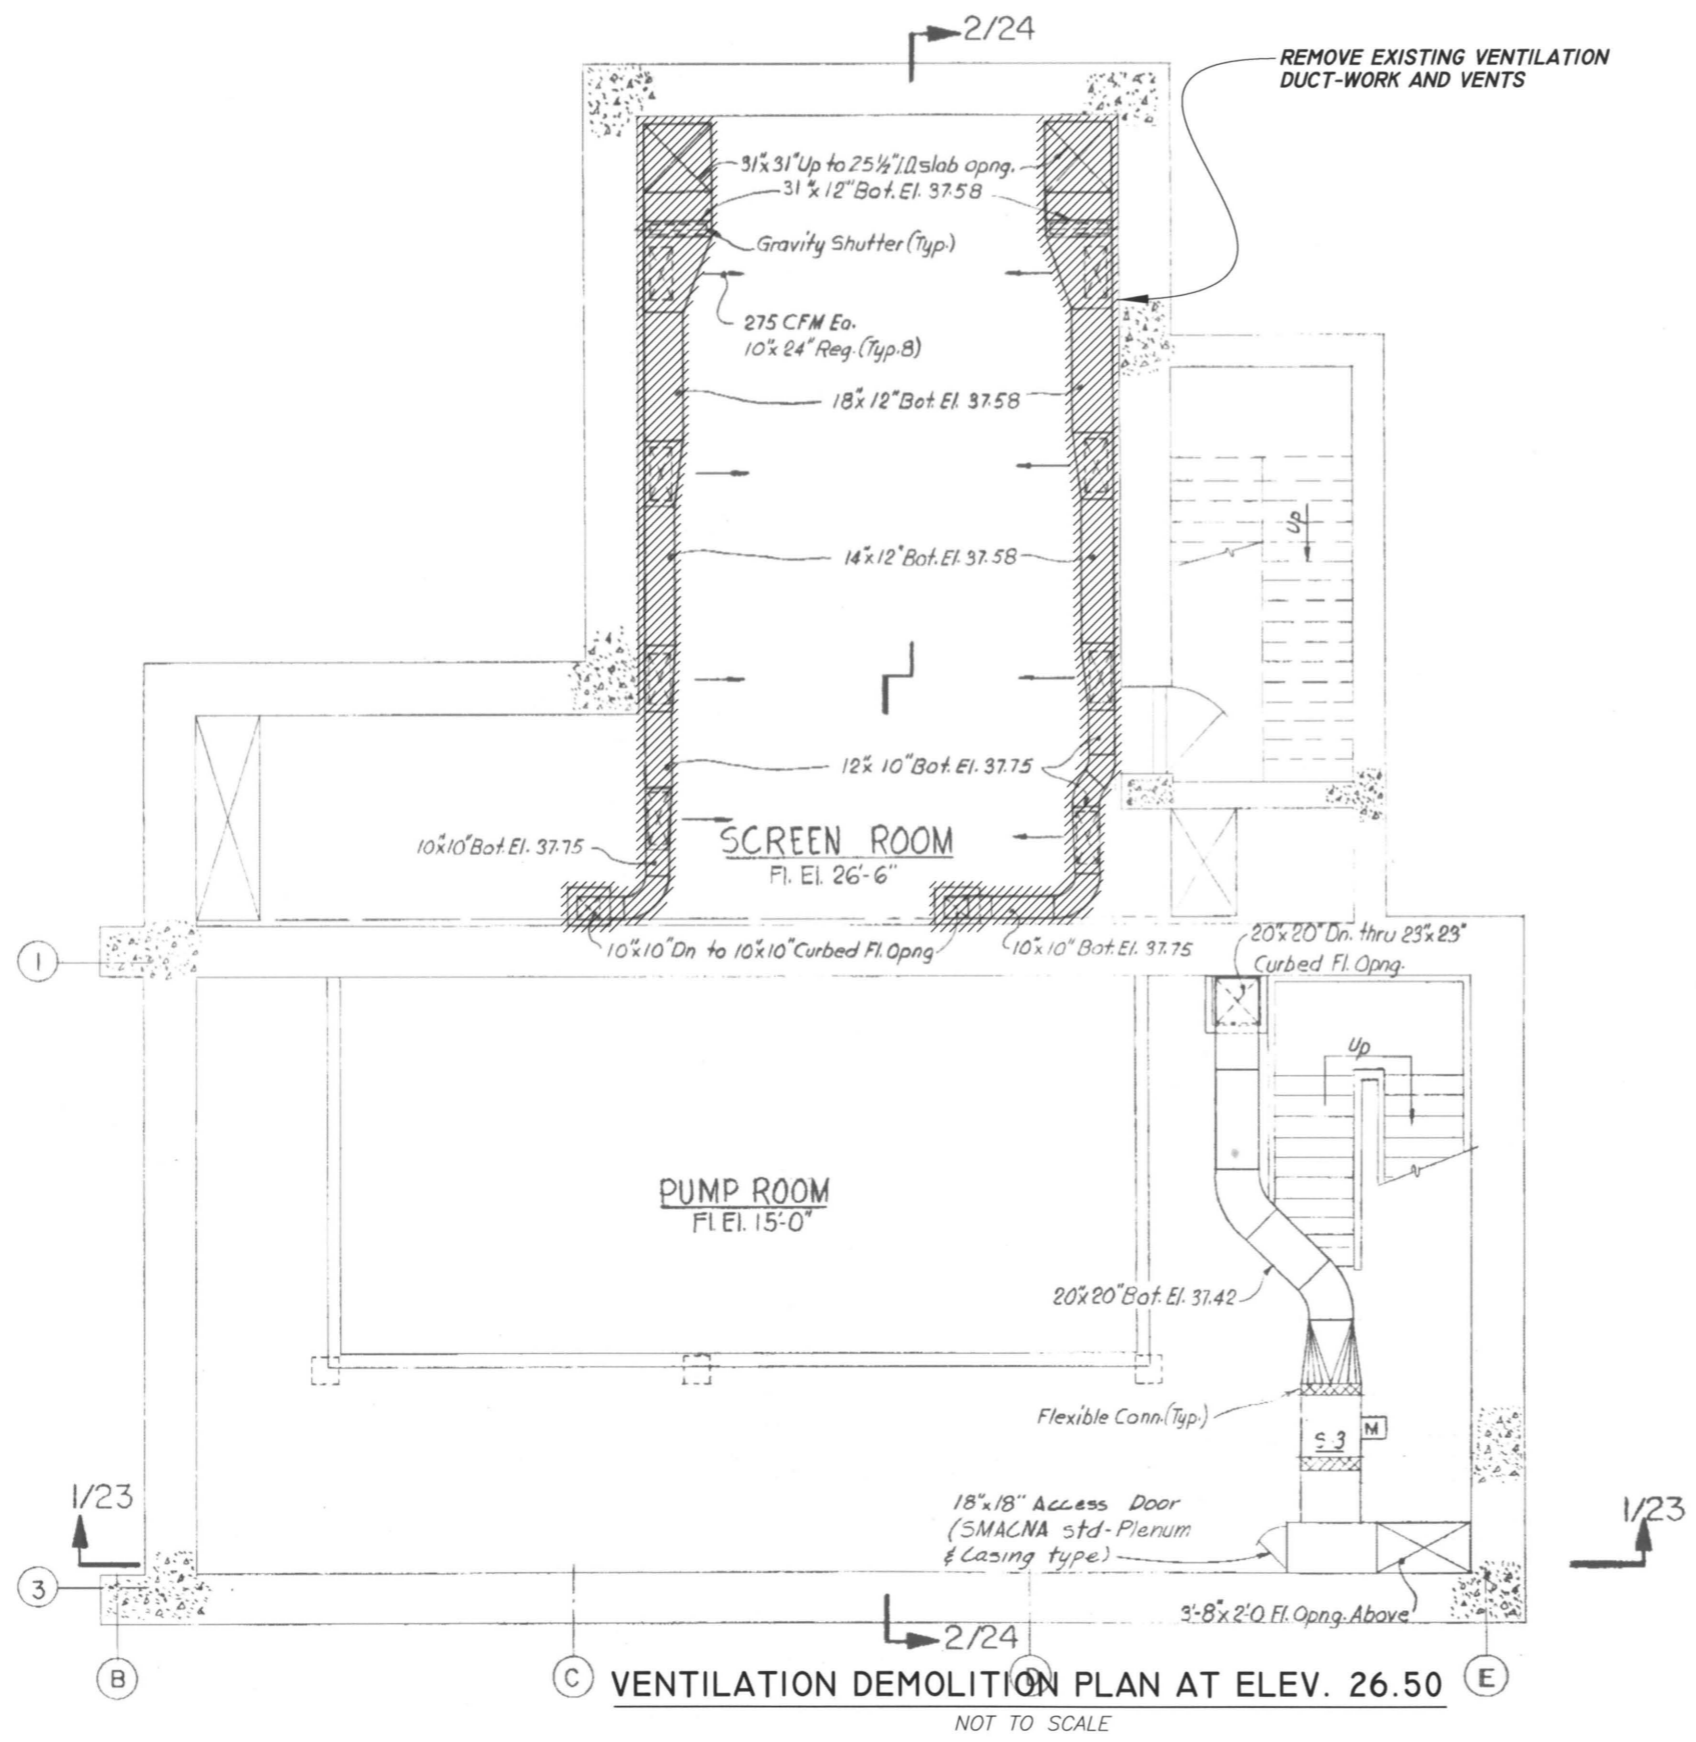

PROJECT RECORD


ITEMS SHOWN HATCHED ARE TO BE REMOVED

VENTILATION DEMOLITION PLAN AT ELEV. 26.50

NOT TO SCALE


User: SSIF Drawing Name: C:\Program Files\AutoCAD Civil 3D 2010\DWG files\PS\University Pumping Station\4511 - Sheets 3-16.dwg Layout- Mar 11, 2011 - 3:58pm

JACINTO CARLOS FERRAS, P.E. #49454 DESIGN DIVISION HEAD WASTEWATER DEPARTMENT	No.	DATE	REVISIONS	DES: D.R.	CITY of TAMPA WASTEWATER DEPARTMENT	UNIVERSITY PUMPING STATION REHABILITATION VENTILATION DEMOLITION PLAN AT ELEV. 26.50	W.O. 4511
	3			DRN: BB			SHEET
	2			CKD:			8
	1			DATE:			

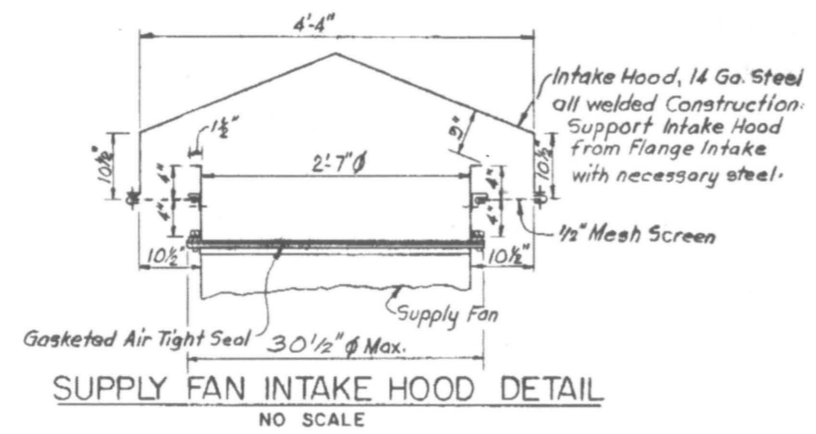

NOTE:

1. All welds ground for smooth finish.

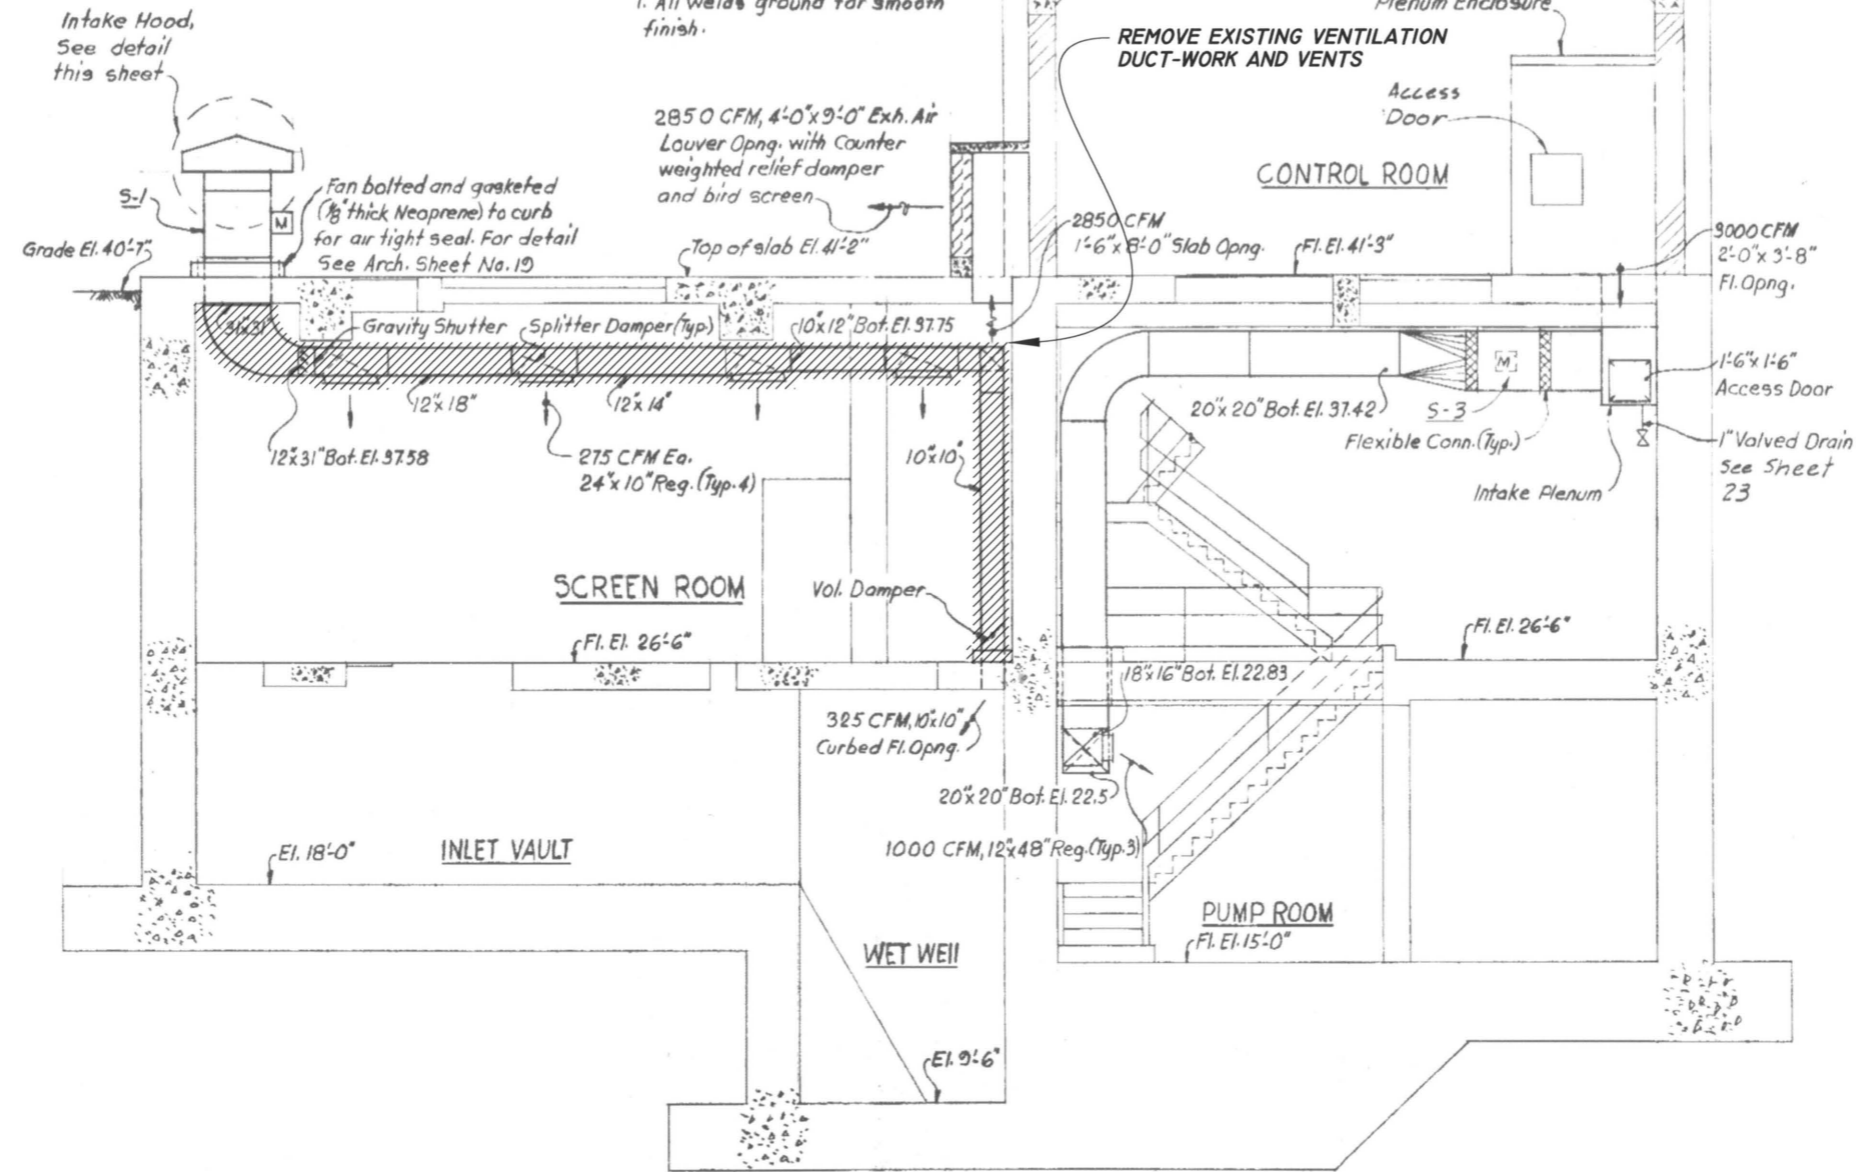


VENTILATION DEMOLITION SECTION

NOT TO SCALE


ITEMS SHOWN HATCHED ARE TO BE REMOVED

User: SS1F Drawing Name: C:\Program Files\AutoCAD Civil 3D 2010\DWG files\University Pumping Station\4511 - Sheets 3-16.dwg Layout - Mar 11, 2011 - 3:58pm

JACINTO CARLOS FERRAS, P.E. #49454 DESIGN DIVISION HEAD WASTEWATER DEPARTMENT	No.	DATE	REVISIONS	DES: D.R. DRN: BB CKD: DATE:	CITY of TAMPA WASTEWATER DEPARTMENT	UNIVERSITY PUMPING STATION REHABILITATION VENTILATION DEMOLITION SECTION	W.O. 4511
	3						SHEET
	2						9
	1						

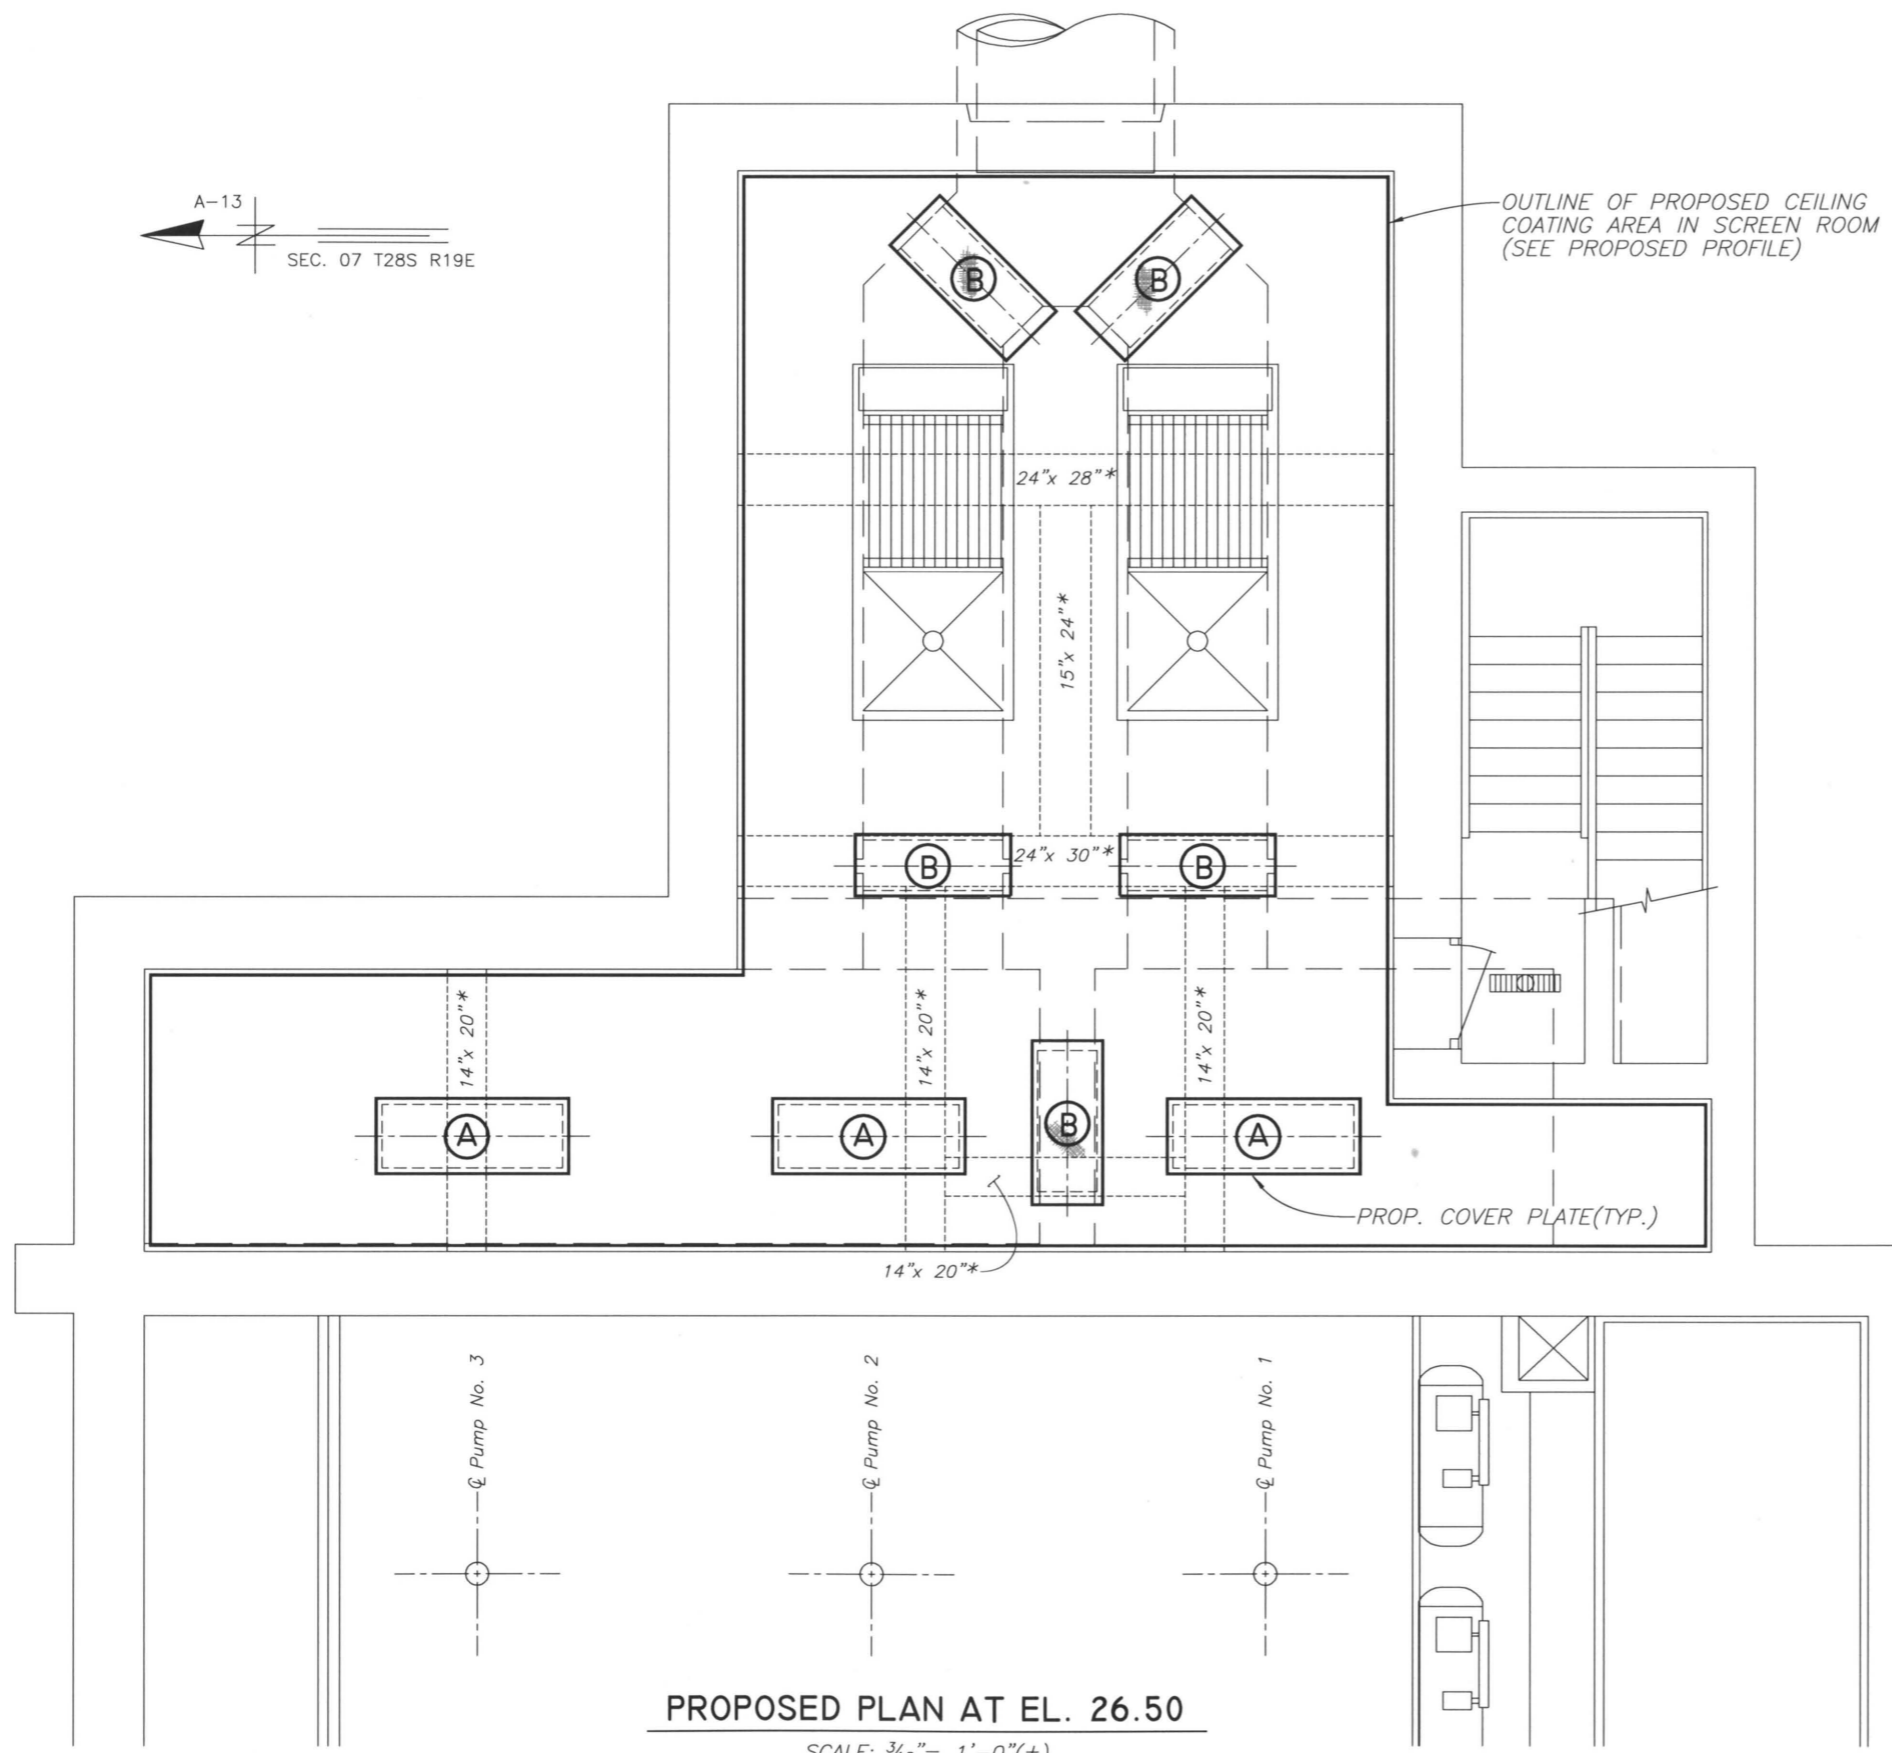

OUTLINE OF PROPOSED CEILING COATING AREA IN SCREEN ROOM (SEE PROPOSED PROFILE)

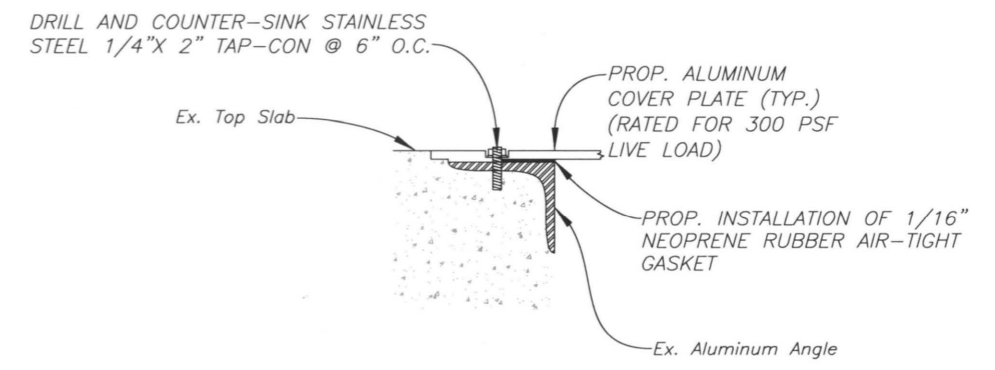

ALUMINUM COVER PLATE INSTALLATION DETAIL
N.T.S

PROJECT RECORD

--- Represents Existing Beams on Screen Room Ceiling (TO BE COATED)

* (APPROXIMATE LOCATIONS AND SIZES)

ALUMINUM COVER PLATE SCHEDULE		
TYPE	QTY.	OPENING DIMENSIONS *
(A)	3	5'-4" x 2'-0"
(B)	5	5'-0" x 1'-6"

* CONTRACTOR SHALL FIELD-VERIFY DIMENSIONS

PROPOSED PLAN AT EL. 26.50

SCALE: 3/16" = 1'-0" (±)

No.	DATE	REVISIONS
3		
2		
1		

DES: D.R.
DRN: BB
CKD:
DATE:

CITY of TAMPA
WASTEWATER DEPARTMENT


UNIVERSITY PUMPING STATION
REHABILITATION
PROPOSED SCREEN ROOM PLAN AT ELEV. 26.50

W.O. 4511
SHEET
10

User: SS1F Drawing Name: C:\Program Files\AutoCAD Civil 3D 2010\DWG files\PS\University Pumping Station\4511 -Sheets 3-16.dwg
Layout: Mar 11, 2011 - 3:58pm

JACINTO CARLOS FERRAS, P.E. #49454
DESIGN DIVISION HEAD
WASTEWATER DEPARTMENT

A-13
SEC. 07 T28S R19E

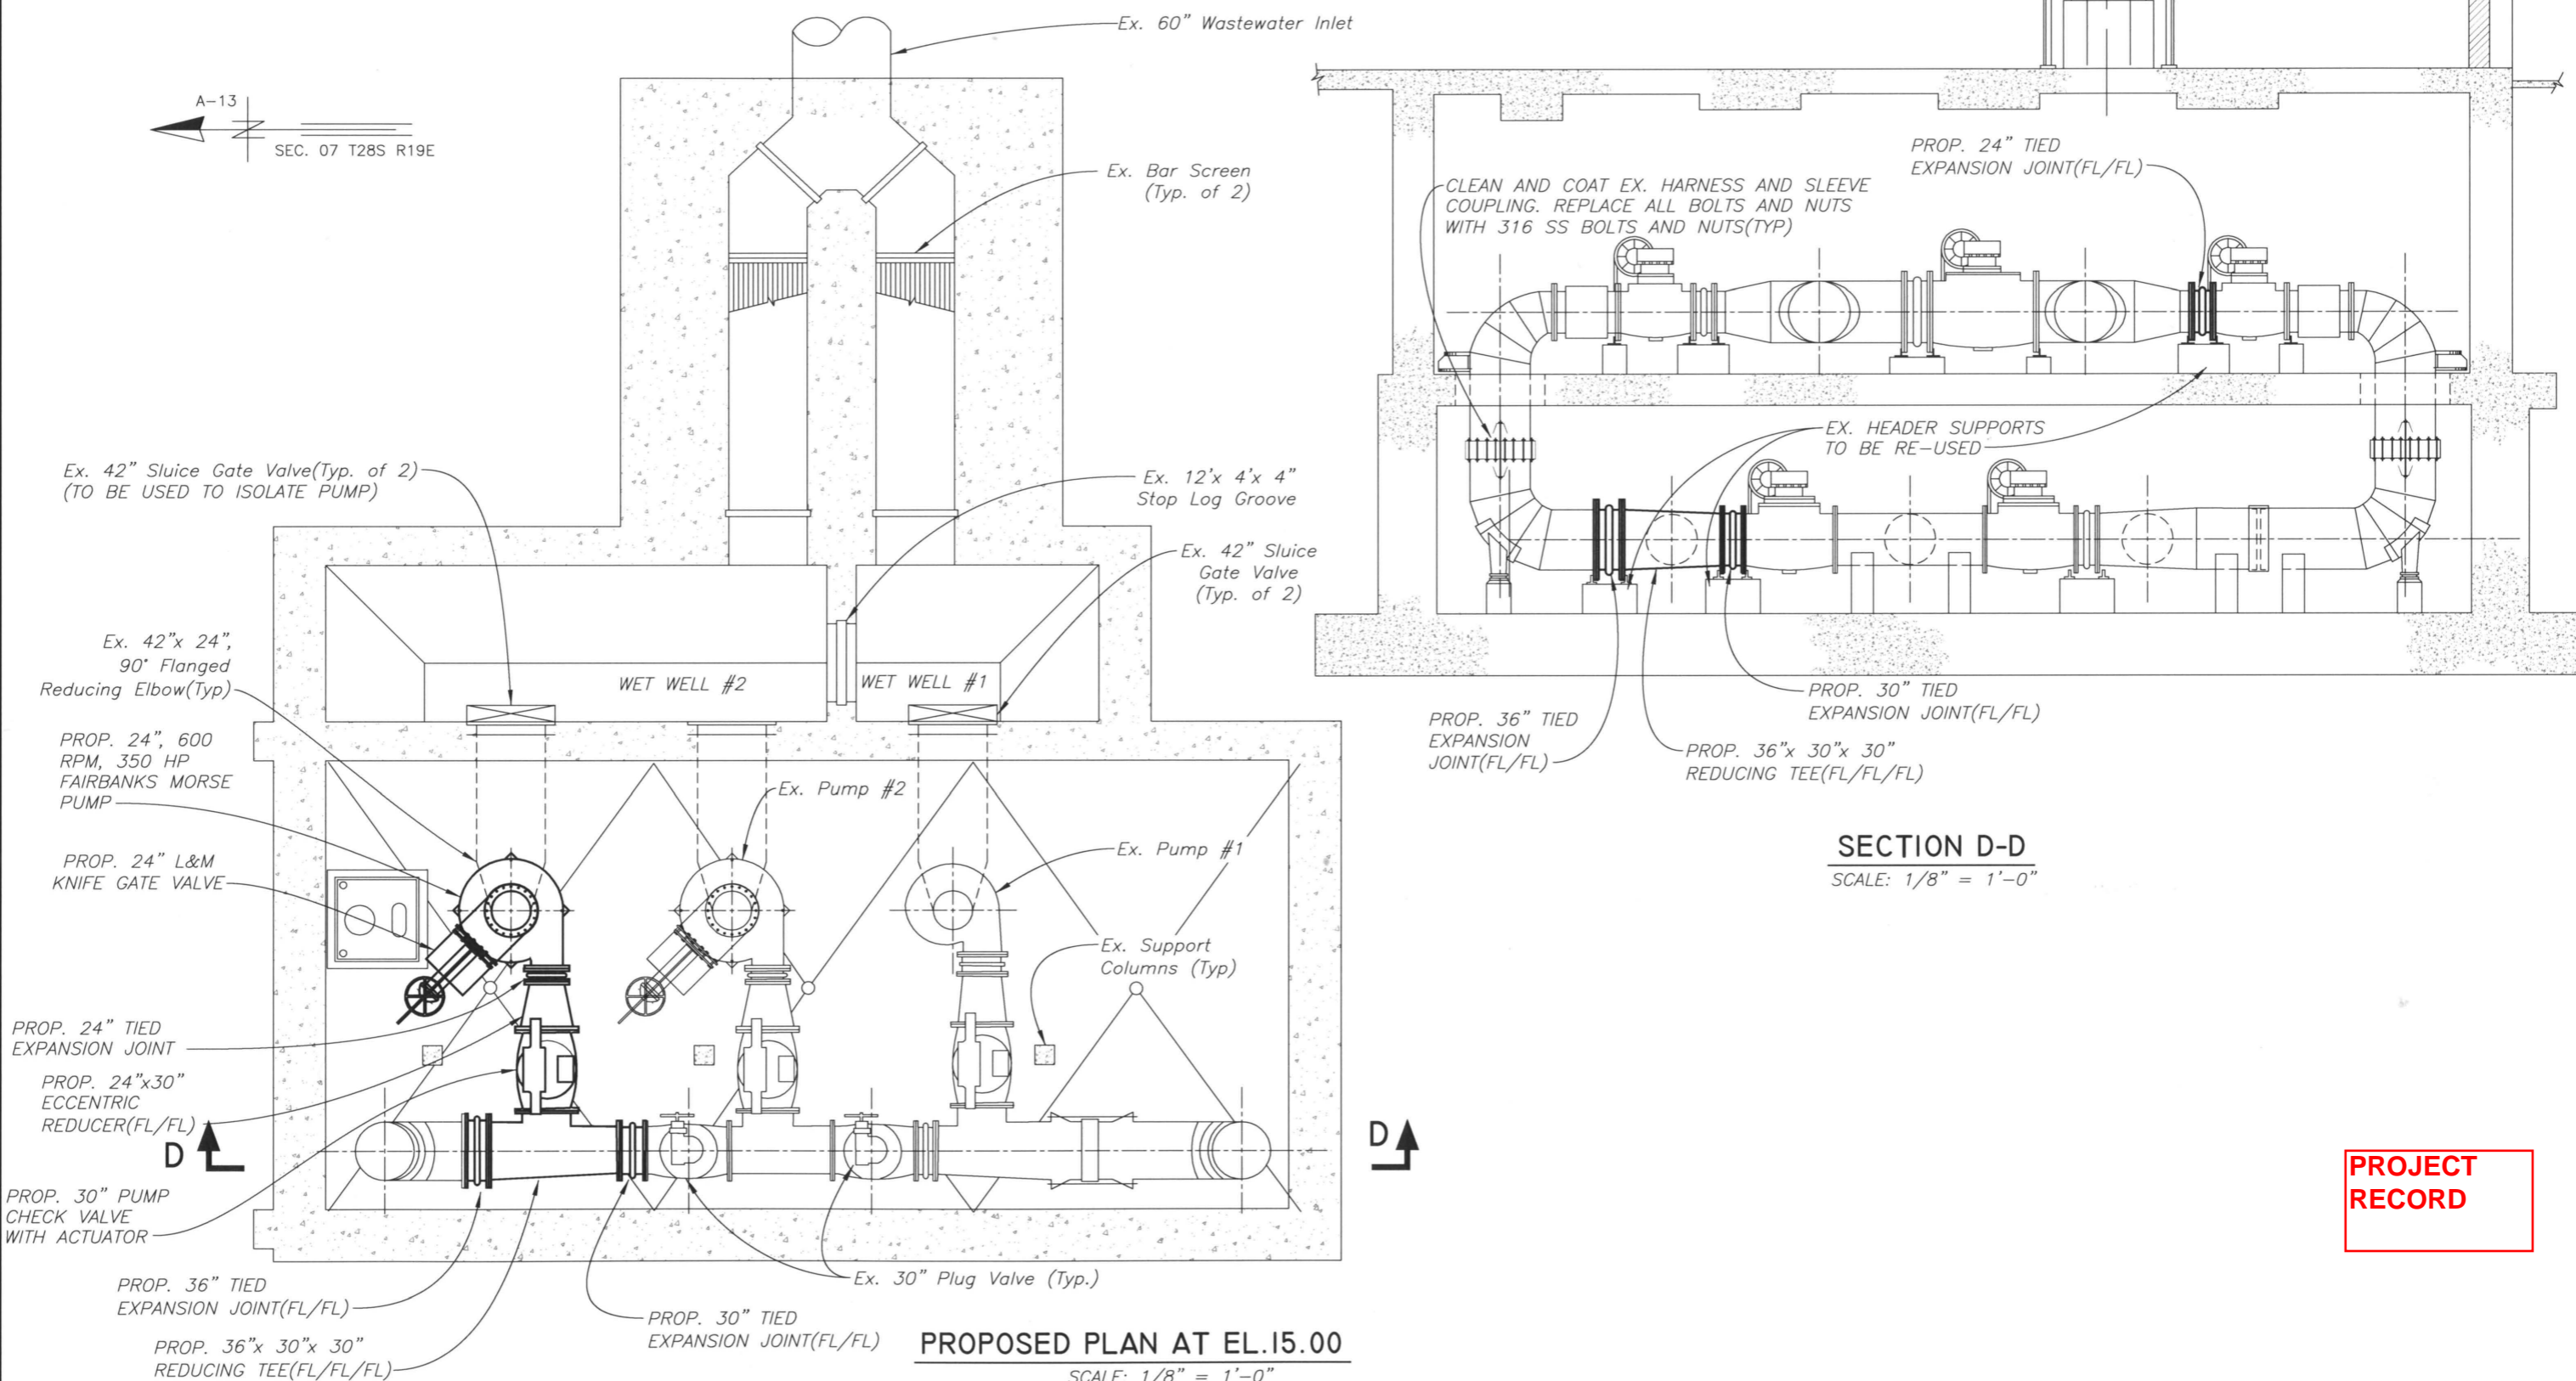

SECTION D-D
SCALE: 1/8" = 1'-0"

PROPOSED PLAN AT EL.15.00
SCALE: 1/8" = 1'-0"

PROJECT RECORD

JACINTO CARLOS FERRAS, P.E. #49454
DESIGN DIVISION HEAD
WASTEWATER DEPARTMENT

No.	DATE	REVISIONS
3		
2		
1		


DES: D.R.
DRN: BB
CKD:
DATE:

CITY of TAMPA
WASTEWATER DEPARTMENT

UNIVERSITY PUMPING STATION
REHABILITATION
PROPOSED PLAN AT ELEV. 15.00 AND SECTION

W.O. 4511
SHEET
11

User: SS1F Drawing Name: C:\Program Files\Autocad\Civil 3D 2010\DWG files\University Pumping Station\4511 - Sheets 3-16.dwg Layout - Mar 11, 2011 - 3:55pm

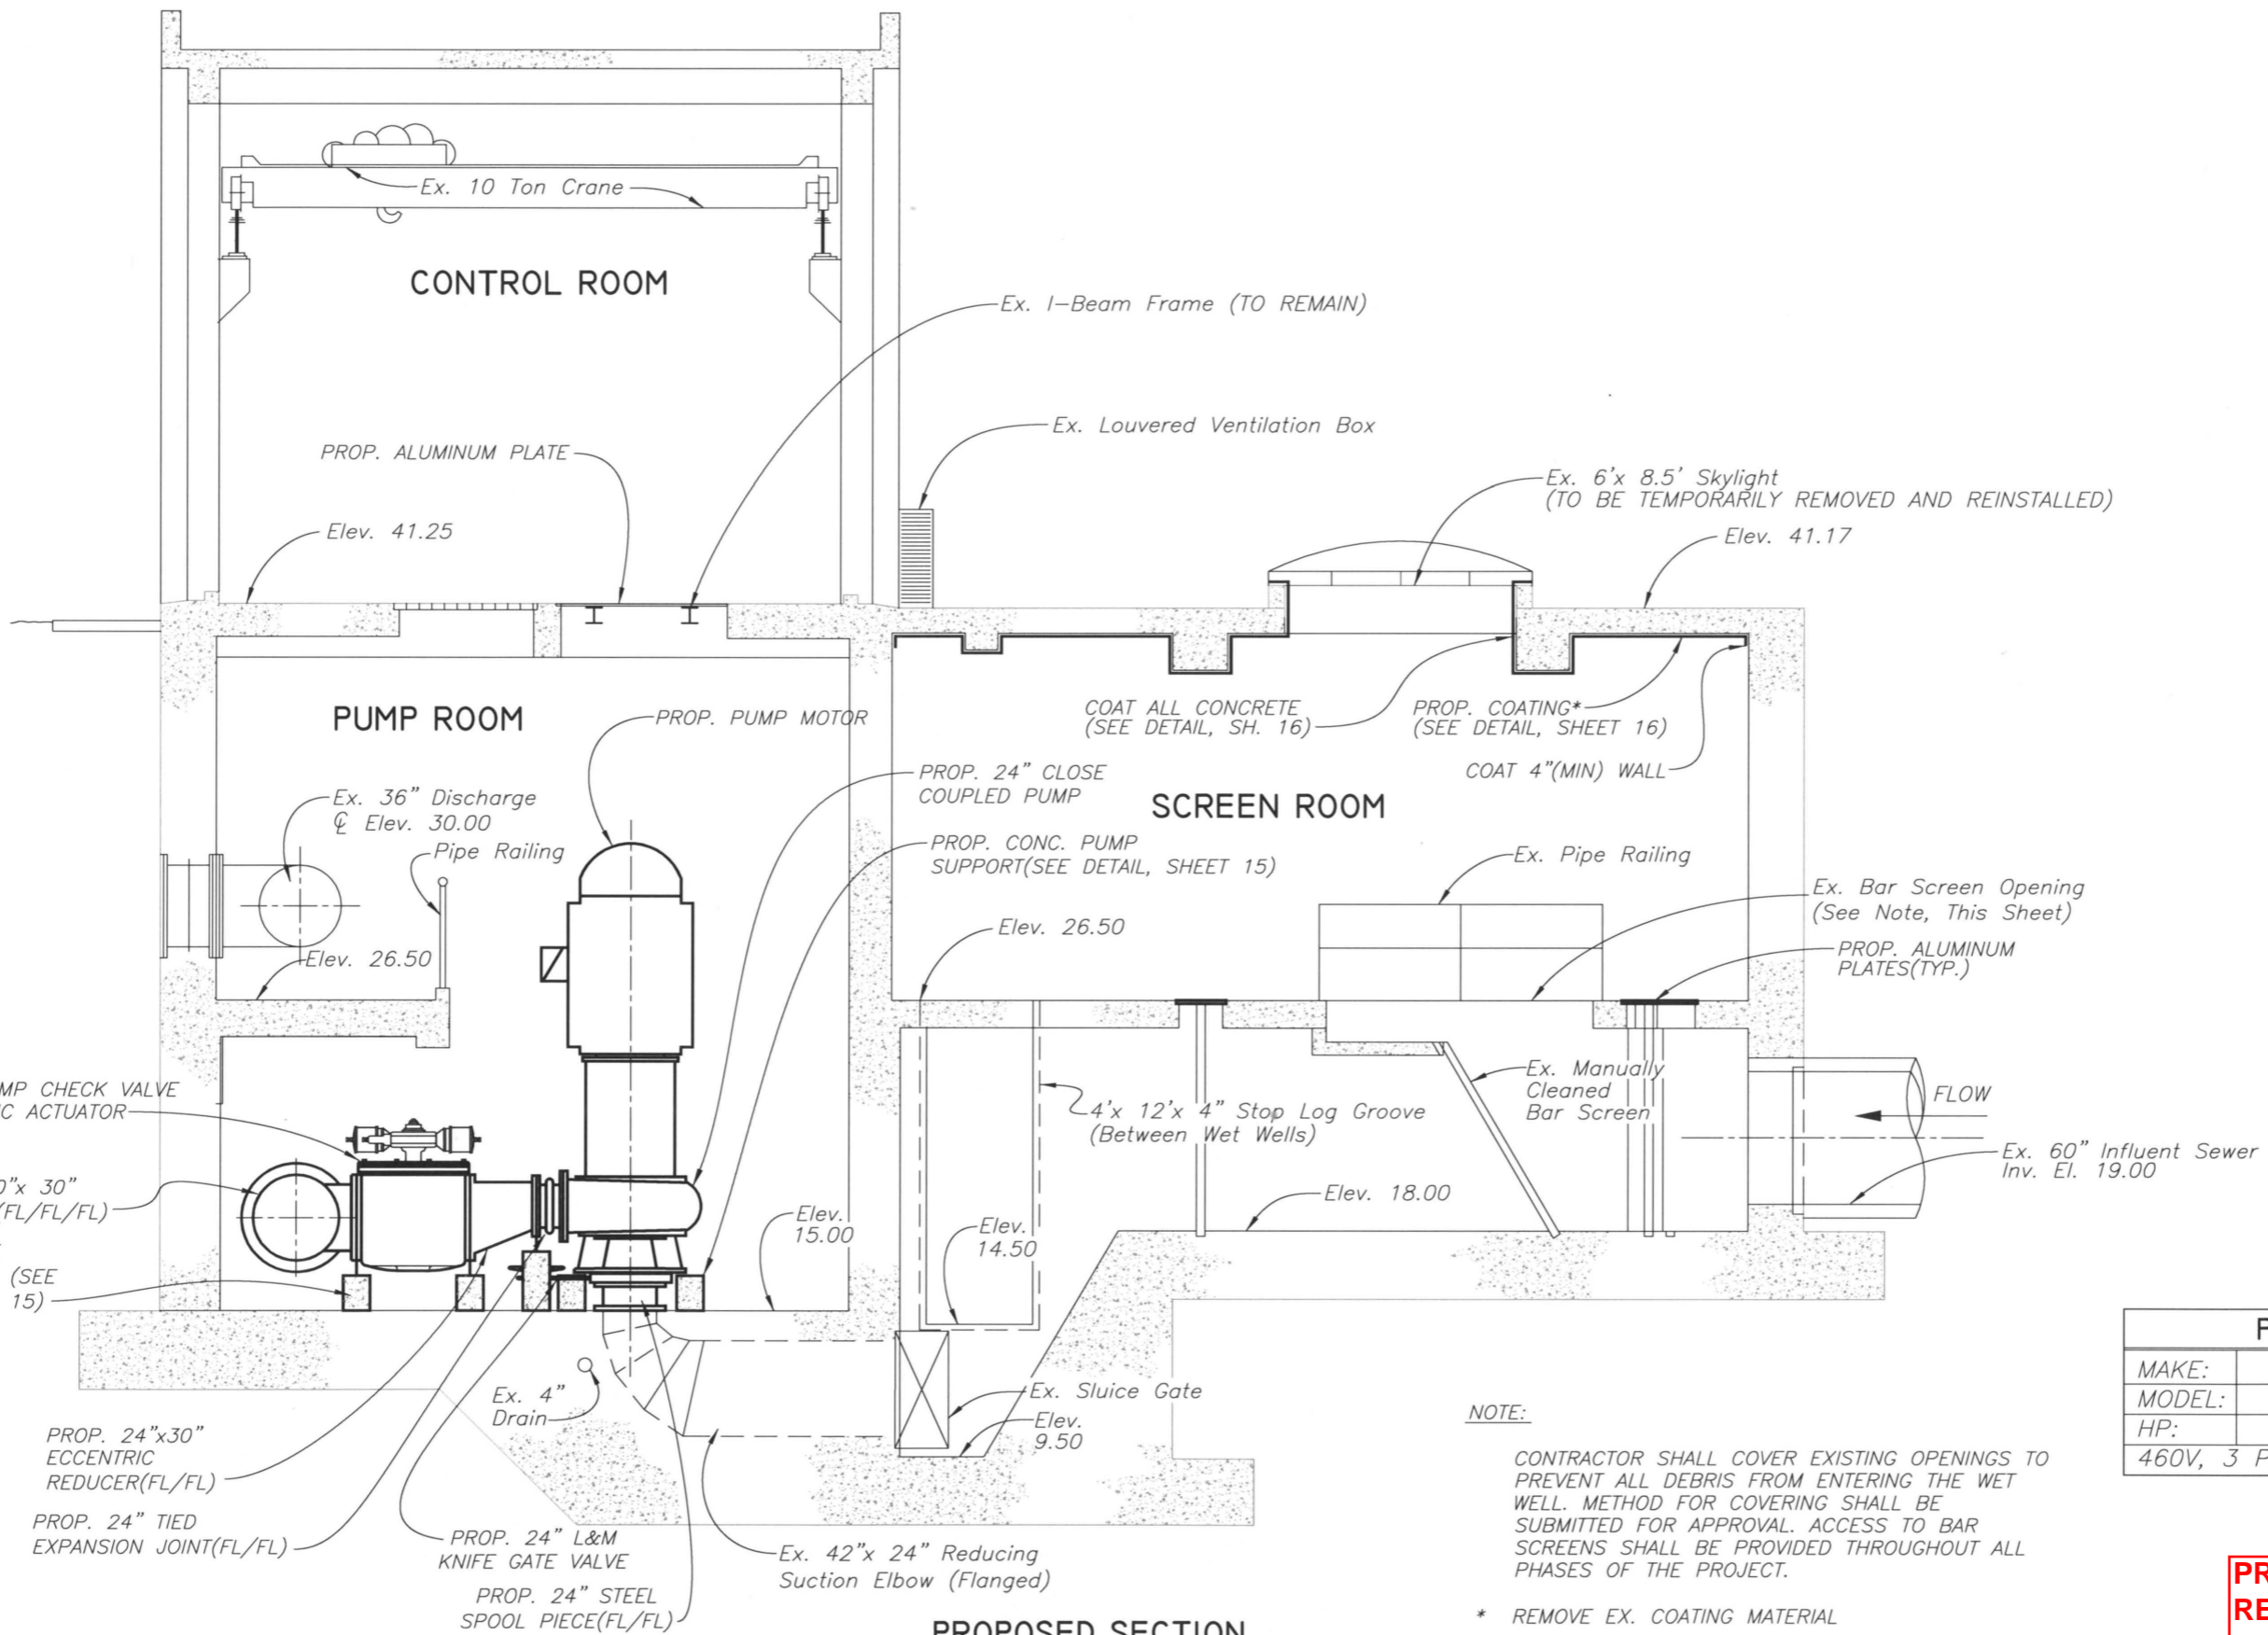

PROPOSED SECTION
NOT TO SCALE

NOTE:
CONTRACTOR SHALL COVER EXISTING OPENINGS TO PREVENT ALL DEBRIS FROM ENTERING THE WET WELL. METHOD FOR COVERING SHALL BE SUBMITTED FOR APPROVAL. ACCESS TO BAR SCREENS SHALL BE PROVIDED THROUGHOUT ALL PHASES OF THE PROJECT.

* REMOVE EX. COATING MATERIAL

PUMP DATA	
MAKE:	FAIRBANKS MORSE
MODEL:	C5741
HP:	350
460V, 3 Phase, 503 FLA, 594 RPM	

PROJECT RECORD

User: SS1F Drawing Name: C:\Program Files\AutoCAD Civil 3D 2010\DWG files\PS\University Pumping Station\4511 -Sheets 3-16.dwg Layout- Mar 11, 2011 - 3:58pm

JACINTO CARLOS FERRAS, P.E. #49454
DESIGN DIVISION HEAD
WASTEWATER DEPARTMENT


No.	DATE	REVISIONS
3		
2		
1		

DES: D.R.
DRN: BB
CKD:
DATE:

CITY of TAMPA
WASTEWATER DEPARTMENT

**UNIVERSITY PUMPING STATION
REHABILITATION
PROPOSED SECTION**

W.O. 4511
SHEET
12

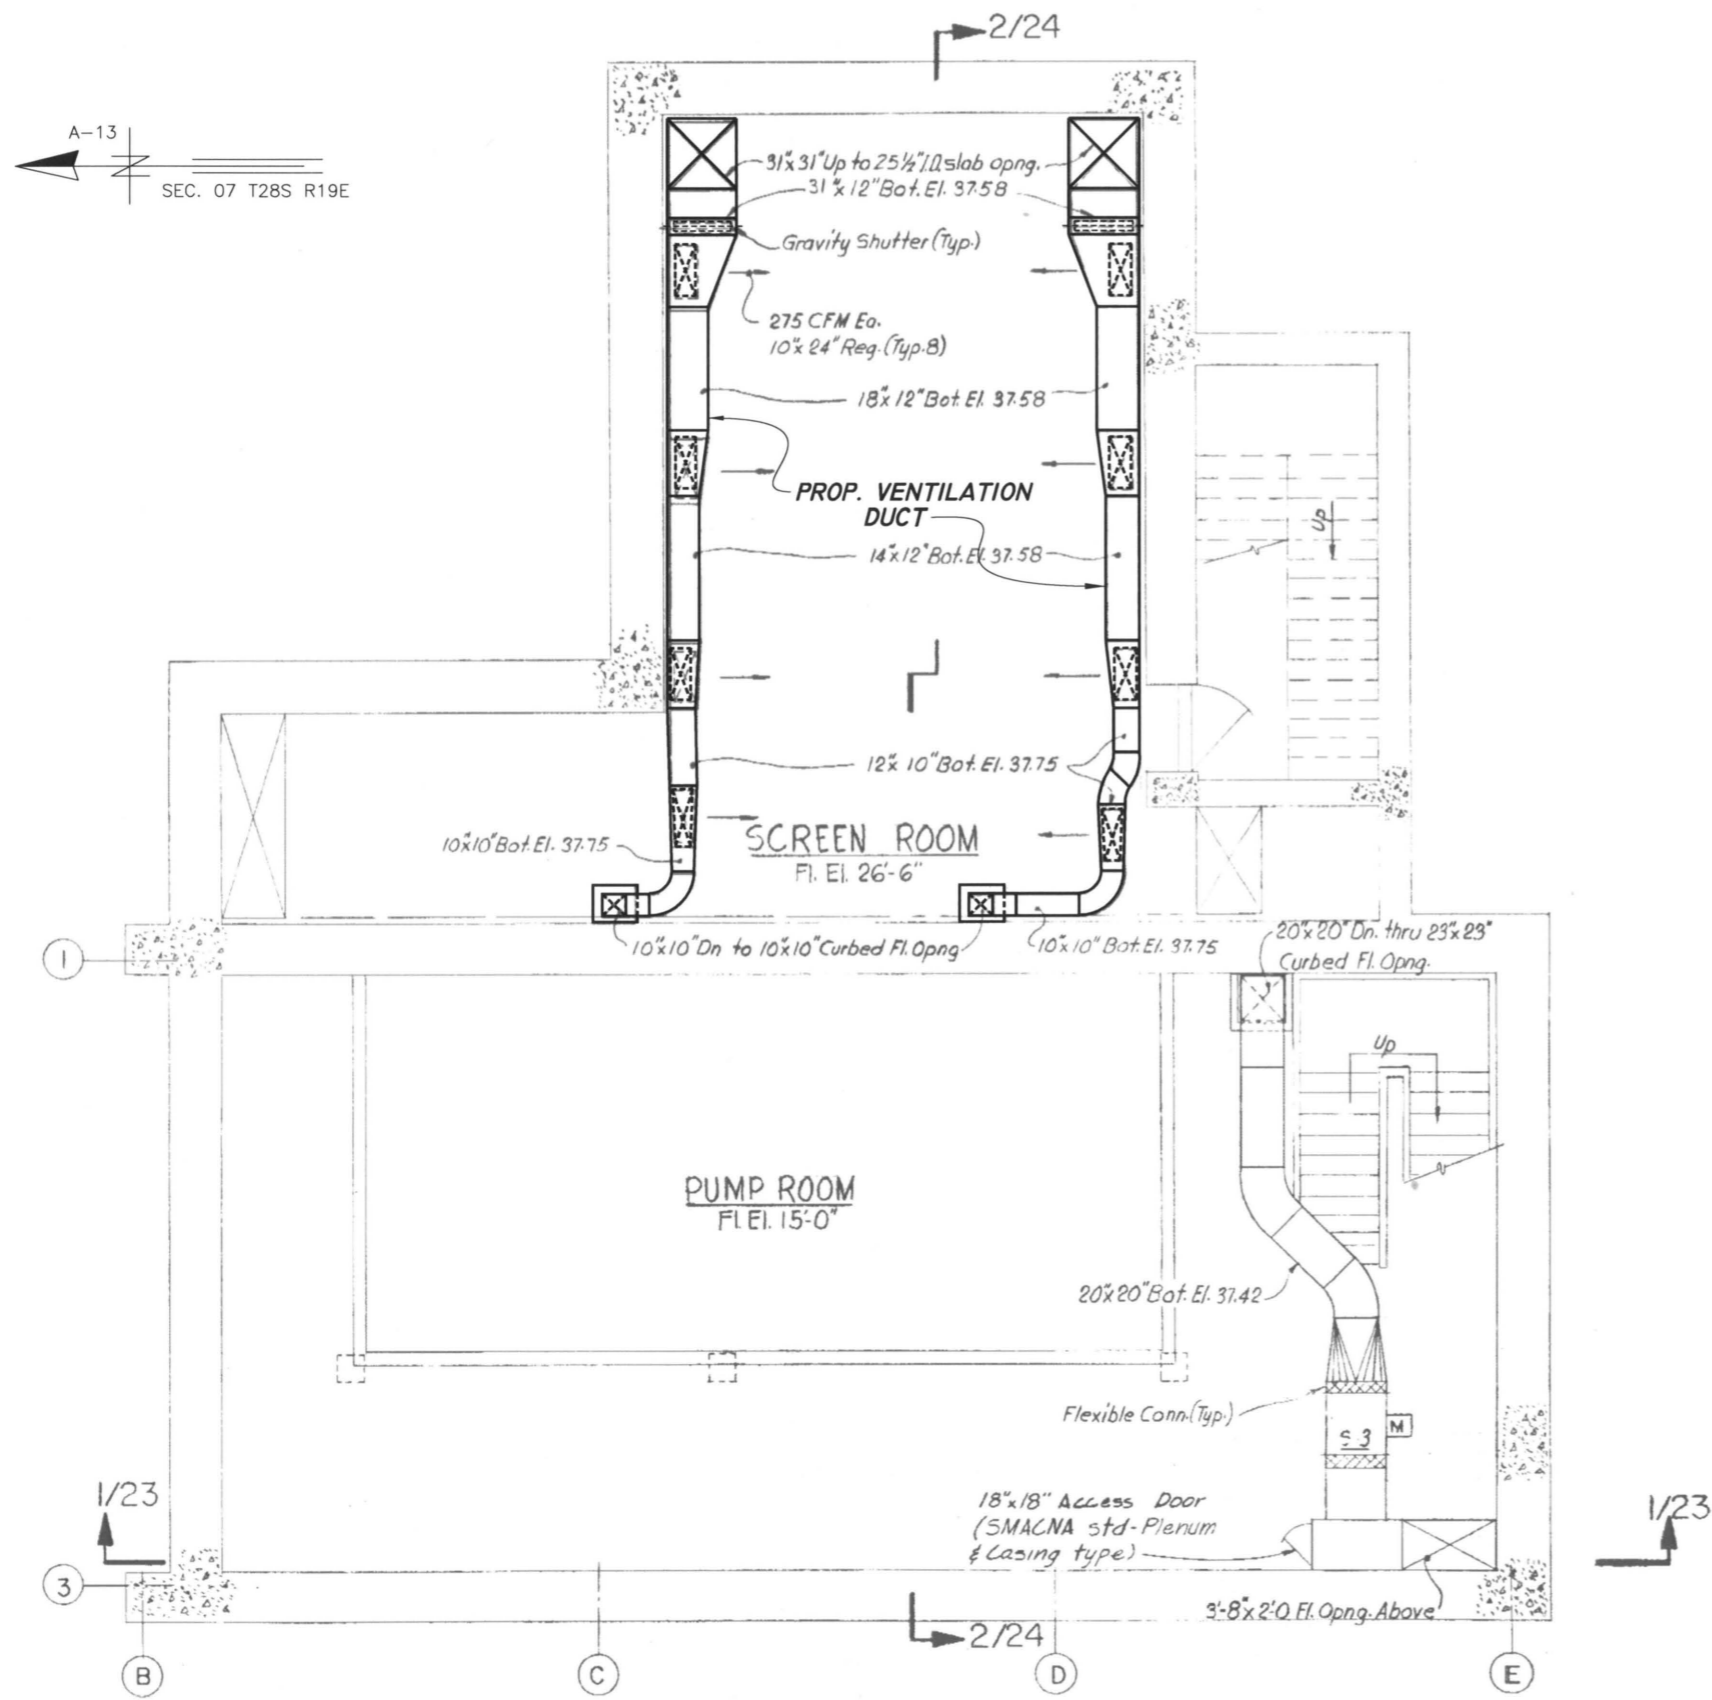

VENTILATION NOTES:

1. ALL DUCT DIMENSIONS ARE INSIDE DIMENSIONS AND ARE IN INCHES UNLESS OTHERWISE NOTED.
2. ALL DUCT SYSTEMS SHALL BE FIBERGLASS REINFORCED PLASTIC (FRP) OR 316 STAINLESS STEEL. EXISTING DUCTS ARE RECTANGULAR AND THE INTENT IS TO REPLACE THE EXISTING DUCTS WITH THE SAME SIZE DUCTS AND CONFIGURATIONS. IF RECTANGULAR DUCTS ARE NOT AVAILABLE, THE CONTRACTOR MAY SUBMIT FOR APPROVAL DRAWINGS FOR CIRCULAR DUCTS THAT WILL ACHIEVE THE DESIRED FLOW RATES. ANY ADDITIONAL WORK OR MATERIALS REQUIRED TO INSTALL CIRCULAR DUCTS SHALL BE IN KIND WITH NO ADDITIONAL COST TO THE CITY.
3. CONTRACTOR SHALL FURNISH AND INSTALL DUCT SUPPORTS MADE OF EITHER 316 STAINLESS STEEL OR FRP DUCT SYSTEM SUPPORTS WITH 316 STAINLESS STEEL HARDWARE. SUPPORTS SHALL BE SPACED AS RECOMMENDED BY DUCT SYSTEM MANUFACTURER, HOWEVER, SPACING SHALL NOT EXCEED THE SUPPORT SPACING OF THE EXISTING DUCT SYSTEM.
4. CONTRACTOR SHALL SUBMIT DUCT SYSTEMS LAYOUT DRAWINGS TO THE ENGINEER FOR APPROVAL. THE LAYOUT DRAWING SHALL DEPICT THE DUCTS, DUCT SUPPORT LOCATIONS, REGISTERS, VOLUME DAMPERS, PROPOSED HARDWARE AND ALL MATERIALS BEING PROPOSED.
5. AIR FLOW RATES INDICATED REPRESENT THE LOW SPEED OPERATION (900 RPM).


PROJECT RECORD

PROPOSED VENTILATION PLAN AT ELEV. 26.50

NOT TO SCALE


User: SSIF Drawing Name: C:\Program Files\AutoCAD Civil 3D 2010\DWG files\PS\University Pumping Station\4511 - Sheets 3-16.dwg Layout - Mar 11, 2011 - 3:58pm

JACINTO CARLOS FERRAS, P.E. #49454 DESIGN DIVISION HEAD WASTEWATER DEPARTMENT	No.	DATE	REVISIONS	DES: D.R.	CITY of TAMPA WASTEWATER DEPARTMENT	UNIVERSITY PUMPING STATION REHABILITATION PROPOSED VENTILATION PLAN AT ELEV. 26.50	W.O. 4511
	3			DRN: BB			SHEET
	2			CKD:			13
	1			DATE:			

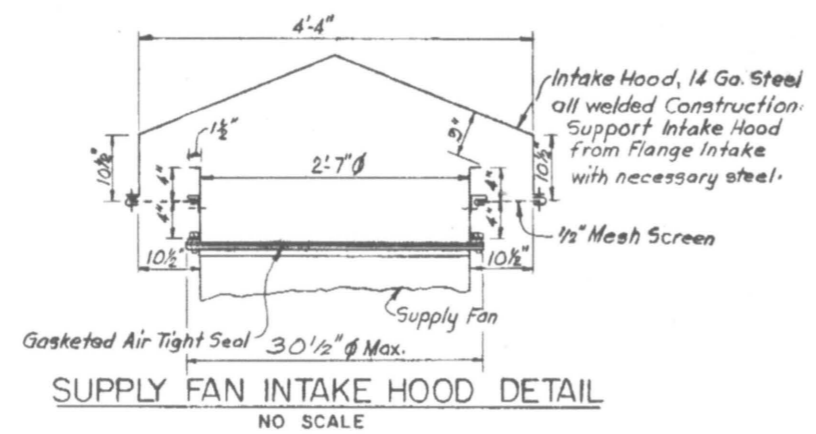

NOTE:

1. All welds ground for smooth finish.

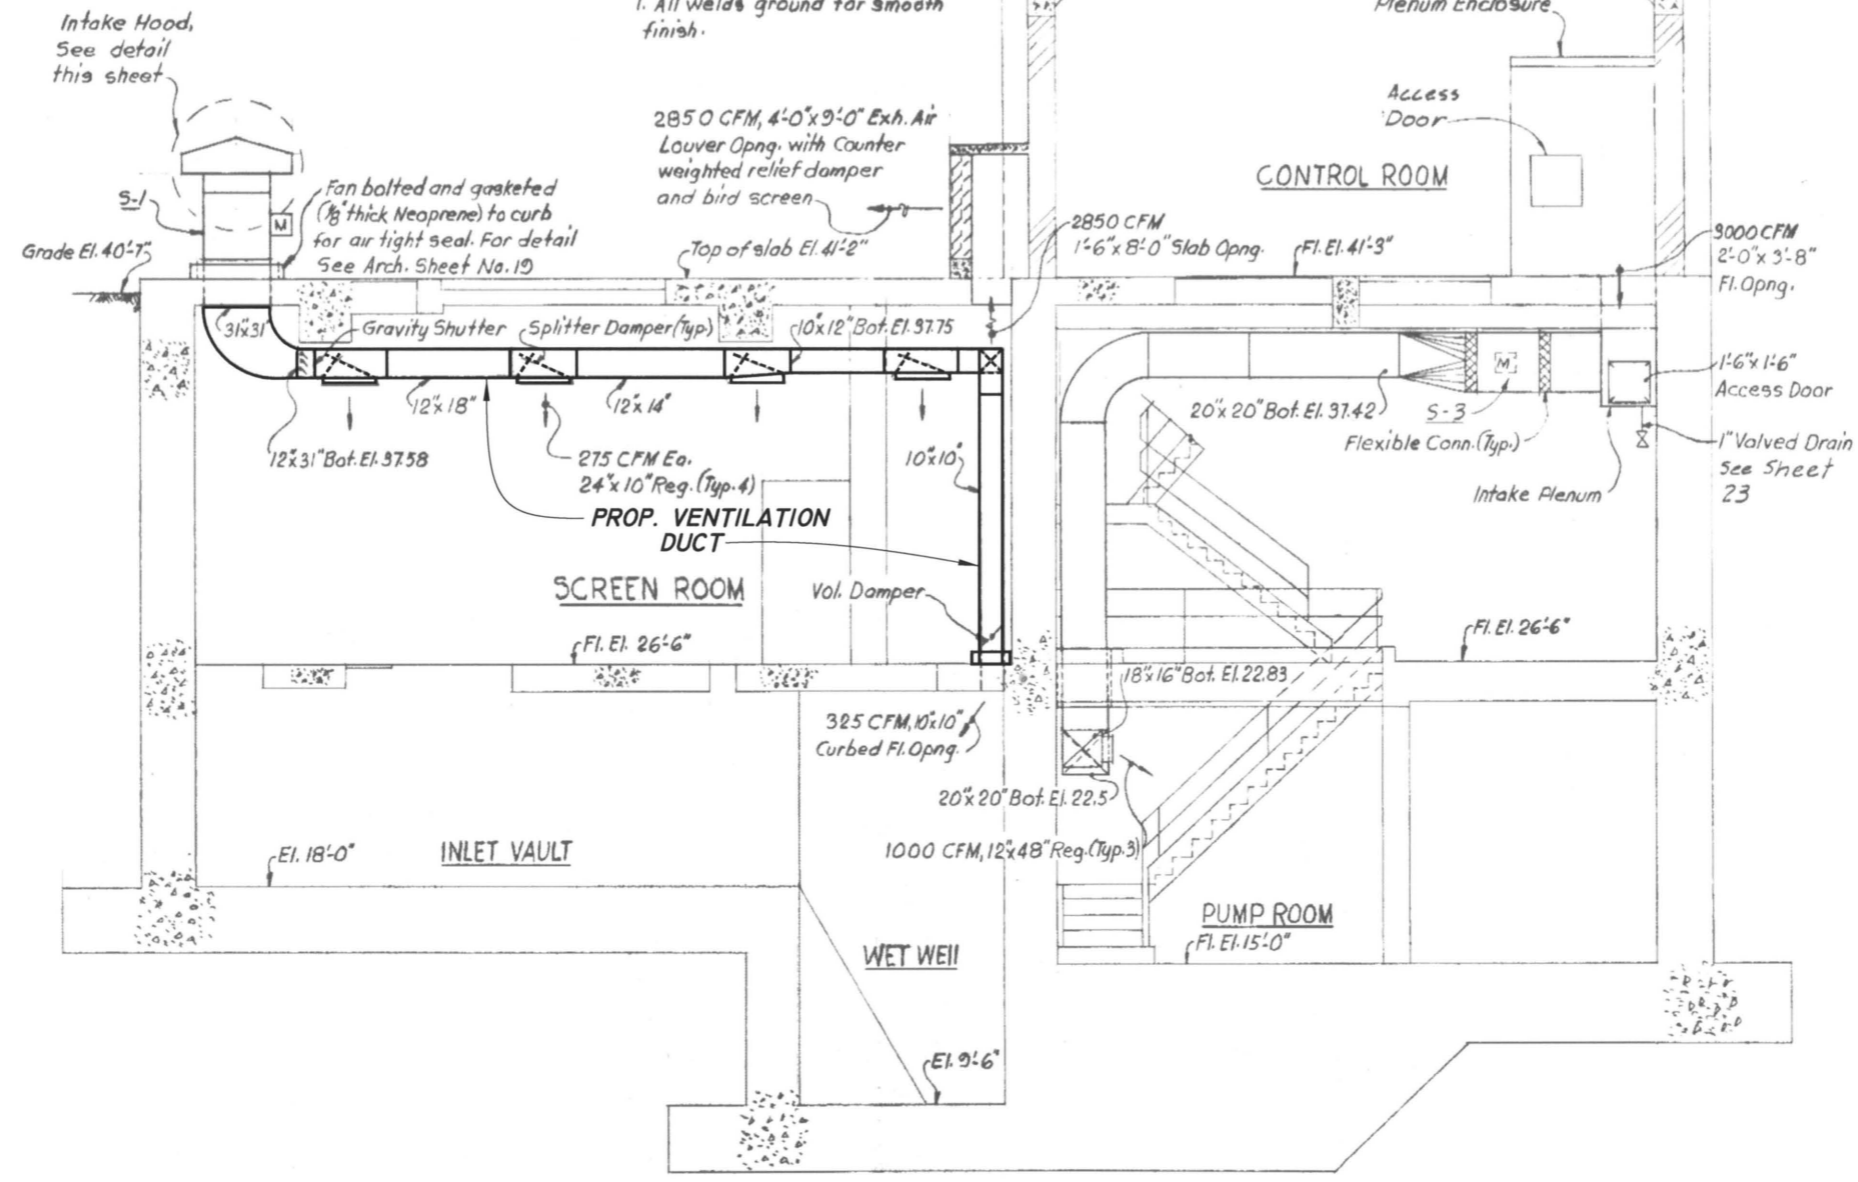


PROPOSED VENTILATION SECTION
NOT TO SCALE

PROJECT RECORD

User: SSIF Drawing Name: C:\Program Files\AutoCAD Civil 3D 2010\DWG Files\PS\University Pumping Station\4511 -Sheets 3-16.dwg Layout - Mar 11, 2011 - 3:58pm


JACINTO CARLOS FERRAS, P.E. #49454 DESIGN DIVISION HEAD WASTEWATER DEPARTMENT	No.	DATE	REVISIONS	DES: D.R. DRN: BB CKD: DATE:	CITY of TAMPA WASTEWATER DEPARTMENT	UNIVERSITY PUMPING STATION REHABILITATION PROPOSED VENTILATION SECTION	W.O. 4511
	3						SHEET
	2						14
	1						

B069-168

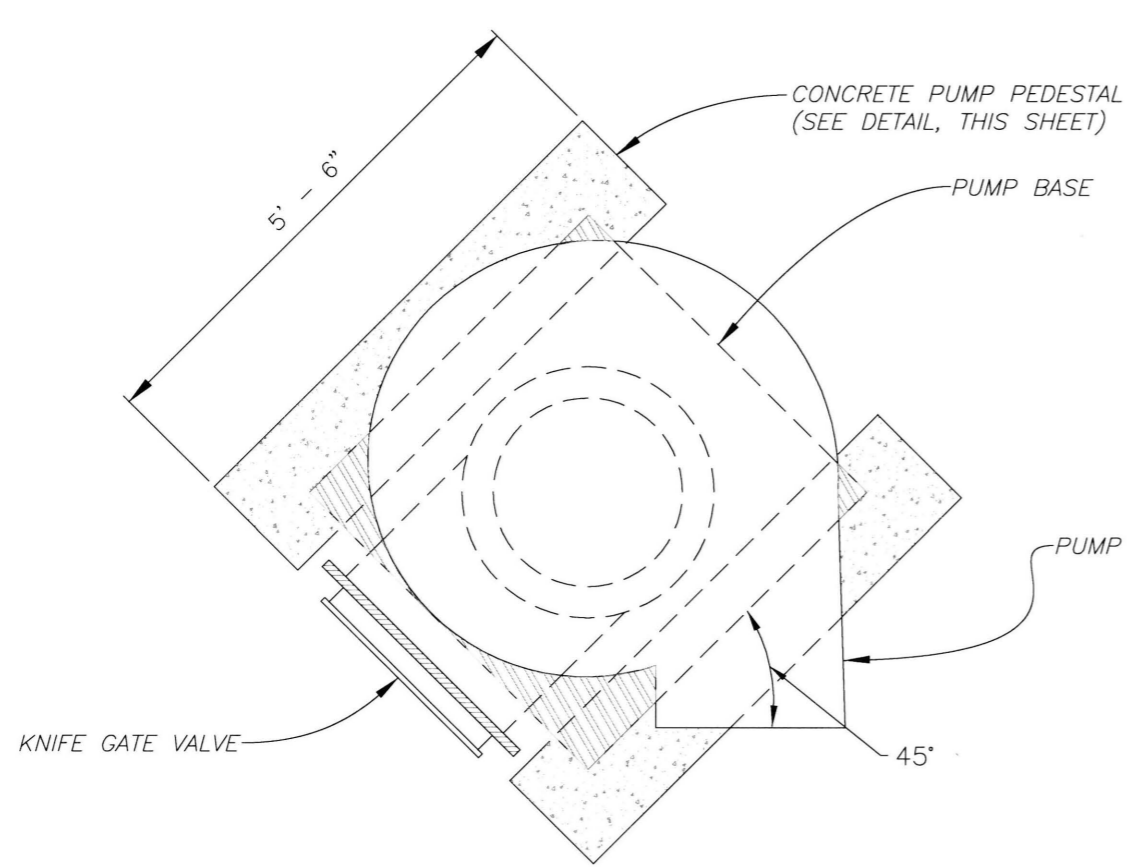

PROP. PUMP SUPPORT - PLAN



NOT TO SCALE

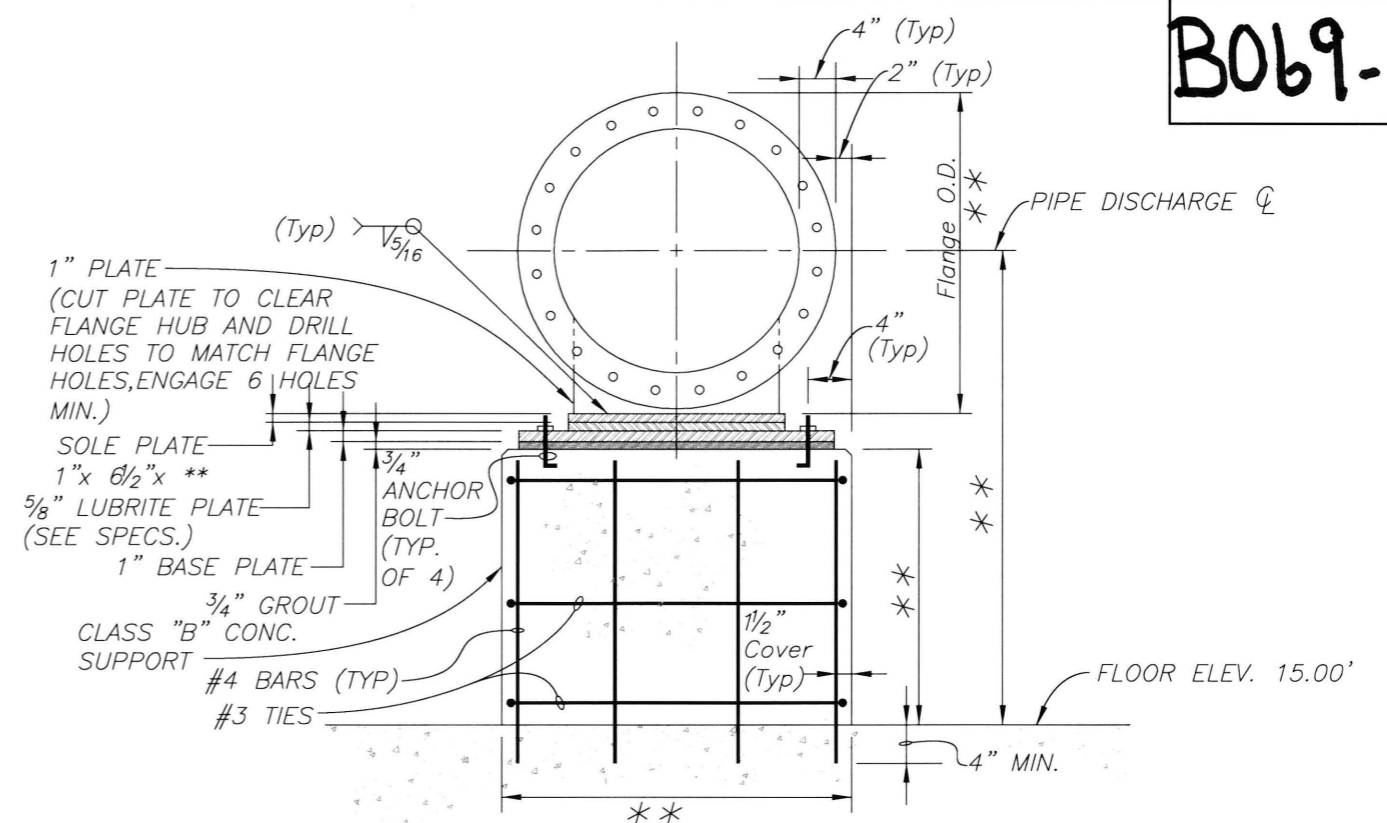

PROP. FLANGE SUPPORT DETAIL I


N.T.S.

** Dimension Dependant on Pipe Diameter

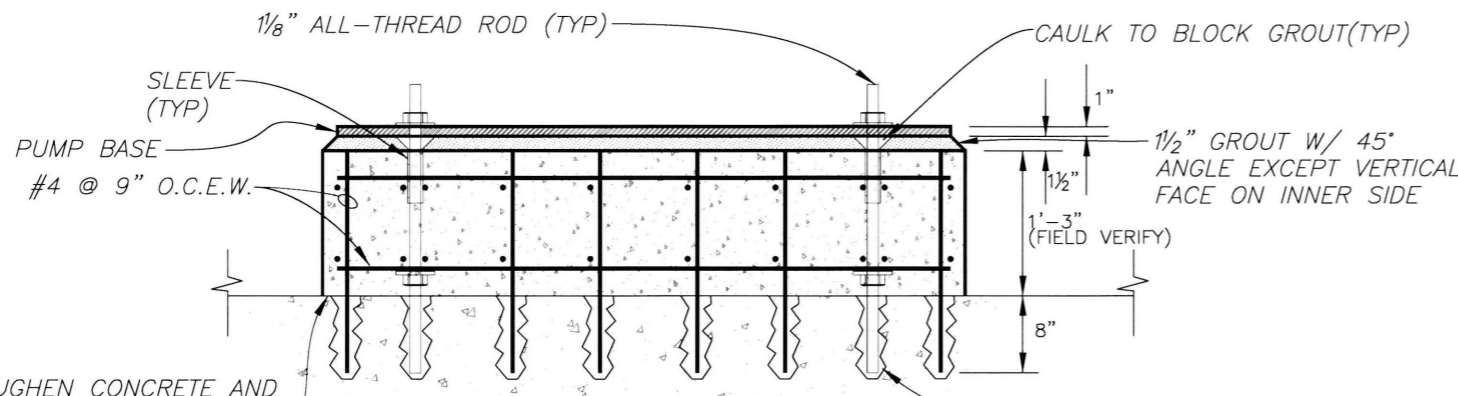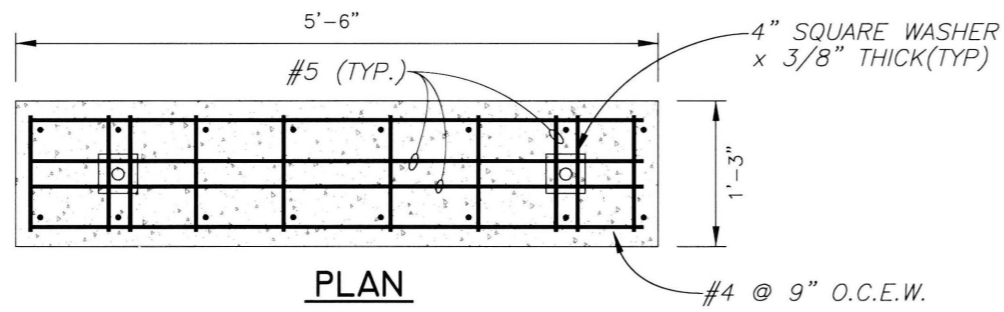

PROP. PUMP PEDESTAL DETAIL

NOT TO SCALE

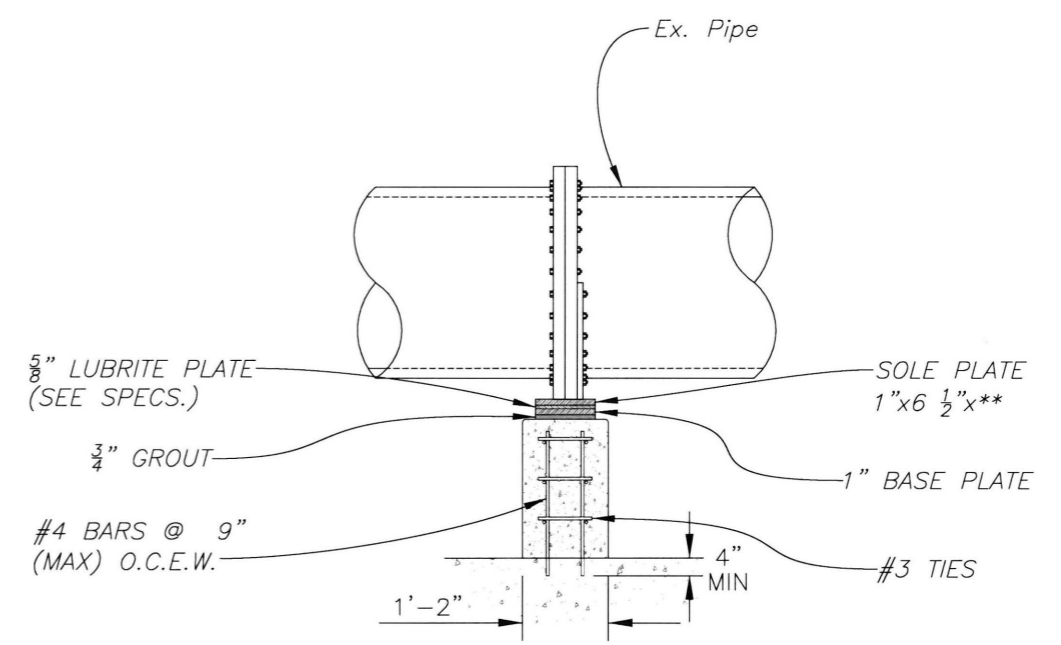

PROP. FLANGE SUPPORT DETAIL 2


NOT TO SCALE

PROJECT RECORD


User: SSIF Drawing Name: C:\Program Files\Autocad Civil 3D 2010\DWG Files\University Pumping Station\4511 - Sheets 3-16.dwg Layout - Feb 17, 2011 - 12:15pm

JACINTO CARLOS FERRAS, P.E. #49454 DESIGN DIVISION HEAD WASTEWATER DEPARTMENT	No.	DATE	REVISIONS	DES: JH DRN: BB CKD: JF DATE: 2/17/11	CITY of TAMPA WASTEWATER DEPARTMENT	UNIVERSITY PUMPING STATION REHABILITATION MISCELLANEOUS PUMP ROOM DETAILS	W.O. 5395
	3						SHEET
	2						15
	1						


B069-169

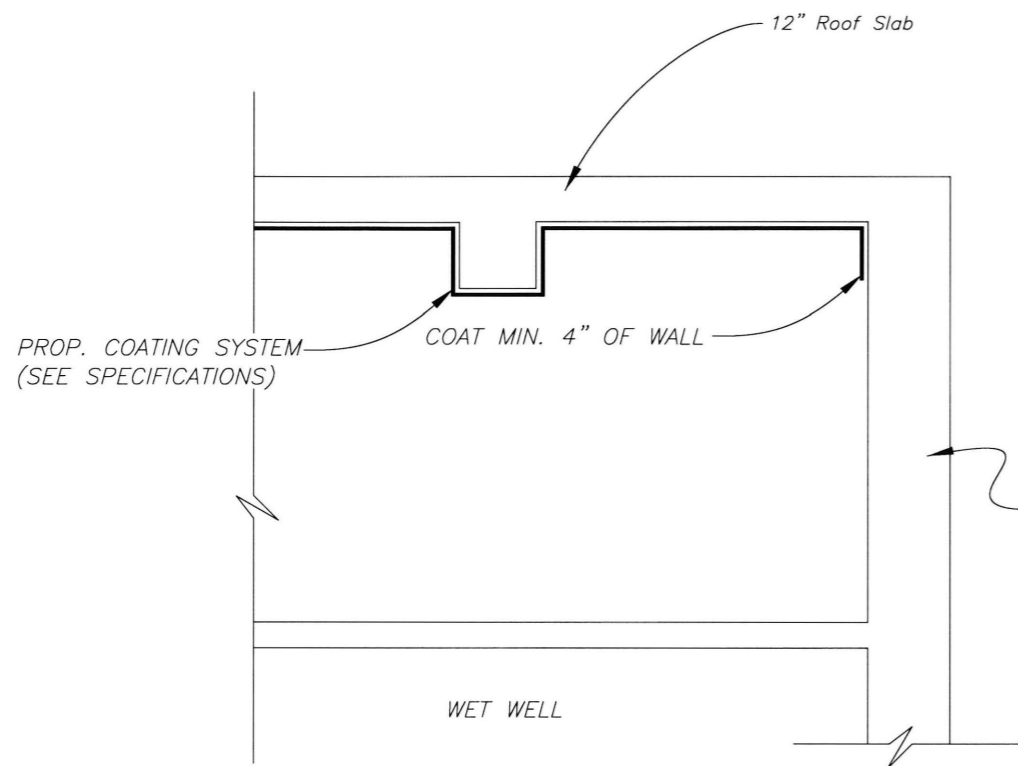

TYPICAL COATING SECTION AT CORNERS
NOT TO SCALE

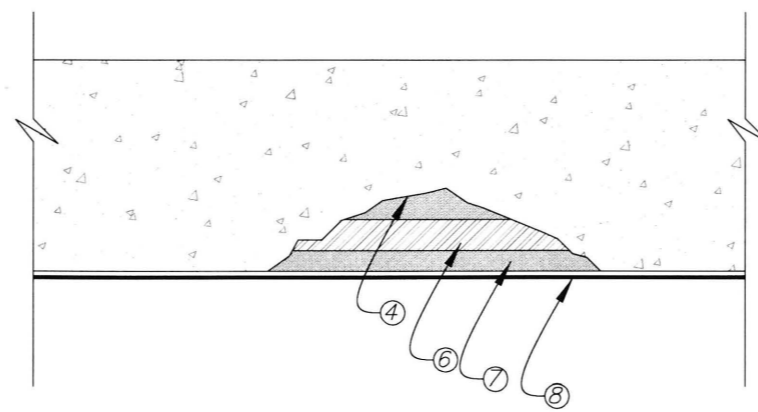

CONCRETE RESTORATION DETAIL
NOT TO SCALE

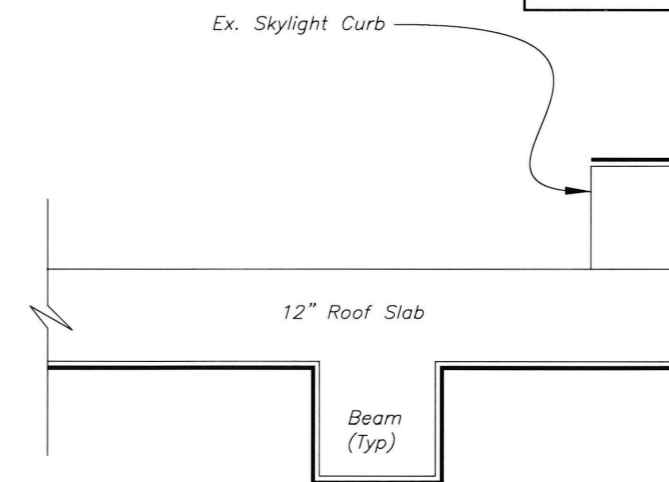

TYPICAL COATING SECTION AT CEILING OPENINGS
NOT TO SCALE

CONCRETE RESTORATION AND COATING NOTES:

1. CONTRACTOR SHALL PROVIDE ACCESS TO CITY'S PERSONNEL FOR CLEANING OF BAR SCREENS DURING ALL PHASES OF THE PROJECT.
2. CONTRACTOR IS RESPONSIBLE FOR PROVIDING A SAFE, WELL-VENTILATED WORK ENVIRONMENT. O.S.H.A. STANDARD SAFETY EQUIPMENT (SAFETY HARNESES, GAS MONITORS, LOWER EXPLOSIVE LIMIT DETECTORS, ETC.) SHALL BE UTILIZED WHERE NEEDED. CONTRACTOR MAY USE EXISTING SUPPLY FANS FOR AS LONG AS THEY DO NOT CONFLICT WITH THE PROPOSED WORK.
3. EXISTING COATING SHALL BE COMPLETELY REMOVED BEFORE NEW REPAIR MATERIAL AND COATING ARE INSTALLED. PREPARE SURFACE AS INSTRUCTED BY COATING SYSTEM MATERIAL MANUFACTURER.
4. REMOVE ALL LOOSE AND DETERIORATED CONCRETE TO STRUCTURALLY SOUND CONCRETE. CERTAIN AREAS MAY REQUIRE MECHANICAL REMOVAL METHODS SUCH AS CHIPPING, BRUSHING, ETC.
5. SAND BLASTING OR WATER JETTING WILL BE ALLOWED PROVIDED THE CONTRACTOR TAKES THE NECESSARY MEASURES TO COVER WET WELL OPENINGS TO PREVENT ANY SAND OR DEBRIS FROM ENTERING THE WET WELL. ALSO, ALL ABOVE GROUND EQUIPMENT MUST COMPLY WITH CITY OF TAMPA ORDINANCES ON NOISE POLLUTION. CONTRACTOR SHALL SUBMIT A DETAILED PLAN TO THE ENGINEER FOR APPROVAL SHOWING THE PROPOSED METHOD OF COVERING THE OPENINGS.
6. EXPOSED REINFORCING STEEL SHALL BE CLEANED AND PREPARED THOROUGHLY BY BLAST CLEANING AND COATED WITH A CORROSION INHIBITOR (SIKA ARMATIC 110 EPOCHEM OR APPROVED EQUAL)
7. FILL VOIDS OF DETERIORATED CONCRETE SECTIONS WITH REPAIR MATERIAL (SIKATOP 123 PLUS, SIKAREPAIR 224 OR APPROVED EQUAL) IN ACCORDANCE WITH THE SPECIFICATIONS AND MANUFACTURER'S INSTRUCTIONS. IT IS NOT THE ENGINEER'S INTENT TO RESTORE THE ORIGINAL SURFACE PROFILE OF THE WALL OR CEILING. PROVIDE A MINIMUM OF 1" COVER OVER RESTORED RE-BAR.
8. PROPOSED 125 MIL COATING PER SPECIFICATIONS AND MANUFACTURER'S INSTRUCTIONS. CONTRACTOR SHALL SUBMIT PROPOSED COATING FOR APPROVAL.

PROJECT RECORD

User: SSIF Drawing Name: C:\Program Files\AutoCAD Civil 3D 2010\DWG files\PS\University Pumping Station\4511 - Sheets 3-16.dwg Layout - Feb 16, 2011 - 3:58pm

JACINTO CARLOS FERRAS, P.E. #49454
DESIGN DIVISION HEAD
WASTEWATER DEPARTMENT

No.	DATE	REVISIONS
3		
2		
1		


DES: DR
DRN: BB
CKD: JF
DATE: 2/17/11

CITY of TAMPA
WASTEWATER DEPARTMENT


**UNIVERSITY PUMPING STATION
REHABILITATION
CONCRETE RESTORATION DETAILS AND NOTES**

W.O. 5395
SHEET
16

PUMP No.3 START SEQUENCE

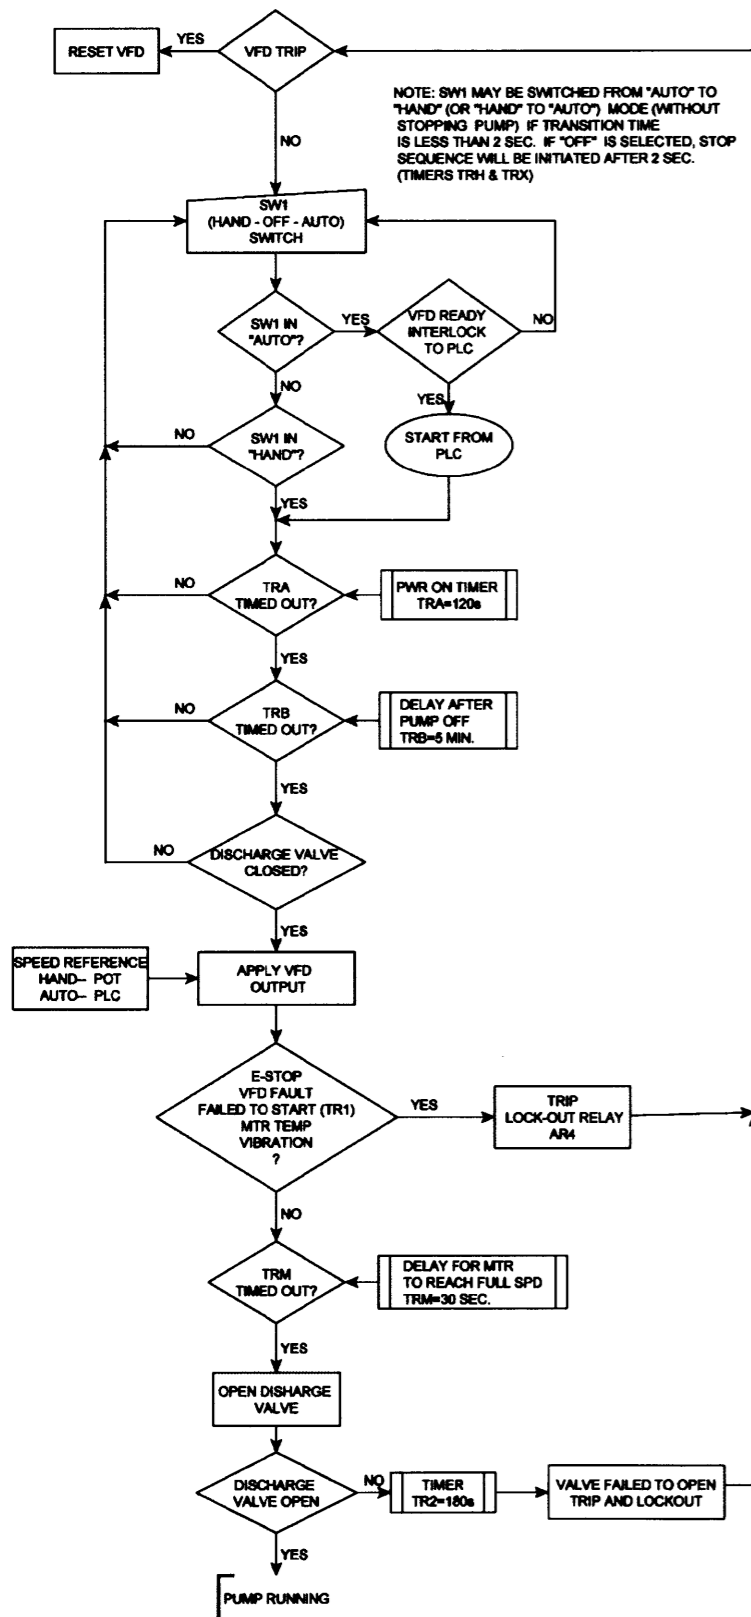

PUMP No.3 STOP SEQUENCE

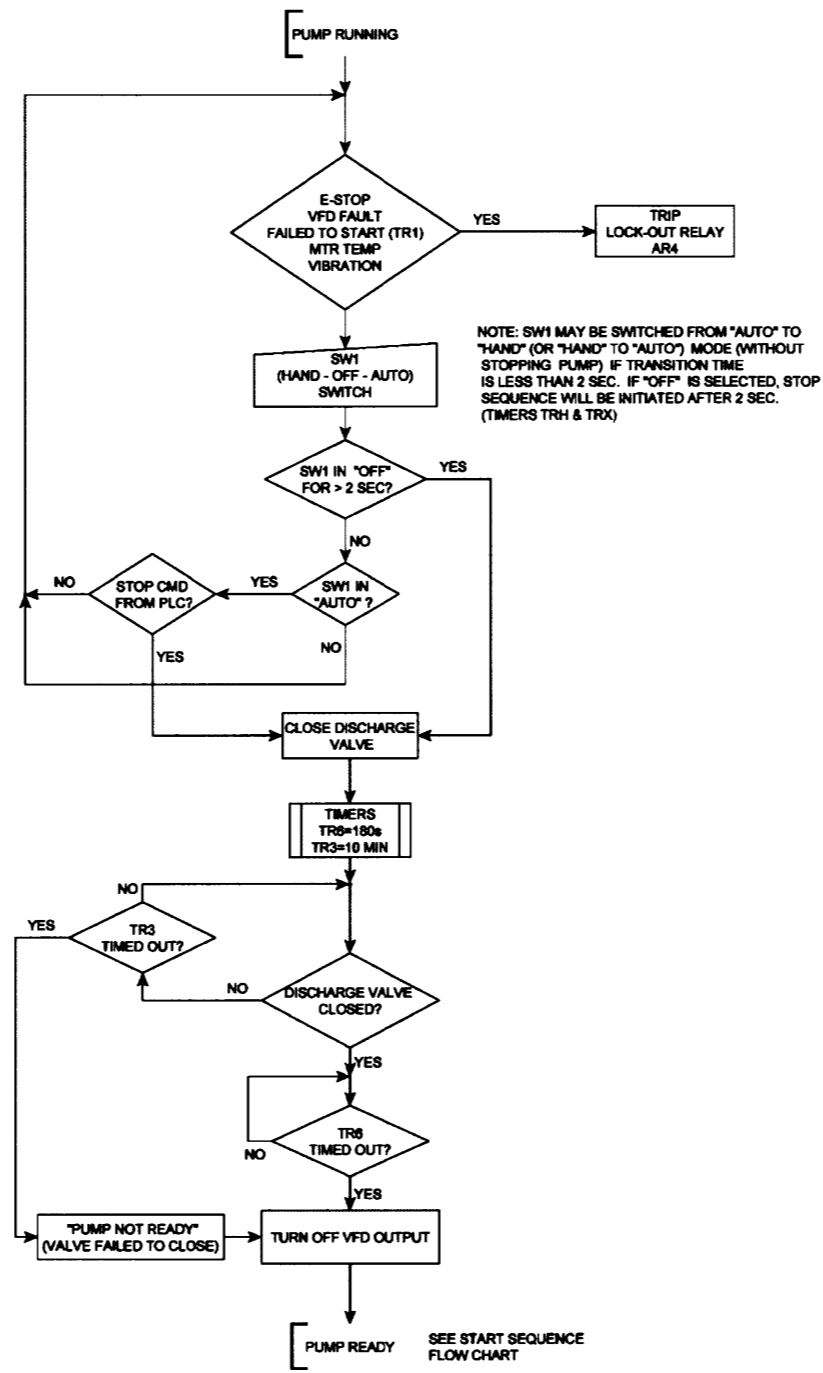

LEGEND

- DISCONNECTING DEVICE
- MOTOR CIRCUIT PROTECTOR
30 AMPERE CONTINUOUS RATING
90 AMPERE MAGNETIC TRIP SETTING
- CONTROL POWER TRANSFORMER
- FUSE
- NORMALLY OPEN CONTACT
- NORMALLY CLOSED CONTACT
- MOTOR STARTER COIL
- MOTOR THERMAL OVERLOAD
- PILOT LIGHT (RED LENS)
- TERMINAL STRIP
- HOUR METER
- STOP PUSHBUTTON
WITH PROVISIONS FOR PADLOCK
- 3 POSITION SELECTION SWITCH
- LIMIT SWITCH, NORMALLY OPEN
- LIMIT SWITCH, NORMALLY CLOSED
- PRESSURE SWITCH, NORMALLY OPEN
- 3 PHASE MOTOR
- MOUNTED NEAR EQUIPMENT OR
MOTOR (LOCAL)
- NEUTRAL
- PUSHBUTTON WITH PROVISIONS
FOR LOCK. (N.O.)
- N.C. PUSHBUTTON
- LOCAL CONTROL STATION
ES - EMERGENCY STOP
- GROUND SENSE RELAY
- TWISTED PAIR SHIELDED CABLE
- NORMALLY CLOSED "ON DELAY"
TIMING RELAY
- NORMALLY OPEN "ON DELAY"
TIMING RELAY
- INSTANT CLOSE - DELAY OPEN
TIMING RELAY (OFF DELAY)
- INSTANT OPEN - DELAY CLOSE
TIMING RELAY (OFF DELAY)

PROJECT
RECORD

ROMAN D. KORCHAK, P.E. #42626
ELECTRICAL SECTION HEAD
WASTEWATER DEPARTMENT

No.	DATE	REVISIONS
3		
2		
1		

DES: RDK
DRN: RDK
CKD: *[Signature]*
DATE: 11/16/2010


CITY of TAMPA
WASTEWATER DEPARTMENT

UNIVERSITY PUMPING STATION
REHABILITATION
PUMP CONTROL FLOW CHARTS & SYMBOLS

W.O. 4511
SHEET
E0

B069-171

PROPOSED SEWAGE PUMPS CONTROL CENTER (SECTIONS 6 & 7)

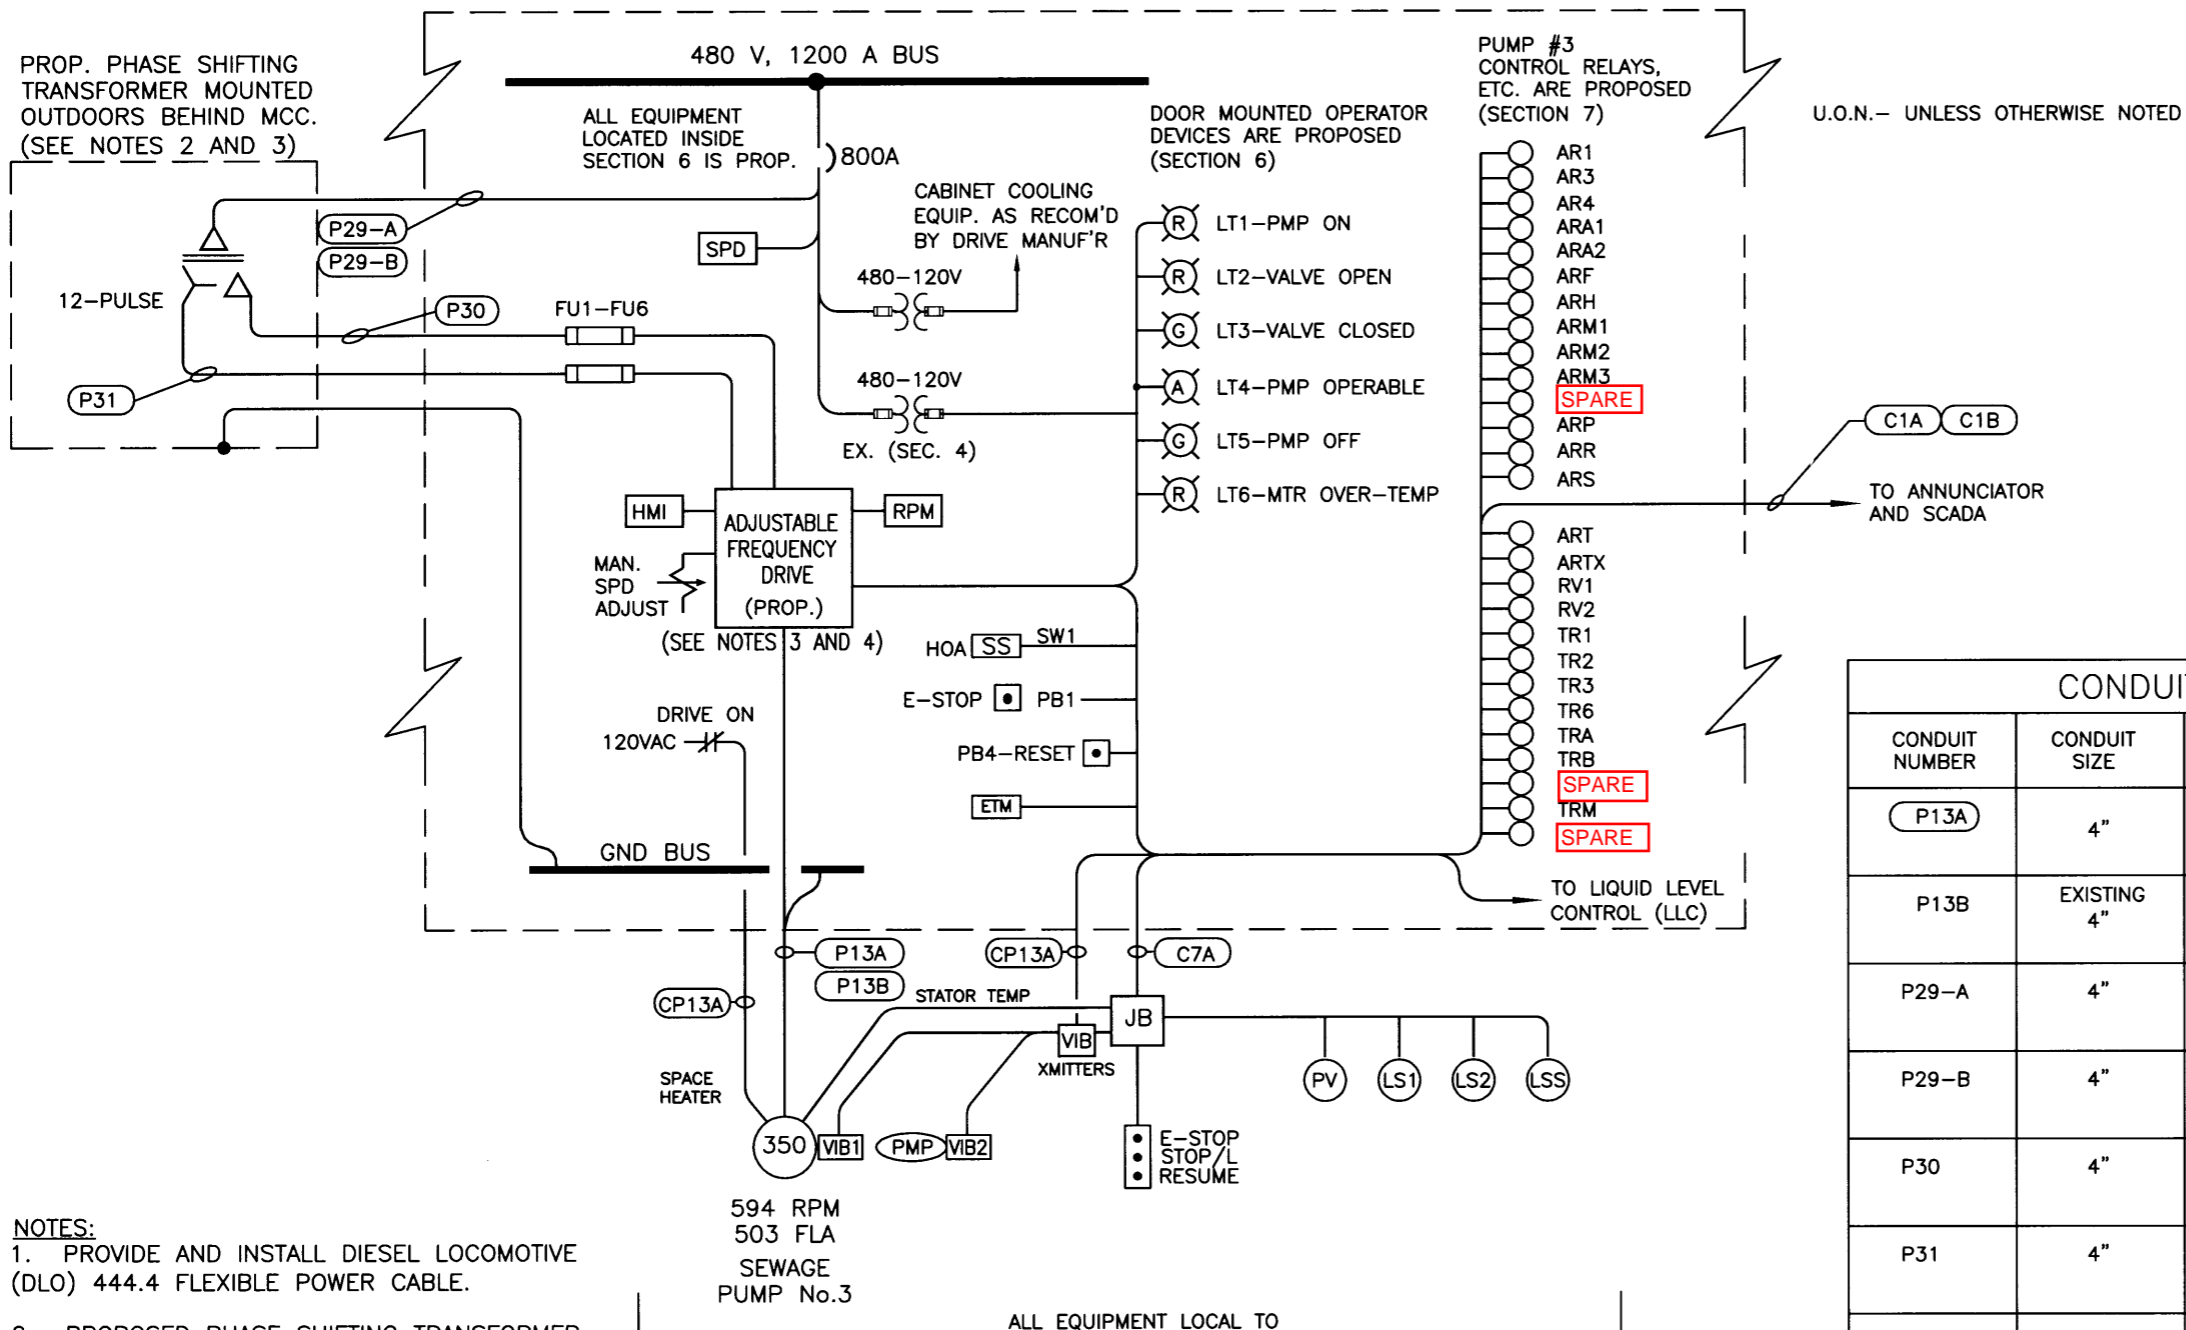


ONE LINE DIAGRAM - PUMP No. 3
480V - 3PH - 60HZ


- NOTES:**
1. PROVIDE AND INSTALL DIESEL LOCOMOTIVE (DLO) 444.4 FLEXIBLE POWER CABLE.
 2. PROPOSED PHASE SHIFTING TRANSFORMER SHALL BE PROVIDED BY VFD SUPPLIER.
 3. THE CONTRACTOR SHALL FURNISH ALL LABOR AND MATERIALS REQUIRED TO CONNECT FROM PROPOSED TRANSFORMER TO PROPOSED VFD.
 4. REMOVAL OF EXISTING EQUIPMENT AND INSTALLATION OF VFD AND ASSOCIATED EQUIPMENT IN SECTION 6 OF MCC SHALL BE PERFORMED BY THE VFD MANUFACTURER.
 5. ALL OTHER CONTROL WORK MAY BE PERFORMED AT THE DISCRETION OF THE CONTRACTOR.

CONDUIT AND CONDUCTOR SCHEDULE					
CONDUIT NUMBER	CONDUIT SIZE	CONDUCTOR QUAN. & SIZE	FROM	TO	REMARKS
P13A	4"	(3)-400KCMIL (1)-#2/0 GND	PUMP CONTROL CENTER, SEC. 6	PUMP MOTOR No. 3	POWER LEADS
P13B	EXISTING 4"	(3)-400KCMIL (1)-#2/0 GND	PUMP CONTROL CENTER, SEC. 7	12-PULSE TRANSFORMER	PRIMARY LEADS
P29-A	4"	(3)-DLO 444.4 (1)-#2/0 GND (SEE NOTE 1)	PUMP CONTROL CENTER, SEC. 6	T.B. AT PUMP No.3 MOTOR	CONTROL WIRING
P29-B	4"	(3)-DLO 444.4 (1)-#2/0 GND (SEE NOTE 1)	PUMP CONTROL CENTER, SEC. 7	PUMP MOTOR No. 3	SPACE HEATER
P30	4"	(3)-DLO 444.4 (1)-#2/0 GND (SEE NOTE 1)	PUMP CONTROL CENTER, SEC. 6	VIB. XMITTERS	ANALOG SIG.
P31	4"	(3)-DLO 444.4 (1)-#2/0 GND (SEE NOTE 1)	PUMP CONTROL CENTER, SEC. 7	VIB. XMITTERS	120VAC POWER
C7A	1-1/2"	(34)-#14 (2)-#12 GND	PUMP CONTROL CENTER, SEC. 6	METERING AND SCADA PANEL	ANNUN. & RTU WIRING
CP13A	2"	(2)-#10 (1)-#10 GND (2)#16-2C, SHLD (2)#16-3C, SHLD	PUMP CONTROL CENTER, SEC. 7		
C1A OR C1B	EXISTING	ADD COND. AS REQ'D	PUMP CONTROL CENTER, SEC. 7		


PROJECT RECORD

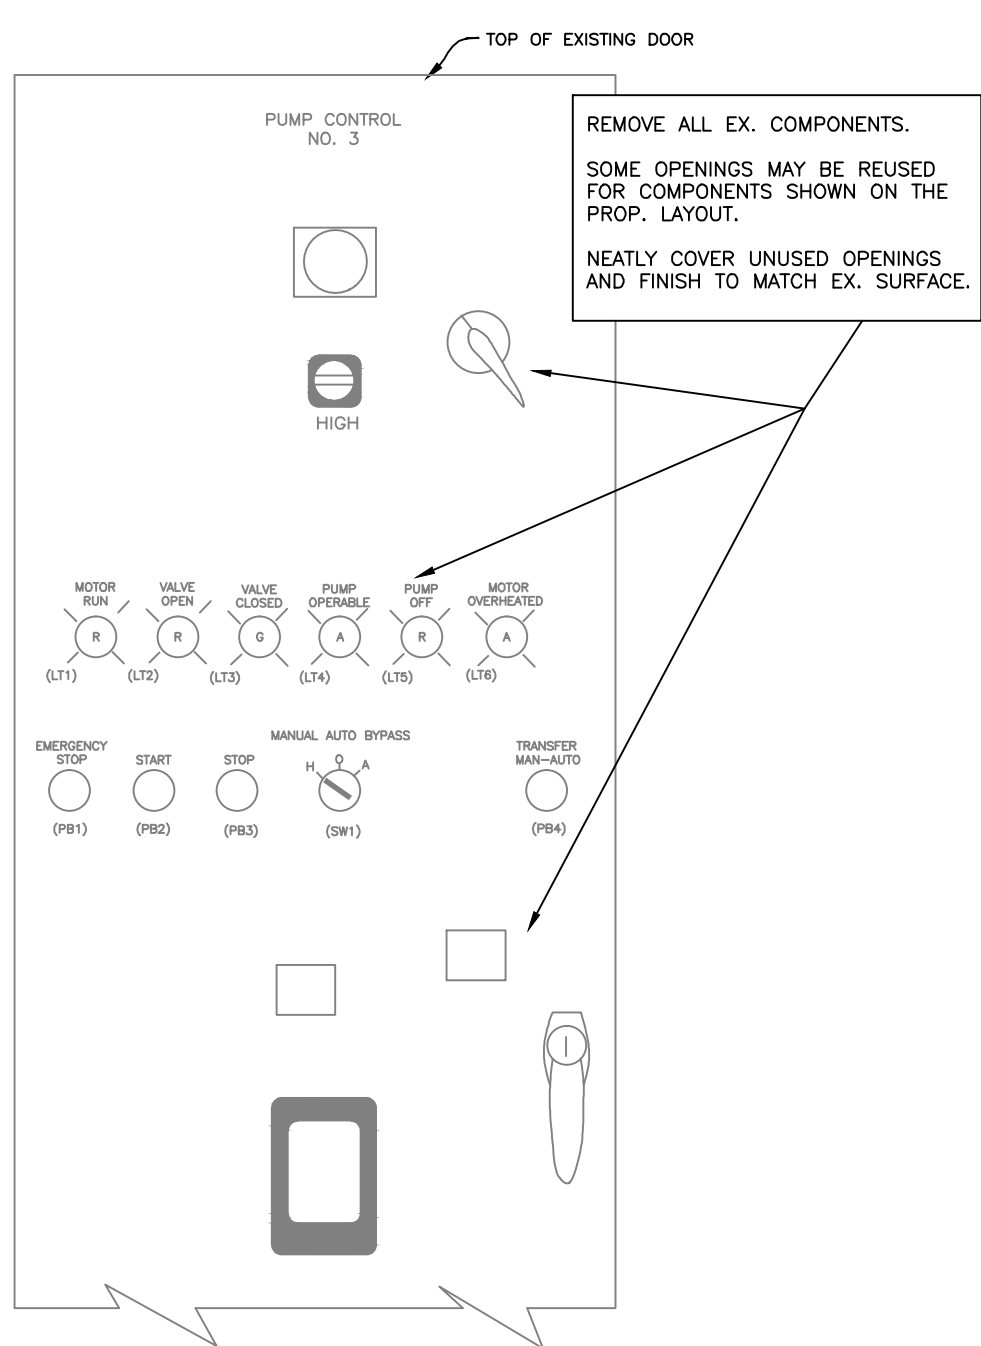

SEWAGE PUMP No.3
SECTION 6- EX. LAYOUT
 (SEE INDEXED NOTE 1, SHT. E3)

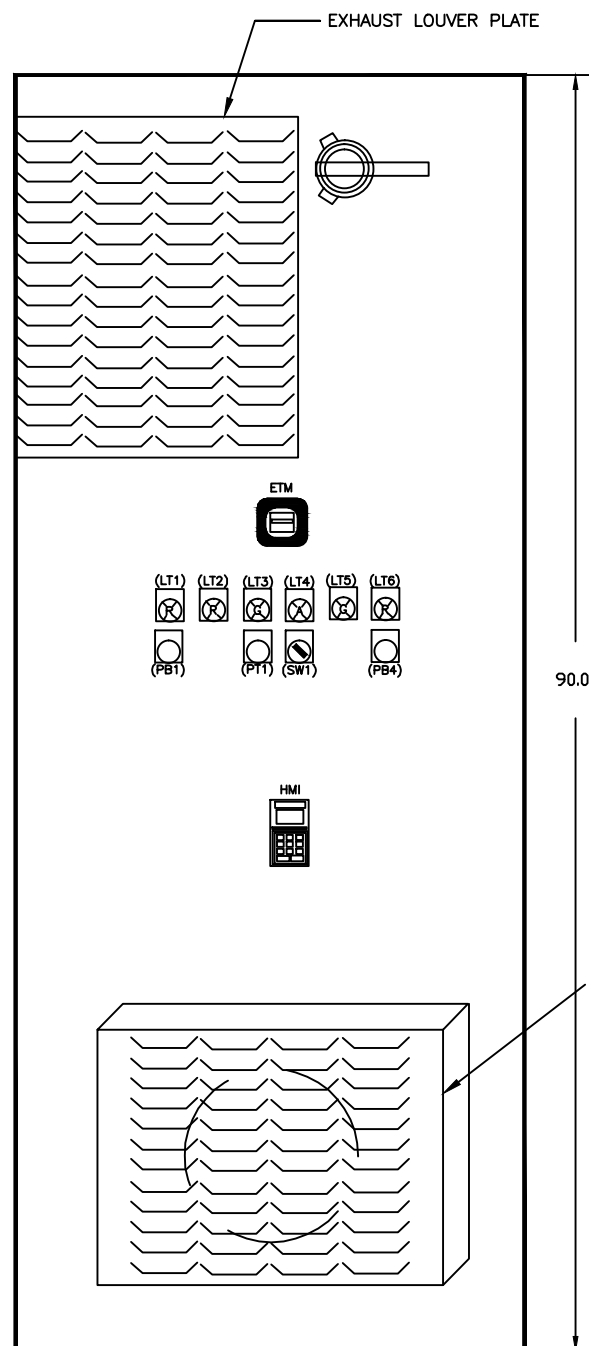

SEWAGE PUMP No.3
SECTION 6 - PROP. LAYOUT
 (SEE INDEXED NOTE 1, SHT. E3)

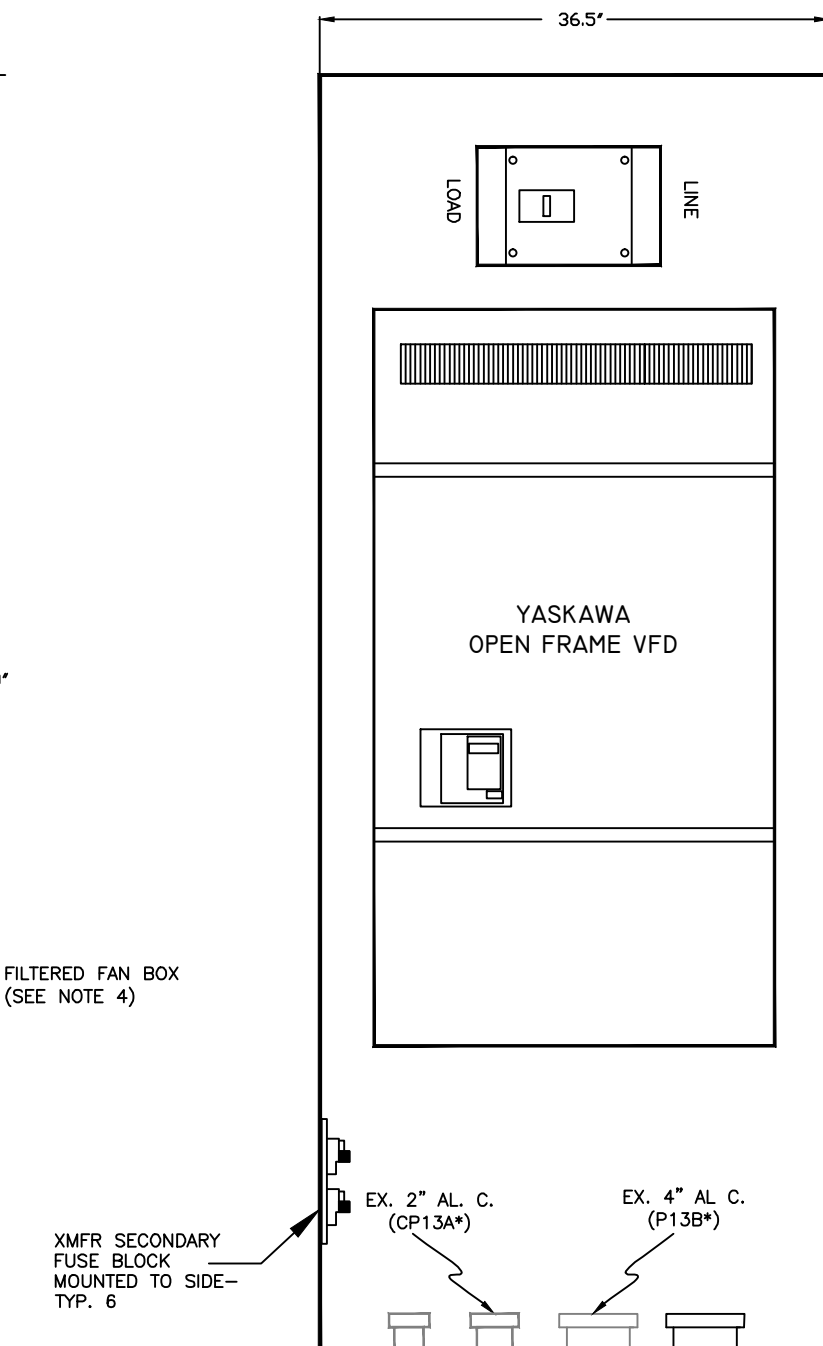

SEWAGE PUMP No.3
SECTION 6 - PROP. LAYOUT
 (DOOR REMOVED FOR CLARITY)
 (SEE INDEXED NOTE 2, SHT. E3)

- NOTES:**
- EXISTING CONDUITS TO BE REUSED BY ELECTRICAL CONTRACTOR.
 - PROPOSED 4" AL. CONDUIT SHALL BE OF THE SAME MATERIAL AND LENGTH AS EXISTING 4" AL. C.
 - SEE SHEET E3 FOR PART SCHEDULE.
 - VFD #3 VENTILATION SHALL BE PROVIDED AND INSTALLED BY AN INDIVIDUAL WITH YASKAWA AUTHORIZED SERVICE PROVIDER CERTIFICATION.
 - LIGHTER LINE WEIGHT ITEMS ARE EXISTING.
- * INDICATES CONDUIT NUMBER

PROJECT RECORD

ROMAN D. KORCHAK, P.E. #42626
 ELECTRICAL SECTION HEAD
 WASTEWATER DEPARTMENT

No.	DATE	REVISIONS
3		
2		
1		


DES: LRG
 DRN: LRG
 CKD:
 DATE:

CITY of TAMPA
 WASTEWATER DEPARTMENT

UNIVERSITY PUMPING STATION
 REHABILITATION
 ELECTRICAL- VFD CUBICLE LAYOUT

W.O. 4511
 SHEET
E2

B069-173

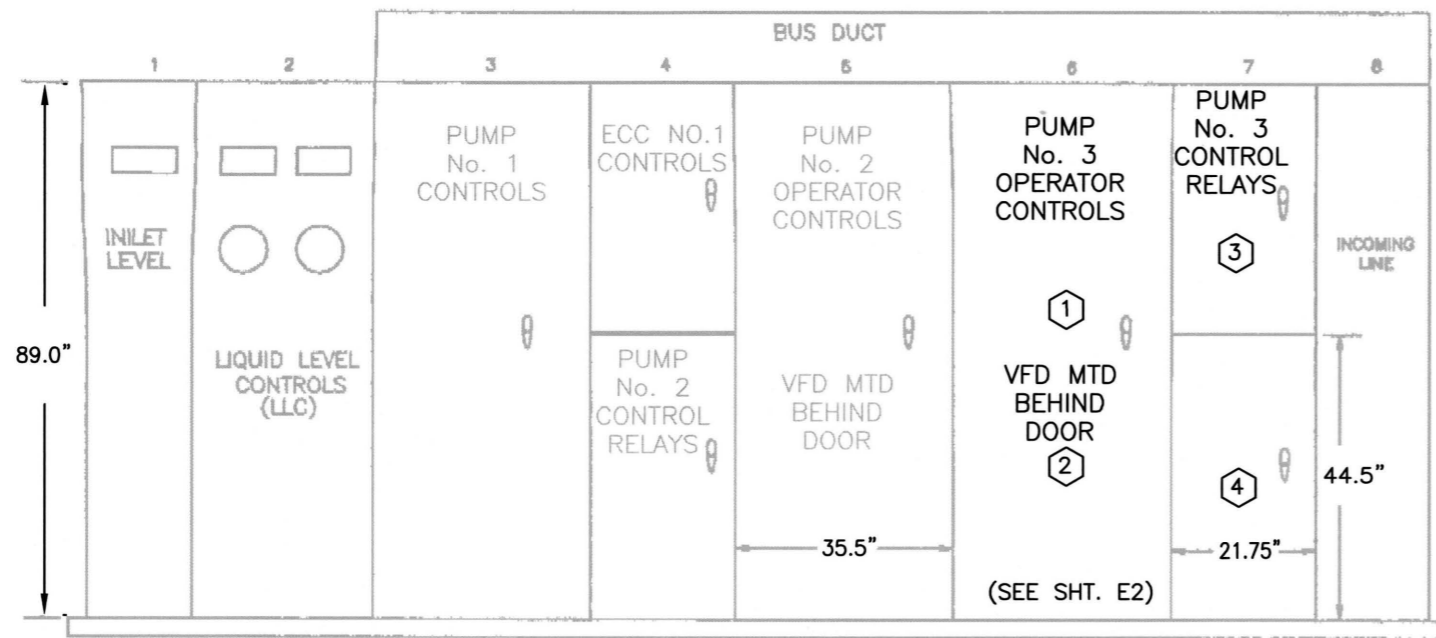

**EXISTING SEWAGE PUMPS CONTROL CENTER
(FRONT ELEVATION)**

THE NOTED EXISTING EQUIPMENT SHALL BE REMOVED OR MODIFIED AS REQUIRED TO FACILITATE THE INSTALLATION OF THE NEW EQUIPMENT PROVIDED AND INSTALLED UNDER THIS CONTRACT.

INDEXED NOTES:

- 1 REMOVE ALL EXISTING DOOR MOUNTED OPERATOR DEVICES AND INSTALL PROPOSED DEVICES AS SHOWN. NEATLY COVER EXISTING OPENINGS NOT BEING UTILIZED AND FINISH TO MATCH EXISTING SURFACE. PROVIDE PROPER LEGEND PLATES AS SHOWN ON PARTS SCHEDULE. PROPOSED LEGEND PLATES ENGRAVING, LETTERING SIZE, AND MATERIAL SHALL MATCH EXISTING LEGEND PLATES. THE VFD MANUFACTURER SHALL REMOVE EXISTING EQUIPMENT IN SECTION 6 AND INSTALL THE PROPOSED VFD AND ALL ASSOCIATED EQUIPMENT REQUIRED TO SUPPORT THE INSTALLATION OF THE PROPOSED VFD.
- 2 ALL EQUIPMENT LOCATED INSIDE SECTION 6 IS PROPOSED.
- 3 AS-BUILT RECORDS SHOW THAT SECTION 7 CONTAINS ONLY EXISTING ECC No. 3 CONTROLS—CONTRACTOR SHALL VERIFY THIS, AND BRING ANY DISCREPANCIES TO THE ATTENTION OF THE ENGINEER. REMOVE THE EXISTING CONTROLS AND REPLACE WITH THE THE PUMP No. 3 PROPOSED CONTROLS SHOWN ON SHEET E5.
- 4 PROPOSED 12-PULSE TRANSFORMER CONDUIT ENTRY/EXIT LOCATION.

PARTS SCHEDULE			
SYMBOL	DESCRIPTION	MANUF'R / MODEL	REMARKS
LT1	PILOT LIGHT, 120VAC, LED TYPE, PRESS TO TEST, W/ RED LENS	SQUARE D, CLASS 9001, SKT-38LRR9	LEGEND PLATE: " MOTOR RUN "
LT2	PILOT LIGHT, 120VAC, LED TYPE, PRESS TO TEST, W/ RED LENS	SQUARE D, CLASS 9001, SKT-38LRR9	LEGEND PLATE: " VALVE OPEN "
LT3	PILOT LIGHT, 120VAC, LED TYPE, PRESS TO TEST, W/ GREEN LENS	SQUARE D, CLASS 9001, SKT-38LGG9	LEGEND PLATE: " VALVE CLOSED "
LT4	PILOT LIGHT, 120VAC, LED TYPE, PRESS TO TEST, W/ YELLOW LENS	SQUARE D, CLASS 9001, SKT-38LYY9	LEGEND PLATE: " PUMP OPERABLE "
LT5	PILOT LIGHT, 120VAC, LED TYPE, PRESS TO TEST, W/ GREEN LENS	SQUARE D, CLASS 9001, SKT-38LGG9	LEGEND PLATE: " PUMP OFF "
LT6	PILOT LIGHT, 120VAC, LED TYPE, PRESS TO TEST, W/ RED LENS	SQUARE D, CLASS 9001, SKT-38LRR9	LEGEND PLATE: " MOTOR OVERTEMP "
PB1	RED MUSHROOM HEAD PUSH BUTTON, 1-3/8" DIA.	SQUARE D, CLASS 9001, SKR4RH13	LEGEND PLATE: " EMERGENCY STOP "
PB4	BLACK FLUSH HEAD PUSH BUTTON	SQUARE D, CLASS 9001, SKR1B, W/ (2) KA2 CONTACTS	LEGEND PLATE: " DRIVE RESET "
SW1	THREE POSITION SWITCH (MAINTAINED)	SQUARE D, CLASS 9001, SKS43BH2	LEGEND PLATE: " MODE HAND-OFF-AUTO "
PT1	10- TURN POTENTIOMETER W/ TURNS COUNTING DIAL	HONEYWELL #73JA2K POT BOURNS #H-46-6A DIAL	LEGEND PLATE: " MANUAL SPEED ADJUST "
ETM	ELAPSED TIME METER	GRASSLIN/INTERMATIC, INC UWZ SERIES UWZ48	PROVIDE SOCKET BASE
CVT	CONTROL VOLTAGE TRANSFORMER	SQUARE D, CLASS 9070, TF 500D1	500 VA, 240/480- 120 V
AR1, AR3, AR4, ARA1, ARA2, ARF, ARH, ARM1, ARM2, ARM3, ARO, ARP, ARR, ARS, ART, ARTX, RV1, RV2	CONTROL RELAY-- 120VAC COIL; 4PDT, 15AMP, AgNi CONTACTS; MECH & LED RELAY STATUS INDICATOR; CONTACT PUSH TO TEST BUTTON; W/ DIN RAIL SOCKET	TELEMECANIQUE RPM42F7 RELAY W/ RPZF4 SOCKET	PROVIDE ALUMINUM DIN RAIL AND LABELING AS NECESSARY
TR1, TR2, TR3, TR6, TRA, TRB, TRH, TRM, TRX	UNIVERSAL TIME DELAY RELAY-- SOLID STATE, 120VAC INPUT; DPDT, 10AMP CONTACTS; KNOB ADJUSTABLE DELAY; 0.1-SEC TO 1000-MIN. DELAY IN SIX RANGES; W/ DIN RAIL SOCKET	ABB / SSAC MODEL TRU3 RELAY W/ NDS-11 SOCKET	PROVIDE ALUMINUM DIN RAIL AND LABELING AS NECESSARY
TB	TERMINALS, 600V 30A	PHOENIX CONTACT STYLE UK5N	PROVIDE AL. DIN RAIL AND LABEL AS NECESSARY

**MCC SECTIONS 6 & 7, PARTS SCHEDULE
(SCHEMATIC ON SHEETS E4 -E6)**

**PROJECT
RECORD**


ROMAN D. KORCHAK, P.E. #42626 ELECTRICAL SECTION HEAD WASTEWATER DEPARTMENT	No.	DATE	REVISIONS	DES: LRG/RDK DRN: LRG/RDK CKD: <i>RL</i> DATE: 2/18/11	CITY of TAMPA WASTEWATER DEPARTMENT	UNIVERSITY PUMPING STATION REHABILITATION MCC LAYOUT AND PARTS SCHEDULE	W.O. 4511 SHEET E3
	3						
	2						
	1						

B069-174

NOTES:

- △ - DENOTES PROPOSED FIELD CONNECTION TERMINALS LOCATED IN THE UPPER HALF OF SECTION 7 OF THE PUMP CONTROL CENTER (SEE SHT. E5). THE SHOP DRAWING SUBMITTAL SHALL SHOW TERMINAL DESIGNATION DETAILS.
- COORDINATE WITH EQUIPMENT MANUFACTURER WIRING DETAILS & SPECIFIC I/O CONNECTION POINTS.
- COORDINATE INSTRUMENTATION/CONTROL CONNECTIONS W/ CITY PERSONNEL.
- "*" INDICATES DEVICE IS LOCATED REMOTE FROM ADJUSTABLE FREQUENCY DRIVE ENCLOSURE.
- PROVIDE AND INSTALL A YASKAWA ELECTRIC AMERICA MODEL CIMR-P7U4220-107 VARIABLE FREQUENCY DRIVE WITH THE FOLLOWING RATINGS- 480VAC, 12-PULSE, 567AMP, 472KVA, INPUT CONVERTER; 515AMP, 390KVA, OUTPUT INVERTER.
- THE DIGITAL OPERATOR SHALL BE MOUNTED ON THE AFD ENCLOSURE FRONT DOOR AS SHOWN ON SHT. E2.

PUMP No.3 VFD ENCLOSURE

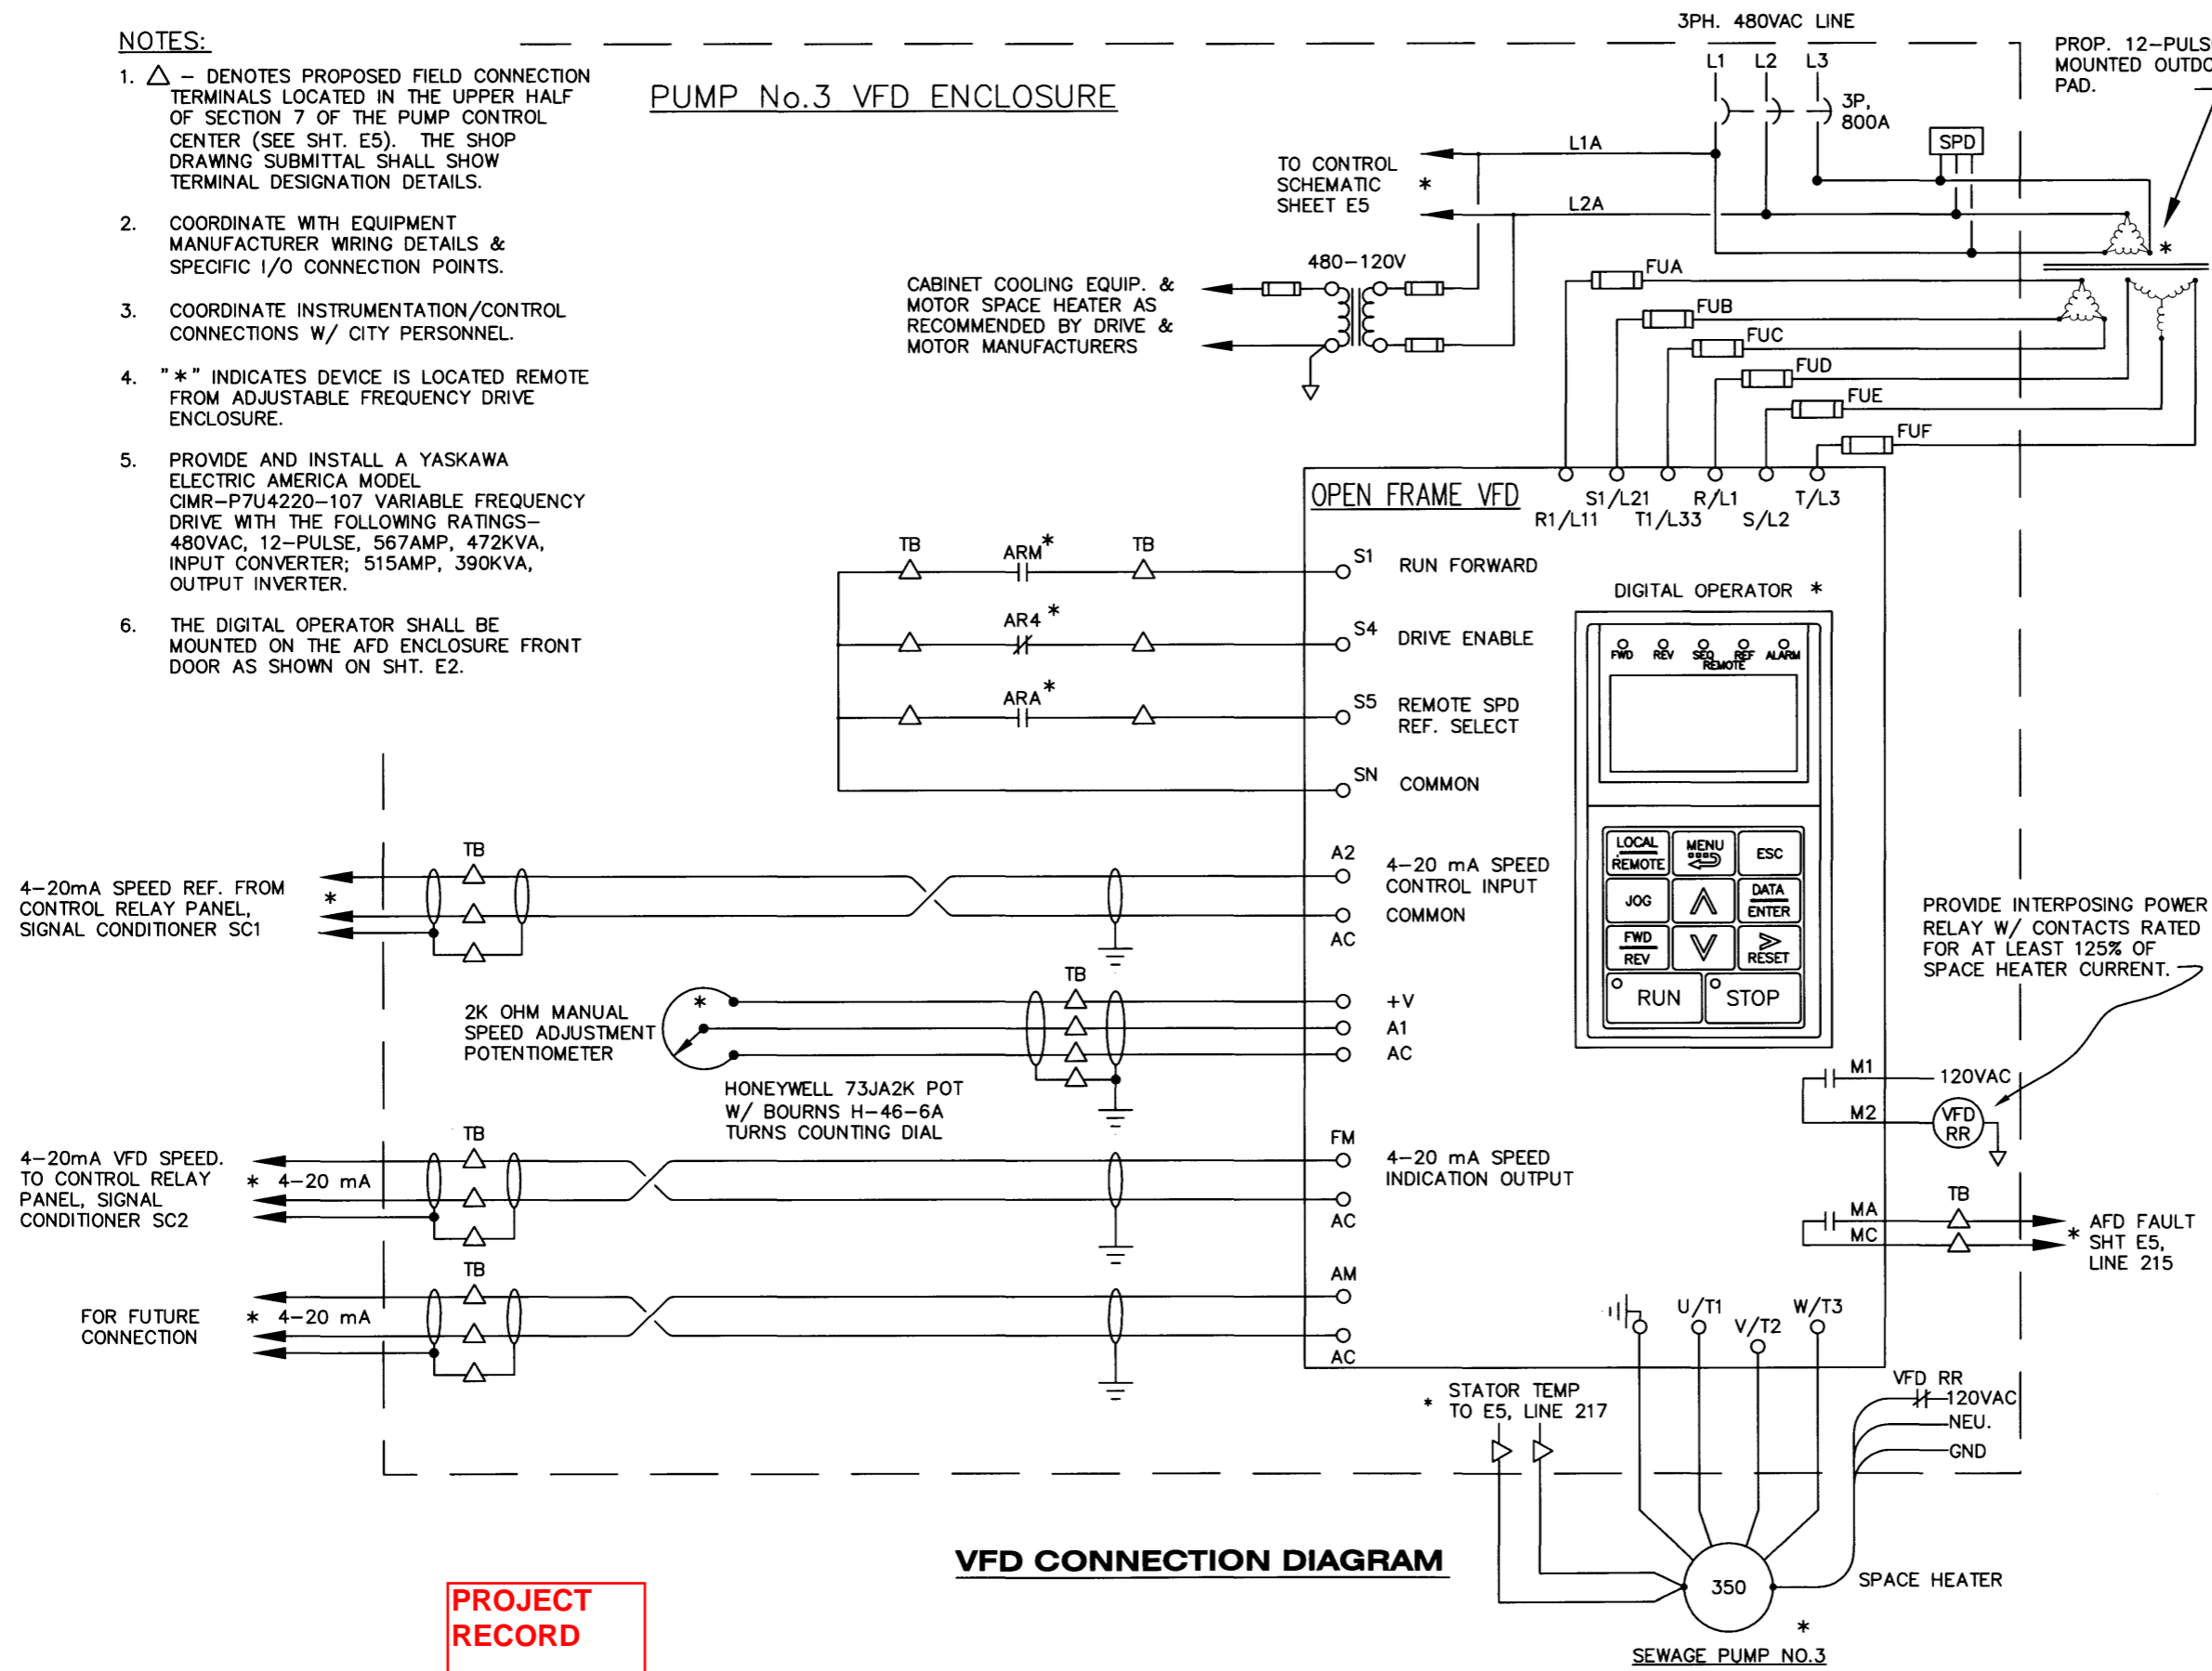


VFD CONNECTION DIAGRAM

PROJECT RECORD

VFD PROGRAMMING		
PARAMETER No.	SETTING	DESCRIPTION
02-01	0	DISABLE LOCAL/REMOTE KEY
02-02	0	DISABLE STOP KEY
B1-01	1	SPEED REF. FROM TERMINALS
B1-02	1	SPEED CMD FROM TERMINALS
H1-02	6A	S4 SET TO DRIVE ENABLE
H1-03	03	S5 SET TO AUX. SPD CMD
H2-01	00	M1, M2 CLOSED DURING "RUN"
H3-02	100.0	A1 GAIN SET TO 100%
H3-03	50.0	A1 ZERO BIAS SET TO 50%
H3-08	02	A2 SET FOR 4-20MA INPUT
H3-09	02	TERMINAL A2 SET TO AUX. SPD REF.
H3-10	100.0	A2 GAIN SET TO 100%
H3-11	50.0	A2 ZERO BIAS SET TO 50%
H3-13	0	TERMINAL A1 SET TO MAIN SPD REF.
H4-01	2	FM SET FOR 4-20MA SPEED OUTPUT
H4-02	100.0	FM GAIN SET TO 100%
H4-03	50.0	FM ZERO BIAS SET TO 50%
H4-04	3	AM SET TO DRIVE OUTPUT CURRENT
H4-05	100.0	AM GAIN SET TO 100%
H4-06	0	AM ZERO BIAS SET TO 50%
H4-07	02	FM SET FOR 4-20MA OUTPUT
H4-08	02	AM SET FOR 4-20MA OUTPUT



B069-175

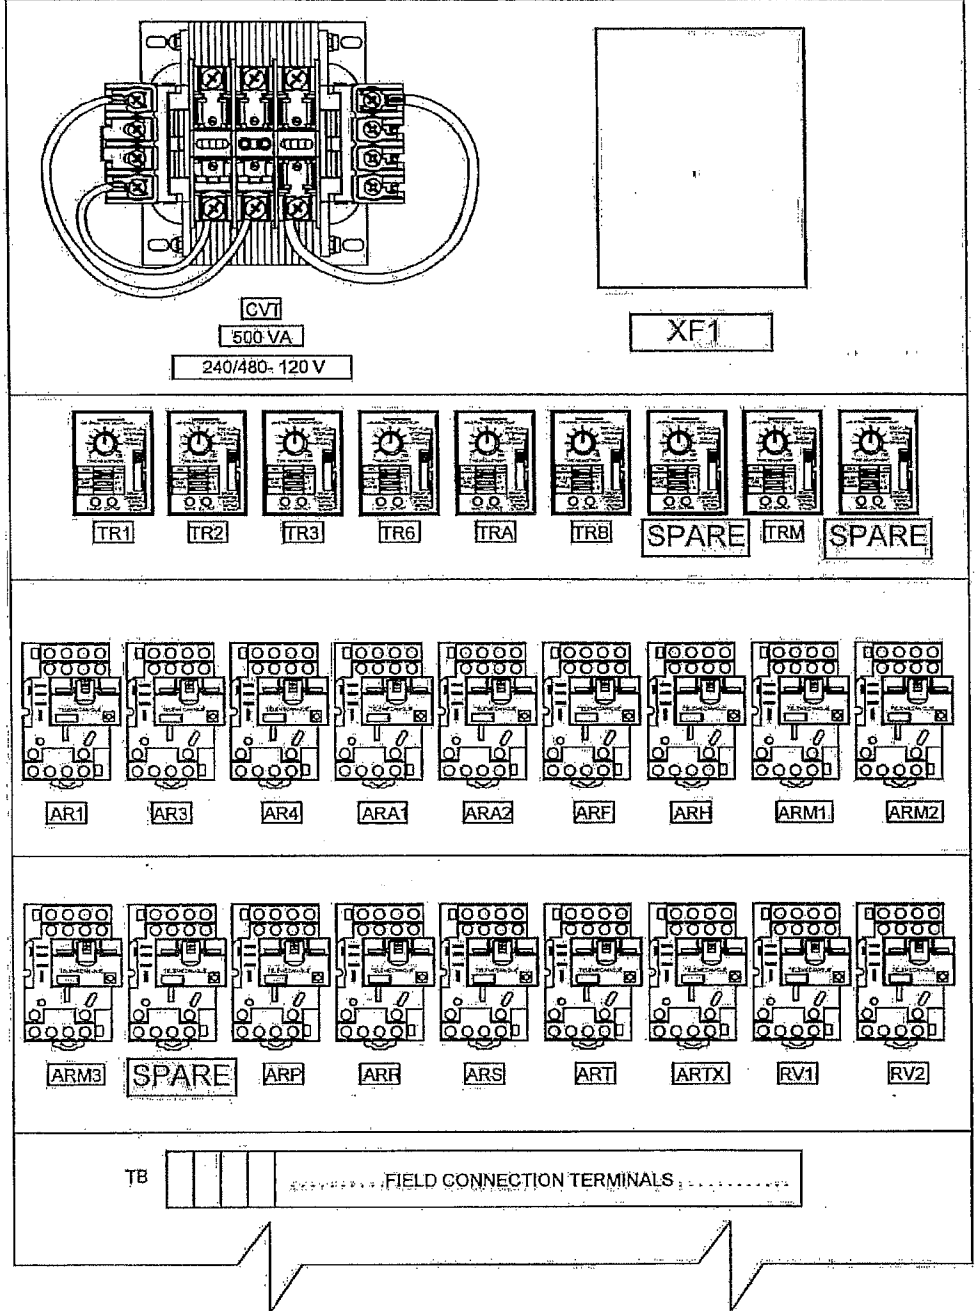

PUMP No. 3. PROPOSED CONTROLS LAYOUT
 SCALE: 1:4
 (CONTROLS ARE LOCATED IN THE UPPER HALF OF SECTION 7 OF THE PUMP CONTROL CENTER)

PROJECT RECORD

ROMAN D. KORCHAK, P.E. #42626 ELECTRICAL SECTION HEAD WASTEWATER DEPARTMENT	No.	DATE	REVISIONS	DES: RDK/LRG	CITY of TAMPA WASTEWATER DEPARTMENT	UNIVERSITY PUMPING STATION REHABILITATION PUMP No.3 CONTROLS (SHT. 1 OF 6)	W.O. 4511
	3			DRN: RDK/LRG			SHEET
	2			CKD: 2/18/11			E5
	1			DATE: 2/18/11			

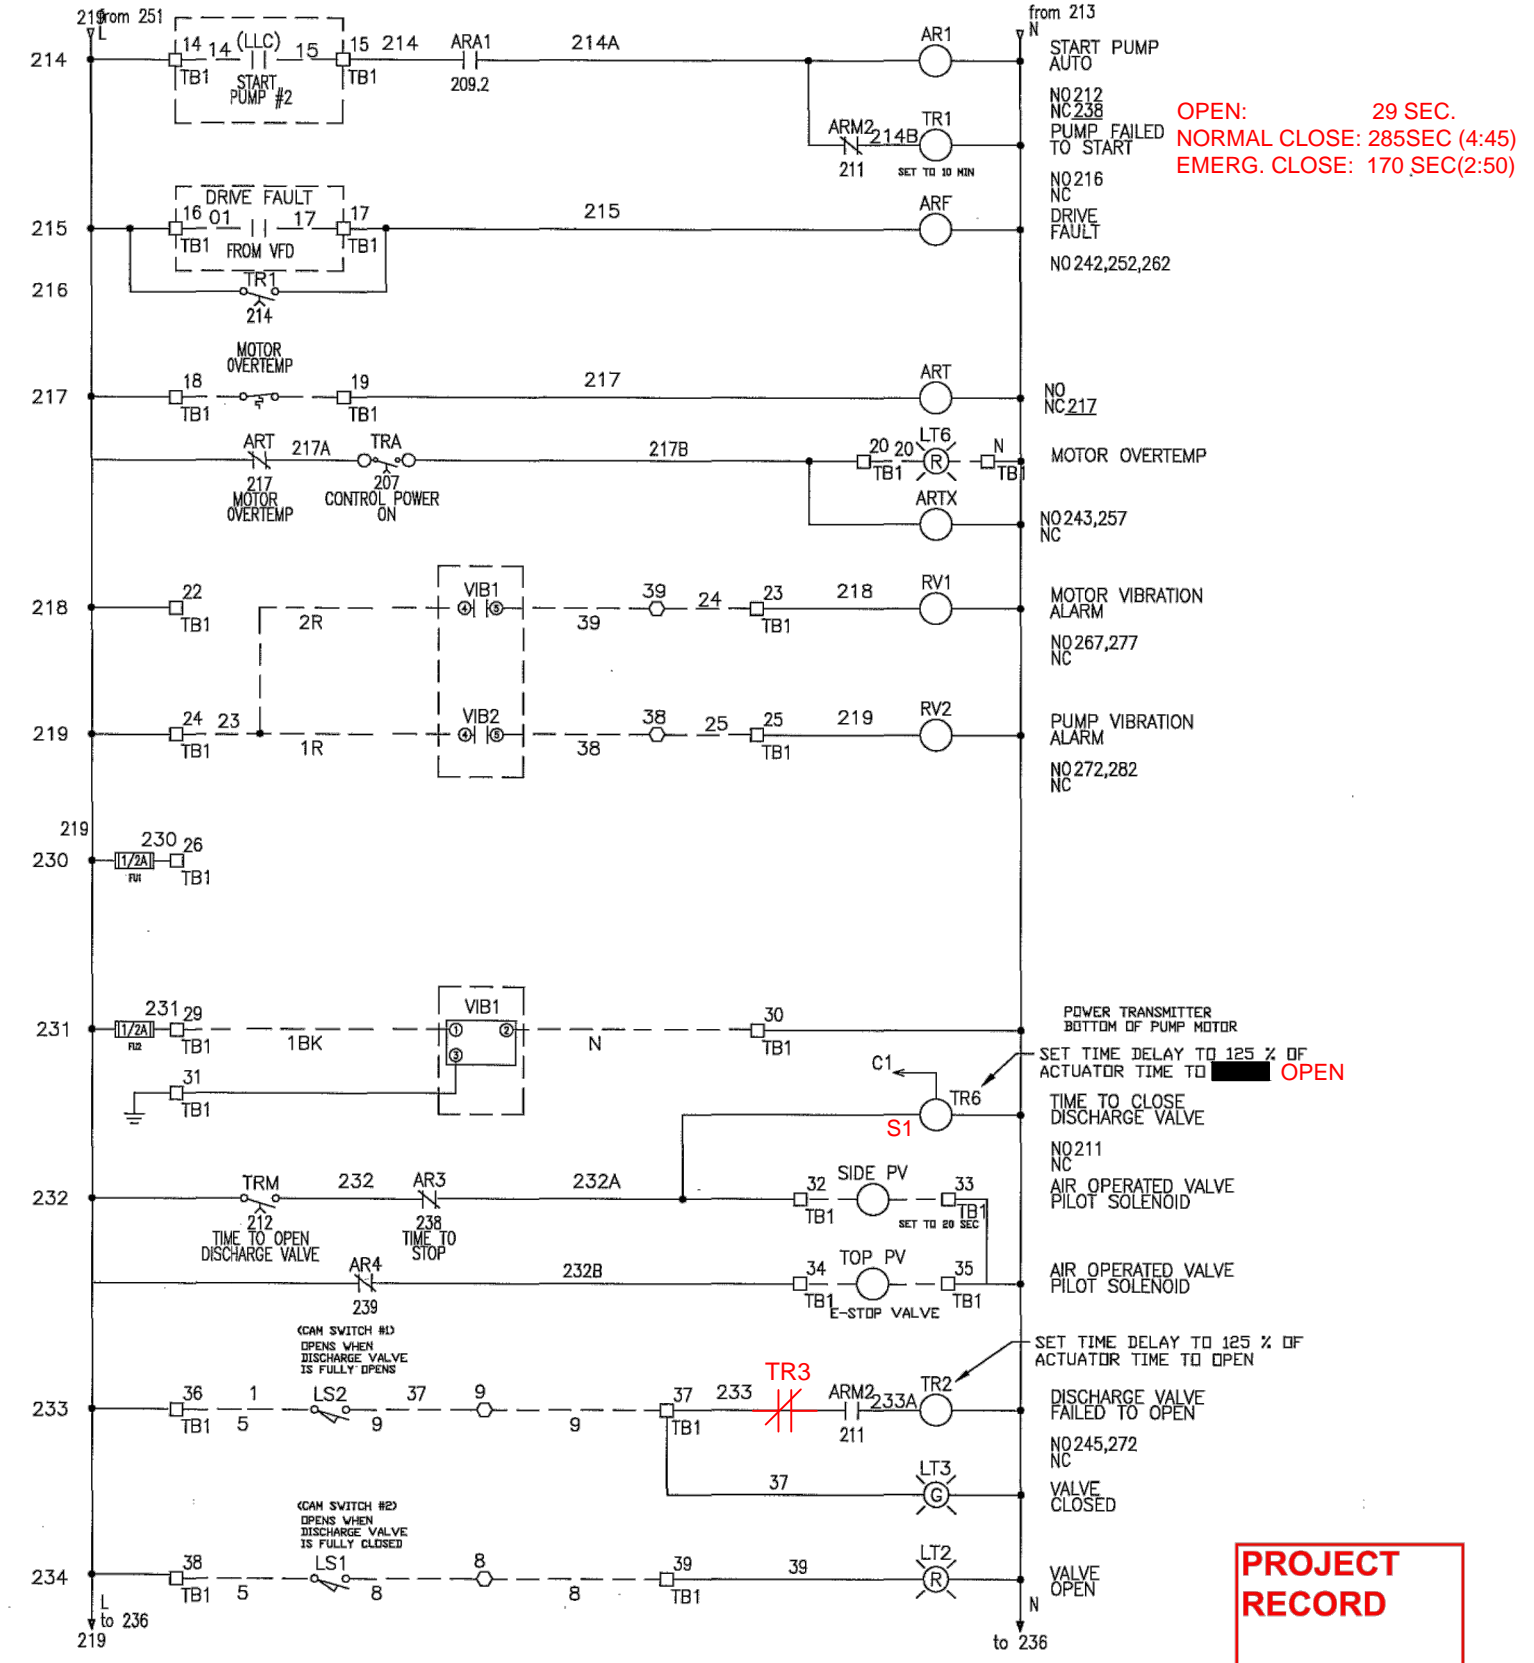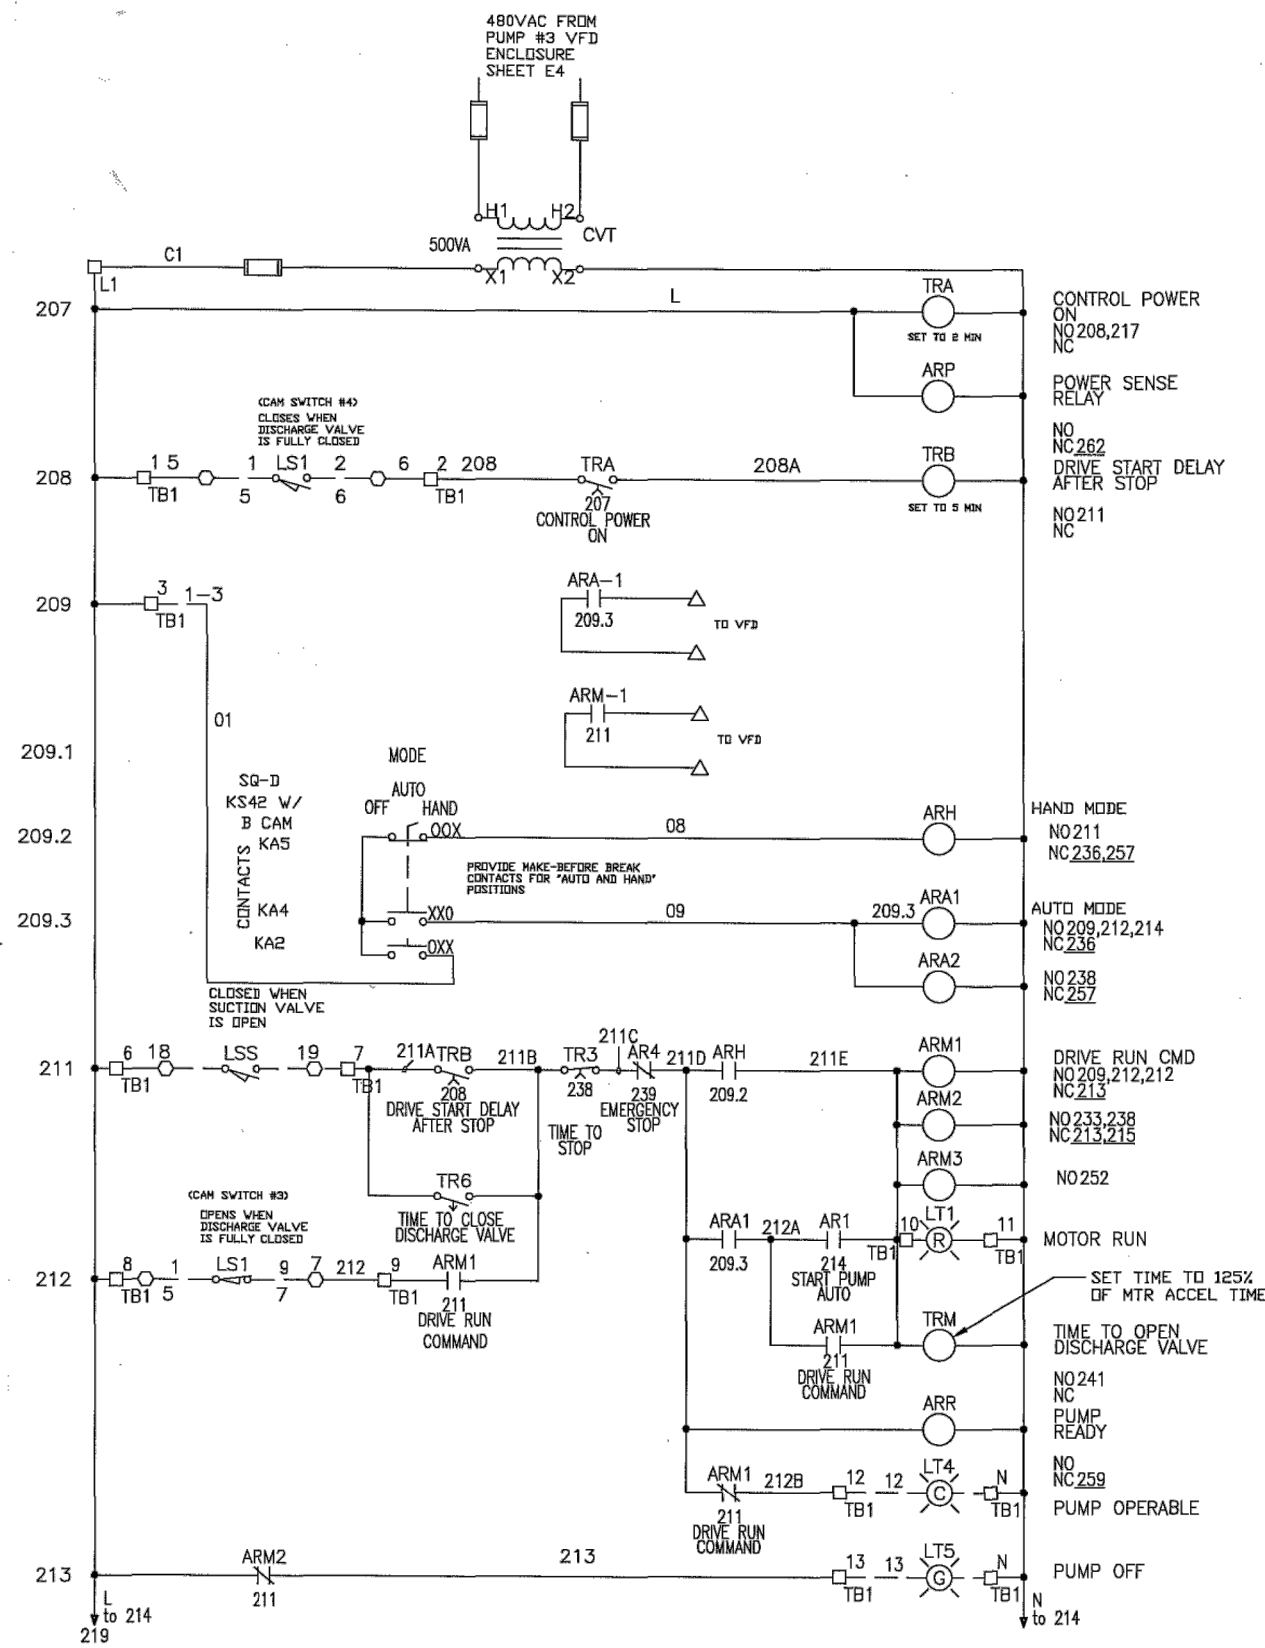

OPEN: 29 SEC.
 NORMAL CLOSE: 285SEC (4:45)
 EMERG. CLOSE: 170 SEC(2:50)

PROJECT RECORD

ROMAN D. KORCHAK, P.E. #42626
 ELECTRICAL SECTION HEAD
 WASTEWATER DEPARTMENT

No.	DATE
3	
2	
1	

NOTES:2015
 1010-12 E01 & E02
 IS UNDER CITY
 CONTRACT 8-C-34

1010-18 E01 & E02
 IS UNDER CITY
 CONTRACT 11-C-00008

REVISIONS

DES: RDK
 DRN: RDK
 CKD: *RDK*
 DATE: 11/8/2010

CITY of TAMPA
 WASTEWATER DEPARTMENT

UNIVERSITY PUMPING STATION
 REHABILITATION
 PUMP No.3 CONTROLS (SHT. 2 OF 6)


W.O. 451
 SHEET
E5A

B069-176



LS	CONTACT	DISCHARGE VALVE POSITION		
		FULLY CLOSED	INTERMED POSITION	FULLY OPEN
LS1	1		X	X
	2	X		
	3		X	X
	4	X		
LS2	1	X	X	
	2			X
	3	X	X	
	4			X

PROJECT RECORD

B069-176A

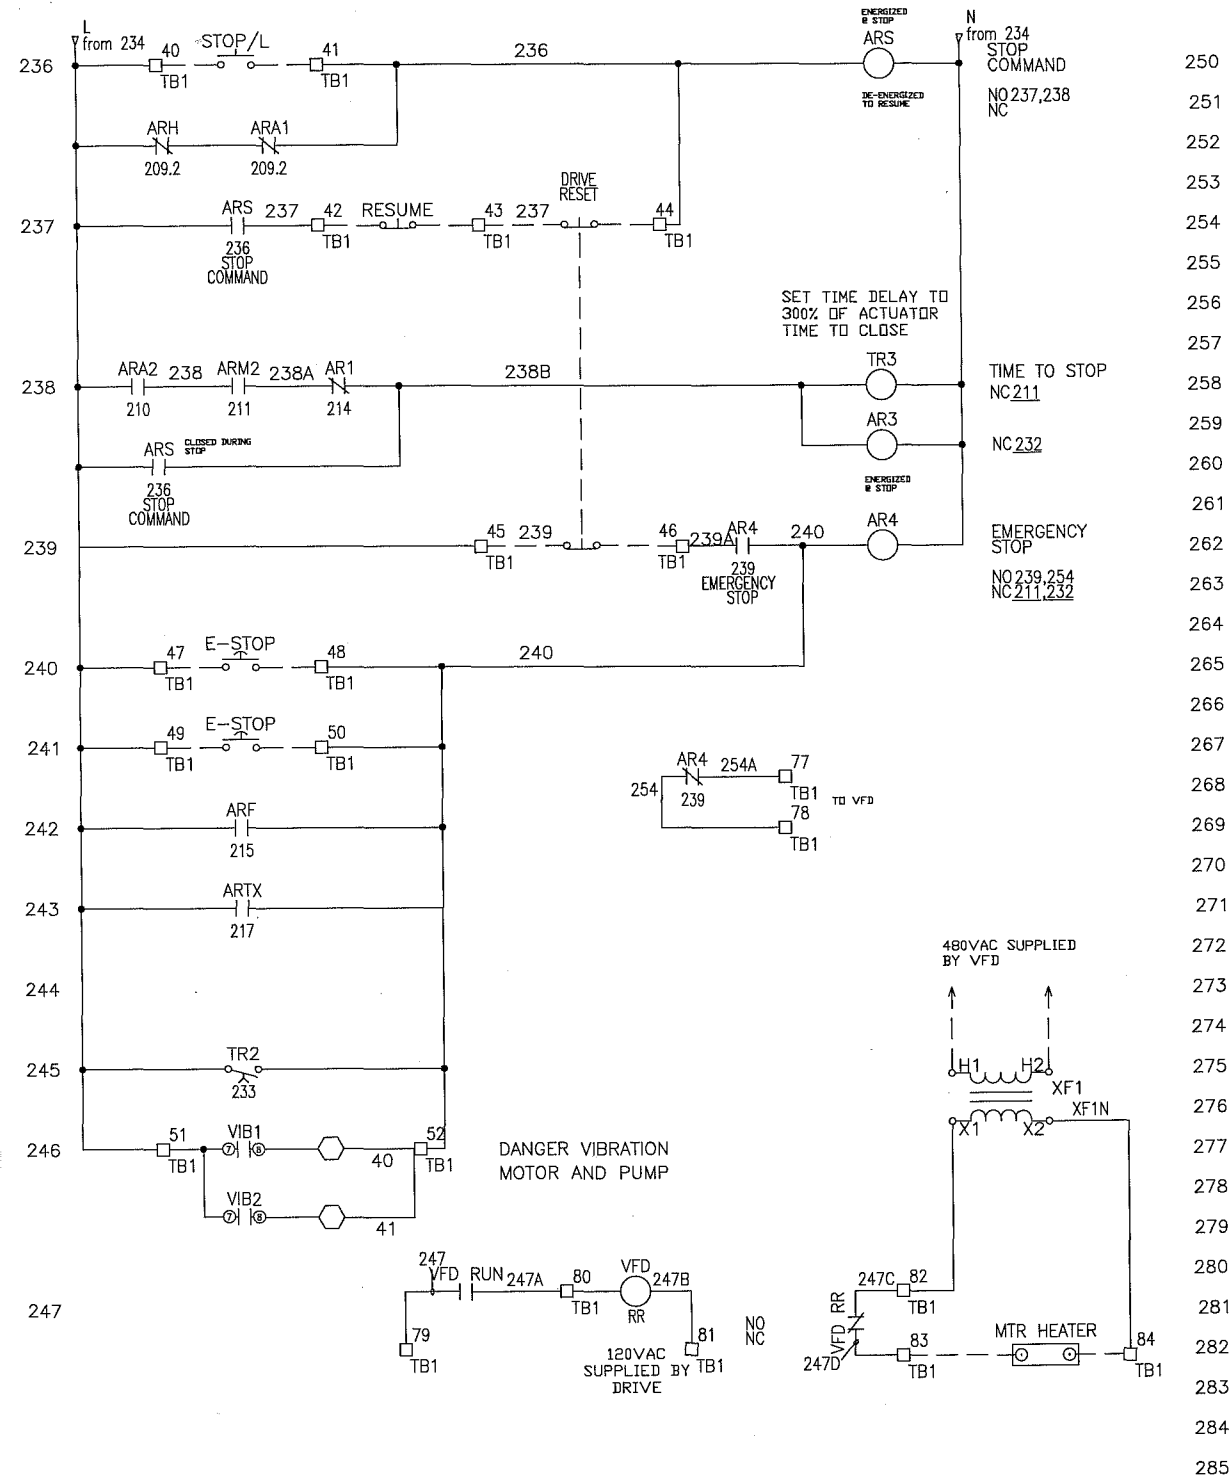

250
251
252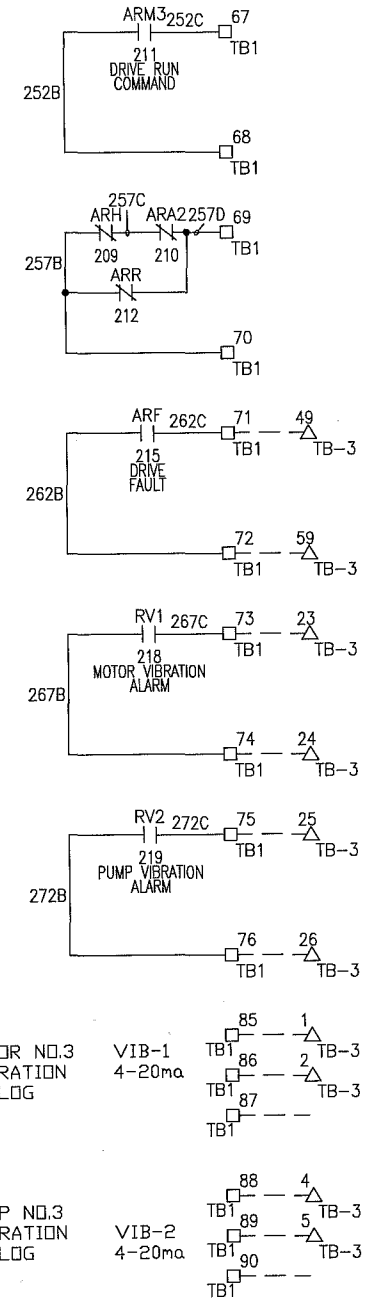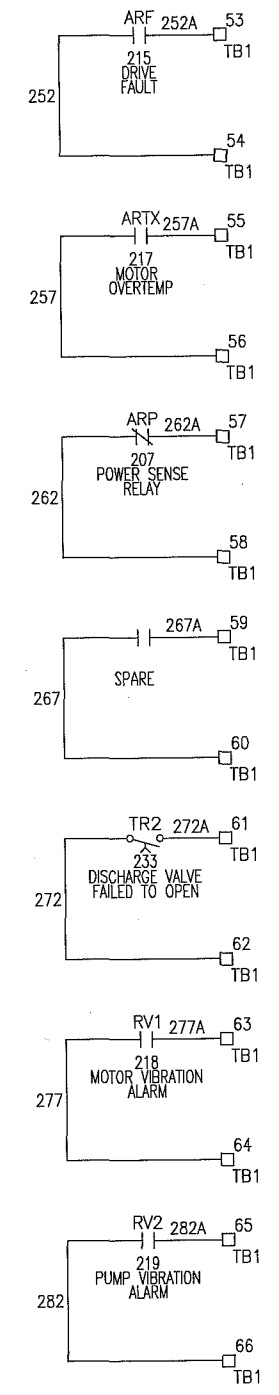
PROJECT RECORD

TO EXISTING ANNUNCIATOR NO.2

TO EXISTING SCADA RTU

ROMAN D. KORCHAK, P.E. #42626 ELECTRICAL SECTION HEAD WASTEWATER DEPARTMENT	No.	DATE	REVISIONS	DES: RDK	CITY of TAMPA WASTEWATER DEPARTMENT	UNIVERSITY PUMPING STATION REHABILITATION PUMP No.3 CONTROLS (SHT. 4 OF 6)	W.O. 4511
	3			DRN: RDK			SHEET
	2			CKD: <i>[Signature]</i>			E6A
	1			DATE: 11/8/2010			

VIB1 TRANSMITTER

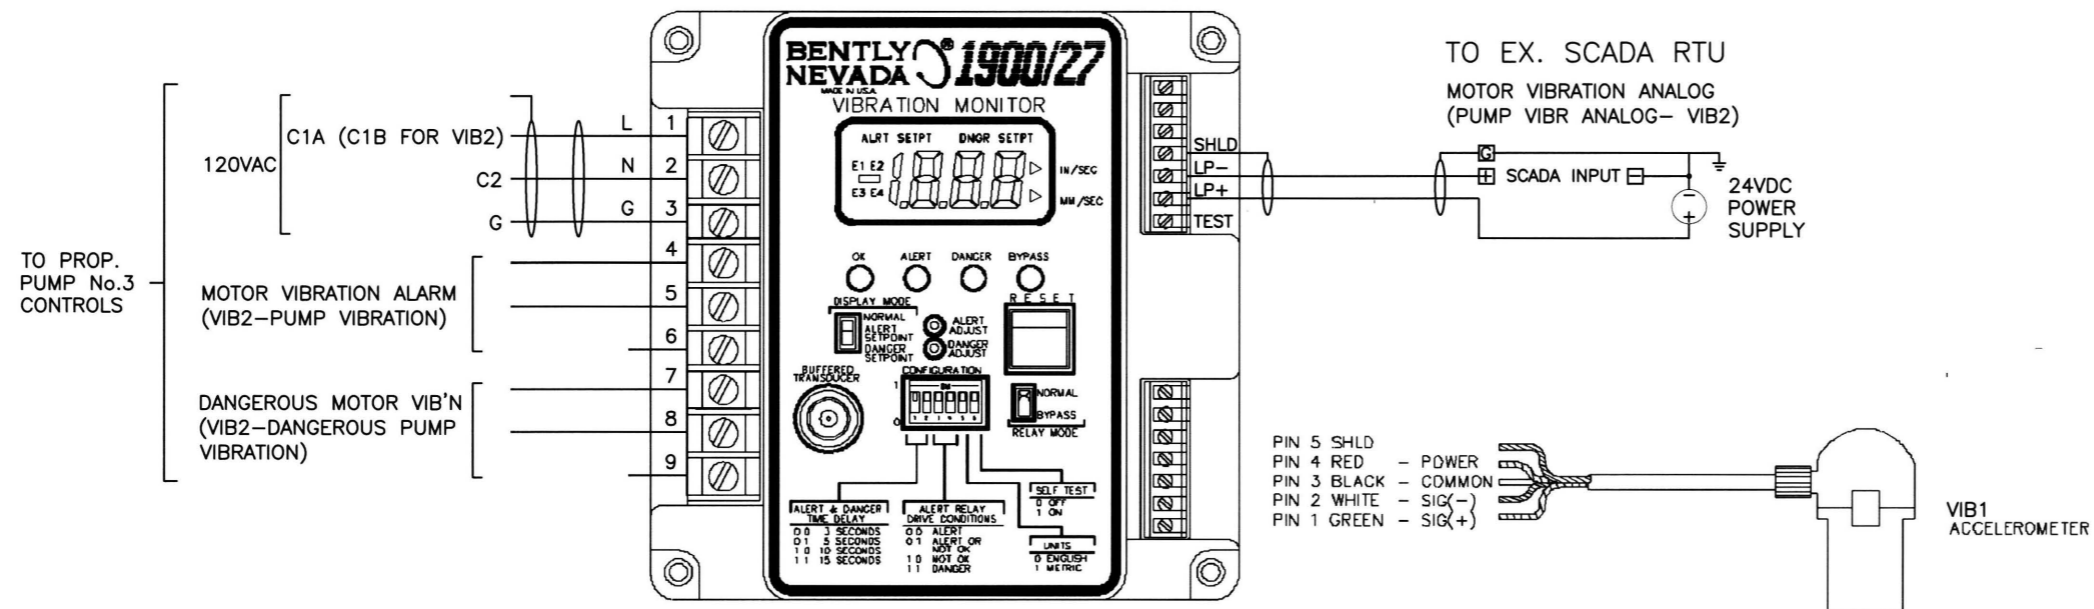

POWER SUPPLY CONNECTIONS	
INPUT VOLTAGE	CONNECTIONS
110 VAC	1 LINE 2 NEUTRAL 3 GROUND
220 VAC	1 LINE 1 2 LINE 2/NEUTRAL 3 GROUND
24 VDC	1 +24 VDC 2 COMMON 3 GROUND

RELAY CONTACTS			
		NORMALLY DE-ENERGIZED (FACTORY DEFAULT)	NORMALLY ENERGIZED
ALERT	4	NORMALLY CLOSED	NORMALLY OPEN
	5	COMMON	COMMON
	6	NORMALLY OPEN	NORMALLY CLOSED
DANGER	7	NORMALLY CLOSED	NORMALLY OPEN
	8	COMMON	COMMON
	9	NORMALLY OPEN	NORMALLY CLOSED


MOTOR VIBRATION MONITOR, VIB1
(PUMP VIBRATION MONITOR, VIB2, IS SIMILAR)

THE PUMP / MOTOR SUPPLIER SHALL PROVIDE THE SPECIFIED VIBRATION MONITORING EQUIPMENT AND INSTALL THE ACCELEROMETERS ON THE MACHINERY AS REQUIRED. VIB1 AND VIB2 TRANSMITTERS SHALL BE MOUNTED IN A COMMON NEMA 4X S.S. ENCLOSURE MOUNTED NEAR THE MACHINERY AND WIRED AS REQUIRED BY THE ELECTRICAL SUBCONTRACTOR.

PROJECT RECORD

ROMAN D. KORCHAK, P.E. #42626 ELECTRICAL SECTION HEAD WASTEWATER DEPARTMENT	No.	DATE	REVISIONS	DES: LRG	CITY of TAMPA WASTEWATER DEPARTMENT	UNIVERSITY PUMPING STATION REHABILITATION PUMP No.3 CONTROLS (SHT. 5 OF 6)	W.O. 4511
	3			DRN: LRG			SHEET
	2			CKD: <i>JK</i>			E7
	1			DATE: 2/18/11			

B069-178

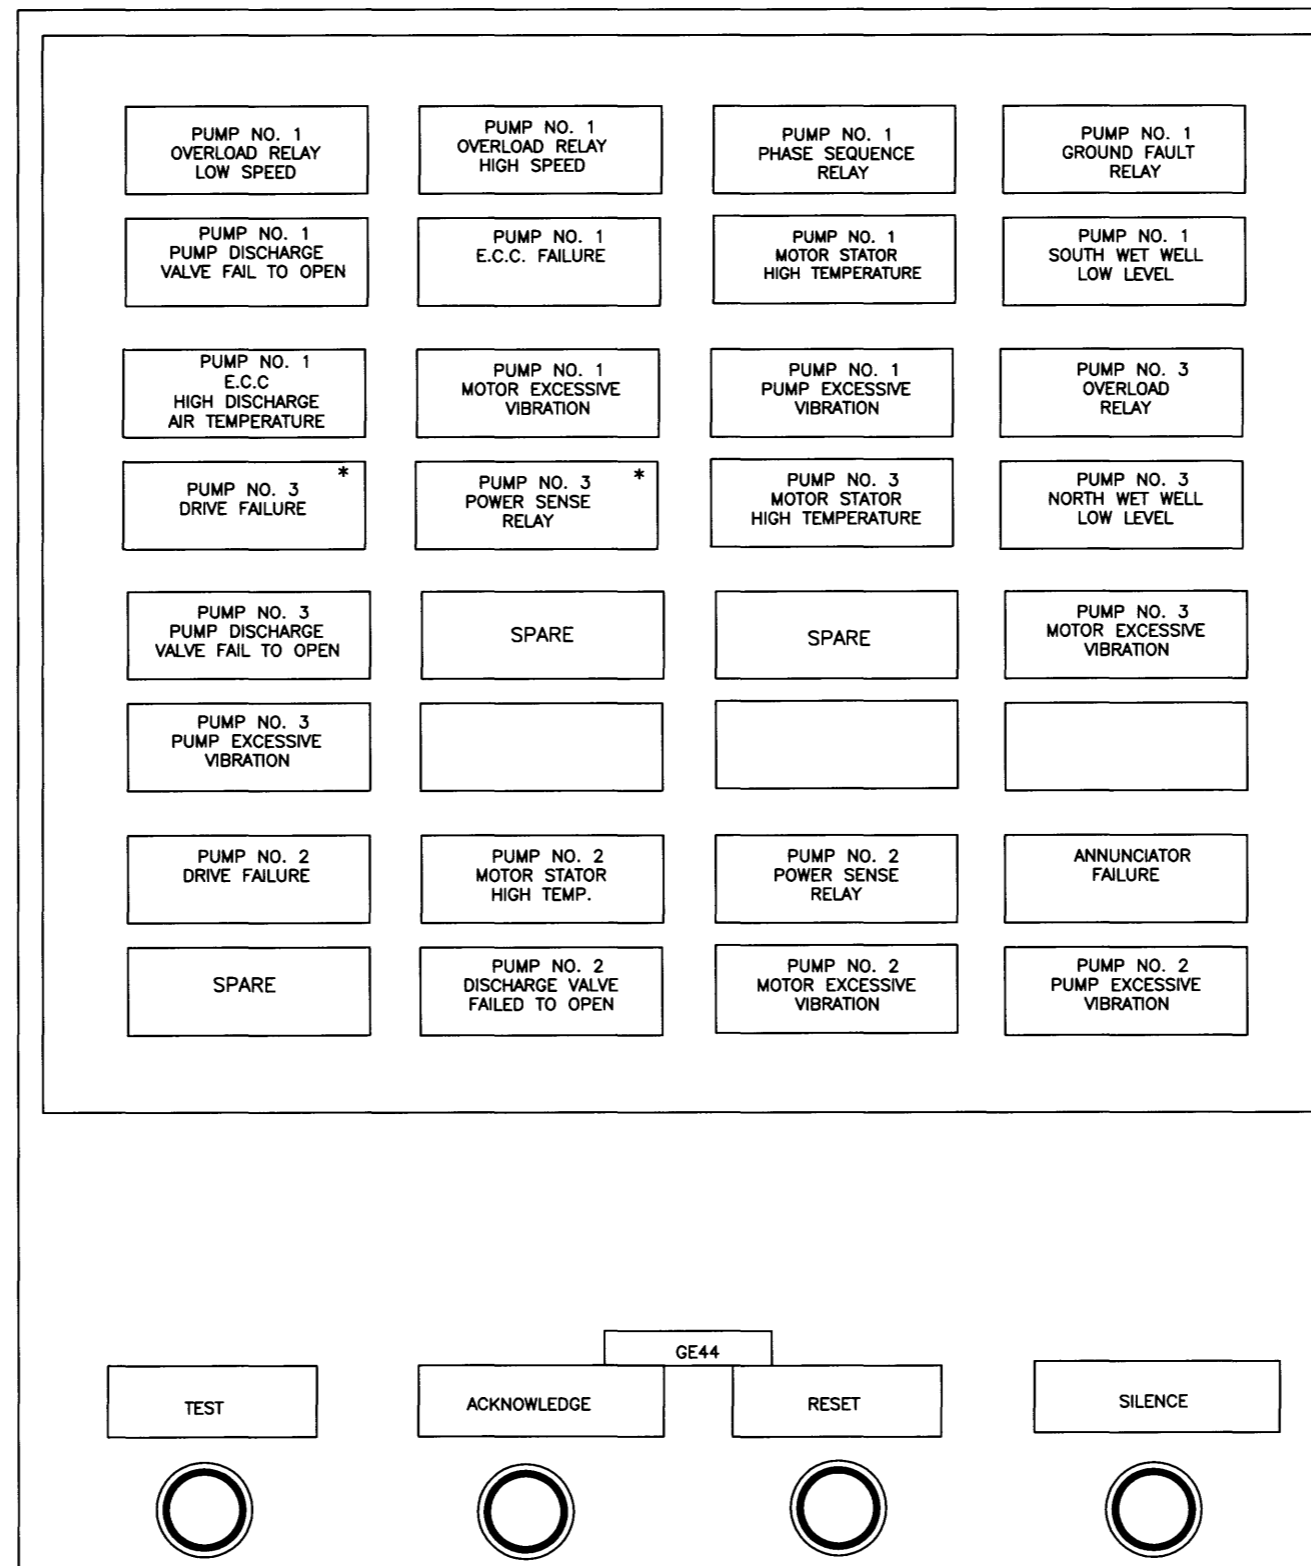


EXISTING ANNUNCIATOR

WINDOWS TO BE REMOVED AND REPLACED WITH NOMENCLATURE AS SHOWN ARE MARKED "*". WINDOWS MARKED "SPARE" SHALL BE BLANK.

PROJECT RECORD


ROMAN D. KORCHAK, P.E. #42626 ELECTRICAL SECTION HEAD WASTEWATER DEPARTMENT	No.	DATE	REVISIONS	DES: LRG	CITY of TAMPA WASTEWATER DEPARTMENT	UNIVERSITY PUMPING STATION REHABILITATION PUMP No.3 CONTROLS (SHT. 6 OF 6)	W.O. 4511
	3			DRN: LRG			SHEET
	2			CKD: <i>PK</i>			E8
	1			DATE: 2/18/11			

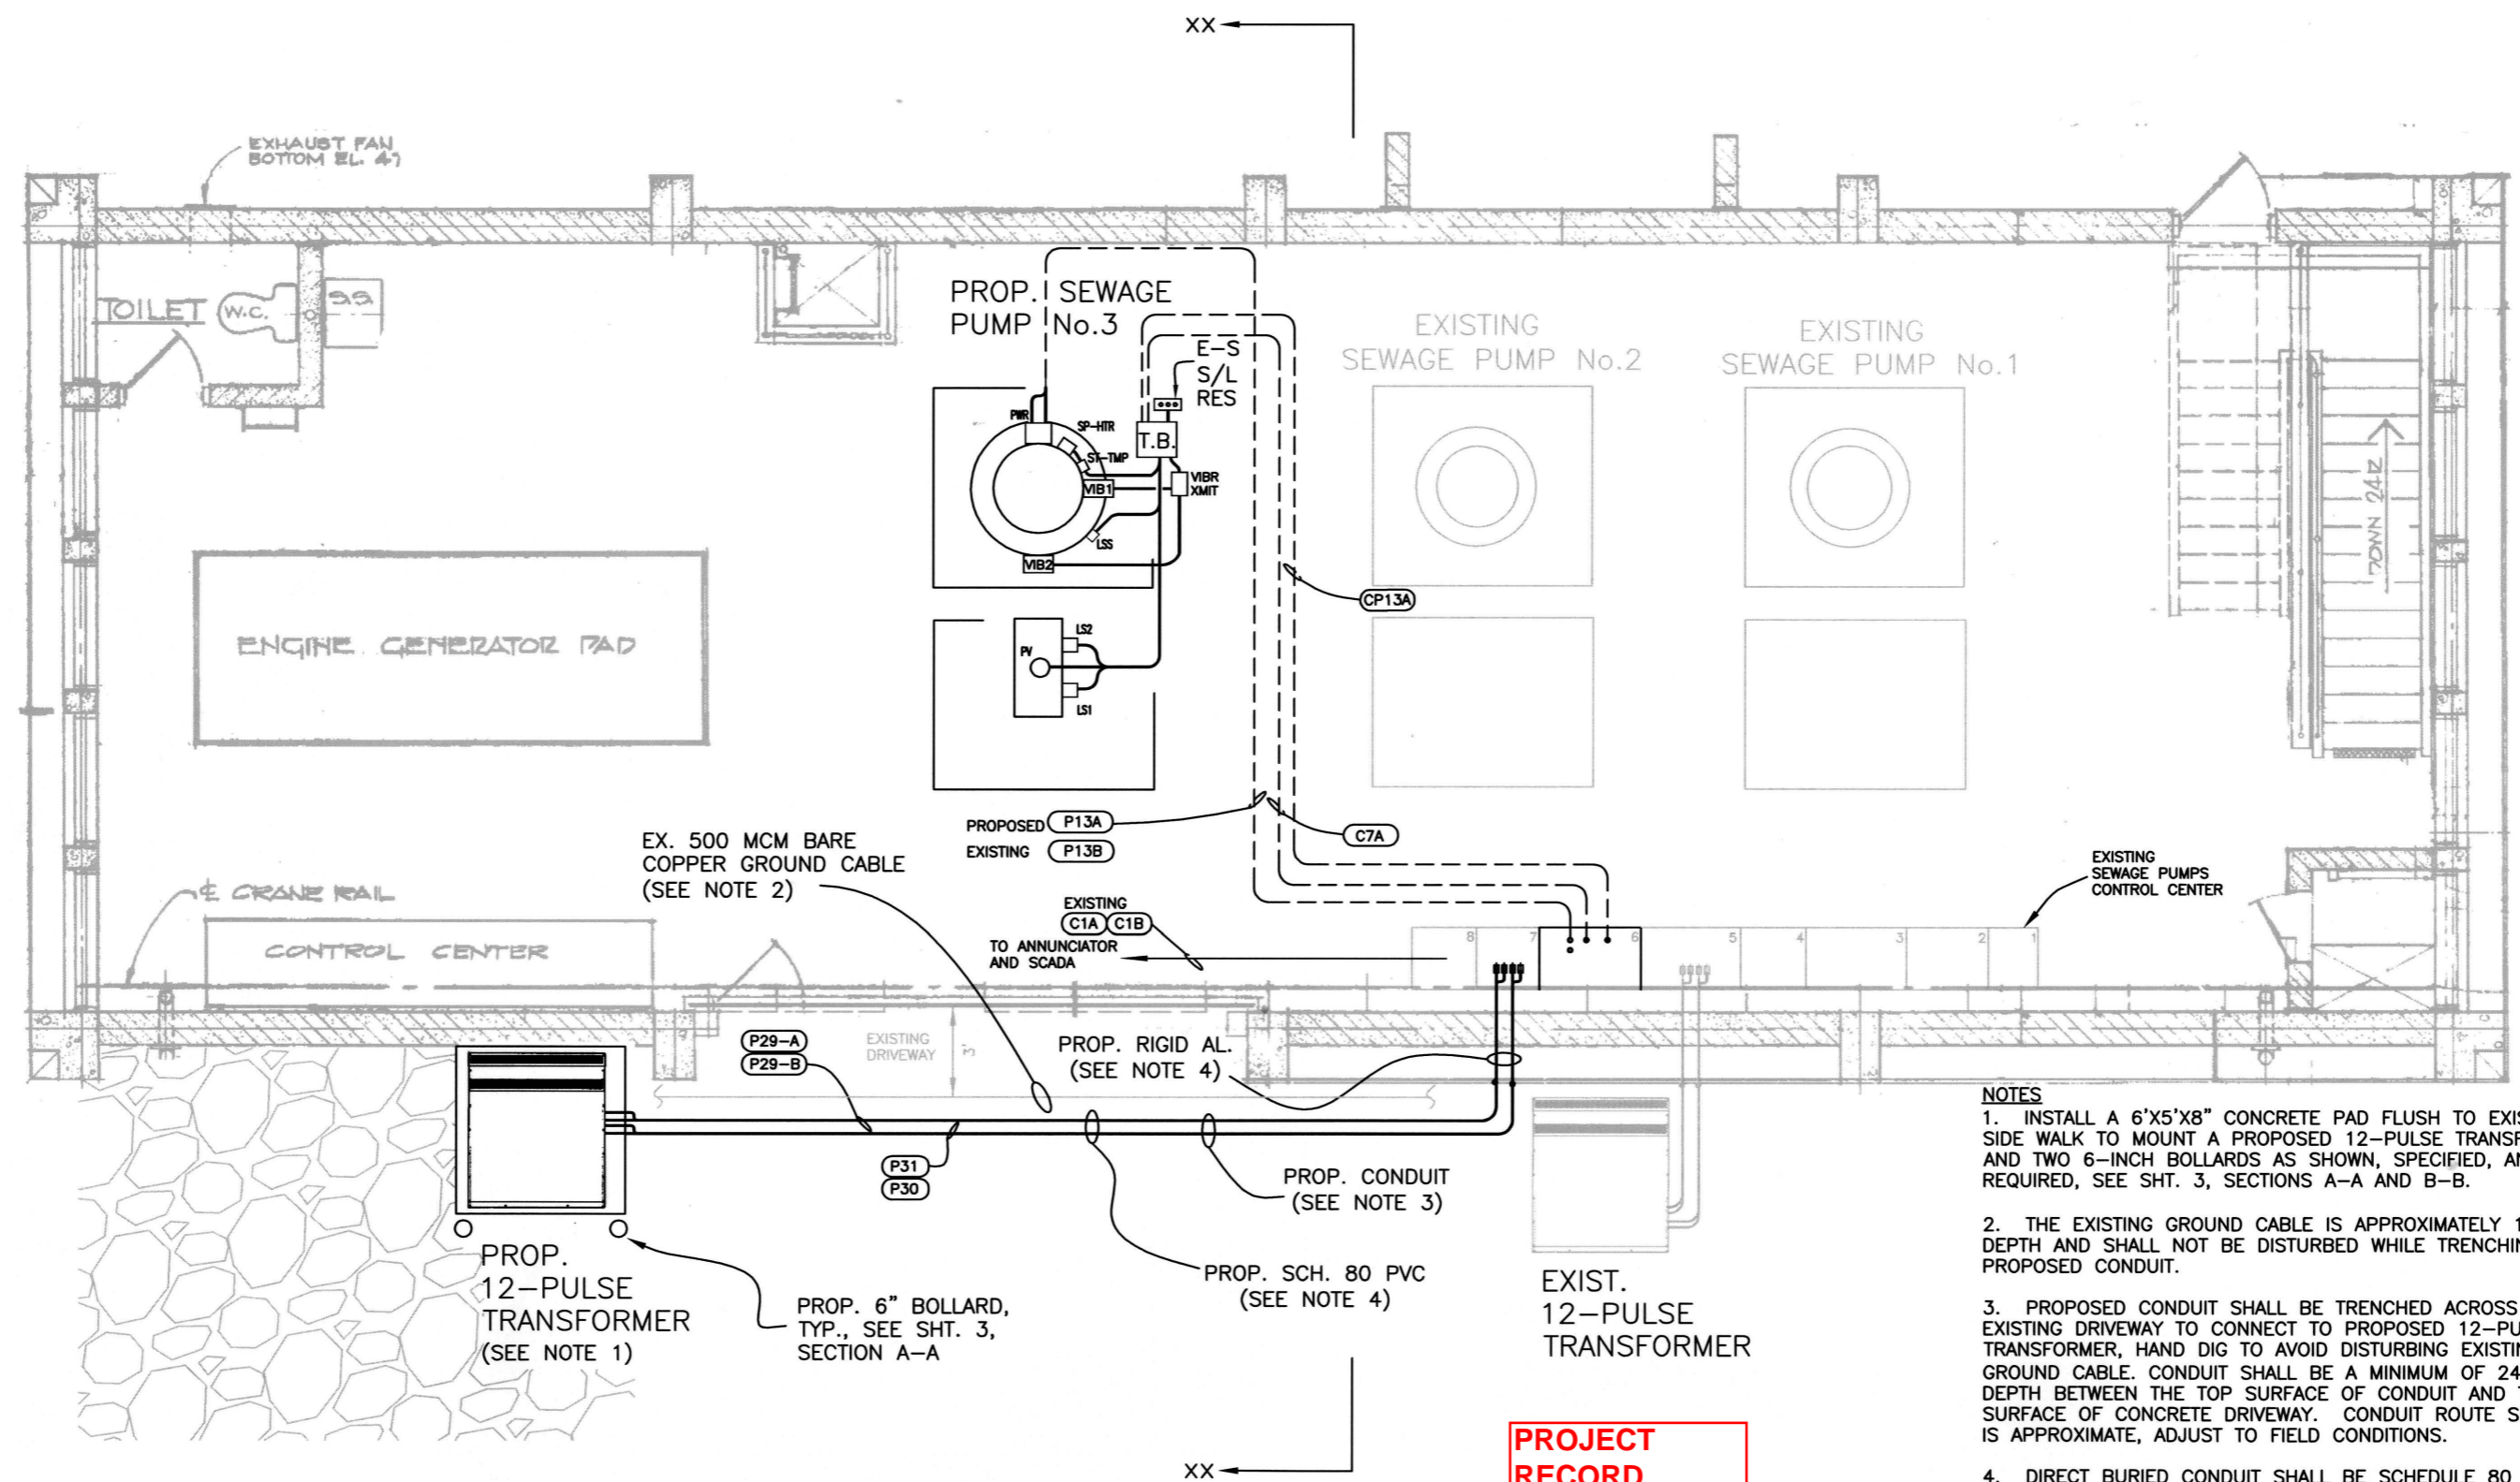

- NOTES**
1. INSTALL A 6'X5'X8" CONCRETE PAD FLUSH TO EXISTING SIDE WALK TO MOUNT A PROPOSED 12-PULSE TRANSFORMER AND TWO 6-INCH BOLLARDS AS SHOWN, SPECIFIED, AND REQUIRED, SEE SHT. 3, SECTIONS A-A AND B-B.
 2. THE EXISTING GROUND CABLE IS APPROXIMATELY 15" IN DEPTH AND SHALL NOT BE DISTURBED WHILE TRENCHING PROPOSED CONDUIT.
 3. PROPOSED CONDUIT SHALL BE TRENCHED ACROSS EXISTING DRIVEWAY TO CONNECT TO PROPOSED 12-PULSE TRANSFORMER, HAND DIG TO AVOID DISTURBING EXISTING GROUND CABLE. CONDUIT SHALL BE A MINIMUM OF 24" IN DEPTH BETWEEN THE TOP SURFACE OF CONDUIT AND TOP SURFACE OF CONCRETE DRIVEWAY. CONDUIT ROUTE SHOWN IS APPROXIMATE, ADJUST TO FIELD CONDITIONS.
 4. DIRECT BURIED CONDUIT SHALL BE SCHEDULE 80 PVC AND CONDUIT EXPOSED SHALL BE RIGID ALUMINUM AS SHOWN, SPECIFIED, AND REQUIRED. COAT ALUMINUM CONDUIT IN CONTACT WITH THE SOIL AND OTHER INCOMPATIBLE MATERIALS, WITH TWO COATS OF BITUMASTIC.

PLAN VIEW
 SCALE: 3/16"=1'-0"
 SEWAGE PUMPS CONTROL CENTER ON TOP FL.- EL. 41.25'
 PUMP MOTORS AND ACCESSORIES ON BOTTOM FL.- EL. 15.00'

ROMAN D. KORCHAK, P.E. #42626 ELECTRICAL SECTION HEAD WASTEWATER DEPARTMENT	No.	DATE	REVISIONS	DES: LRG	CITY of TAMPA WASTEWATER DEPARTMENT	UNIVERSITY PUMPING STATION REHABILITATION ELECTRICAL - POWER PLAN	W.O. 4511
	3			DRN: LRG			SHEET
	2			CKD: <i>PK</i>			E9
	1			DATE: 2/18/11			

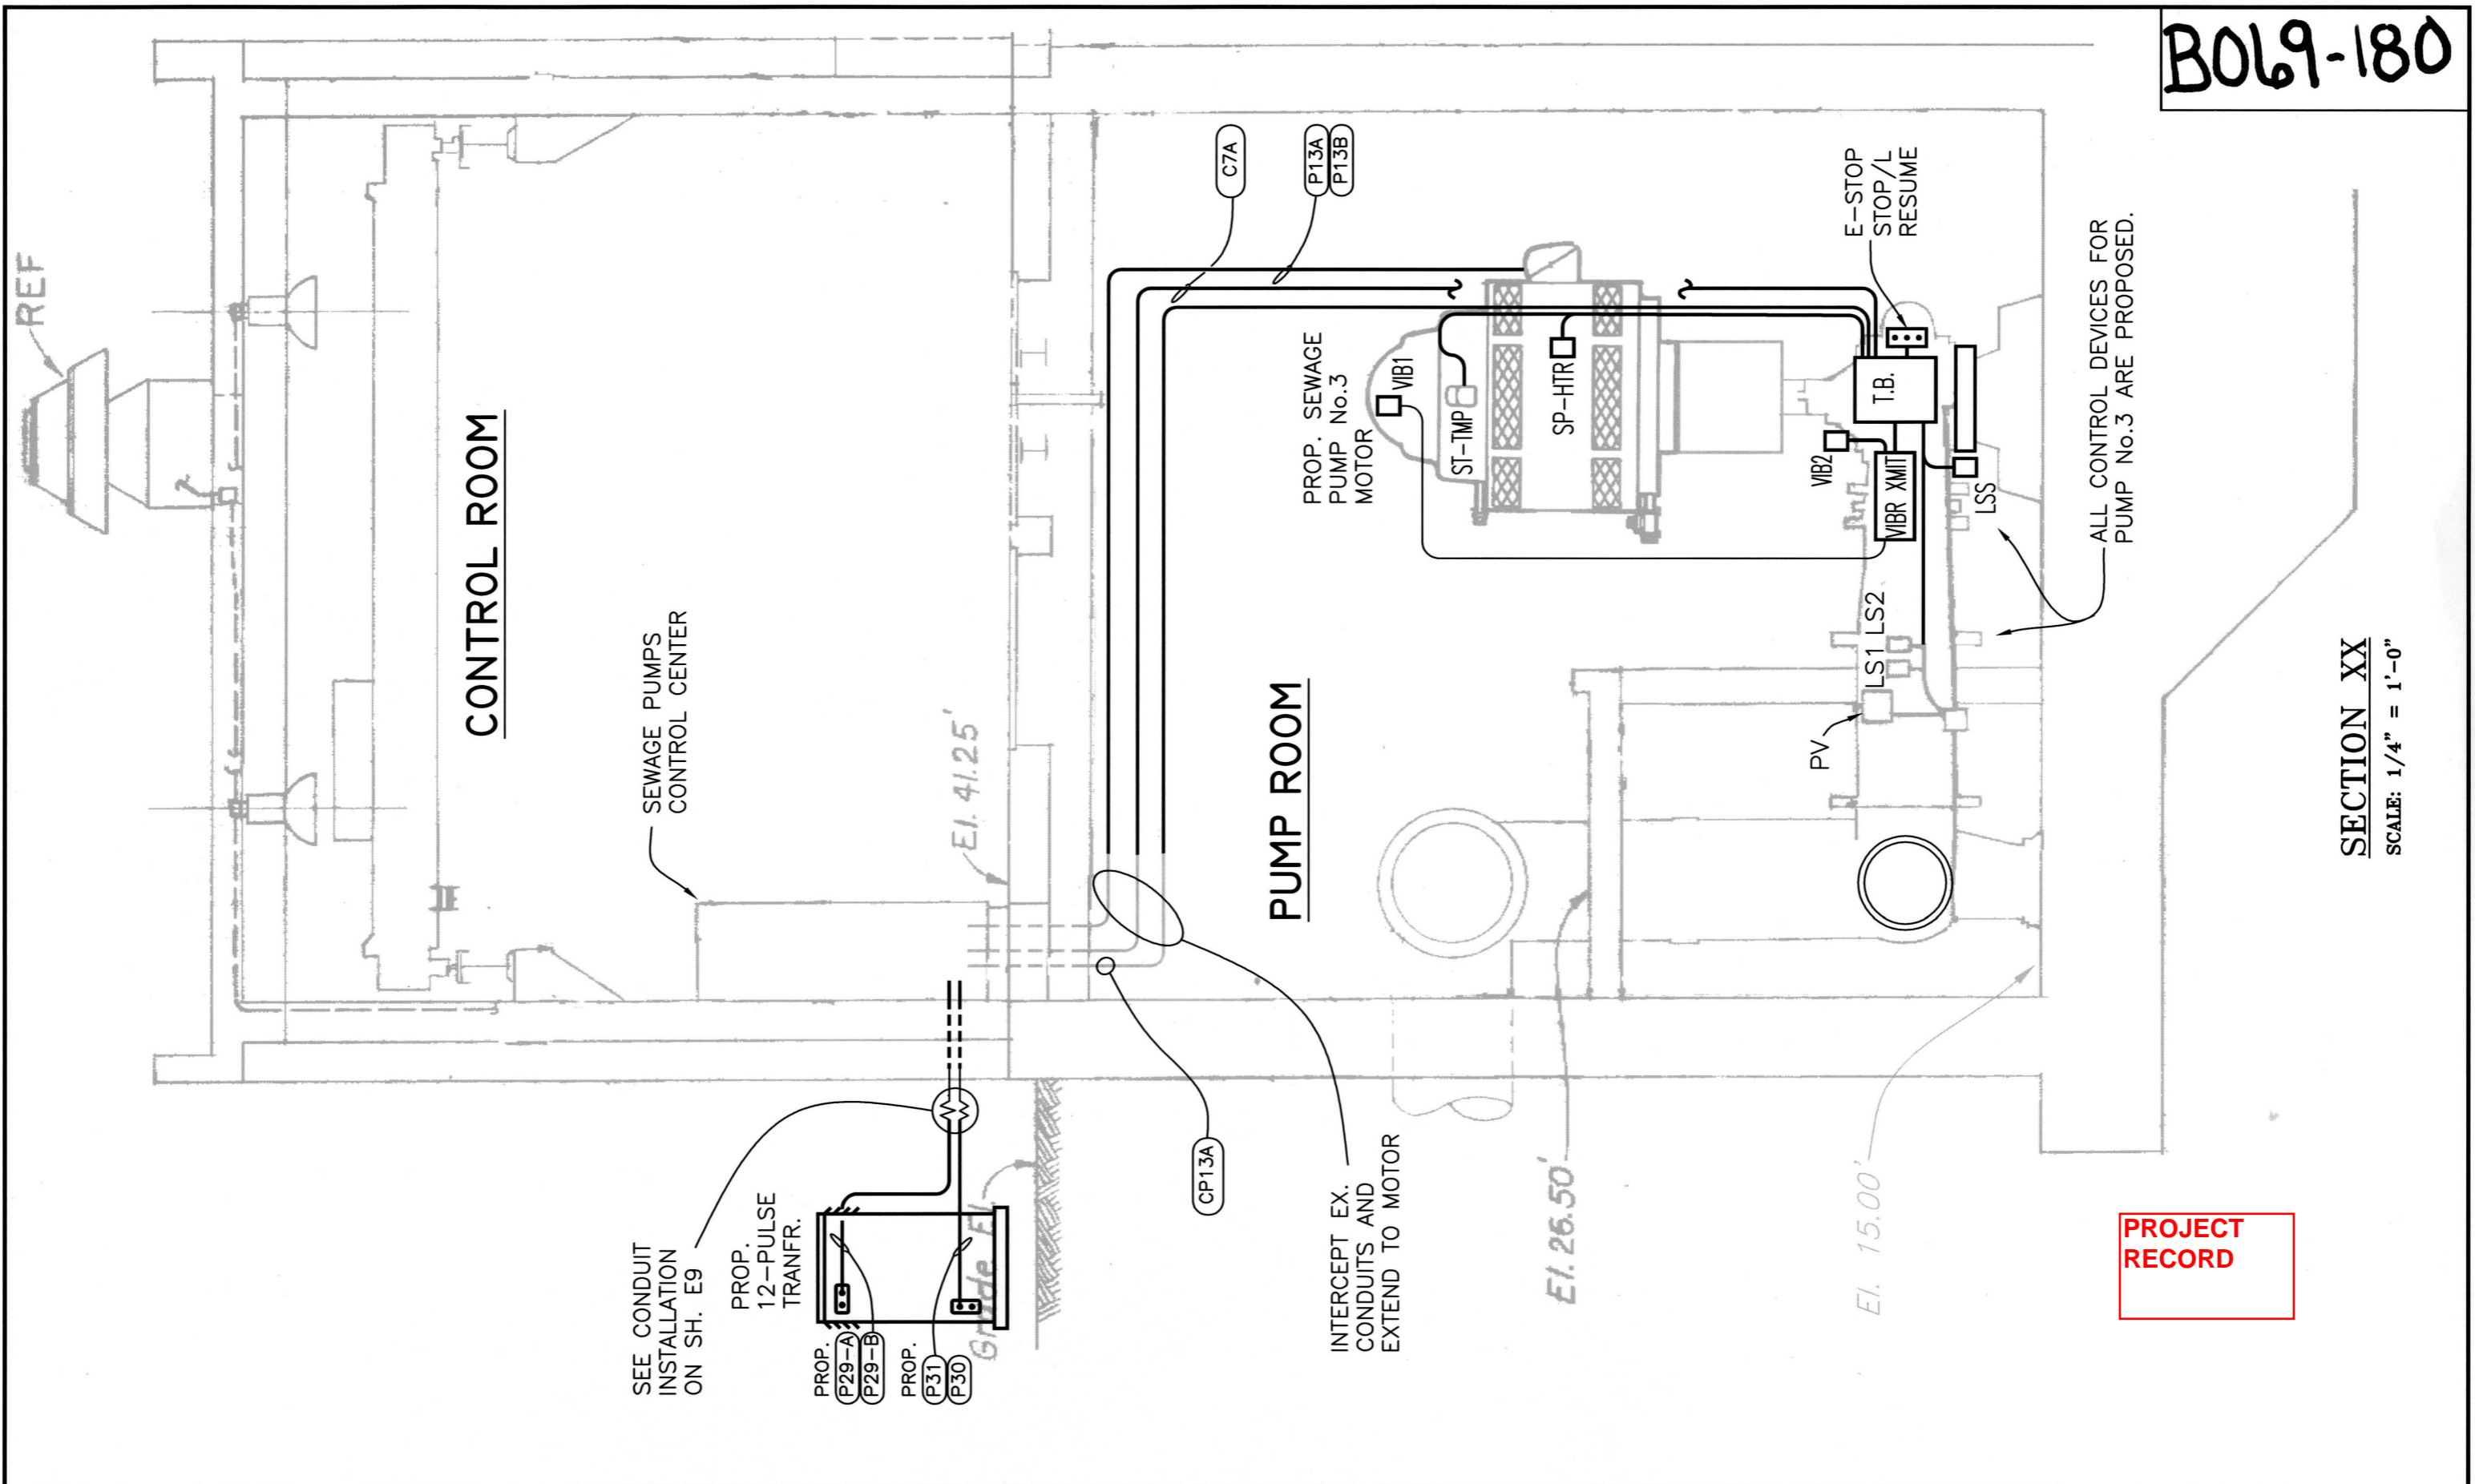

CONTROL ROOM

SEWAGE PUMPS CONTROL CENTER

PUMP ROOM

SECTION XX
SCALE: 1/4" = 1'-0"

PROJECT RECORD

ROMAN D. KORCHAK, P.E. #42626
ELECTRICAL SECTION HEAD
WASTEWATER DEPARTMENT



No.	DATE	REVISIONS
3		
2		
1		

DES: LRG
DRN: LRG
CKD: EK
DATE: 2/18/11

CITY of TAMPA
WASTEWATER DEPARTMENT

UNIVERSITY PUMPING STATION
REHABILITATION
ELECTRICAL - POWER SECTION

W.O. 4511
SHEET
E10

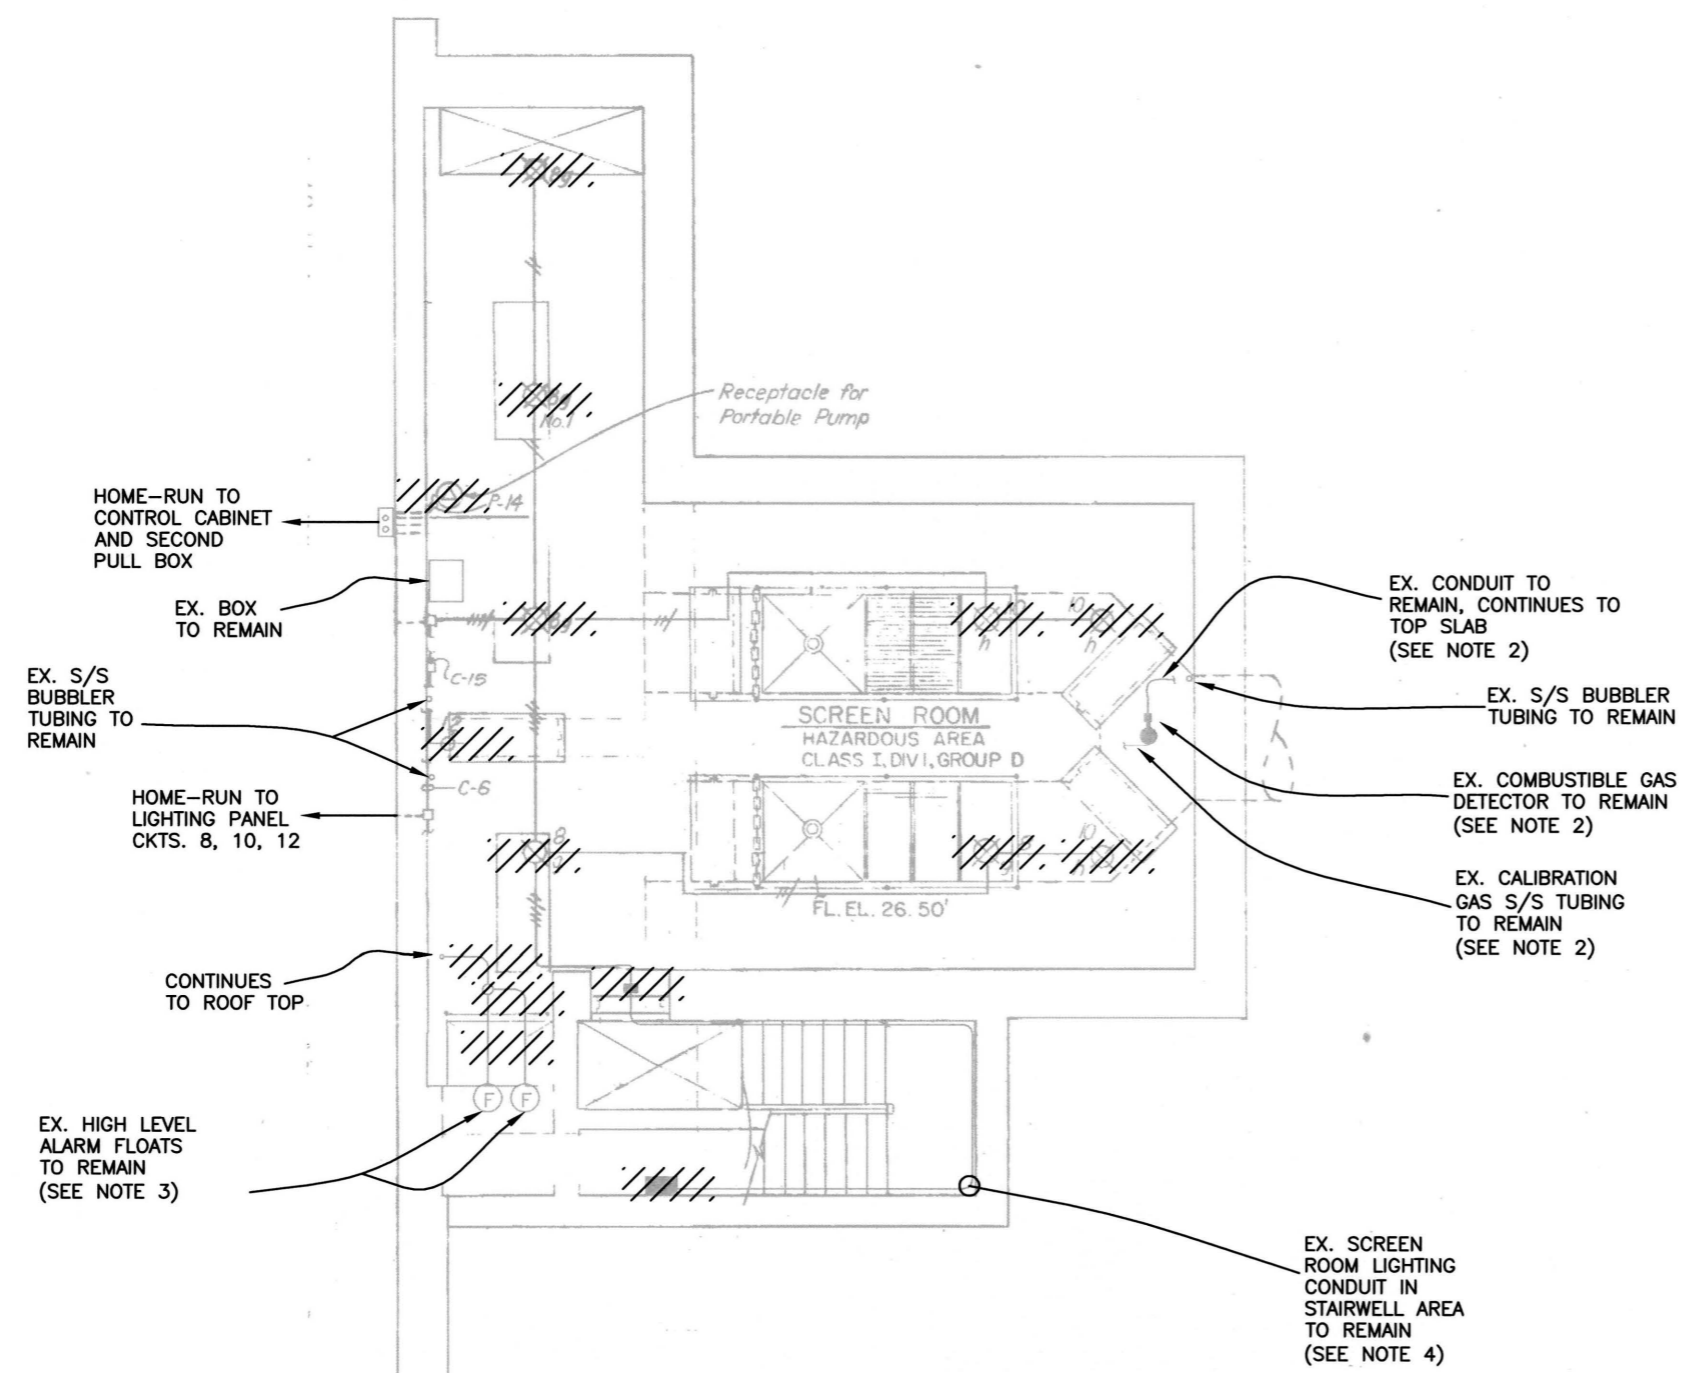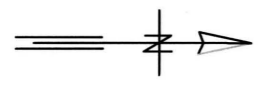


EXISTING SCREEN ROOM PLAN VIEW - EL 2.50
SCALE 1/8" = 1'

- NOTES:**
1. THE SCREEN ROOM AREA IS CLASSIFIED CLASS I, DIVISION 1, GROUP D AREA (HAZARDOUS LOCATION); THEREFORE, NEC CH. 5 APPLIES. REMOVE FROM THE WET WELL AREA ALL ELECTRICAL EQUIPMENT AS SHOWN, SPECIFIED, AND REQUIRED. THIS INCLUDES, BUT IS NOT LIMITED TO: LIGHTING SYSTEMS, POWER RECEPTACLES, CONVENIENCE RECEPTACLES, INTERCOM, SWITCHES, PILOT LIGHTS, AND ALL ASSOCIATED CONDUITS AND SUPPORT SYSTEMS. PATCH/SEAL PENETRATIONS AND DAMAGED CONCRETE WITH APPROVED PRODUCTS AND FINISH TO MATCH SURROUNDING SURFACE.
 2. THE EXISTING COMBUSTIBLE GAS DETECTOR, TRANSMITTER AND ASSOCIATED EQUIPMENT AND CONDUIT SHALL BE REUSED.
 3. THE EXISTING HIGH LEVEL ALARM FLOATS AND ASSOCIATED EQUIPMENT SHALL BE REUSED.
 4. THE EXISTING SCREEN ROOM LIGHTING CONDUIT IN THE STAIRWELL AREA SHALL REMAIN. REMOVE EXISTING LIGHT SWITCH IN THE STAIRWELL AREA.

PROJECT RECORD


HATCHED AREAS REPRESENT ITEMS TO BE REMOVED

ROMAN D. KORCHAK, P.E. #42626 ELECTRICAL SECTION HEAD WASTEWATER DEPARTMENT	No.	DATE	REVISIONS	DES: LRG	CITY of TAMPA WASTEWATER DEPARTMENT	UNIVERSITY PUMPING STATION REBILITATION ELECTRICAL- DEMOLITION	W.O. 4511
	3			DRN: LRG			SHEET
	2			CKD: <i>RL</i>			EII
	1			DATE: 2/18/11			

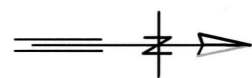

NOTES:


1. CLASS I DIVISION I, GROUP D, FLUORESCENT FIXTURE W/ (2)-800mA HIGH OUTPUT 4 FT. LAMPS AND LOW TEMPERATURE BALLAST. FIXTURE SHALL BE CONSTRUCTED OF COPPER FREE ALUMINUM ALLOY AND STAINLESS STEEL HARDWARE. 120VAC OPERATION W/ T6 TEMPERATURE CODE. USE 316 STAINLESS STEEL HANGING HARDWARE BASIS OF DESIGN --R-A-L XP800-4-2L-A.
2. PROVIDE: (1) WEATHER-PROOF SNAP SWITCH FOR WET WELL LIGHTS W/ EXTRA POLE FOR VENTILATION CONTROL, (1) NEMA 4X LEL ALARM LIGHT, AND (1) NEMA 4X MOMENTARY PUSHBUTTON FOR LEL ALARM TEST.
3. ALL CONDUITS, FITTINGS, AND TERMINAL BOXES INSTALLED SHALL BE RIGID ALUMINUM COATED WITH 40mil PVC OUTSIDE AND 2mil URETHANE INSIDE, AS MANUFACTURED BY ROBROY. ALL MATERIALS AND INSTALLATION METHODS IN THE WET WELL AREA MUST BE CONSISTENT W/ NEC CH. 5 STANDARDS FOR A CLASS I, DIVISION I, GROUP D AREA.
4. THE CONTRACTOR SHALL TRACE-OUT EXISTING WIRING AND VERIFY PROPER CONNECTIONS TO THE END DEVICES. EXISTING CONDUCTORS IN THE WET WELL SHALL BE REPLACED, UNLESS NOTED OTHERWISE. ALL SPLICES SHALL BE MADE AS SPECIFIED, IN PROPOSED JUNCTION BOXES LOCATED AS CLOSE TO THE EXISTING CONDUIT SEALS AS PRACTICABLE. IF HOME RUN CONDUCTORS ON THE NON-CCLASSIFIED SIDE OF THE CONDUIT SEALS ARE FOUND TO BE DETERIORATED, THEY SHALL BE REMOVED, AND NEW CONDUCTORS SHALL BE INSTALLED AFTER RECEIVING WRITTEN APPROVAL FOR EXTRA WORK FROM THE ENGINEER. REPLACE ALL DISTURBED CONDUIT SEALS.
5. PROVIDE AND INSTALL NEW CONDUIT, SUPPORTS, AND SEALS FOR EXISTING HIGH WATER FLOAT SWITCHES. IF CONDUCTORS ARE FOUND TO BE DETERIORATED, THEY SHALL BE REMOVED, AND NEW CONDUCTORS SHALL BE INSTALLED. CONTRACTOR SHALL FIELD VERIFY EXACT LOCATION OF FLOAT SWITCHES.
6. CORE DRILL CONCRETE AS REQUIRED TO INSTALL CONDUITS. FILL ANNULAR SPACE USING APPROVED PRODUCTS AND FINISH TO MATCH EXISTING SURFACE.
7. TOUCH-UP ANY DAMAGED PVC COATING USING MANUFACTURER RECOMMENDED PRODUCTS. MATCH EXISTING SURFACE.
8. THE EXISTING SCREEN ROOM LIGHTING CONDUIT SUPPORTS IN THE STAIRWELL AREA SHALL BE REMOVED AND REPLACED WITH STAINLESS STEEL ONE-HOLE STRAPS.
9. INSTALL NEW BLOWER CONTROL CONDUIT AND CONDUCTORS IN THE STAIRWELL AREA AS SHOWN, SPECIFIED, AND REQUIRED. USE STAINLESS STEEL ONE-HOLE STRAPS TO SUPPORT CONDUIT.
10. THE EXISTING COMBUSTIBLE GAS DETECTOR CONDUIT SUPPORTS SHALL BE REMOVED AND REPLACED WITH STAINLESS STEEL ONE-HOLE STRAPS.

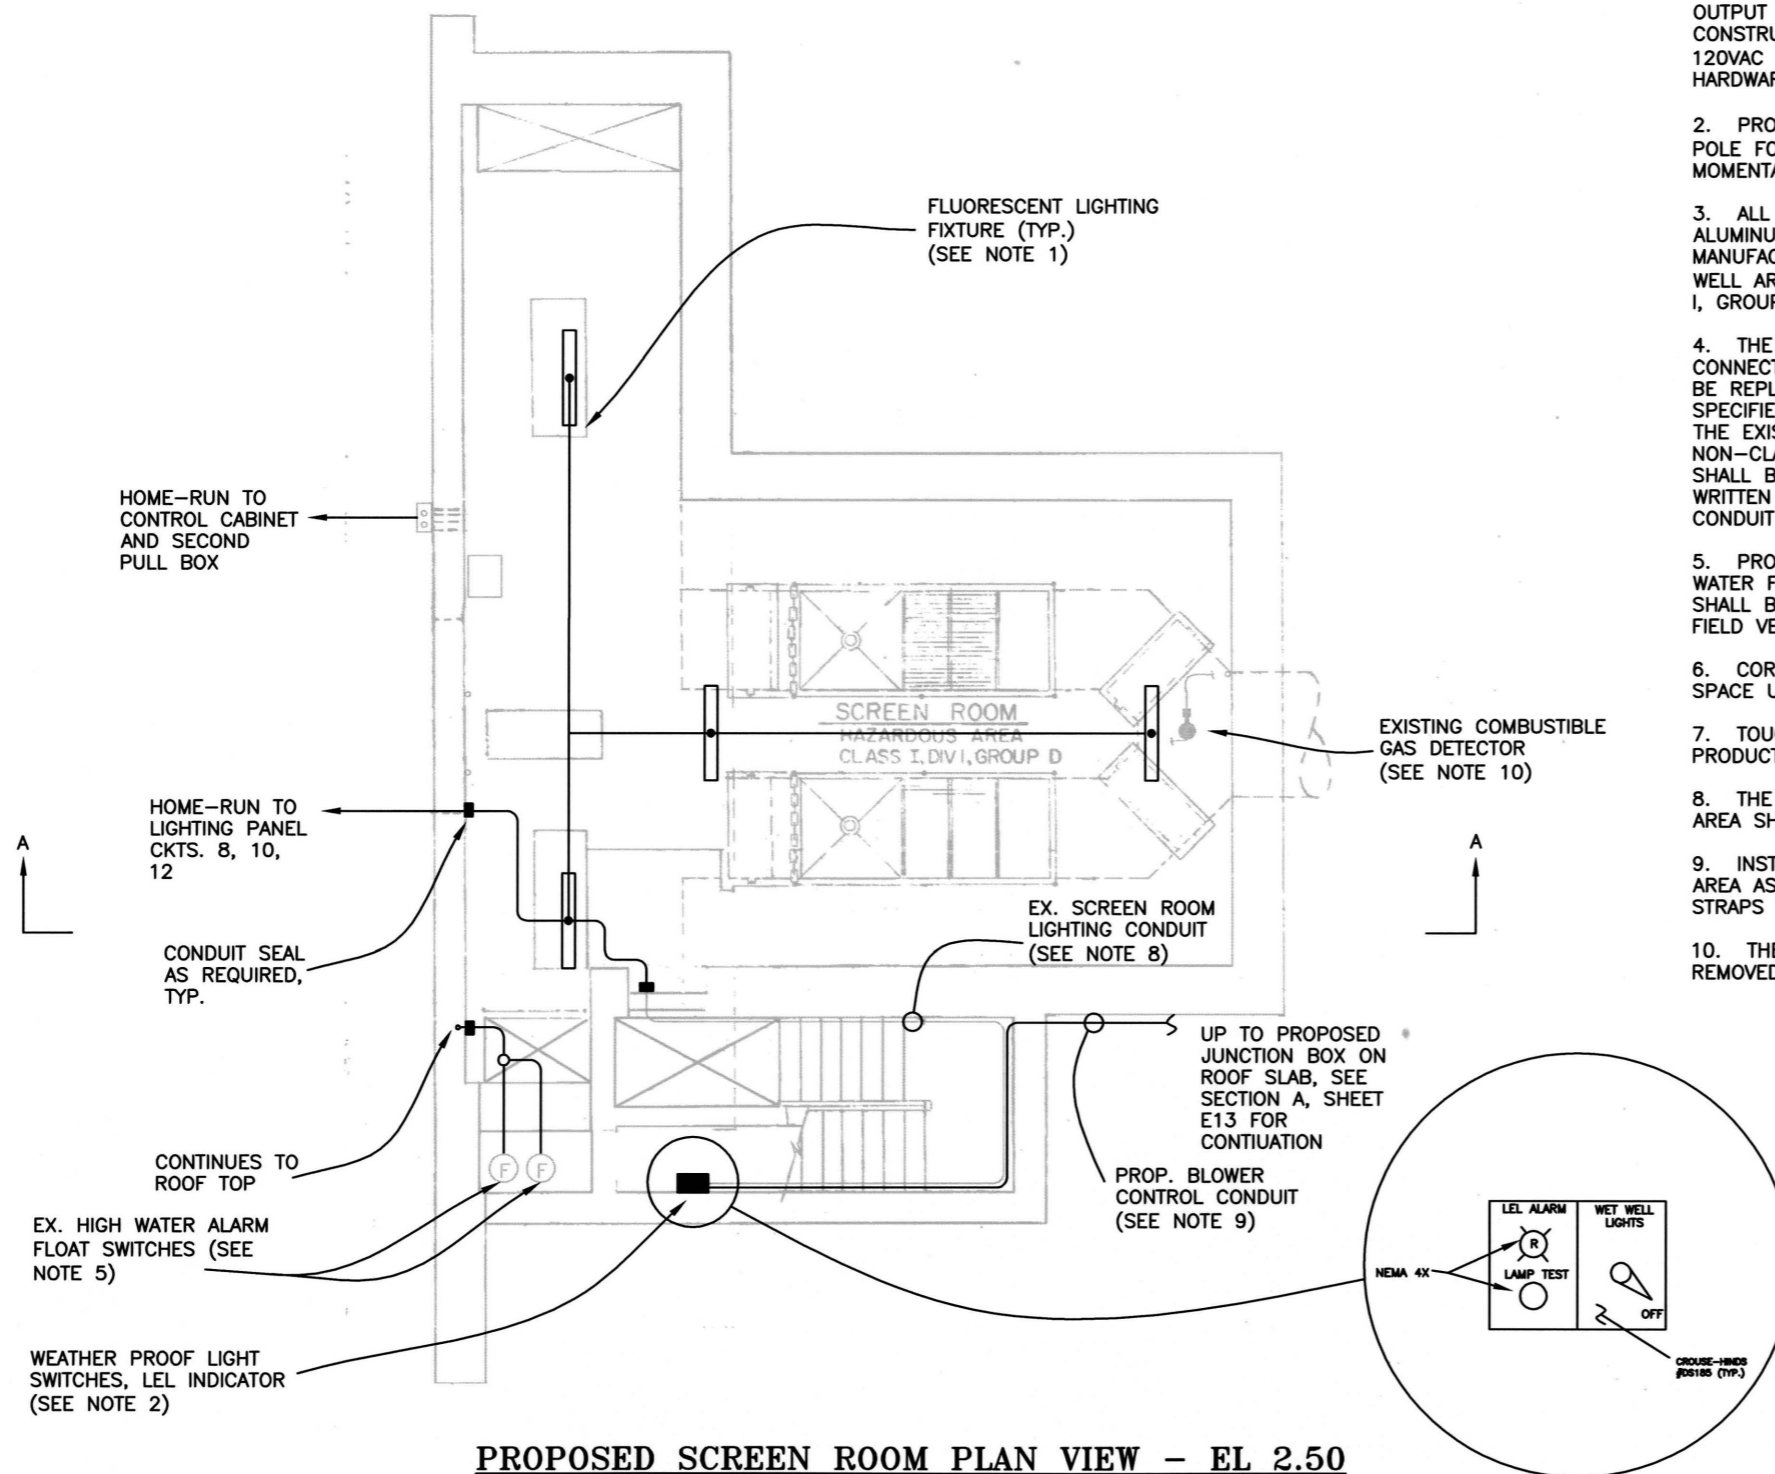

PROPOSED SCREEN ROOM PLAN VIEW - EL 2.50
SCALE 1/8" = 1'

PROJECT RECORD

ROMAN D. KORCHAK, P.E. #42626 ELECTRICAL SECTION HEAD WASTEWATER DEPARTMENT	No.	DATE	REVISIONS	DES: LRG	CITY of TAMPA WASTEWATER DEPARTMENT	UNIVERSITY PUMPING STATION REHABILITATION PROPOSED PLAN- WET WELL AREA	W.O. 4511
	3			DRN: LRG			SHEET
	2			CKD: RK			E12
	1			DATE: 2/18/11			

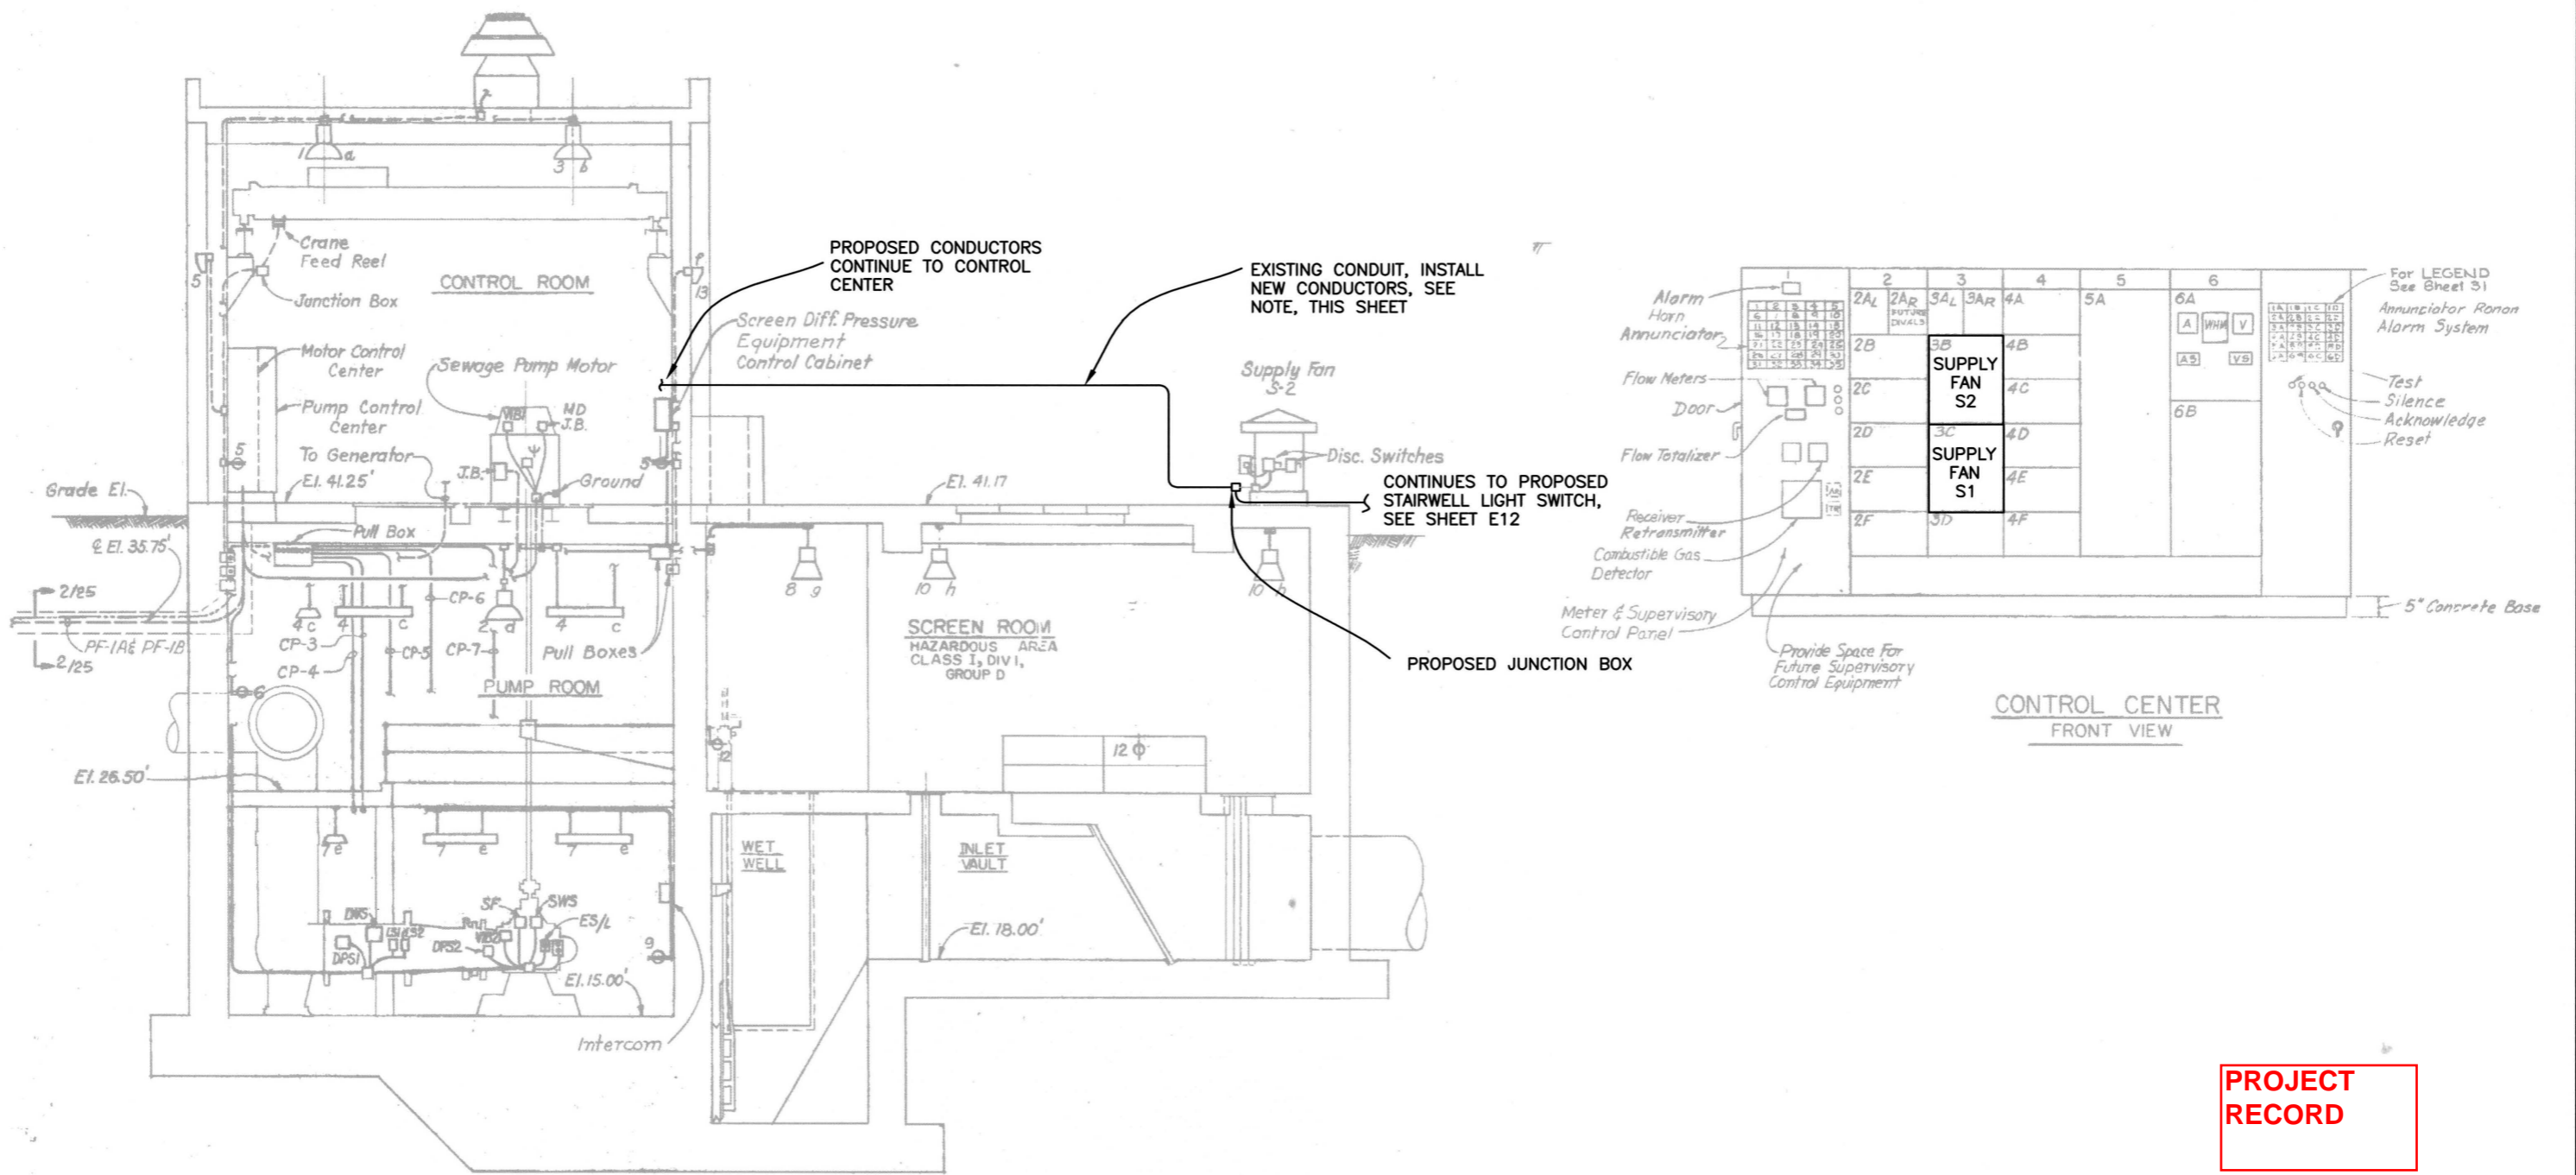

SECTION A-A
1/8" = 1'-0"

PROJECT RECORD

NOTE: INTERCEPT EXISTING CONDUIT RUNNING FROM SUPPLY FANS 1 AND 2 TO CONTROL CENTER. INSTALL A JUNCTION BOX AND UTILIZE EXISTING CONDUIT TO INSTALL CONDUCTORS FROM PROPOSED STAIR WELL LIGHT SWITCH TO CONTROL CENTER AS SHOWN, SPECIFIED, AND REQUIRED.

ROMAN D. KORCHAK, P.E. #42626 ELECTRICAL SECTION HEAD WASTEWATER DEPARTMENT	No.	DATE	REVISIONS	DES: LRG DRN: LRG CKD: RK DATE: 2/18/11	CITY of TAMPA WASTEWATER DEPARTMENT	UNIVERSITY PUMPING STATION REHABILITATION SECTION A-A	W.O. 4511
	3						SHEET
	2						E13
	1						

NOTES:


1. THE WET WELL LIGHT SWITCH SHALL CONNECT TO THE EXISTING SUPPLY FAN (S-1, S-2) CONTROLS LOCATED IN THE CONTROL CENTER. FAN OPERATION IS DEPENDENT ON THE EXISTING H/O/A AND SPEED SWITCHES AS FOLLOWS:

AUTO- FAN OPERATES ON LOW SPEED UNTIL THE SCREEN ROOM LIGHTS ARE TURNED ON OR 25% LEL ALARM IS REACHED. SUPPLY FAN WILL THEN RUN AT HIGH SPEED UNTIL LIGHTS ARE TURNED OFF.


MAN.- FAN OPERATES CONTINUOUSLY ON HIGH SPEED AS SELECTED ON MCC.

OFF - FAN IS TURNED OFF.


2. RUN A PROPERLY SIZED BONDING CONDUCTOR IN ALL CONDUITS.

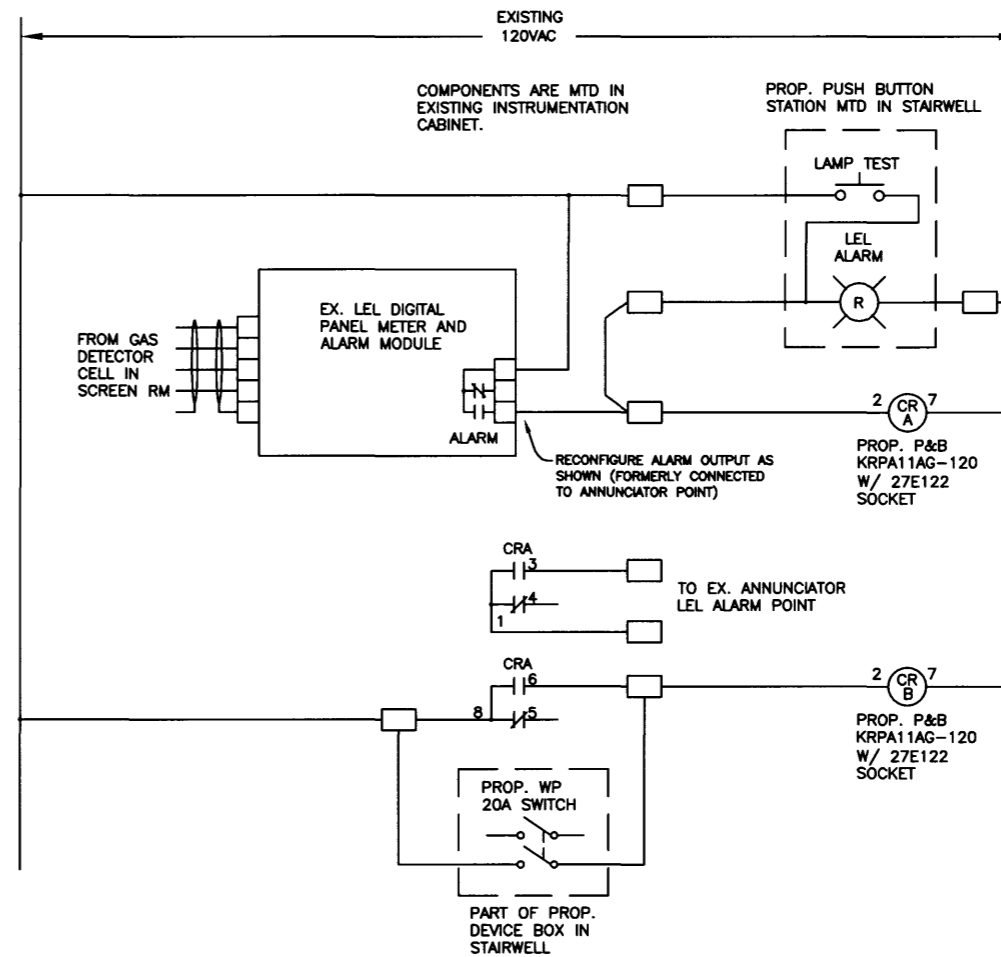

SUPPLY FAN S1

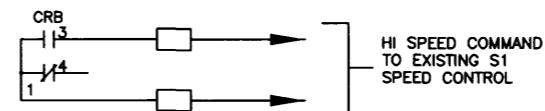

SUPPLY FAN S2

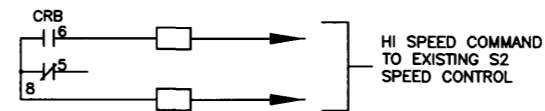


BLOWER SPEED CONTROL AND LEL ALARM

PROJECT RECORD

ROMAN D. KORCHAK, P.E. #42626 ELECTRICAL SECTION HEAD WASTEWATER DEPARTMENT	No.	DATE	REVISIONS	DES: LRG DRN: LRG CKD: <i>TK</i> DATE: 2/18/11	CITY of TAMPA WASTEWATER DEPARTMENT	UNIVERSITY PUMPING STATION REHABILITATION SCREEN ROOM SUPPLY FAN SCHEMATIC	W.O. 4511 SHEET E14
	3						
	2						
	1						

LOCATION MAP

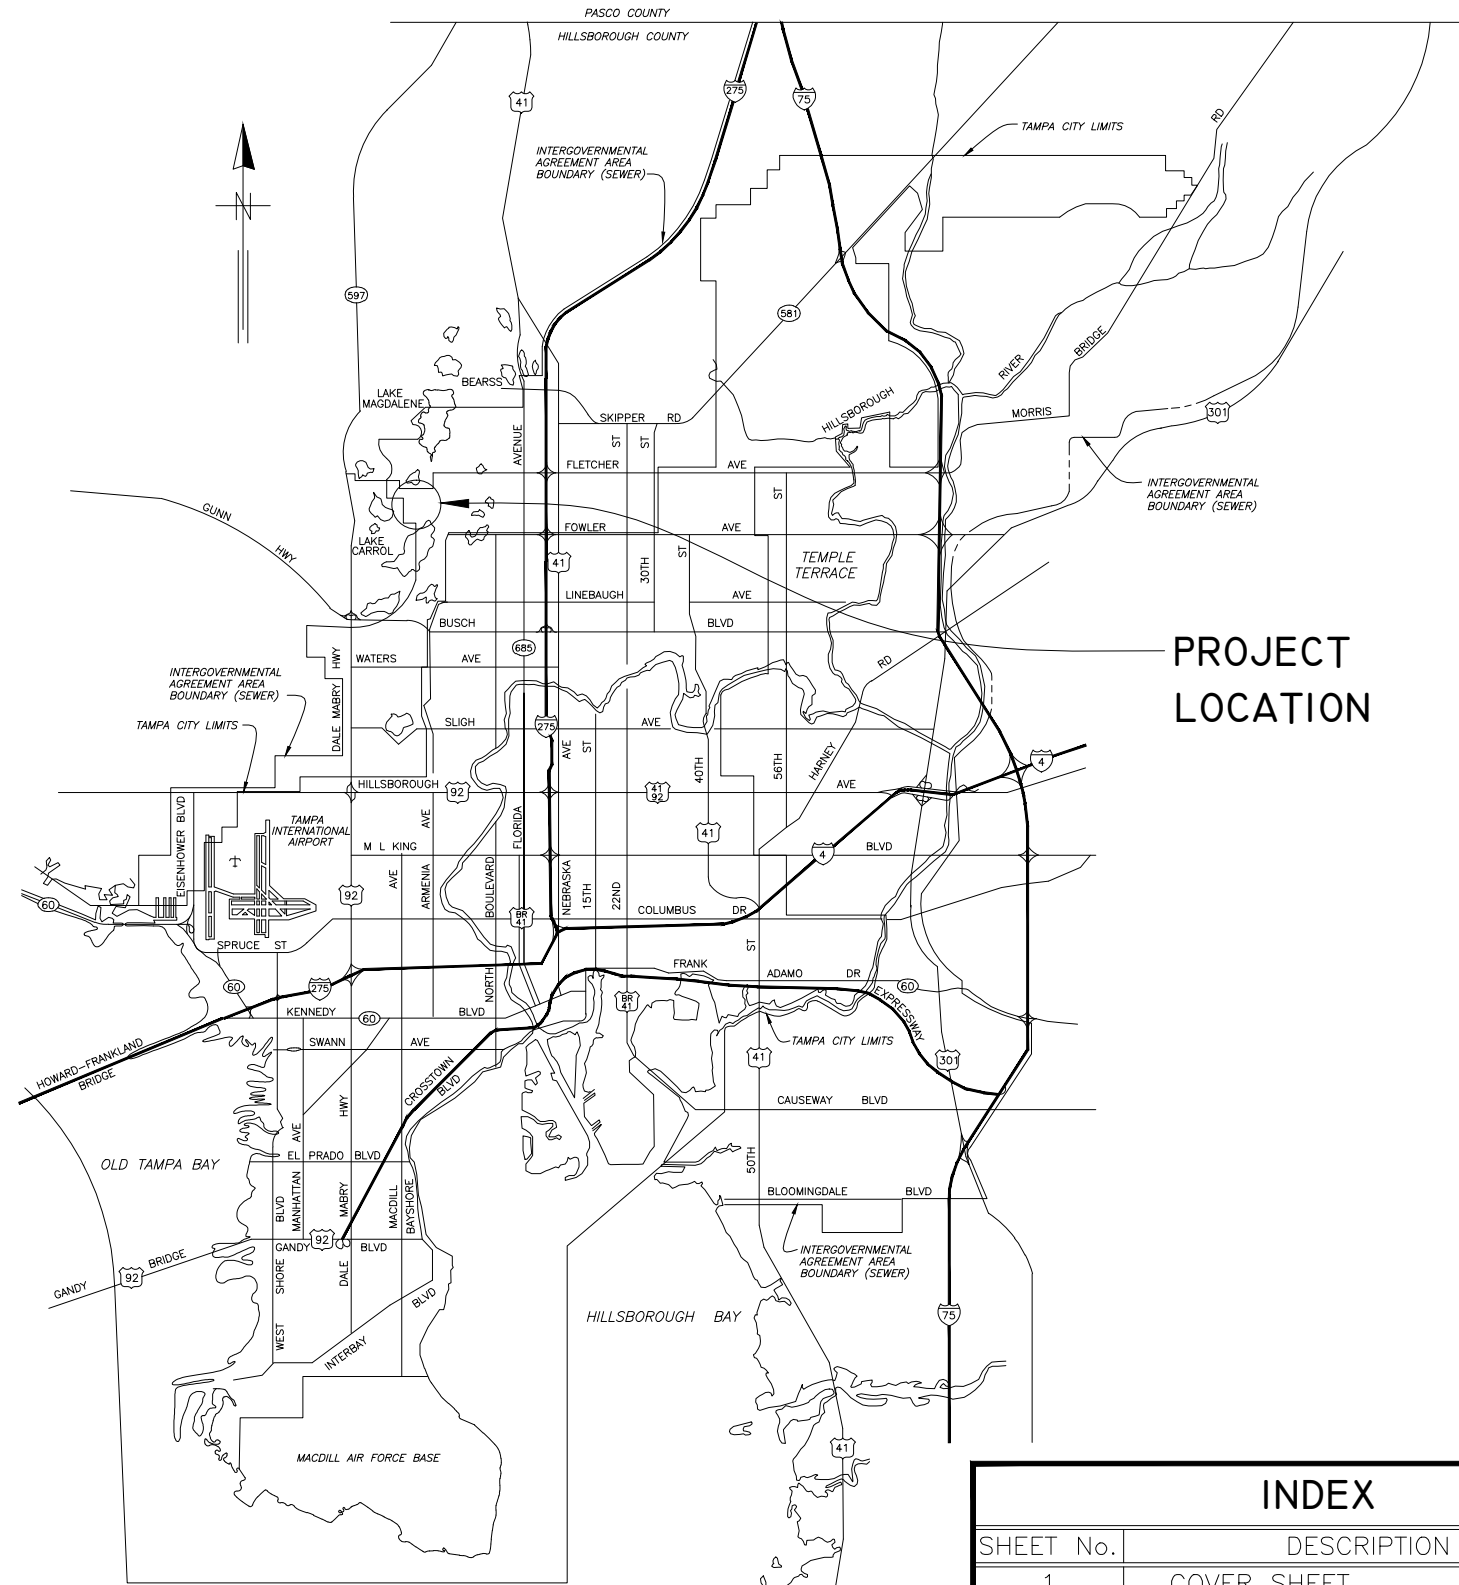

PROJECT LOCATION

CITY of TAMPA



WASTEWATER DEPARTMENT


**PLANS FOR
UNIVERSITY PUMPING STATION
EMERGENCY REPAIRS**

W.O. No. 1000801

INDEX	
SHEET No.	DESCRIPTION
1	COVER SHEET
2	SITE PLAN & CONNECTION DETAIL
3	DEMOLITION PLAN
4	PROPOSED PLAN


Layout - Sep 30, 2015 - 7:59am

JACINTO CARLOS FERRAS, P.E. #49454 DESIGN DIVISION HEAD WASTEWATER DEPARTMENT	No.	DATE	REVISIONS	DES: J.F.	CITY of TAMPA WASTEWATER DEPARTMENT	COVER SHEET	W.O.1000801
	3			DRN: BB			SHEET
	2			CKD:			1
	1			DATE:			

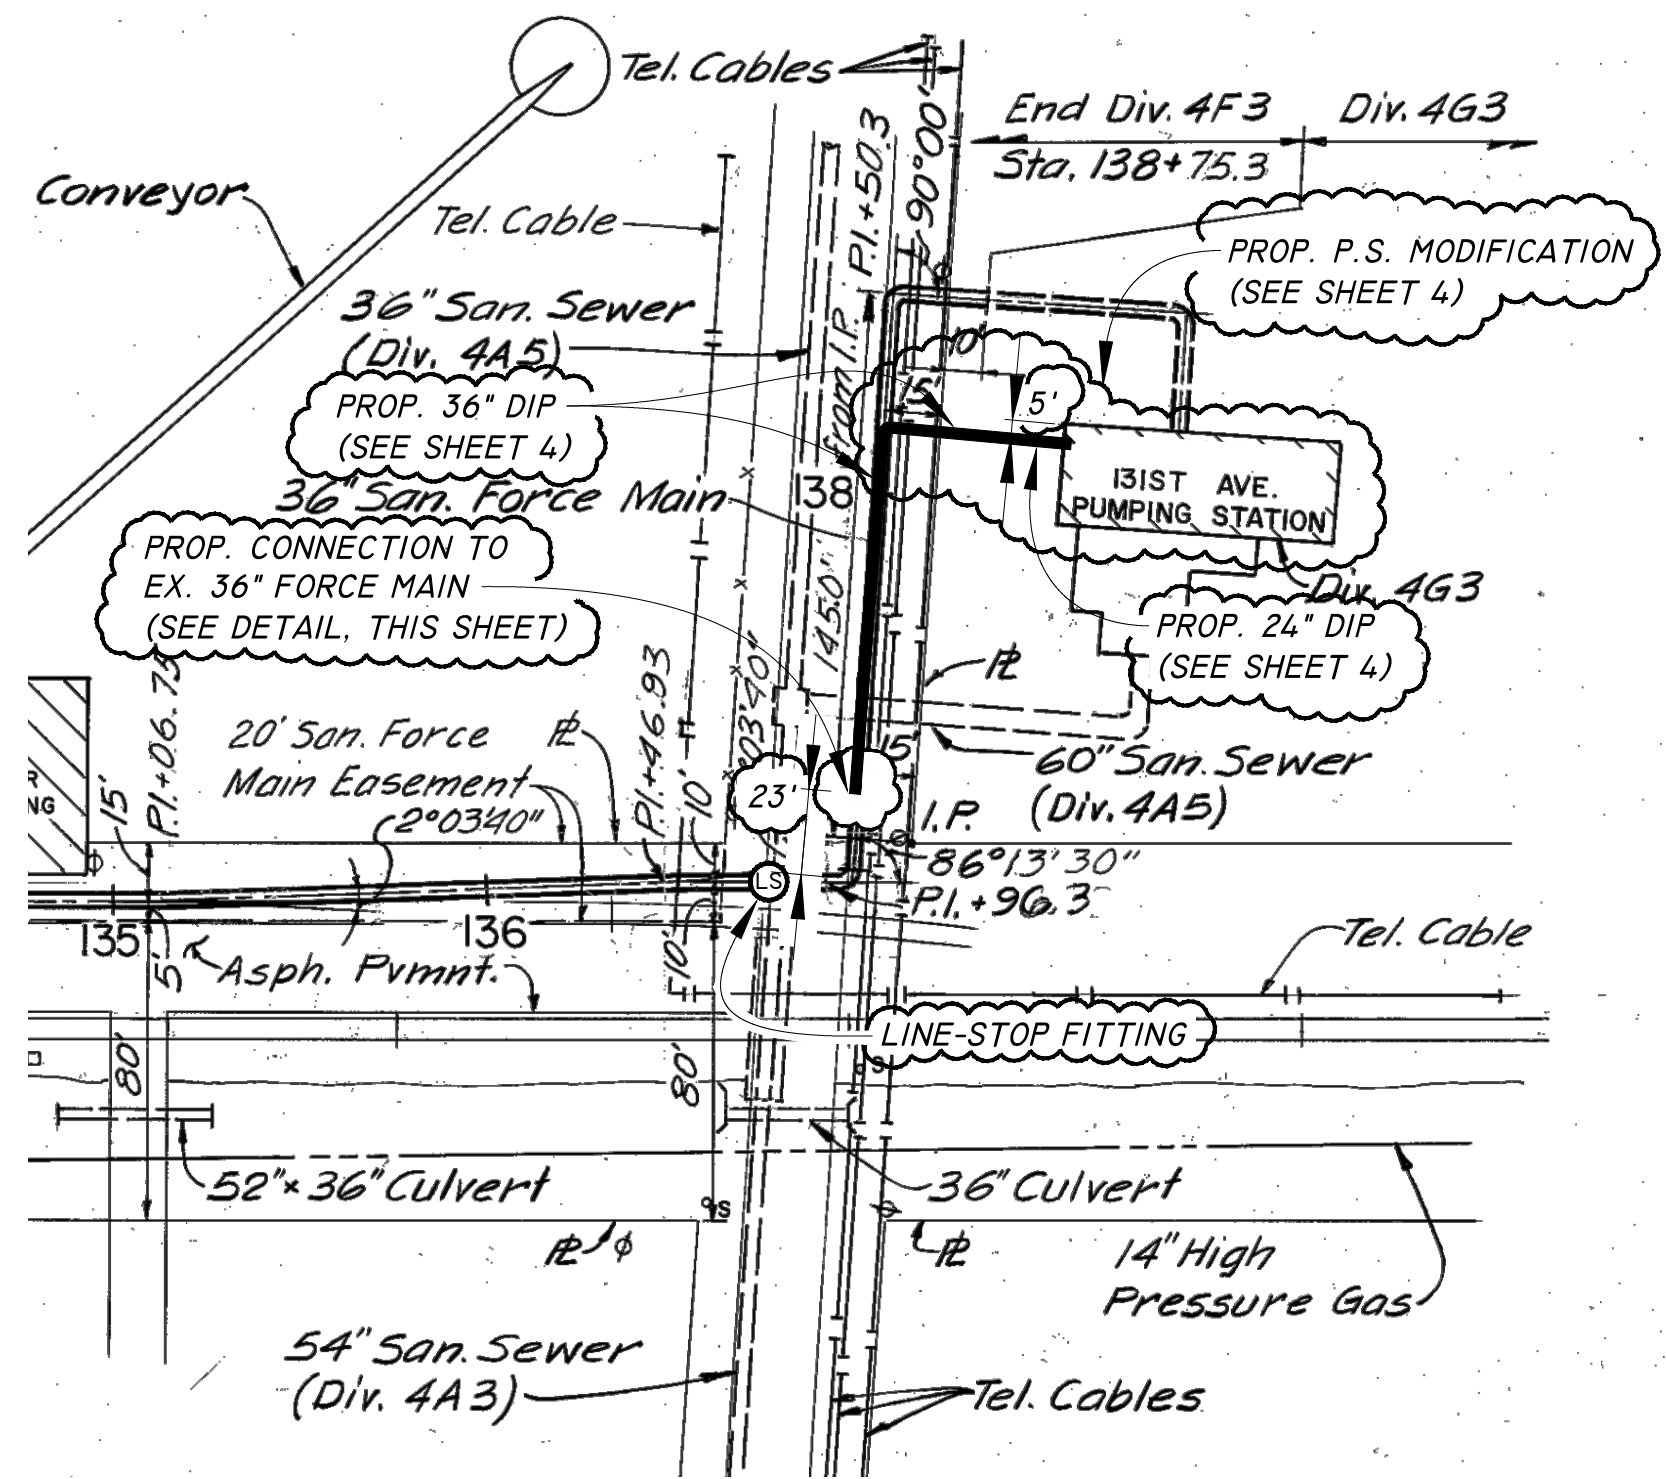

SITE PLAN

APPROXIMATE SCALE: 1" = 50'

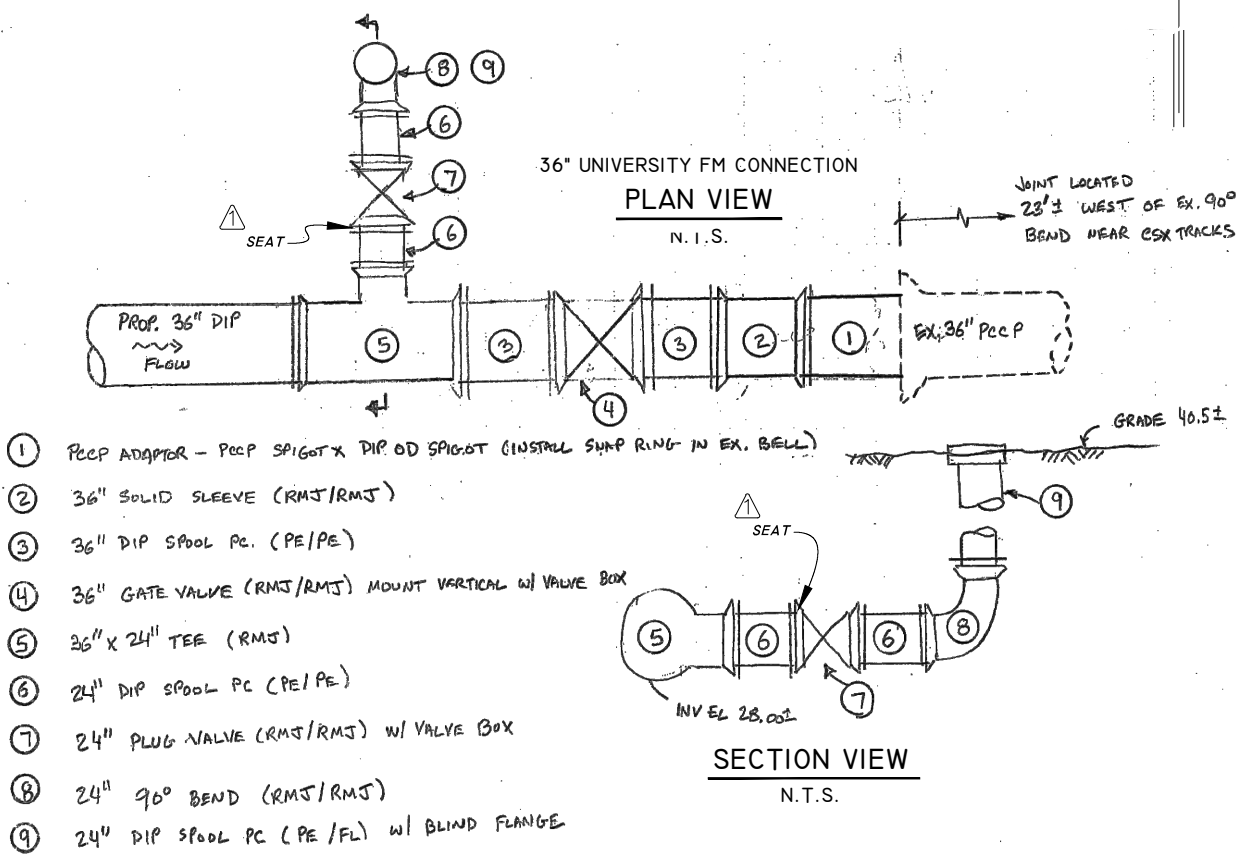

- ① PECP ADAPTER - PECP SPIGOT X DIP OD SPIGOT (INSTALL SHIM RING IN EX. BELL)
- ② 36\" SOLID SLEEVE (RMS/RMS)
- ③ 36\" DIP SPOOL PC (PE/PE)
- ④ 36\" GATE VALVE (RMS/RMS) MOUNT VERTICAL W/ VALVE BOX
- ⑤ 36\" X 24\" TEE (RMS)
- ⑥ 24\" DIP SPOOL PC (PE/PE)
- ⑦ 24\" PLUG VALVE (RMS/RMS) W/ VALVE BOX
- ⑧ 24\" 90° BEND (RMS/RMS)
- ⑨ 24\" DIP SPOOL PC (PE/FL) W/ BLIND FLANGE

PROPOSED CONNECTION DETAIL
NOT TO SCALE

USE, 2011 Sep 30, 2015 - 2:56pm
UNIVERSITY PUMPING STATION EMERGENCY REPAIRS
UNIVERSITY OF TAMPA

JACINTO CARLOS FERRAS, P.E. #49454
DESIGN DIVISION HEAD
WASTEWATER DEPARTMENT


No.	DATE	REVISIONS
3		
2		
⚠	09/30/15	SHOW SEAT-SIDE OF PROPOSED PLUG VALVES

DES: J.F.
DRN: J.F.BB
CKD:
DATE:

CITY of TAMPA
WASTEWATER DEPARTMENT


UNIVERSITY PUMPING STATION
EMERGENCY REPAIRS
SITE PLAN AND PROPOSED CONNECTION

A-13
SEC. 07 T285 R19E

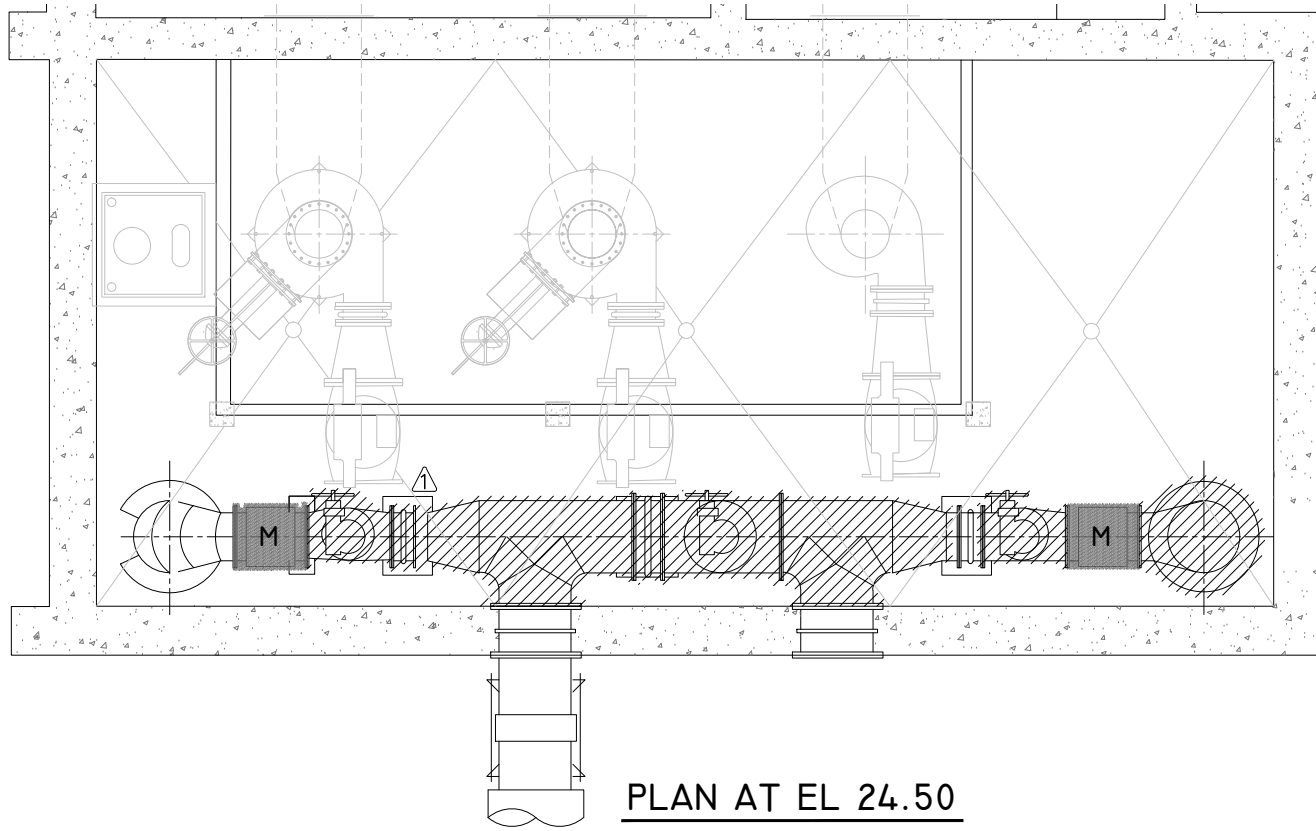


PLAN AT EL 24.50

APPROXIMATE SCALE: 1/8" = 1'-0"

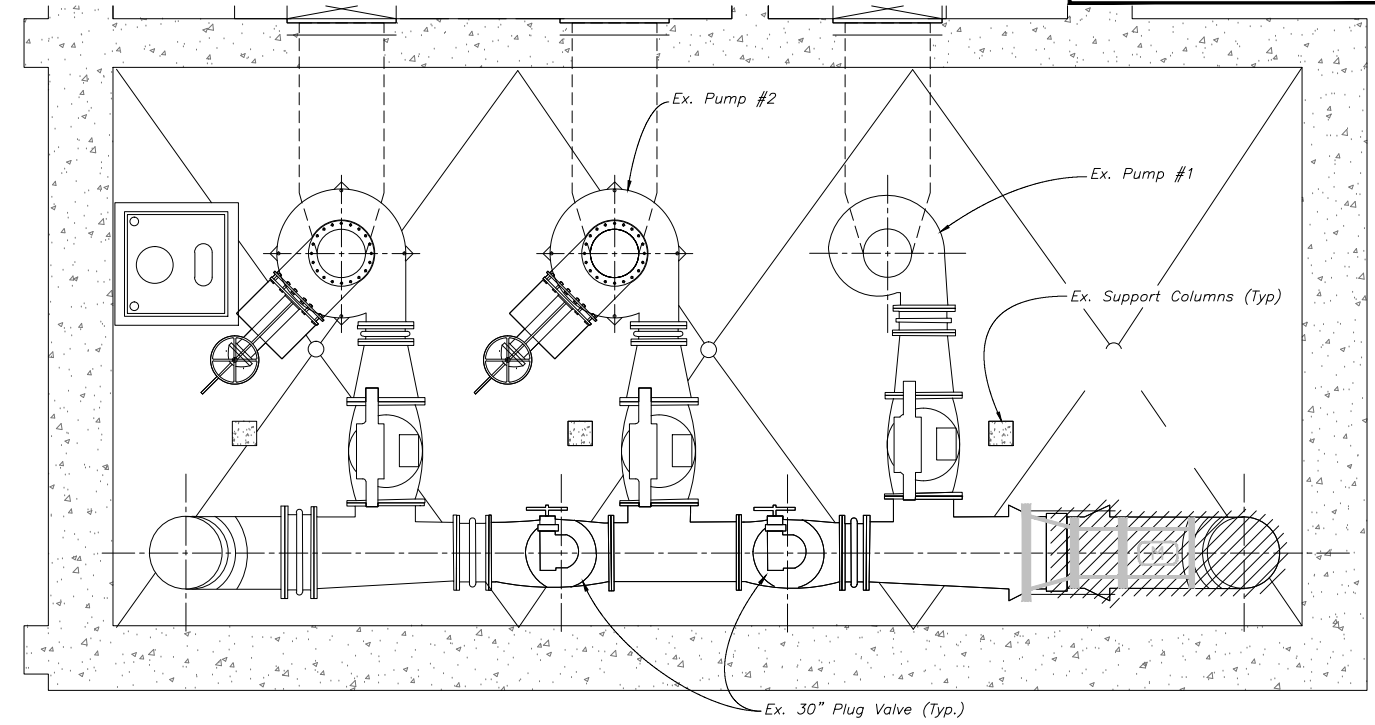

PLAN AT EL.15.00


APPROXIMATE SCALE: 1/8" = 1'-0"

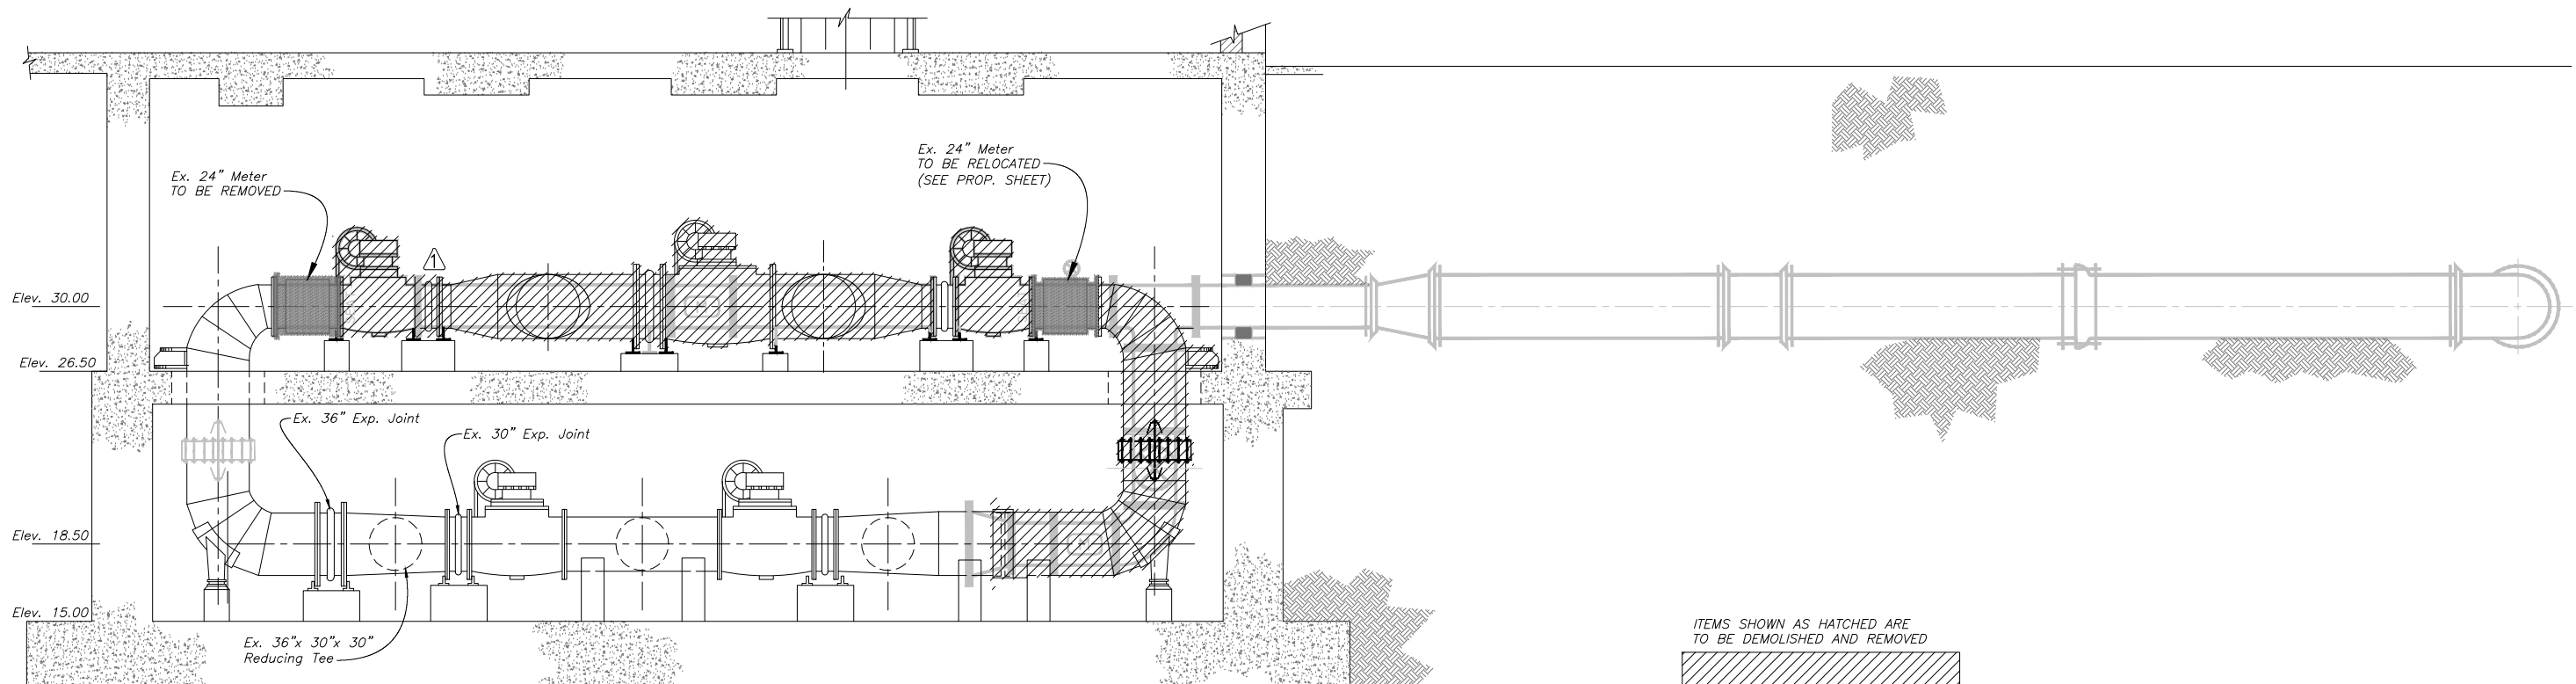

SECTION

APPROXIMATE SCALE: 1/8" = 1'-0"

ITEMS SHOWN AS HATCHED ARE TO BE DEMOLISHED AND REMOVED

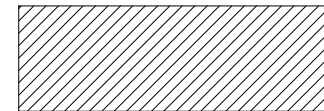

WWS - Sep 30, 2015 - 2:56pm
 JACINTO CARLOS FERRAS, P.E. #49454
 DESIGN DIVISION HEAD
 WASTEWATER DEPARTMENT


No.	DATE	REVISIONS
3		
2		
1	09/30/15	HATCHED N. EXPANSION JOINT (TO BE REMOVED)

DES: J.F.
DRN: BB
CKD:
DATE:

CITY of TAMPA
WASTEWATER DEPARTMENT

**UNIVERSITY PUMPING STATION
EMERGENCY REPAIRS
DEMOLITION PLAN AND SECTION**


W.O.1000801
SHEET
3

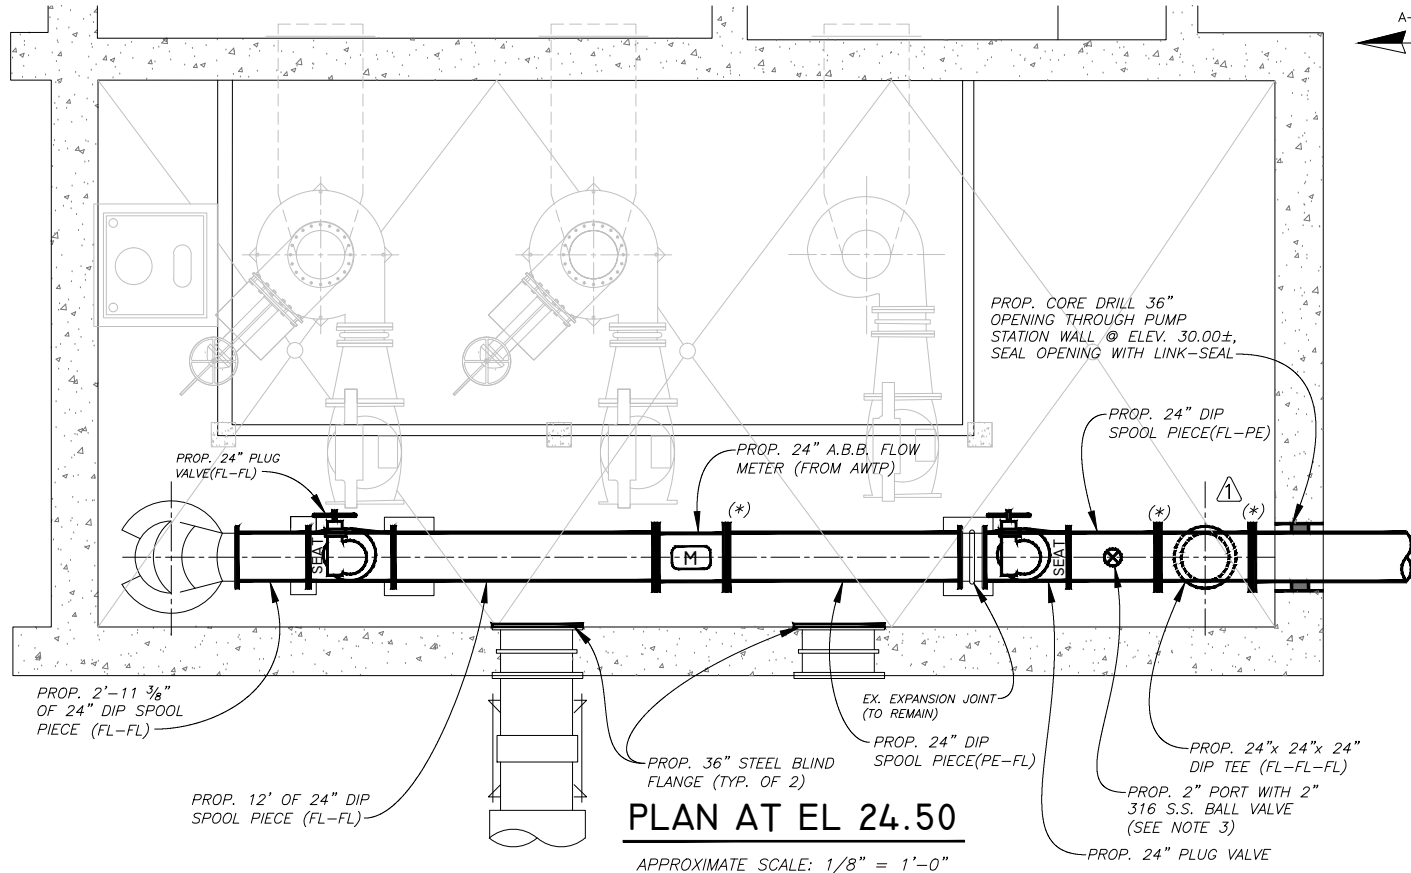

PLAN AT EL 24.50


APPROXIMATE SCALE: 1/8" = 1'-0"

A-13
SEC. 07 T28S R19E

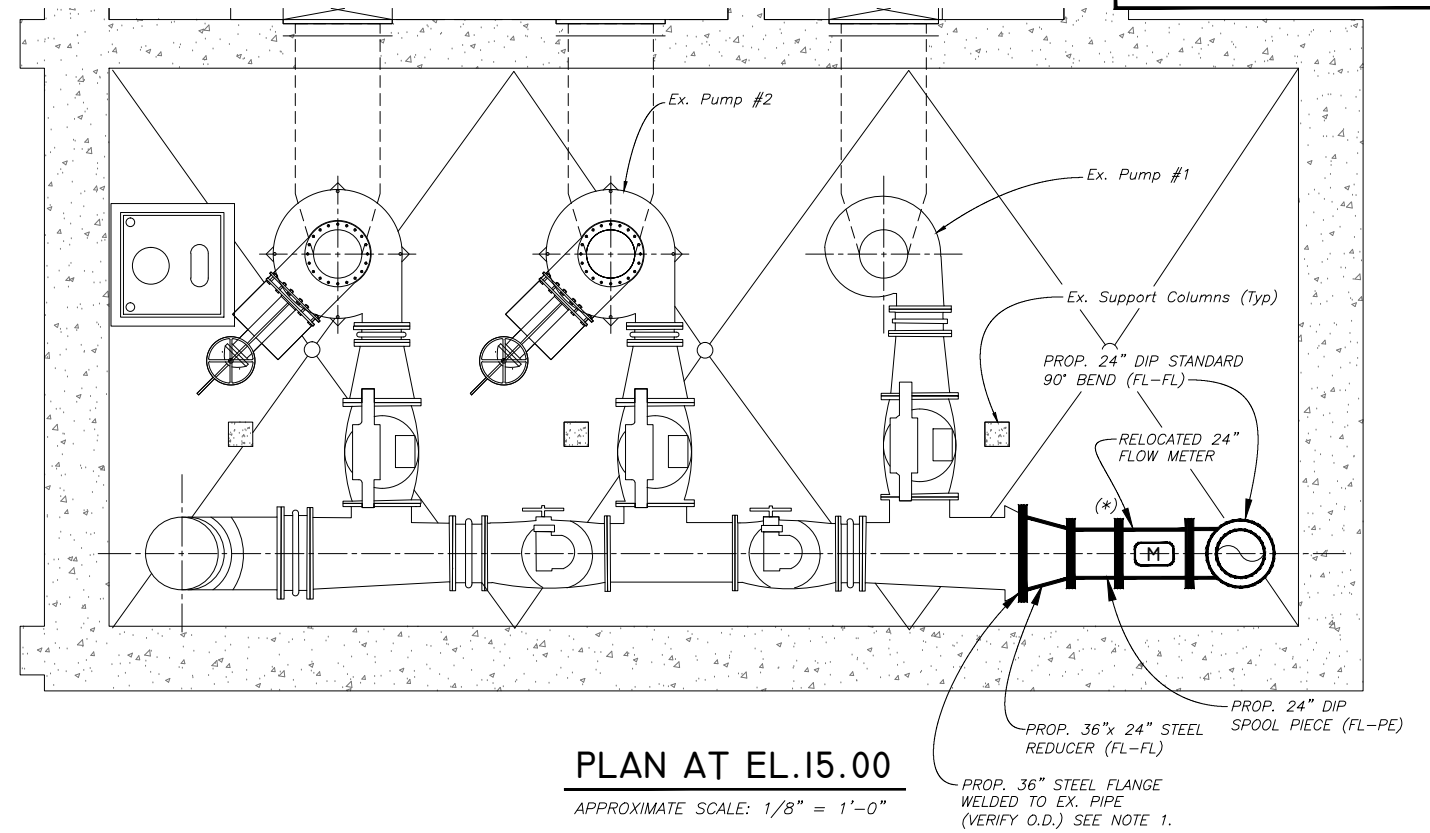

PLAN AT EL.15.00

APPROXIMATE SCALE: 1/8" = 1'-0"

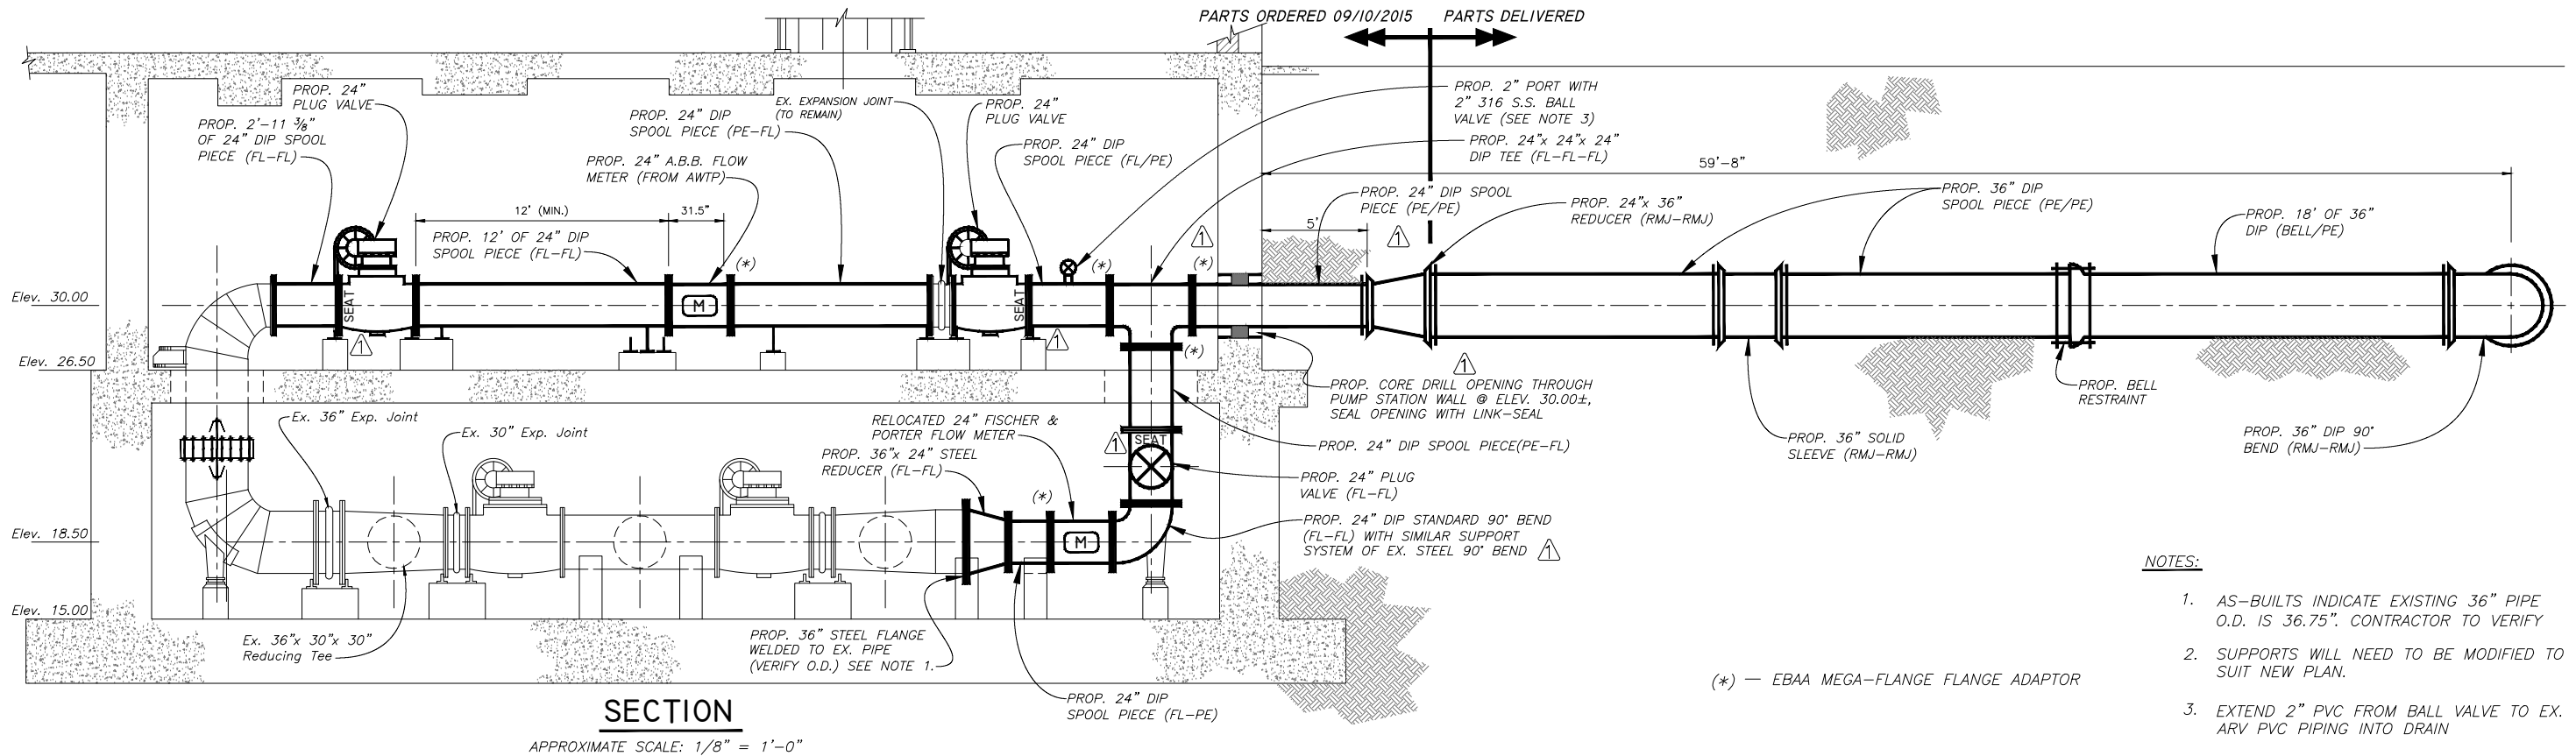

SECTION

APPROXIMATE SCALE: 1/8" = 1'-0"

PARTS ORDERED 09/10/2015 PARTS DELIVERED

NOTES:

- AS-BUILTS INDICATE EXISTING 36" PIPE O.D. IS 36.75". CONTRACTOR TO VERIFY
- SUPPORTS WILL NEED TO BE MODIFIED TO SUIT NEW PLAN.
- EXTEND 2" PVC FROM BALL VALVE TO EX. ARV PVC PIPING INTO DRAIN

(*) — EBAA MEGA-FLANGE FLANGE ADAPTOR

Layout - Sep 30, 2015 - 2:56pm

No.	DATE	REVISIONS
3		
2		
⚠	09/30/15	SHOW SEAT-SIDE OF PROP. PLUG VALVES, PIPE W/O EXPANSION JOINTS & MISC. REVISIONS


DES: J.F.
DRN: BB
CKD:
DATE:

CITY of TAMPA
WASTEWATER DEPARTMENT

UNIVERSITY PUMPING STATION
EMERGENCY REPAIRS
PROPOSED PLAN AND SECTION

W.O.1000801
SHEET
4

LOCATION MAP

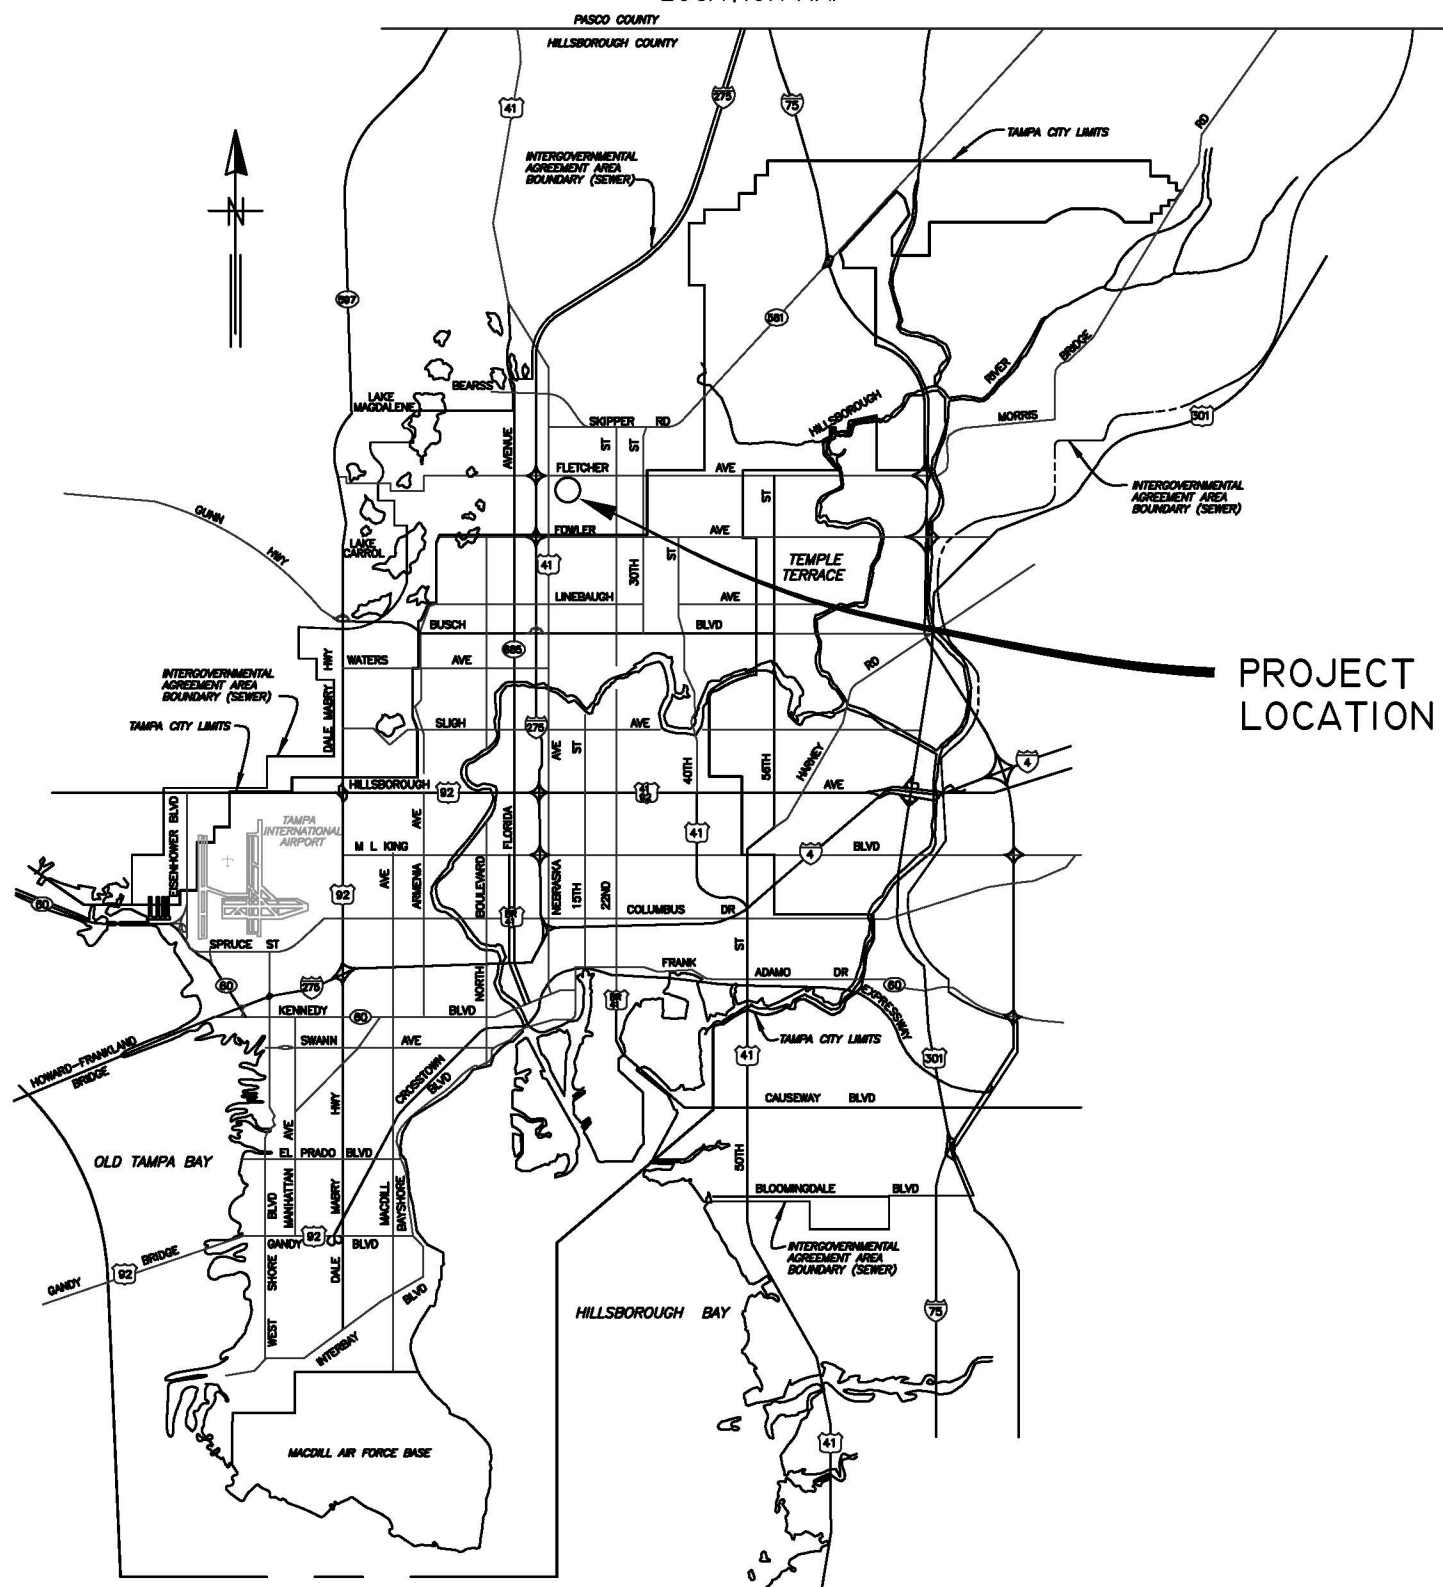

CITY of TAMPA



PROJECT LOCATION

WASTEWATER DEPARTMENT

PLANS FOR


UNIVERSITY PUMP STATION
ODOR CONTROL PLATFORM

JACINTO CARLOS FERRAS, P.E. #49454 DESIGN DIVISION HEAD WASTEWATER DEPARTMENT	No.	DATE	REVISIONS	DES: RJ/TS	CITY of TAMPA WASTEWATER DEPARTMENT	UNIVERSITY PUMPING STATION PROPOSED ODOR CONTROL PLATFORM	WO#1000089
	3			DRN: BL			SHEET
	2			CKD:			1
	1			DATE:			of 7

SHEET INDEX	
SHEET NUMBER	SHEET TITLE
1	COVER
2	INDEX, LOCATION MAP, NOTES
3	EXISTING SITE PLAN
4	PROPOSED PLATFORM PLAN VIEW
5	ISOMETRIC VIEW
6,7	ELEVATION VIEWS

GENERAL NOTES

1. CONTRACTOR SHALL COORDINATE ALL CONSTRUCTION ACTIVITIES WITH THE WASTEWATER INSPECTOR, WASTEWATER PERSONNEL AND PUMP STATION OPERATOR.
2. NORMAL WORKING HOURS SHALL BE WEEKDAYS 7:30AM TO 4:00PM UNLESS OTHERWISE APPROVED BY THE ENGINEER.
3. CONTRACTOR SHALL VERIFY QUANTITIES OF ALL NECESSARY SUPPORTS, GRATING, RAILING, LADDERS AND HARDWARE.
4. DIMENSIONS SHOWN ARE NOT NECESSARILY ACCURATE TO THE DEGREE REQUIRED FOR FABRICATION. EXISTING DIMENSIONS AND VIEWS ARE SHOWN BASED ON THE BEST INFORMATION AVAILABLE. CONTRACTOR SHALL FIELD VERIFY ALL PERTINENT DIMENSIONS AND REFLECT THEM ON DETAILED SHOP DRAWINGS FOR APPROVAL BEFORE ANY FABRICATION.
5. SHOP DRAWINGS SHALL BE SUBMITTED AND APPROVED BY THE CITY FOR ALL PROPOSED ITEMS. ALL SUBMITTALS AND SHOP DRAWINGS SHALL BE ORIGINALS OR HIGH QUALITY COPIES (CLEARLY LEGIBLE). NO FAXED SHEETS OR POOR QUALITY COPIES WILL BE ACCEPTED FOR SUBMITTAL REVIEW.
6. DURING CONSTRUCTION, CONTRACTOR SHALL MAINTAIN A CLEAR PATH TO EXISTING PUMPING STATION EQUIPMENT FOR CITY STAFF TO ACCESS AND MAINTAIN THE EXISTING PUMPING STATION.
7. OSHA STANDARD SAFETY EQUIPMENT SUCH AS SAFETY HARNESS, GAS MONITORS, LOWER EXPLOSIVE LIMIT (LEL) DETECTORS, BREATHING APPARATUS, ETC. SHALL BE UTILIZED WHERE THE WORK DICTATES THEIR USE.
8. ALL COMPONENTS OF THE PLATFORM (EXCEPT CONNECTING HARDWARE) SHALL BE FIBERGLASS. THE FIBERGLASS SHALL BE CAPABLE OF WITHSTANDING UV RAYS, CAUSTIC SODA, SODIUM HYPOCHLORITE, HYDROGEN SULFIDE AND CHLORINE. AT MINIMUM THE COMPONENTS SHALL BE EXTREN 625 VINYL ESTER OR APPROVED EQUAL.
9. GRATING SHALL BE PULTRUDED FIBERGLASS AND CAPABLE OF WITHSTANDING UV RAYS, CAUSTIC SODA, SODIUM HYPOCHLORITE, HYDROGEN SULFIDE AND CHLORINE. GRATING SHALL HAVE A NON-SLIP SURFACE AND SECURED USING STAINLESS STEEL CLIPS.
10. PLATFORM SHALL MEET OSHA STANDARDS AND ANY PERTINENT BUILDING CODES.
11. ALL HARDWARE SHALL BE 316 STAINLESS STEEL.
12. ALL CONNECTIONS SHALL BE FIXED AND RIGID.
13. PLATFORM SHALL BE DESIGNED TO CARRY A MINIMUM OF 40 PSF UNIFORM LOAD AND A 300 LB CONCENTRATED LOAD WITH APPROPRIATE SAFETY FACTORS AND HAVE A MAXIMUM DEFLECTION OF 1/4".
14. PLATFORM SHALL BE DESIGNED TO CARRY A MINIMUM 1000 LB LATERAL LOAD AT THE TOP OF THE PLATFORM
15. VERTICAL SUPPORT MEMBERS SHALL BE PLACED IN A MANNER THAT MINIMIZES INTERFERENCES WITH MAINTENANCE ACTIVITY AND WITHIN THE WASHDOWN TROUGH AREA, AS DETERMINED BY THE ENGINEER.
16. PLATFORM SHALL ALLOW EASY ACCESS TO BOTH UPPER AND LOWER ACCESS PORTS AS DEPICTED ON PLANS.
17. PLATFORM SHALL HAVE TWO (2) LADDERS AS DEPICTED ON PLANS.
18. PLATFORM GRATING SHALL BE 14'-6" ABOVE WASHDOWN AREA GRADE.


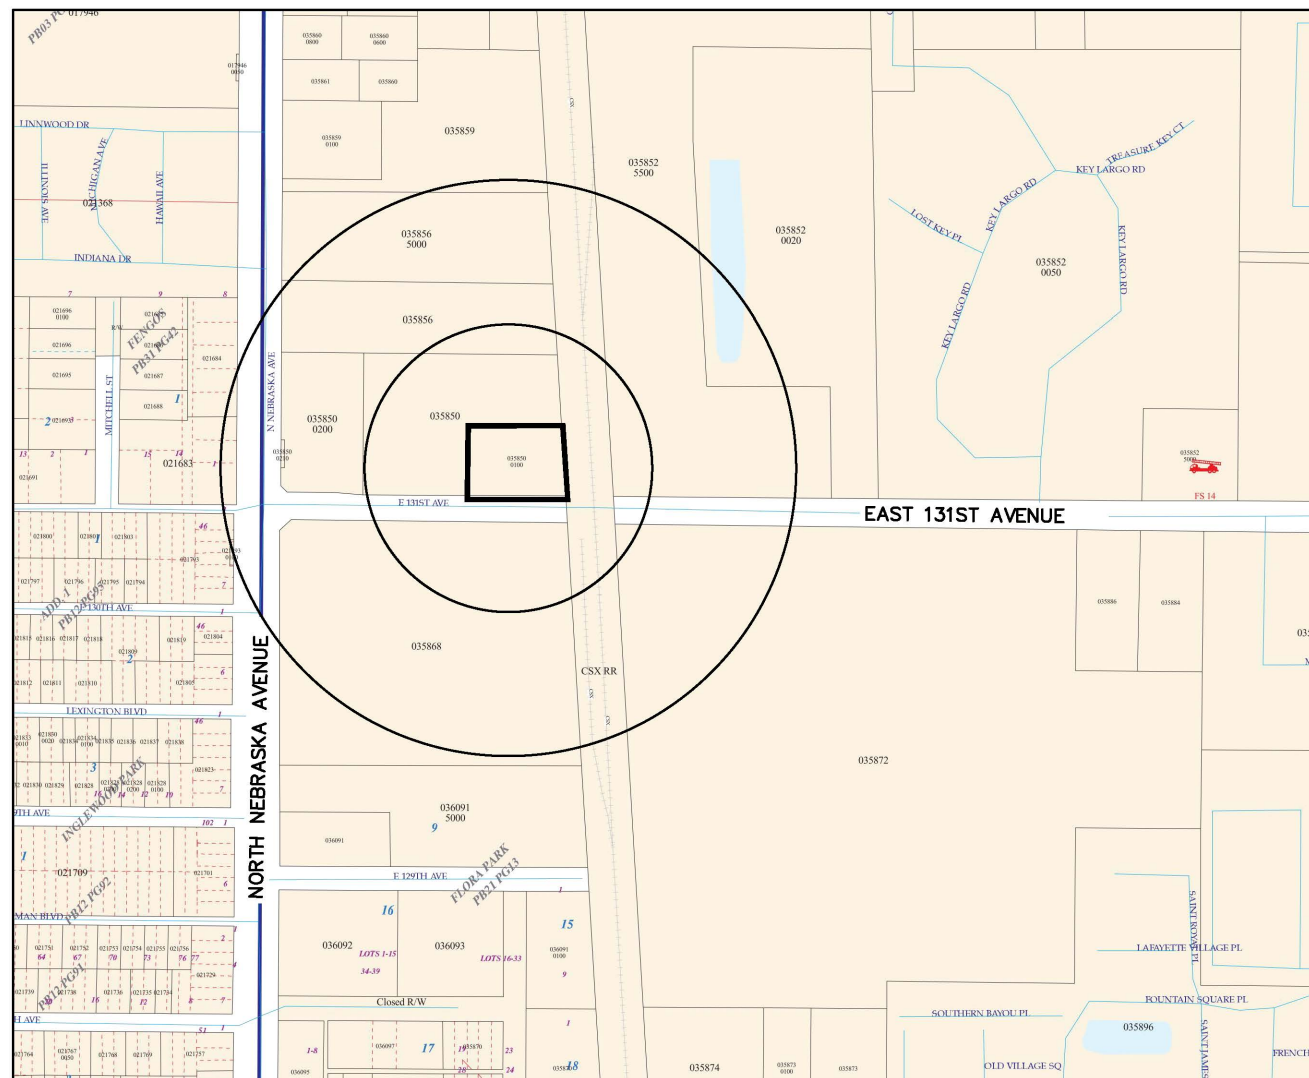


COT ATLAS A-13
SEC 07 T28S R19E

**PROJECT LOCATION
920 EAST 131st AVENUE**

JACINTO CARLOS FERRAS, P.E. #49454 DESIGN DIVISION HEAD WASTEWATER DEPARTMENT	No.	DATE	REVISIONS	DES: RJ/T.S. DRN: B.L. CKD: DATE:	CITY of TAMPA WASTEWATER DEPARTMENT	UNIVERSITY PUMPING STATION PROPOSED ODOR CONTROL PLATFORM INDEX, PROJECT LOCATION MAP, NOTES	WO#1000089
	3						SHEET
	2						2
	1						OF 7

EXISTING FIBERGLASS
SUPPORTS ARE
SHOWN IN BOLD

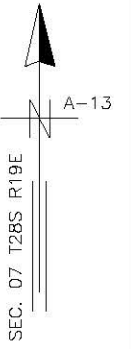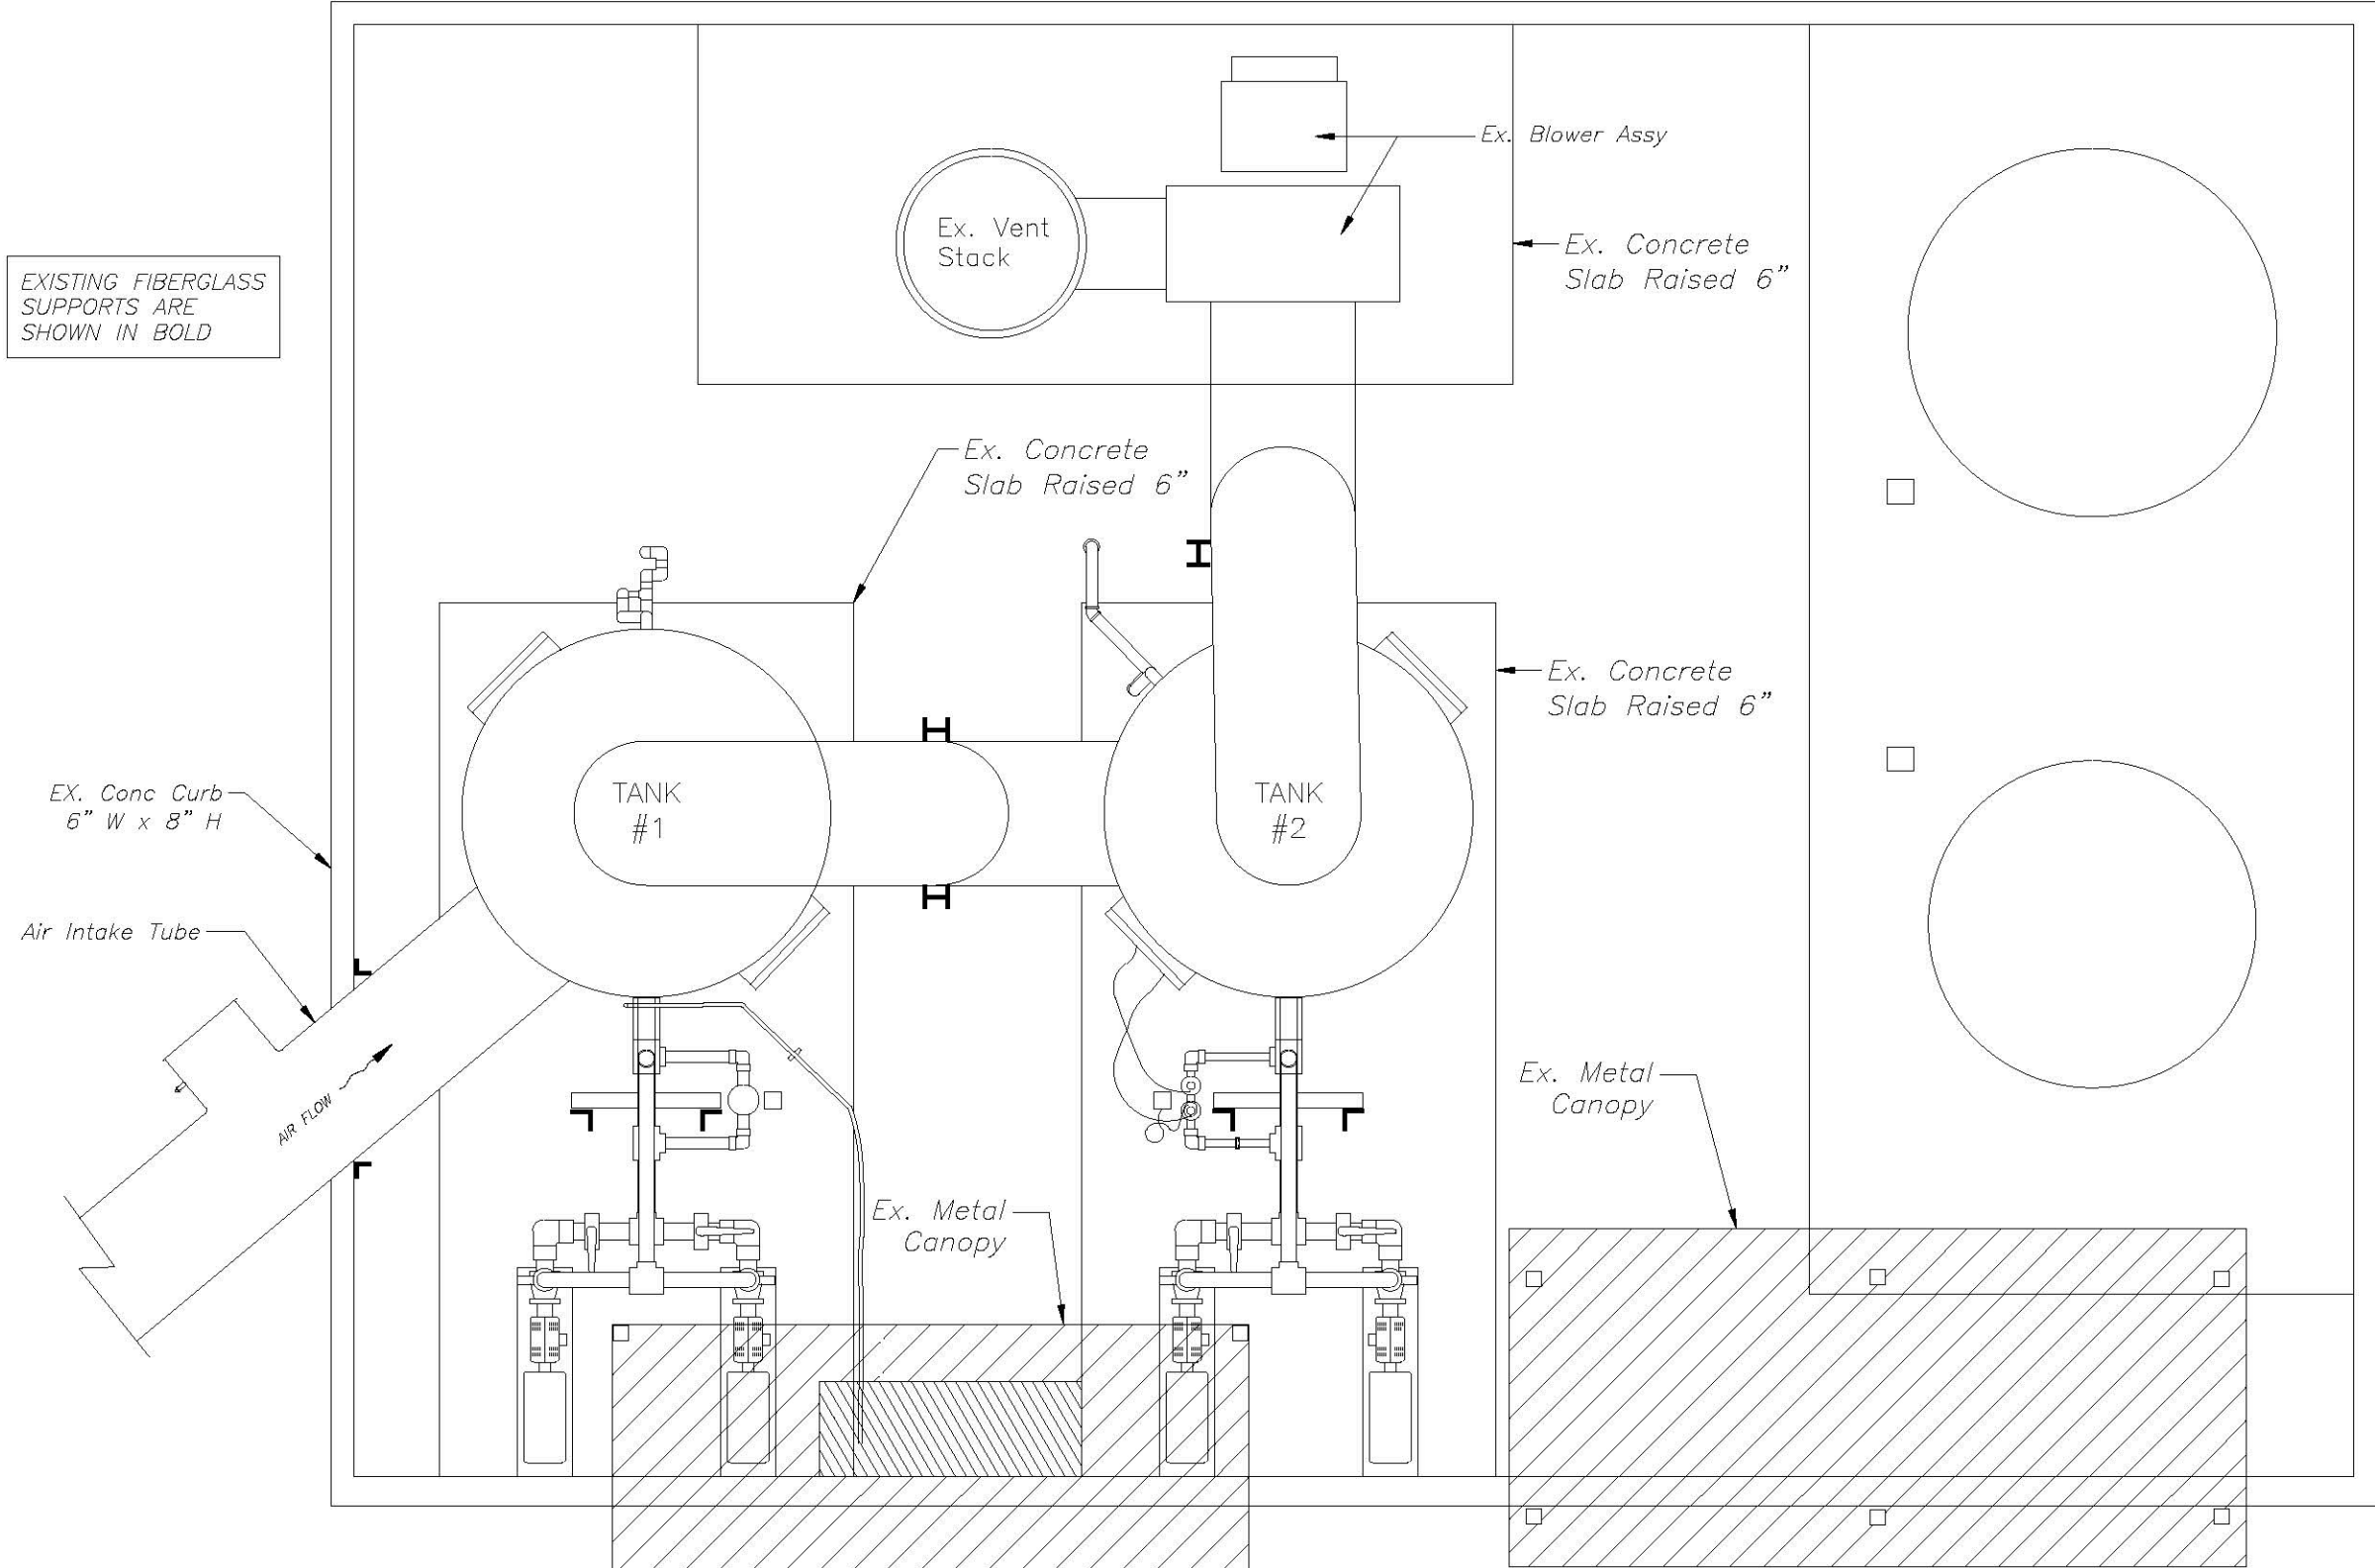

SITE PLAN
N.T.S.

JACINTO CARLOS FERRAS, P.E. #49454
DESIGN DIVISION HEAD
WASTEWATER DEPARTMENT

No.	DATE	REVISIONS
3		
2		
1		



DES: RJ/T.S.
DRN: B.L.
CKD:
DATE:

CITY of TAMPA
WASTEWATER DEPARTMENT

**UNIVERSITY PUMPING STATION PROPOSED
ODOR CONTROL PLATFORM
EXISTING SITE PLAN**

WO#1000089
SHEET
3
OF 7

K:\WWP\Projects\2014\2014_University PS Platform\Working Drawings\Final Set\Sh3_University Odor Platform - Existing Site.dwg, 10/31/2014 7:52:37 AM, 1:1

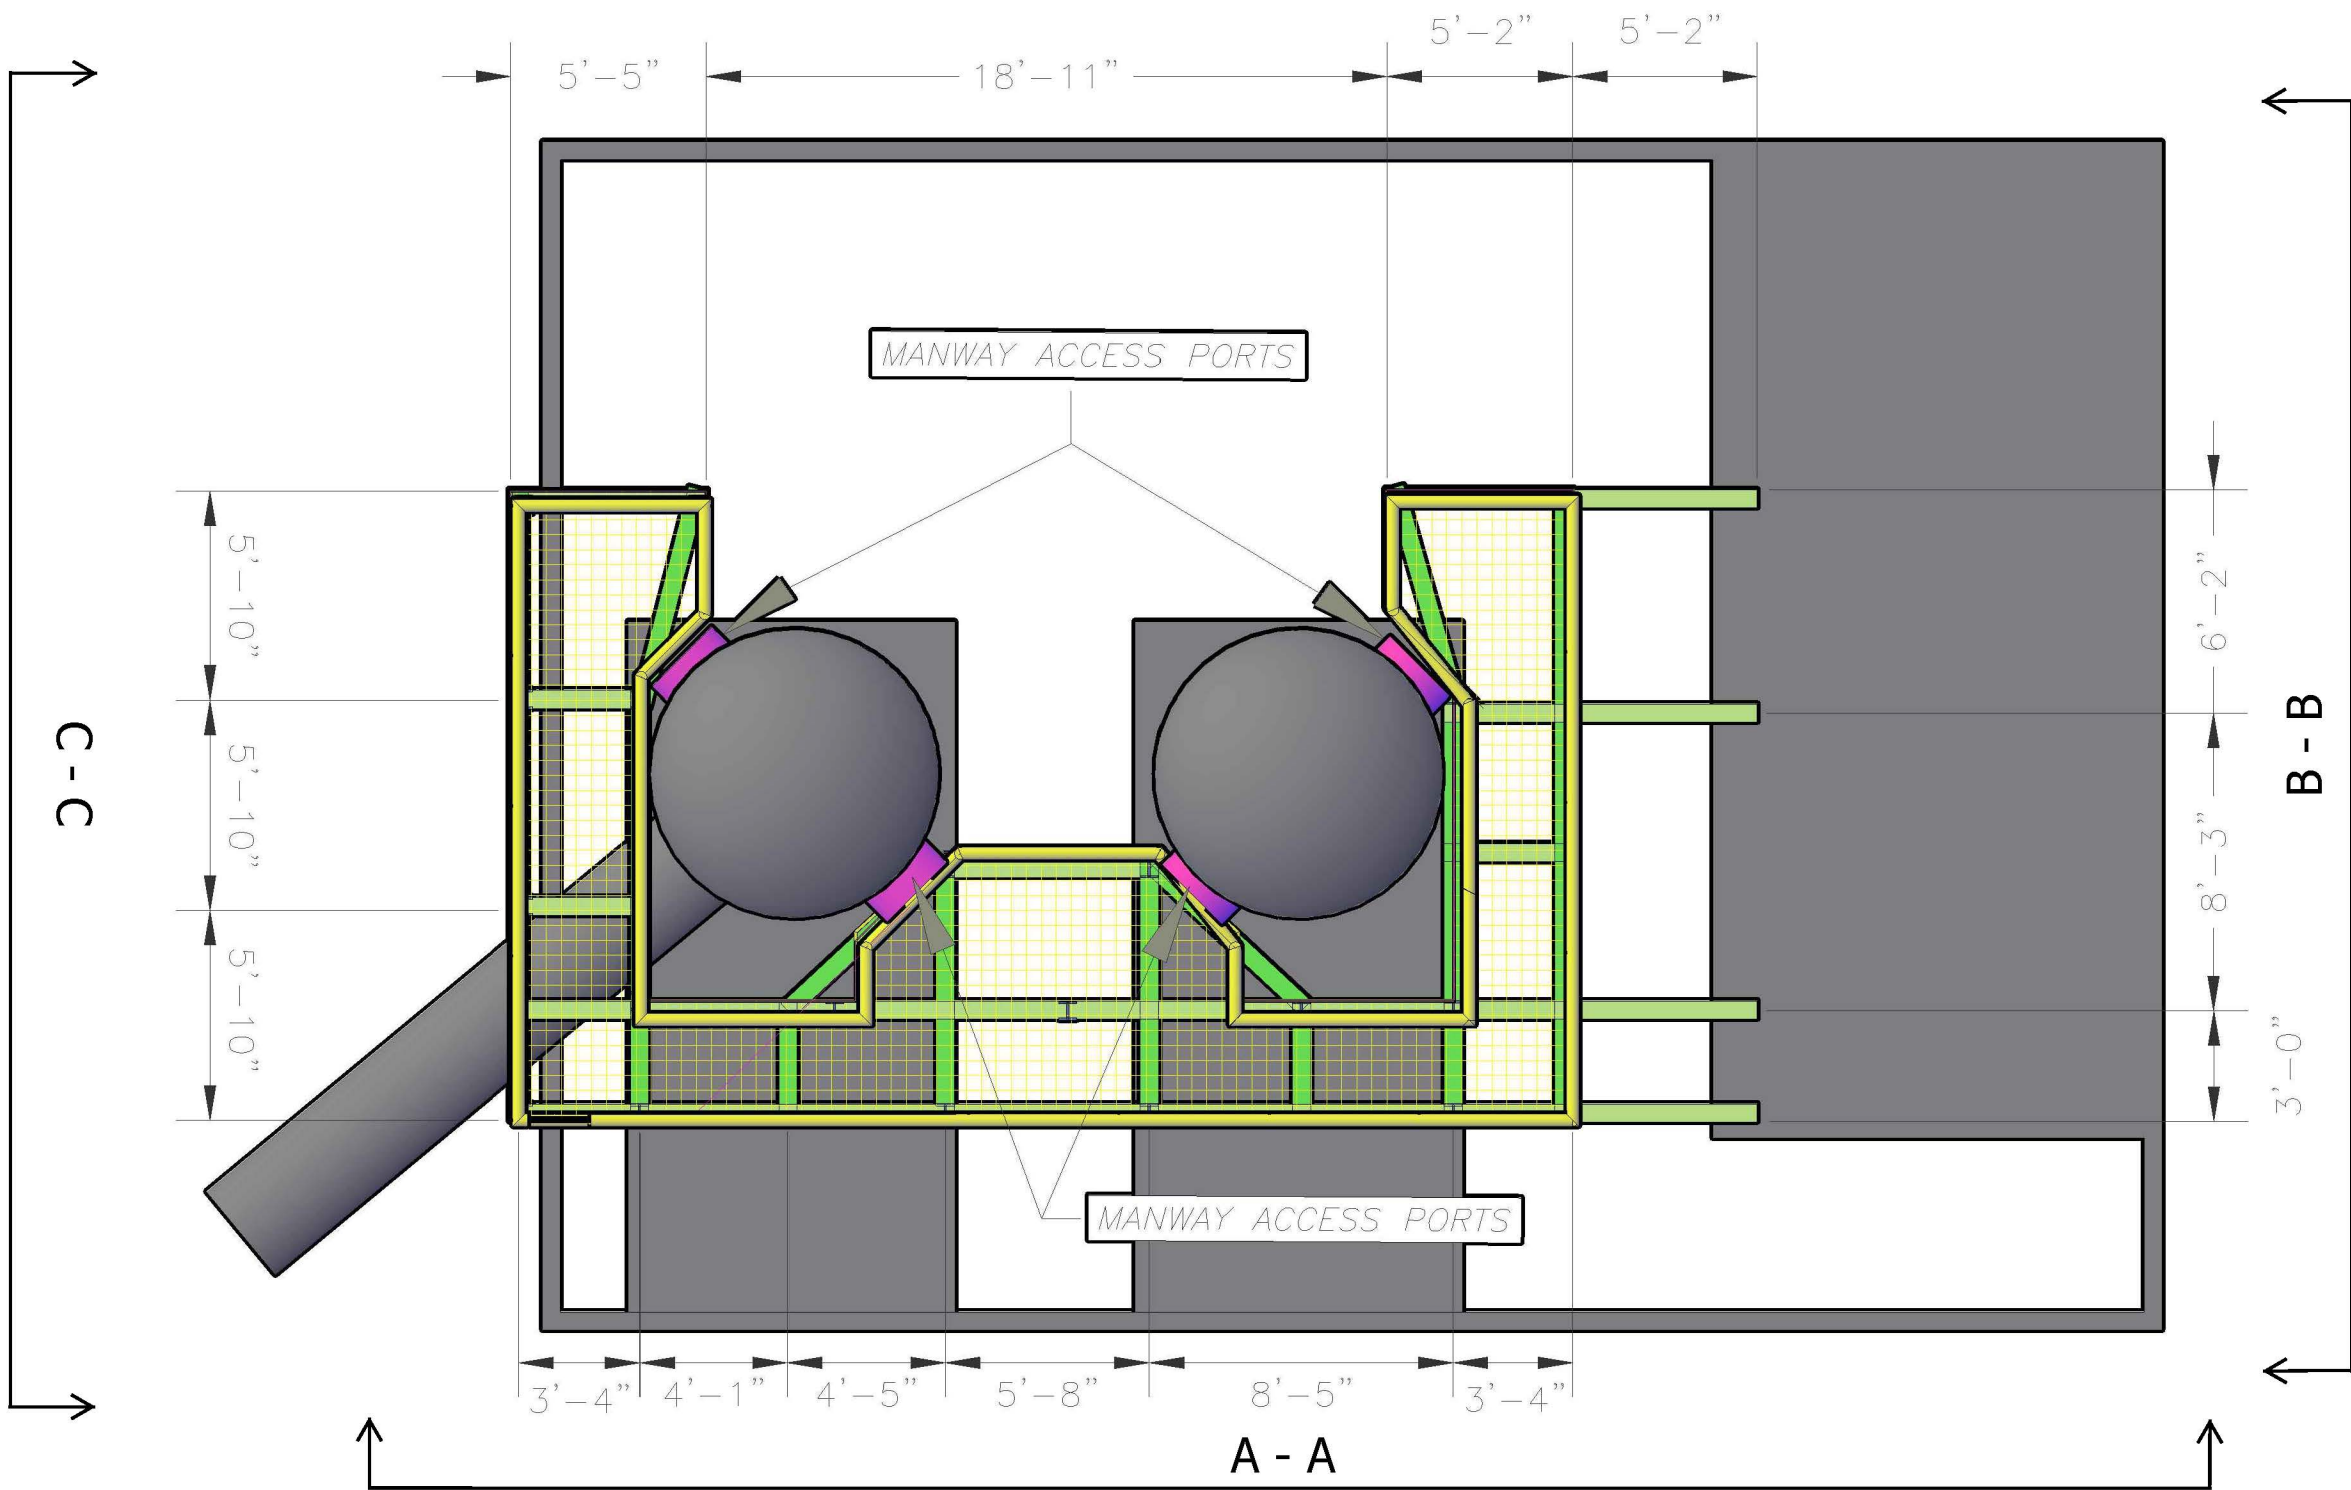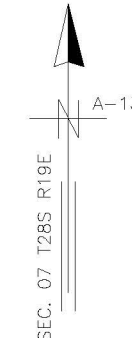

NOTE:
 DIMENSIONS SHOWN ARE NOT NECESSARILY ACCURATE TO THE DEGREE REQUIRED FOR FABRICATION. EXISTING DIMENSIONS AND VIEWS ARE SHOWN BASED ON THE BEST INFORMATION AVAILABLE. CONTRACTOR SHALL FIELD VERIFY ALL PERTINENT DIMENSIONS AND REFLECT THEM ON DETAILED SHOP DRAWINGS FOR APPROVAL BEFORE ANY FABRICATION.

PLATFORM PLAN VIEW
 N.T.S.

K:\WW_Projects\2014\2014_University PS Platform\Dwg\Working Drawings\Final Set\Sh4_University Odor Control Platform_Plan View.dwg, 10/30/2014 2:54:57 PM, 1:1

JACINTO CARLOS FERRAS, P.E. #49454
 DESIGN DIVISION HEAD
 WASTEWATER DEPARTMENT


No.	DATE	REVISIONS
3		
2		
1		

DES: RJ/TS
 DRN: BL
 CKD:
 DATE:


CITY of TAMPA
 WASTEWATER DEPARTMENT

**UNIVERSITY PUMPING STATION PROPOSED
 ODOR CONTROL PLATFORM
 PLAN VIEW**


WO#1000089
 SHEET
4
 OF 7

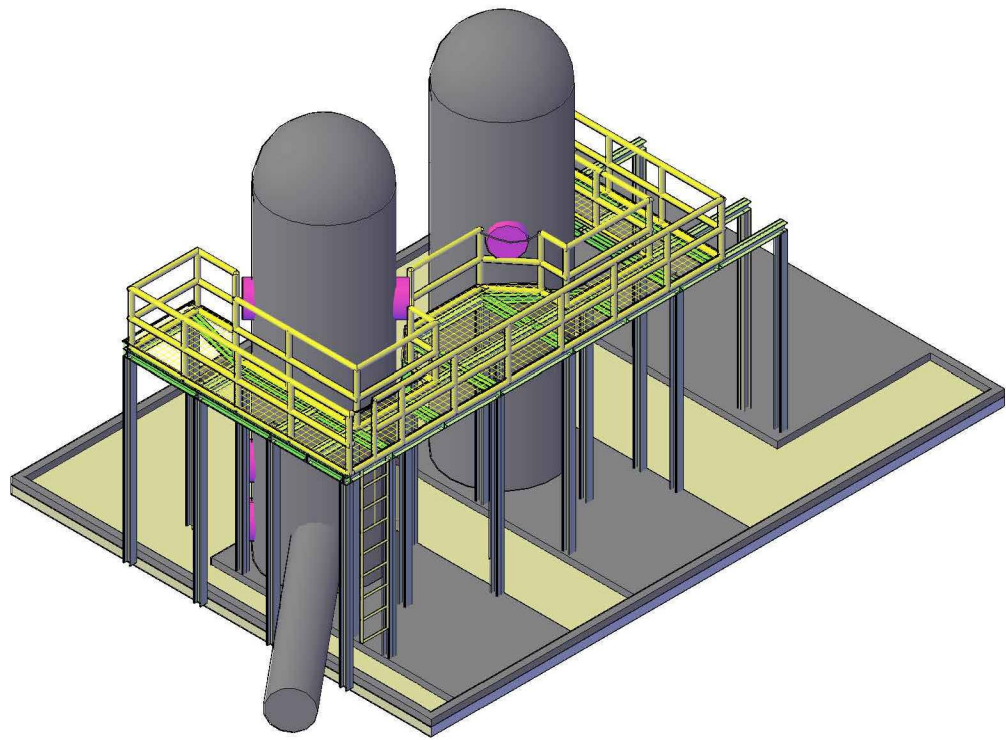


PLATFORM SW ISOMETRIC VIEW
N.T.S.

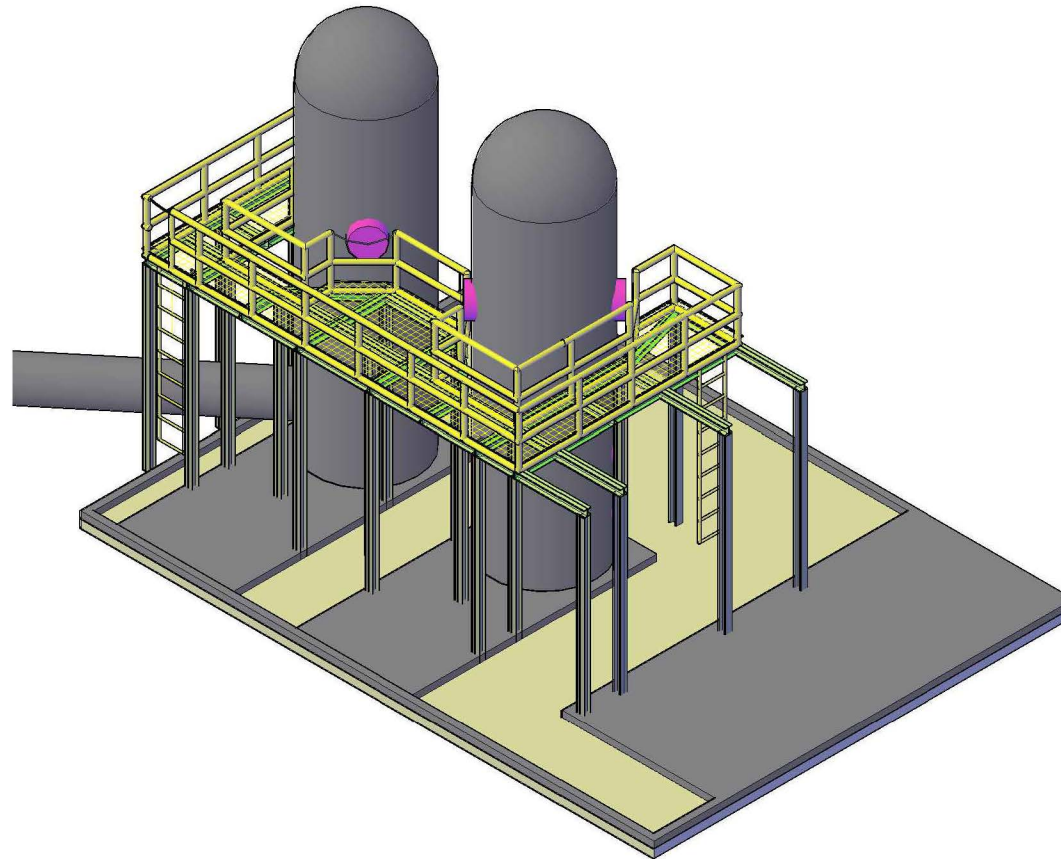

PLATFORM SE ISOMETRIC VIEW
N.T.S.

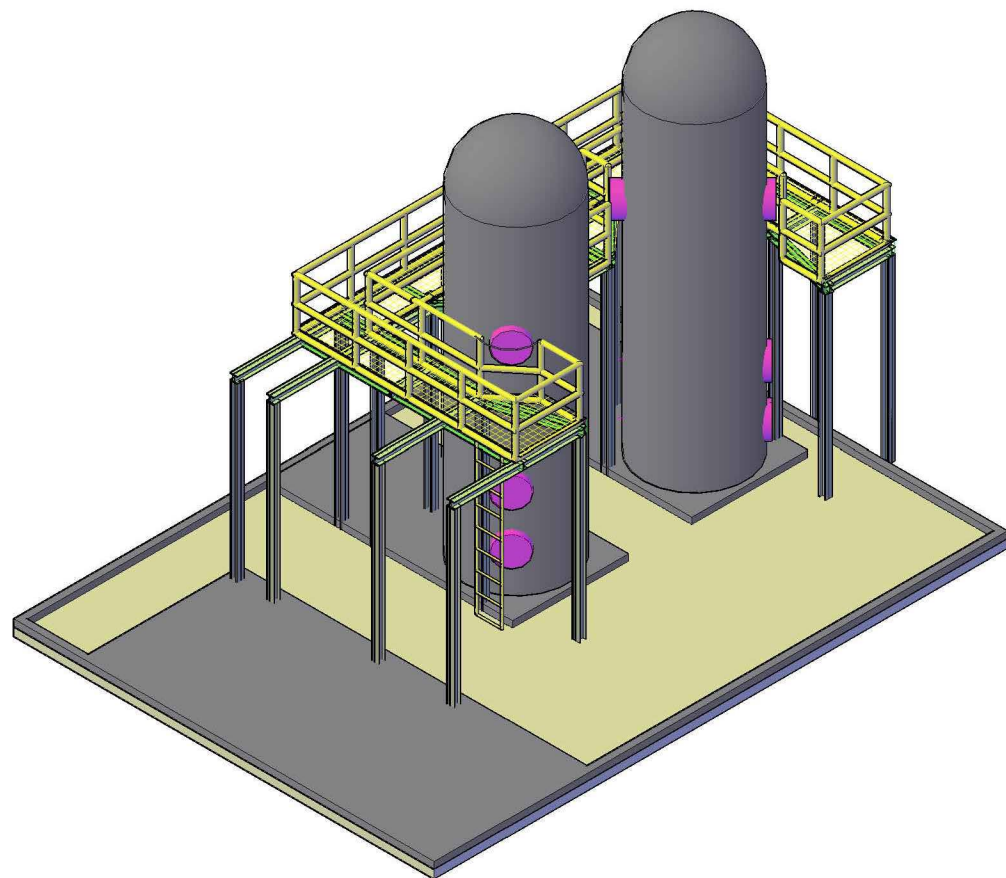


PLATFORM NE ISOMETRIC VIEW
N.T.S.

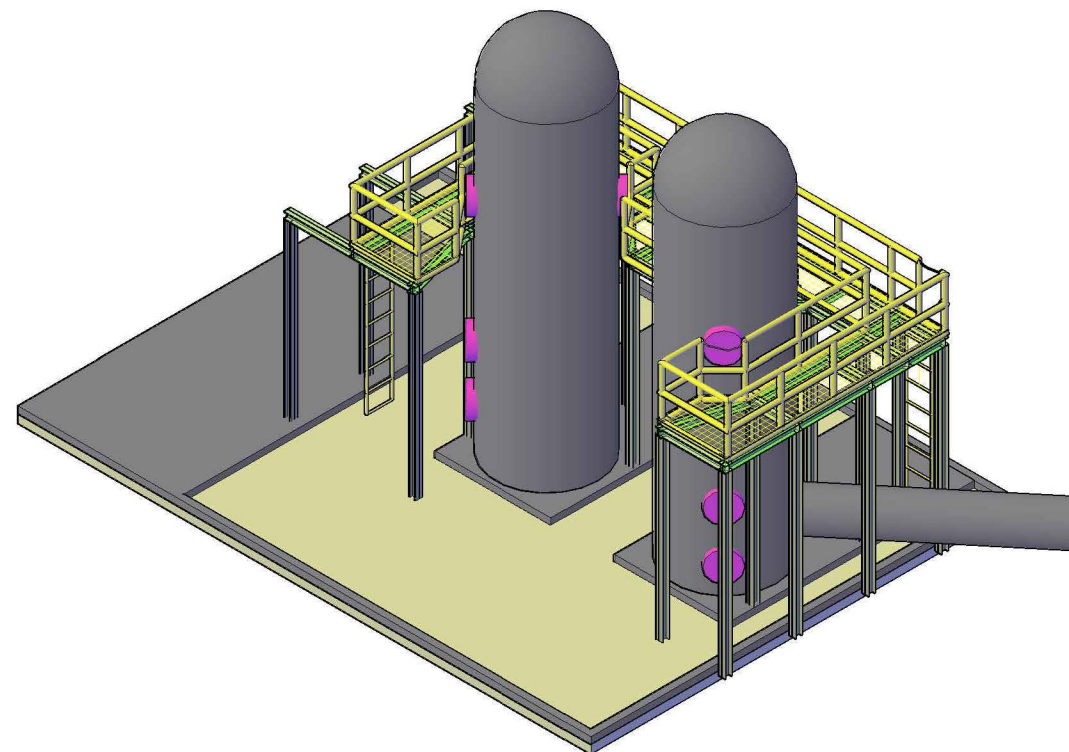

PLATFORM NW ISOMETRIC VIEW
N.T.S.

JACINTO CARLOS FERRAS, P.E. #49454 DESIGN DIVISION HEAD WASTEWATER DEPARTMENT	No.	DATE	REVISIONS	DES: RJ/TS	CITY of TAMPA WASTEWATER DEPARTMENT	UNIVERSITY PUMPING STATION PROPOSED ODOR CONTROL PLATFORM ISOMETRIC VIEWS	WO#100089
	3			DRN: BL			SHEET
	2			CKD:			5
	1			DATE:			OF 7

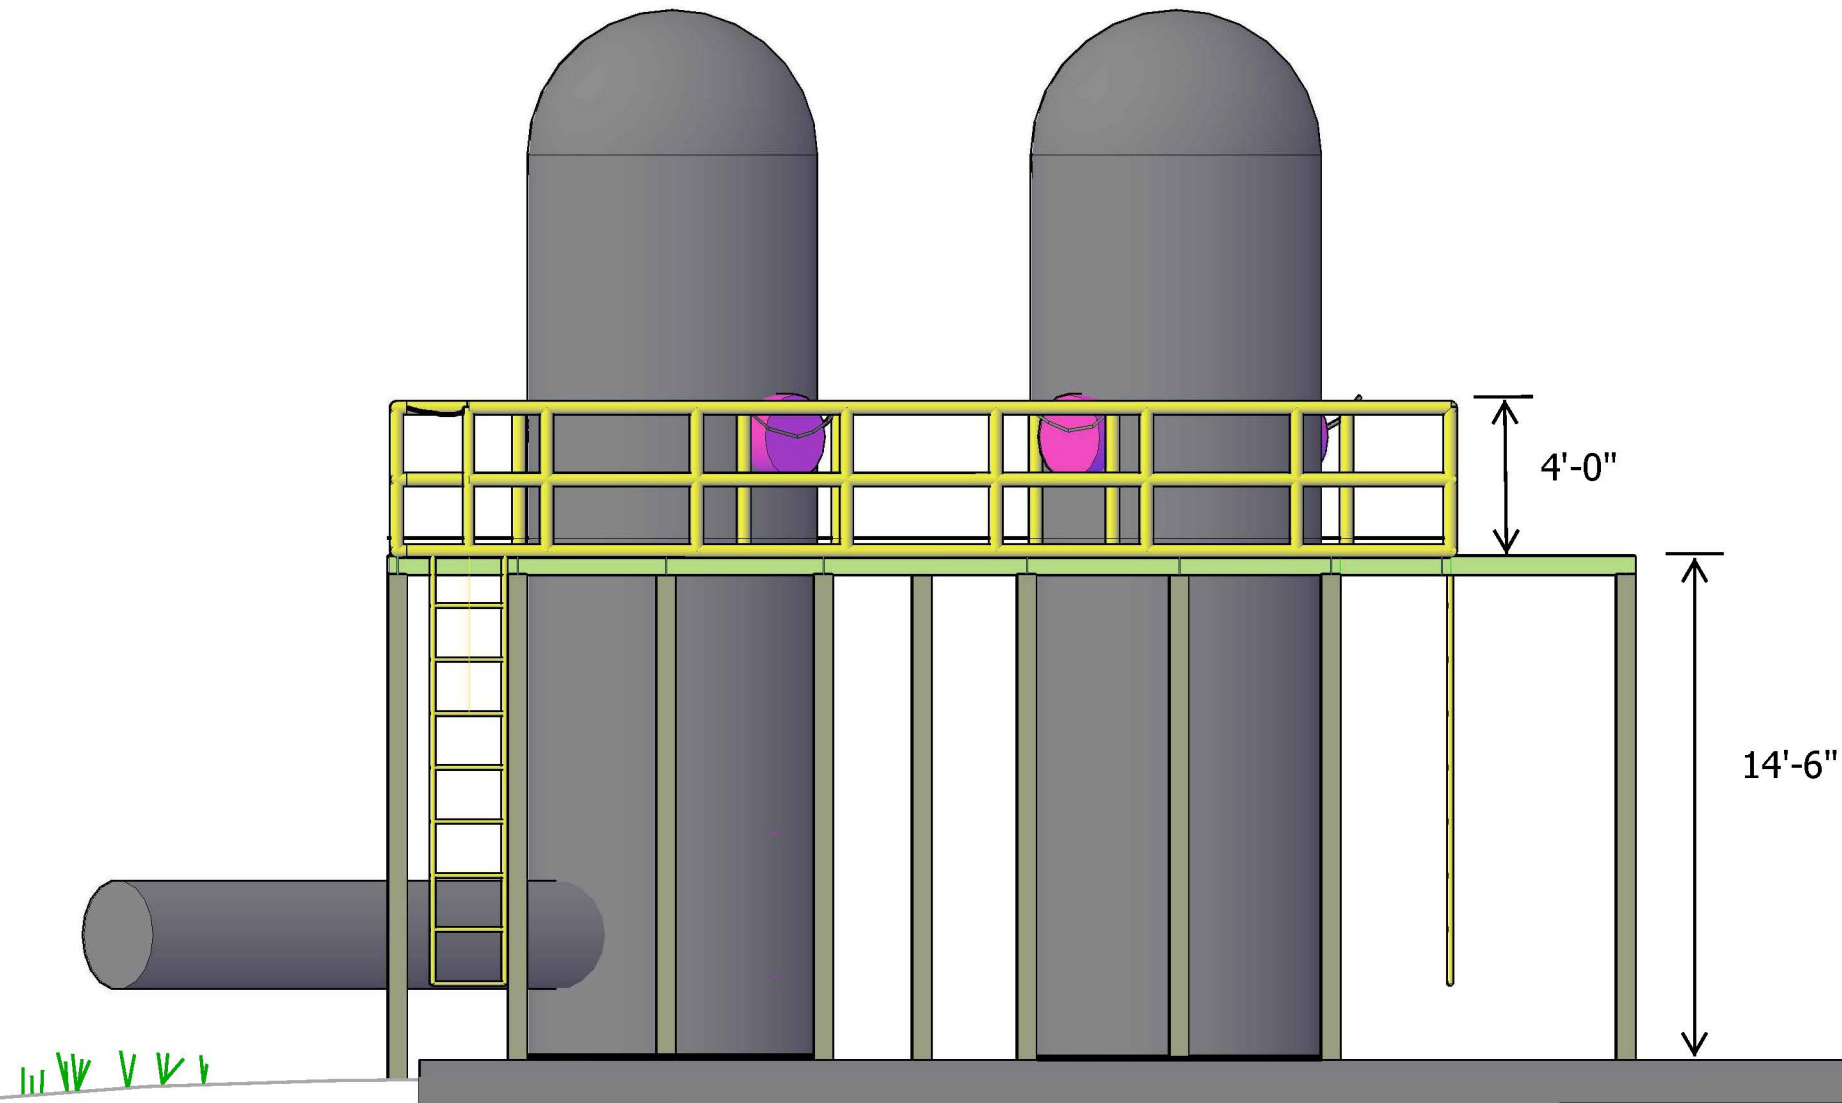


PLATFORM ELEVATION A-A
N.T.S.

NOTE:
DIMENSIONS SHOWN ARE NOT NECESSARILY ACCURATE TO THE DEGREE REQUIRED FOR FABRICATION. EXISTING DIMENSIONS AND VIEWS ARE SHOWN BASED ON THE BEST INFORMATION AVAILABLE. CONTRACTOR SHALL FIELD VERIFY ALL PERTINENT DIMENSIONS AND REFLECT THEM ON DETAILED SHOP DRAWINGS FOR APPROVAL BEFORE ANY FABRICATION.


JACINTO CARLOS FERRAS, P.E. #49454 DESIGN DIVISION HEAD WASTEWATER DEPARTMENT	No.	DATE	REVISIONS	DES:	CITY of TAMPA WASTEWATER DEPARTMENT	UNIVERSITY PUMPING STATION PROPOSED ODOR CONTROL PLATFORM FRONT ELEVATION	WO#1000089
	3			DRN:			SHEET
	2			CKD:			6
	1			DATE:			OF 7

K:\WWP\Projects\2014\2014_University PS Platform\Dwg\Working Drawings\Final Set\University Odor Control Platform - 3D - Elevations.dwg, 10/31/2014 8:18:33 AM, 1:1

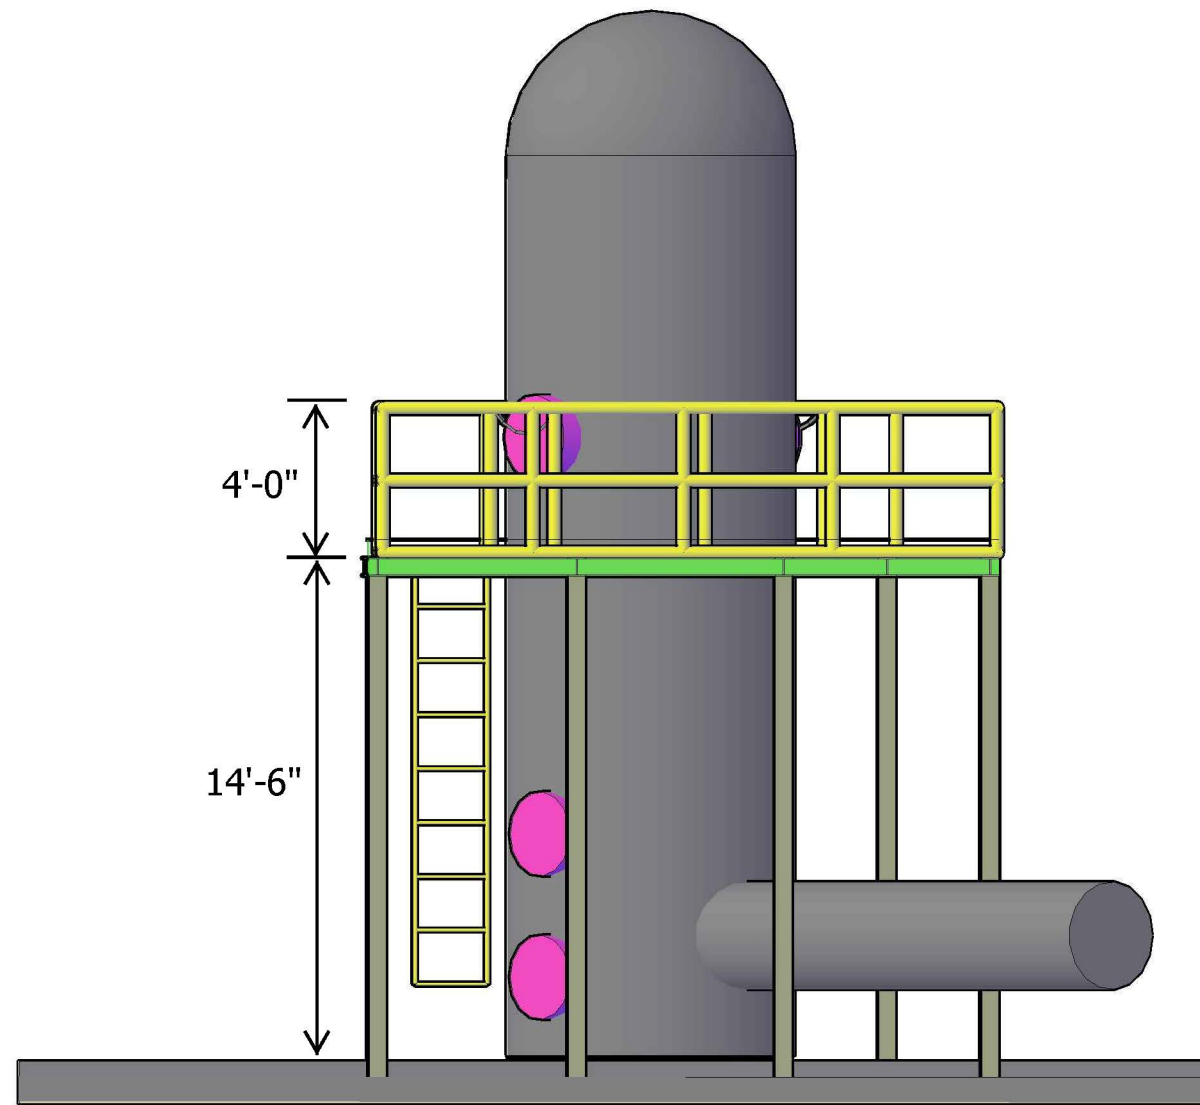

PLATFORM ELEVATION C-C

N.T.S.


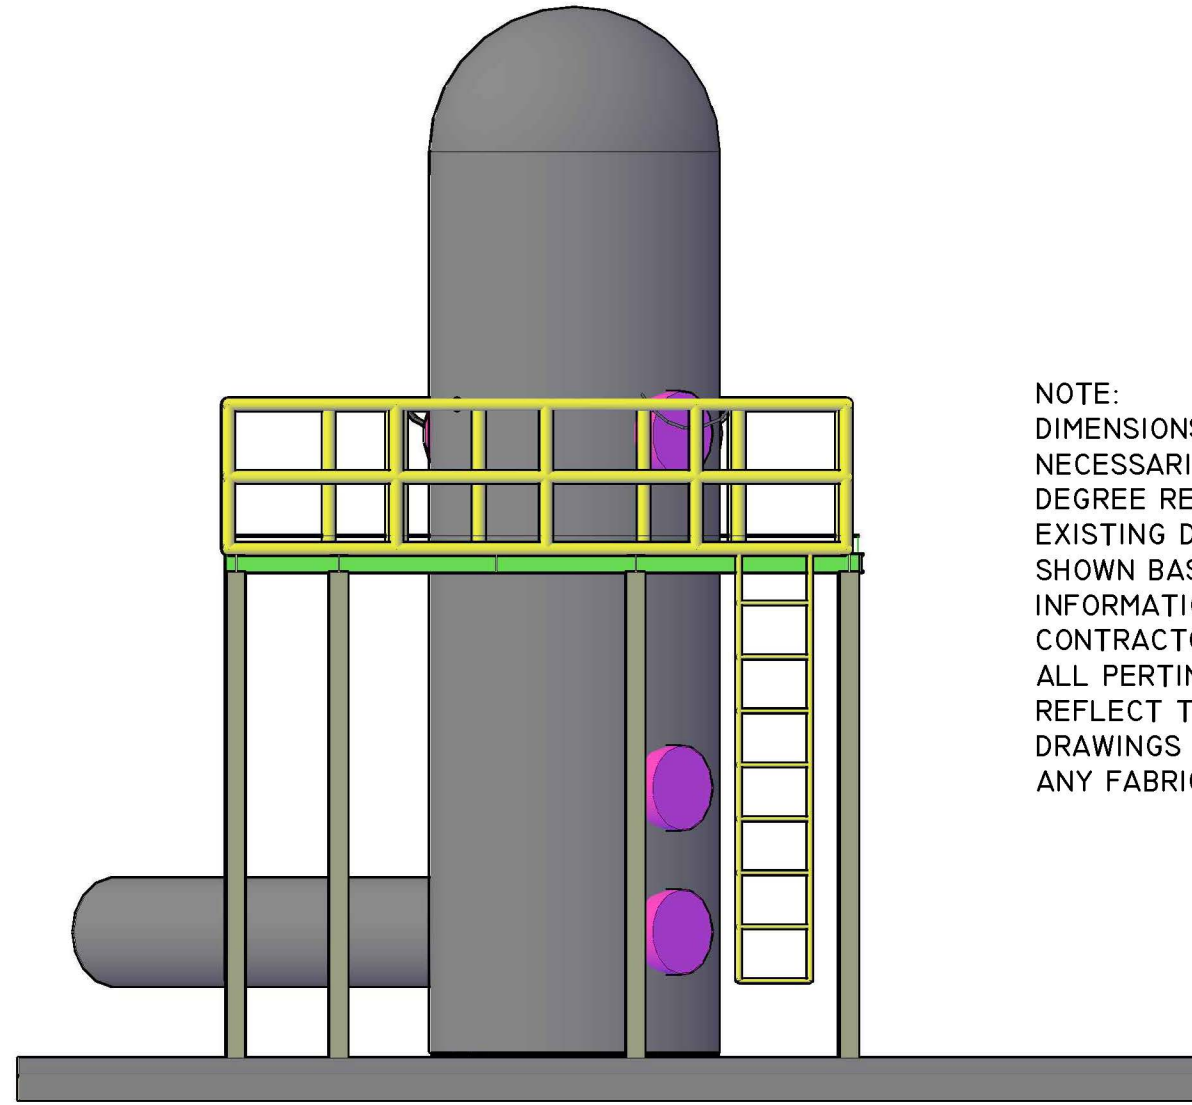


PLATFORM ELEVATION B-B

N.T.S.

NOTE:
 DIMENSIONS SHOWN ARE NOT NECESSARILY ACCURATE TO THE DEGREE REQUIRED FOR FABRICATION. EXISTING DIMENSIONS AND VIEWS ARE SHOWN BASED ON THE BEST INFORMATION AVAILABLE. CONTRACTOR SHALL FIELD VERIFY ALL PERTINENT DIMENSIONS AND REFLECT THEM ON DETAILED SHOP DRAWINGS FOR APPROVAL BEFORE ANY FABRICATION.

No.	DATE	REVISIONS
3		
2		
1		

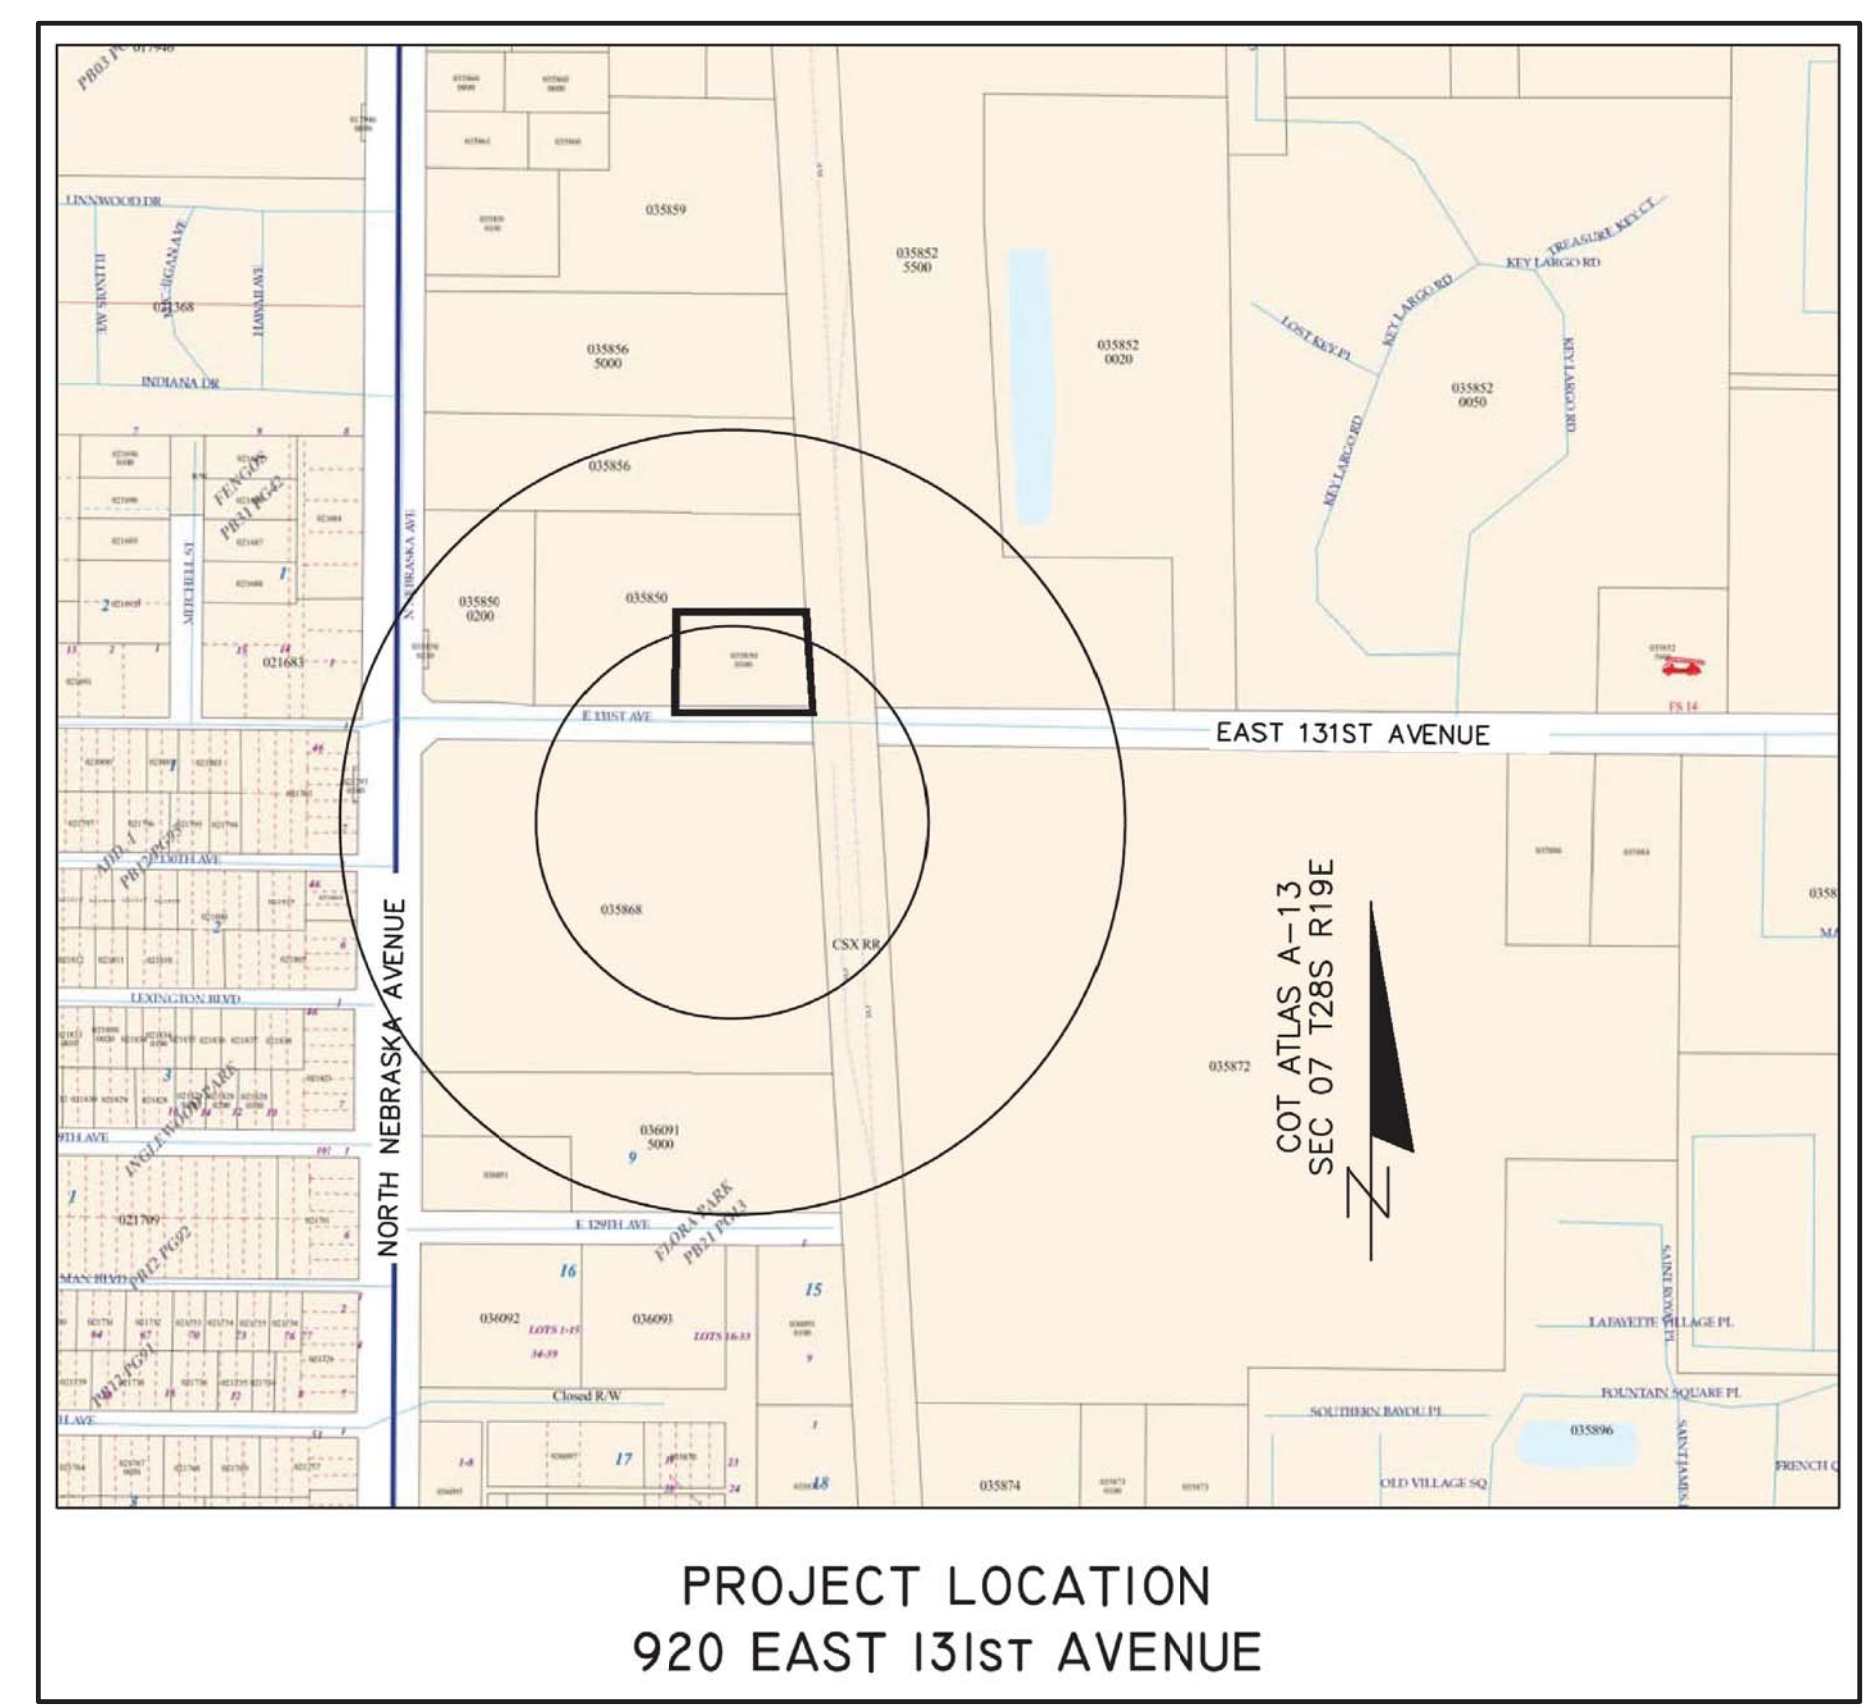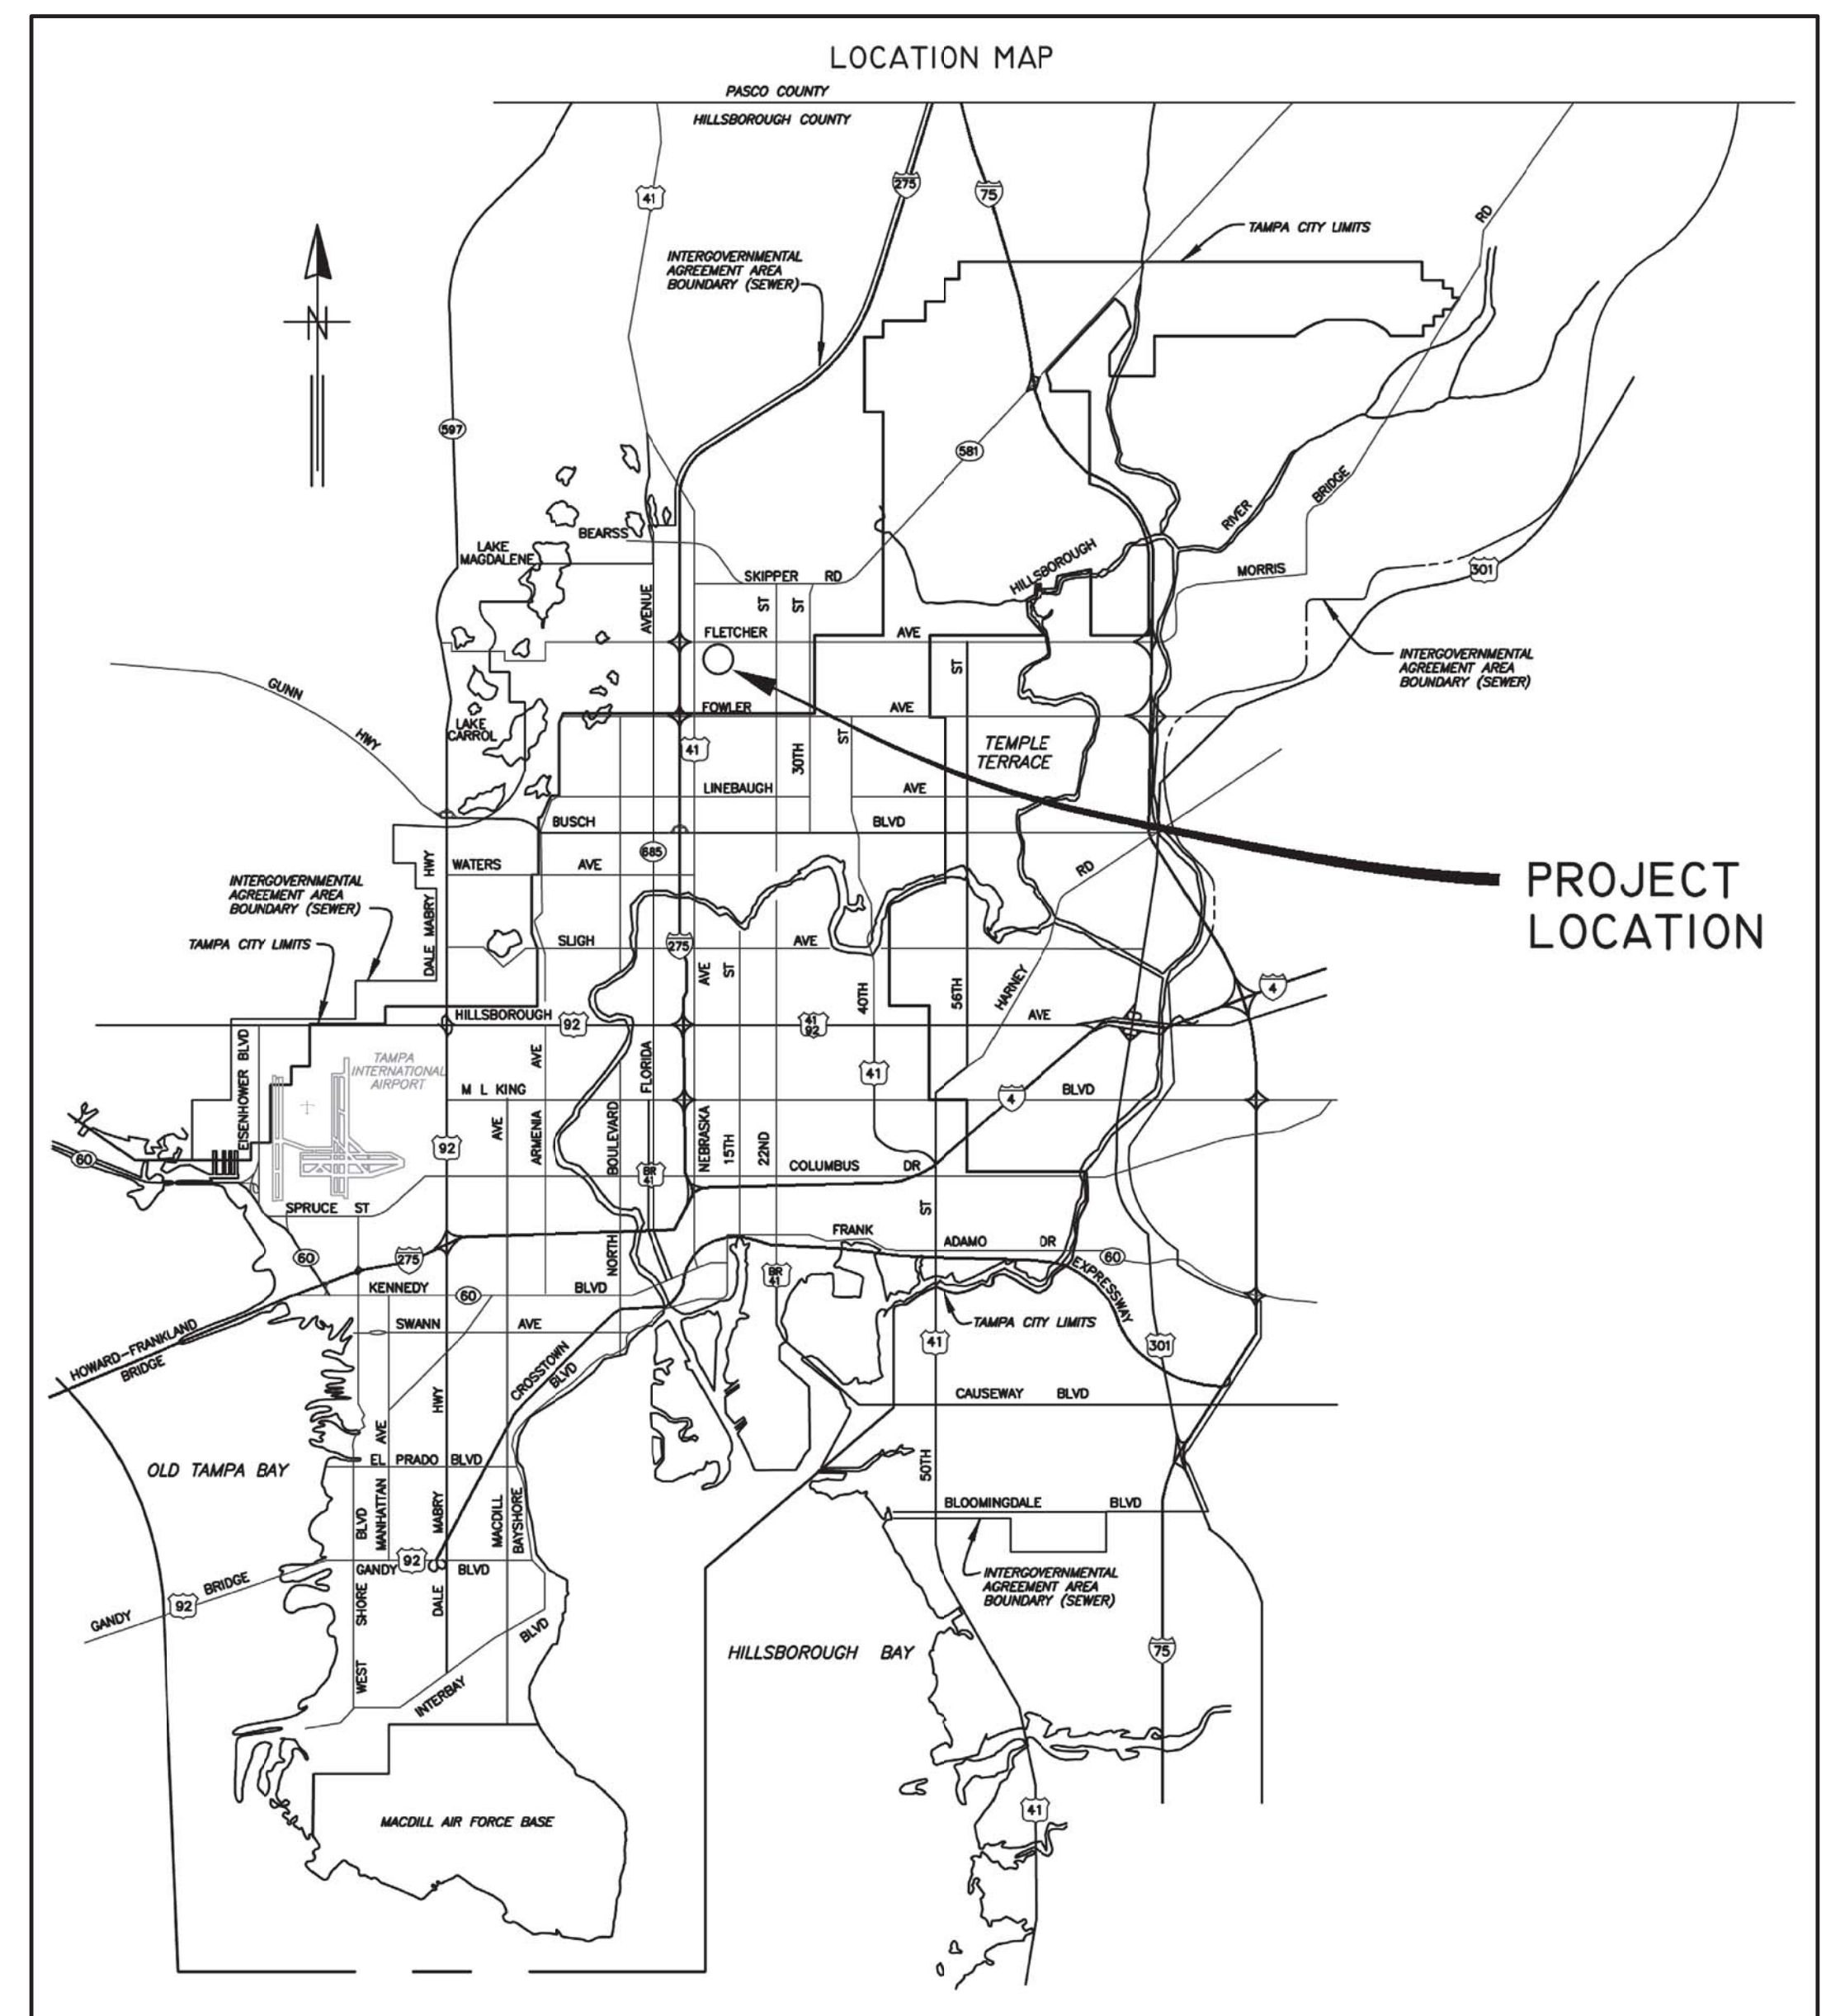

SURVEYOR'S NOTES:

1. THE BASIS OF ELEVATIONS FOR THIS SURVEY IS BASED ON THE PAD ITSELF; HAVING A PERIMETER WALL WITH TOP ELEVATION ASSUMED TO BE 10.00'.
2. FIELD SURVEY WORK WAS PERFORMED ON MARCH 12, 2016 AND IS CONTAINED IN FIELD BOOK #1601, P. 63.
3. THE PURPOSE OF THIS SURVEY IS TO SHOW LOCATIONS OF NEWLY CONSTRUCTED PLATFORM SUPPORT BEAMS AS THEY RELATE TO CONCRETE PLATFORM.
4. USE OF THIS SURVEY BY ANYONE OTHER THAN THOSE PREPARED FOR/CERTIFIED TO, WILL BE THE RE-USERS SOLE RISK WITHOUT LIABILITY TO THE SURVEYOR.

SHEET LIST

- SHEET 1: COVER
SHEET 2: AS-BUILT LOCATIONS FOR
NEWLY CONSTRUCTED SUPPORT BEAMS

AS-BUILT SURVEY

UNIVERSITY PUMP STATION

CITY OF TAMPA

3/25/2016	0	ORIGINAL DRAWING
DATE	NO.	REVISION

FOR THE BENEFIT OF:
LEISURE CONSTRUCTION
1301 SEMINOLE BOULEVARD
LARGO, FLORIDA 33770




EMME Land Surveying, LLC.
1054 KAPP DRIVE, CLEARWATER, FLORIDA 33765-2111
OFFICE (727) 474-3751, FAX (727) 474-3753
STATE OF FLORIDA CERTIFICATE OF AUTHORIZATION LB NO. 7895
email: emmelandsurvey@gmail.com
web: www.emmelandsurveying.com

CERTIFIED AS A BOUNDARY AND TOPOGRAPHIC SURVEY
LAST DAY OF FIELD WORK: 03/12/2016
Elizabeth K. Merta
ELIZABETH KATHLEEN MERTA
FLORIDA PROFESSIONAL SURVEYOR AND MAPPER NO. 6113
UNLESS IT BEARS THE SIGNATURE AND ELECTRONIC SEAL OR ORIGINAL RAISED SEAL OF A FLORIDA LICENSED SURVEYOR AND MAPPER; THIS DRAWING, SKETCH, PLAN OR MAP IS FOR INFORMATIONAL PURPOSES ONLY AND IS NOT VALID.

COVER
UNIVERSITY PUMP STATION

SCALE: 1" = 2'	SHEET 1 OF 2
DRAWN BY: D.M.G.	
CHECKED BY: E.K.M.	
JOB NO. 2015243	

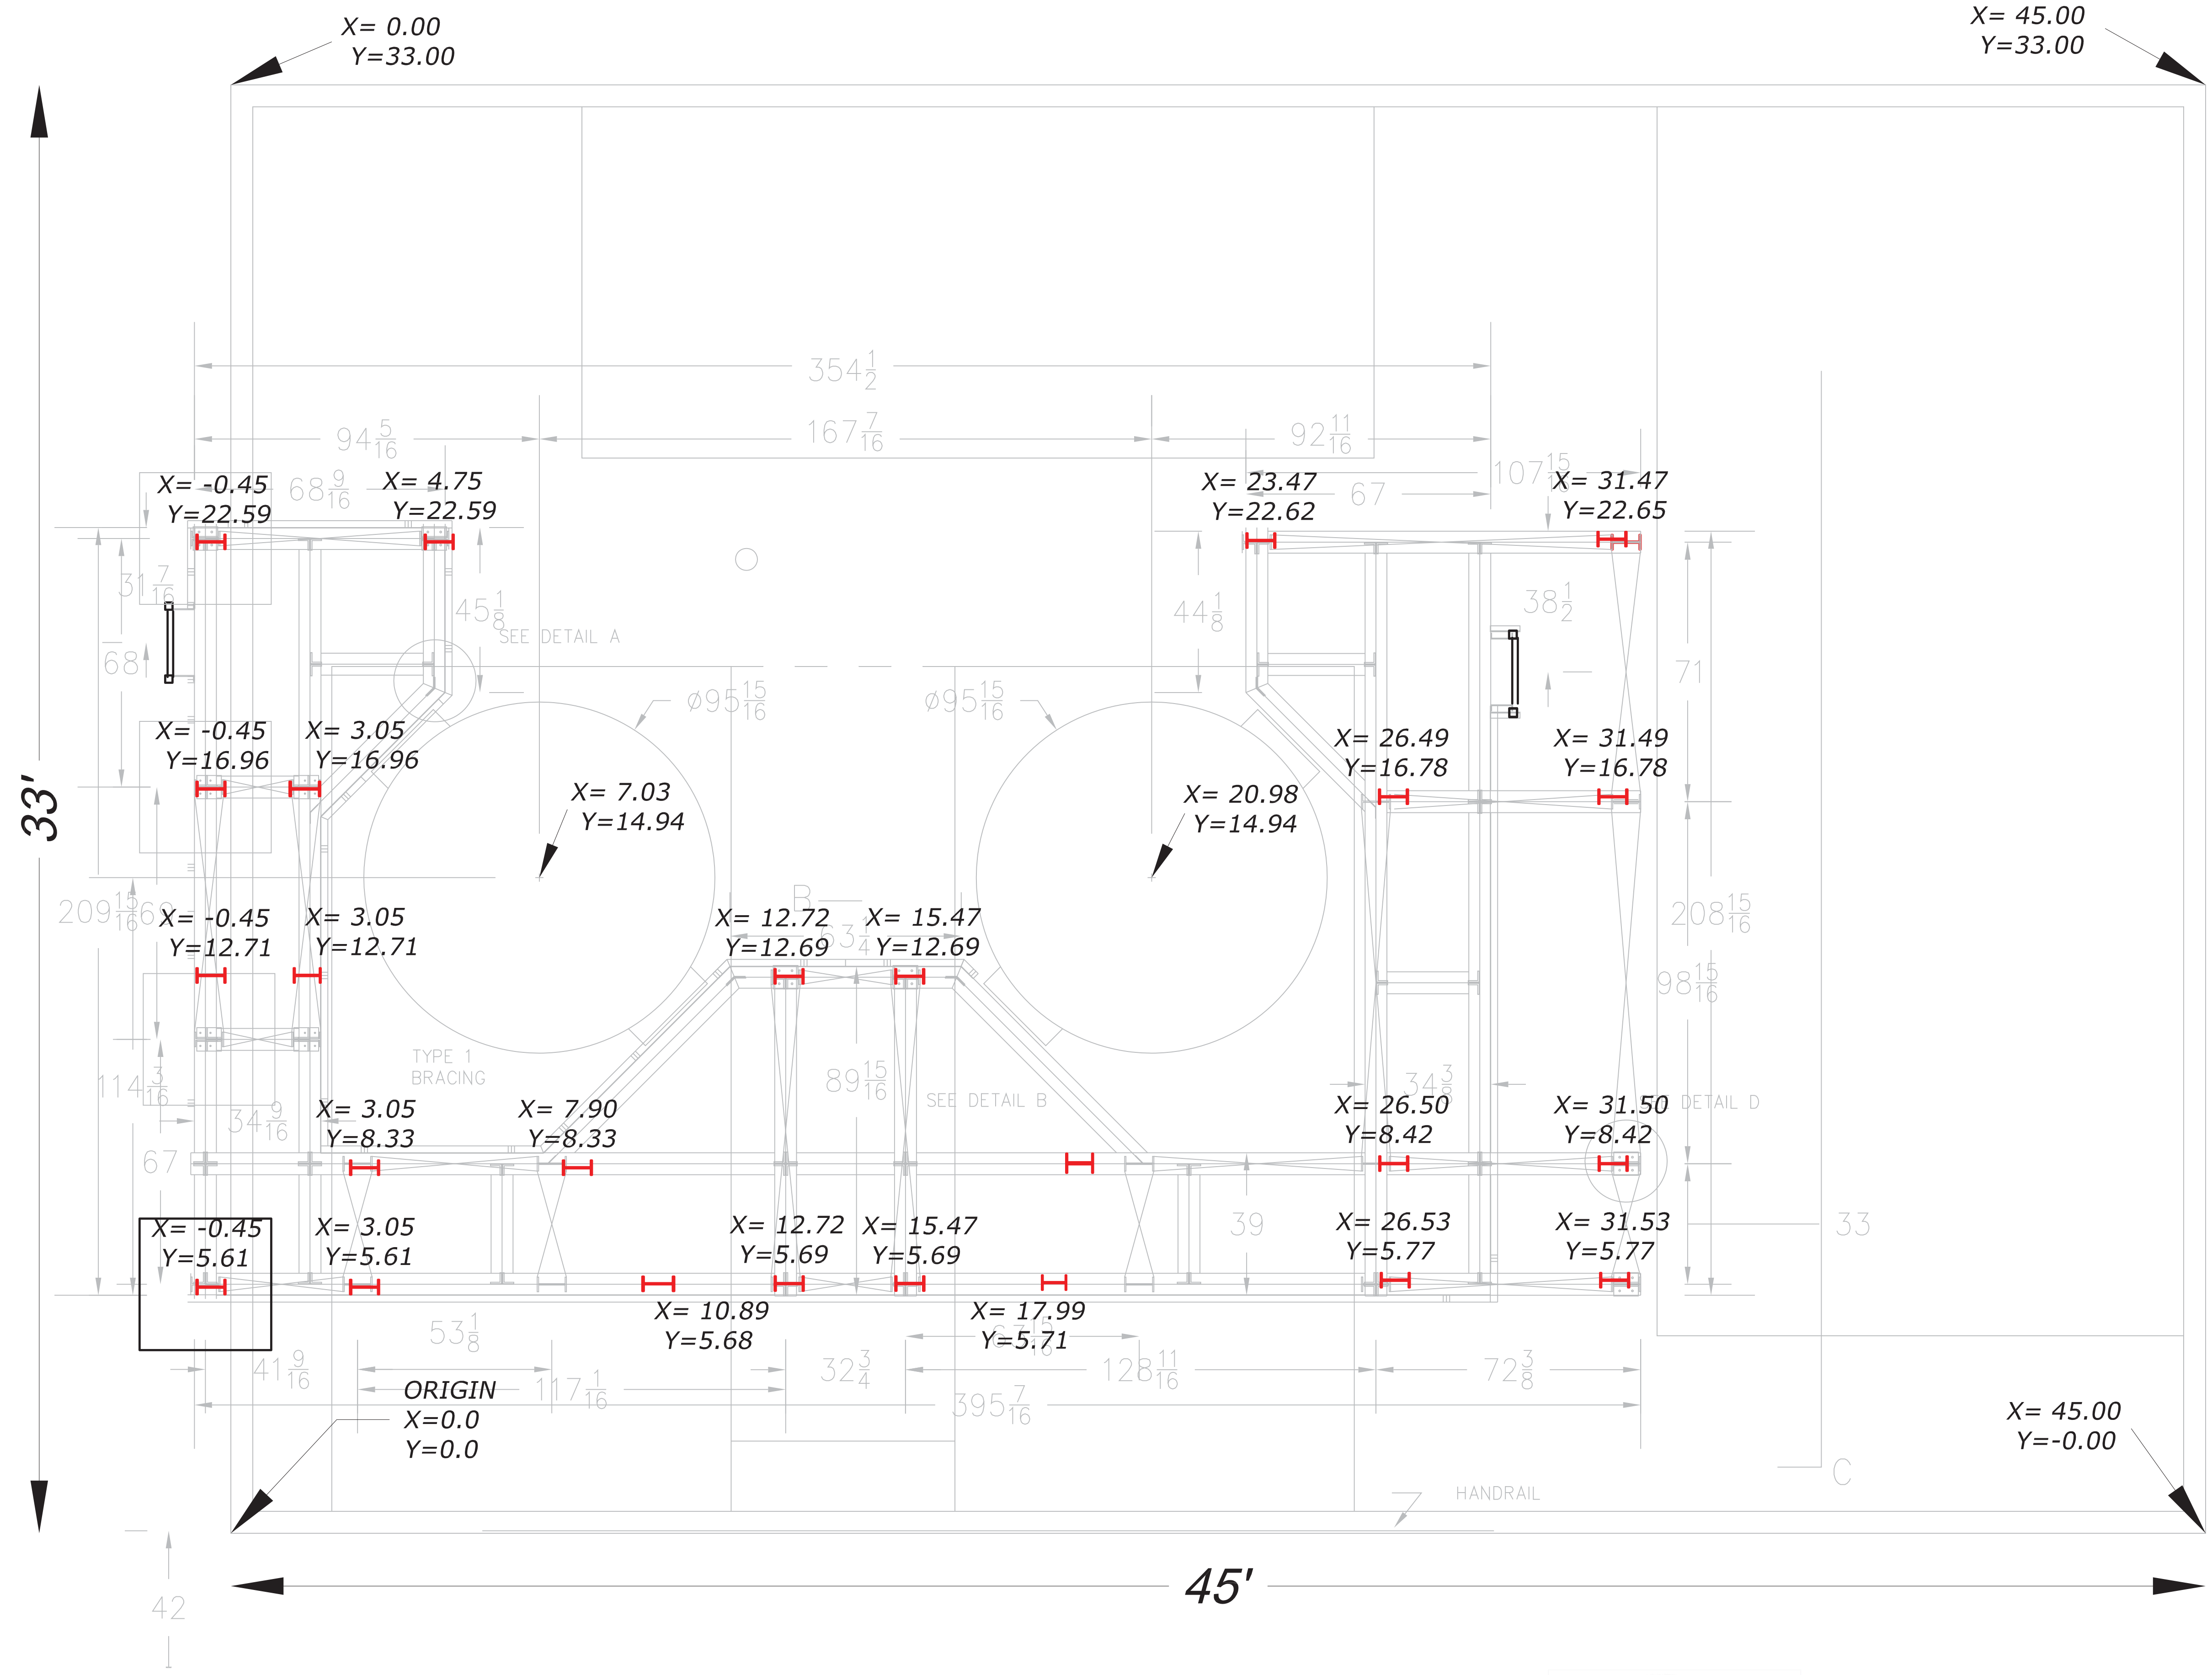

3/25/2016	0	ORIGINAL DRAWING
DATE	NO.	REVISION

FOR THE BENEFIT OF:
LEISURE CONSTRUCTION
 1301 SEMINOLE BOULEVARD
 LARGO, FLORIDA 33770



EMME Land Surveying, LLC.
 1054 KAPP DRIVE, CLEARWATER, FLORIDA 33765-2111
 OFFICE (727) 474-3751, FAX (727) 474-3753
 STATE OF FLORIDA CERTIFICATE OF AUTHORIZATION LB NO. 7895
 email: emmelandsurvey@gmail.com
 web: www.emmelandsurveying.com


CERTIFIED AS A BOUNDARY AND TOPOGRAPHIC SURVEY
 LAST DAY OF FIELD WORK: 06/09/2015

 ELIZABETH KATHLEEN MERTA
 FLORIDA PROFESSIONAL SURVEYOR AND MAPPER NO. 6113
 UNLESS IT BEARS THE SIGNATURE AND ELECTRONIC SEAL OR ORIGINAL RAISED SEAL OF A FLORIDA LICENSED SURVEYOR AND MAPPER, THIS DRAWING, SKETCH, PLAN OR MAP IS FOR INFORMATIONAL PURPOSES ONLY AND IS NOT VALID.

I BEAM SUPPORT LOCATIONS
 UNIVERSITY PUMP STATION

SCALE: 1" = 2'	SHEET 2 OF 2
DRAWN BY: D.G.	
CHECKED BY: E.K.M.	
JOB NO. 2015243	

LOCATION MAP

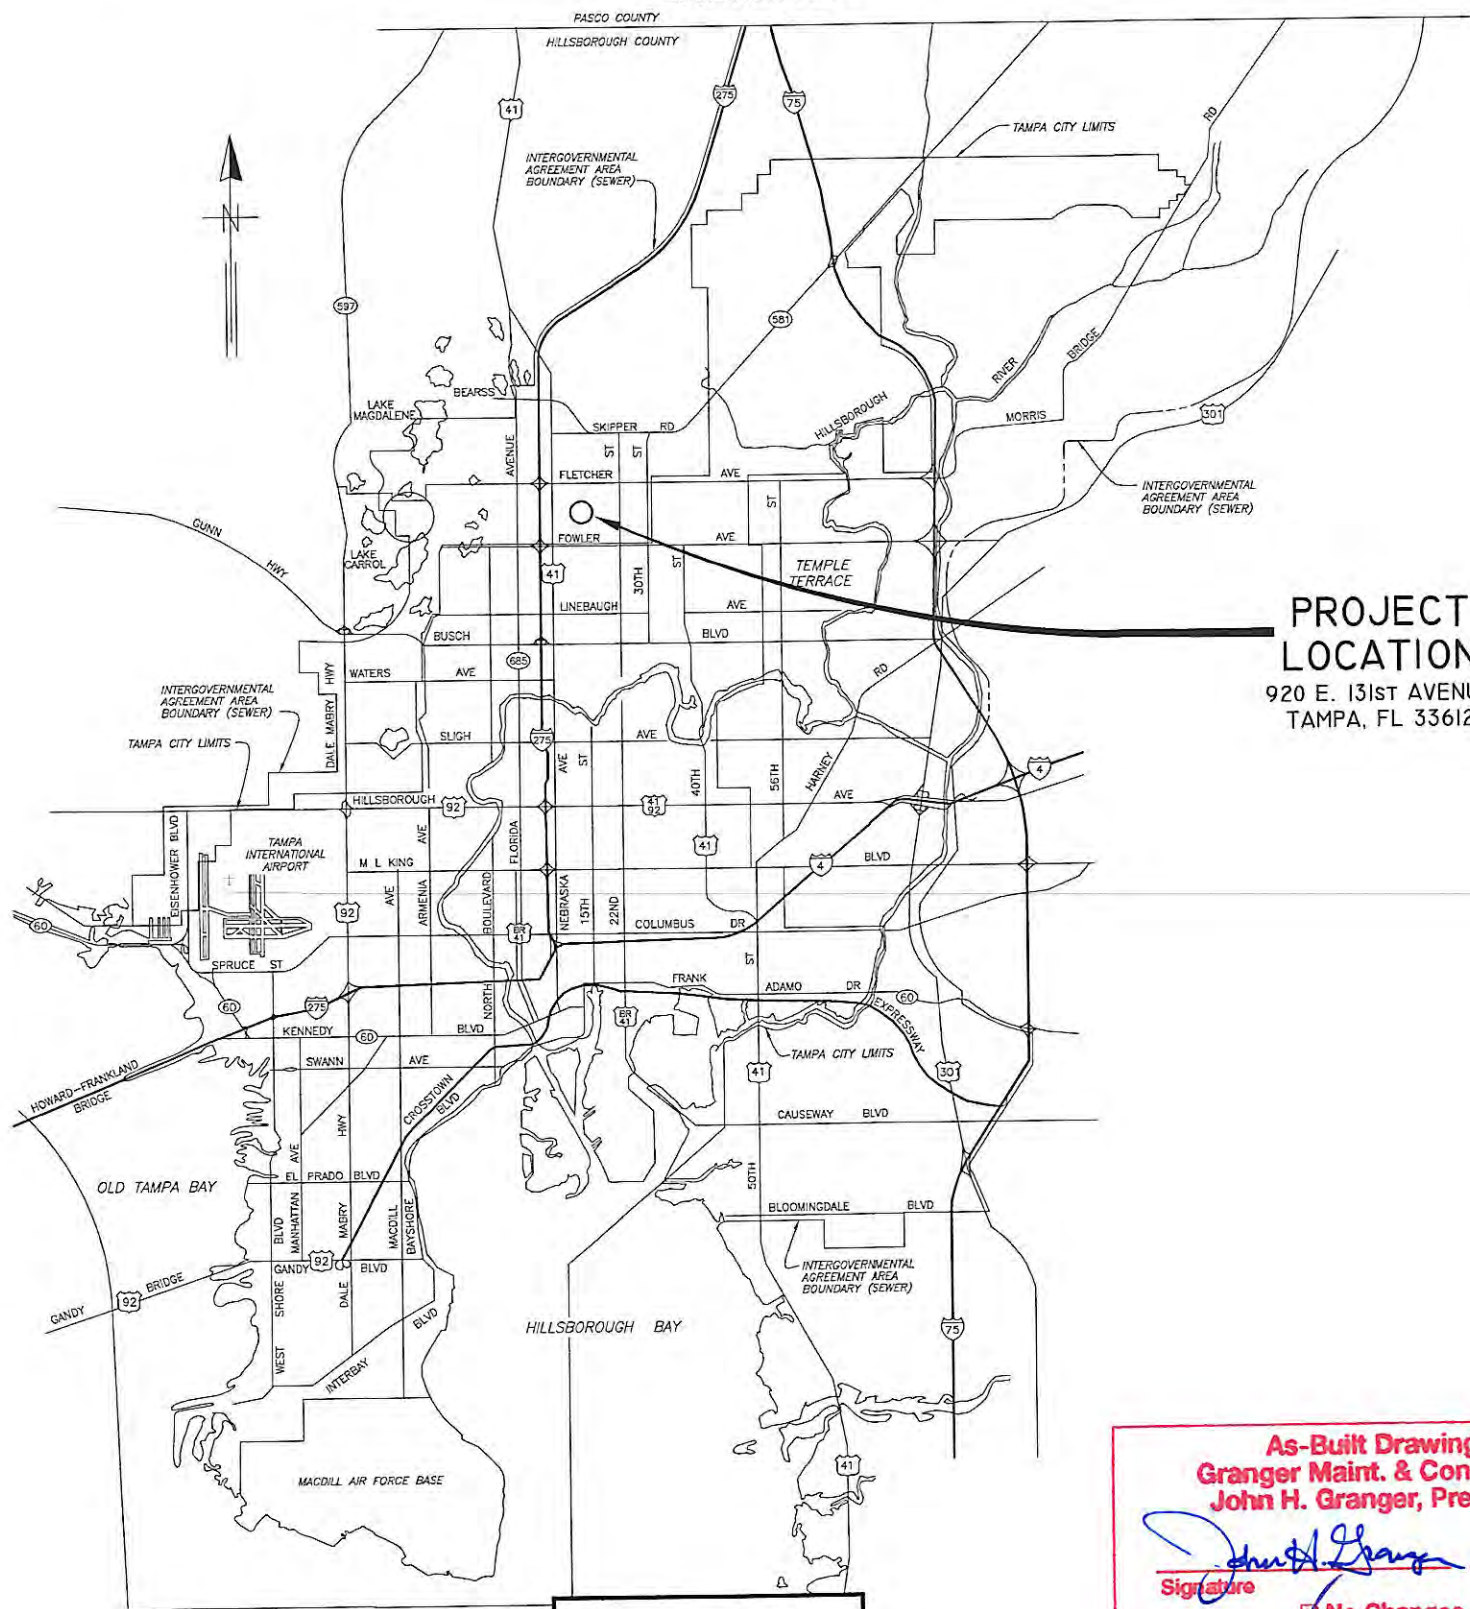

PROJECT LOCATION
 920 E. 131st AVENUE
 TAMPA, FL 33612

CITY of TAMPA



WASTEWATER DEPARTMENT

PLANS FOR

UNIVERSITY PUMPING STATION
 PUMP #1 REPLACEMENT

CONTRACT: 16-C-00019

As-Built Drawings
 Granger Maint. & Constr. Inc.
 John H. Granger, President

John H. Granger 6/22/2022
 Signature Date



No Changes



C:\PROGRAMFILES\AUTOCAD\CIVIL3D2010\DWGFILES\PS\UNIVERSITY.P.S.\4511-SHEET-01.DWG


JACINTO CARLOS FERRAS, P.E. #49454 DESIGN DIVISION HEAD WASTEWATER DEPARTMENT	TIMOTHY D. THOMAS, PE - FPE 47079 TRICON CONSULTING ENGINEERS ELECTRICAL / INSTRUMENTATION DESIGN	No.	DATE	REVISIONS	DES: J.H. DRN: JB CKD: DATE:	CITY of TAMPA WASTEWATER DEPARTMENT	COVER SHEET	SHEET
		3						1
		2						
		1						

K:\WASTEWATERPROJECTS\UNIVERSITYPUMP#1\DESIGN\PLANS\DRAWING\DWG

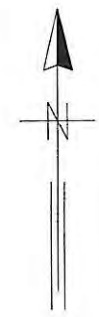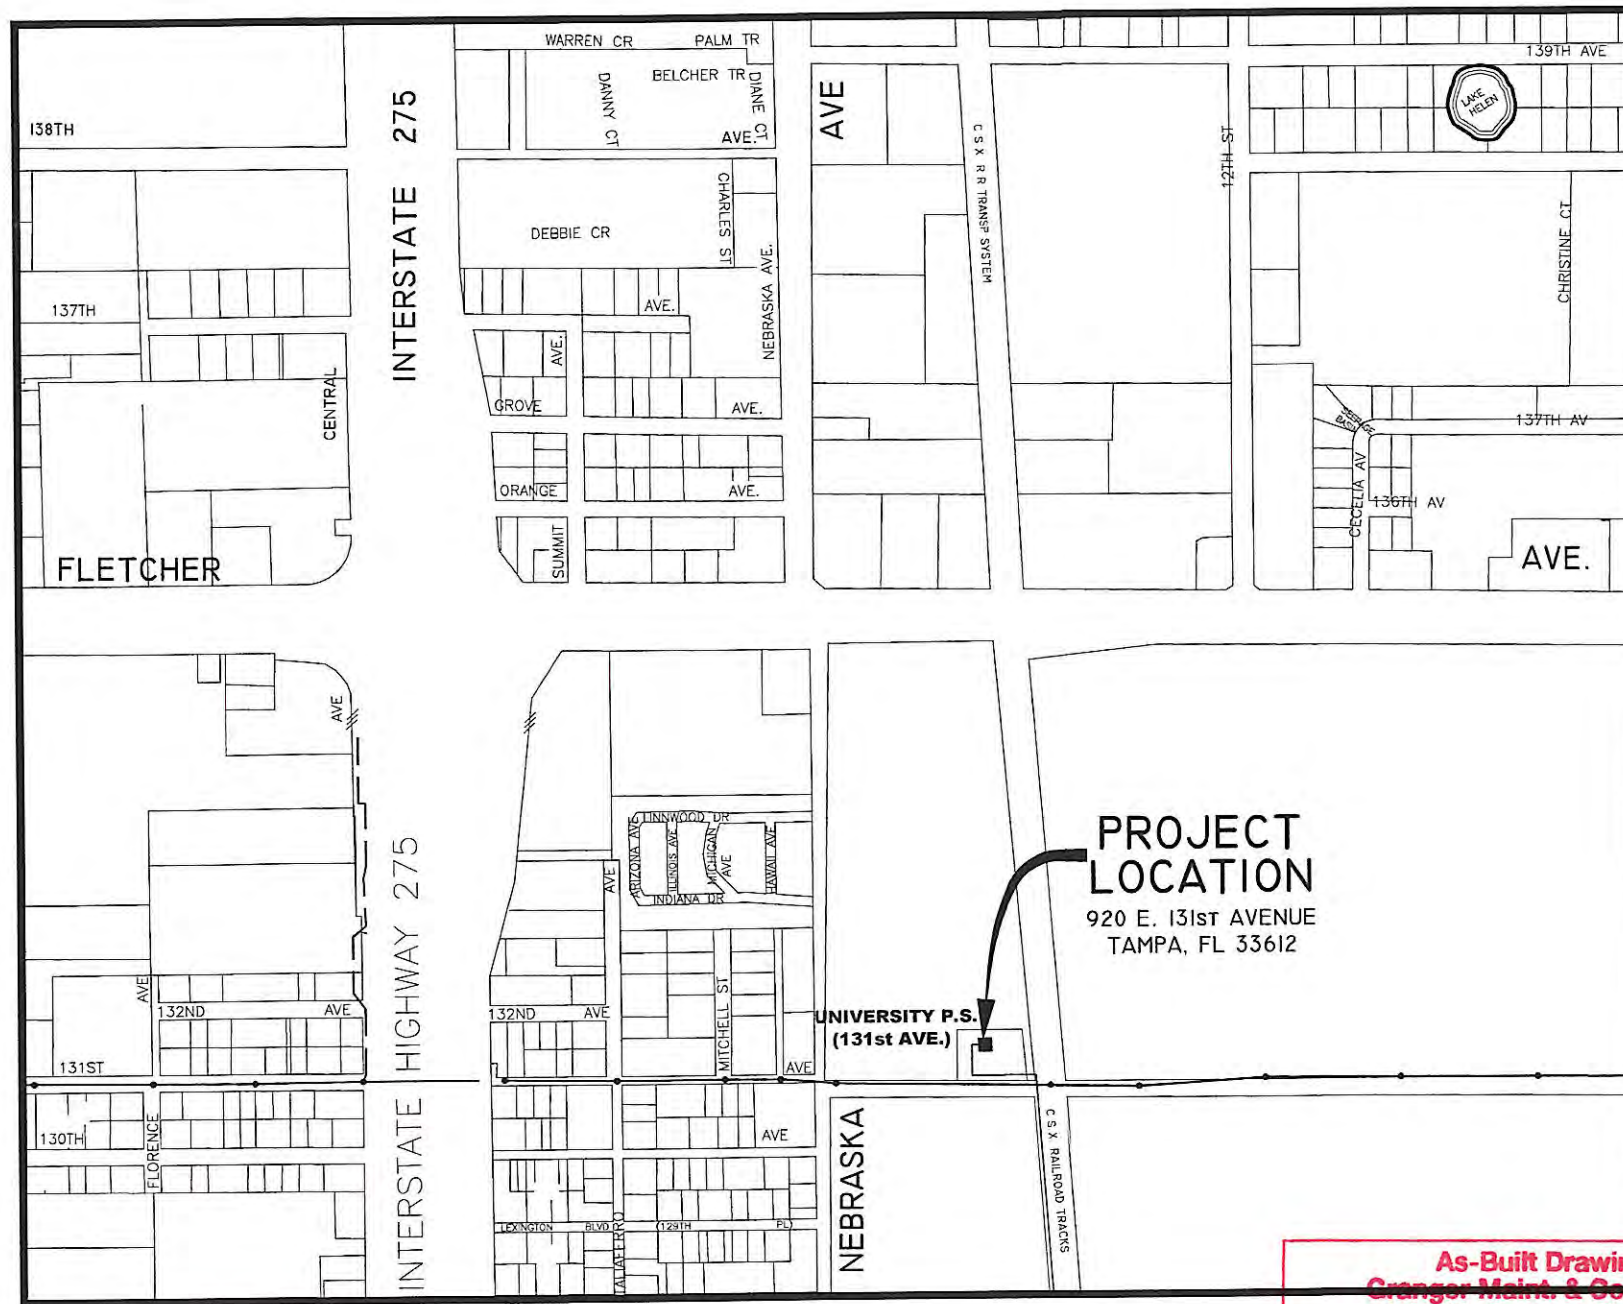


INDEX	
SH. No.	DESCRIPTION
1	COVER SHEET
2	INDEX & PROJECT MAP
3	SITE PLAN
4	GENERAL NOTES
5	DEMOLITION PLAN AT ELEV. 15.00 AND SECTION
6	DEMOLITION SECTION
7	PROPOSED PLAN AT ELEV. 15.00 AND SECTION
8	PROPOSED SECTION
9	MISCELLANEOUS PUMP ROOM DETAILS
10	WET WELL ISOLATION DETAILS
E0	ELECTRICAL - TIMING DIAGRAM, LEGEND & ABBREVIATIONS
E1	ELECTRICAL - ELECTRICAL POWER PLAN - ELEV. 41.25
E2	ELECTRICAL - ELECTRICAL POWER PLAN - ELEV. 15.00
E3	ELECTRICAL - ELECTRICAL POWER SECTION
E4	ELECTRICAL - CONTROL CENTER FRONT ELEVATION
E5	ELECTRICAL - SECTION 3 MODIFICATIONS
E6	ELECTRICAL - LLC AND VFD FRONT ELEVATIONS
E7	ELECTRICAL - ELECTRICAL ONE-LINE DIAGRAM
E8	ELECTRICAL - VFD INTERCONNECTIONS
E9	ELECTRICAL - PUMP No. 1 CONTROL PANEL
E10	ELECTRICAL - PUMP No. 1 CONTROLS (SHEET 1 OF 3)
E11	ELECTRICAL - PUMP No. 1 CONTROLS (SHEET 2 OF 3)
E12	ELECTRICAL - PUMP No. 1 CONTROLS (SHEET 3 OF 3)
E13	ELECTRICAL - PUMP No. 2 CONTROL PANEL
E14	ELECTRICAL - PUMP No. 2 CONTROLS (SHEET 1 OF 2)
E15	ELECTRICAL - PUMP No. 2 CONTROLS (SHEET 2 OF 2)
E16	ELECTRICAL - MOTOR CONTROL CENTER ELEVATION
E17	ELECTRICAL - ANNUNCIATOR PLC DETAILS
E18	ELECTRICAL - ANNUNCIATOR PLC WIRING DIAGRAMS
E19	ELECTRICAL - DISCRETE I/O WIRING DIAGRAMS
E20	ELECTRICAL - PROPOSED ANNUNCIATOR SCREENS
E21	ELECTRICAL - CONDUIT AND CABLE SCHEDULE

PROJECT MAP
NOT TO SCALE

As-Built Drawings
Granger Maint. & Constr. Inc.
John H. Granger, President
 **6/22/2022**
 Signature Date
 No Changes

JACINTO CARLOS FERRAS, P.E. #49454 DESIGN DIVISION HEAD WASTEWATER DEPARTMENT	<table border="1"> <thead> <tr> <th>No.</th> <th>DATE</th> <th>REVISIONS</th> </tr> </thead> <tbody> <tr><td>3</td><td></td><td></td></tr> <tr><td>2</td><td></td><td></td></tr> <tr><td>1</td><td></td><td></td></tr> </tbody> </table>	No.	DATE	REVISIONS	3			2			1			DES: J.H. DRN: BB CKD: DATE:	CITY of TAMPA WASTEWATER DEPARTMENT	UNIVERSITY PUMPING STATION PUMP No. 1 REPLACEMENT INDEX & PROJECT MAP	SHEET 2
No.	DATE	REVISIONS															
3																	
2																	
1																	

User: ss11 Drawing Name: K:\Wastewater Projects\University PS pump #1\Design\Plans\Drafting\DWG\University P.S. - Pump#1-Sheets 3-b-8-8.dwg Layout - Nov 21, 2016 - 2:24pm

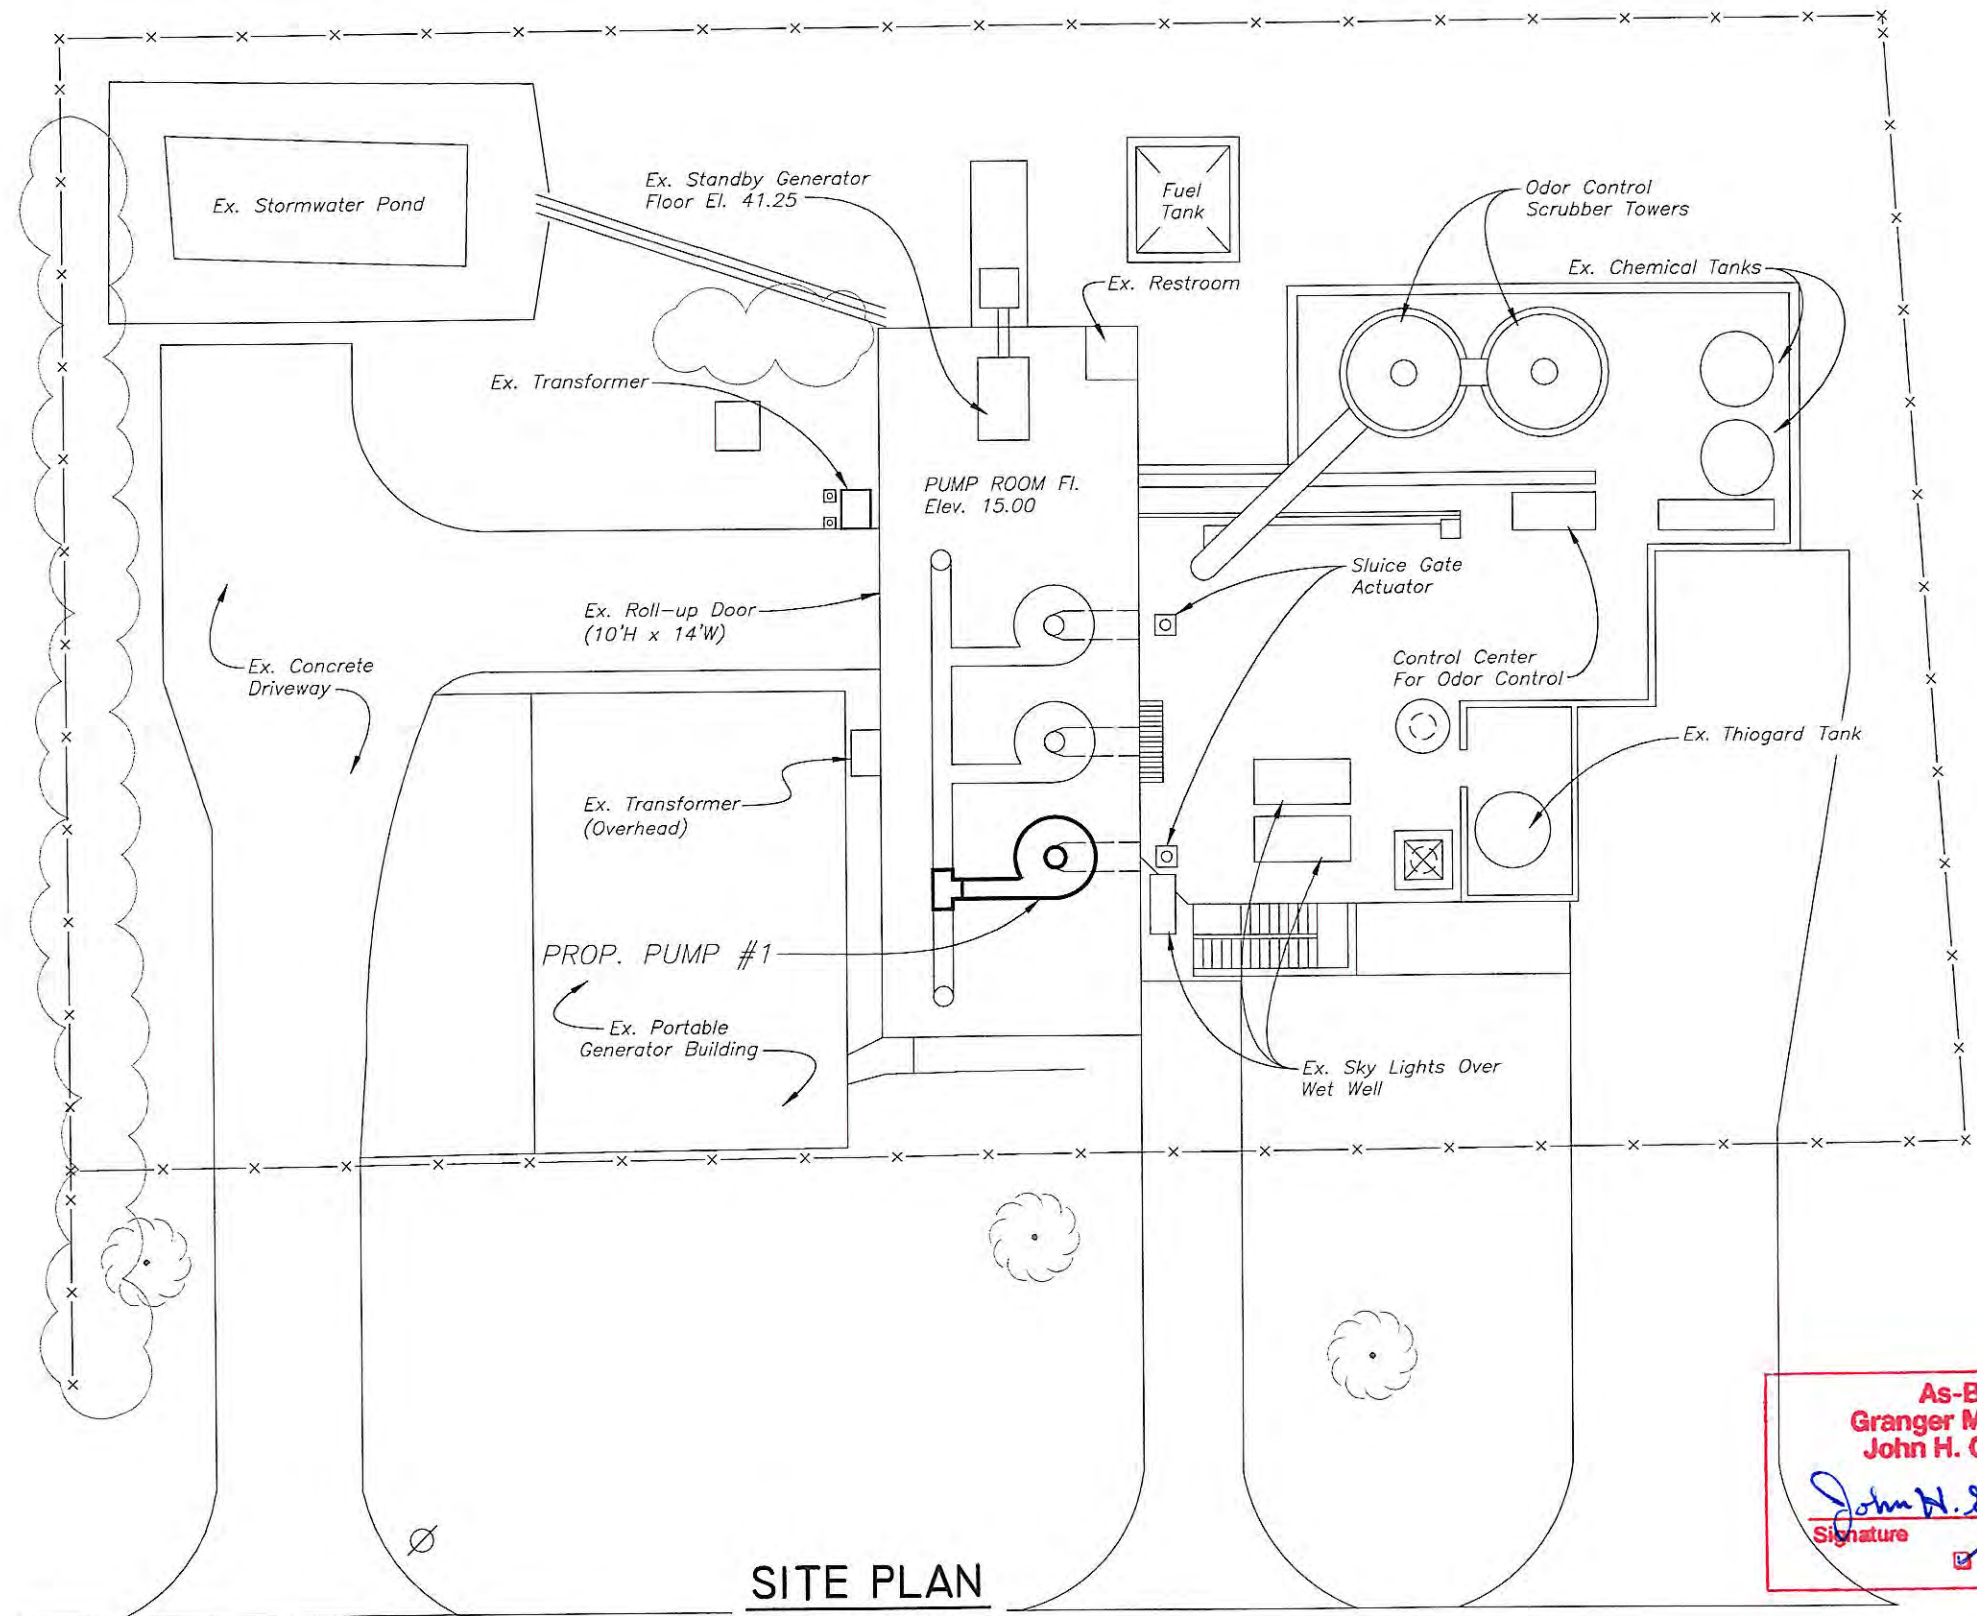

SITE PLAN
NOT TO SCALE

As-Built Drawings
Granger Maint. & Constr. Inc.
John H. Granger, President
John H. Granger 6/22/2022
 Signature Date
 No Changes

JACINTO CARLOS FERRAS, P.E. #49454
 DESIGN DIVISION HEAD
 WASTEWATER DEPARTMENT

No.	DATE	REVISIONS
3		
2		
1		

DES: J.H.
 DRN: BB
 CKD:
 DATE:

CITY of TAMPA
 WASTEWATER DEPARTMENT

UNIVERSITY PUMPING STATION
PUMP #1 REPLACEMENT
SITE PLAN

SHEET
3

NOTES

GENERAL NOTES

- G-1. CONTRACTOR SHALL COORDINATE ALL CONSTRUCTION ACTIVITIES WITH DEPARTMENT PERSONNEL AND PUMPING STATION OPERATIONS.
- G-2. EXISTING DIMENSIONS AND ELEVATIONS ARE BASED ON THE BEST INFORMATION AVAILABLE. TRUE DIMENSIONS AND ELEVATIONS SHALL BE DETERMINED IN THE FIELD PRIOR TO LAYOUT AND SHOP DRAWING SUBMITTALS.
- G-3. ALL SUBMITTALS AND SHOP DRAWINGS SHALL BE ORIGINALS OR HIGH QUALITY COPIES (EASILY READABLE). NO FAXED SHEETS OR POOR QUALITY COPIES WILL BE ACCEPTED FOR SUBMITTAL REVIEW.
- G-4. PRIOR TO PUMP #1 DEMOLITION, CITY FORCES WILL CLOSE THE NECESSARY PLUG VALVES INSIDE THE PUMPING STATION TO ISOLATE THE DISCHARGE SIDE OF PUMP #1. THE CITY REQUIRES A MIN. 1 WEEK ADVANCE NOTICE FOR THIS WORK.
- G-5. CONTRACTOR SHALL INSTALL TWO STOP LOGS AND A 42" INFLATABLE PLUG IN WET WELL IN ORDER TO ISOLATE SUCTION SIDE OF PUMP #1. SEE WET WELL DETAILS ON SHEET 10.
- G-6. MECHANICAL AND ELECTRICAL EQUIPMENT TO BE LOCKED OUT SHALL BE LOCKED OUT WITH A MULTIPLE-LOCK MASTER LOCK-OUT DEVICE, WHICH SHALL BE INSTALLED BY CITY PERSONNEL AND LOCKED BY BOTH THE CITY PERSONNEL AND THE CONTRACTOR.
- G-7. THE CONTRACTOR IS RESPONSIBLE FOR PROVIDING, INSTALLING, LEVELING AND ALIGNING MOTOR AND PUMP. PROCEDURES FOR INSTALLATION, AS OUTLINED IN THE HYDRAULIC INSTITUTE STANDARDS, MOST CURRENT EDITION, SHALL BE ADHERED TO. SEE SPECIFIC PROVISION SP-80. IF CONFLICT BETWEEN THE SPECS AND THE H.I.S. PROCEDURE ARISE, THE MOST STRINGENT STANDARD SHALL BE FOLLOWED.
- G-8. PROPOSED PUMP SHALL BE A 400 HORSEPOWER, 24-INCH, 600 RPM FAIRBANKS MORSE VERTICAL CLOSE-COUPLED ANGLEFLOW PUMP MODEL #C5741. PUMP SHALL BE RATED FOR 29.3 MGD @ 62.0 FEET TDH. SEE SPECIFICATIONS FOR MOTOR INFORMATION.
- G-9. PROPOSED KNIFE GATE VALVE SHALL BE A MODEL 145, "PERFORMANCE PLUS" KNIFE GATE, AS MADE BY TYCO VALVE AND CONTROLS; SEE SPECIFICATIONS FOR DETAILS. KNIFE GATE VALVE SHALL BE EQUIPPED WITH ELECTRIC POWERED ACTUATOR, AS MADE BY ROTORK, LIMITORQUE, OR EQUAL; SEE SPECIFICATIONS FOR DETAILS.
- G-10. EXISTING 30" PUMP CHECK VALVE AND PNEUMATIC ACTUATOR SHALL BE REMOVED AND PLACED IN SAFE STORAGE DURING DEMOLITION ACTIVITIES. PUMP CHECK VALVE ASSEMBLY SHALL BE RE-INSTALLED IN NEW LOCATION WITH PROPOSED PUMP #1, PIPE AND FITTINGS. CONTRACTOR SHALL BE RESPONSIBLE FOR RE-CONNECTING PUMP CHECK VALVE ACTUATOR TO PNEUMATIC AIR SUPPLY, POWER AND CONTROLS SOURCES. SEE ELECTRICAL SHEETS FOR DETAILS.
- G-11. AIR SUPPLY FOR PNEUMATICALLY ACTUATED PUMP-CHECK VALVE SHALL BE FROM EXISTING STATION AIR. ARRANGEMENT OF PIPING AND CONNECTIONS TO EXISTING PIPES SHALL BE MADE BY THE CONTRACTOR UNDER THE DIRECTION OF THE ENGINEER.
- G-12. ANCHOR BOLTS SHALL BE AS PER PUMP MANUFACTURER'S RECOMMENDATIONS. ANCHOR BOLTS SHALL BE DOUBLE-NUTTED AND FINISHED WITH NON-SHRINK GROUT. ALL BOLTS SHALL EXTEND BEYOND THE FASTENING NUTS BY A MINIMUM OF 1/2-INCH.


- G-13. ALL HARDWARE, UNLESS OTHERWISE NOTED, SHALL BE TYPE 316 STAINLESS STEEL.
- G-14. PROP. 30"x 30"x 24" REDUCING TEE SHALL BE FABRICATED TO SUIT THE DIMENSIONS OF THE PROPOSED EQUIPMENT AND SHALL BE A36-STEEL WITH A 150 PSI RATING. STEEL FITTINGS SHALL BE MANUFACTURED BY AN AWWA CERTIFIED FABRICATOR.
- G-15. ALL CEMENTITIOUS CONCRETE AND GROUT, UNLESS OTHERWISE SPECIFIED, SHALL BE CLASS "B" 4000 PSI COMPRESSIVE STRENGTH AT 28 DAYS.
- G-16. EXPOSED CONCRETE CORNERS SHALL HAVE A 3/4" CHAMFER AND RE-ENTRANT CORNERS SHALL HAVE A 3/4" FLAT FILLET UNLESS OTHERWISE NOTED.
- G-17. CONCRETE PEDESTAL SHOP DRAWINGS INCLUDING FLANGE SUPPORT DETAILS SHALL BE SUBMITTED FOR APPROVAL.
- G-18. ALL STEEL REINFORCING SHALL BE DETAILED ACCORDING TO THE LATEST "ACI MANUAL OF STANDARD PRACTICE FOR DETAILING REINFORCED CONCRETE STRUCTURES". ACTUAL PLACEMENT OF STEEL REINFORCING SHALL BE SHOWN ON SHOP DRAWINGS. ALL LAPS AND SPLICES SHALL BE AT LEAST 32 BAR DIAMETERS OR 24 INCHES.
- G-19. CERTAIN PORTIONS OF THIS PROJECT MAY REQUIRE NIGHT TIME WORK.
- G-20. ALL NOTES PERTAINING TO PROPOSED WORK INSIDE SCREEN ROOM ARE LOCATED ON PERTINENT SHEETS.
- G-21. PROP. FLOW METER SHALL BE A 24" ABB ELECTROMAGNETIC FLOW METER, WATERMASTER SERIES, AS MADE BY ABB. SEE SPECIFICATIONS FOR DETAILS.
- G-22. ALL DUCTILE IRON PIPE AND FITTINGS SHALL BE LINED WITH PROTECTO 401 CERAMIC EPOXY (40 MILS DFT), OR EQUAL. ALL STEEL PIPE AND FITTINGS SHALL BE LINED WITH 40 MILS (DFT) OF "SG-14" GLASS LINING (PORCELAIN ENAMEL), AS MADE BY U.S. PIPE, OR EQUAL.
- G-23. THE PUMPING STATION SHALL REMAIN IN OPERATION DURING THE ENTIRE PUMP No.1 REPLACEMENT PROJECT. THE CONTRACTOR SHALL PLAN HIS WORK ACCORDINGLY.
- G-24. ALL WORK SHALL BE PERFORMED IN ACCORDANCE WITH THE FLORIDA BUILDING CODE 5th EDITION 2014, AND CHAPTER 5 OF THE CITY OF TAMPA CODE.
- G-25. CONTRACTOR SHALL REMOVE EX. WET WELL #1 (42") SLUICE GATE AND ENTIRE ELECTRIC ACTUATOR ASSEMBLY.
- G-26. CONFIGURATION FOR THREE PROPOSED KNIFE GATE VALVE ACTUATORS SHALL BE AS INDICATED IN THE PLANS.
- G-27. ALL ELECTRICAL WORK SHALL BE PERFORMED IN ACCORDANCE WITH THE FLORIDA BUILDING CODE 5th EDITION 2014, CHAPTER 5 OF THE CITY OF TAMPA CODE AND THE NATIONAL FIRE PROTECTION ASSOCIATION (NFPA) SERIES 70, NATIONAL ELECTRICAL CODE (NEC) 2011 EDITION.

DEMOLITION NOTES

- D-1. ALL DIMENSIONS ARE APPROXIMATE. TRUE DIMENSIONS SHALL BE DETERMINED IN THE FIELD.
- D-2. SALVAGEABLE MATERIAL, AS DETERMINED BY DEPARTMENT PERSONNEL, SHALL BE DELIVERED TO THE CITY OF TAMPA'S HOWARD F. CURREN AWTP AT 2700 MARITIME BOULEVARD. NON-SALVAGEABLE MATERIALS ARE TO BE REMOVED FROM THE SITE AND PROPERLY DISPOSED OF AT THE CONTRACTOR'S EXPENSE. IN GENERAL, ALL PUMP AND CONTROLS EQUIPMENT SHALL REMAIN PROPERTY OF THE CITY AND SHALL BE DELIVERED TO THE TREATMENT PLANT.
- D-3. ALL ALUMINUM FRAMES AND PLATFORMS ON PUMP #1 SHALL BE SALVAGED AND DELIVERED TO THE TREATMENT PLANT.
- D-4. THE PUMP STATION SITE SHALL BE MAINTAINED IN AS NEAT AND ORDERLY CONDITION AS POSSIBLE DURING CONSTRUCTION OPERATIONS. WALKWAYS AND DRIVEWAYS SHALL BE KEPT CLEAR FOR DEPARTMENT PERSONNEL TO PASS THROUGH.
- D-5. CONTRACTOR SHALL CUT ALL EXPOSED REINFORCING STEEL TO A DEPTH OF 1-INCH BELOW THE EXPOSED SURFACE AND GROUT OVER.
- D-6. CONTRACTOR SHALL SUBMIT A PLAN FOR APPROVAL THAT WILL PREVENT THE EXPANSION JOINTS IN THE 30"-36" DISCHARGE HEADER FROM EXPANDING AFTER THE EXISTING 30"x 30"x 36' TEE HAS BEEN REMOVED IN THE PUMP ROOM.



"POSSIBLE" CONSTRUCTION SEQUENCE

- S-1. CITY FORCES CLOSE EX. 30" & 24" PLUG VALVES IN PUMP ROOM TO ISOLATE DISCHARGE SIDE OF PUMP #1. CONTRACTOR TO INSTALL STOP LOGS AND 42" PLUG IN SCREEN ROOM TO ISOLATE SUCTION SIDE OF PUMP #1.
- S-2. PROCEED WITH DEMOLITION AND INSTALL 24" KNIFE GATE VALVE AS SOON AS POSSIBLE.
- S-3. INSTALL PROPOSED PUMP #1, PUMP CHECK VALVE, FLOW METER, PIPE AND FITTINGS (INCLUDING ELECTRICAL WORK).
- S-4. PERFORM REQUIRED TESTS ON PROPOSED PUMPING EQUIPMENT.
- S-5. PERFORM TRAINING, COMPLETE PUNCH LIST ITEMS.

As-Built Drawings
Granger Maint. & Constr. Inc.
John H. Granger, President

 Signature Date 6/22/2022
 No Changes

User: ss11 Drawing Name: K:\wastewater_projects\university_rs_pump #1\Design\plans\urating\urating\university_rs_pump #1-sheet 4.dwg
 Layout: Nov 22, 2016 9:56am

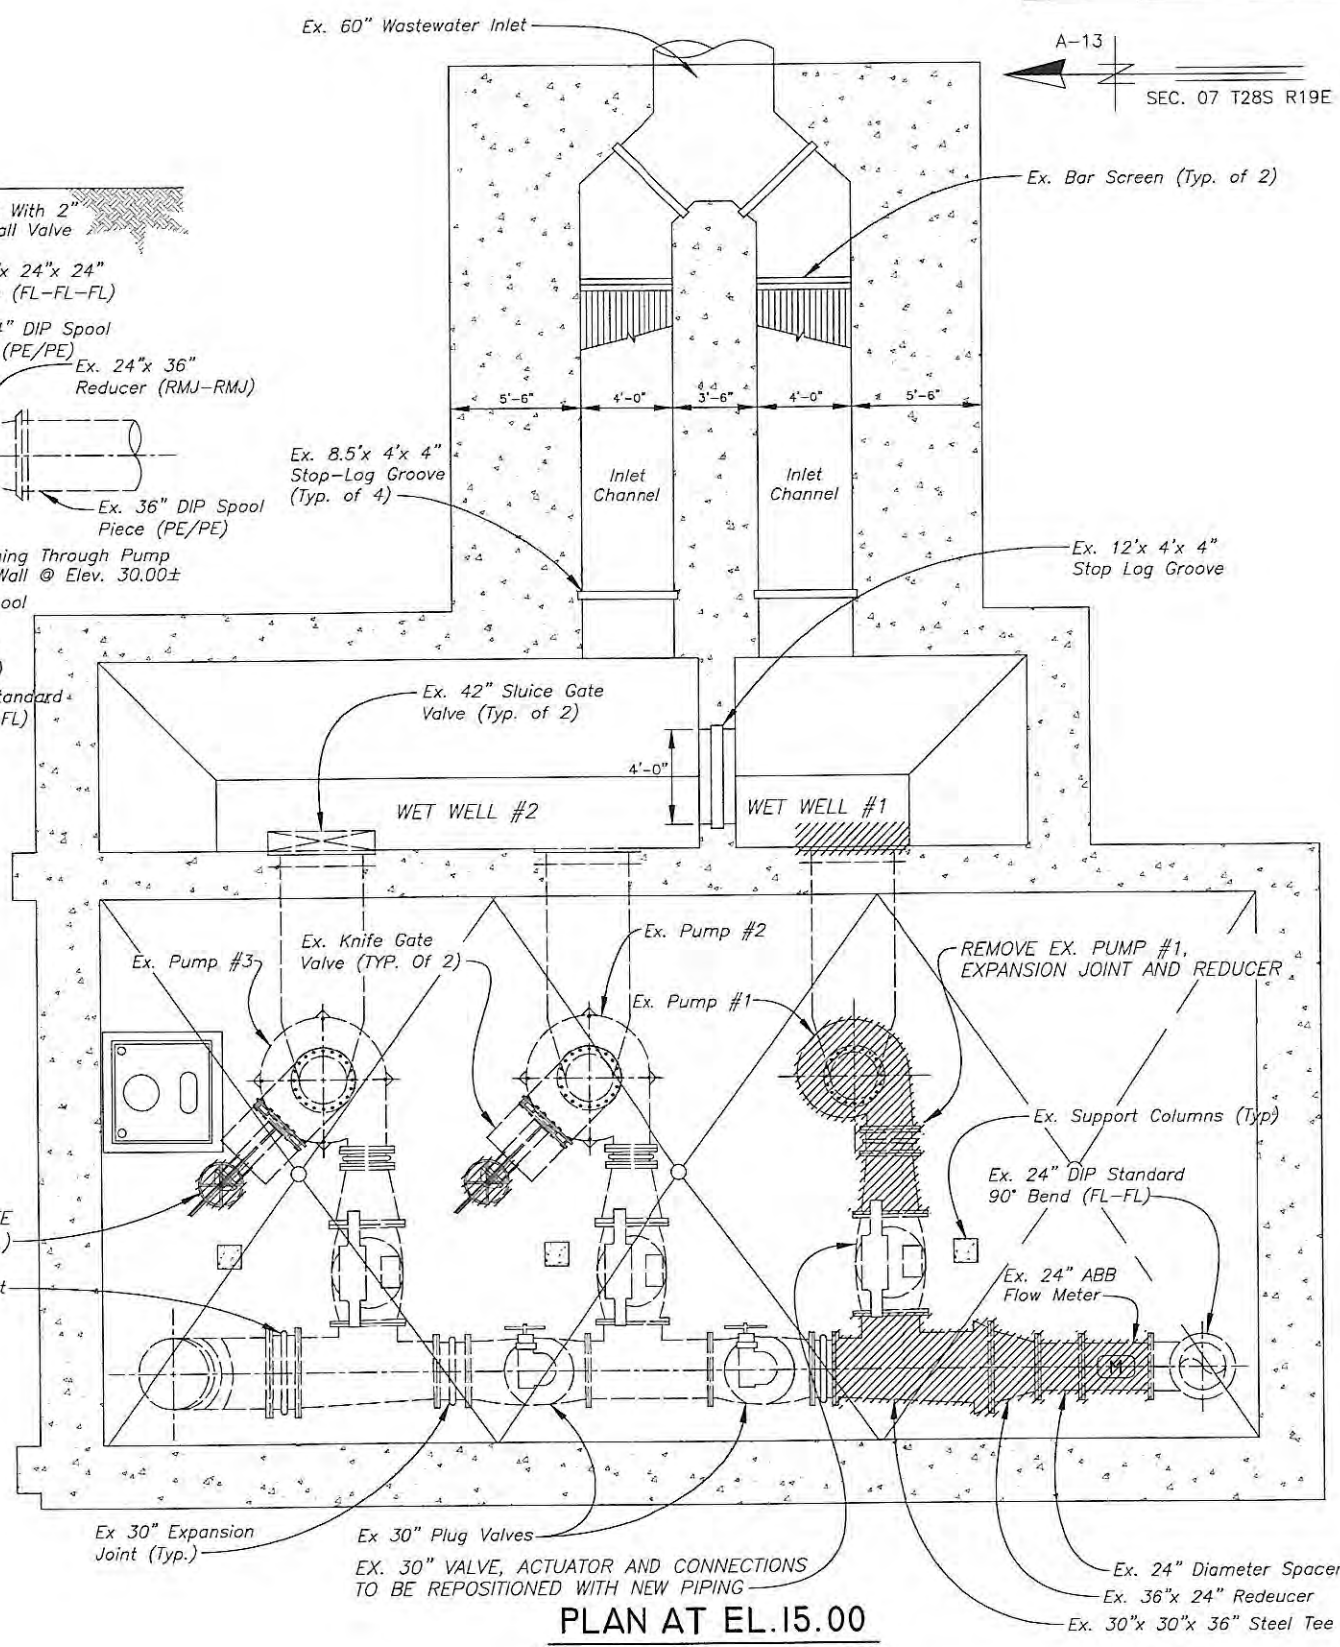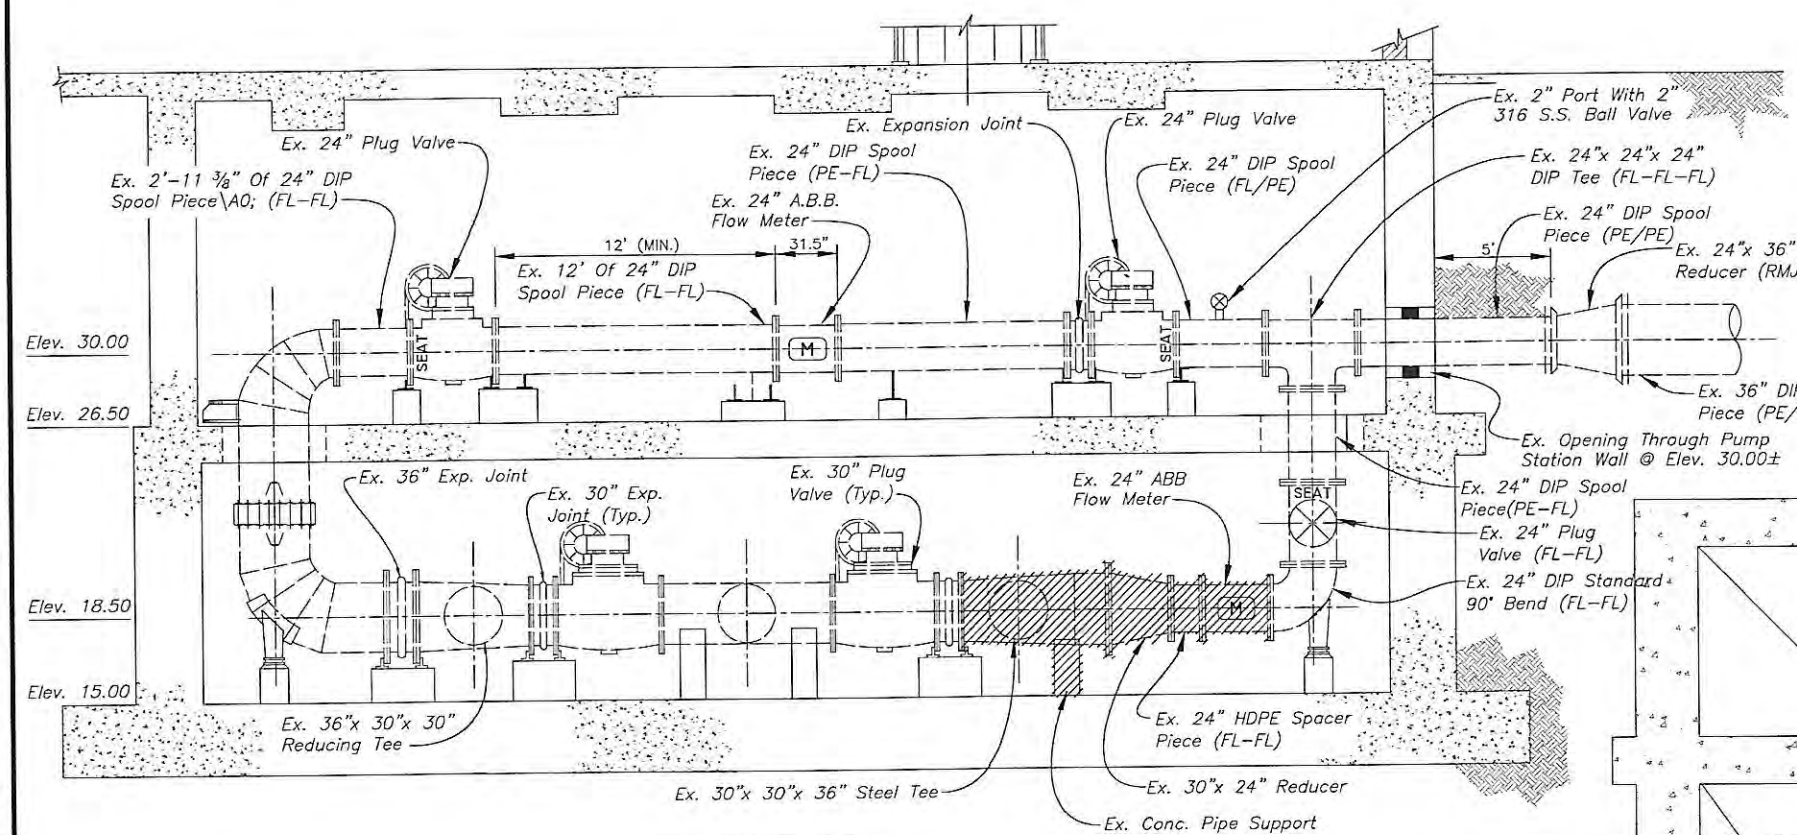JACINTO CARLOS FERRAS, P.E. #49454 DESIGN DIVISION HEAD WASTEWATER DEPARTMENT	No. DATE REVISIONS 3 2 1	DES: J.H. DRN: BB CKD: DATE:	CITY of TAMPA WASTEWATER DEPARTMENT	UNIVERSITY PUMPING STATION PUMP #1 REPLACEMENT GENERAL NOTES	SHEET 4
---	-----------------------------------	---------------------------------------	--	--	-------------------



As-Built Drawings
Granger Maint. & Constr. Inc.
John H. Granger, President

John H. Granger 6/22/2022
Signature Date

No Changes

ITEMS SHOWN AS HATCHED ARE TO BE DEMOLISHED AND REMOVED

JACINTO CARLOS FERRAS, P.E. #49454
 DESIGN DIVISION HEAD
 WASTEWATER DEPARTMENT
 Nov 21, 2016 - 2:24pm




JACINTO CARLOS FERRAS, P.E. #49454 DESIGN DIVISION HEAD WASTEWATER DEPARTMENT	No.	DATE	REVISIONS	DES: J.H.	CITY of TAMPA WASTEWATER DEPARTMENT	UNIVERSITY PUMPING STATION PUMP #1 REPLACEMENT DEMOLITION PLAN AND SECTION	SHEET
	3			DRN: BB			5
	2			CKD:			
	1			DATE:			

User: ss11 Drawing Name: K:\Wastewater Projects\University P5 pump\DWG\Design\Plans\Drafting\UNG\University P5 - Pump#1 - Sheets J-6-B-Dwg Layout - Nov 21, 2016 2:24pm

As-Built Drawings
Granger Maint. & Constr. Inc.
John H. Granger, President

John H. Granger 6/22/2022
 Signature Date

No Changes

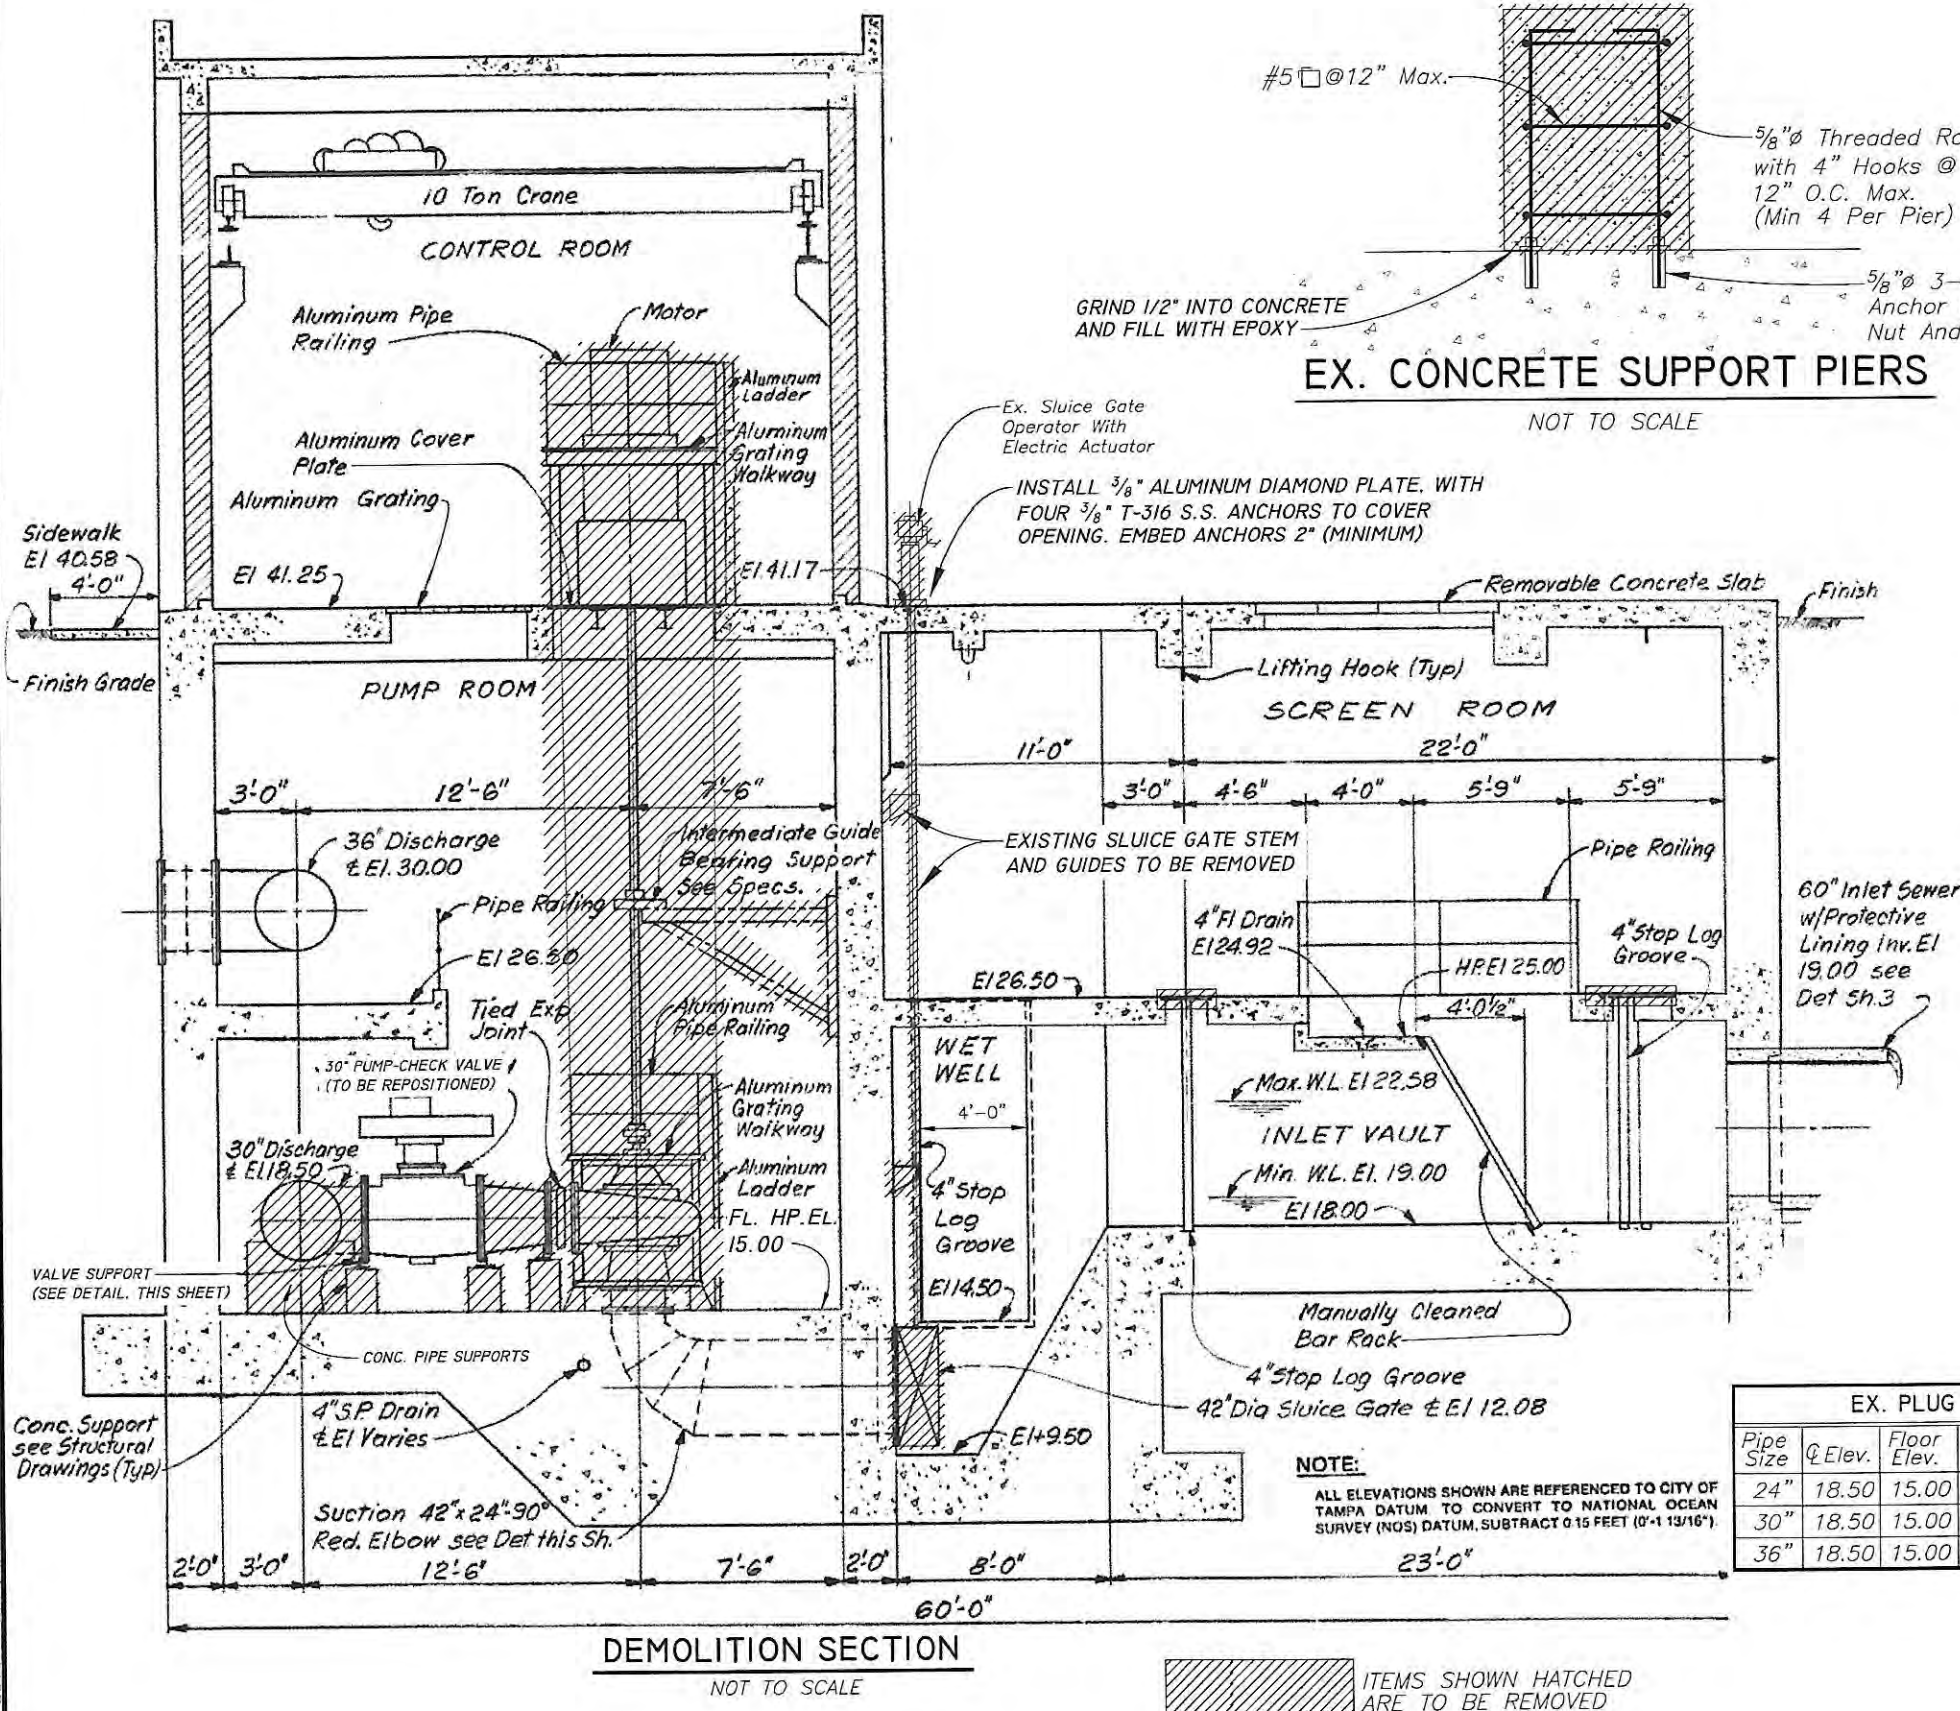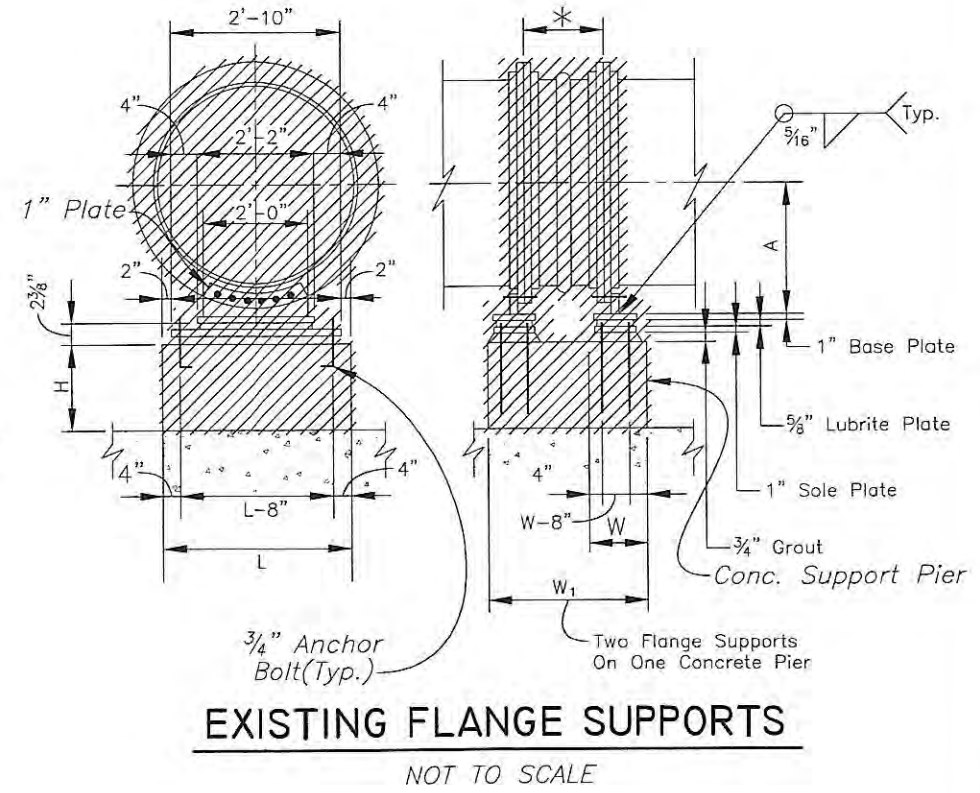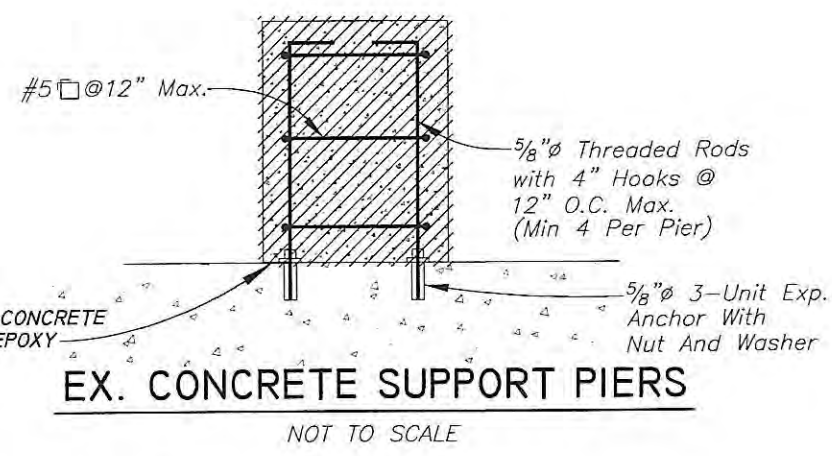


EX. PLUG VALVE AND EXPANSION JOINT SUPPORT DIMENSIONS (TO BE FIELD VERIFIED)


Pipe Size	Q Elev.	Floor Elev.	Location	A	B	C	D	E	W	W ₁	L	H
24"	18.50	15.00	Low Discharge Header	1'-6"	2'-10"	10"	2'-2"	10"	1'-2"	*	3'-2"	1'-8 5/8"
30"	18.50	15.00	Low Discharge Hdr & Pumps	1'-9 3/8"	2'-10"	10"	2'-2"	10"	1'-2"	*	3'-2"	1'-5 1/4"
36"	18.50	15.00	Low Discharge Hdr & Pumps	2'-1"	2'-10"	10"	2'-2"	10"	—	*	3'-2"	1'-1 5/8"

* Shown For Information Only. Not Included In This Contract

JACINTO CARLOS FERRAS, P.E. #49454 DESIGN DIVISION HEAD WASTEWATER DEPARTMENT	No.	DATE	REVISIONS	DES: J.H.	CITY of TAMPA WASTEWATER DEPARTMENT	UNIVERSITY PUMPING STATION PUMP #1 REPLACEMENT DEMOLITION SECTION	SHEET
	3			DRN: BB			6
	2			CKD:			
	1			DATE:			

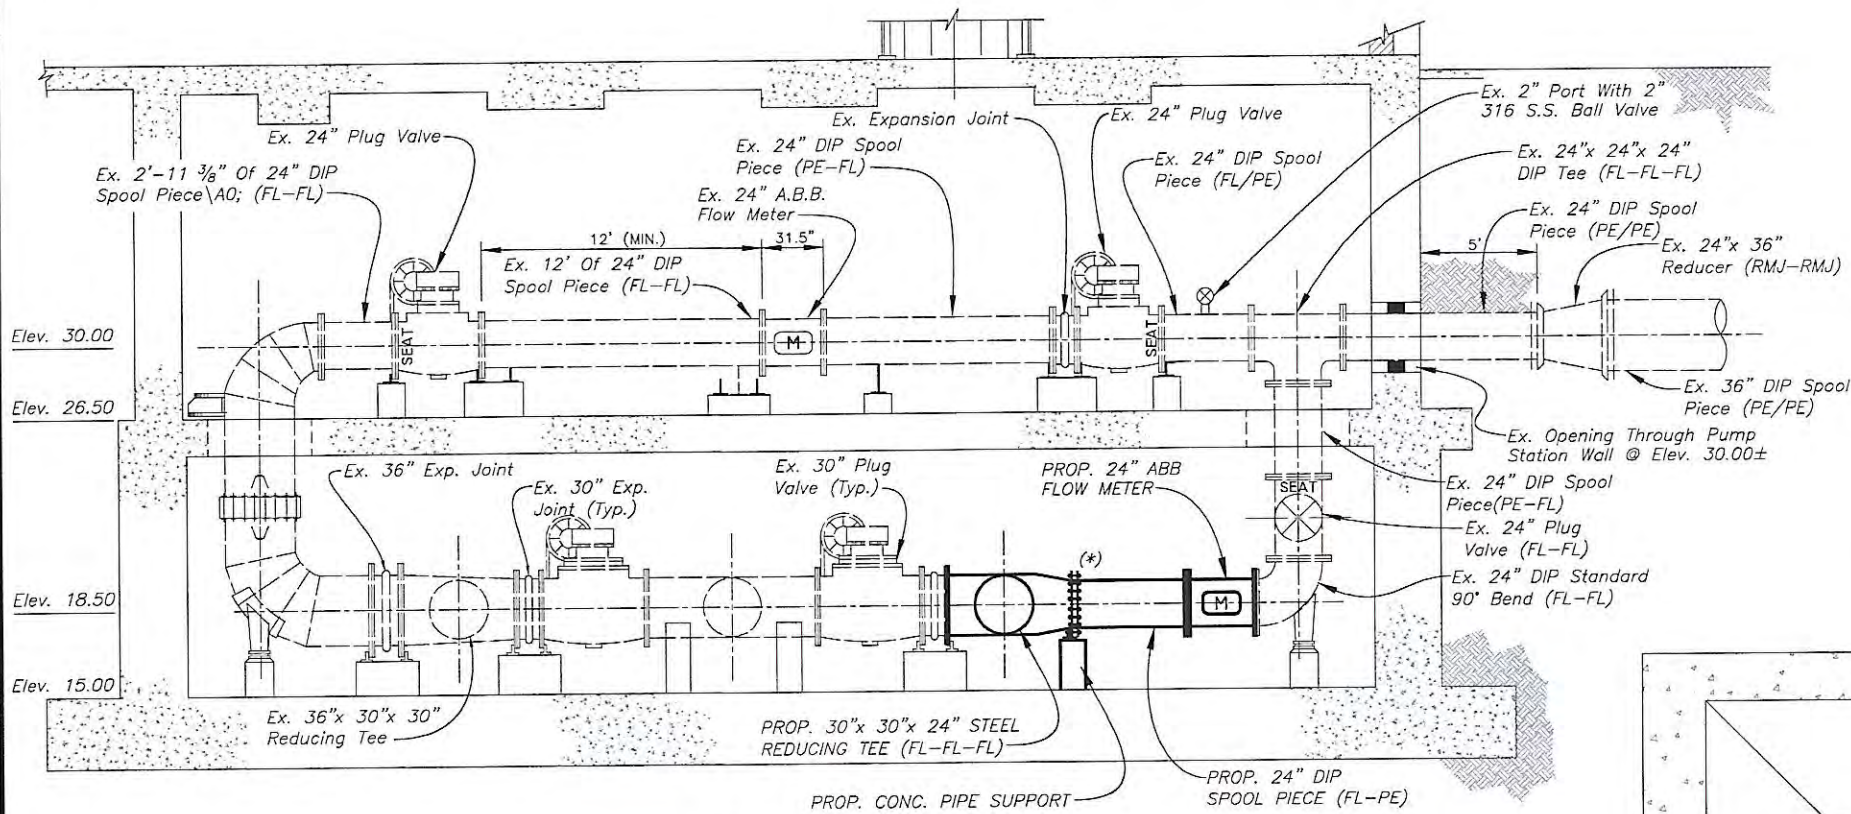

SECTION
 APPROXIMATE SCALE: 1/8" = 1'-0"
 (*) — EBAA MEGA-FLANGE FLANGE ADAPTOR

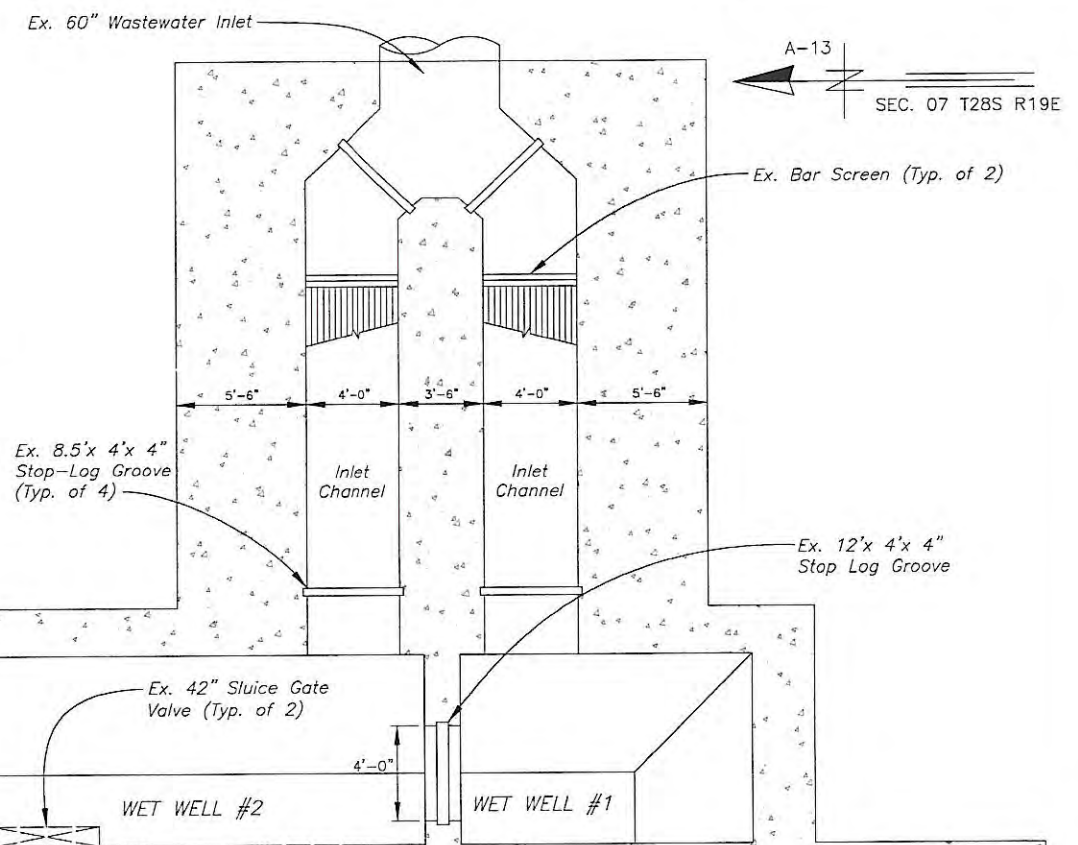

PLAN AT EL. 15.00
 APPROXIMATE SCALE: 1/8" = 1'-0"



PROP. ELECTRIC KNIFE GATE VALVE ACTUATORS (TYP. OF 3)

As-Built Drawings
 Granger Maint. & Constr. Inc.
 John H. Granger, President

John H. Granger 6/22/2022
 Signature Date


No Changes

PROPOSED CONFIGURATION FOR KNIFE GATE VALVE ACTUATORS

Nov 21, 2016 - 2:24pm
 Layout -
 JACINTO CARLOS FERRAS, P.E. #49454
 DESIGN DIVISION HEAD
 WASTEWATER DEPARTMENT

JACINTO CARLOS FERRAS, P.E. #49454 DESIGN DIVISION HEAD WASTEWATER DEPARTMENT	No.	DATE	REVISIONS	DES: J.H. DRN: BB CKD: DATE:	CITY of TAMPA WASTEWATER DEPARTMENT	UNIVERSITY PUMPING STATION PUMP #1 REPLACEMENT PROPOSED PLAN AND SECTION	SHEET
	3						7
	2						
	1						

User: ss11 Drawing Name: K:\Wastewater Projects\University P.S. Pump #1 - Sheets 3-6-8-B.dwg
 Date: Nov 21, 2016 2:24PM

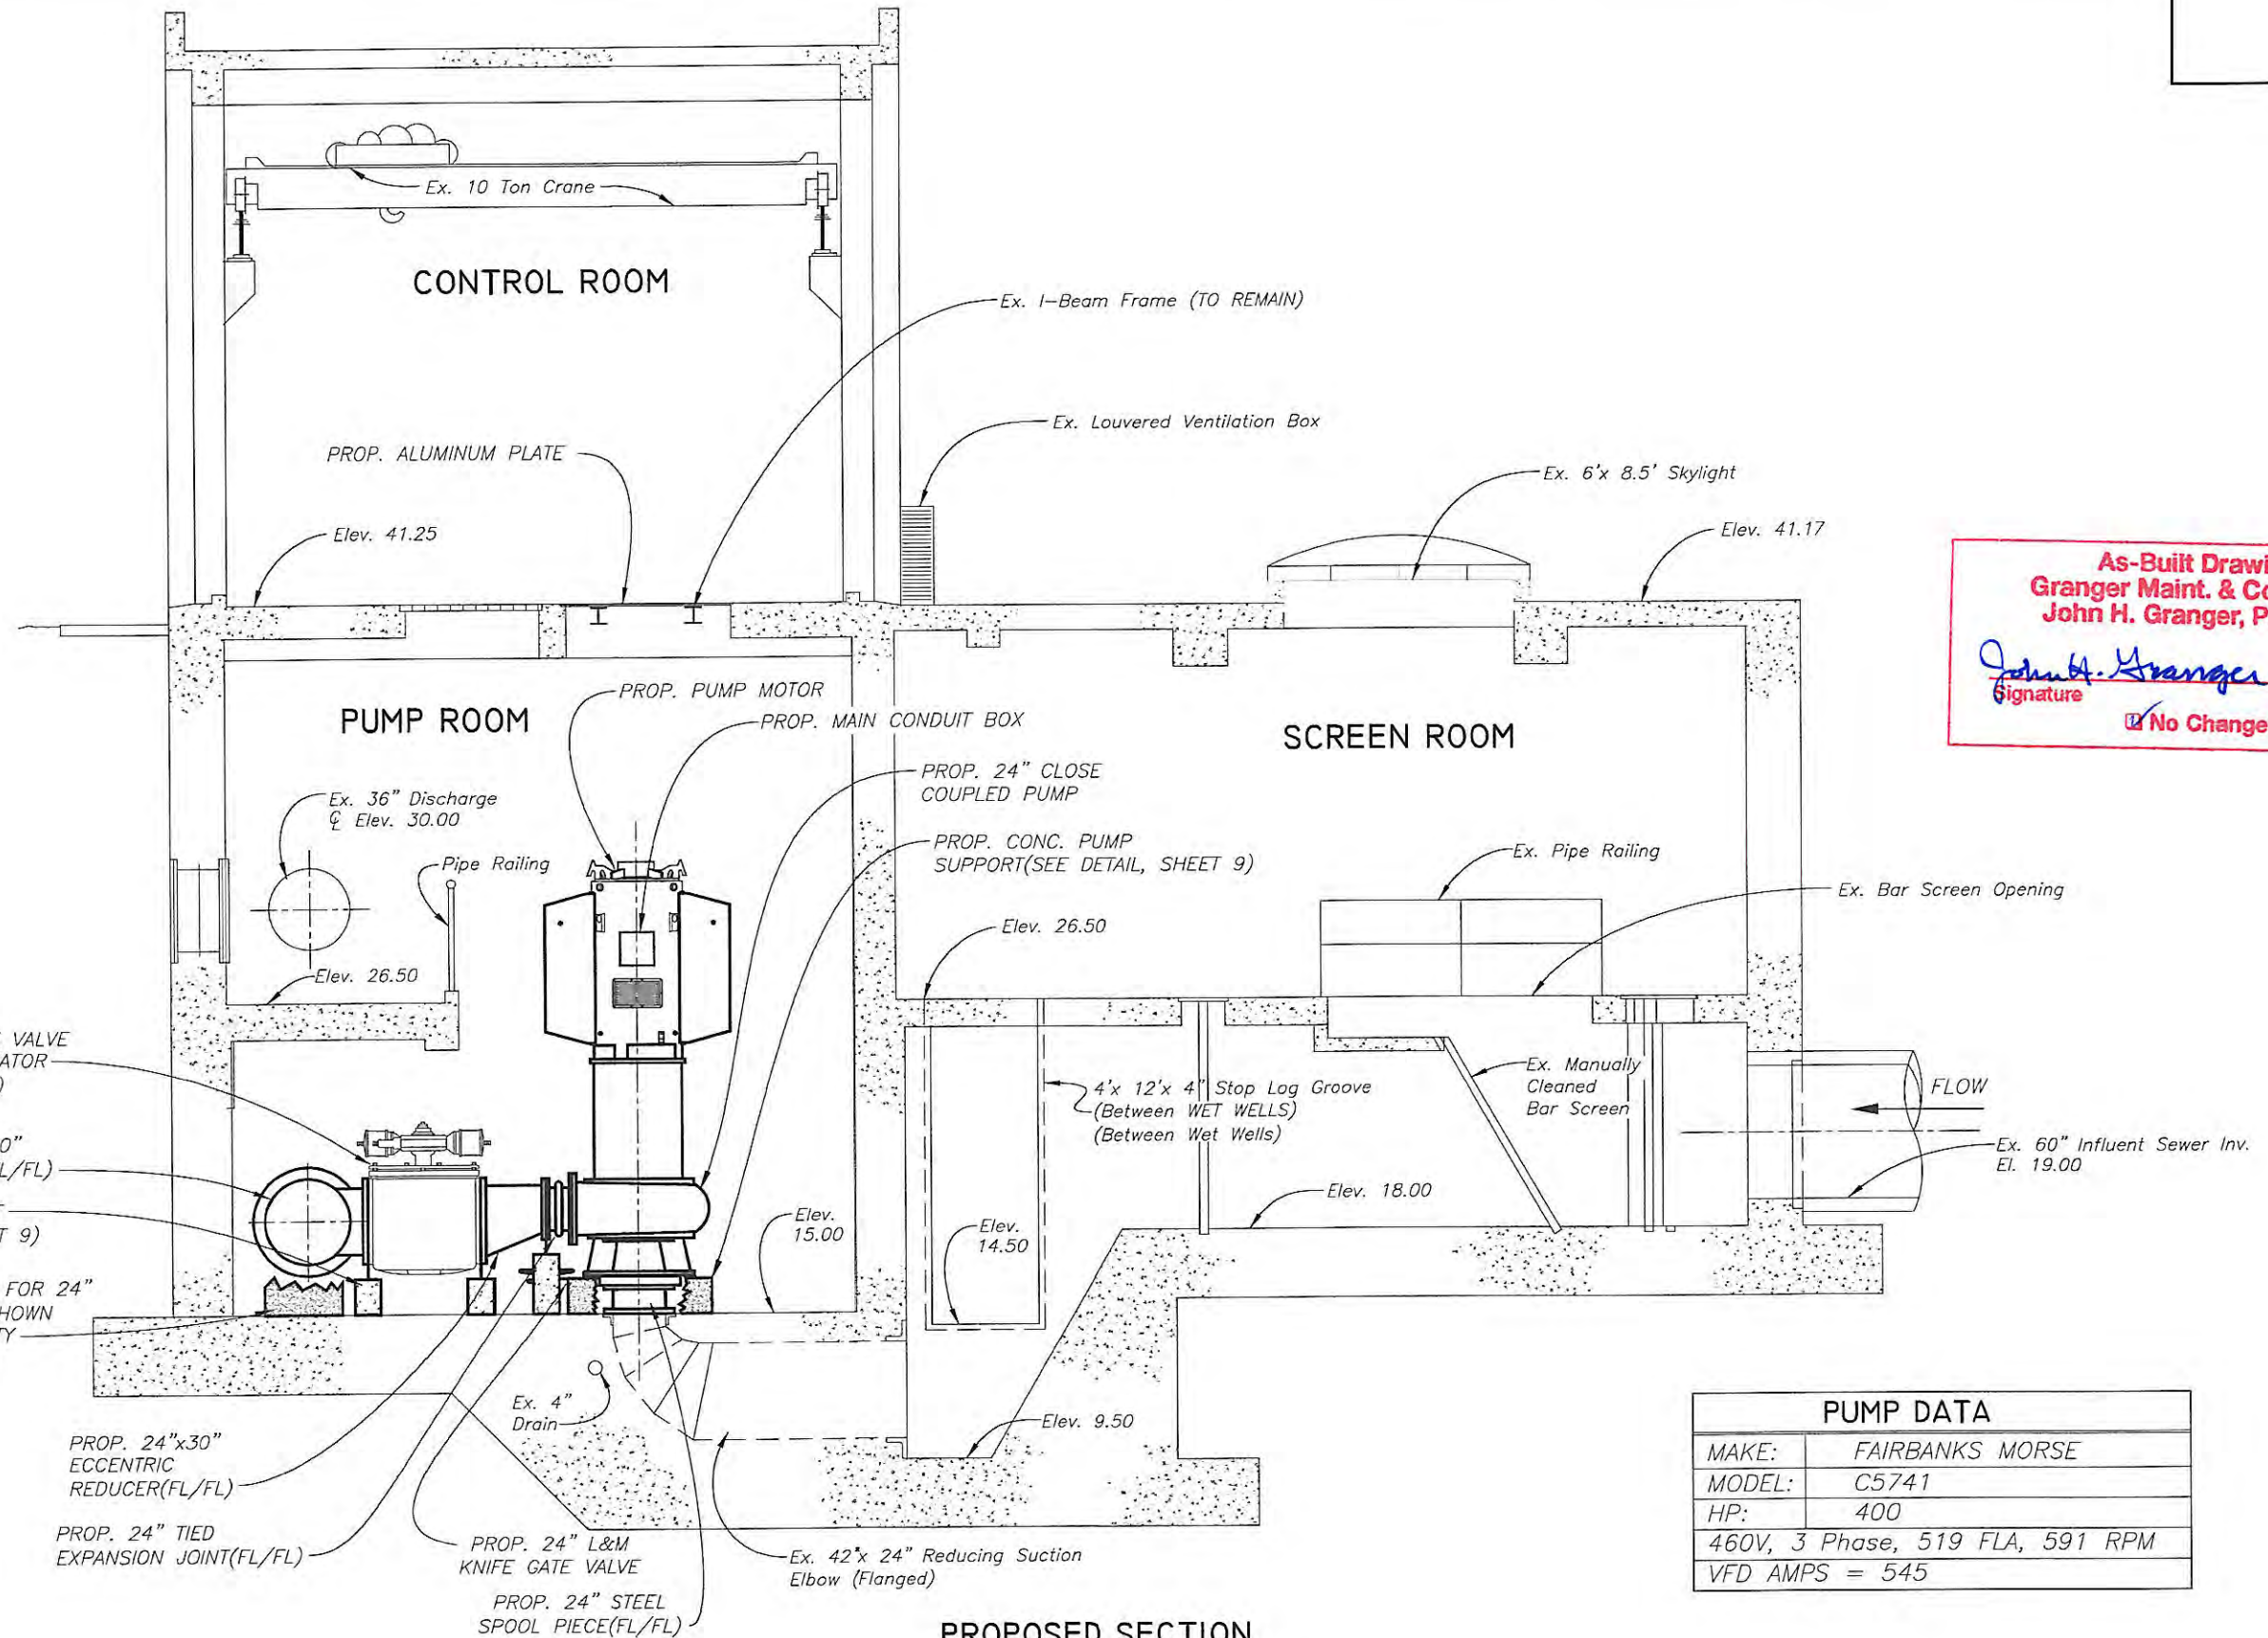

As-Built Drawings
Granger Maint. & Constr. Inc.
John H. Granger, President
John H. Granger 6/22/2022
 Signature Date
 No Changes

PUMP DATA	
MAKE:	FAIRBANKS MORSE
MODEL:	C5741
HP:	400
460V, 3 Phase, 519 FLA, 591 RPM	
VFD AMPS = 545	

PROPOSED SECTION
NOT TO SCALE

JACINTO CARLOS FERRAS, P.E. #49454
 DESIGN DIVISION HEAD
 WASTEWATER DEPARTMENT

No.	DATE	REVISIONS
3		
2		
1		


DES: J.H.
 DRN: BB
 CKD:
 DATE:

CITY of TAMPA
 WASTEWATER DEPARTMENT


UNIVERSITY PUMPING STATION
 PUMP #1 REPLACEMENT
 PROPOSED SECTION

SHEET
8

User: ss11 Drawing Name: K:\Wastewater Projects\University PS pump #1\Design Plans\Urating\UWG\University PS - Pump #1-Sheet-09.dwg Layout: Nov 21, 2016 2:24pm

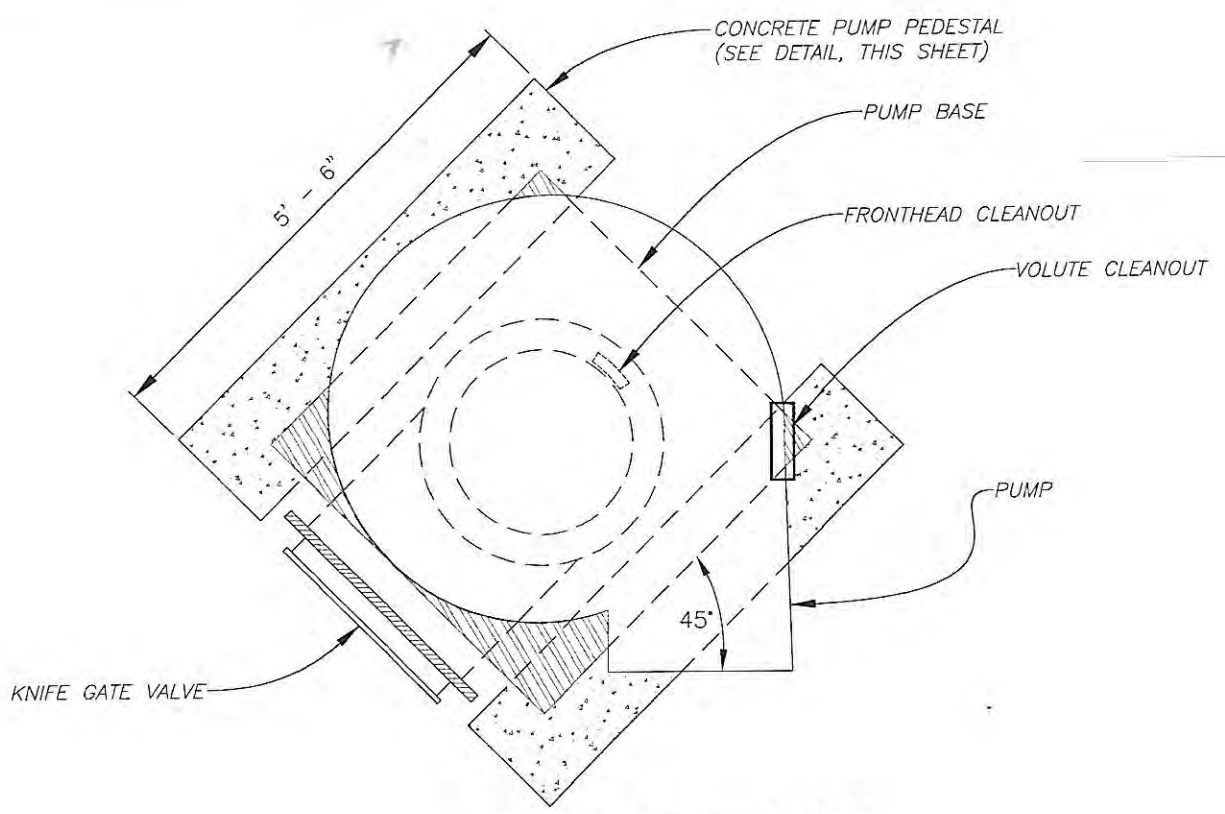


PROP. PUMP SUPPORT PLAN
NOT TO SCALE

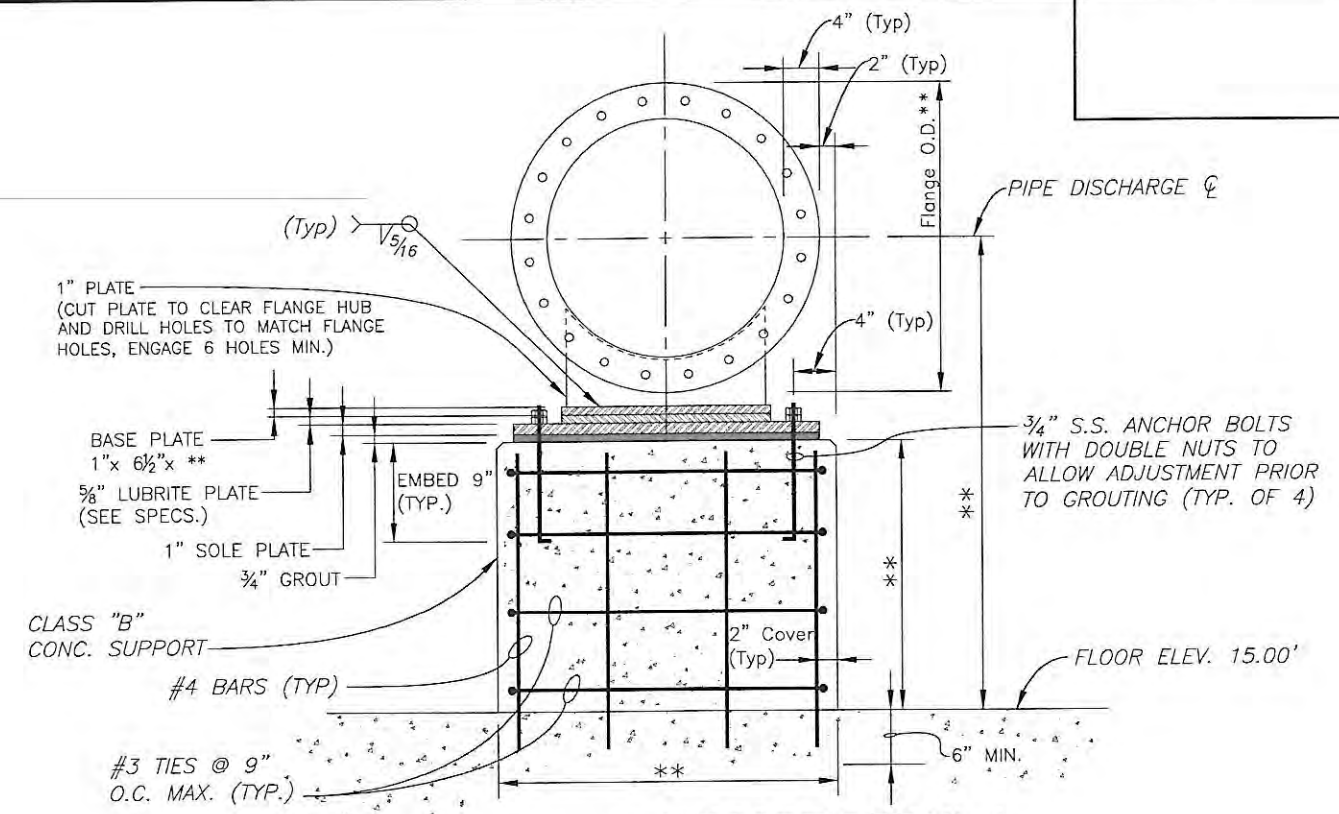


PROP. FLANGE SUPPORT DETAIL I
N.T.S.


** Dimension Dependent on Pipe Diameter

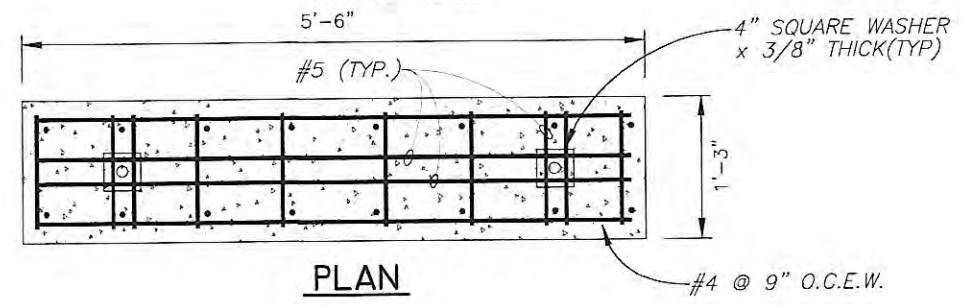

PLAN

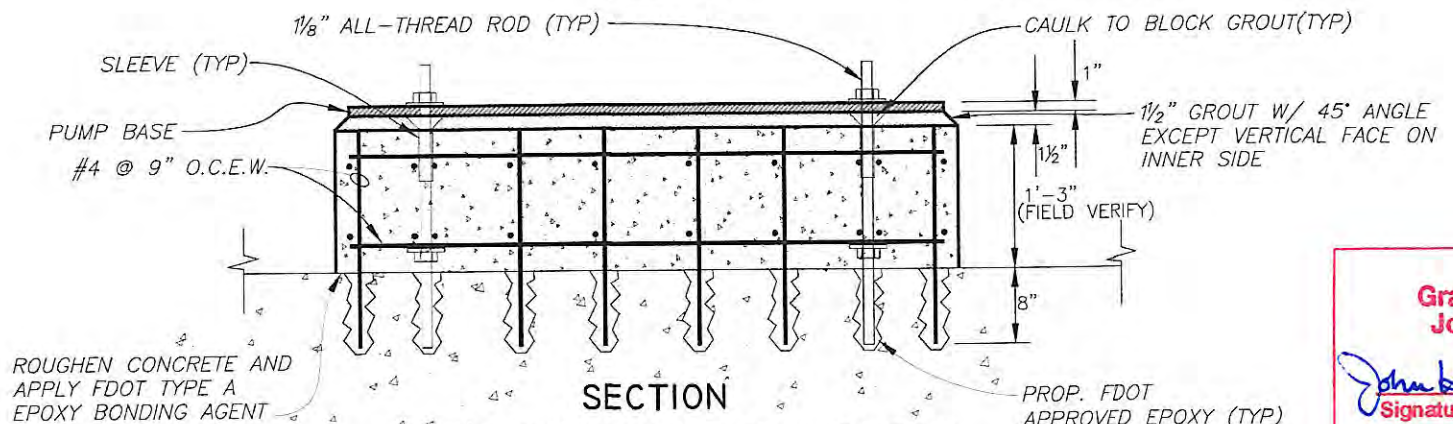

PROP. PUMP PEDESTAL DETAIL
NOT TO SCALE

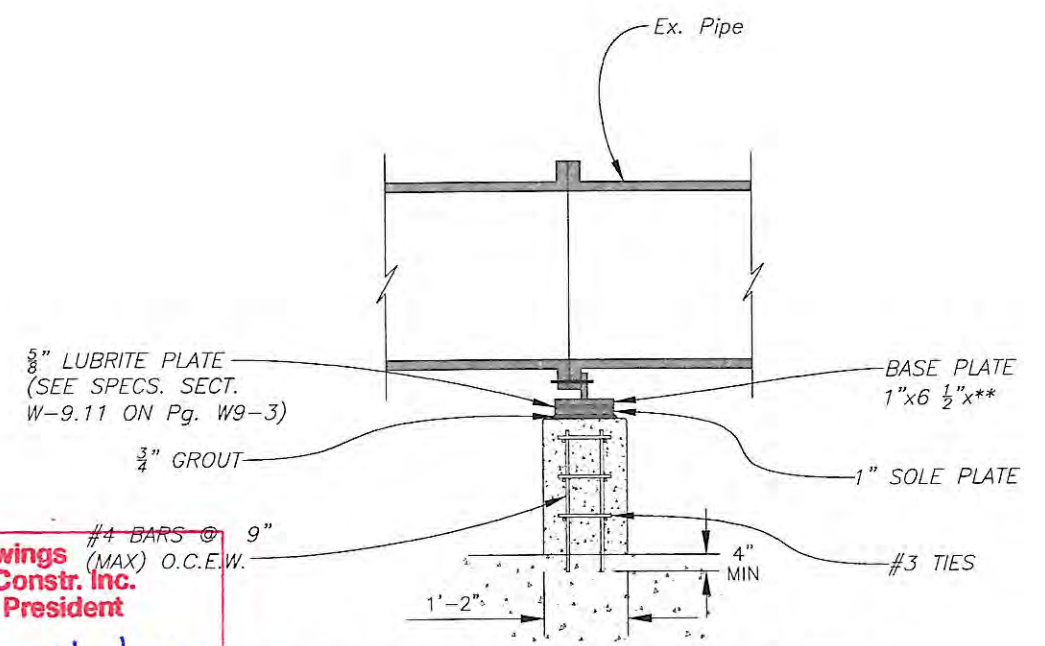

PROP. FLANGE SUPPORT DETAIL 2
NOT TO SCALE

As-Built Drawings
Granger Maint. & Constr. Inc.
John H. Granger, President
John H. Granger Signature 6/22/2022 Date
 No Changes


No.	DATE	REVISIONS
3		
2		
1		

JACINTO CARLOS FERRAS, P.E. #49454
DESIGN DIVISION HEAD
WASTEWATER DEPARTMENT

DES: J.H.
DRN: BB
CKD:
DATE:


CITY of TAMPA
WASTEWATER DEPARTMENT

UNIVERSITY PUMPING STATION
REHABILITATION
MISCELLANEOUS PUMP ROOM DETAILS

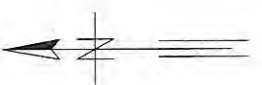

NOTES:

1. CITY WILL FURNISH THE CONTRACTOR WITH TWO STAINLESS STEEL STOP LOGS.
2. CONTRACTOR TO INSTALL STOP LOGS IN THE WET WELL #1 INLET CHANNEL AND IN BETWEEN WET WELLS PRIOR TO REMOVING EXISTING PUMP #1 IN PUMP ROOM AND INSTALLING 24" KNIFE GATE VALVE.
3. AFTER STOP LOGS HAVE BEEN INSTALLED, CONTRACTOR SHALL INSTALL HYDRAULIC SUMP PUMP IN THE ISOLATED WET WELL #1 IN ORDER TO PUMP WET WELL DOWN AND CATCH ANY WASTEWATER BYPASSING THE STOP LOGS.
4. AFTER WET WELL IS PUMPED DOWN, CONTRACTOR SHALL INSTALL, AND MAINTAIN A 42" INFLATABLE PLUG IN THE PUMP #1 INFLUENT PIPE.
5. INFLATABLE PLUG, HYDRAULIC PUMP AND STOP LOGS MAY BE REMOVED AFTER 24" SPOOL PIECE AND KNIFE GATE VALVE ARE SUCCESSFULLY INSTALLED IN THE PUMP ROOM.
6. OSHA STANDARD SAFETY EQUIPMENT SUCH AS SAFETY HARNESSSES, GAS MONITORS, LOWER EXPLOSIVE LIMIT (LEL) DETECTORS, ETC. SHALL BE UTILIZED WHERE THE WORK DICTATES THEIR USE, AND SHALL BE SOLE RESPONSIBILITY OF THE CONTRACTOR.

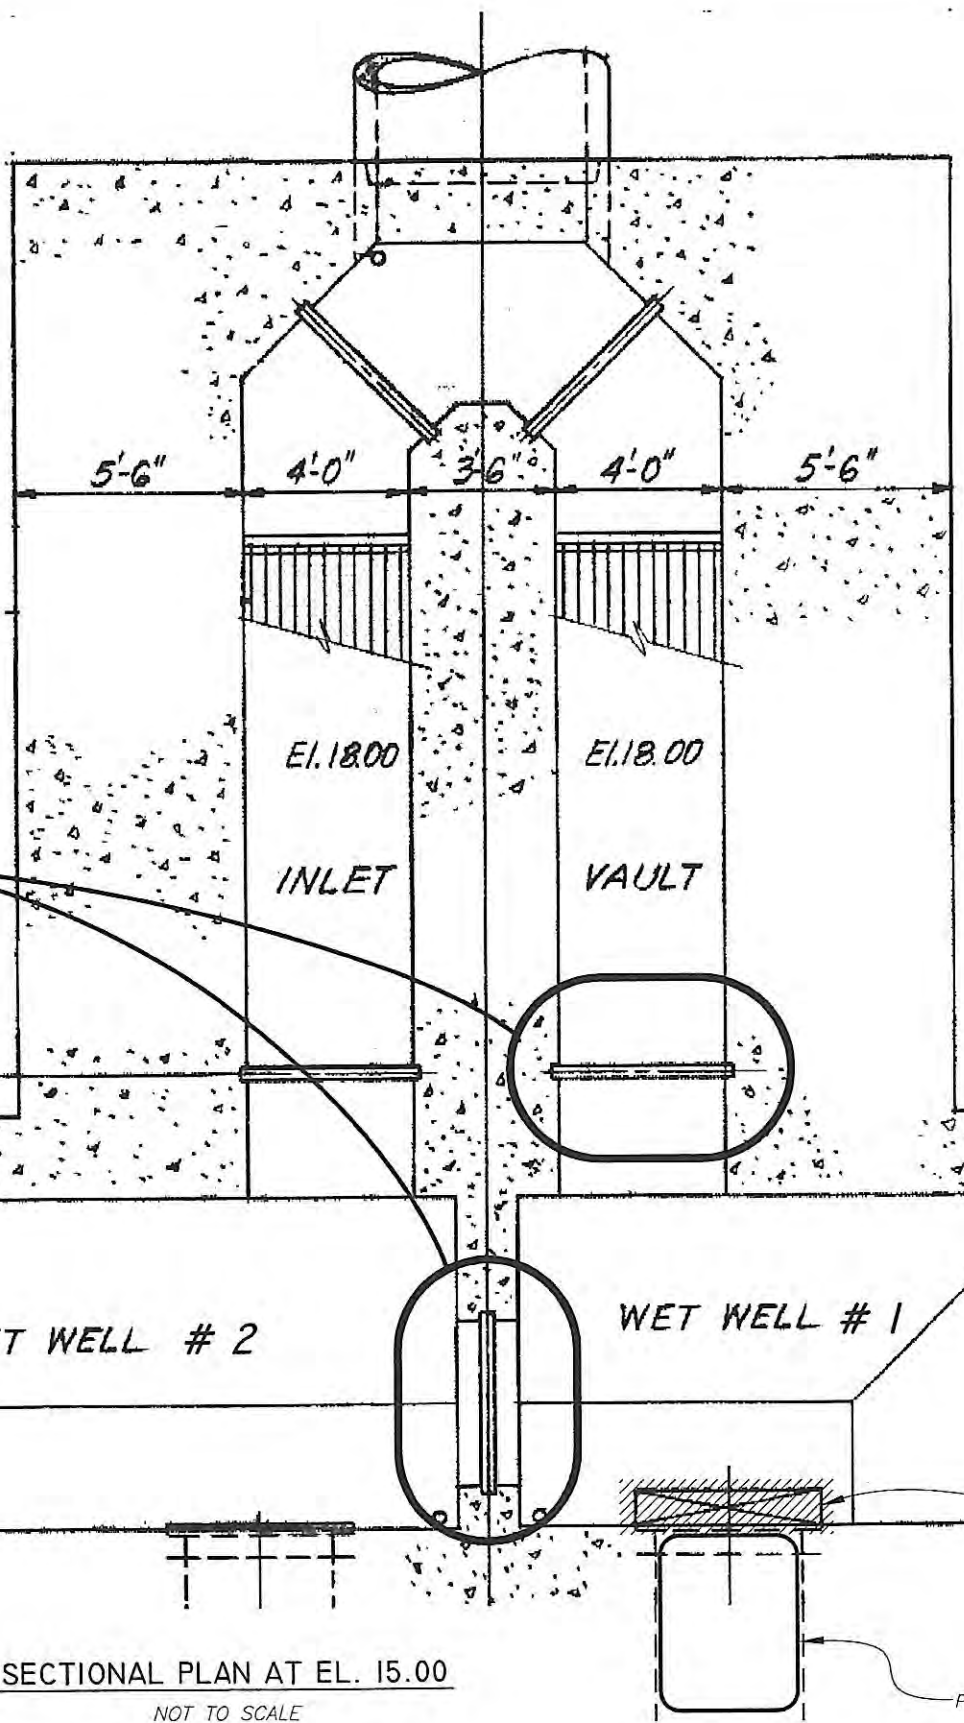


STOP-LOGS TO BE
INSTALLED IN EXISTING 4"
STOP-LOG GROOVES

As-Built Drawings
Granger Maint. & Constr. Inc.
John H. Granger, President

John H. Granger 6/22/2022
Signature Date

No Changes

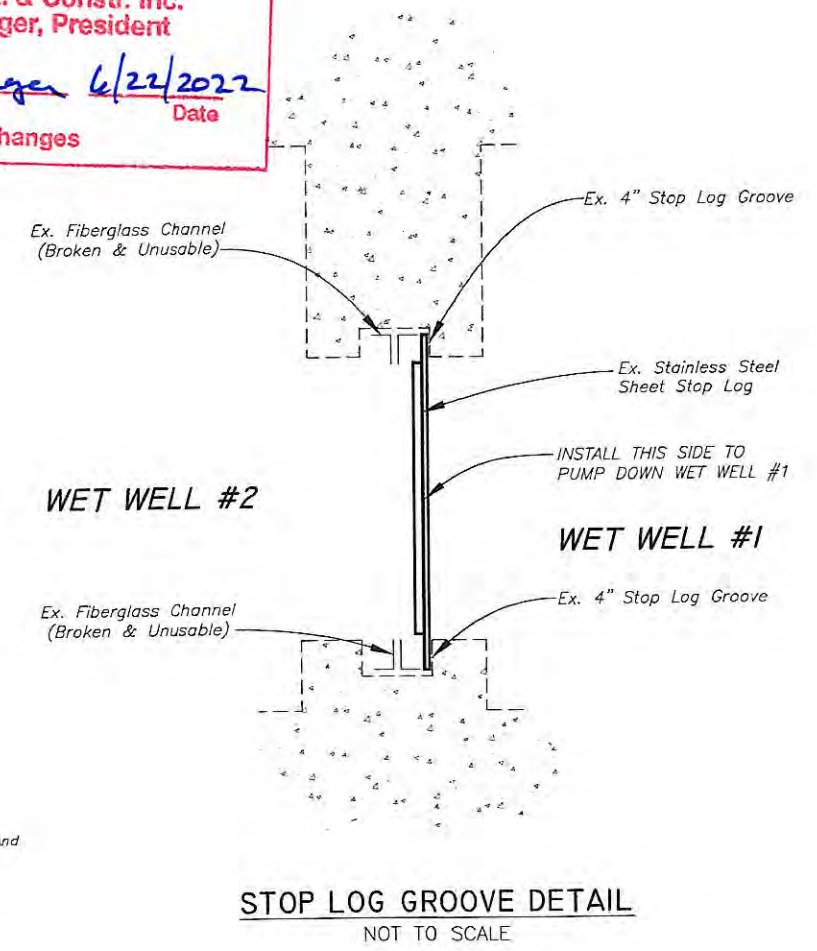

SECTIONAL PLAN AT EL. 15.00
NOT TO SCALE

STOP LOG GROOVE DETAIL
NOT TO SCALE

ITEMS SHOWN HATCHED
ARE TO BE REMOVED

3311 ...
 2018 - 2:30pm

JACINTO CARLOS FERRAS, P.E. #49454
DESIGN DIVISION HEAD
WASTEWATER DEPARTMENT


No.	DATE	REVISIONS
3		
2		
1		

DES: J.H.
DRN: BB
CKD:
DATE:

CITY of TAMPA
WASTEWATER DEPARTMENT

UNIVERSITY PUMPING STATION
PUMP #1 REPLACEMENT
WET WELL ISOLATION DETAILS

SHEET
10

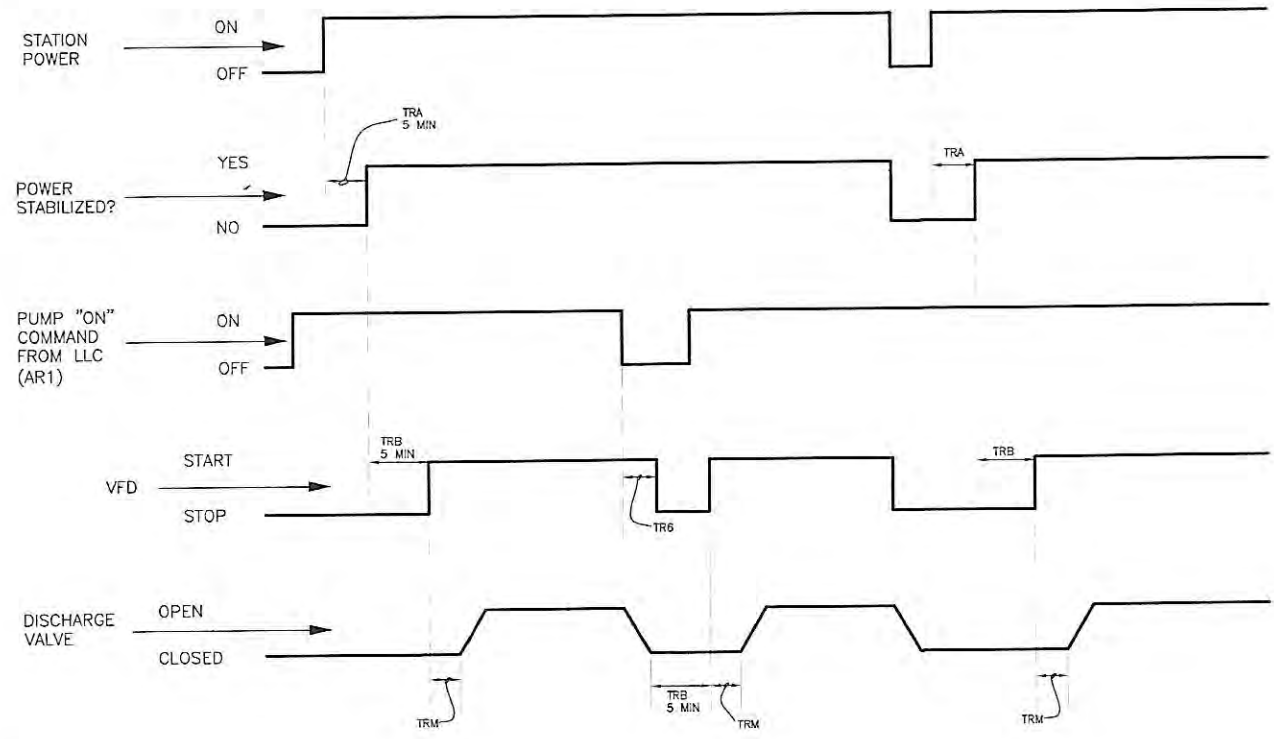


**SEWAGE PUMP No. 1
(TIMING DIAGRAM)**

ABBREVIATIONS:

4C	4 CONDUCTOR	HZ	HERTZ
A	AMPS	IG	ISOLATED GROUND
AF	AMPERE FRAME	KVA	KILOVOLT AMPERES
AM	AMMETER	KW	KILOWATTS
AT	AMPERE TRIP	MAX	MAXIMUM
AFF	ABOVE FINISHED FLOOR	MIN	MINIMUM
AFG	ABOVE FINISHED GRADE	N/A	NOT APPLICABLE
ATL	ACROSS-THE-LINE	PH	PHASE
C	CONDUIT	PM	POWER MONITOR
CLF	CURRENT LIMITING FUSE	RECP	RECEPTACLE
CT	CURRENT TRANSFORMER	RPM	REVOLUTIONS PER MINUTE
CU	COPPER	RTU	REMOTE TERMINAL UNIT
EX	EXISTING	RVSS	REDUCED VOLTAGE SOFT STARTER
ELEC	ELECTRICAL	SPD	SURGE PROTECTION DEVICE
EXP	EXPLOSION PROOF	TYP	TYPICAL
FU	FUSE	V	VOLTS
GFI	GROUND FAULT INTERRUPTER	W	WIRE
GND	GROUNDING CONDUCTOR	WP	WEATHERPROOF
HP	HORSEPOWER		

- LEGEND**
- DISCONNECTING DEVICE
 - MOTOR CIRCUIT PROTECTOR
30 AMPERE CONTINUOUS RATING
90 AMPERE MAGNETIC TRIP SETTING
 - CONTROL POWER TRANSFORMER
 - FUSE
 - NORMALLY OPEN CONTACT } OR TIME DELAY RELAY,
 NORMALLY CLOSED CONTACT } INSTANT TRANSFER SWITCH
 - MOTOR STARTER COIL
 - MOTOR THERMAL OVERLOAD
 - PILOT LIGHT (RED LENS)
 - TERMINAL STRIP
 - ELAPSED TIME METER
 - STOP PUSHBUTTON
WITH PROVISIONS FOR PADLOCK
 - 3 POSITION SELECTOR SWITCH
 - LIMIT SWITCH, NORMALLY OPEN
 - LIMIT SWITCH, NORMALLY CLOSED
 - PRESSURE SWITCH, NORMALLY OPEN
 - 3 PHASE MOTOR
 - MOUNTED NEAR EQUIPMENT OR
MOTOR (LOCAL)
 - NEUTRAL
 - PUSHBUTTON WITH PROVISIONS
FOR LOCK (N.O.)
 - N.C. PUSHBUTTON
 - LOCAL CONTROL STATION
ES - EMERGENCY STOP
 - GROUND SENSE RELAY
 - TWISTED PAIR SHIELDED CABLE
 - NORMALLY CLOSED "ON DELAY"
TIMING RELAY
 - NORMALLY OPEN "ON DELAY"
TIMING RELAY
 - INSTANT CLOSE - DELAY OPEN
TIMING RELAY (OFF DELAY)
 - INSTANT OPEN - DELAY CLOSE
TIMING RELAY (OFF DELAY)

EXAMPLE OF SECTION CUT AND DETAIL

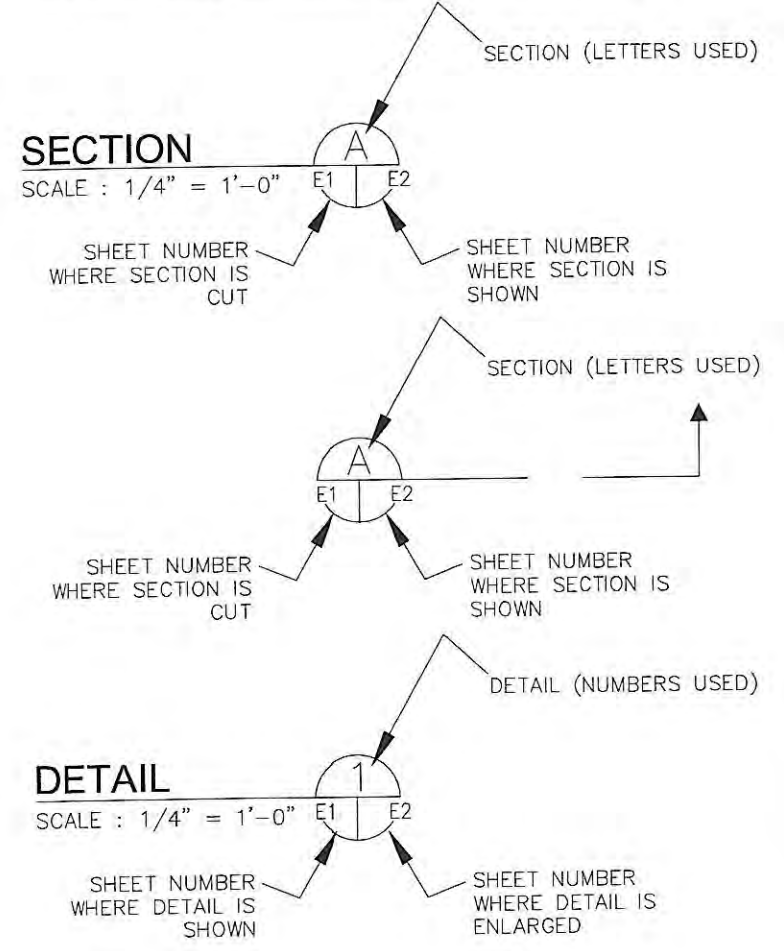

As-Built Drawings
Granger Maint. & Constr. Inc.
John H. Granger, President

John H. Granger 6/22/2022
 Signature Date


No Changes



TIMOTHY THOMAS, P.E. #47079	No.	DATE	REVISIONS	DES: TDT	CITY of TAMPA WASTEWATER DEPARTMENT	UNIVERSITY P.S. PUMP NO. 1 REPLACEMENT TIMING DIAGRAM, LEGEND & ABBREV	W.O. 4511
	3			DRN: JLH			SHEET
	2			CKD: TDT			E0
	1			DATE: 11/21/16			OF

NO Changes

John H. Granger 5/17/22

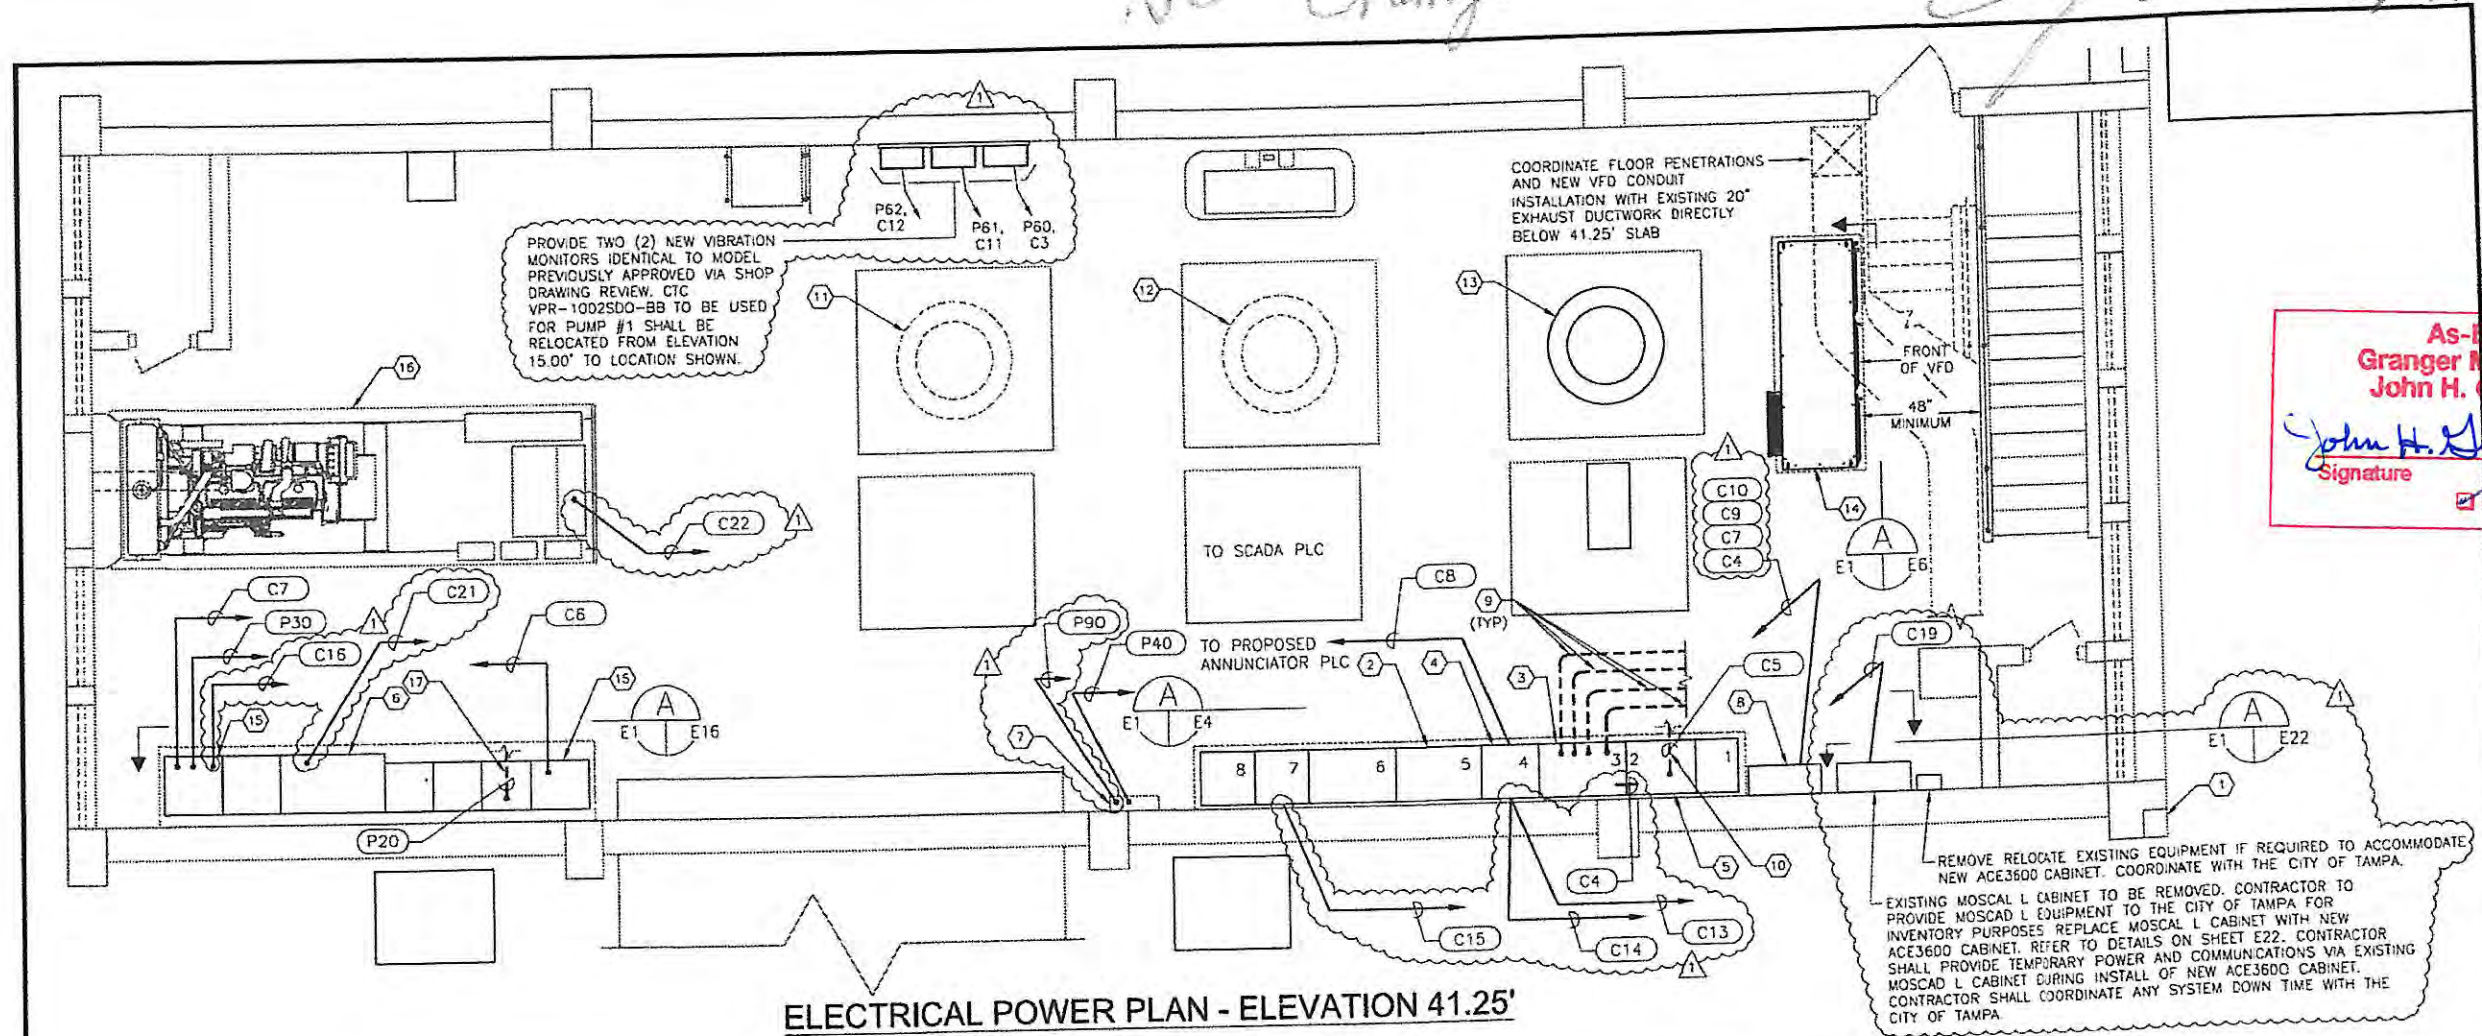

As-Built Drawings
Granger Maint. & Constr. Inc.
John H. Granger, President

John H. Granger 6/22/2022
Signature Date

No Changes

ELECTRICAL POWER PLAN - ELEVATION 41.25'
SCALE: 3/16" = 1'-0"

- KEYED NOTES:**
- 1 EXISTING PUMP STATION BUILDING
 - 2 EXISTING SEWAGE PUMPS CONTROL CENTER. REFER ALSO TO ELEVATION ON SHEET E4.
 - 3 EXISTING CUBICLE NO. 3 CONTAINING EXISTING PUMP NO. 1 MOTOR STARTER. EXISTING STARTER TO BE REMOVED. REFER TO SHEETS E4 AND E5 FOR OTHER WORK REQUIRED.
 - 4 EXISTING CUBICLE NO. 4 CONTAINING PUMP NO. 1 AND PUMP NO. 2 CONTROLS. (PUMP NO. 1 CONTROLS ABOVE CUBICLE 4A, PUMP NO. 2 CONTROLS BELOW, CUBICLE 4B). REFER TO SHEET E4 FOR WORK REQUIRED.
 - 5 EXISTING LIQUID LEVEL CONTROL (LLC) PANEL. REFER TO SHEET E4 MODIFICATIONS REQUIRED TO ACCOMMODATE NEW FLOW METER TO BE INSTALLED AT ELEVATION 15.00'. REFER TO SHEET E2 FOR NEW FLOW METER LOCATION.
 - 6 EXISTING MOTOR CONTROL CENTER, AUTOMATIC TRANSFER SWITCH AND ANNUNCIATOR LINEUP. REFER TO SHEETS E2 AND E16 FOR ELEVATION AND WORK REQUIRED.
 - 7 EXISTING 120/208V PANEL. CONTRACTOR TO PROVIDE AND INSTALL THREE (3) NEW, 120V, SINGLE-POLE CIRCUIT BREAKERS. ONE CIRCUIT FOR NEW FLOW METER 120V POWER, ONE CIRCUIT FOR NEW ANNUNCIATOR PLC 120V POWER, ONE FOR SIGNAL ISOLATORS/CONVERTERS 120V POWER.
 - 8 EXISTING PLC CONTROL CABINET CONTRACTOR TO PROVIDE NEW 3/4" CONDUIT WITH ONE (1) 2/C #16 TWISTED SHIELD CABLE (BELDEN 8719) TO NEW FLOW METER TRANSMITTER TO BE INSTALLED IN LIQUID LEVEL CONTROL PANEL. REFER TO NOTE #9 ON SHEET E2. PROVIDE NEW CONDUIT/CONDUCTORS, C3, C4, C7, C9 AND C10.
 - 9 NEW CONDUIT AND CONDUCTORS TO BE INSTALLED TO NEW PUMP NO. 1 AT ELEVATION 15.00'. REFER TO SHEET E2 FOR CONTINUATION.
 - 10 EXISTING CONDUIT. CONDUIT CURRENTLY CONTAINS ONE MANUFACTURER SUPPLIED FLOW METER TRANSMITTER CABLE. CONTRACTOR TO INSTALL NEW FLOW METER TRANSMITTER CABLE (FROM FLOW METER IN NOTE #8 ON SHEET E2) IN EXISTING CONDUIT.
 - 11 EXISTING SEWAGE PUMP NO. 3 (AT ELEVATION 15.00'). NO WORK REQUIRED.
 - 12 EXISTING SEWAGE PUMP NO. 2 (AT ELEVATION 15.00'). NO WORK REQUIRED.
 - 13 EXISTING SEWAGE PUMP NO. 1 (AT ELEVATION 41.25') TO BE REMOVED AND REPLACED. REFER ALSO TO CIVIL SHEETS AND SHEET E2.
 - 14 PROPOSED LOCATION OF NEW 400 HP VFD FOR PUMP NO. 1 (AT ELEVATION 41.25'). REFER TO SHEET E6 FOR ELEVATION.
 - 15 EXISTING ANNUNCIATOR PANEL TO BE REMOVED. REFER ALSO TO SHEET E16 FOR WORK REQUIRED.
 - 16 EXISTING GENERATOR NO WORK REQUIRED.
 - 17 PROVIDE AND INSTALL NEW 3/4" CONDUIT WITH 3-#12 + 1-#12 GND DOWN TO ELEVATION 15.00' FOR NEW KNIFE GATE VALVE ACTUATORS. REFER ALSO TO SHEET E2.


NOTE:
REFER ALSO TO SHEET E4 FOR OTHER CONDUIT/CONDUCTORS REQUIRED.



TIMOTHY THOMAS, P.E. #47079	No.	DATE	REVISIONS	DES: TDT	CITY of TAMPA WASTEWATER DEPARTMENT	UNIVERSITY P.S. PUMP NO. 1 REPLACEMENT ELECTRICAL POWER PLAN EL 41.25'	W.O. 4511
	3			DRN: JLH			SHEET
	2			CKD: TDT			EI
	1	1-7-19	ACE3600 ADDITION REVISION	DATE: 11/21/16			OF

NO Changes

John H. Granger 5/17/22

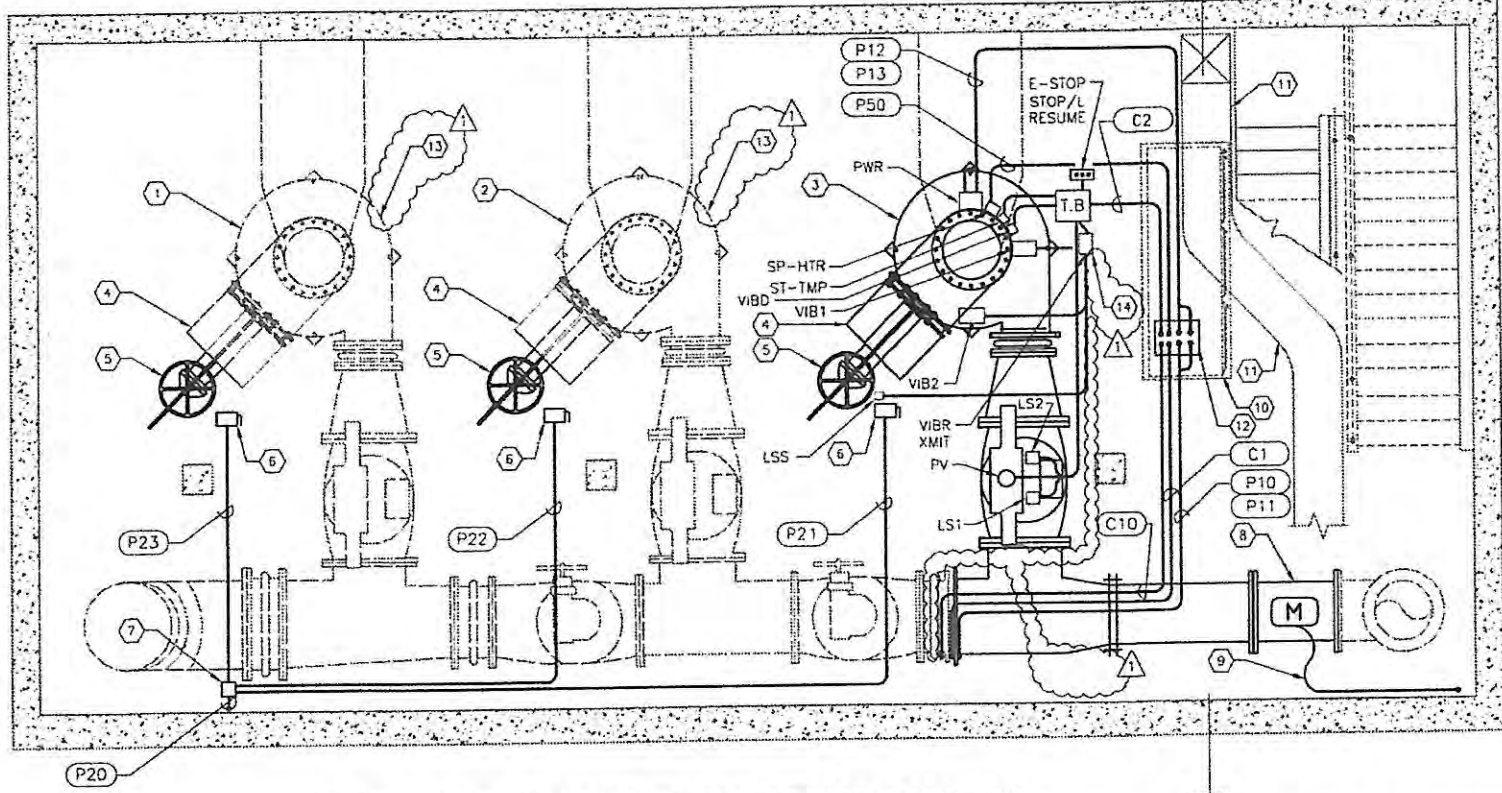

ELECTRICAL POWER PLAN ELEVATION 15.00'
SCALE : 3/16" = 1'-0"

REFER TO SHEET E3 FOR ELEVATION REGARDING PUMP MOTOR NO. 1 CONDUCTOR INSTALLATION.

As-Built Drawings
Granger Maint. & Constr. Inc.
John H. Granger, President
John H. Granger 6/22/2022
Signature Date
 No Changes

GENERAL NOTES:
1. NOT ALL CONDUITS/CONDUCTORS SHOWN FOR CLARITY REFER ALSO TO SHEETS E1 AND E3.

- KEYED NOTES:**
- ① EXISTING SEWAGE PUMP NO. 3 NO WORK REQUIRED.
 - ② EXISTING SEWAGE PUMP NO. 2 NO WORK REQUIRED
 - ③ NEW SEWAGE PUMP NO. 1 (TO BE INSTALLED AT ELEVATION 15.00') REFER ALSO TO CIVIL SHEETS.
 - ④ EXISTING KNIFE GATE VALVE. REFER ALSO TO CIVIL SHEETS
 - ⑤ NEW KNIFE GATE VALVE ACTUATOR REFER ALSO TO CIVIL SHEETS.
 - ⑥ PROVIDE AND INSTALL NEW 600V, 30A, 3-POLE MANUAL SWITCH IN NEMA 4 DIE CAST ZINC ALLOY, SQUARE-D 2510KW2CH OR EQUAL. FIELD LOCATE BASED ON ACTUATOR SELECTED. MOUNT WITH 1-5/8" X 1-5/8" STAINLESS STEEL UNISTRUT PROVIDE 3/4" WATERTIGHT, NON-METALLIC FLEXIBLE CONDUIT CONNECTION TO ACTUATOR WITH 3-#12 + 1-#12 GND.
 - ⑦ PROVIDE AND INSTALL NEW 6" X 6" X 4" NEMA 4X STAINLESS STEEL JUNCTION BOX AT EL 15.00' FOR ACTUATOR FEEDER CIRCUIT. FIELD LOCATE.
 - ⑧ NEW 24" ABB METER AND ASSOCIATED FLOW METER ELEMENT
 - ⑨ EXISTING 3/4" CONDUIT. CONDUIT CONTINUES UP TO JUNCTION BOX AT ELEVATION 26.50'. AN EXISTING CONDUIT IS INSTALLED FROM THE JUNCTION BOX TO THE LIQUID LEVEL CONTROL PANEL. CONTRACTOR TO PROVIDE AND INSTALL NEW FLOW METER SIGNAL CABLE FROM FLOW METER ELEMENT (NOTE #8) TO THE NEW FLOW METER TRANSMITTER TO BE INSTALLED IN THE EXISTING LIQUID LEVEL CONTROL PANEL. REFER ALSO TO SHEET E1.
 - ⑩ PROPOSED LOCATION OF NEW 400 HP VFD FOR PUMP NO. 1 (AT ELEVATION 41.25' ABOVE). REFER TO ALSO TO SHEET E1.
 - ⑪ EXISTING 20" EXHAUST DUCTWORK DIRECTLY BELOW 41.25' SLAB. LOCATION SHOWN IS APPROXIMATE.
 - ⑫ COORDINATE FLOOR PENETRATIONS AND NEW VFD CONDUIT INSTALLATION WITH VFD MANUFACTURER'S CONDUIT ENTRY WINDOW AND EXISTING 20" EXHAUST DUCTWORK DIRECTLY BELOW 41.25' SLAB.
 - ⑬ CONTRACTOR SHALL REMOVE EXISTING VIBRATION EQUIPMENT AND PROVIDE AND INSTALL NEW SENSORS AND INSTALL ASSOCIATED CONDUCTORS UP TO ELEVATION 41.25'. REFER TO SHEET E1 FOR NEW CTC EQUIPMENT LOCATION. EXISTING CONDUCTORS CURRENTLY USED FOR VIBRATION EQUIPMENT 120V AC POWER, PUMP AND MOTOR VIBRATION ALARMS, AS WELL AS, FOR PUMP AND MOTOR VIBRATION & TEMPERATURE 4-20mA SIGNALS SHALL BE DISCONNECTED AT THE EXISTING TERMINAL BOX AT ELEVATION 15.00' AND ABANDONED.
 - ⑭ CONTRACTOR SHALL RELOCATE CTC EQUIPMENT FROM PROPOSED LOCATION ON ELEVATION 15.00' TO ELEVATION 41.25'. REFER TO SHEET E1 FOR PROPOSED CTC EQUIPMENT LOCATION. PROVIDE AND INSTALL NEW SENSORS AND INSTALL ASSOCIATED CONDUCTORS UP TO PROPOSED CTC EQUIPMENT AT ELEVATION 41.25'. CONDUCTORS CURRENTLY USED FOR VIBRATION EQUIPMENT 120V AC POWER, PUMP AND MOTOR VIBRATION ALARMS, AS WELL AS, FOR PUMP AND MOTOR VIBRATION & TEMPERATURE 4-20mA SIGNALS SHALL BE DISCONNECTED AT THE EXISTING TERMINAL BOX AT ELEVATION 15.00' AND ABANDONED.




TIMOTHY THOMAS, P.E. #47079	No.	DATE	REVISIONS	DES: TDT	CITY of TAMPA WASTEWATER DEPARTMENT	UNIVERSITY P.S. PUMP NO. 1 REPLACEMENT ELECTRICAL POWER PLAN EL 15.00'	W.O. 4511
	3			DRN: JLH			SHEET
	2			CKD: TDT			E2
	1	1-7-19	ACE3600 ADDITION REVISION	DATE: 11/21/16			OF

No Changes

John H. Granger

5/17/22

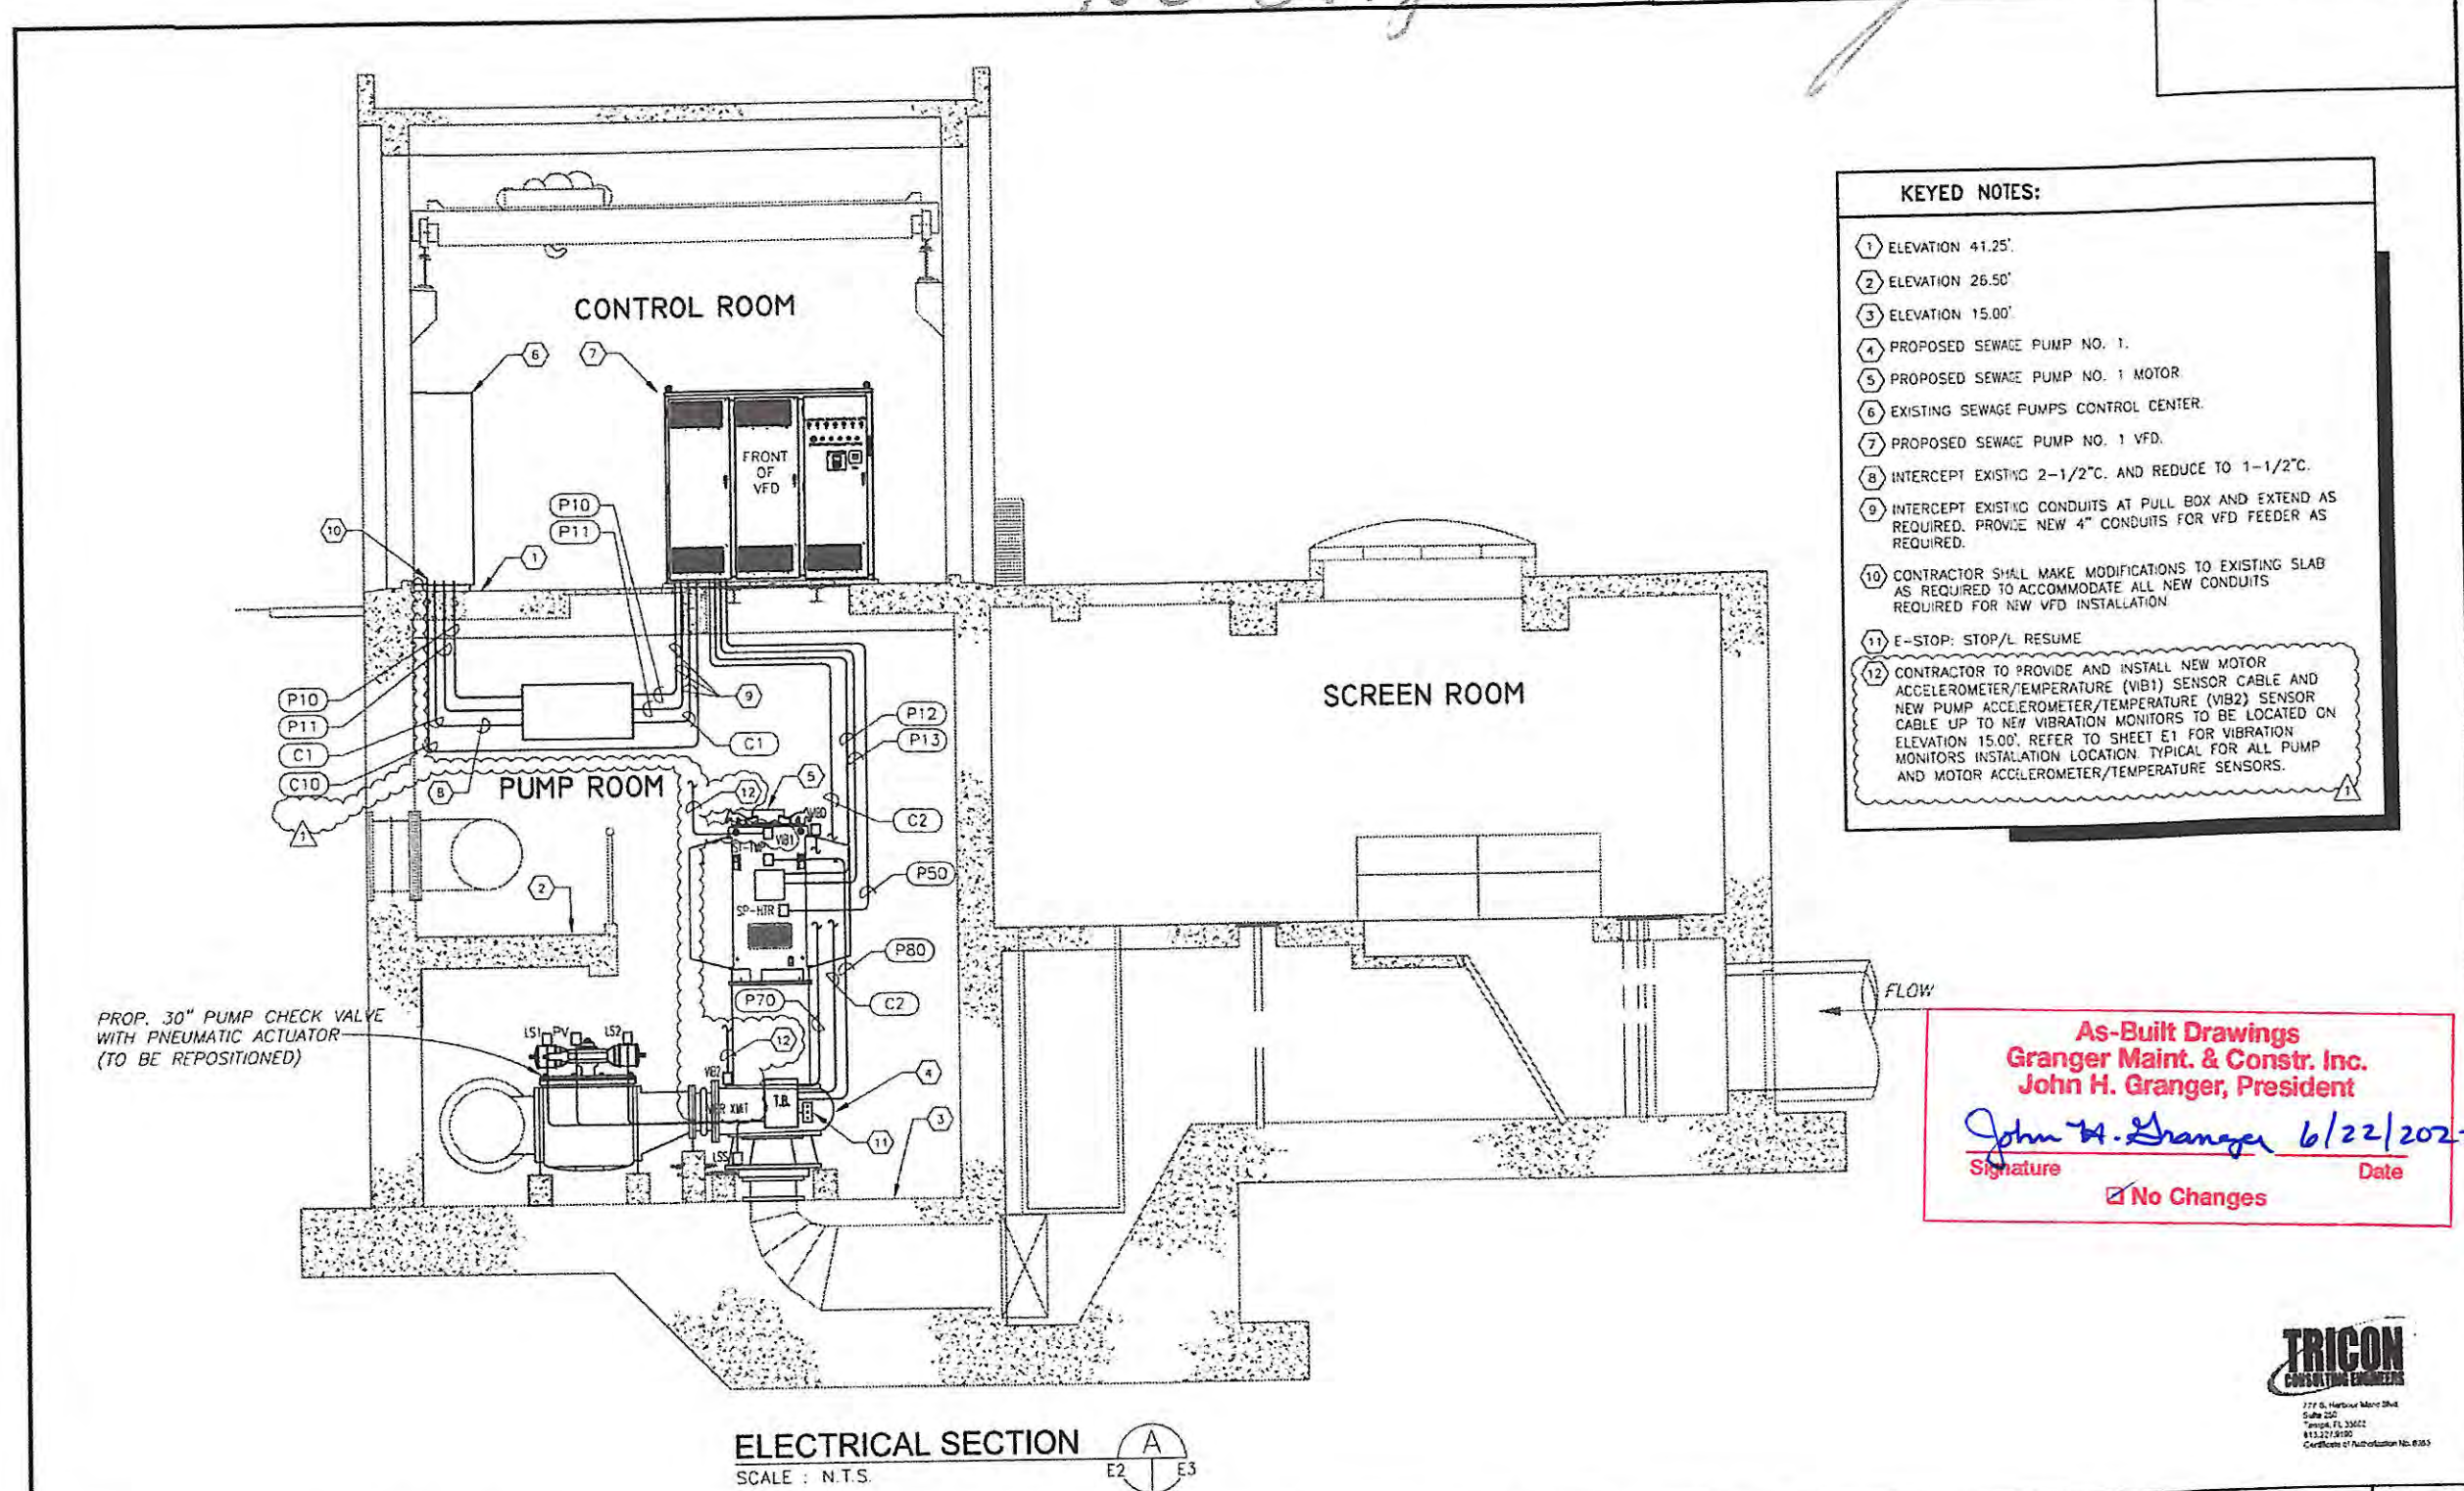

- KEYED NOTES:**
- ① ELEVATION 41.25'
 - ② ELEVATION 26.50'
 - ③ ELEVATION 15.00'
 - ④ PROPOSED SEWAGE PUMP NO. 1.
 - ⑤ PROPOSED SEWAGE PUMP NO. 1 MOTOR
 - ⑥ EXISTING SEWAGE PUMPS CONTROL CENTER.
 - ⑦ PROPOSED SEWAGE PUMP NO. 1 VFD.
 - ⑧ INTERCEPT EXISTING 2-1/2" C. AND REDUCE TO 1-1/2" C.
 - ⑨ INTERCEPT EXISTING CONDUITS AT PULL BOX AND EXTEND AS REQUIRED. PROVIDE NEW 4" CONDUITS FOR VFD FEEDER AS REQUIRED.
 - ⑩ CONTRACTOR SHALL MAKE MODIFICATIONS TO EXISTING SLAB AS REQUIRED TO ACCOMMODATE ALL NEW CONDUITS REQUIRED FOR NEW VFD INSTALLATION.
 - ⑪ E-STOP: STOP/L RESUME
 - ⑫ CONTRACTOR TO PROVIDE AND INSTALL NEW MOTOR ACCELEROMETER/TEMPERATURE (VIB1) SENSOR CABLE AND NEW PUMP ACCELEROMETER/TEMPERATURE (VIB2) SENSOR CABLE UP TO NEW VIBRATION MONITORS TO BE LOCATED ON ELEVATION 15.00'. REFER TO SHEET E1 FOR VIBRATION MONITORS INSTALLATION LOCATION TYPICAL FOR ALL PUMP AND MOTOR ACCELEROMETER/TEMPERATURE SENSORS.

PROP. 30" PUMP CHECK VALVE WITH PNEUMATIC ACTUATOR (TO BE REPOSITIONED)

As-Built Drawings
Granger Maint. & Constr. Inc.
John H. Granger, President

John H. Granger 6/22/2022
 Signature Date

No Changes

ELECTRICAL SECTION
 SCALE : N.T.S.




TIMOTHY THOMAS, P.E. #47079	<table border="1" style="width: 100%; border-collapse: collapse;"> <thead> <tr> <th>No.</th> <th>DATE</th> <th>REVISIONS</th> </tr> </thead> <tbody> <tr> <td>3</td> <td></td> <td></td> </tr> <tr> <td>2</td> <td></td> <td></td> </tr> <tr> <td>1</td> <td>1-7-19</td> <td>ACE3500 ADDITION REVISION</td> </tr> </tbody> </table>	No.	DATE	REVISIONS	3			2			1	1-7-19	ACE3500 ADDITION REVISION	DES: TDT DRN: JLH CKD: TDT DATE 11/21/16	CITY of TAMPA WASTEWATER DEPARTMENT	UNIVERSITY P.S. PUMP NO. 1 REPLACEMENT ELECTRICAL POWER SECTION	W.O. 4511 SHEET E3 OF
No.	DATE	REVISIONS															
3																	
2																	
1	1-7-19	ACE3500 ADDITION REVISION															

No Changes

Granger

5/17/22

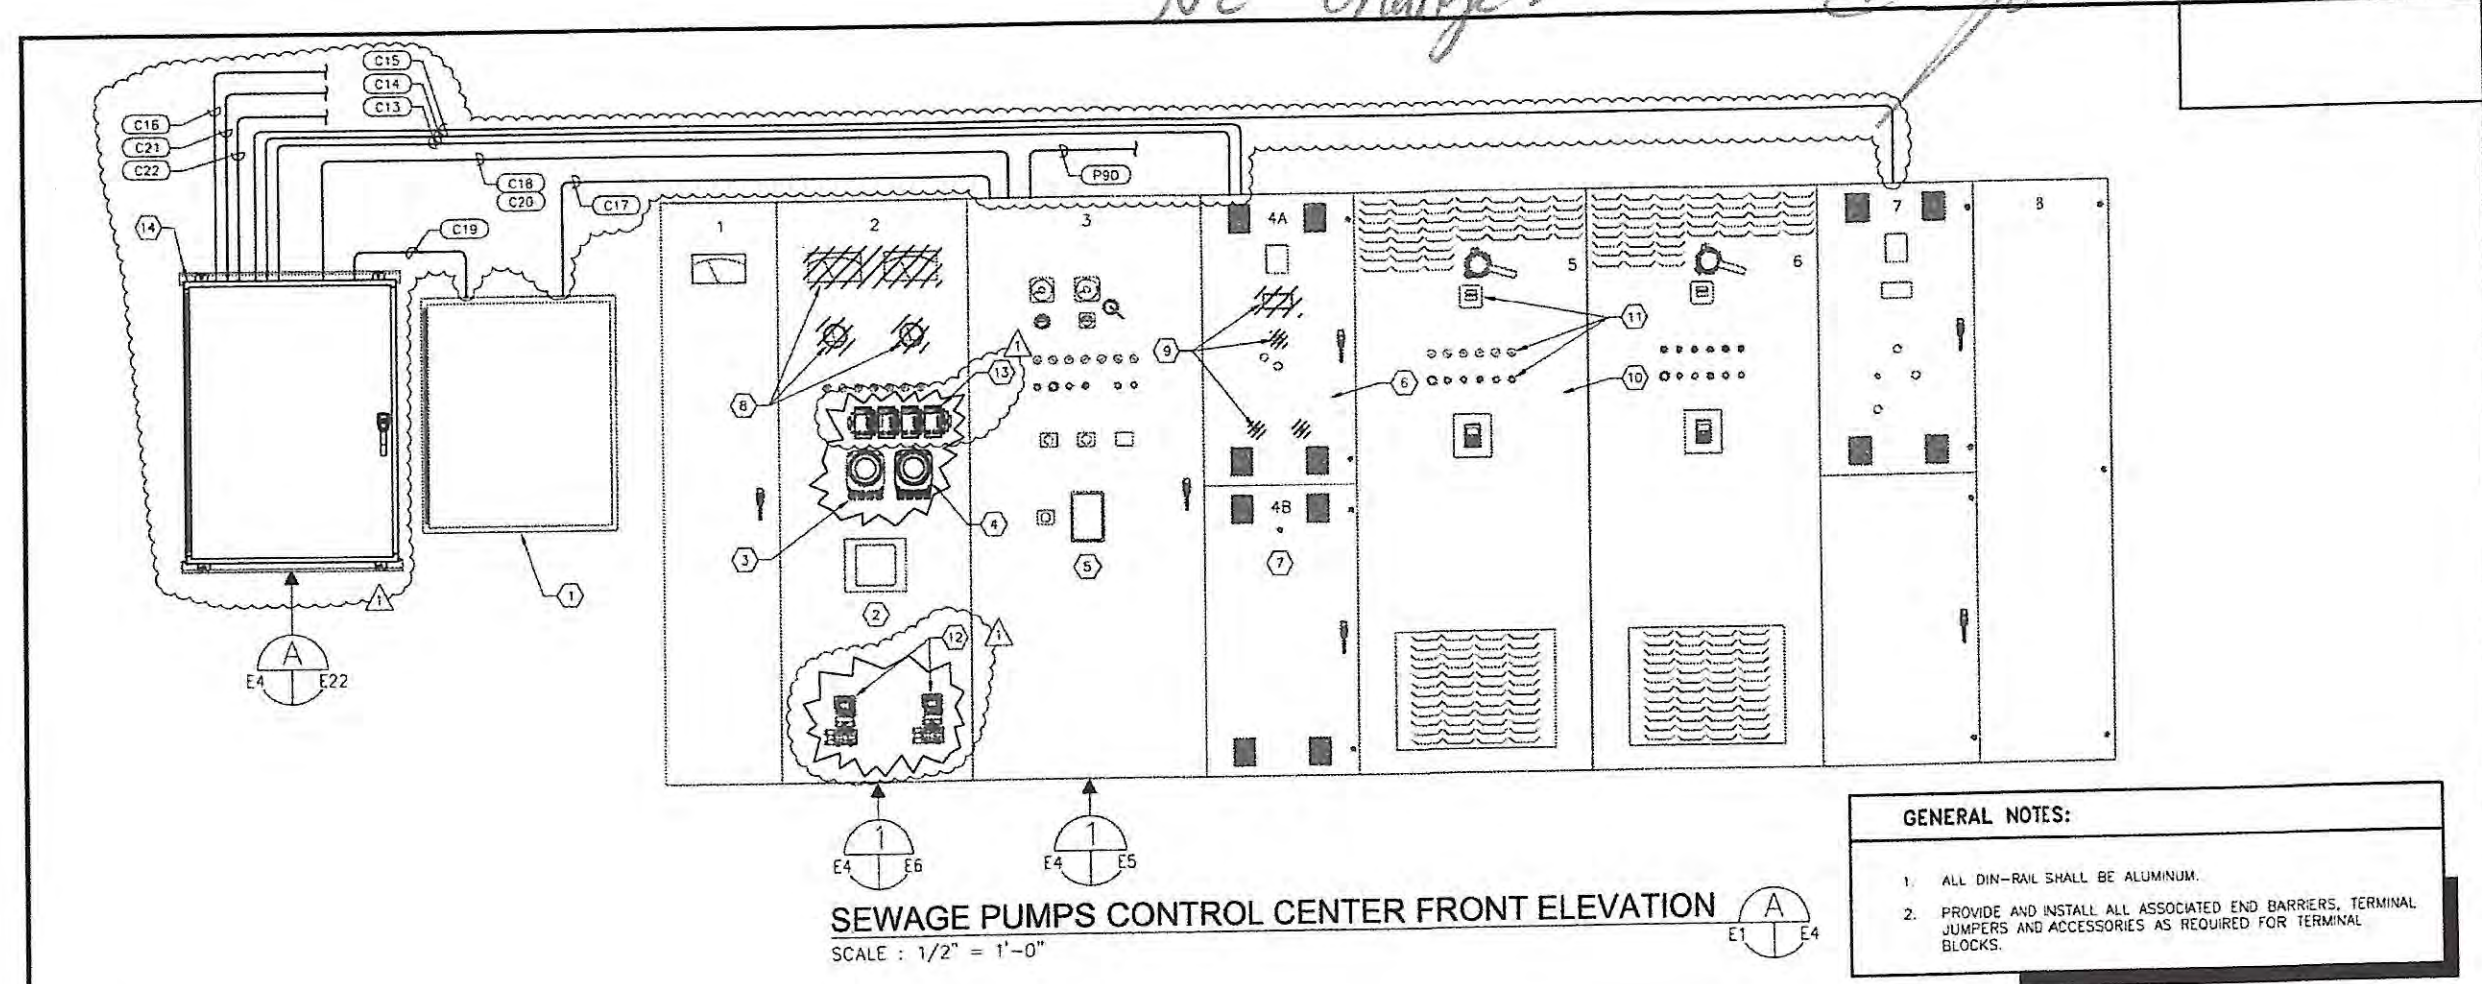

SEWAGE PUMPS CONTROL CENTER FRONT ELEVATION
SCALE : 1/2" = 1'-0"

GENERAL NOTES:

- ALL DIN-RAIL SHALL BE ALUMINUM.
- PROVIDE AND INSTALL ALL ASSOCIATED END BARRIERS, TERMINAL JUMPERS AND ACCESSORIES AS REQUIRED FOR TERMINAL BLOCKS.

KEYED NOTES:

- EXISTING PLC CONTROL CABINET. REFER TO SHEET E1 FOR CONDUIT AND CONDUCTORS REQUIRED.
- EXISTING LIQUID LEVEL CONTROLS (LLC) CUBICLE. REFER TO DETAIL ON SHEET E6 FOR OTHER WORK REQUIRED.
- EXISTING ABB FLOW METER TRANSMITTER LOCATED ON BACKPLATE OF LLC (BEHIND LLC DOOR).
- PROVIDE AND INSTALL NEW ABB FLOW METER TRANSMITTER. PROVIDE AND INSTALL 2-#12 + 1-#12 GND TO 120/208V PANELBOARD FOR FLOW METER TRANSMITTER 120V POWER (P40). PROVIDE AND INSTALL 2/C #15 TWISTED SHIELDED (BELDEN 8719) FROM NEW FLOW METER TRANSMITTER TO EXISTING PLC. TRANSMITTER CABLE BY MANUFACTURER.
- EXISTING SEWAGE PUMP NO. 1 CUBICLE (SECTION 3) REFER TO SHEET E5 FOR WORK REQUIRED.
- EXISTING CUBICLE 4A FOR PUMP NO 1 CONTROLS. CONTRACTOR SHALL REMOVE ALL INTERIOR COMPONENTS MADE OBSOLETE BY THE INSTALLATION OF THE NEW PUMP NO. 1 VFD. REFER TO CONDUIT AND CABLE SCHEDULE ON SHEET E21 REFER ALSO TO SHEETS E8, E9, E10 AND E11 FOR NEW VFD CONTROLS PROVIDE AND INSTALL NEW 600V, 20A TERMINAL BLOCKS (ALLEN-BRADLEY 1492-W3) FOR NEW CONDUCTORS TO BE INSTALLED FROM VFD. REFER ALSO TO GENERAL NOTES. NOTE: NEW CONTROLS FOR PUMP NO. 1 SHALL BE MOUNTED IN THE PROPOSED FREE-STANDING VFD CABINET LOCATED TO THE EAST.
- EXISTING CUBICLE 4B FOR PUMP NO 2 CONTROLS. REFER TO SHEETS E13, E14 AND E15 FOR REPLACEMENT OF EXISTING CONTROLS.
- EXISTING DEVICES TO BE REMOVED AND REPLACED WITH NEW. REFER TO DETAIL ON SHEET E6 FOR WORK REQUIRED.
- REMOVE EXISTING DEVICES AND PROVIDE AND INSTALL 1/4" ALUMINUM PLATE OVER EXISTING CUT-OUTS. PAINT TO MATCH EXISTING SURFACE.
- EXISTING SECTION 5 CONTAINING EXISTING PUMP NO. 2 VFD.
- EXISTING DEVICES TO BE REPLACED. REFER TO SHEETS E13, E14 AND E15 FOR NEW PUSHBUTTONS, PILOT LIGHTS, ETC. REQUIRED.
- APPROXIMATE LOCATION FOR EXISTING GAUGE PRESSURE TRANSMITTERS FOR WEST AND EAST WET WELL LEVELS. CONTRACTOR TO FIELD VERIFY LOCATION AND TYPE.
- PROVIDE AND INSTALL FOUR (4): 4-20mA SIGNAL ISOLATOR/CONVERTERS. MOORE INDUSTRIES ECT/4-20mA/2X4-20mA/117AC/DIN, OR EQUAL IF INSTRUMENT REQUIRES LOOP POWER, CONTRACTOR SHALL INSTALL ECT/4-20mA/2X4-20mA/117AC/TX/DIN, OR EQUAL. EACH ISOLATOR/CONVERTER SHALL BE PROVIDED WITH A 120V, 1 AMPERE THERMAL CIRCUIT BREAKER. THERMAL CIRCUIT BREAKERS SHALL BE PHOENIX CONTACT TCP TYPE. PROVIDE WITH SCREW TYPE CONNECTION, FUSE BASE TERMINAL BLOCK, PHOENIX CONTACT TYPE UK 6-FS/C. ALL COMPONENTS SHALL BE MOUNTED TO LIQUID LEVEL CONTROLS (LLC) CUBICLE BACKPANEL WITH 35mm ALUMINUM DIN-RAIL. PROVIDE NEW TERMINAL BLOCKS AS REQUIRED. LOCATION SHOWN FOR NEW COMPONENTS IS APPROXIMATE. CONTRACTOR SHALL RELOCATE DEVICES, AND/OR RELOCATE EXISTING DEVICES, AS NECESSARY.
- REMOVE EXISTING TELEMETRY CABINET, THEN PROVIDE AND INSTALL NEW ACE3600 CABINET. MOUNT CABINET TO WALL WITH 1-5/8" X 1-5/8" STAINLESS STEEL UNISTRUT. REFER TO SHEET E22 FOR ACE3600 CABINET DETAILS.

As-Built Drawings
Granger Maint. & Constr. Inc.
John H. Granger, President
John H. Granger 6/22/2022
Signature Date
 No Changes



No.	DATE	REVISIONS	DES: TDT	DRN: JLH	CKD: TDT	DATE: 11/21/16
3						
2						
1	1-7-19	ACE3600 ADDITION REVISION				

TIMOTHY THOMAS, P.E. #47079


CITY of TAMPA
WASTEWATER DEPARTMENT

UNIVERSITY P.S.
PUMP NO. 1 REPLACEMENT
CONTROL CENTER FRONT ELEVATION


W.O. 4511
SHEET
E4
OF

N.O Changes


Trigon 5/17/22

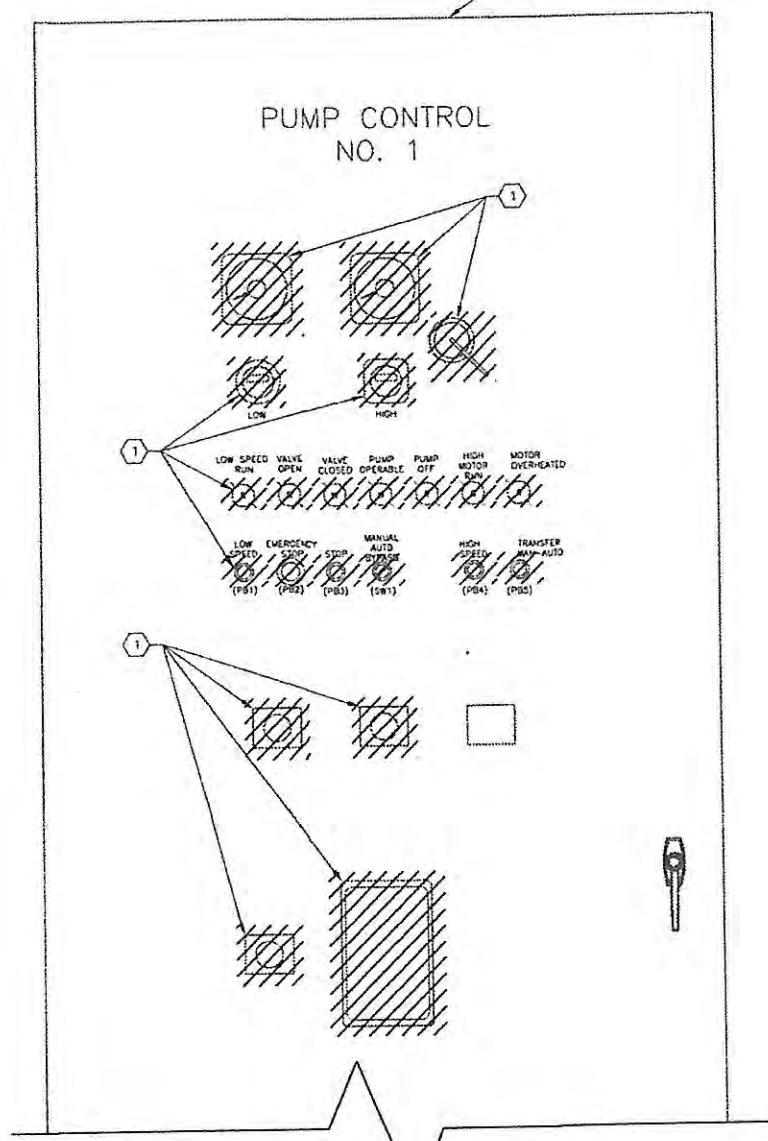

SEWAGE PUMP No. 1 CONTROLS
EXISTING FRONT DOOR LAYOUT DETAIL
SCALE : N.T.S.

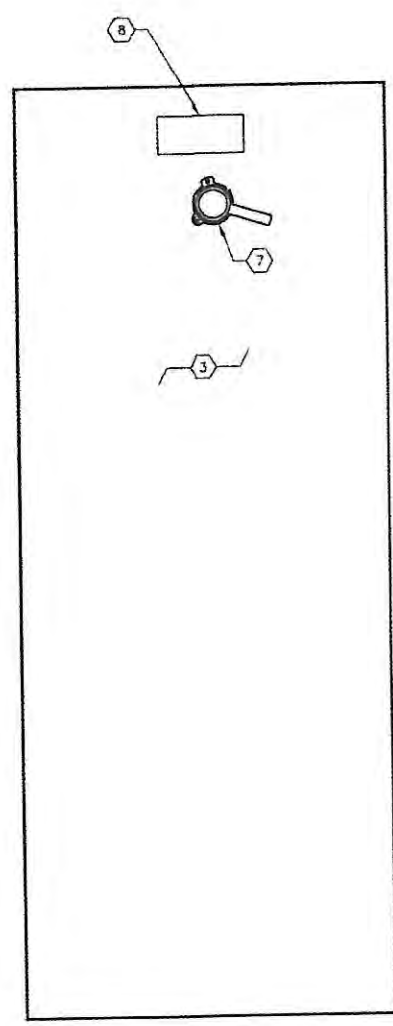

SEWAGE PUMP No. 1
SECTION 3 PROPOSED
EXTERIOR LAYOUT
SCALE : N.T.S.

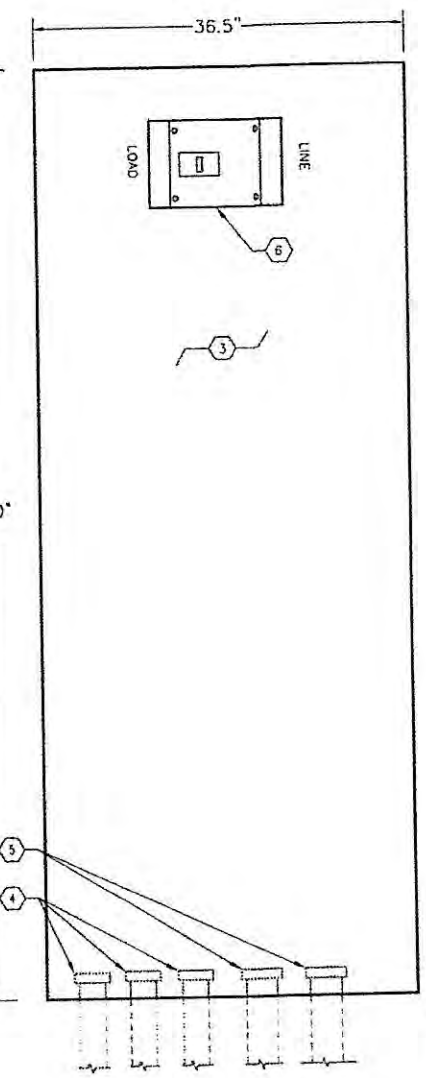

SEWAGE PUMP No. 1
SECTION 3 PROPOSED
INTERIOR LAYOUT
SCALE : N.T.S.

- KEYED NOTES:**
- 1 REMOVE ALL EXISTING DOOR MOUNTED OPERATOR DEVICES AND INSTALL PROPOSED DEVICES AS SHOWN. NEATLY COVER EXISTING OPENINGS NOT BEING UTILIZED AND PAINT TO MATCH EXISTING SURFACE. PROVIDE PROPER LEGEND PLATES AS SHOWN. PROPOSED LEGEND PLATES ENGRAVING, LETTERING SIZE, AND MATERIAL SHALL MATCH EXISTING LEGEND PLATES.
 - 2 TOP OF EXISTING DOOR.
 - 3 ALL EQUIPMENT SHOWN AS LOCATED ON OR IN SECTION 3 IS PROPOSED.
 - 4 THREE (3) EXISTING 2-1/2" CONDUITS. CONTRACTOR MAY REUSE EXISTING CONDUITS AS NEEDED.
 - 5 CONTRACTOR SHALL MAKE MODIFICATIONS TO EXISTING SLAB AS REQUIRED TO ACCOMMODATE NEW 4" ALUMINUM CONDUITS REQUIRED FOR NEW VFD FEEDERS.
 - 6 NEW 600V, 800A, 3-POLE MAIN CIRCUIT BREAKER FOR VFD FEEDER.
 - 7 NEW OPERATOR FOR MAIN CIRCUIT BREAKER TO BE INSTALLED ON OUTER DOOR OF SECTION 3. OPERATOR SHALL BE ABLE TO BE LOCKED IN THE 'OFF' POSITION.
 - 8 CONTRACTOR SHALL PROVIDE NEW LEGEND PLATE LABELED AS 'PUMP NO 1 FEEDER'. PROPOSED LEGEND PLATE ENGRAVING, LETTERING SIZE, AND MATERIAL SHALL MATCH EXISTING LEGEND PLATES.

- GENERAL NOTES:**
1. ALL EXISTING COMPONENTS LOCATED WITHIN SECTION 3 THAT ARE NO LONGER REQUIRED FOR THE PROPER OPERATION OF PUMP NO. 1 VFD SHALL BE REMOVED.
 2. LIGHTER LINE WEIGHT ITEMS ARE EXISTING.
 3. REFER TO SHEET E8, E10 AND E11 FOR NEW PUMP NO. 1 VFD WIRING DIAGRAM.

As-Built Drawings
Granger Maint. & Constr. Inc.
John H. Granger, President

John H. Granger 6/22/2022
Signature Date

No Changes

TRICON
CONSULTING ENGINEERS
777 S. Harbour Island Rd.
Suite 500
Tampa, FL 33602
813.227.2100
Professional of Public Health No. 8583

No.	DATE	REVISIONS
3		
2		
1		

DES: TDT
DRN: JLH
CKD: TDT
DATE: 11/21/16


CITY of TAMPA
WASTEWATER DEPARTMENT

UNIVERSITY P.S.
PUMP NO. 1 REPLACEMENT
SECTION 3 MODIFICATIONS


W.O. 4511
SHEET
E5
OF

TIMOTHY THOMAS, P.E. #47079

NO Changes
 J. Granger
 5/17/22

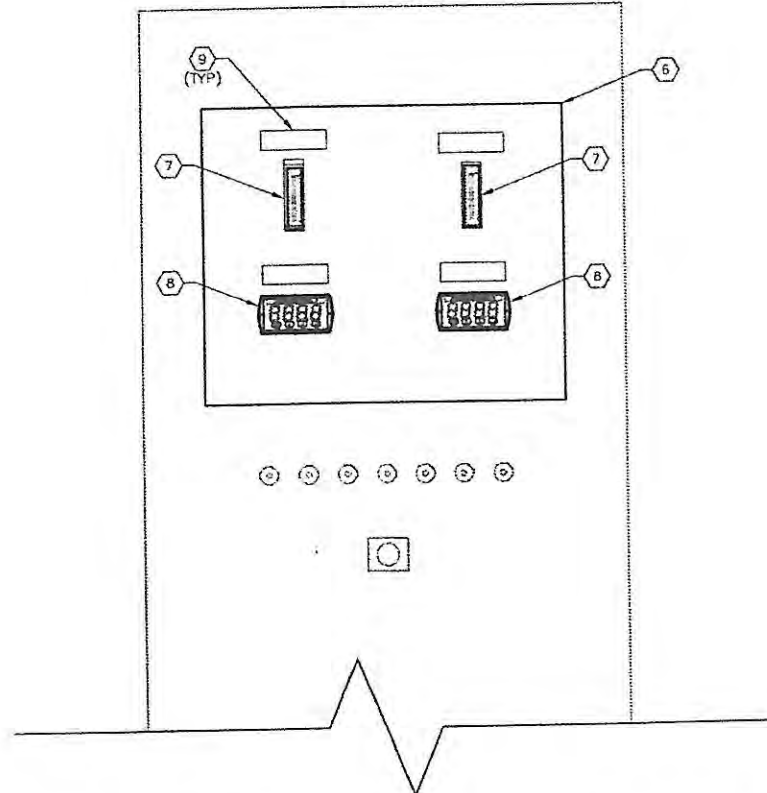

LIQUID LEVEL CONTROLS (LLC) FRONT ELEVATION
 SCALE : N.T.S.

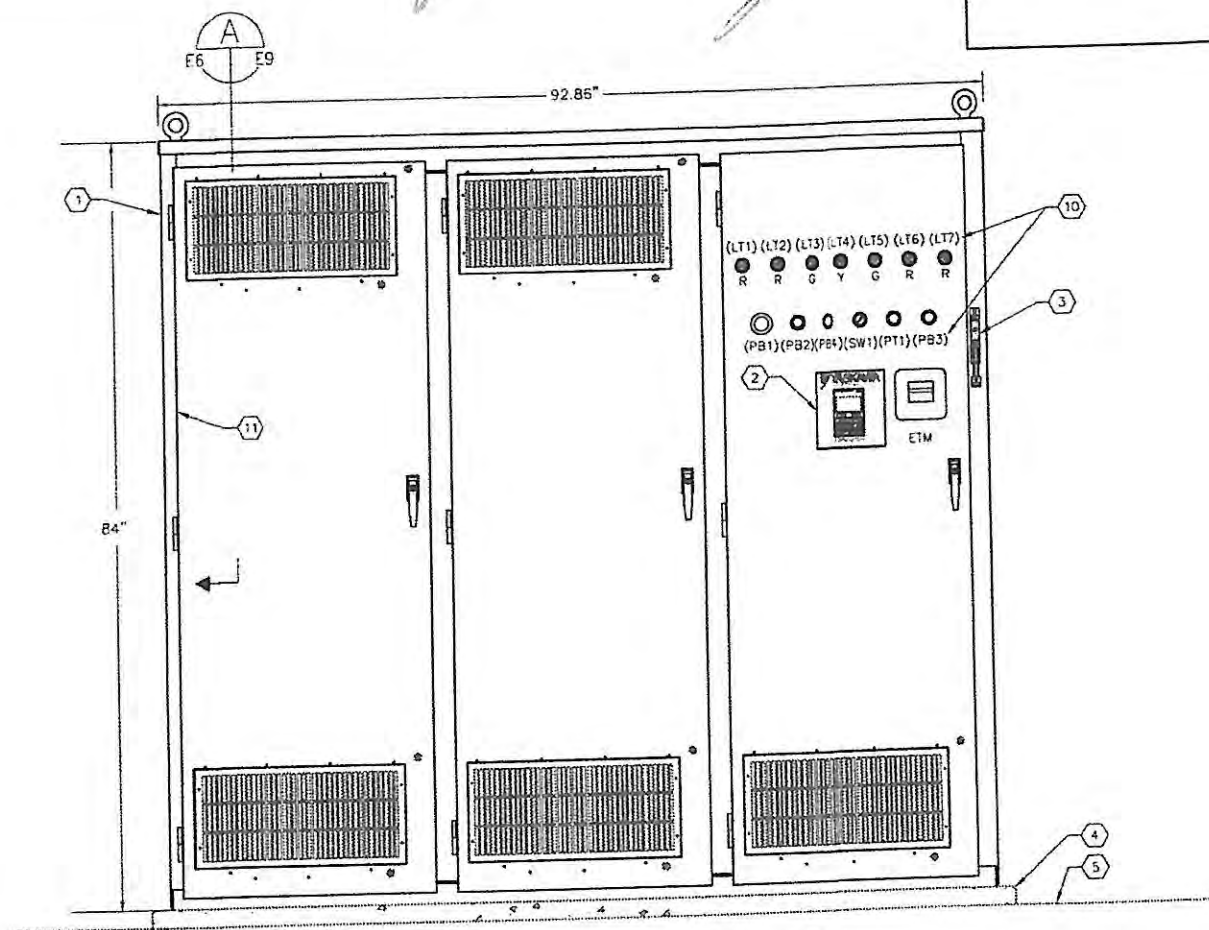

VFD FRONT ELEVATION
 SCALE : N.T.S.



- KEYED NOTES:**
- 1 NEW 400 HP VFD FOR SEWAGE PUMP NO. 1.
 - 2 VFD HMI.
 - 3 VFD MAIN CIRCUIT BREAKER OPERATOR
 - 4 CONTRACTOR TO PROVIDE AND INSTALL 2" HOUSEKEEPING PAD.
 - 5 EXISTING SLAB AT ELEVATION 41.25'.
 - 6 AFTER EXISTING DEVICES HAVE BEEN REMOVED (AS INDICATED ON SHEET E4) CONTRACTOR SHALL PROVIDE AND INSTALL 1/4" ALUMINUM PLATE OVER EXISTING CUT-OUTS. PAINT TO MATCH EXISTING SURFACE.
 - 7 CONTRACTOR TO PROVIDE AND INSTALL NEW OMEGA HORIZONTAL SCALE BAR GRAPH DISPLAY. OMEGA MODEL # BG-18-4-P7 (110V-50/60 HZ POWER SUPPLY). CONNECT UNIT TO NEW 120V (P40) CIRCUIT PROVIDED FOR NEW FLOW METER.
 - 8 CONTRACTOR TO PROVIDE AND INSTALL NEW PRECISION DIGITAL PROCESS METER. MODEL PD765-6X5-10. CONNECT UNIT TO NEW 120V (P40) CIRCUIT PROVIDED FOR NEW FLOW METER.
 - 9 PROVIDE AND INSTALL NEW LAMACOID NAMEPLATE (TYPICAL). LETTERING SHALL BE 1/2" MINIMUM AND SHALL MATCH EXISTING VERBIAGE. SECURE NAMEPLATE WITH STAINLESS STEEL SCREWS.
 - 10 REFER TO SHEETS E9, E10 AND E11 FOR DEVICE IDENTIFICATIONS.
 - 11 REFER TO SHEET E9 FOR VFD NO. 1 CONTROL PANEL DETAIL (CONTROL PANEL LOCATED IN THE INTERIOR OF VFD NO. 1 ON LEFT SIDE WALL OF ENCLOSURE)

As-Built Drawings
Granger Maint. & Constr. Inc.
John H. Granger, President

John H. Granger 6/22/2022
 Signature Date

No Changes



No.	DATE	REVISIONS
3		
2		
1		

TIMOTHY THOMAS, P.E. #47079


DES: TDT
 DRN: JLH
 CKD: TDT
 DATE: 11/21/16

CITY of TAMPA
 WASTEWATER DEPARTMENT

UNIVERSITY P.S.
PUMP NO. 1 REPLACEMENT
LLC AND VFD FRONT ELEVATIONS

W.O. 4511
 SHEET
E6
 OF

No Changes *Tricon* *5/17/22*

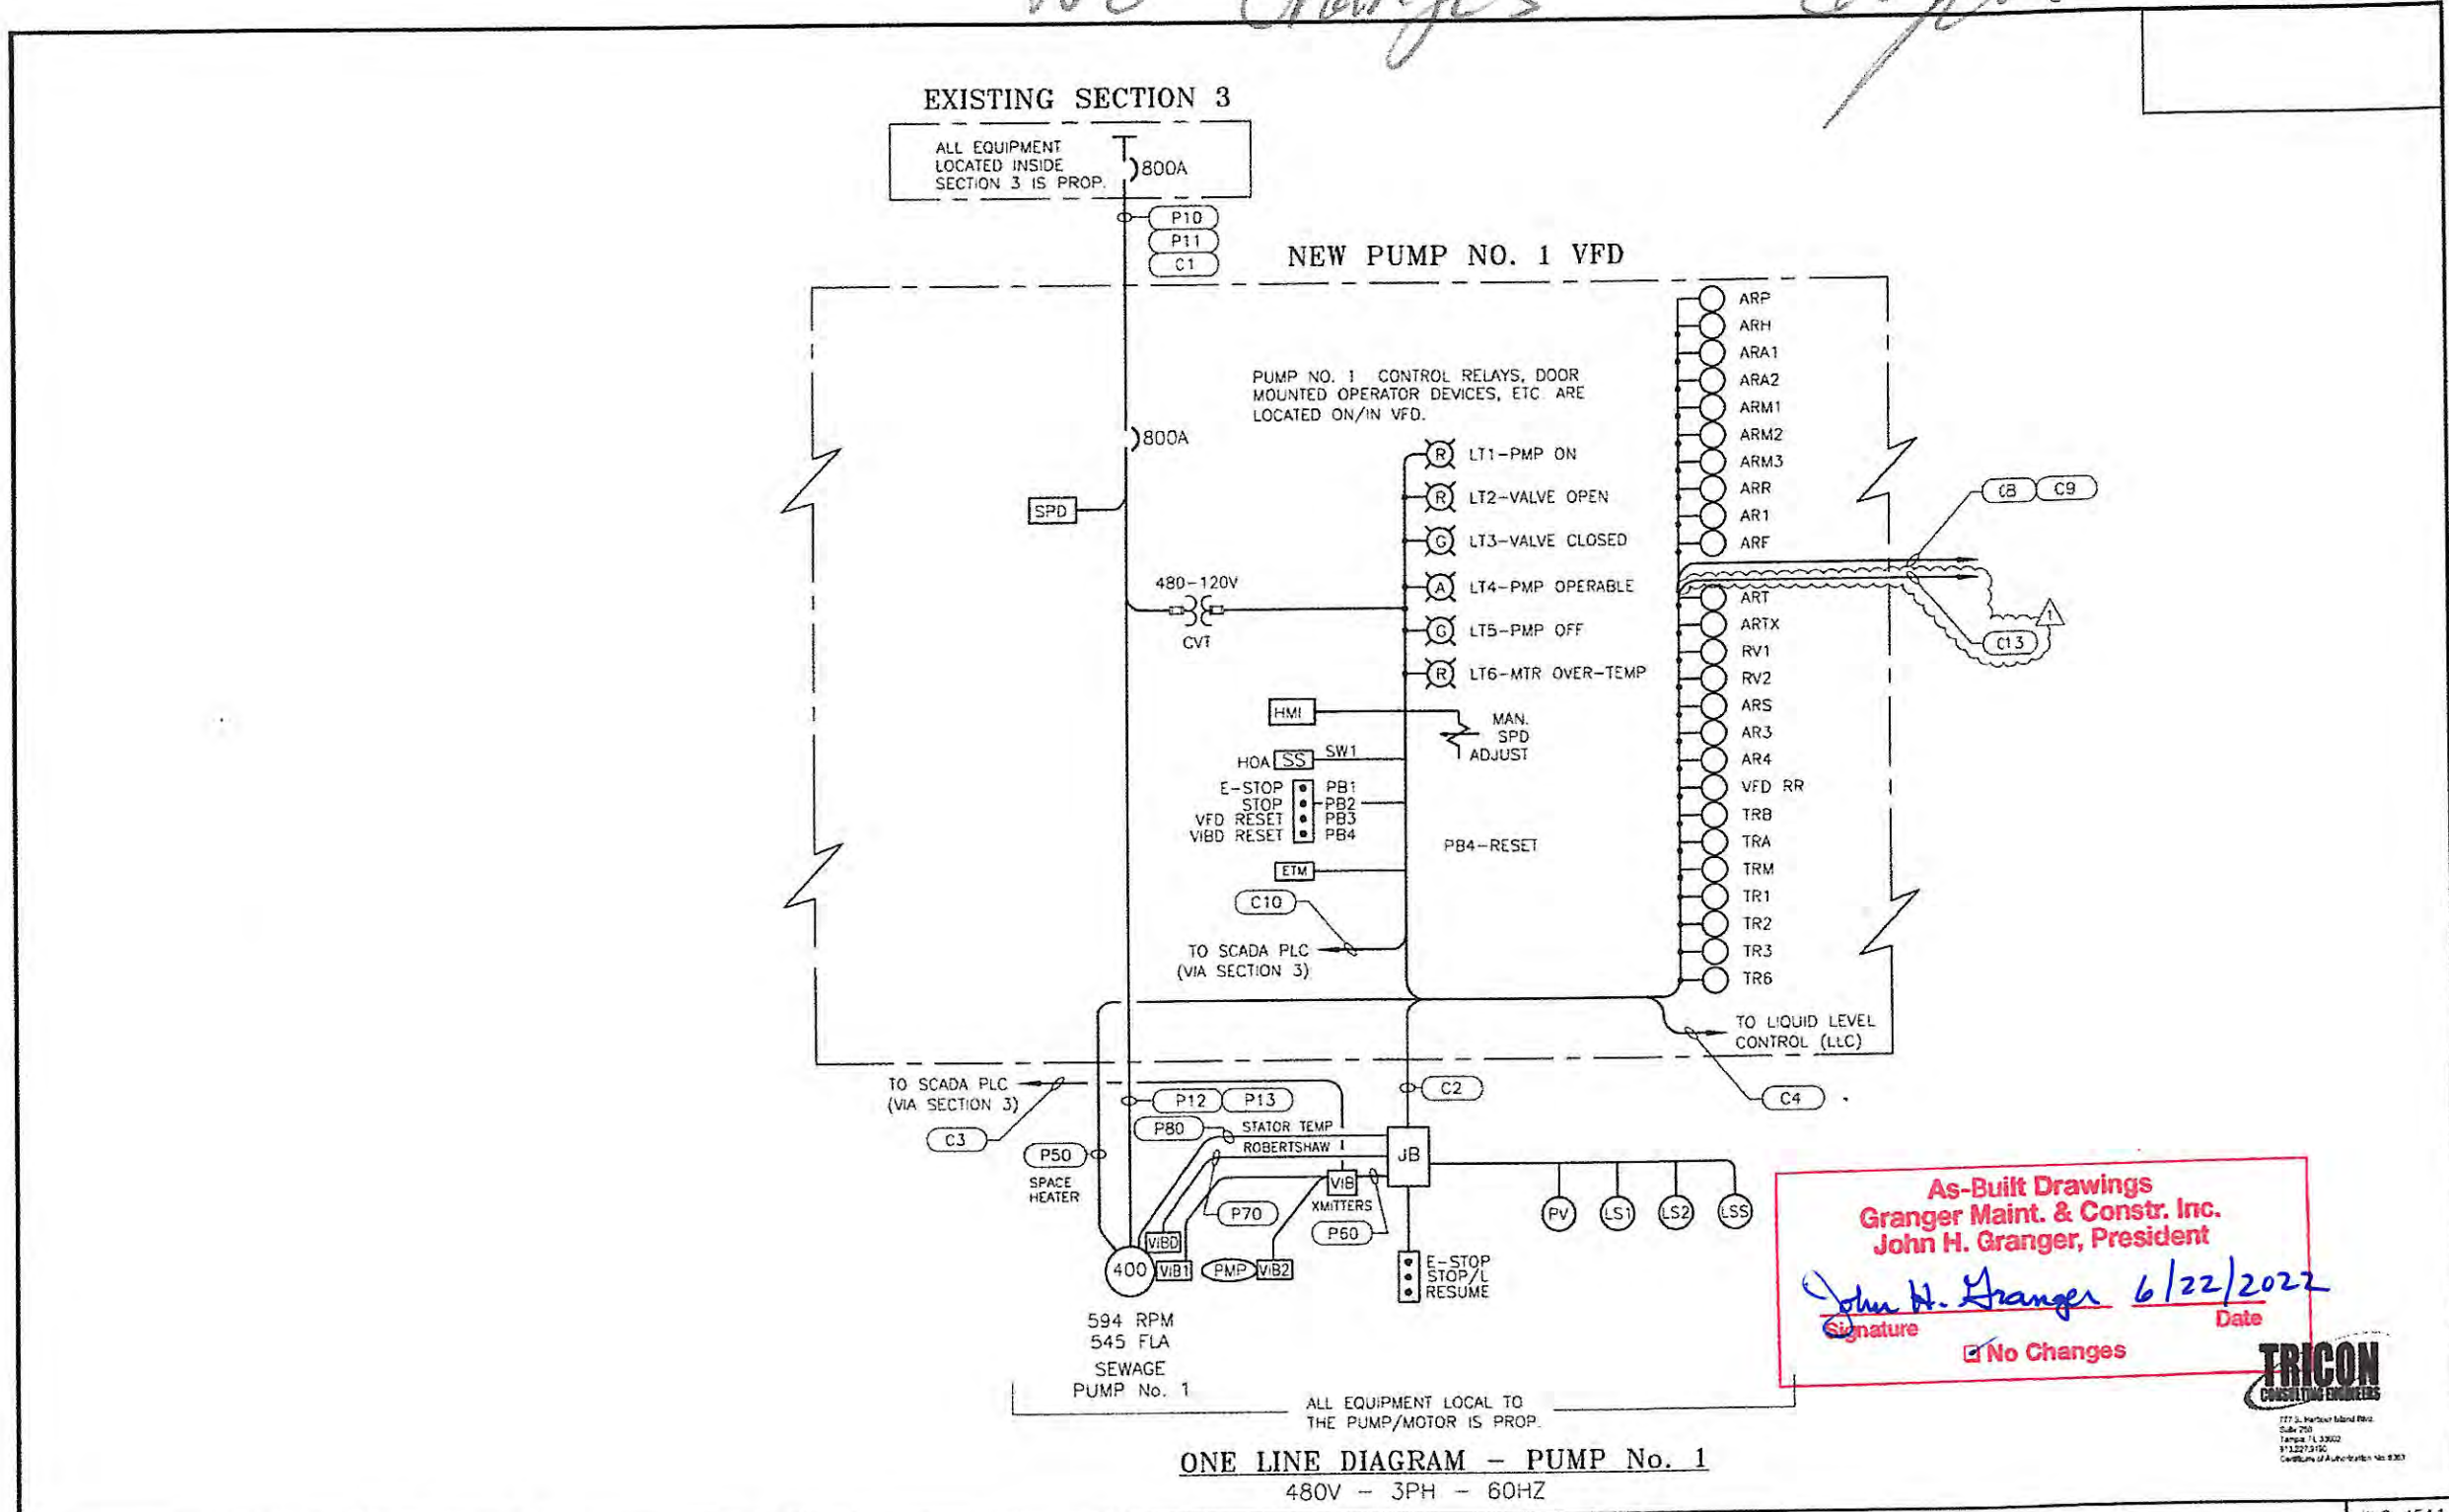


ONE LINE DIAGRAM - PUMP No. 1
480V - 3PH - 60HZ

TIMOTHY THOMAS, P.E. #47079	No.	DATE	REVISIONS	DES: TDT	CITY of TAMPA WASTEWATER DEPARTMENT	UNIVERSITY P.S. PUMP NO. 1 REPLACEMENT ELECTRICAL ONE-LINE DIAGRAM	W.O. 4511
	3			DRN: JLH			SHEET
	2			CKD: TDT			E7
	1	1-7-19	ACE3600 ADDITION REVISION	DATE: 11/21/16			OF

TRICON
CONSULTING ENGINEERS
777 S. Harbour Island Blvd.
Suite 200
Tampa, FL 33602
813.227.5150
Certificate of Public Health No. 0001

NO Changes *Trigon* 5/17/22

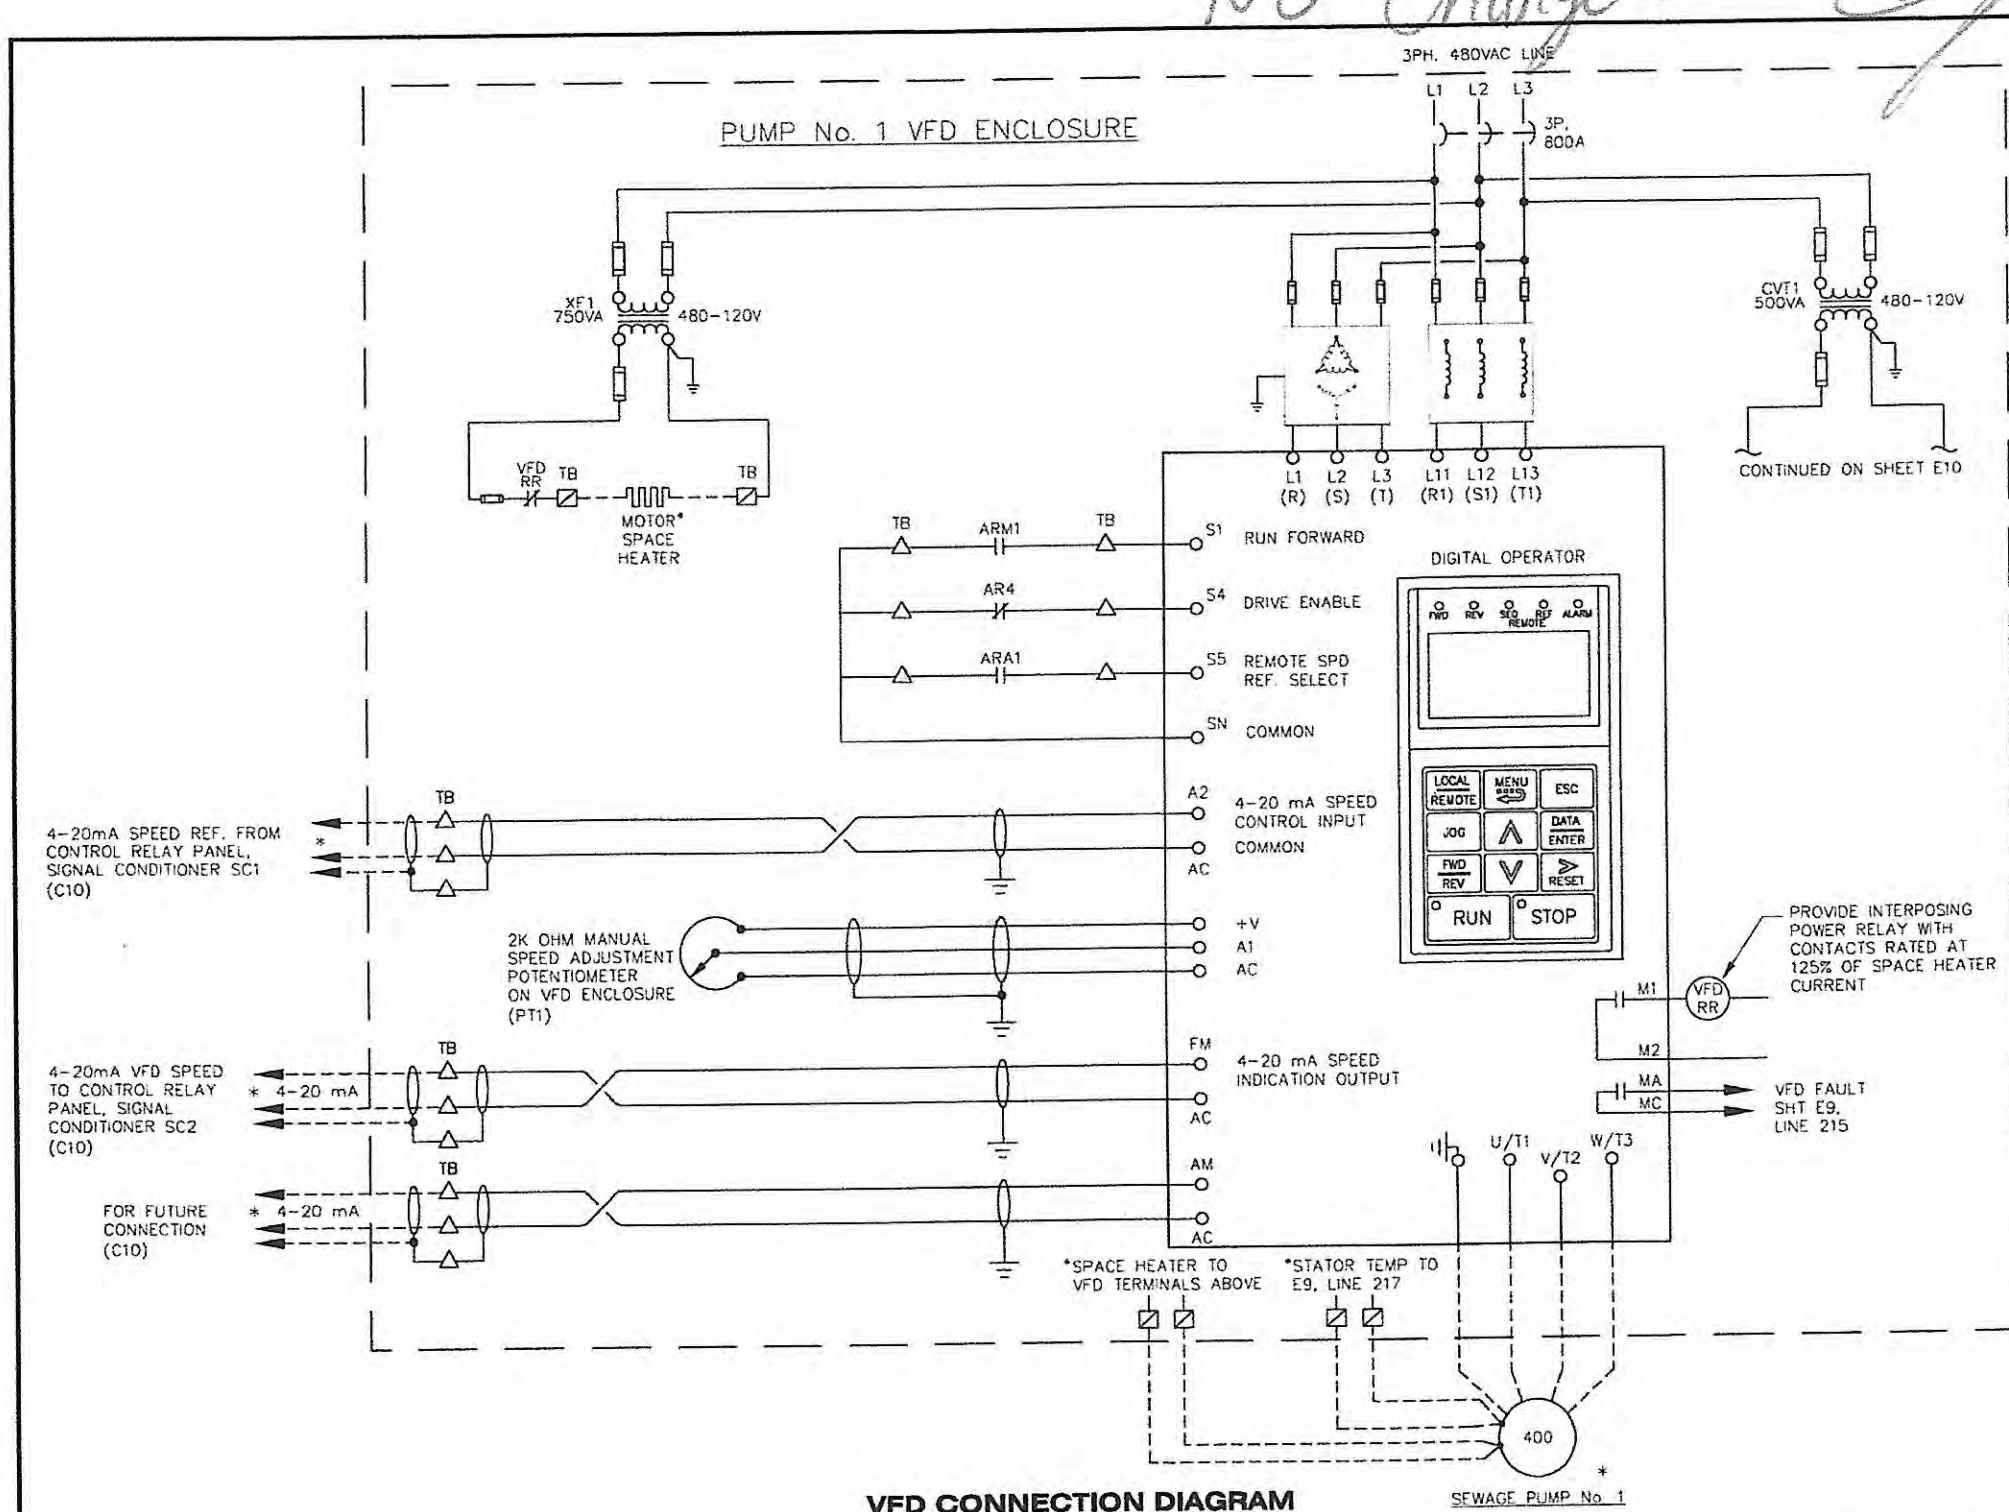

- NOTES:**
1. Δ - DENOTES FIELD CONNECTION TERMINALS LOCATED IN NEW PUMP No. 1 VFD.
 2. COORDINATE WITH EQUIPMENT MANUFACTURER WIRING DETAILS & SPECIFIC I/O CONNECTION POINTS.
 3. COORDINATE INSTRUMENTATION/CONTROL CONNECTIONS W/ CITY PERSONNEL.
 4. "*" INDICATES DEVICE IS LOCATED REMOTE FROM VARIABLE FREQUENCY DRIVE ENCLOSURE.
 5. PROVIDE AND INSTALL A YASKAWA IQ1000 VARIABLE FREQUENCY DRIVE WITH THE FOLLOWING RATINGS - 480VAC, 12-PULSE, 590AMP, 491 KVA, INPUT CONVERTER; 545AMP, 412 KVA, OUTPUT INVERTER.
 6. THE DIGITAL OPERATOR SHALL BE MOUNTED ON THE VFD ENCLOSURE FRONT DOOR AS SHOWN ON SHT. E2.
 7. \square - DENOTES FIELD CONNECTION TERMINALS LOCATED IN THE NEW PUMP No. 1 VFD.

As-Built Drawings
Granger Maint. & Constr. Inc.
John H. Granger, President

John H. Granger 6/22/2022
 Signature Date

No Changes



VFD CONNECTION DIAGRAM

SEWAGE PUMP No. 1


TIMOTHY THOMAS, P.E. #47079	No.	DATE	REVISIONS	DES: TDT	CITY of TAMPA WASTEWATER DEPARTMENT	UNIVERSITY P.S. PUMP NO. 1 REPLACEMENT ELECTRICAL - VFD INTERCONNECTIONS	W.O. 4511
	3			DRN: JLH			SHEET
	2			CKD: TDT			E8
	1			DATE: 11/21/16			OF

NO Changes

Trigon 3/17/22

SYMBOL	DESCRIPTION	MANUFACTURER/MODEL	REMARKS
CVT1	CONTROL VOLTAGE TRANSFORMER	SQUARE D/CLASS 9070-TF500D1	500VA, 120-480V
XF1	CONTROL VOLTAGE TRANSFORMER	SQUARE D/CLASS 9070-TF750D1	750VA, 120-480V
SP1, 2	SURGE SUPPRESSOR	PHOENIX CONTACT 2838186	24V DC SURGE PROTECTION DEVICE
LT1	LEGEND PLATE: MOTOR RUN	SQUARE D/CLASS 9001 SKT-38LRR9	RED LENS INDICATOR LIGHT 120 V, LED TYPE & PRESS TEST
LT2	LEGEND PLATE: VALVE OPEN	SQUARE D/CLASS 9001 SKT-38LRR9	RED LENS INDICATOR LIGHT 120 V, LED TYPE & PRESS TEST
LT3	LEGEND PLATE: VALVE CLOSED	SQUARE D/CLASS 9001 SKT-38LGG9	GREEN LENS INDICATOR LIGHT 120 V, LED TYPE & PRESS TEST
LT4	LEGEND PLATE: PUMP OPERABLE	SQUARE D/CLASS 9001 SKT-38LYY9	YELLOW LENS INDICATOR LIGHT 120 V, LED TYPE & PRESS TEST
LT5	LEGEND PLATE: PUMP OFF	SQUARE D/CLASS 9001 SKT-38LGG9	GREEN LENS INDICATOR LIGHT 120 V, LED TYPE & PRESS TEST
LT6	LEGEND PLATE: MOTOR OVERTEMP	SQUARE D/CLASS 9001 SKT-38LRR9	RED LENS INDICATOR LIGHT 120 V, LED TYPE & PRESS TEST
LT7	LEGEND PLATE: VIBRATION	SQUARE D/CLASS 9001 SKT-38LRR9	RED LENS INDICATOR LIGHT 120 V, LED TYPE & PRESS TEST
PB1	LEGEND PLATE: EMERGENCY STOP	SQUARE D/CLASS 9001 SKR-4RH13	RED MUSHROOM HEAD PUSH BUTTON 1-3/8" DIAMETER
PB2	LEGEND PLATE: STOP	SQUARE D/CLASS 9001 SKR-1R W/ (2) KA2 CONTACTS	RED FLUSH HEAD PUSH BUTTON
PB3	LEGEND PLATE: DRIVE RESET	SQUARE D/CLASS 9001 SKR-1B W/ (2) KA2 CONTACTS	BLACK FLUSH HEAD PUSH BUTTON
PB4	LEGEND PLATE: VIBO RESET	SQUARE D/CLASS 9001 SKR-1B W/ (2) KA2 CONTACTS	BLACK FLUSH HEAD PUSH BUTTON
SW1	LEGEND PLATE: OFF AUTO HAND	SQUARE D/CLASS 9001 SKS43BH2 W/ KA5, KA4 AND KA2 CONTACTS	THREE POSITION SWITCH MAINTAINED WITH AUTO-HAND OVERLAP
PT1	MANUAL SPEED ADJUST	HONEYWELL #73JA2K POT AND BOURNS #H-46-6A DIAL	10-TURN POTENTIOMETER W/TURNS COUNTING DIAL
ETM	ELAPSED TIME METER	GARASSLIN/INTERMATIC, INC LWZ SERIES UWZ48	PROVIDE SOCKET BASE
AR P, H, A1, A2, M1, M2, M3, M, R, I, F, T, TX, RV1, RV2, S, 3, 4, VR1 AND VFD RR	CONTROL RELAYS	SQUARE D 120V AC RELAY	PROVIDE 120V AC RELAY BASE SQUARE D RP2F4
TR 1, 2, 3 A, B, M	TIMING DELAY "ON DELAY"	ABB TRU3 120V AC TIMER RELAY	PROVIDE ABB NDS-11 TIMER BASE
TR6	TIMING DELAY "OFF DELAY"	ABB TRU3 120V AC TIMER RELAY	PROVIDE ABB NDS-11 TIMER BASE

PUMP NO. 1 CONTROLS PARTS SCHEDULE
(SCHEMATICS ON SHEETS E10 - E11)

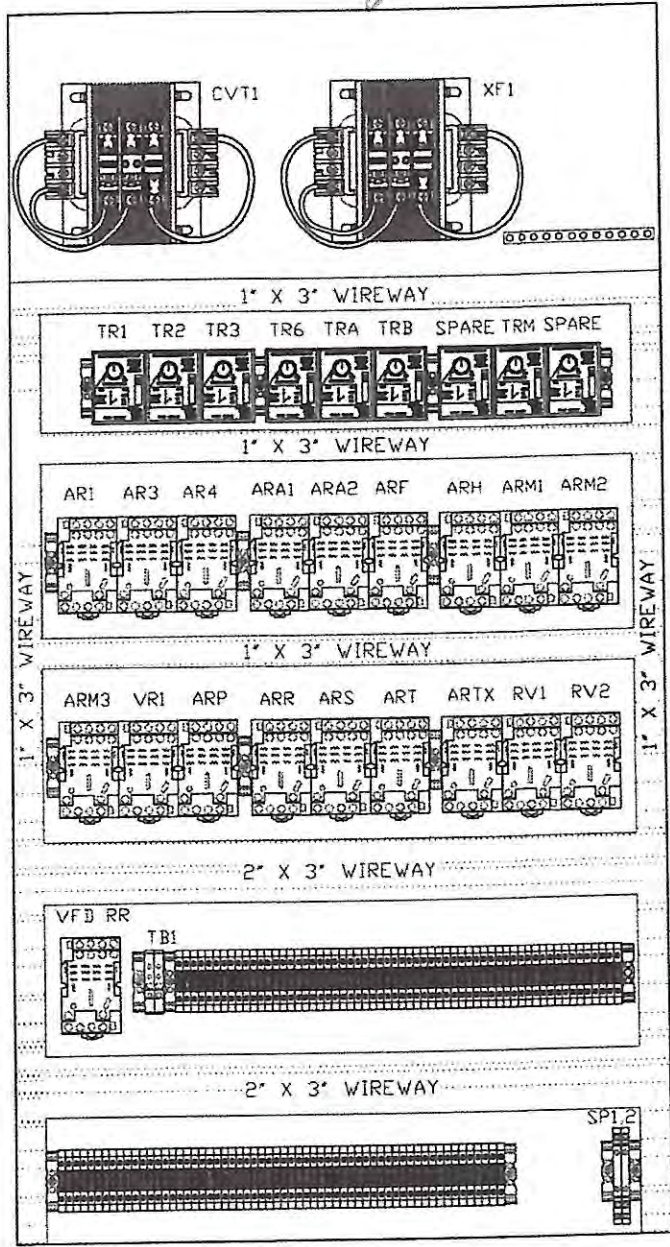

DETAIL 1, PUMP NO. 1 PROPOSED CONTROLS LAYOUT
SCALE: N.T.S.

NOTE: CONTROLS SHALL BE PLACED IN THE ORDER AS SHOWN. CONTROL PANEL TO BE INSTALLED IN NEW PUMP NO. 1 VFD

- GENERAL NOTES:**
- SCOPE OF WORK REQUIRES THE REMOVAL OF ALL EXISTING TRANSFORMERS, RELAYS, WIREWAY, ETC CURRENTLY USED FOR PUMP NO. 1 SPEED CONTROLS. THE EXISTING COMPONENTS FOR THE PUMP NO. 1 SPEED CONTROLS ARE LOCATED IN CUBICLE 4A OF THE PUMP CONTROL CENTER. CONTRACTOR SHALL PROVIDE NEW BACKPANEL AND COMPONENTS AS SHOWN AND FOLLOW THE SCHEMATIC DIAGRAMS ON SHEETS E10 AND E11. THE NEW CONTROL PANEL SHALL BE INSTALLED IN THE PROPOSED VFD CABINET LOCATED TO THE EAST. ALL PILOT DEVICES AND VFM HMI SHALL BE MOUNTED ON THE VFD DOOR AS SHOWN ON SHEET E6.
 - PROVIDE TERMINAL BLOCKS, SQUARE D TYPE 3004362 AS REQUIRED.
 - PROVIDE TERMINAL JUMPERS, PHOENIX CONTACT 0203519 AS REQUIRED.
 - PROVIDE END CLAMPS, PHOENIX CONTACT 0800866 AS REQUIRED.
 - PROVIDE TERMINAL END COVERS, PHOENIX CONTACT 3003020 AS REQUIRED.
 - PROVIDE PRIMARY FUSES, BUSSMAN FNQR-3 AS REQUIRED.
 - PROVIDE SECONDARY FUSES, BUSSMAN FNQ-7 AS REQUIRED.
 - ALL DIN RAIL SHALL BE ALUMINUM.
 - MOTOR SPACE HEATER RELAY (VFD RR) SHALL BE LOCATED IN THE VFD ENCLOSURE AS SHOWN.

As-Built Drawings
Granger Maint. & Constr. Inc.
John H. Granger, President

John H. Granger 6/22/2022
Signature Date

No Changes

No.	DATE	REVISIONS
3		
2		
1		

TIMOTHY THOMAS, P.E. #47079

DES: TOT
DRN: JLH
CKD: TOT
DATE: 11/21/16

CITY of TAMPA
WASTEWATER DEPARTMENT

UNIVERSITY P.S.
PUMP NO. 1 REPLACEMENT
PUMP NO. 1 CONTROL PANEL


W.O. 4511
SHEET
E9
OF



NO CHANGES

[Handwritten Signature]

5/17/22

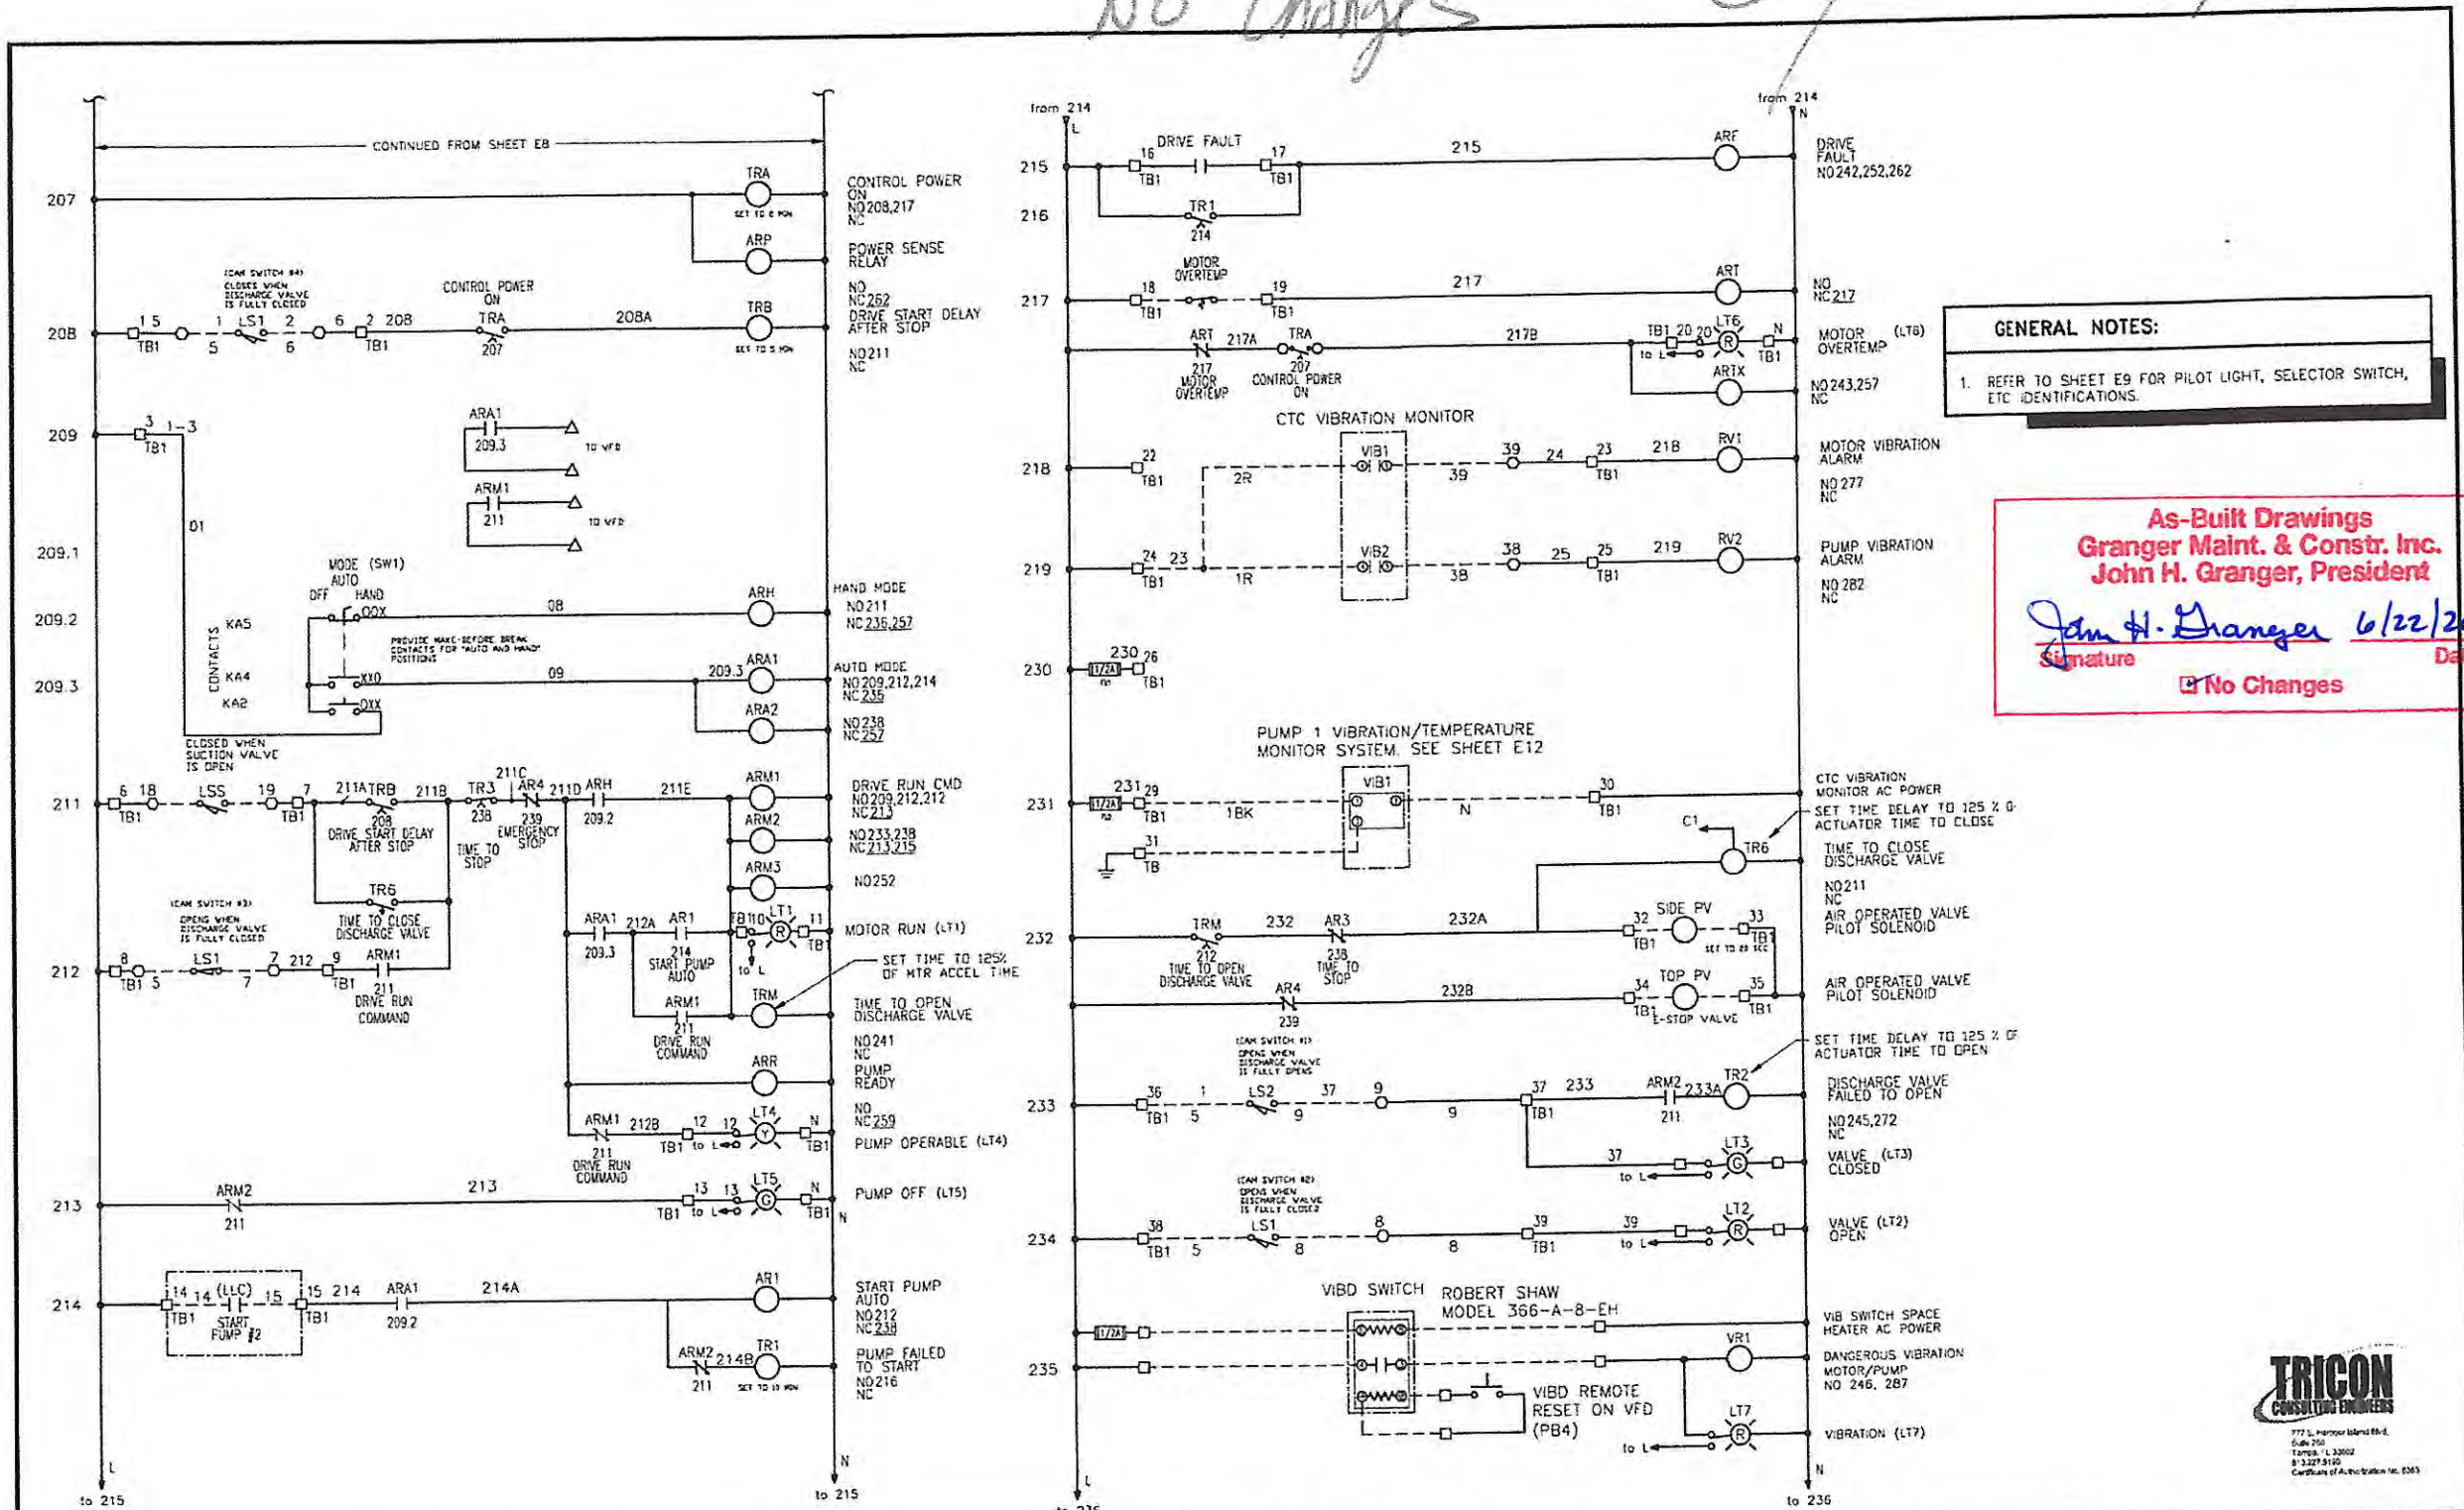


GENERAL NOTES:
 1. REFER TO SHEET E9 FOR PILOT LIGHT, SELECTOR SWITCH, ETC IDENTIFICATIONS.

As-Built Drawings
Granger Maint. & Constr. Inc.
John H. Granger, President
John H. Granger 6/22/2022
 Signature Date
 No Changes



TIMOTHY THOMAS, P.E. #47079	No.	DATE	REVISIONS	DES: TDT	CITY of TAMPA WASTEWATER DEPARTMENT	UNIVERSITY P.S. PUMP NO. 1 REPLACEMENT PUMP NO. 1 CONTROLS (SHT. 1 OF 3)	W.O. 4511
	3			DRN: JLH			SHEET
	2			CKD: TDT			E10
	1			DATE: 11/21/16			OF


NO Change *Truman* 5/17/22

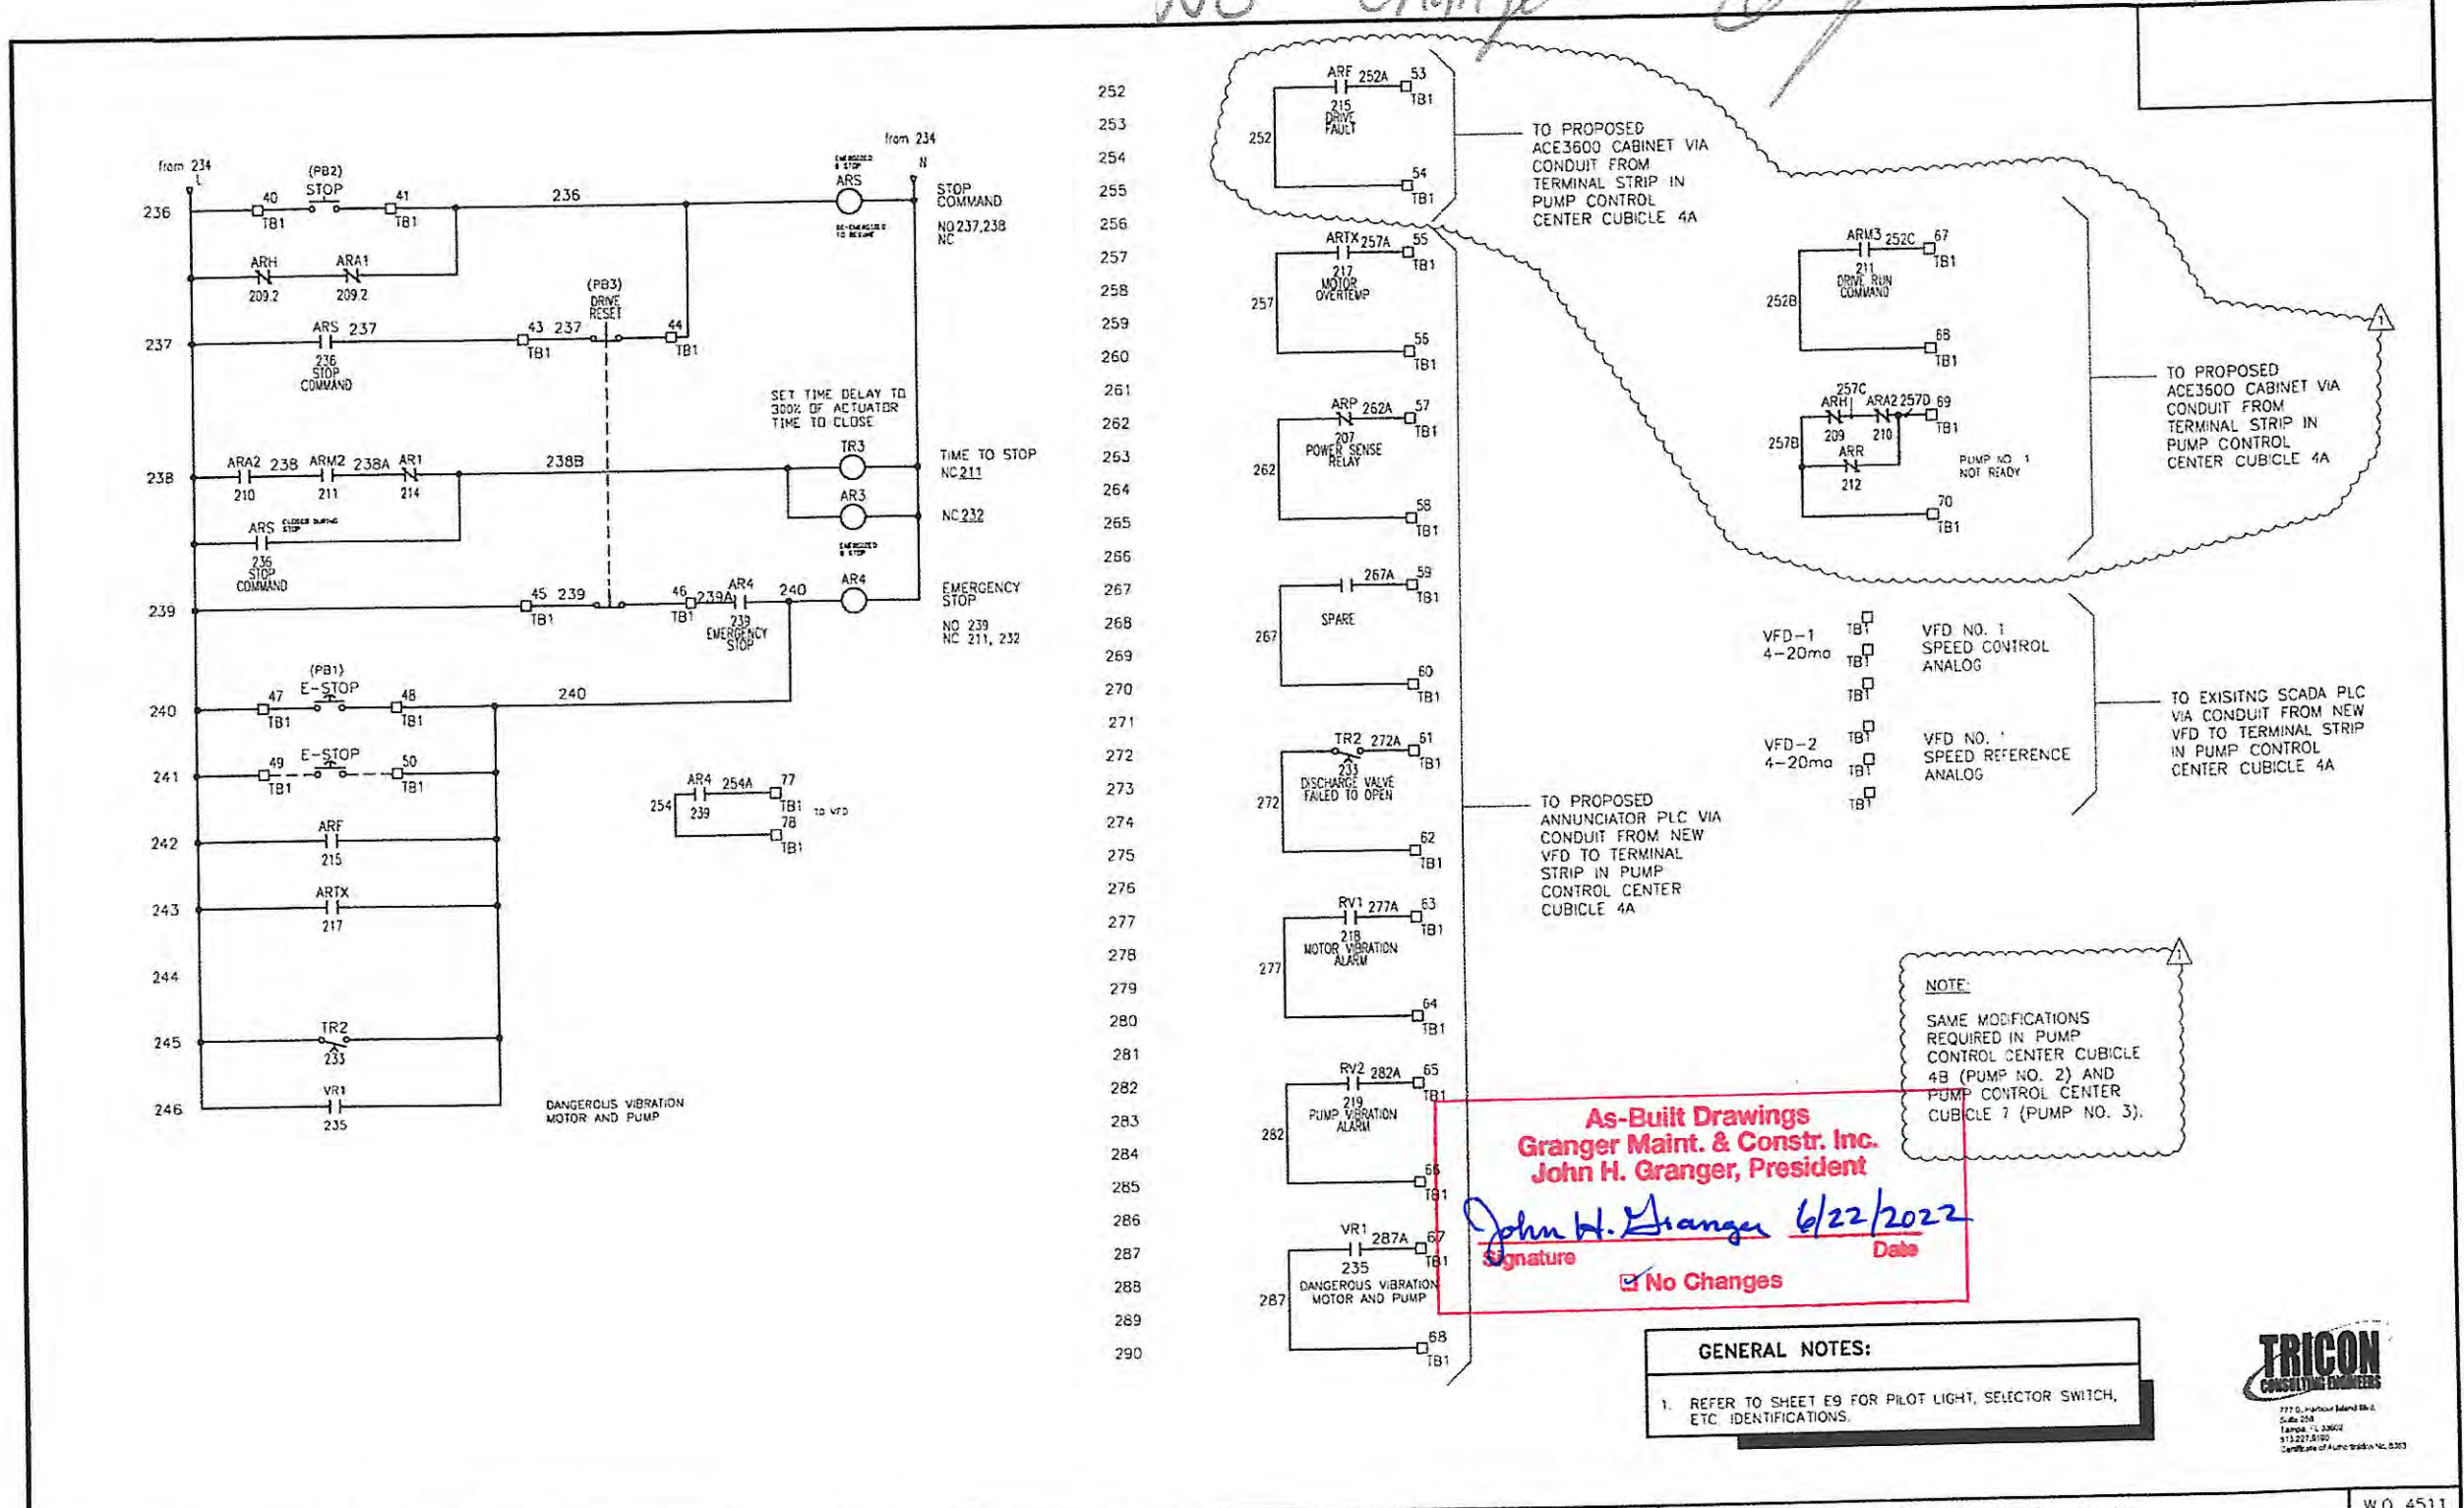

No.	DATE	REVISIONS	DES: TDT	CITY of TAMPA WASTEWATER DEPARTMENT	UNIVERSITY P.S. PUMP NO. 1 REPLACEMENT PUMP NO. 1 CONTROLS (SHT. 2 OF 3)	W.O. 4511 SHEET E11 OF
3			DRN: JLH			
2			CKD: TDT			
1	1-7-19	ACE3600 ADDITION REVISION	DATE: 11/21/16			



NO Changes
[Signature]
 5/17/22

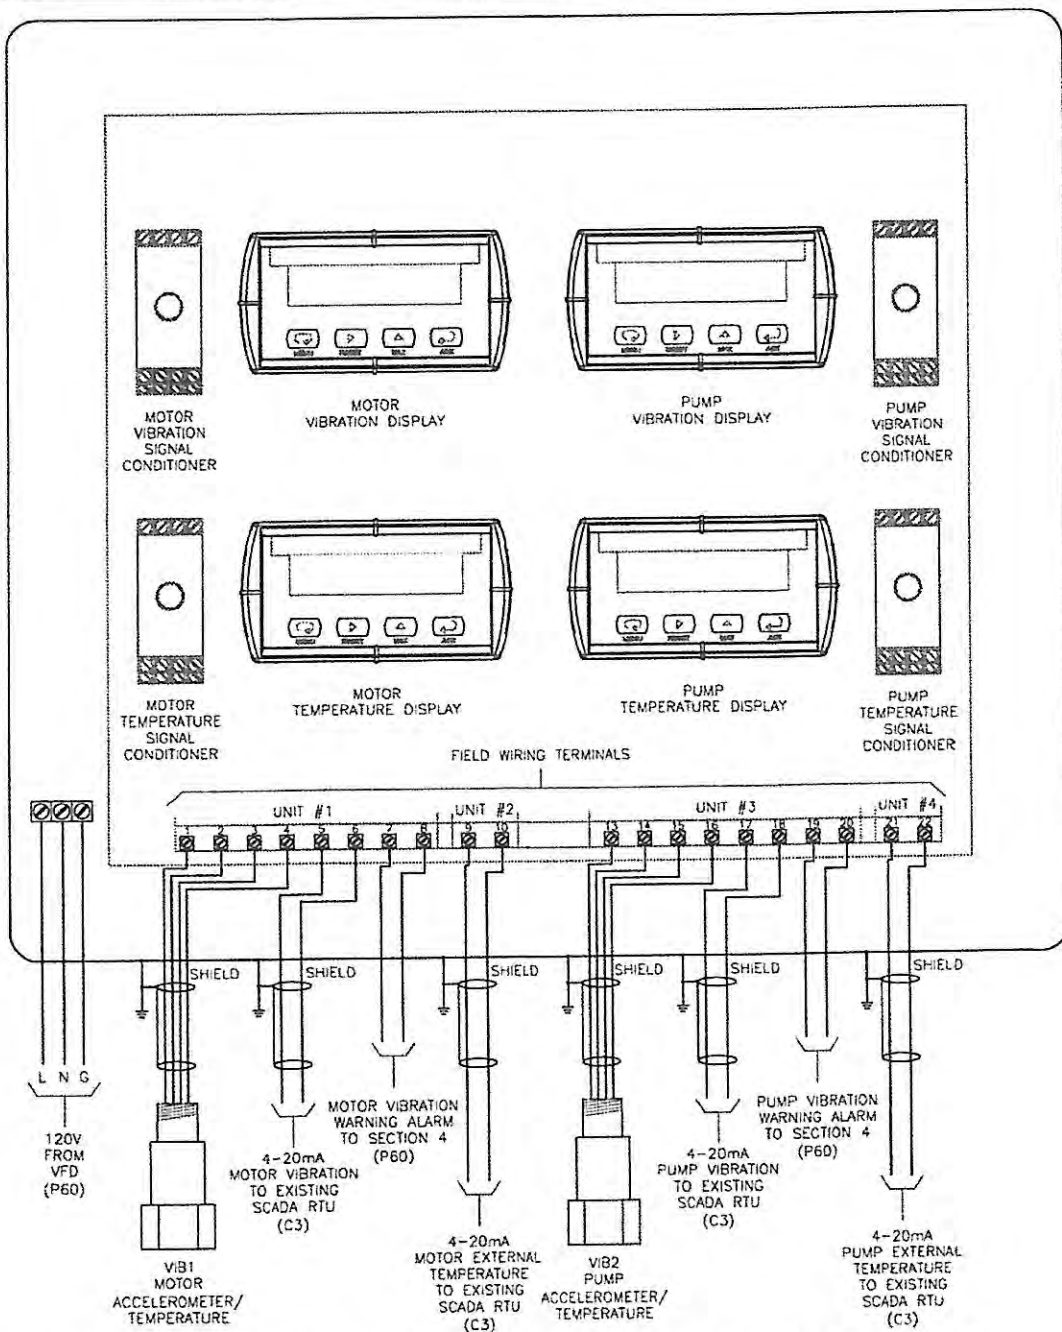

UNIT No.	TERMINAL No.	TA102 CONDUCTOR	COLOR	REMARKS
UNIT No 1	1	Ain +	RED	MOTOR VIBRATION INPUT
UNIT No 1	2	Ain -	BLACK	COMMON
UNIT No 1	3	Ain	SILVER	GROUND
UNIT No. 1	4	Ain	WHITE	MOTOR TEMPERATURE INPUT
UNIT No. 1	5			MOTOR VIBRATION 4-20mA OUTPUT
UNIT No 1	6			MOTOR VIBRATION 4-20mA OUTPUT
UNIT No. 1	7			MOTOR VIBRATION ALARM NO CONTACT
UNIT No 1	8			MOTOR VIBRATION ALARM COMMON
UNIT No 2	9			MOTOR TEMPERATURE 4-20mA OUTPUT
UNIT No 2	10			MOTOR TEMPERATURE 4-20mA OUTPUT
UNIT No. 3	13	Ain +	RED	PUMP VIBRATION INPUT
UNIT No. 3	14	Ain -	BLACK	COMMON
UNIT No. 3	15	Ain	SILVER	GROUND
UNIT No 3	16	Ain	WHITE	PUMP TEMPERATURE INPUT
UNIT No. 3	17			PUMP VIBRATION 4-20mA OUTPUT
UNIT No. 3	18			PUMP VIBRATION 4-20mA OUTPUT
UNIT No. 3	19			PUMP VIBRATION ALARM NO CONTACT
UNIT No. 3	20			PUMP VIBRATION ALARM COMMON
UNIT No. 4	21			PUMP TEMPERATURE 4-20mA OUTPUT
UNIT No 4	22			PUMP TEMPERATURE 4-20mA OUTPUT

CTC VIBRATION MONITOR - CTC MODEL # VPR-1002SDO-BB

THE PUMP / MOTOR SUPPLIER SHALL PROVIDE THE SPECIFIED VIBRATION MONITORING EQUIPMENT AND INSTALL THE ACCELEROMETERS/TEMPERATURE SENSORS VIB1 AND VIB2 (CTC MODEL # TA102 EACH) ON THE MACHINERY AS REQUIRED. THE SIGNAL CONDITIONERS AND DISPLAYS SHALL BE INSTALLED IN A COMMON FIBERGLASS ENCLOSURE MOUNTED NEAR THE MACHINERY AND WIRED AS REQUIRED BY THE ELECTRICAL SUBCONTRACTOR.

As-Built Drawings
Granger Maint. & Constr. Inc.
John H. Granger, President
John H. Granger 6/22/2022
 Signature Date
 No Changes




TIMOTHY THOMAS, P.E. #47079	No.	DATE	REVISIONS	DES: TDT	CITY of TAMPA WASTEWATER DEPARTMENT	UNIVERSITY P.S. PUMP NO. 1 REPLACEMENT PUMP NO. 1 CONTROLS (SHT. 3 OF 3)	W.O. 4511
	3			DRN: JLH			SHEET
	2			CKD: TDT			E12
	1			DATE: 11/21/16			of

NO Changes 5/17/22

SYMBOL	DESCRIPTION	MANUFACTURER/MODEL	REMARKS
CVT1	CONTROL VOLTAGE TRANSFORMER	SQUARE D/CLASS 9070-TF500D1	500VA, 120-480V
XF1	CONTROL VOLTAGE TRANSFORMER	SQUARE D/CLASS 9070-TF750D1	750VA, 120-480V
SP1, 2	SURGE SUPPRESSOR	PHOENIX CONTACT 28391B6	24V DC SURGE PROTECTION DEVICE
LT1	LEGEND PLATE: MOTOR RUN	SQUARE D/CLASS 9001 SKT-38LRR9	RED LENS INDICATOR LIGHT 120 V, LED TYPE & PRESS TEST
LT2	LEGEND PLATE: VALVE OPEN	SQUARE D/CLASS 9001 SKT-38LRR9	RED LENS INDICATOR LIGHT 120 V, LED TYPE & PRESS TEST
LT3	LEGEND PLATE: VALVE CLOSED	SQUARE D/CLASS 9001 SKT-38LGG9	GREEN LENS INDICATOR LIGHT 120 V, LED TYPE & PRESS TEST
LT4	LEGEND PLATE: PUMP OPERABLE	SQUARE D/CLASS 9001 SKT-38LYY9	YELLOW LENS INDICATOR LIGHT 120 V, LED TYPE & PRESS TEST
LT5	LEGEND PLATE: PUMP OFF	SQUARE D/CLASS 9001 SKT-38LGG9	GREEN LENS INDICATOR LIGHT 120 V, LED TYPE & PRESS TEST
LT6	LEGEND PLATE: MOTOR OVERTEMP	SQUARE D/CLASS 9001 SKT-38LRR9	RED LENS INDICATOR LIGHT 120 V, LED TYPE & PRESS TEST
PB1	LEGEND PLATE: EMERGENCY STOP	SQUARE D/CLASS 9001 SKR-4RH13	RED MUSHROOM HEAD PUSH BUTTON 1-3/8" DIAMETER
PB2	LEGEND PLATE: STOP	SQUARE D/CLASS 9001 SKR-1R W/ (2) KA2 CONTACTS	RED FLUSH HEAD PUSH BUTTON
PB3	LEGEND PLATE: DRIVE RESET	SQUARE D/CLASS 9001 SKR-1B W/ (2) KA2 CONTACTS	BLACK FLUSH HEAD PUSH BUTTON
SW1	LEGEND PLATE: OFF AUTO HAND	SQUARE D/CLASS 9001 SKS43BH2 W/ KA5, KA4 AND KA2 CONTACTS	THREE POSITION SWITCH MAINTAINED WITH AUTO-HAND OVERLAP
PT1	MANUAL SPEED ADJUST	HONEYWELL #73JA2K POT AND BOURNS #H-46-6A DIAL	10-TURN POTENTIOMETER W/TURNS COUNTING DIAL
ETM	ELAPSED TIME METER	GARASSLIN/INTERMATIC, INC. LWZ SERIES LWZ48	PROVIDE SOCKET BASE
(AR) P, H, A1, A2, M1, M2, M3, M, R, 1, F, T, TX, RV1, RV2, S, 3, 4, AND VFD RR	CONTROL RELAYS	SQUARE D 120V AC RELAY	PROVIDE 120V AC RELAY BASE SQUARE D RPZF4
(TR) 1, 2, 3 A, B, M	TIMING DELAY "ON DELAY"	ABB TRU3 120V AC TIMER RELAY	PROVIDE ABB NDS-11 TIMER BASE
	TIMING DELAY "OFF DELAY"	ABB TRU3 120V AC TIMER RELAY	PROVIDE ABB NDS-11 TIMER BASE

SECTION 4B, PUMP NO. 2 CONTROLS PARTS SCHEDULE
(SCHEMATICS ON SHEETS E14 - E15)

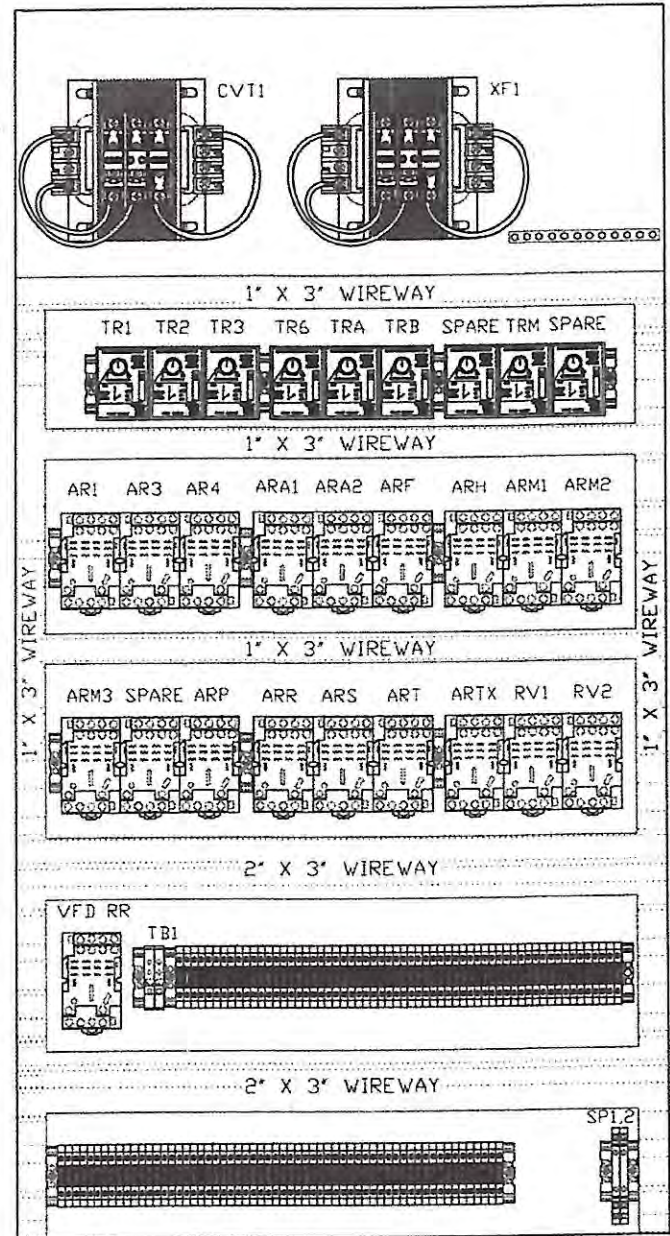

**DETAIL 1. PUMP NO. 2
PROPOSED CONTROLS LAYOUT**
NOTE: CONTROLS SHALL BE PLACED IN
THE ORDER AS SHOWN

- GENERAL NOTES:**
- SCOPE OF WORK REQUIRES THE REMOVAL OF ALL EXISTING TRANSFORMERS, RELAYS, WIREWAY, ETC. CURRENTLY USED FOR PUMP NO. 2 VFD CONTROLS. THE EXISTING COMPONENTS FOR THE PUMP NO. 2 VFD CONTROLS ARE LOCATED IN CUBICLE 4B OF THE PUMP CONTROL CENTER. CONTRACTOR SHALL PROVIDE NEW BACKPANEL AND COMPONENTS AS SHOWN. ALL CONTROL CONDUCTORS INTERIOR TO THE CUBICLE AND INSTALLED TO THE PUMP NO. 2 VFD (LOCATED IN ADJACENT SECTION 5) SHALL BE NEW. CONDUCTORS CURRENTLY INSTALLED TO FIELD DEVICES (LIMIT SWITCHES, VIBRATION TRANSMITTER POWER/RELAY CONTACTS, E-STOP AT MOTOR, ETC.) SHALL BE REUSED. NEW PILOT LIGHTS, SELECTOR SWITCHES, ETC. SHALL BE PROVIDED AND INSTALLED ON THE FRONT DOOR OF SECTION 5.
 - PROVIDE TERMINAL BLOCKS, SQUARE D TYPE 3004362 AS REQUIRED.
 - PROVIDE TERMINAL JUMPERS, PHOENIX CONTACT 0203519 AS REQUIRED.
 - PROVIDE END CLAMPS, PHOENIX CONTACT 0800886 AS REQUIRED.
 - PROVIDE TERMINAL END COVERS, PHOENIX CONTACT 3003020 AS REQUIRED.
 - PROVIDE PRIMARY FUSES, BUSSMAN FNQR-3 AS REQUIRED.
 - PROVIDE SECONDARY FUSES, BUSSMAN FNQ-7 AS REQUIRED.
 - ALL DIN RAIL SHALL BE ALUMINUM.
 - MOTOR SPACE HEATER RELAY (VFD RR) SHALL BE LOCATED IN THIS CUBICLE AS SHOWN.

As-Built Drawings
Granger Maint. & Constr. Inc.
John H. Granger, President

John H. Granger 6/22/2022
Signature Date

No Changes



No.	DATE	REVISIONS
3		
2		
1		

TIMOTHY THOMAS, P.E. #47079

DES: TDT
DRN: JLH
CKD: TDT
DATE: 11/21/16


CITY of TAMPA
WASTEWATER DEPARTMENT

UNIVERSITY P.S.
PUMP NO. 1 REPLACEMENT
PUMP NO. 2 CONTROL PANEL

W.O. 4511
SHEET
E13
OF

No Changes

Trigon
3/17/22

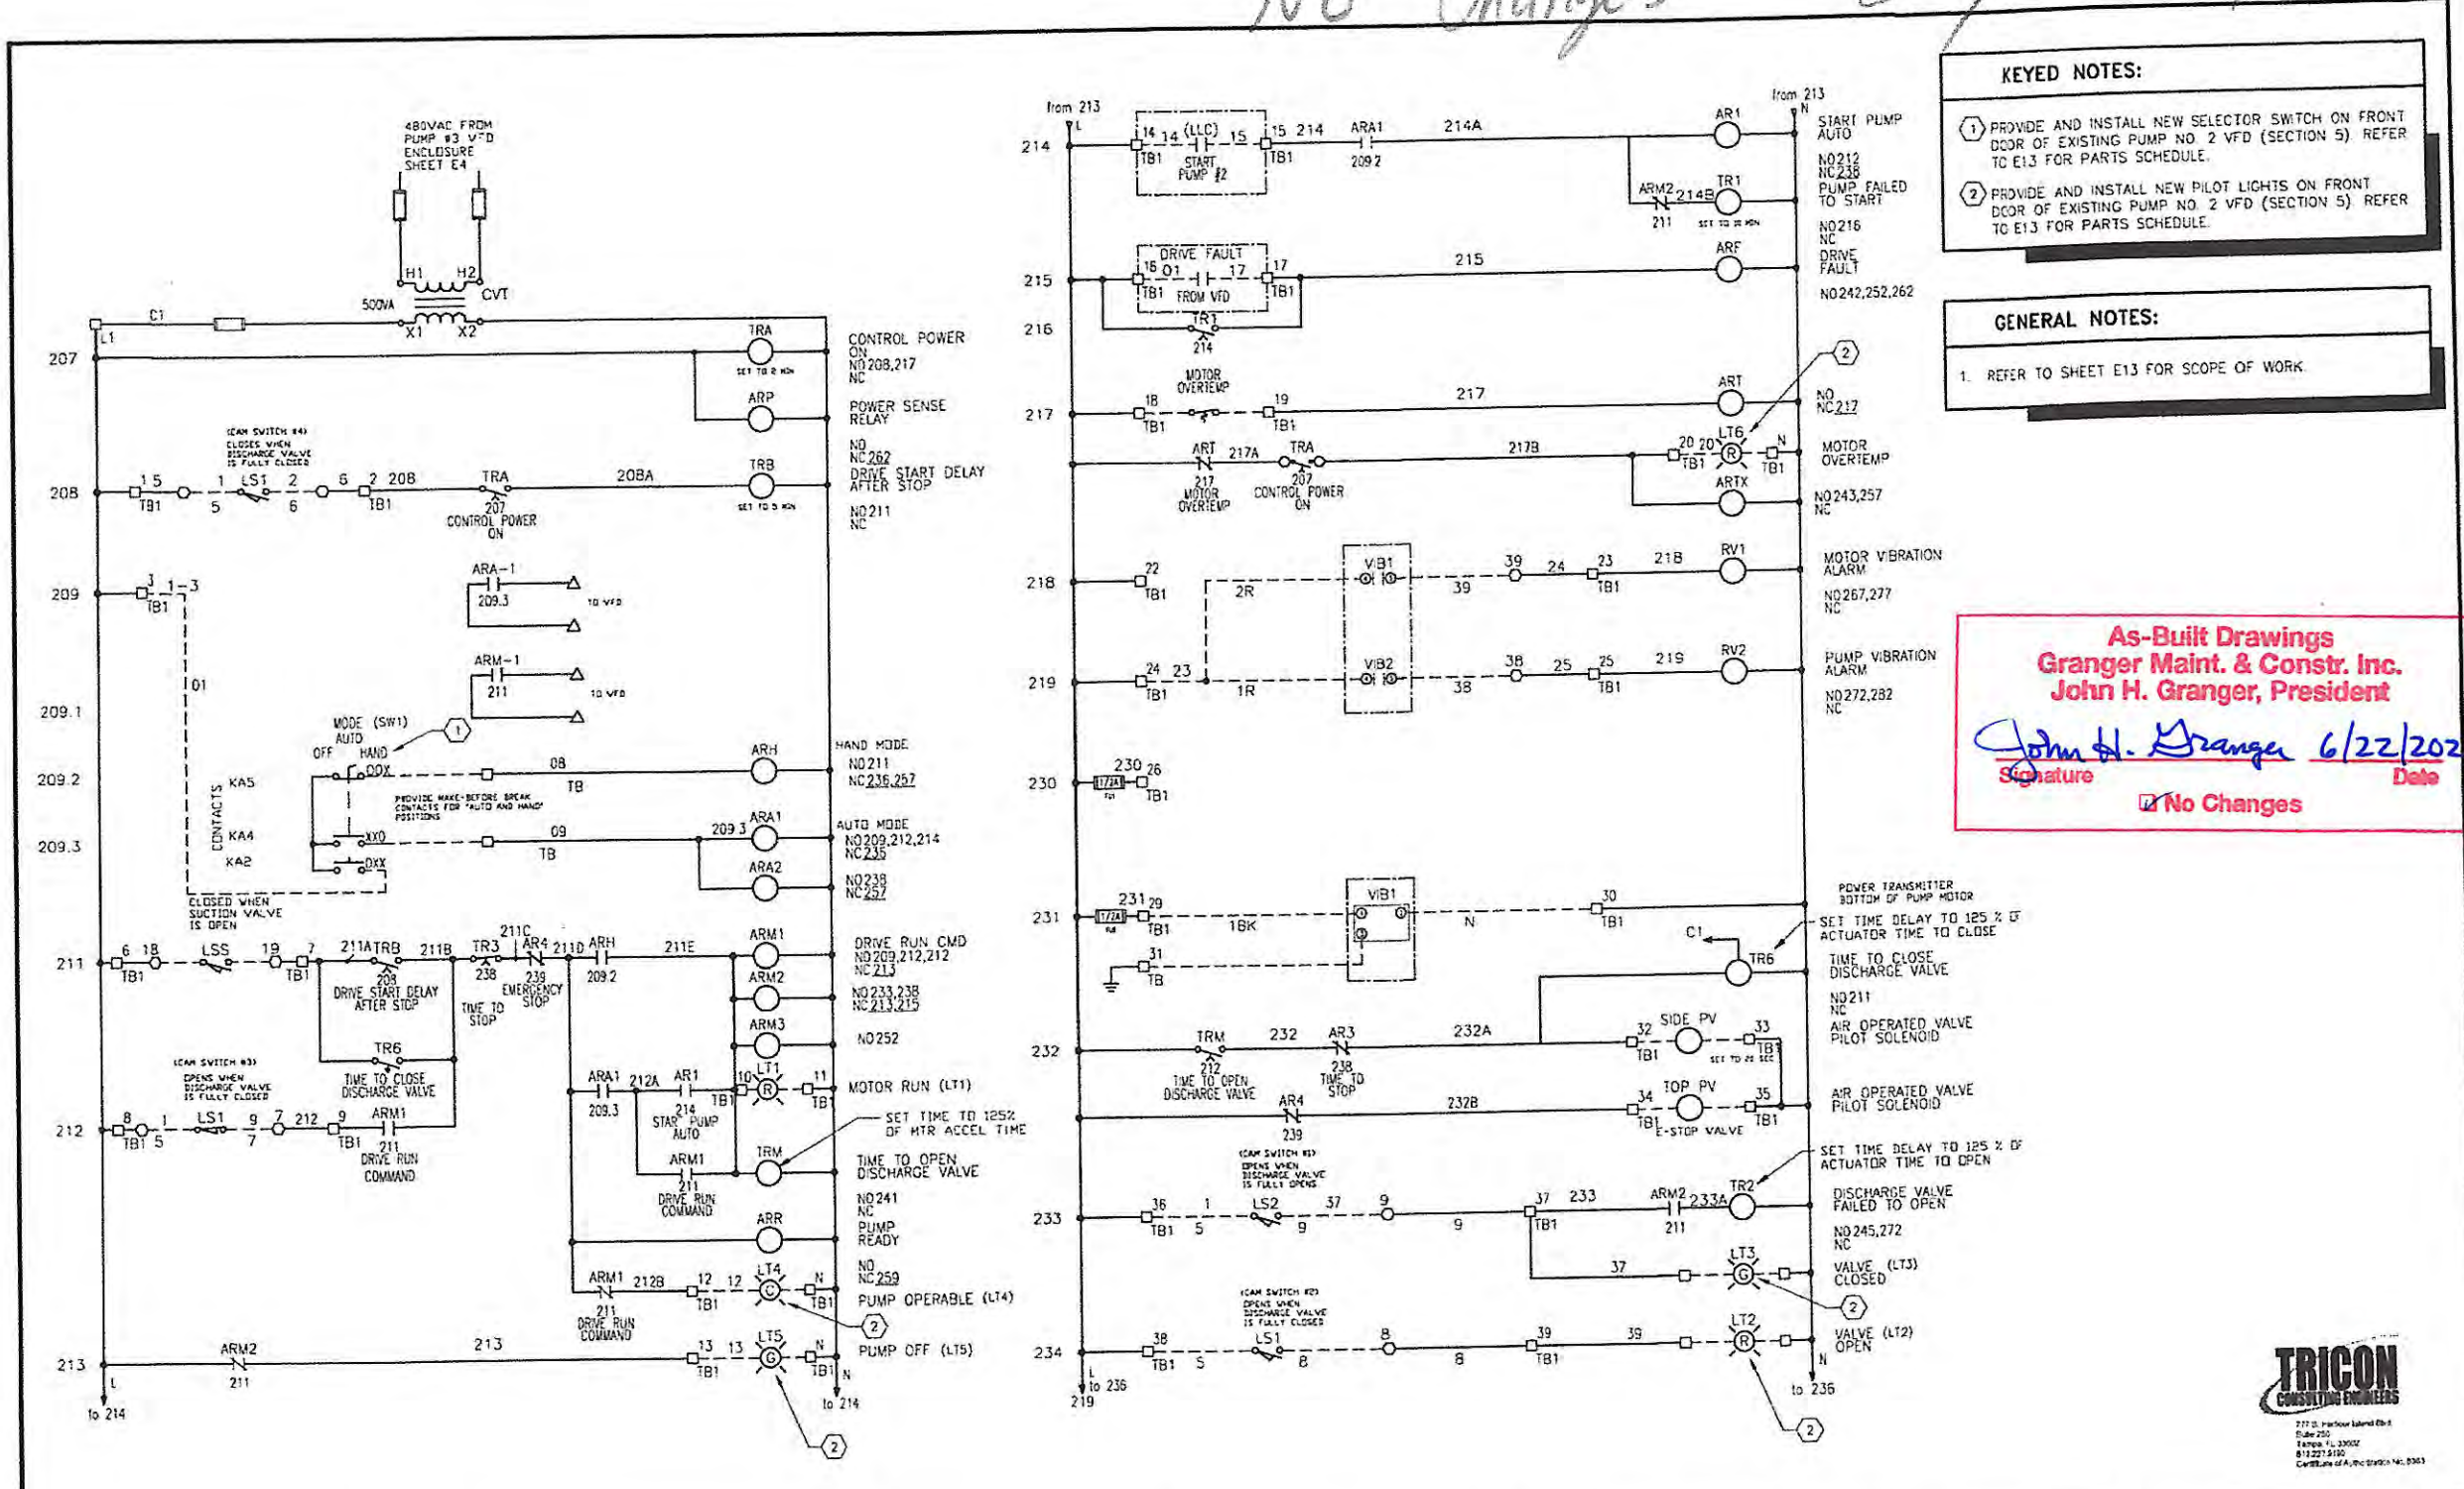

KEYED NOTES:

- 1 PROVIDE AND INSTALL NEW SELECTOR SWITCH ON FRONT DOOR OF EXISTING PUMP NO. 2 VFD (SECTION 5) REFER TO E13 FOR PARTS SCHEDULE.
- 2 PROVIDE AND INSTALL NEW PILOT LIGHTS ON FRONT DOOR OF EXISTING PUMP NO. 2 VFD (SECTION 5) REFER TO E13 FOR PARTS SCHEDULE.

GENERAL NOTES:

1. REFER TO SHEET E13 FOR SCOPE OF WORK.

As-Built Drawings
Granger Maint. & Constr. Inc.
John H. Granger, President

John H. Granger 6/22/2022
Signature Date

No Changes




TIMOTHY THOMAS, P.E. #47079	No.	DATE	REVISIONS	DES: TDT DRN: JLH CKD: TDT DATE: 11/21/16	CITY of TAMPA WASTEWATER DEPARTMENT	UNIVERSITY P.S. PUMP NO. 1 REPLACEMENT PUMP NO. 2 CONTROLS (SHT. 1 OF 2)	W.O. 4511 SHEET E14 OF
	3						
	2						
	1						

No Changes

[Handwritten Signature]

5/17/22

As-Built Drawings
 Granger Maint. & Constr. Inc.
 John H. Granger, President
John H. Granger 6/22/2022
 Signature Date
 No Changes

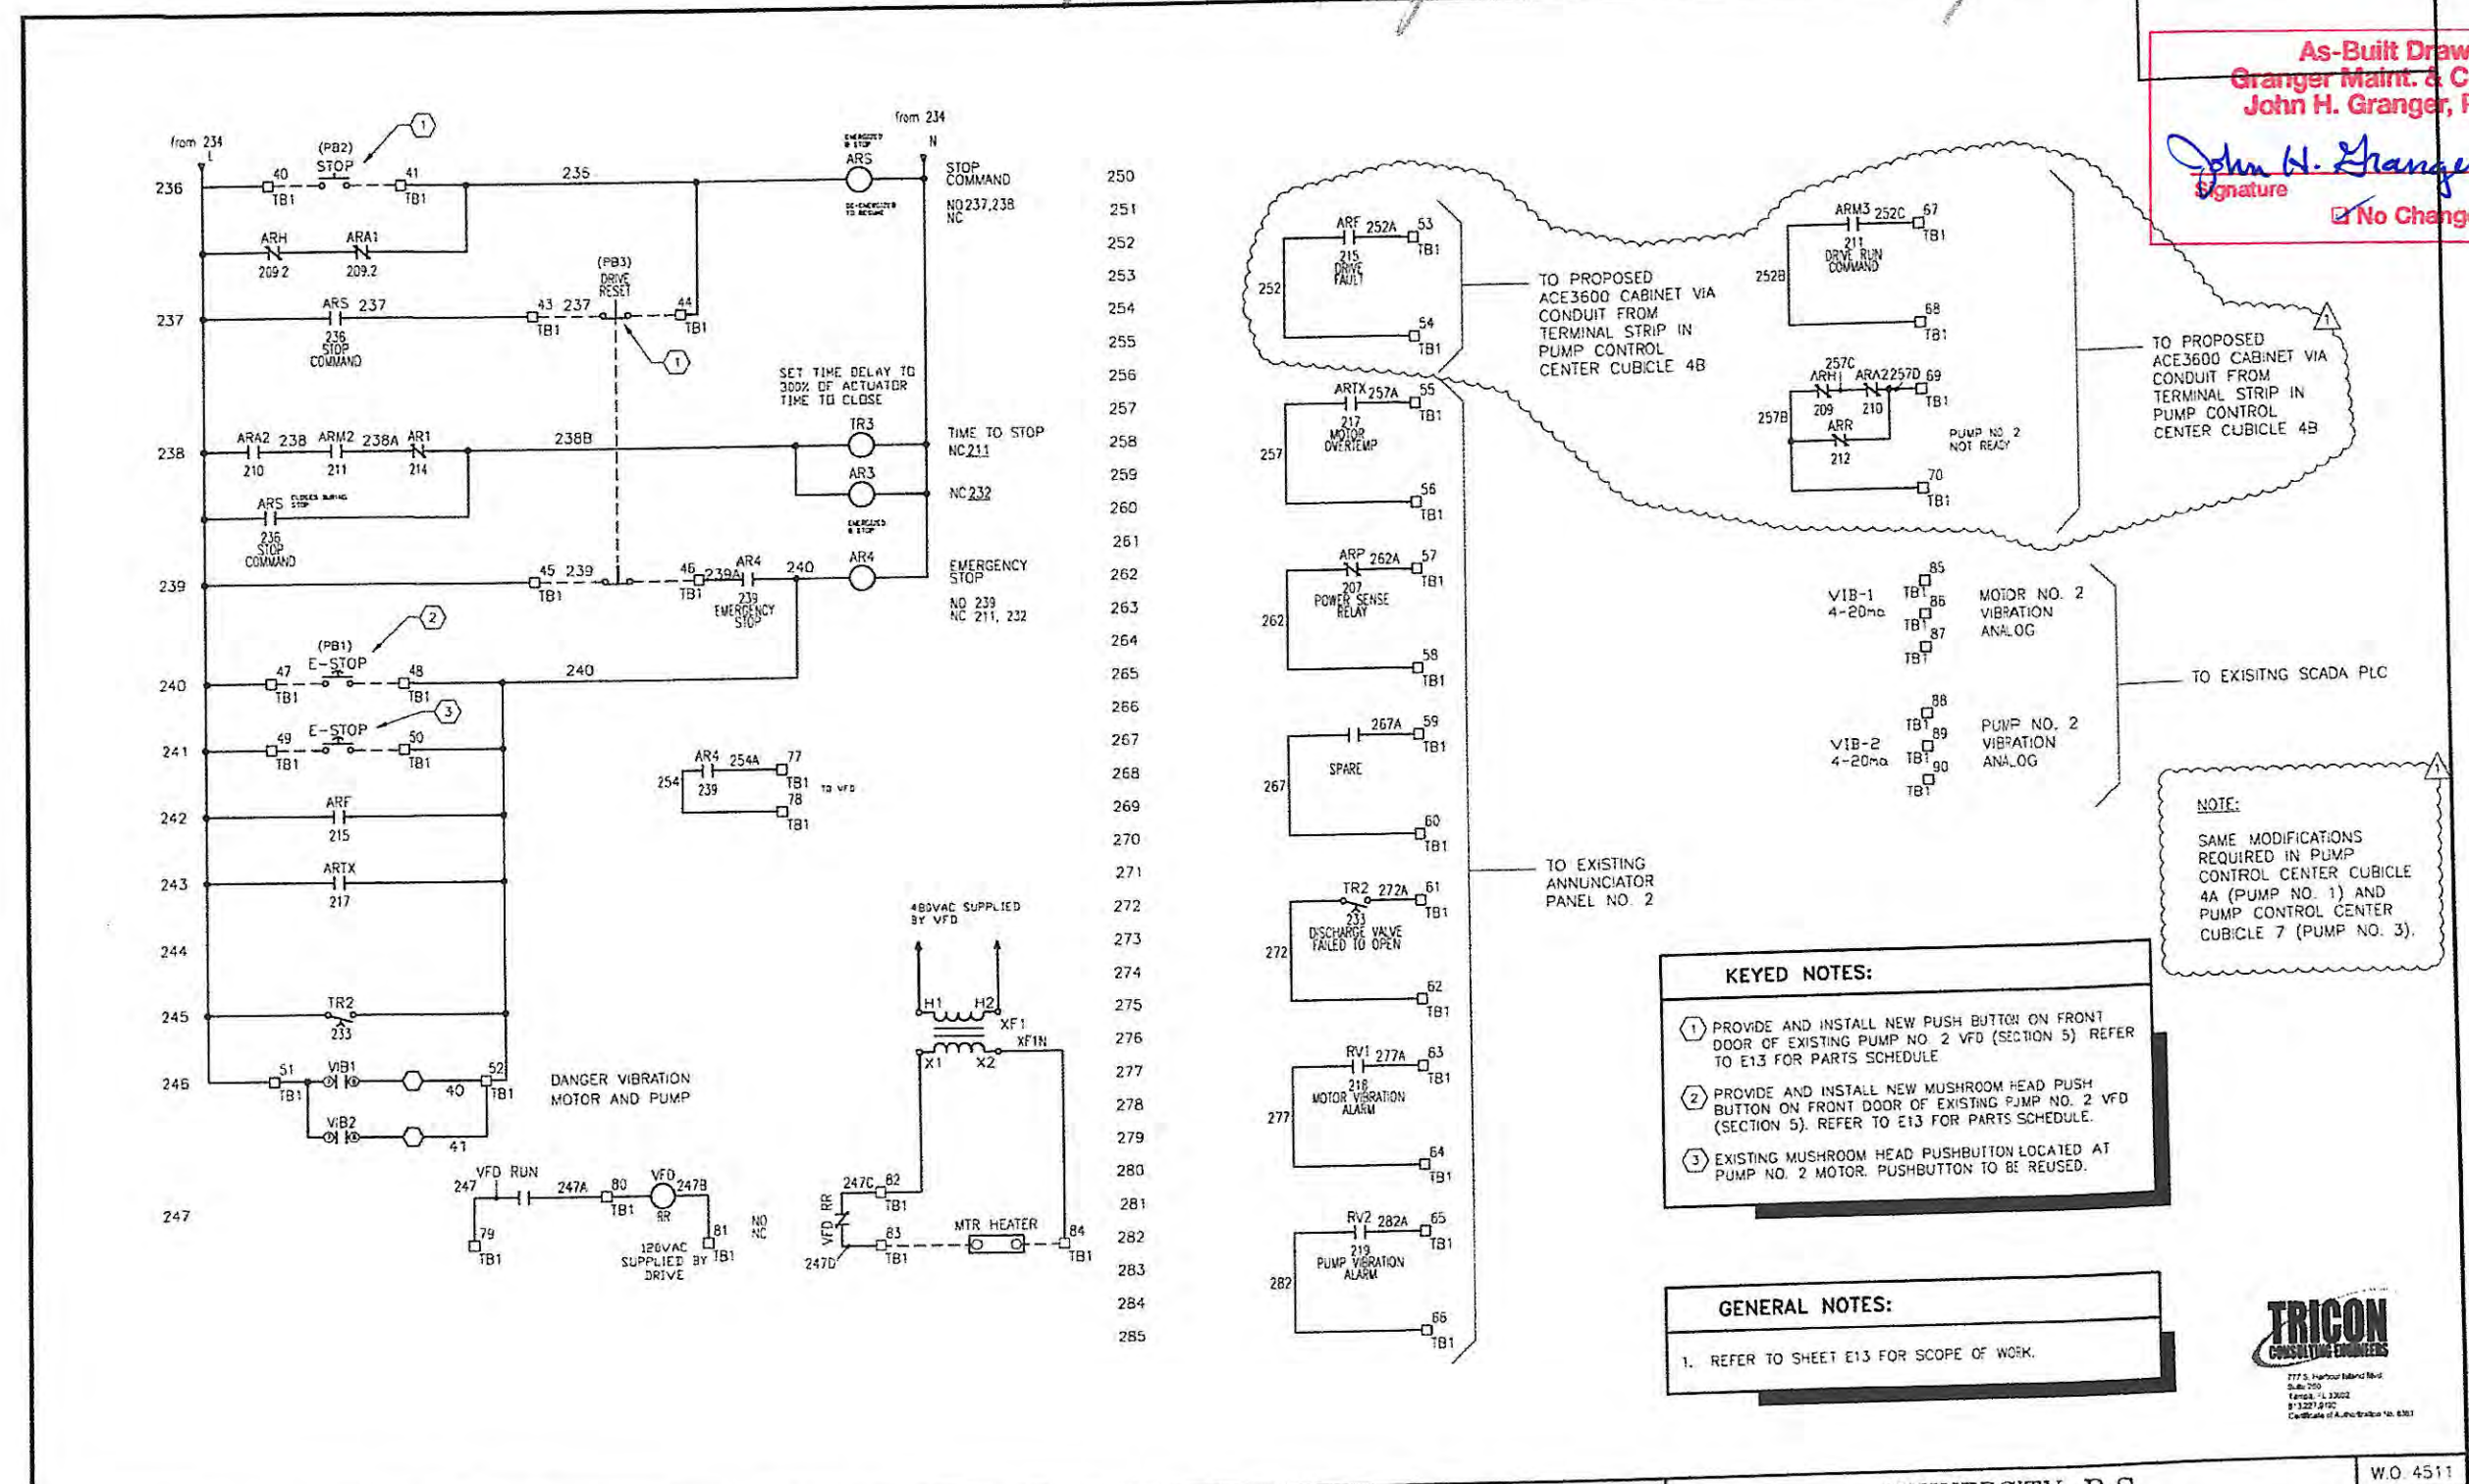

KEYED NOTES:

- 1 PROVIDE AND INSTALL NEW PUSH BUTTON ON FRONT DOOR OF EXISTING PUMP NO. 2 VFD (SECTION 5) REFER TO E13 FOR PARTS SCHEDULE.
- 2 PROVIDE AND INSTALL NEW MUSHROOM HEAD PUSH BUTTON ON FRONT DOOR OF EXISTING PUMP NO. 2 VFD (SECTION 5). REFER TO E13 FOR PARTS SCHEDULE.
- 3 EXISTING MUSHROOM HEAD PUSHBUTTON LOCATED AT PUMP NO. 2 MOTOR. PUSHBUTTON TO BE REUSED.

GENERAL NOTES:

1. REFER TO SHEET E13 FOR SCOPE OF WORK.

NOTE:
 SAME MODIFICATIONS REQUIRED IN PUMP CONTROL CENTER CUBICLE 4A (PUMP NO. 1) AND PUMP CONTROL CENTER CUBICLE 7 (PUMP NO. 3).




TIMOTHY THOMAS, P.E. #47079	No.	DATE	REVISIONS	DES: TDT	CITY of TAMPA WASTEWATER DEPARTMENT	UNIVERSITY P.S. PUMP NO. 1 REPLACEMENT PUMP NO. 2 CONTROLS (SHT. 2 OF 2)	W.O. 4511
	3			DRN: JLH			SHEET
	2			CKD: TDT			E15
	1	1-7-19	ACE3600 ADDITION REVISION	DATE: 11/21/16			OF

No Changes

Granger

5/17/22

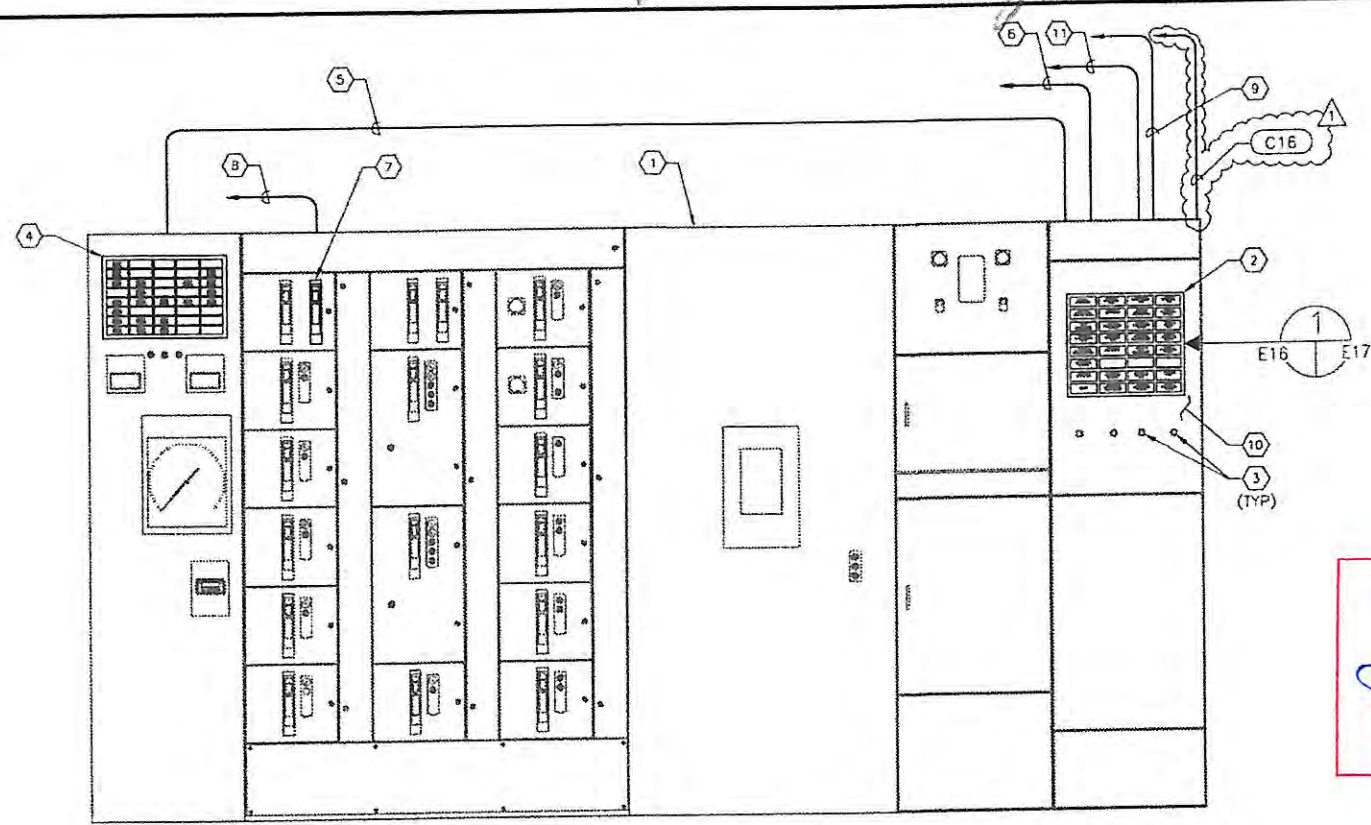

As-Built Drawings
Granger Maint. & Constr. Inc.
John H. Granger, President

John H. Granger 6/22/2022
 Signature Date

No Changes

MOTOR CONTROL CENTER FRONT ELEVATION
 SCALE : 1/2" = 1'-0" A
E1 E16

- KEYED NOTES:**
- ① EXISTING MOTOR CONTROL CENTER AND AUTOMATIC TRANSFER SWITCH LINEUP.
 - ② EXISTING ANNUNCIATOR NO. 1 TO BE REMOVED. CONTRACTOR SHALL PROVIDE AND INSTALL 1/4" ALUMINUM PLATE OVER EXISTING ANNUNCIATOR CUT-OUT. PAINT TO MATCH EXISTING SURFACE. CONTRACTOR TO PROVIDE AND INSTALL NEW MAPLE SYSTEMS HMI, GE PLC, ETC. TO SERVE AS NEW ANNUNCIATOR SYSTEM. REFER TO DETAILS ON SHEET E16.
 - ③ CONTRACTOR SHALL REUSE TWO (2) OF THE EXISTING PUSH BUTTONS FOR INPUTS TO ANNUNCIATOR PLC. REFER TO SHEET E17 FOR DETAILS.
 - ④ EXISTING ANNUNCIATOR NO. 2 TO BE REMOVED. CONTRACTOR SHALL PROVIDE AND INSTALL 1/4" ALUMINUM PLATE OVER EXISTING ANNUNCIATOR CUT-OUT. PAINT TO MATCH EXISTING SURFACE.
 - ⑤ CONTRACTOR TO PROVIDE AND INSTALL 50-#14 + 2-#12 GND IN 1-1/2" CONDUIT TO NEW ANNUNCIATOR PLC (C6). PROVIDE AND INSTALL NEW 600V, 20A TERMINAL BLOCKS (ALLEN-BRADLEY 1492-W3) FOR NEW CONDUCTORS TO BE INSTALLED TO NEW ANNUNCIATOR PLC AND TO TERMINATE EXISTING CONDUCTORS (TO BE REUSED) FROM PUMP CONTROL CENTER. REFER ALSO TO GENERAL NOTES.
 - ⑥ PROVIDE AND INSTALL 2-#12 + 1-#12 GND IN 3/4" C. TO 120/208V PANELBOARD FOR ANNUNCIATOR PLC 120V POWER (P30).
 - ⑦ CONTRACTOR TO REMOVE EXISTING 480V, 100A, 3-POLE 000R CONTROL CIRCUIT BREAKER AND INSTALL NEW 480V, 15A, 3-POLE CIRCUIT BREAKER FOR NEW KNIFE GATE VALVE ACTUATORS.
 - ⑧ PROVIDE AND INSTALL NEW 3/4" CONDUIT WITH 3-#12 + 1-#12 GND DOWN TO ELEVATION 15.00' FOR NEW KNIFE GATE VALVE ACTUATORS (P20). CONTRACTOR TO FIELD ROUTE AS REQUIRED. REFER ALSO TO SHEET E2.
 - ⑨ PROVIDE AND INSTALL NEW 3/4" CONDUIT WITH 2/C-#22 TWISTED SHIELDED CABLE (BELDEN 3106A) TO EXISTING SCADA PLC (C7) REFER ALSO TO SHEET E1.
 - ⑩ NEW ANNUNCIATOR PLC SHALL BE INSTALLED BEHIND EXISTING DOOR.
 - ⑪ CONTRACTOR TO PROVIDE AND INSTALL 22-#14 + 2-#12 GND IN 1-1/4" CONDUIT TO PUMP CONTROL CENTER CUBICLE 4A (C8).


- GENERAL NOTES:**
1. ALL EN-RAIL SHALL BE ALUMINUM.
 2. PROVIDE AND INSTALL ALL ASSOCIATED END BARRERS, TERMINAL JUMPERS AND ACCESSORIES AS REQUIRED FOR TERMINAL BLOCKS.




TIMOTHY THOMAS, P.E. #47079	No.	DATE	REVISIONS	DES: TDT	CITY of TAMPA WASTEWATER DEPARTMENT	UNIVERSITY P.S. PUMP NO. 1 REPLACEMENT MOTOR CONTROL CENTER ELEVATION	W.O. 4511
	3			DRN: JLH			SHEET
	2			CKD: TDT			E16
	1	1-7-19	ACE3600 ADDITION REVISION	DATE: 11/21/16			OF

NO Changes

Tricon
5/17/22

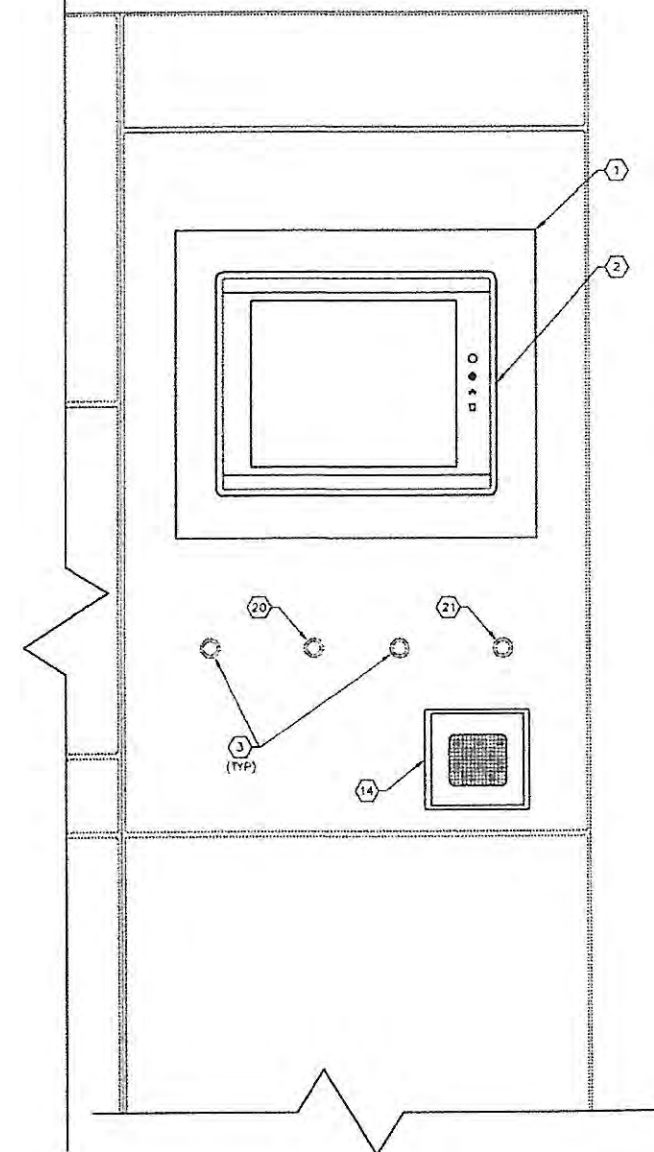

PROPOSED ANNUNCIATOR EXERIOR DETAIL
SCALE : N.T.S.

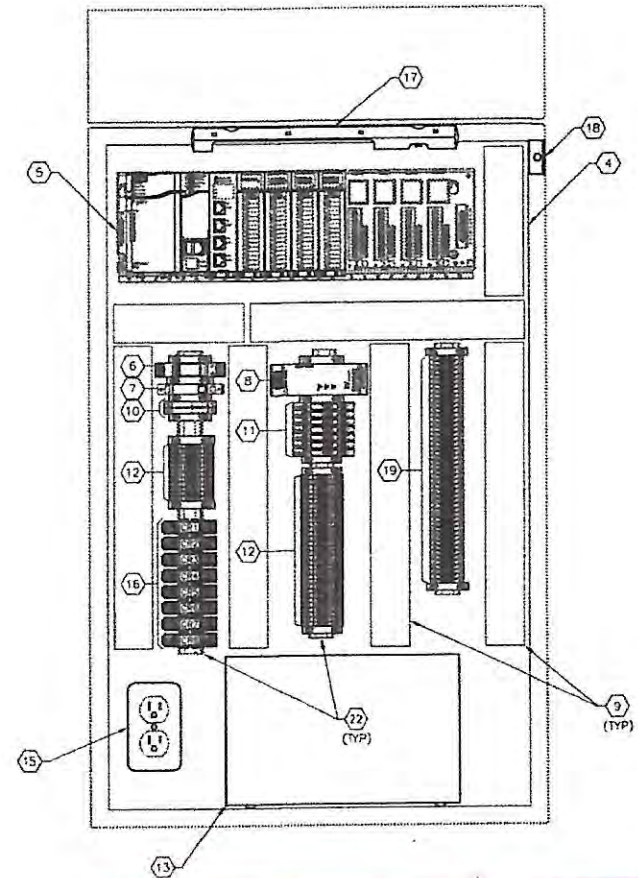

PROPOSED ANNUNCIATOR INTERIOR DETAIL
SCALE : N.T.S.

As-Built Drawings
Granger Maint. & Constr. Inc.
John H. Granger, President

John H. Granger 6/22/2022
Signature Date

No Changes

- KEYED NOTES:**
- 1 CONTRACTOR SHALL PROVIDE AND INSTALL 1/4" ALUMINUM PLATE OVER EXISTING ANNUNCIATOR CUT-OUT. PAINT TO MATCH EXISTING SURFACE.
 - 2 PROVIDE AND INSTALL HUMAN MACHINE INTERFACE (HMI). MAPLE SYSTEMS HM15150P. REFER TO SHEET E20 FOR PROPOSED ANNUNCIATOR SCREENS.
 - 3 CONTRACTOR SHALL REMOVE EXISTING PUSH BUTTONS CURRENTLY UTILIZED FOR 'TEST' AND 'RESET'. PROVIDE APPROPRIATE PLUG FOR HOLE CREATED AFTER REMOVING EXISTING PUSH BUTTON. PAINT TO MATCH EXISTING SURFACE.
 - 4 PROVIDE AND INSTALL NEW ALUMINUM BACKPLATE.
 - 5 PROVIDE AND INSTALL PLC RACK. PLC RACK TO CONSIST OF : ONE (1) - GE RX3; CPU : IC695CPE305-ABAG; ONE (1) - SERIAL COMMUNICATION MODULE: GE IC695CMM004; THREE (3) DC INPUT MODULES: GE IC694MDL241; ONE (1) A/C RELAY MODULE: GE IC694MDL916; ONE (1) 120V POWER SUPPLY: GE IC695PSA140; ONE (1) 12-SLOT BACK PLANE: GE IC695CHS012.
 - 6 PROVIDE AND INSTALL INCOMING 120V POWER SURGE PROTECTION DEVICES. PHOENIX CONTACT #285B357.
 - 7 PROVIDE AND INSTALL 120V CIRCUIT BREAKER. 15 AMPERE SQUARE-D QOU115.
 - 8 PROVIDE AND INSTALL 120VAC-24VDC POWER SUPPLY 'PS1' WITH 5 AMPERE OUTPUT. PHOENIX CONTACT #2866750.
 - 9 PROVIDE AND INSTALL 2"x3" PANDUIT (OR EQUAL) WIRING SYSTEM WITH COVERS (TYPICAL).
 - 10 PROVIDE AND INSTALL 120V. THERMAL CIRCUIT BREAKERS. REFER TO ANNUNCIATOR PLC WIRING DIAGRAM ON SHEET E15 FOR QUANTITIES AND SIZES. ALL THERMAL CIRCUIT BREAKERS SHALL BE PHOENIX CONTACT TCP TYPE.
 - 11 PROVIDE AND INSTALL FUSE TERMINAL BLOCKS FOR DC POWER. PHOENIX CONTACT UK 5-HES1.
 - 12 PROVIDE AND INSTALL MULTI-LEVEL TERMINAL BLOCKS. PHOENIX CONTACT #3044636.
 - 13 PROVIDE AND INSTALL 700VA UPS. APC BR700G.
 - 14 PROVIDE AND INSTALL ALARM HORN. WP, FEDERAL SIGNAL MODEL #350WB IN RED WP BACK BOX. HORN TO BE ON PANEL EXTERIOR.
 - 15 PROVIDE AND INSTALL DUPLEX SERVICE RECEPTACLE. HUBBELL CRF201 OR EQUAL.
 - 16 PROVIDE AND INSTALL SQUARE-D 8501 R SERIES (OR EQUAL) SPDT RELAYS WITH 120V COILS. PROVIDE RELAY BASE AND HOLD DOWN SPRING FOR RELAY.
 - 17 PROVIDE AND INSTALL 24V DC LED CABINET LIGHT HOFFMAN CAT # LED24V15. PROVIDE BRACKET TO MOUNT FIXTURE TO BACKPANEL.
 - 18 PROVIDE AND INSTALL REMOTE DOOR SWITCH SWITCH AND ASSOCIATED DOOR SWITCH CABLE FOR 24V DC LED CABINET LIGHT. HOFFMAN CAT # ALF5WD.
 - 19 PROVIDE AND INSTALL SURGE PROTECTION DEVICES FOR 24V DC DISCRETE INPUT CIRCUITS. PHOENIX CONTACT #2794699.
 - 20 CONTRACTOR SHALL REUSE EXISTING PUSH BUTTON 'ACKNOWLEDGE' FOR INPUTS TO ANNUNCIATOR PLC.
 - 21 CONTRACTOR SHALL REUSE EXISTING PUSH BUTTON 'SILENCE' FOR INPUTS TO ANNUNCIATOR PLC.
 - 22 ALUMINUM DIN RAIL (TYPICAL)

- GENERAL NOTES :**
1. PROVIDE AND INSTALL ALL ASSOCIATED END BARRIERS, TERMINAL JUMPERS AND ACCESSORIES AS REQUIRED FOR TERMINAL BLOCKS, FUSE HOLDERS AND SURGE PROTECTION DEVICES SHOWN AS REQUIRED.




TIMOTHY THOMAS, P.E. #47079	No.	DATE	REVISIONS	DES: TDT	CITY of TAMPA WASTEWATER DEPARTMENT	UNIVERSITY P.S. PUMP NO. 1 REPLACEMENT ANNUNCIATOR PLC DETAILS	3	W.O. 4511 SHEET E17 OF
	2			DRN: JLH				
	1			CKD: TDT				
				DATE: 11/21/16				


NO CHANGES

Tru

5/17/22

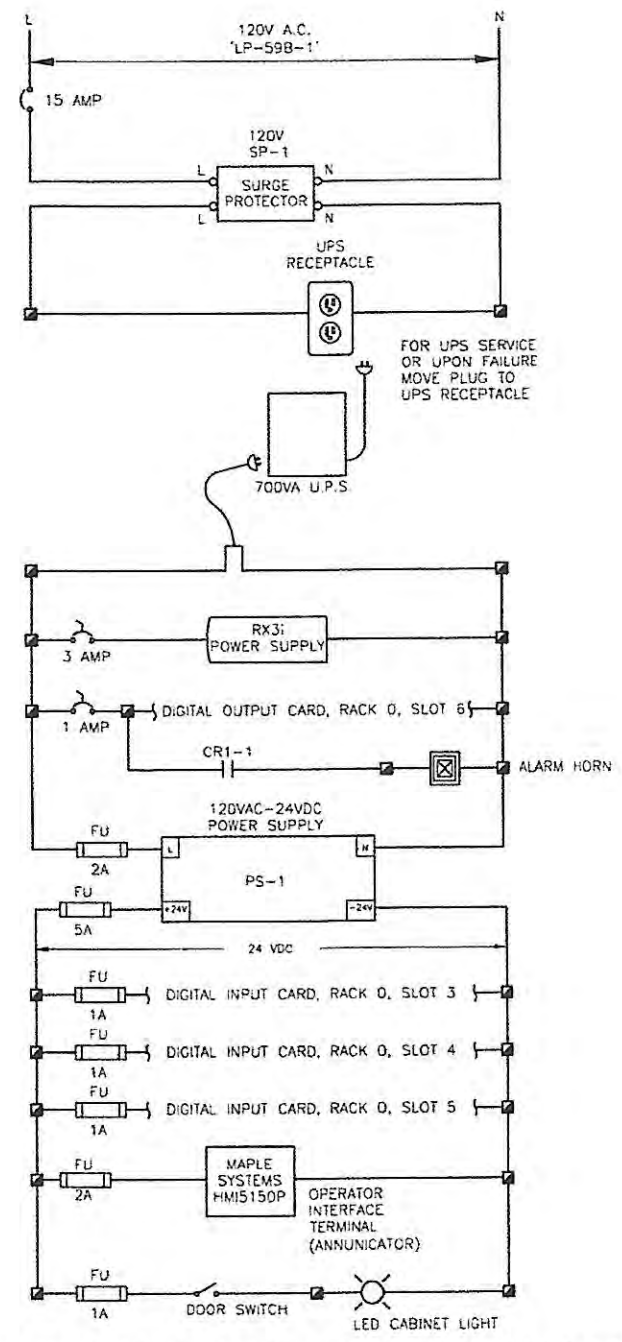

ANNUNCIATOR PLC POWER WIRING DIAGRAM

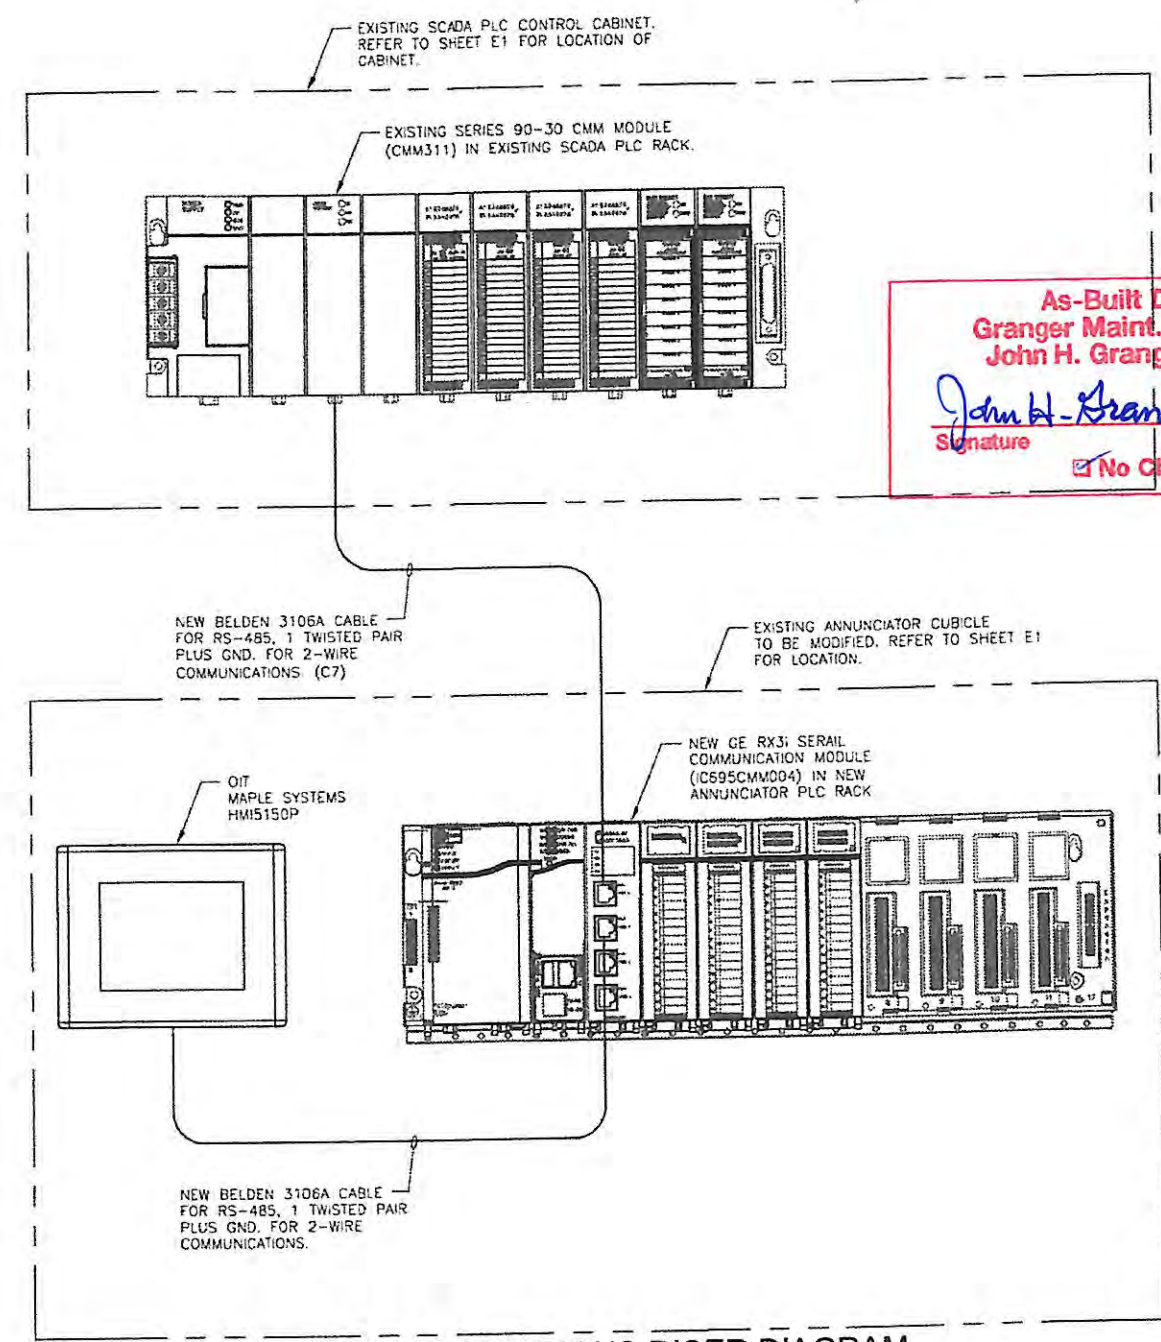

COMMUNICATIONS RISER DIAGRAM

As-Built Drawings
 Granger Maint. & Constr. Inc.
 John H. Granger, President
John H. Granger 6/22/2022
 Signature Date
 No Changes



No.	DATE	REVISIONS
3		
2		
1		

TIMOTHY THOMAS, P.E. #47079


DES: TDT
 DRN: JLH
 CKD: TDT
 DATE: 11/21/16

CITY of TAMPA
 WASTEWATER DEPARTMENT


UNIVERSITY P.S.
 PUMP NO. 1 REPLACEMENT
 ANNUNCIATOR PLC WIRING DIAGRAMS

W.O. 4511
 SHEET
E18
 OF

NO CHANGES *Truman* 5/17/22

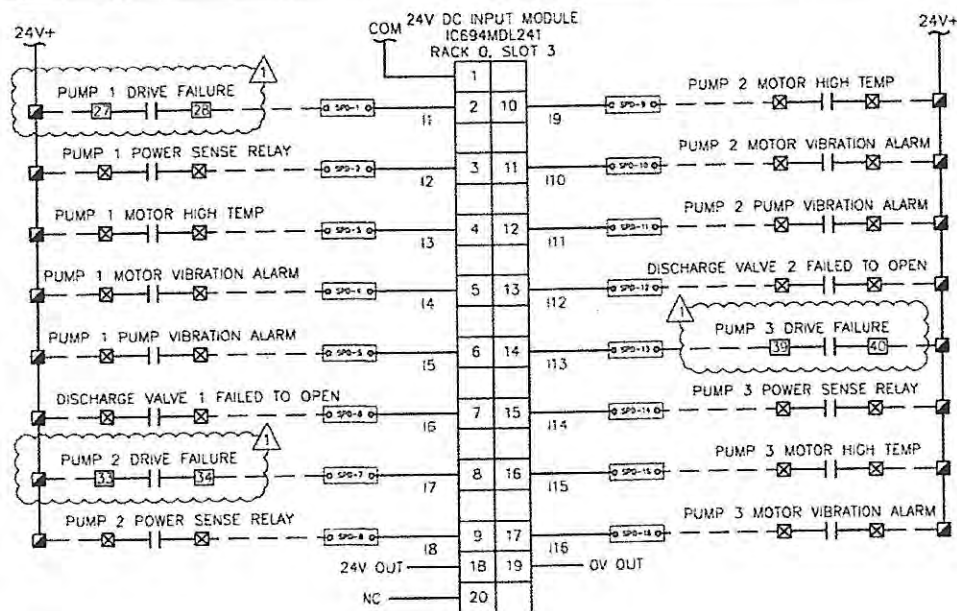


PLC DISCRETE INPUT CARD WIRING DIAGRAM - SLOT 3

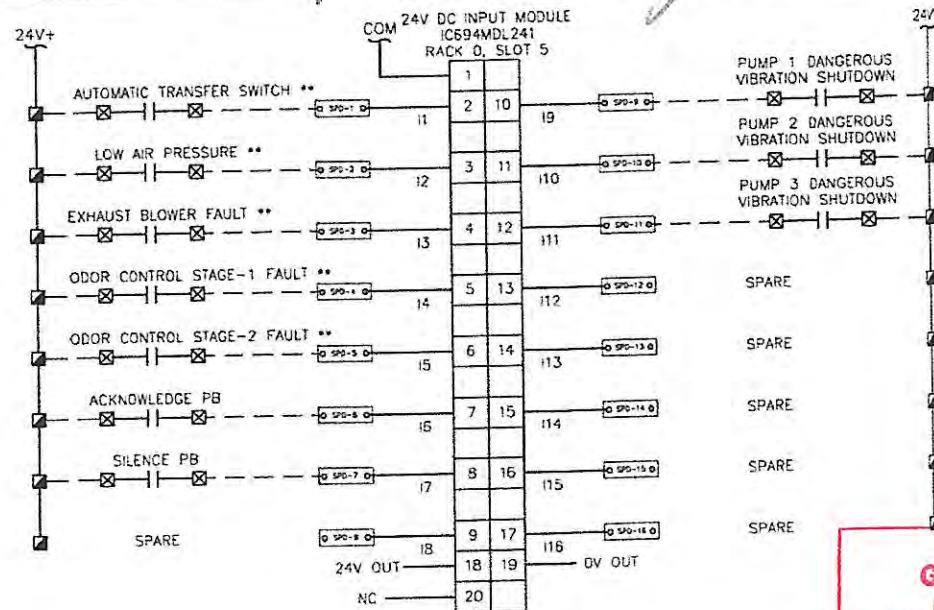


PLC DISCRETE INPUT CARD WIRING DIAGRAM - SLOT 5

As-Built Drawings
 Granger Maint. & Constr. Inc.
 John H. Granger, President
John H. Granger 6/22/2022
 Signature Date
 No Changes

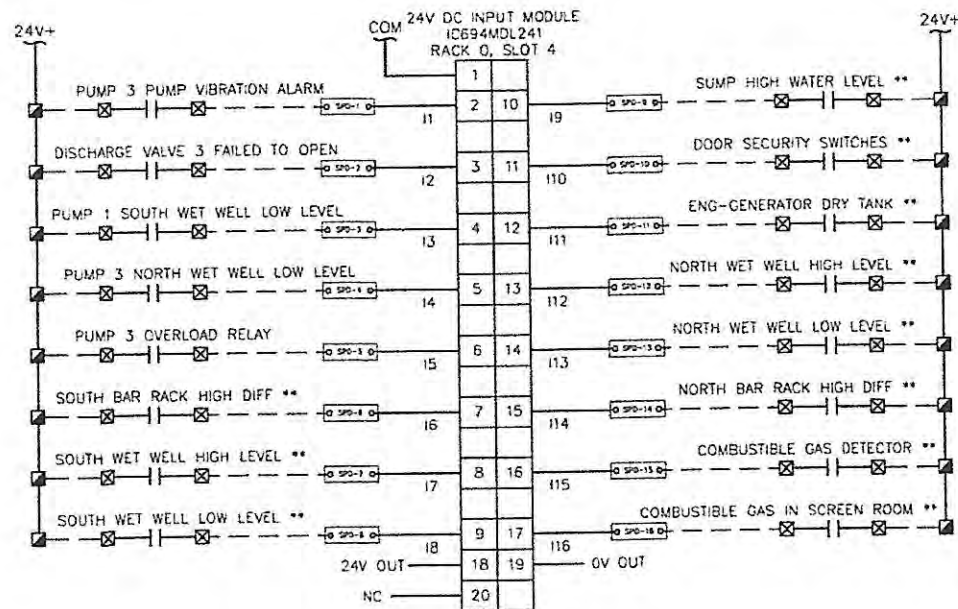

PLC DISCRETE INPUT CARD WIRING DIAGRAM - SLOT 4

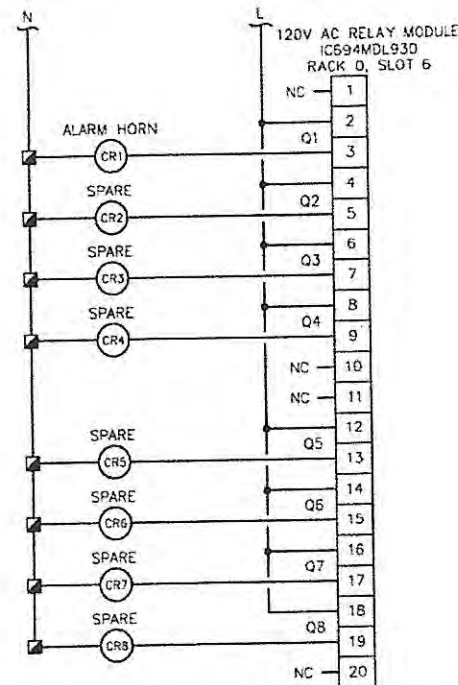

PLC RELAY OUTPUT CARD WIRING DIAGRAM - SLOT 6

- LEGEND**
- DENOTES FIELD WIRING
 - ☒ DENOTES TERMINAL ON FIELD DEVICE
 - ☑ DENOTES TERMINAL IN ANNUNCIATOR PLC CABINET
 - ☒ DENOTES TERMINAL NEW ACE3600 CABINET
 - ** DENOTES INPUT FROM EXISTING ANNUNCIATOR #2 LOCATED ON SOUTH END OF MOTOR CONTROL CENTER



No.	DATE	REVISIONS
3		
2		
1	1-7-19	ACE3600 ADDITION REVISION

DES: TDT
 DRN: JLH
 CKD: TDT
 DATE: 11/21/16

CITY of TAMPA
 WASTEWATER DEPARTMENT

UNIVERSITY P.S.
 PUMP NO. 1 REPLACEMENT
 DISCRETE I/O WIRING DIAGRAMS

W.O. 4511
 SHEET
E19
 OF

TIMOTHY THOMAS, P.E. #47079

NO CHANGES

[Handwritten Signature]

3/17/22

NOTE:
THE EQUIPMENT NECESSARY
TO PROVIDE THIS
INFORMATION WILL BE
PROVIDED IN THE FUTURE.

NOTE:
THE EQUIPMENT NECESSARY
TO PROVIDE THIS
INFORMATION WILL BE
PROVIDED IN THE FUTURE.

PUMP #1	PUMP #2	PUMP #3	SWITCHGEAR
STOPPED	RUNNING	STOPPED	MAIN "A" CLOSED
0.0 % SPEED	67.8 % SPEED	0.0 % SPEED	MAIN "B" CLOSED
0.0 KW	97.3 KW	0.0 KW	TIE OPENED
0.0 AMPS	146 AMPS	0.0 AMPS	MAIN "A" AMPS
FAIL TO START	FAIL TO START	FAIL TO START	MAIN "B" AMPS
AFD READY	AFD READY	AFD NOT READY	MAIN "A" KW
W. W. UPSTREAM HIGH WARNING	P#2 FAILED TO START	P#2 STATOR SEAL LEAK	
W. W. UPSTREAM HIGH ALARM	P#2 DISH. VALVE FAIL TO OPEN	P#2 CABLE SEAL LEAK	
W. W. DWNSTREAM LOW WARNING	P#2 DISH. VALVE FAIL TO CLOSE	P#2 BEARING OVERTEMP.	
BUBBLER CNTRL PWR FAIL	P#2 AFD FAIL	P#4 FAILED TO START	
LEL GAS 25%	P#2 MTR STATOR OVERTEMP.	P#4 DISH. VALVE FAIL TO OPEN	
LEL GAS 50%	P#2 STATOR SEAL LEAK	P#4 DISH. VALVE FAIL TO CLOSE	
GAS DETECTOR OK	P#2 CABLE SEAL LEAK	P#4 AFD FAIL	
P#1 FAILED TO START	P#2 BEARING OVERTEMP.	P#4 MTR STATOR OVERTEMP.	
P#1 DISH. VALVE FAIL TO OPEN	P#3 FAILED TO START	P#4 STATOR SEAL LEAK	
P#1 DISH. VALVE FAIL TO CLOSE	P#3 DISH. VALVE FAIL TO OPEN		
P#1 AFD FAIL	P#3 DISH. VALVE FAIL TO CLOSE	WASTEWATER FLOW HGD	
P#1 MTR STATOR OVERTEMP.	P#3 AFD FAIL		
P#1 STATOR SEAL LEAK	P#3 MTR STATOR OVERTEMP.		
ALARMS			

PROPOSED ANNUNCIATOR SAMPLE SCREEN 1

PUMP #1	PUMP #2	PUMP #3	PUMP #4	SWITCHGEAR
STOPPED	RUNNING	STOPPED	STOPPED	MAIN "B" KW
0.0 % SPEED	67.8 % SPEED	0.0 % SPEED	0.0 % SPEED	MAIN "A" PF
0.0 KW	97.3 KW	0.0 KW	0.0 KW	MAIN "B" PF
0.0 AMPS	146 AMPS	0.0 AMPS	0.0 AMPS	MAIN "A" KVA
FAIL TO START	FAIL TO START	FAIL TO START	FAIL TO START	MAIN "B" KVA
AFD READY	AFD READY	AFD NOT READY	AFD READY	MCC-65A AMPS
SUMP PUMP LEVEL	SCREEN CONTROL POWER	COMPACTOR RUNNING		
PLANT WATER PRESSURE	SCREEN RUNNING	COMPACTOR FAULT		
HVAC TROUBLE	SCREEN FAULT	COMPACTOR LOW LOAD		
	SCREEN SPRAY WASH FAILURE	COMPACTOR HIGH LOAD		
LIGHTING ATS TROUBLE	SCREEN SPRAY WATER FLOW GPM			
LIGHTING ATS ON BUS "A"				
LIGHTING ATS ON BUS "B"	SCREEN ATS TROUBLE			
	SCREEN ATS ON BUS "A"			
	SCREEN ATS ON BUS "B"			
ALARMS				

PROPOSED ANNUNCIATOR SAMPLE SCREEN 2

As-Built Drawings
Granger Maint. & Constr. Inc.
John H. Granger, President

John H. Granger 6/22/2022
Signature Date

No Changes

NOTE:
1. THE ANNUNCIATOR HMI IS A MAPLE SYSTEMS # HM15150P
2. SCREEN 1 AND SCREEN 2 SHOWS THE INFORMATION DISPLAYED ON THE SAME HMI AT DIFFERENT TIMES AS CONTROLLED BY OPERATOR TOUCH-SCREEN NPUT.
3. DISPLAY GRAPHICS AND CHARACTERISTICS SHALL FOLLOW THE STANDARDS SET FORTH AT SULPHUR SPRINGS AND YBOR PUMPING STATIONS.



No.	DATE	REVISIONS
3		
2		
1		

DES: TDT
DRN: JLH
CKD: TDT
DATE: 11/21/16

CITY of TAMPA
WASTEWATER DEPARTMENT

UNIVERSITY P.S.
PUMP NO. 1 REPLACEMENT
PROPOSED ANNUNCIATOR SCREENS

W.O. 4511
SHEET
E20
OF

TIMOTHY THOMAS, P.E. #47079

No Changes

[Handwritten Signature]

5/17/22

CONDUIT AND CABLE SCHEDULE

CONDUIT No.	SIZE	NUMER OF CONDUCTORS/SIZE	FROM	TO	REMARKS
P10	4"	3-500kcmil + 1-2/O GND	PUMP CONTROL CENTER SECTION #3	PUMP NO. 1 VFD	POWER LEADS. PROVIDE NEW CONDUIT/CONDUCTORS (TO EXISTING PULL BOX)
P11	4"	3-500kcmil + 1-2/O GND	PUMP CONTROL CENTER SECTION #3	PUMP NO. 1 VFD	POWER LEADS. PROVIDE NEW CONDUIT/CONDUCTORS (TO EXISTING PULL BOX)
P12	4"	3-500kcmil + 1-2/O GND	PUMP NO. 1 VFD	PUMP MOTOR NO. 1	POWER LEADS. PROVIDE NEW CONDUIT/CONDUCTORS. PROVIDE ALUMINUM CORE, LIQUID TIGHT, FLEXIBLE CONNECTION TO MOTOR
P13	4"	3-500kcmil + 1-2/O GND	PUMP NO. 1 VFD	PUMP MOTOR NO. 1	POWER LEADS. PROVIDE NEW CONDUIT/CONDUCTORS. PROVIDE ALUMINUM CORE, LIQUID TIGHT, FLEXIBLE CONNECTION TO MOTOR
P20	3/4"	3-#12 + 1-#12 GND	MOTOR CONTROL CENTER, 1B	NEW JB AT ELEV 15.00'	KNIFE GATE VALVE ACTUATORS - 480V FEEDER. PROVIDE NEW CONDUIT/CONDUCTORS. FIELD ROUTE DOWN TO ELEVATION 15.00'
P21	3/4"	3-#12 + 1-#12 GND	NEW JB AT ELEV 15.00'	NEW PUMP NO. 1 ACTUATOR	480V FEEDER. PROVIDE NEW CONDUIT/CONDUCTORS.
P22	3/4"	3-#12 + 1-#12 GND	NEW JB AT ELEV 15.00'	NEW PUMP NO. 2 ACTUATOR	480V FEEDER. PROVIDE NEW CONDUIT/CONDUCTORS.
P23	3/4"	3-#12 + 1-#12 GND	NEW JB AT ELEV 15.00'	NEW PUMP NO. 3 ACTUATOR	480V FEEDER. PROVIDE NEW CONDUIT/CONDUCTORS.
P30	3/4"	2-#12 + 1-#12 GND	EXISTING 120/208V PANELBOARD	NEW ANNUNCIATOR PLC	ANNUNCIATOR PLC 120V POWER. PROVIDE NEW CONDUIT/CONDUCTORS
P40	3/4"	2-#12 + 1-#12 GND	EXISTING 120/208V PANELBOARD	LIQUID LEVEL CONTROLS	NEW FLOW METER TRANSMITTER, BARGRAPH INDICATORS AND DIGITAL PANEL METERS 120V POWER PROVIDE NEW CONDUIT/CONDUCTORS.
P50	3/4"	2-#10 + 1-#10 GND	PUMP NO. 1 VFD	PUMP MOTOR NO. 1	MOTOR SPACE HEATER 120V POWER. PROVIDE NEW CONDUIT/CONDUCTORS PROVIDE NON-METALLIC, FLEXIBLE CONNECTION TO MOTOR
P60	3/4"	6-#12 + 1-#12 GND	PUMP NO. 1 VFD	VIBRATION TRANS ELEV 41.25'	VIBRATION TRANSMITTER 120V POWER AND ALARM RELAY OUTPUTS. PROVIDE NEW CONDUIT/CONDUCTORS FROM NEW TRANSMITTER AT ELEVATION 41.25'.
P61	3/4"	6-#12 + 1-#12 GND	PUMP NO. 2 VFD	VIBRATION TRANS ELEV 41.25'	VIBRATION TRANSMITTER 120V POWER AND ALARM RELAY OUTPUTS. PROVIDE NEW CONDUIT/CONDUCTORS FROM NEW TRANSMITTER AT ELEVATION 41.25'.
P62	3/4"	6-#12 + 1-#12 GND	PUMP NO. 3 VFD	VIBRATION TRANS ELEV 41.25'	VIBRATION TRANSMITTER 120V POWER AND ALARM RELAY OUTPUTS. PROVIDE NEW CONDUIT/CONDUCTORS FROM NEW TRANSMITTER AT ELEVATION 41.25'.
P70	3/4"	6-#12 + 1-#12 GND	PUMP NO. 1 VFD	ROBERTSHAW VIBRASWITCH	VIBRASWITCH 120V POWER, RESET AND ALARM RELAY OUTPUT (VIA TERMINAL BOX AT PUMP MOTOR NO. 1). PROVIDE NEW CONDUIT/CONDUCTORS
P80	3/4"	2-#12 + 1-#12 GND	PUMP NO. 1 VFD	MOTOR NO. 1 THERMAL SWITCH	THERMAL SWITCH CONTACT (VIA TERMINAL BOX AT PUMP MOTOR NO. 1). PROVIDE NEW CONDUIT/CONDUCTORS
P90	3/4"	2-#12 + 1-#12 GND	EXISTING 120/208V PANELBOARD	LIQUID LEVEL CONTROLS	NEW SIGNAL ISOLATORS/CONVERTERS 120V POWER PROVIDE NEW CONDUIT/CONDUCTORS.
C1	1-1/2"	36-#14 + 2-#12 GND	PUMP CONTROL CENTER CUBICLE 4A	PUMP NO. 1 VFD	PROVIDE NEW CONDUIT/CONDUCTORS. COUNT INCLUDES SPARES.
C2	2"	50-#12 + 2-#12 GND	PUMP NO. 1 VFD	T.B. AT PUMP MOTOR NO. 1	PROVIDE NEW CONDUIT/CONDUCTORS. COUNT INCLUDES SPARES.
C3	1-1/4"	FOUR - 2/C #16 TW-SH	PUMP 1 VIB/TEMP TRANS ELEV 41.25'	EXISTING SCADA PLC	FOUR (4): 2/C-#16 (BELDEN 8719 EACH) FOR PUMP AND MOTOR VIBRATION & TEMPERATURE ANALOG SIGNALS VIA NEW TERMINAL BLOCKS IN SECTION 3
C4	EX	2-#14 + 1-#14 GND	LIQUID LEVEL CONTROLS (LLC)	PUMP NO. 1 VFD	VFD START AND PUMP READY SIGNALS TO/FROM LLC. PROVIDE NEW CONDUCTORS AND UTILIZE EXISTING RACEWAY FROM LLC TO SECTION 3.
C5	EX	SUPPLIED BY MANUFACTURER	LIQUID LEVEL CONTROLS (LLC)	NEW FM TRANSMITTER	MANUFACTURER SUPPLIED CABLE TO FLOW METER IN EX CONDUIT 2/C #16 (BELDEN 8719) FROM TRANSMITTER TO SCADA PLC
C6	1-1/2"	50-#14 + 2-#12 GND	EXISTING ANNUNCIATOR NO. 2	NEW ANNUNCIATOR PLC	PROVIDE NEW CONDUIT/CONDUCTORS. CONDUCTOR COUNT INCLUDES SPARES.
C7	3/4"	ONE - 2/C #22 TW-SH W/GND	EXISTING SCADA PLC	NEW ANNUNCIATOR PLC	2/C #22 (BELDEN 3106A) FOR NEW ANNUNCIATOR PLC COMMUNICATIONS TO EXISTING SCADA PLC. PROVIDE NEW CONDUIT/CONDUCTORS
C8	1-1/4"	22-#14 + 2-#12 GND	PUMP CONTROL CENTER CUBICLE 4A	NEW ANNUNCIATOR PLC	PROVIDE NEW CONDUIT/CONDUCTORS. COUNT INCLUDES SPARES.
C9	EX	2-#14 + 1-#14 GND	PUMP CONTROL CENTER CUBICLE 4A	EXISTING SCADA PLC	VFD SIGNALS TO EXISTING SCADA PLC. PROVIDE NEW CONDUCTORS AND UTILIZE EXISTING RACEWAY FROM SECTION 3 TO SCADA PLC.
C10	1"	THREE - 2/C #16 TW-SH	PUMP NO. 1 VFD	EXISTING SCADA PLC	THREE (4): 2/C-#16 (BELDEN 8719 EACH) FOR VFD SPEED CONTROL, SPEED REFERENCE (ONE SPARE) ANALOG SIGNALS VIA NEW TERMINAL BLOCKS IN SECTION 3
C11	1-1/4"	FOUR - 2/C #16 TW-SH	PUMP 2 VIB/TEMP TRANS ELEV 41.25'	EXISTING SCADA PLC	FOUR (4): 2/C-#16 (BELDEN 8719 EACH) FOR PUMP AND MOTOR VIBRATION & TEMPERATURE ANALOG SIGNALS VIA NEW TERMINAL BLOCKS IN SECTION 3
C12	1-1/4"	FOUR - 2/C #16 TW-SH	PUMP 3 VIB/TEMP TRANS ELEV 41.25'	EXISTING SCADA PLC	FOUR (4): 2/C-#16 (BELDEN 8719 EACH) FOR PUMP AND MOTOR VIBRATION & TEMPERATURE ANALOG SIGNALS VIA NEW TERMINAL BLOCKS IN SECTION 3
C13	3/4"	6-#14 + 1-#12 GND	PUMP CONTROL CENTER CUBICLE 4A	NEW ACE3600 CABINET	PUMP NO. 1 FAULT, RUNNING AND NOT READY SIGNALS
C14	3/4"	6-#14 + 1-#12 GND	PUMP CONTROL CENTER CUBICLE 4B	NEW ACE3600 CABINET	PUMP NO. 2 FAULT, RUNNING AND NOT READY SIGNALS
C15	3/4"	6-#14 + 1-#12 GND	PUMP CONTROL CENTER CUBICLE 7	NEW ACE3600 CABINET	PUMP NO. 3 FAULT, RUNNING AND NOT READY SIGNALS
C16	3/4"	6-#14 + 1-#12 GND	NEW ACE3600 CABINET	NEW ANNUNCIATOR PLC	PUMP NO. 1, PUMP NO. 2 AND PUMP NO. 3 FAULT SIGNALS.
C17	1-1/4"	FOUR - 2/C #16 TW-SH	LIQUID LEVEL CONTROLS	EXISTING SCADA PLC	FOUR (4): 2/C-#16 (BELDEN 8719 EACH) FOR WET WELL WEST AND WET WELL EAST LEVEL, FLOW METER NO. 1 AND FLOW METER NO. 2 4-20mA ANALOG SIGNALS.
C18	1-1/4"	FOUR - 2/C #16 TW-SH	LIQUID LEVEL CONTROLS	NEW ACE3600 CABINET	FOUR (4): 2/C-#16 (BELDEN 8719 EACH) FOR WET WELL WEST AND WET WELL EAST LEVEL; FLOW METER NO. 1 AND FLOW METER NO. 2 4-20mA ANALOG SIGNALS.
C19	1-1/2"	32-#14 + 1-#12 GND	NEW ACE3600 CABINET	EXISTING SCADA PLC	WET WELL HIGH, DRY WELL HIGH, PUMP NO. 1 RUNNING, PUMP NO. 1 READY, PUMP NO. 2 RUNNING, PUMP NO. 2 READY, PUMP NO. 3 RUNNING, PUMP NO. 3 READY, TECO POWER, MAIN CIRCUIT BREAKER, GEN RUNNING, GEN FIRE ALARM AND LOW PSI SIGNALS. COUNT INCLUDES SPARES.
C20	3/4"	6-#14 + 1-#12 GND	LIQUID LEVEL CONTROLS	NEW ACE3600 CABINET	WET WELL HIGH, DRY WELL HIGH AND LOW PSI SIGNALS. COUNT INCLUDES SPARES. CONTRACTOR TO FIELD VERIFY ORIGIN OF RELAY CONTACTS.
C21	3/4"	6-#14 + 1-#12 GND	MCC/ATS	NEW ACE3600 CABINET	TECO POWER AVAILABLE AND MAIN CIRCUIT BREAKER OPEN SIGNALS. COUNT INCLUDES SPARES. CONTRACTOR TO FIELD VERIFY ORIGIN OF RELAY CONTACTS.
C22	3/4"	6-#14 + 1-#12 GND	GENERATOR CONTROL PANEL	NEW ACE3600 CABINET	GENERATOR RUNNING AND GENERATOR FIRE ALARM SIGNALS. COUNT INCLUDES SPARES. CONTRACTOR TO FIELD VERIFY ORIGIN OF RELAY CONTACTS.



As Built Drawings
Granger Maint. & Constr. Inc.
John H. Granger, President

John H. Granger 10/22/2022
Signature Date

No Changes

TIMOTHY THOMAS, P.E. #47079

No.	DATE	REVISIONS
3		
2		
1	11-9-18	ACE3600 ADDITION REVISION


DES: TDT
DRN: JLH
CKD: TDT
DATE: 11/21/16

CITY of TAMPA
WASTEWATER DEPARTMENT

UNIVERSITY P.S.
PUMP NO. 1 REPLACEMENT
CONDUIT AND CABLE SCHEDULE

W.O. 4511
SHEET
E21
OF

NO Changes *Trigon* 3/17/22

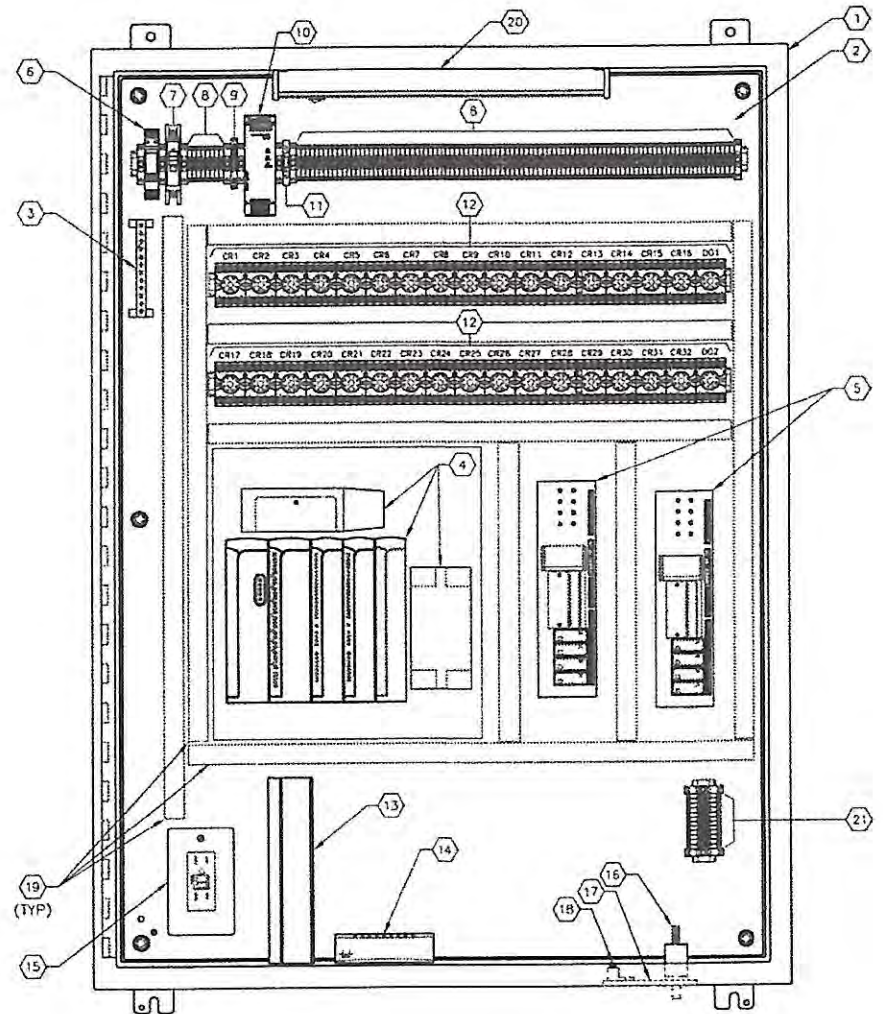

**PROPOSED ACE3600 CABINET
INTERIOR ELEVATION**
SCALE : NOT TO SCALE



ENTIRE SHEET IS NEW TO CONTRACT DOCUMENT SET

KEYED NOTES:

- 1 PROVIDE AND INSTALL 48" X 36" X 10" NEMA 4X 316 SS ENCLOSURE WITH 3-POINT PADLOCKABLE LATCHING SYSTEM AND DOOR STOP KIT, HAMMOND HW483610S16HK.
- 2 PROVIDE AND INSTALL BACKPANEL, HAMMOND 18P4533.
- 3 PROVIDE AND INSTALL GROUND BAR SYSTEM PANDUIT UGBZ/0-414-12
- 4 PROVIDE AND INSTALL ONE (1) MOTOROLA ACE3600 PLC-3640 CPU, PART#: V446; ONE (1) AC POWER SUPPLY 100-240V, PART#: V261; ONE (1) ACE MIXED I/O MODULE-16DI, 4DO(EE), (4)±20mA ANALOG IN, PART#: V245 WITH 24VDC PLUG-IN; TWO (2) BLANK I/O MODULES PART#: V20, ONE (1) 40 WIRE CABLE WITH TB HOLDER 3M, PART#: V358; ONE (1) 20 PIN TB HOLDER KIT, PAT# V158; ONE (1) 40 PIN TB HOLDER KIT, PART#: V153; ONE (1) ACE3600 3-SLOT FRAME, PART#: V103; ONE (1) METAL CHASSIS, PART#: V214; ONE (1) MOTOROLA XPR5350 RADIO; ONE (1) 10Ah 12V DC BATTERY AND CABLES, PART#: V328
- 5 PROVIDE AND INSTALL TWO (2)-MIXED I/O AUXILIARY INTERFACES, WILKERSON BOARD, PART# SIB V245/V453.
- 6 PROVIDE AND INSTALL 120V AC SURGE PROTECTION DEVICE, PHOENIX CONTACT #2905228.
- 7 PROVIDE AND INSTALL 120V, 15 AMPERE, SINGLE-POLE CIRCUIT BREAKER, SQUARE D QOU-115.
- 8 PROVIDE AND INSTALL TERMINAL BLOCKS, 30 AMPERE RATING, PHOENIX CONTACT UK5N TYPE.
- 9 PROVIDE AND INSTALL 120V, 1 AMPERE THERMAL CIRCUIT BREAKER, THERMAL CIRCUIT BREAKERS SHALL BE PHOENIX CONTACT TCP TYPE, PROVIDE WITH SCREW TYPE CONNECTION, FUSE BASE TERMINAL BLOCK, PHOENIX CONTACT TYPE UK 6-FS1/C.
- 10 PROVIDE AND INSTALL 120VAC-24VDC POWER SUPPLY WITH 5 AMPERE OUTPUT, PHOENIX CONTACT #2866750.
- 11 PROVIDE AND INSTALL FUSED TERMINAL BLOCK, PHOENIX CONTACT UK 5-HESI TYPE, PROVIDE 5 A FUSE WITH TERMINAL BLOCK.
- 12 PROVIDE AND INSTALL 3PDT RELAYS WITH 24V DC COILS AND 10 AMPERE CONTACTS, POTTER AND BRUMFIELD KRPA-14AG-24, B PIN PLUG-IN TYPE, PROVIDE SOCKET AND HOLD DOWN SPRING FOR EACH RELAY.
- 13 EXISTING CISCO RV042 WAN ISP ROUTER TO BE RELOCATED FROM THE MOSCAD L RTU TO BE REPLACED UNDER THIS REVISION.
- 14 EXISTING ARRIS DG1670 CABLE MODEM TO BE RELOCATED FROM THE MOSCAD L RTU TO BE REPLACED UNDER THIS REVISION.
- 15 PROVIDE AND INSTALL GF1 RECEPTACLE, HUBBELL, GFR53521A OR EQUAL FOR CABLE MODEM AND CISCO RV042 ROUTER.
- 16 PROVIDE AND INSTALL 300 MHz TO 1.2 GHz COAXIAL RF SURGE PROTECTOR, IPOLYPHASER IUSX-NFF, (VERIFY COAXIAL CABLE CONNECTION REQUIREMENTS PRIOR TO ORDERING)
- 17 PROVIDE AND INSTALL 2" X 5" L X 1/4" COPPER GROUNDING PLATE (CUSTOM).
- 18 PROVIDE AND INSTALL SINGLE BARREL ONE-HOLE COPPER GRPOUNDING LUG, PANDUIT HLT-25-X.
- 19 PROVIDE AND INSTALL 1"X3" PANDUIT (OR EQUAL) WIRING SYSTEM WITH COVERS (TYPICAL).
- 20 PROVIDE AND INSTALL 120V AC LED CABINET LIGHT WITH INTEGRAL LIGHT SWITCH, HAMMOND FLK7LED.
- 21 PROVIDE AND INSTALL TERMINAL BLOCKS FOR 4-20mA SIGNALS AND SHIELDS, PHOENIX CONTACT UK5N TYPE.

GENERAL NOTES:

- 1 PROVIDE AND INSTALL ALL ASSOCIATED END BARRIERS, TERMINAL JUMPERS AND SPACERS AS REQUIRED FOR TERMINAL BLOCKS, FUSE HOLDERS AND DEVICES SHOWN OR REQUIRED.
- 2 PROVIDE AND INSTALL 35mm ALUMINUM DIN RAIL (AUTOMATION DIRECT DN-R35SA1) QUANTITY AS REQUIRED.
- 3 PROVIDE AND INSTALL CORROSION INHIBITOR, HOFFMAN # AHC110E.

As-Built Drawings
Granger Maint. & Constr. Inc.
John H. Granger, President
John H. Granger 6/22/2022
Signature Date
 No Changes



No.	DATE	REVISIONS	DES: TDT
3			DRN: JLH
2			CKD: TDT
1	1-7-19	ACE3600 ADDITION REVISION	DATE: 11/21/16

TIMOTHY THOMAS, P.E. #47079

CITY of TAMPA
WASTEWATER DEPARTMENT

UNIVERSITY P.S.
PUMP NO. 1 REPLACEMENT
ACE3600 CABINET DETAILS



W.O. 4511
SHEET
E22
OF

NO CHANGES

Handwritten signature

3/17/22

ENTIRE SHEET IS NEW TO CONTRACT DOCUMENT SET

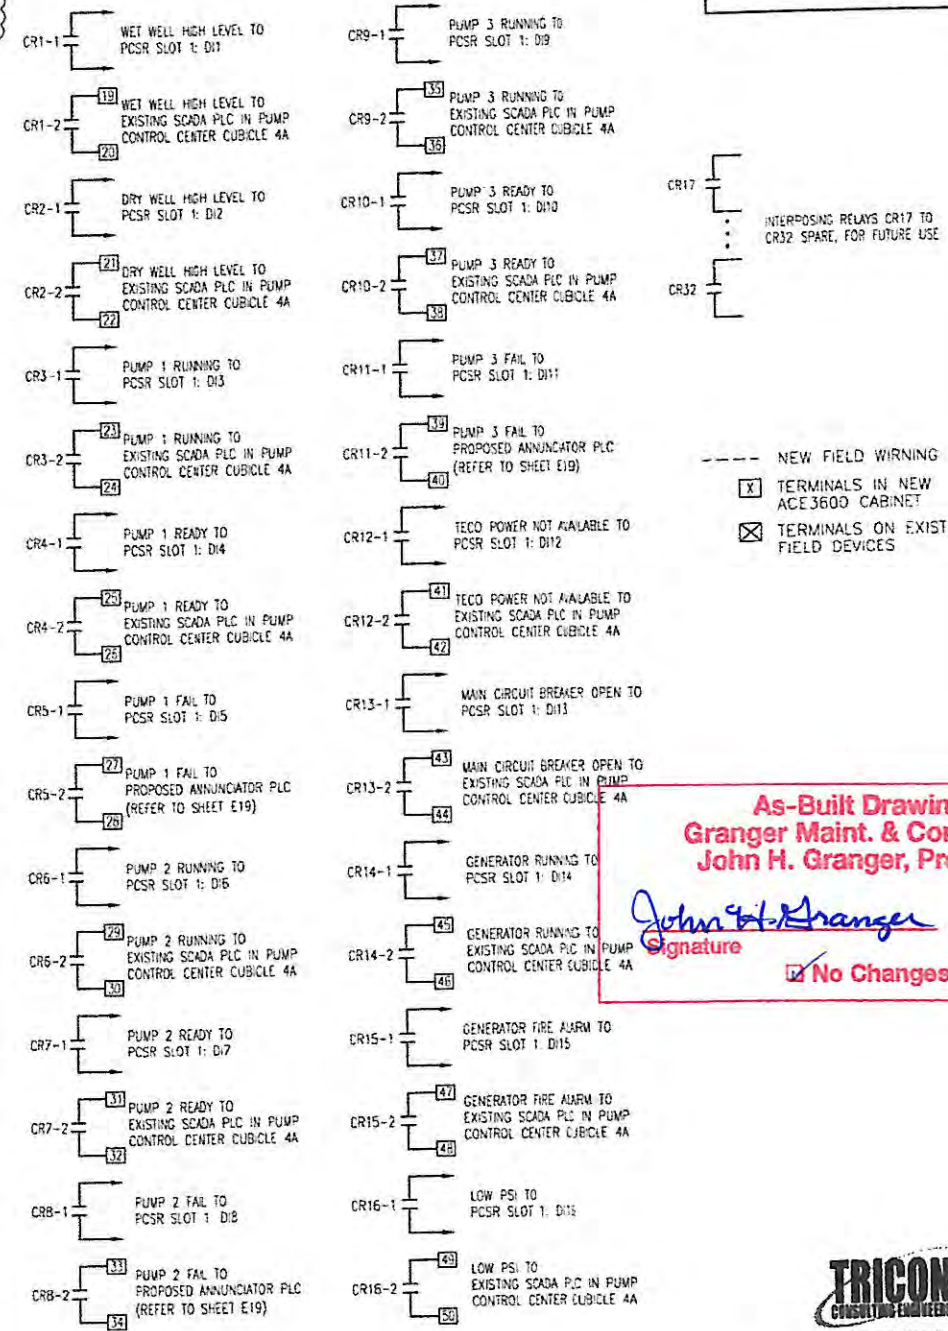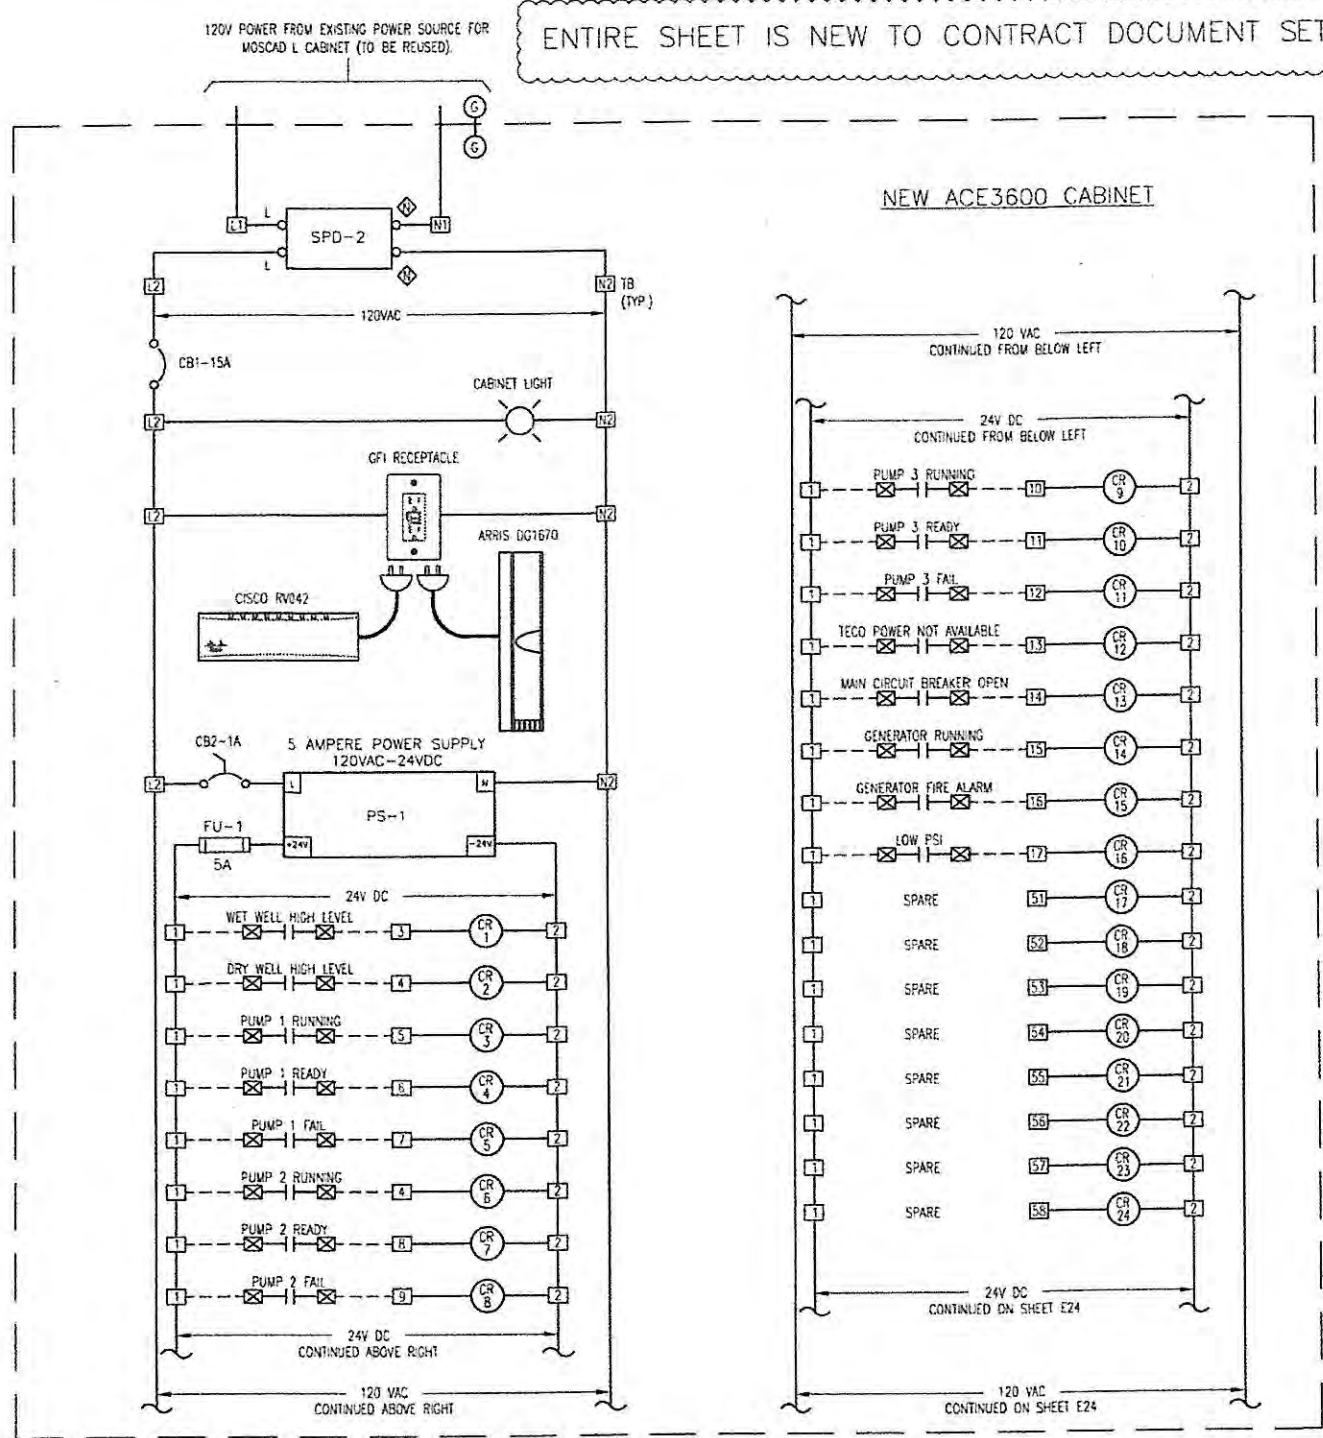

As-Built Drawings
Granger Maint. & Constr. Inc.
John H. Granger, President
John H. Granger 6/22/2022
 Signature Date
 No Changes



No.	DATE	REVISIONS
3		
2		
1	1-7-19	ACE3600 ADDITION REVISION

TIMOTHY THOMAS, P.E. #47079

DES: TDT
 DRN: JLH
 CKD: TDT
 DATE: 11/21/16


CITY of TAMPA
 WASTEWATER DEPARTMENT

UNIVERSITY P.S.
 PUMP NO. 1 REPLACEMENT
 ACE3600 WIRING SCHEMATIC (1 OF 3)


W.O. 4511
 SHEET
E23
 OF

No Changes
Tracy 5/17/22



ENTIRE SHEET IS NEW TO CONTRACT DOCUMENT SET

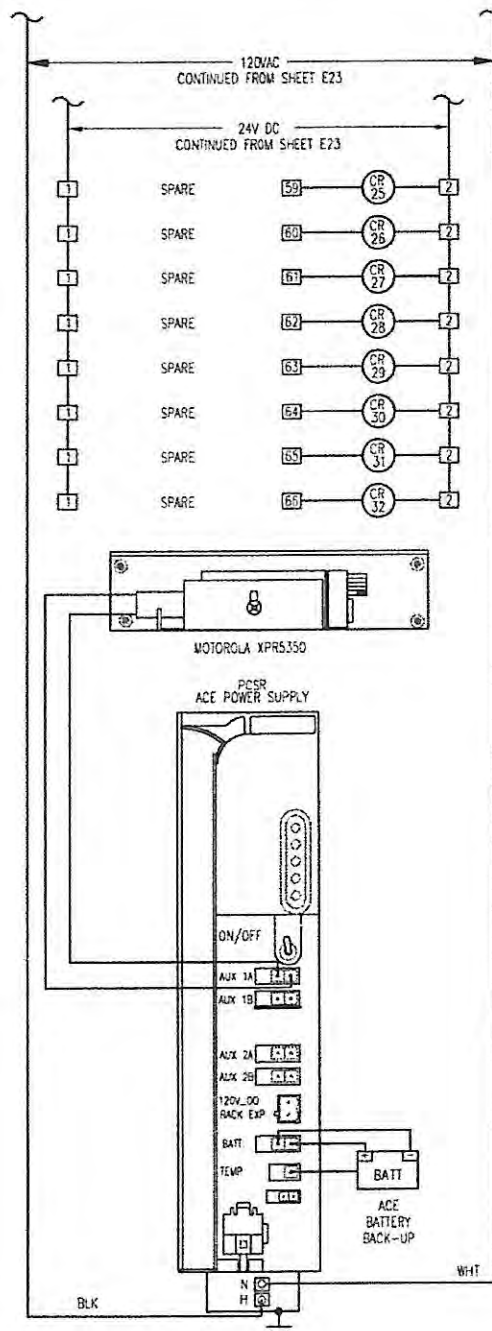

- TERMINALS ON ACE I/O MODULE (GENERAL)
- ⊠ TERMINALS IN NEW ACE3600 CABINET
- ⊗ TERMINALS ON FIELD DEVICES

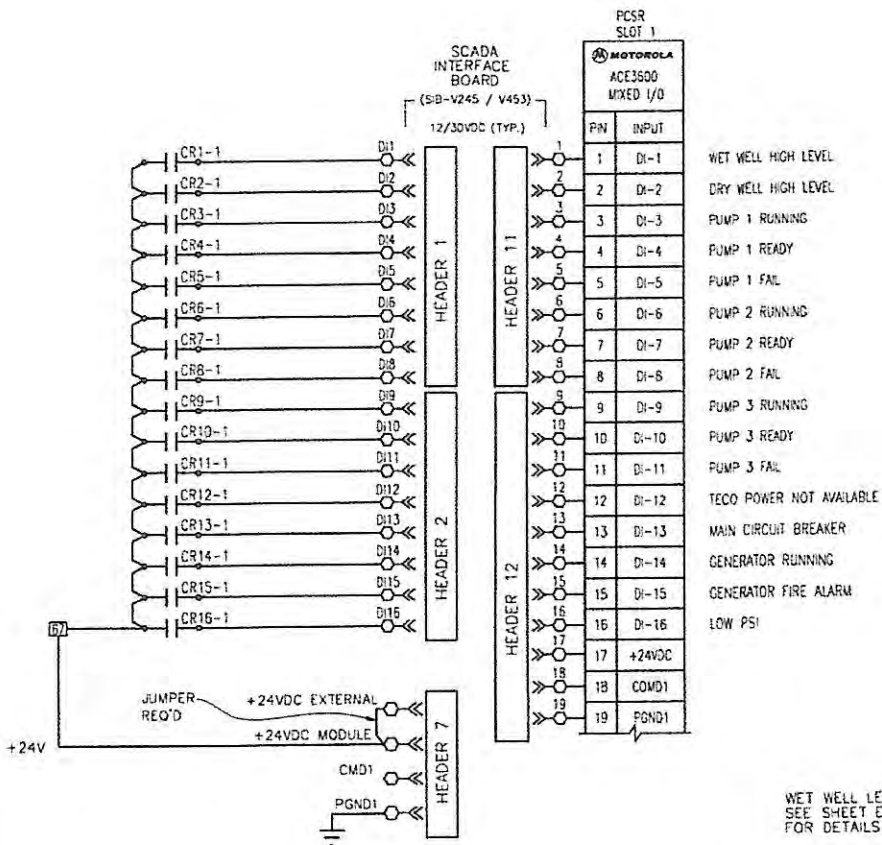


As-Built Drawings
Granger Maint. & Constr. Inc.
John H. Granger, President
John H. Granger 6/22/2022
 Signature Date
 No Changes

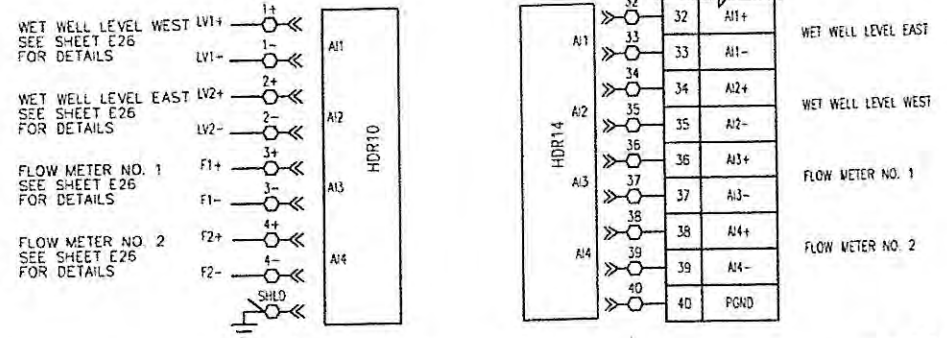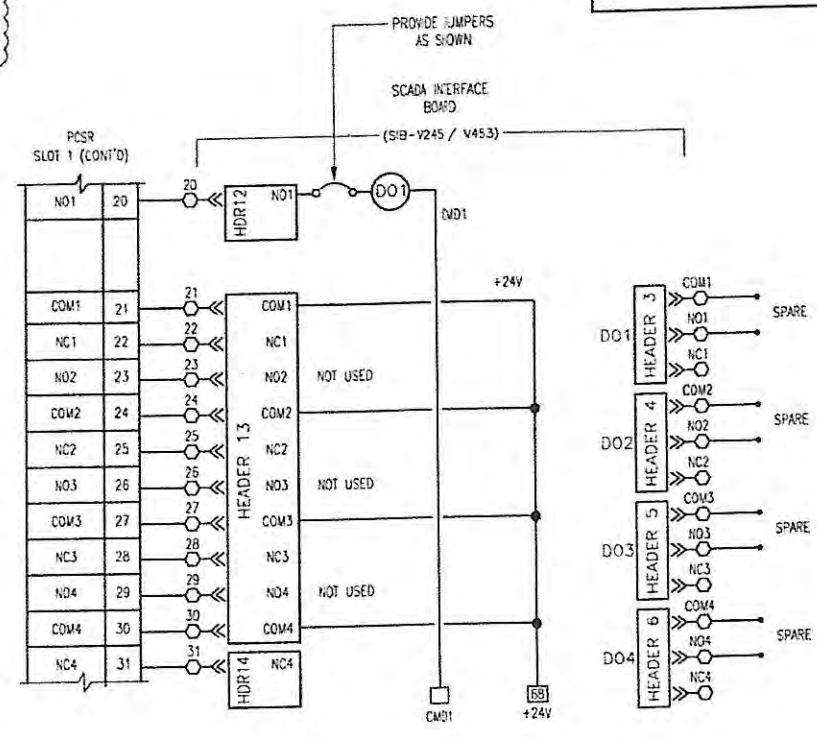

TIMOTHY THOMAS, P.E. #47079	No.	DATE	REVISIONS	DES: TDT	CITY of TAMPA WASTEWATER DEPARTMENT	UNIVERSITY P.S. PUMP NO. 1 REPLACEMENT ACE3600 WIRING SCHEMATIC (2 OF 3)	W.O. 4511
	3			DRN: JLH			SHEET
	2			CKD: TDT			E24
	1	1-7-19	ACE3600 ADDITION REVISION	DATE: 11/21/16			OF

No Changes JH Granger
5/17/22

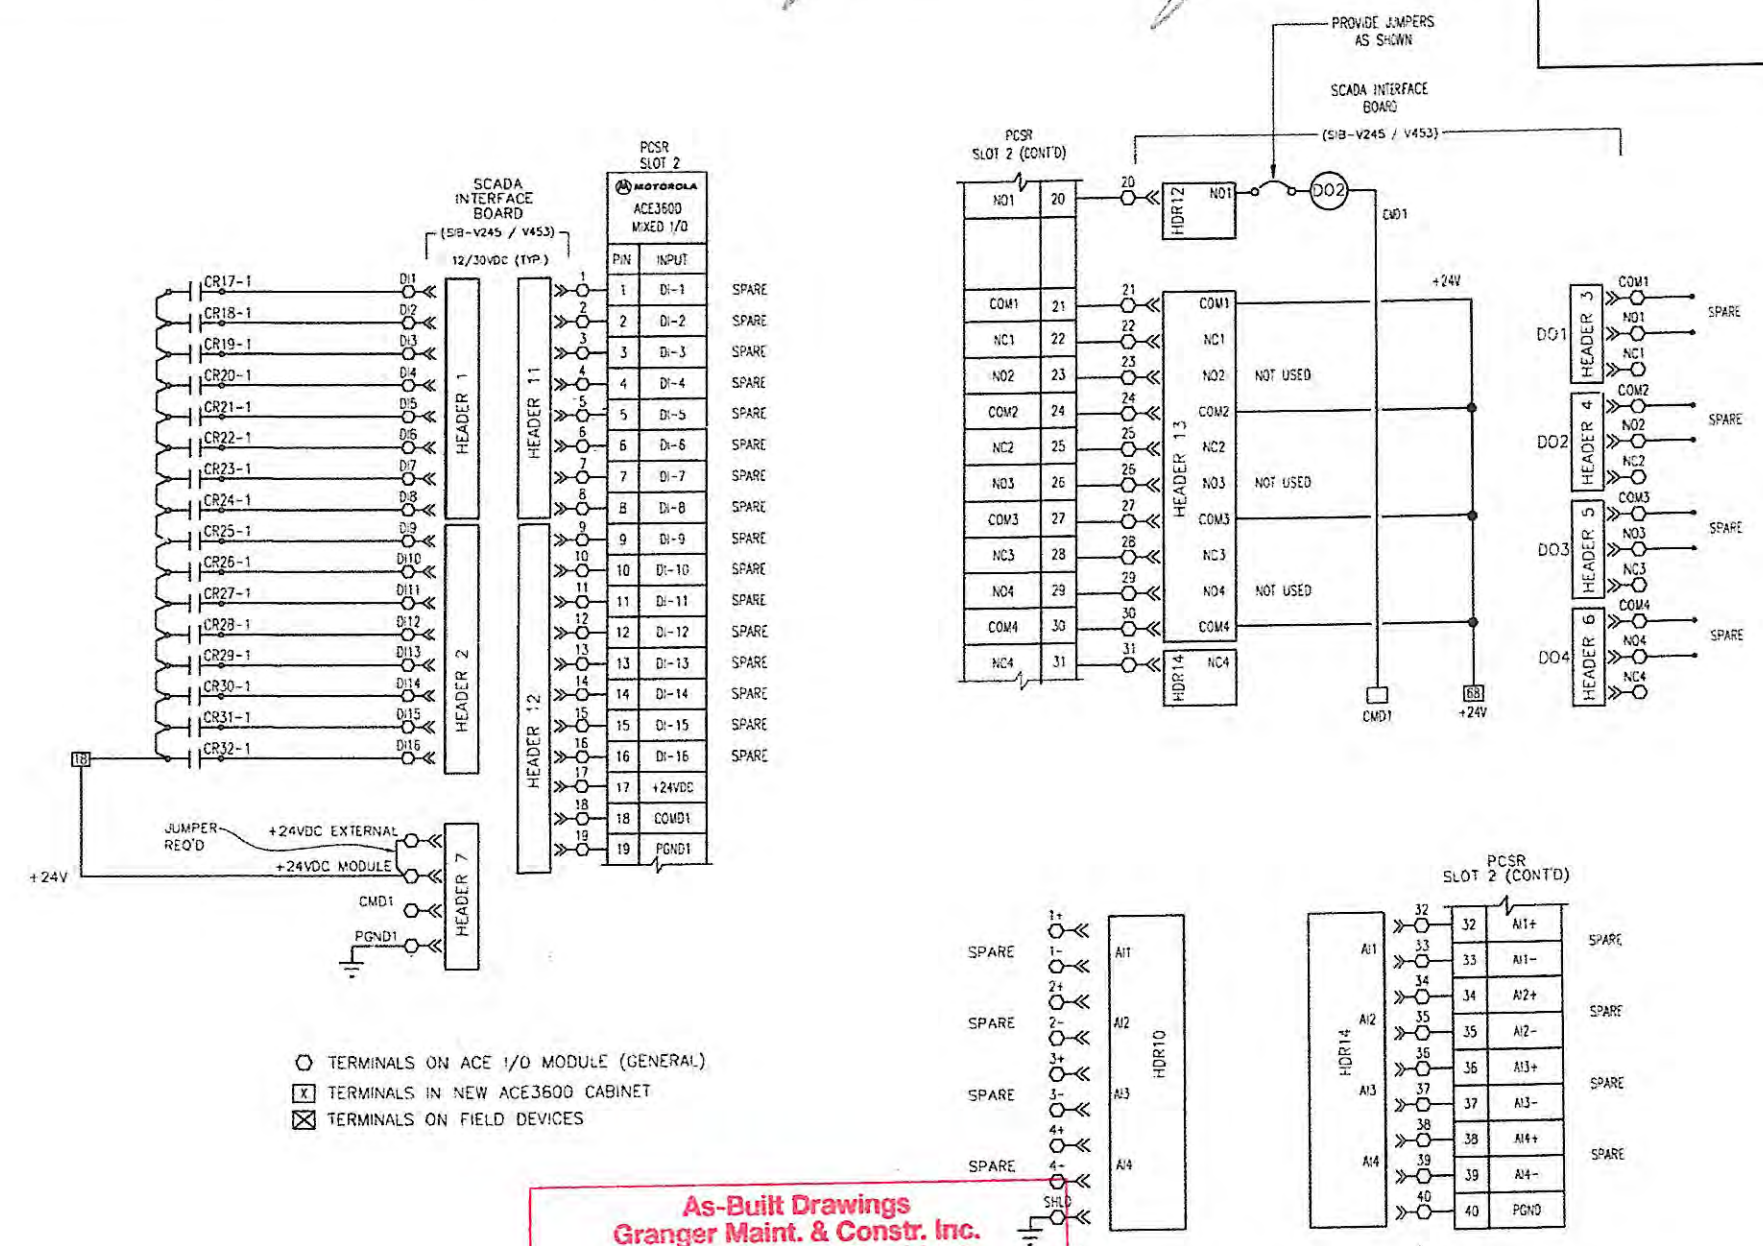

- TERMINALS ON ACE I/O MODULE (GENERAL)
- ⊗ TERMINALS IN NEW ACE3600 CABINET
- ⊗ TERMINALS ON FIELD DEVICES

As-Built Drawings
Granger Maint. & Constr. Inc.
John H. Granger, President
John H. Granger 6/22/2022
 Signature Date
 No Changes

ENTIRE SHEET IS NEW TO CONTRACT DOCUMENT SET



TIMOTHY THOMAS, P.E. #47079	No.	DATE	REVISIONS	DES: TDT	CITY of TAMPA WASTEWATER DEPARTMENT	UNIVERSITY P.S. PUMP NO. 1 REPLACEMENT ACE3600 WIRING SCHEMATIC (3 OF 3)	W.O. 4511
	3			DRN: JLH			SHEET
	2			CKD: TDT			E25
	1	1-23-19	ACE3600 ADDITION REVISION	DATE: 11/21/16			OF


No Changes

Trigon

5/17/22

ENTIRE SHEET IS NEW
TO CONTRACT DOCUMENT SET

- GENERAL NOTES:**
- EXISTING SCALES, DIGITAL PROCESS METERS, SURGE PROTECTION DEVICES, ETC. NOT SHOWN FOR CLARITY.
 - 120V AC POWER CIRCUIT AND THERMAL CIRCUIT BREAKERS REQUIRED FOR NEW SIGNAL ISOLATOR/CONVERTERS, NOT SHOWN FOR CLARITY. REFER ALSO TO SHEET E4.

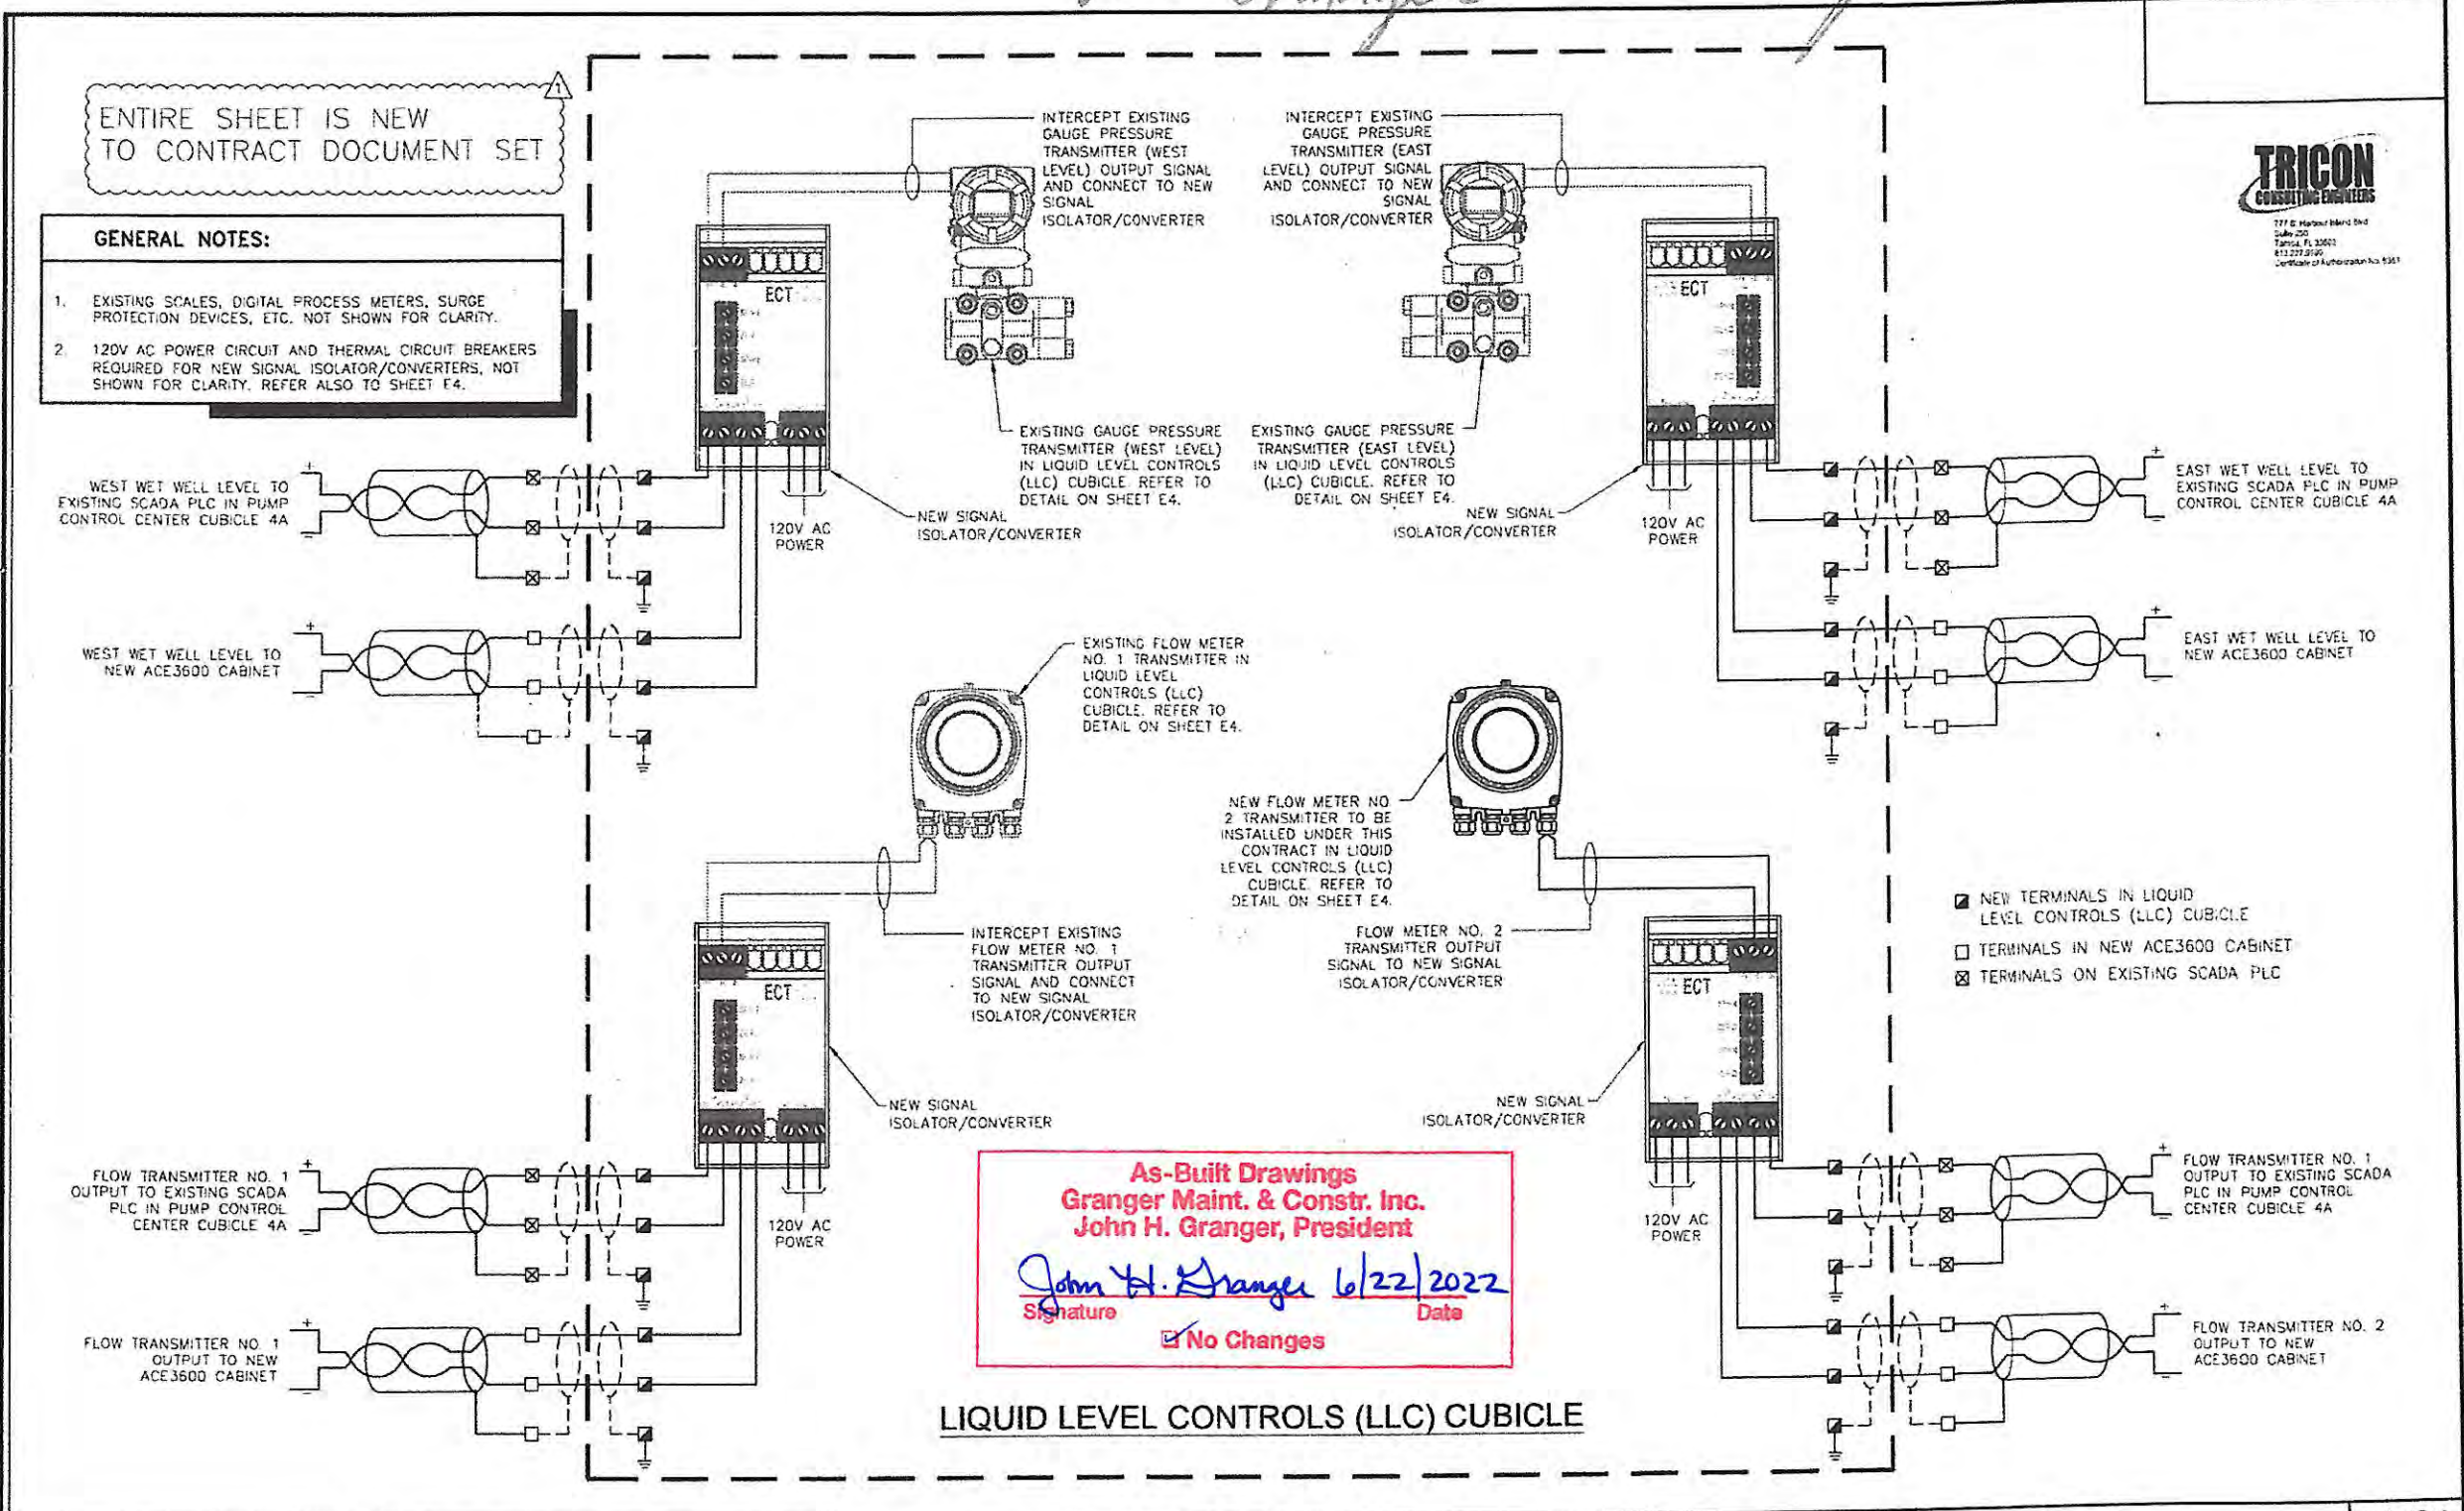


As-Built Drawings
Granger Maint. & Constr. Inc.
John H. Granger, President
John H. Granger 6/22/2022
 Signature Date
 No Changes

LIQUID LEVEL CONTROLS (LLC) CUBICLE

TIMOTHY THOMAS, P.E. #47079	No.	DATE	REVISIONS	DES: TDT	CITY of TAMPA WASTEWATER DEPARTMENT	UNIVERSITY P.S. PUMP NO. 1 REPLACEMENT LLC WIRING MODIFICATION DIAGRAM	W.O. 4511
	3			DRN: JLH			SHEET
	2			CKD: TDT			E26
	1	1-7-19	ACE3600 ADDITION REVISION	DATE: 11/21/16			OF

NO Changes

Tricon
5/17/22

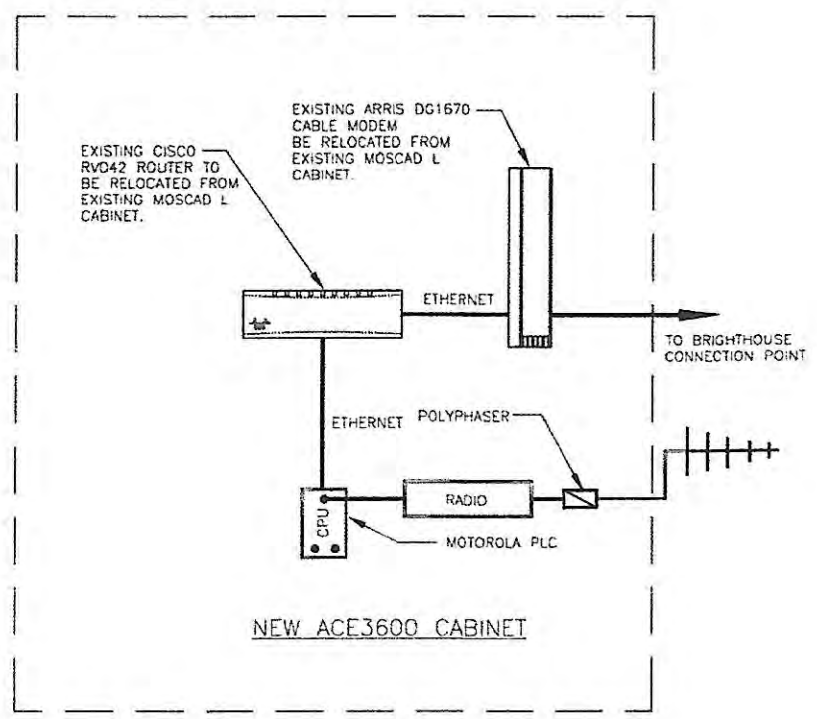

COMMUNICATIONS RISER DIAGRAM

As-Built Drawings
Granger Maint. & Constr. Inc.
John H. Granger, President
John H. Granger 6/22/2022
Signature Date
 No Changes

ENTIRE SHEET IS NEW TO CONTRACT DOCUMENT SET




TIMOTHY THOMAS, P.E. #47079	No.	DATE	REVISIONS	DES: TDT	CITY of TAMPA WASTEWATER DEPARTMENT	UNIVERSITY P.S. PUMP NO. 1 REPLACEMENT COMMUNICATIONS RISER DIAGRAM	W.O. 4511
	3			DRN: JLH			SHEET
	2			CKD: TDT			E27
	1	1-7-19	ACE3600 ADDITION REVISION	DATE: 11/21/16			OF




CITY OF TAMPA, FLORIDA UNIVERSITY PUMPING STATION AUTOMATIC BAR SCREEN

AUGUST 2018


CONTRACT: 18-C-00016

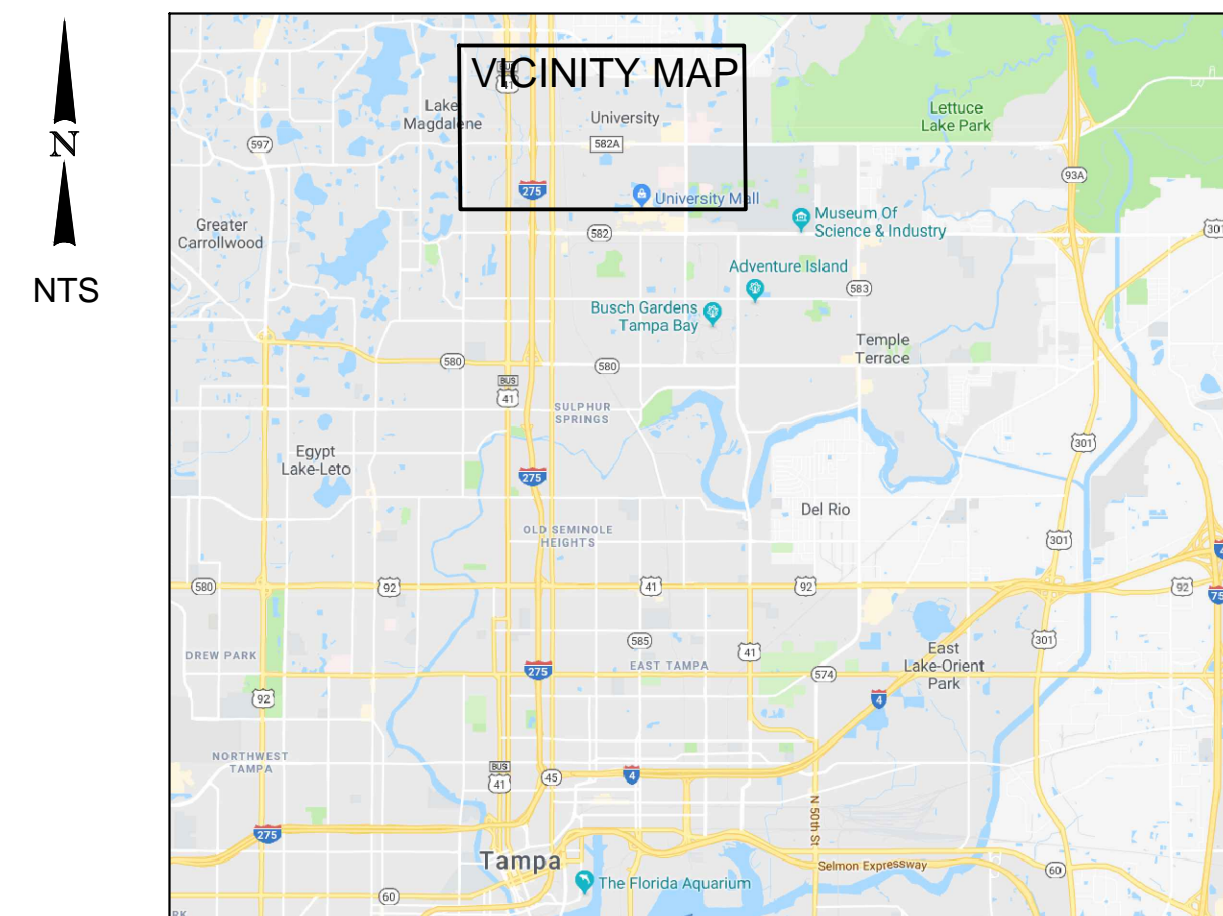

LOCATION MAP
NTS

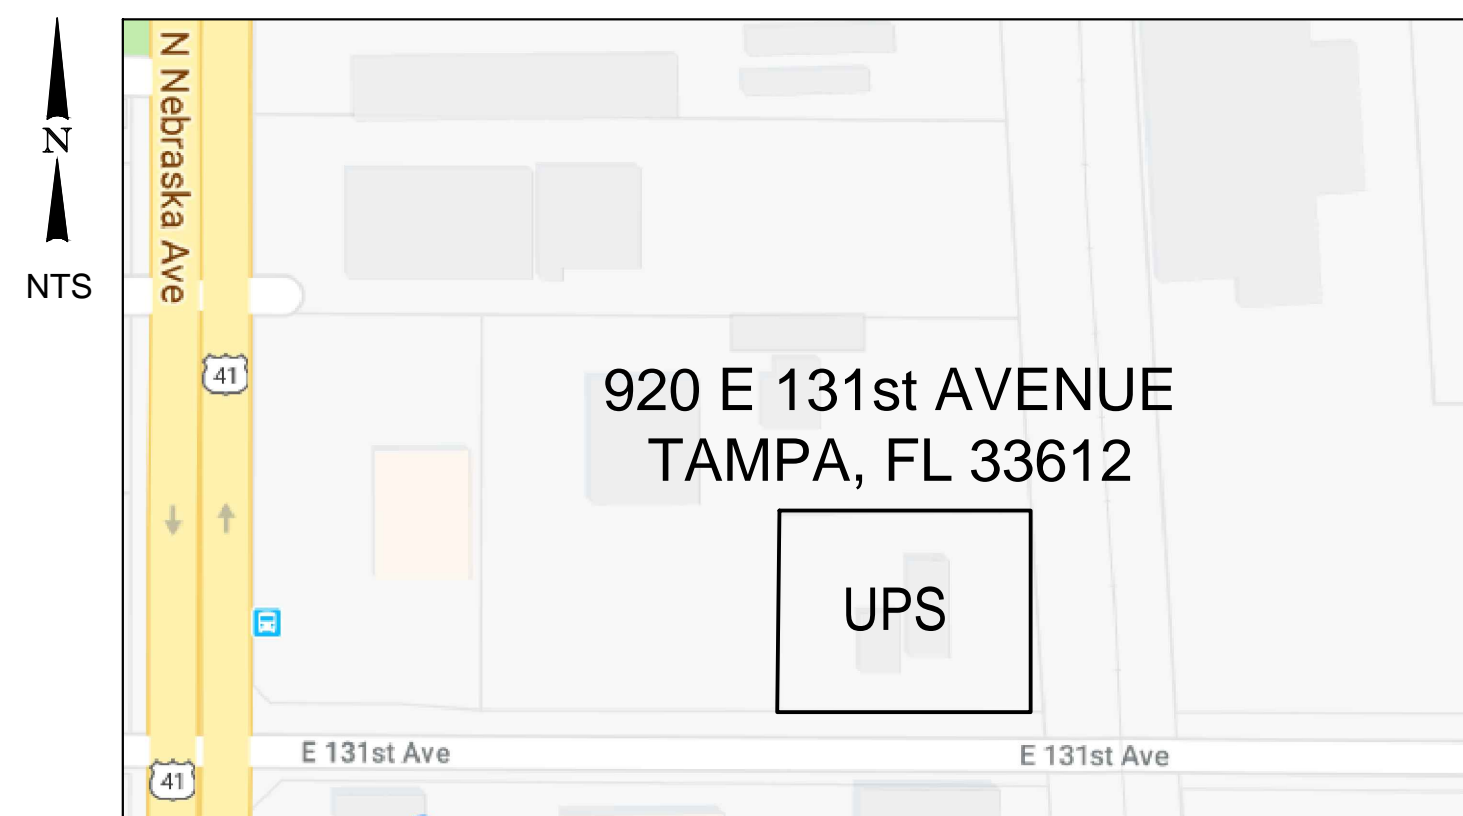

VICINITY MAP
NTS

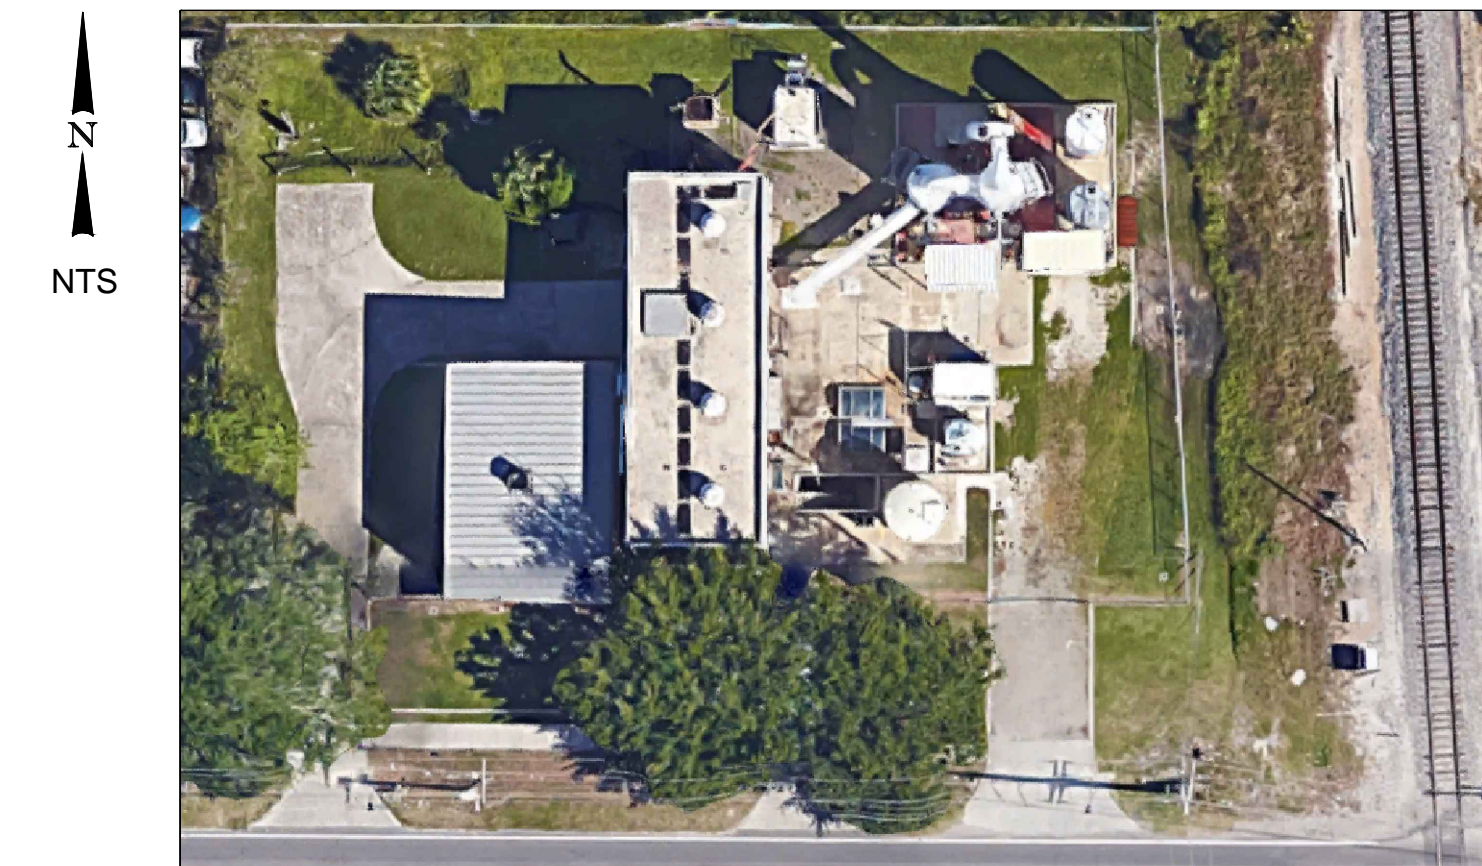

UNIVERSITY PUMPING STATION
NTS

All Drawings Within Drawing Set Are To Be Considered As-Builts.




302 Knights Run Avenue,
Suite 900
Tampa, FL 33602
813.254.5838
FIRM'S FLORIDA
CERT. NO.
AAP000034/CA3806
IB26000797/LC26000381



777 S. Harbour Island Blvd.
Suite 250
Tampa, FL 33602
813.227.9190
Certificate of Authorization No. 8363

P:\4291800\WG00.DWG

DESIGNED				
DRAWN				
CHECKED				
REV. NO.	DATE	DESCRIPTION	REV. BY	
		JOSEPH B. BARKSDALE, PE 46545 GRESHAM SMITH & PARTNERS GENERAL / MECHANICAL	JASON FUKUDA, PE 66000 GRESHAM SMITH & PARTNERS STRUCTURAL	TIMOTHY D. THOMAS, PE - FPE 47079 TRICON CONSULTING ENGINEERS ELECTRICAL
				PROJECT: CITY OF TAMPA UNIVERSITY PUMPING STATION AUTOMATIC BAR SCREEN
		DESCRIPTION: COVER PAGE		DATE: AUGUST 2018 GSP JOB No. 4291800 SHEET: G-0 1 OF 27

SHEET INDEX

SHEET #	SHEET	DESCRIPTION
GENERAL		
1	G-0	COVER PAGE
2	G-1	SHEET INDEX, ABBREVIATION, GENERAL NOTES, AND REFERENCE SYMBOLS
MECHANICAL		
3	M-1	EXISTING SITE PLAN - KEY PLAN
4	M-2	UPPER PLAN LAYOUT AND DEMOLITION
5	M-3	LOWER PLAN DEMOLITION
6	M-4	UPPER PLAN
7	M-5	SECTIONS
8	M-6	LOWER PLAN - SECTIONS AND DETAILS
9	M-7	MECHANICAL STANDARD DETAILS
STRUCTURAL		
10	S-1	STRUCTURAL GENERAL NOTES
11	S-2	UPPER PLAN AND SECTION AND ISOMETRIC VIEW
12	S-3	LOWER PLAN
13	S-4	CONCRETE REPAIR PHOTOS
14	S-5	REPAIR DETAILS
15	S-6	STRUCTURAL DETAILS
ELECTRICAL		
16	E-1	LEGEND, ABBREVIATIONS AND NOTES
17	E-2	EXISTING SITE PLAN
18	E-3	ELECTRICAL PLAN - ELEVATION 41.17'
19	E-4	HAZARDOUS AREA IDENTIFICATION
20	E-5	PUMPING STATION ELEVATION 41.25' ELECTRICAL PLAN
21	E-6	EXISTING ANNUNCIATOR CONTROL PANEL INTERIOR DETAIL
22	E-7	EXISTING ANNUNCIATOR CONTROL PANEL NEW MODULE WIRING
23	E-8	SLIDE GATE ACTUATOR CONTROL WIRING
24	E-9	CONTACT DEVELOPMENT DIAGRAM
25	E-10	ACTUATOR DISCONNECT DETAIL
26	E-11	PROPOSED ANNUNCIATOR ADDITIONS SAMPLE SCREEN
REFERENCE FILE		
27	REF-1	JUNCTION CHAMBER DETAILS

ABBREVIATIONS

ABS	AUTOMATIC BAR SCREEN
BIO	BIOXIDE
CONC	CONCRETE
CPVC	CHLORINATED POLYVINYL CHLORIDE
DN	DOWN
DIP	DUCTILE IRON PIPE
DTR	DUMPSTER
EOP	EDGE OF PAVEMENT
FM	FORCE MAIN
MG	MAGNESIUM HYDROXIDE
MH	MANHOLE
MOT	MAINTENANCE OF TRAFFIC
POT	POTABLE WATER
PVC	POLYVINYL CHLORIDE
RCP	REINFORCED CONCRETE PIPE
SS	STAINLESS STEEL
SG	SLIDE GATE
TNK	TANK
WC	WASHING COMPACTOR
Ø	DIAMETER

GENERAL NOTES

- G-1. CONTRACTOR SHALL COORDINATE ALL CONSTRUCTION ACTIVITIES WITH CONTRACT ADMINISTRATOR DEPARTMENT, WASTEWATER PERSONNEL AND PUMPING STATION OPERATIONS.
- G-2. EXISTING DIMENSIONS AND ELEVATIONS ARE BASED ON THE BEST INFORMATION AVAILABLE. TRUE DIMENSIONS AND ELEVATIONS SHALL BE DETERMINED IN THE FIELD BY THE CONTRACTOR PRIOR TO LAYOUT AND SHOP DRAWING SUBMITTALS.
- G-3. ALL SUBMITTALS AND SHOP DRAWINGS SHALL BE ORIGINALS OR HIGH-QUALITY COPIES (EASILY READABLE). NO FAXED SHEETS OR POOR QUALITY COPIES WILL BE ACCEPTED FOR SUBMITTAL REVIEW.
- G-4. MECHANICAL AND ELECTRICAL EQUIPMENT TO BE LOCKED OUT SHALL BE LOCKED OUT WITH A MULTIPLE-LOCK MASTER LOCK-OUT DEVICE, WHICH SHALL BE INSTALLED BY CITY PERSONNEL AND LOCKED BY BOTH THE CITY PERSONNEL AND CONTRACTOR.
- G-5. THE CONTRACTOR IS RESPONSIBLE FOR PROVIDING, INSTALLING, LEVELING AND ALIGNING EQUIPMENT, GATES, AND VALVES.
- G-6. PROPOSED SLIDE GATE VALVE SHALL BE A STAINLESS-STEEL SLIDE GATE, AS MADE BY RODNEY HUNT OR EQUAL; SEE SPECIFICATIONS FOR DETAILS. SLIDE GATE VALVE SHALL BE EQUIPPED WITH ELECTRIC POWERED ACTUATOR, AS MADE BY ROTORK, LIMITORQUE, OR EQUAL; SEE SPECIFICATIONS FOR DETAILS.
- G-7. PROPOSED AUTOMATIC BAR SCREEN AND WASHER COMPACTOR SHALL BE STAINLESS STEEL AS MADE BY HYDRODYNE INC. OR EQUAL, SEE SPECS FOR DETAILS.
- G-8. ANCHOR BOLTS SHALL BE AS PER SCREEN MANUFACTURER'S RECOMMENDATIONS. ANCHOR BOLTS SHALL BE DOUBLE-NUTTED AND FINISHED WITH NON-SHRINK GROUT. ALL BOLTS SHALL EXTEND BEYOND THE FASTENING NUTS BY A MINIMUM OF 1/2-INCH.
- G-9. ALL STEEL AND HARDWARE, UNLESS OTHERWISE NOTED, SHALL BE TYPE 316 STAINLESS STEEL.
- G-10. ALL CEMENTITIOUS CONCRETE AND GROUT, UNLESS OTHERWISE SPECIFIED, SHALL BE CLASS "B" 4000 PSI COMPRESSIVE STRENGTH AT 28 DAYS.
- G-11. EXPOSED CONCRETE CORNERS SHALL HAVE A 3/4" CHAMFER AND RE-ENTRANT CORNERS SHALL HAVE A 3/4" FLAT FILLET UNLESS OTHERWISE NOTED.
- G-12. CONCRETE PEDESTAL SHOP DRAWINGS INCLUDING FLANGE SUPPORT DETAILS SHALL BE SUBMITTED FOR APPROVAL.
- G-13. ALL STEEL REINFORCING SHALL BE DETAILED ACCORDING TO THE LATEST "ACI MANUAL OF STANDARD PRACTICE FOR DETAILING REINFORCED CONCRETE STRUCTURES". ACTUAL PLACEMENT OF STEEL REINFORCING SHALL BE SHOWN ON SHOP DRAWINGS. ALL LAPS AND SPLICES SHALL BE AT LEAST 32 BAR DIAMETERS OR 24 INCHES.
- G-14. CERTAIN PORTIONS OF THIS PROJECT MAY REQUIRE NIGHT TIME WORK.
- G-15. ALL NOTES PERTAINING TO PROPOSED WORK INSIDE SCREEN ROOM ARE LOCATED ON PERTINENT SHEETS.
- G-16. ALL WORK SHALL BE PERFORMED IN ACCORDANCE WITH THE FLORIDA BUILDING CODE 6TH EDITION 2017, AND CHAPTER 5 OF THE CITY OF TAMPA CODE.
- G-17. CONTRACTOR SHALL REMOVE EXISTING WET WELL STOP LOGS FOR THE REPLACEMENT WITH SLIDE GATE.
- G-18. CONFIGURATION FOR THE PROPOSED SLIDE GATE VALVE ACTUATORS SHALL BE AS INDICATED IN THE PLANS.
- G-19. ALL ELECTRICAL WORK SHALL BE PERFORMED IN ACCORDANCE WITH THE FLORIDA BUILDING CODE 6TH EDITION 2017, CHAPTER 5 OF THE CITY OF TAMPA CODE AND THE NATIONAL FIRE PROTECTION ASSOCIATION (NFPA) SERIES 70/NATIONAL ELECTRICAL CODE (NEC) 2014 EDITION.
- G-20. CONTRACTOR SHALL OBTAIN A TEMPORARY TRAFFIC CONTROL PERMIT FOR THE ROAD CLOSURE INCLUDING A CERTIFIED MOT.

DEMOLITION NOTES

- D-1. ALL DIMENSIONS ARE APPROXIMATE. TRUE DIMENSIONS SHALL BE DETERMINED IN THE FIELD.
- D-2. SALVAGEABLE MATERIAL, AS DETERMINED BY DEPARTMENT PERSONNEL, SHALL BE DELIVERED TO THE CITY OF TAMPA'S HOWARD F. CURREN AWTP AT 2700 MARITIME BOULEVARD. NON-SALVAGEABLE MATERIALS ARE TO BE REMOVED FROM THE SITE AND PROPERLY DISPOSED OF AT THE CONTRACTOR'S EXPENSE. IN GENERAL, ALL PUMPS AND CONTROLS EQUIPMENT SHALL REMAIN PROPERTY OF THE CITY AND SHALL BE DELIVERED TO THE TREATMENT PLANT.
- D-3. EXISTING MANUALLY RAKED BAR SCREEN SHALL BE SALVAGED AND DELIVERED TO THE TREATMENT PLANT.
- D-4. THE PUMP STATION SITE SHALL BE MAINTAINED IN AS NEAT AND ORDERLY CONDITION AS POSSIBLE DURING CONSTRUCTION OPERATIONS. WALKWAYS AND DRIVEWAYS SHALL BE KEPT CLEAR FOR DEPARTMENT PERSONNEL TO PASS THROUGH.
- D-5. CONTRACTOR SHALL CUT ALL EXPOSED REINFORCING STEEL TO A DEPTH OF 1-INCH BELOW THE EXPOSED SURFACE AND GROUT OVER.
- D-6. CONTRACTOR SHALL PREVENT DUST NUISANCE FROM THE OPERATIONS. CONTRACTOR SHALL SPRINKLE RUBBISH AND DEBRIS WITH WATER TO KEEP DUST TO A MINIMUM.
- D-7. CONTRACTOR SHALL CLEAN AND REMOVE ALL DEBRIS FROM EXISTING WET WELL PRIOR TO CONCRETE RESTORATION.

"POSSIBLE" CONSTRUCTION SEQUENCE

- S-1. CONTRACTOR SETS UP MOT AND INSTALLS BYPASS PUMPING SYSTEM. TEST BYPASS SYSTEM WHILE PUMP STATION IS TURNED OFF. ALL BYPASS PUMPS MUST OPERATE DURING TEST PERIOD. TESTING WILL REQUIRE 24 HOUR TROUBLE FREE OPERATION BEFORE SETTING PIPE PLUGS.
- S-2. CONTRACTOR INSTALLS (2) PIPE PLUGS IN 60" INFLUENT PIPE AND BEGINS BYPASS PUMPING.
- S-3. CONTRACTOR CLEANS AND REPAIRS CONCRETE AND LINER WITHIN WET WELL.
- S-4. INSTALL PROPOSED SCREEN, SLIDE GATE, CONVEYOR, AND LOADOUT AREA.
- S-5. PERFORM REQUIRED TESTS ON PROPOSED SCREENING SYSTEM.
- S-6. REMOVE BYPASS SYSTEM AND MOT.
- S-7. PERFORM TRAINING, COMPLETE PUNCH LIST ITEMS.


REFERENCE SYMBOLS

SECTION IDENTIFICATION 																							
DETAIL IDENTIFICATION 																							
SECTION IDENTIFICATION 																							
PIPING IDENTIFICATION 																							
EQUIPMENT IDENTIFICATION 																							
MISCELLANEOUS <table border="0"> <tr> <td></td> <td>ROOM NUMBER</td> </tr> <tr> <td></td> <td>DOOR NUMBER</td> </tr> <tr> <td></td> <td>WINDOW NUMBER</td> </tr> <tr> <td></td> <td>ACCESSORY NUMBER</td> </tr> <tr> <td></td> <td>WALL TYPE NUMBER</td> </tr> <tr> <td></td> <td>SHEET KEY NOTES</td> </tr> </table>		ROOM NUMBER		DOOR NUMBER		WINDOW NUMBER		ACCESSORY NUMBER		WALL TYPE NUMBER		SHEET KEY NOTES	<table border="0"> <tr> <td></td> <td>COORDINATE POINT</td> </tr> <tr> <td></td> <td>ROUND OR DIAMETER</td> </tr> <tr> <td>@</td> <td>AT</td> </tr> <tr> <td></td> <td>ANGLE</td> </tr> <tr> <td></td> <td>CENTERLINE</td> </tr> </table>		COORDINATE POINT		ROUND OR DIAMETER	@	AT		ANGLE		CENTERLINE
	ROOM NUMBER																						
	DOOR NUMBER																						
	WINDOW NUMBER																						
	ACCESSORY NUMBER																						
	WALL TYPE NUMBER																						
	SHEET KEY NOTES																						
	COORDINATE POINT																						
	ROUND OR DIAMETER																						
@	AT																						
	ANGLE																						
	CENTERLINE																						

P:\4291800\WG-1.dwg, Aug 15, 2018 - 9:25am

DESIGNED	G DICK		302 Knights Run Avenue, Suite 900 Tampa, FL 33602 813.254.5838	APPROVED BY:			PROJECT:	CITY OF TAMPA UNIVERSITY PUMPING STATION AUTOMATIC BAR SCREEN	DESCRIPTION:	SHEET INDEX, ABBREVIATION, GENERAL NOTES AND REFERENCE SYMBOLS	DATE:	AUGUST 2018
DRAWN	O GOMEZ		FIRM'S FLORIDA CERT. NO. AAP000034/CA3806 IB26000797/LC26000381	JOSEPH B. BARKSDALE FLA. LIC. NO 46545	DATE			GSP JOB No.	4291800			
CHECKED	G JACOB							SHEET:	G-1			
REV. NO.	DATE		DESCRIPTION	REV. BY					2 OF 27			

P:\4291800\N\M-1.dwg, Aug 15, 2018 - 9:26am

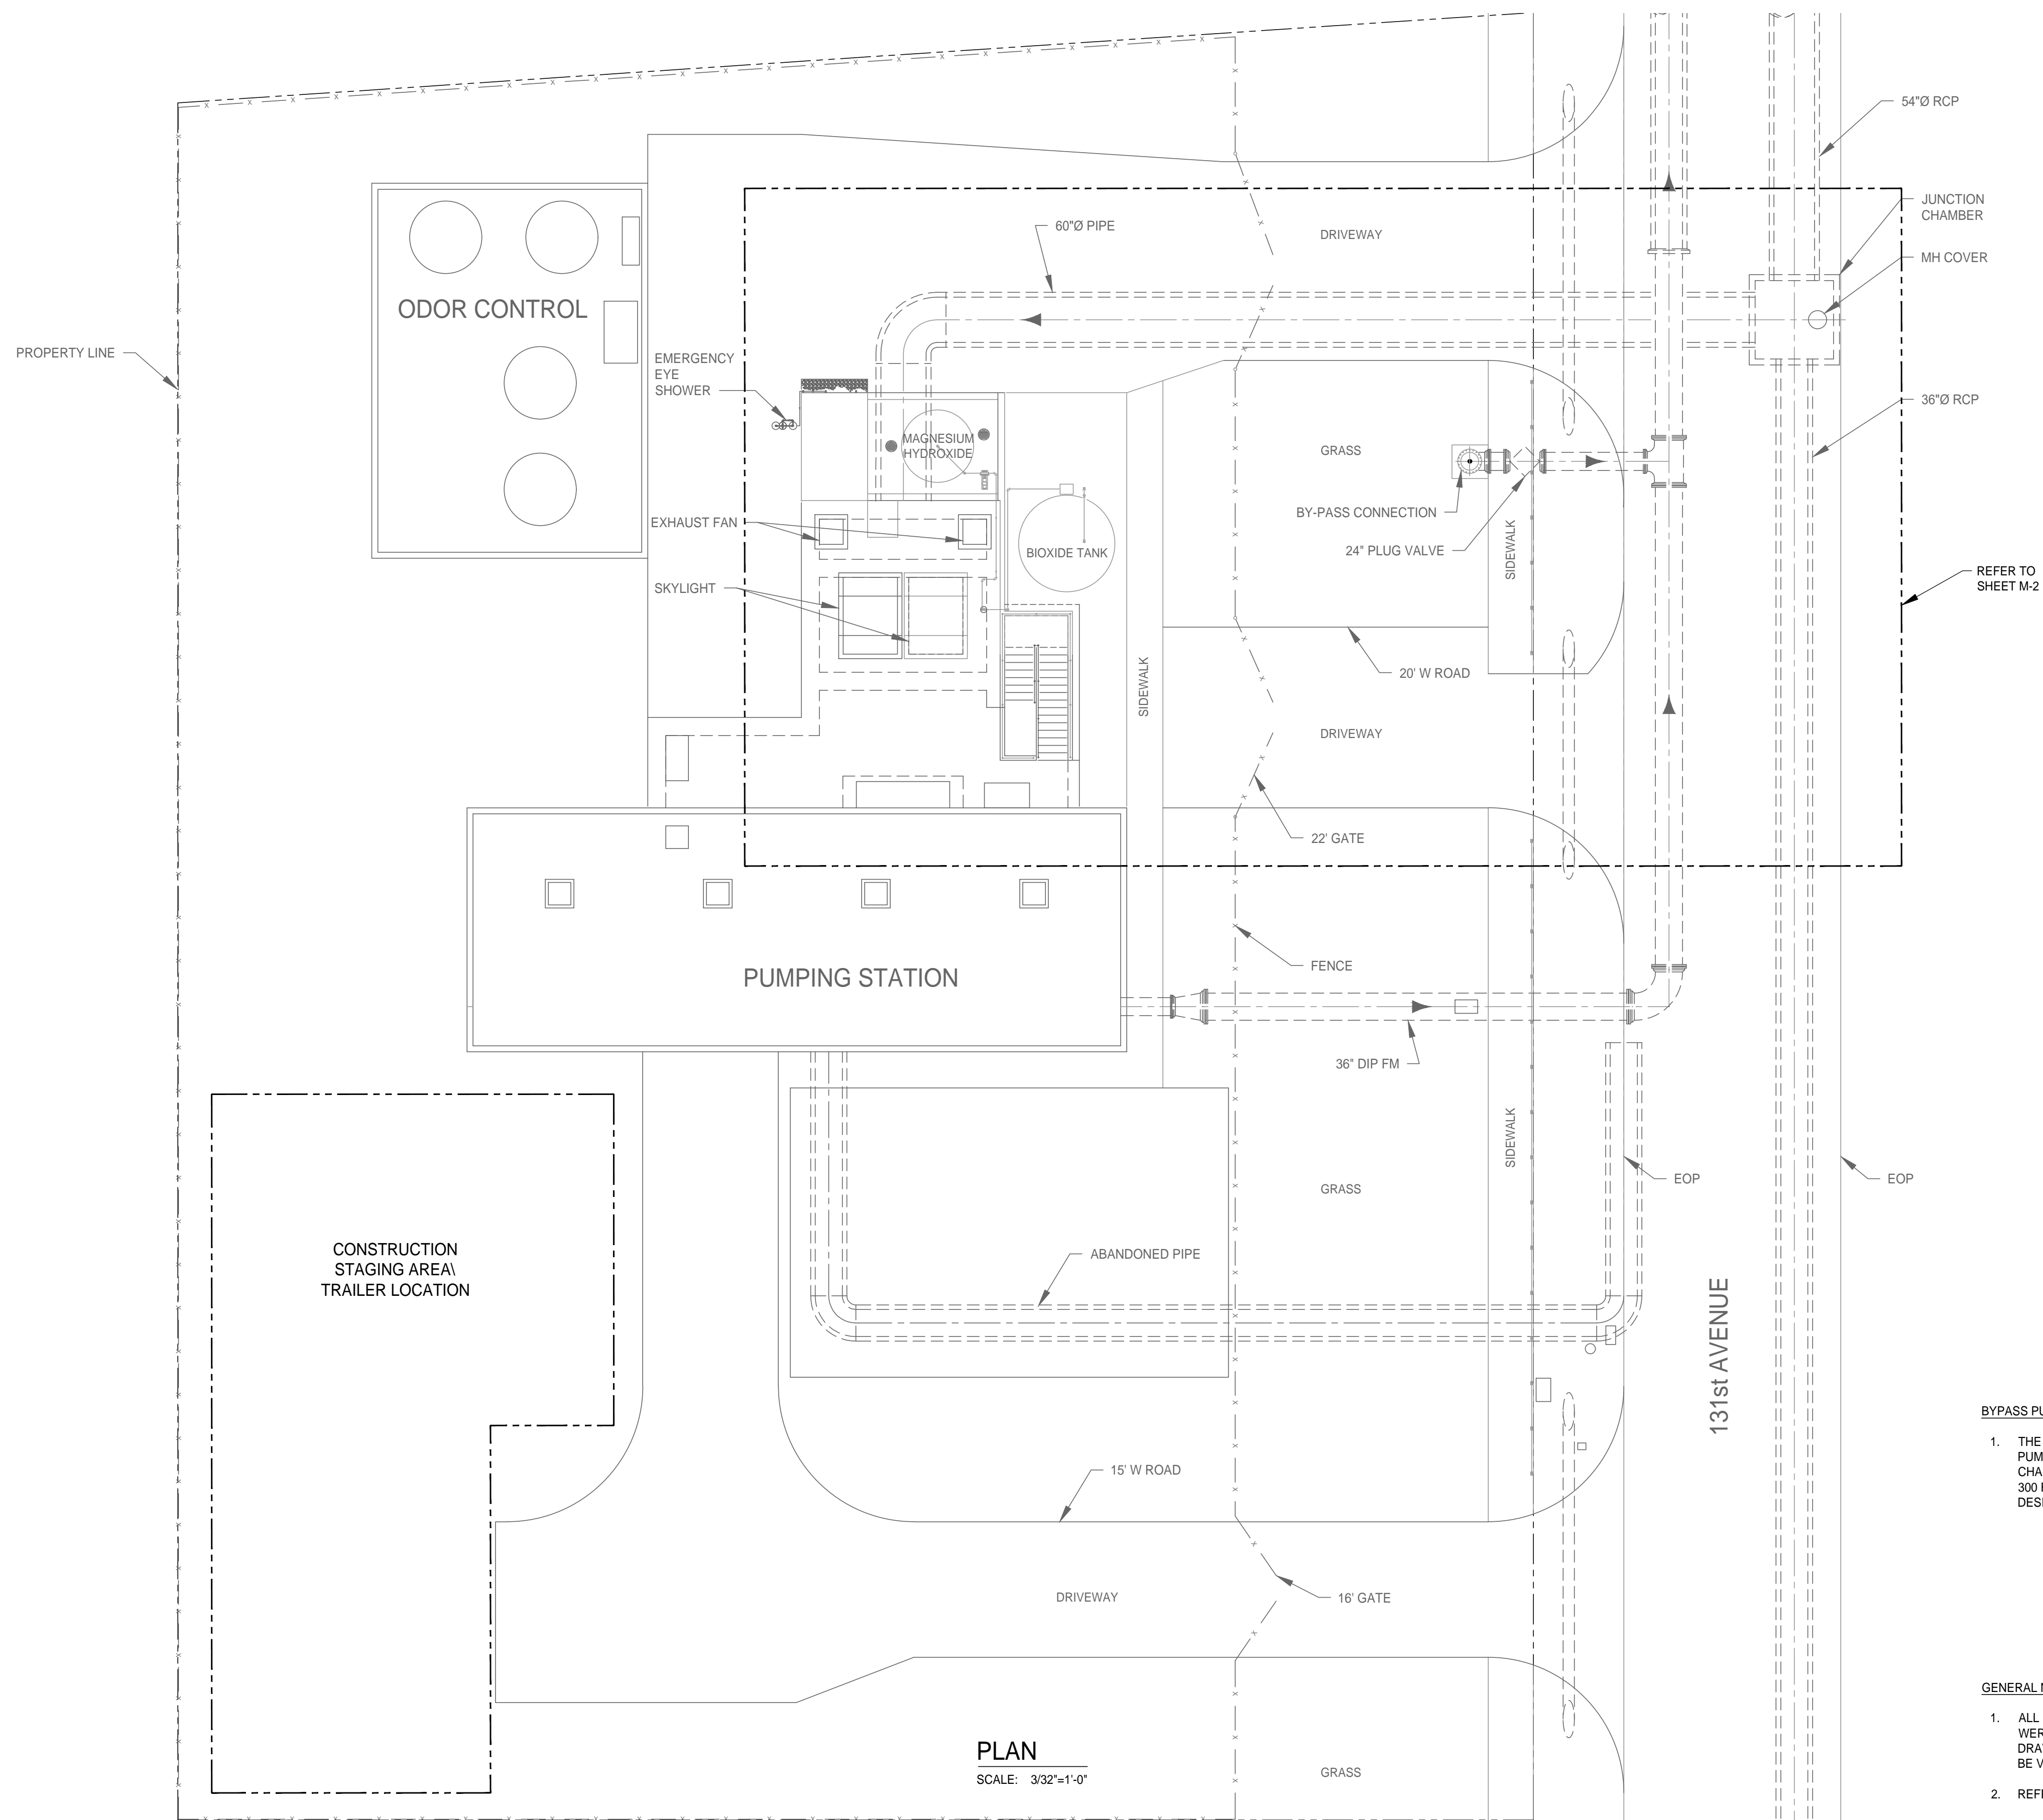

BYPASS PUMPING NOTES:

1. THE CONTRACTOR WILL UTILIZE MANHOLES FOR THE BYPASS PUMPING. THE FIRST MANHOLE IS LOCATED AT THE JUNCTION CHAMBER AND THE SECOND MANHOLE IS LOCATED APPROXIMATELY 300 FEET WEST OF THE JUNCTION CHAMBER. THE CONTRACTOR SHALL DESIGN AND SUBMIT THE BYPASS PLANS PER SPECIFICATIONS.

GENERAL NOTES:

1. ALL DIMENSIONS AND ELEVATIONS OF EXISTING FACILITIES WERE OBTAINED FROM PREVIOUS CONSTRUCTION AND RECORD DRAWINGS. ALL EXISTING DIMENSIONS AND ELEVATIONS SHALL BE VERIFIED IN THE FIELD BY THE CONTRACTOR.
2. REFER TO SHEET G-1 AND S-1 FOR ADDITIONAL NOTES.

PLAN
SCALE: 3/32"=1'-0"

REV. NO.	DATE	DESCRIPTION	REV. BY

DESIGNED: G DICK
DRAWN: O GOMEZ
CHECKED: G JACOB



302 Knights Run Avenue, Suite 900
Tampa, FL 33602
813.254.5838
FIRM'S FLORIDA
CERT. NO.
AAP000034/CA3806
1B26000797/LC26000381

APPROVED BY:

JOSEPH B. BARKSDALE
FLA. LIC. NO. 46545




PROJECT: CITY OF TAMPA
UNIVERSITY PUMPING STATION
AUTOMATIC BAR SCREEN

DESCRIPTION:
**EXISTING SITE PLAN
KEY PLAN**

DATE: AUGUST 2018
GSP JOB No. 4291800
SHEET: M-1 3 OF 27


P:\4291800\N\N-2.dwg, Aug 15, 2018 - 9:27am

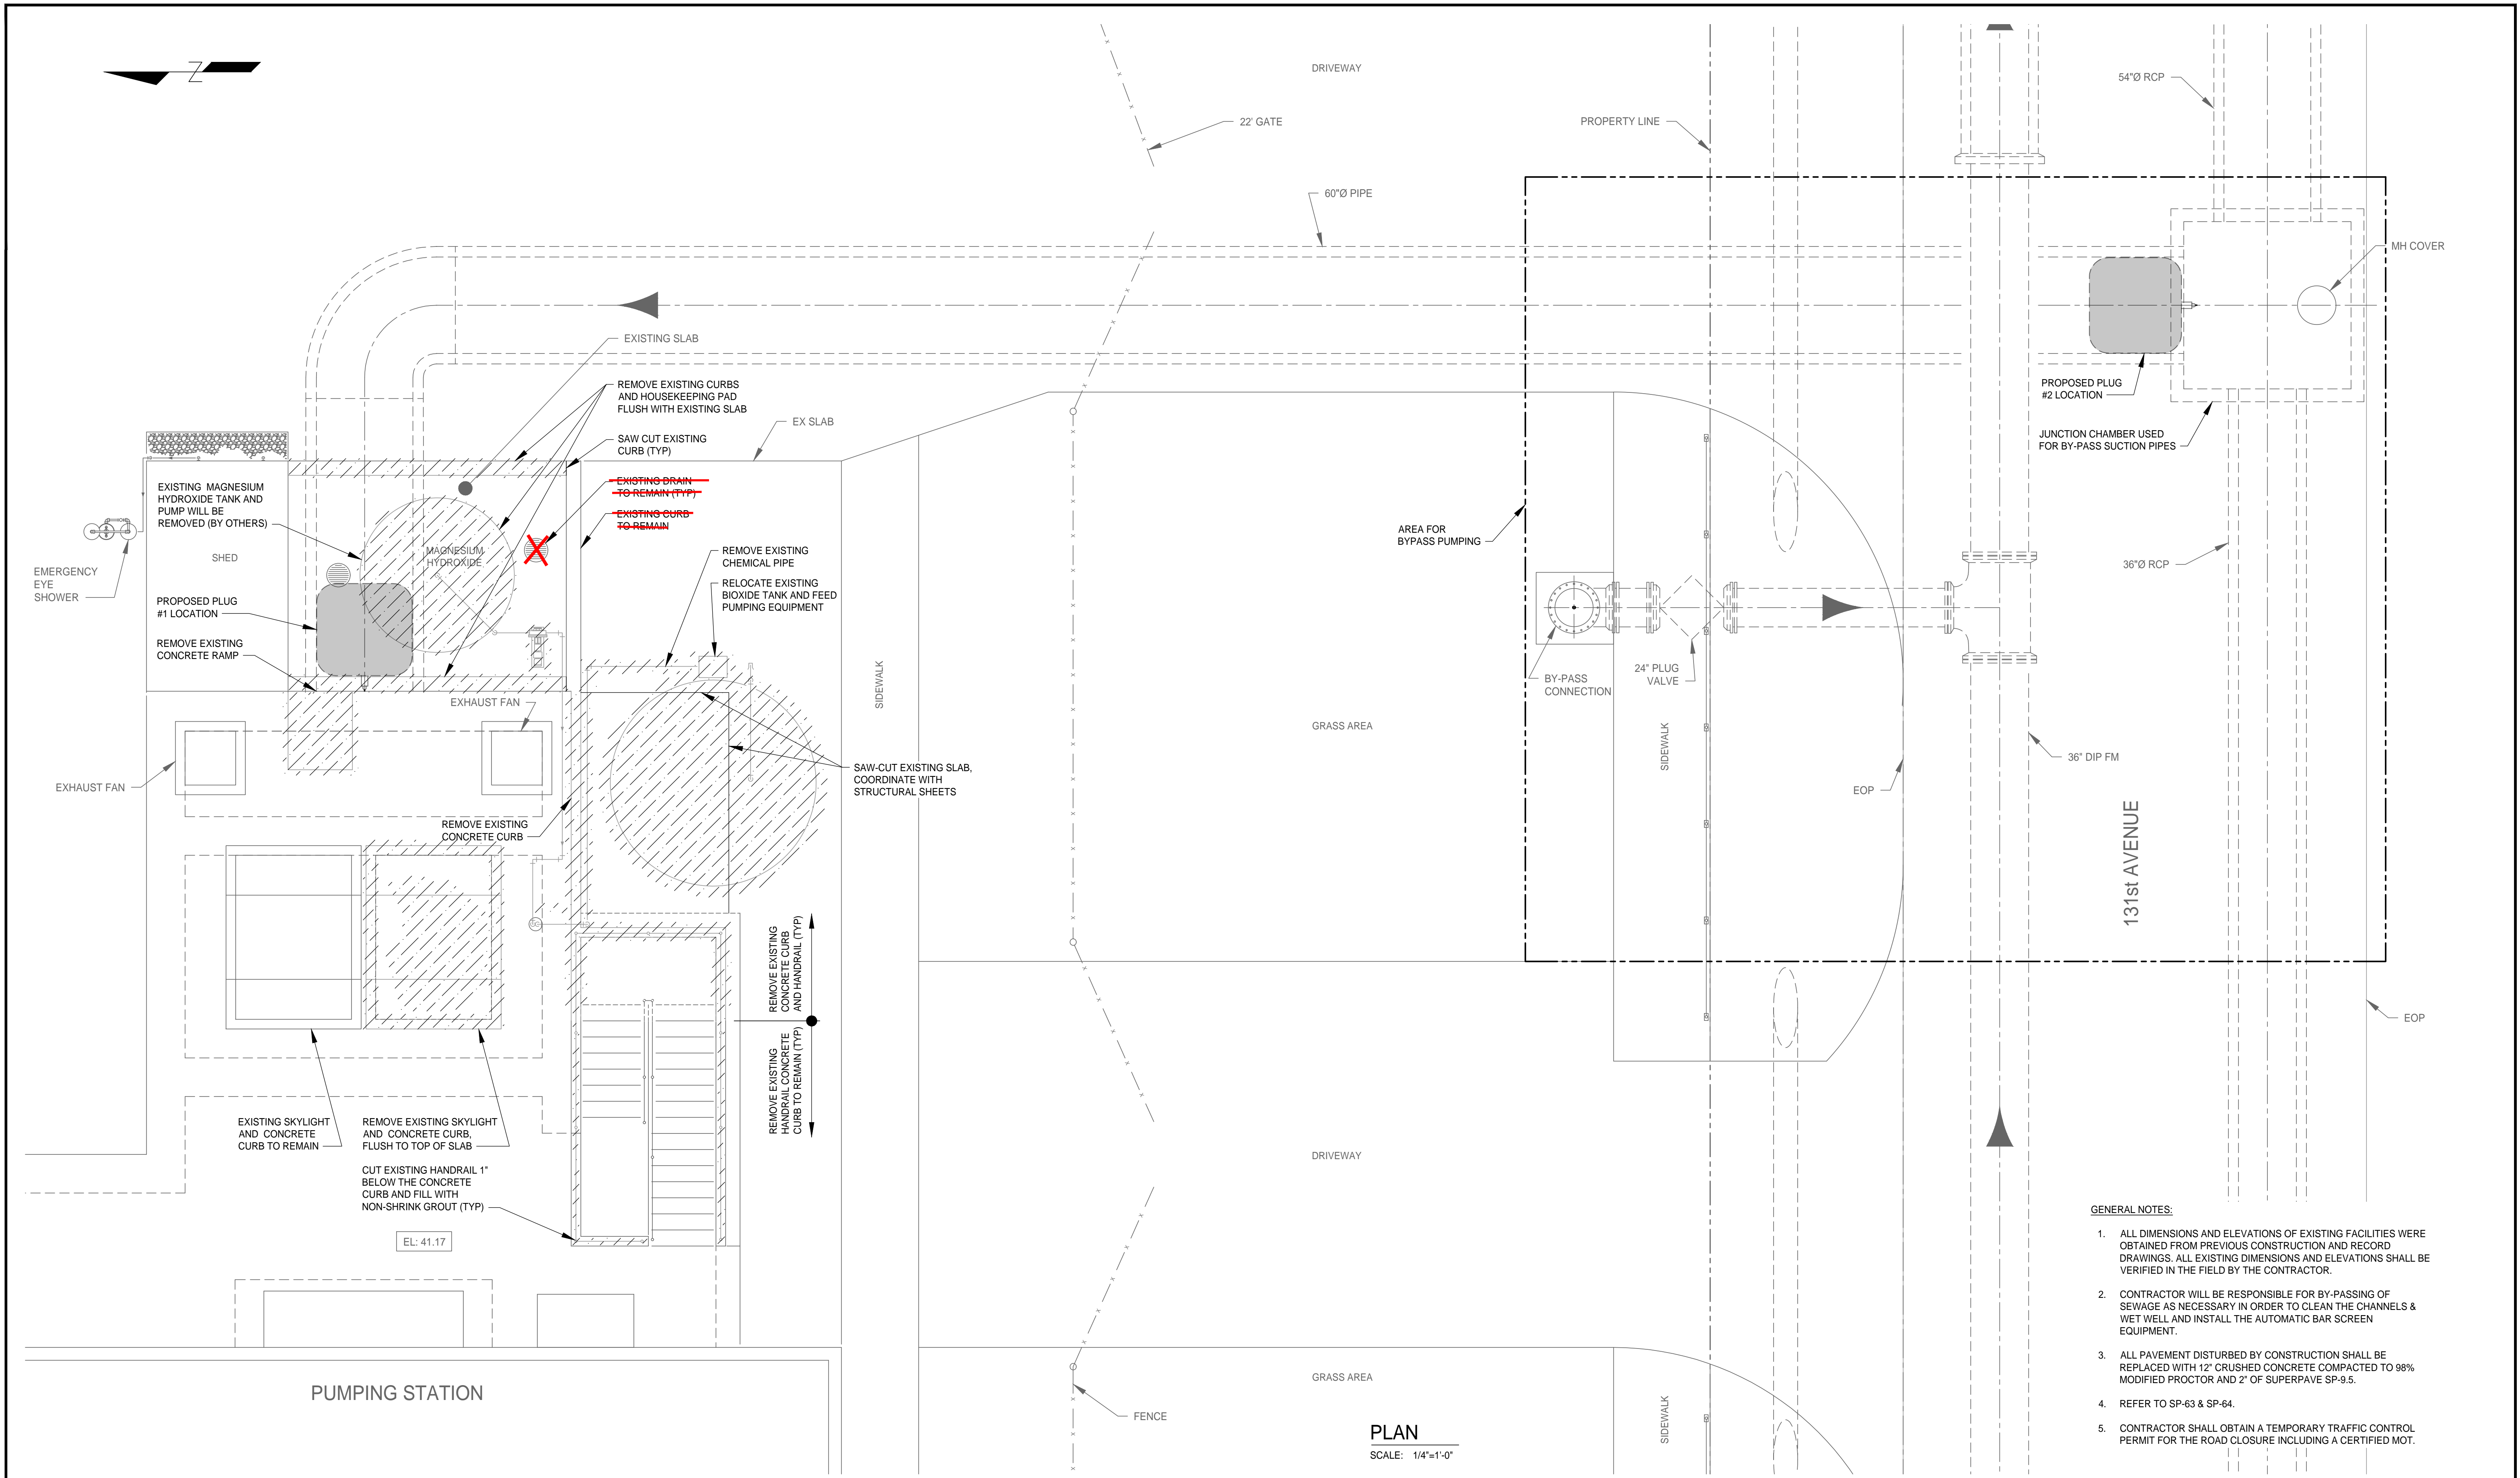

- GENERAL NOTES:**
1. ALL DIMENSIONS AND ELEVATIONS OF EXISTING FACILITIES WERE OBTAINED FROM PREVIOUS CONSTRUCTION AND RECORD DRAWINGS. ALL EXISTING DIMENSIONS AND ELEVATIONS SHALL BE VERIFIED IN THE FIELD BY THE CONTRACTOR.
 2. CONTRACTOR WILL BE RESPONSIBLE FOR BY-PASSING OF SEWAGE AS NECESSARY IN ORDER TO CLEAN THE CHANNELS & WET WELL AND INSTALL THE AUTOMATIC BAR SCREEN EQUIPMENT.
 3. ALL PAVEMENT DISTURBED BY CONSTRUCTION SHALL BE REPLACED WITH 12" CRUSHED CONCRETE COMPACTED TO 98% MODIFIED PROCTOR AND 2" OF SUPERPAVE SP-9.5.
 4. REFER TO SP-63 & SP-64.
 5. CONTRACTOR SHALL OBTAIN A TEMPORARY TRAFFIC CONTROL PERMIT FOR THE ROAD CLOSURE INCLUDING A CERTIFIED MOT.

REV. NO.	DATE	DESCRIPTION	REV. BY

DESIGNED	G DICK
DRAWN	O GOMEZ
CHECKED	G JACOB


GS & P
 302 Knights Run Avenue, Suite 900
 Tampa, FL 33602
 813.254.5838
 FIRM'S FLORIDA
 CERT. NO.
 AAP000034/CA3806
 IB26000797/LC26000381

APPROVED BY:	DATE
JOSEPH B. BARKSDALE FLA. LIC. NO. 46545	





PROJECT: CITY OF TAMPA
UNIVERSITY PUMPING STATION
AUTOMATIC BAR SCREEN

DESCRIPTION:
UPPER PLAN LAYOUT
AND DEMOLITION

DATE:	AUGUST 2018
GSP JOB No.	4291800
SHEET:	M-2 4 OF 27


P:\4291800\N\N-3.dwg, Aug 15, 2018 - 9:27am

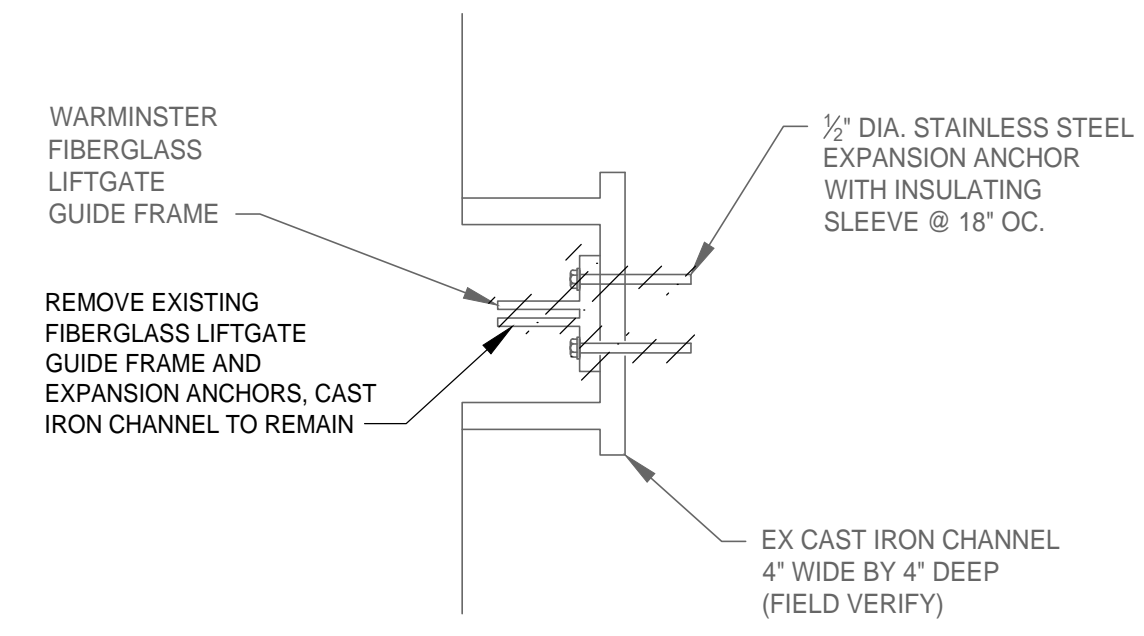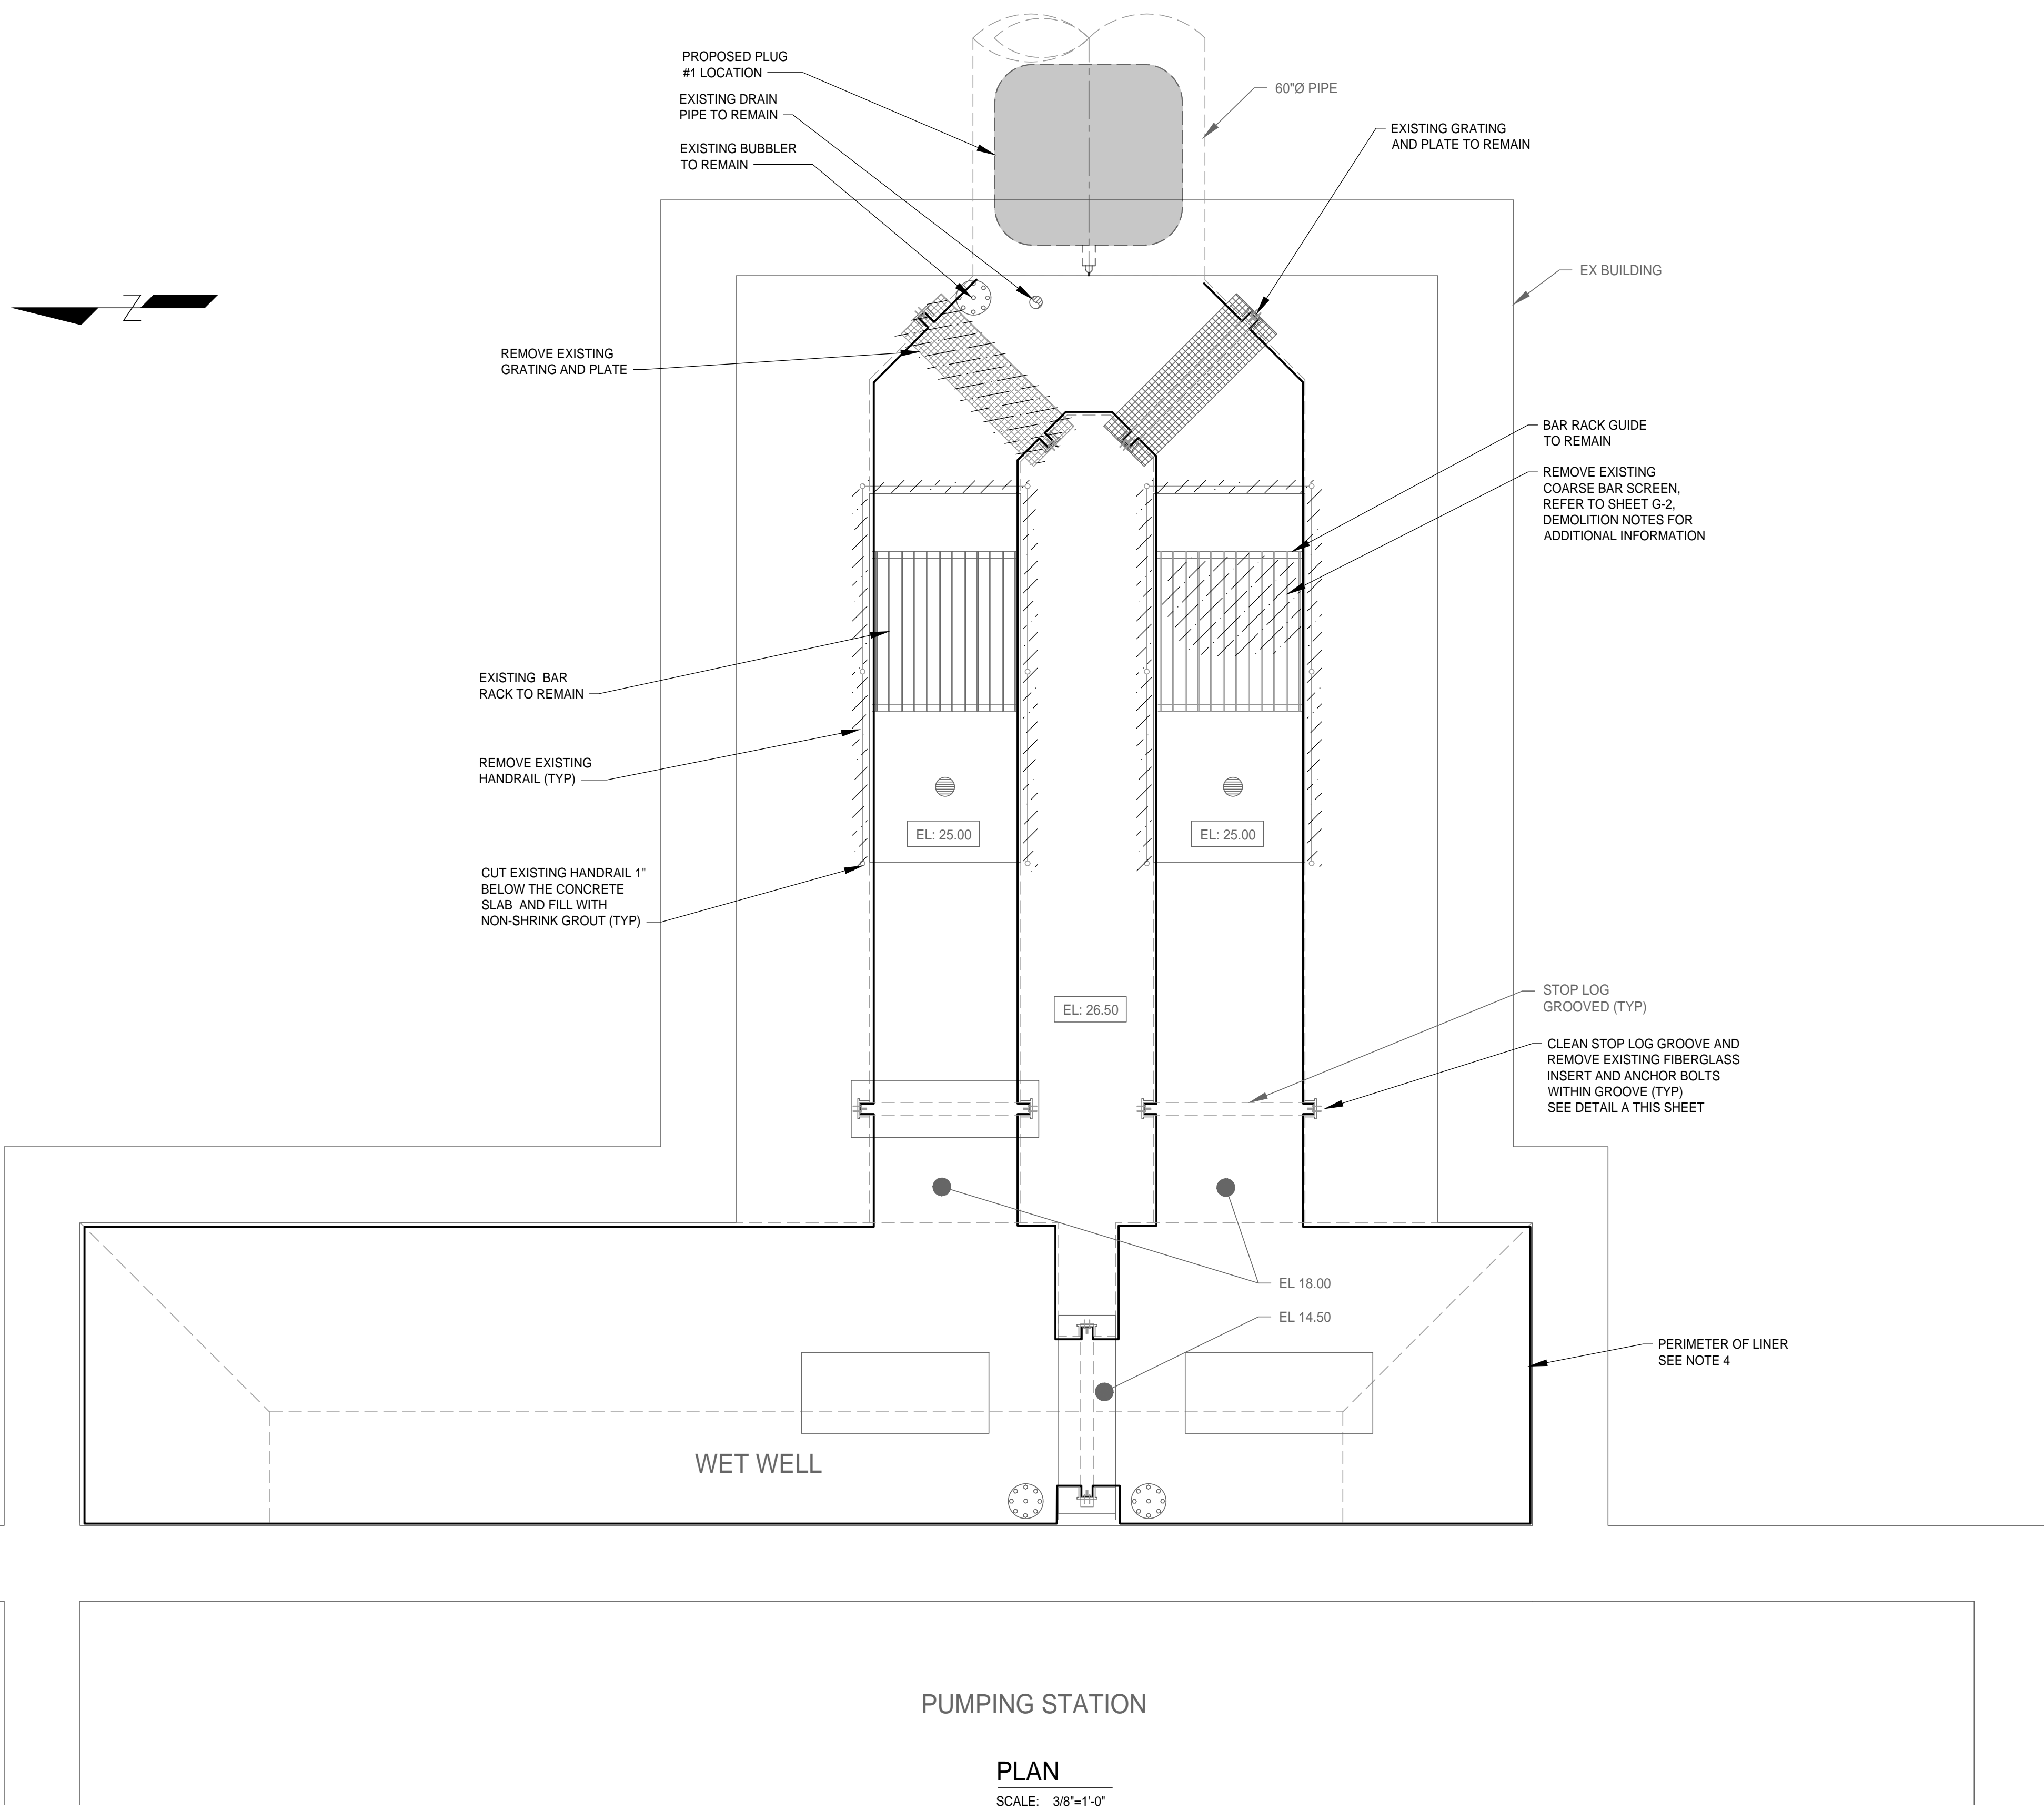

DETAIL A
SCALE: NTS

- GENERAL NOTES:**
- ALL DIMENSIONS AND ELEVATIONS OF EXISTING FACILITIES WERE OBTAINED FROM PREVIOUS CONSTRUCTION AND RECORD DRAWINGS. ALL EXISTING DIMENSIONS AND ELEVATIONS SHALL BE VERIFIED IN THE FIELD BY THE CONTRACTOR.
 - REFER TO SHEET G-1 AND S-1 FOR ADDITIONAL NOTES.
 - CONTRACTOR SHALL CLEAN ENTIRE CHANNEL & WET WELL AND ALL DEBRIS REMOVED PRIOR TO CONCRETE REPAIRS.
 - CONTRACTOR WILL NEED TO CHECK ENTIRE STRUCTURE TO DETERMINE IF EXISTING PVC LINER IS FIRMLY ATTACHED AND CONCRETE IS IN SOUND CONDITION. ALL CORRODED CONCRETE AND UNATTACHED LINER MUST BE REMOVED AND CONCRETE REPAIRED AND COATED PER SPECIFICATIONS.

DESIGNED	G DICK	<p>302 Knights Run Avenue, Suite 900 Tampa, FL 33602 813.254.5838</p> <p>FIRM'S FLORIDA CERT. NO. AAP000034/CA3806 1B26000797/LC26000381</p>	APPROVED BY:	<p>DATE</p>	PROJECT:	CITY OF TAMPA UNIVERSITY PUMPING STATION AUTOMATIC BAR SCREEN	DESCRIPTION:	LOWER PLAN DEMOLITION	DATE:	AUGUST 2018		
DRAWN	O GOMEZ					GSP JOB No.	4291800					
CHECKED	G JACOB				JOSEPH B. BARKSDALE FLA. LIC. NO 46545					SHEET:	M-3	5 OF 27
REV. NO.	DATE		DESCRIPTION		REV. BY							

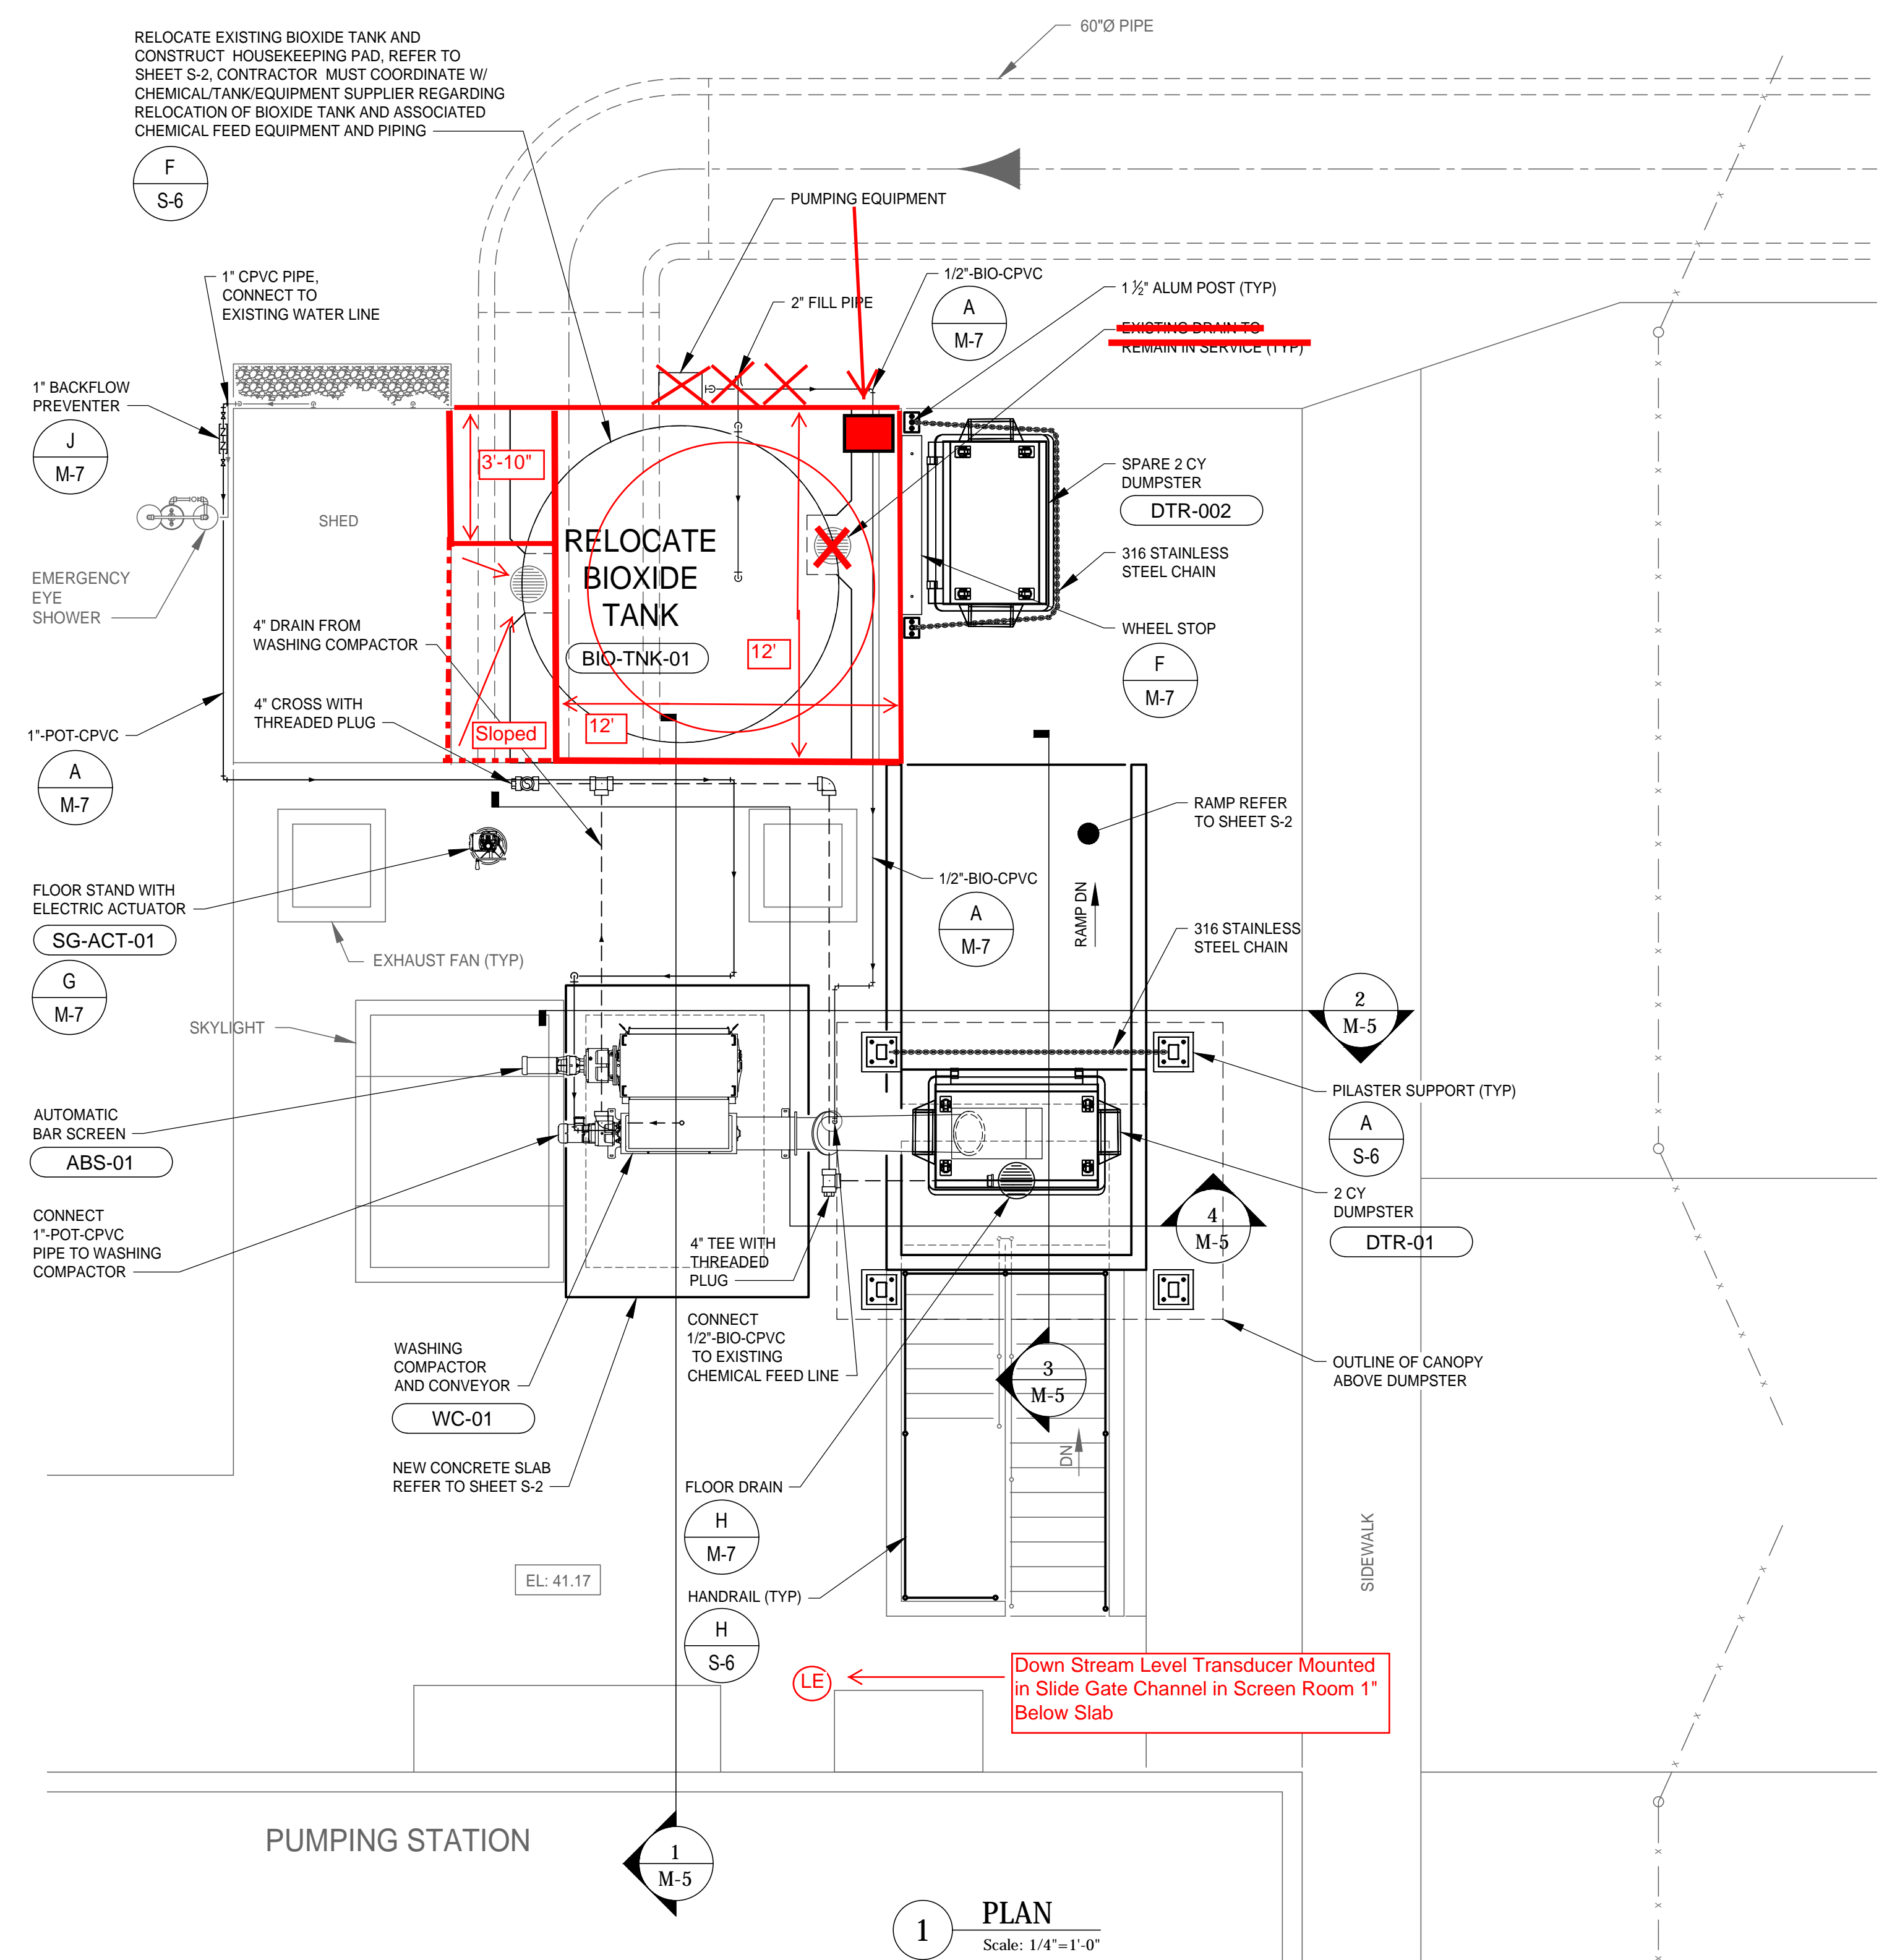

1 PLAN
Scale: 1/4" = 1'-0"

- GENERAL NOTES:**
1. ALL DIMENSIONS AND ELEVATIONS OF EXISTING FACILITIES WERE OBTAINED FROM PREVIOUS CONSTRUCTION AND RECORD DRAWINGS. ALL EXISTING DIMENSIONS AND ELEVATIONS SHALL BE VERIFIED IN THE FIELD BY THE CONTRACTOR.
 2. REFER TO SHEET G-1 AND S-1 FOR ADDITIONAL NOTES.
 3. REFER TO ELECTRICAL SHEETS FOR ADDITIONAL INFORMATION.

P:\4291800\W-M-4.dwg, Aug 15, 2018 - 9:28am

REV. NO.	DATE	DESCRIPTION	REV. BY

DESIGNED: G DICK
 DRAWN: O GOMEZ
 CHECKED: G JACOB



302 Knights Run Avenue, Suite 900
 Tampa, FL 33602
 813.254.5838
 FIRM'S FLORIDA
 CERT. NO.
 AAP000034/CA3806
 IB26000797/LC26000381

APPROVED BY: _____ DATE: _____
 JOSEPH B. BARKSDALE
 FLA. LIC. NO. 46545







PROJECT: CITY OF TAMPA
 UNIVERSITY PUMPING STATION
 AUTOMATIC BAR SCREEN

DESCRIPTION: UPPER PLAN

DATE: AUGUST 2018
 GSP JOB No. 4291800
 SHEET: M-4 6 OF 27

P:\4291800\N\M-5.dwg, Aug 15, 2018 - 9:29am

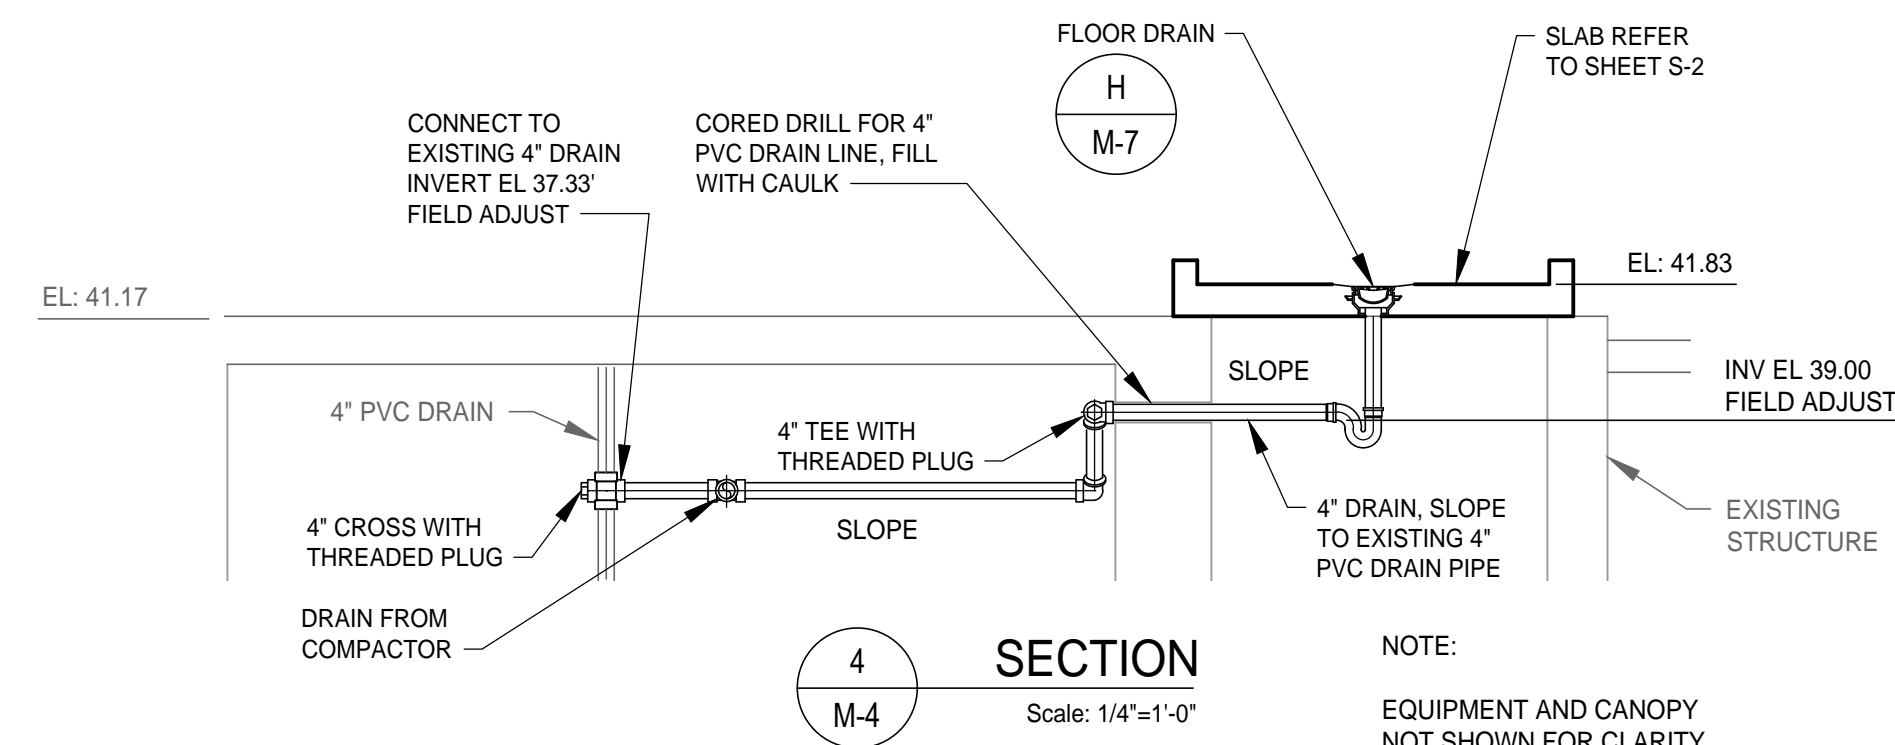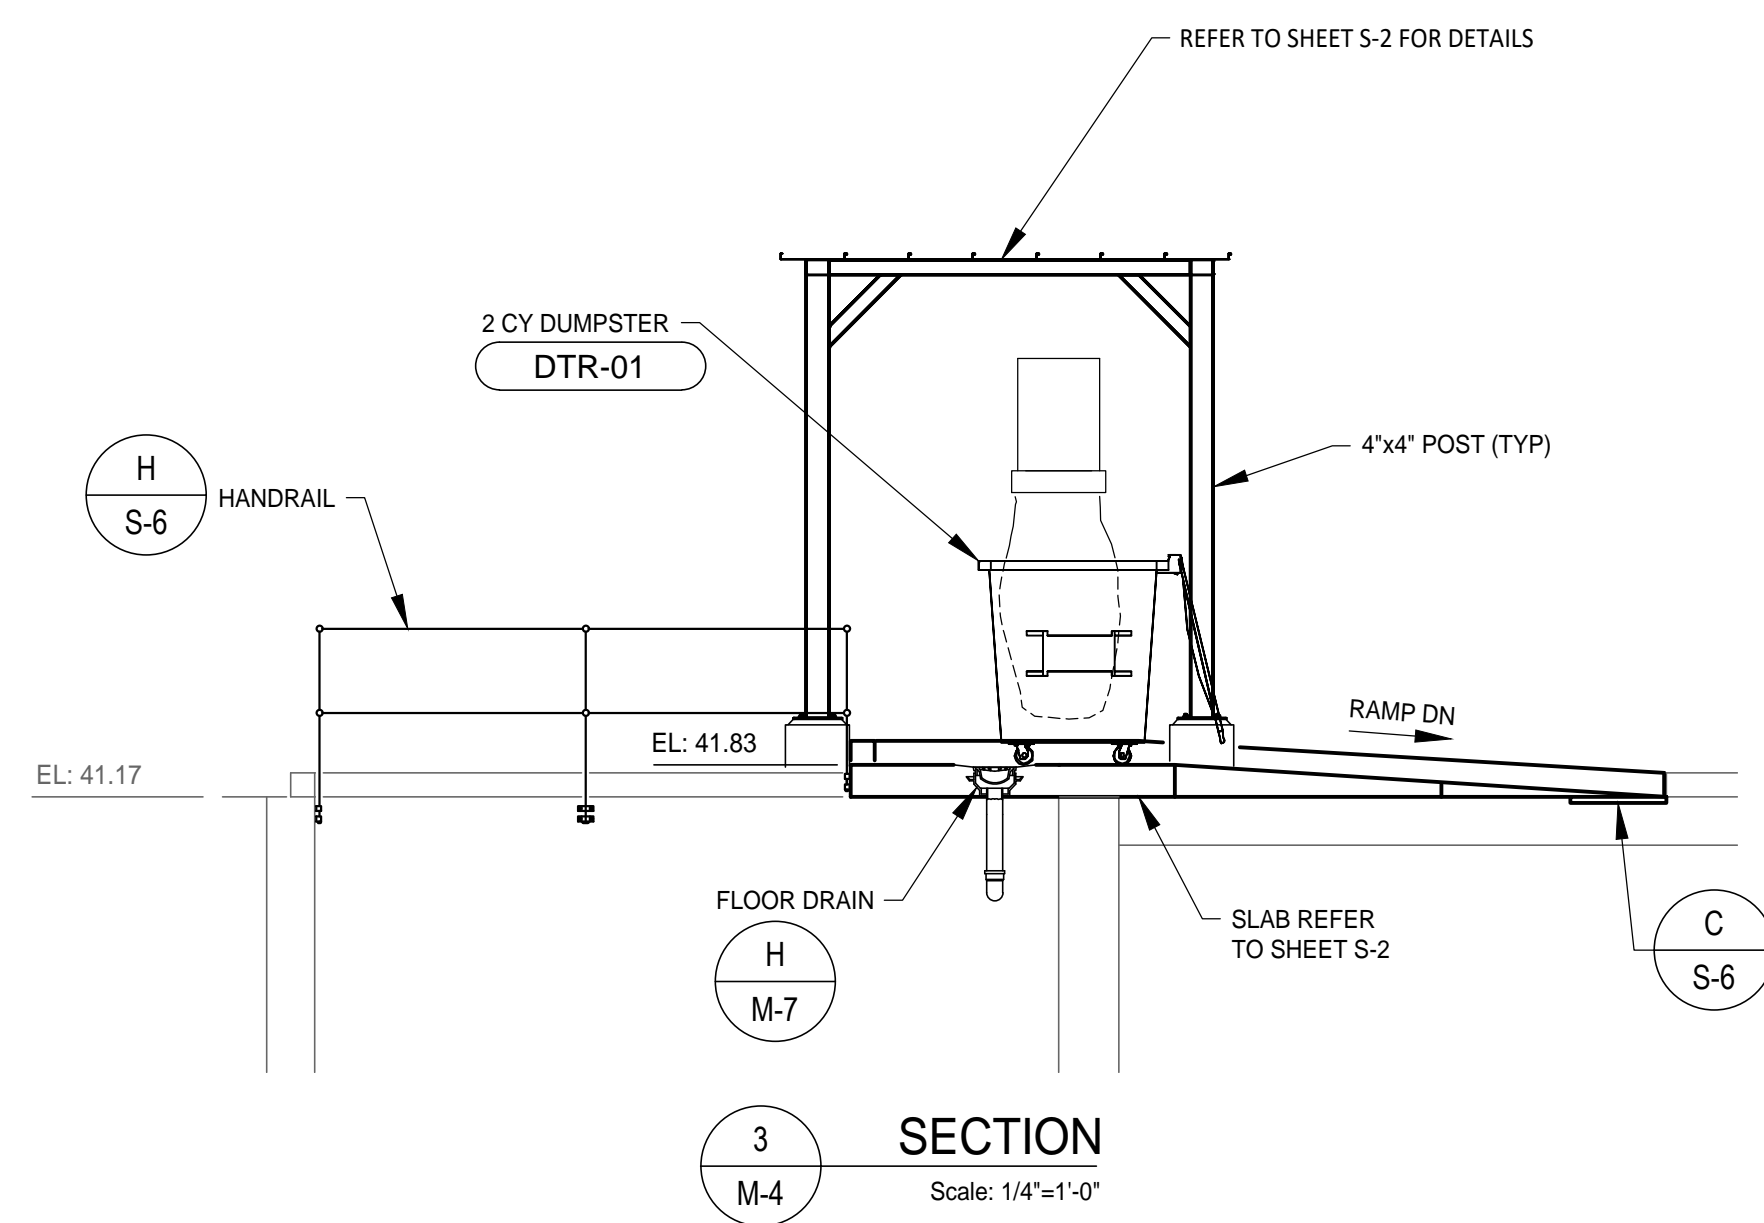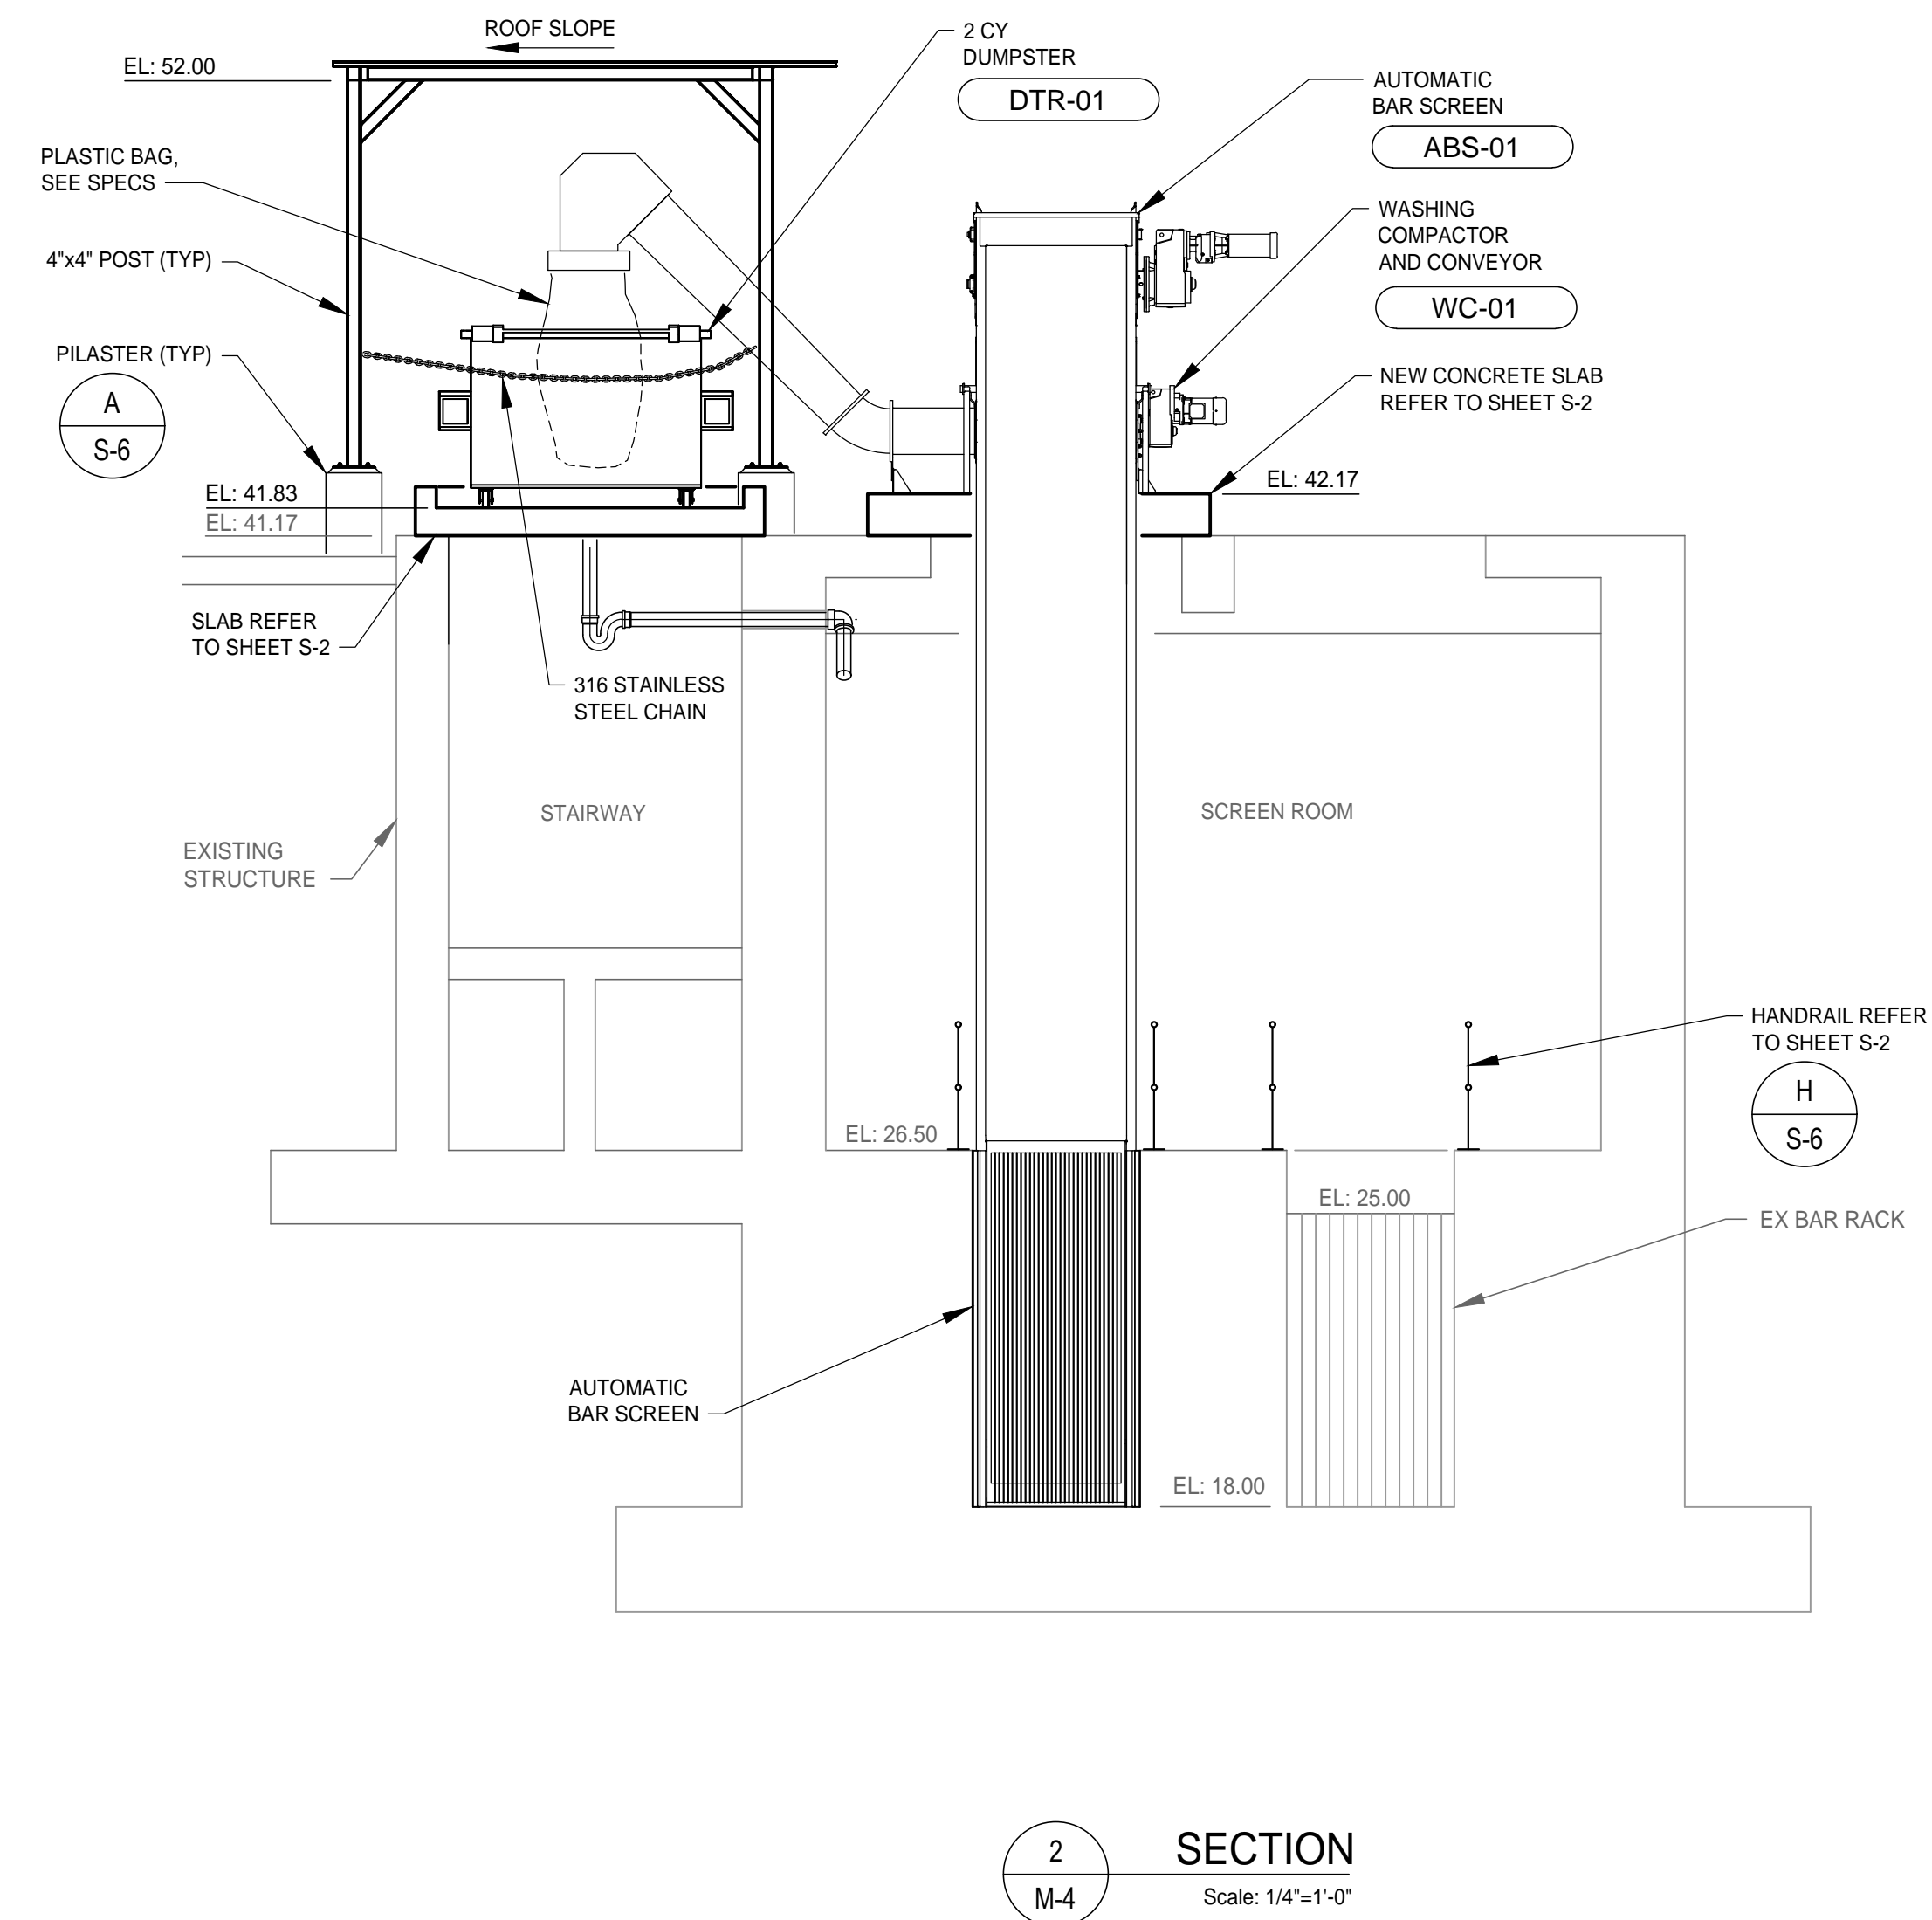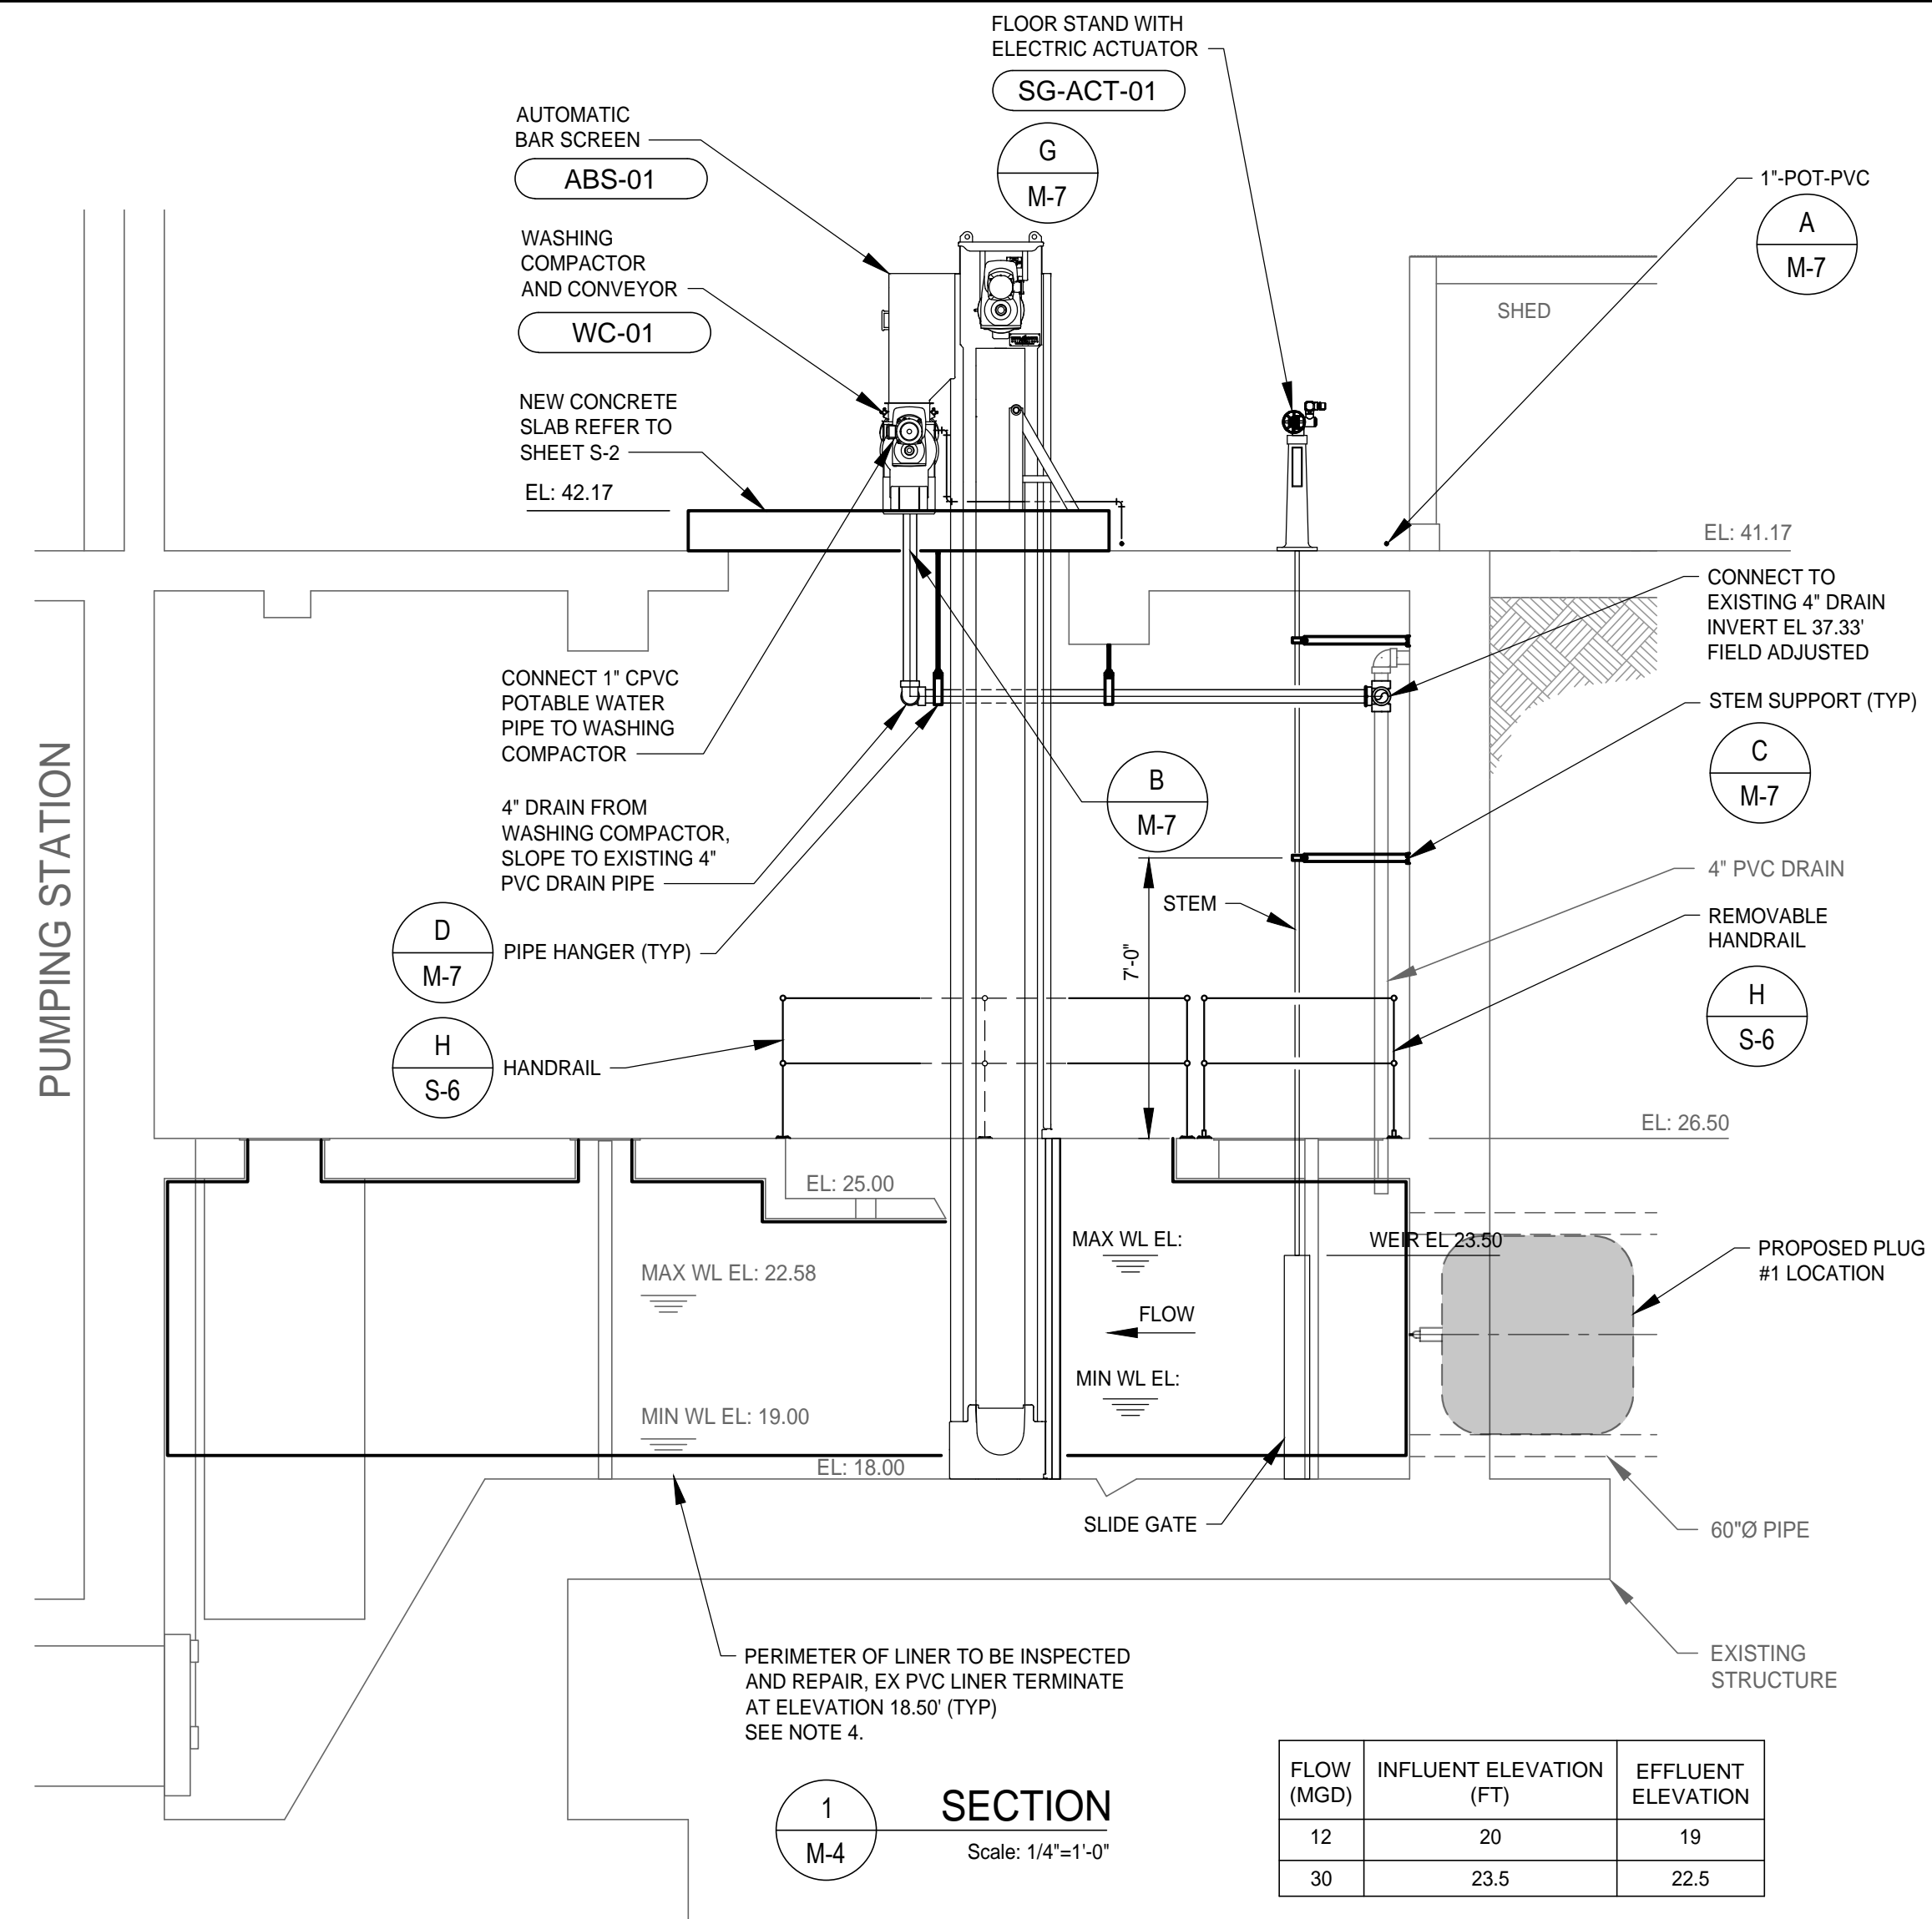

- GENERAL NOTES:**
- ALL DIMENSIONS AND ELEVATIONS OF EXISTING FACILITIES WERE OBTAINED FROM PREVIOUS CONSTRUCTION AND RECORD DRAWINGS. ALL EXISTING DIMENSIONS AND ELEVATIONS SHALL BE VERIFIED IN THE FIELD BY THE CONTRACTOR.
 - REFER TO SHEET G-1 AND S-1 FOR ADDITIONAL NOTES.
 - CONTRACTOR SHALL CLEAN ENTIRE CHANNEL & WET WELL AND ALL DEBRIS REMOVED PRIOR TO CONCRETE REPAIRS.
 - CONTRACTOR WILL NEED TO CHECK ENTIRE STRUCTURE TO DETERMINE IF EXISTING PVC LINER IS FIRMLY ATTACHED AND CONCRETE IS IN SOUND CONDITION. ALL CORRODED CONCRETE AND UNATTACHED LINER MUST BE REMOVED AND CONCRETE REPAIRED AND COATED PER SPECIFICATIONS.

REV. NO.	DATE	DESCRIPTION	REV. BY

DESIGNED: G DICK
 DRAWN: O GOMEZ
 CHECKED: G JACOB

302 Knights Run Avenue, Suite 900
 Tampa, FL 33602
 813.254.5838
 FIRM'S FLORIDA
 CERT. NO.
 AAP000034/CA3806
 IB26000797/LC26000381

APPROVED BY:
 JOSEPH B. BARKSDALE
 FLA. LIC. NO. 46545




PROJECT: CITY OF TAMPA
 UNIVERSITY PUMPING STATION
 AUTOMATIC BAR SCREEN


DESCRIPTION: SECTIONS

DATE: AUGUST 2018
 GSP JOB No. 4291800
 SHEET: M-5 7 OF 27


P:\4291800\N\H-G.dwg, Aug 15, 2018 - 9:30am

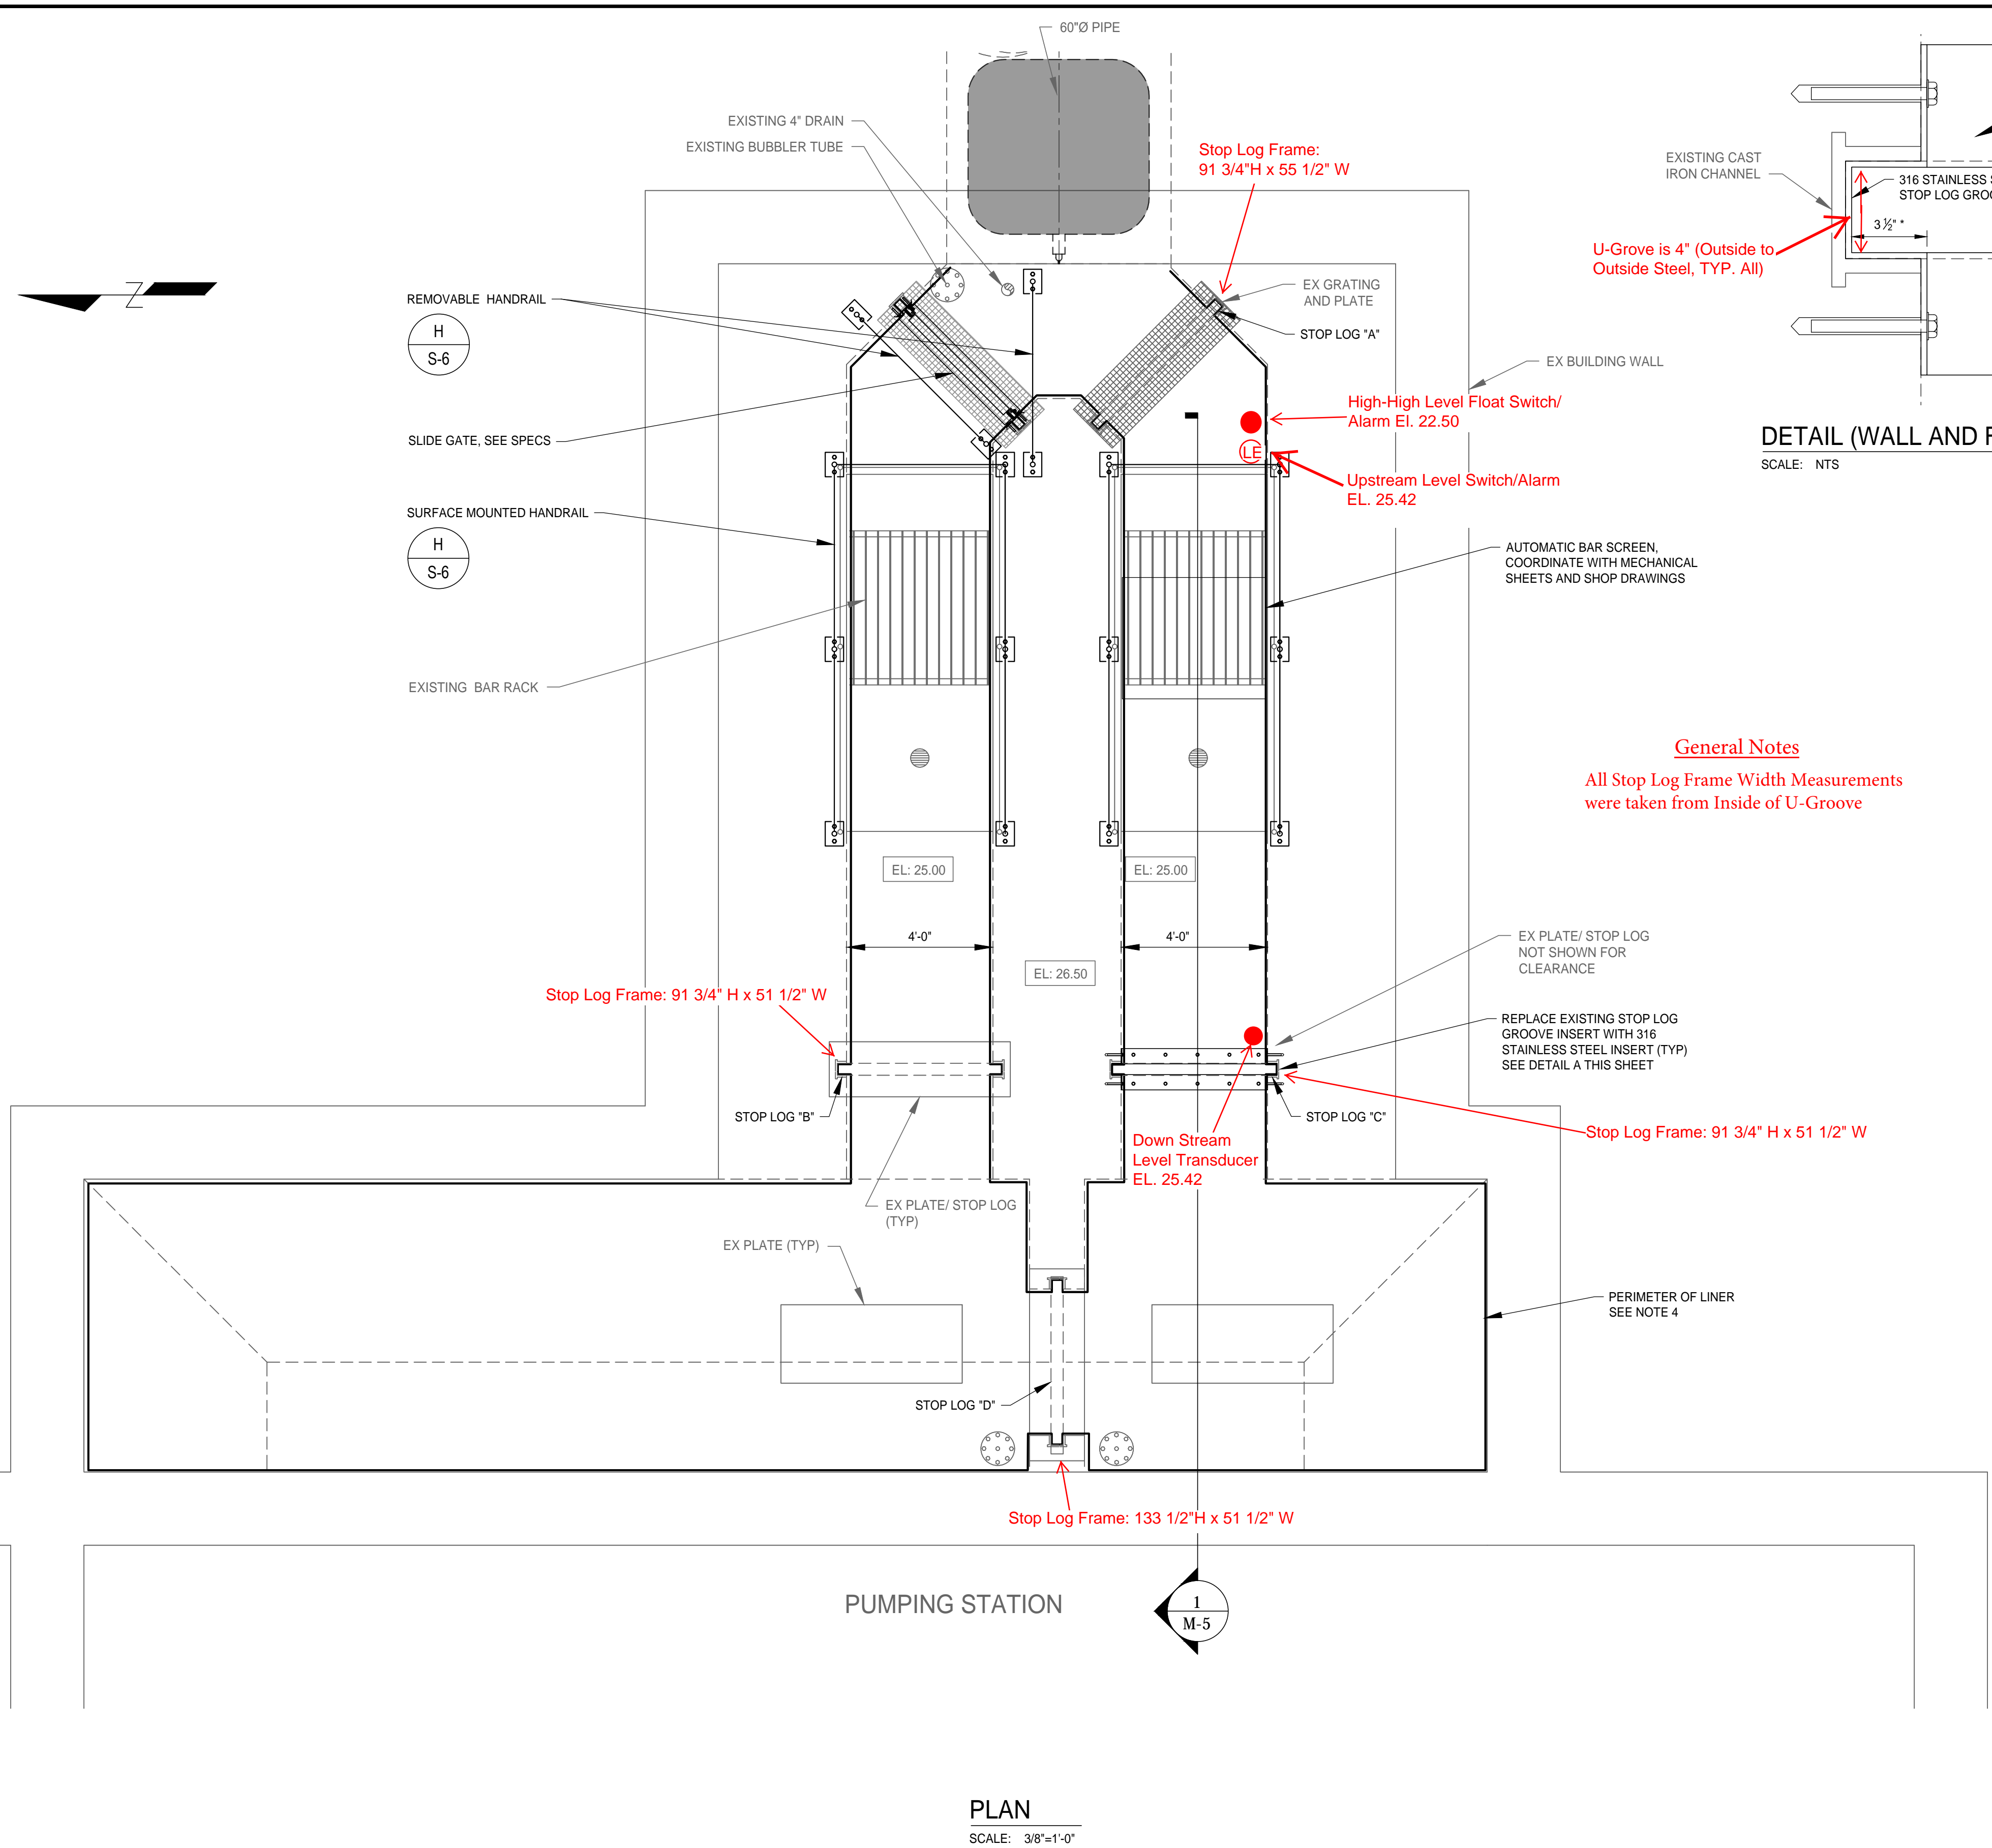


PLAN
SCALE: 3/8"=1'-0"

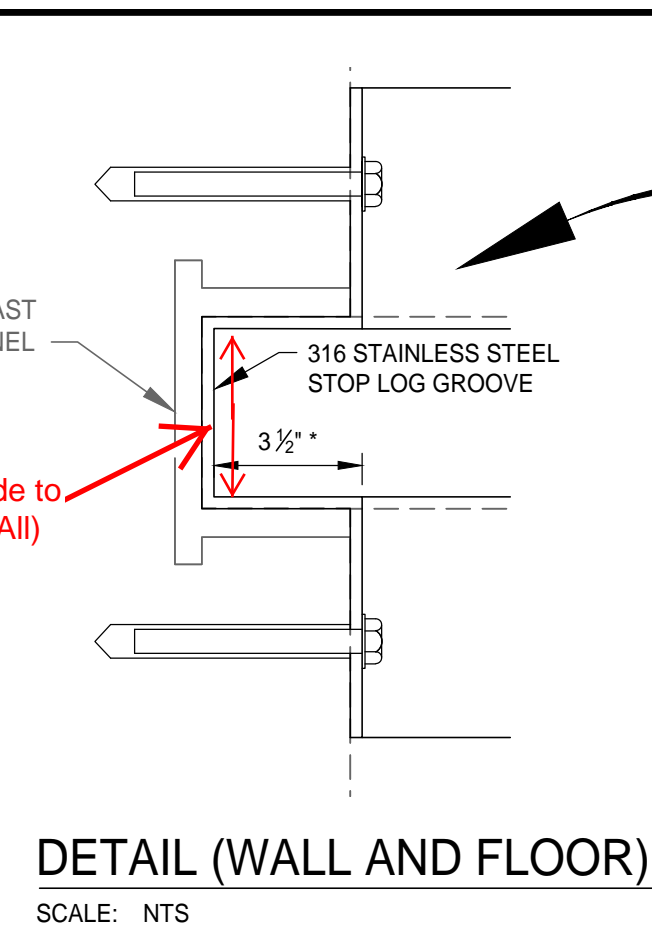


DETAIL (WALL AND FLOOR)
SCALE: NTS

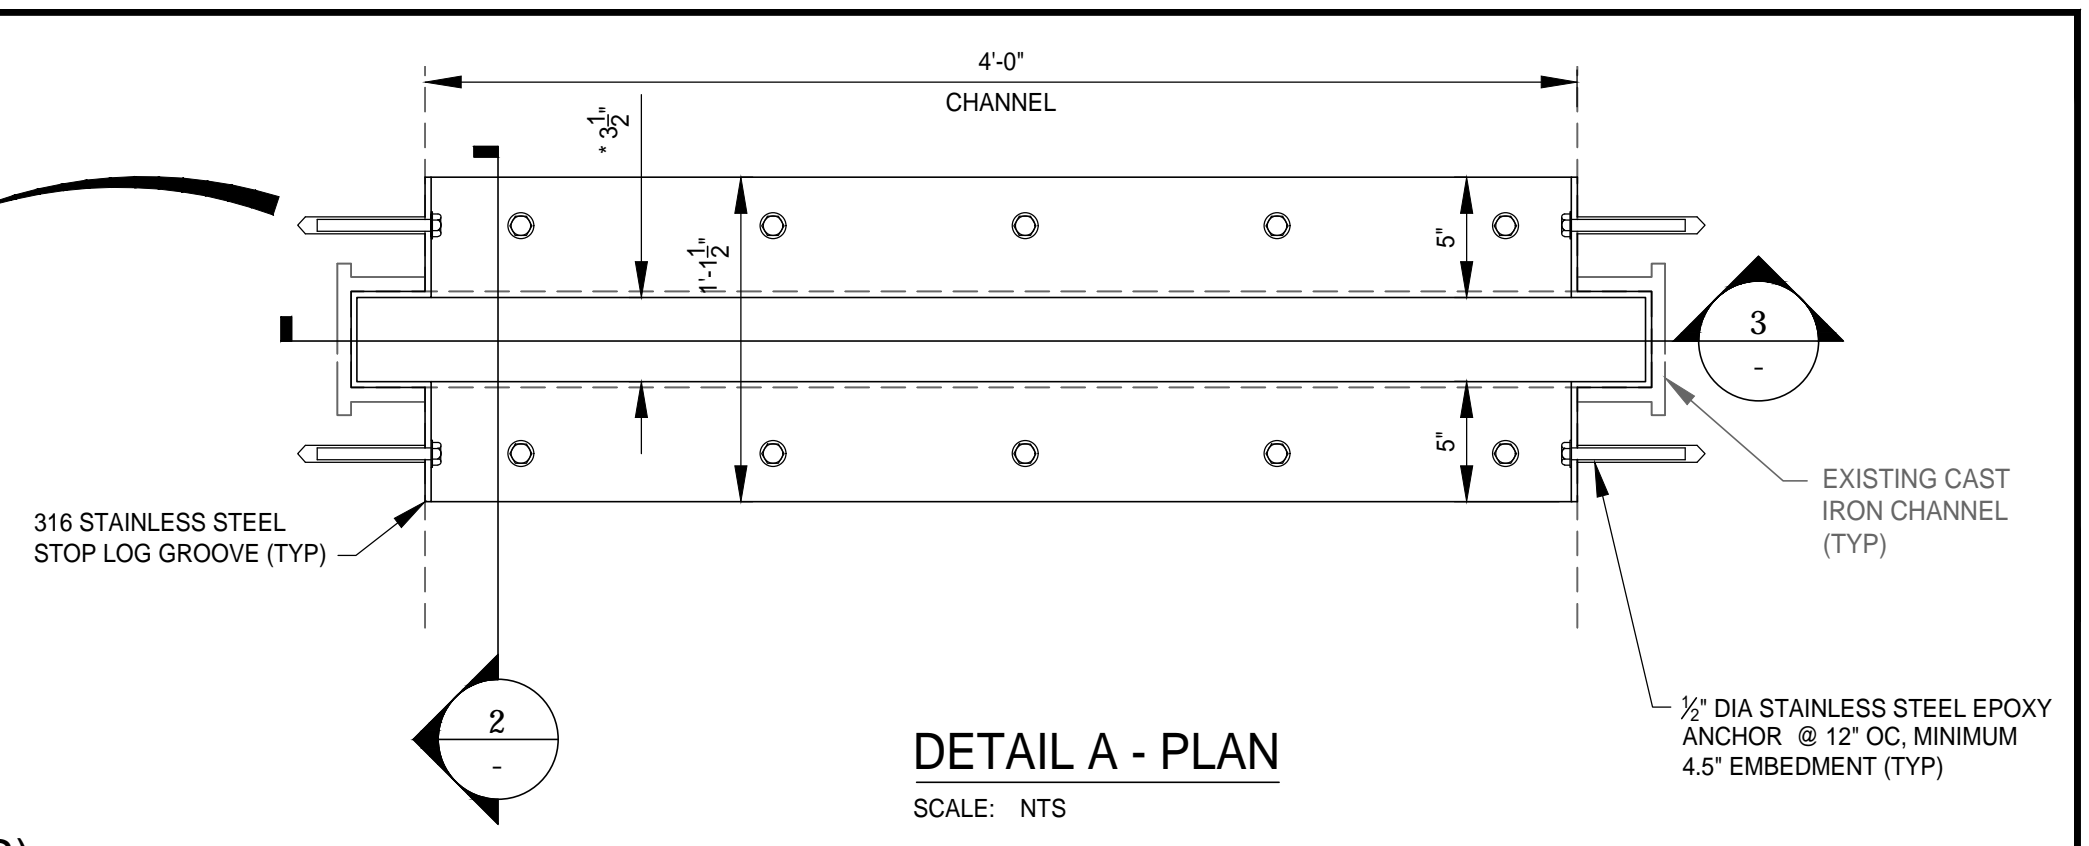

DETAIL A - PLAN
SCALE: NTS

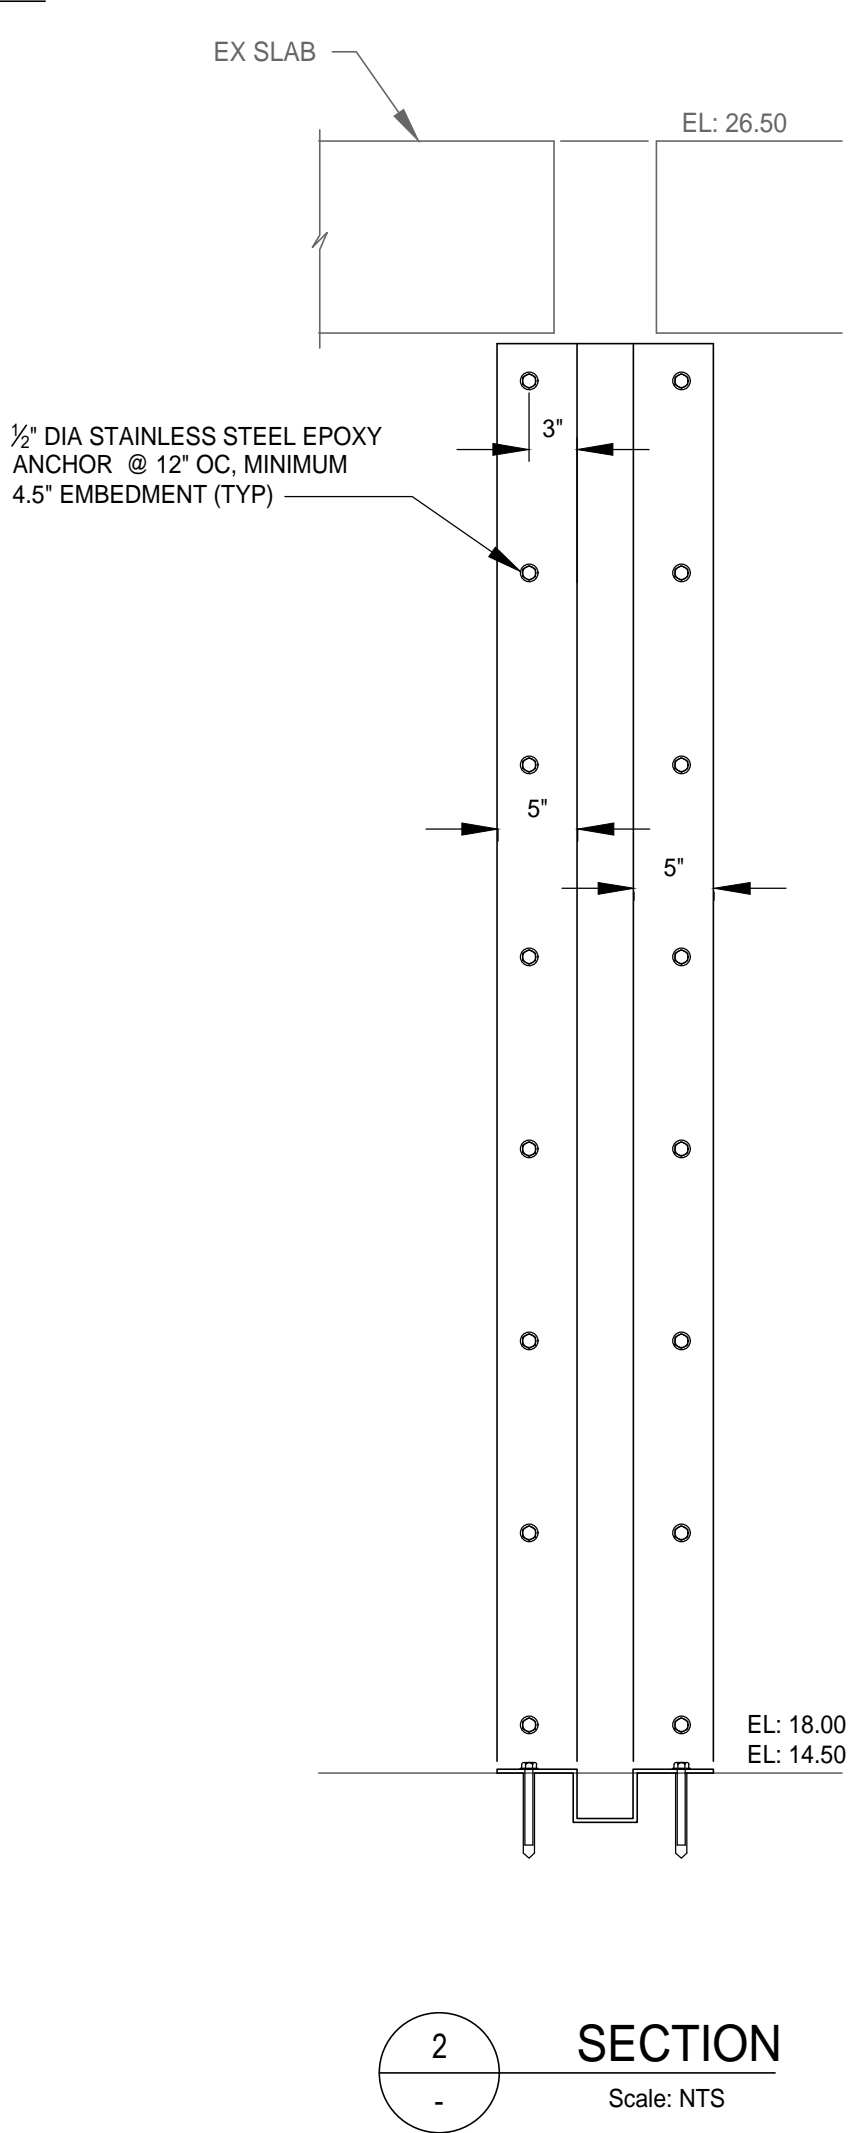

SECTION 2
Scale: NTS

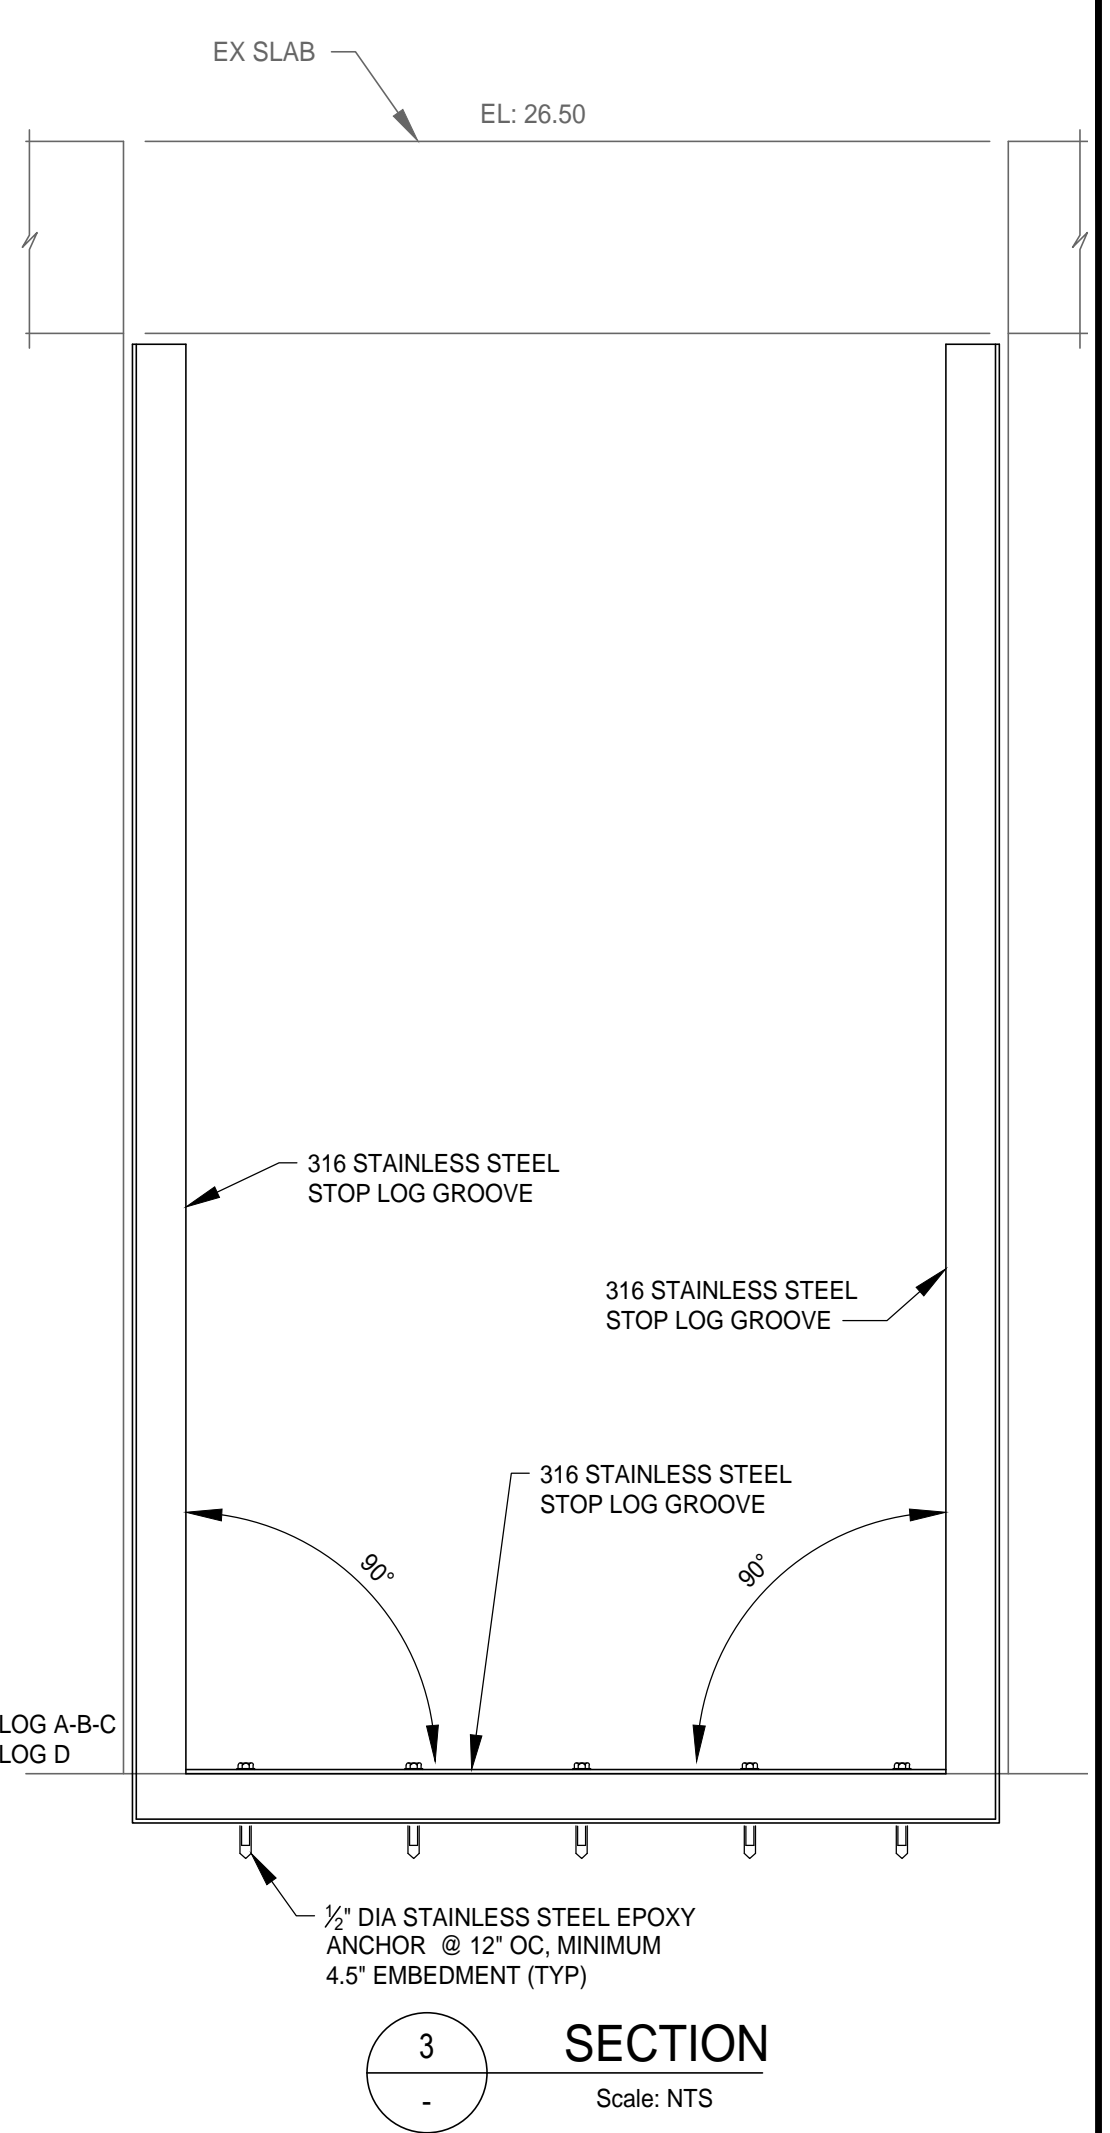


SECTION 3
Scale: NTS

General Notes
All Stop Log Frame Width Measurements were taken from Inside of U-Groove

GENERAL NOTES:

1. ALL DIMENSIONS AND ELEVATIONS OF EXISTING FACILITIES WERE OBTAINED FROM PREVIOUS CONSTRUCTION AND RECORD DRAWINGS. ALL EXISTING DIMENSIONS AND ELEVATIONS SHALL BE VERIFIED IN THE FIELD BY THE CONTRACTOR.
2. REFER TO SHEET G-1 AND S-1 FOR ADDITIONAL NOTES.
3. REFER TO ELECTRICAL SHEETS FOR ADDITIONAL INFORMATION.
4. CONTRACTOR WILL NEED TO CHECK ENTIRE STRUCTURE TO DETERMINE IF EXISTING PVC LINER IS FIRMLY ATTACHED AND CONCRETE IS IN SOUND CONDITION. ALL CORRODED CONCRETE AND UNATTACHED LINER MUST BE REMOVED AND CONCRETE REPAIRED AND COATED PER SPECIFICATIONS.
5. * CONTRACTOR TO VERIFY ALL EXISTING STOP LOG GROOVE DIMENSIONS BEFORE FABRICATING NEW 316 SS STOP LOG GROOVES. ALL PROPOSED STOP LOG GROOVES SHALL BE THE SAME UNIFORM WIDTH AND DEPTH (FOR STOP LOG A,B & C).
6. EXISTING CAST IRON GROOVES SHALL BE HIGH PRESSURE WASHED OR SAND BLASTED TO REMOVE ALL LOOSE, UNSOUND MATERIAL BEFORE INSTALLING OF NEW STOP LOG GROOVES. CONTRACTOR MAY NEED TO FILL VOID AREAS WITH CONCRETE REPAIR MATERIAL OR OTHER APPROVED MATERIAL TO PREVENT VOIDS BEHIND NEW STOP LOG GROOVES.
7. SAND BLASTING SHALL BE 100% CONTAINED.

DESIGNED	G DICK		
DRAWN	O GOMEZ		
CHECKED	G JACOB		
REV. NO.	DATE	DESCRIPTION	REV. BY

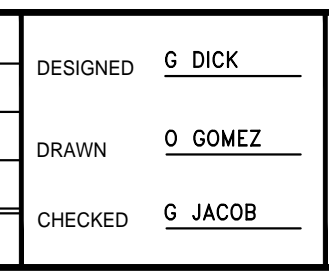

302 Knights Run Avenue, Suite 900
Tampa, FL 33602
813.254.5838
FIRM'S FLORIDA
CERT. NO.
AAP000034/CA3806
IB26000797/LC26000381

APPROVED BY:

JOSEPH B. BARKSDALE
FLA. LIC. NO 46545



PROJECT:
**CITY OF TAMPA
UNIVERSITY PUMPING STATION
AUTOMATIC BAR SCREEN**


DESCRIPTION:
**LOWER PLAN
SECTIONS AND DETAILS**

DATE:
AUGUST 2018
GSP JOB No. 4291800
SHEET: **M-6** 8 OF 27


PIPE DIAMETER	DIMENSIONS IN INCHES				LOAD RATING LBS
	'A'	'B' SEE NOTE 3 BELOW	'C' HOLE DIAMETER	'D' FLAT BAR SIZE	
3/4	5 15/16	2 1/2	7/16	3/16x1 1/4	190
1	6 1/4	2 5/8	7/16	3/16x1 1/4	190
1 1/4	6 11/16	2 3/4	7/16	3/16x1 1/4	190
1 1/2	6 15/16	3	7/16	3/16x1 1/4	190
2	8 5/16	3 3/16	7/16	1/4x1 1/4	420
2 1/2	8 7/8	3 7/16	7/16	1/4x1 1/4	420
3	9 1/8	3 3/4	7/16	1/4x1 1/4	420
3 1/2	10 1/16	4	7/16	1/4x1 1/4	420
4	10 9/16	4 1/4	9/16	1/4x1 1/2	610
5	11 3/4	4 3/4	9/16	1/4x1 1/2	610
6	14 3/8	5 5/16	9/16	3/8x1 1/2	870
8	16 5/8	6 5/16	9/16	3/8x1 1/2	870

- NOTES:
- WHERE SUBMERGED, PIPE CLAMP, ANCHORS, SHIELD, NUTS AND LOCKWASHER TO BE TYPE 316 STAINLESS STEEL.
 - WHEN USED WITH PVC OR FIBERGLASS PIPE, PROVIDE STEEL SHIELD WITH LOOSE FIT AROUND PIPE AT CLAMP. WRAP COPPER TUBING WITH 2" WIDE STRIP OF RUBBER AT CLAMP.
 - FOR FLANGED PIPING, INCREASE 'B' DIMENSION AS REQUIRED.


A PIPE CLAMP FOR INDIVIDUAL PIPES
(FOR PIPE 8" DIAMETER AND SMALLER)

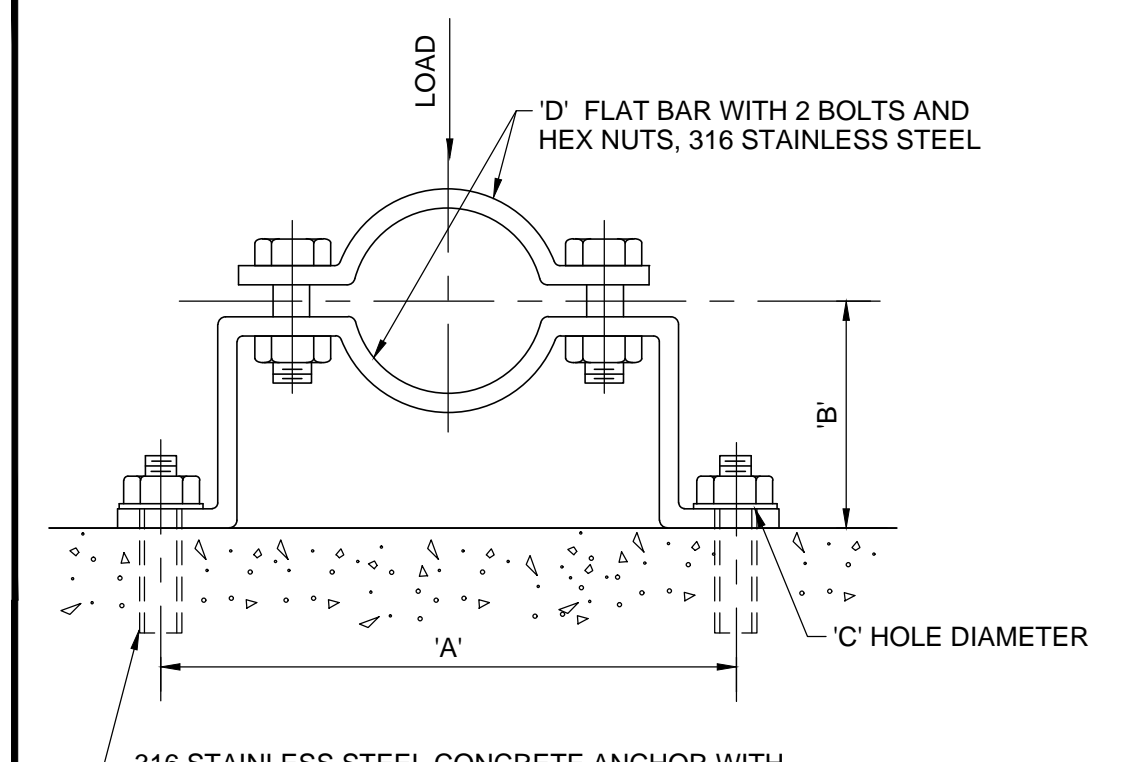

316 STAINLESS STEEL CONCRETE ANCHOR WITH HEX NUT AND LOCKWASHER (TYPICAL) SEE SPECIFICATIONS.
3/8" DIAMETER FOR 3/4" TO 3 1/2" DIAMETER PIPE
1/2" DIAMETER FOR 4" TO 8" DIAMETER PIPE

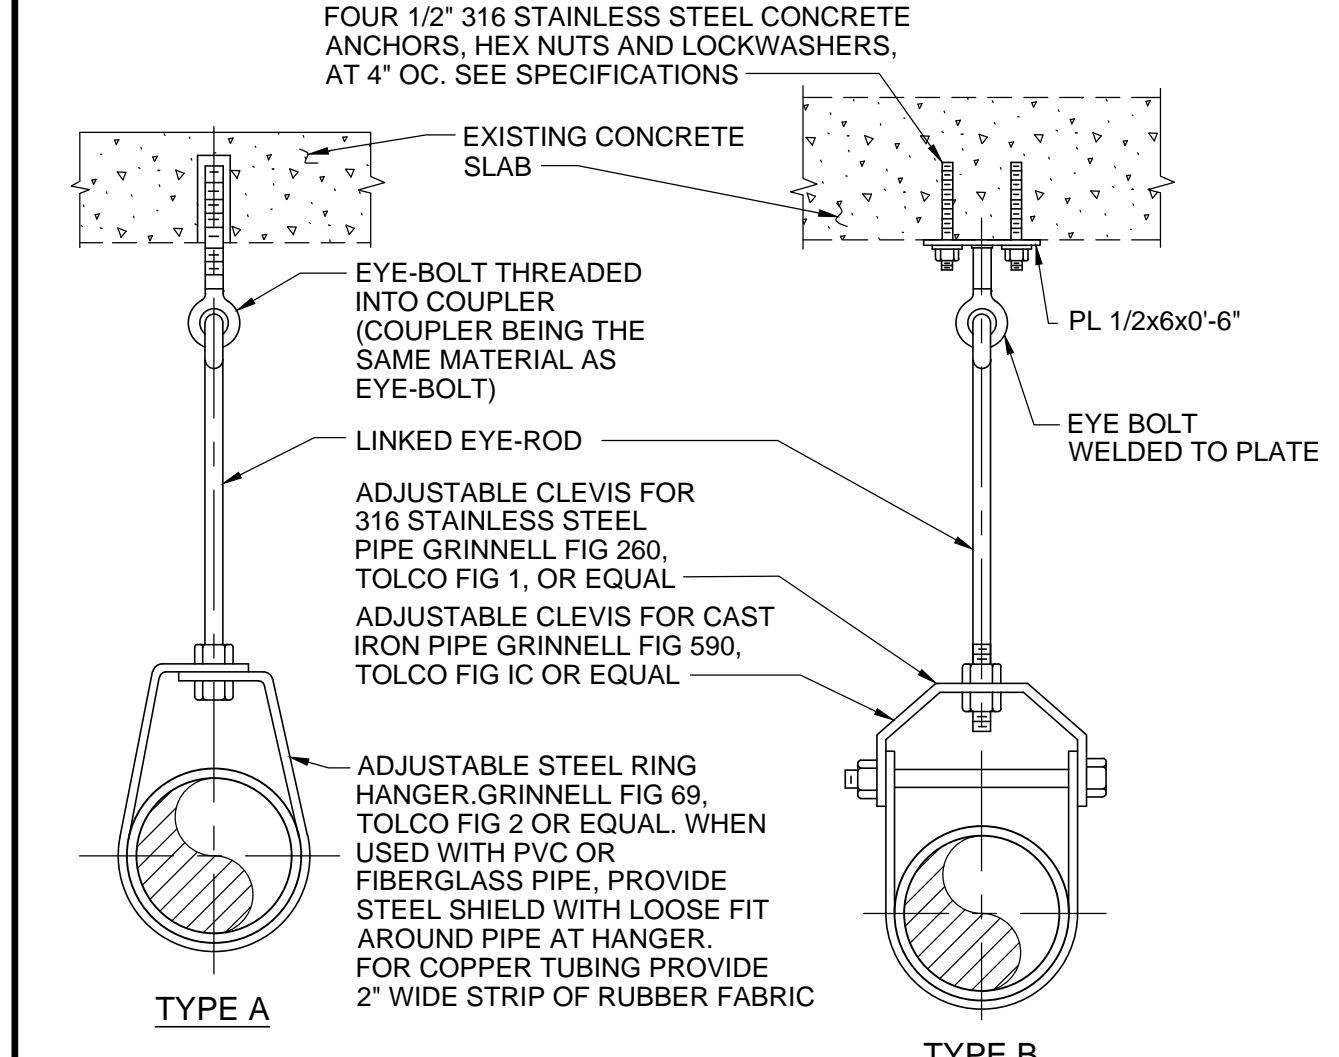

D PIPE HANGER FOR EXISTING CONCRETE
(FOR PIPE 16" DIAMETER AND SMALLER)

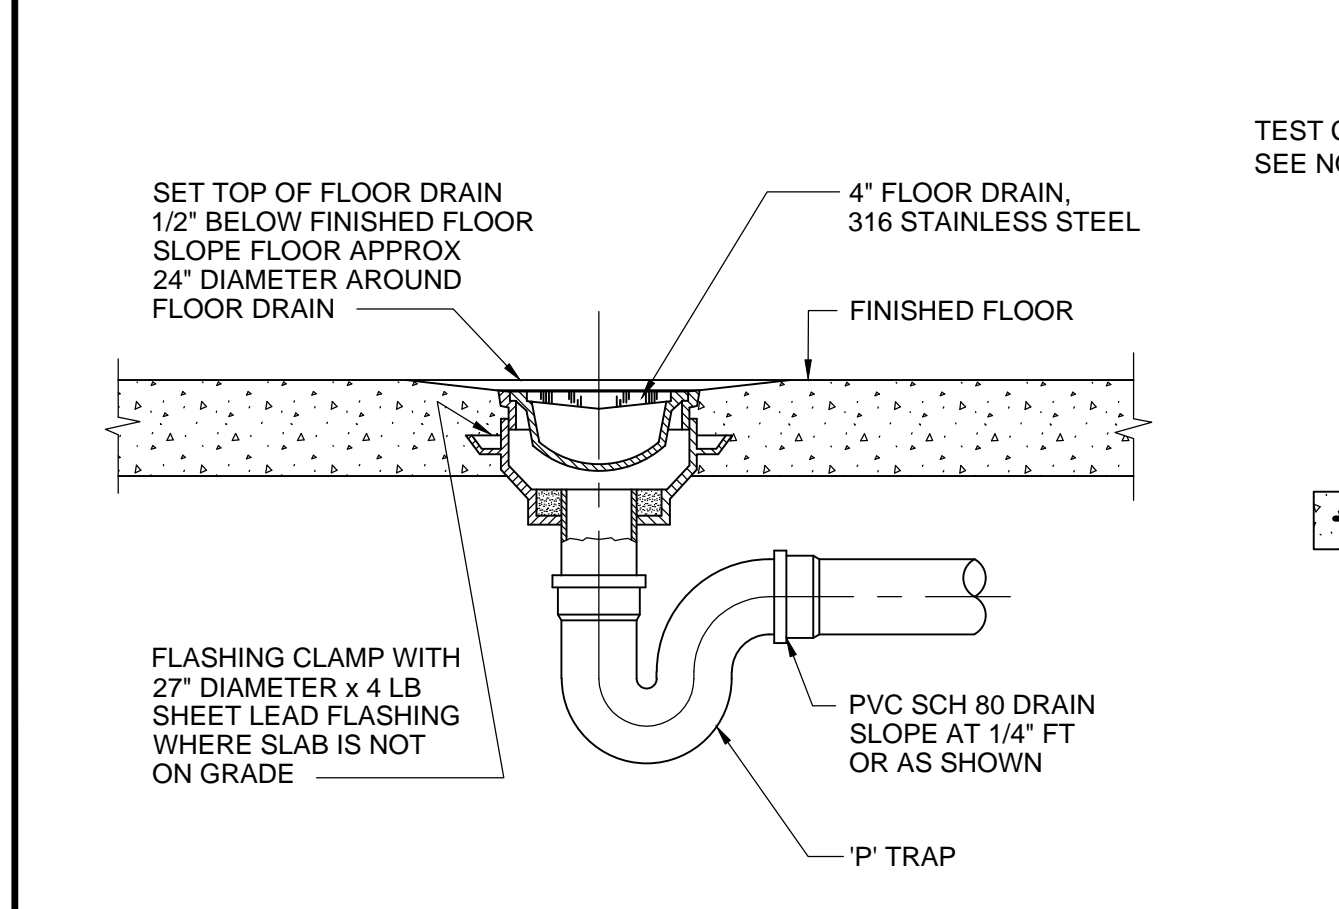


H FLOOR DRAIN

PIPE DIAMETER (INCHES)	ROD DIAMETER (INCHES)	MAX SUPPORT SPACING (FEET)		WEIGHT LIMIT (LBS)	
		STEEL PIPE	CI PIPE	TYPE A	TYPE B
1 & SMALLER	3/8	6	10	300	610
1 1/4 TO 2	3/8	10	10	300	610
2 1/2 TO 3 1/2	1/2	12	10	525	1130
4 TO 5	5/8	14	10	650	1430
6, 8	3/4	17	10	1000	1940
10, 12	7/8	18	---	---	3600
14, 16	1	20	---	---	3800


- NOTES:
- DESIGN IS FOR STATIC LOAD, ONLY.
 - FOR ADDITIONAL REQUIREMENTS SEE SPECIFICATION SECTION 'PIPE SUPPORTS'.
 - ALL HANGER COMPONENTS SHALL BE 316 STAINLESS STEEL.

D PIPE HANGER FOR EXISTING CONCRETE
(FOR PIPE 16" DIAMETER AND SMALLER)

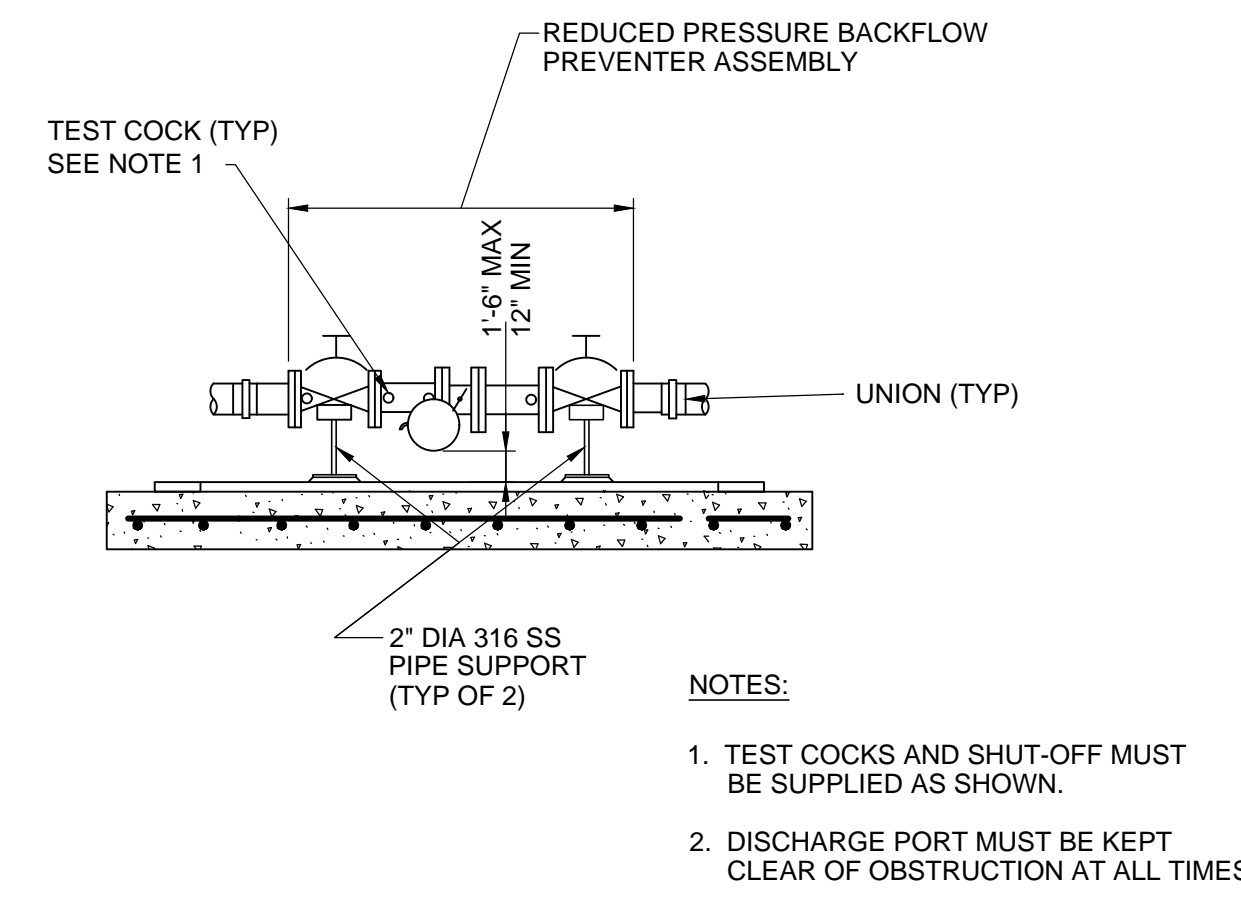


J BACKFLOW PREVENTER


DESIGNED	G DICK
DRAWN	O GOMEZ
CHECKED	G JACOB
REV. BY	

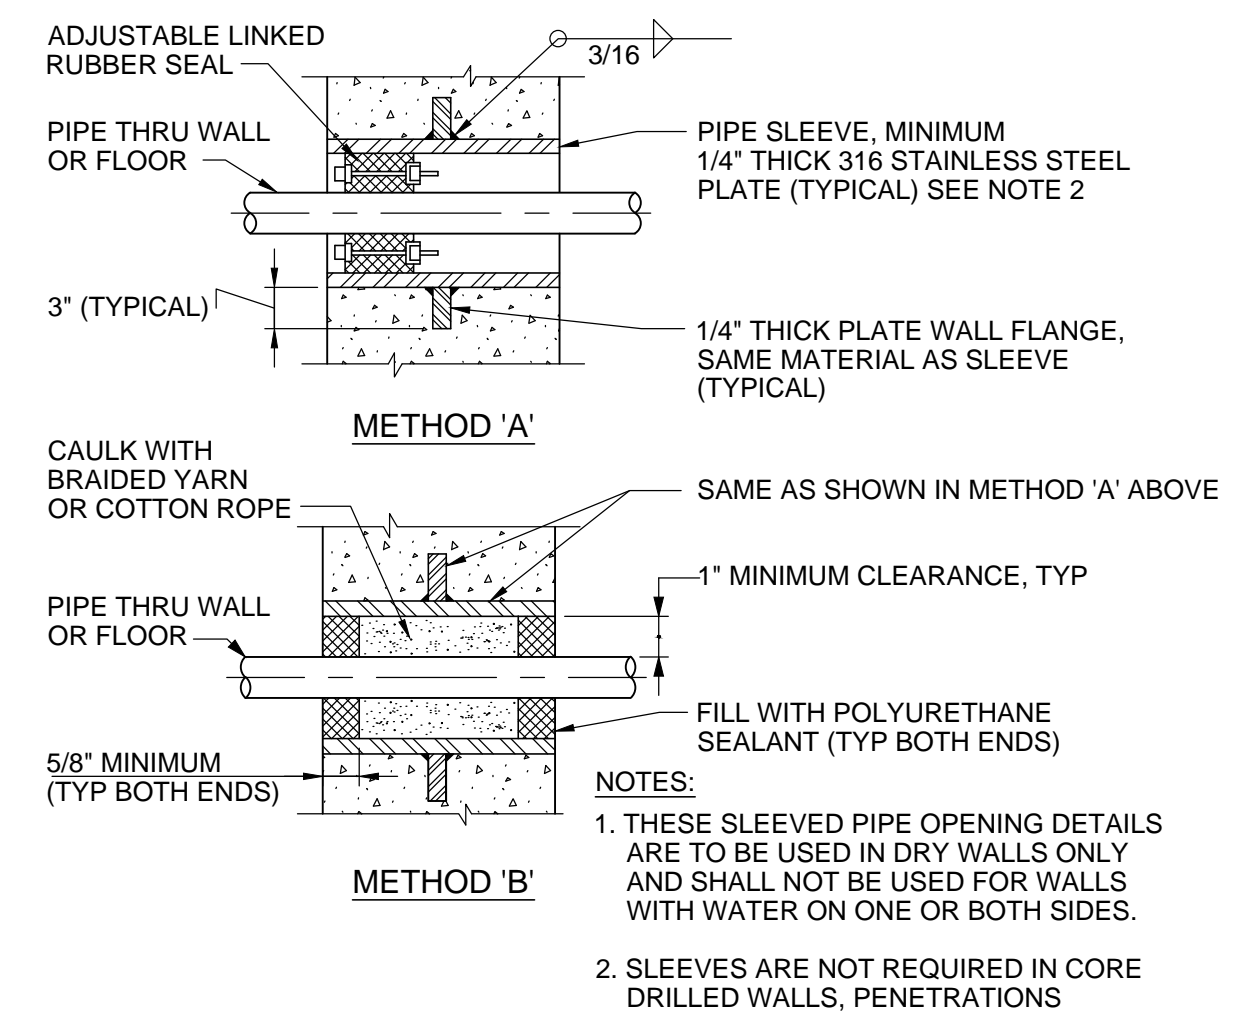


B SLEEVED PIPE OPENING

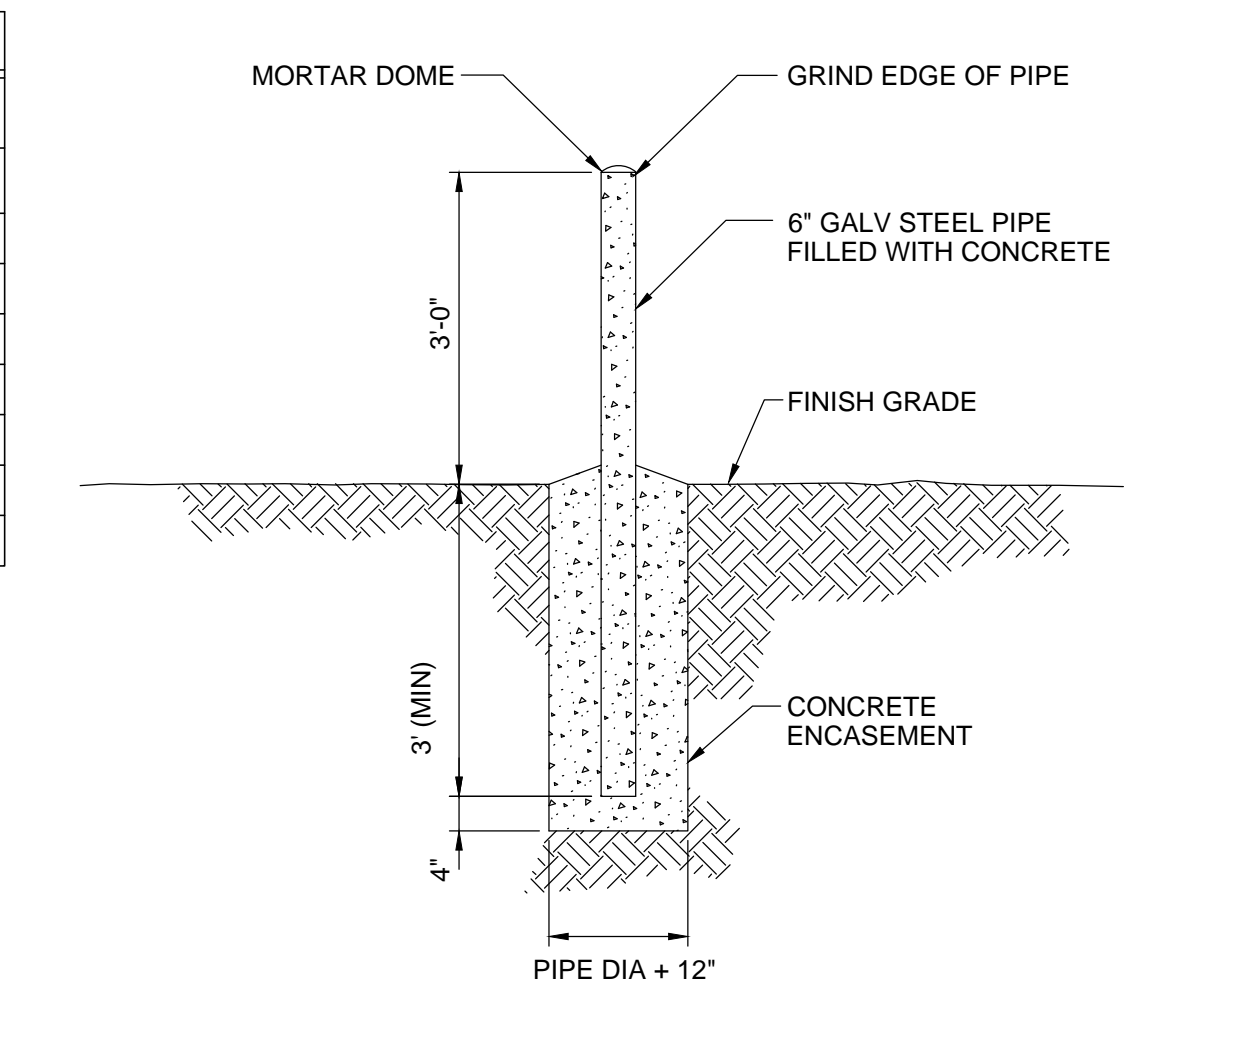


E GUARD POST

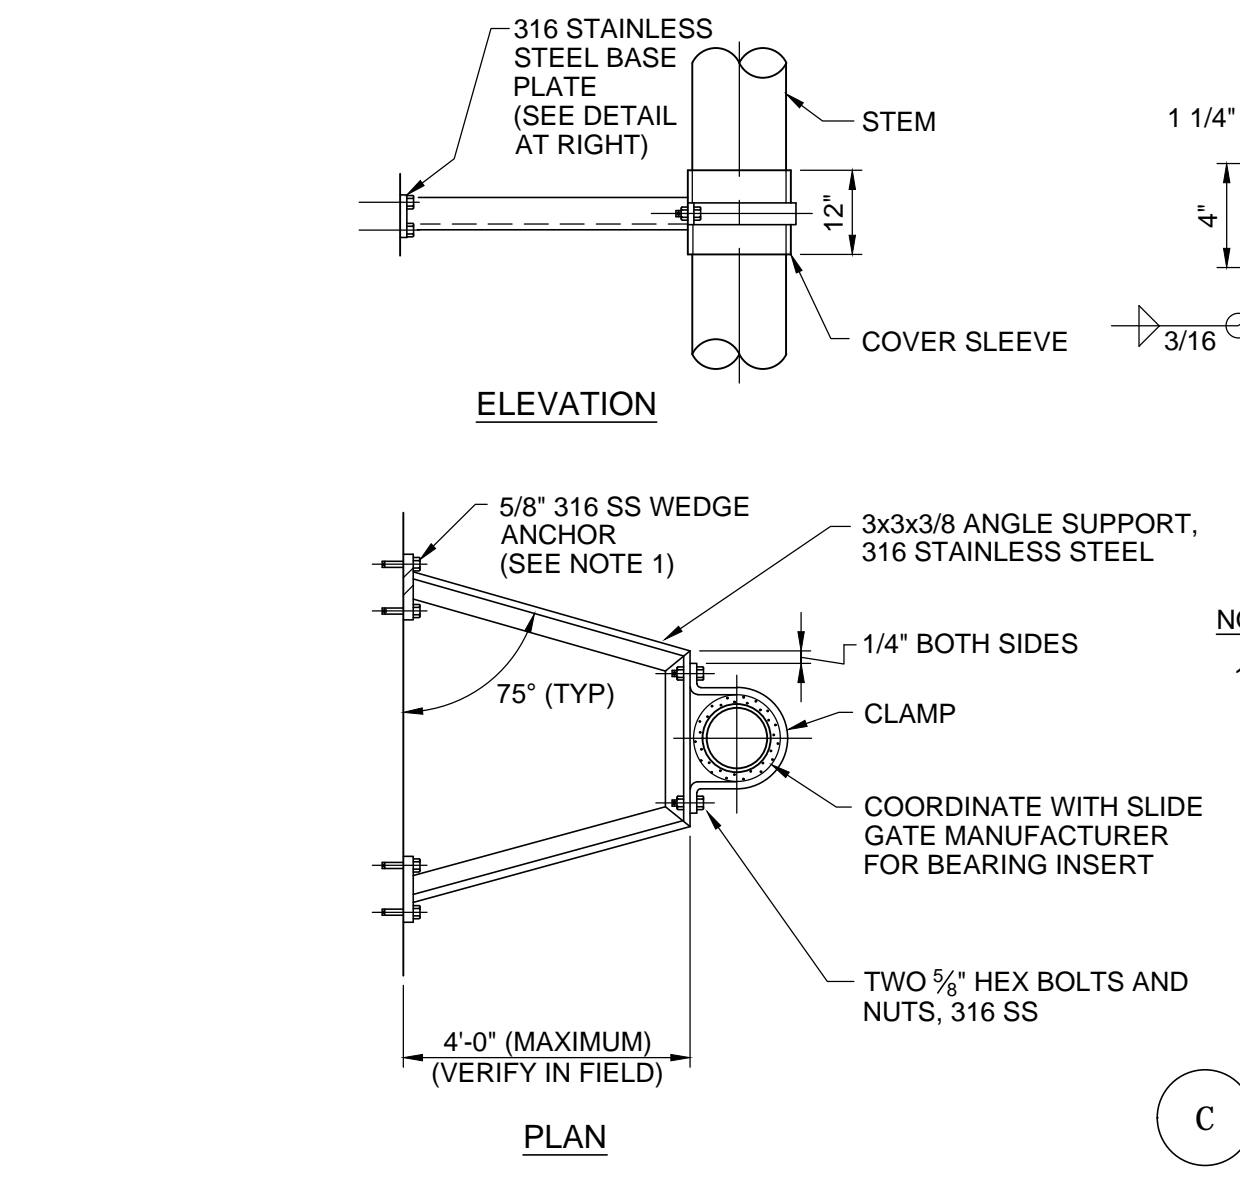

C STEM SUPPORT

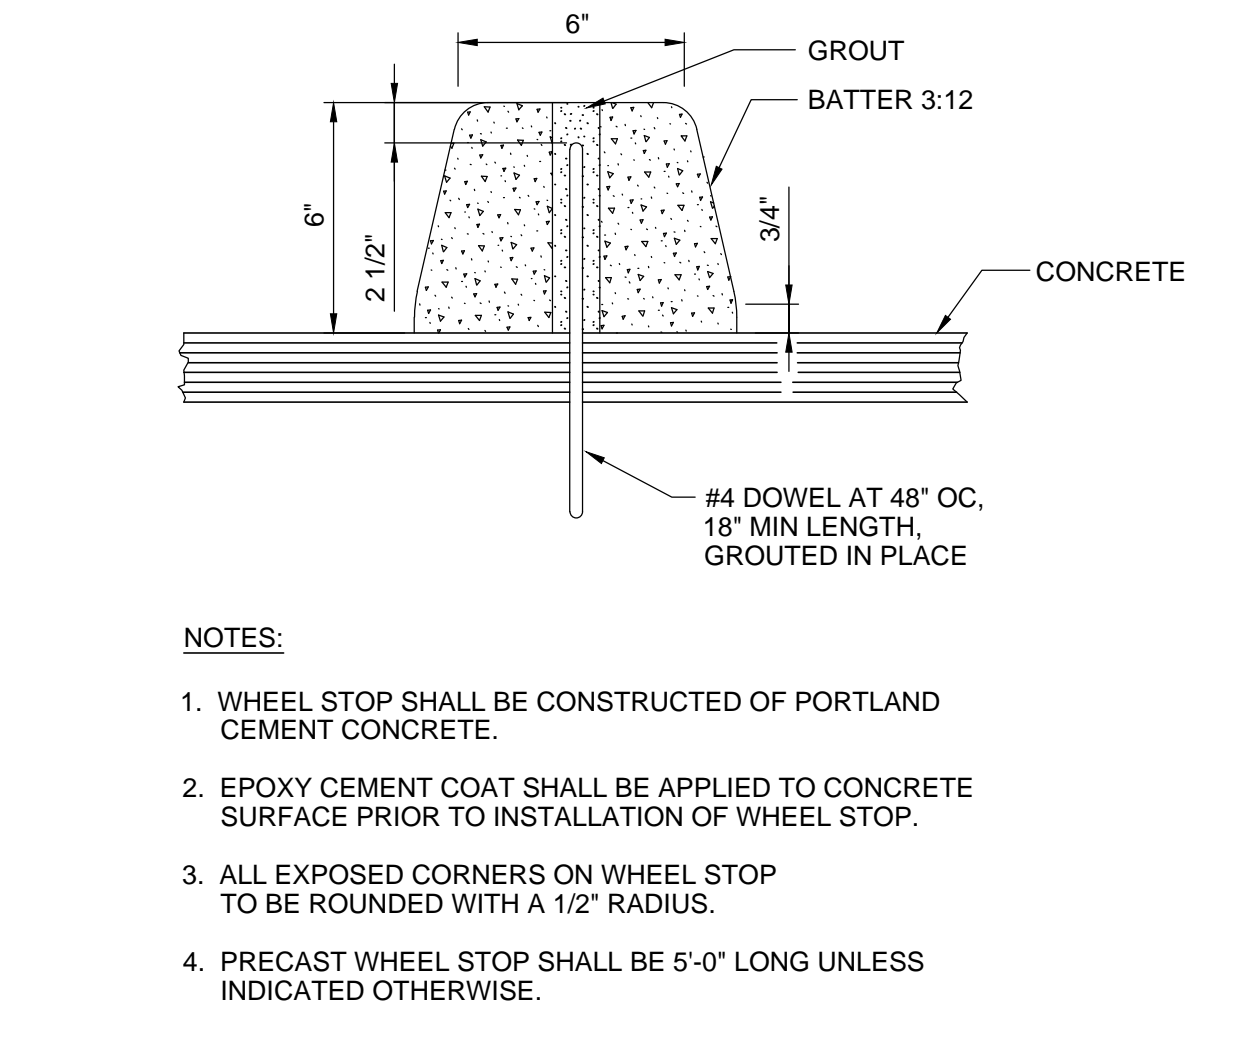

F PRECAST WHEEL STOP



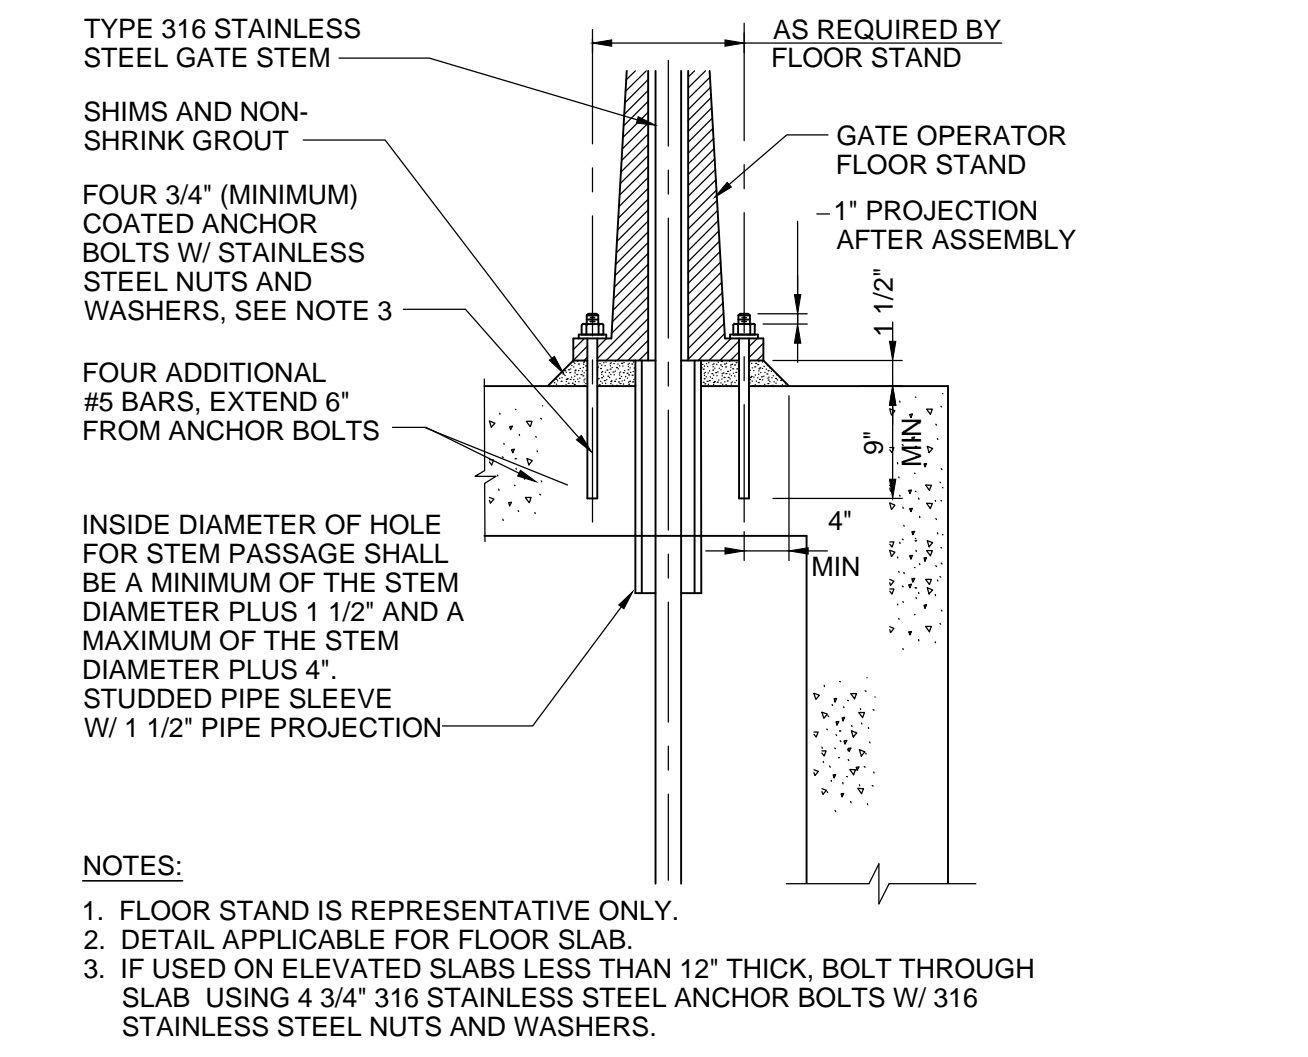


G FLOOR STAND INSTALLATION

P:\4291800\N\M-7.dwg, Aug 15, 2018 - 9:30am

REV. NO.	DATE	DESCRIPTION	REV. BY	DESIGNED	G DICK		302 Knights Run Avenue, Suite 900 Tampa, FL 33602 813.254.5838 FIRM'S FLORIDA CERT. NO. AAP000034/CA3806 IB26000797/LC26000381	APPROVED BY:			PROJECT:	CITY OF TAMPA UNIVERSITY PUMPING STATION AUTOMATIC BAR SCREEN	DESCRIPTION:	MECHANICAL STANDARD DETAILS	DATE:	AUGUST 2018
				DRAWN	O GOMEZ			JOSEPH B. BARKSDALE	DATE			GSP JOB No.	4291800			
				CHECKED	G JACOB			FLA. LIC. NO	46545		SHEET:	M-7	9 OF 27			
				REV. BY												


P:\4291800\AS-2.dwg, Aug 15, 2018 - 9:32am

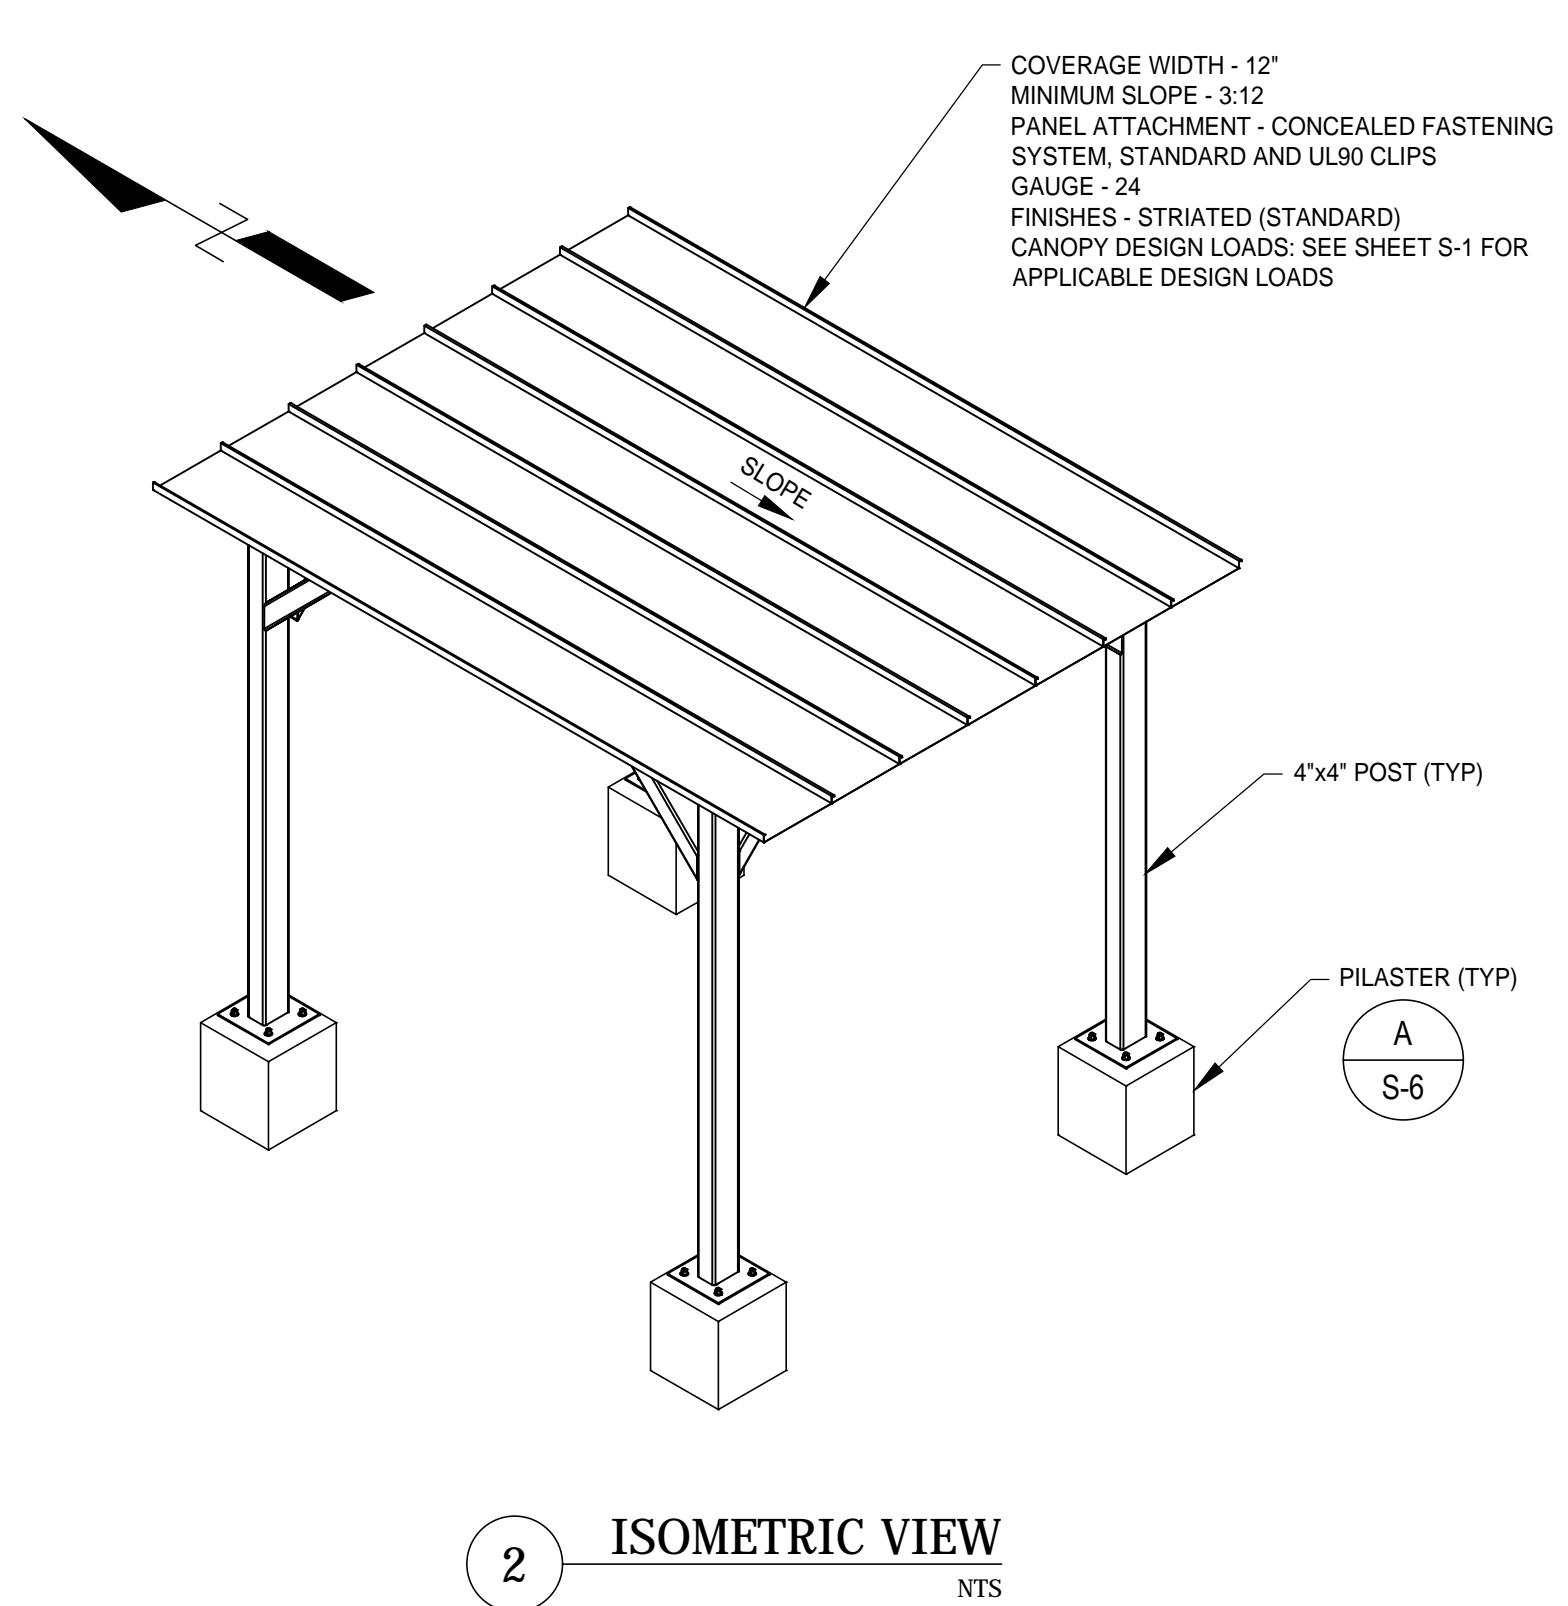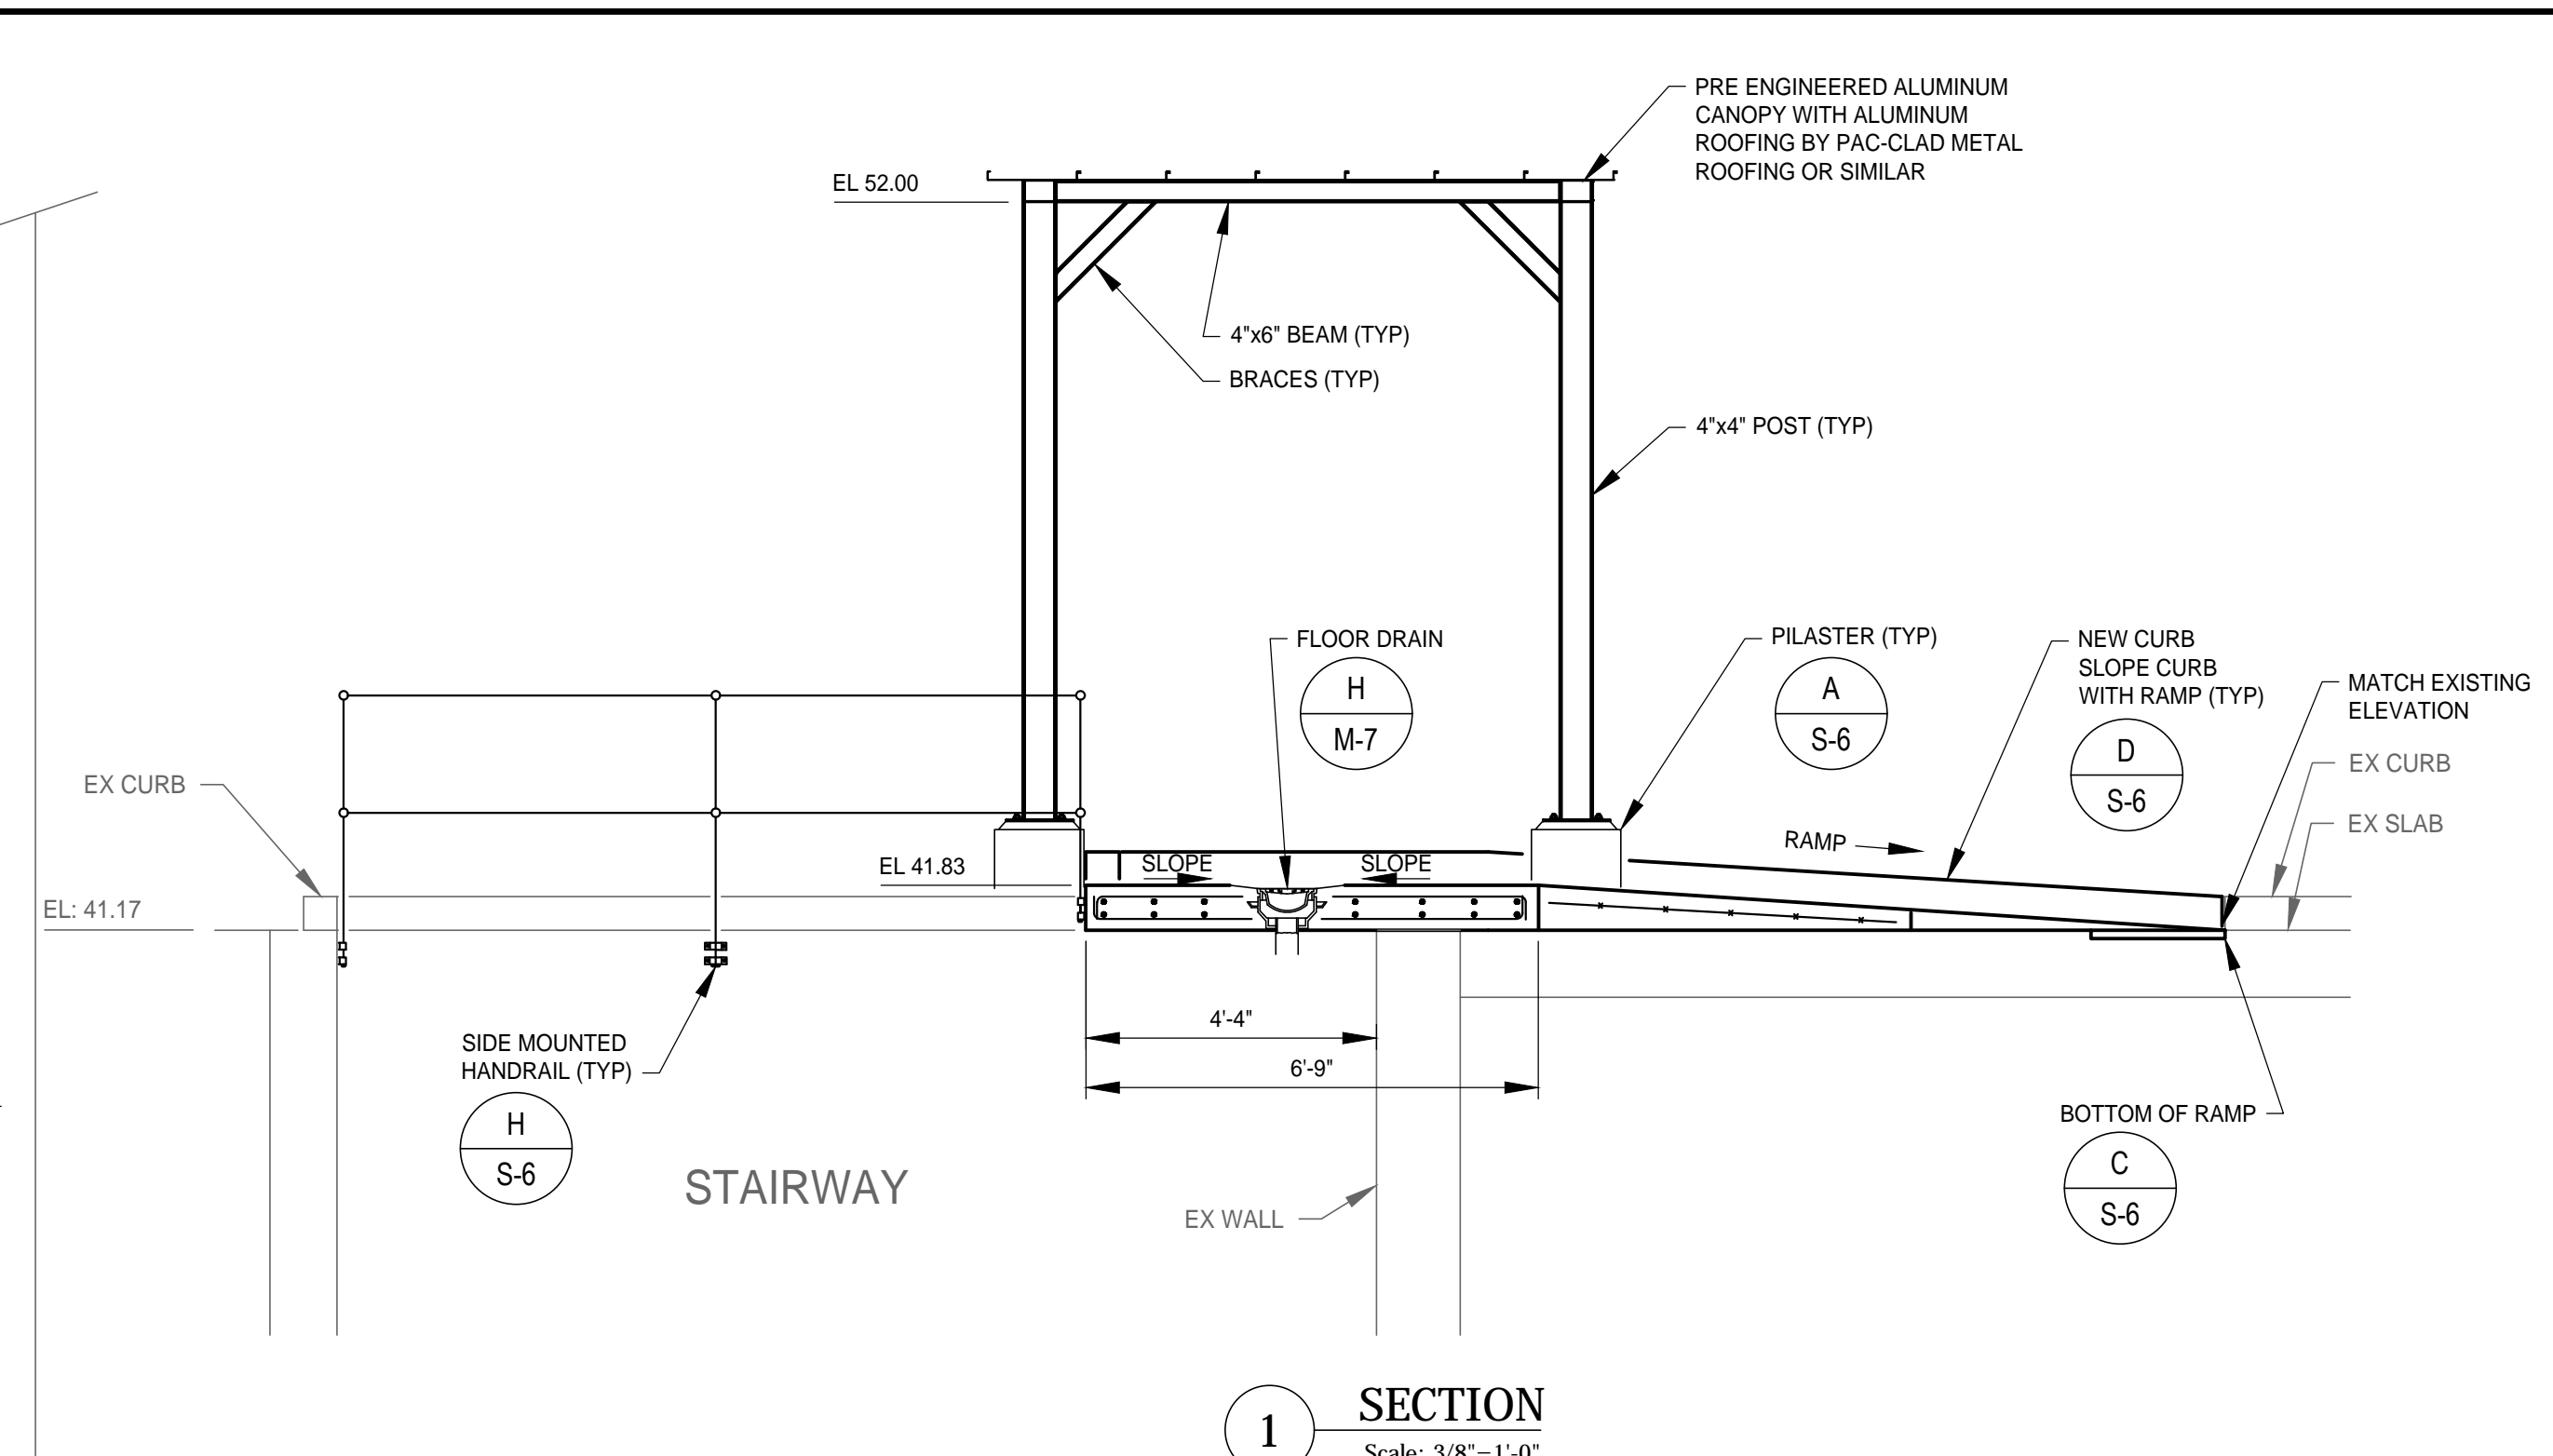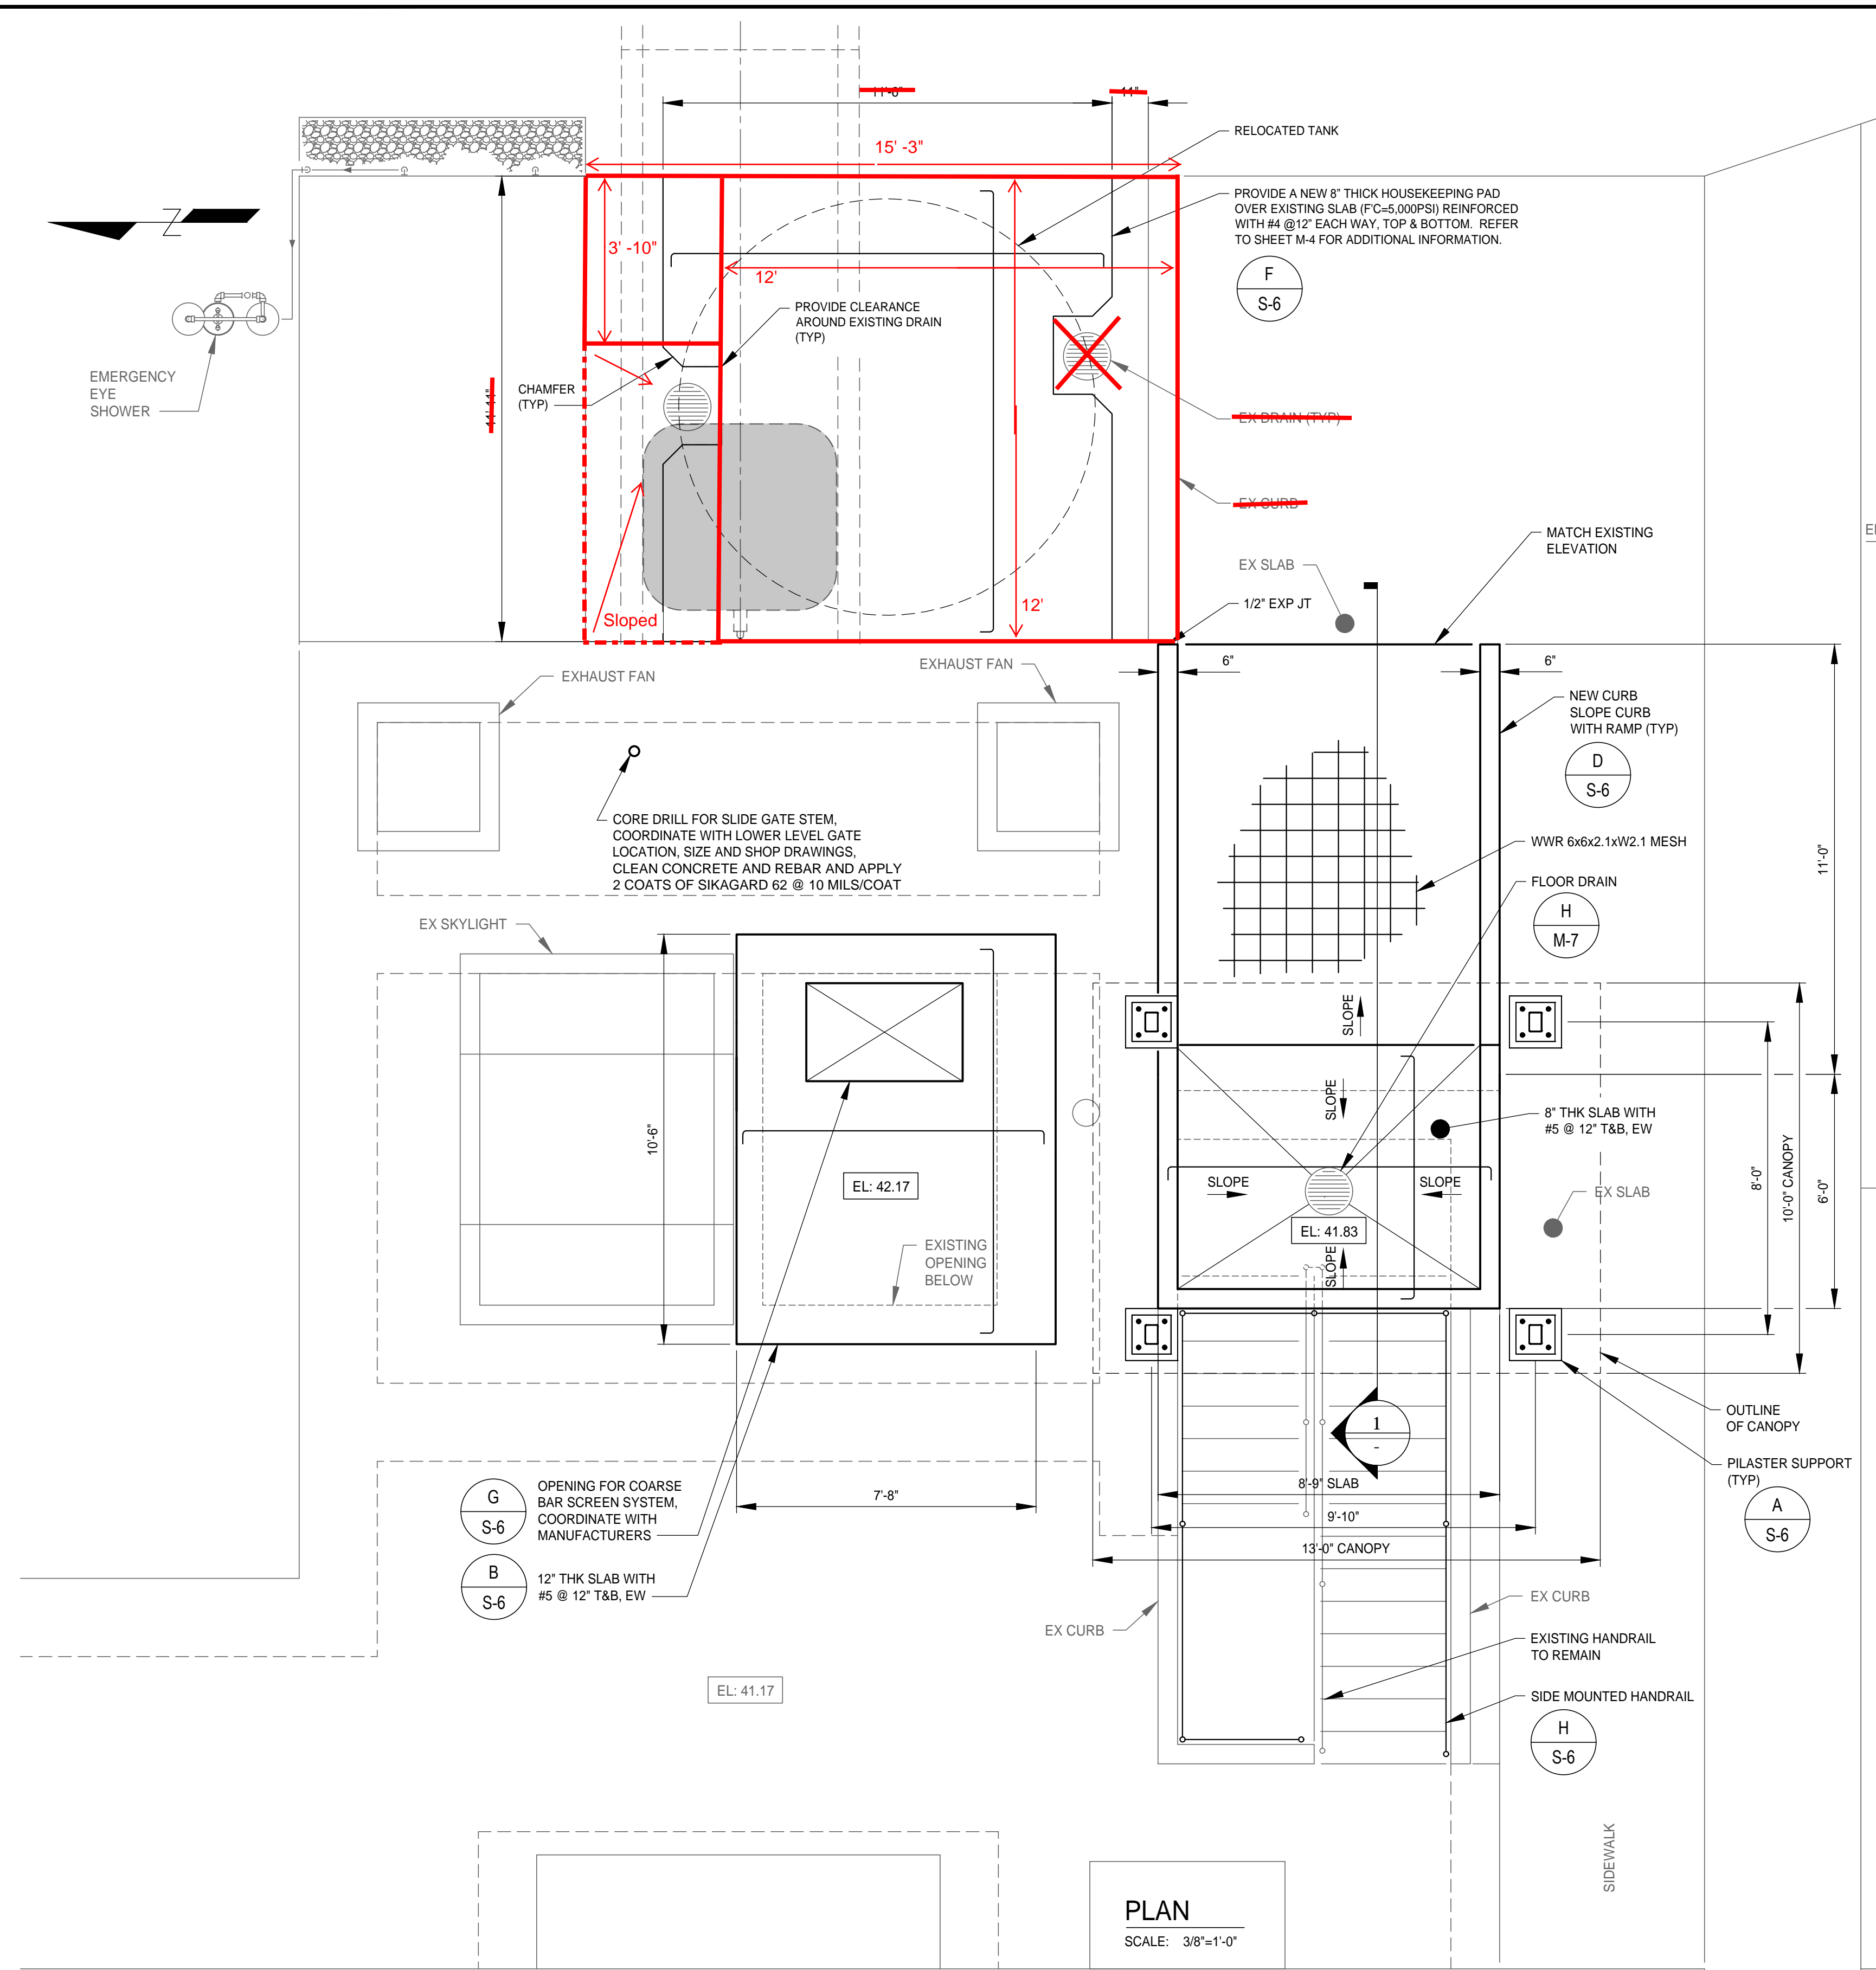

- GENERAL NOTES:**
- ALL DIMENSIONS AND ELEVATIONS OF EXISTING FACILITIES WERE OBTAINED FROM PREVIOUS CONSTRUCTION AND RECORD DRAWINGS. ALL EXISTING DIMENSIONS AND ELEVATIONS SHALL BE VERIFIED IN THE FIELD BY THE CONTRACTOR.
 - REFER TO SHEET G-1 AND S-1 FOR ADDITIONAL NOTES.

DESIGNED	RJ TAZELAAR	<p>302 Knights Run Avenue, Suite 900 Tampa, FL 33602 813.254.5838 FIRM'S FLORIDA CERT. NO. AAP000034/CA3806 1B2600797/LC26000381</p>	APPROVED BY:	<p>CITY OF TAMPA UNIVERSITY PUMPING STATION AUTOMATIC BAR SCREEN</p>	DESCRIPTION:	<p>UPPER PLAN, SECTION AND ISOMETRIC VIEW</p>	DATE:	AUGUST 2018	
DRAWN	O GOMEZ						GSP JOB No.	4291800	
CHECKED	J FUKUDA		JASON FUKUDA FLA. LIC. NO 66000				SHEET:	S-2	11 OF 27
REV. NO.	DATE		DESCRIPTION		REV. BY				

P:\4291800\W\S-3.dwg, Aug 15, 2018 - 9:33am

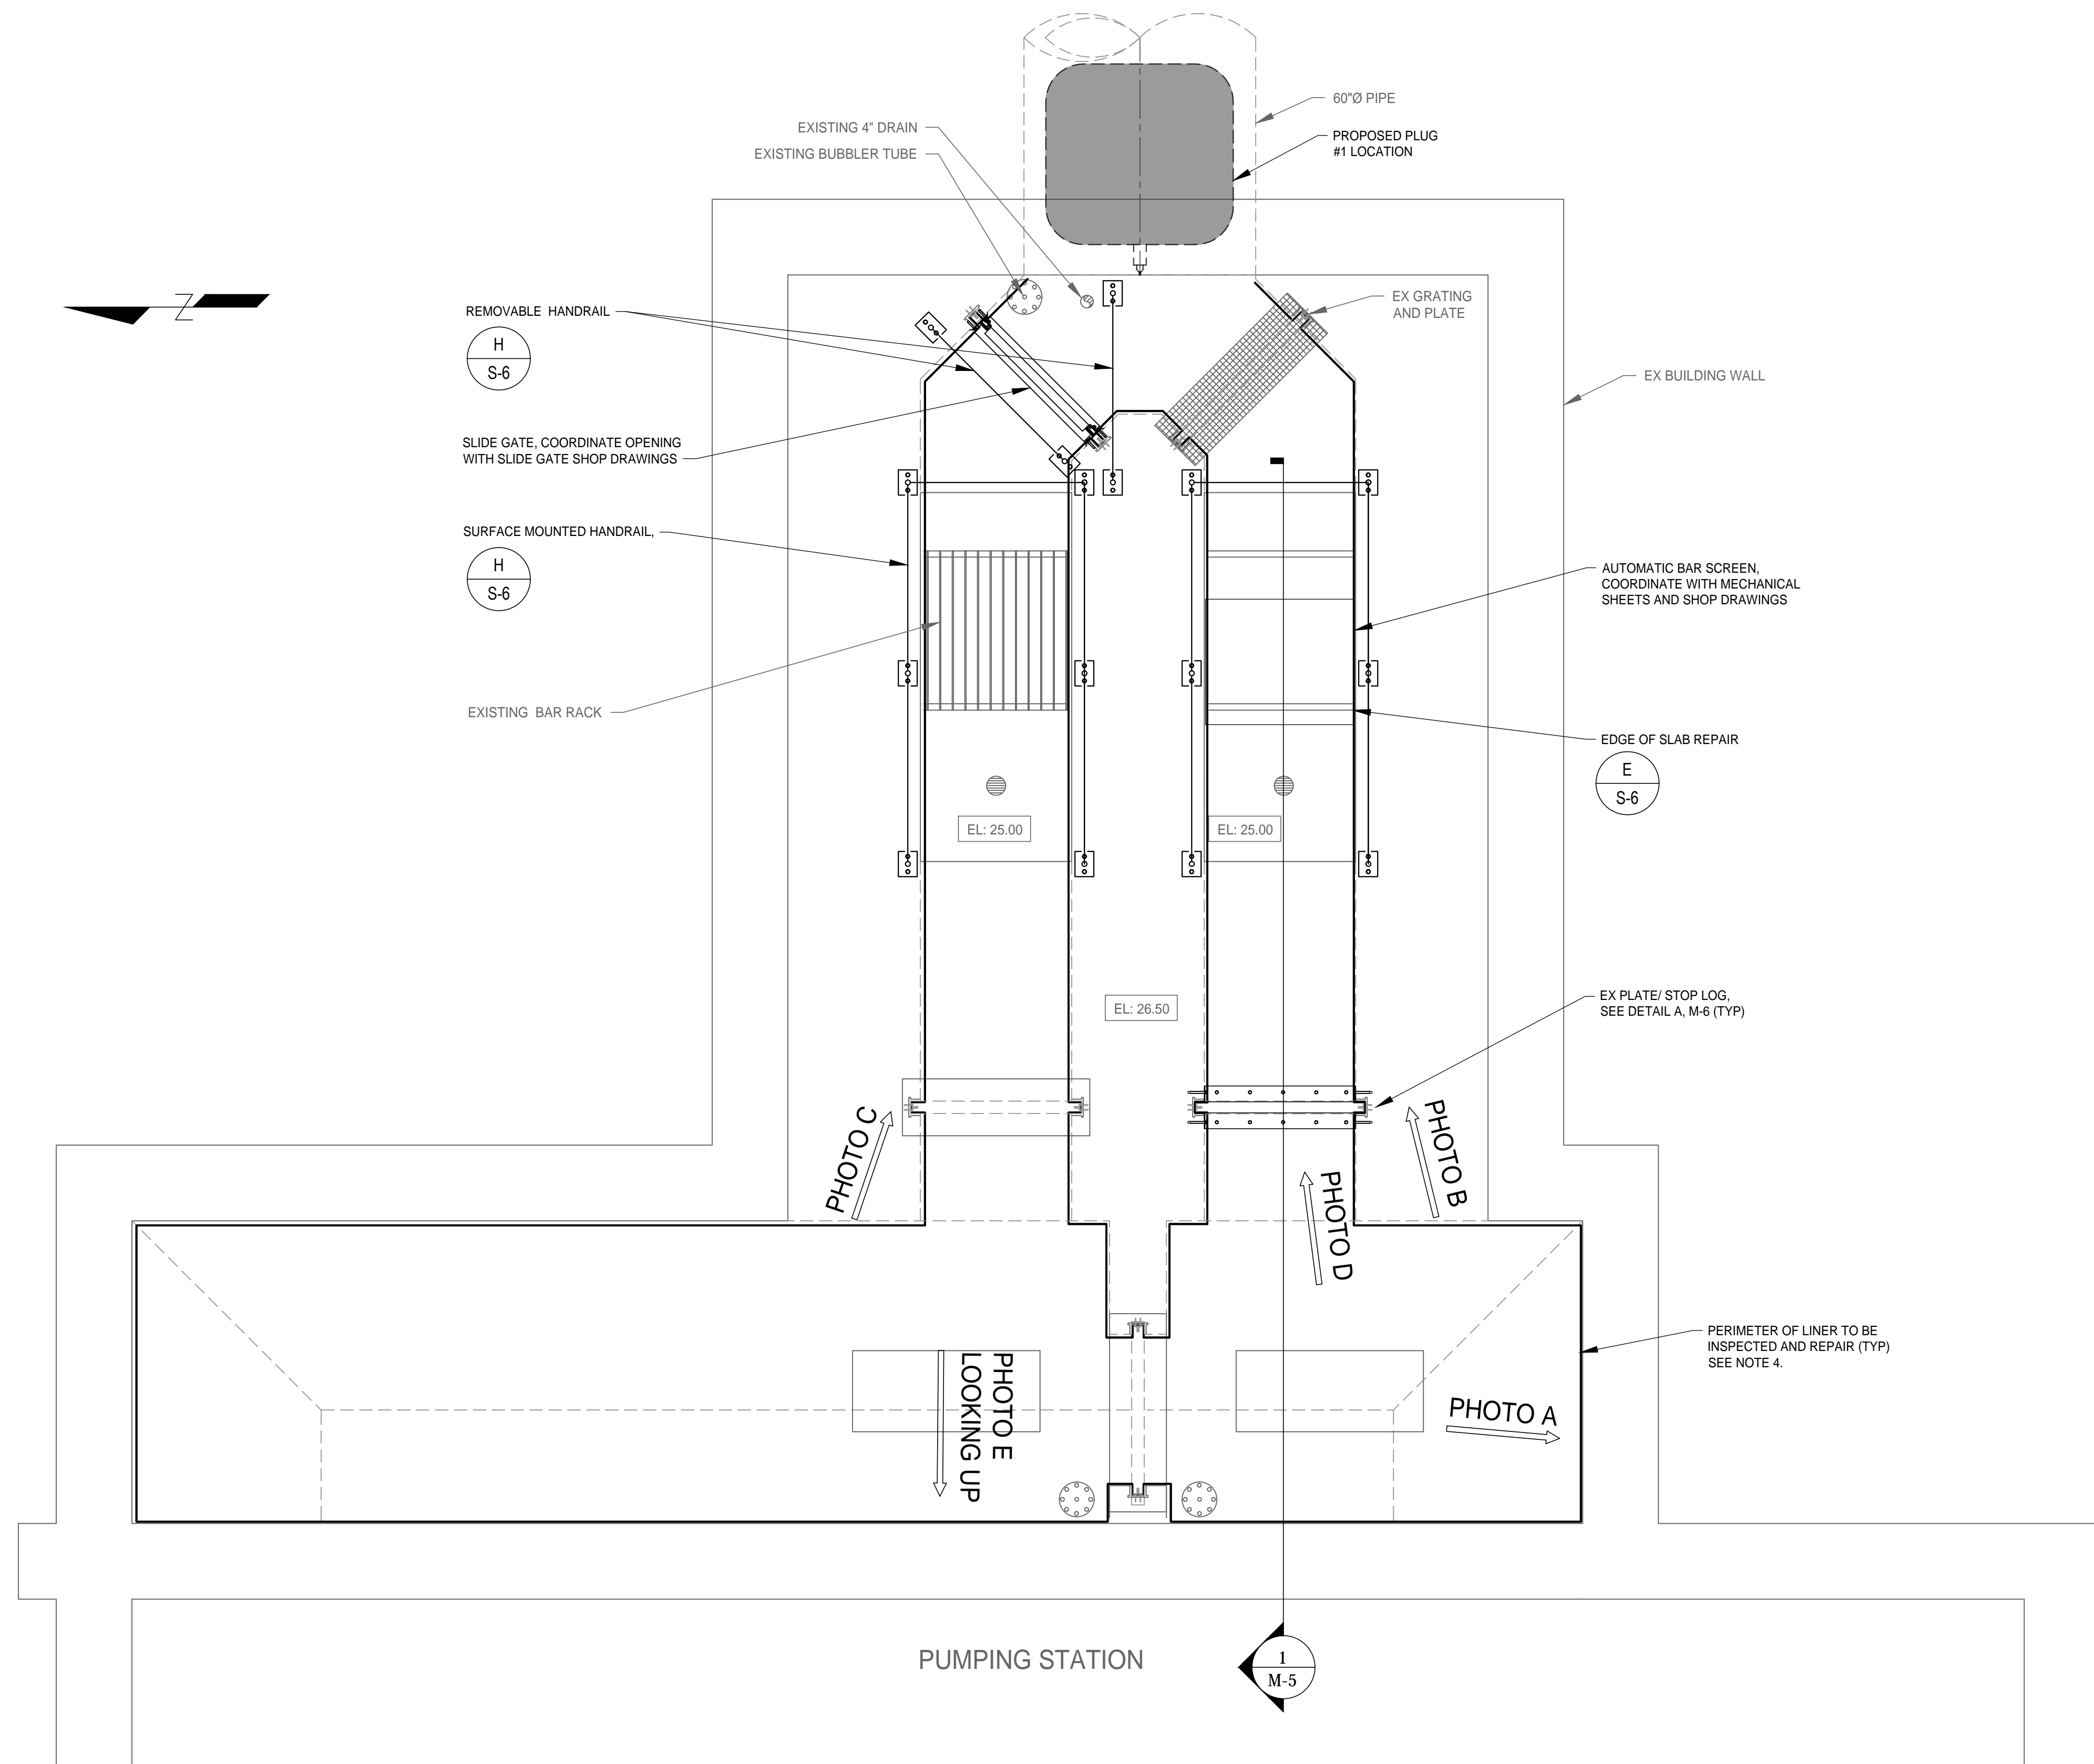


PUMPING STATION
PLAN
 SCALE: 3/8"=1'-0"

- GENERAL NOTES:**
1. ALL DIMENSIONS AND ELEVATIONS OF EXISTING FACILITIES WERE OBTAINED FROM PREVIOUS CONSTRUCTION AND RECORD DRAWINGS. ALL EXISTING DIMENSIONS AND ELEVATIONS SHALL BE VERIFIED IN THE FIELD BY THE CONTRACTOR.
 2. REFER TO SHEET G-1 AND S-1 FOR ADDITIONAL NOTES.
 3. FOR PHOTO LOCATION REFER TO SHEET S-4.
 4. CONTRACTOR WILL NEED TO CHECK ENTIRE STRUCTURE TO DETERMINE IF EXISTING PVC LINER IS FIRMLY ATTACHED AND CONCRETE IS IN SOUND CONDITION. ALL CORRODED CONCRETE AND UNATTACHED LINER MUST BE REMOVED AND CONCRETE REPAIRED AND COATED PER SPECIFICATIONS.

REV. NO.	DATE	DESCRIPTION	REV. BY

DESIGNED: R.J. TAZELAAR
 DRAWN: O. GOMEZ
 CHECKED: J. FUKUDA



302 Knights Run Avenue, Suite 900
 Tampa, FL 33602
 813.254.5838
 FIRM'S FLORIDA
 CERT. NO.
 AAP000034/CA3806
 1B26000797/LC26000381

APPROVED BY:
 JASON FUKUDA
 FLA. LIC. NO. 66000




PROJECT: CITY OF TAMPA
 UNIVERSITY PUMPING STATION
 AUTOMATIC BAR SCREEN

DESCRIPTION: LOWER PLAN

DATE:	AUGUST 2018
GSP JOB No.	4291800
SHEET:	S-3
	12 OF 27



A PHOTO
NTS

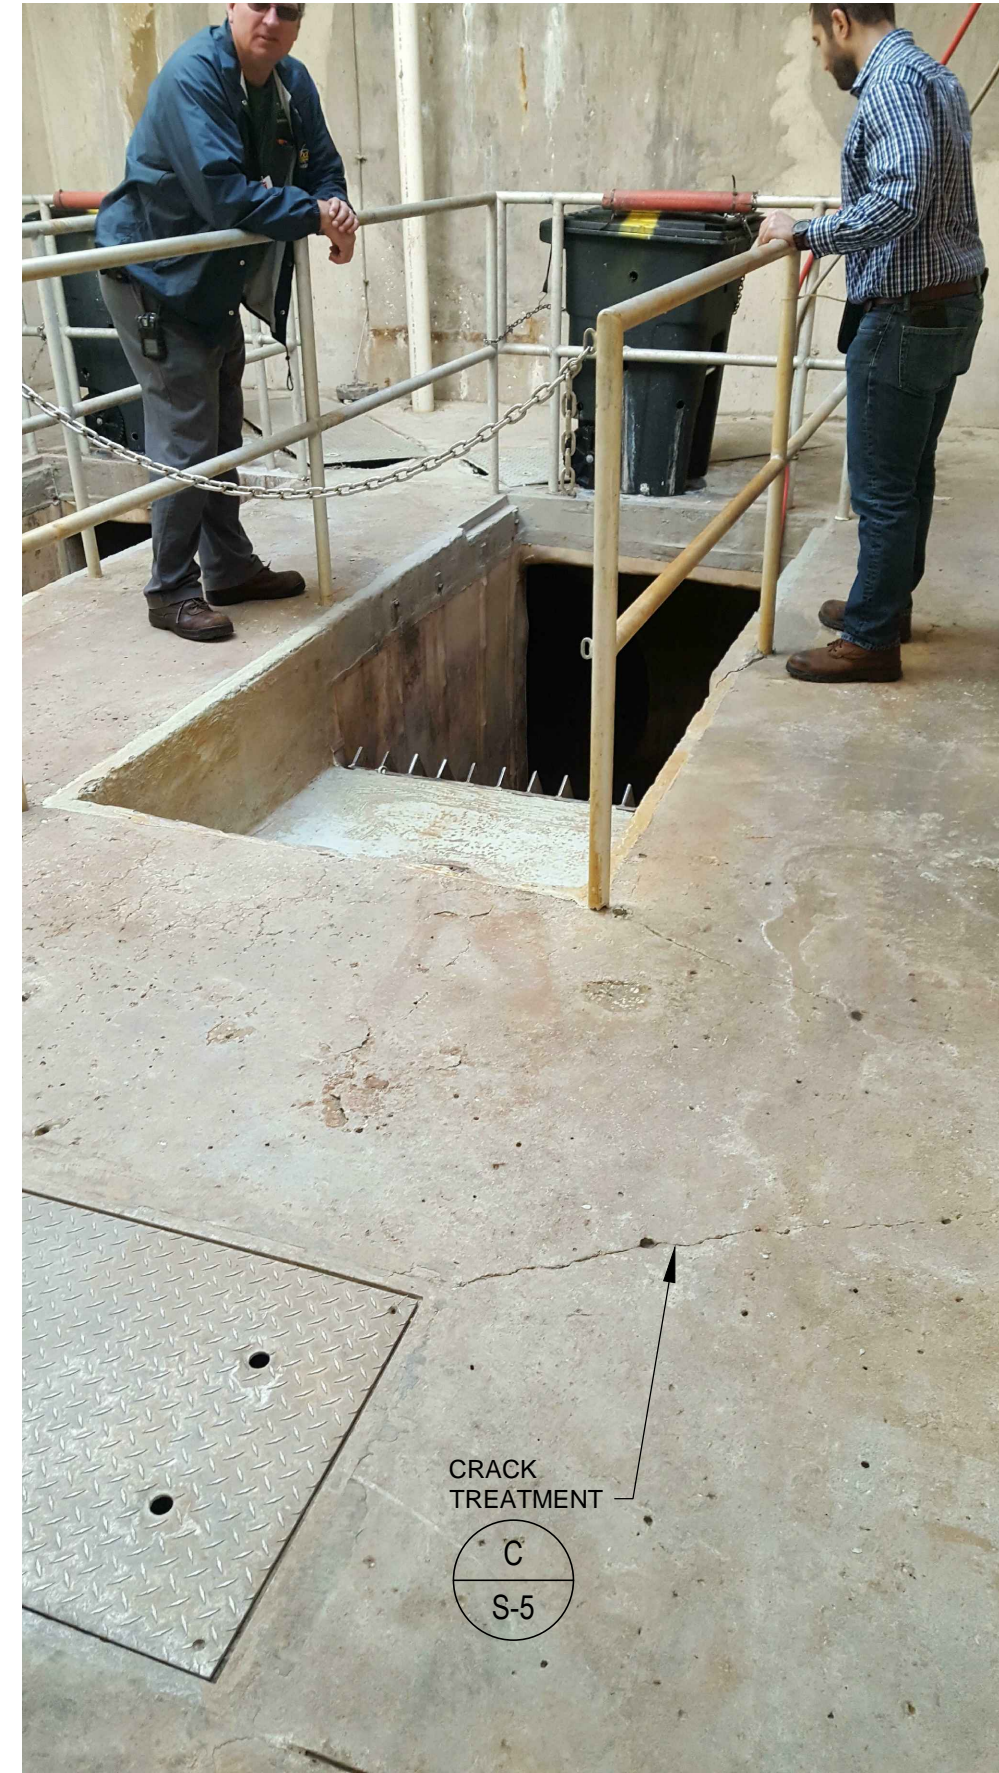

B PHOTO
NTS



C PHOTO
NTS



D PHOTO
NTS





E PHOTO
NTS

GENERAL NOTES:

1. THE PHOTOS PRESENTED ON THIS SHEET PROVIDE EXAMPLES AT CONCRETE REPAIR TYPES. AN ESTIMATED QUANTITY FOR THE VARIOUS TYPES OF REPAIRS IS PROVIDED IN THE BID FORM. THE ACTUAL NUMBER OF EACH CONCRETE REPAIR TYPE WILL BE DETERMINED AFTER CONTRACT EXECUTION.

P:\4291800\N\S-4.dwg, Aug 15, 2018 - 9:34am

DESIGNED	RJ TAZELAAR	 302 Knights Run Avenue, Suite 900 Tampa, FL 33602 813.254.5838 FIRM'S FLORIDA CERT. NO. AAP000034/CA3806 IB26000797/LC26000381	APPROVED BY:	 CITY OF TAMPA UNIVERSITY PUMPING STATION AUTOMATIC BAR SCREEN	DESCRIPTION:	CONCRETE REPAIR PHOTOS	DATE:	AUGUST 2018	
DRAWN	O GOMEZ						GSP JOB No.	4291800	
CHECKED	J. FUKUDA		JASON FUKUDA FLA. LIC. NO 66000		DATE		SHEET:	S-4	13 OF 27
REV. NO.	DATE		DESCRIPTION		REV. BY				

- USE REPAIR MATERIALS PER MANUFACTURERS INSTRUCTIONS
- PROVIDE TEMPORARY SHORING DURING BEAM REPAIR UNTIL BEAM REPAIR IS COMPLETE AND REPAIR MATERIAL IS CURED A MINIMUM OF SEVEN (7) DAYS. COORDINATE LOCATION AND DESIGN OF SHORING WITH OWNER'S OPERATIONAL REQUIREMENTS. SHORING DRAWINGS SHALL BE SIGNED AND SEALED BY ENGINEER LICENSED IN FLORIDA.
- PREVENT VEHICULAR TRAFFIC FROM LOADING BEAM UNTIL REPAIR MATERIAL HAS ATTAINED A MINIMUM STRENGTH OF 3000 PSI AND REPAIR MATERIAL IS CURED A MINIMUM OF SEVEN (7) DAYS.
- PROVIDE TESTING AGENCY TO PERFORM TESTING OF REPAIR MATERIAL ACCORDING TO ASTM C39
- ARRANGE TO HAVE A REPRESENTATIVE OF REPAIR MATERIAL MFR VERIFY INSTALLATION AND PREPARATION ACCORDING TO MANUFACTURERS POINTED INSTRUCTIONS.

A GENERAL NOTES

- EXPOSED SURFACES OF WORK ELEMENTS MUST BE THOROUGHLY CLEANED PRIOR TO APPLYING REPAIR.
- TAKE EXTREME CARE WHEN REMOVING EXISTING SPALLED CONCRETE SO AS NOT TO DAMAGE EXISTING REINFORCING STEEL. COMPLETELY CLEAN EXPOSED EXISTING REINFORCING STEEL TO REMOVE RUST. NOTIFY ENGINEER IF CORRODED REBAR HAS LOST CROSS-SECTIONAL AREA.
- PROVIDE EPOXY MODIFIED CEMENTITIOUS CORROSION INHIBITING BONDING AGENT EQUIVALENT TO SIKACRETE 211 SCC PLUS PER MANUFACTURER'S APPLICATION REQUIREMENTS.
- POWER DRIVEN HAND TOOLS USED FOR REMOVAL OF UNSOUND CONCRETE ARE SUBJECT TO THE FOLLOWING RESTRICTONS:
 - A. PNEUMATIC HAMMERS HEAVIER THAN 35 LB. CLASS SHALL NOT BE USED.
 - B. CHIPPING HAMMERS OF THE 15 LB. CLASS SHALL BE USED TO REMOVE CONCRETE FROM BEHIND REINFORCING STEEL.


B CONCRETE WALL REPAIR NOTES

- SOUND TEST AND MARK CONCRETE AREA TO BE REMOVED.
- REMOVE ALL UNSOUND DETERIOTED CONCRETE
- COAT REINFORCING WITH TWO COATS OF SIKAAARMATED 110 EPOCEM
- FORM/POUR REPAIR OPTION - SIKACRETE 211SCC PLUS FROM 1" - 8" PER LIFT.
- HAND APPLIED REPAIR OPTION - SIKAQUICK VOH - FROM 1/8" - 3" PER LIFT.

F CONCRETE BEAM REPAIR NOTES


- REMOVE UNATTACHED PVC LINER AND COAT WITH 125 MILS OF C.P.P. AND OVERLAP PVC LINER BY 3"
- MAY REQUIRED ADDITIONAL ANCHORS AT THE EDGE OF EXISTING PVC LINER.

G WET WELL REPAIRS

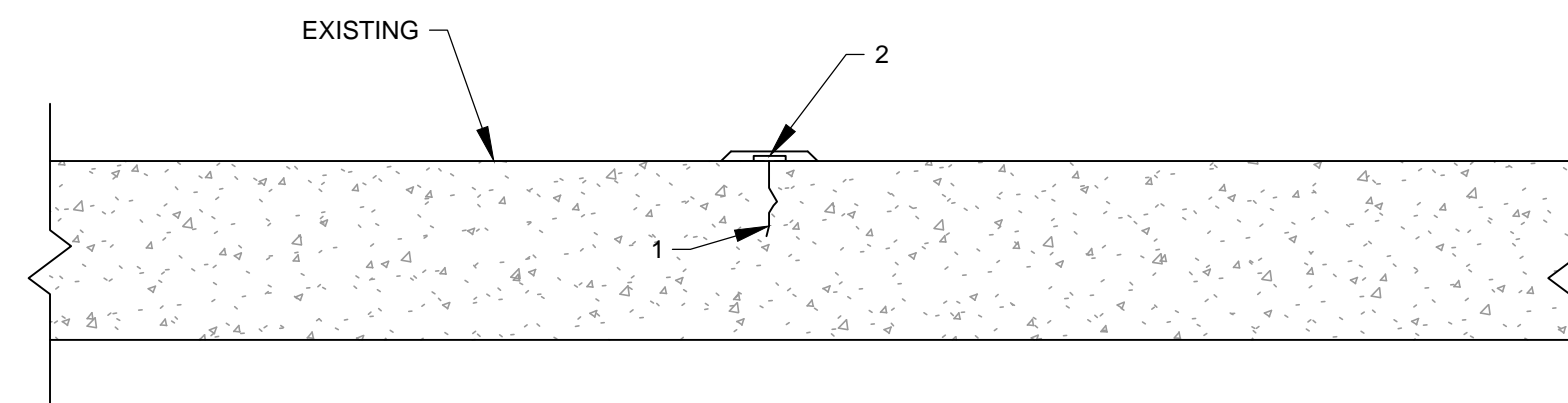


1. ROUT ALL CRACKS TO A MINIMUM OF 1/4" WIDE BY 1/4" DEEP.
2. APPLY A 6" WIDE LAYER OF SIKAFLEX 2c EURETHANE WITH A 4" NAP ROLLER. WHILE THE PRODUCT IS STILL WET, INSTALL A LAYER OF SIKAFLEX TAPE AND APPLY A SECOND LAYER OF SIKAFLEX 2c EURETHANE.

C CRACK TREATMENT
NTS

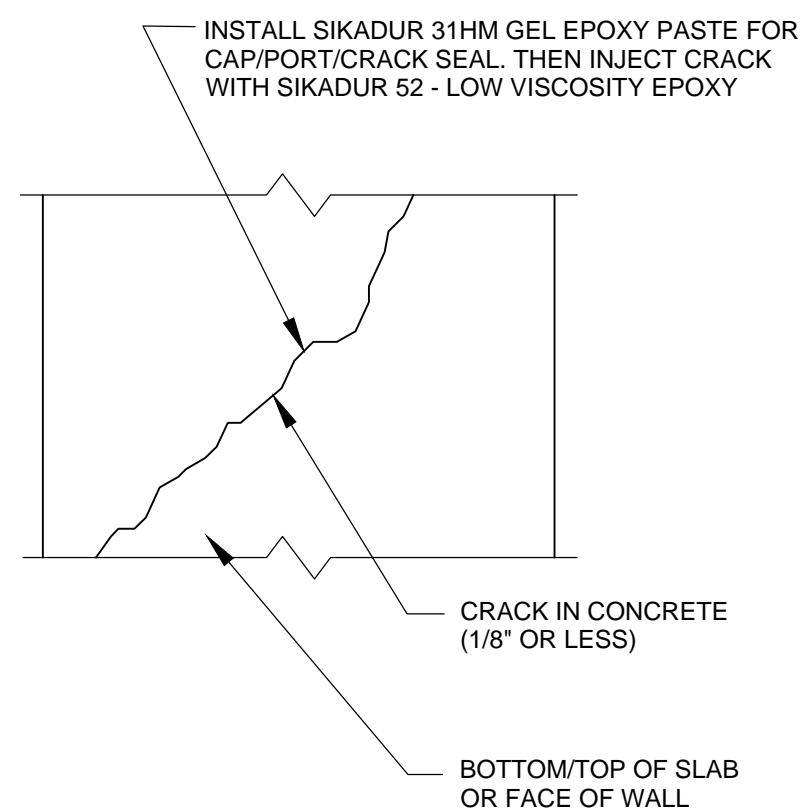


D HAIRLINE CRACK REPAIR
NTS

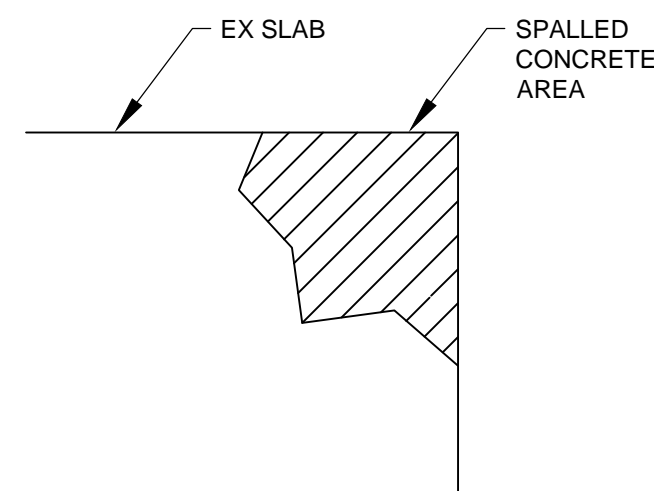

NOTES:

1. THIS SURFACE MUST BE MECHANICALLY PREPARED. AREA TO BE REPAIRED MUST BE CLEAN, SOUND AND FREE OF CONTAMINANTS. ALL LOOSE AND DETERIORATED CONCRETE MUST BE REMOVED.
2. CLEAN ALL EXPOSED REBAR AND COAT WITH SIKAAARMATED 110.
3. RECAST TO ORIGINAL SURFACE PROFILE USING SIKAQUICK VOH.
4. FINISH WITH MEDIUM BROOM FINISH.


E CONCRETE REPAIR
NTS

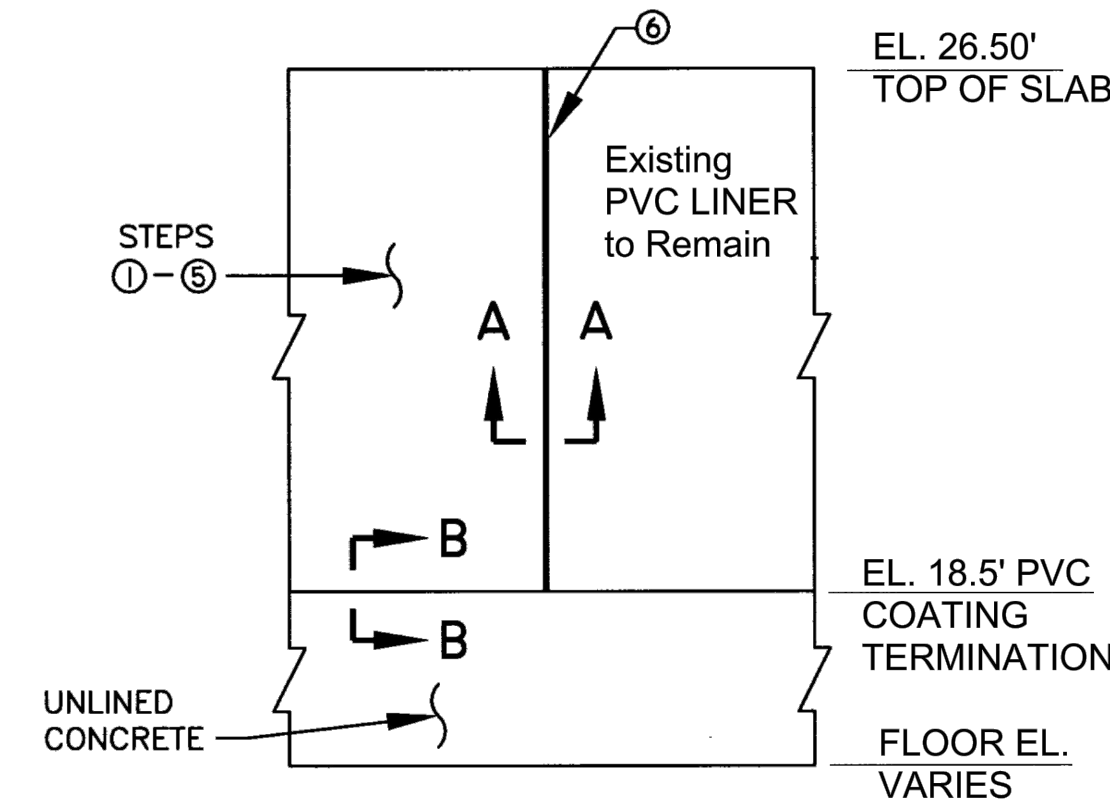

SECTION VIEW
PROP. COATING/EX. PVC LINER TRANSITION DETAIL
N.T.S.


- ① REMOVE FAILING PVC LINER UNTIL SOUND LINER IS OBSERVED.
- ② HYDROBLAST* UNLINED DETERIORATED CONCRETE TO STRUCTURALLY SOUND CONCRETE
- ③ EXPOSED REINFORCING STEEL SHALL BE CLEANED, PREPARED AND COATED WITH CORROSION INHIBITOR.
- ④ FILL VOIDS OF DETERIORATED CONCRETE SECTIONS WITH REPAIR MATERIAL IN ACCORDANCE WITH THE SPECIFICATIONS AND MANUFACTURER'S INSTRUCTIONS.
- ⑤ SAW CUT COATING TERMINATION AND COAT 125 MILS MDFT COATING, SEE SPECIFICATIONS.
- ⑥ MECHANICALLY ANCHOR 2" WIDE SS316 (3/8" THK.) STRIP AT EX. LINER/NEW COATING INTERFACE. FASTEN WITH 3/8" SS316 HILTI WEDGE ANCHORS AT 2' O.C.

*CONTRACTOR MAY UTILIZE SAND BLASTING IN LIEU OF HYDROBLASTING, WITH 100% CONTAINMENT OF SAND, DEBRIS, AND AEROSOL DRIFT.

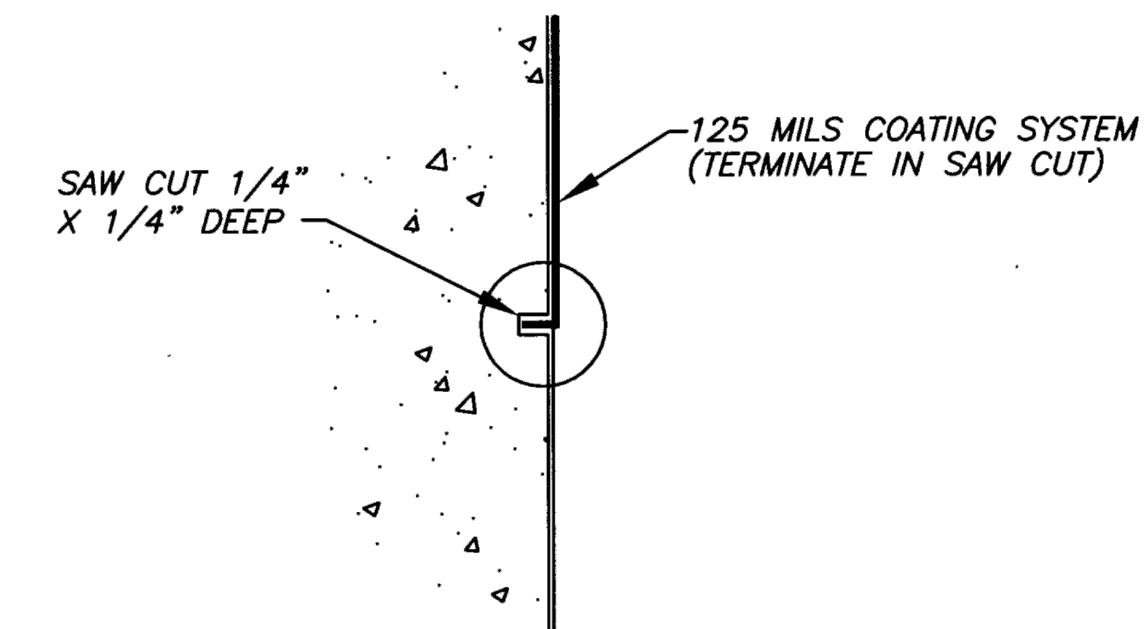

SECTION B-B
N.T.S.

NOTE: COATING TERMINATION AS SHOWN, WILL BE INCLUDED IN THE COST OF THE COATING SYSTEM PER SQUARE FOOT(SF)

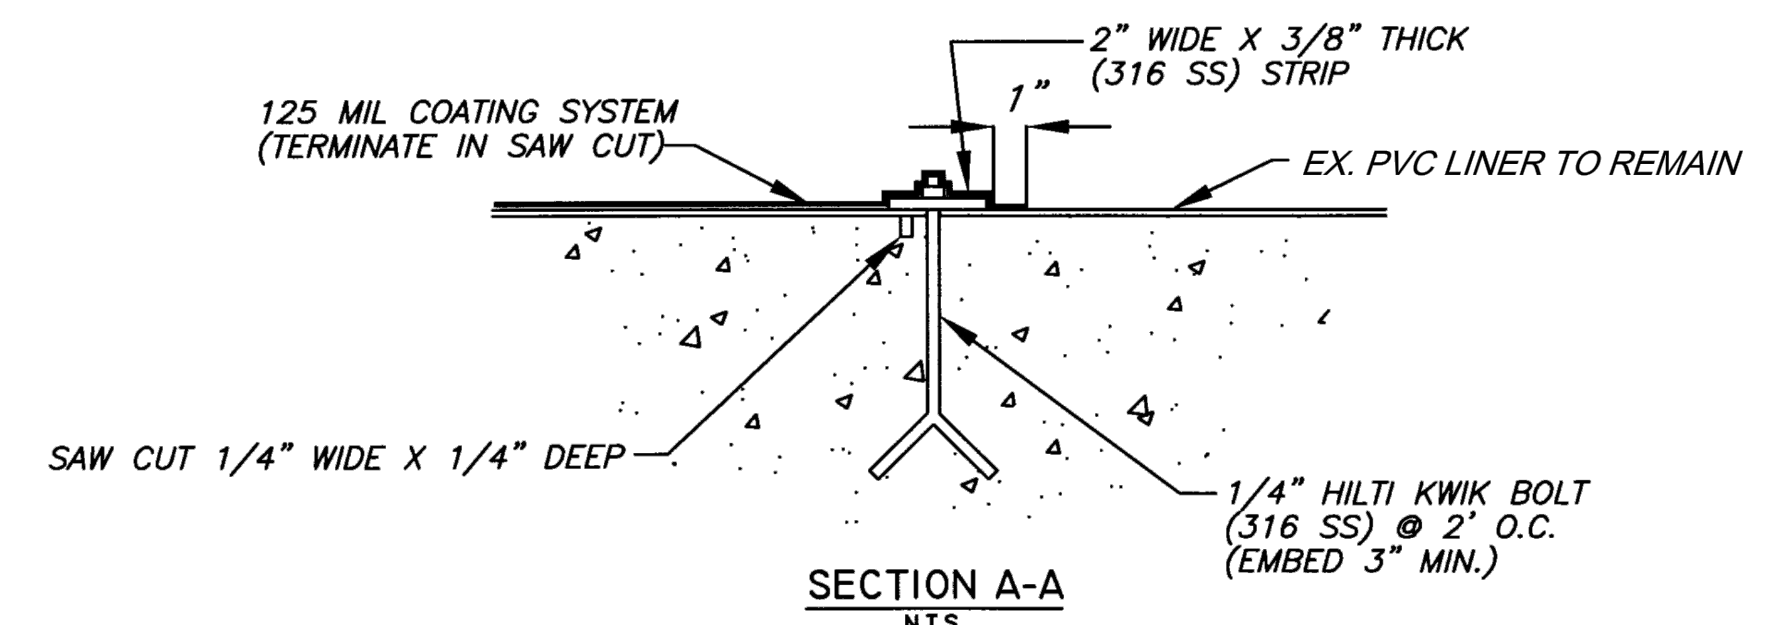


SECTION A-A
N.T.S.

NOTE: COATING /PVC LINER TRANSITION AS SHOW, WILL BE PAID PER SQUARE FOOT(SF) OF TRANSITION STRIP INSTALLED.


LINER TRANSITION DETAIL
NTS

P:\4291800\N\S-5.dwg, Aug 15, 2018 - 9:34am


DESIGNED	RJ TAZELAAR	 302 Knights Run Avenue, Suite 900 Tampa, FL 33602 813.254.5838 FIRM'S FLORIDA CERT. NO. AAP000034/CA3806 IB26000797/LC26000381	APPROVED BY:	 DATE	PROJECT:	CITY OF TAMPA UNIVERSITY PUMPING STATION AUTOMATIC BAR SCREEN	DESCRIPTION:	REPAIR DETAILS	DATE:	AUGUST 2018	
DRAWN	O GOMEZ		CHECKED		JASON FUKUDA FLA. LIC. NO 66000		GSP JOB No.	4291800	SHEET:	S-5	14 OF 27
CHECKED	J FUKUDA										
REV. NO.	DATE		DESCRIPTION		REV. BY						

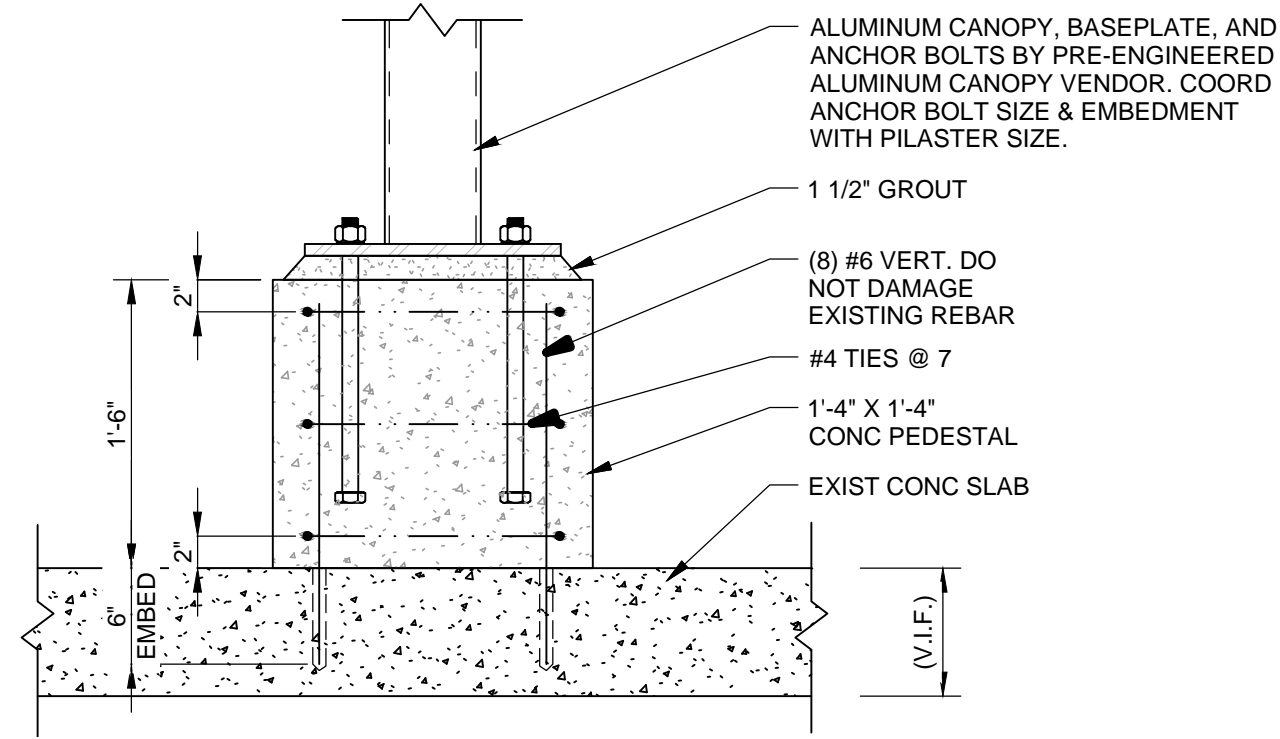


A PILASTER - POST INSTALLED
NTS

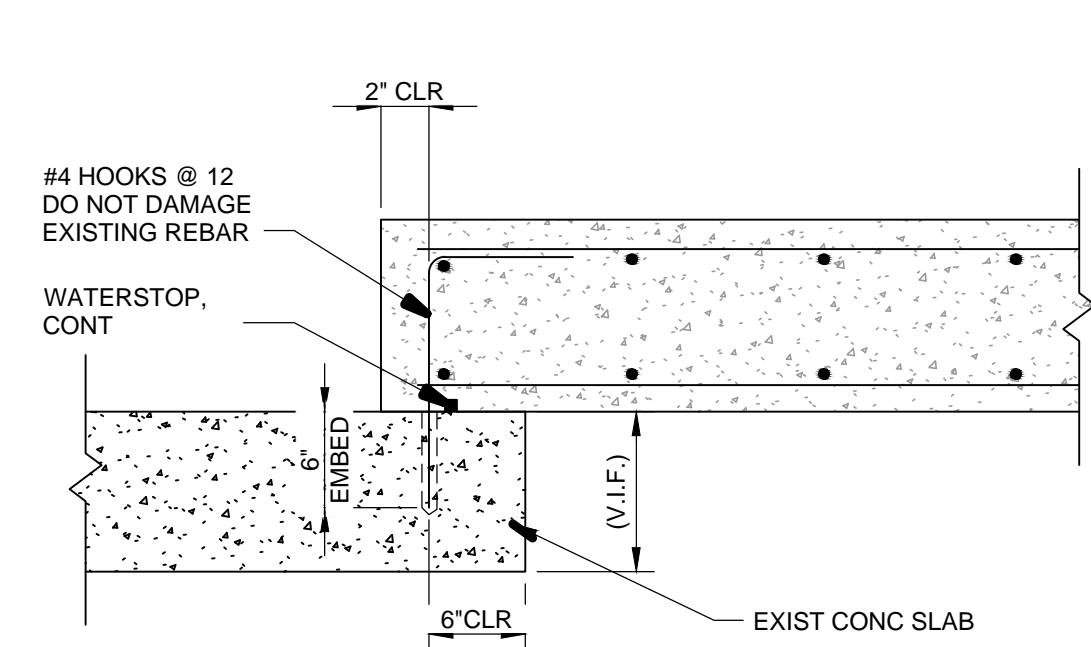


B NEW SLAB AT EXISTING
NTS

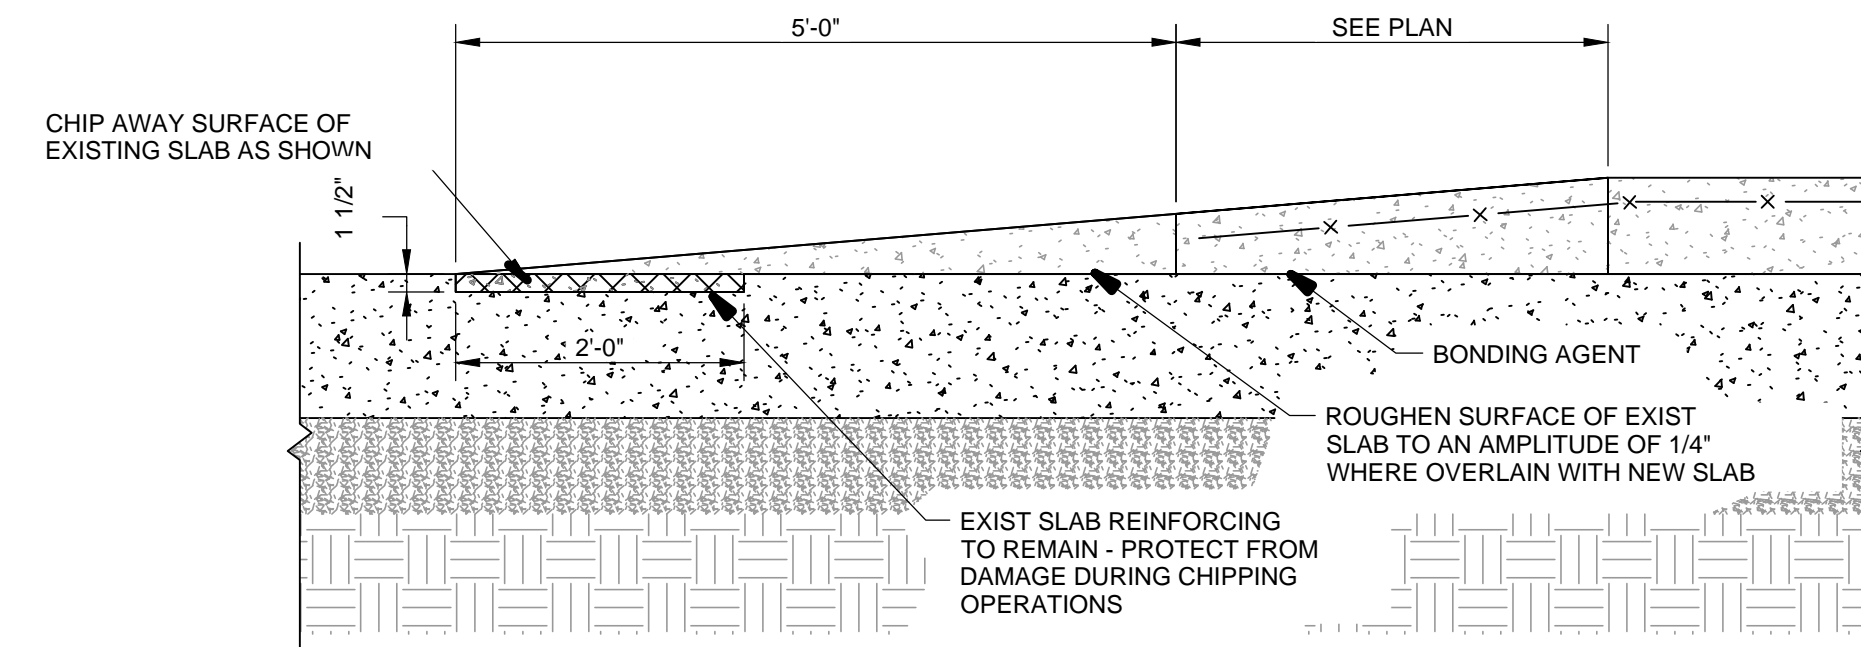


C BOTTOM OF RAMP
NTS

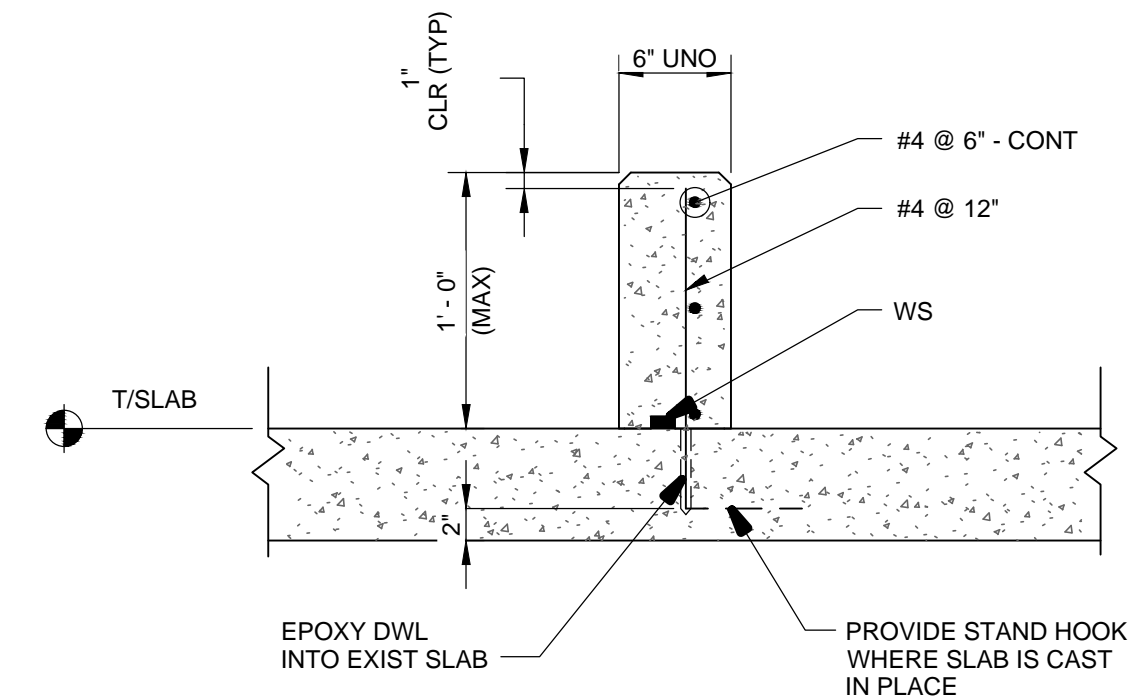


D TYPICAL CURB REINFORCEMENT
NTS

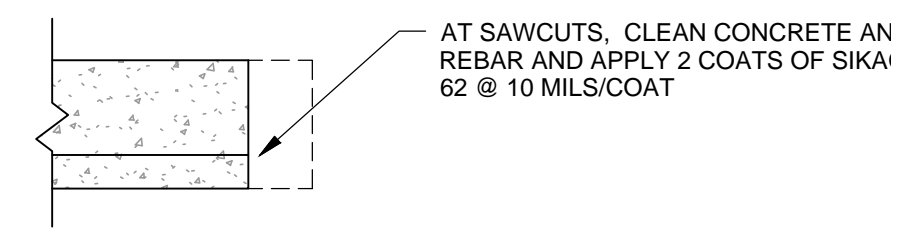

E EDGE OF SLAB REPAIR
NTS




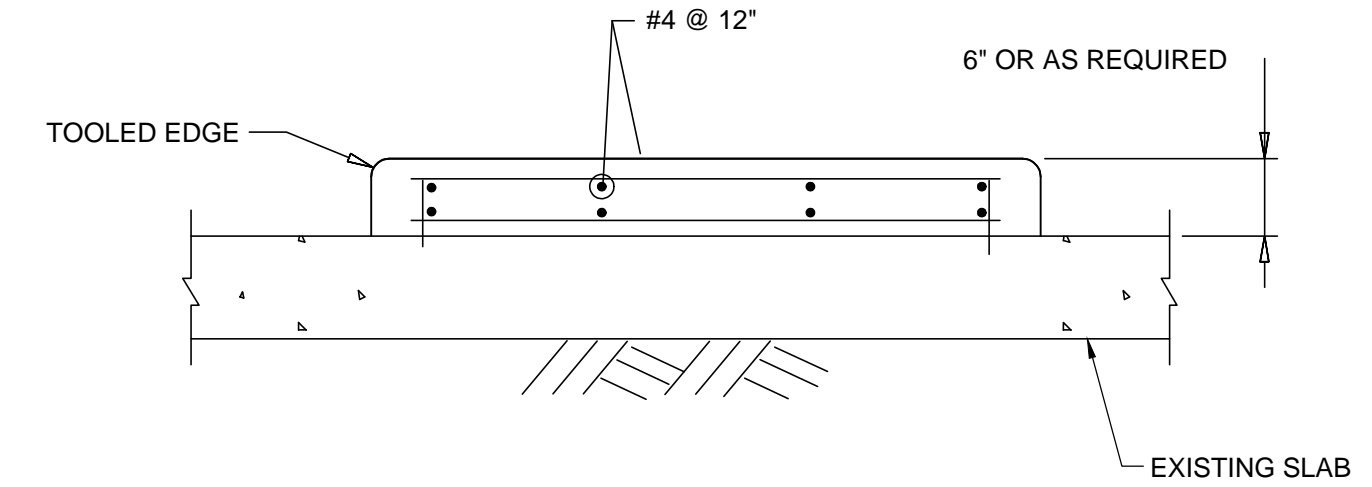


F HOUSEKEEPING PAD
NTS

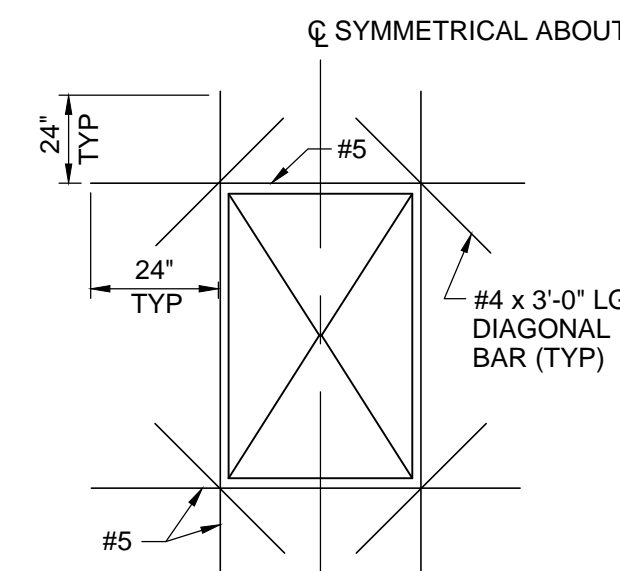

G ADDITIONAL REINFORCEMENT
AROUND RECTANGULAR OPENING
NTS

- NOTES:
1. CUT NORMAL REINFORCING AT OPENING.
 2. FOR SLAB WITH TWO LAYERS OF REINFORCING PROVIDE 1 BAR EACH FACE.
 3. BAR LENGTHS FOR GRADE 60.

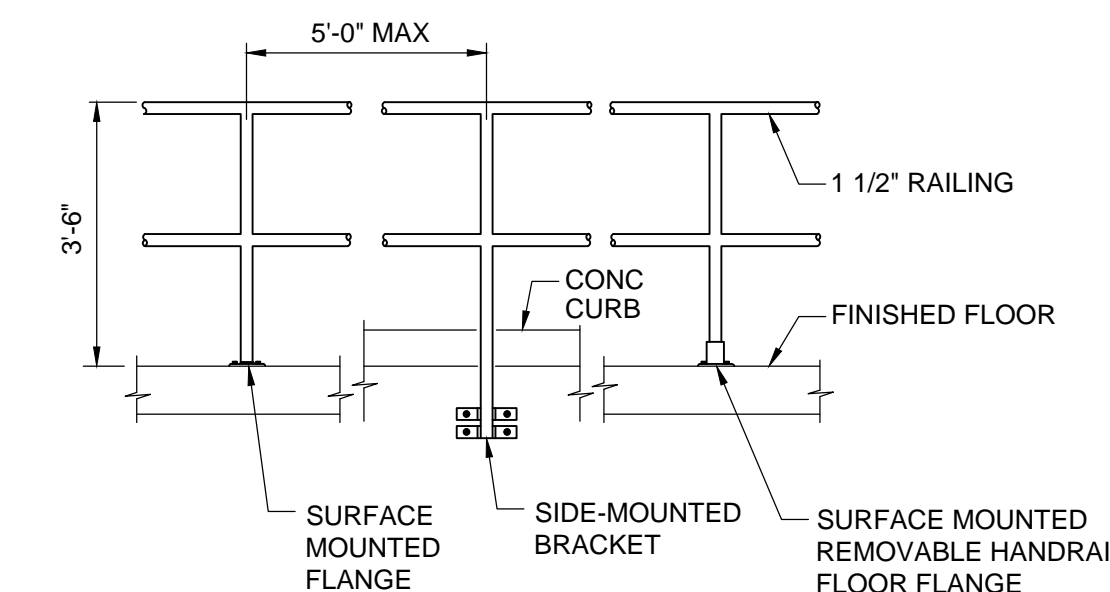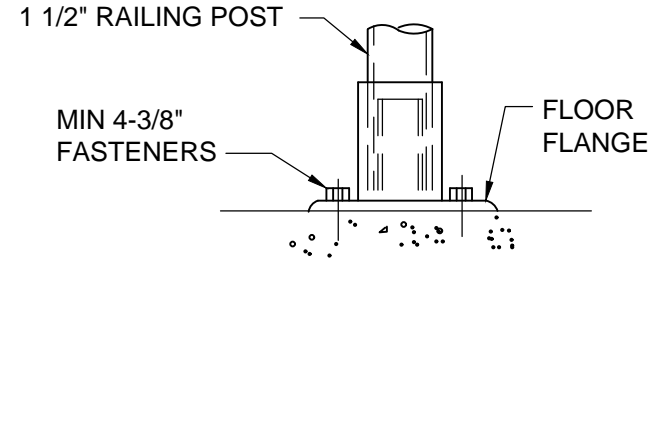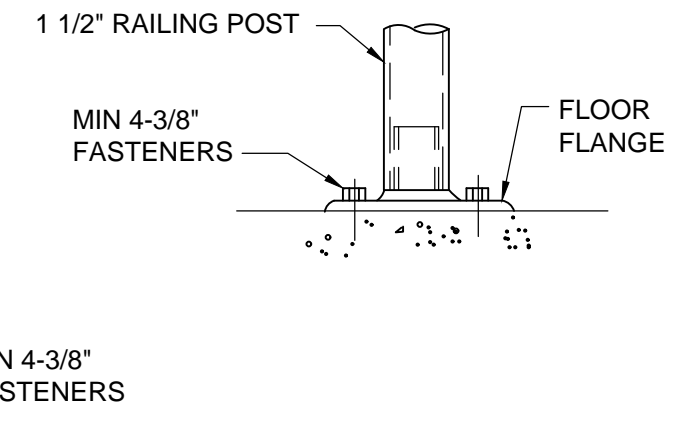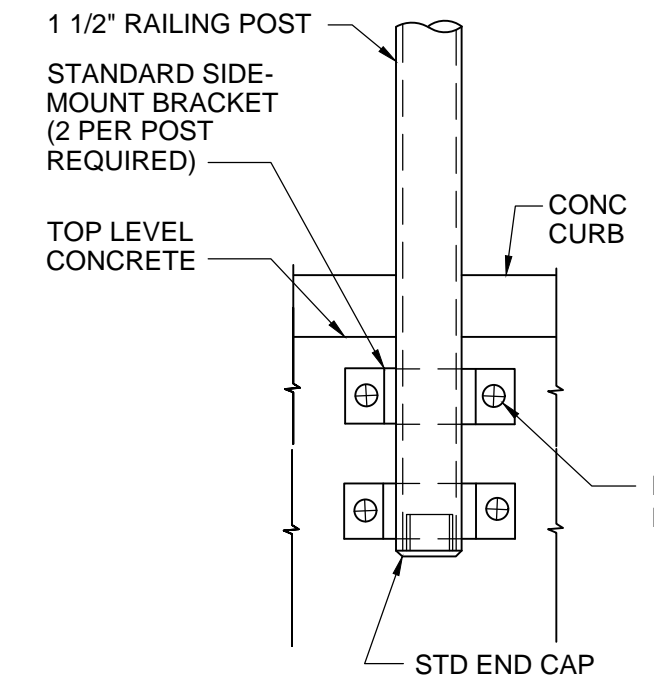

H HANDRAIL DETAIL
NTS

- NOTES:
1. HANDRAIL SHALL BE ALUMINUM WITH MECHANICAL JOINTS UNLESS INDICATED OTHERWISE.
 2. POSTS AND RAILING SHALL BE 1 1/2\"/>

P:\4291800\W\S-G.dwg, Aug 15, 2018 - 9:35am

DESIGNED	RJ TAZELAAR		302 Knights Run Avenue, Suite 900 Tampa, FL 33602 813.254.5838 FIRM'S FLORIDA CERT. NO. AAP000034/CA3806 IB26000797/LC26000381	APPROVED BY:		PROJECT:	CITY OF TAMPA UNIVERSITY PUMPING STATION AUTOMATIC BAR SCREEN	DESCRIPTION:	STRUCTURAL DETAILS	DATE:	AUGUST 2018
DRAWN	O GOMEZ			JASON FUKUDA		DATE	GSP JOB No.	4291800			
CHECKED	J. FUKUDA			FLA. LIC. NO.		66000	SHEET:	S-6			
REV. NO.	DATE			DESCRIPTION		REV. BY		15 OF 27			

C:\TDP\Projects\2017\26-50\231703284 Gresham Uni Screen\GS Bid Border 8-15-18\E-1.dwg, Aug 15, 2018 - 10:24am

- CONDUIT RUN EXPOSED
- - - - - CONDUIT RUN CONCEALED UNDERGROUND
- - - - - CONDUIT RUN CONCEALED IN FLOOR OR SLAB

— g — g — GROUNDING ELECTRODE CONDUCTOR


[— CONDUIT STUB OUT AND CAP

⊙ GROUND ROD

○ JUNCTION BOX


○ JUNCTION BOX WITH FLEXIBLE CONNECTION

480V
15 KVA, 1*
120/240V

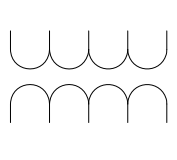

TRANSFORMER, 480V INDICATED PRIMARY VOLTAGE, 120/240V INDICATES SECONDARY VOLTAGE, 15 KVA REPRESENTS POWER RATING, AND 1* INDICATES SINGLE PHASE (THREE PHASE IF NOT INDICATED)


3P
30A



THERMAL MAGNETIC CIRCUIT BREAKER WITH NUMBER OF POLES AND AMPERE RATING

COMBINATION MAGNETIC STARTER WITH CONTROL POWER TRANSFORMER (SIZED FOR LOAD). LETTERS INDICATE TYPE :

N - NON-REVERSING
R - REVERSING
2S - TWO-SPEED
C - CONTACTOR
SS - SOLID STATE SOFT START

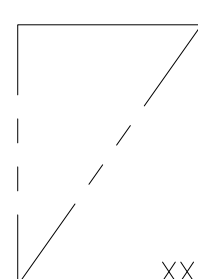

XXX	XXX DEVICE	DESCRIPTION
HLS	HLS	HIGH LEVEL SWITCH
HOA	HOA	HAND-OFF-AUTO
LD	LD	LEAK DETECTION
LLS	LLS	LOW LEVEL SWITCH
LOR	LOR	LOCAL-OFF-REMOTE
PB	PB	PUSH BUTTON
RTU	RTU	REMOTE TERMINAL UNIT
SS	SS	SOFT STARTER
SS/B	SS/B	SOFT START OR BYPASS
TS	TS	TEMPERATURE SWITCH
TVSS	TVSS	TRANSIENT VOLTAGE SURGE SUPPRESSOR
ZS	ZS	POSITION SENSOR (LIMIT SWITCH)

⊃ FUSE

⊙ XX MOTOR

⊃ THERMAL OVERLOAD

⊃ UTILITY METER

⊃ TRANSFER SWITCH

⊃ ELECTRIC PANELBOARD

⊃ DISCONNECT OR SAFETY SWITCH

⊃ FLOAT SWITCH. OPENS ON LOW LEVEL.

⊃ FLOAT SWITCH. CLOSES ON LOW LEVEL.

⊃ NORMALLY OPEN (N.O.) CONTACT

⊃ NORMALLY CLOSED (N.C.) CONTACT

⊃ GROUND CONNECTION

⊃ INDICATING PILOT LIGHT LETTER INDICATES COLOR OF LENS

⊃ DISCONNECT OR TOGGLE SWITCH

⊃ NORMALLY OPEN MOMENTARY CIRCUIT CLOSING PUSH-BUTTON SWITCH, SPRING OPEN. NUMBER OF ELECTRICAL CONTACTS ON SWITCH SHOWN ON CONTROL SCHEMATIC

⊃ NORMALLY CLOSED MOMENTARY CIRCUIT OPENING PUSH-BUTTON SWITCH, SPRING CLOSE. NUMBER OF ELECTRICAL CONTACTS ON SWITCH SHOWN ON CONTROL SCHEMATIC


⊃ LIMIT SWITCH NORMALLY CLOSED CONTACT. CONTACT OPENS WHEN ACTUATED

⊃ TORQUE SWITCH NORMALLY CLOSED CONTACT. CONTACT OPENS WHEN ACTUATED

⊃ PUMP THERMAL SENSOR

⊃ MECHANICAL HEAT DETECTOR

EXAMPLE OF SECTION CUT AND DETAIL

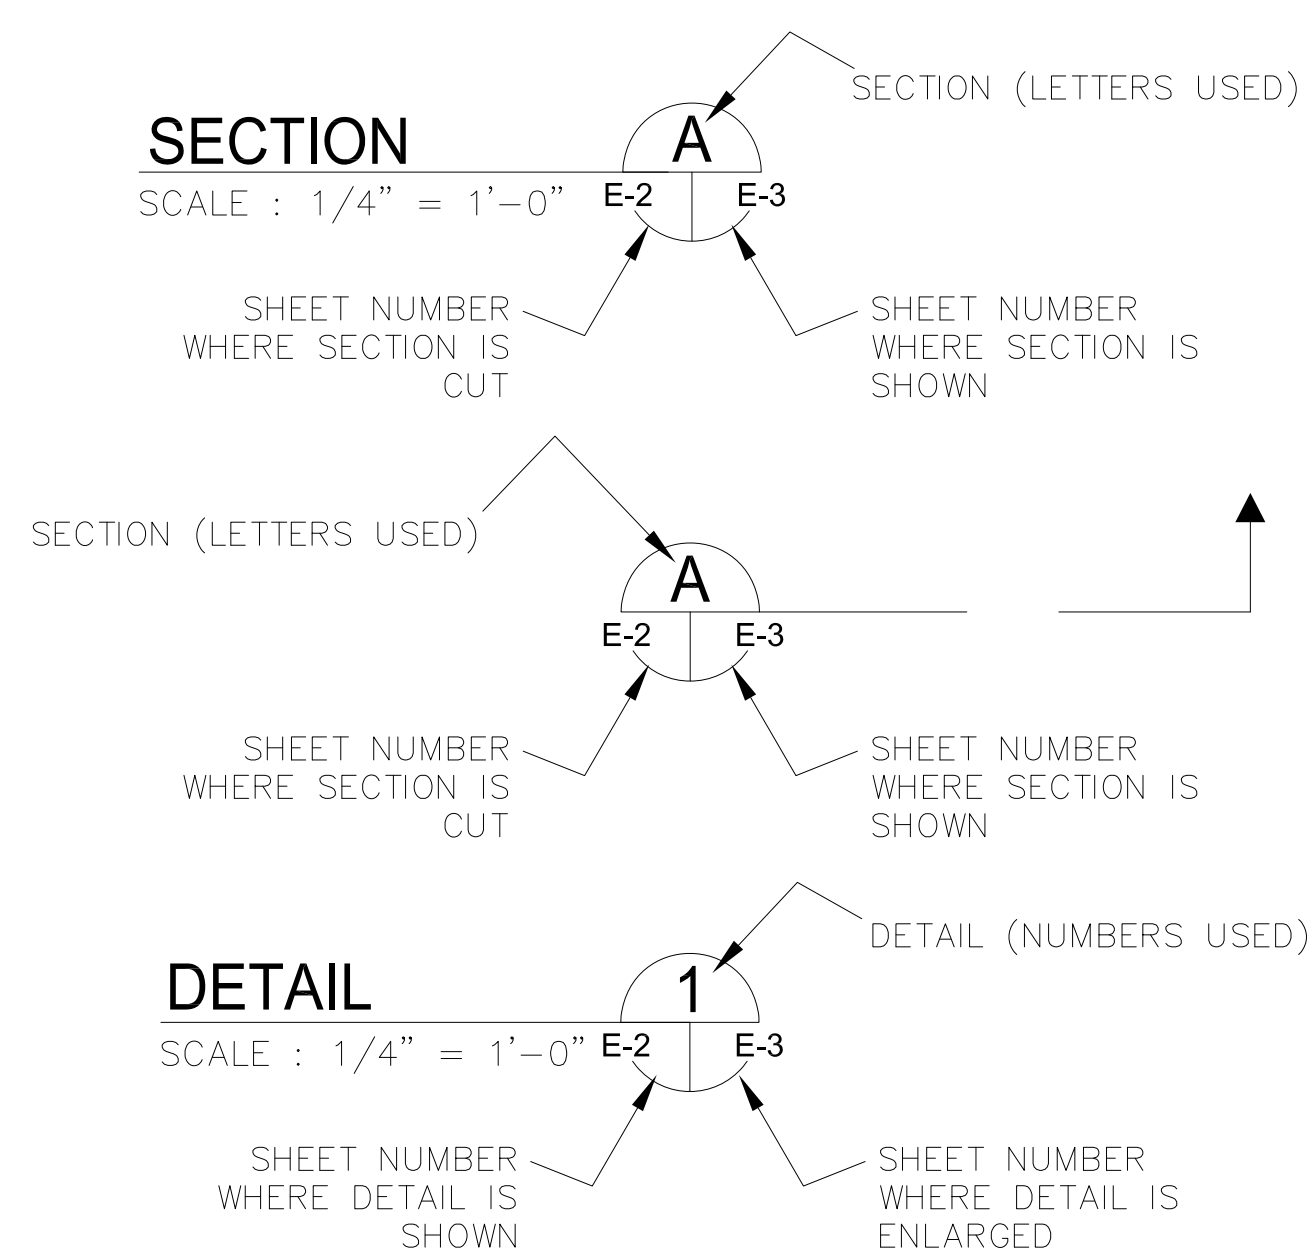

GENERAL NOTES

THE WORK CONSIST OF FURNISHING ALL LABOR, MATERIALS, EQUIPMENT, AND TECHNICAL SUPERVISION TO INSTALL THE ELECTRICAL COMPONENTS AS INDICATED AND SHOWN. THE WORK INCLUDES, BUT IS NOT LIMITED TO, THE FOLLOWING:



- CONTRACTOR SHALL SUBMIT SHOP DRAWINGS FOR APPROVAL PRIOR TO PURCHASING EQUIPMENT OR COMMENCING CONSTRUCTION.
- ALL WIRING SHALL BE IDENTIFIED WITH NUMBERS AT ALL TERMINALS AND ON WIRING DIAGRAMS.
- FIELD VERIFY ALL EQUIPMENT LOCATIONS AND CONNECTIONS PRIOR TO COMMENCING CONSTRUCTION.
- ALL NEW EQUIPMENT SHALL BE PERMANENTLY IDENTIFIED WITH A BLACK ON WHITE LAMACOID TAG ENGRAVED WITH MINIMUM 3/16 INCH LETTERING.
- ALL CONDUCTOR LENGTHS SHALL BE CONTINUOUS. NO SPLICES OR CONDUCTOR TERMINATIONS SHALL BE PERMITTED UNLESS SPECIFICALLY DESIGNATED IN THE DRAWINGS.
- ALL EXISTING INSTALLATIONS DENOTED ON THE DRAWINGS ARE FOR THE CONTRACTORS REFERENCE ONLY.
- INSTALL CIRCUIT BREAKERS, CONDUIT, CONDUCTORS, MANUAL SWITCH, I/O MODULES, SURGE PROTECTION DEVICES AS INDICATED TO ACCOMMODATE THE NEW BAR SCREEN CONTROL PANEL AND NEW SLIDE GATE ACTUATOR AS SHOWN AND SPECIFIED.
- ALL ELECTRICAL WORK SHALL BE PERFORMED IN ACCORDANCE WITH THE FLORIDA BUILDING CODE (FBC) 6TH EDITION 2017, THE NATIONAL ELECTRICAL CODE (NEC) 2014 AND CHAPTER 5 OF THE CITY OF TAMPA CODE.
- TEST AND START-UP REPORTS FOR THE BAR SCREEN AND SLIDE GATE ACTUATOR SHALL BE INCLUDED IN THE OPERATION AND MAINTENANCE (O&M) MANUALS PROVIDED UNDER THIS CONTRACT. ALL CIRCUIT BREAKER SETTINGS SHALL BE TABULATED AND INCLUDED IN THE O&M MANUAL.

ABBREVIATIONS:

A	AMPS
AFF	ABOVE FINISHED FLOOR
AFG	ABOVE FINISHED GRADE
ATL	ACROSS-THE-LINE
C	CONDUIT
CU	COPPER
EX	EXISTING
ELEC	ELECTRICAL
EXP	EXPLOSION PROOF
FU	FUSE
GFI	GROUND FAULT INTERRUPTER
GND	GROUNDING CONDUCTOR
HP	HORSEPOWER
HZ	HERTZ
IG	ISOLATED GROUND
KVA	KILOVOLT AMPERES
KW	KILOWATTS
MAX	MAXIMUM
MIN	MINIMUM
N/A	NOT APPLICABLE
PH	PHASE
RECP	RECEPTACLE
RPM	REVOLUTIONS PER MINUTE
RTU	REMOTE TERMINAL UNIT
SPD	SURGE PROTECTION DEVICE
TYP	TYPICAL
V	VOLTS
WP	WEATHERPROOF



777 S. Harbour Island Blvd,
Suite 350
Tampa, FL 33602
813.227.9190
Certificate of Authorization No. 8363

DESIGNED	TDT	 <p>302 Knights Run Avenue, Suite 900 Tampa, FL 33602 813.254.5838</p> <p>FIRM'S FLORIDA CERT. NO. AAP000034/CA3806 IB26000797/LC26000381</p>	APPROVED BY:	 <p>TIMOTHY THOMAS FLA. LIC. NO. 47079</p>	PROJECT:	CITY OF TAMPA UNIVERSITY PUMPING STATION AUTOMATIC BAR SCREEN	DESCRIPTION:	LEGEND, ABBREVIATIONS AND NOTES	DATE:	AUGUST 2018
DRAWN	JLH		CHECKED		TDT	GSP JOB No.	4291800			
REV. NO.	DATE		DESCRIPTION		REV. BY	SHEET:	E-1 16 OF 27			




KEYED NOTES:

- ① EXISTING PUMP STATION BUILDING, ELEVATION 41.25'. REFER TO SHEET E-5 FOR WORK REQUIRED.
- ② EXISTING BIOXIDE TANK TO BE RELOCATED. REFER TO SHEET E-3 FOR PROPOSED LOCATION.
- ③ EXISTING CONDUIT AND CONDUCTORS TO BIOXIDE TANK. THE EXISTING CONDUIT CONTAINS VARIOUS CONDUCTORS WHICH SERVE OTHER EQUIPMENT. THE CONTRACTOR SHALL INTERCEPT THIS CONDUIT AT THE MOST CONVENIENT LOCATION AND EXTEND THE BIOXIDE TANK CONDUCTORS TO THE PROPOSED TANK LOCATION. SPLICING OF CONDUCTORS WILL NOT BE PERMITTED. CONTRACTOR SHALL PROVIDE NEW CONDUCTORS (MATCHING THE EXISTING BIOXIDE TANK CONDUCTORS) FROM POINT OF ORIGIN TO NEW BIOXIDE TANK LOCATION.
- ④ REFER TO SHEET E-3 FOR NEW BAR SCREEN LOCATION, SLIDE GATE MOTOR OPERATOR LOCATION, NEW BIOXIDE TANK LOCATION, ETC.


GENERAL NOTES:

- 1. REFER TO MECHANICAL SHEETS FOR EXACT EQUIPMENT LOCATIONS AND DEMOLITION REQUIREMENTS.

PROPERTY LINE

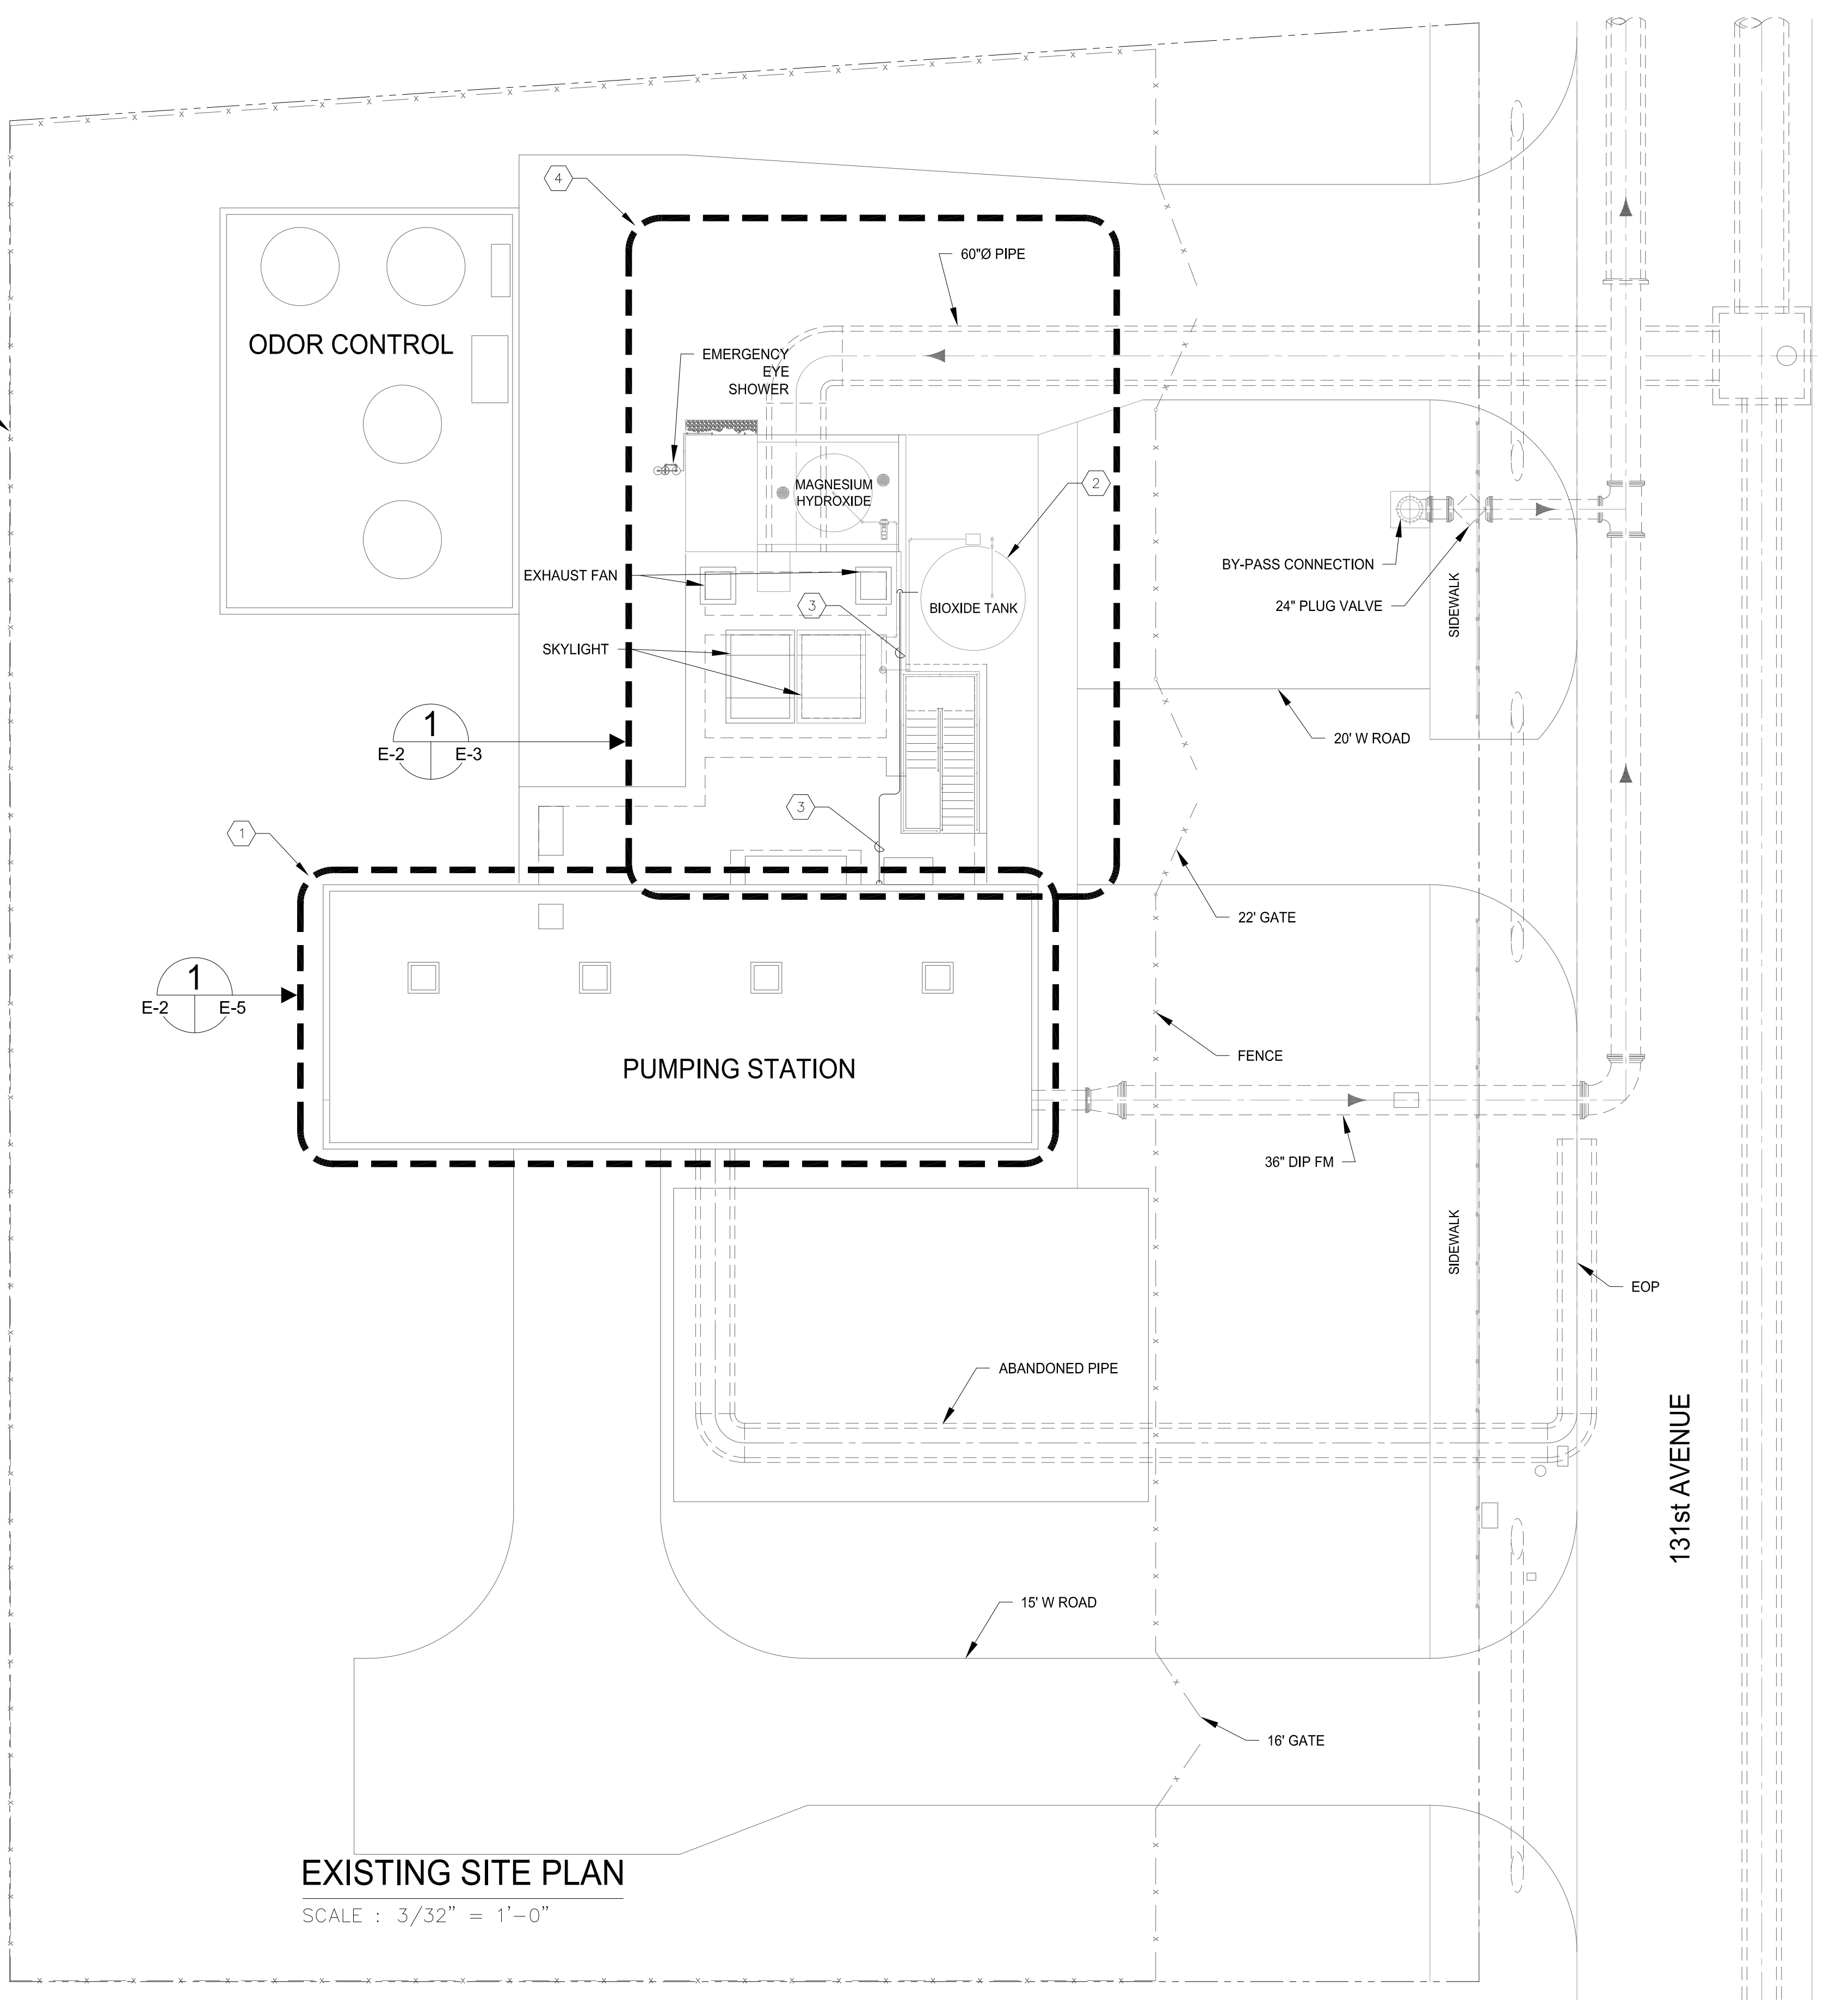

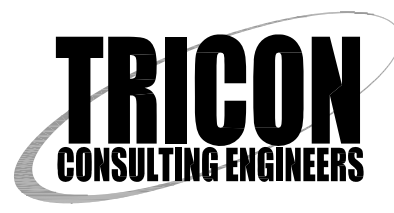


EXISTING SITE PLAN
SCALE : 3/32" = 1'-0"



777 S. Harbour Island Blvd,
Suite 350
Tampa, FL 33602
813.227.9190
Certificate of Authorization No. 6363

C:\TDP\Projects\2017\26-50\231703284 Gresham Uni Screen\GS Bid Border 8-15-18\E-2.dwg, Aug 15, 2018 - 10:33am

DESIGNED	TDT		302 Knights Run Avenue, Suite 900 Tampa, FL 33602 813.254.5838 FIRM'S FLORIDA CERT. NO. AAP000034/CA3806 1B26000797/LC26000381	APPROVED BY:		PROJECT:	CITY OF TAMPA UNIVERSITY PUMPING STATION AUTOMATIC BAR SCREEN	DESCRIPTION:	EXISTING SITE PLAN	DATE:	AUGUST 2018	
DRAWN	JLH			TIMOTHY THOMAS		DATE		FLA. LIC. NO.		47079	GSP JOB No.	4291800
CHECKED	TDT										SHEET:	E-2

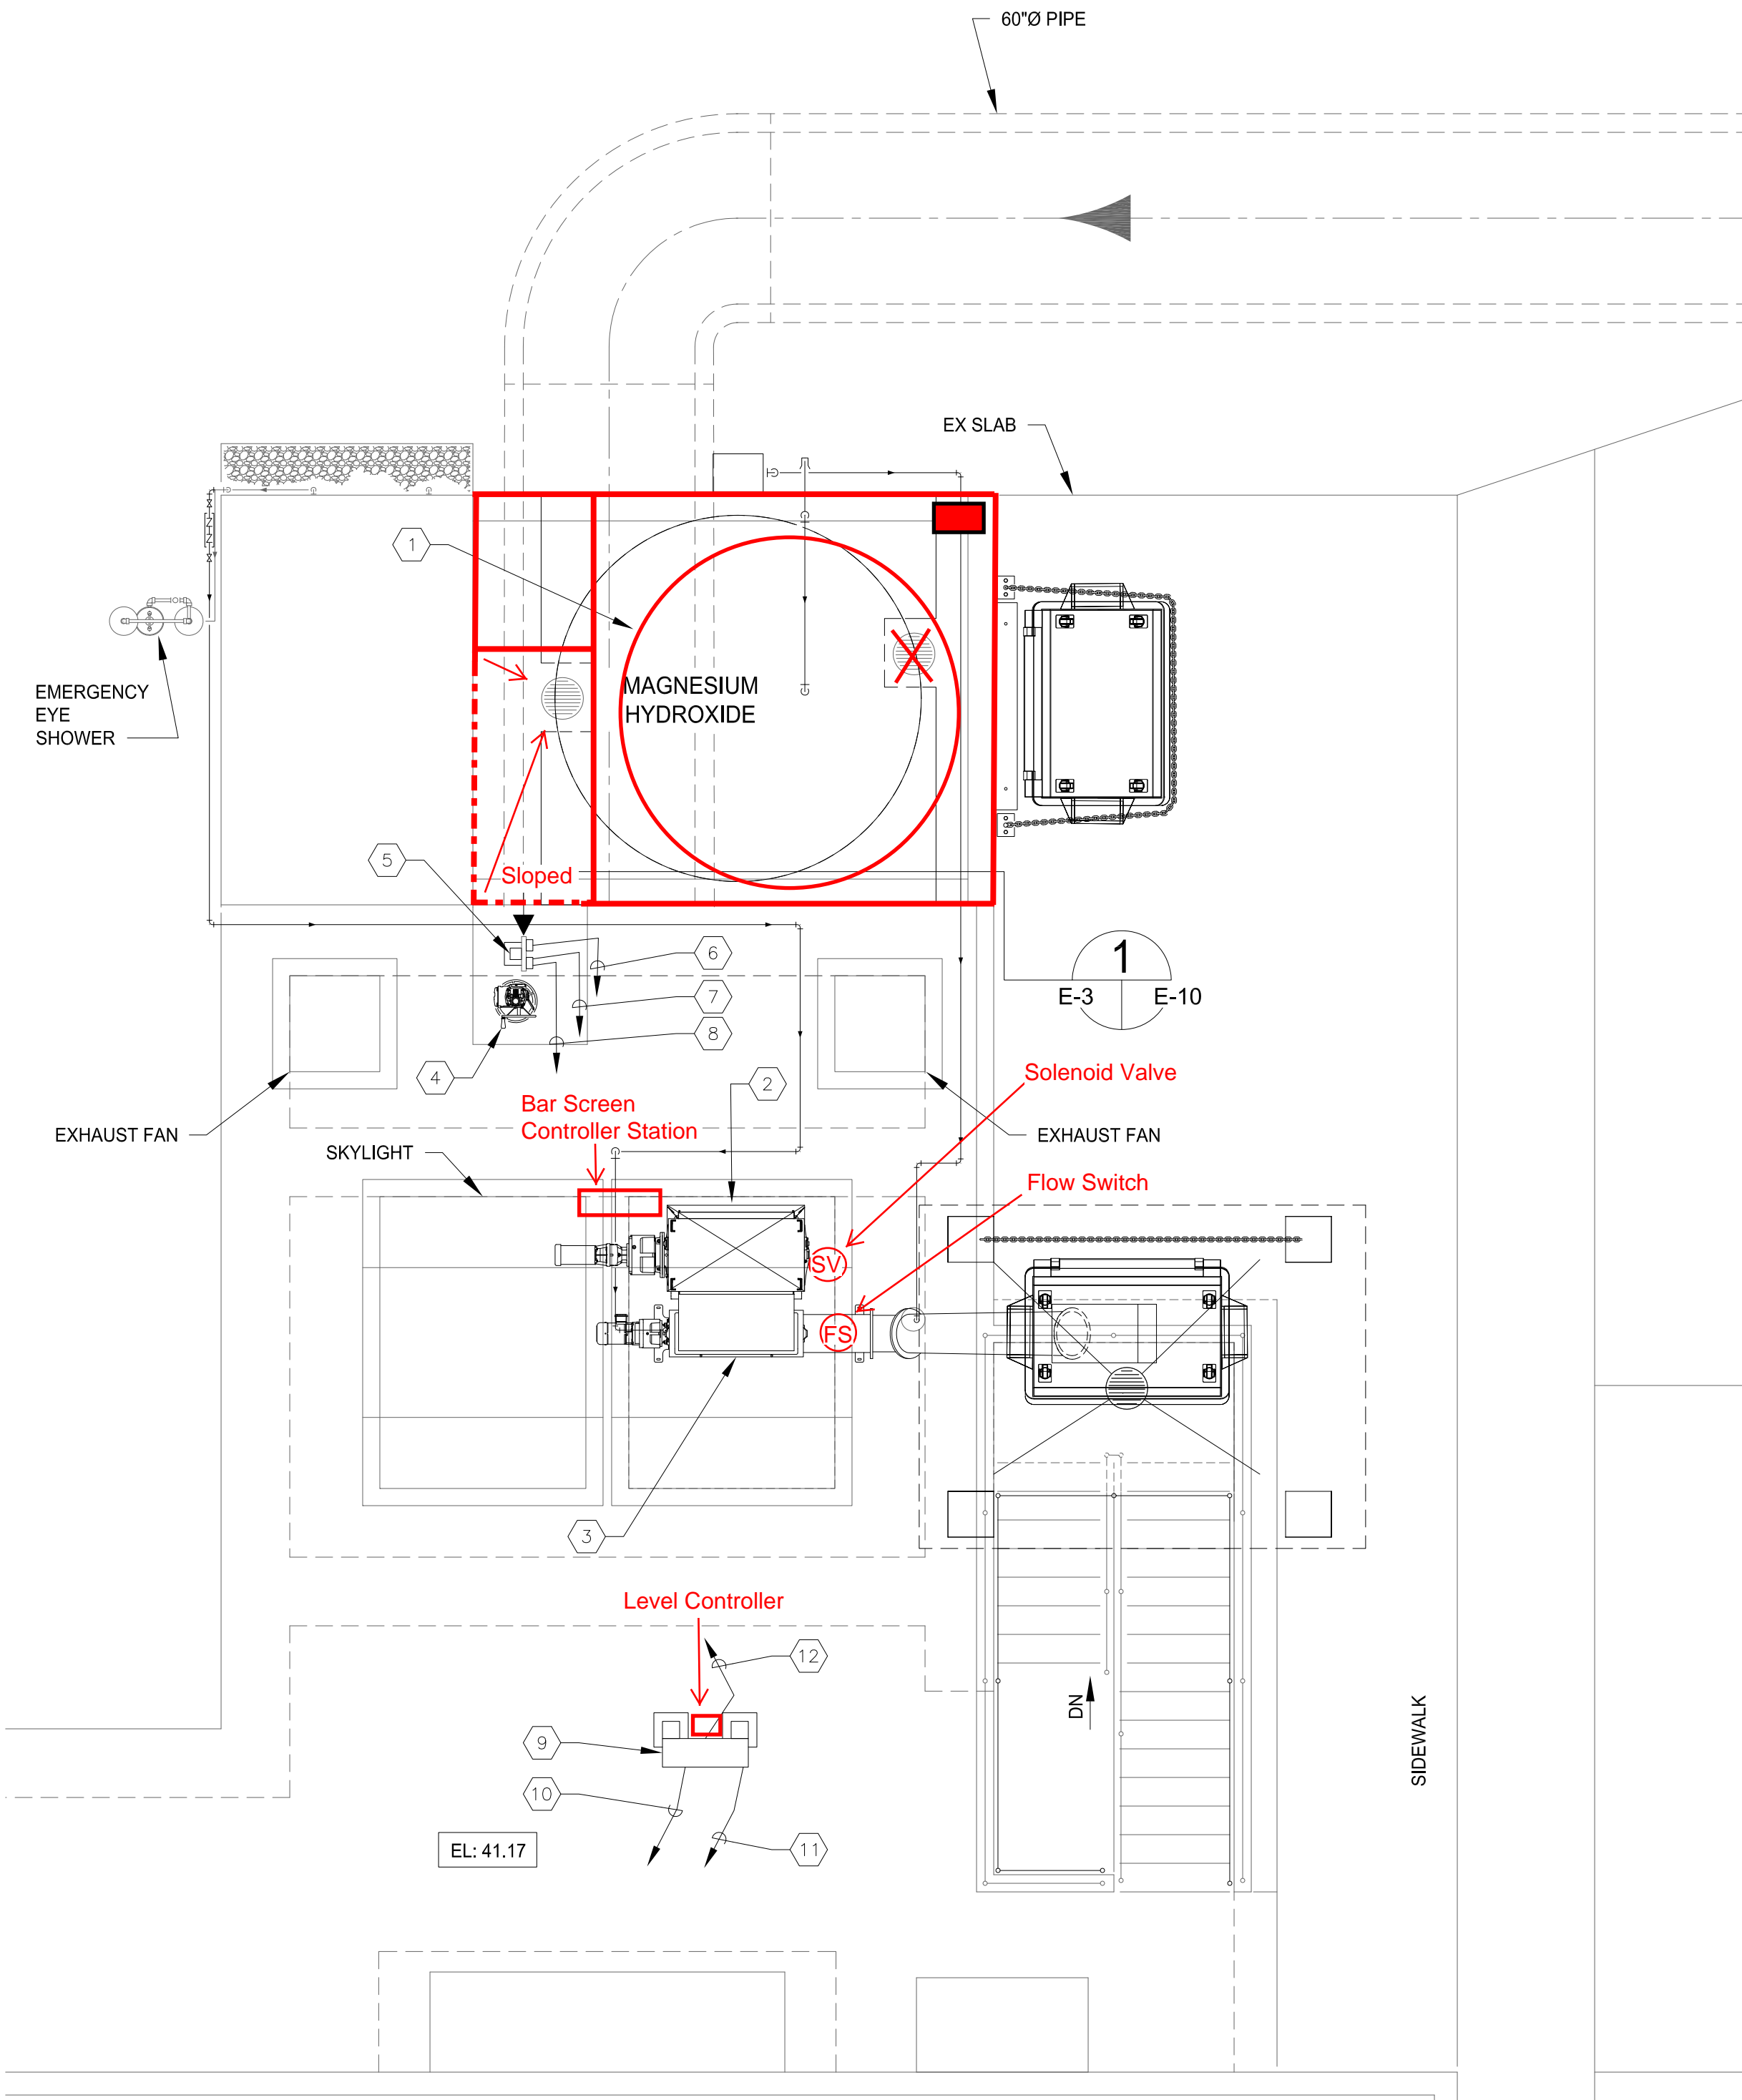

ELECTRICAL PLAN ELEVATION 41.17'
 SCALE : 1/4" = 1'-0"

- KEYED NOTES:**
- 1 PROPOSED LOCATION FOR RELOCATED BIOXIDE TANK. CONTRACTOR TO PROVIDE NEW CONDUIT AND CONDUCTORS TO ACCOMMODATE THE NEW BIOXIDE TANK LOCATION. FIELD ROUTE NEW CONDUIT AS REQUIRED. INSTALL NEW CONDUIT TO AVOID TRIPPING HAZARDS. REFER ALSO TO KEYED NOTE #3 ON SHEET E-2.
 - 2 PROPOSED BAR SCREEN.
 - 3 PROPOSED COMPACTOR.
 - 4 PROPOSED STAND FOR SLIDE GATE ELECTRIC ACTUATOR.
 - 5 PROVIDE AND INSTALL NEW 600V, 30A, 3-POLE MANUAL DISCONNECT SWITCH, SELECTOR SWITCH AND ASSOCIATED JUNCTION BOXES. REFER TO DETAIL ON SHEET E-10.
 - 6 PROVIDE AND INSTALL 3-#10 + 1-#10 GND IN 3/4"C. FROM MANUAL SWITCH TO EXISTING MCC (REFER TO KEYED NOTE #10 ON SHEET E-5 FOR MCC LOCATION). FIELD ROUTE CONDUIT AS REQUIRED. REFER TO SHEET E-5 FOR CONTINUATION.
 - 7 PROVIDE AND INSTALL 2-#14 + 1-#14 GND IN 3/4"C. FROM 24V DC JUNCTION BOX TO NEW BAR SCREEN CONTROL PANEL (REFER TO KEYED NOTE #8 BELOW FOR BAR SCREEN CONTROL PANEL LOCATION) FOR AUTO OPEN ON HIGH LEVEL BYPASS CONDUCTORS. FIELD ROUTE CONDUIT AS REQUIRED.
 - 8 PROVIDE AND INSTALL NEW 3/4" CONDUIT WITH 12-#14 + 1-#14 GND FROM NEW SLIDE GATE OPERATOR TO ANNUNCIATOR CONTROL PANEL FOR SLIDE GATE INPUT/OUTPUTS (4-#14 OPEN, CLOSE, STOP, COMMAND COMMANDS, 2-#14 VALVE UNDER REMOTE CONTROL INDICATION, 2-#14 VALVE OPEN INDICATION, 2-#14 VALVE CLOSED INDICATION). FIELD ROUTE CONDUIT AS REQUIRED. REFER TO SHEET E-5 FOR EXISTING ANNUNCIATOR CONTROL PANEL LOCATION. REFER TO SHEET E-5 FOR CONDUIT CONTINUATION.
 - 9 PROVIDE AND INSTALL NEW BAR SCREEN CONTROL PANEL. MOUNT WITH TWO (2) 6" SQUARE ALUMINUM POSTS. PROVIDE FULL FILLET WELD TO 12" X 12" X 3/4" ALUMINUM BASE PLATES. SECURE BASE PLATES TO CONCRETE SLAB WITH FOUR (4) STAINLESS STEEL 1/2" DIA. X 8" BOLTS & STAINLESS STEEL HEX NUTS WITH LOCKWASHER. DRILL CONCRETE & EMBED BOLTS AND ANCHORS IN EPOXY. COAT BOTTOM OF BASE PLATE WITH ASPHALT PAINT. PROVIDE NEOPRENE GASKET BETWEEN ALL STAINLESS STEEL AND ALUMINUM COMPONENTS.
 - 10 PROVIDE AND INSTALL 3-#10 + 1-#10 GND IN 3/4"C. FROM BAR SCREEN CONTROL PANEL TO EXISTING MCC (REFER TO KEYED NOTE #10 ON SHEET E-5 FOR MCC LOCATION). FIELD ROUTE CONDUIT AS REQUIRED. REFER TO SHEET E-5 FOR CONTINUATION.
 - 11 PROVIDE AND INSTALL NEW 1" CONDUIT WITH 26-#14 + 1-#14 GND FROM NEW BAR SCREEN CONTROL PANEL TO EXISTING ANNUNCIATOR CONTROL PANEL FOR BAR SCREEN INPUT/OUTPUTS. REFER TO SHEET E-9 FOR CONTACT DEVELOPMENT. REFER TO SHEET E-5 FOR CONDUIT CONTINUATION AND EXISTING ANNUNCIATOR CONTROL PANEL LOCATION. FIELD ROUTE CONDUIT AS REQUIRED.
 - 12 REFER TO KEYED NOTE #7 ABOVE.

- GENERAL NOTES:**
1. FOR HAZARDOUS AREA IDENTIFICATION REFER TO SHEET E-4.
 2. CONTRACTOR SHALL COORDINATE WITH BAR SCREEN SUPPLIER FOR REQUIREMENTS FOR THE BAR SCREEN LOCAL CONTROL STATION AND THE COMPACTOR LOCAL CONTROL STATION INSTALLATION, INCLUDING PROPOSED LOCATION, REQUIRED CONDUIT AND CONDUCTORS.
 3. CONTRACTOR SHALL COORDINATE WITH BAR SCREEN SUPPLIER FOR REQUIREMENTS FOR: ALL BAR SCREEN EQUIPMENT MOTOR WIRING, MOTOR THERMOSTATS, SOLENOID VALVES, HIGH LEVEL FLOAT SWITCH, ULTRASONIC LEVEL TRANSDUCERS AND ALL OTHER ANCILLARY EQUIPMENT FOR A FULLY COMPLETE AND FUNCTIONING SYSTEM. ALL CONDUCTORS, CONNECTIONS, LOCATIONS, ETC. SHALL BE PER THE BAR SCREEN SUPPLIERS SPECIFICATIONS.
 4. THE BAR SCREEN CONTROL PANEL SHALL BE INSTALLED OUTSIDE OF THE AREA CLASSIFIED AS CLASS I, DIV 2. THE BAR SCREEN LOCAL CONTROL STATION AND THE COMPACTOR LOCAL CONTROL STATION SHALL BE INSTALLED WITHIN THE AREA CLASSIFIED AS CLASS I, DIV 2. REFER TO SHEET E-4 FOR HAZARDOUS AREA IDENTIFICATION.
 5. ALL INSTALLATIONS WITHIN THE CLASSIFIED AREA SHALL COMPLY WITH ARTICLE 502 OF THE 2014 NATIONAL ELECTRICAL CODE.




777 S. Harbour Island Blvd.
 Suite 350
 Tampa, FL 33602
 813.227.9190
 Certificate of Authorization No. 8363


C:\TDP\Projects\2017\26-50\231703284 Gresham Uni Screen\GS Bid Border 8-15-18\E-3.dwg, Aug 15, 2018 - 10:37am

DESIGNED	TDT	 GS & P	302 Knights Run Avenue, Suite 900 Tampa, FL 33602 813.254.5838 FIRM'S FLORIDA CERT. NO. AAP000034/CA3806 IB26000797/LC26000381		APPROVED BY:	 City of Tampa Florida		PROJECT:	CITY OF TAMPA UNIVERSITY PUMPING STATION AUTOMATIC BAR SCREEN	DESCRIPTION:	ELECTRICAL PLAN ELEVATION 41.17'	DATE:	AUGUST 2018	
DRAWN	JLH				TIMOTHY THOMAS						GSP JOB No.	4291800	SHEET:	E-3
CHECKED	TDT				FLA. LIC. NO.	47079	DATE					18 OF 27		
REV. NO.	DATE	DESCRIPTION	REV. BY											

C:\TDT\Projects\2017\26-50\231703284 Gresham Uni Screen\GS_Bld_Border_8-15-18\E-4.dwg, Aug 15, 2018 - 10:40am

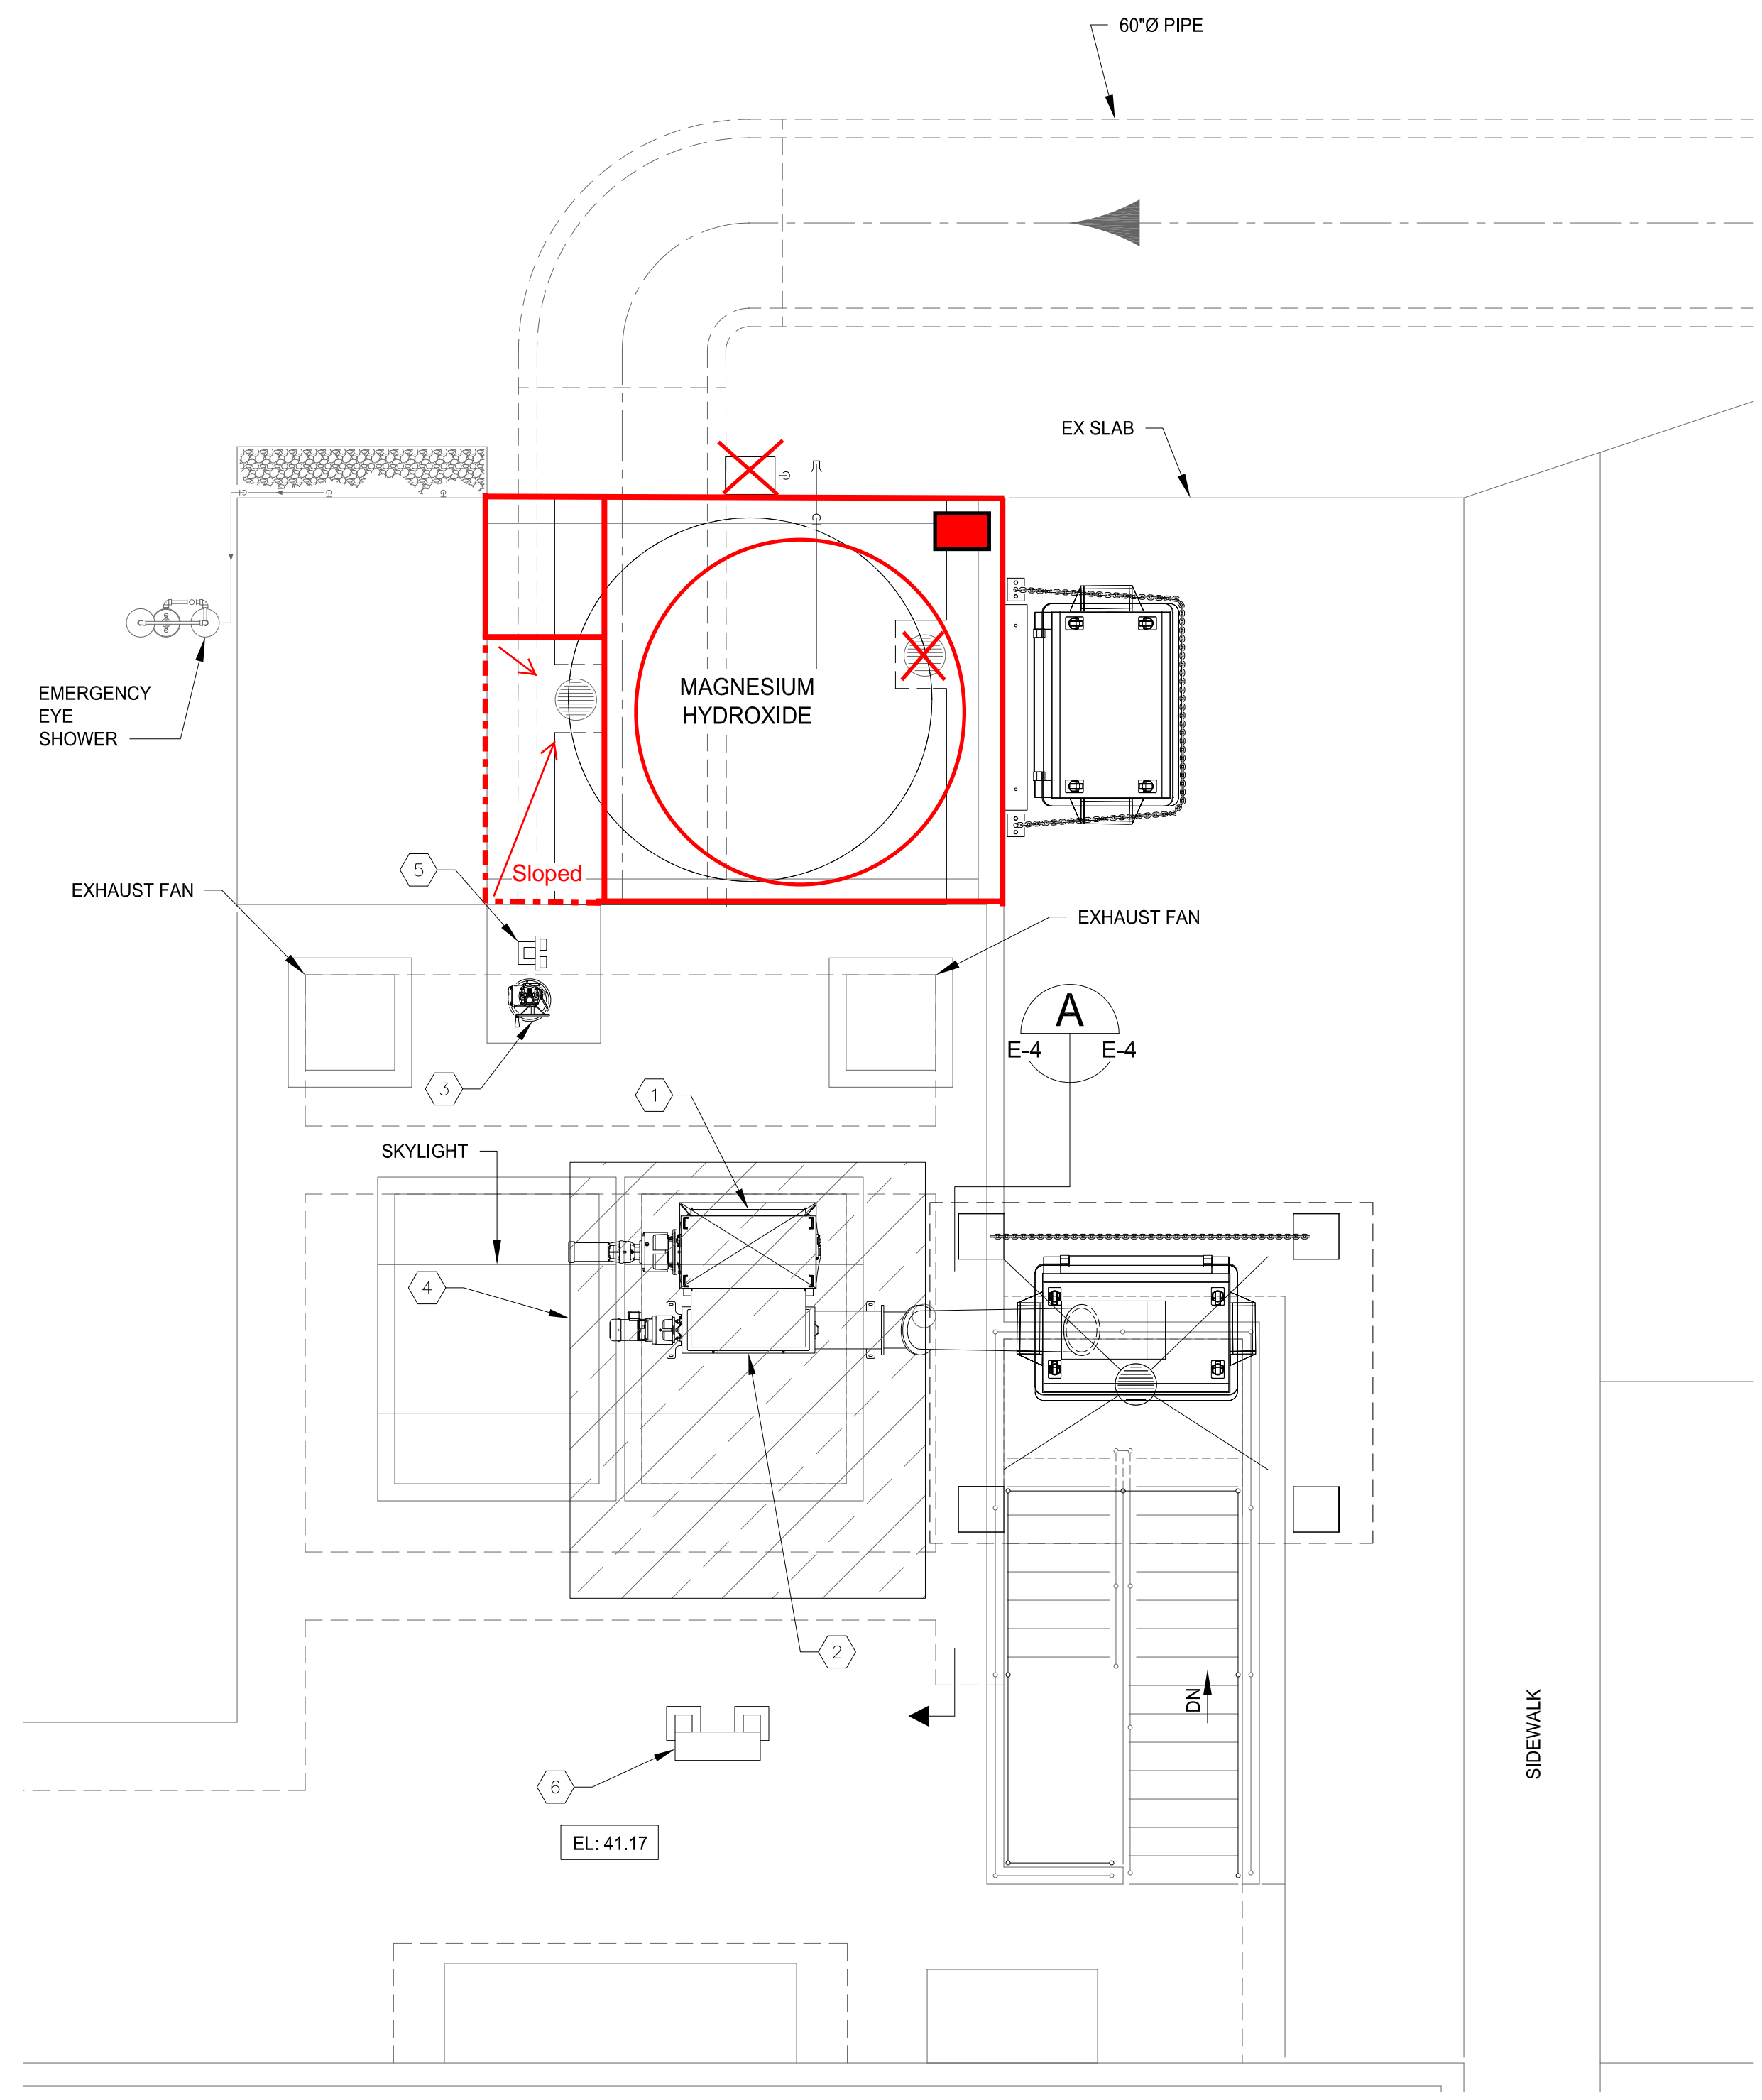


HAZARDOUS AREA ELEVATION 41.17'
SCALE : 1/4" = 1'-0"

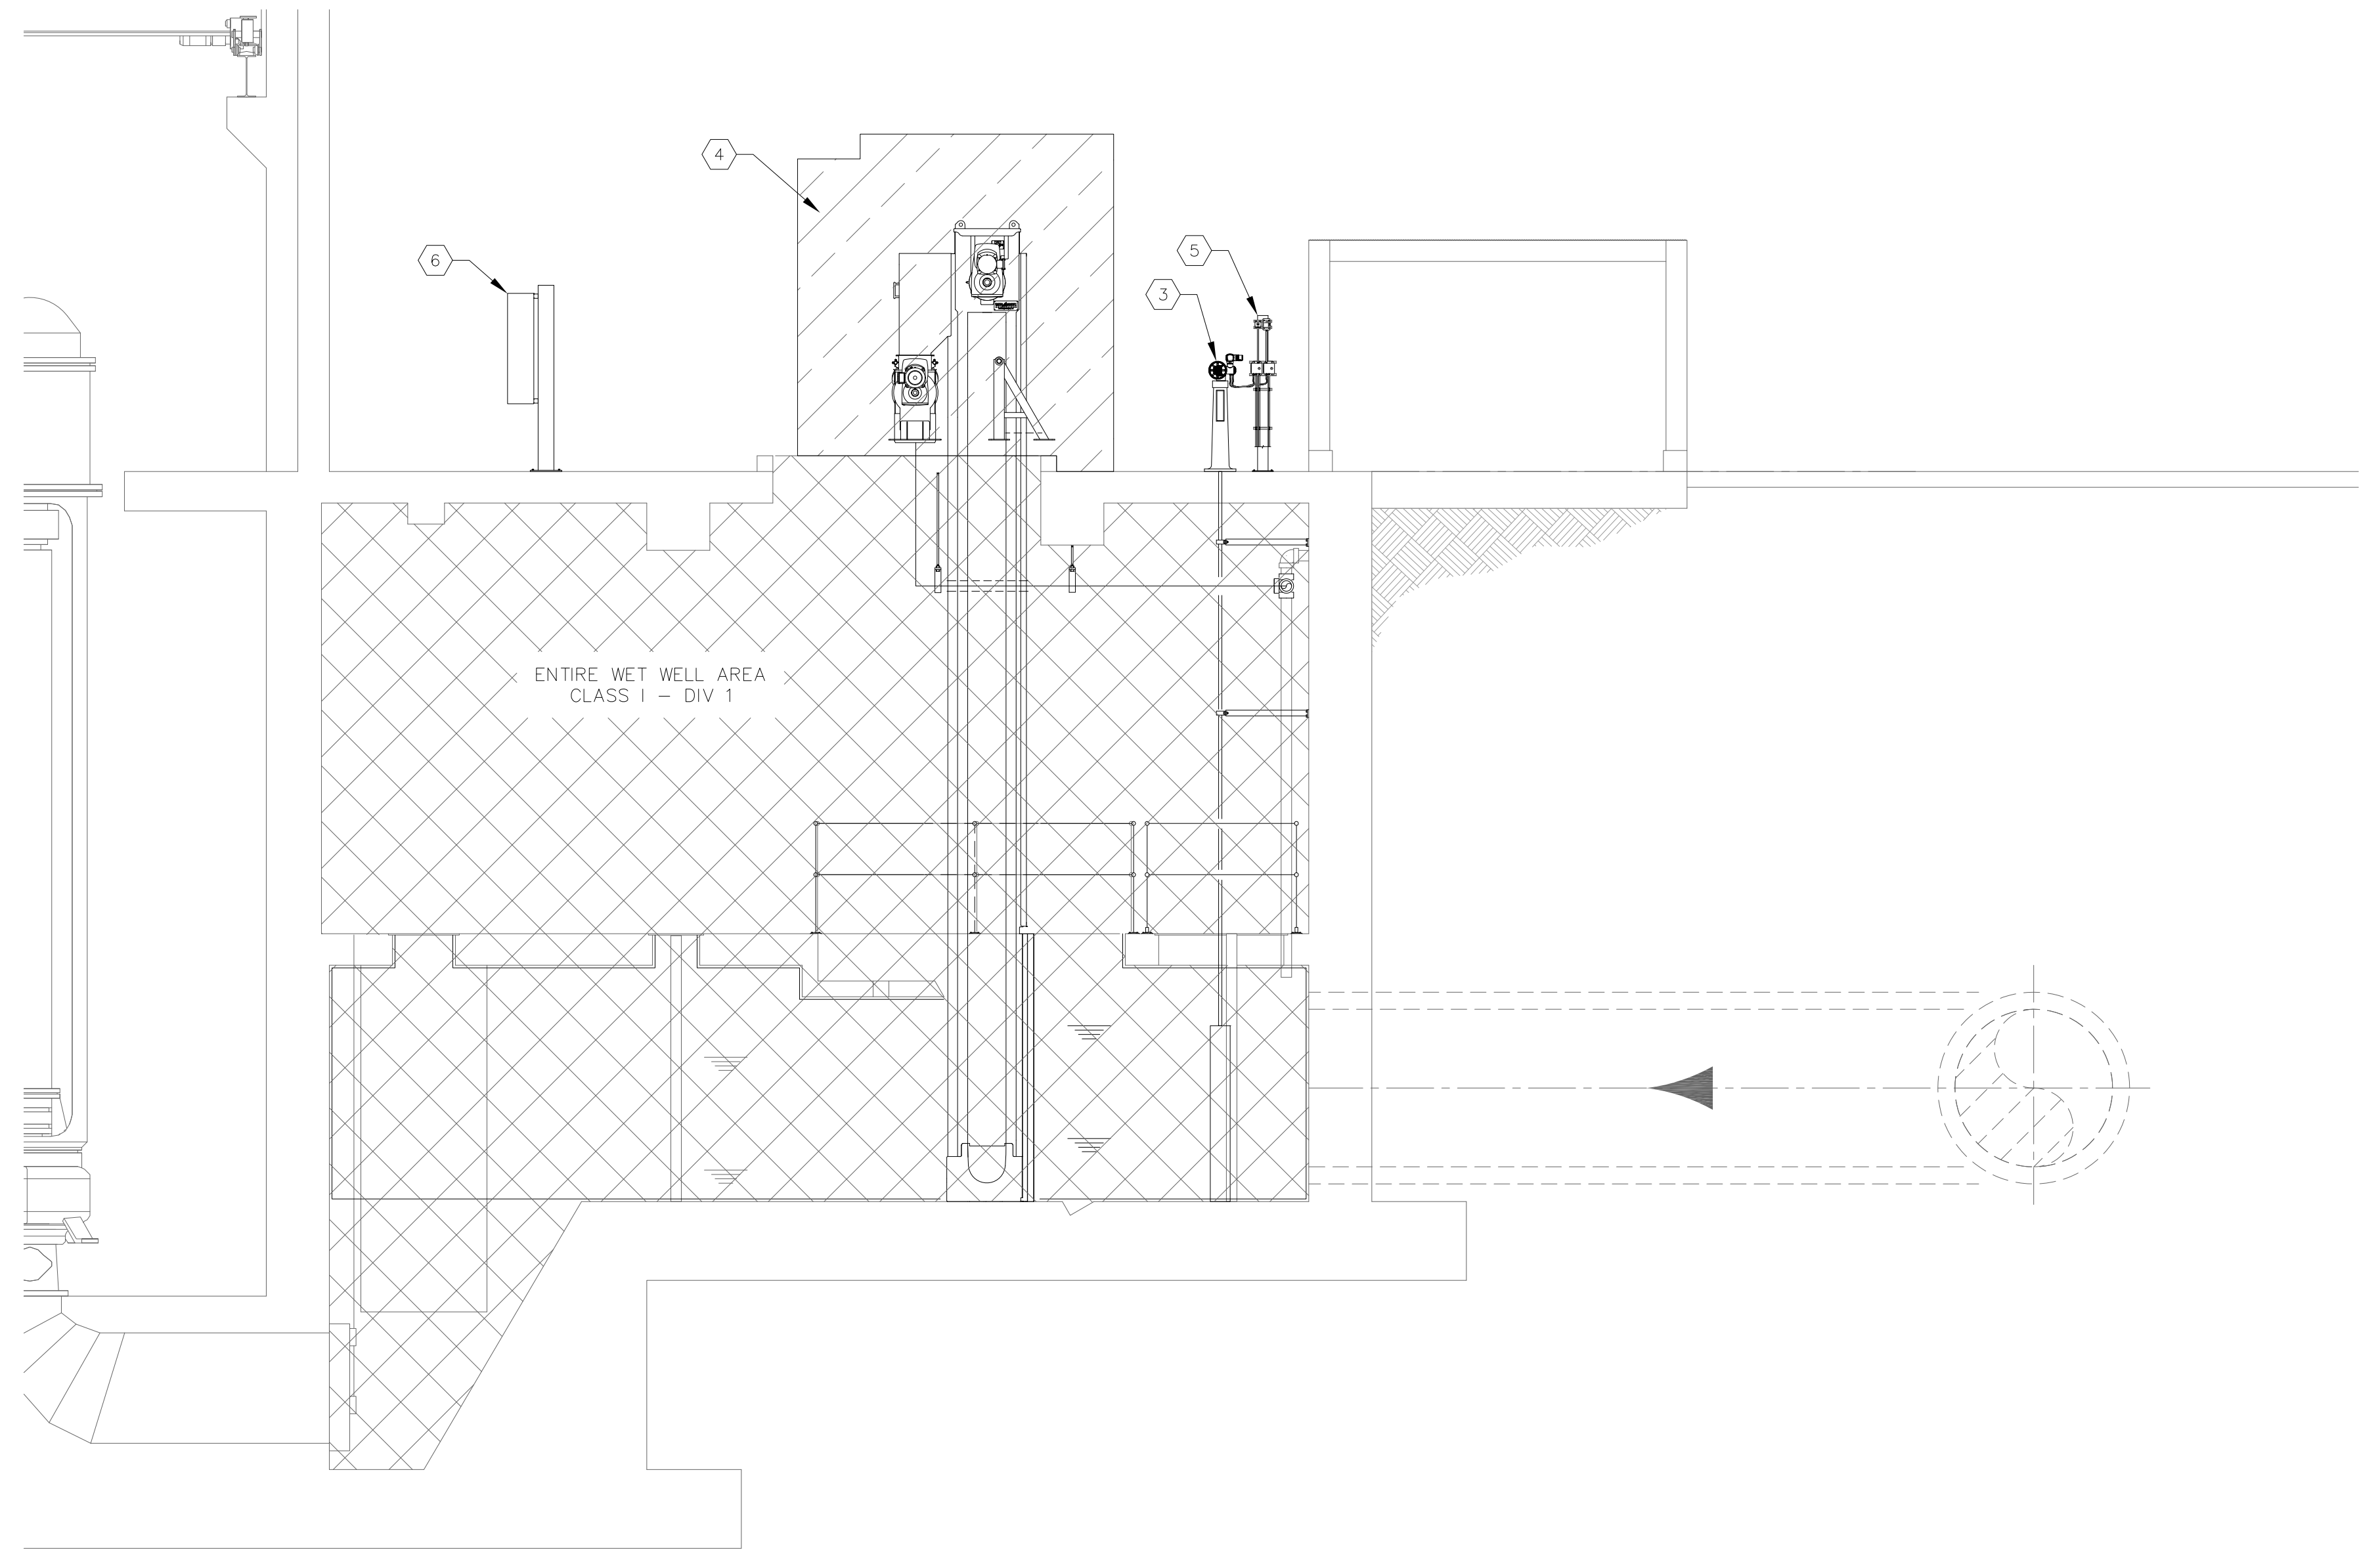

HAZARDOUS AREA SECTION VIEW
SCALE : 1/4" = 1'-0"

- KEYED NOTES:**
- 1 PROPOSED BAR SCREEN.
 - 2 PROPOSED COMPACTOR.
 - 3 PROPOSED STAND AND ELECTRIC OPERATOR FOR SLIDE GATE.
 - 4 CLASS I - DIV 2 AREA : 36" ENVELOPE AROUND BAR SCREEN AND COMPACTOR EQUIPMENT.
 - 5 PROPOSED ACTUATOR DISCONNECT. REFER TO DETAIL ON SHEET E-10.
 - 6 PROPOSED BAR SCREEN CONTROL PANEL (PROVIDED BY BAR SCREEN SUPPLIER).


- CLASSIFIED AREA LEGEND:**
- CLASS I - DIV 1
 - CLASS I - DIV 2

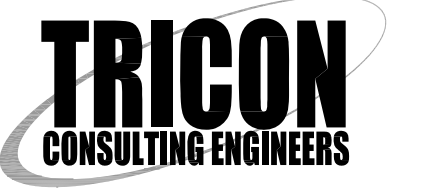

777 S. Harbour Island Blvd.
Suite 350
Tampa, FL 33602
813.227.9190
Certificate of Authorization No. 8363



DESIGNED	TDT		302 Knights Run Avenue, Suite 900 Tampa, FL 33602 813.254.5838 FIRM'S FLORIDA CERT. NO. AAP000034/CA3806 IB26000797/LC26000381	APPROVED BY:			PROJECT:	CITY OF TAMPA UNIVERSITY PUMPING STATION AUTOMATIC BAR SCREEN	DESCRIPTION:	HAZARDOUS AREA IDENTIFICATION	DATE:	AUGUST 2018
DRAWN	JLH			TIMOTHY THOMAS	DATE			GSP JOB No.	4291800			
CHECKED	TDT			FLA. LIC. NO.	47079			SHEET:	E-4			
REV. NO.	DATE			DESCRIPTION	REV. BY				19 OF 27			

C:\TDP\Projects\2017\26-50\231703284 Gresham Uni Screen\GS Bid Border 8-15-18\E-5.dwg, Aug 15, 2018 - 10:42am

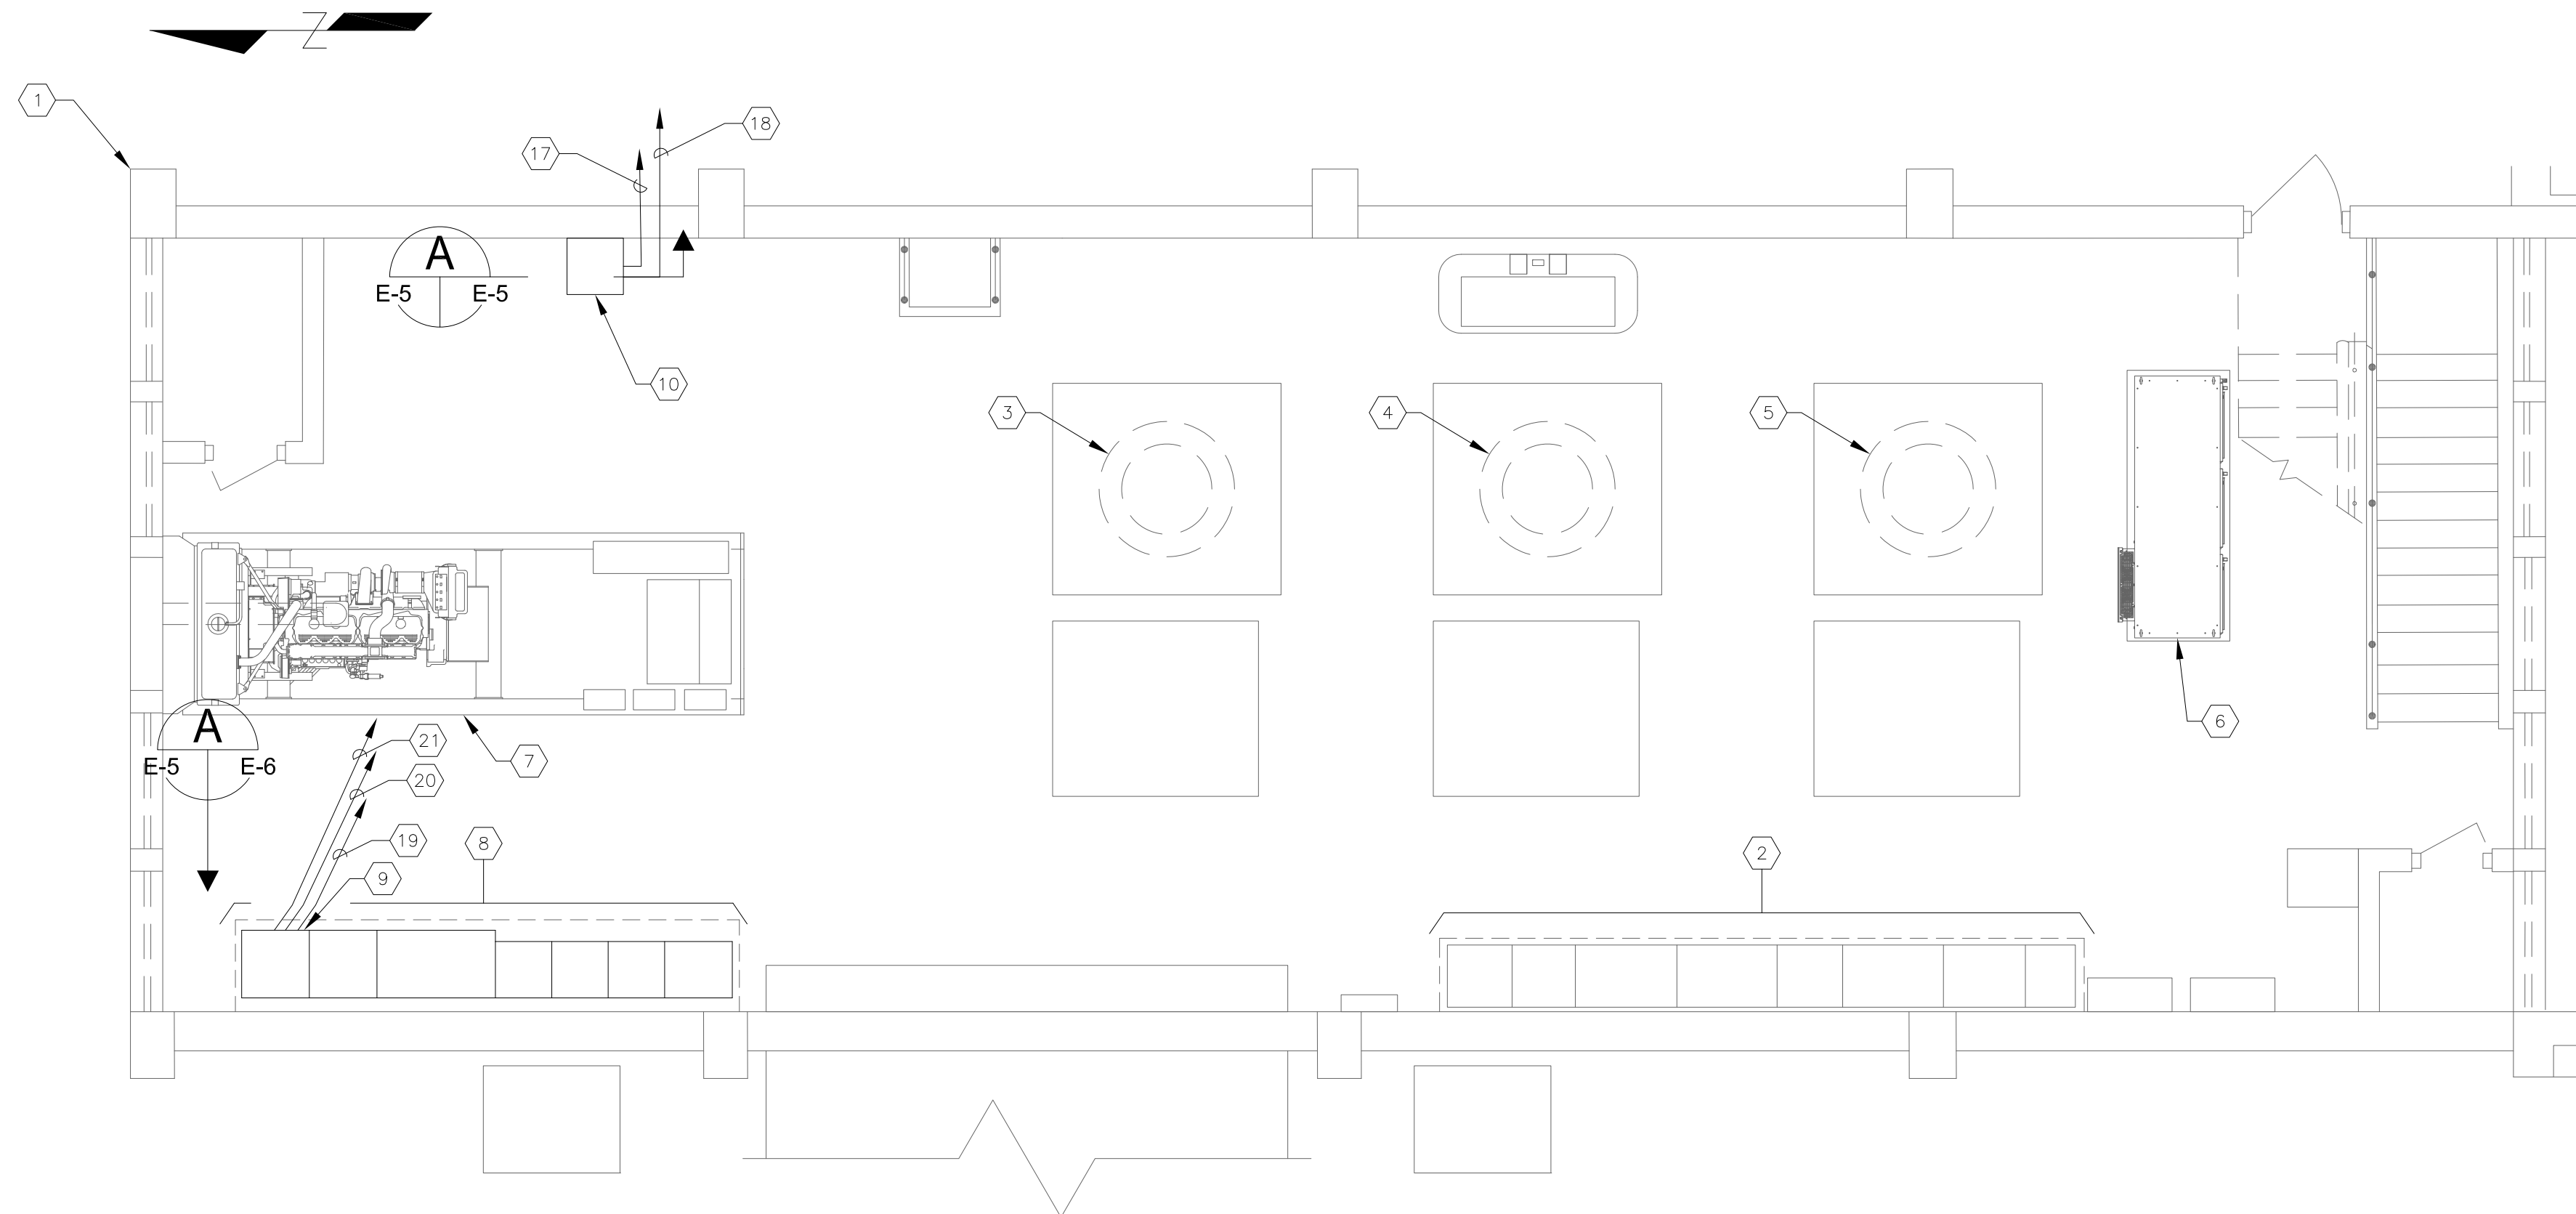



PUMPING STATION ELECTRICAL PLAN

SCALE : 1/4" = 1'-0"

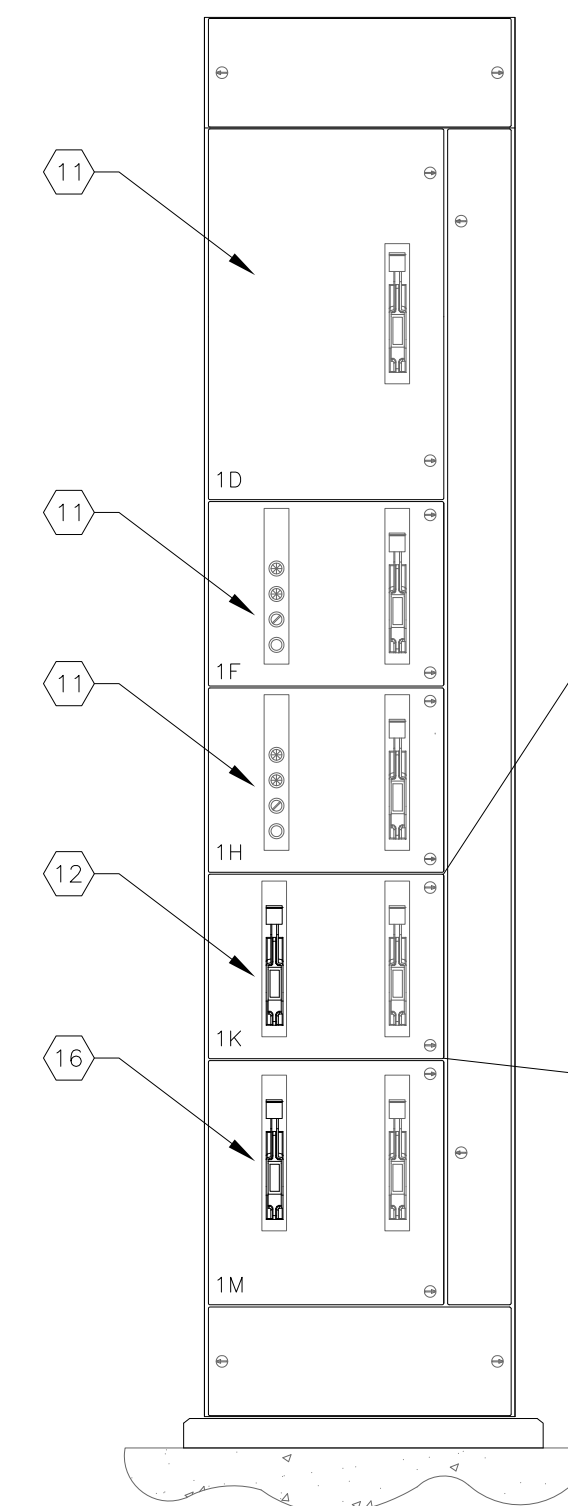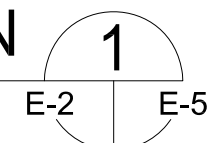

EXISTING MCC ELEVATION

SCALE : 1/4" = 1'-0"

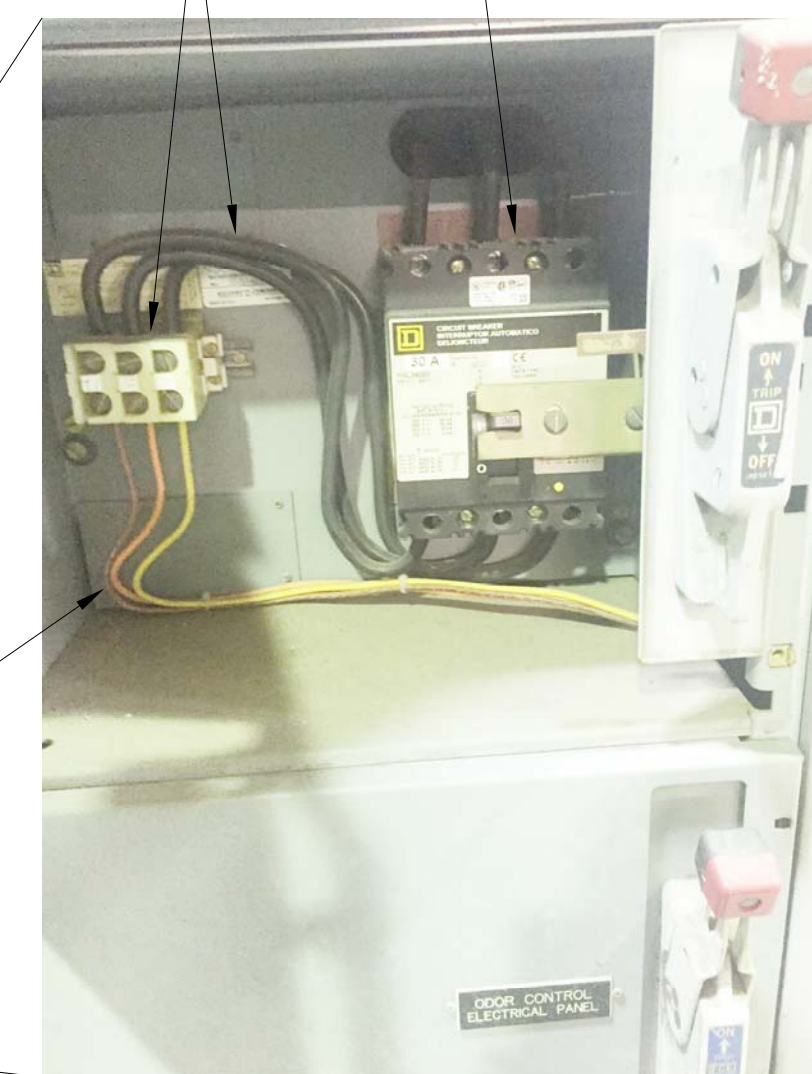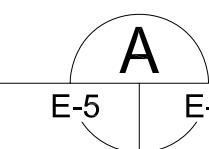

KEYED NOTES:

- 1 EXISTING PUMP STATION BUILDING, ELEVATION 41.25'.
- 2 EXISTING SEWAGE PUMPS CONTROL CENTER. NO WORK REQUIRED.
- 3 EXISTING SEWAGE PUMP NO. 3 (AT ELEVATION 15.00'). NO WORK REQUIRED.
- 4 EXISTING SEWAGE PUMP NO. 2 (AT ELEVATION 15.00'). NO WORK REQUIRED.
- 5 EXISTING SEWAGE PUMP NO. 1 (AT ELEVATION 15.00') NO WORK REQUIRED.
- 6 EXISTING 400 HP VFD FOR PUMP NO. 1 (AT ELEVATION 41.25'). NO WORK REQUIRED.
- 7 EXISTING GENERATOR. NO WORK REQUIRED.
- 8 EXISTING MOTOR CONTROL CENTER, AUTOMATIC TRANSFER SWITCH AND ANNUNCIATOR CONTROL PANEL.
- 9 EXISTING ANNUNCIATOR CONTROL PANEL. REFER TO SHEET E-6 FOR WORK REQUIRED.
- 10 EXISTING 480V, 3Ø, 300A VERTICAL BUS, MOTOR CONTROL CENTER (MCC). SQUARE D MODEL 4 TYPE. REFER TO ELEVATION A ON THIS SHEET FOR WORK REQUIRED.
- 11 EXISTING MCC BUCKET. NO WORK REQUIRED.
- 12 EXISTING BUCKET FOR SLUICE GATES 1-3. CONTRACTOR TO PROVIDE AND INSTALL NEW 3-POLE, 600V, 30 AMPERE CIRCUIT BREAKER (SQUARE D FHL36030) FOR NEW MOTOR OPERATED SLIDE GATE. CONTRACTOR SHALL ALSO PROVIDE AND INSTALL NEW CIRCUIT BREAKER THROUGH-DOOR OPERATING HANDLE, NEW BUCKET DOOR (TO ACCOMMODATE NEW OPERATING HANDLE), NEW LABEL FOR BUCKET DOOR AND ALL OTHER ANCILLARY COMPONENTS AS REQUIRED FOR PROPER OPERATION. REFER ALSO TO KEYED NOTES #13, #14 AND #15.
- 13 EXISTING 3-POLE, 600V, 30 AMPERE CIRCUIT BREAKER (SQUARE D FHL36030) TO REMAIN.
- 14 CONTRACTOR TO REMOVE EXISTING POWER DISTRIBUTION BLOCK AND EXISTING CONDUCTORS FROM LOAD SIDE OF CIRCUIT BREAKER TO POWER DISTRIBUTION BLOCK.
- 15 CONTRACTOR TO CONNECT EXISTING FIELD WIRING DIRECTLY TO LOAD SIDE OF CIRCUIT BREAKER.
- 16 EXISTING BUCKET FOR ODOR CONTROL ELECTRICAL PANEL. CONTRACTOR TO PROVIDE AND INSTALL NEW 3-POLE, 600V, 30 AMPERE CIRCUIT BREAKER (SQUARE D FHL36030) FOR NEW BAR SCREEN CONTROL PANEL. CONTRACTOR SHALL ALSO PROVIDE AND INSTALL NEW CIRCUIT BREAKER THROUGH-DOOR OPERATING HANDLE, NEW BUCKET DOOR (TO ACCOMMODATE NEW OPERATING HANDLE) AND ALL OTHER ANCILLARY COMPONENTS AS REQUIRED FOR PROPER OPERATION. CONTRACTOR TO MAKE FIELD MODIFICATIONS (SIMILAR TO KEYED NOTES #14 AND #15) IF REQUIRED.
- 17 CONTRACTOR TO PROVIDE AND INSTALL NEW 3/4" CONDUIT WITH 3-#10 + 1-#10 GND TO SERVE AS NEW 480V, 3Ø FEEDER TO NEW SLIDE GATE ACTUATOR MANUAL DISCONNECT SWITCH. REFER TO SHEET E-3 FOR CONTINUATION.
- 18 CONTRACTOR TO PROVIDE AND INSTALL NEW 3/4" CONDUIT WITH 3-#10 + 1-#10 GND TO SERVE AS NEW 480V, 3Ø FEEDER TO NEW BAR SCREEN CONTROL PANEL. REFER TO SHEET E-3 FOR CONTINUATION.
- 19 CONTRACTOR TO PROVIDE AND INSTALL NEW 3/4" CONDUIT WITH 2-#14 + 1-#14 GND TO NEW SLIDE GATE AUTO OPEN HIGH LEVEL BYPASS SELECTOR SWITCH FOR ANNUNCIATOR CONTROL PANEL BYPASS INDICATION. REFER TO SHEET E-3 FOR CONTINUATION. REFER TO SHEET E-7 FOR I/O ASSIGNMENTS AND LISTING. REFER TO SHEET E-9 FOR CONTACT DEVELOPMENT.
- 20 CONTRACTOR TO PROVIDE AND INSTALL NEW 3/4" CONDUIT WITH 12-#14 + 1-#14 GND TO NEW SLIDE GATE OPERATOR FOR ANNUNCIATOR CONTROL PANEL SLIDE GATE INPUT/OUTPUTS (4-#14 OPEN, CLOSE, STOP COMMANDS AND COMMAND; 2-#14 VALVE UNDER REMOTE CONTROL INDICATION; 2-#14 VALVE OPEN INDICATION; 2-#14 VALVE CLOSED INDICATION; 2-#14 AUTO OPEN HIGH LEVEL BYPASSED). REFER TO SHEET E-3 FOR CONTINUATION. REFER TO SHEET E-7 FOR I/O ASSIGNMENTS AND LISTING. REFER TO SHEET E-9 FOR CONTACT DEVELOPMENT.
- 21 CONTRACTOR TO PROVIDE AND INSTALL NEW 1" CONDUIT WITH 26-#14 + 1-#14 GND TO NEW BAR SCREEN CONTROL PANEL FOR ANNUNCIATOR CONTROL PANEL BAR SCREEN INPUT/OUTPUTS. REFER TO SHEET E-3 FOR CONTINUATION. REFER TO SHEET E-9 FOR CONTACT DEVELOPMENT.

GENERAL NOTES:

- 1. EXISTING MCC IN KEYED NOTE #10 DOES NOT CONSIST OF STAB-ON CIRCUIT BREAKER ARRANGEMENT. CONTRACTOR SHALL PROVIDE CABLE-ON BUS CONNECTIONS WITH NEW CU CONDUCTORS FOR BOTH NEW CIRCUIT BREAKER LINE SIDE FEEDERS.



777 S. Harbour Island Blvd.
Suite 350
Tampa, FL 33602
813.227.9190
Certificate of Authorization No. 8363

REV. NO.	DATE	DESCRIPTION	REV. BY

DESIGNED	TDT
DRAWN	JLH
CHECKED	TDT



302 Knights Run Avenue, Suite 900
Tampa, FL 33602
813.254.5838
FIRM'S FLORIDA
CERT. NO.
AAP000034/CA3806
IB26000797/LC26000381

APPROVED BY:	DATE
TIMOTHY THOMAS	
FLA. LIC. NO. 47079	




PROJECT:
CITY OF TAMPA
UNIVERSITY PUMPING STATION
AUTOMATIC BAR SCREEN

DESCRIPTION:
PUMPING STATION
ELEVATION 41.25'
ELECTRICAL PLAN

DATE:	AUGUST 2018
GSP JOB No.	4291800
SHEET:	E-5 20 OF 27

C:\TDP\Projects\2017\26-50\231703284 Gresham Uni Screen\GS Bid Border 8-15-18\E-6.dwg, Aug 15, 2018 - 11:19am


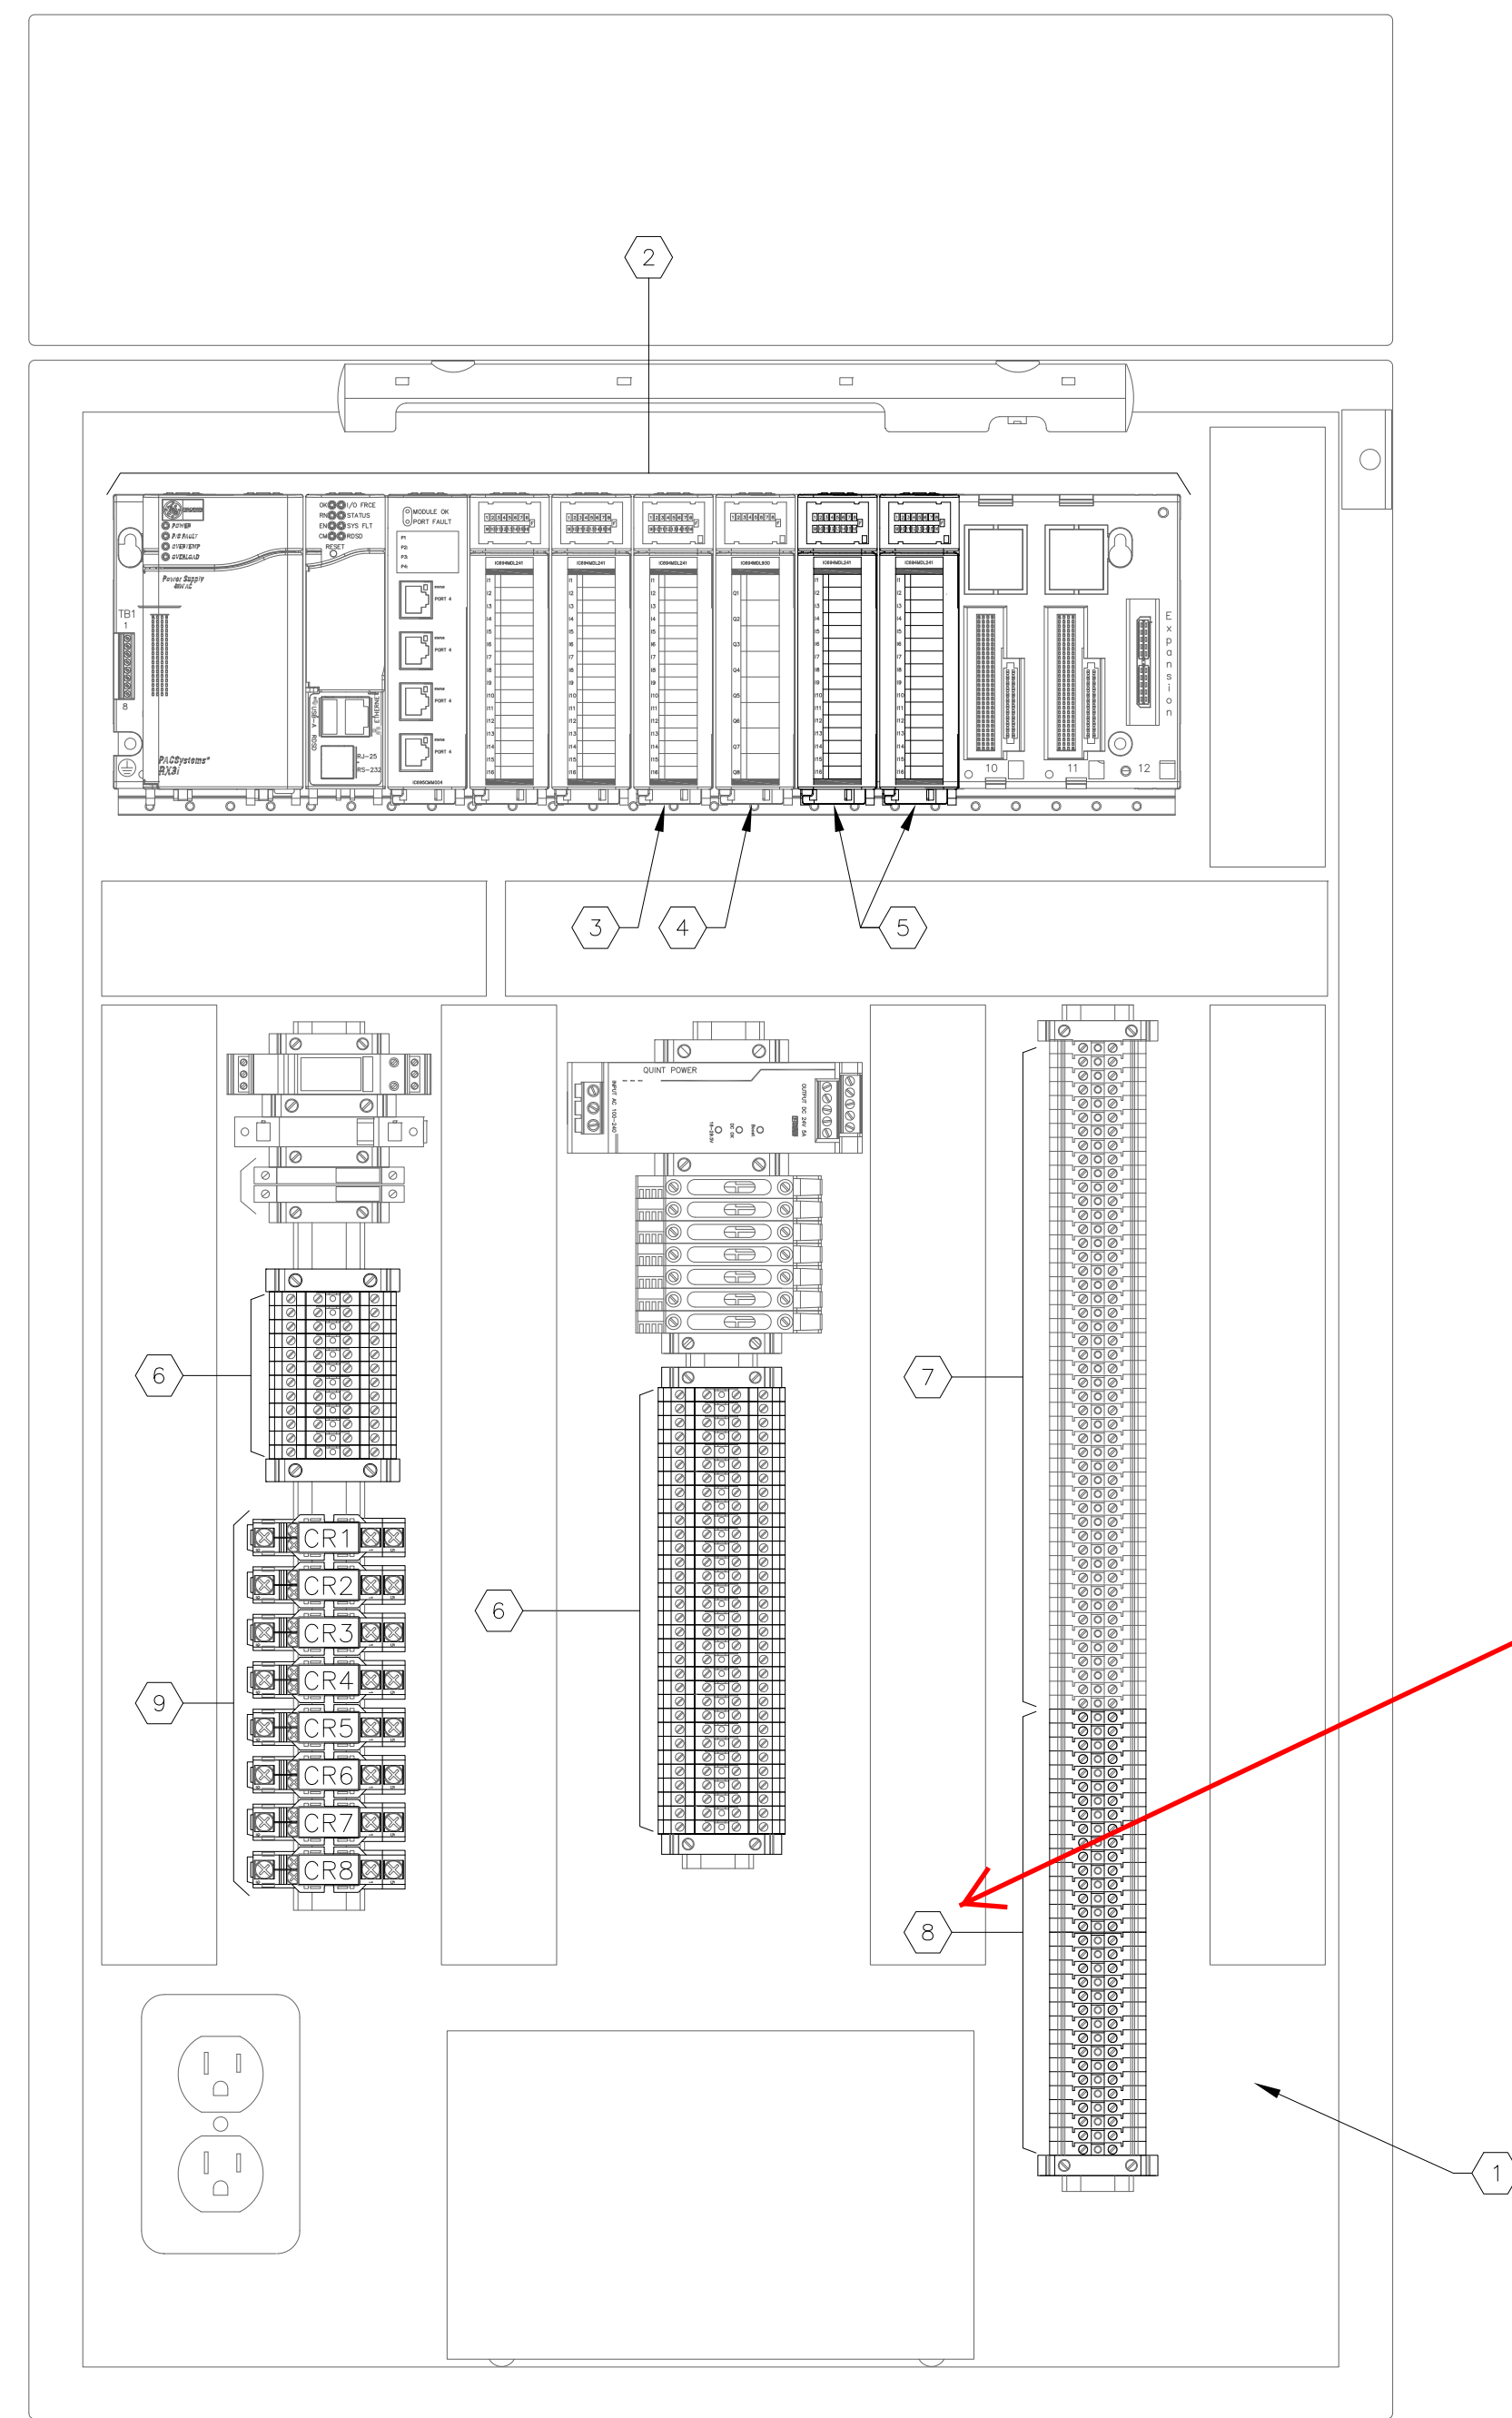


- KEYED NOTES:**
- ① INTERIOR OF EXISTING ANNUNCIATOR CONTROL PANEL. CONTRACTOR TO MAKE MODIFICATIONS TO EXISTING CONTROL PANEL AS NOTED BELOW.
 - ② EXISTING PLC RACK CONSISTING OF: ONE (1) – GE RX3i CPU : IC695CPE305-ABAG; ONE (1) – SERIAL COMMUNICATION MODULE: GE IC695CMM004; THREE (3) DC INPUT MODULES: GE IC694MDL241; ONE (1) A/C RELAY MODULE: GE IC694MDL916; ONE (1) 120V POWER SUPPLY: GE IC695PSA140; ONE (1) 12-SLOT BACK PLANE: GE IC695CHS012.
 - ③ EXISTING DC INPUT MODULE (GE IC694MDL241) CURRENTLY LOCATED IN SLOT 6. CONTRACTOR SHALL UTILIZE SPARE INPUTS FOR NEW INPUTS REQUIRED UNDER THIS CONTRACT. REFER TO SHEET E-7 FOR DETAILS.
 - ④ EXISTING A/C RELAY MODULE (GE IC694MDL930) CURRENTLY LOCATED IN SLOT 7. CONTRACTOR SHALL UTILIZE SPARE OUTPUTS (AND ASSOCIATED RELAYS) FOR NEW OUTPUTS REQUIRED UNDER THIS CONTRACT. REFER TO SHEET E-7 FOR DETAILS.
 - ⑤ CONTRACTOR TO PROVIDE AND INSTALL TWO (2) NEW DC INPUT MODULES (EACH GE IC694MDL241). INSTALL IN SLOTS 8 AND 9 RESPECTIVELY. REFER TO SHEET E-7 FOR DETAILS.
 - ⑥ EXISTING MULTI-LEVEL TERMINAL BLOCKS. CONTRACTOR SHARE UTILIZE SPARE TERMINAL BLOCKS AS REQUIRED.
 - ⑦ EXISTING SURGE PROTECTION DEVICES FOR 24V DC DISCRETE INPUT CIRCUITS. CONTRACTOR SHARE UTILIZE SPARE SURGE PROTECTION DEVICES AS REQUIRED.
 - ⑧ CONTRACTOR TO PROVIDE AND INSTALL THIRTY TWO (32) NEW SURGE PROTECTION DEVICES FOR 24V DC DISCRETE INPUT MODULE TO BE INSTALLED IN SLOTS 8 AND 9. PHOENIX CONTACT #2794699. PROVIDE AND INSTALL ADDITIONAL DIN-RAIL, END BARRIERS, ACCESSORIES AS REQUIRED TO ACCOMMODATE NEW SURGE PROTECTION DEVICES AS REQUIRED.
 - ⑨ EXISTING SQUARE-D 8501 R SERIES SPDT RELAYS WITH 120V COILS. CONTRACTOR SHARE UTILIZE SPARE INTERPOSING RELAYS CR2, CR3 AND CR4 AS REQUIRED. REFER TO SHEET E-7 FOR DETAILS.

Per Change ORder #5 & RFI #8, Slot's 8 & 9 as shown on diagram did not exist in Panel. Contractor had to install slot 8, as referenced here, on the right inside wall of the panel. See next page for Full I/O detail of Slots 8 & 9


**EXISTING ANNUNCIATOR CONTROL PANEL
INTERIOR DETAIL**

SCALE : N.T.S.

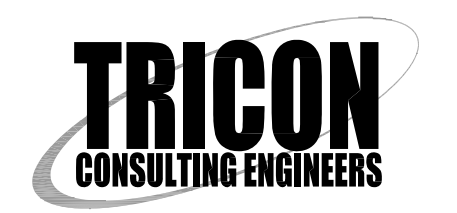
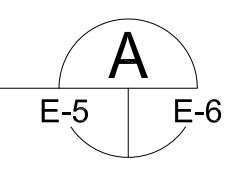


777 S. Harbour Island Blvd.
Suite 350
Tampa, FL 33602
813.227.9190
Certificate of Authorization No. 8363

DESIGNED	TD	<p>302 Knights Run Avenue, Suite 900 Tampa, FL 33602 813.254.5838</p> <p>FIRM'S FLORIDA CERT. NO. AAP000034/CA3806 1B26000797/LC26000381</p>	APPROVED BY:	<p>CITY OF TAMPA UNIVERSITY PUMPING STATION AUTOMATIC BAR SCREEN</p>	DESCRIPTION:	<p>EXISTING ANNUNCIATOR CONTROL PANEL INTERIOR DETAIL</p>	DATE:	AUGUST 2018
DRAWN	JLH		TIMOTHY THOMAS FLA. LIC. NO. 47079		DATE		GSP JOB No.	4291800
CHECKED	TD						SHEET:	E-6
REV. NO.	DATE	DESCRIPTION	REV. BY					

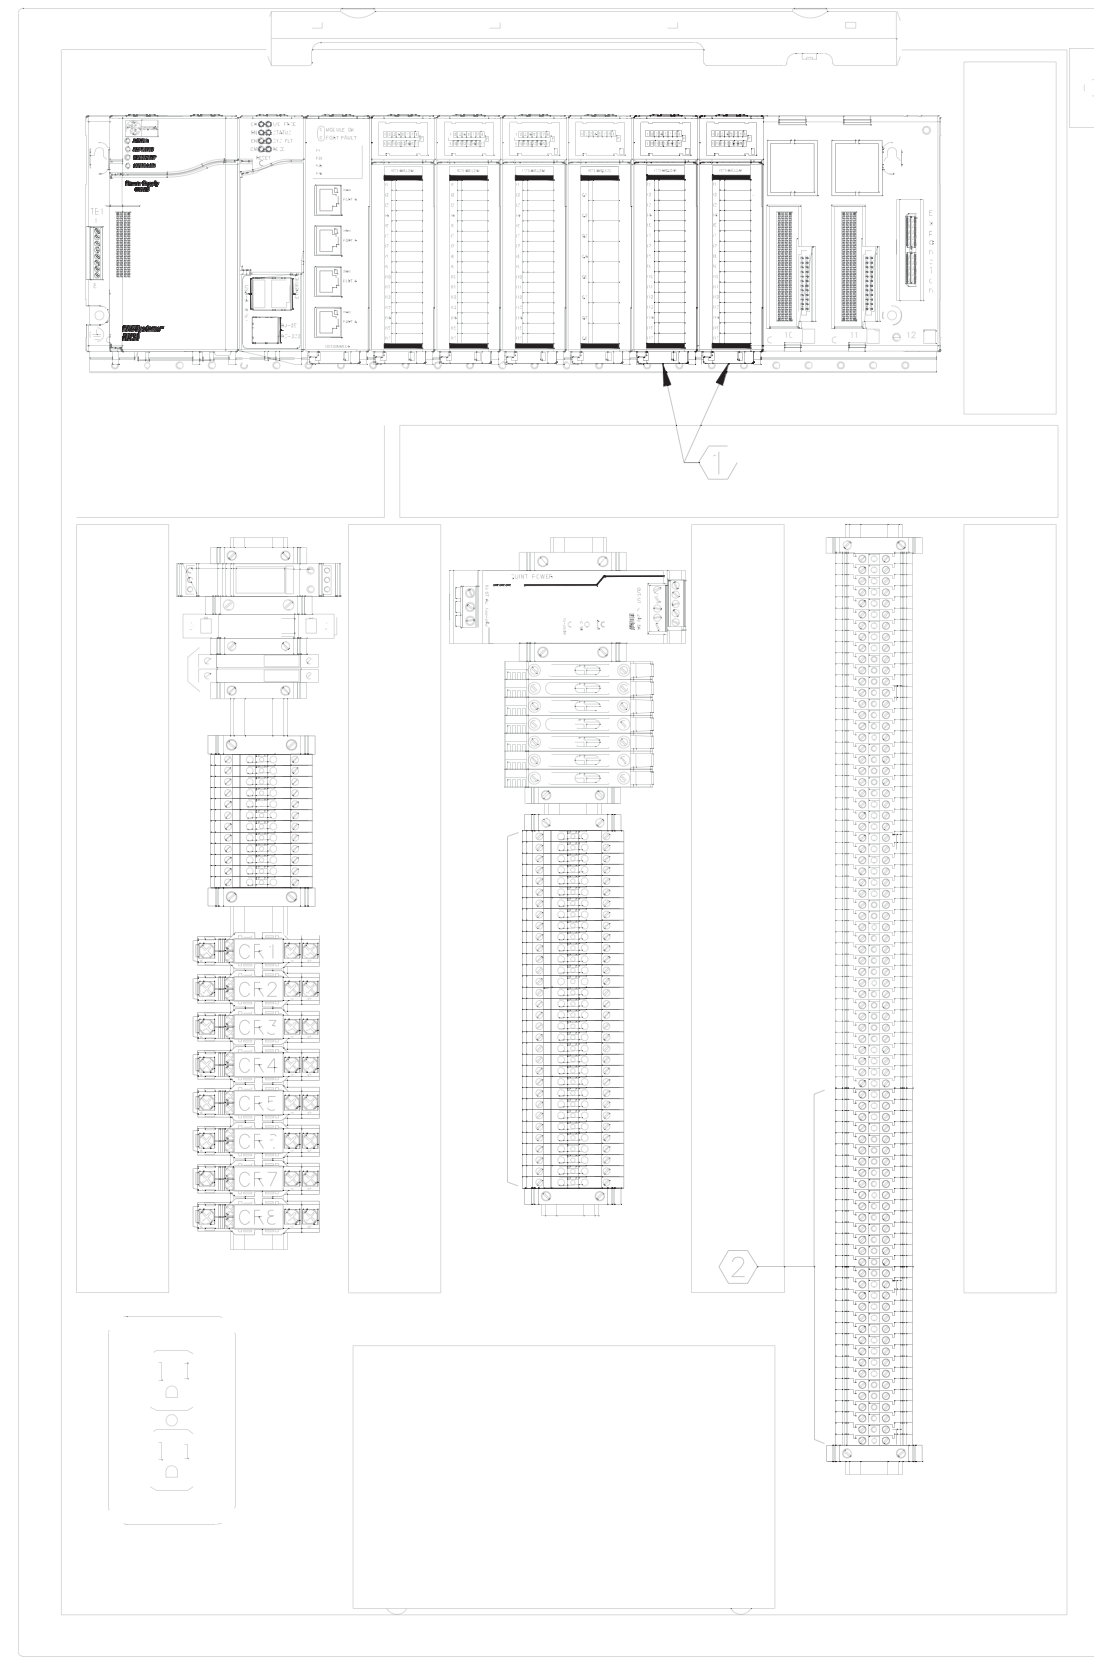

MOUNTED ON RIGHT SIDE FRAME

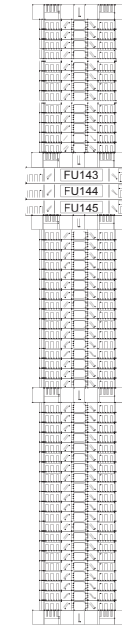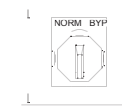

DRAWING NUMBER M-01

SUBMITTAL DRAWINGS



**City of Tampa
University Pump Station
Automatic Bar Screen
Panel Layout
Annunciator Panel**

Automated Integration
P.O. Box 777
Brandon, FL 33509

DESIGNED BY: G S & P		DATE: 12/28/19
DRAWN BY: S.Van Kley	CHKD BY: P.O'Donnell	Ai JOB No: 162J06
UL DRAWING # N/A	UL SERIAL # N/A	PROJECT NO: 18-C-00016

NO.		
02	05/14/20	As-Installed
01	12/28/19	Submittals



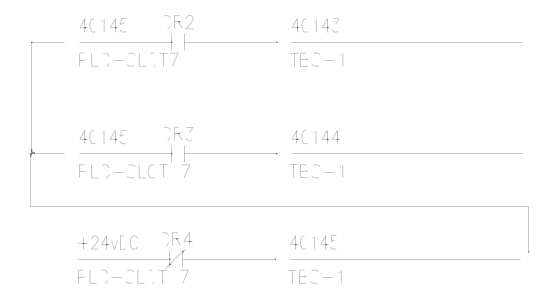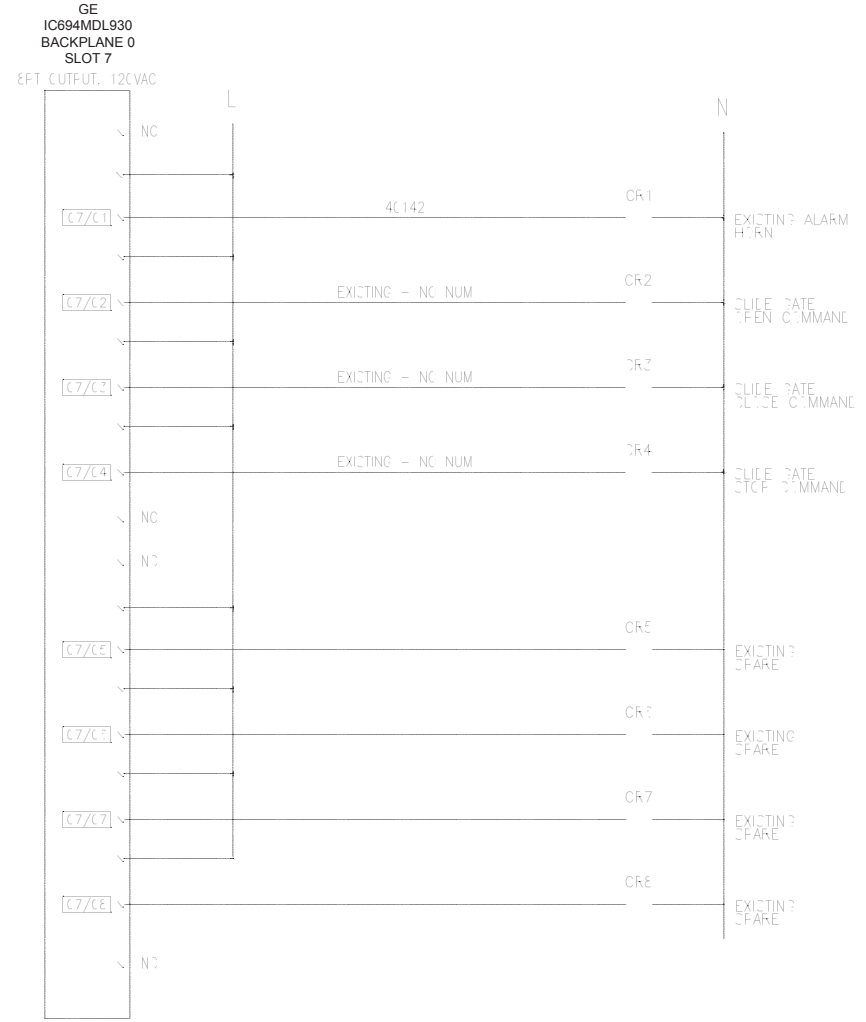

DRAWING
NUMBER
E-01

SUBMITTAL DRAWINGS


City of Tampa
University Pump Station
Automatic Bar Screen
PLC CARDS 6 & 7
Annunciator Panel

Automated Integration
333 N Falkenburg Rd.
Suit B-227
Tampa FL 33619

DESIGNED BY: G S & P		DATE: 12/28/19
DRAWN BY: N. Van Kley	CHKD BY: S. Van Kley	Ai JOB No: 162J06
UL DRAWING # N/A	UL SERIAL # N/A	PROJECT NO: 18-C-00016

NO.	DATE	DESCRIPTION
03	05/14/20	As Installed
02	04/21/20	As Modified
01	03/25/19	Submittal



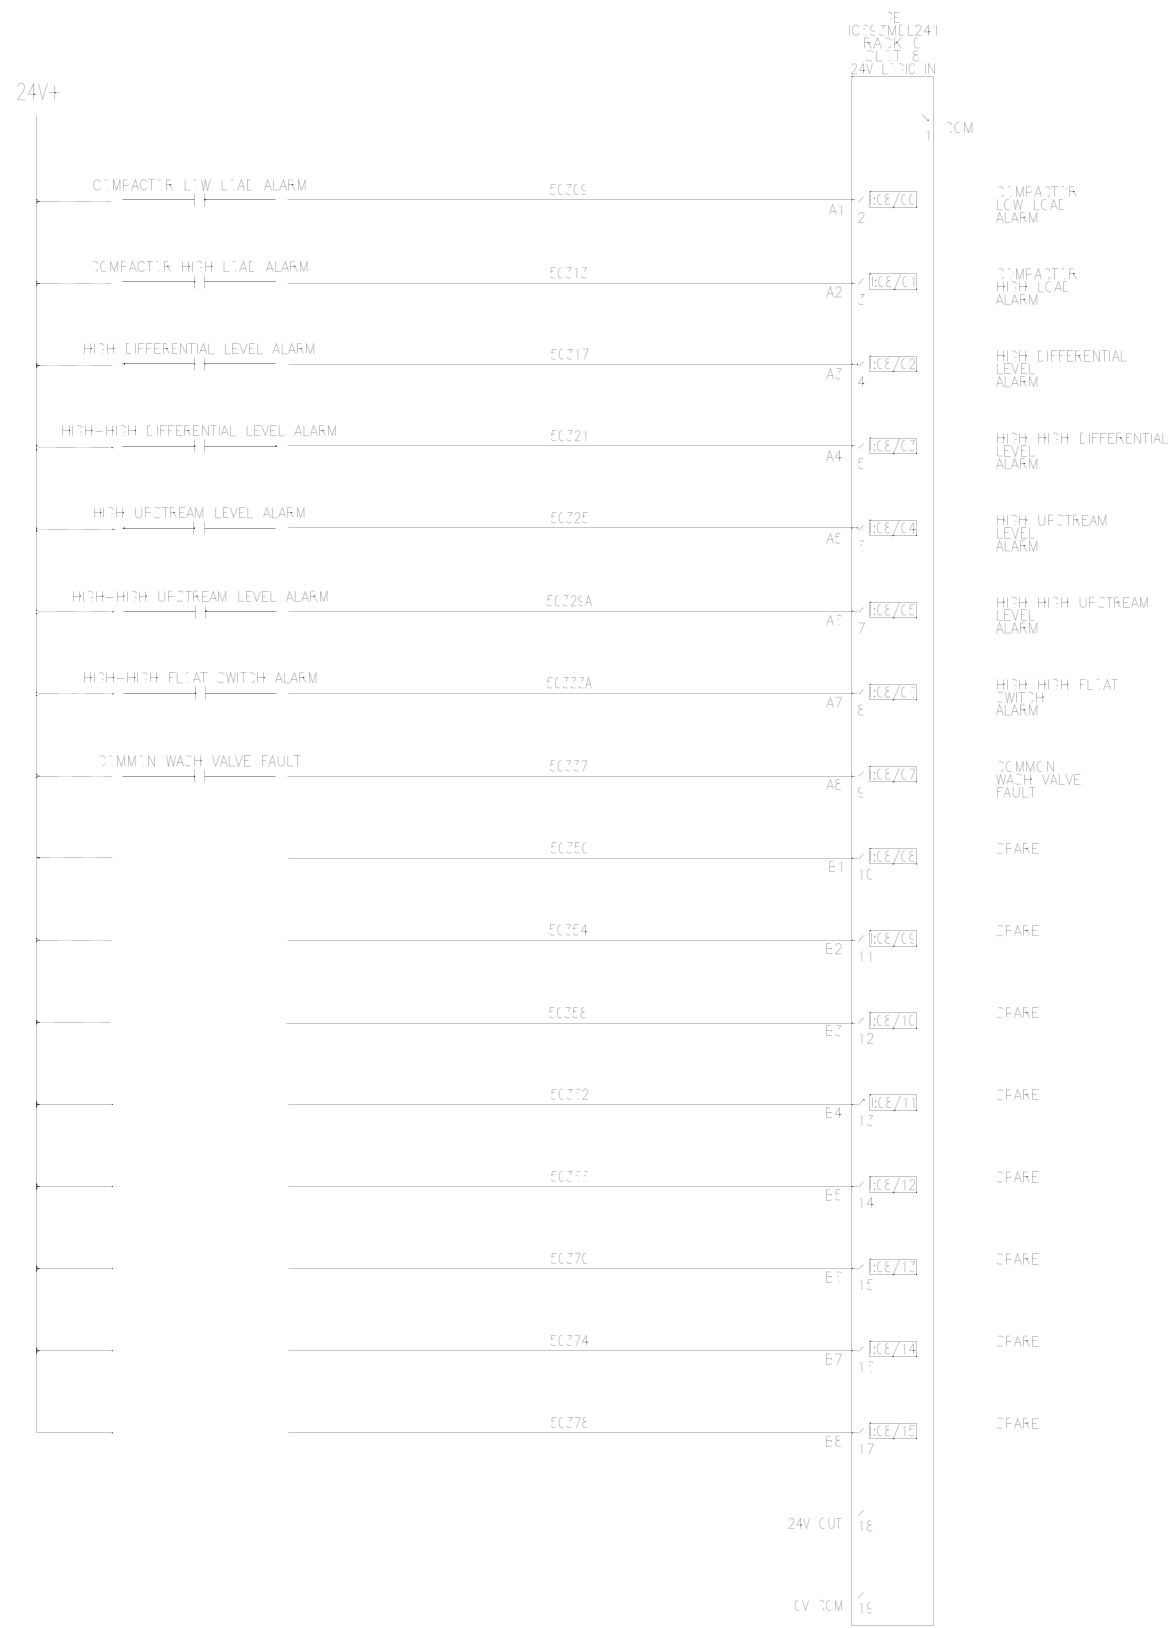

DRAWING NUMBER E-02

SUBMITTAL DRAWINGS

**City Of Tampa
University Pumping Station
Automatic Bar Screen
PLC CARDS 8 & 9
Existing Annunciator Control Panel**


Automated Integration
333 N. Falkenburg Rd.
Suite B-227
Tampa, FL 33619

DESIGNED BY: Tricon Consulting Engineers		DATE: 03/25/19
DRAWN BY: J.BUSHONG	CHKD BY: J.BUSHONG	Ai JOB No: 162J06
DRAWING # 162J06-2	SERIAL # 162J06-2	PROJECT NO: 18-C-00016

NO.			
03	05/14/20	As Installed	
02	04/21/20	As Modified	
01	03/25/19	Submittal	



MOUNTED ON RIGHT SIDE FRAME

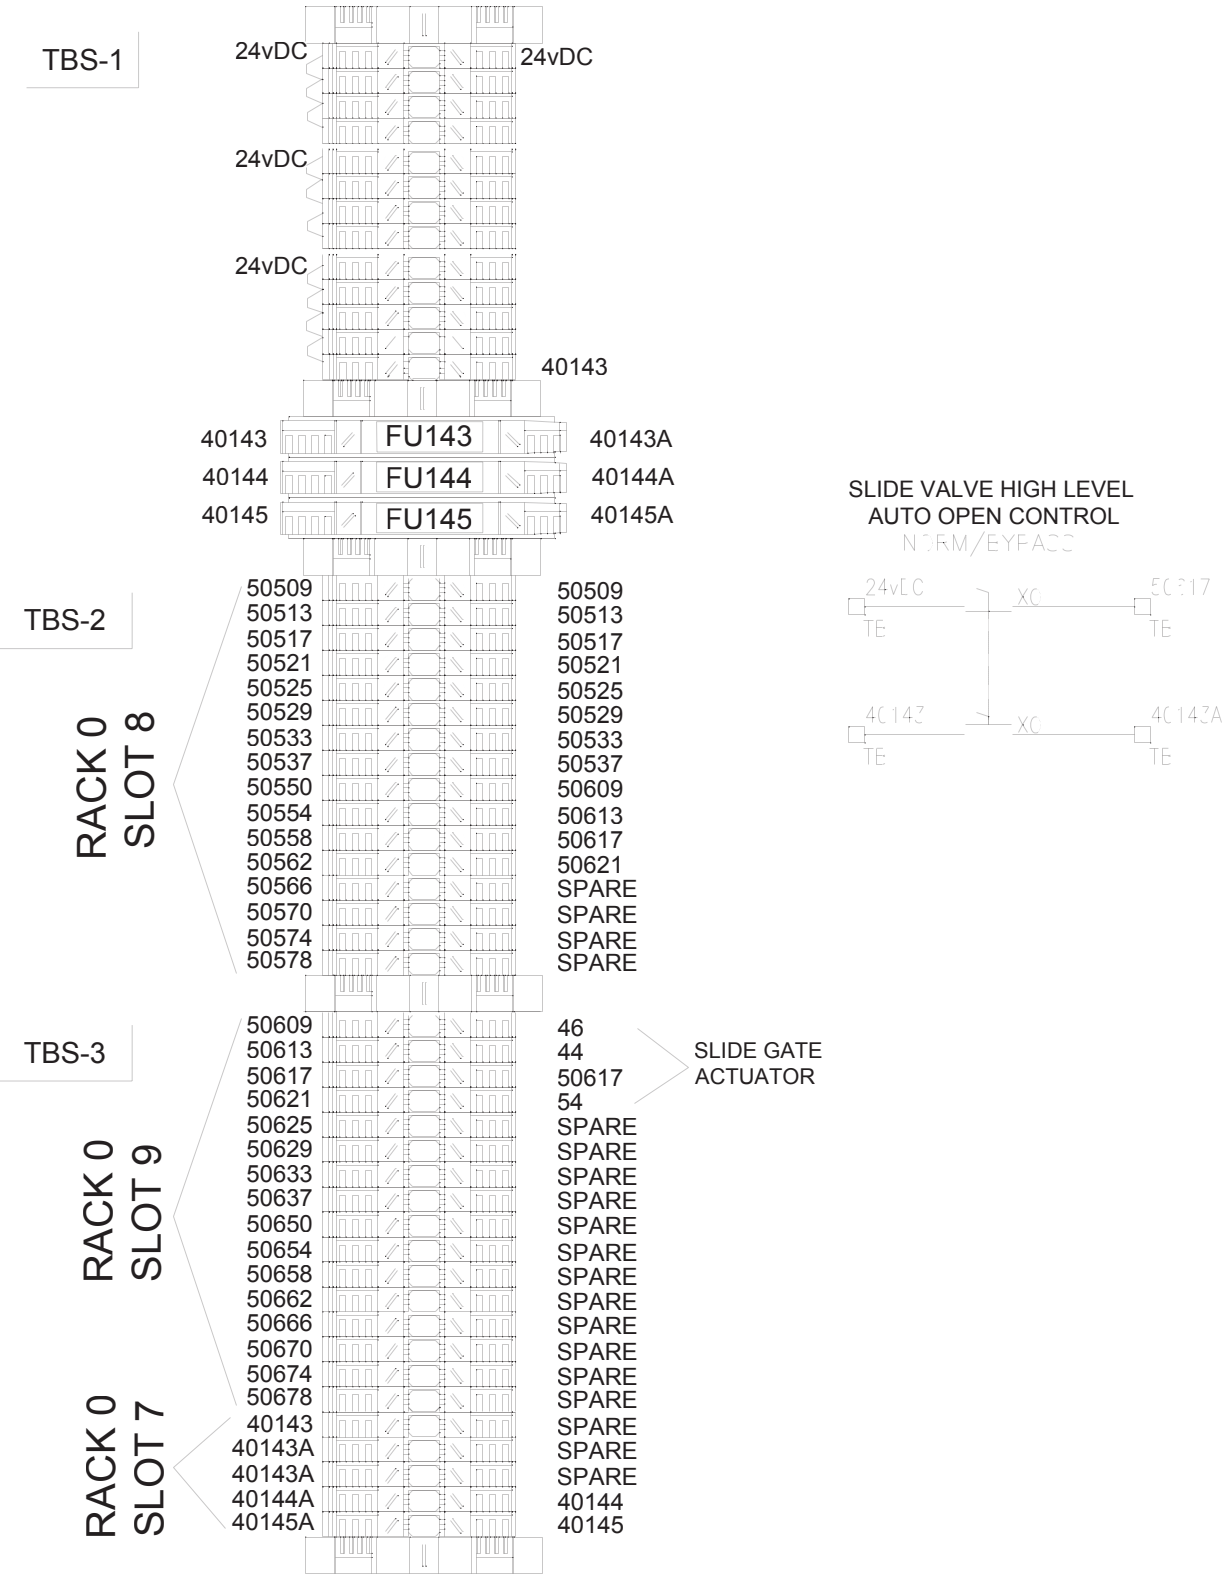

SUBMITTAL DRAWINGS

City of Tampa
University Pump Station
Automatic Bar Screen
RIGHT SIDE-FRAME TERMINALS
Annunciator Panel


Automated Integration
 333 N Falkenburg Rd.
 Suit B-227
 Tampa FL 33619

DESIGNED BY: G S & P		DATE: 12/28/19
DRAWN BY: S.Van Kley	CHKD BY: P.O'Donnell	Ai JOB No: 162J06
UL DRAWING # N/A	UL SERIAL # N/A	PROJECT NO: 18-C-00016

03	05/14/20	As-Installed
02	04/21/20	As Modified
01	06/07/19	Submittals
NO.		

DRAWING NUMBER
TB-01



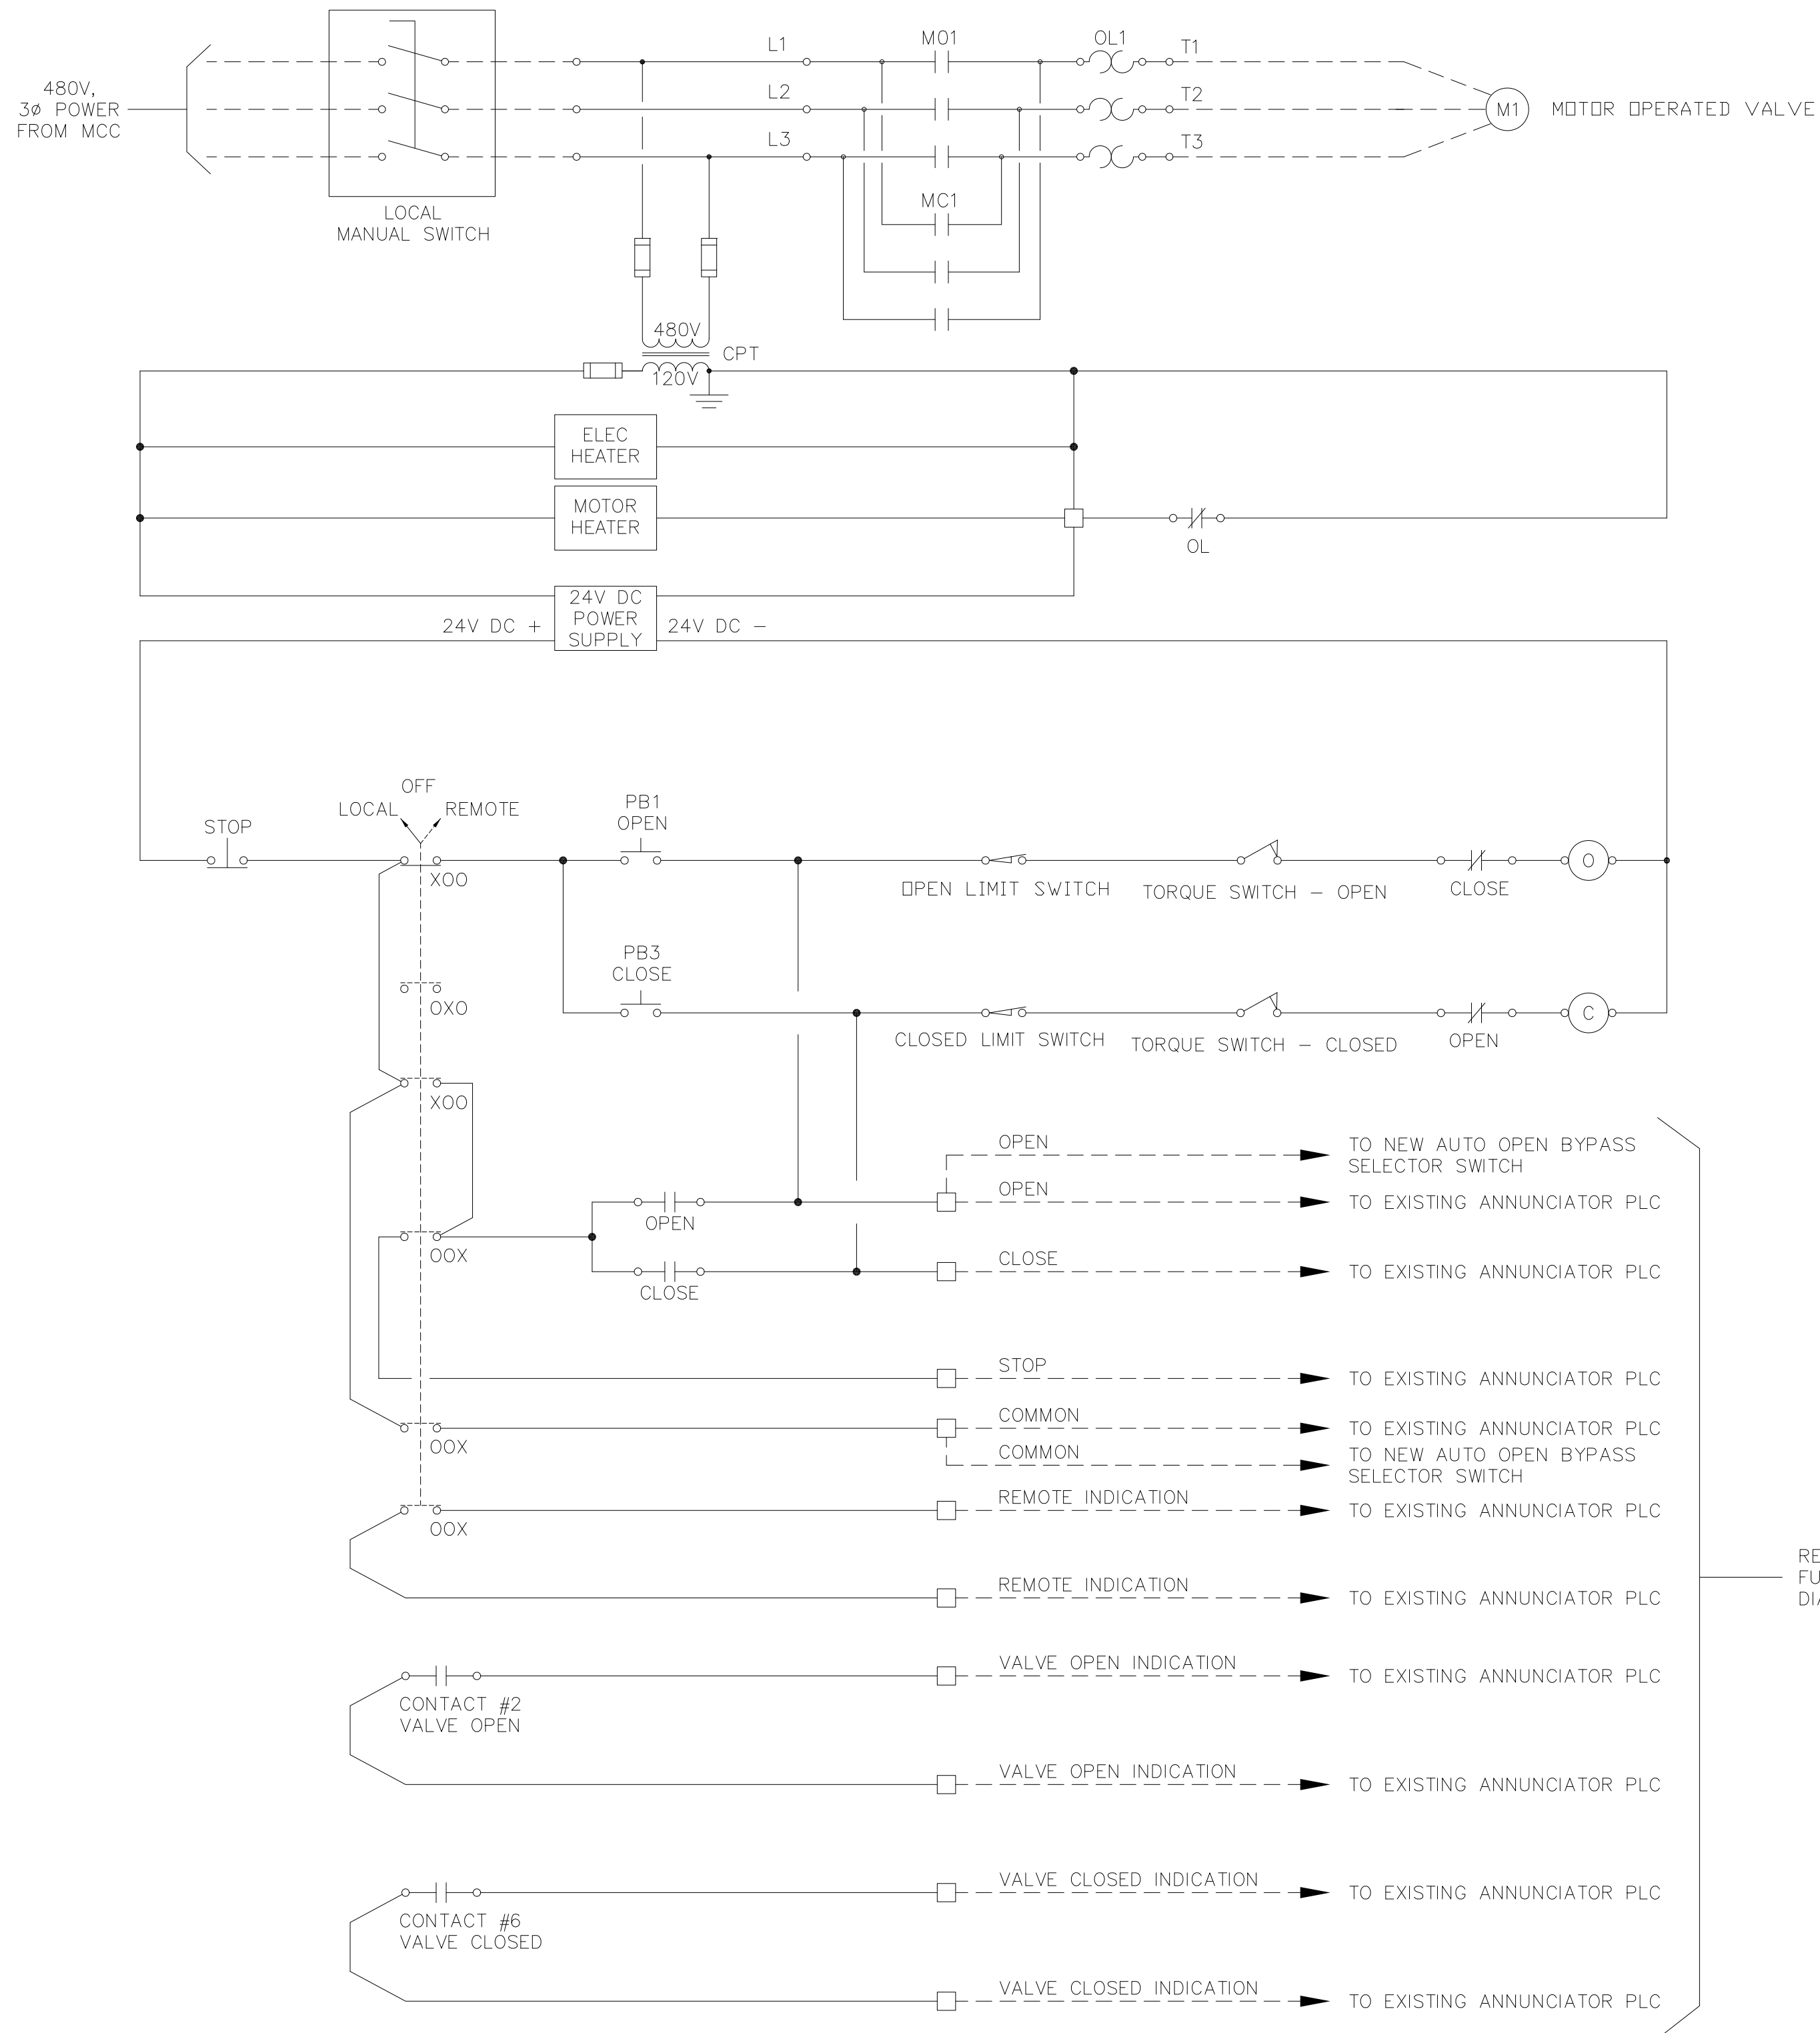

GENERAL NOTES:

1. THE CONTROL WIRING DIAGRAM PRESENTED HERE IS BASED ON THE SPECIFICATIONS AND INFORMATION REFLECTED BY A SPECIFIC MANUFACTURER. THE CONTRACTOR SHALL MODIFY THE FIELD WIRING SHOWN AS REQUIRED BASED ON THE ACTUAL ACTUATOR PURCHASED/PROVIDED.

LEGEND

----- DENOTES FIELD WIRING

☒ DENOTES TERMINAL ON ACTUATOR CONTROLLER

■ DENOTES TERMINAL IN ANNUNCIATOR PLC CABINET


SLIDE GATE ACTUATOR CONTROL WIRING



C:\TDP\Projects\2017\26-50\231703284 Gresham Uni Screen\GS Bid Border 8-15-18\E-8.dwg, Aug 15, 2018 - 11:21am

DESIGNED	TDT	<p>302 Knights Run Avenue, Suite 900 Tampa, FL 33602 813.254.5838</p> <p>FIRM'S FLORIDA CERT. NO. AAP000034/CA3806 1B26000797/LC26000381</p>	APPROVED BY:	<p>TIMOTHY THOMAS FLA. LIC. NO 47079</p>	PROJECT:	CITY OF TAMPA UNIVERSITY PUMPING STATION AUTOMATIC BAR SCREEN	DESCRIPTION:	SLIDE GATE ACTUATOR CONTROL WIRING	DATE:	AUGUST 2018	
DRAWN	JLH							GSP JOB No.	4291800		
CHECKED	TDT									SHEET:	E-8
REV. NO.	DATE		DESCRIPTION		REV. BY						23 OF 27

C:\TDP\Projects\2017\26-50\231703284 Gresham Uni Screen\GS Bid Border 8-15-18\E-9.dwg, Aug 15, 2018 - 11:10am

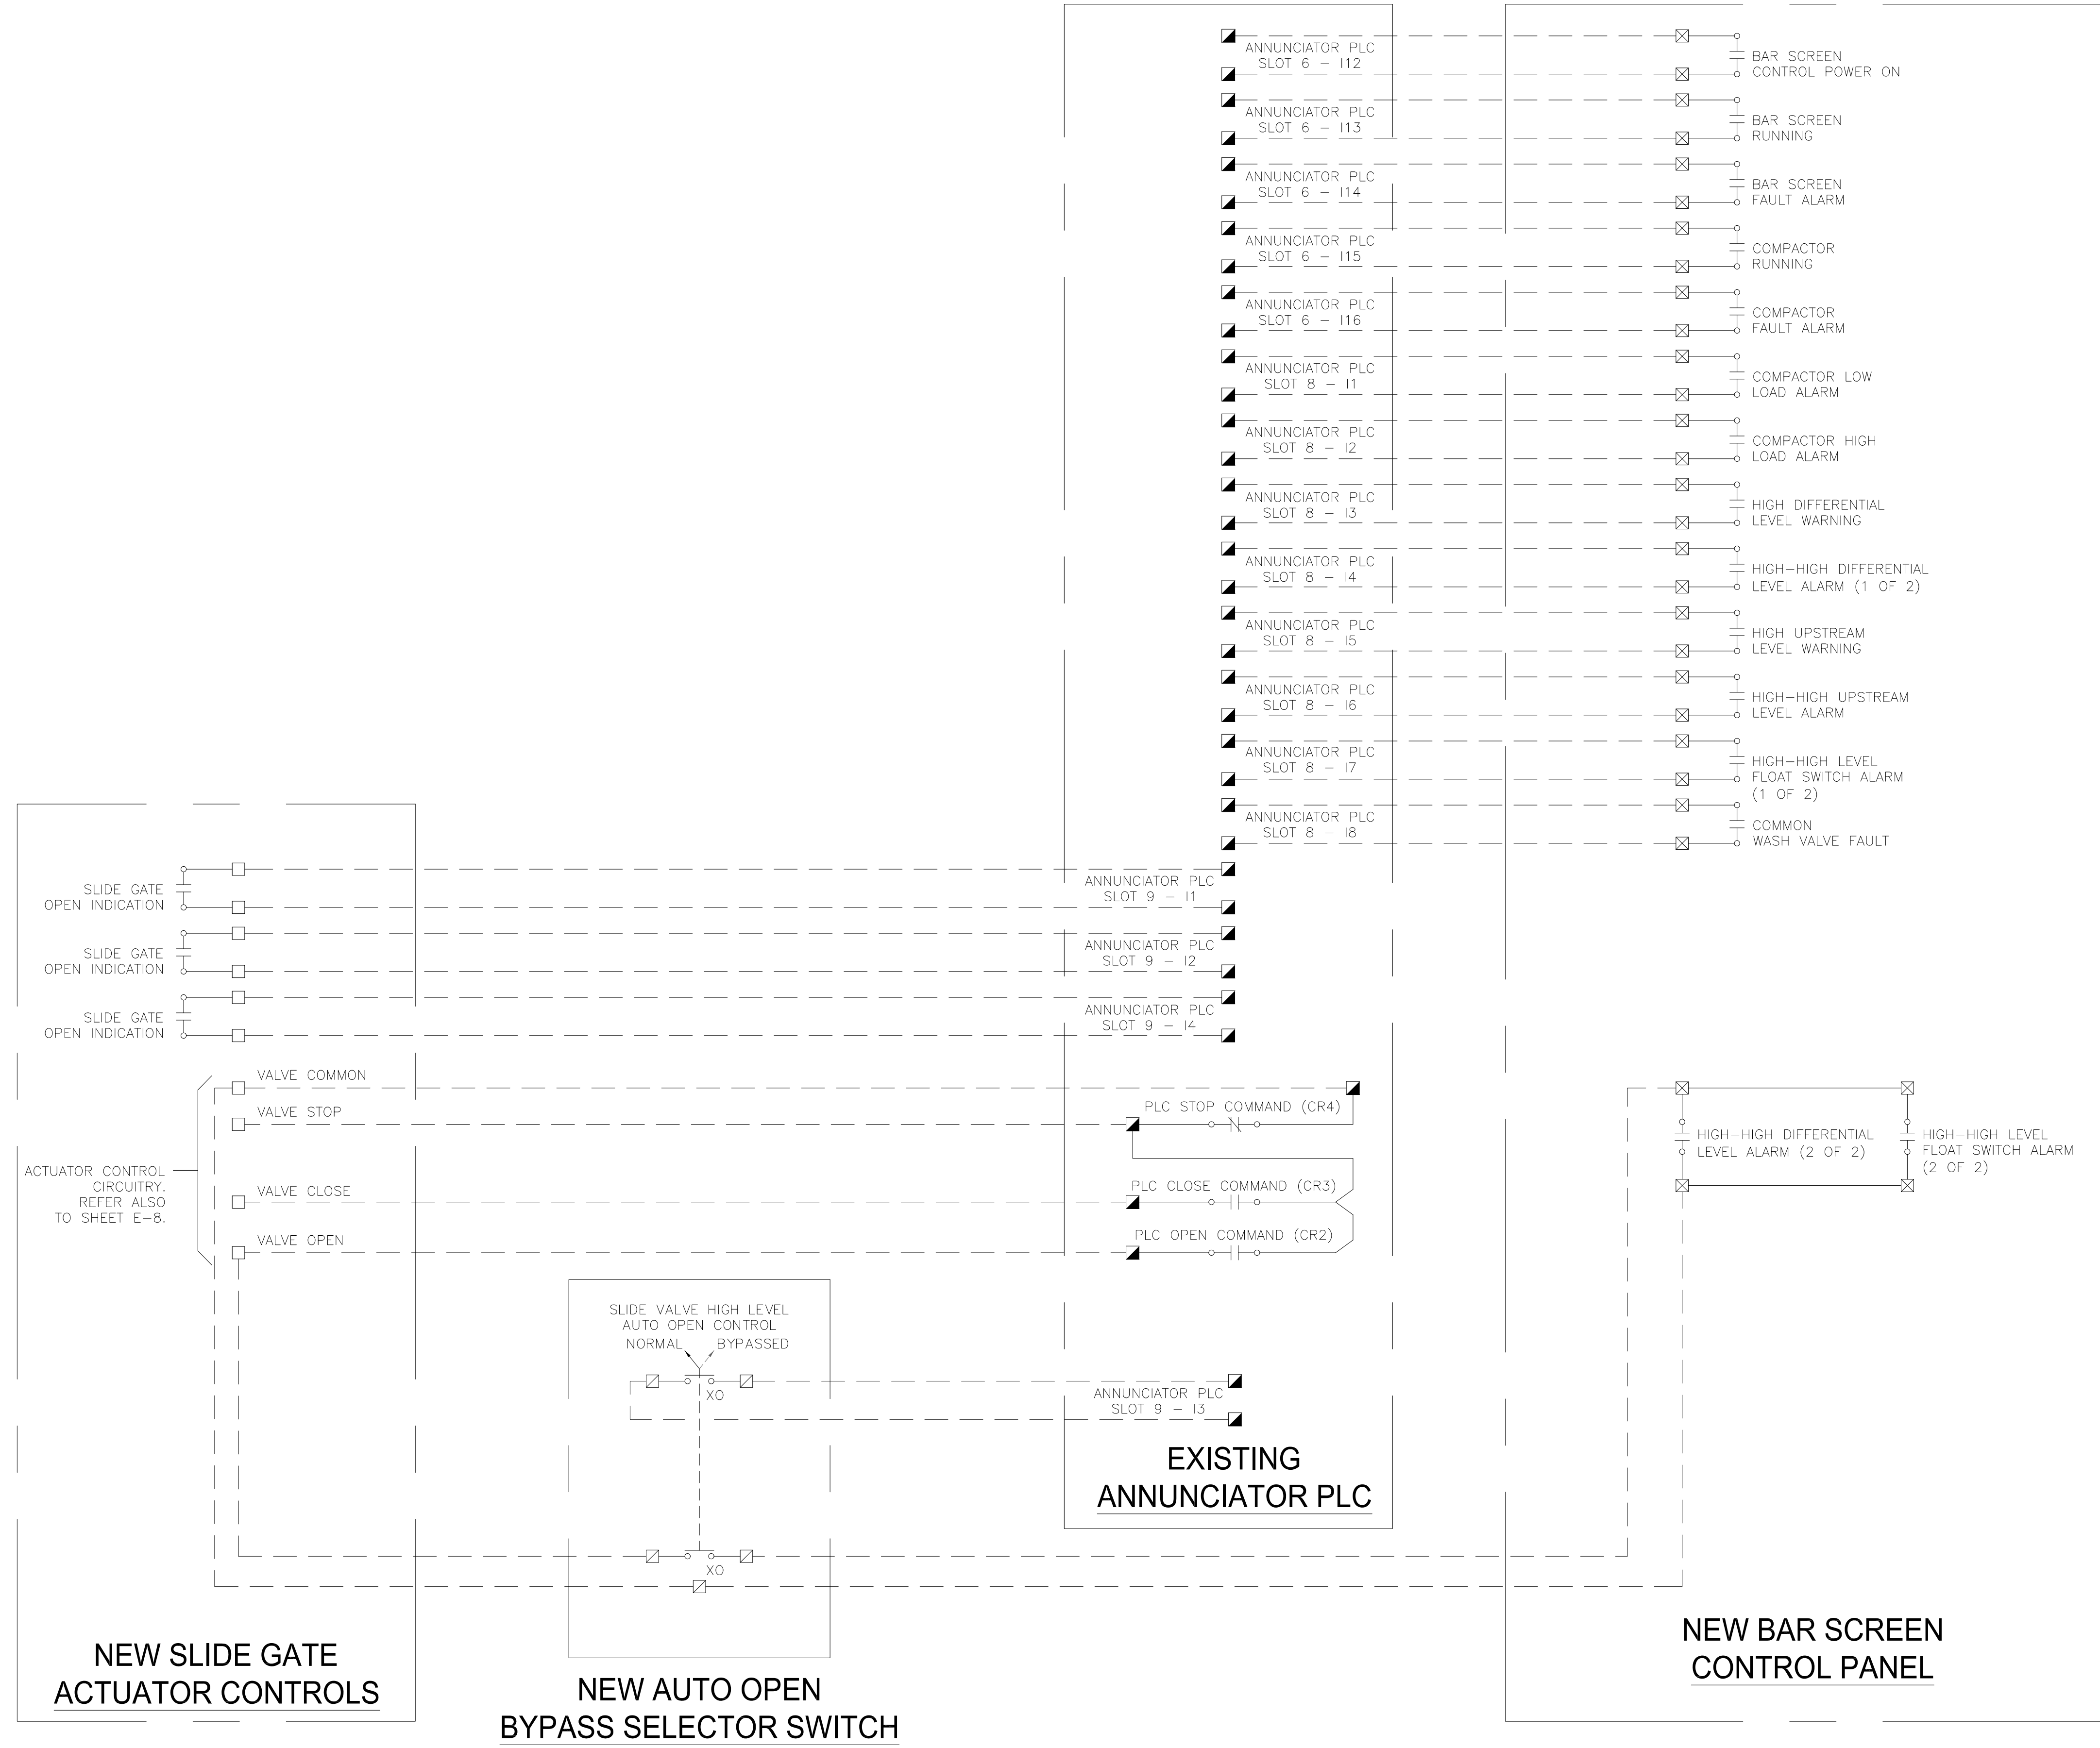


- LEGEND**
- DENOTES FIELD WIRING
 - DENOTES TERMINAL ON ACTUATOR CONTROLLER
 - ▴ DENOTES TERMINAL IN ANNUNCIATOR PLC CABINET
 - ⊠ DENOTES TERMINAL IN BAR SCREEN CONTROL PANEL
 - ⊞ DENOTES TERMINAL IN AUTO OPEN BYPASS SELECTOR SWITCH



DESIGNED	TDT	<p>302 Knights Run Avenue, Suite 900 Tampa, FL 33602 813.254.5838</p> <p>FIRM'S FLORIDA CERT. NO. AAP000034/CA3806 1B26000797/LC26000381</p>	APPROVED BY:	<p>CITY OF TAMPA UNIVERSITY PUMPING STATION AUTOMATIC BAR SCREEN</p>	DESCRIPTION:	CONTACT DEVELOPMENT DIAGRAM	DATE:	AUGUST 2018	
DRAWN	JLH		TIMOTHY THOMAS		DATE	GSP JOB No.	4291800	SHEET:	E-9 24 OF 27
CHECKED	TDT		FLA. LIC. NO.		47079				
REV. NO.	DATE		DESCRIPTION		REV. BY				

C:\TDT\Projects\2017\26-50\231703284 Gresham Uni Screen\GS Bid Border 8-15-18\E-10.dwg, Aug 15, 2018 - 11:03am

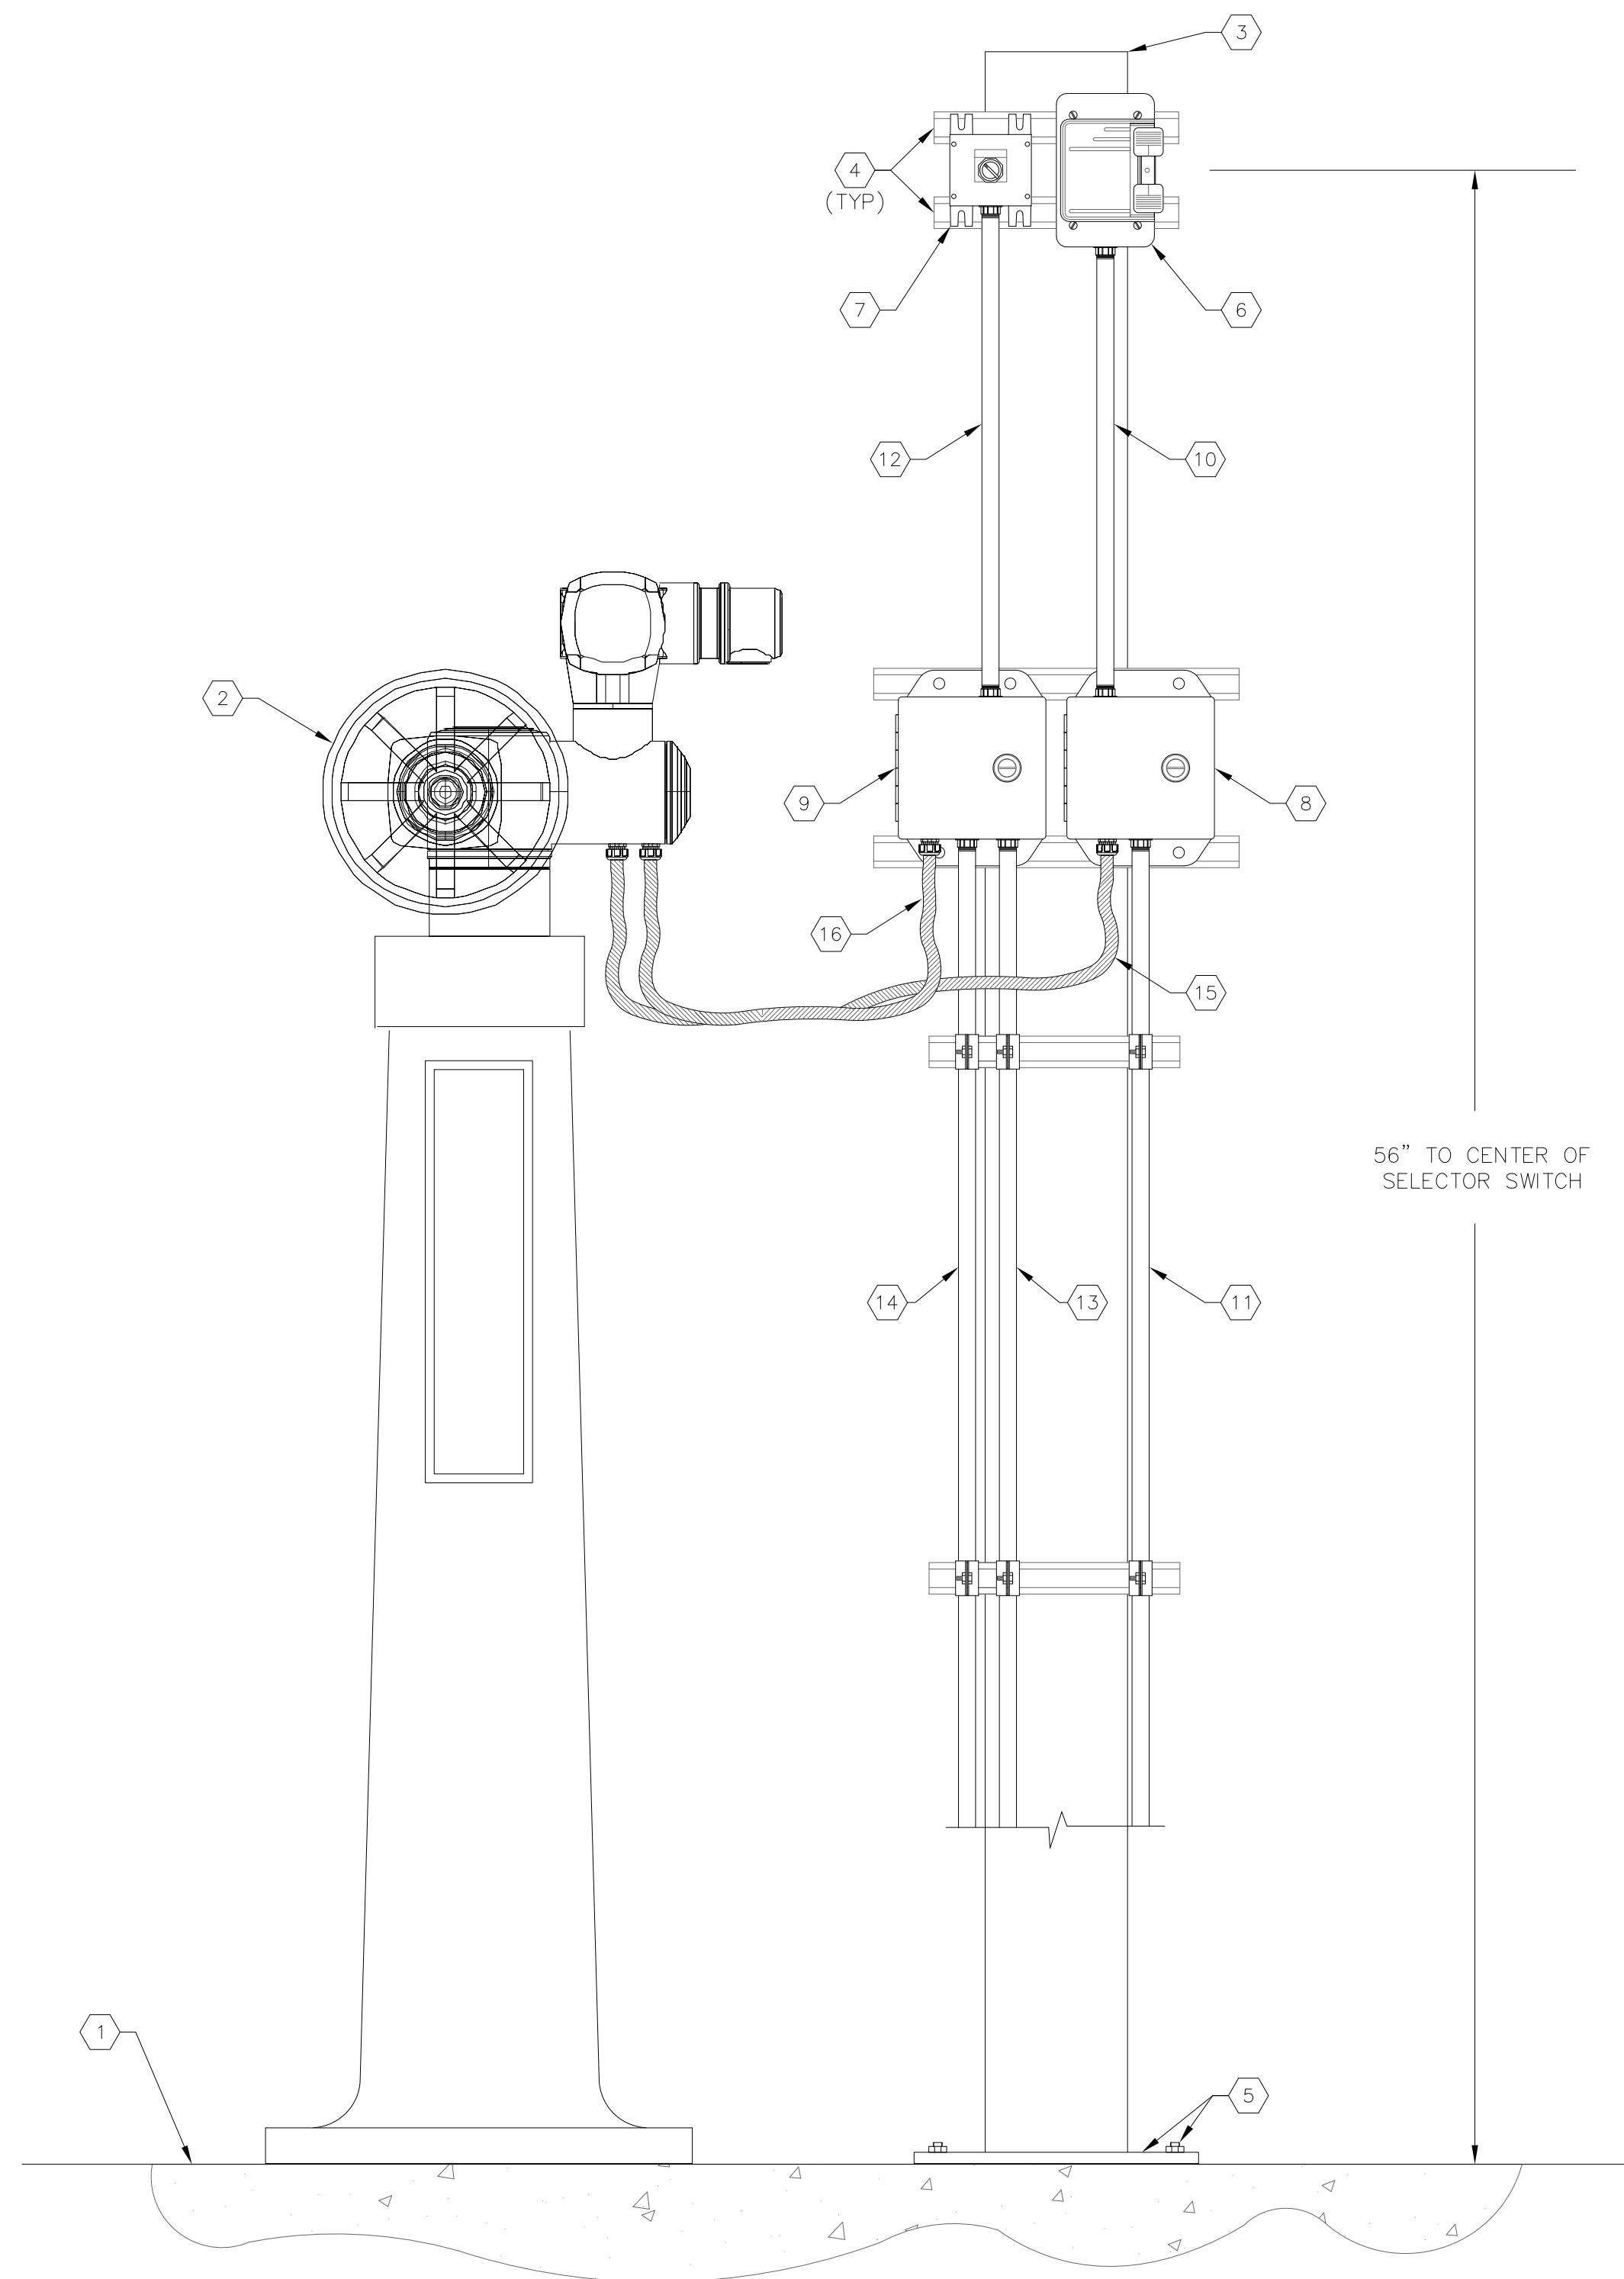

ACTUATOR DISCONNECT DETAIL

SCALE : N.T.S.

1
E-3 E-10

KEYED NOTES:

- 1 EXISTING SLAB, ELEVATION 41.25'.
- 2 PROPOSED SLIDE GATE ELECTRICAL OPERATOR AND ASSOCIATED STAND. REFER ALSO TO CIVIL/MECHANICAL DRAWINGS.
- 3 PROVIDE AND INSTALL 4" SQUARE ALUMINUM POST WITH 3/4" WALL THICKNESS. WELD 1/4" CAP TO TOP OF POST.
- 4 PROVIDE AND INSTALL 1-5/8" X 1-5/8" 316 STAINLESS STEEL UNISTRUT, ALL MOUNTING HARDWARE SHALL BE 316 STAINLESS STEEL. UNISTRUT BOLTS SHALL BE INSTALLED THROUGH POST. INSTALL NEOPRENE GASKETS WHERE STAINLESS STEEL COMES IN CONTACT WITH ALUMINUM. PROVIDE END CAPS ON ALL UNISTRUT ENDS.
- 5 PROVIDE AND INSTALL 8" X 8" X 1/2" ALUMINUM BASE PLATE. SECURE BASE PLATE TO CONCRETE W/(4) STAINLESS STEEL 1/2" DIA. X 8" BOLTS & STAINLESS STEEL HEX NUTS WITH LOCKWASHER. DRILL CONCRETE & EMBED BOLTS AND ANCHORS IN EPOXY. COAT BOTTOM OF BASE PLATE WITH ASPHALT PAINT. PROVIDE NEOPRENE GASKET BETWEEN ALL STAINLESS STEEL AND ALUMINUM COMPONENTS.
- 6 PROVIDE AND INSTALL NEW 600V, 30A, 3-POLE MANUAL SWITCH IN NEMA 4 DIE CAST ZINC ALLOY, SQUARE-D 2510KW2CH TO SERVE AS ACTUATOR 480V DISCONNECTING MEANS.
- 7 PROVIDE AND INSTALL A NEMA 4X TWO-POSITION SELECTOR SWITCH (MAINTAINED CONTACTS) IN A NEMA 4X STAINLESS STEEL ENCLOSURE, ALLEN BRADLEY, SQUARE D OR EQUAL. SELECTOR SWITCH TO BE UTILIZED TO BYPASS AUTO OPEN SLIDE GATE ON HIGH LEVEL WHEN DESIRED.
- 8 PROVIDE AND INSTALL 4" X 4" X 3" 316 STAINLESS STEEL JUNCTION BOX WITH STAINLESS STEEL HINGES AND QUARTER TURN LATCH, HAMMOND EJ443S16. JUNCTION BOX TO SERVE AS RACEWAY FOR ACTUATOR 480V CONDUCTORS (NO TERMINATIONS).
- 9 PROVIDE AND INSTALL 4" X 4" X 3" 316 STAINLESS STEEL JUNCTION BOX WITH STAINLESS STEEL HINGES AND QUARTER TURN LATCH, HAMMOND EJ443S16. JUNCTION BOX TO SERVE AS RACEWAY FOR ACTUATOR 24V DC CONTROL CONDUCTORS (NO TERMINATIONS).
- 10 PROVIDE AND INSTALL NEW 3/4" RIGID ALUMINUM CONDUIT WITH 6-#10 + 1-#10 GND FOR SLIDE GATE ACTUATOR 480V, 3Ø FEEDER.
- 11 PROVIDE AND INSTALL NEW 3/4" RIGID ALUMINUM CONDUIT WITH 3-#10 + 1-#10 GND TO EXISTING MCC FOR SLIDE GATE ACTUATOR 480V, 3Ø FEEDER. REFER TO SHEET E-5 FOR EXISTING MCC LOCATION.
- 12 PROVIDE AND INSTALL NEW 3/4" RIGID ALUMINUM CONDUIT WITH 3-#14 + 1-#14 GND FOR SLIDE GATE ACTUATOR AUTO CLOSE BYPASS SELECTION.
- 13 PROVIDE AND INSTALL NEW 3/4" RIGID ALUMINUM CONDUIT WITH 2-#14 + 1-#14 GND TO NEW BAR SCREEN CONTROL PANEL (REFER TO SHEET E-3 FOR CONTROL PANEL LOCATION) FOR SLIDE GATE ACTUATOR AUTO CLOSE BYPASS SELECTION.
- 14 PROVIDE AND INSTALL NEW 3/4" RIGID ALUMINUM CONDUIT WITH 12-#14 + 1-#14 GND TO EXISTING ANNUNCIATOR CONTROL PANEL FOR NEW SLIDE GATE OPERATOR INPUT/OUTPUTS (4-#14 OPEN, CLOSE, STOP COMMANDS AND COMMAND; 2-#14 VALVE UNDER REMOTE CONTROL INDICATION; 2-#14 VALVE OPEN INDICATION; 2-#14 VALVE CLOSED INDICATION; 2-#14 AUTO CLOSE HIGH LEVEL BYPASS). REFER TO SHEET E-5 FOR EXISTING ANNUNCIATOR CONTROL PANEL LOCATION.
- 15 PROVIDE AND INSTALL NEW 3/4" LIQUIDTIGHT FLEXIBLE NONMETALLIC CONDUIT WITH 3-#10 + 1-#10 GND FOR SLIDE GATE ACTUATOR 480V, 3Ø FEEDER.
- 16 PROVIDE AND INSTALL NEW 3/4" LIQUIDTIGHT FLEXIBLE NONMETALLIC CONDUIT WITH 12-#14 + 1-#14 GND FOR SLIDE GATE ACTUATOR 24V DC CONTROLS.

GENERAL NOTES:


1. CONTRACTOR SHALL COORDINATE THE EXACT LOCATION OF THE ACTUATOR DISCONNECT WITH THE CITY OF TAMPA.
2. REFER TO SHEET E-7 FOR I/O ASSIGNMENTS AND LISTING. REFER TO SHEET E-9 FOR CONTACT DEVELOPMENT.



777 S. Harbour Island Blvd.
Suite 350
Tampa, FL 33602
813.227.9190
Certificate of Authorization No. 8363

REV. NO.	DATE	DESCRIPTION	REV. BY

DESIGNED	TDT
DRAWN	JLH
CHECKED	TDT


GS & P
 302 Knights Run Avenue, Suite 900
 Tampa, FL 33602
 813.254.5838
 FIRM'S FLORIDA
 CERT. NO.
 AAP000034/CA3806
 IB26000797/LC26000381


APPROVED BY:	DATE
TIMOTHY THOMAS FLA. LIC. NO. 47079	




PROJECT:	CITY OF TAMPA UNIVERSITY PUMPING STATION AUTOMATIC BAR SCREEN
----------	---

DESCRIPTION:	ACTUATOR DISCONNECT DETAIL
--------------	----------------------------------


DATE:	AUGUST 2018
GSP JOB No.	4291800
SHEET:	E-10 25 OF 27

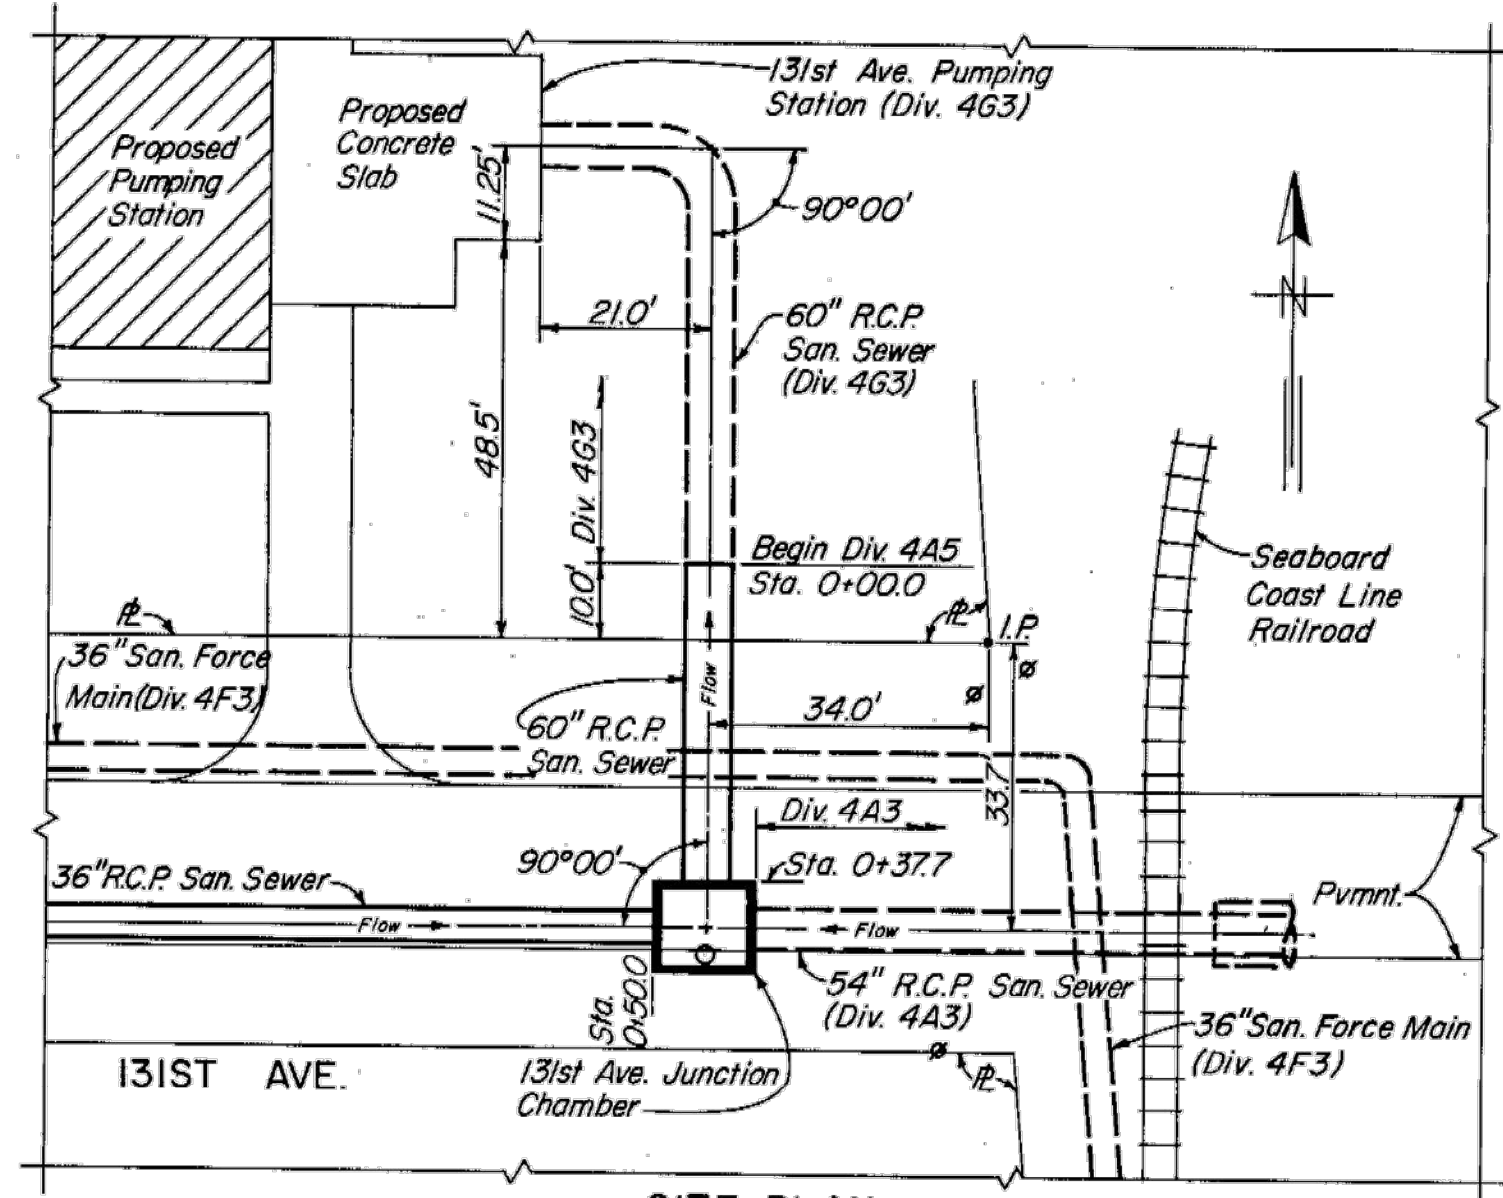


SITE PLAN
SCALE: 1" = 20'

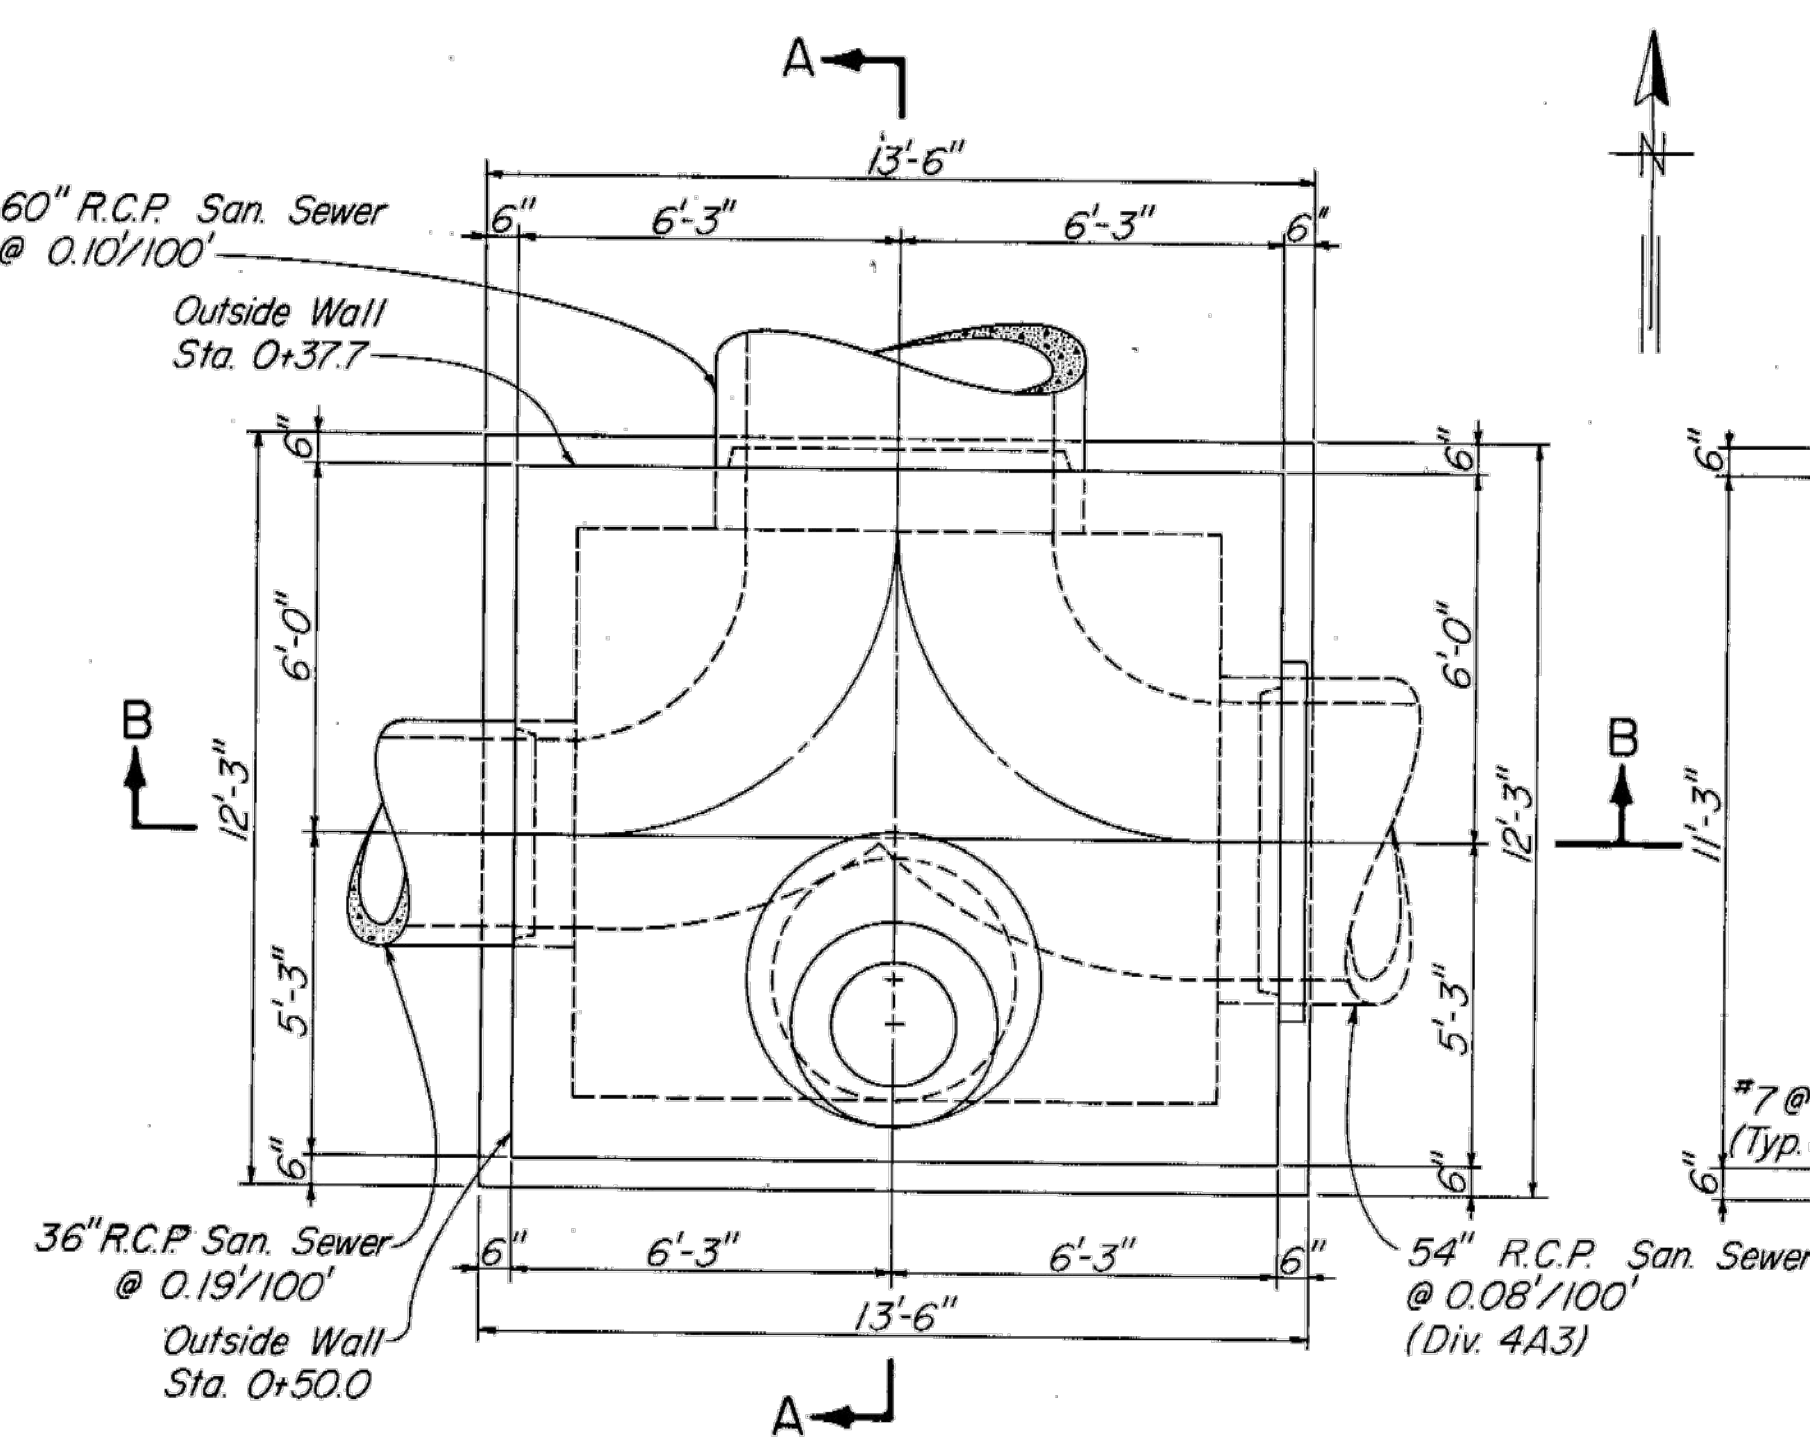

PLAN
SCALE: 3/8" = 1'-0"

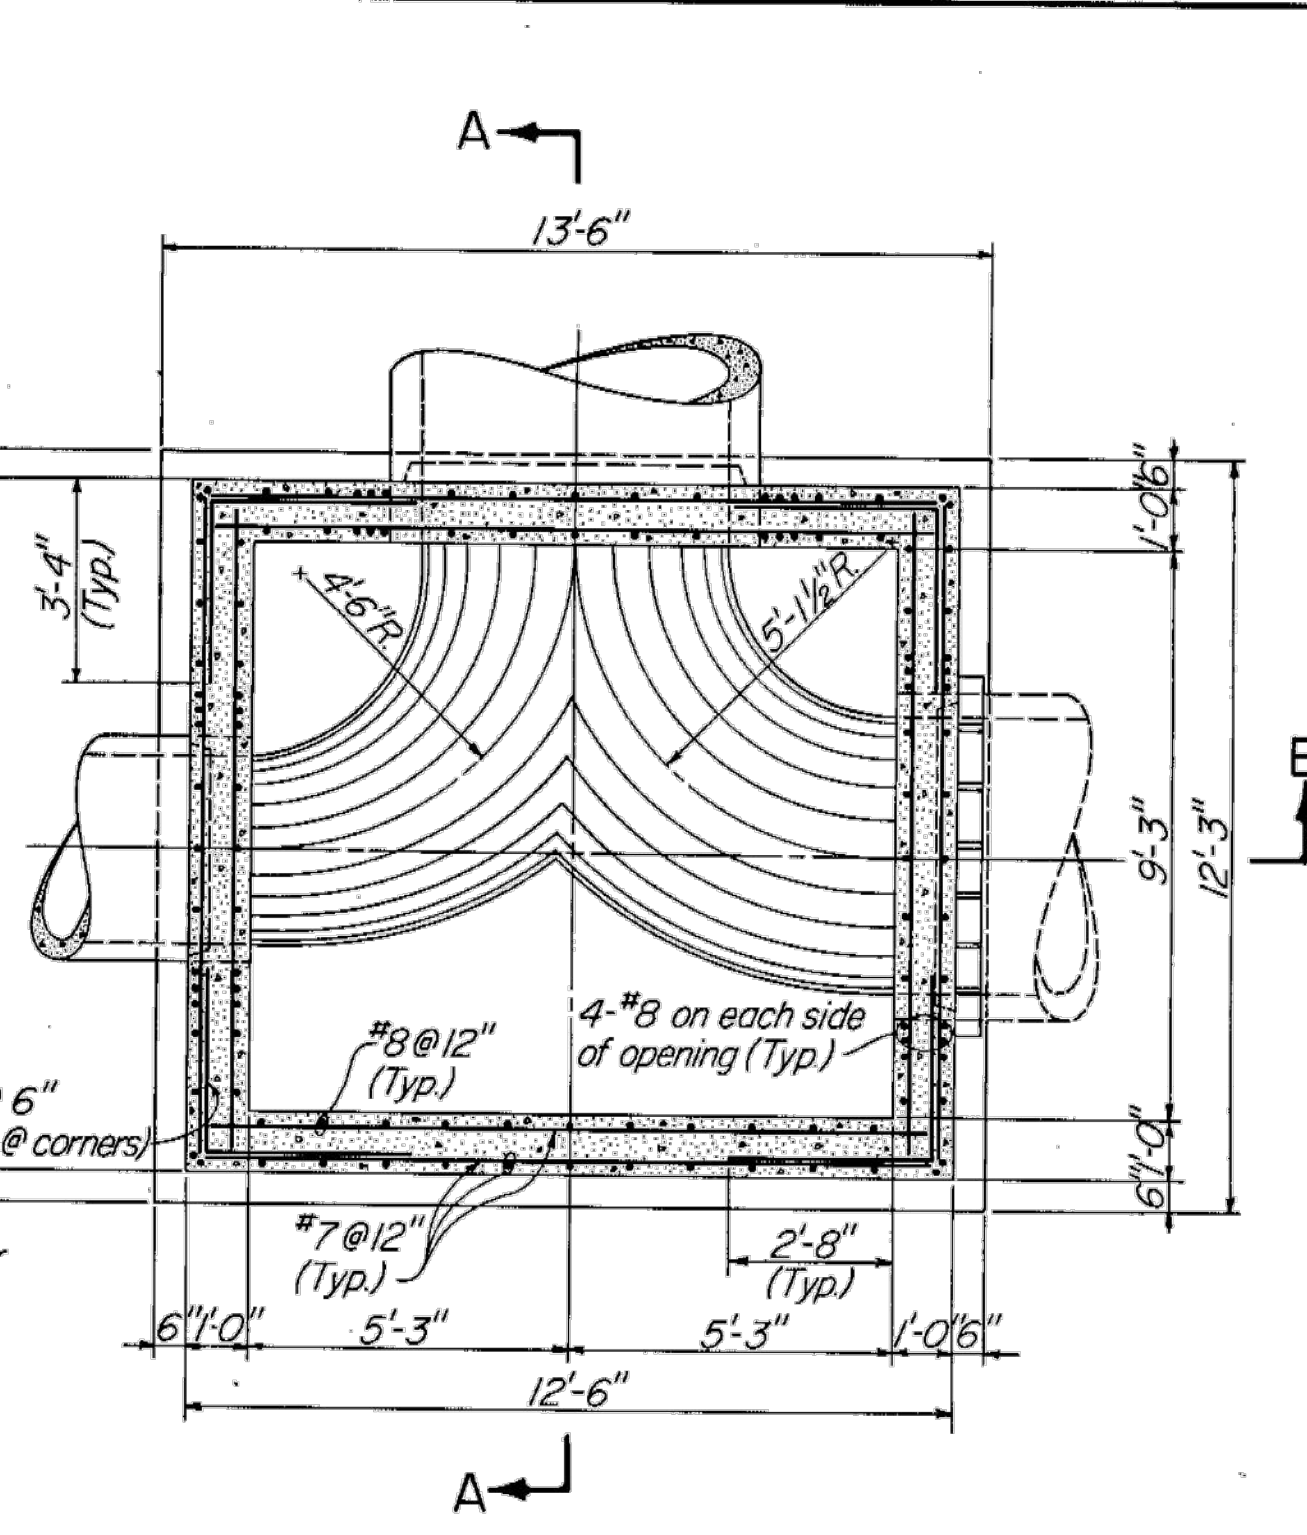


SECTIONAL PLAN C-C
SCALE: 3/8" = 1'-0"

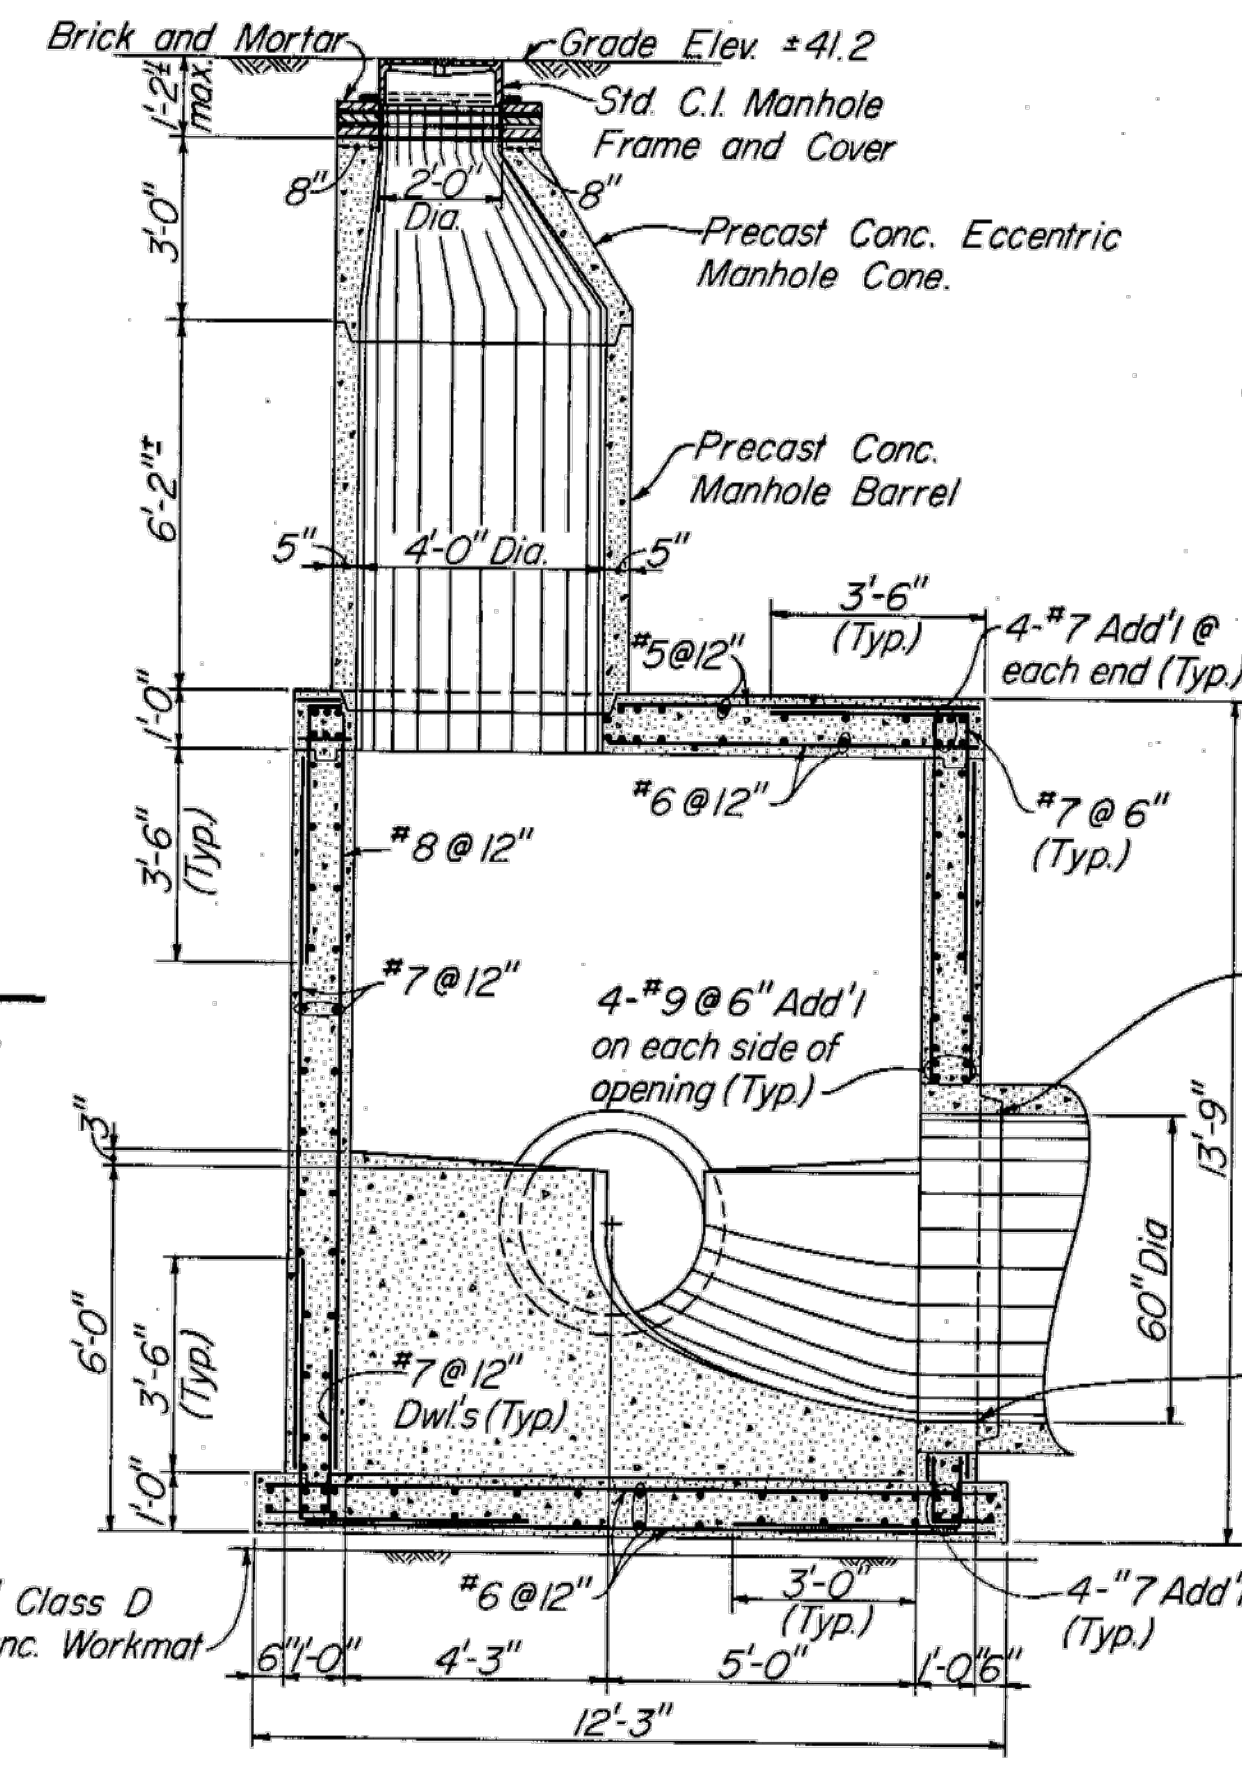


SECTION A-A
SCALE: 3/8" = 1'-0"

- Notes:
1. Precast Concrete Eccentric Manhole Cone and Manhole Barrel shall conform to ASTM Des. C 478
 2. Interior surfaces of Junction Chamber shall be lined with plastic sheet lining as shown in detail on Sheet 7.
 3. Install approved, continuous, 4-inch wide, flat, ribbed, center-bulb type P.V.C. waterstops in all construction joints. Waterstops shall not be less than 1/8-inch thick at the narrowest point and not less than 3/8-inch thick immediately adjacent to the bulb.

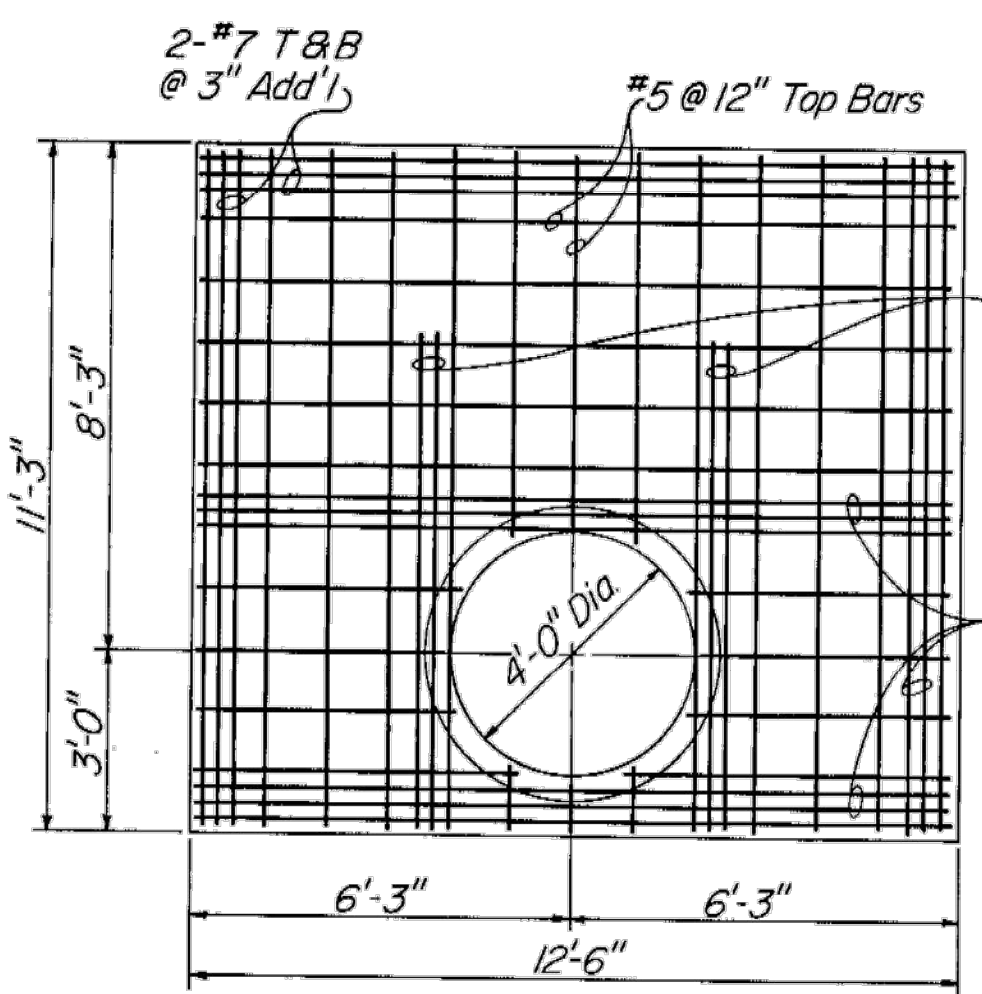

ROOF PLAN
SCALE: 3/8" = 1'-0"

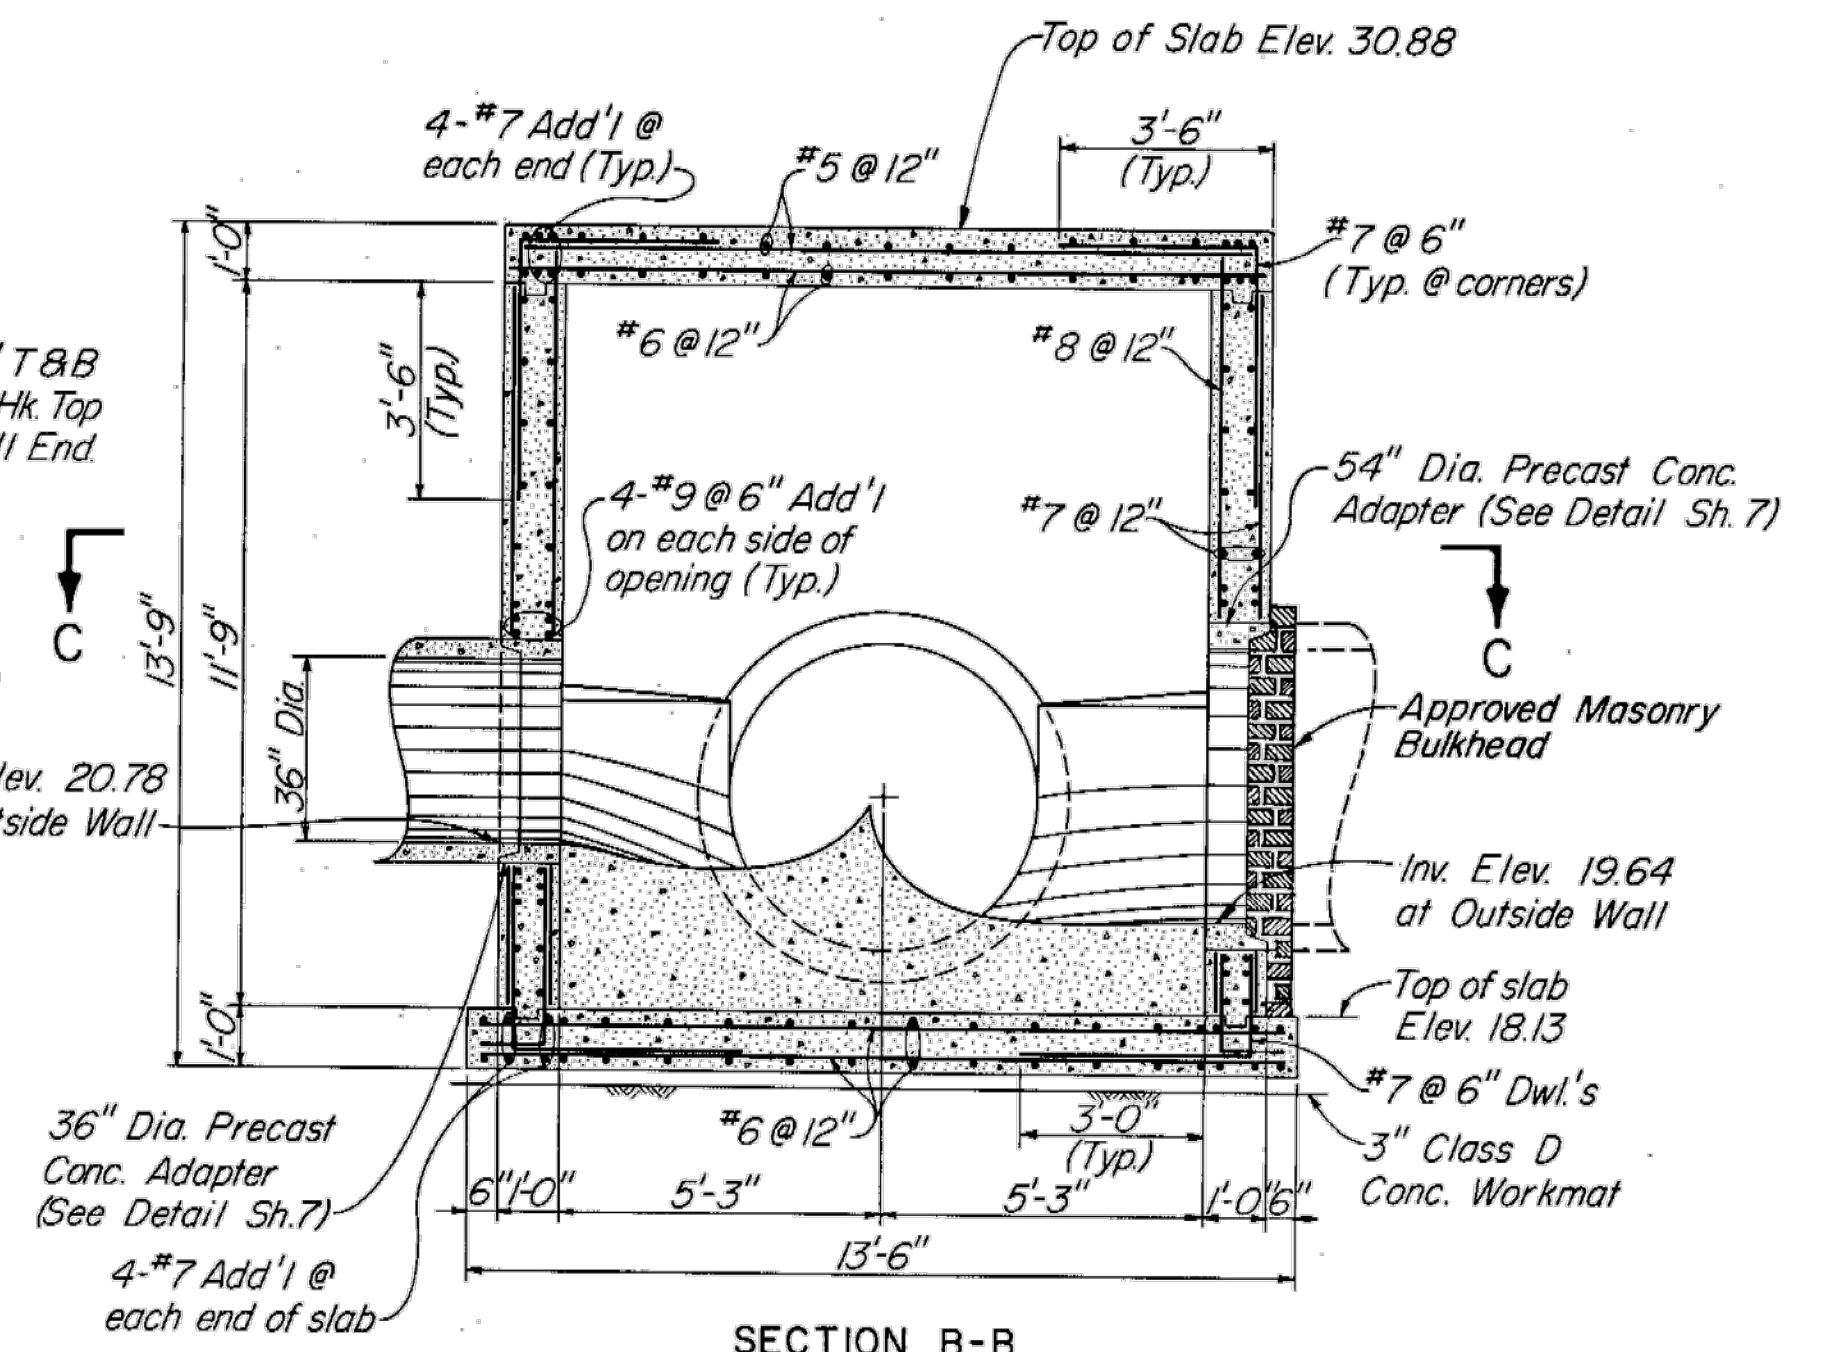

SECTION B-B
SCALE: 3/8" = 1'-0"

AS BUILT
c.s/wa 10/02

GREELEY AND HANSEN ENGINEERS 222 S. RIVERSIDE PLAZA CHICAGO, ILLINOIS 60606	DESIGNED SMK, T.L.W. DRAWN K.E.F. CHECKED T.L.W.	APPROVED Supt., Dept. of Sanitary Sewers DATE: _____ GREELEY AND HANSEN, ENGINEERS	SCALE 0 20 40 FT 1" = 20' 0 1 2 3 4 5 6 7 FT 3/8" = 1'-0"	CITY OF TAMPA, FLORIDA SEWAGE DISPOSAL SYSTEM 131ST AVE. INTERCEPTING SEWER(WEST)	DIVISION 4A5 131ST AVE. JUNCTION CHAMBER DETAILS	PROJ. NO. S 202-70-300 4A5 SHEET 6 OF 10. DATE SEPT. 1972 REV. 1
	REVISION NO. DATE APP.	REVISION NO. DATE APP.	REVISION NO. DATE APP.	REVISION NO. DATE APP.	REVISION NO. DATE APP.	REVISION NO. DATE APP.

INFORMATION PURPOSES ONLY

P:\4291800\REF-1.dwg, Aug 15, 2018 - 9:31am

DESIGNED: G DICK		302 Knights Run Avenue, Suite 900 Tampa, FL 33602 813.254.5838 FIRM'S FLORIDA CERT. NO. AAP000034/CA3806 IB26000797/LC26000381	APPROVED BY: _____		PROJECT: CITY OF TAMPA UNIVERSITY PUMPING STATION AUTOMATIC BAR SCREEN	DESCRIPTION: JUNCTION CHAMBER DETAILS	DATE: AUGUST 2018
DRAWN: O GOMEZ			JOSEPH B. BARKSDALE FLA. LIC. NO. 46545		DATE: _____		SHEET: REF-1 27 OF 27
REV. NO. DATE DESCRIPTION	REV. BY	CHECKED: G JACOB					